

6304 Sable Ln
0143150

CERTIFICATE OF COMPLETION
GUILFORD COUNTY DEPARTMENT OF PUBLIC HEALTH


100-4A

SEPTIC TANK INSPECTION CERTIFICATE

Name Godfrey, John Date 11-6-87

Location Lots 20 & 21 AS ONE Lot E.K. Thrower S/D
SABLE LANE

Installation 1400gpi 600' Contractor Goldston

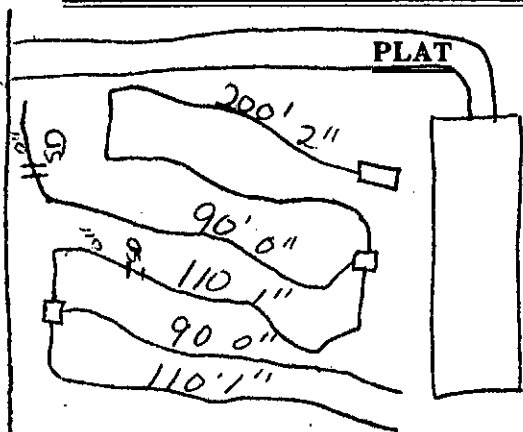

Remarks

Approved

Disapproved

[Handwritten signature]
(Sanitarian)

Building Permit No. 42323

Health Department Permit No. 017309