


RENOVATIONS FOR THE WILLIAMS FAMILY


BUILD SET 10/8/15

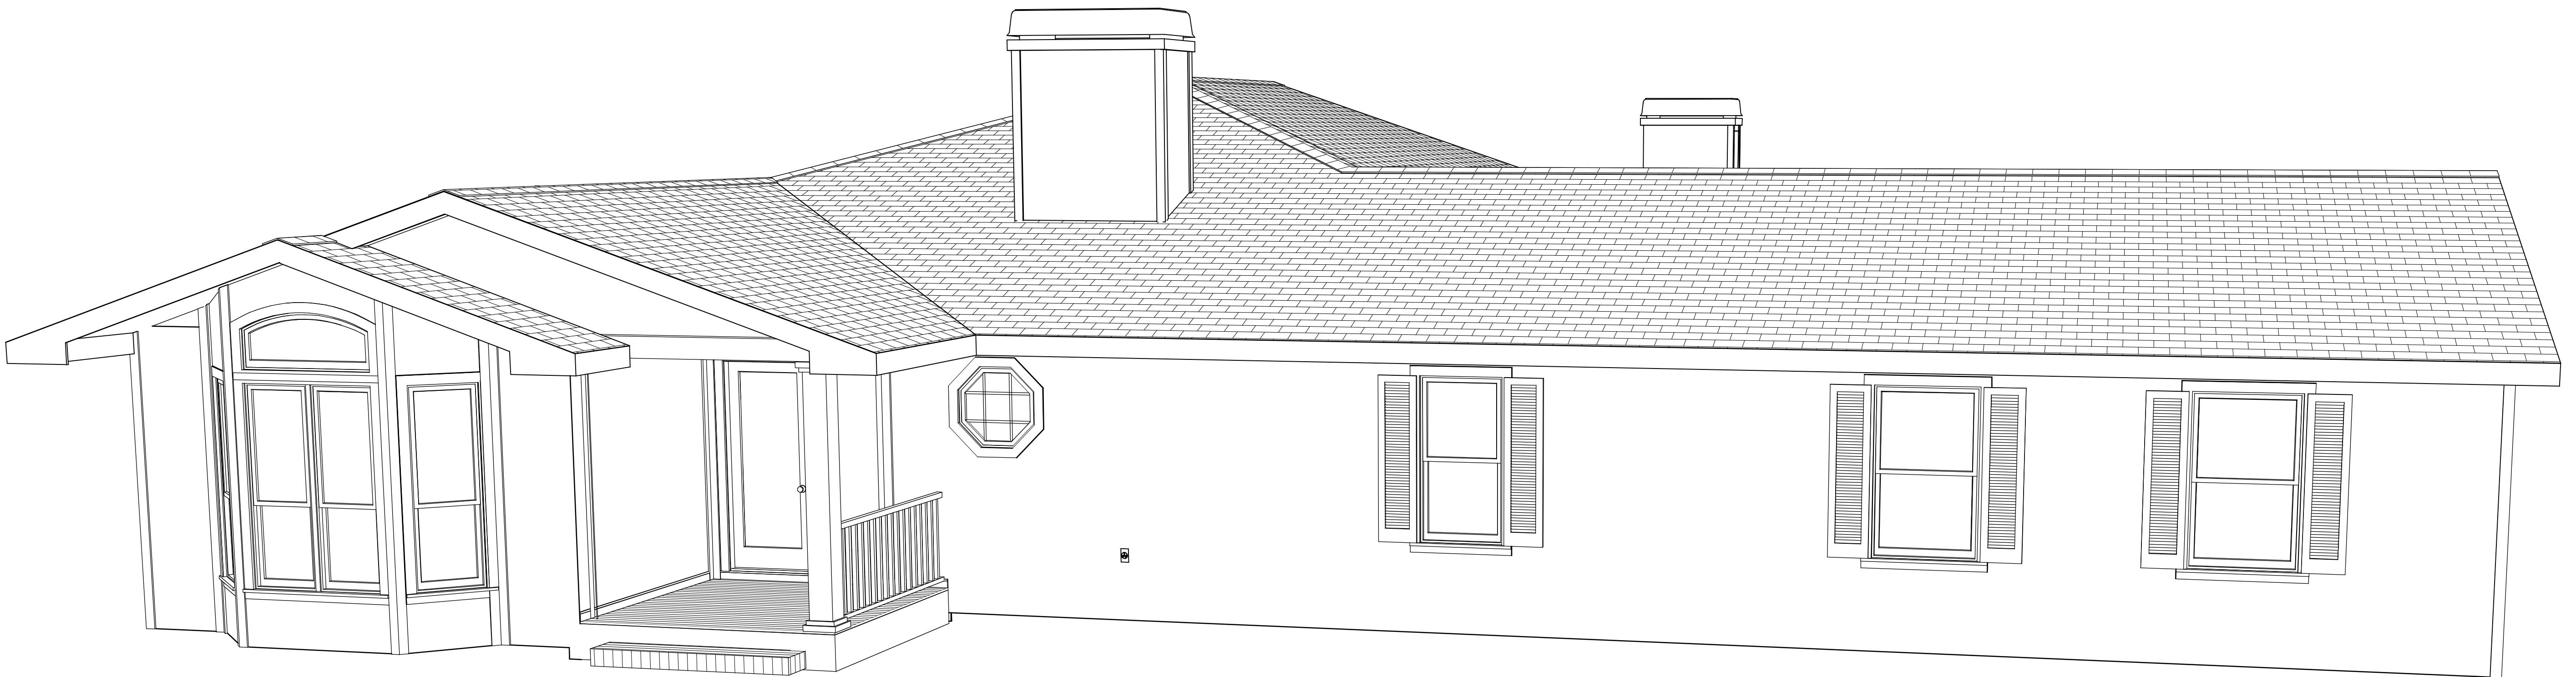

LAKE VILLAS, PT OF LOTS 28-30
3189 DOCTORS LAKE DRIVE
ORANGE PARK, FL 32073 R/E #: 37-04-25-008402-001-00
BUILT BY: PICKETT CONSTRUCTION, INC.
9526 ARGYLE FOREST BLVD.
SUITE B2 #302
JACKSONVILLE, FL 32222
OFFICE: 904-282-5505
CELL: 904-591-0190
CGC1506644

COPYRIGHT 2015 - DESIGNS FOR LIVING, LLC. Under Federal Statute HR 5490 of the Architectural Drawing Act & Title 17 specific copyright laws apply to all published works of Designs for Living, LLC, herein referred to as Designer. It is unlawful for anyone to copy these drawings, either in whole or in part, without the express written permission of the designer! The use of any plans, specifications, electronic or hard copy prints shall be restricted to the original site for which they were prepared and publication thereof is expressly limited to such use. Title to all works, specifically all drawings, specifications, and modified derivatives of any blueprints, e-prints, drawings, or specifications remain the Designers without prejudice. VISUAL CONTACT with any of these drawings, or their purchase, constitutes prima facie evidence of the acceptance of these restrictions! This has held precedent in the North Florida Court system! Any and all violations WILL result in legal action being taken and litigated damages to the full extent allowed by law! No exceptions and no excuses! Contractor &/or owner shall verify all dimensions, details, & specifications prior to construction. Every attempt has been made to avoid mistakes. The contractor and the owners also fully acknowledge that they have fully acknowledged that they have full copyright release approval and that they have fully acknowledged that they have begun!

PLAN #	2059
NO.	DESCRIPTION
BY	DATE
BUILT BY:	Pickett Construction, Inc. 9526 Argyle Forest Blvd. Jacksonville, FL 32222 CGC1506644
PROJECT DESCRIPTION:	THE WILLIAMS FAMILY 3189 Doctors Lake Drive Orange Park, FL 32073
Bid Drawings provided by:	Designs for Living, LLC RESIDENTIAL DESIGN & CONSULTING SERVING N/E FLORIDA SINCE 1978 904-730-7135
DATE:	10/8/2015
SCALE:	N.T.S
SHEET:	A-1

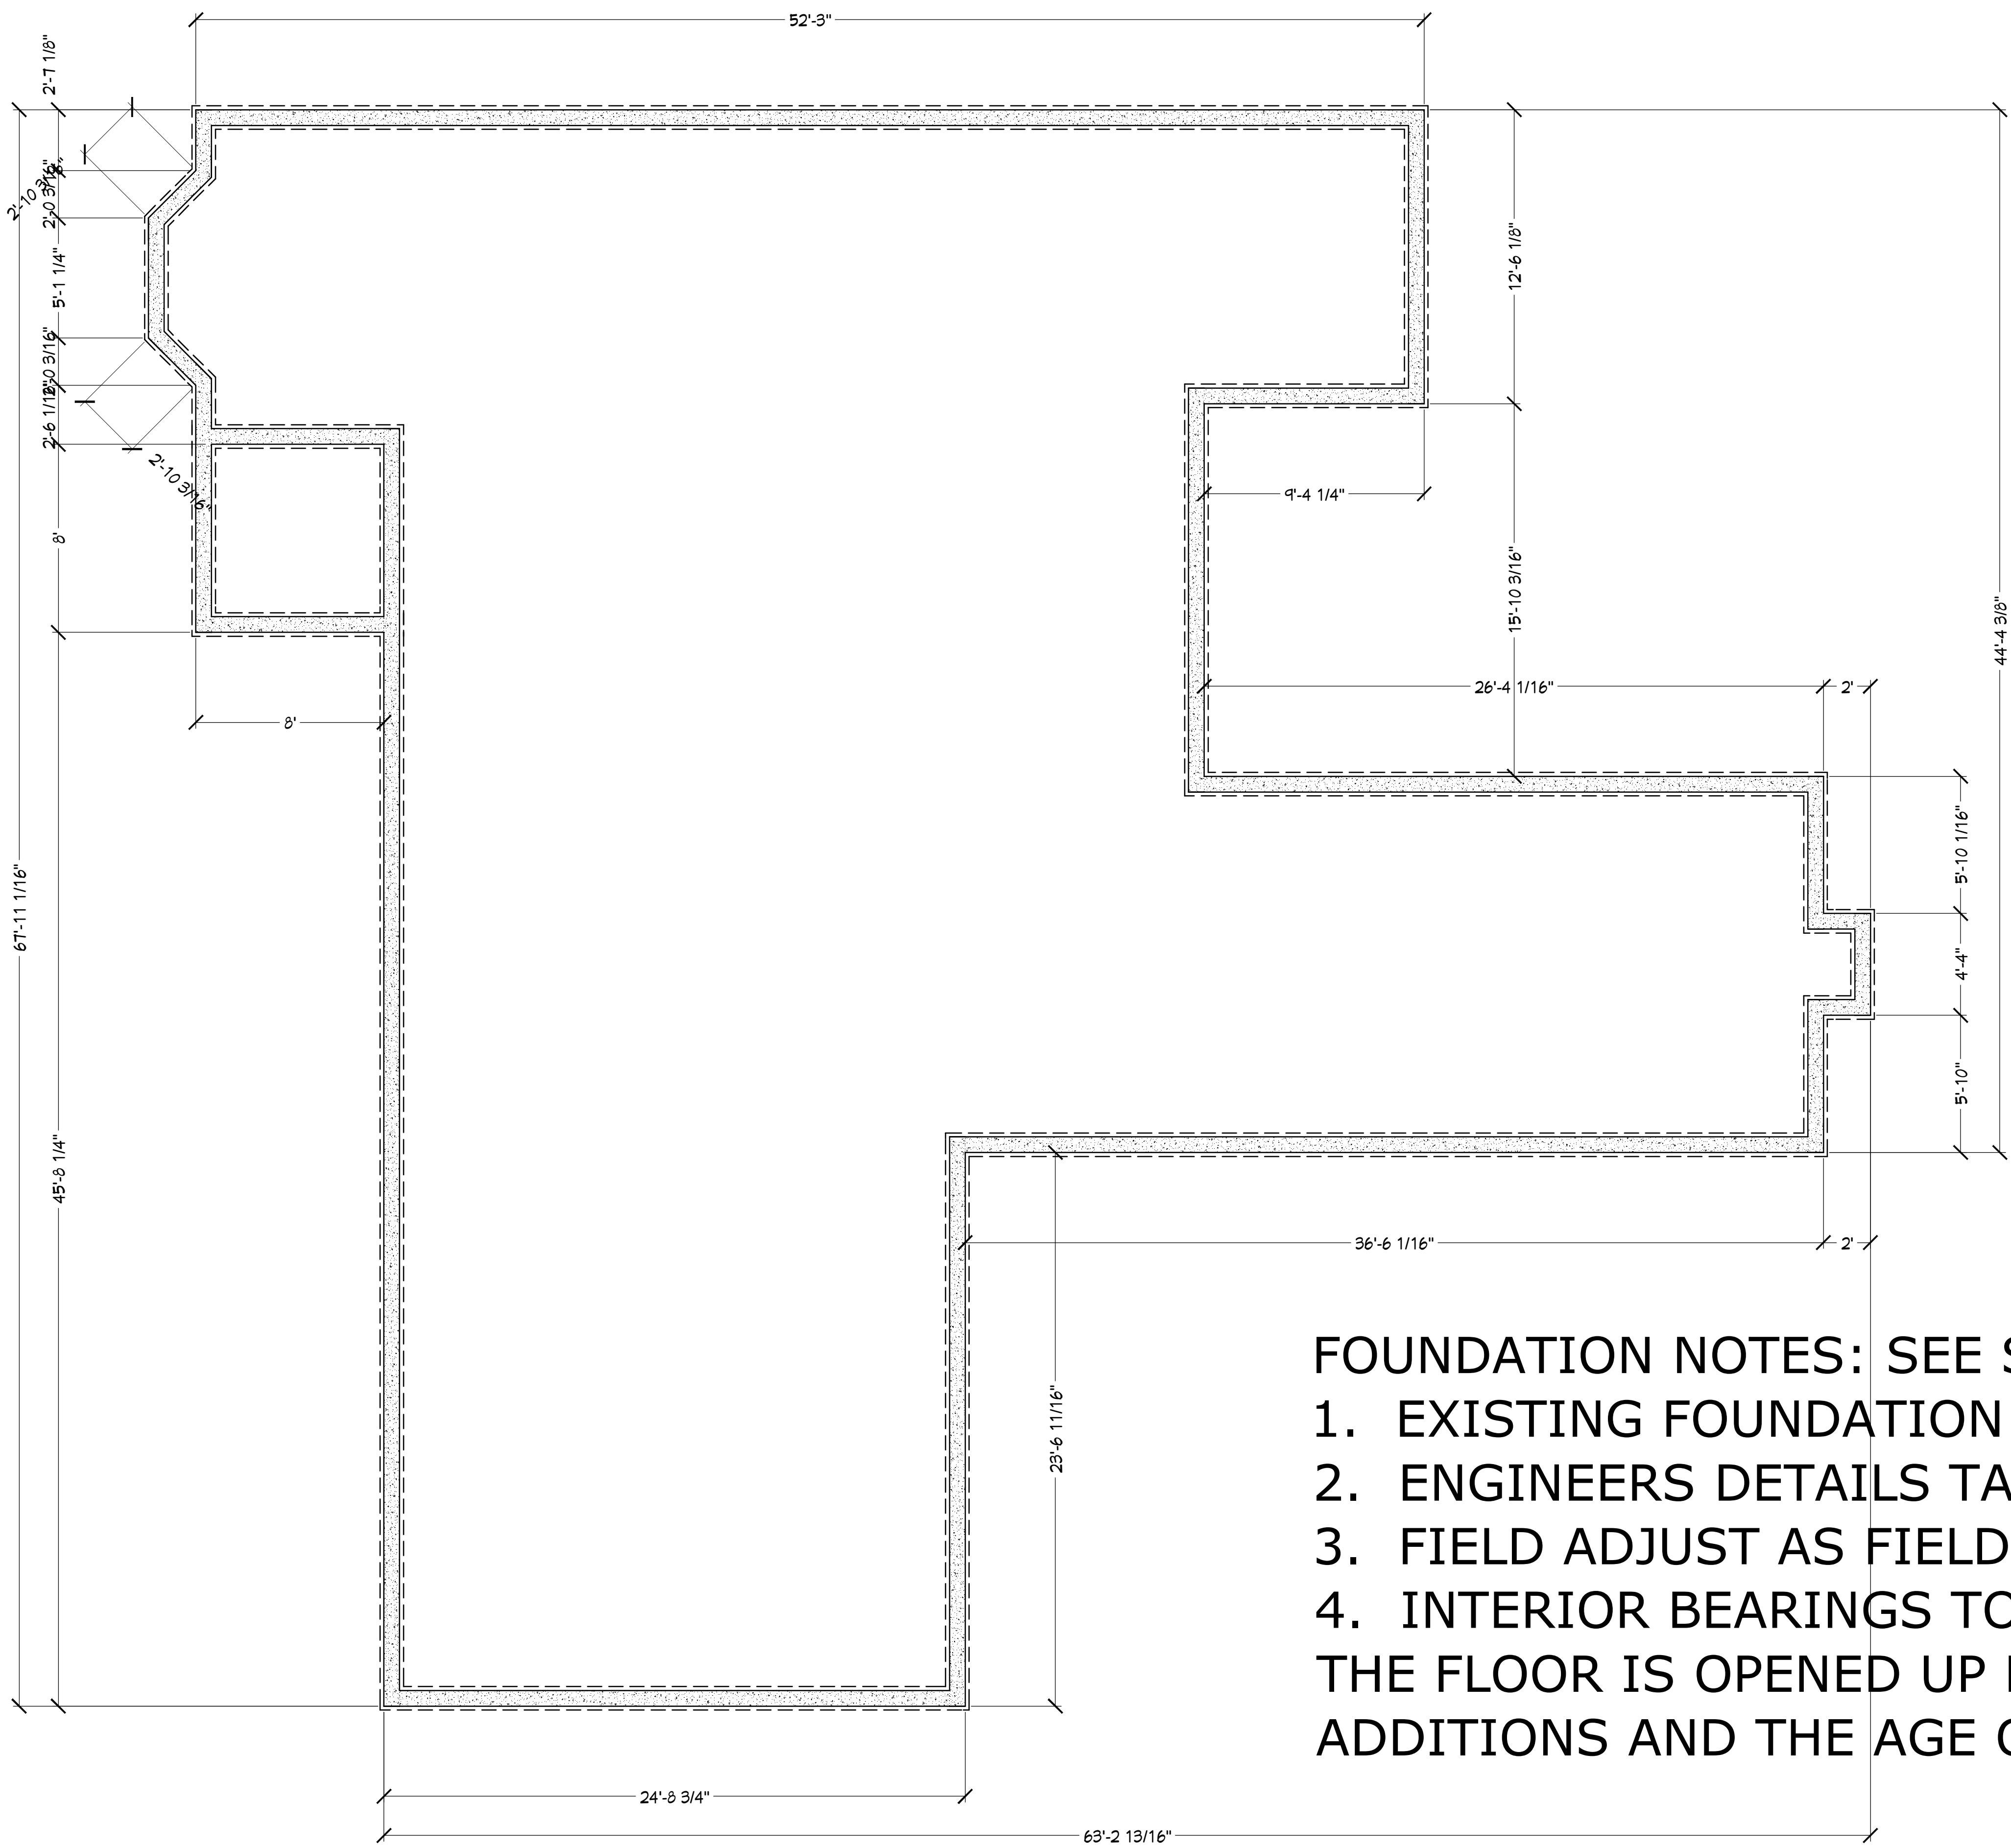

FOUNDATION NOTES: SEE SPECIFICATIONS

1. EXISTING FOUNDATION IS OFF GRADE
 2. ENGINEERS DETAILS TAKE PRECEDENCE
 3. FIELD ADJUST AS FIELD CONDITIONS REQUIRED
 4. INTERIOR BEARINGS TO BE DETERMINED AFTER
THE FLOOR IS OPENED UP DUE TO THE MULTIPLE
ADDITIONS AND THE AGE OF THE WORK

FOUNDATION PLAN

COPYRIGHT 2015: DESIGNS FOR LIVING, LLC. -Under Federal Statute HR 5490 of the Architectural Drawing Act & Title 17 specific tacit copyright laws apply to all published works of Designs for Living, LLC, herein referred to as Designer. It is unlawful for anyone to copy these drawings, either in whole or in part, without the express written permission of the Designer! The use of any plans, specifications, electronic or hard copy prints shall be restricted to the original site for which they were prepared and publication thereof is expressly limited to such use. Title to all works, specifically all drawings, specifications, and modified derivatives of any blueprints, e-files, drawings, or specifications remain the Designers without prejudice. VISUAL CONTACT with any of these drawings, or their purchase constitutes prima facie evidence of the acceptance of these restrictions! This has held precedent in the North Florida Court system! Any and all violations WILL result in legal action being taken and litigated damages to the full extent allowed by law! No exceptions and no excuses!Contractor &/or owner shall verify all dimensions, details, & specifications prior to construction. Every attempt has been made to avoid mistakes. The contractor and the owners also fully acknowledge that they have full copyright release approval and Designs for Living LLC nor R.E. Chip Mitchell shall not be liable for error for copyright infringement or other errors after delivery via email of drawings including after construction has begun!

PLAN # 2059

THE WILLIAMS FAMILY
3189 Doctors Lake Drive
Orange Park, FL 32073


drawings provided by:
Designs for Living, LLC
RESIDENTIAL DESIGN & CONSULTING
SINCE 1969
SERVING N/E FLORIDA SINCE 1978
904-730-7135

DATE:

SCALE:

$$1/4^\circ = 1^\circ 0^\circ$$

8

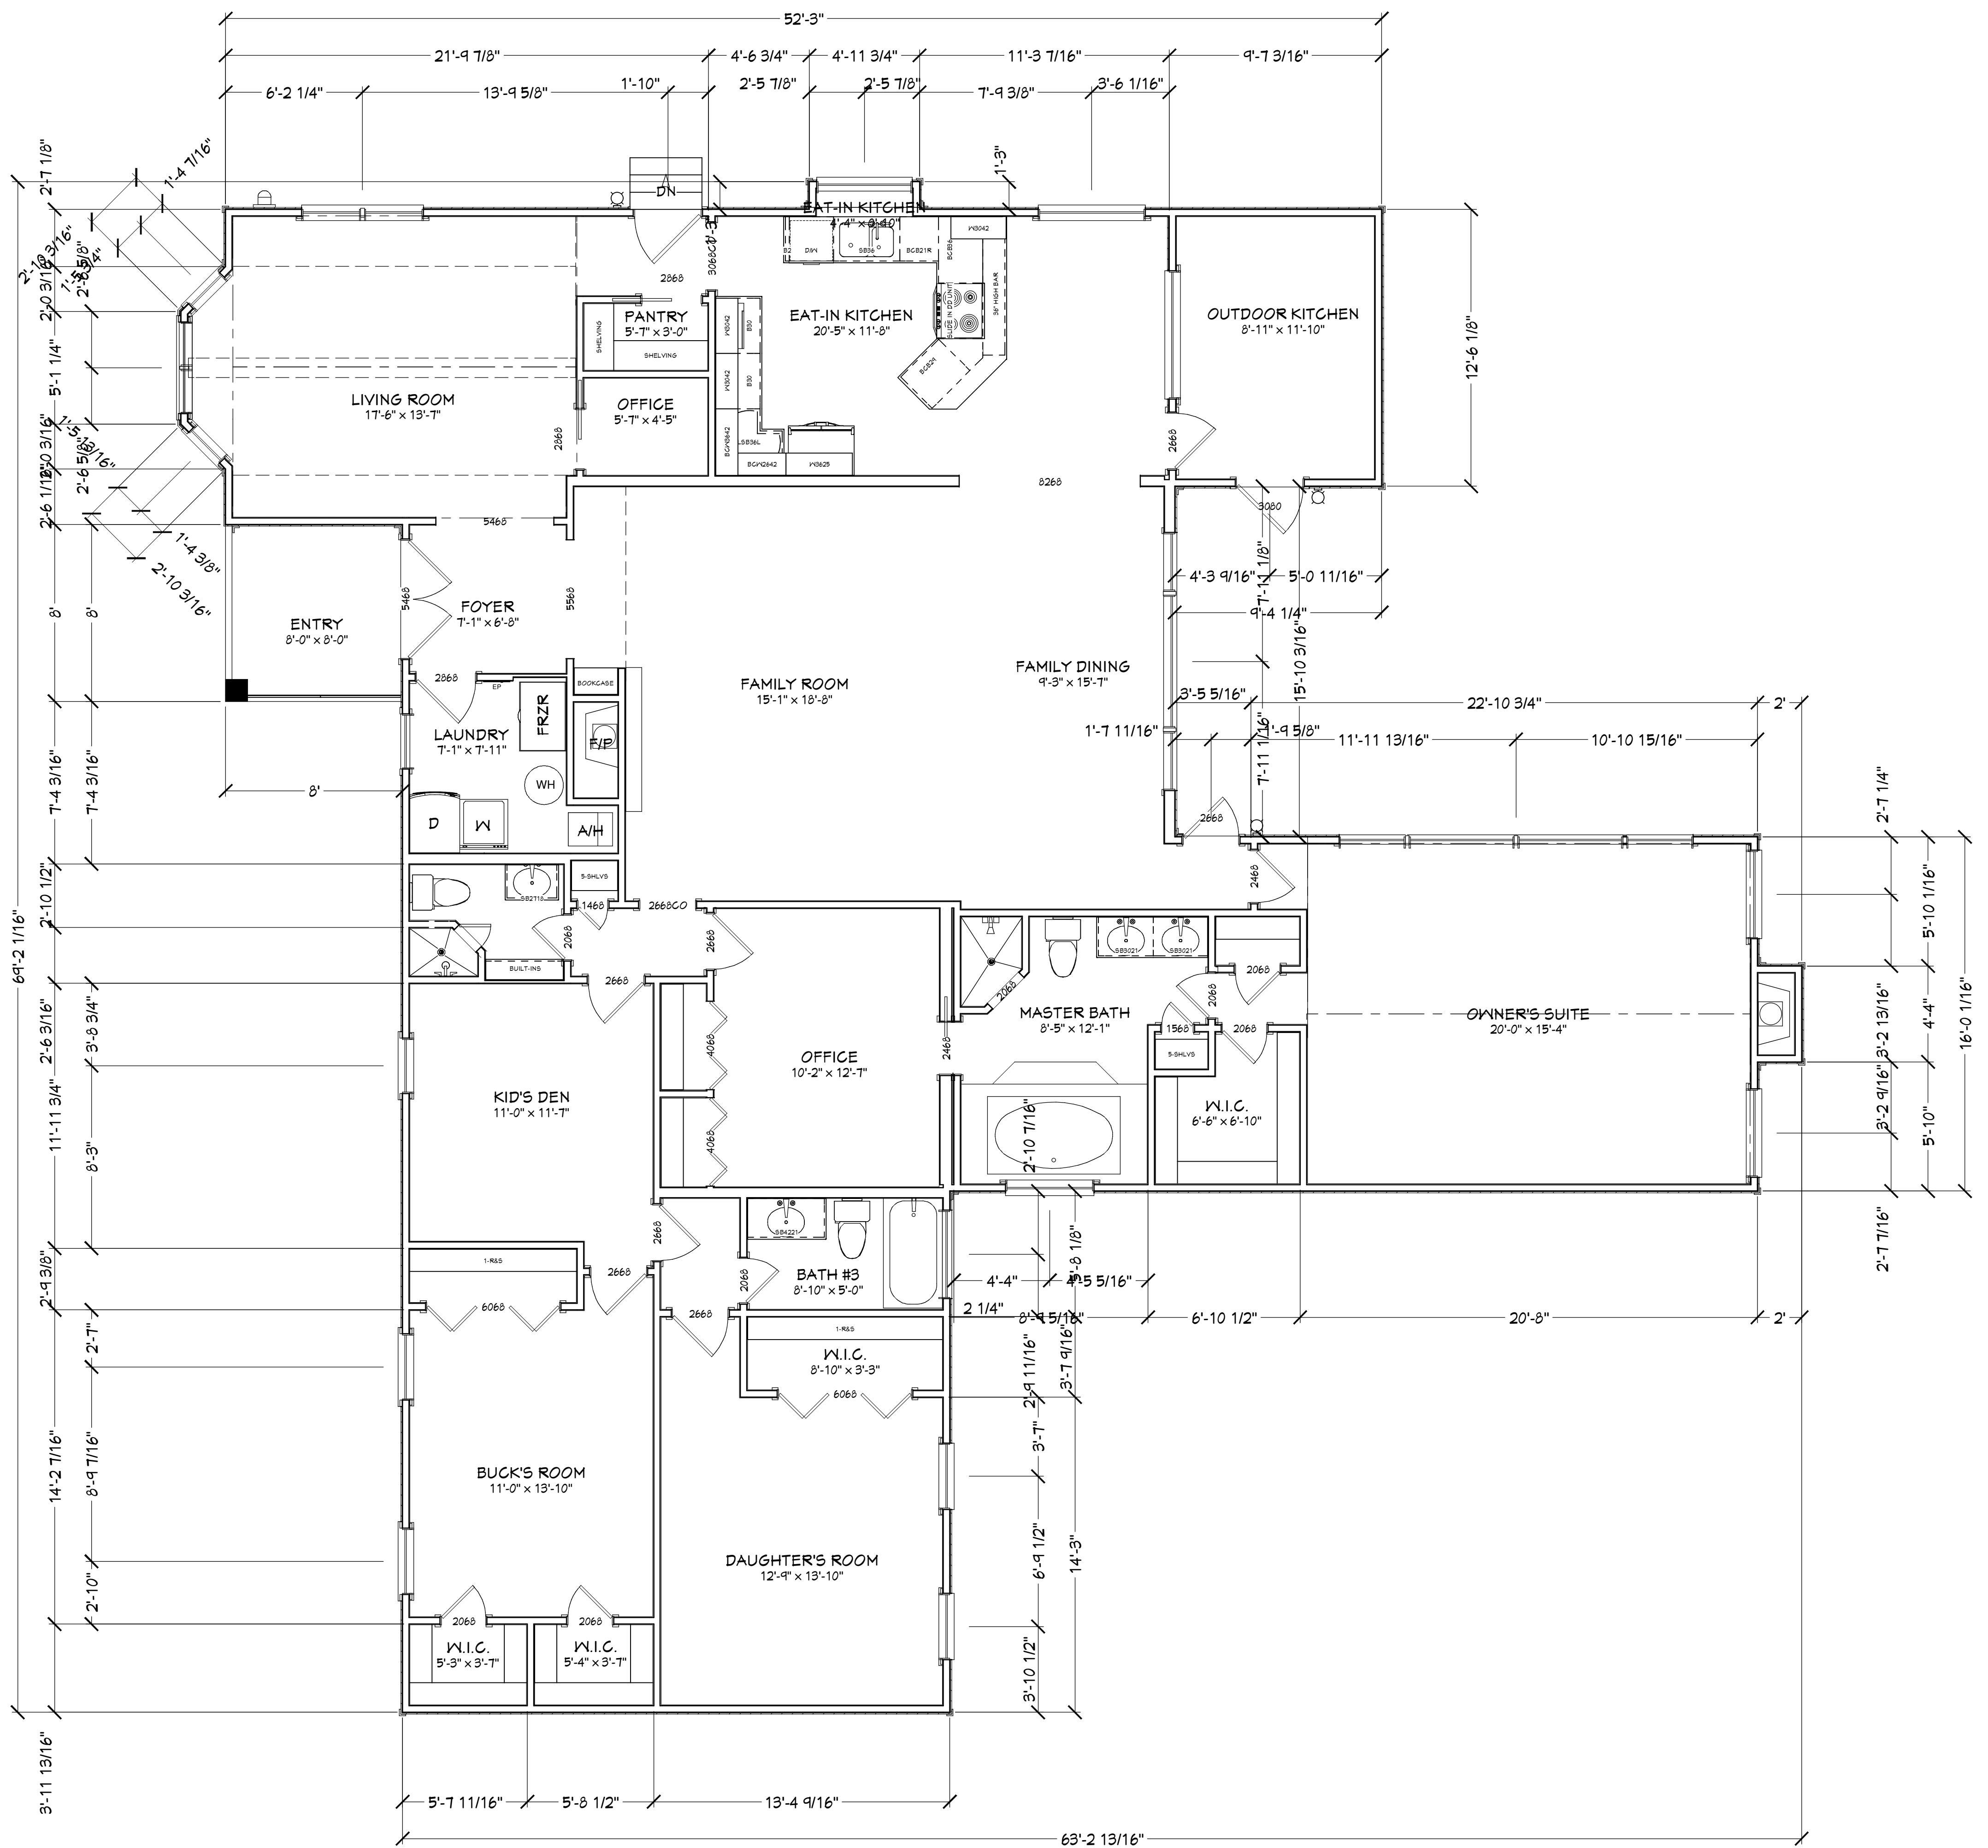

AS-BUILT FLOOR PLAN

**PLAN #
2059**

Pickett Construction, Inc.
9526 Argyle Forest Blvd.
Jacksonville, FL 32222
CGC1506644


PROJECT DESCRIPTION:
THE WILLIAMS FAMILY
3189 Doctors Lake Drive
Orange Park, FL 32073

Bid Drawings provided by:
Designs for Living, LLC
RESIDENTIAL DESIGN & CONSULTING
SERVING N/E FLORIDA SINCE 1978
904-730-7135

DATE:
10/8/2015


SCALE:
1/4" = 1'-0"

SHEET:
A-4

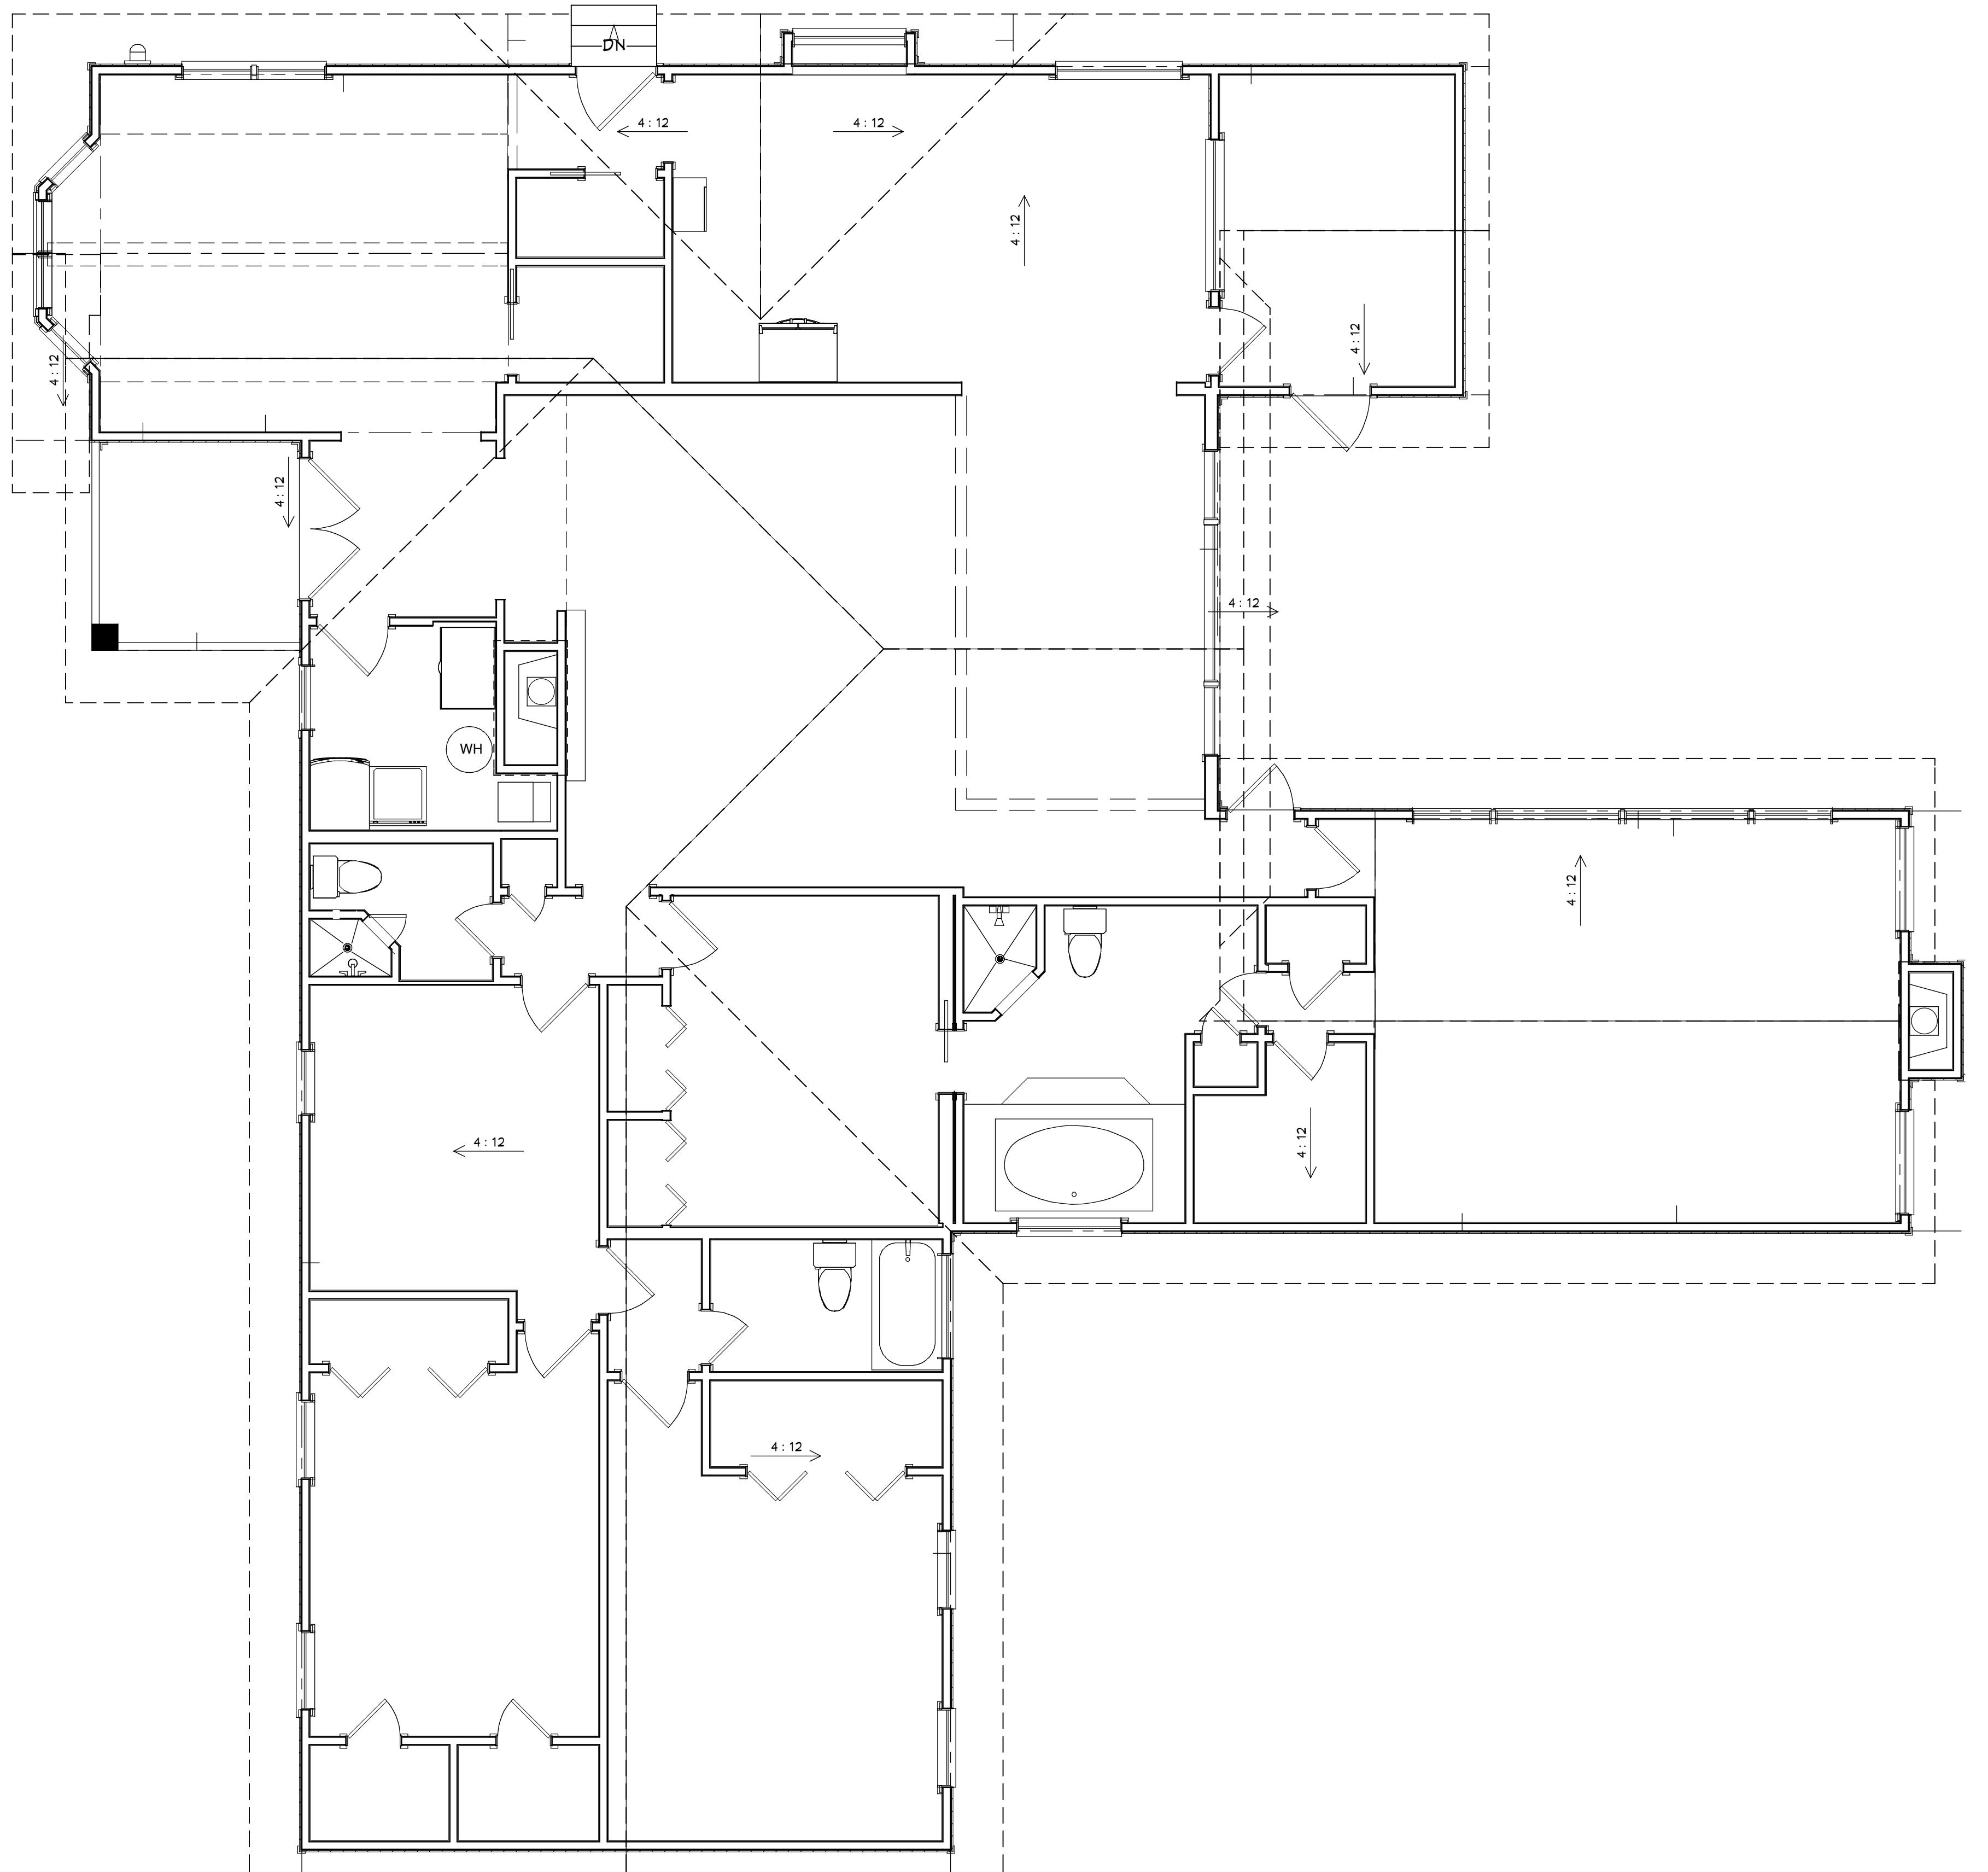


AS-BUILT ROOF PLAN


COPYRIGHT 2015 - DESIGNS FOR LIVING, LLC. Under Federal Statute HR 5490 of the Architectural Drawing Act & Title 17 specific copyright laws apply to all published works of Designs for Living, LLC, herein referred to as Designer. It is unlawful for anyone to copy these drawings, either in whole or in part, without the express written permission of the designer! The use of any plans, specifications, electronic or hard copy prints shall be restricted to the original site for which they were prepared and publication thereof is expressly limited to such use. Title to all works, specifically all drawings, specifications and modifications thereto is expressly held by the designer. Any and all violations will result in legal action being taken and drawings or specifications remain the designers without prejudice. VISUAL CONTACT with any of these drawings, or their purchase, constitutes prima facie evidence of the acceptance of these restrictions! This has held precedent in the North Florida Court system! Any and all violations will result in legal action being taken and litigated damages to the full extent allowed by law! No exceptions and no excuses! Contractor &/or owner shall verify all dimensions, details & specifications prior to construction. Every attempt has been made to avoid mistakes. The contractor and the owners also fully acknowledge that they have fully acknowledged that they have full copyright release approval and that they have fully acknowledged that they have begun!

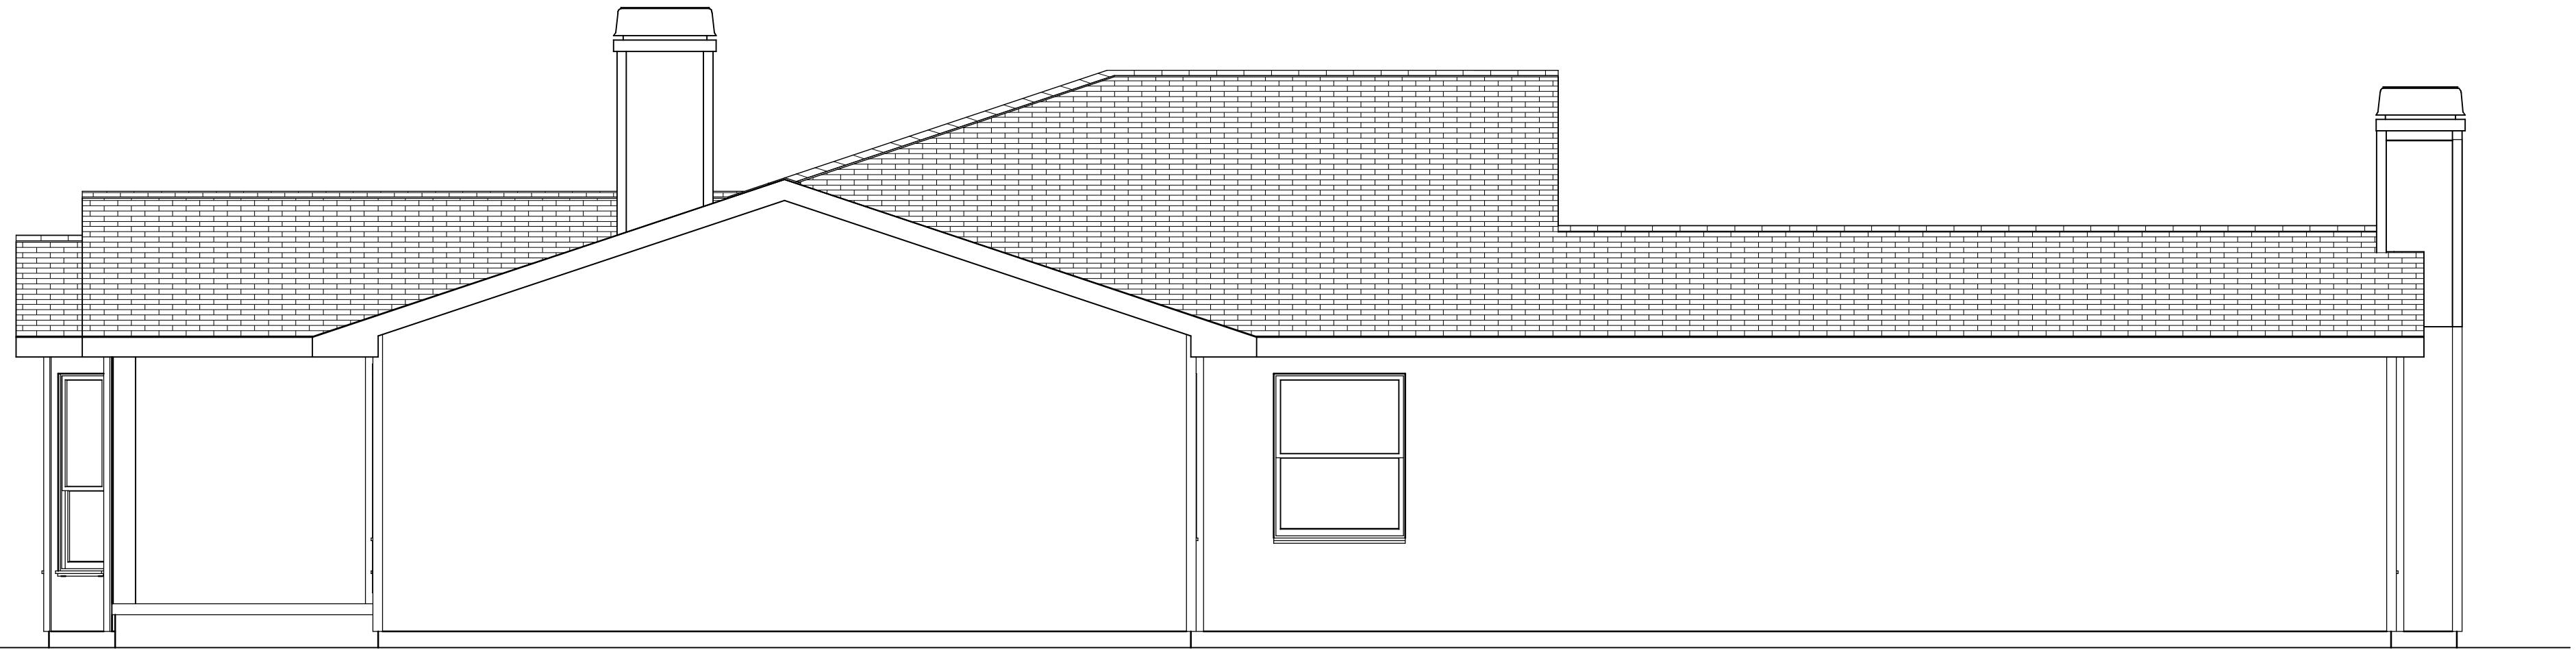


RIGHT ELEVATION

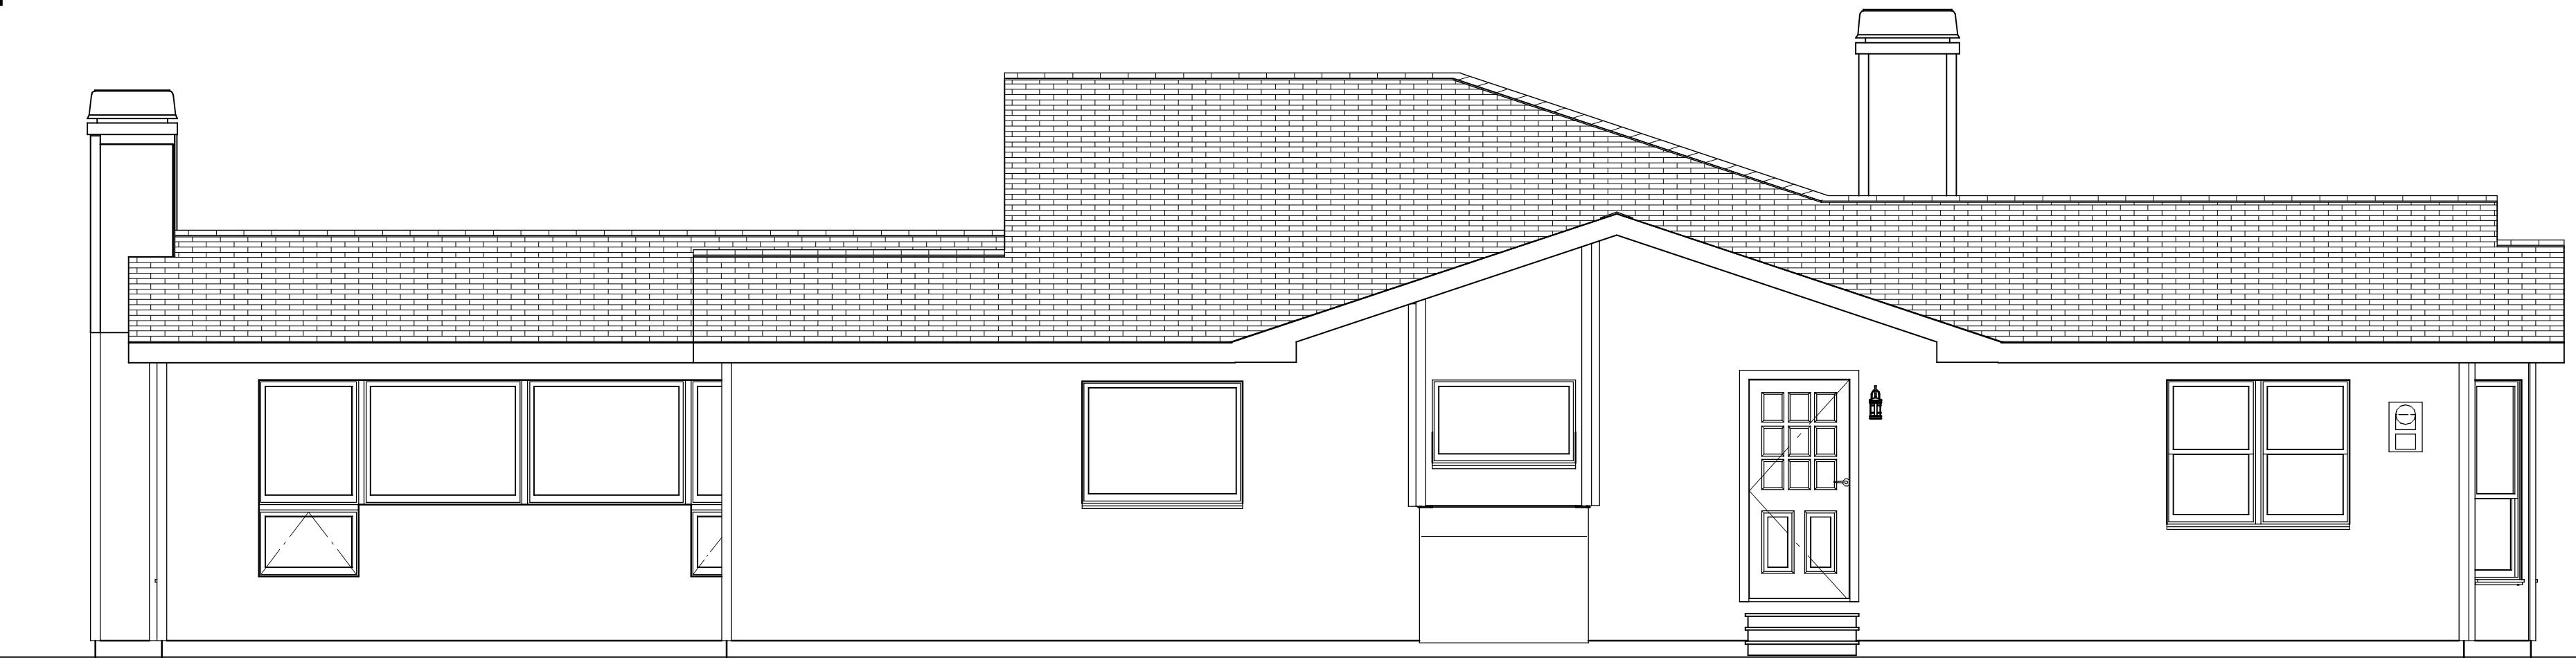

LEFT ELEVATION

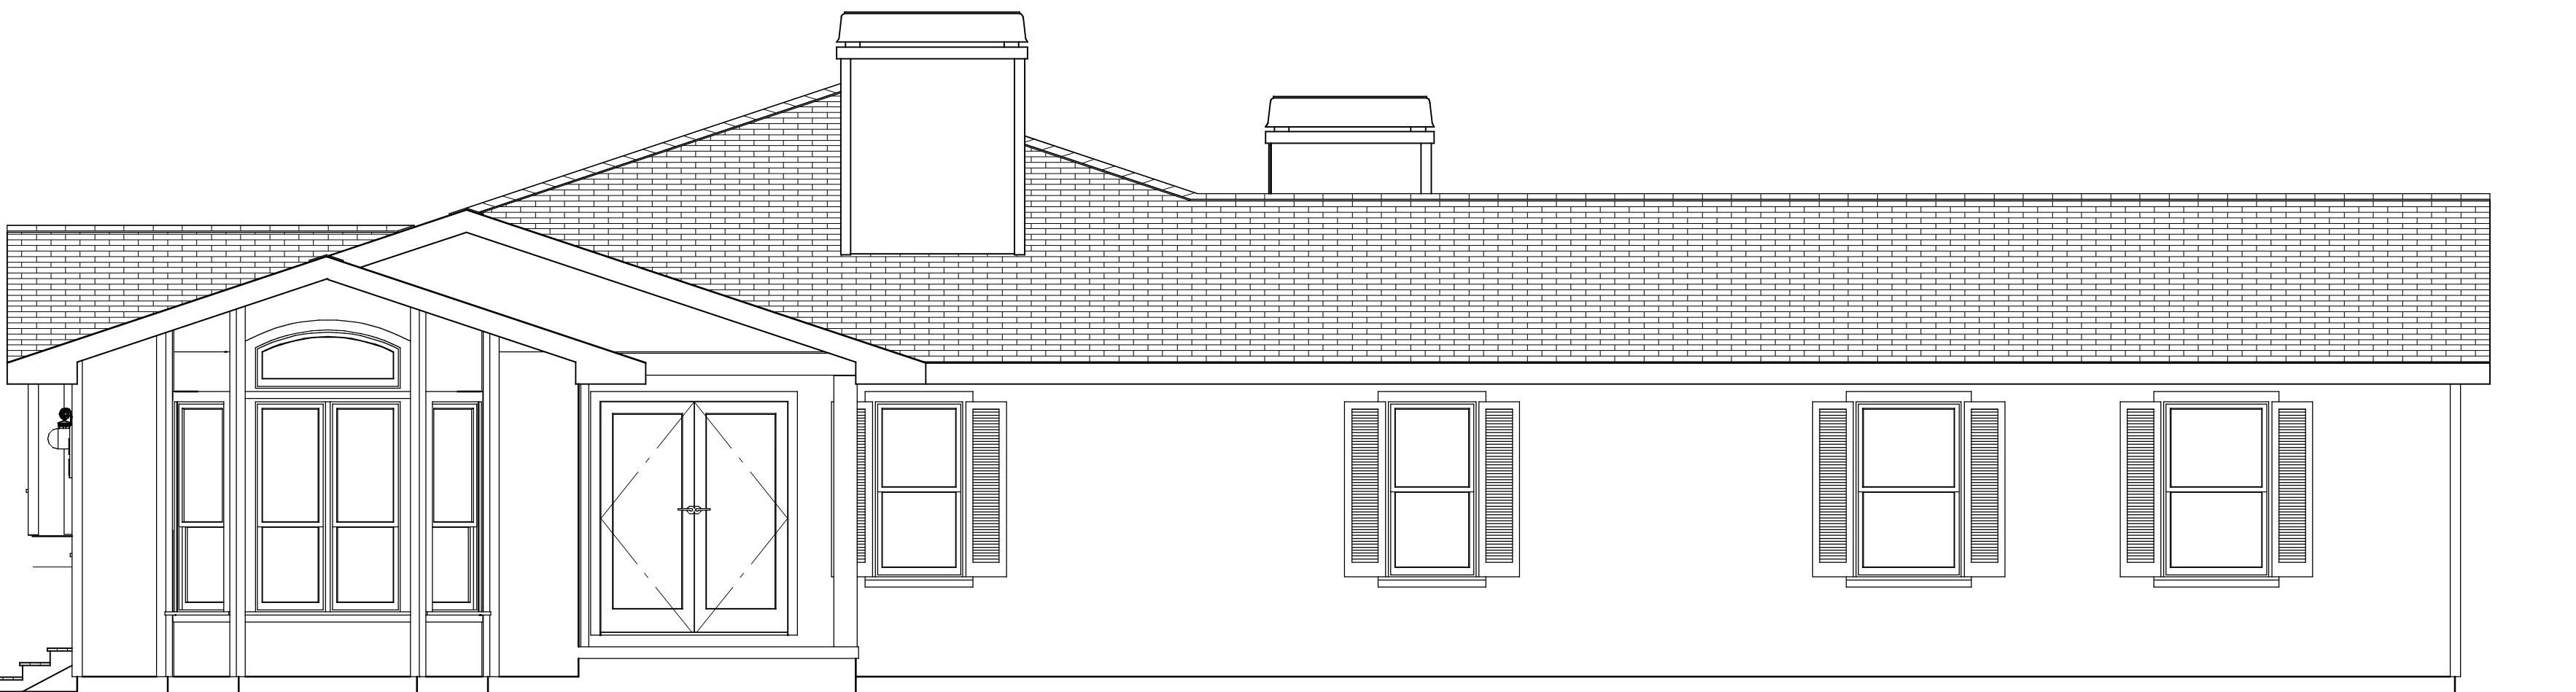

FRONT ELEVATION

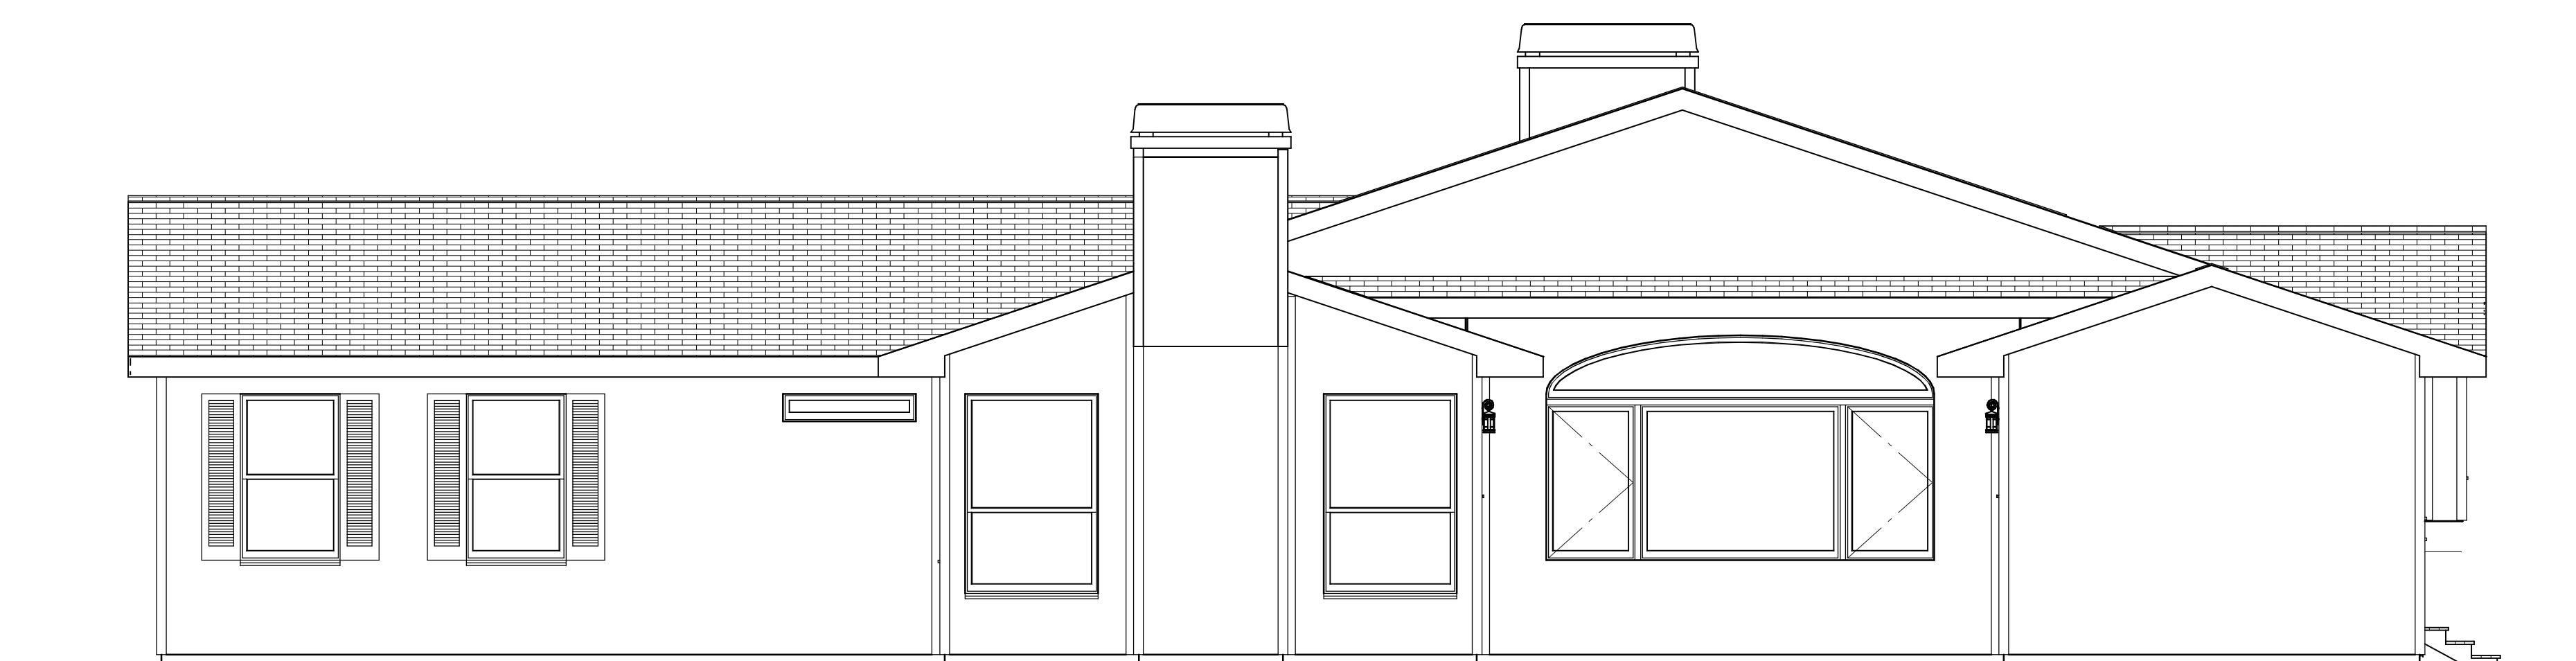

REAR ELEVATION

AS-BUILT ELEVATIONS

COPYRIGHT 2015 - DESIGNS FOR LIVING, LLC. Under Federal Statute HR 5490 of the Architectural Drawing Act & Title 17 specific copyright laws apply to all published works of Designs for Living, LLC, herein referred to as Designer. It is unlawful for anyone to copy these drawings, either in whole or in part, without the express written permission of the designer! The use of any plans, specifications, electronic or hard copy prints shall be restricted to the original site for which they were prepared and publication thereof is expressly limited to such use. Title to all works, specifically all drawings, specifications, and modified derivatives of any blueprints, series, drawings, or specifications remain the designer without prejudice. VISUAL CONTACT with any of these drawings, or their purchase, constitutes prima facie evidence of the acceptance of these restrictions! This has held precedent in the North Florida Court system! Any and all violations WILL result in legal action being taken and litigated damages to the full extent allowed by law! No exceptions and no excuses! Contractor &/or owner shall verify all dimensions, details, & specifications prior to construction. Every attempt has been made to avoid mistakes. The contractor and the owners also fully acknowledge that they have full copyright release approval and liability released for any errors after delivery via email of drawings, including after construction has begun!

PLAN #
2059

NO.	DESCRIPTION	BY	DATE

BUILT BY:
Pickett Construction, Inc.
9526 Argyle Forest Blvd.
Jacksonville, FL 32222
CGC1506644

PROJECT DESCRIPTION:
THE WILLIAMS FAMILY
3189 Doctors Lake Drive
Orange Park, FL 32073

Bid Drawings provided by:
Designs for Living, LLC
RESIDENTIAL DESIGN & CONSULTING
SERVING N/E FLORIDA SINCE 1978
904-730-7135

DATE:
10/8/2015
SCALE:
1/4" = 1'-0"
SHEET:

A-5

**PLAN #
2059**

NO.	DESCRIPTION	BY	DATE

BUILT BY:
Pickett Construction, Inc.
9526 Argyle Forest Blvd.
Jacksonville, FL 32222
CGC1506644

PROJECT DESCRIPTION:
THE WILLIAMS FAMILY

3189 Doctors Lake Drive
Orange Park, FL 32073



Bid Drawings provided by:
Designs for Living, LLC
RESIDENTIAL DESIGN & CONSULTING
SERVING N/E FLORIDA SINCE 1978
904-730-7135

DATE:
10/8/2015


SCALE:
1/4" = 1'-0"

SHEET:
A-6

COPYRIGHT 2015 - DESIGNS FOR LIVING, LLC. Under Federal Statute HR 5490 of the Architectural Drawing Act & Title 17 specific copyright laws apply to all published works of Designs for Living, LLC, herein referred to as Designer. It is unlawful for anyone to copy these drawings, either in whole or in part, without the express written permission of the designer! The use of any plans, specifications, electronic or hard copy prints shall be restricted to the original site for which they were prepared and publication thereof is expressly limited to such use. Title to all works, specifically all drawings, specifications and modified derivatives of any blueprints, series, drawings or specifications remain the designer's without prejudice. VISUAL CONTACT with any of these drawings, or their purchase, constitutes prima facie evidence of the acceptance of these restrictions! This has held precedent in the North Florida Court system. Any and all violations WILL result in legal action being taken and litigated damages to the full extent allowed by law! No exceptions and no excuses! Contractor &/or owner shall verify all dimensions, details & specifications prior to construction. Every attempt has been made to avoid mistakes. The contractor and the owners also fully acknowledge that they have full copyright release approval and liability for any errors after delivery via email of drawings, including after construction has begun!

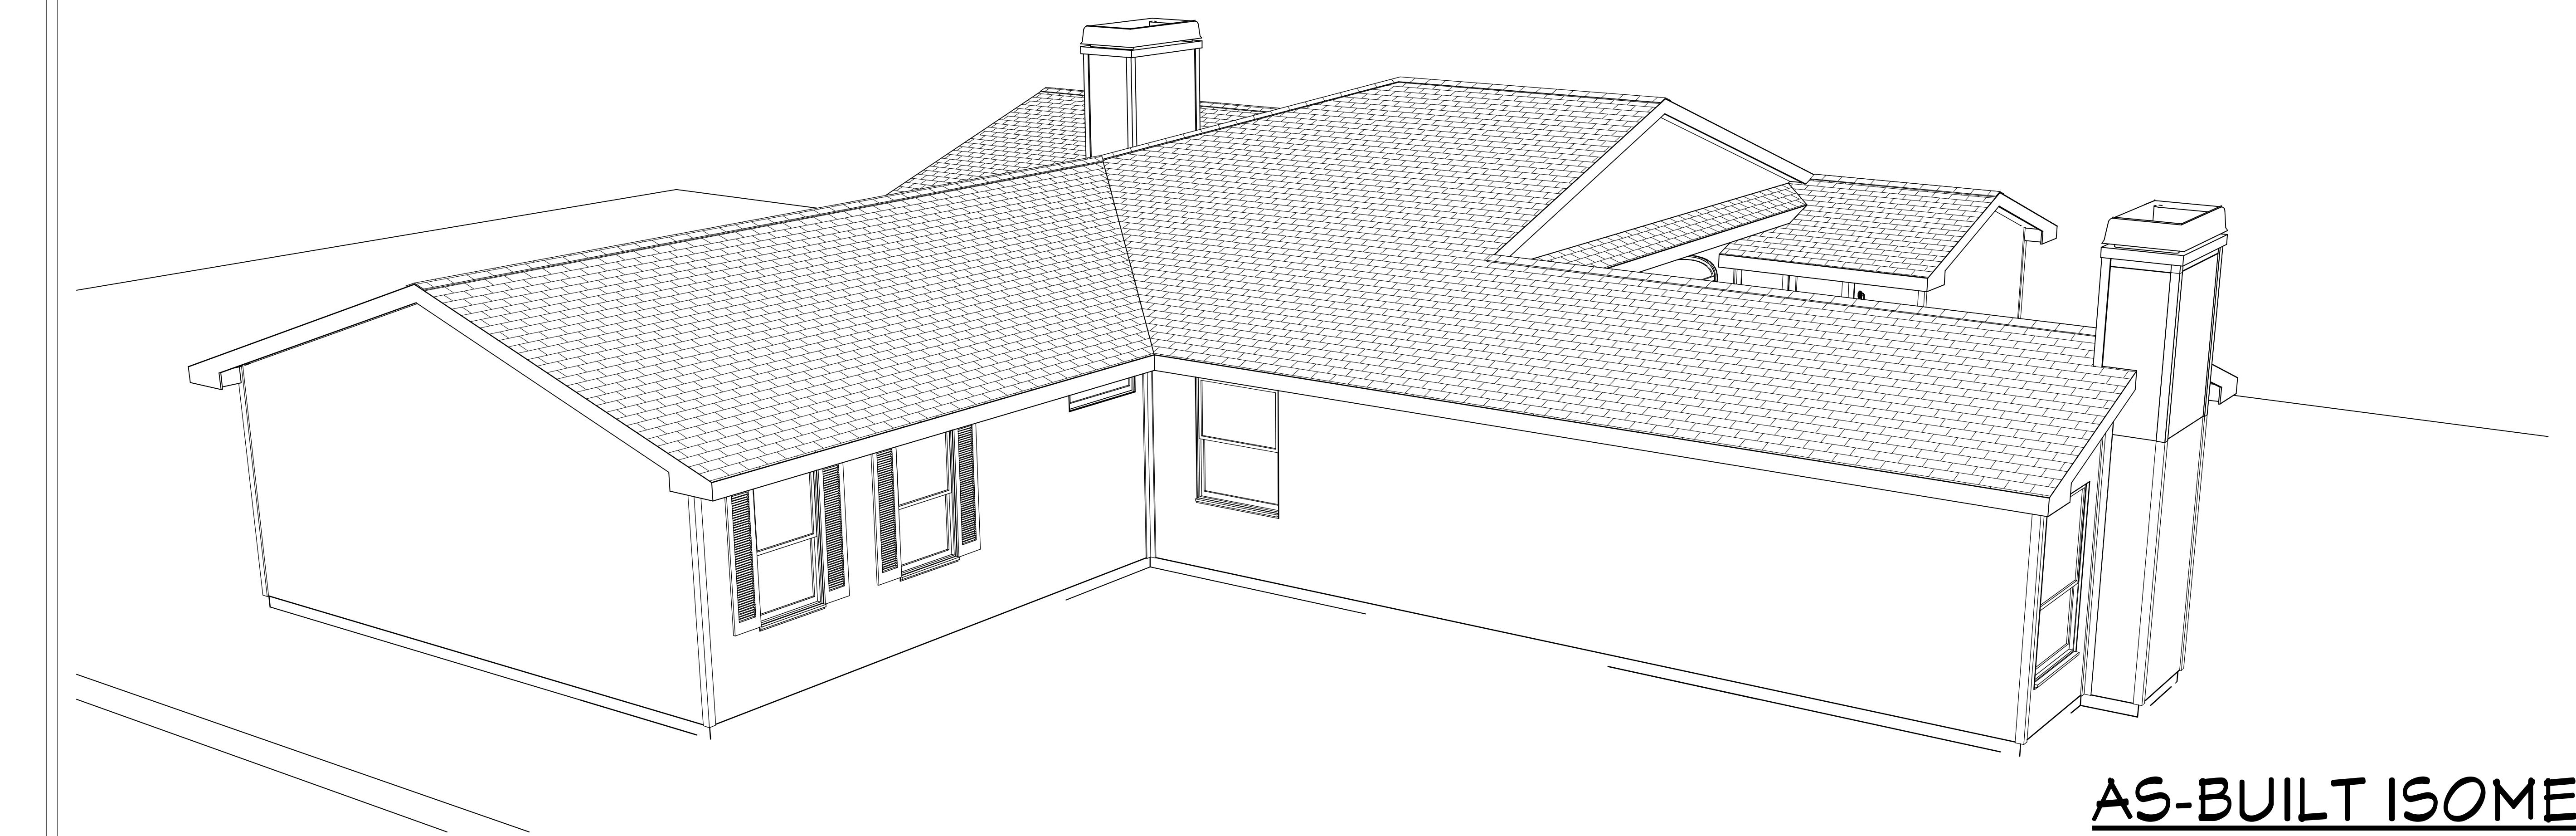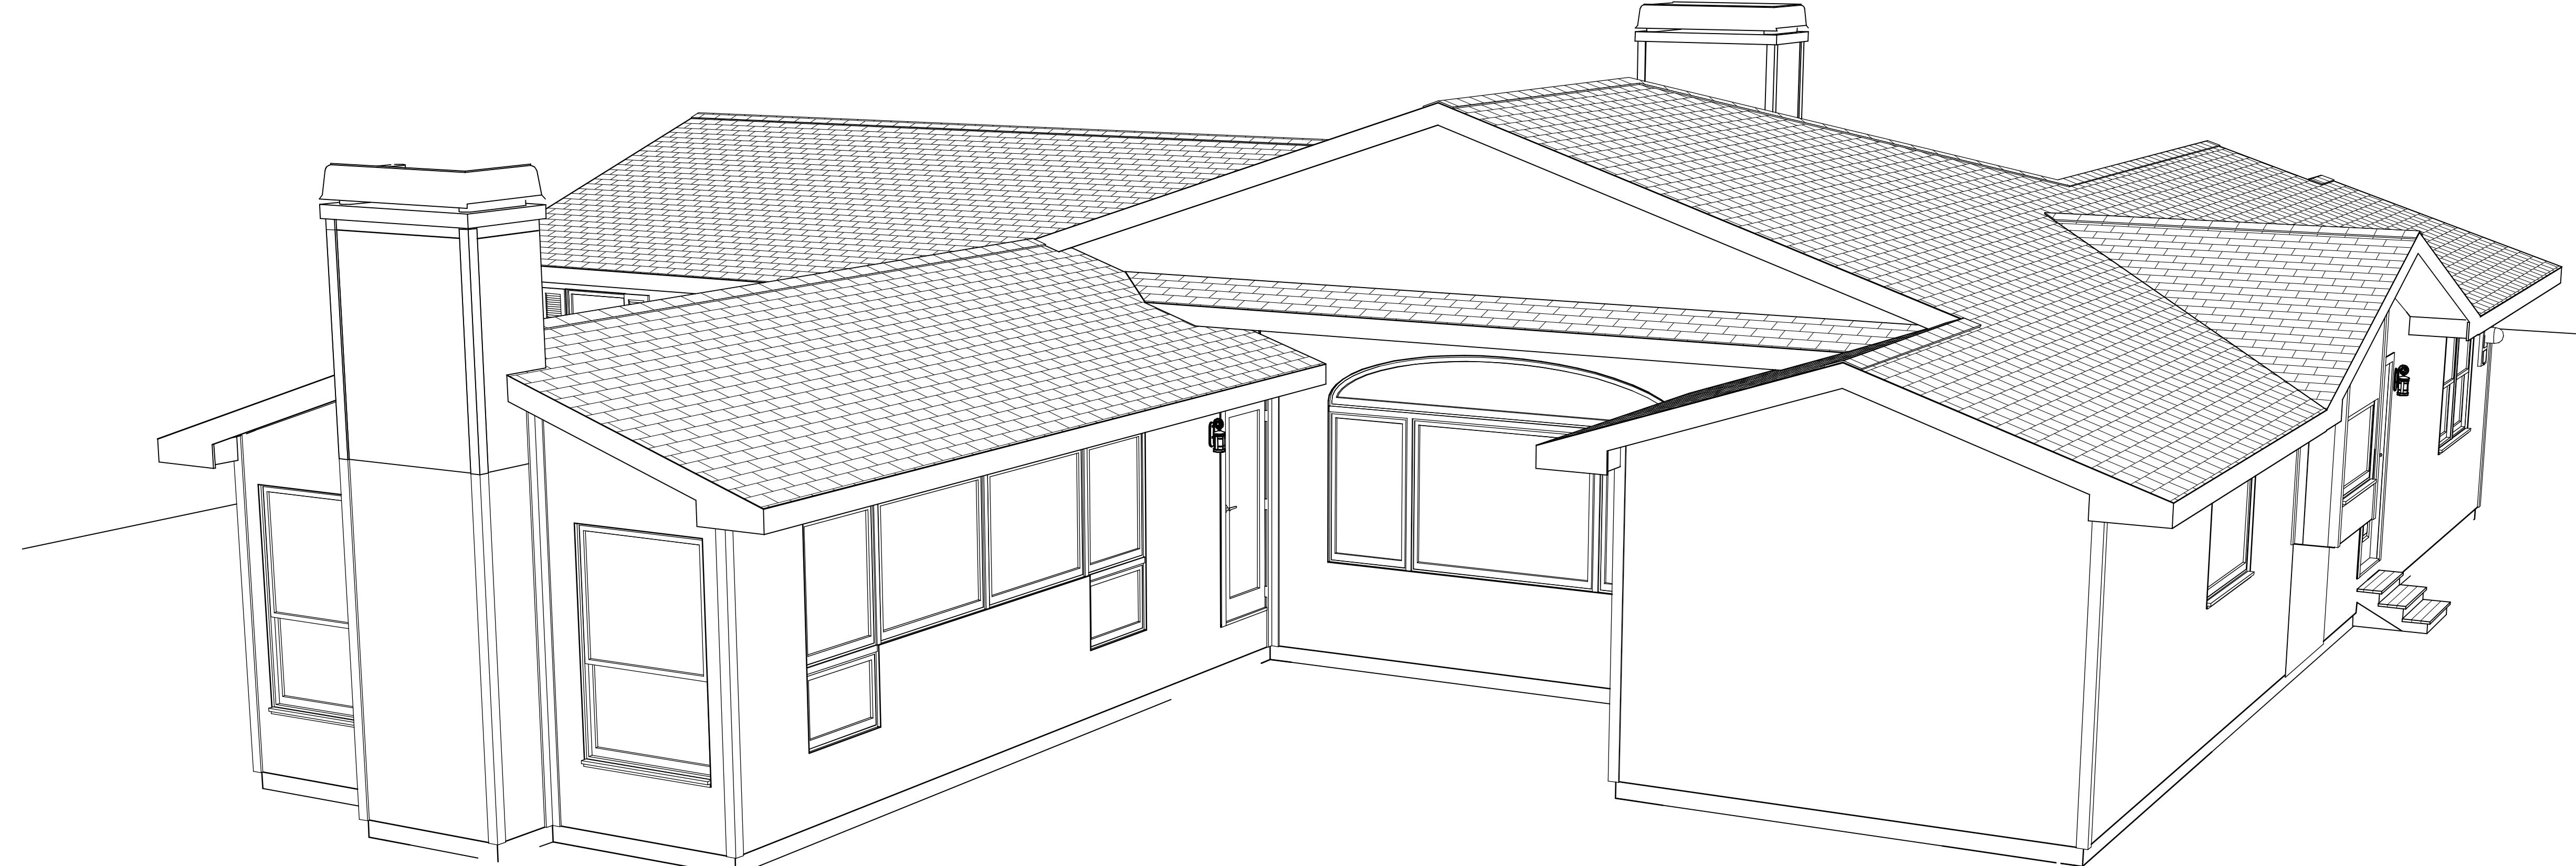

AS-BUILT ISOMETRICS

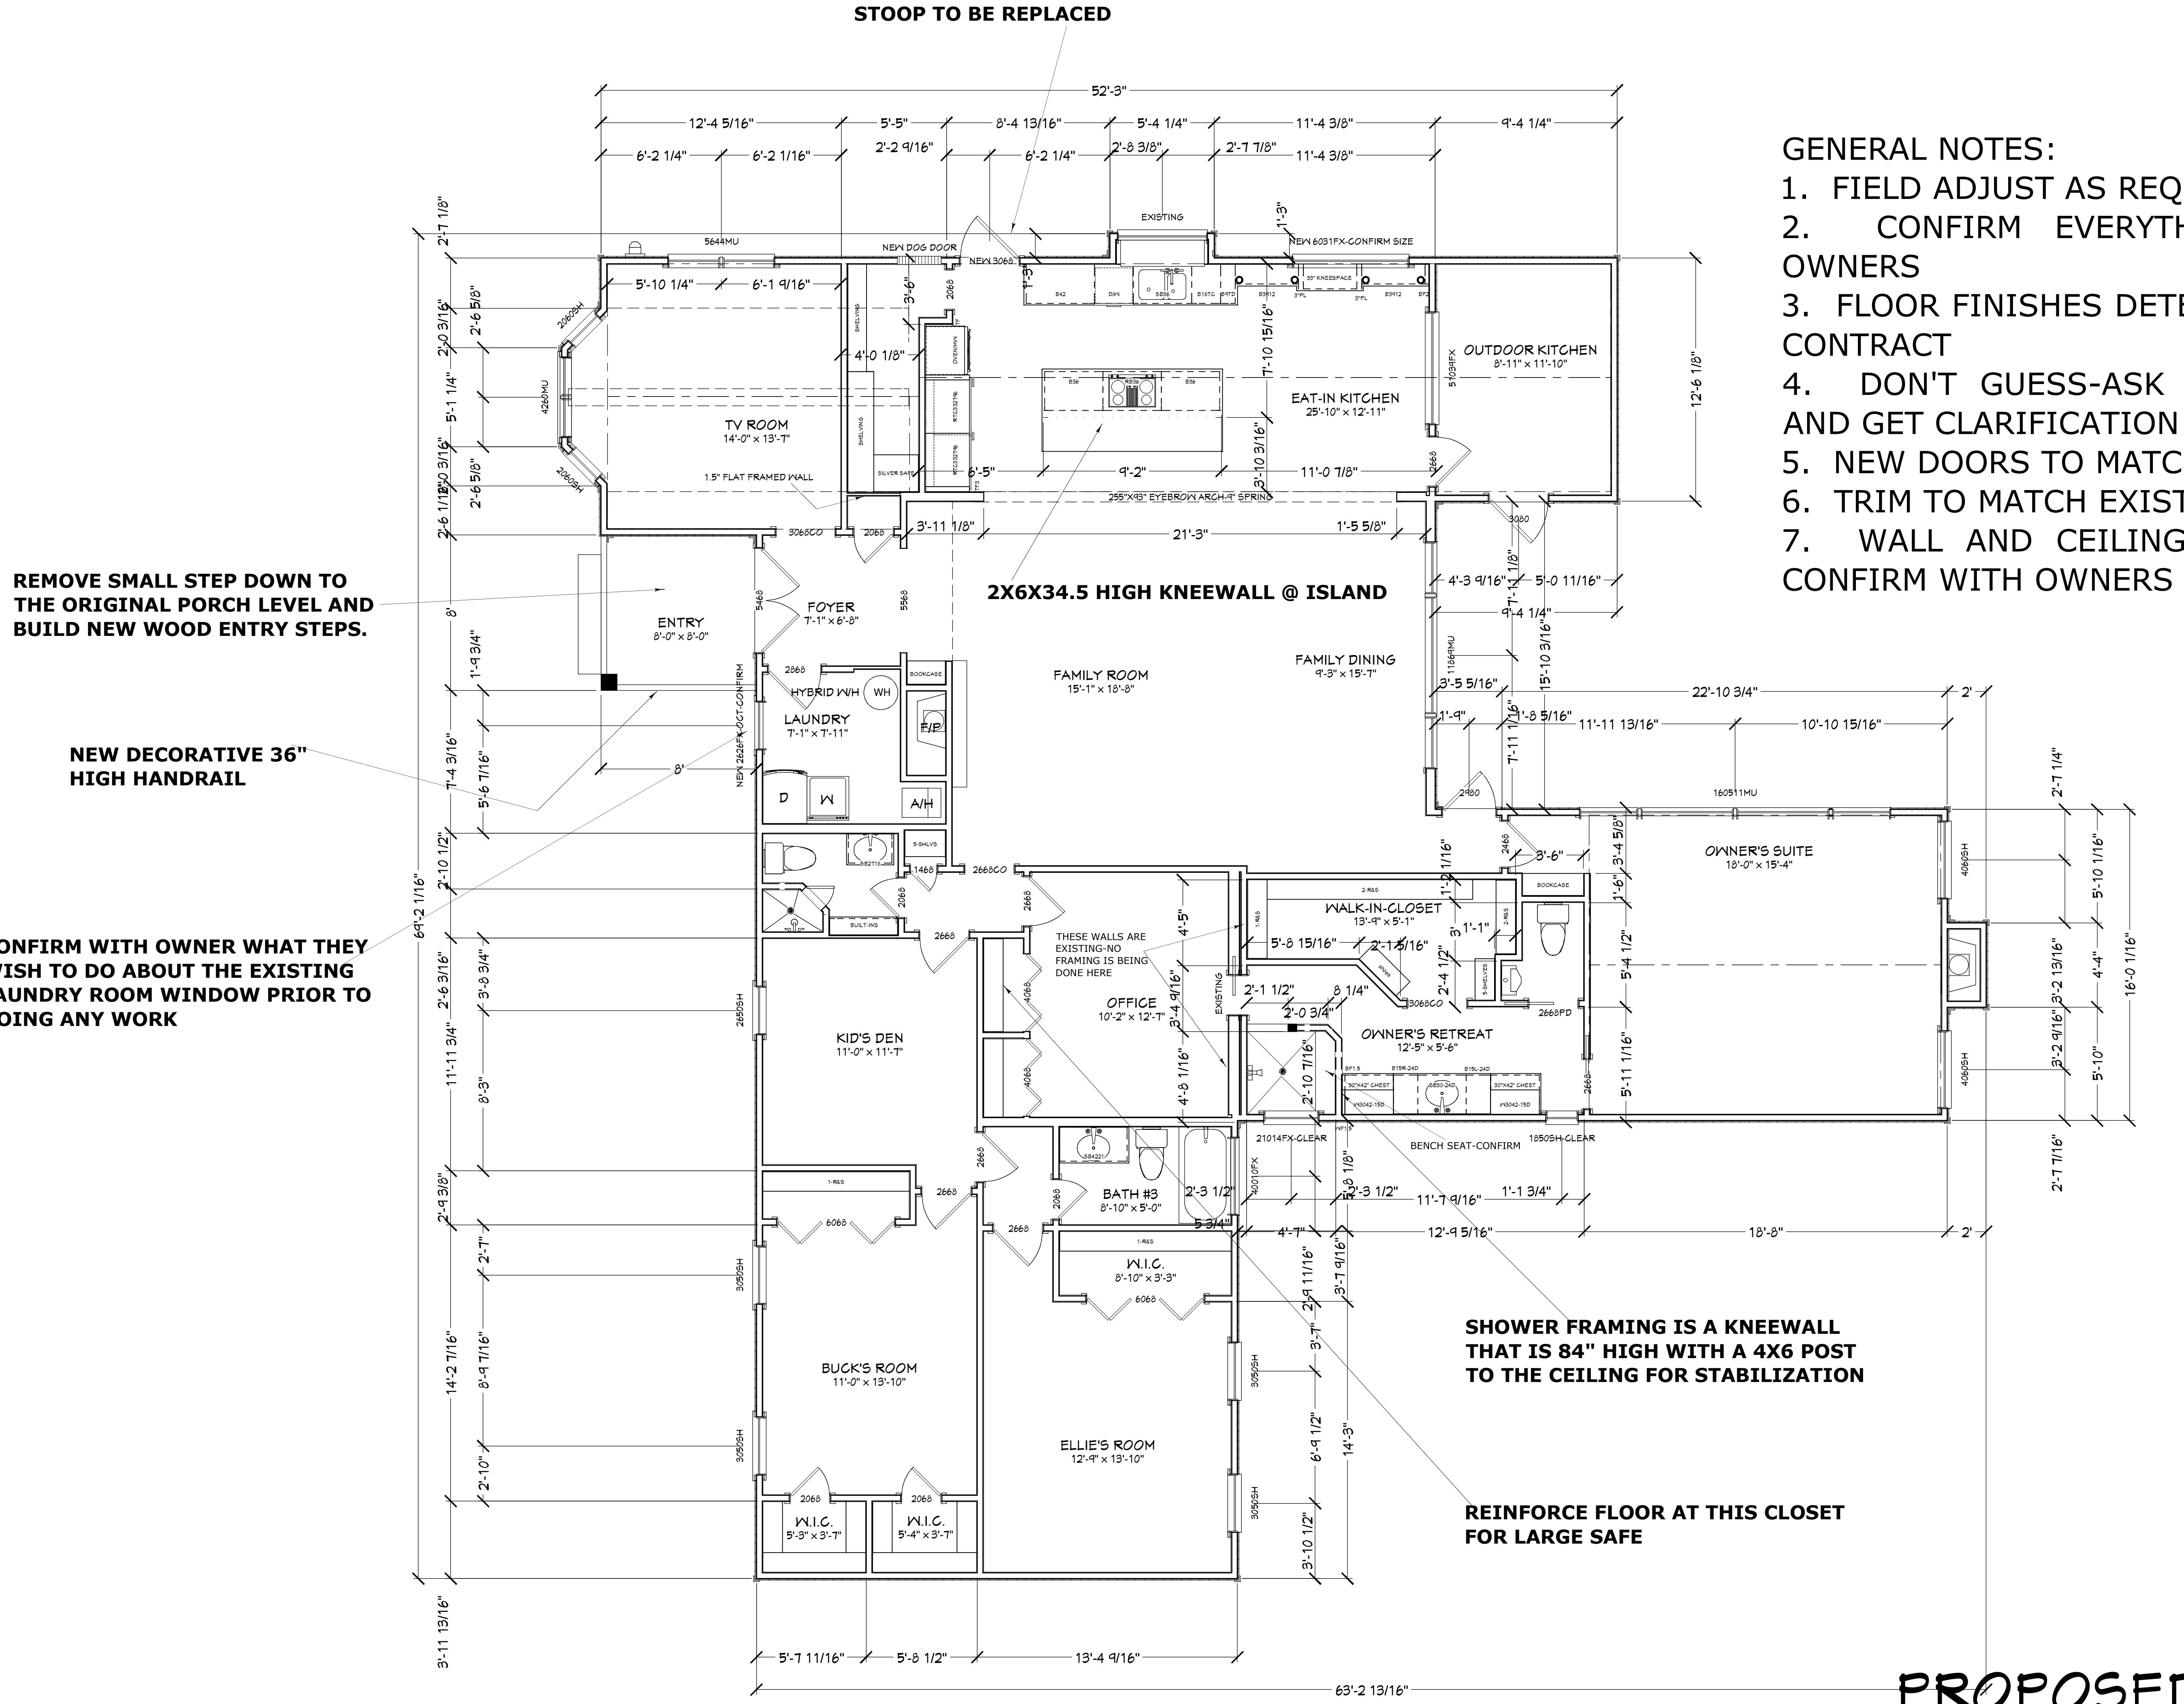

PROPOSED PLAN

COPYRIGHT 2015 - DESIGNS FOR LIVING, LLC. Under Federal Statute HR 5490 of the Architectural Drawing Act & Title 17 specific copyright laws apply to all published works of Designs for Living, LLC, herein referred to as Designer. It is unlawful for anyone to copy these drawings, either in whole or in part, without the express written permission of the designer! The use of any plans, specifications, electronic or hard copy prints shall be restricted to the original site for which they were prepared and publication thereof is expressly limited to such use. Title to all works, specifically all drawings and modified derivatives of any blueprints, series, drawings or specifications remain the designer's without prejudice. VISUAL CONTACT with any of these restrictions! This has held precedent in the North Florida Court system! Any and all violations will result in legal action being taken and litigated damages to the full extent allowed by law! No exceptions and no excuse! Contractor &/or owner shall verify all dimensions, details & specifications prior to construction. Every attempt has been made to avoid mistakes. The contractor and the owners also fully acknowledge that they have full copyright release approval and liability for any errors or omissions in these drawings. The contractor and the owners also fully acknowledge that they have full copyright release approval and liability for any errors or omissions in these drawings, including after construction has begun!

NO.	DESCRIPTION	BY	DATE

BUILT BY:
Pickett Construction, Inc.
9526 Argyle Forest Blvd.
Jacksonville, FL 32222
CGC1506644

PROJECT DESCRIPTION:
THE WILLIAMS FAMILY
3189 Doctors Lake Drive
Orange Park, FL 32073

Bid Drawings provided by:
Designs for Living, LLC
RESIDENTIAL DESIGN & CONSULTING
SERVING N/E FLORIDA SINCE 1978
904-730-7135

DATE:
10/8/2015

SCALE:
1/4" = 1'-0"


SHEET:
A-8

COPYRIGHT 2015 - DESIGNS FOR LIVING, LLC. Under Federal Statute HR 5490 of the Architectural Drawing Act & Title 17 specific copyright laws apply to all published works of Designs for Living, LLC, herein referred to as Designer. It is unlawful for anyone to copy these drawings, either in whole or in part, without the express written permission of the designer! The use of any plans, specifications, electronic or hard copy prints shall be restricted to the original site for which they were prepared and publication thereof is expressly limited to such use. Tie in all works, specifically all drawings and modified derivatives of any blueprints, series, drawings or specifications remain the designers without prejudice. VISUAL CONTACT with any of these restrictions! This has held precedent in the North Florida Court system! Any and all violations will result in legal action being taken and litigated damages to the full extent allowed by law! No exceptions and no excuse! Contractor &/or owner shall verify all dimensions, details, specifications prior to construction. Every attempt has been made to avoid mistakes. The contractor and the owners also fully acknowledge that they have full copyright release approval and

Designs for Living LLC nor R.E. Chip Mitchell shall not be liable for error for copyright infringement or other errors after delivery via email of drawings, including after construction has begun!

ELECTRICAL - DATA - AUDIO LEGEND

SYMBOL	DESCRIPTION
	Ceiling Fan
	Ventilation Fans: Ceiling Mounted, Wall Mounted
	Ceiling Mounted Light Fixtures: Surface/Pendant, Recessed, Heat Lamp, Low Voltage
	Wall Mounted Light Fixtures: Flush Mounted, Wall Sconce
	Chandelier Light Fixture
	Fluorescent Light Fixture
	240V Receptacle
	110V Receptacles: Duplex, Weather Proof, GFCI
	Switches: Single Pole, Weather Proof, 3-Way, 4-Way
	Switches: Dimmer, Timer
	Audio Video: Control Panel, Switch
	Speakers: Ceiling Mounted, Wall Mounted
	Wall Jacks: CAT5, CAT5 + TV, TV/Cable
	Telephone Jack
	Intercom
	Thermostat
	Door Chime, Door Bell Button
	Smoke Detectors: Ceiling Mounted, Wall Mounted
	Electrical Breaker Panel

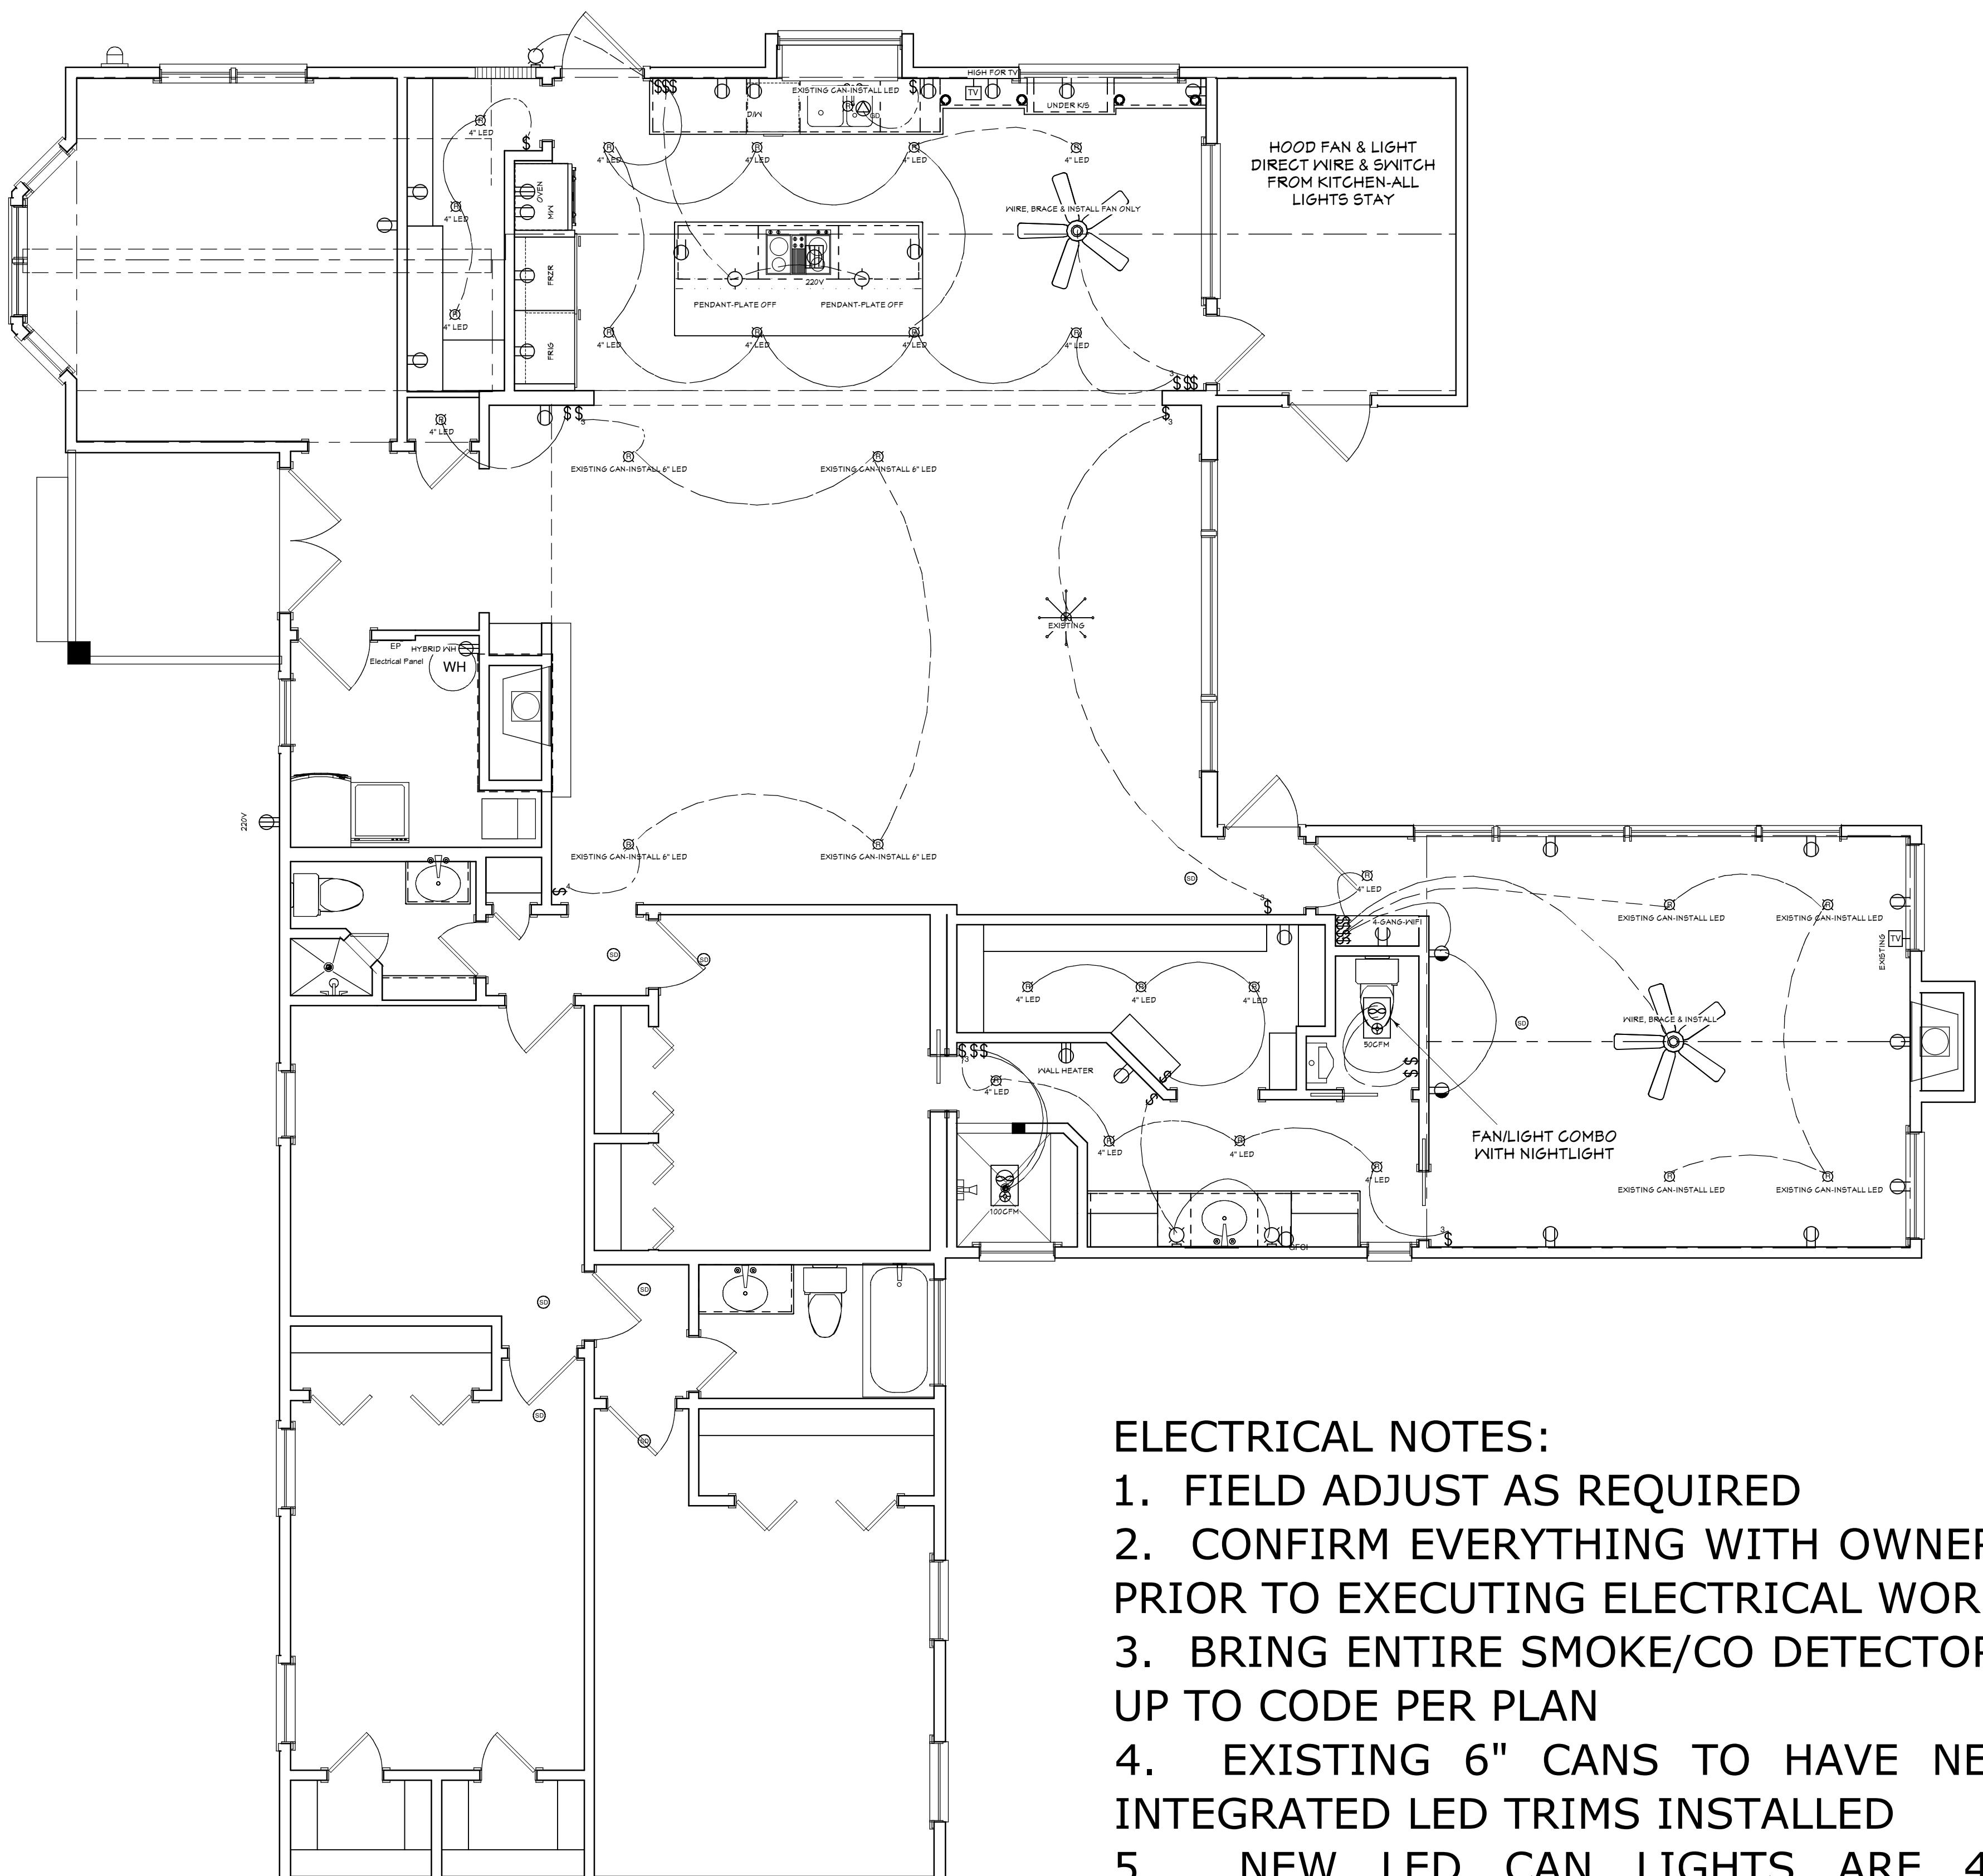

ELECTRICAL NOTES:

1. FIELD ADJUST AS REQUIRED
2. CONFIRM EVERYTHING WITH OWNERS PRIOR TO EXECUTING ELECTRICAL WORK
3. BRING ENTIRE SMOKE/CO DETECTORS UP TO CODE PER PLAN
4. EXISTING 6" CANS TO HAVE NEW INTEGRATED LED TRIMS INSTALLED
5. NEW LED CAN LIGHTS ARE 4"- CONFIRM WITH OWNERS

**PLAN #
2059**

NO.	DESCRIPTION	BY	DATE



BUILT BY:
Pickett Construction, Inc.
9526 Argyle Forest Blvd.
Jacksonville, FL 32222
CGC1506644

PROJECT DESCRIPTION:
THE WILLIAMS FAMILY
3189 Doctors Lake Drive
Orange Park, FL 32073


Bid Drawings provided by:
Designs for Living, LLC
RESIDENTIAL DESIGN & CONSULTING
SERVING N/E FLORIDA SINCE 1978
904-730-7155

DATE:
10/8/2015
SCALE:
1/2" = 1'-0"
SHEET:
A-9


COPYRIGHT 2015 - DESIGNS FOR LIVING, LLC - Under Federal Statute HR 5490 of the Architectural Drawing Act & Title 17 specific trait copyright laws apply to all published works of Designs for Living, LLC, herein referred to as Designer. It is unlawful for anyone to copy these drawings, either in whole or in part, without the express written permission of the designer! The use of any plans, specifications, electronic or hard copy prints shall be restricted to the original site for which they were prepared and publication thereof is expressly limited to such use. Title to all works, specifically all drawings, specifications and modified derivatives of any blueprints, series, drawings or specifications remain the designer without prejudice. Visual contact with any of these drawings, or their purchase, constitutes prima facie evidence of the acceptance of these restrictions! This has held precedent in the North Florida Court system. Any and all violations will result in legal action being taken and litigated damages to the full extent allowed by law! No exceptions and no excuse! Contractor &/or owner shall verify all dimensions, details, specificiations prior to construction. Every attempt has been made to avoid mistakes. The contractor and the owners also fully acknowledge that they have full copyright release approval and liability released for any errors after delivery via email of drawings, including after construction has begun!

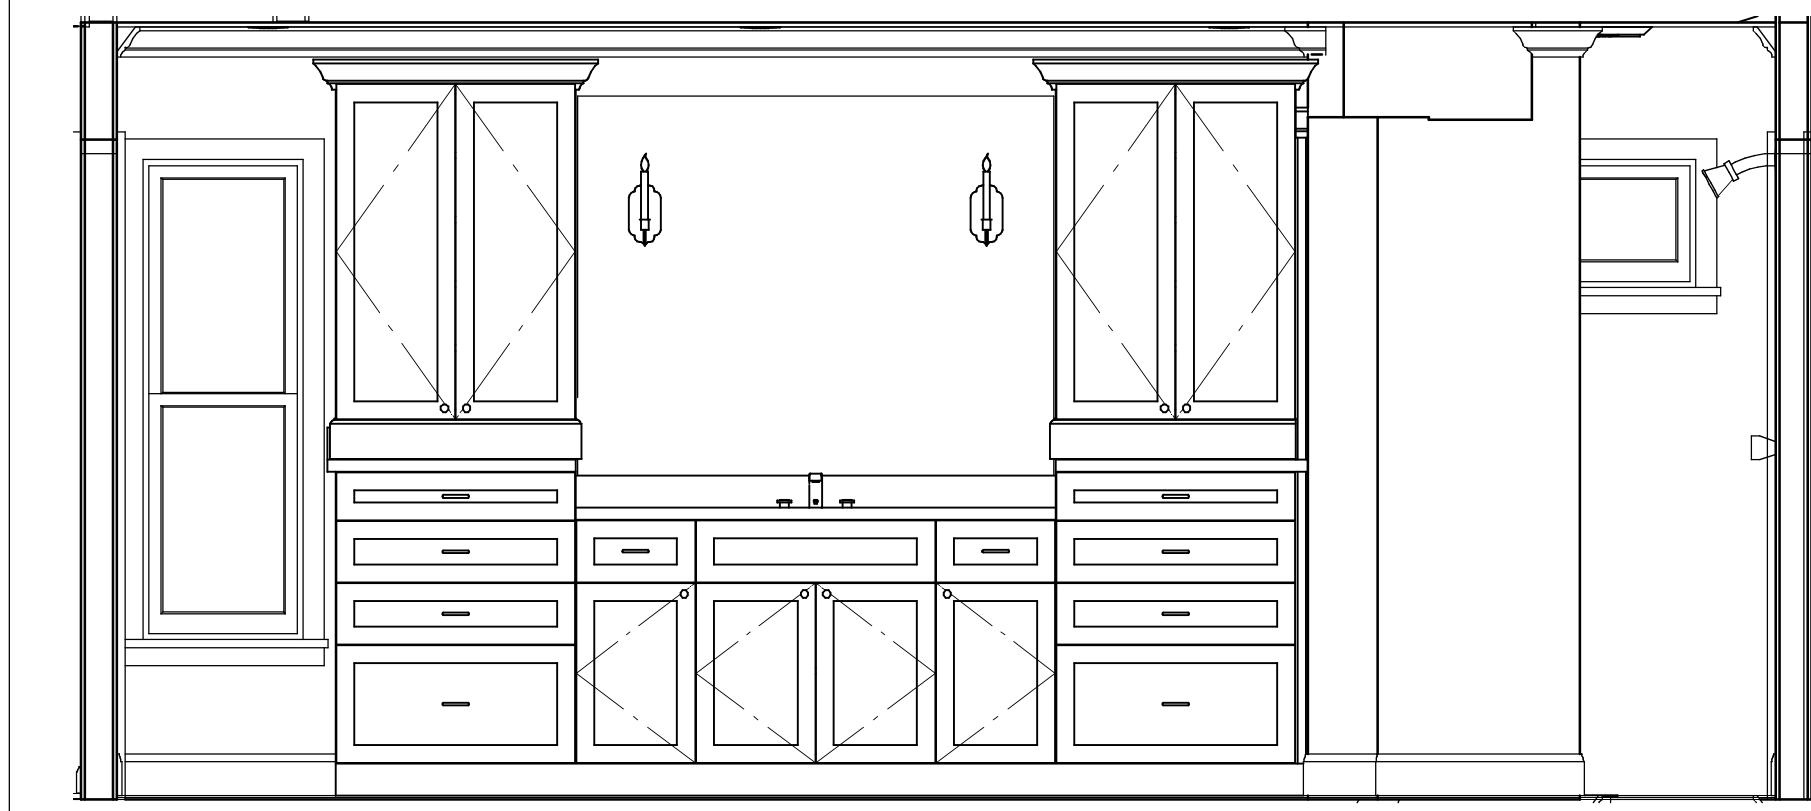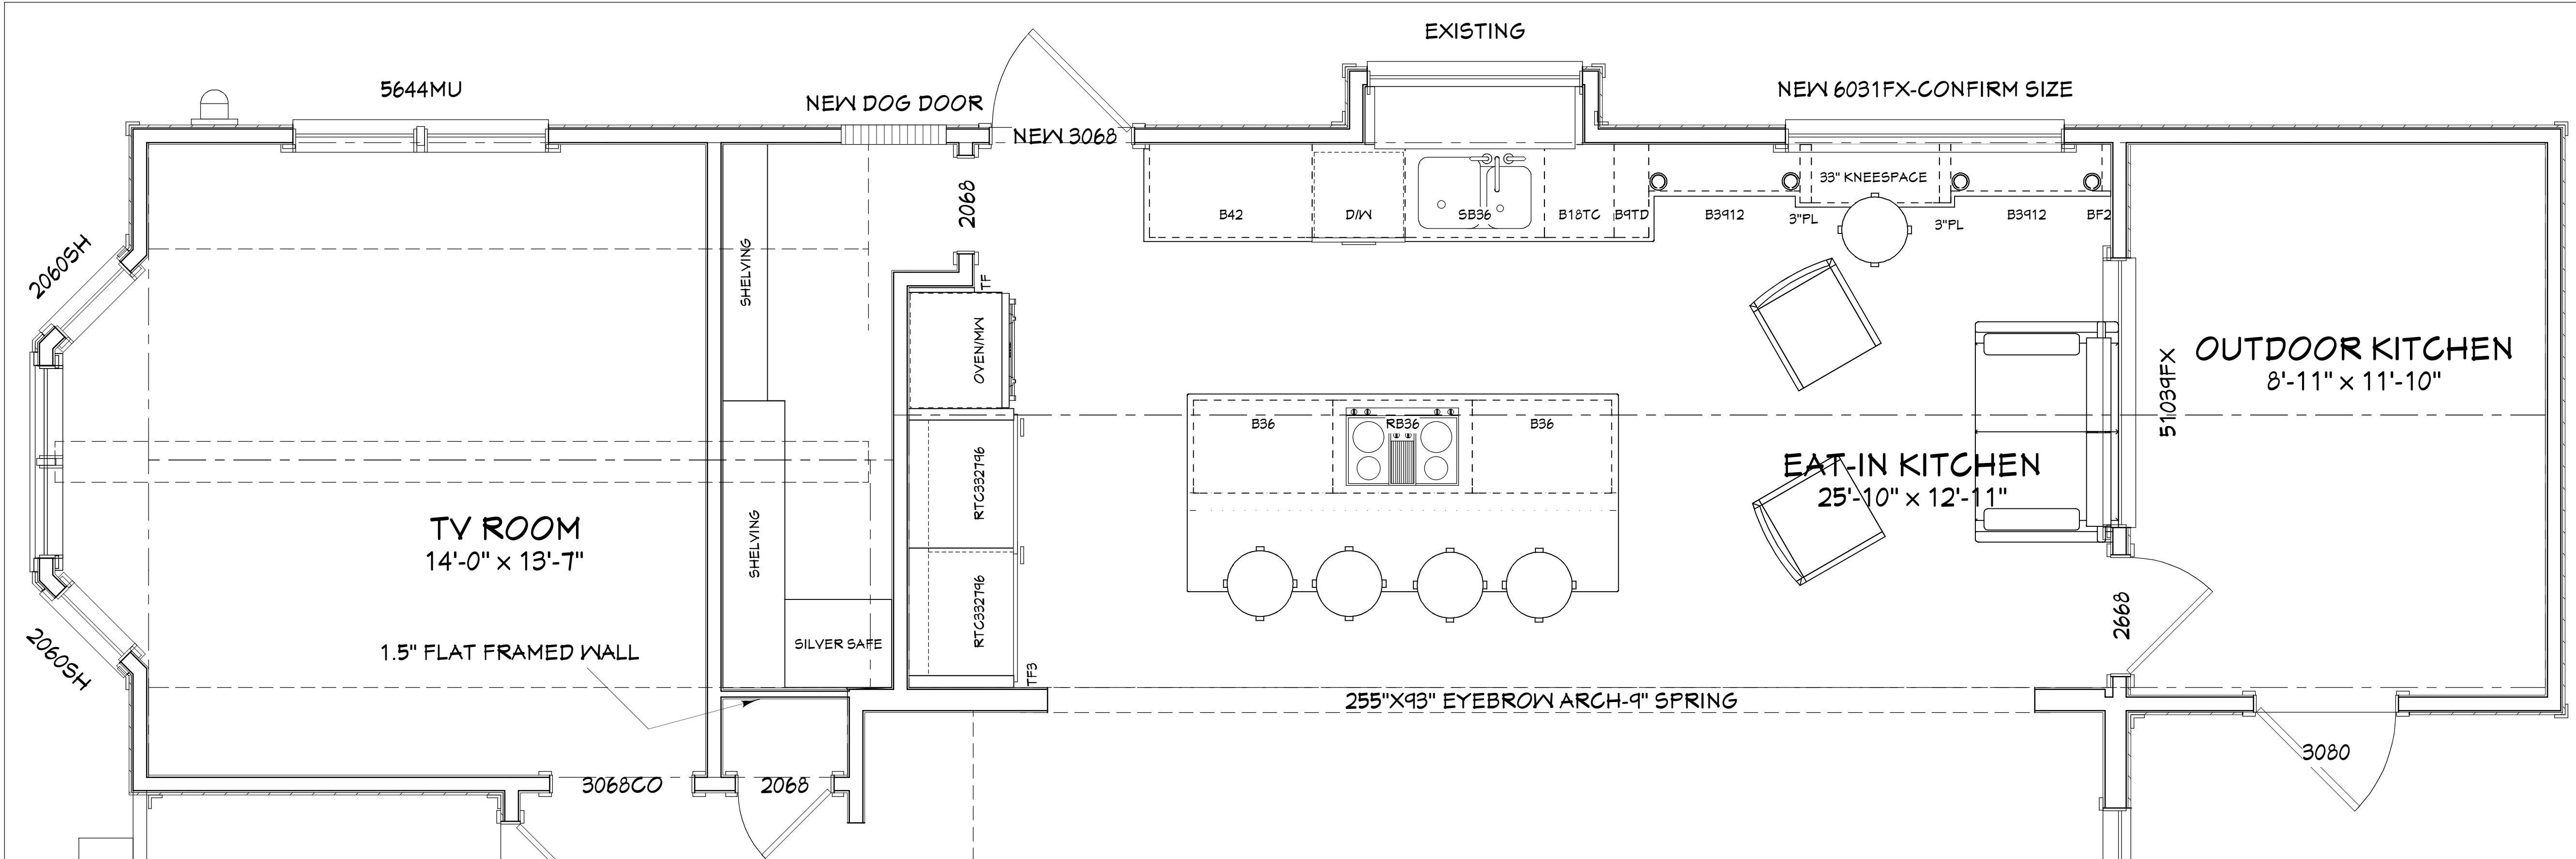


OWNER'S BATH

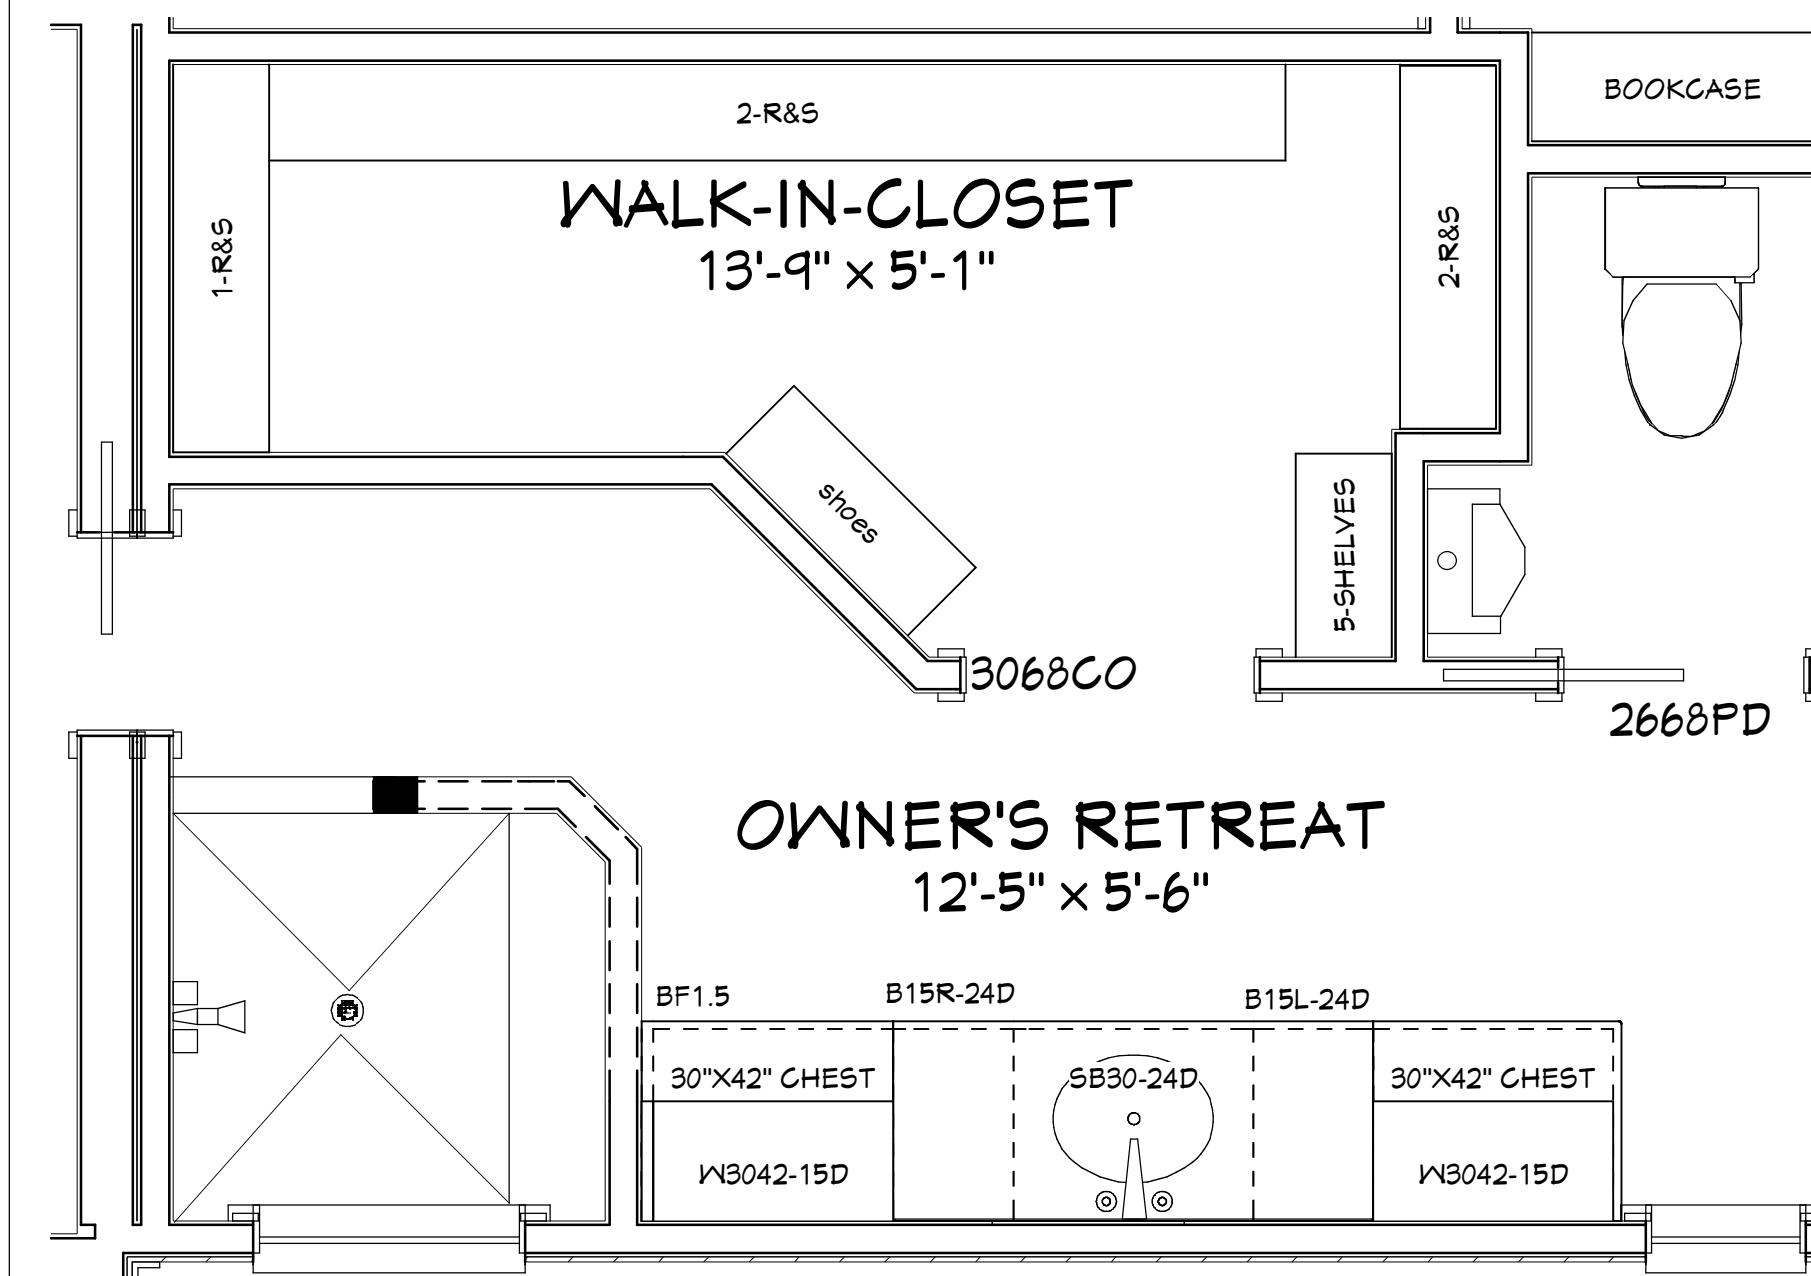


OWNER'S RETREAT
12'5" x 5'6"

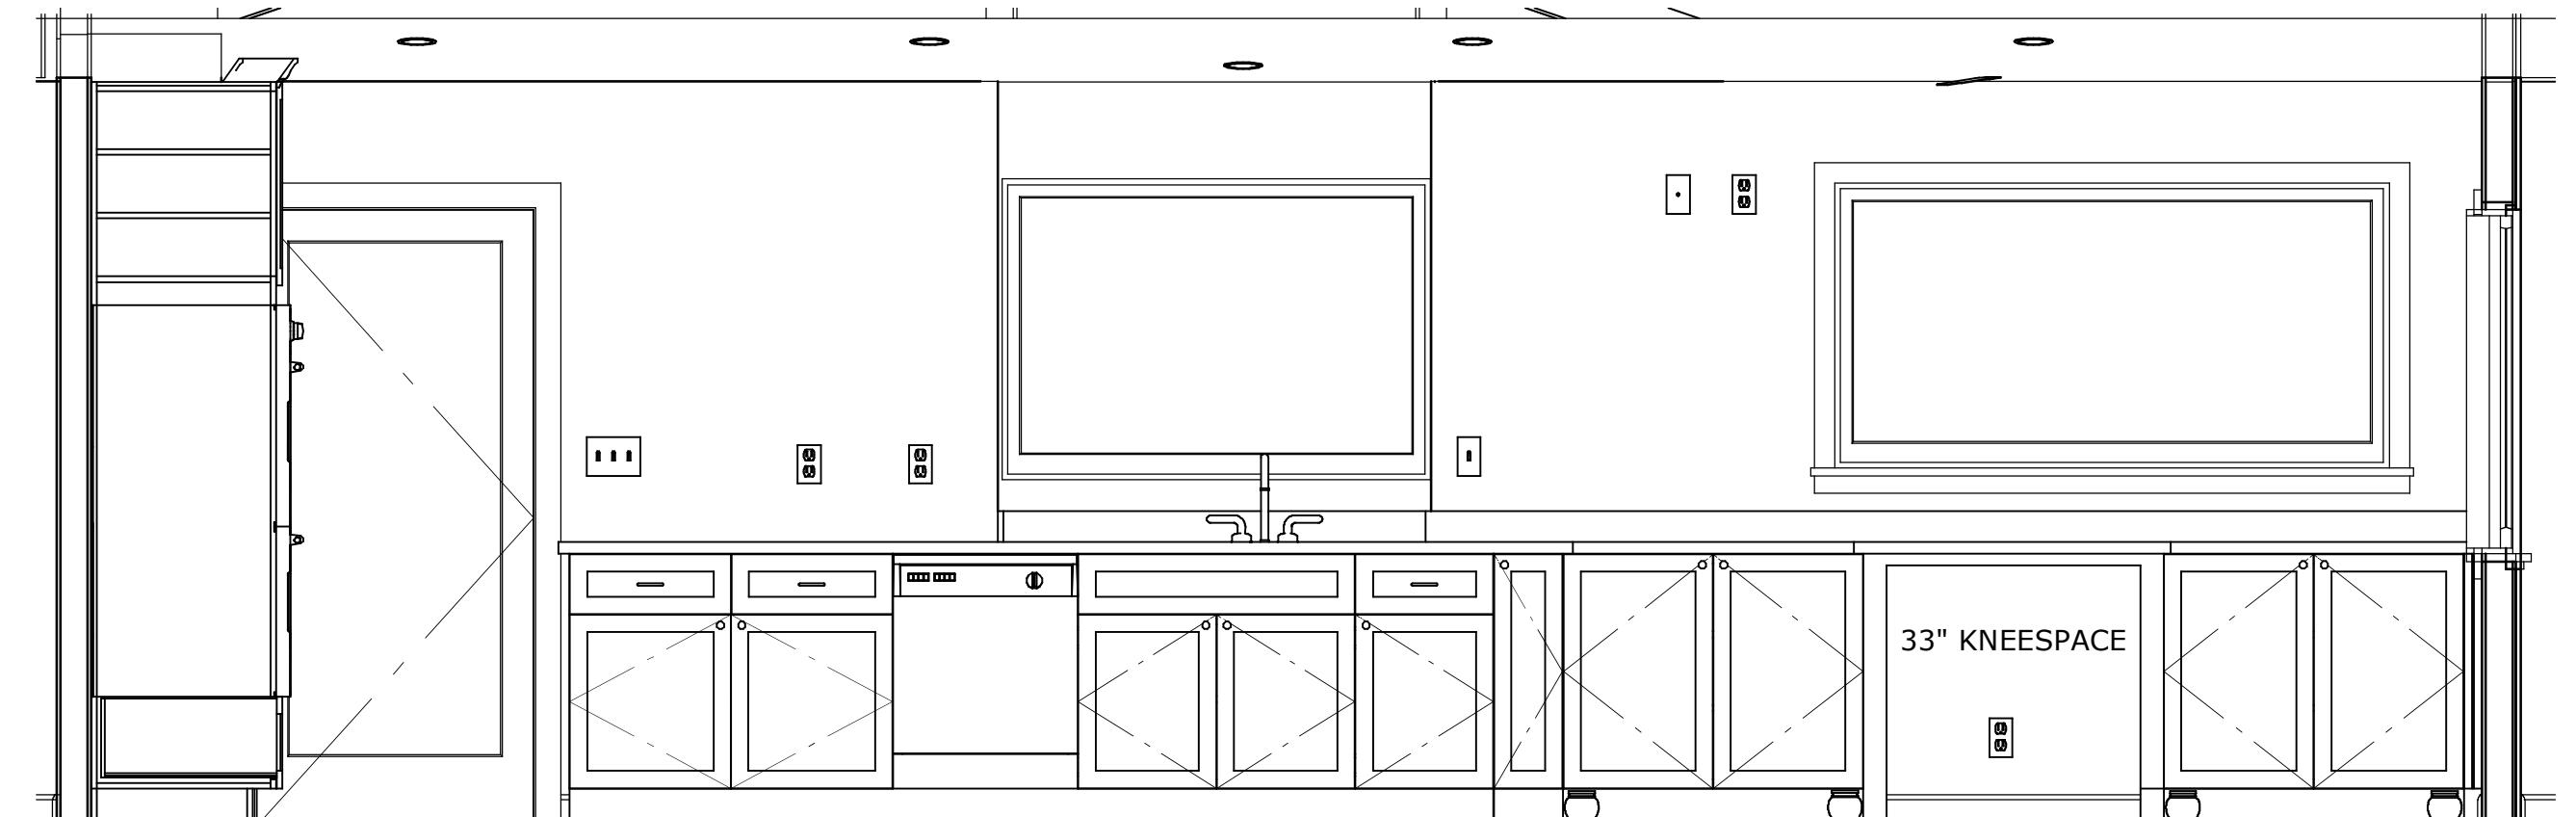

FOOD PREP/CLEANING AREA

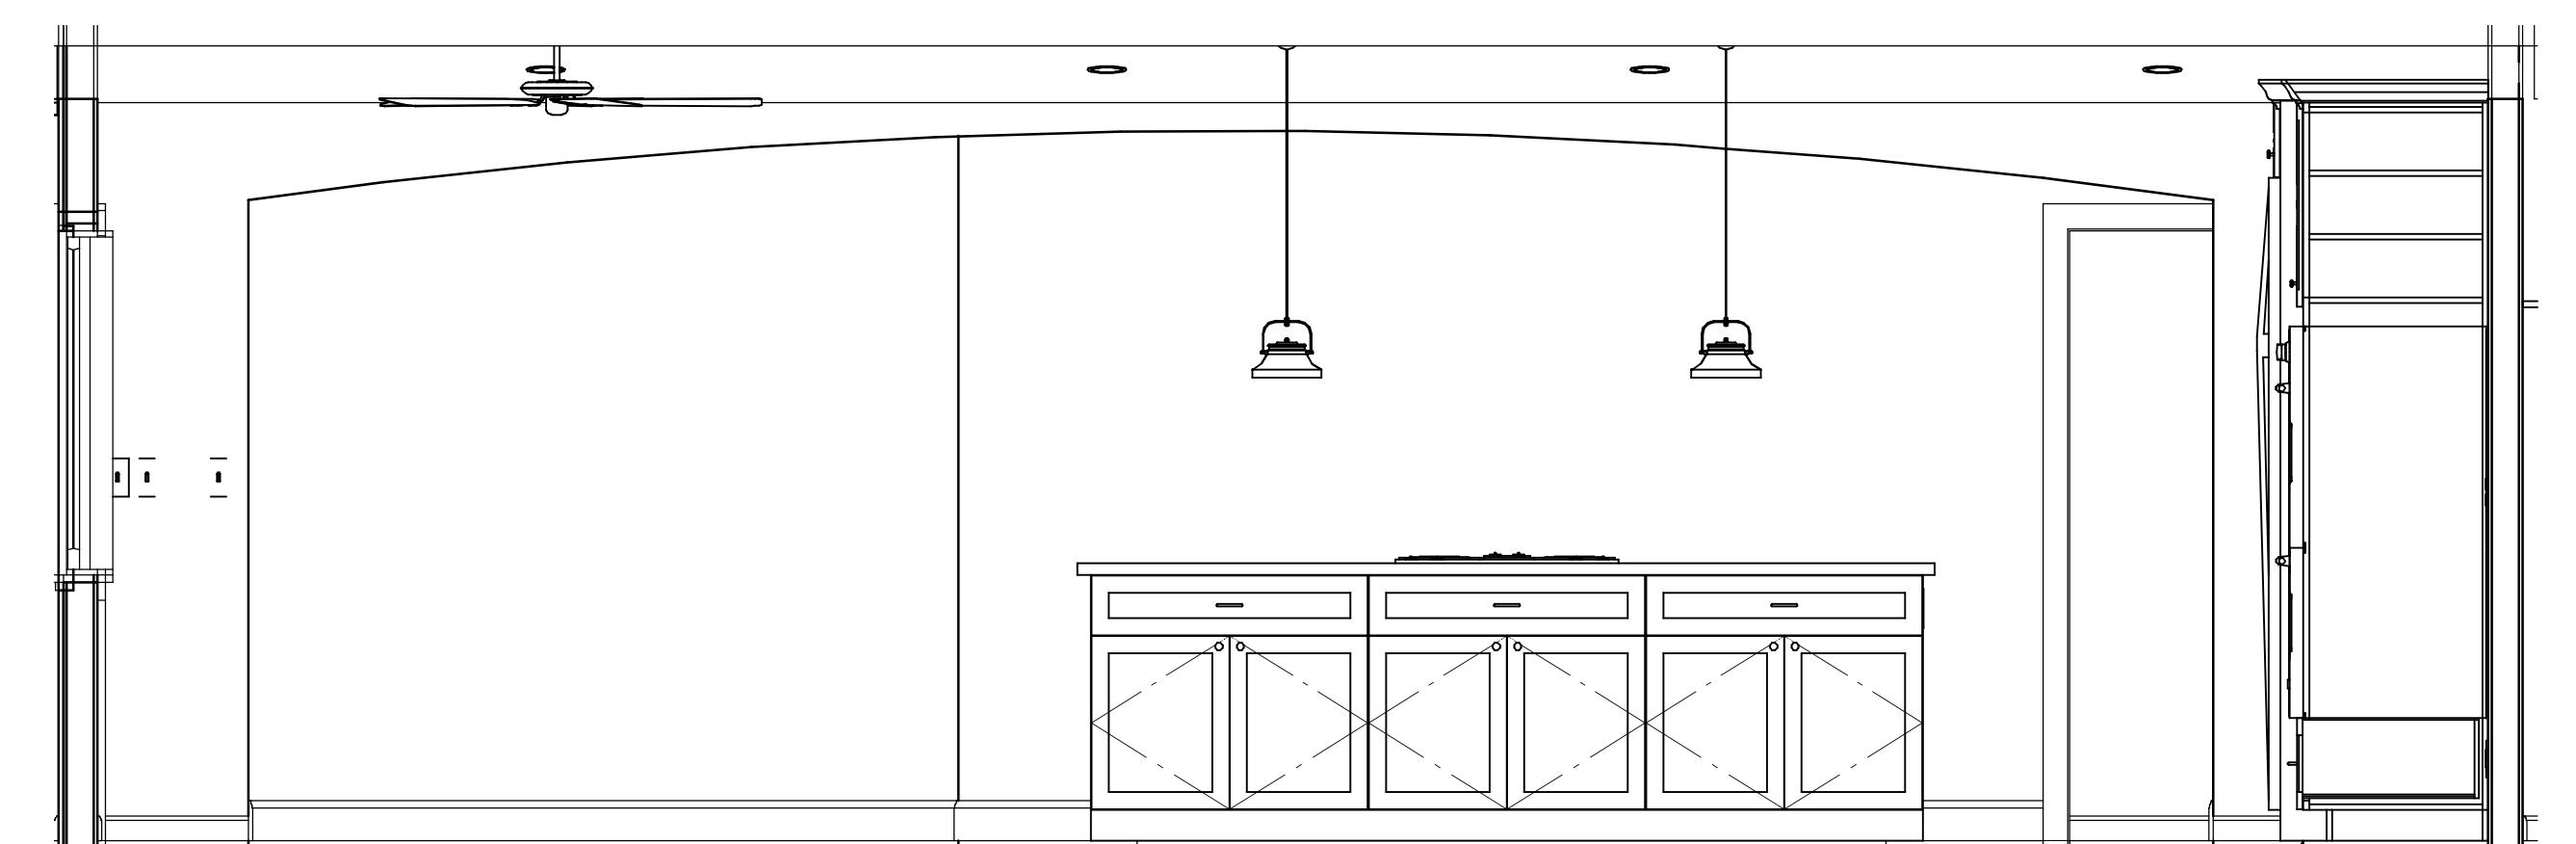

COOKING/EATING AREA

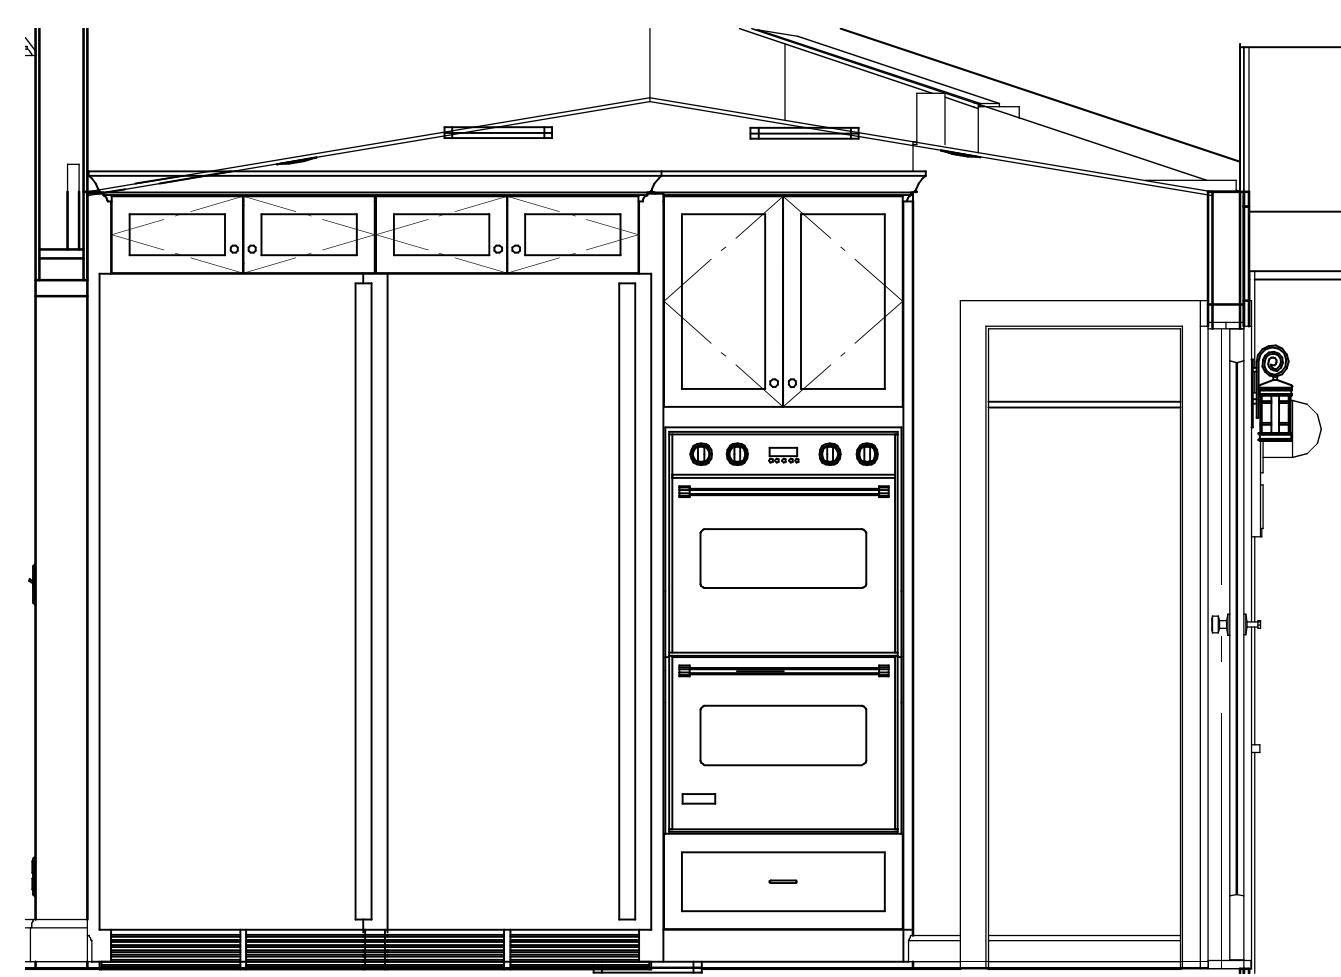

FRIG/FRZR/BAKING AREA

CABINET PLAN