


REIGERT-JOHNSON FAMILY RENOVATIONS

BID PLAN: 7/30/2017

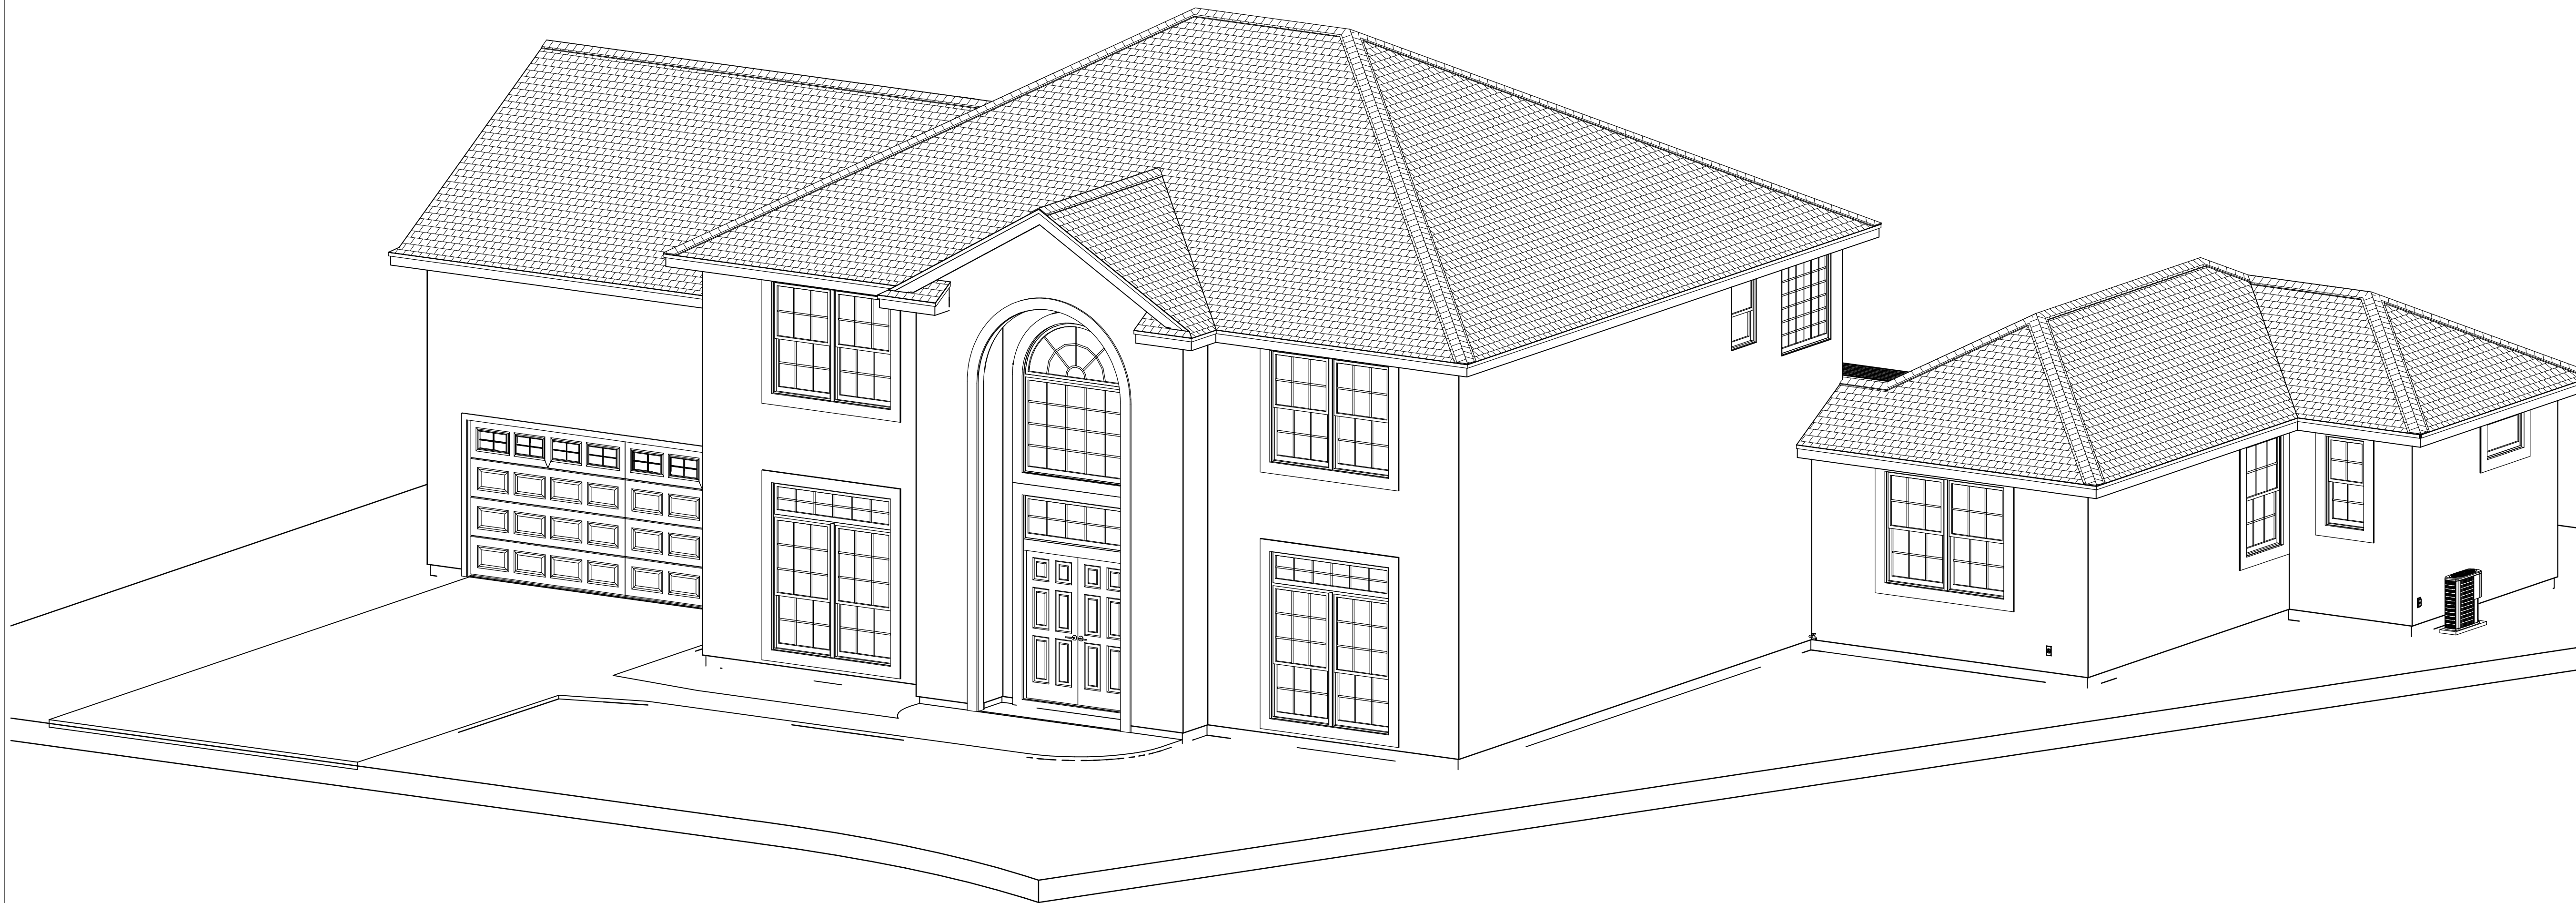

508 E SURF SPRAY LANE
PONTE VEDRA BEACH, FL 32082
R/E #: 062156-2521

BUILT BY:
TOM TROUT, INC
5569-1 BOWDEN ROAD
JACKSONVILLE, FL 32216
CBC026189
904-737-5412

COVER PAGE

PLANS NOT RELEASED FOR CONSTRUCTION

COPYRIGHT © 2017: DESIGN'S FOR LIVING, LLC Under section 102 of the Architectural Works Copyright Protection Act (title 17 of the United States Code) specific copyright laws apply to original design of a building created in any tangible medium of expression, including a computerized plan, model or drawing, and is subject to copyright protection as an "architectural work" by Designs for Living, LLC herein referred to as "the Designer". It is unlawful for anyone to copy these drawings, either in whole or in part, without the express written permission of the Designer! The use of any plans, specifications, electronic or hard copy prints and drawings are restricted to the original site for which they were prepared and publication thereof is expressly limited! This has held precedent in the North Florida Court system! Any and all violations WILL result in legal action being taken and financial damages to the full extent allowed by law! No exceptions and no excuses! Contractor &/or owner shall verify all dimensions, details, & specifications prior to construction. The contractor and the owners also fully acknowledge that they have full copyright release approval and Designs for Livings LLC R.O. Chip Mitchell shall not be liable for error for copyright infringement or other errors after delivery via email of drawings including after construction has begun! This copyright law is only valid on building designs created on or after December 1, 1990.

CLIENT APPROVAL SIGNATURE	DATE
DOUGLAS L. REIGERT-JOHNSON	
VANESSA J. REIGERT-JOHNSON	



PROJECT DESCRIPTION:
**RENOVATIONS FOR THE
REIGERT-JOHNSON FAMILY**
508 E SURF SPRAY LANE
PONTE VEDRA BEACH, FL 32082
R/E #: 062156-2521



DATE:

7/30/2017



SCALE:

N.T.S.

SHEET:

A-1

SITE LOCATION

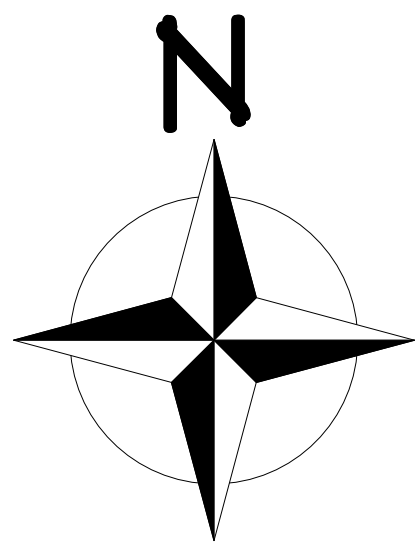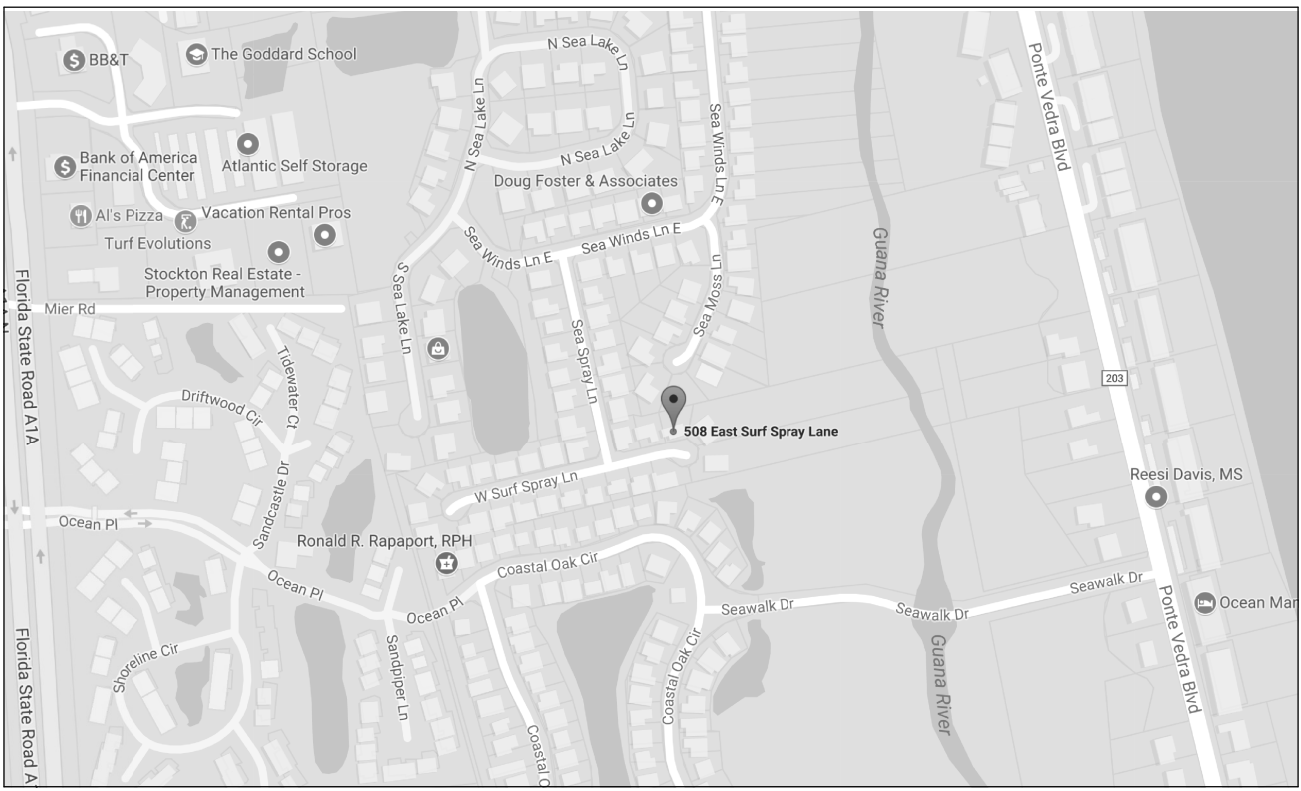


WATER: JEA
SEWER: JEA
ELECTRIC: JEA

ZONING: PSD
SETBACKS:
FRONT: 20'
SIDES: 5'
REAR: 10'
MAX. BLDG. HT: 35'
BUILDING IMPERVIOUS: 35%
MAXIMUM IMPERVIOUS: 70%

SETBACKS ARE MEASURED
TO THE BODY OF THE HOME

WIND DESIGN CRITERIA:
WIND SPEED: 130 MPH
EXPOSURE CATEGORY: "C"
BUILDING TYPE: ENCLOSED
BUILDING CATEGORY: II
IMPORTANCE FACTOR: 1.0
TOPOGRAPHY: FLAT
MEAN ROOF HEIGHT: -25 FT
BUILDING CODE: 2014 FBC-R

The applicant/owner/contractor shall immediately contact St. Johns County lot grading staff should modifications to the drainage plan be required during site development, based on actual field conditions.

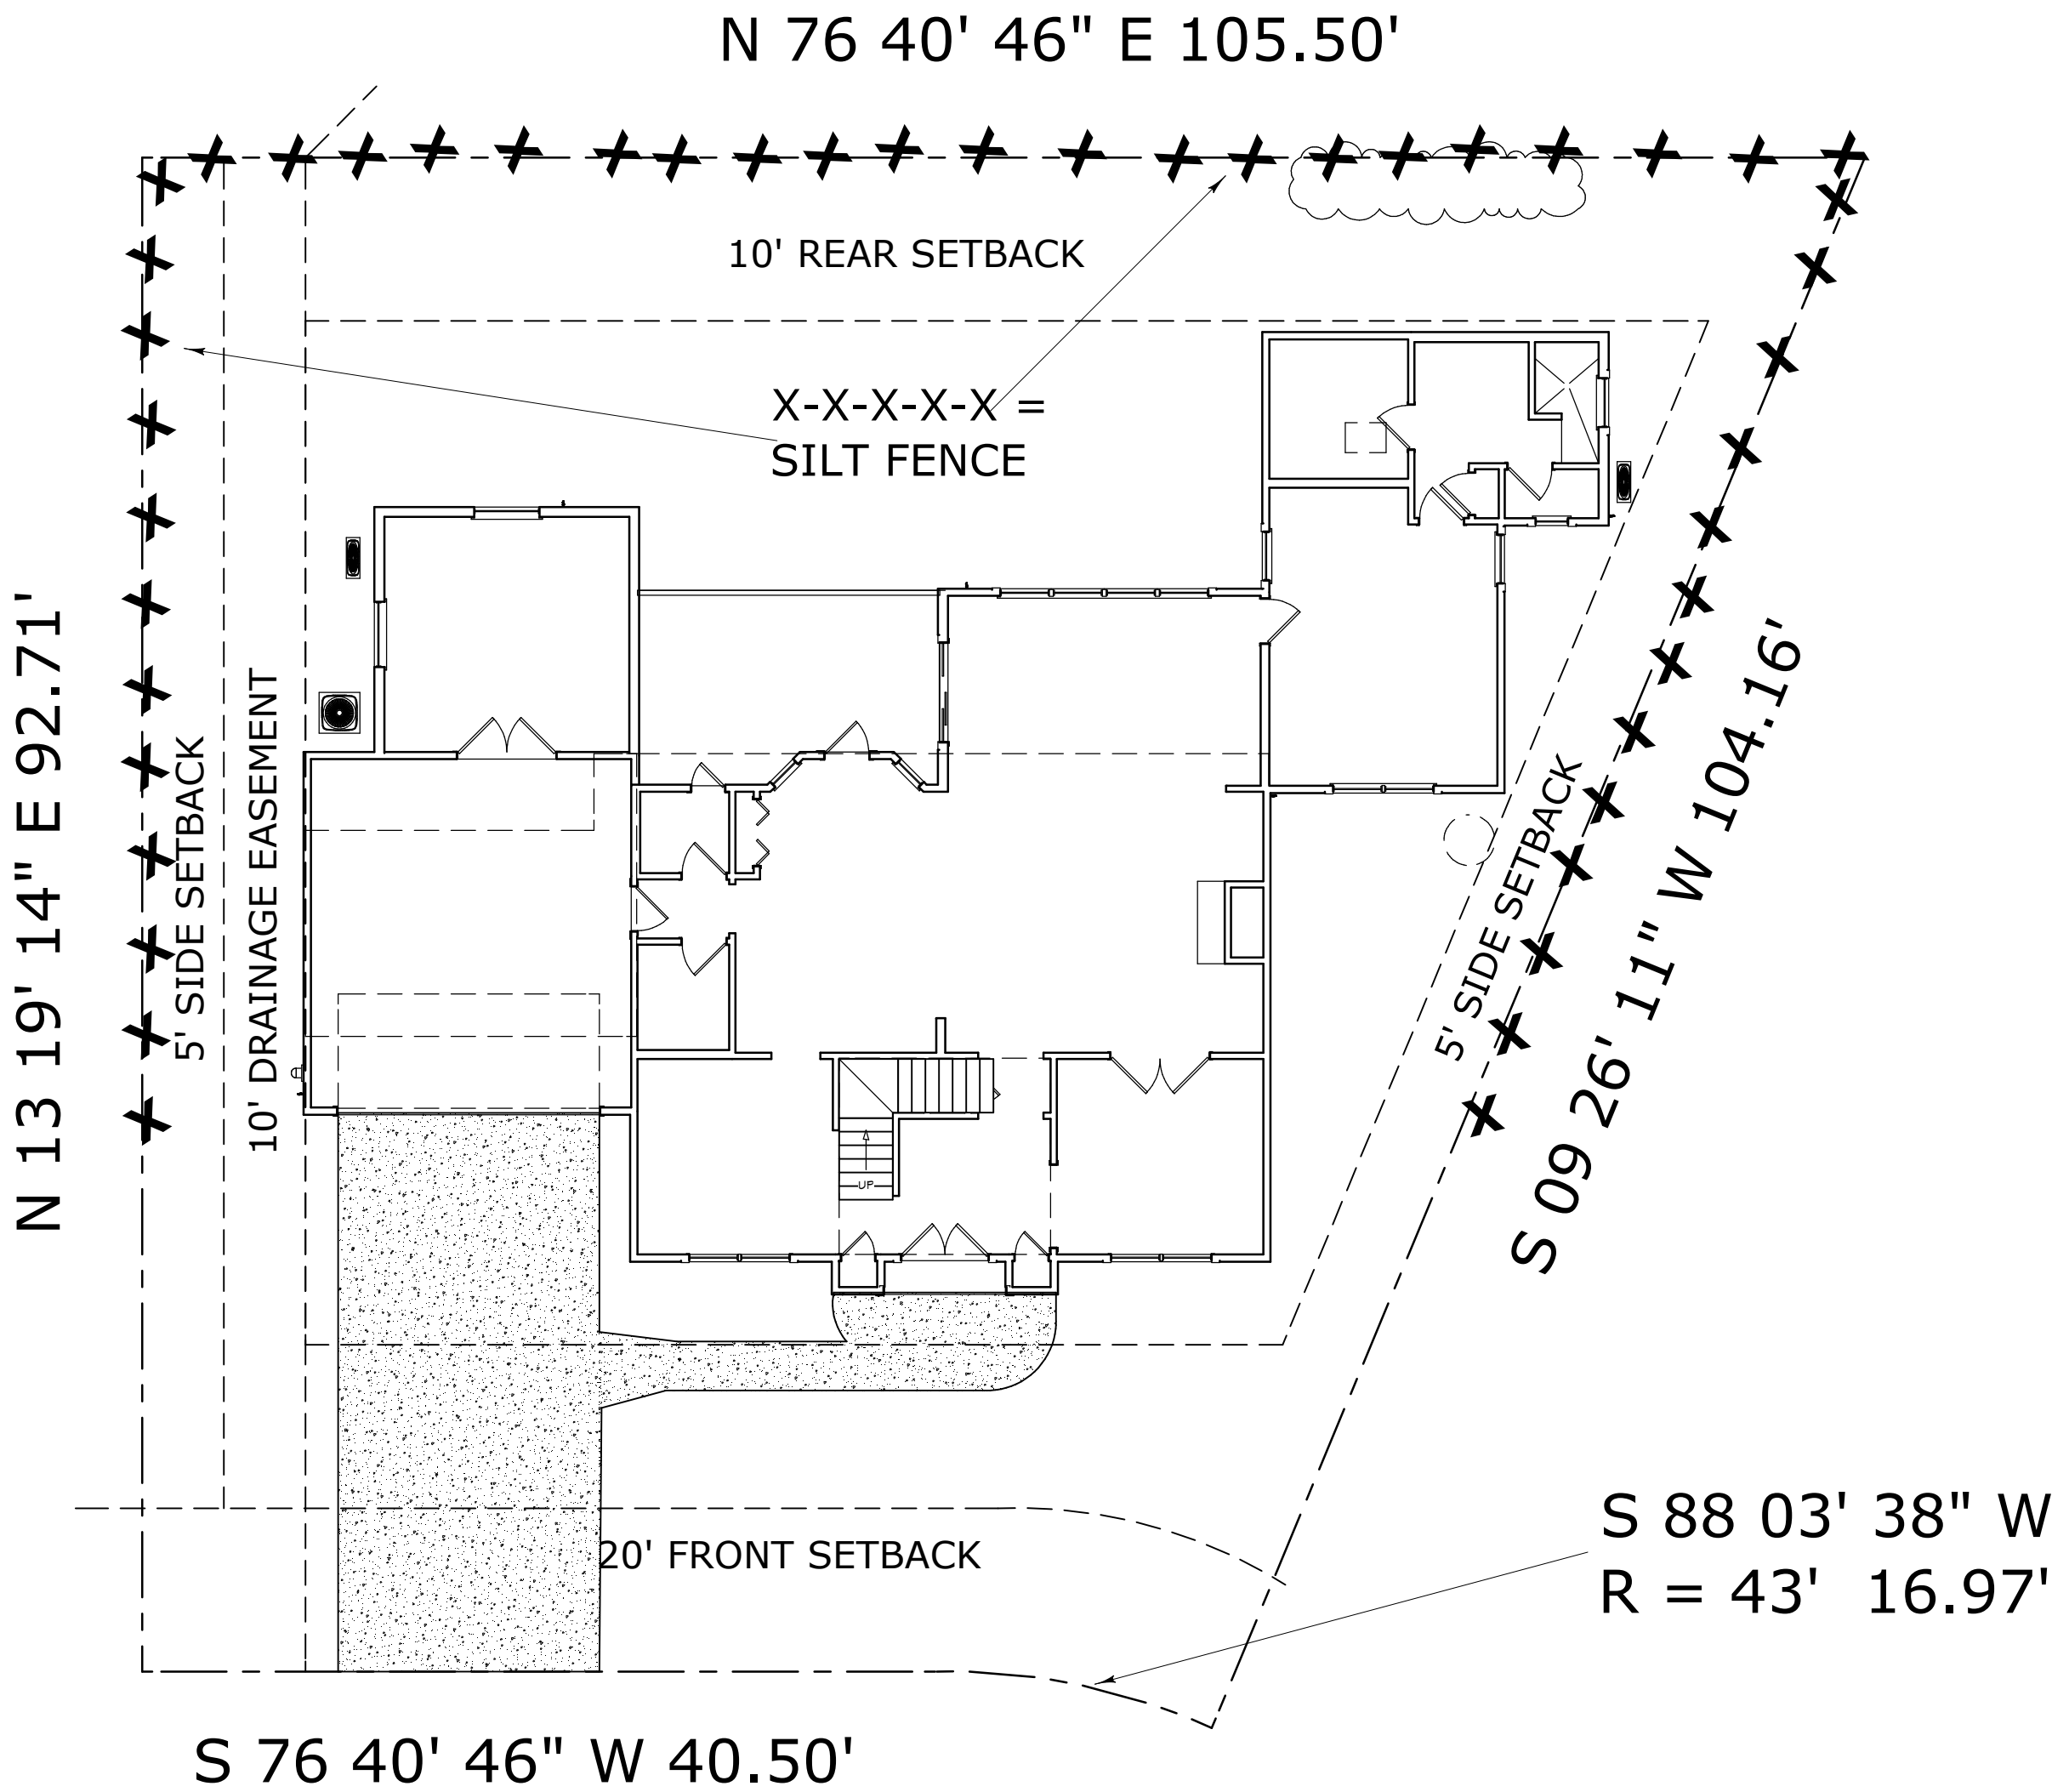

FOUNDATIONS ARE
MONOLITHIC
FOOTERS & SLABS

HVAC PAD LOCATION-A
MINIMUM 5 FOOT FROM
THE PROPERTY LINE
SHALL BE MAINTAINED

NOTE: 1% MINIMUM SLOPE WILL
BE PROVIDED FROM BUILDING
TO DISCHARGE POINT PER
SECTION 6.04.06H OF THE LAND
DEVELOPMENT CODE.

508 EAST SURF SPRAY LANE

TYPE: "B" DRAINAGE FLOOD ZONE: "X, XS, & AE"

SITE CALCULATIONS:
LAND AREA: 8,100 S.F.
HOME COVERAGE: 2,790.15 S.F.
% OF BUILDING COVERAGE: 34.45 %
WALKS, DRIVES, AC PAD COVERAGE: 675.56 S.F.
% OF WALKS, DRIVES, PATIO & AC PAD COVERAGE: 8.34%
TOTAL IMPERVIOUS: 42.79 %

LEGAL DESCRIPTION:
R/E #: 010170-0000
PONTE VEDRA BY THE SEA, UNIT 3,
BLOCK 5, LOT 21
RECORDED PLAT BOOK 3146, PAGE 1082

SITE PLAN

PLAN #
A-508

CLIENT APPROVAL SIGNATURE	DATE
DOUGLAS L. REIGERT-JOHNSON	
VANESSA Z. REIGERT-JOHNSON	




PROJECT DESCRIPTION:
RENOVATIONS FOR THE
REIGERT-JOHNSON FAMILY
508 E SURF SPRAY LANE
PONTE VEDRA BEACH, FL 32082
R/E #: 062156-2521



DATE:
7/30/2017
SCALE:
1" = 40'-0"
SHEET:
A-2

PLANS NOT RELEASED FOR CONSTRUCTION

COPYRIGHT 2017: DESIGNS FOR LIVING, LLC. -Under section 102 of the Architectural Works Copyright Protection Act (title 17 of the United States Code) specific tacit copyright laws apply to original design of a building created in any tangible medium of expression, including a constructed building or architectural plans, models, or drawings and is subject to copyright protection as an "architectural work" by Designs for Living, LLC. herein referred to as Designer. It is unlawful for anyone to copy these drawings, either in whole or in part, without the express written permission of the Designer. The use of any plans, specifications, electronic or hard copy prints shall be restricted to the original site for which they were prepared and publication thereof is expressly limited to such use. Title to all works, specifically all drawings, specifications, and modified derivatives of any blueprints, e-files, drawings, or specifications remain the Designers without prejudice. VISUAL CONTACT with any of these drawings, or their purchase constitutes prima facie evidence of the acceptance of these restrictions! This has held precedent in the North Florida Court system! Any and all violations WILL result in legal action being taken and litigated damages to the full extent allowed by law! No exceptions and no excuses! Contractor &/or owner shall verify all dimensions, details, & specifications prior to construction. Every attempt shall be made to ensure accuracy and quality. This copyright law is only valid on building designs created on or after December 1, 1990. Other errors after delivery via email of drawings including after construction has begun. This copyright law is only valid on building designs created on or after December 1, 1990.

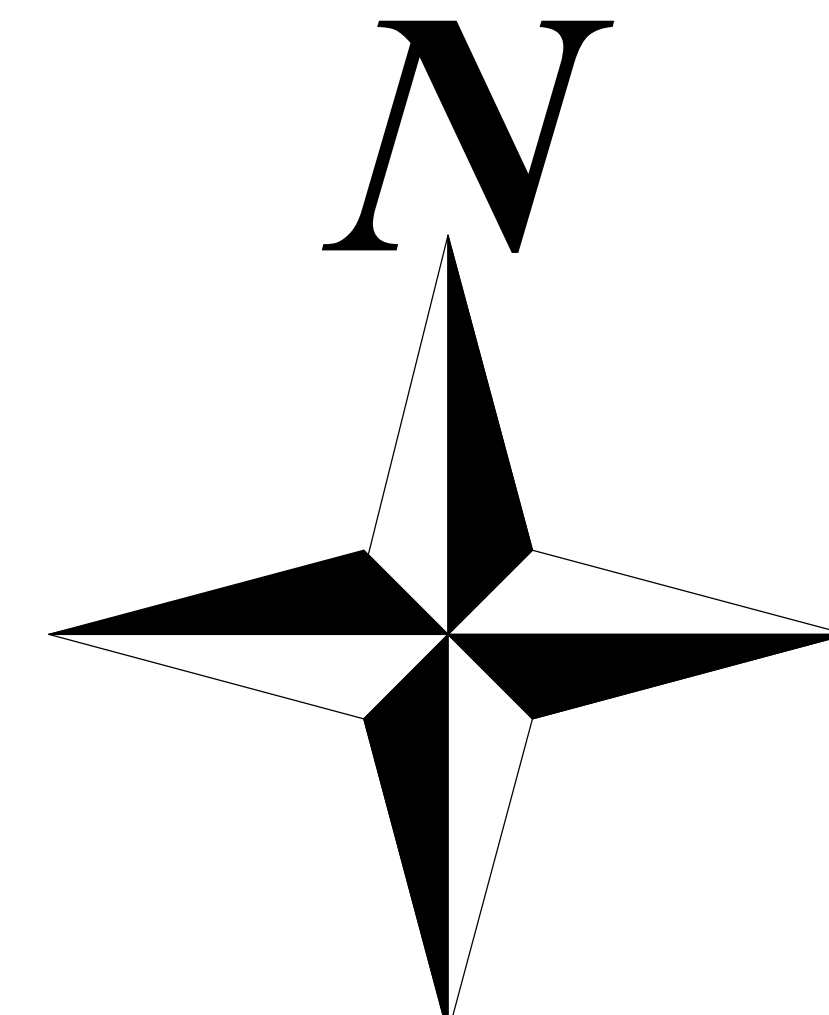


CONTRACT NOTE: THE CONTRACT AND SPECIFICATIONS TAKE PRECEDENCE OVER THESE DRAWINGS. ANY CONFLICTS WILL DEFAULT TO SAID DOCUMENTS.


FOUNDATION PLAN

PLANS NOT RELEASED FOR CONSTRUCTION

 
COPYRIGHT 2017: DESIGNS FOR LIVING, LLC - Under section 102 of the Architectural Works Copyright Protection Act (title 17 of the United States Code) specific tacit copyright laws apply to original design of a building created in any tangible medium of expression, including a constructed building or architectural plans, models, or drawings and is subject to copyright protection as an "architectural work" by Designs for Living, LLC. herein referred to as Designer. It is unlawful for anyone to copy these drawings, either in whole or in part, without the express written permission of the Designer. The use of any plans, specifications, electronic or hard copy prints shall be restricted to the original site for which they were prepared and publication thereof is expressly limited to such use. Title to all works, specifically all drawings, specifications, and modified derivatives of any blueprints, e-files, drawings, or specifications remain the Designer's without prejudice. VISUAL CONTACT with any of these drawings, or their purchase constitutes prima facie evidence of the acceptance of these restrictions! This has held precedent in the North Florida Court system! Any and all violations WILL result in legal action being taken and litigated damages to the full extent allowed by law! No exceptions and no excuses! Contractor &/or owner shall verify all dimensions, details, & specifications prior to construction. Every attempt has been made to avoid mistakes. The contractor and the owners also fully acknowledge that they have full copyright release approval and Designs for Livings LLC nor R.E. Chip Mitchell shall not be liable for error for copyright infringement or other errors after delivery via email of drawings including after construction has begun! This copyright law is only valid on building designs created on or after December 1, 1990.

PLAN # A-508	
CLIENT APPROVAL SIGNATURE DOUGLAS L. REIGERT-JOHNSON	DATE 7/30/2017
Design Drawings provided by: 	
PROJECT DESCRIPTION: RENOVATIONS FOR THE REIGERT-JOHNSON FAMILY 508 E SURE SPRAY LANE PONTE VEDRA BEACH, FL 32082 P/A/E # 0623456-757-1	
BUILT BY:  5569-1 BOWDEN ROAD CBC026189 JACKSONVILLE, FL 32216 904-737-5412	
DATE: 7/30/2017	
SCALE: 1/2" = 1'-0"	
SHEET: A-3	

CONTRACT NOTE: THE CONTRACT AND SPECIFICATIONS TAKE PRECEDENCE OVER THESE DRAWINGS. ANY CONFLICTS WILL DEFAULT TO SAID DOCUMENTS.

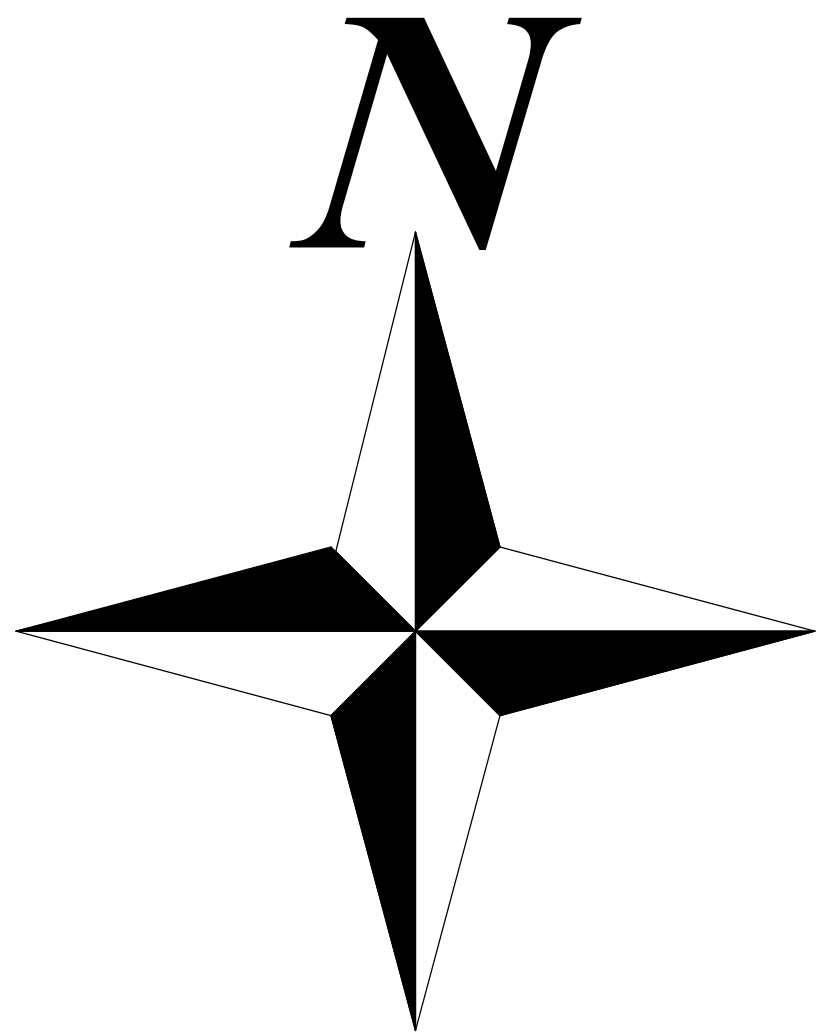

AS-BUILT FOOTAGES (A.N.S.I.):	
GARAGE:	447.92
SCREEN ENCLOSURE:	214.63
SCREENED PORCH:	210.00
ENTRY:	15.17
1ST FLOOR HEATED:	1,158.44
2ND FLOOR HEATED:	1,311.32
TOTAL HEATED:	2,469.76
SLAB AREA:	1,831.53
UNDER ROOF:	3,142.85

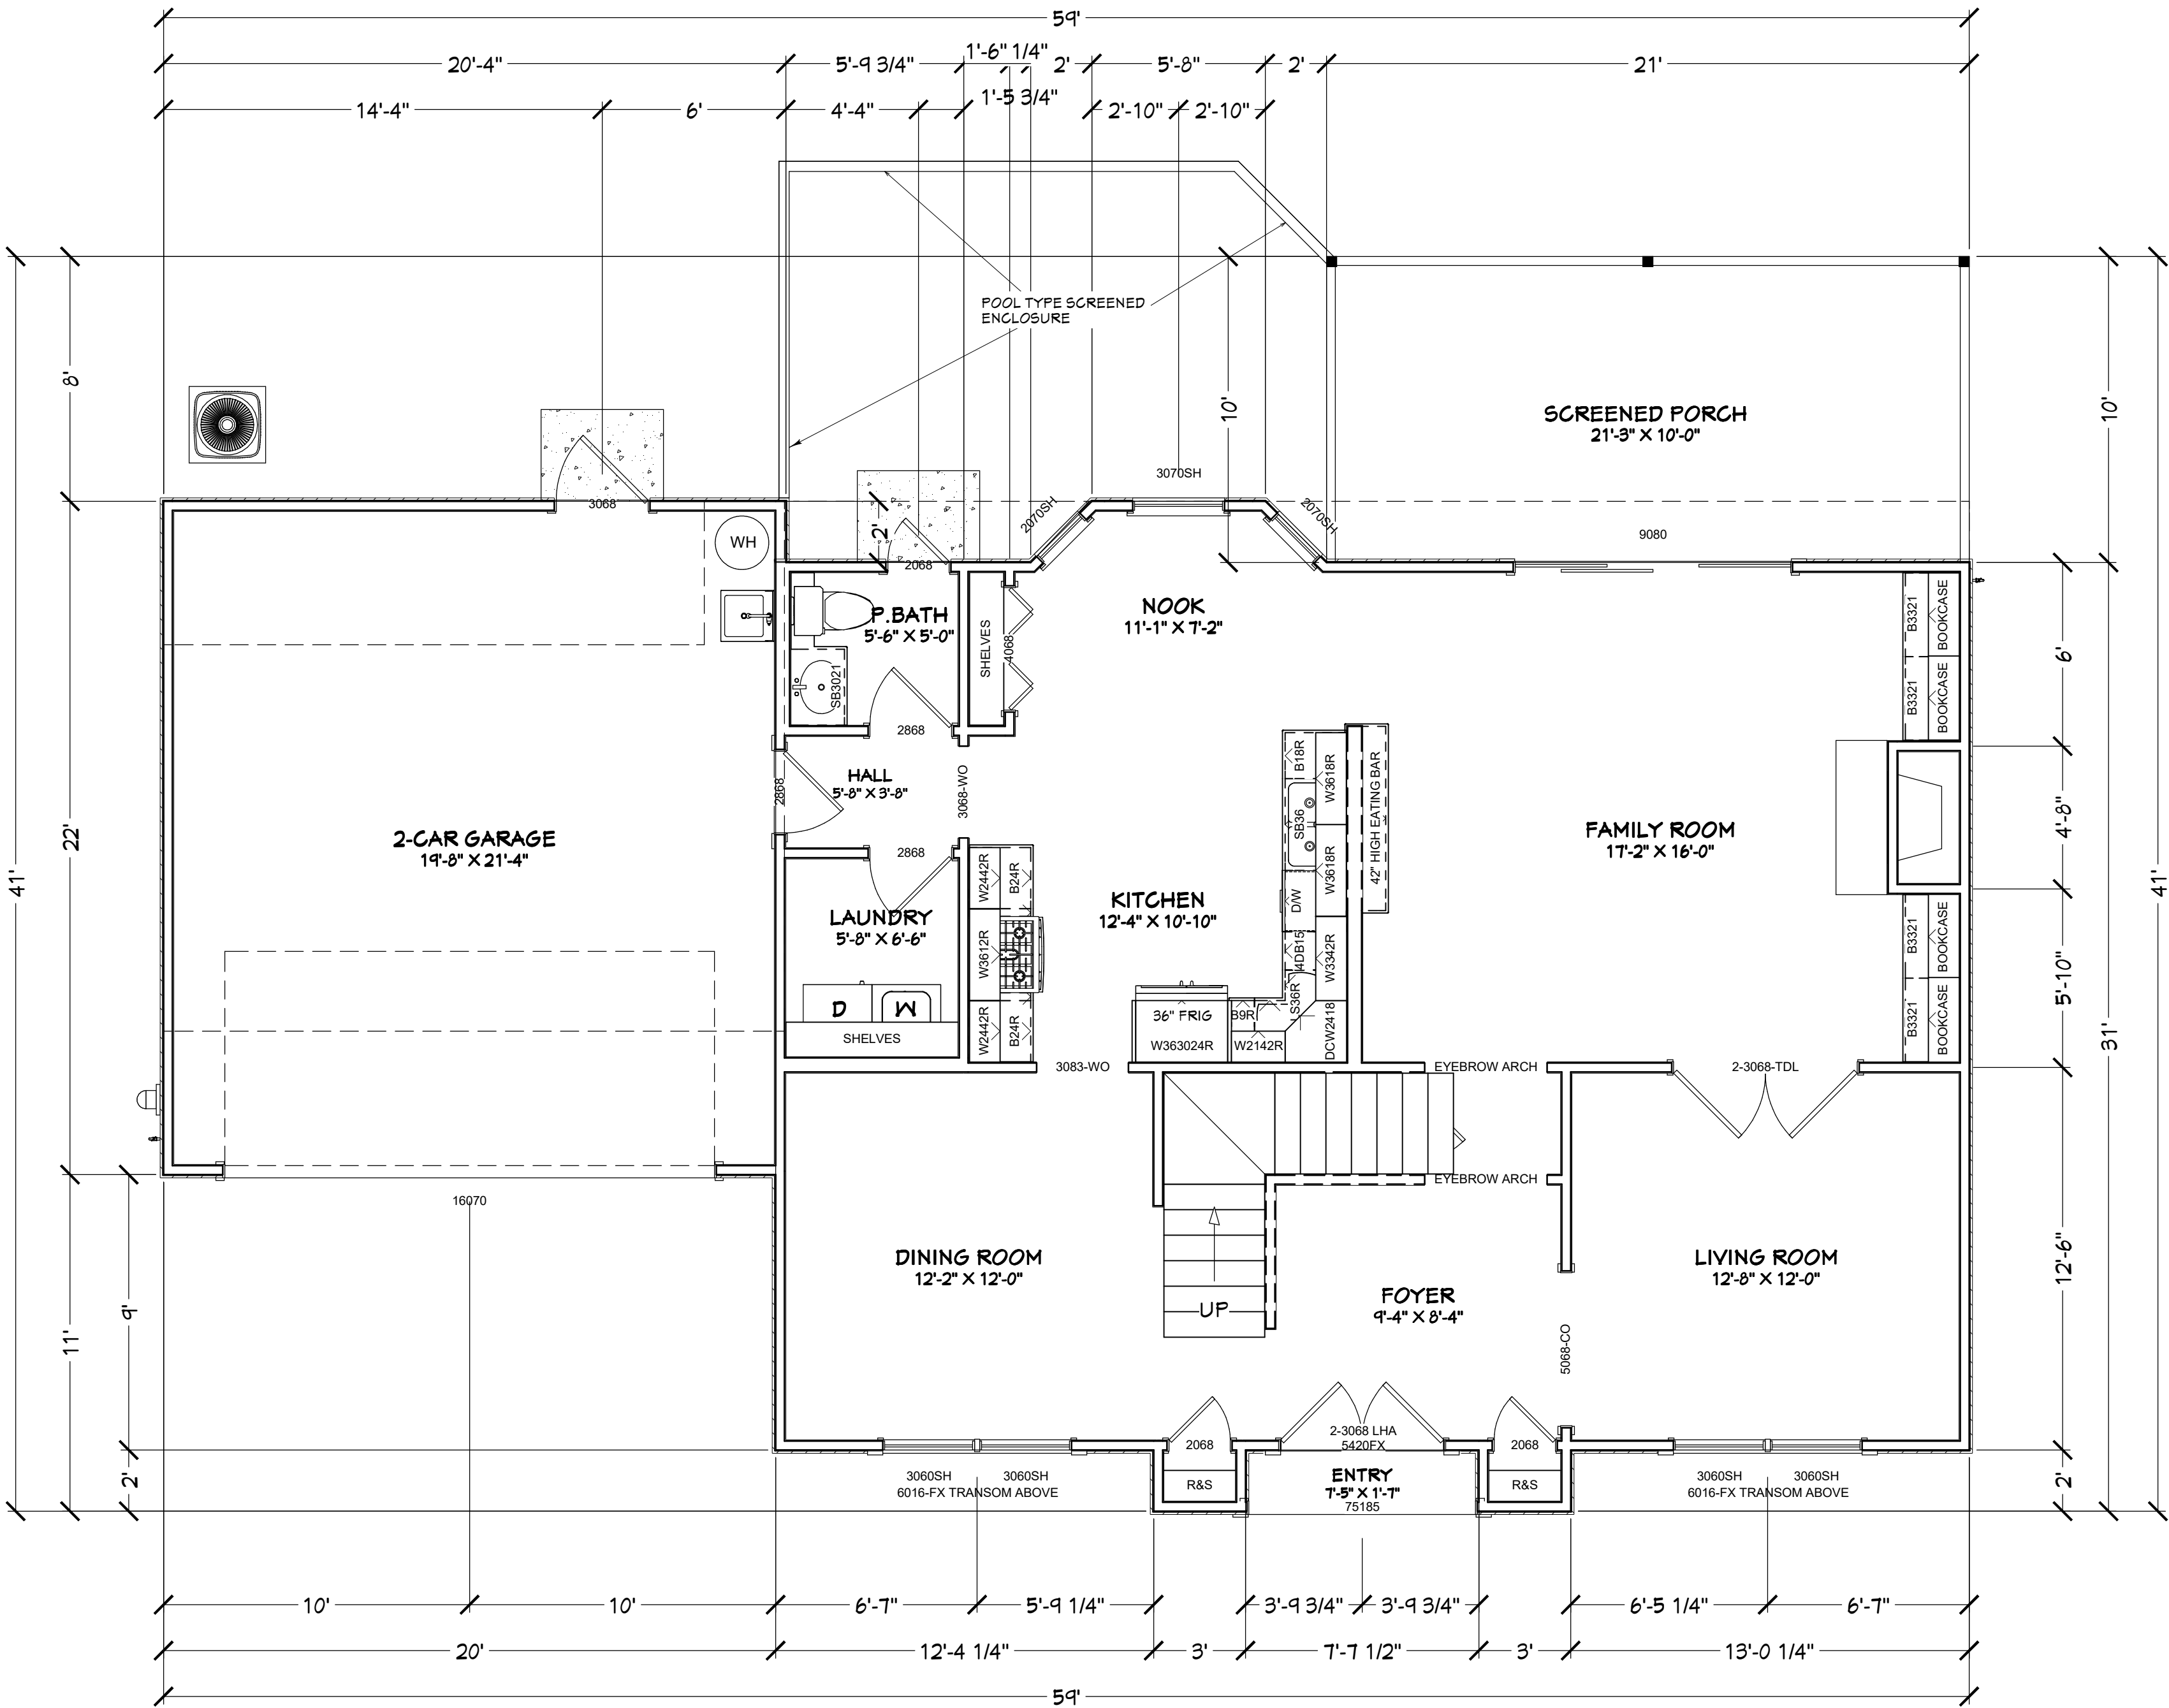

AS-BUILT 1ST FLOOR PLAN

PLANS NOT RELEASED FOR CONSTRUCTION

COPYRIGHT 2017: DESIGNS FOR LIVING, LLC. -Under section 102 of the Architectural Works Copyright Protection Act (title 17 of the United States Code) specific tact copyright laws apply to original created in any tangible medium of expression, including a constructed building or architectural plans, models, or drawings and is subject to copyright protection as an "architectural work" by Designs for Living, LLC. herein referred to as Designer. It is unlawful for anyone to copy these drawings, either in whole or in part, without the express written permission of the Designer. The use of any plans, specifications, electronic or hard copy prints shall be restricted to the original site for which they were prepared and publication thereof is expressly limited to such use. Title to all works, specifically all drawings, specifications, and modified derivatives of any blueprints, e-files, drawings, or specifications remain the Designers without prejudice. VISUAL CONTACT with any of these drawings, or their purchase constitutes prima facie evidence of the acceptance of these restrictions! This has held precedent in the North Florida Court system! Any and all violations WILL result in legal action being taken and litigated damages to the full extent allowed by law! No exceptions and no excuses! Contractor &/or owner shall verify all dimensions, details, & specifications prior to construction. Every attempt shall be made to avoid mistakes. The Designer and/or owner are not responsible for any errors or omissions in the drawings. The Designer and/or owner shall not be liable for copyright infringement or other errors after delivery via email or drawings including after construction has begun. This copyright law is only valid on building designs created on or after December 1, 1990.

PROJECT DESCRIPTION:
RENOVATIONS FOR THE
REIGERT-JOHNSON FAMILY
508 E SURF SPRAY LANE
POMT E VEDRA BEACH, FL 32082
R/E #: 062156-2521

BUILT BY:
TOM TROUT
GENERAL CONTRACTOR
5569-1 BOWDEN ROAD CBCO26189
JACKSONVILLE, FL 32216 904-737-5412

DATE:
7/30/2017
SCALE:
1/4" = 1'-0"
SHEET:
A-4

CLIENT APPROVAL SIGNATURE DATE
DOUGLAS L. REIGERT-JOHNSON
VANESSA Z. REIGERT-JOHNSON


Design Drawings
provided by:
DESIGNS FOR LIVING, LLC
RESIDENTIAL DESIGN WANTS 1989
904-730-7135

PLAN #
A-508

A black and white illustration of a compass rose. The rose has four main points (cardinal directions) and four smaller points (ordinal directions). The cardinal points are represented by larger, solid black triangles, while the ordinal points are represented by smaller, hollow triangles. A large, bold, black letter 'N' is positioned above the top point of the compass rose, indicating North.


AS-BUILT FOOTAGES (A.N.S.I.):	
GARAGE:	447.92
SCREEN ENCLOSURE:	214.63
SCREENED PORCH:	210.00
ENTRY:	15.17
1ST FLOOR HEATED:	1,158.44
2ND FLOOR HEATED:	1,311.32
TOTAL HEATED:	2,469.76
SLAB AREA:	1,831.53
UNDER ROOF:	3,142.85

AS-BUILT 2ND FLOOR PLAN

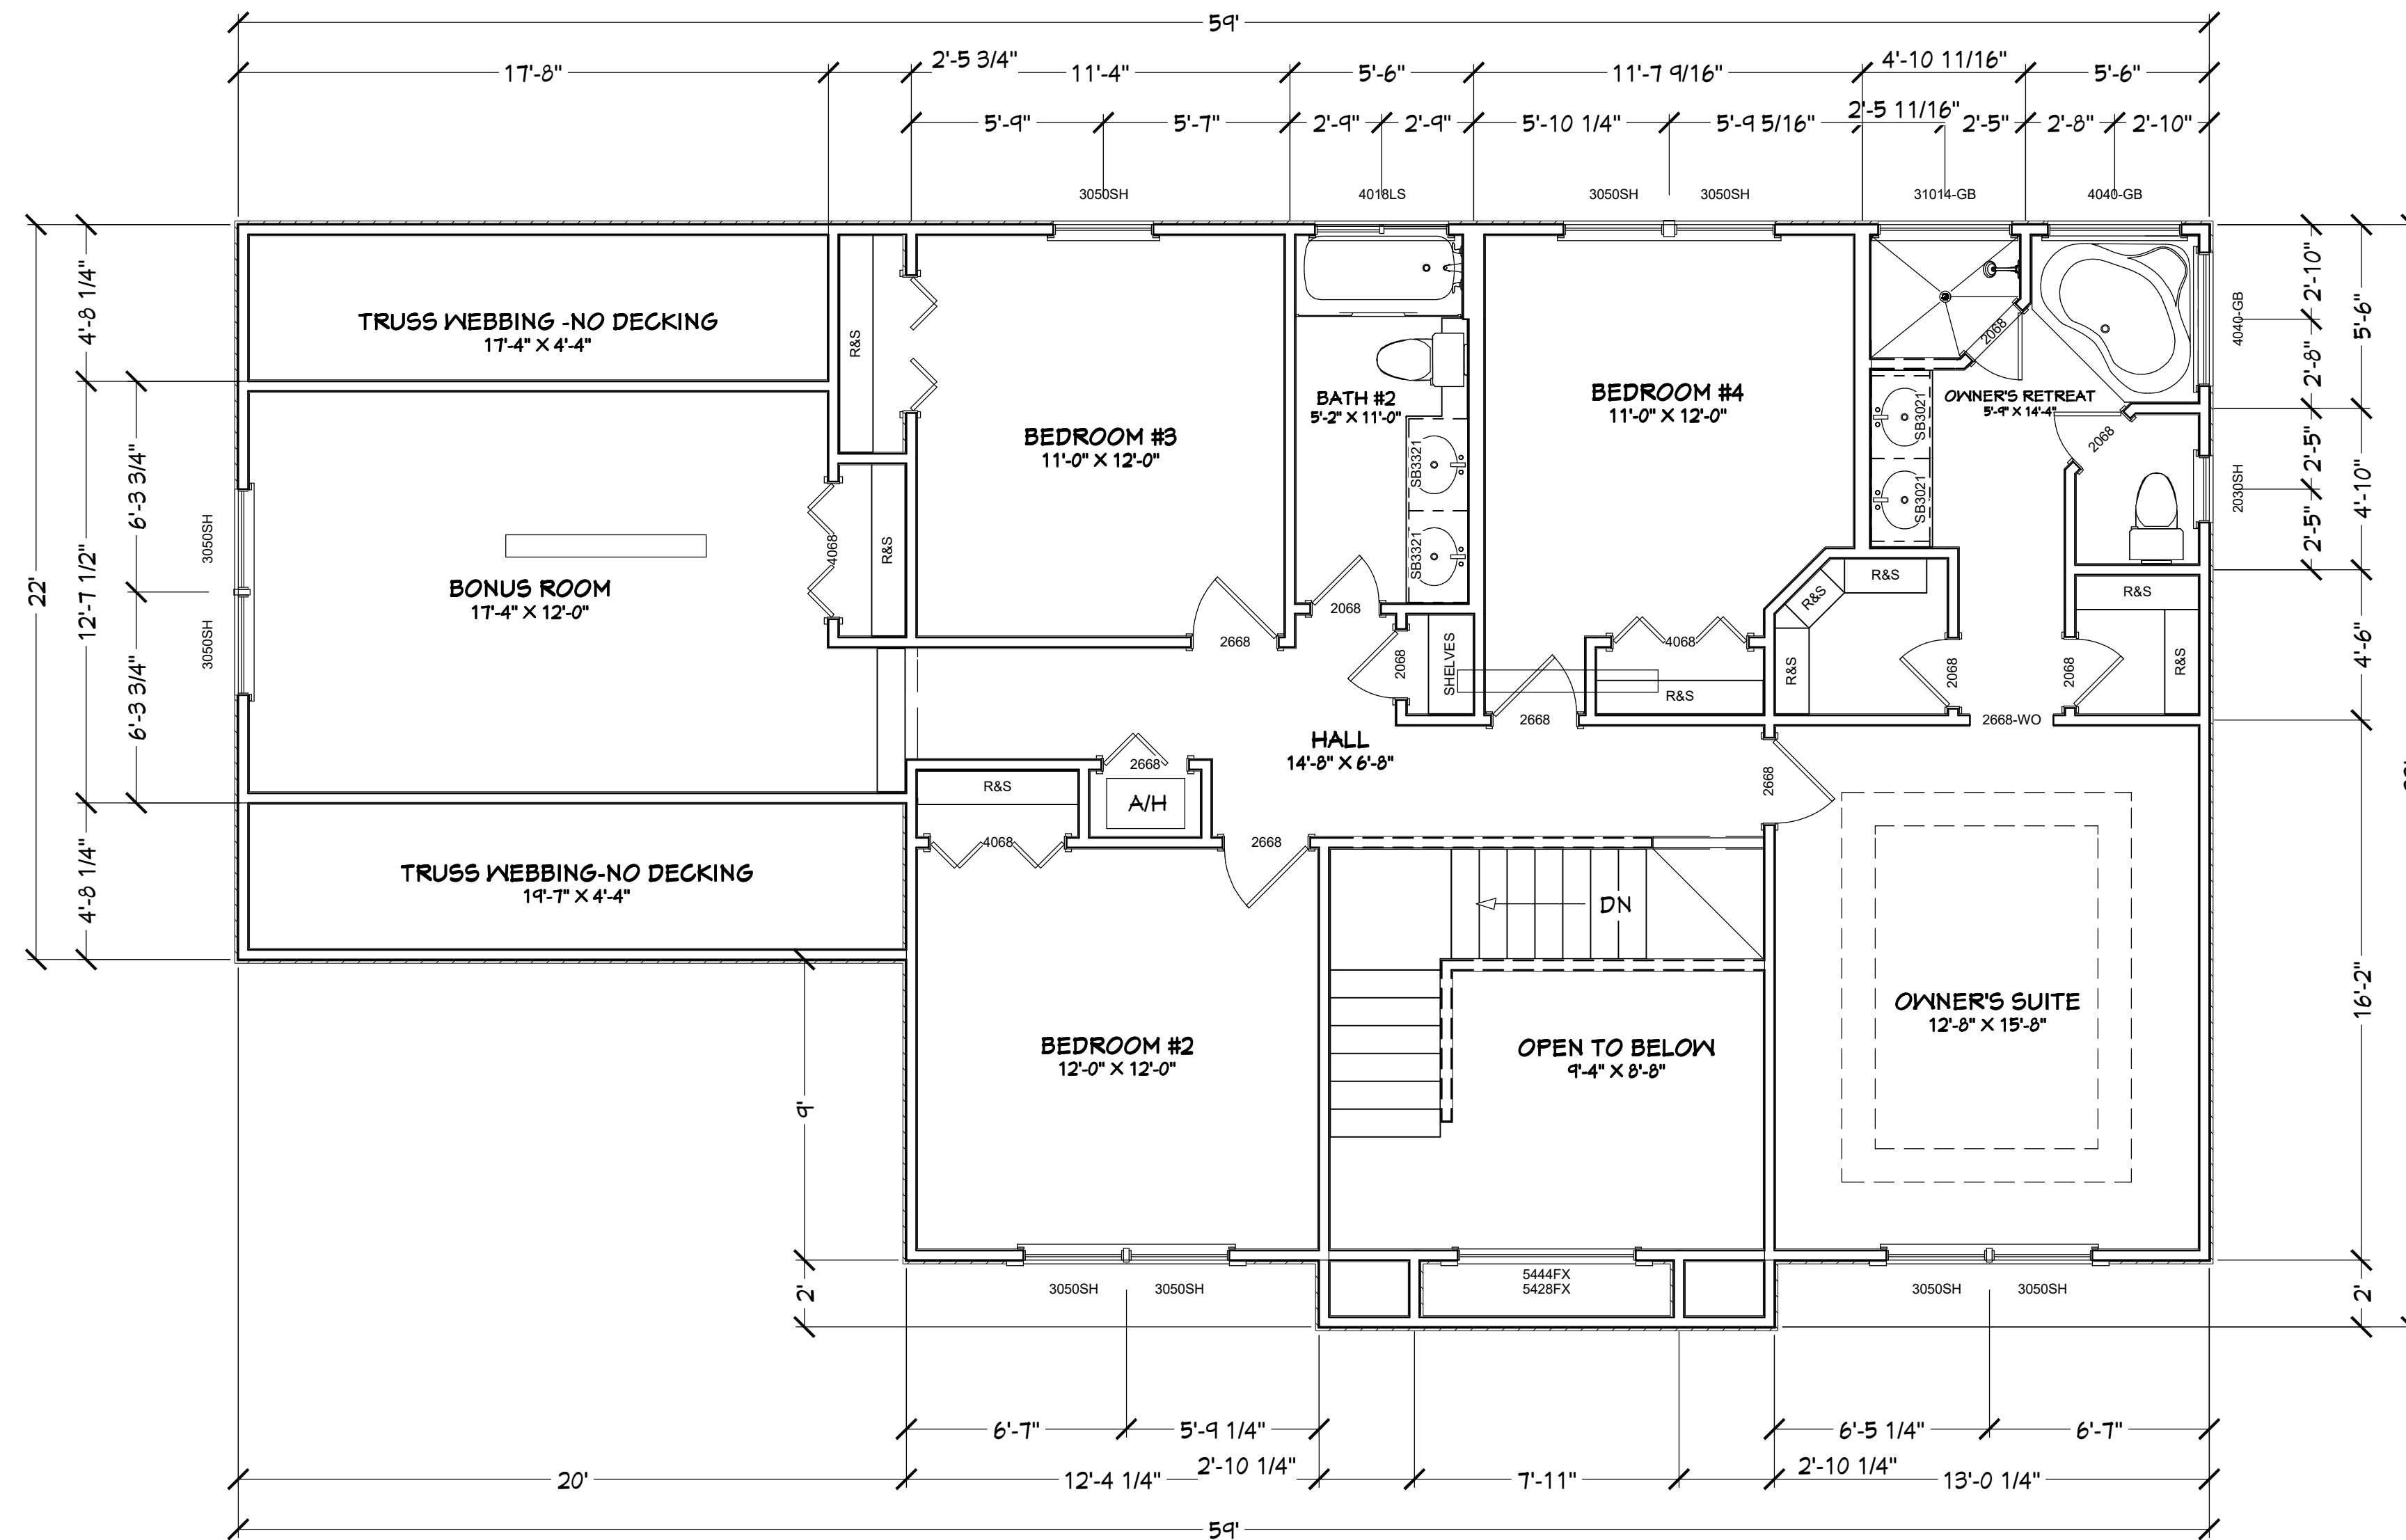

PLANS NOT RELEASED FOR CONSTRUCTION

 COPYRIGHT 2017: DESIGNS FOR LIVING, LLC - Under section 102 of the Architectural Works Copyright Protection Act (title 17 of the United States Code) specific tacit copyright laws apply to original design of a building created in any tangible medium of expression, including a constructed building or architectural plans, models, or drawings and is subject to copyright protection as an "architectural work" by Designs for Living, LLC. herein referred to as Designer. It is unlawful for anyone to copy these drawings, either in whole or in part, without the express written permission of the Designer. The use of any plans, specifications, electronic or hard copy prints shall be restricted to the original site for which they were prepared and publication thereof is expressly limited to such use. Title to all works, specifically all drawings, specifications, and modified derivatives of any blueprints, e-files, drawings, or specifications remain the Designer's without prejudice. VISUAL CONTACT with any of these drawings, or their purchase constitutes prima facie evidence of the acceptance of these restrictions! This has held precedent in the North Florida Court system! Any and all violations WILL result in legal action being taken and litigated damages to the full extent allowed by law! No exceptions and no excuses! Contractor &/or owner shall verify all dimensions, details, & specifications prior to construction. Every attempt has been made to avoid mistakes. The contractor and the owners also fully acknowledge that they have full copyright release approval and Designs for Livings LLC nor R.E. Chip Mitchell shall not be liable for error for copyright infringement or other errors after delivery via email of drawings including after construction has begun! This copyright law is only valid on building designs created on or after December 1, 1990.

 BUILT BY: 5569-1 BOWDEN ROAD CB0026189 JACKSONVILLE, FL 32216 904-737-5412	
DATE: 7/30/2017 SCALE: 1/4" = 1'-0"	
SHEET: A-5 PROJECT DESCRIPTION: RENOVATIONS FOR THE REIGERT-JOHNSON FAMILY 508 ZULF SPRAY LANE PONTA VEDRA BEACH, FL 32082 P.O. # 062156-253	
 Design Drawings provided by: DESIGNS for LIVING RESIDENTIAL DESIGN SINCE 1969 OWN: 730-7135	CLIENT APPROVAL SIGNATURE DOUGLAS L. REIGERT-JOHNSON DOUGLAS L. REIGERT-JOHNSON DOUGLAS L. REIGERT-JOHNSON DATE
PLAN # A-508	


PROJECT DESCRIPTION:
RENOVATIONS FOR THE
REIGERT-JOHNSON FAMILY
508 E SURF SPRAY LANE
PONTE VEDRA BEACH, FL 32082
D/E #.: 062156, 2531

BUILT BY:



TOM TROUT inc.
GENERAL CONTRACTOR

5569-1 BOWDEN ROAD CBC026189
JACKSONVILLE, FL 32216 904-737-5412

DATE:
7/30/2017
SCALE:
1/4" = 1'-0"
SHEET:
A-5

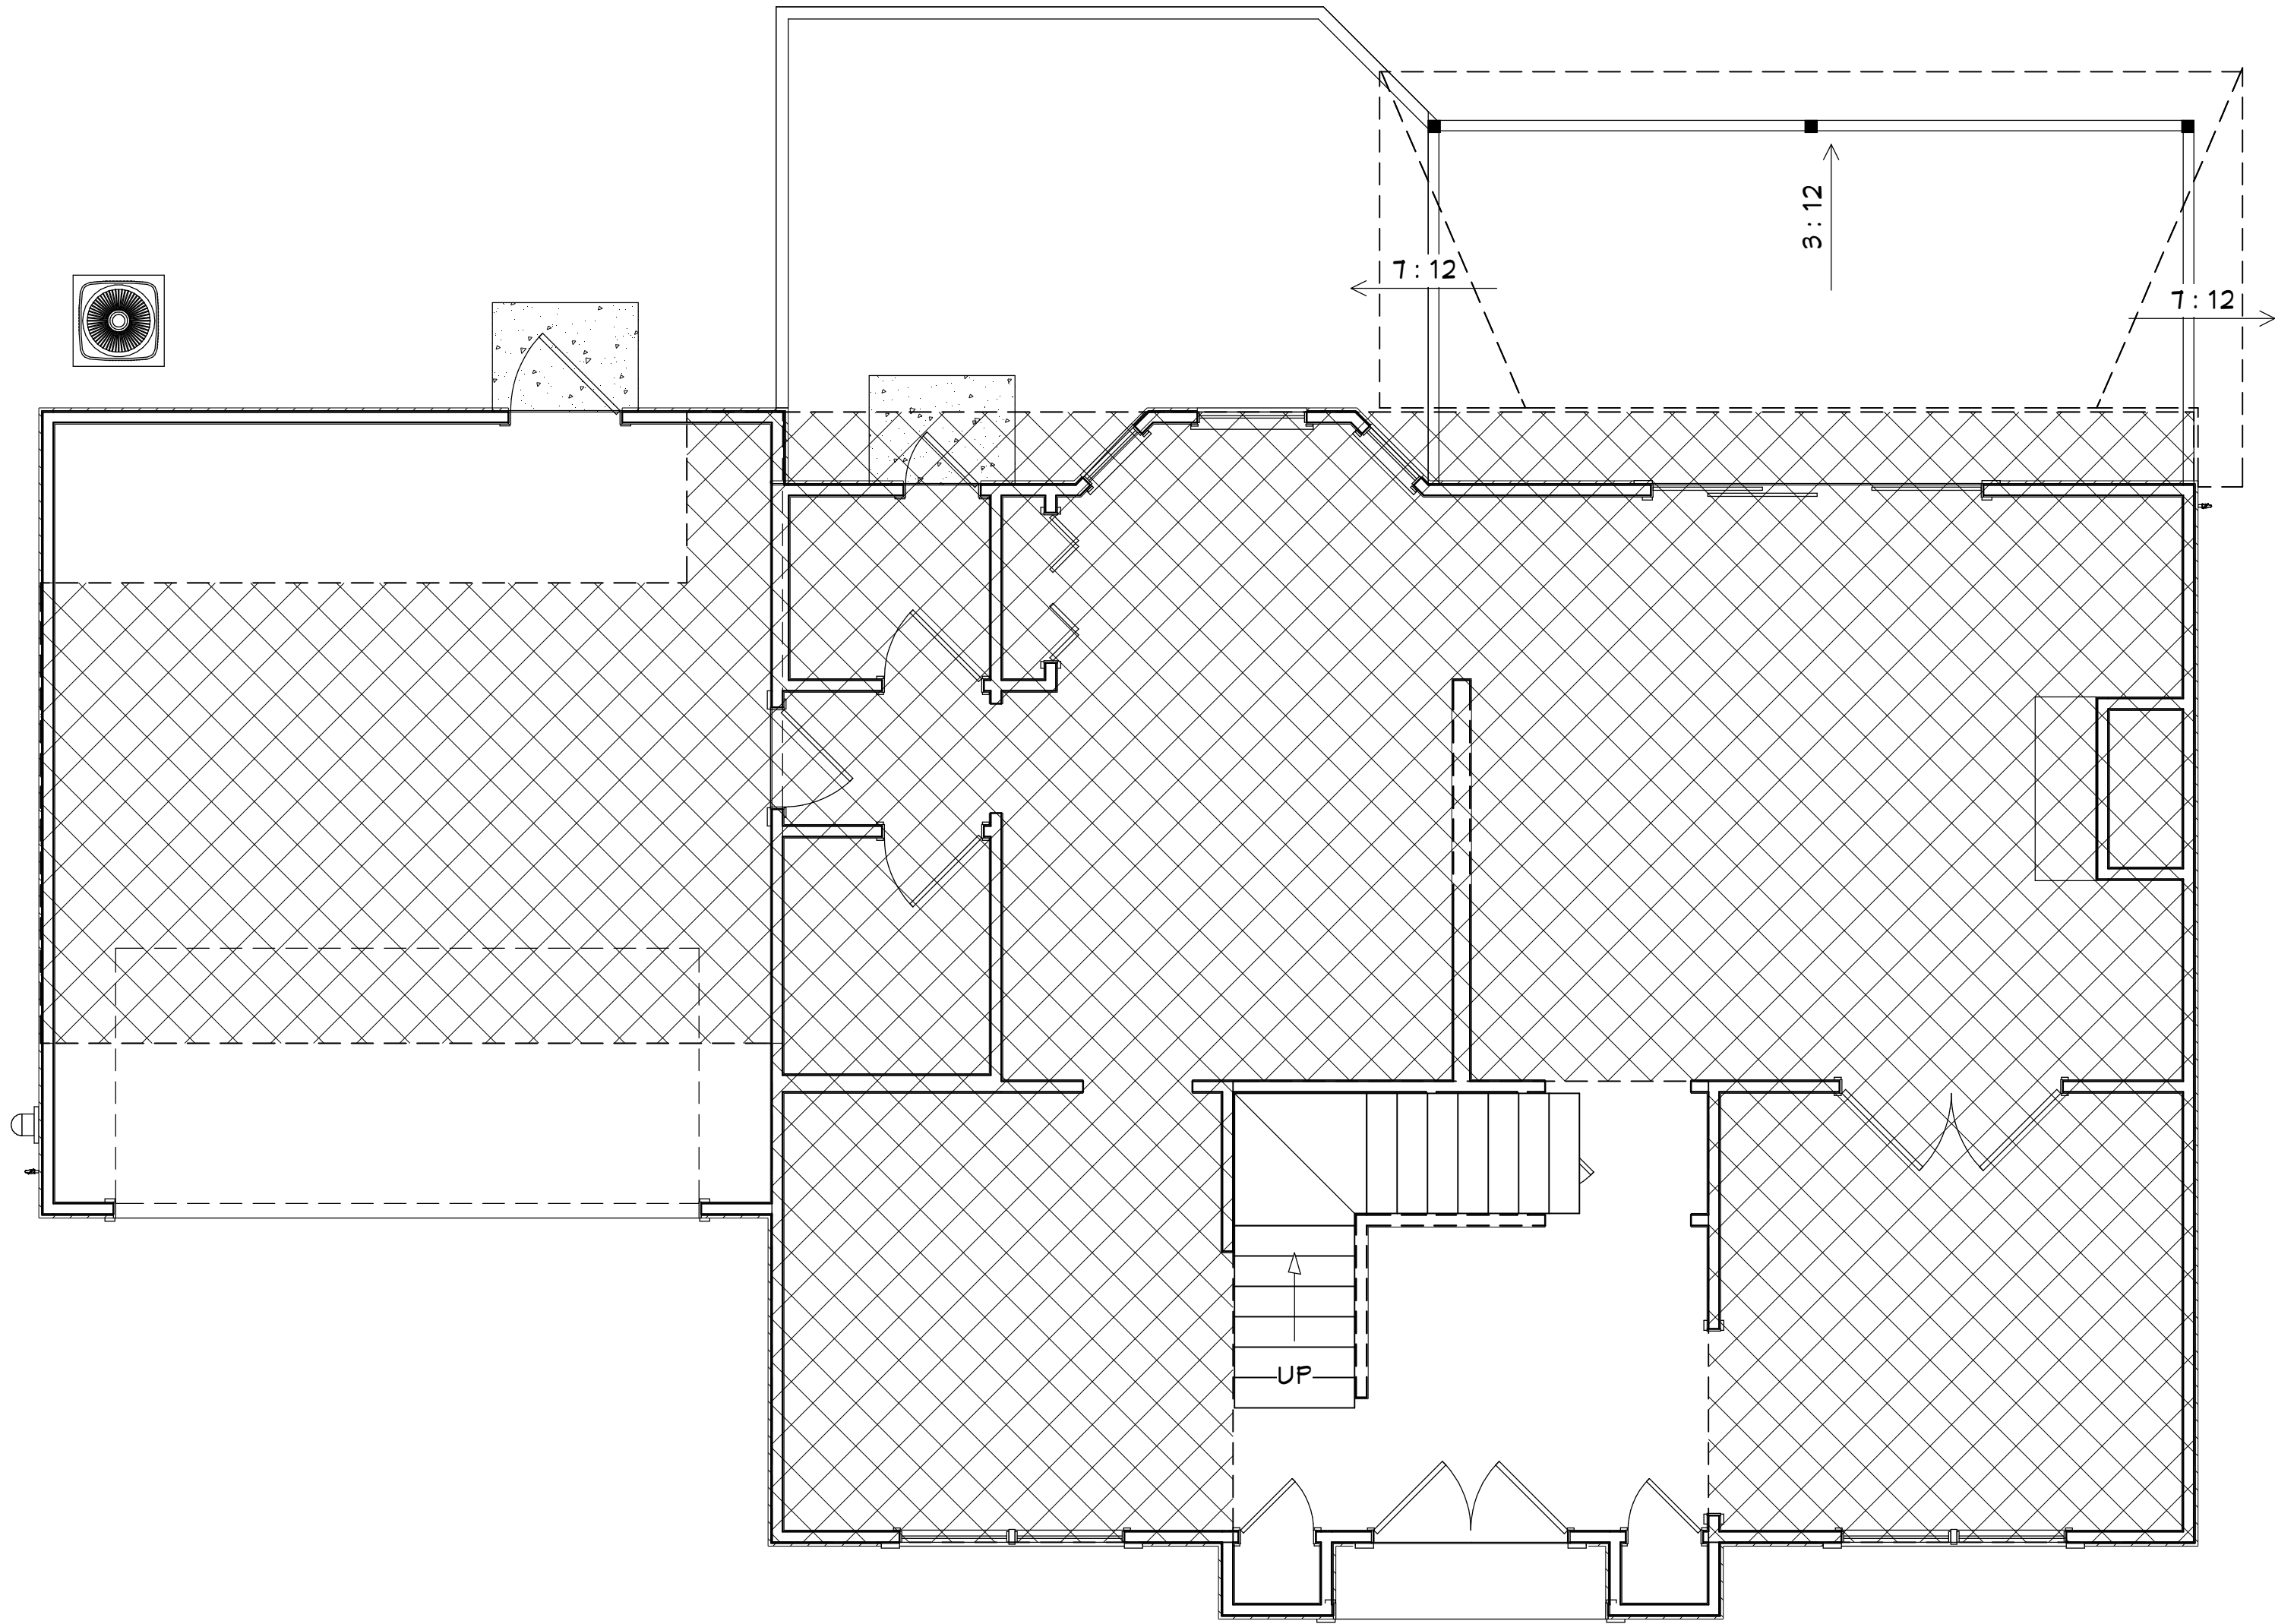

CONTRACT NOTE: THE CONTRACT AND SPECIFICATIONS TAKE PRECEDENCE OVER THESE DRAWINGS. ANY CONFLICTS WILL DEFAULT TO SAID DOCUMENTS.

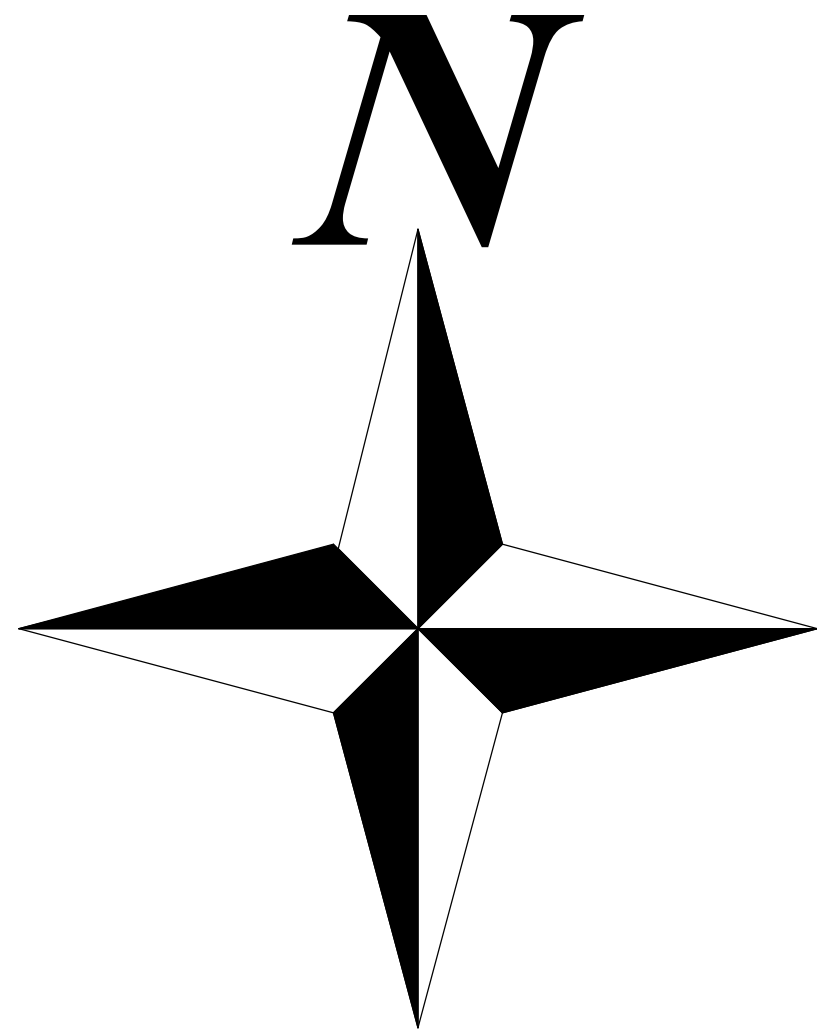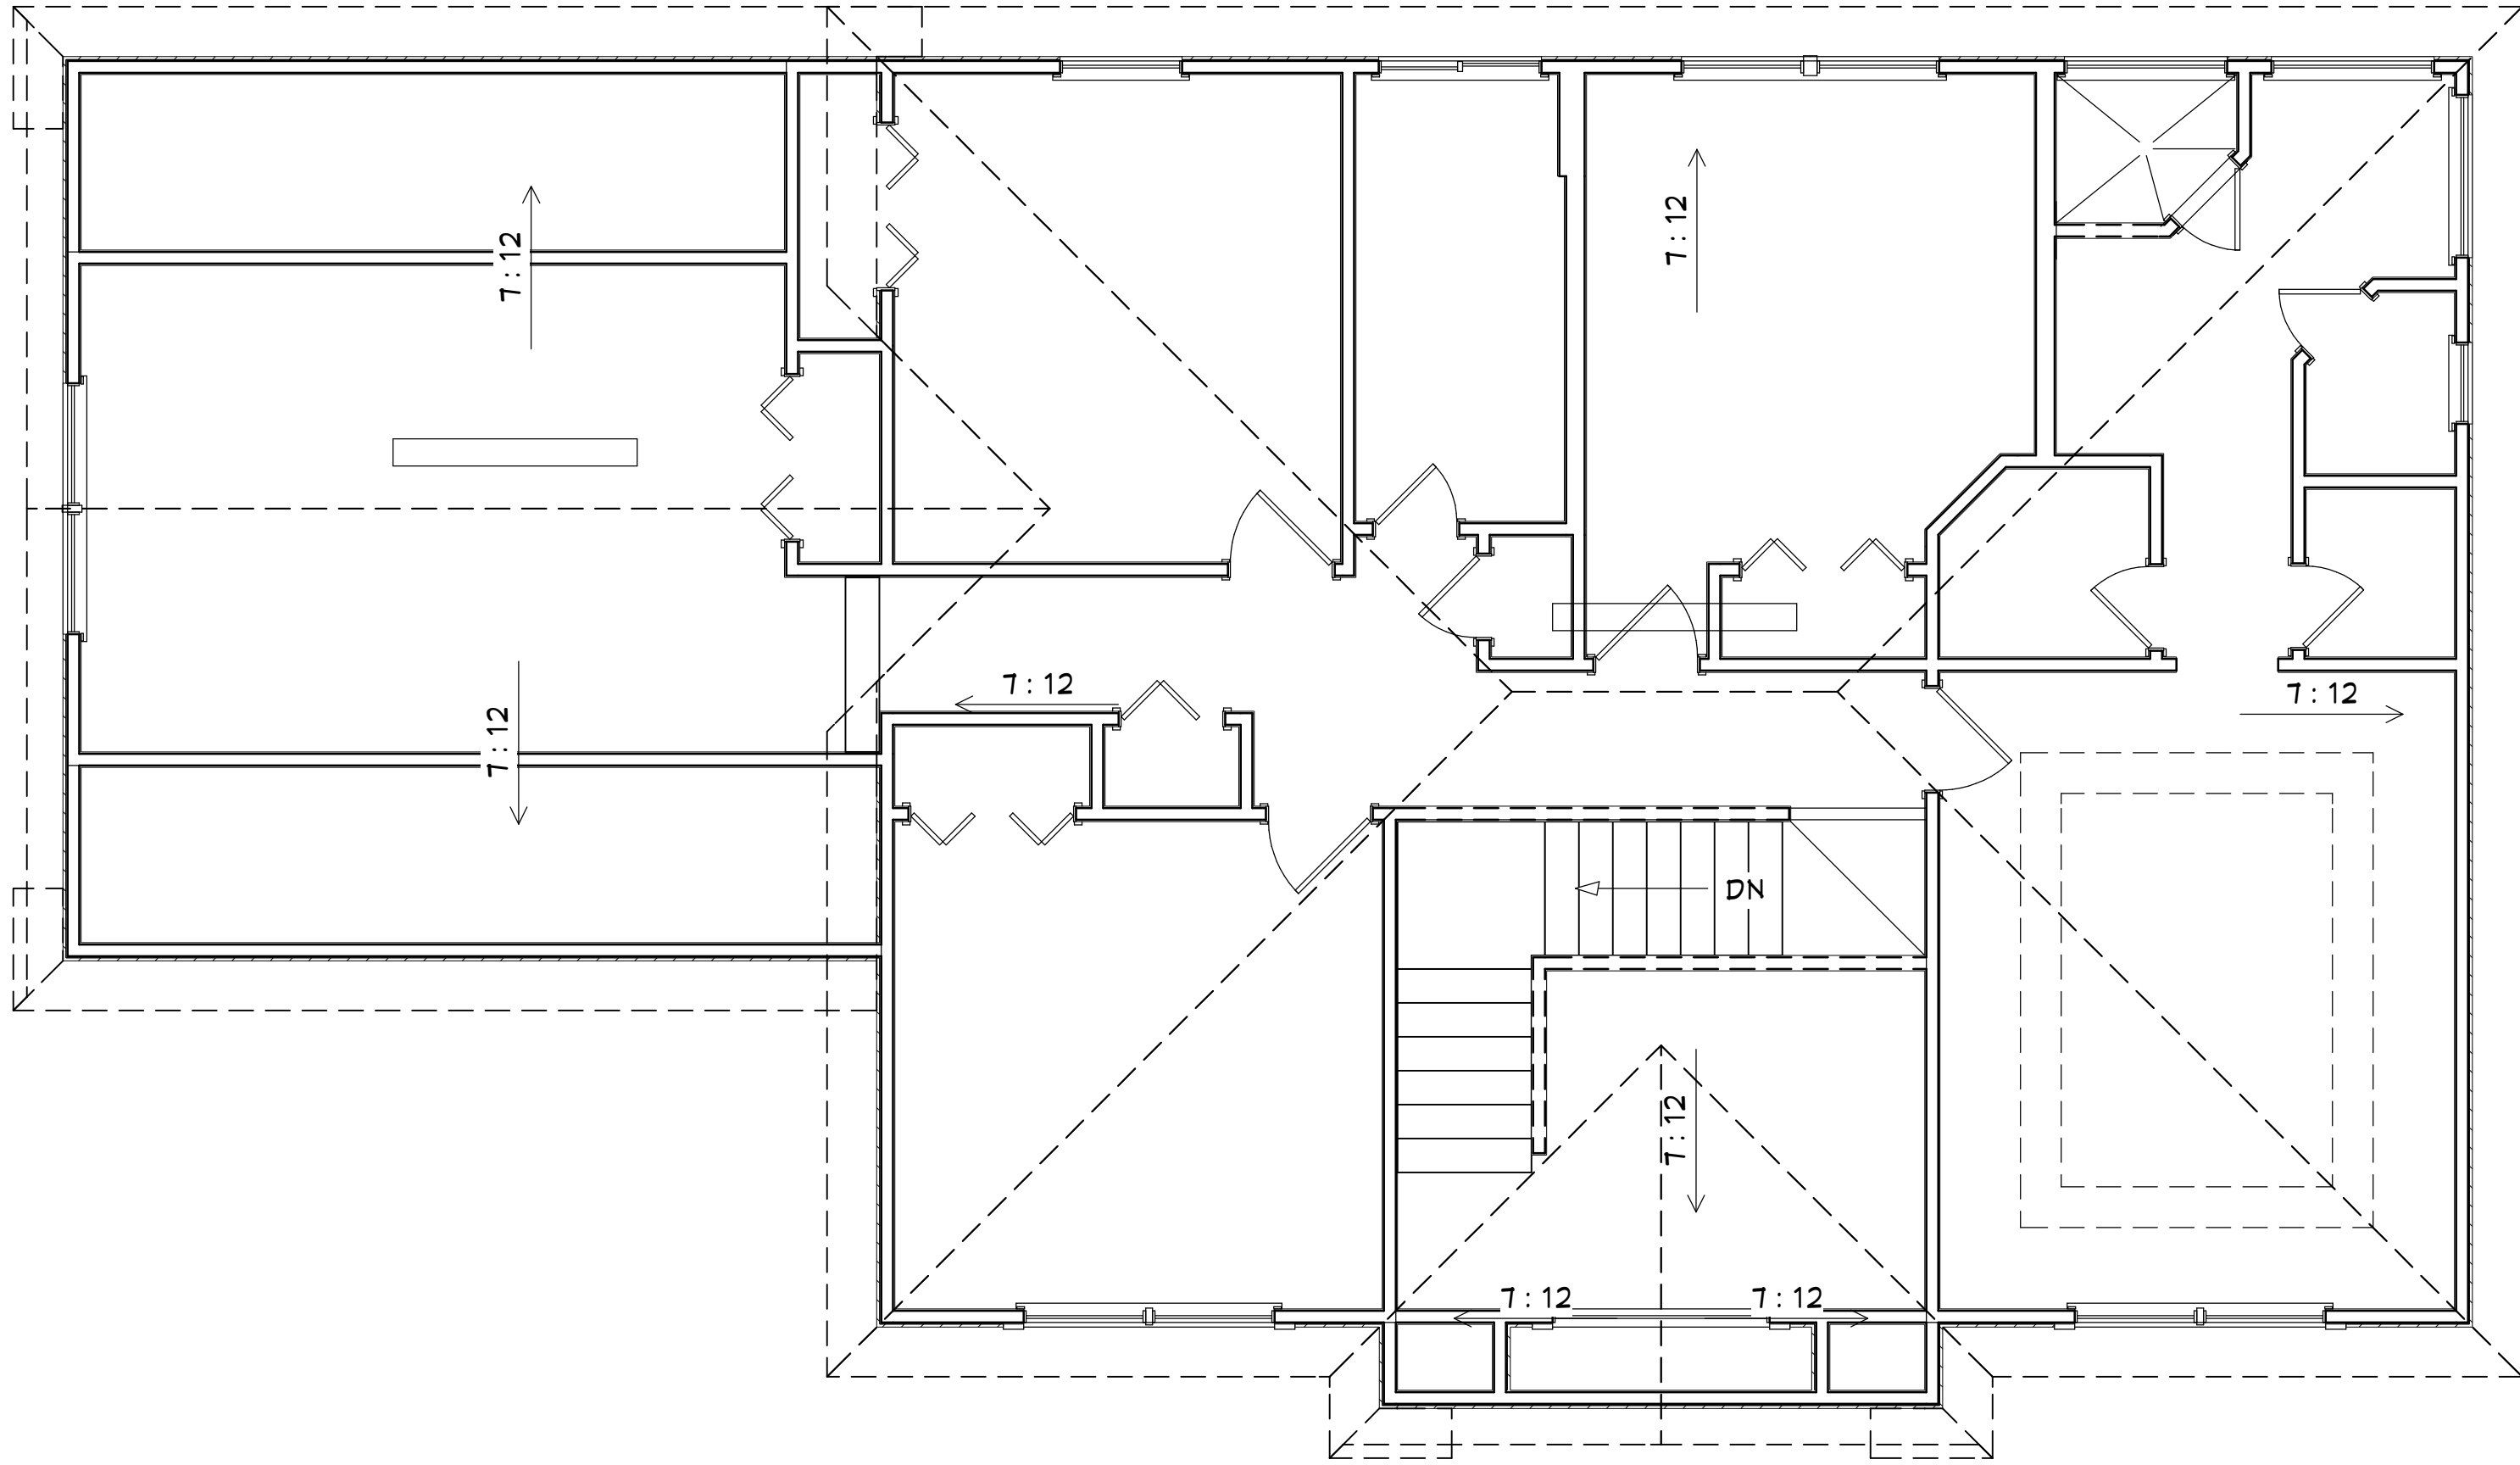

AS-BUILT ROOF PLANS

PLANS NOT RELEASED FOR CONSTRUCTION

COPYRIGHT 2017: DESIGNS FOR LIVING, LLC. -Under section 102 of the Architectural Works Copyright Protection Act (title 17 of the United States Code) specific tact copyright laws apply to original design of a building created in any tangible medium of expression, including a constructed building or architectural plans, models, or drawings and is subject to copyright protection as an "architectural work" by Designs for Living, LLC. herein referred to as Designer. It is unlawful for anyone to copy these drawings, either in whole or in part, without the express written permission of the Designer. The use of any plans, specifications, electronic or hard copy prints shall be restricted to the original site for which they were prepared and publication thereof is expressly limited to such use. Title to all works, specifically all drawings, specifications, and modified derivatives of any blueprints, e-files, drawings, or specifications remain the Designers without prejudice. VISUAL CONTACT with any of these drawings, or their purchase constitutes prima facie evidence of the acceptance of these restrictions! This has held precedent in the North Florida Court system! Any and all violations WILL result in legal action being taken and litigated damages to the full extent allowed by law! No exceptions and no excuses! Contractor &/or owner shall verify all dimensions, details, & specifications prior to construction. Every attempt shall be made to avoid errors and omissions. Copyright release approval and design for construction is hereby granted to the Contractor &/or owner for the project described herein. This copyright law is only valid on building designs created on or after December 1, 1990.

BUILT BY:



TOM TROUT

GENERAL CONTRACTOR

INC.

5569-1 BOWDEN ROAD CB026189
JACKSONVILLE, FL 32216 904-737-5412

DATE:

7/30/2017

SCALE:

1/4" = 1'-0"

SHEET:

A-6

PROJECT DESCRIPTION:

RENOVATIONS FOR THE
REIGERT-JOHNSON FAMILY
508 E SURF SPRAY LANE
PONTE VEDRA BEACH, FL 32082
R/E #: 062156-2521

Design Drawings
provided by:



DESIGNS FOR LIVING

LLC


RESIDENTIAL DESIGN SINCE 1989

904-730-7135


CLIENT APPROVAL SIGNATURE	DATE
DOUGLAS L. REIGERT-JOHNSON	
VANESSA Z. REIGERT-JOHNSON	

PLAN #

A-508

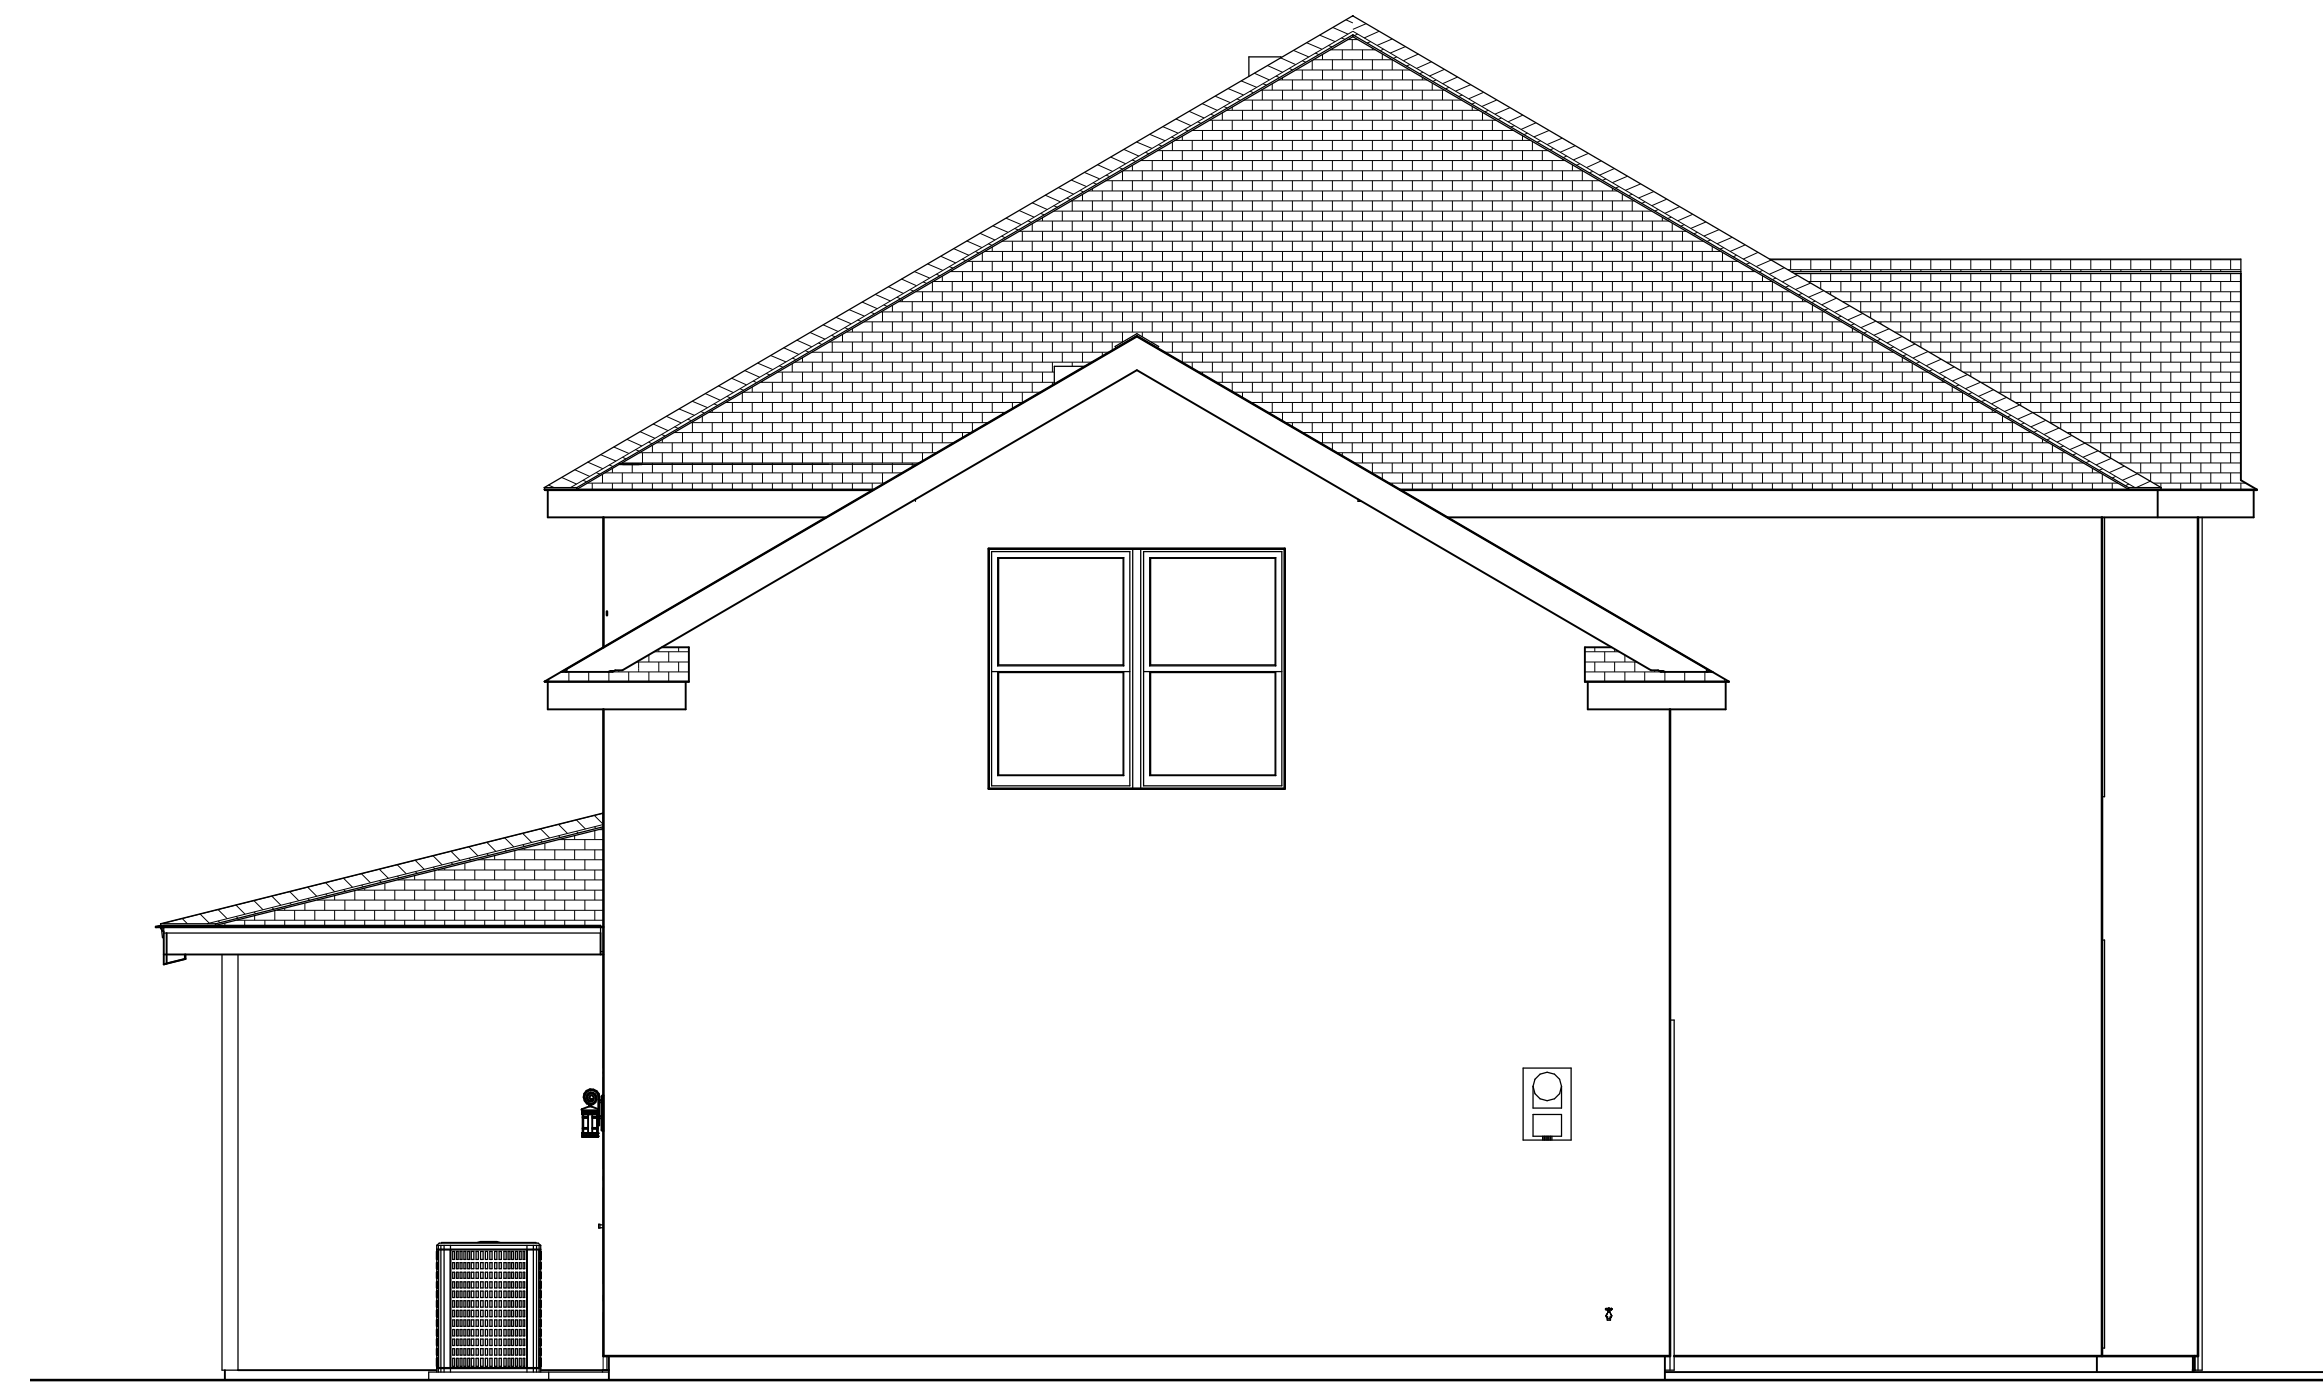

CONTRACT NOTE: THE CONTRACT AND SPECIFICATIONS TAKE PRECEDENCE OVER THESE DRAWINGS. ANY CONFLICTS WILL DEFAULT TO SAID DOCUMENTS.

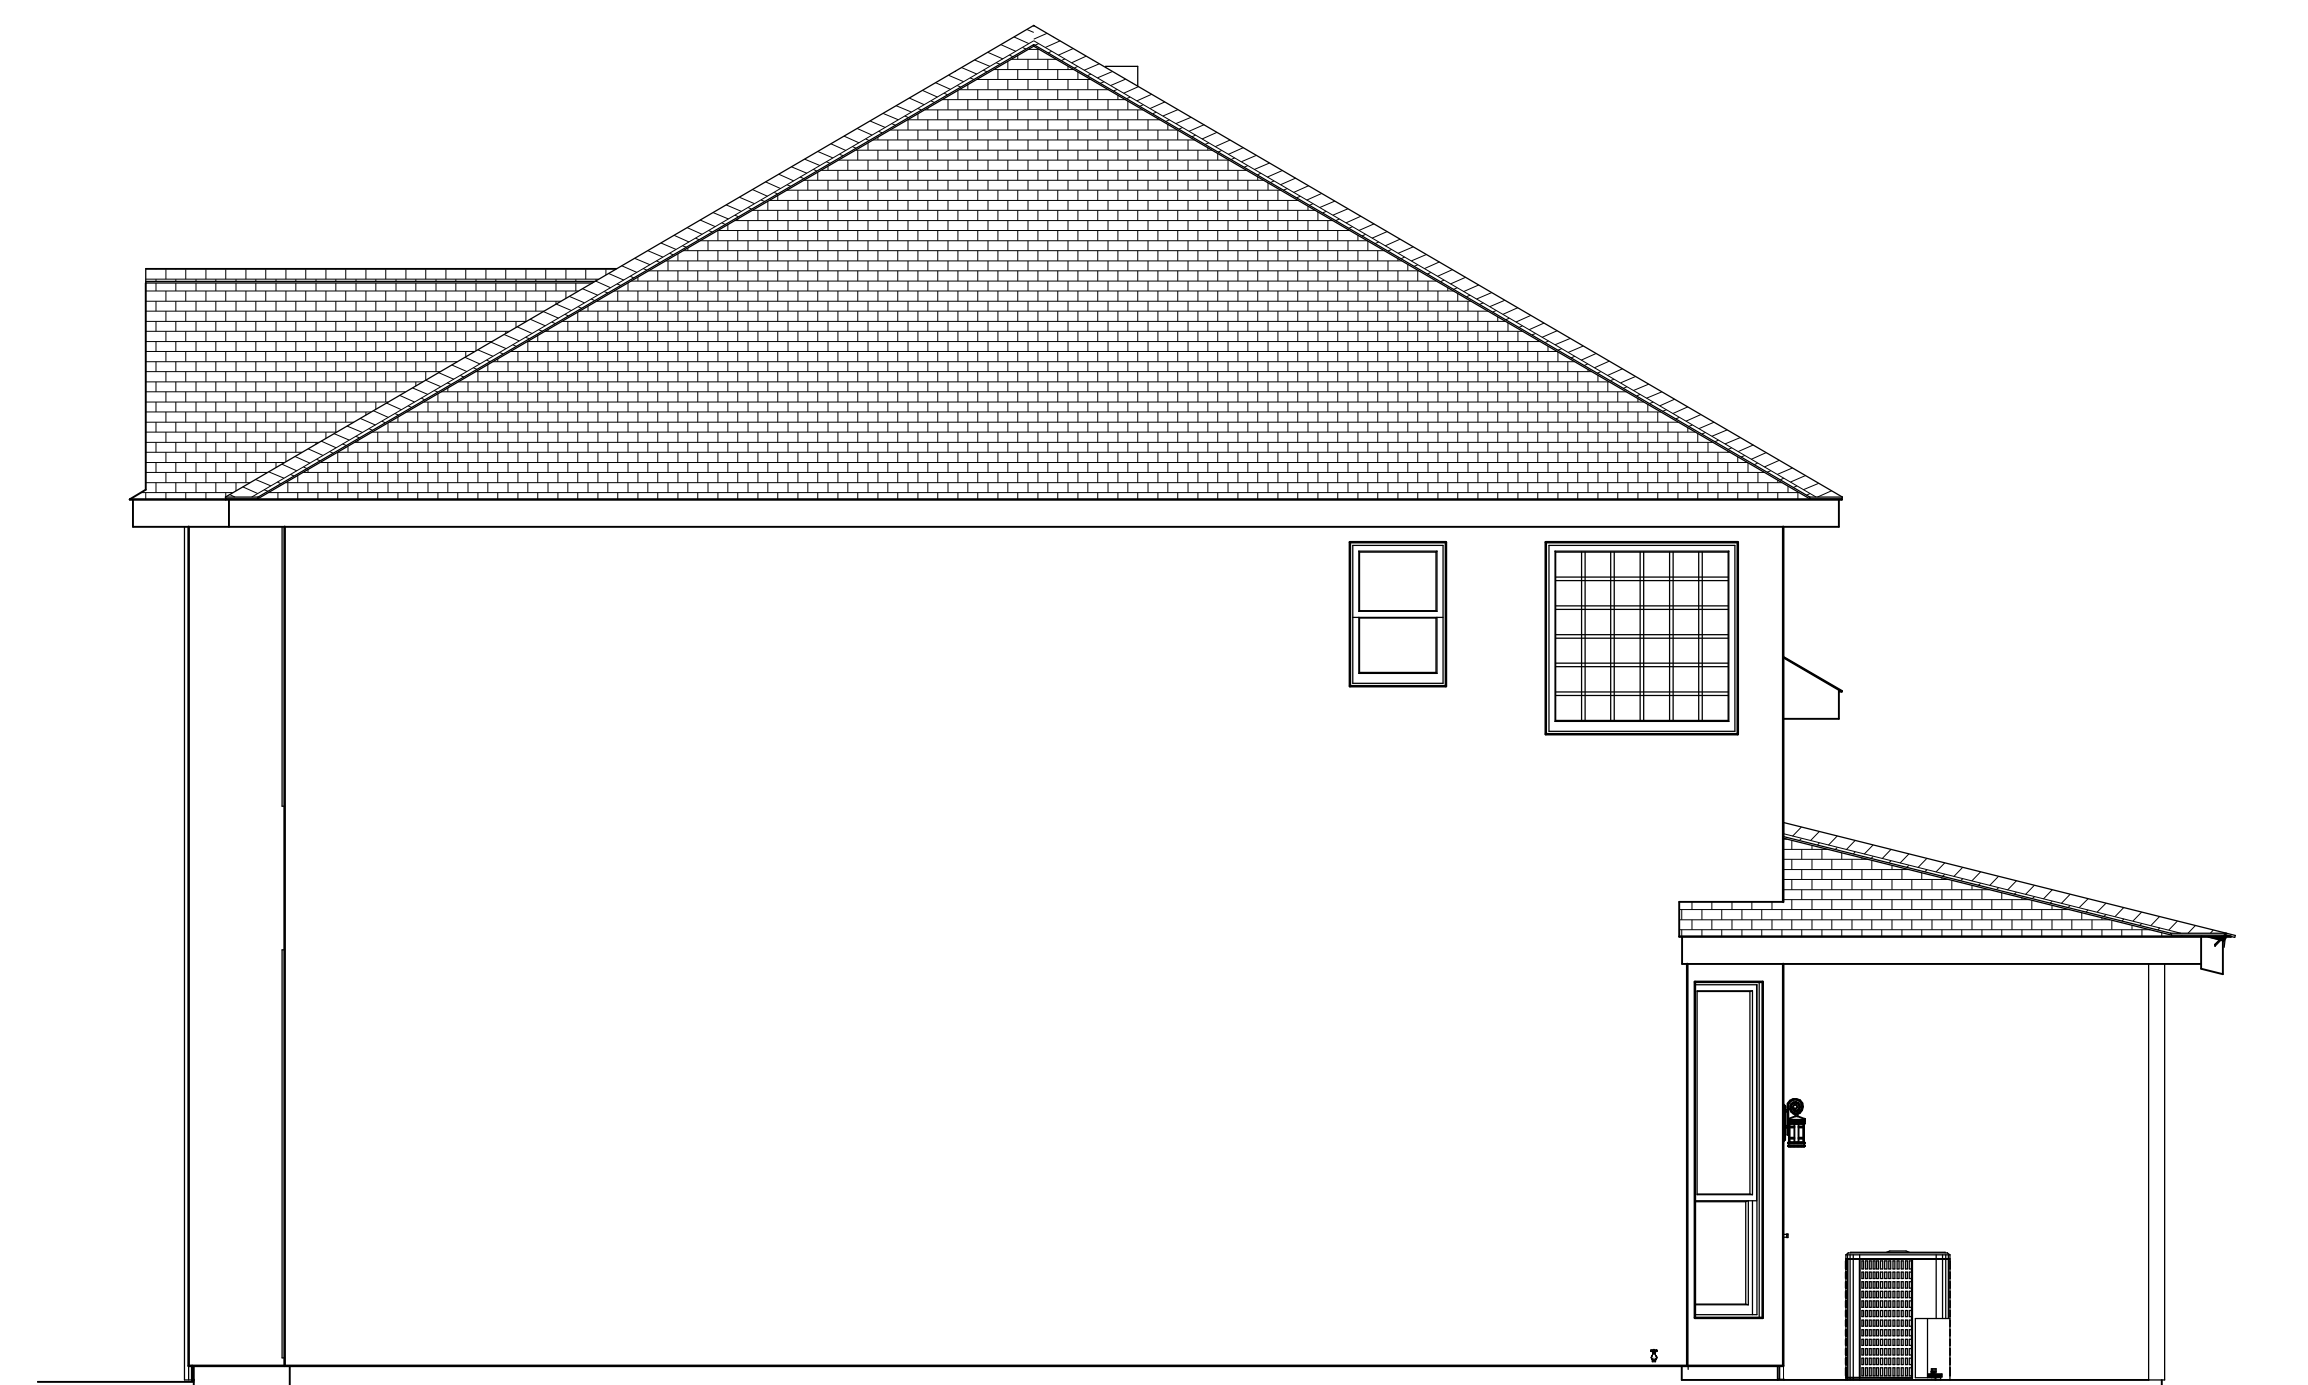

AS-BUILT ELEVATIONS

PLANS NOT RELEASED FOR CONSTRUCTION

COPYRIGHT 2017: DESIGNS FOR LIVING, LLC -Under section 102 of the Architectural Works Copyright Protection Act (title 17 of the United States Code) specific tacit copyright laws apply to original design of a building created in any tangible medium of expression, including a constructed building or architectural plans, models, or drawings and is subject to copyright protection as an "architectural work" by Designs for Living, LLC herein referred to as Designer. It is unlawful for anyone to copy these drawings, either in whole or in part, without the express written permission of the Designer. The use of any plans, specifications, electronic or hard copy prints shall be restricted to the original site for which they were prepared and publication thereof is expressly limited to such use. Title to all works, specifically all drawings, specifications, and modified derivatives of any blueprints, e-files, drawings, or specifications remain the Designer's without prejudice. VISUAL CONTACT with any of these drawings, or their purchase constitutes prima facie evidence of the acceptance of these restrictions! This has held precedent in the North Florida Court system. All and all violations WILL result in legal action being taken and litigated damages to the full extent allowed by law! No exceptions and no excuses! Contractor &/or owner shall verify all dimensions, details, & specifications prior to construction. Every attempt has been made to avoid mistakes. The contractor and the owners also fully acknowledge that they have full copyright release approval and Designs for Livings LLC nor R.E. Chip Mitchell shall not be liable for error for copyright infringement or other errors after delivery via email of drawings including after construction has begun. This copyright law is only valid on building designs created on or after December 1, 1990.

PLAN # A-508	
CLIENT APPROVAL SIGNATURE	DATE
DOUGLAS L. REIGERT-JOHNSON	
VANESSA Z. REIGERT-JOHNSON	

Design Drawings provided by:



DESIGNS for LIVING
LLC
RESIDENTIAL DESIGN SINCE 1989

904-730-7135
904-730-7135

PROJECT DESCRIPTION:

**RENOVATIONS FOR THE
REIGERT-JOHNSON FAMILY**


508 E SURF SPRAY LANE
PONTE VEDRA BEACH, FL 32082
R/E #: 062156-2521

BUILT BY:



5569-1 BOWDEN ROAD CBC026189
JACKSONVILLE, FL 32216 904-737-5412

DATE:	7/30/2017
SCALE:	1/4" = 1'-0"
SHEET:	A-7

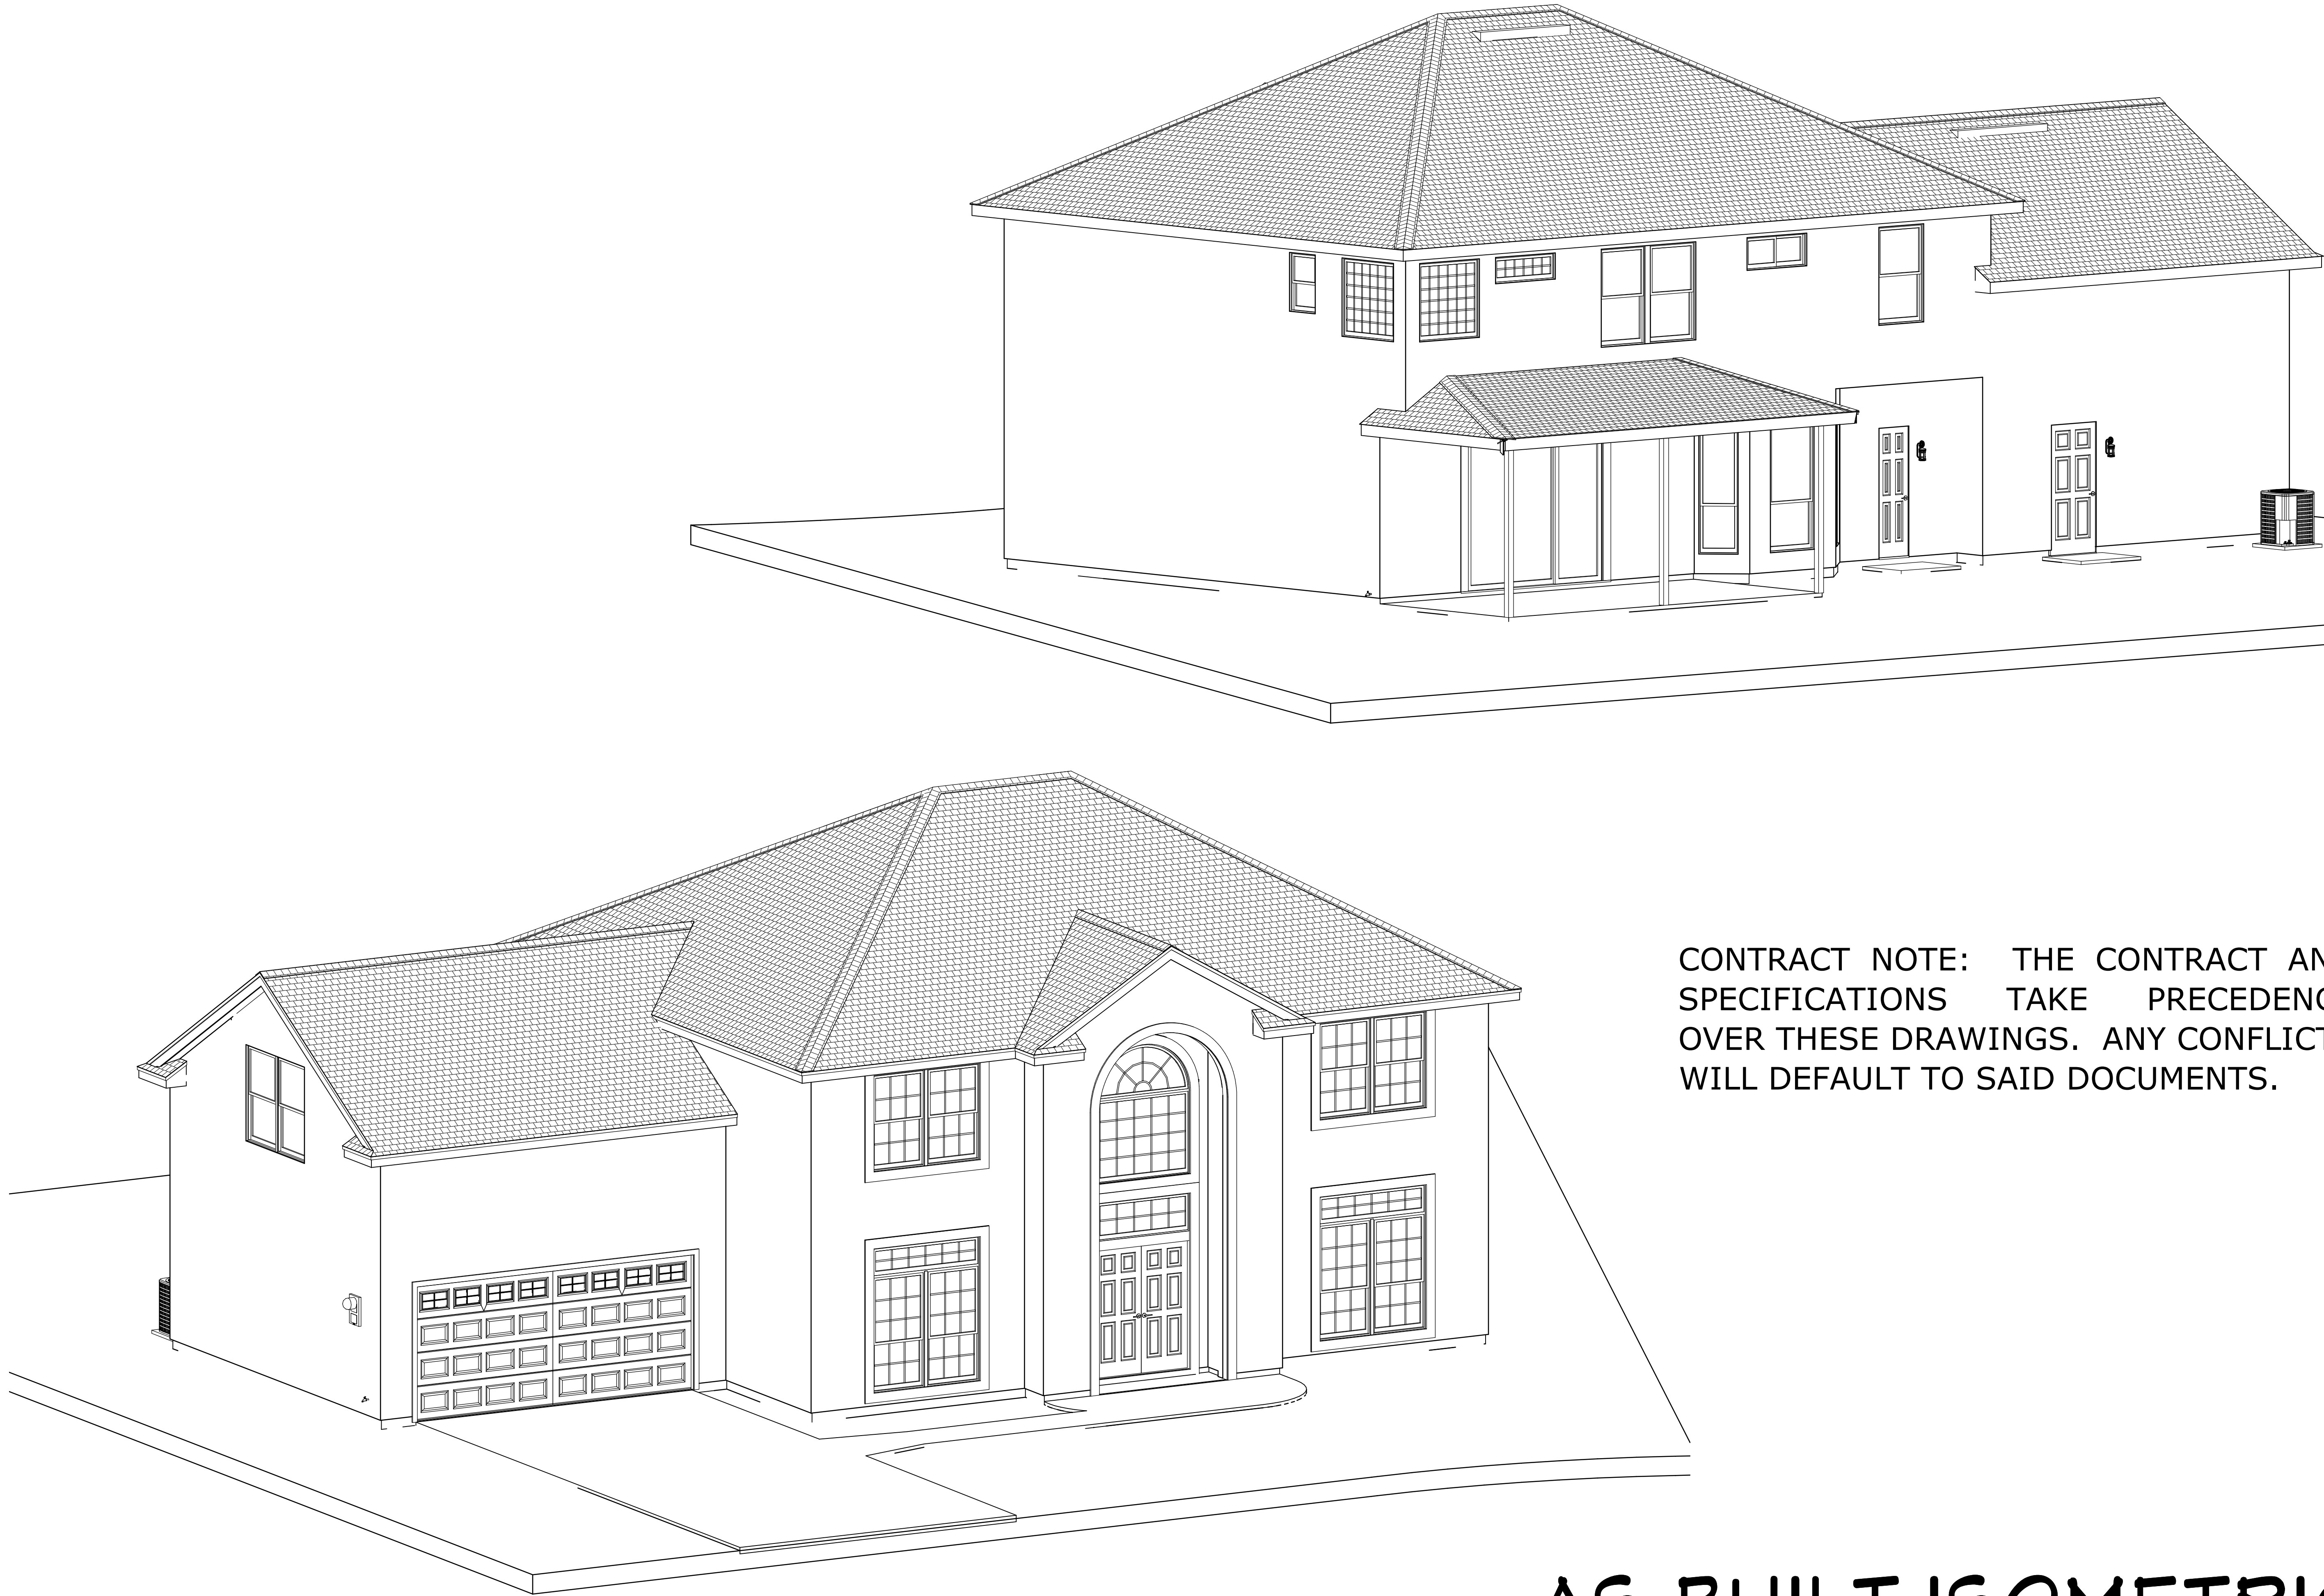

CONTRACT NOTE: THE CONTRACT AND SPECIFICATIONS TAKE PRECEDENCE OVER THESE DRAWINGS. ANY CONFLICTS WILL DEFAULT TO SAID DOCUMENTS.

PLANS NOT RELEASED FOR CONSTRUCTION

AS-BUILT ISOMETRICS

COPYRIGHT 2017: DESIGNS FOR LIVING, LLC. -Under section 102 of the Architectural Works Copyright Protection Act (title 17 of the United States Code) specific tact copyright laws apply to original created in any tangible medium of expression, including a constructed building or architectural plans, models, or drawings and is subject to copyright protection as an "architectural work" by Designs for Living, LLC, herein referred to as Designer. It is unlawful for anyone to copy these drawings, either in whole or in part, without the express written permission of the Designer. The use of any plans, specifications, electronic or hard copy prints shall be restricted to the original site for which they were prepared and publication thereof is expressly limited to such use. Title to all works, specifically all drawings, specifications, and modified derivatives of any blueprints, e-files, drawings, or specifications remain the Designers without prejudice. VISUAL CONTACT with any of these drawings, or their purchase constitutes prima facie evidence of the acceptance of these restrictions. This has held precedent in the North Florida Court system! Any and all violations WILL result in legal action being taken and litigated damages to the full extent allowed by law! No exceptions and no excuses! Contractor &/or owner shall verify all dimensions, details, & specifications prior to construction. Every attempt has been made to avoid mistakes. The Designer does not warrant the accuracy of the drawings and does not assume any liability for errors or omissions. Copyright release approval and design for drawings is given for drawings for K.E. Chip Mitchell shall not be liable for error for copyright infringement or other errors after delivery via email of drawings including after construction has begun. This copyright law is only valid on building designs created on or after December 1, 1990.

PLAN #
A-508

CLIENT APPROVAL SIGNATURE	DATE
DOUGLAS L. REIGERT-JOHNSON	
VANESSA Z. REIGERT-JOHNSON	

Design Drawings
provided by:

DESIGNS for LIVING, LLC
RESIDENTIAL DESIGN BUILT 1989
904-730-7135

PROJECT DESCRIPTION:
RENOVATIONS FOR THE
REIGERT-JOHNSON FAMILY
508 E SURF SPRAY LANE
PONTE VEDRA BEACH, FL 32082
R/E #: 062156-2521

BUILT BY:

TOM TROUT INC.
GENERAL CONTRACTOR
5569-1 BOWDEN ROAD CBC026189
JACKSONVILLE, FL 32216
904-737-5412

DATE:

7/30/2017


SCALE:

N.T.S.

SHEET:


A-8

CONTRACT NOTE: THE CONTRACT AND SPECIFICATIONS TAKE PRECEDENCE OVER THESE DRAWINGS. ANY CONFLICTS WILL DEFAULT TO SAID DOCUMENTS.

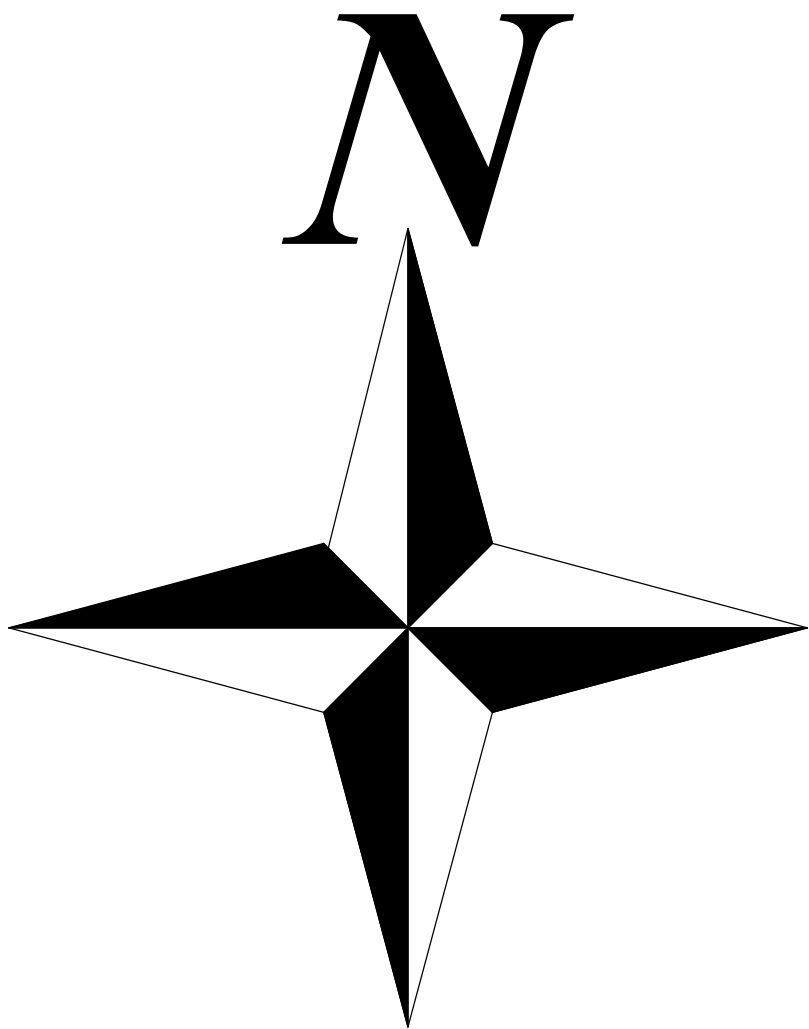

INSULATION NOTES FOR ADDITION:
WALLS: R-13 & 19 AS REQUIRED
CEILINGS: R-38 BLOWN

FOOTAGES (A.N.S.I.):	
NEW HEATED:	721.77
WORKSHOP:	240.00
SCREENED PORCH:	206.85

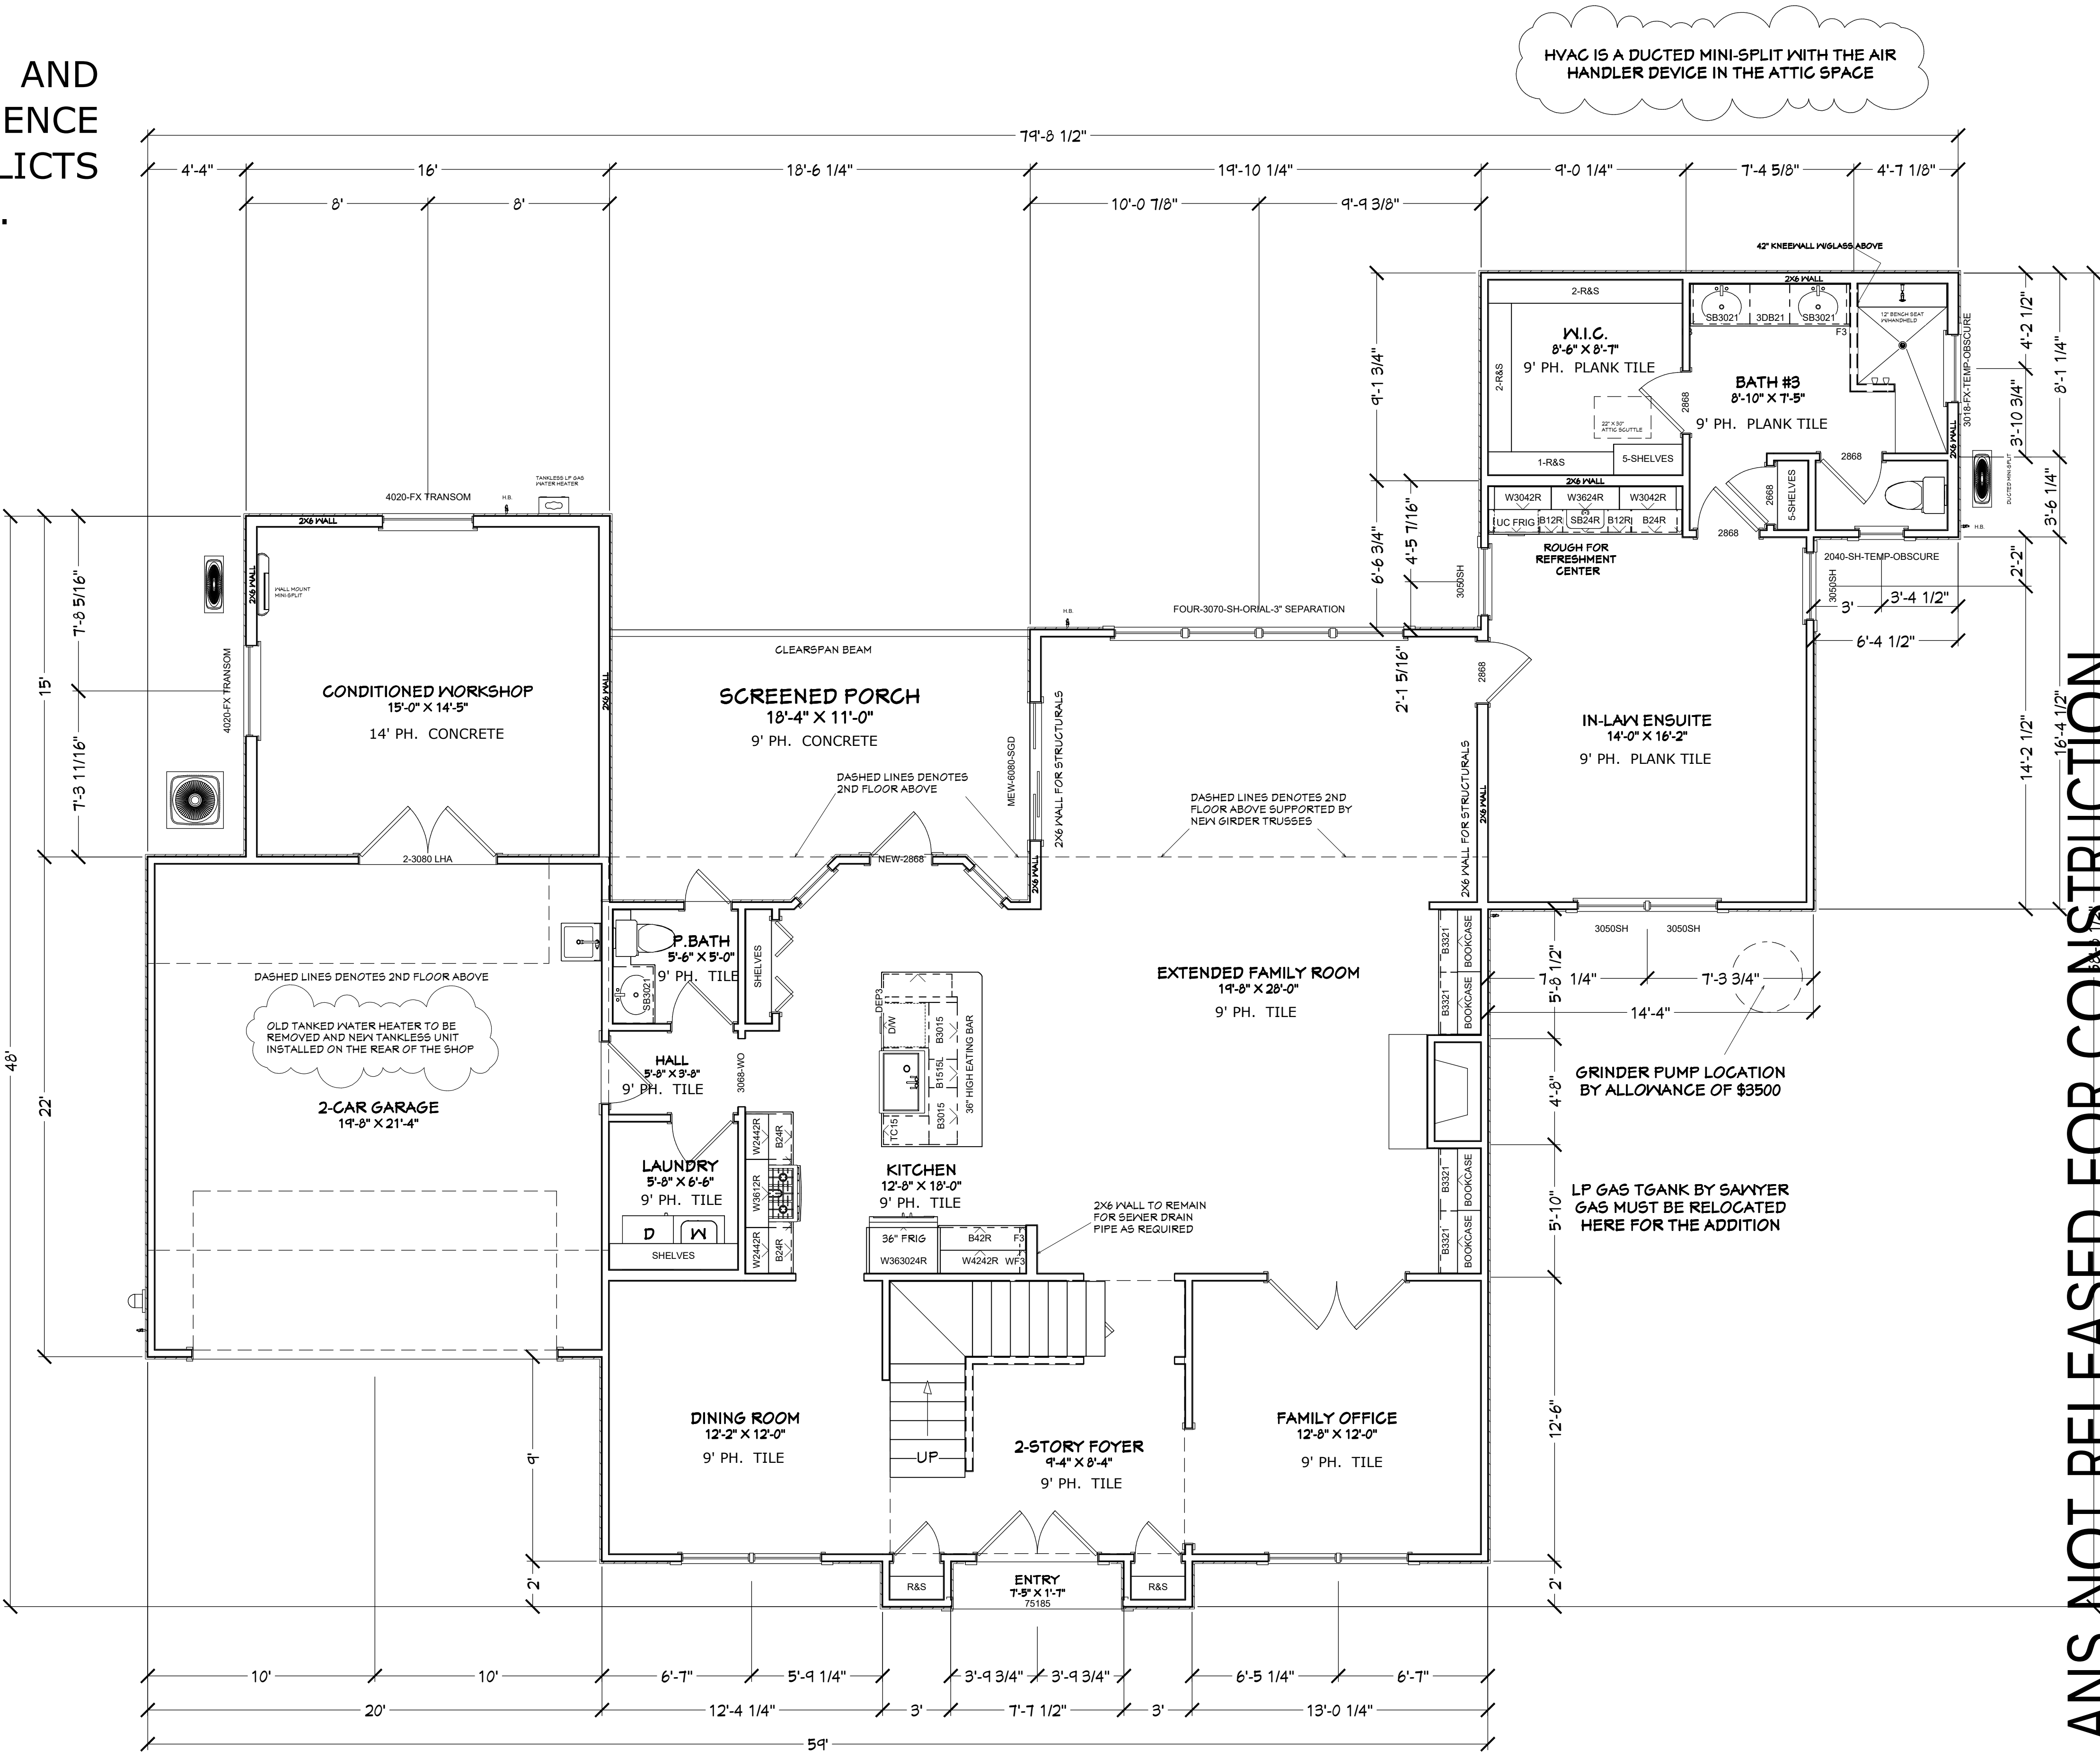

NEW WINDOWS AND DOORS ARE LABELED

PROPOSED 1ST FLOOR PLAN

PLANS NOT RELEASED FOR CONSTRUCTION

COPYRIGHT 2017: DESIGNS FOR LIVING, LLC. -Under section 102 of the Architectural Works Copyright Protection Act (title 17 of the United States Code) specific tacit copyright laws apply to original design of a building created in any tangible medium of expression, including a constructed building or architectural plans, models, or drawings and is subject to copyright protection as an "architectural work" by Designs for Living, LLC. herein referred to as Designer. It is unlawful for anyone to copy these drawings, either in whole or in part, without the express written permission of the Designer. The use of any plans, specifications, electronic or hard copy prints shall be restricted to the original site for which they were prepared and publication thereof is expressly limited to such use. Title to all works, specifically all drawings, specifications, and modified derivatives of any blueprints, e-files, drawings, or specifications remain the Designers without prejudice. VISUAL CONTACT with any of these drawings, or their purchase constitutes prima facie evidence of the acceptance of these restrictions. This has held precedent in the North Florida Court system! Any and all violations WILL result in legal action being taken and litigated damages to the full extent allowed by law! No exceptions and no excuses! Contractor &/or owner shall verify all dimensions, details, & specifications prior to construction. Every attempt shall be made to avoid errors and omissions as well as omissions and omissions. The Designer shall not be liable for copyright infringement or other errors after delivery via email or drawings including after construction has begun. This copyright law is only valid on building designs created on or after December 1, 1990.

PLAN #
A-508

CLIENT APPROVAL SIGNATURE DATE

DOUGLAS L. REIGERT-JOHNSON

VANESSA Z. REIGERT-JOHNSON

Design Drawings provided by:

DESIGNS FOR LIVING, LLC

RESIDENTIAL DESIGNER SINCE 1989

904-730-7135

PROJECT DESCRIPTION:

RENOVATIONS FOR THE REIGERT-JOHNSON FAMILY

508 E SURF SPRAY LANE

PONTE VEDRA BEACH, FL 32082

R/E # : 062156-2521

BUILT BY:

TOM TROUT, INC.

GENERAL CONTRACTOR

5569-1 BOWDEN ROAD CBC026189

JACKSONVILLE, FL 32216

904-737-5412

DATE:

7/30/2017


SCALE:

1/4" = 1'-0"


SHEET:

A-9

CONTRACT NOTE: THE CONTRACT AND SPECIFICATIONS TAKE PRECEDENCE OVER THESE DRAWINGS. ANY CONFLICTS WILL DEFAULT TO SAID DOCUMENTS.

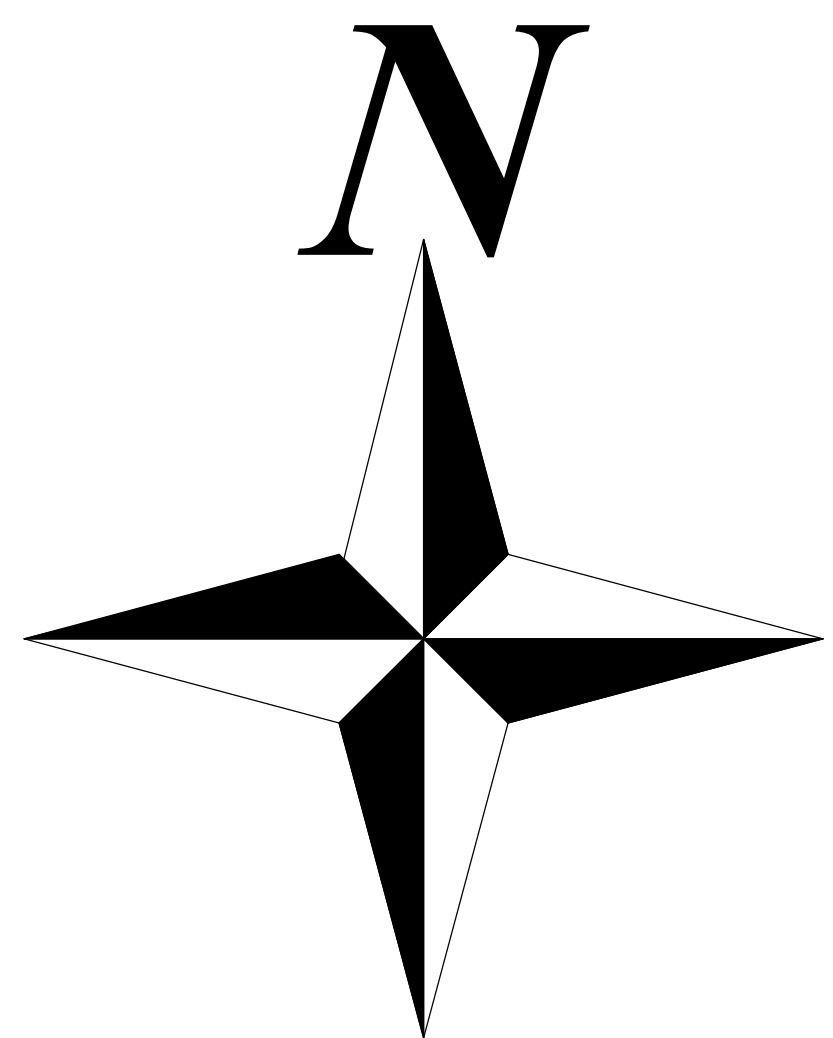

NOTE: NOTHING IS PLANNED TO BE DONE ON THE 2ND FLOOR AREA

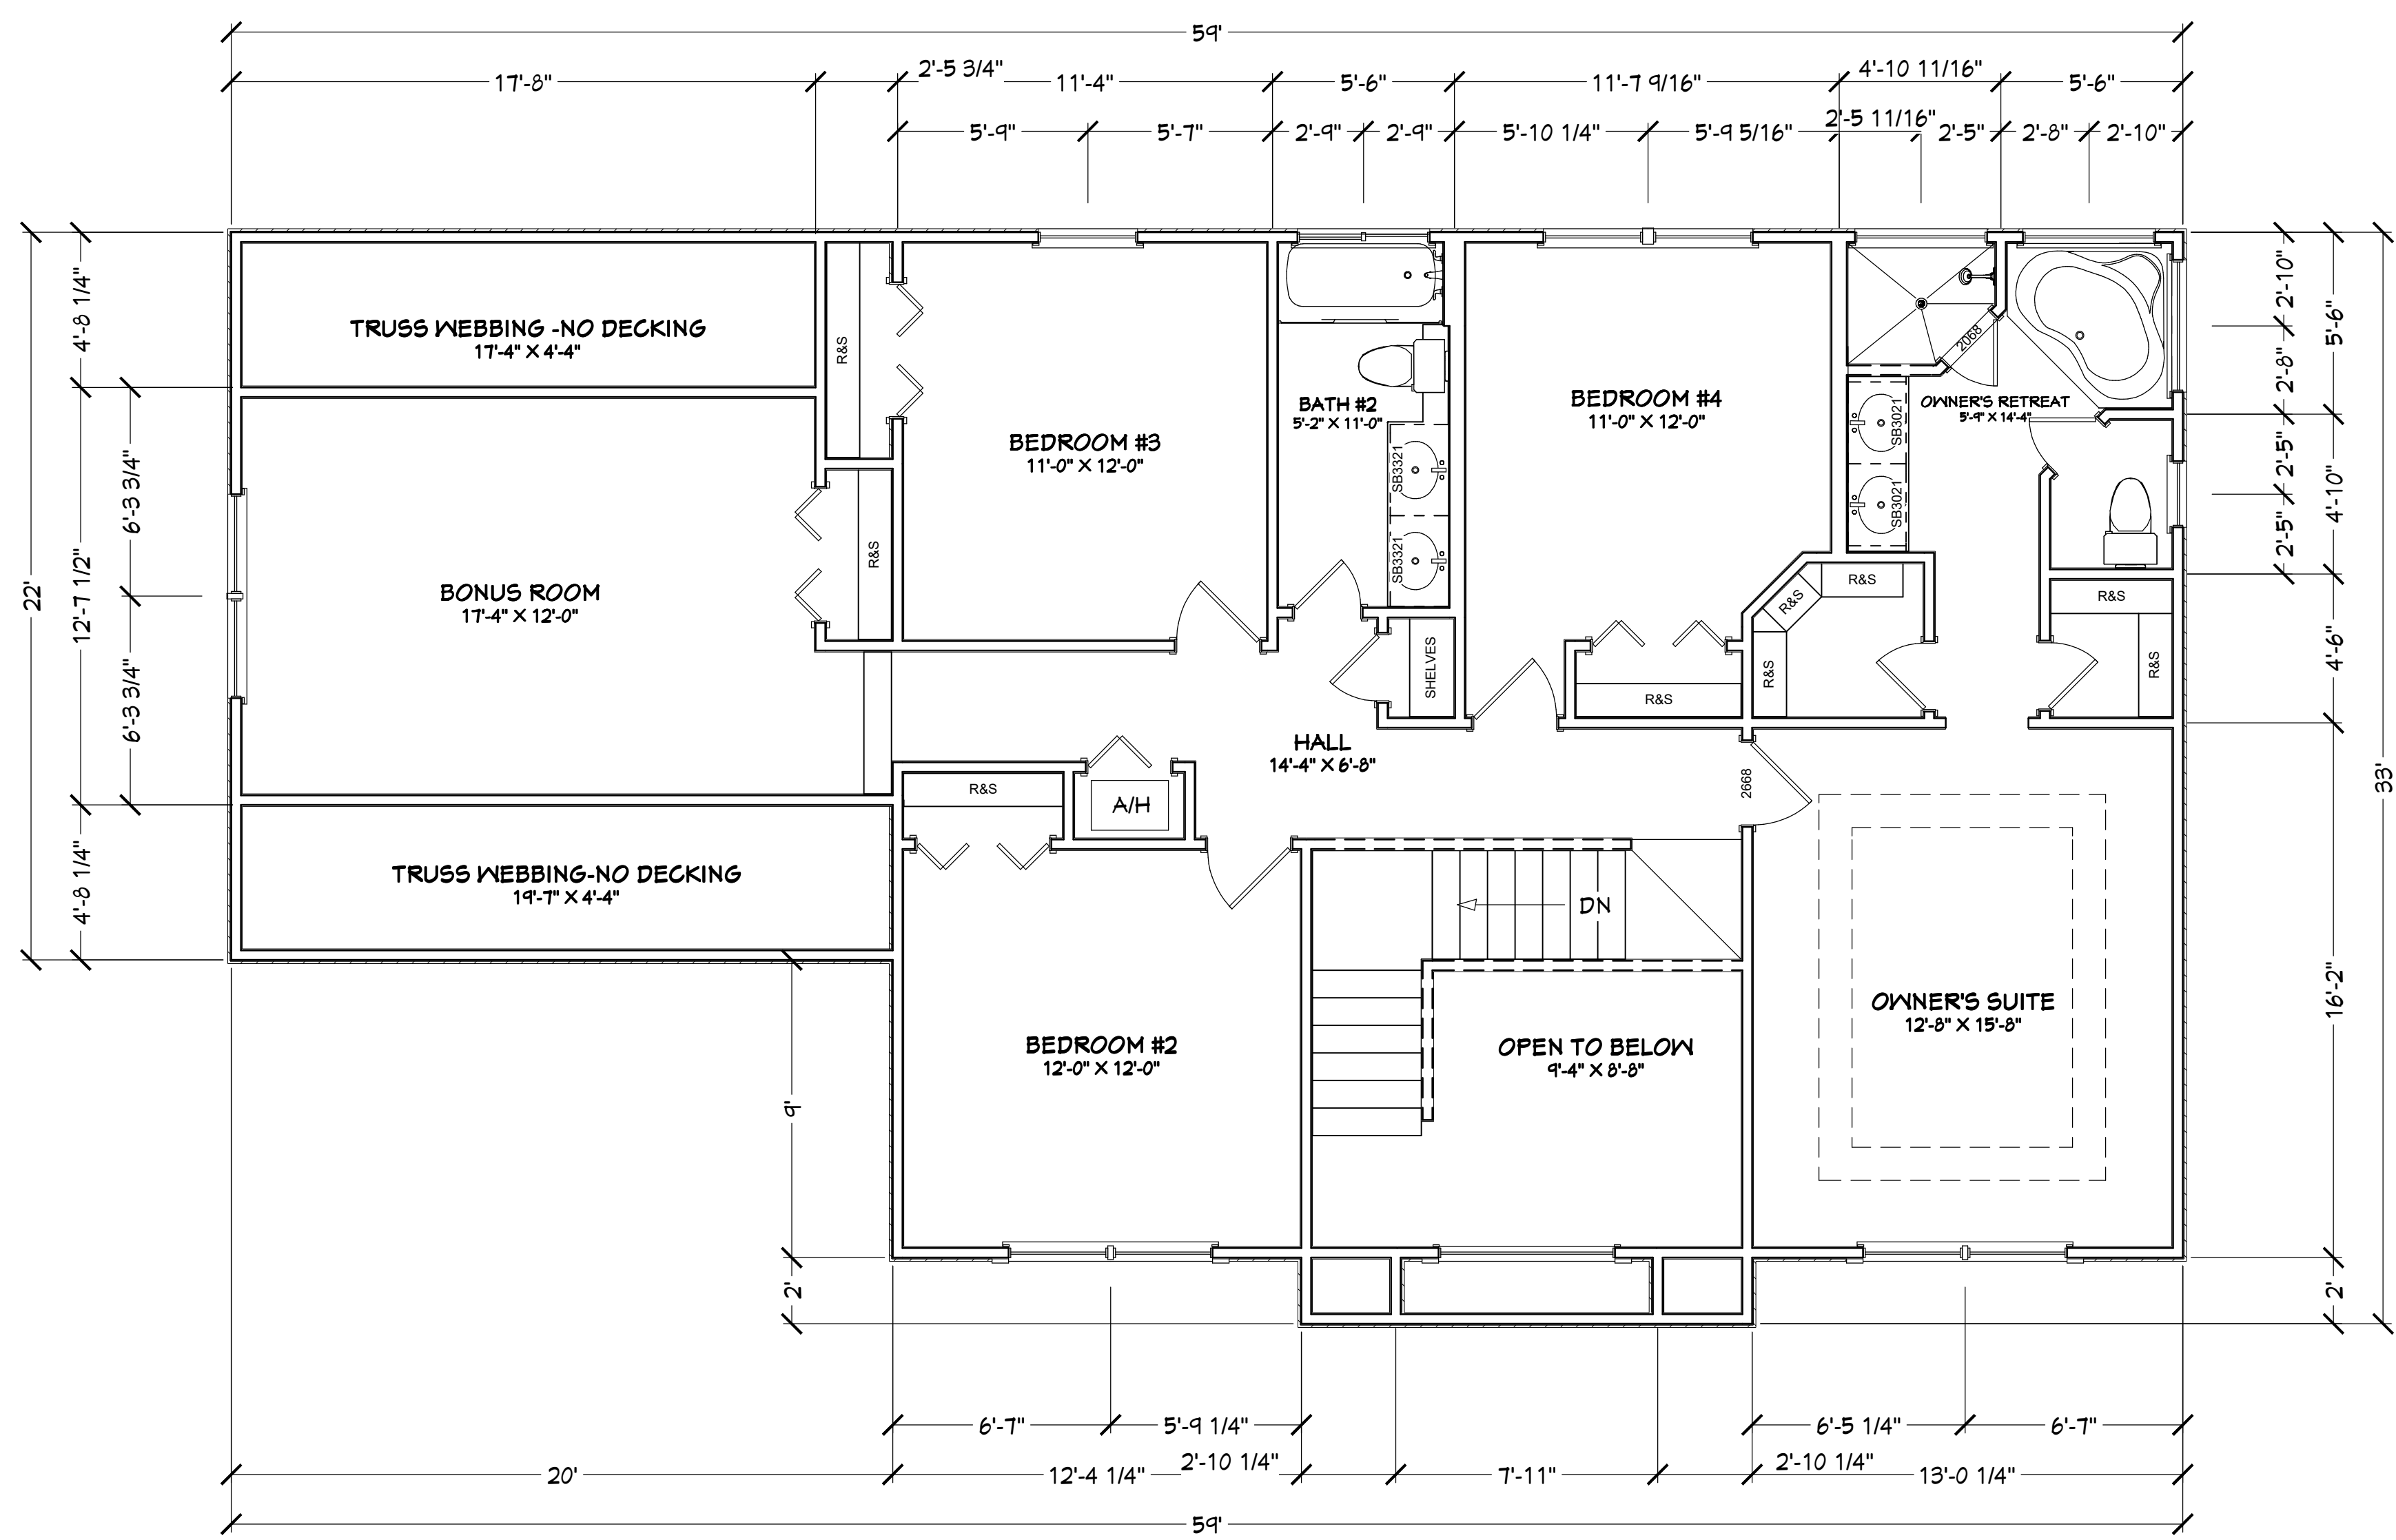

PROPOSED 2ND FLOOR PLAN

PLANS NOT RELEASED FOR CONSTRUCTION

COPYRIGHT 2017: DESIGNS FOR LIVING, LLC. -Under section 102 of the Architectural Works Copyright Protection Act (title 17 of the United States Code) specific tacit copyright laws apply to original design of a building created in any tangible medium of expression, including a constructed building or architectural plans, models, or drawings and is subject to copyright protection as an "architectural work" by Designs for Living, LLC. herein referred to as Designer. It is unlawful for anyone to copy these drawings, either in whole or in part, without the express written permission of the Designer. The use of any plans, specifications, electronic or hard copy prints shall be restricted to the original site for which they were prepared and publication thereof is expressly limited to such use. Title to all works, specifically all drawings, specifications, and modified derivatives of any blueprints, e-files, drawings, or specifications remain the Designers without prejudice. VISUAL CONTACT with any of these drawings, or their purchase constitutes prima facie evidence of the acceptance of these restrictions. This has held precedent in the North Florida Court system! Any and all violations WILL result in legal action being taken and litigated damages to the full extent allowed by law! No exceptions and no excuses! Contractor &/or owner shall verify all dimensions, details, & specifications prior to construction. Every attempt shall be made to avoid mistakes. The Designer and/or owner is not responsible for any errors or omissions in the drawings or specifications. This copyright law is only valid on building designs created on or after December 1, 1990. Other errors after delivery via email or drawings including after construction has begun.

BUILT BY:

5569-1 BOWDEN ROAD CBC026189 JACKSONVILLE, FL 32216 904-737-5412

DATE: 7/30/2017

SCALE: 1/4" = 1'-0"

SHEET: A-10

PROJECT DESCRIPTION:

RENOVATIONS FOR THE REIGERT-JOHNSON FAMILY

508 E SURF SPRAY LANE PONTA VEDRA BEACH, FL 32082 R/E #: 062156-2521

Design Drawings provided by:

DESIGNS FOR LIVING, LLC RESIDENTIAL DESIGN SINCE 1989 904-730-7135

CLIENT APPROVAL SIGNATURE	DATE
DOUGLAS L. REIGERT-JOHNSON	
VANESSA Z. REIGERT-JOHNSON	

PLAN # A-508

INSULATION NOTES FOR ADDITION:
WALLS: R-13 & 19 AS REQUIRED
CEILINGS: R-38 BLOWN



PROPOSED ROOF PLANS

PLANS NOT RELEASED FOR CONSTRUCTION

COPYRIGHT 2017: DESIGNS FOR LIVING, LLC - Under section 102 of the Architectural Works Copyright Protection Act (title 17 of the United States Code) specific tacit copyright laws apply to original design of a building created in any tangible medium of expression, including a constructed building or architectural plans, models, or drawings and is subject to copyright protection as an "architectural work" by Designs for Living, LLC herein referred to as Designer. It is unlawful for anyone to copy these drawings, either in whole or in part, without the express written permission of the Designer. The use of any plans, specifications, electronic or hard copy prints shall be restricted to the original site for which they were prepared and publication thereof is expressly limited to such use. Title to all works, specifically all drawings, specifications, and modified derivatives of any blueprints, e-files, drawings, or specifications remain the Designer's without prejudice. VISUAL CONTACT with any of these drawings, or their purchase constitutes prima facie evidence of the acceptance of these restrictions! This has held precedent in the North Florida Court system! Any and all violations WILL result in legal action being taken and litigated damages to the full extent allowed by law! No exceptions and no excuses! Contractor &/or owner shall verify all dimensions, details, & specifications prior to construction. Every attempt has been made to avoid mistakes. The contractor and the owners also fully acknowledge that they have full copyright release approval and Designs for Livings LLC nor R.E. Chip Mitchell shall not be liable for error for copyright infringement or other errors after delivery via email of drawings including after construction has begun! This copyright law is only valid on building designs created on or after December 1, 1990.

PLAN #
A-508

CLIENT APPROVAL SIGNATURE	DATE
DOUGLAS L. REIGERT-JOHNSON	
VANESSA Z. REIGERT-JOHNSON	

Design Drawings
provided by:

 **DESIGNS for LIVING** LLC
RESIDENTIAL DESIGN SINCE 1969

904-730-7135

PROJECT DESCRIPTION:
**RENOVATIONS FOR THE
REIGERT-JOHNSON FAMILY**
508 E SURF SPRAY LANE
PONTE VEDRA BEACH, FL 32082
R/E #: 062156-2521

BUILT BY:

 **TOM TROUT inc.**
GENERAL CONTRACTOR

5569-1 BOWDEN ROAD CBC026189
JACKSONVILLE, FL 32216 904-737-5412

DATE:
7/30/2017
SCALE:
1/4" = 1'-0"
SHEET:
A-11



PROPOSED FRONT ELEVATION

EXTERIOR NOTES: MATCH EXISTING
SIDING: PAINTED SKIP TROWEL STUCCO
SOFFITS: BUILDER GRADE VENTED VINYL
FASCIA: CPVC OCATED ALUMINUM PLUMB CUT
ROOFING: ARCH FIG SHINGLES
FOUNDATION: MONOLITHIC, NATURAL FINISH PAINTED
STUCCO BANDING: RECOMMEND BANDING ON ALL
NEW WINDOW AND DOOR AREAS

CONTRACT NOTE: THE CONTRACT AND
SPECIFICATIONS TAKE PRECEDENCE
OVER THESE DRAWINGS. ANY CONFLICTS
WILL DEFAULT TO SAID DOCUMENTS.



PROPOSED REAR ELEVATION

PROPOSED FRONT/REAR ELEVATIONS


PLANS NOT RELEASED FOR CONSTRUCTION

COPYRIGHT 2017: DESIGNS FOR LIVING, LLC. -Under section 102 of the Architectural Works Copyright Protection Act (title 17 of the United States Code) specific tact copyright laws apply to original design of a building created in any tangible medium of expression, including a constructed building or architectural plans, models, or drawings and is subject to copyright protection as an "architectural work" by Designs for Living, LLC. herein referred to as Designer. It is unlawful for anyone to copy these drawings, either in whole or in part, without the express written permission of the Designer. The use of any plans, specifications, electronic or hard copy prints shall be restricted to the original site for which they were prepared and publication thereof is expressly limited to such use. Title to all works, specifically all drawings, specifications, and modified derivatives of any blueprints, e-files, drawings, or specifications remain the Designers without prejudice. VISUAL CONTACT with any of these drawings, or their purchase constitutes prima facie evidence of the acceptance of these restrictions! This has held precedent in the North Florida Court system! Any and all violations WILL result in legal action being taken and litigated damages to the full extent allowed by law! No exceptions and no excuses! Contractor &/or owner shall verify all dimensions, details, & specifications prior to construction. Every attempt shall be made to avoid mistakes. The Designer does not assume any responsibility for errors or omissions. Copyright release approval and Design for Living logo shall be required for all reproductions. Copyright 2017. All rights reserved. Design for Living, LLC. Chip Mitchell shall not be liable for copyright infringement or other errors after delivery via email of drawings including after construction has begun. This copyright law is only valid on building designs created on or after December 1, 1990.

PLAN #
A-508

CLIENT APPROVAL SIGNATURE	DATE
DOUGLAS L. REIGERT-JOHNSON	
VANESSA Z. REIGERT-JOHNSON	

Design Drawings
provided by:

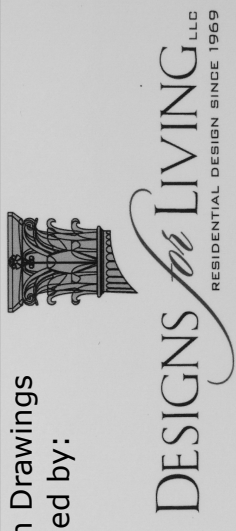

DESIGNS for LIVING, LLC
RESIDENTIAL DESIGN BUILD 1989
904-730-7305

PROJECT DESCRIPTION:
RENOVATIONS FOR THE
REIGERT-JOHNSON FAMILY
508 E SURF SPRAY LANE
PONTE VEDRA BEACH, FL 32082
R/E #: 062156-2521

BUILT BY:



TOM TROUT INC.
GENERAL CONTRACTOR
5569-1 BOWDEN ROAD CBC026189
JACKSONVILLE, FL 32216 904-737-5412

DATE:

7/30/2017


SCALE:

1/4" = 1'-0"


SHEET:

A-12

EXTERIOR NOTES: MATCH EXISTING
SIDING: PAINTED SKIP TROWEL STUCCO
SOFFITS: BUILDER GRADE VENTED VINYL
FASCIA: CPVC OCATED ALUMINUM PLUMB
CUT
ROOFING: ARCH F/G SHINGLES
FOUNDATION: MONOLITHIC, NATURAL
FINISH PAINTED
STUCCO BANDING: RECOMMEND
BANDING ON ALL NEW WINDOW AND
DOOR AREAS

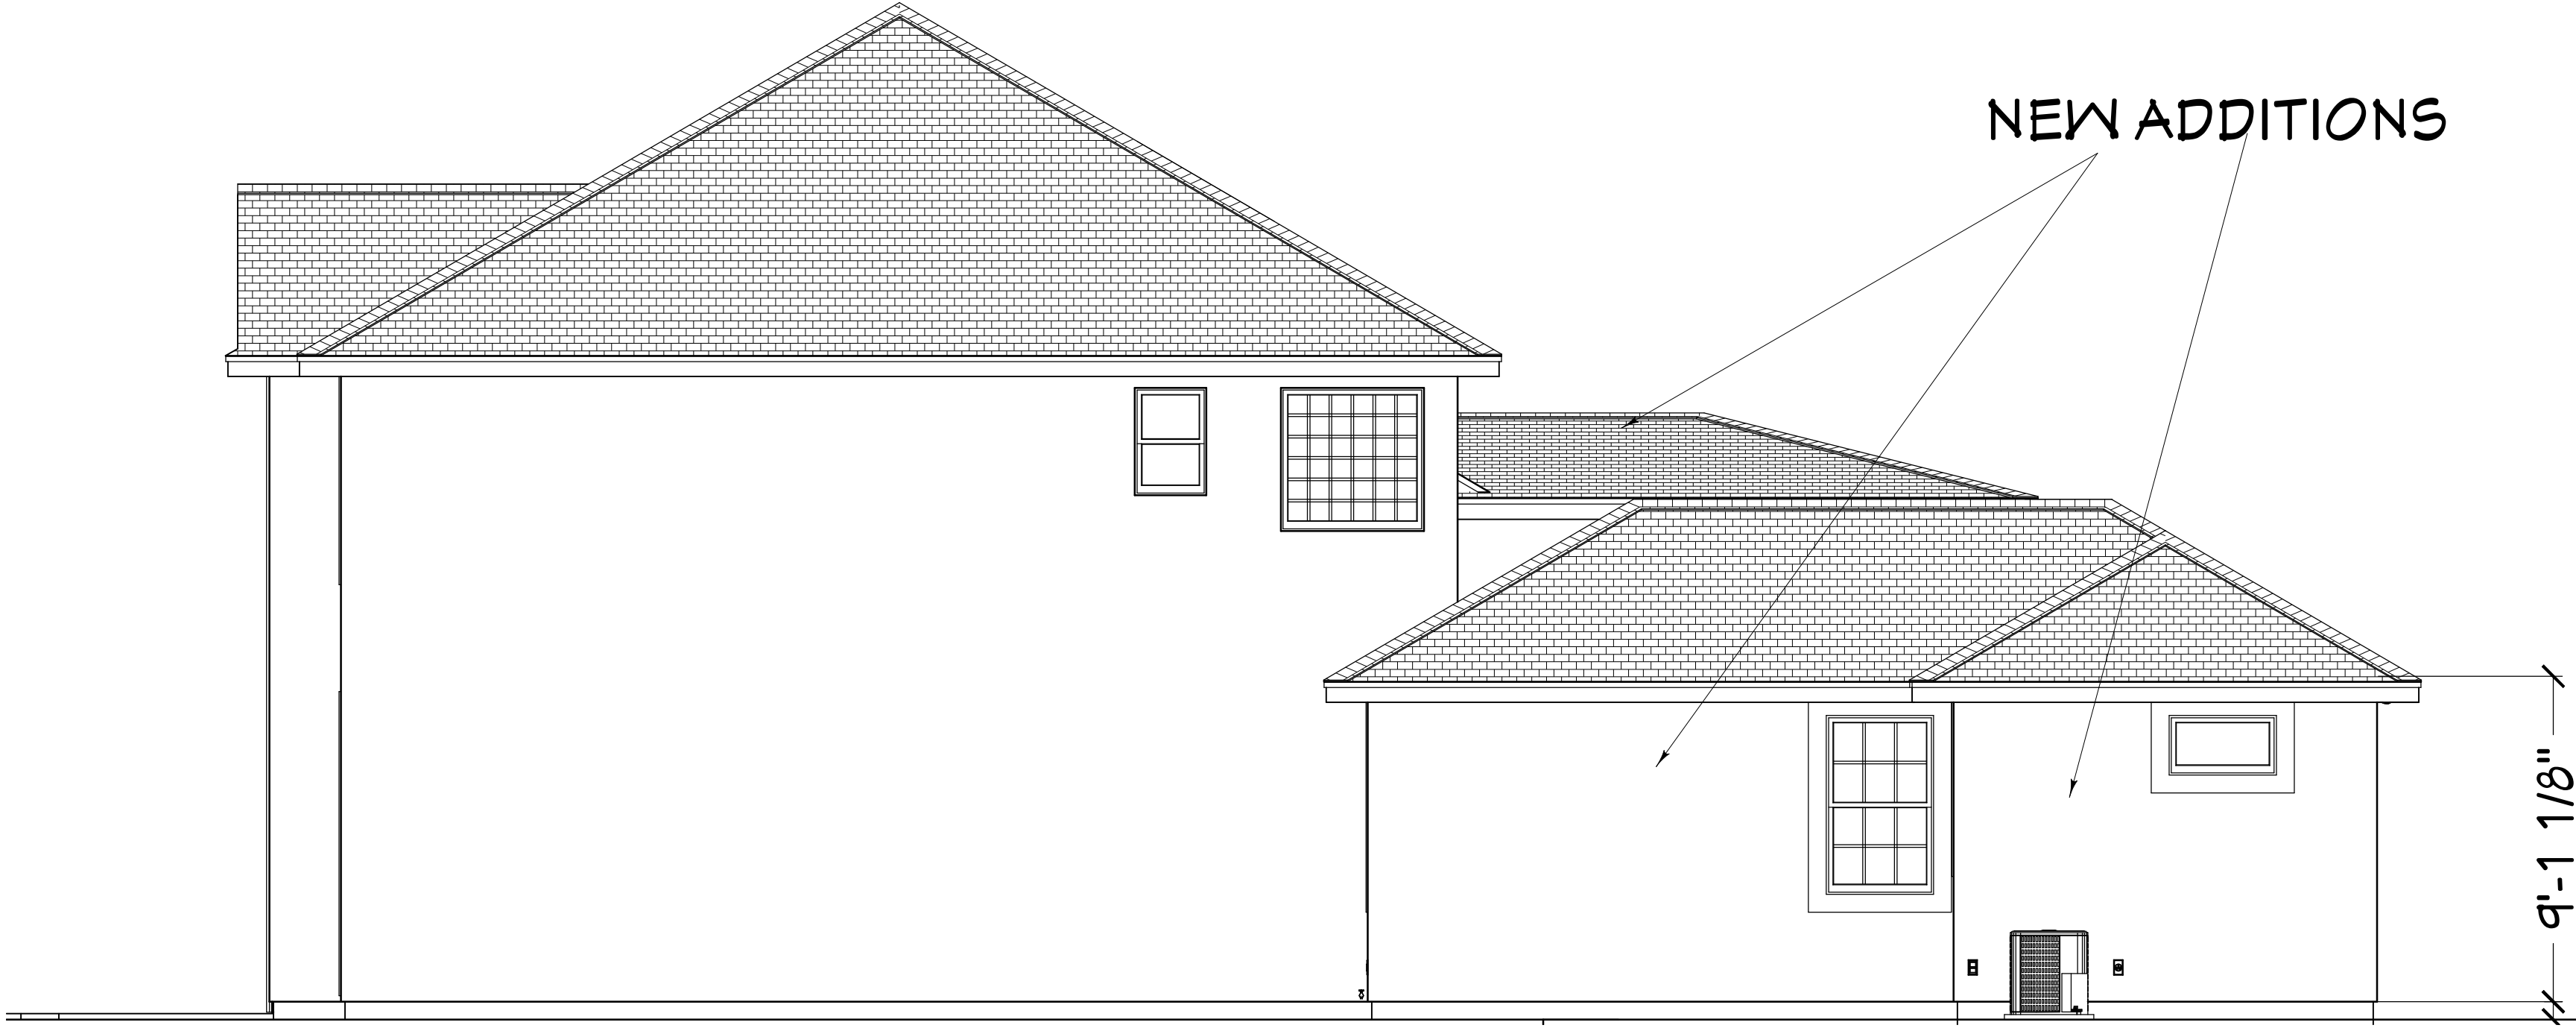

PROPOSED RIGHT ELEVATION

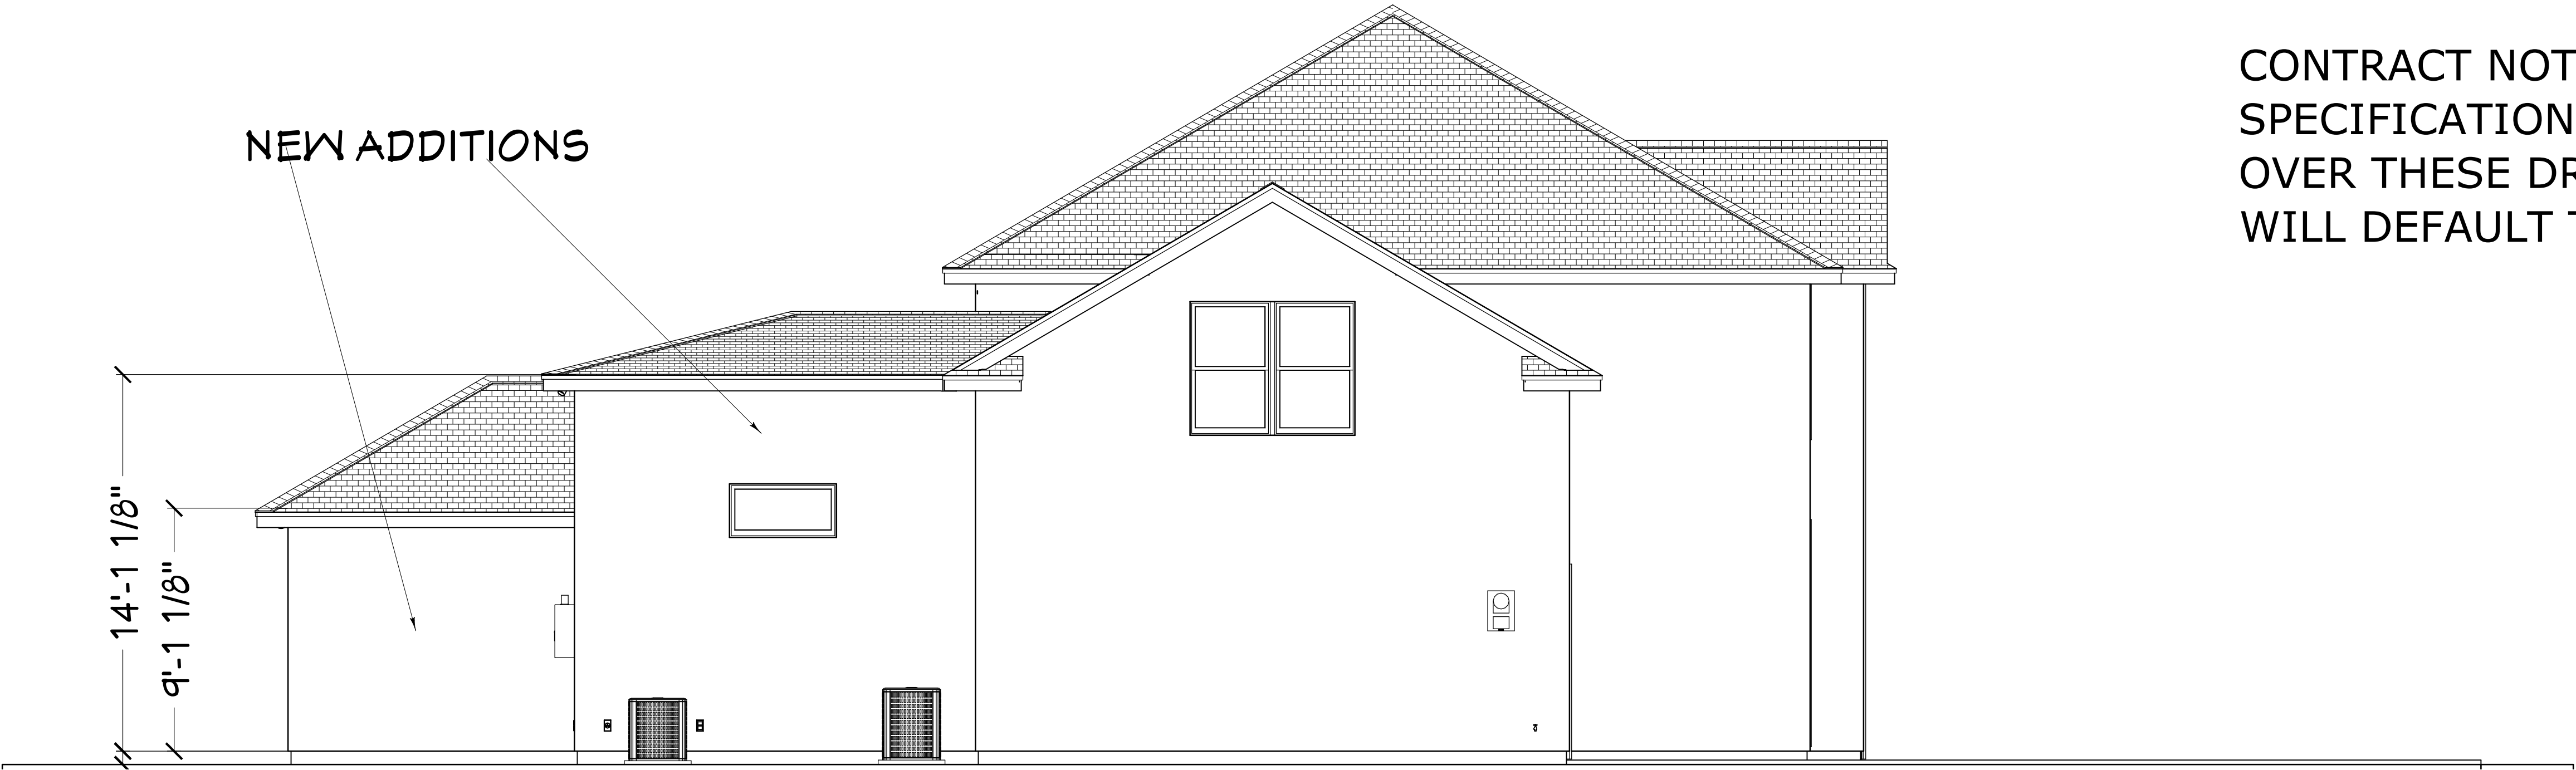

PROPOSED LEFT ELEVATION

CONTRACT NOTE: THE CONTRACT AND
SPECIFICATIONS TAKE PRECEDENCE
OVER THESE DRAWINGS. ANY CONFLICTS
WILL DEFAULT TO SAID DOCUMENTS.

PROPOSED SIDE ELEVATIONS


PLANS NOT RELEASED FOR CONSTRUCTION

COPYRIGHT 2017: DESIGNS FOR LIVING, LLC. -Under section 102 of the Architectural Works Copyright Protection Act (title 17 of the United States Code) specific tacit copyright laws apply to original design of a building created in any tangible medium of expression, including a constructed building or architectural plans, models, or drawings and is subject to copyright protection as an "architectural work" by Designs for Living, LLC. herein referred to as Designer. It is unlawful for anyone to copy these drawings, either in whole or in part, without the express written permission of the Designer. The use of any plans, specifications, electronic or hard copy prints shall be restricted to the original site for which they were prepared and publication thereof is expressly limited to such use. Title to all works, specifically all drawings, specifications, and modified derivatives of any blueprints, e-files, drawings, or specifications remain the Designers without prejudice. VISUAL CONTACT with any of these drawings, or their purchase constitutes prima facie evidence of the acceptance of these restrictions! This has held precedent in the North Florida Court system! Any and all violations WILL result in legal action being taken and litigated damages to the full extent allowed by law! No exceptions and no excuses! Contractor &/or owner shall verify all dimensions, details, & specifications prior to construction. Every attempt has been made to avoid errors and omissions. However, the Designer does not assume any liability for errors or omissions. The Designer shall not be liable for copyright infringement or other errors after delivery via email of drawings including after construction has begun. This copyright law is only valid on building designs created on or after December 1, 1990.

PLAN #
A-508

CLIENT APPROVAL SIGNATURE	DATE
DOUGLAS L. REIGERT-JOHNSON	
VANESSA Z. REIGERT-JOHNSON	

Design Drawings
provided by:

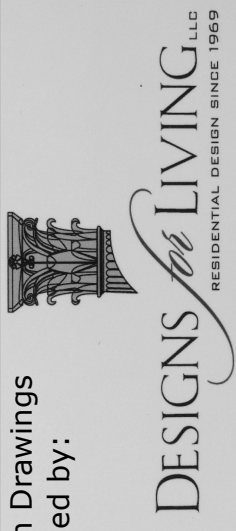

DESIGNS for LIVING, LLC
RESIDENTIAL DESIGNER SINCE 1989
904-730-7135

PROJECT DESCRIPTION:
RENOVATIONS FOR THE
REIGERT-JOHNSON FAMILY
508 E SURF SPRAY LANE
PONTE VEDRA BEACH, FL 32082
R/E #: 062156-2521


BUILT BY:



TOM TROUT INC.
GENERAL CONTRACTOR
5569-1 BOWDEN ROAD CBC026189 904-737-5412
JACKSONVILLE, FL 32216

DATE:
7/30/2017
SCALE:
1/4" = 1'-0"
SHEET:
A-13

EXTERIOR NOTES: MATCH EXISTING
SIDING: PAINTED SKIP TROWEL STUCCO
SOFFITS: BUILDER GRADE VENTED VINYL
FASCIA: CPVC OCATED ALUMINUM PLUMB
CUT
ROOFING: ARCH F/G SHINGLES
FOUNDATION: MONOLITHIC, NATURAL
FINISH PAINTED
STUCCO BANDING: RECOMMEND BANDING
ON ALL NEW WINDOW AND DOOR AREAS

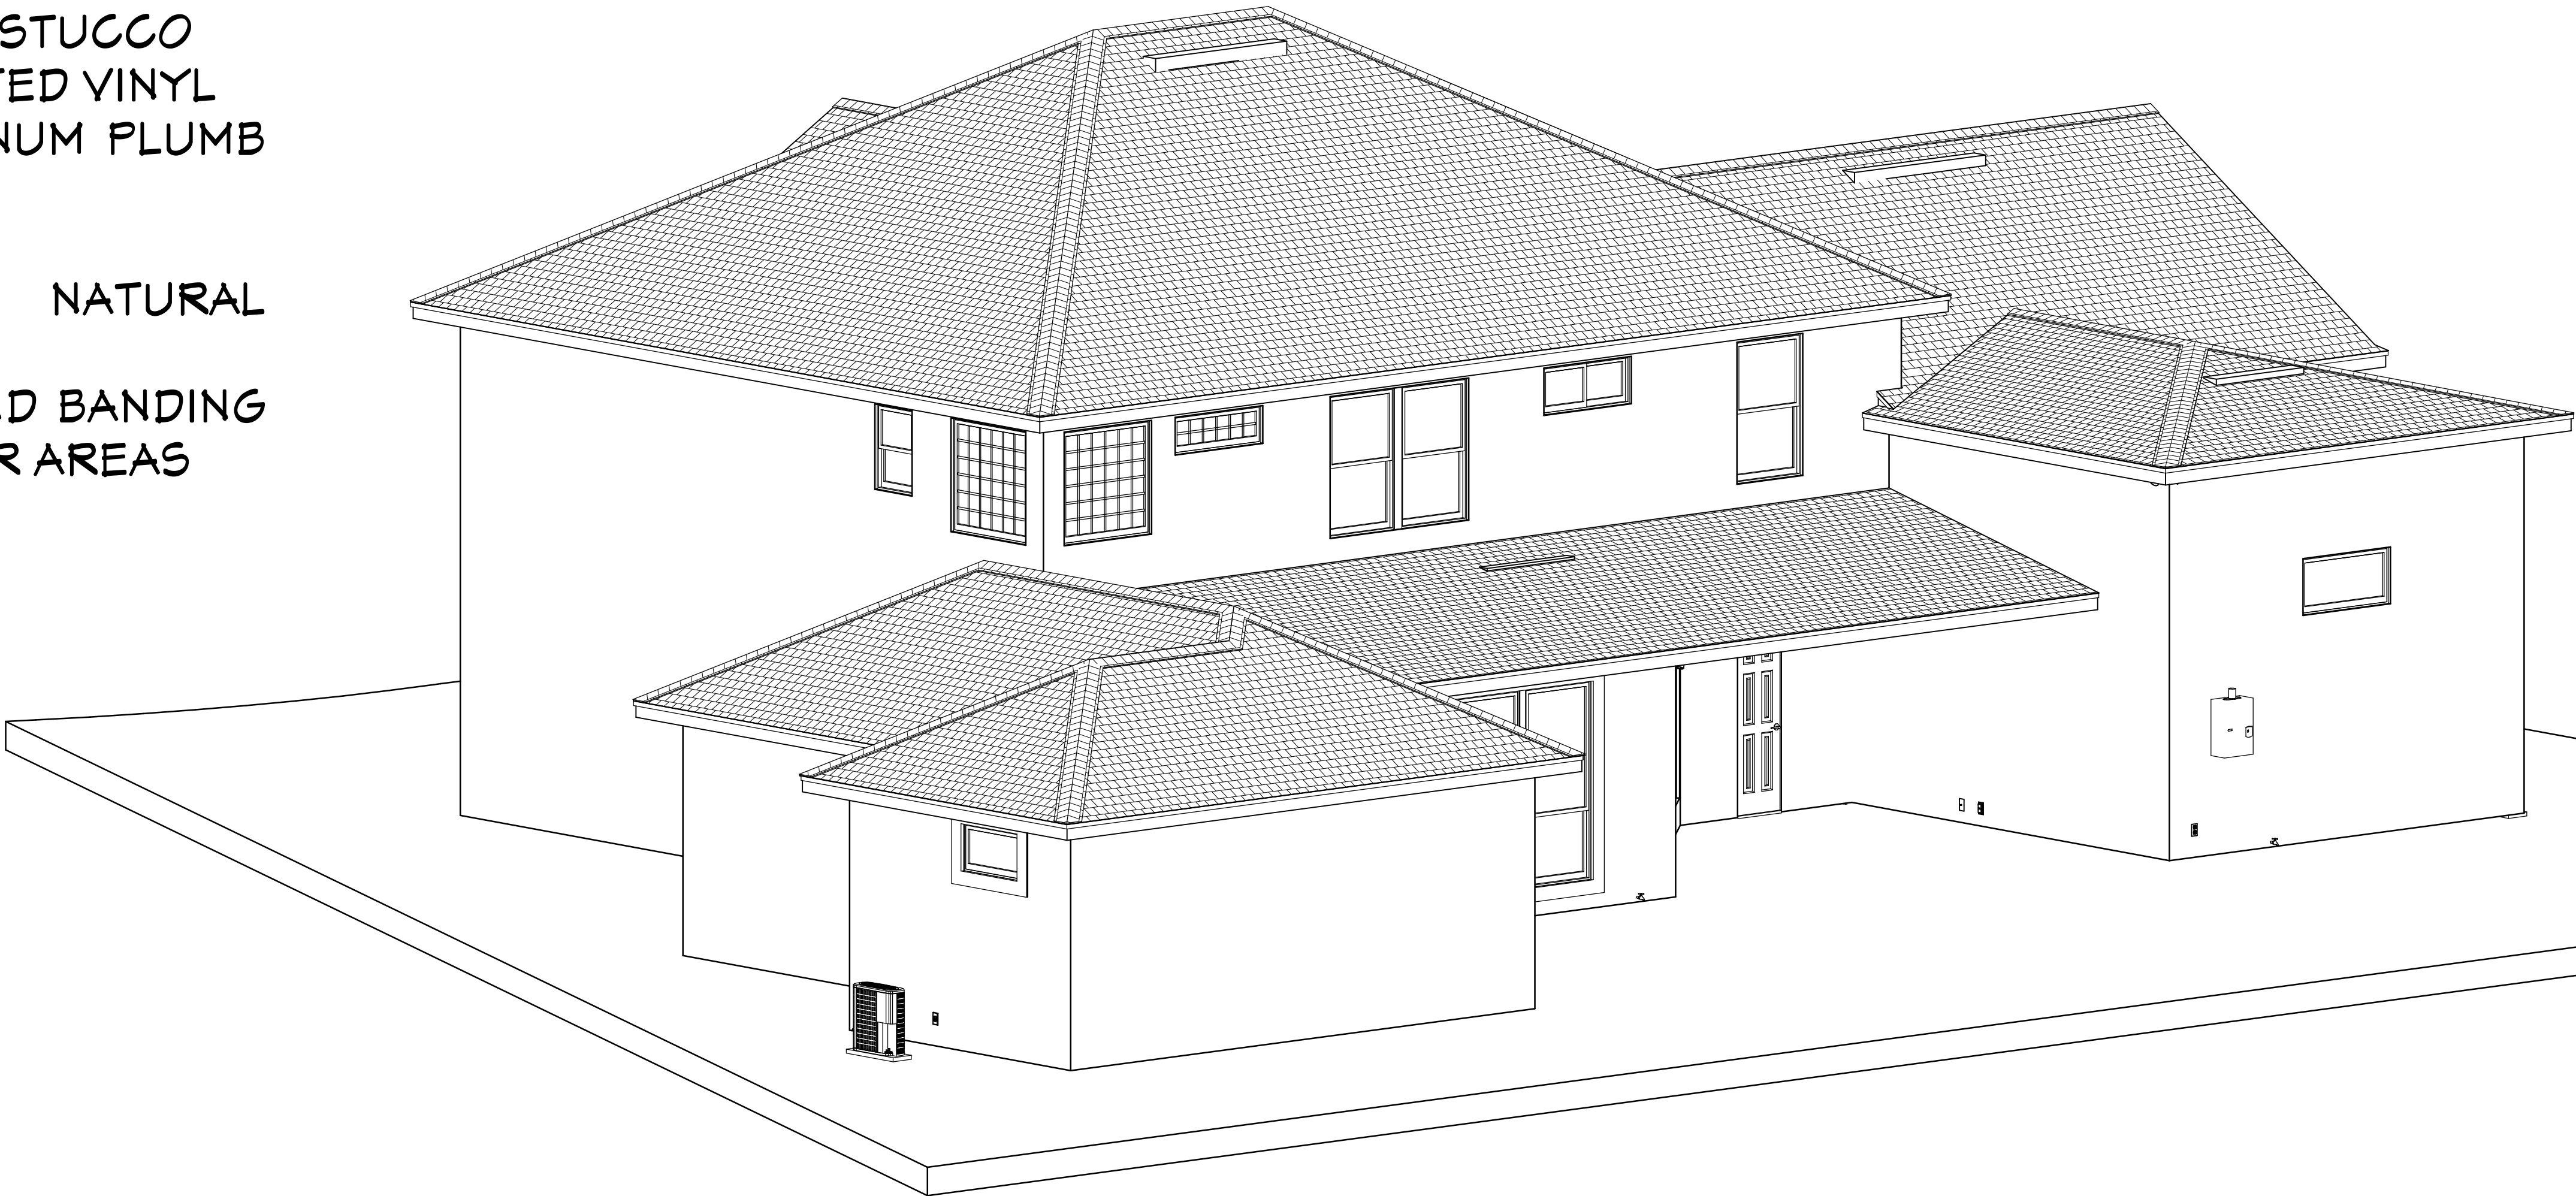

CONTRACT NOTE: THE CONTRACT AND SPECIFICATIONS TAKE PRECEDENCE OVER THESE DRAWINGS. ANY CONFLICTS WILL DEFAULT TO SAID DOCUMENTS.

PROPOSED ISOMETRICS VIEWS

PLANS NOT RELEASED FOR CONSTRUCTION

COPYRIGHT 2017: DESIGNS FOR LIVING, LLC. -Under section 102 of the Architectural Works Copyright Protection Act (title 17 of the United States Code) specific tacit copyright laws apply to original design of a building created in any tangible medium of expression, including a constructed building or architectural plans, models, or drawings and is subject to copyright protection as an "architectural work" by Designs for Living, LLC. herein referred to as Designer. It is unlawful for anyone to copy these drawings, either in whole or in part, without the express written permission of the Designer. The use of any plans, specifications, electronic or hard copy prints shall be restricted to the original site for which they were prepared and publication thereof is expressly limited to such use. Title to all works, specifically all drawings, specifications, and modified derivatives of any blueprints, e-files, drawings, or specifications remain the Designers without prejudice. VISUAL CONTACT with any of these drawings, or their purchase constitutes prima facie evidence of the acceptance of these restrictions! This has held precedent in the North Florida Court system! Any and all violations WILL result in legal action being taken and litigated damages to the full extent allowed by law! No exceptions and no excuses! Contractor &/or owner shall verify all dimensions, details, & specifications prior to construction. Every attempt shall be made to avoid mistakes. The Designer does not warrant, either in writing or orally, that the drawings are complete and accurate. The Designer shall not be liable for copyright infringement or other errors after delivery via email of drawings including after construction has begun. This copyright law is only valid on building designs created on or after December 1, 1990.

PLAN #
A-508

CLIENT APPROVAL SIGNATURE	DATE
DOUGLAS L. REIGERT-JOHNSON	
VANESSA Z. REIGERT-JOHNSON	

Design Drawings
provided by:

DESIGNS for LIVING, LLC
RESIDENTIAL DESIGN BUILD 1999
904-730-7135

PROJECT DESCRIPTION:

RENOVATIONS FOR THE
REIGERT-JOHNSON FAMILY
508 E SURF SPRAY LANE
PONTE VEDRA BEACH, FL 32082
R/E #: 062156-2521

BUILT BY:

TOM TROUT, INC.
GENERAL CONTRACTOR
5569-1 BOWDEN ROAD CBC026189
JACKSONVILLE, FL 32216 904-737-5412

DATE:

7/30/2017

SCALE:

N.T.S.

SHEET:

A-14

