


RENOVATIONS FOR THE MERRITT FAMILY

PRESENTATION 5/6/2016

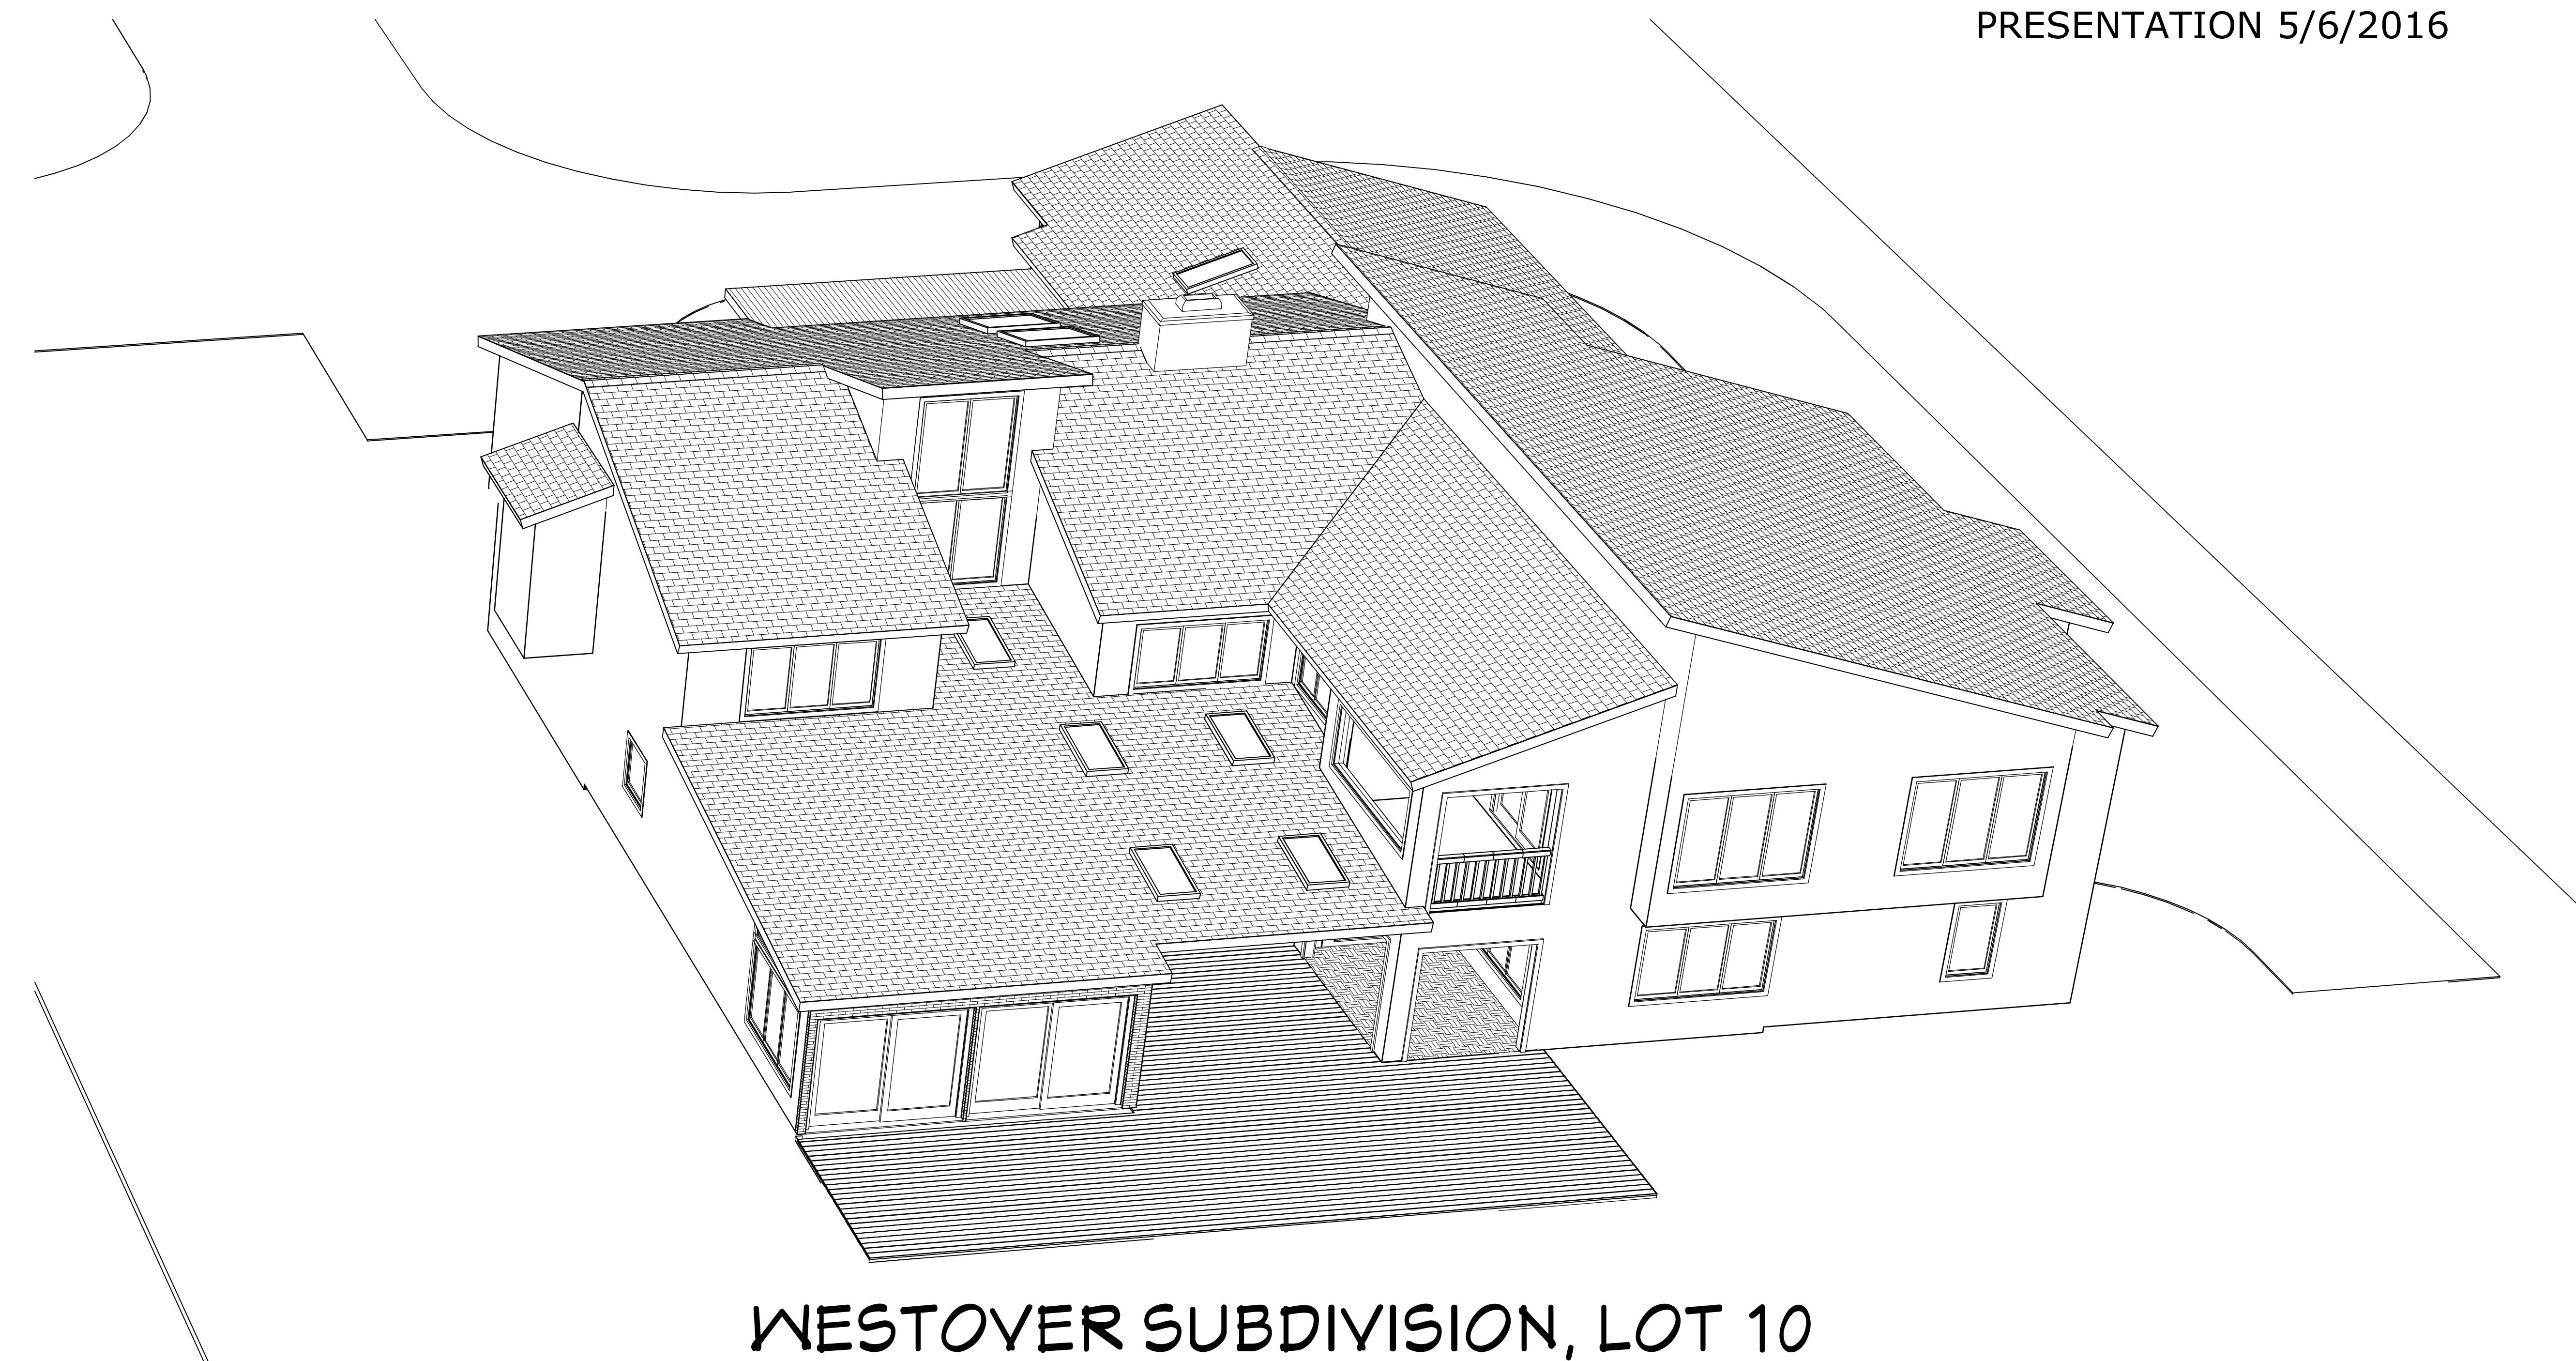

WESTOVER SUBDIVISION, LOT 10
3647 WESTOVER ROAD
FLEMING ISLAND, FL 32003 R/E #: 44-04-26-014094-000-00
BUILT BY: ALEXIS BUILDERS, INC.
5663 BAXTER LAKE DRIVE
JACKSONVILLE, FL 32258

§5490 of the Architectural Drawing Act & Title 17 specific tacit copyright laws apply to all published works of Designs for Living, LLC, herein referred to as Designer. It is unlawful for anyone to copy these drawings, either in whole or in part, without the express consent of the original designer. Title to all works, specifically all drawings, specifications, and modified derivatives of any blueprints, e-files, electronic or hard copy prints shall be restricted to the original site for which they were prepared and publication thereof is expressly limited to such use. Any and all violations WILL result in legal action being taken and AL CONTACT with any of these drawings, or their purchase constitutes prima facie evidence of the acceptance of these restrictions! This has held precedent in the North Florida Court system! Any and all violations WILL result in legal action being taken and excuses! Contractor &/or owner shall verify all dimensions, details, & specifications prior to construction. Every attempt has been made to avoid mistakes. The contractor and the owners also fully acknowledge that they have full copyright release approval and signs for Livesigns LLC nor R.E. Chip Mitchell shall not be liable for error for copyright infringement or other errors after delivery via email of drawings including after construction has begun!

PLAN # 3647

electronic or hard copy prints shall be restricted to the original site for which they were prepared and publication thereof is expressly limited to such use. Title to all works, specifically all drawings, specifications, and modified derivatives of any blueprints, e-files, or their purchase constitutes prima facie evidence of the acceptance of these restrictions! This has held precedent in the North Florida Court system! Any and all violations WILL result in legal action being taken and excuses!Contractor &/or owner shall verify all dimensions, details, & specifications prior to construction. Every attempt has been made to avoid mistakes. The contractor and the owners also fully acknowledge that they have full copyright release approval and designs for Livings LLC nor R.E. Chip Mitchell shall not be liable for error for copyright infringement or other errors after delivery via email of drawings including after construction has begun!

BUILT BY:
Alexis Builders, Inc.
5663 Baxter Lake Drive
Jacksonville, FL 32258
CGC062236


PROJECT DESCRIPTION:
**THE MERRITTI
3647 WEST
FLEMING ISL**

Drawings provided by:
designs for living, LLC
RESIDENTIAL DESIGN & CONSULTING
SINCE 1969
SERVING N/E FLORIDA SINCE 1978
904-730-7135

DATE:

SCALE:

SHEET: A-4

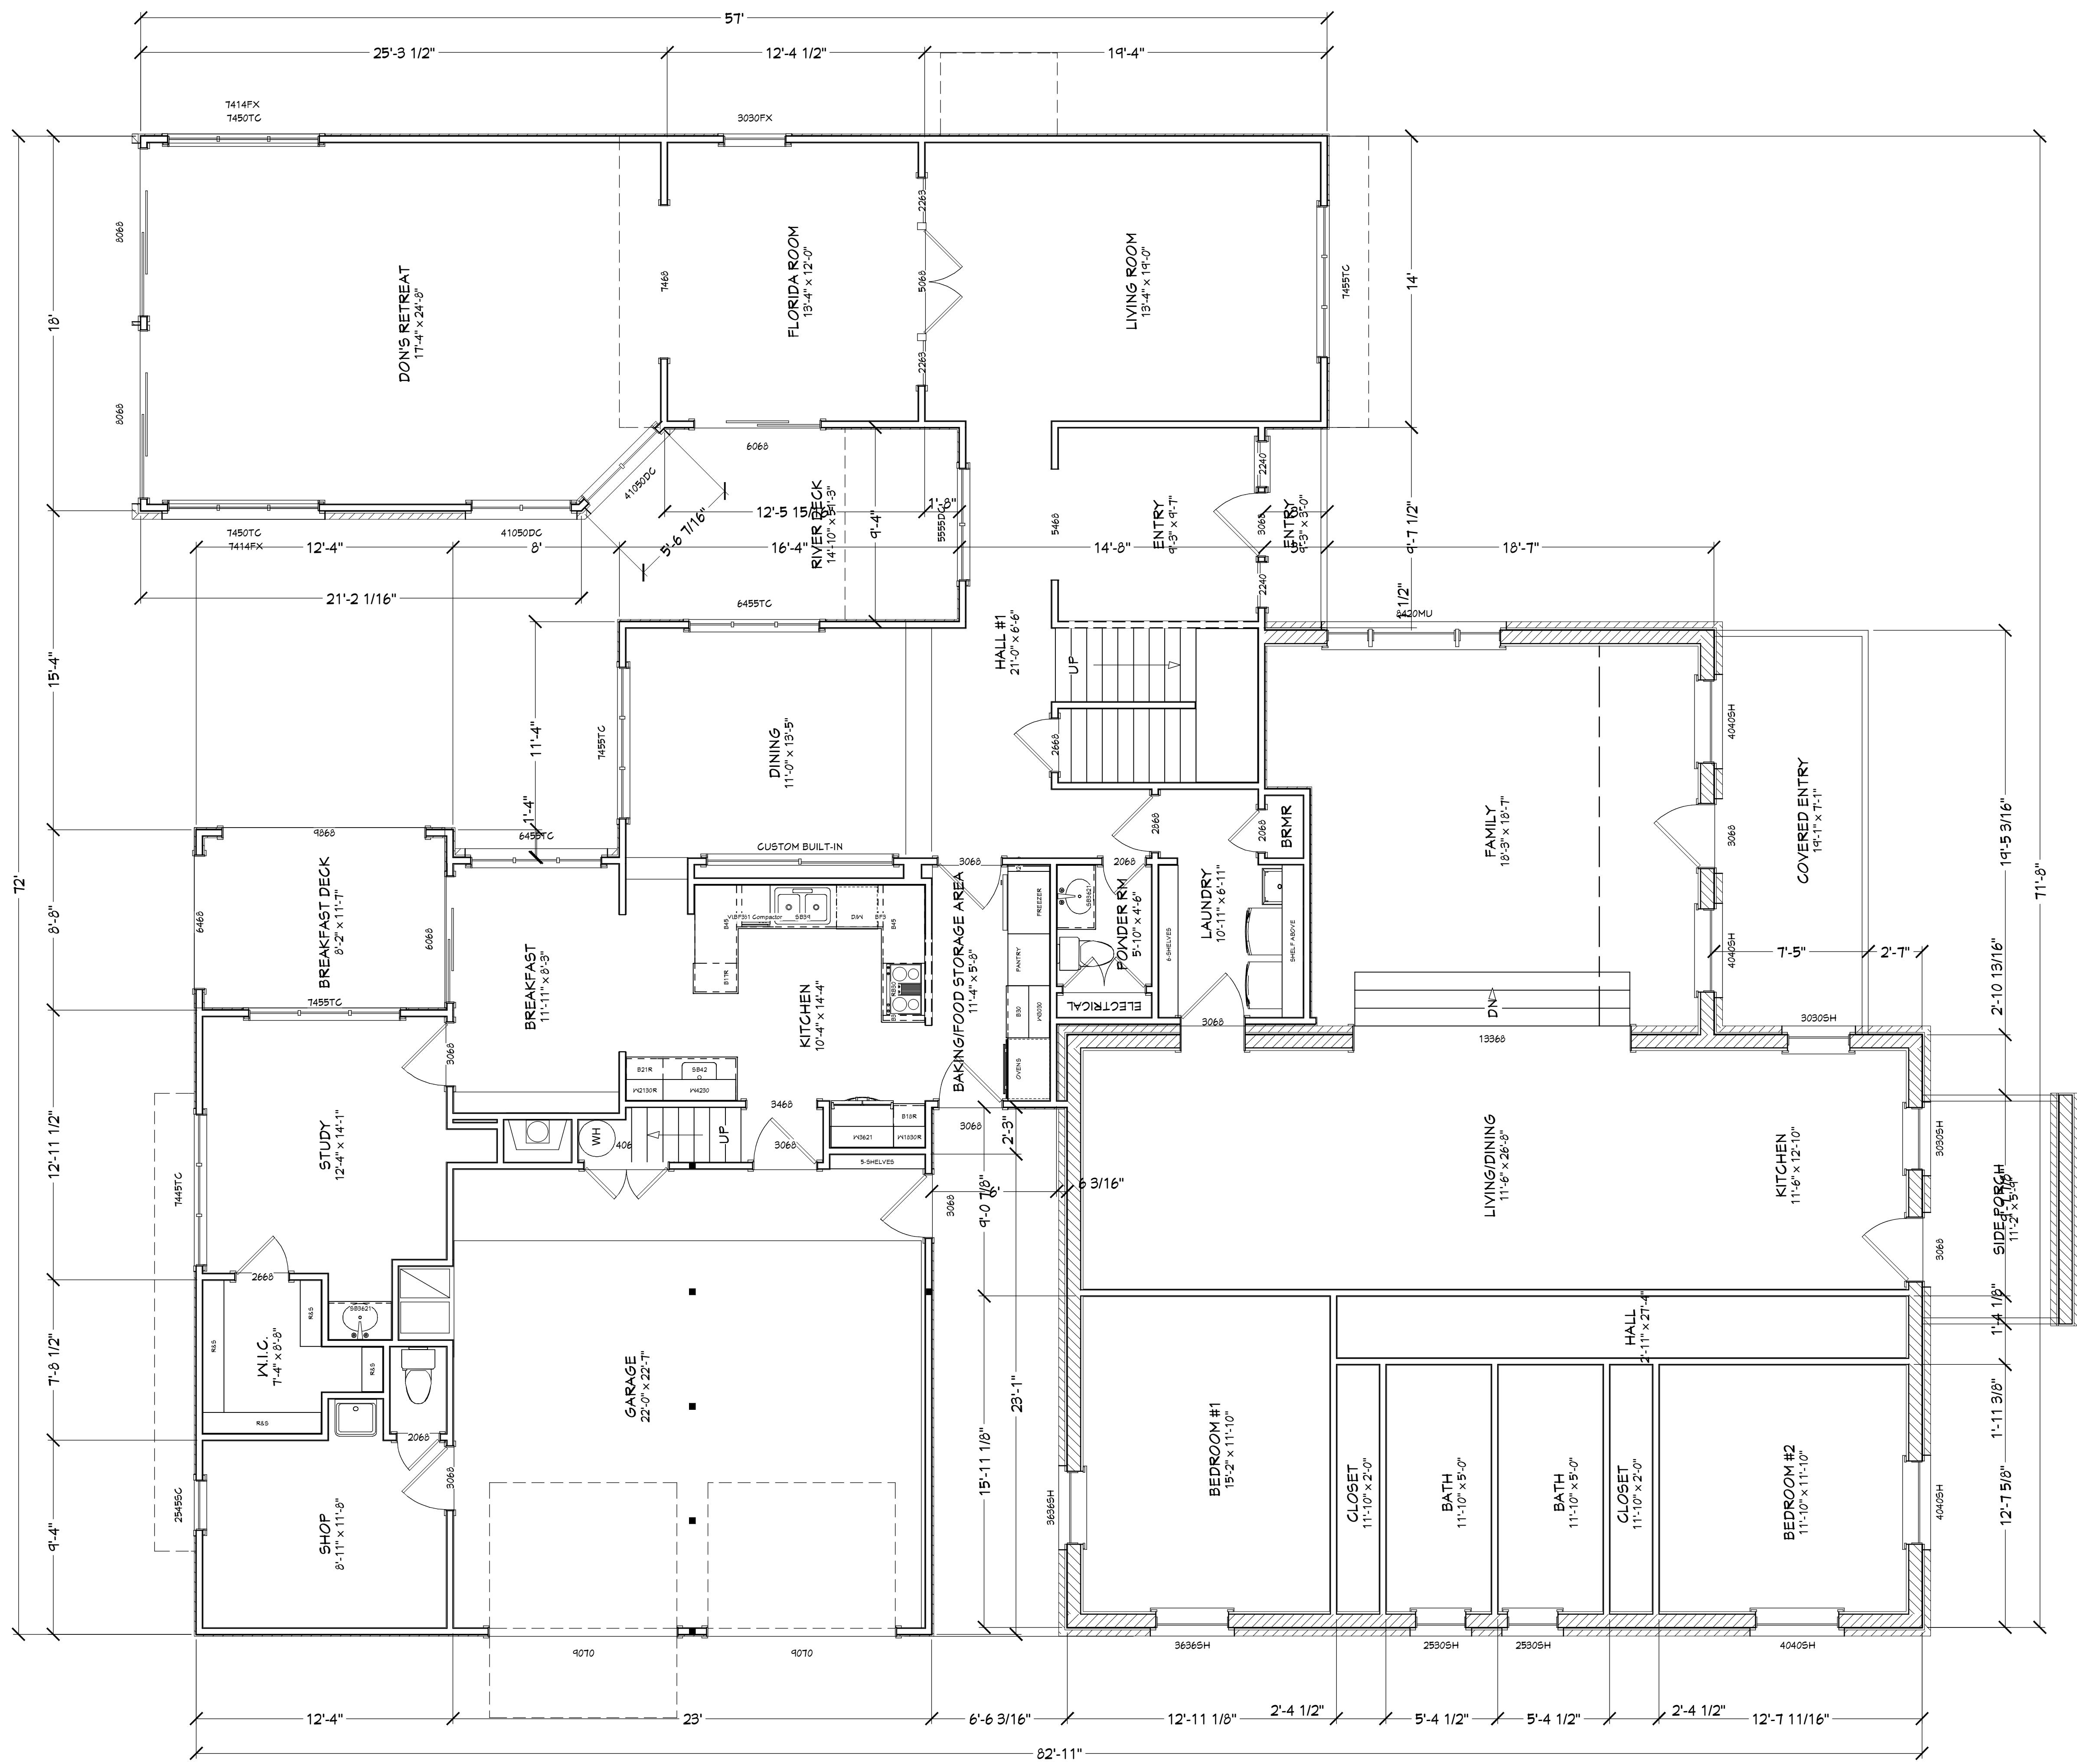

AS-BUILT 1ST FLOOR PLAN

PLAN # 3647

5490 of the Architectural Drawing Act & Title 17 specific tacit copyright laws apply to all published works of Designs for Living, LLC, herein referred to as Designer. It is unlawful for anyone to copy these drawings, either in whole or in part, without the express electronic or hard copy prints shall be restricted to the original site for which they were prepared and publication thereof is expressly limited to such use. Title to all works, specifically all drawings, specifications, and modified derivatives of any blueprints, e-files, or their purchase constitutes prima facie evidence of the acceptance of these restrictions! This has held precedent in the North Florida Court system! Any and all violations WILL result in legal action being taken and excuses! Contractor &/or owner shall verify all dimensions, details, & specifications prior to construction. Every attempt has been made to avoid mistakes. The contractor and the owners also fully acknowledge that they have full copyright release approval and signs for Livesigns LLC nor R.E. Chip Mitchell shall not be liable for error for copyright infringement or other errors after delivery via email of drawings including after construction has begun!

Axius Builders, Inc.
Baxter Lake Drive
Sonville, FL 322258
CGC0622236


PROJECT DESCRIPTION:
THE MERRITT FAMILY HOME
3647 WESTOVER ROAD
FLEMING ISLAND, FL 32003

Drawings provided by:
designs for living, LLC
RESIDENTIAL DESIGN & CONSULTING
SINCE 1969
SERVING N/E FLORIDA SINCE 1978
904-730-7135

DATE:
10/20/2015


SCALE:

SHEET: A - 5

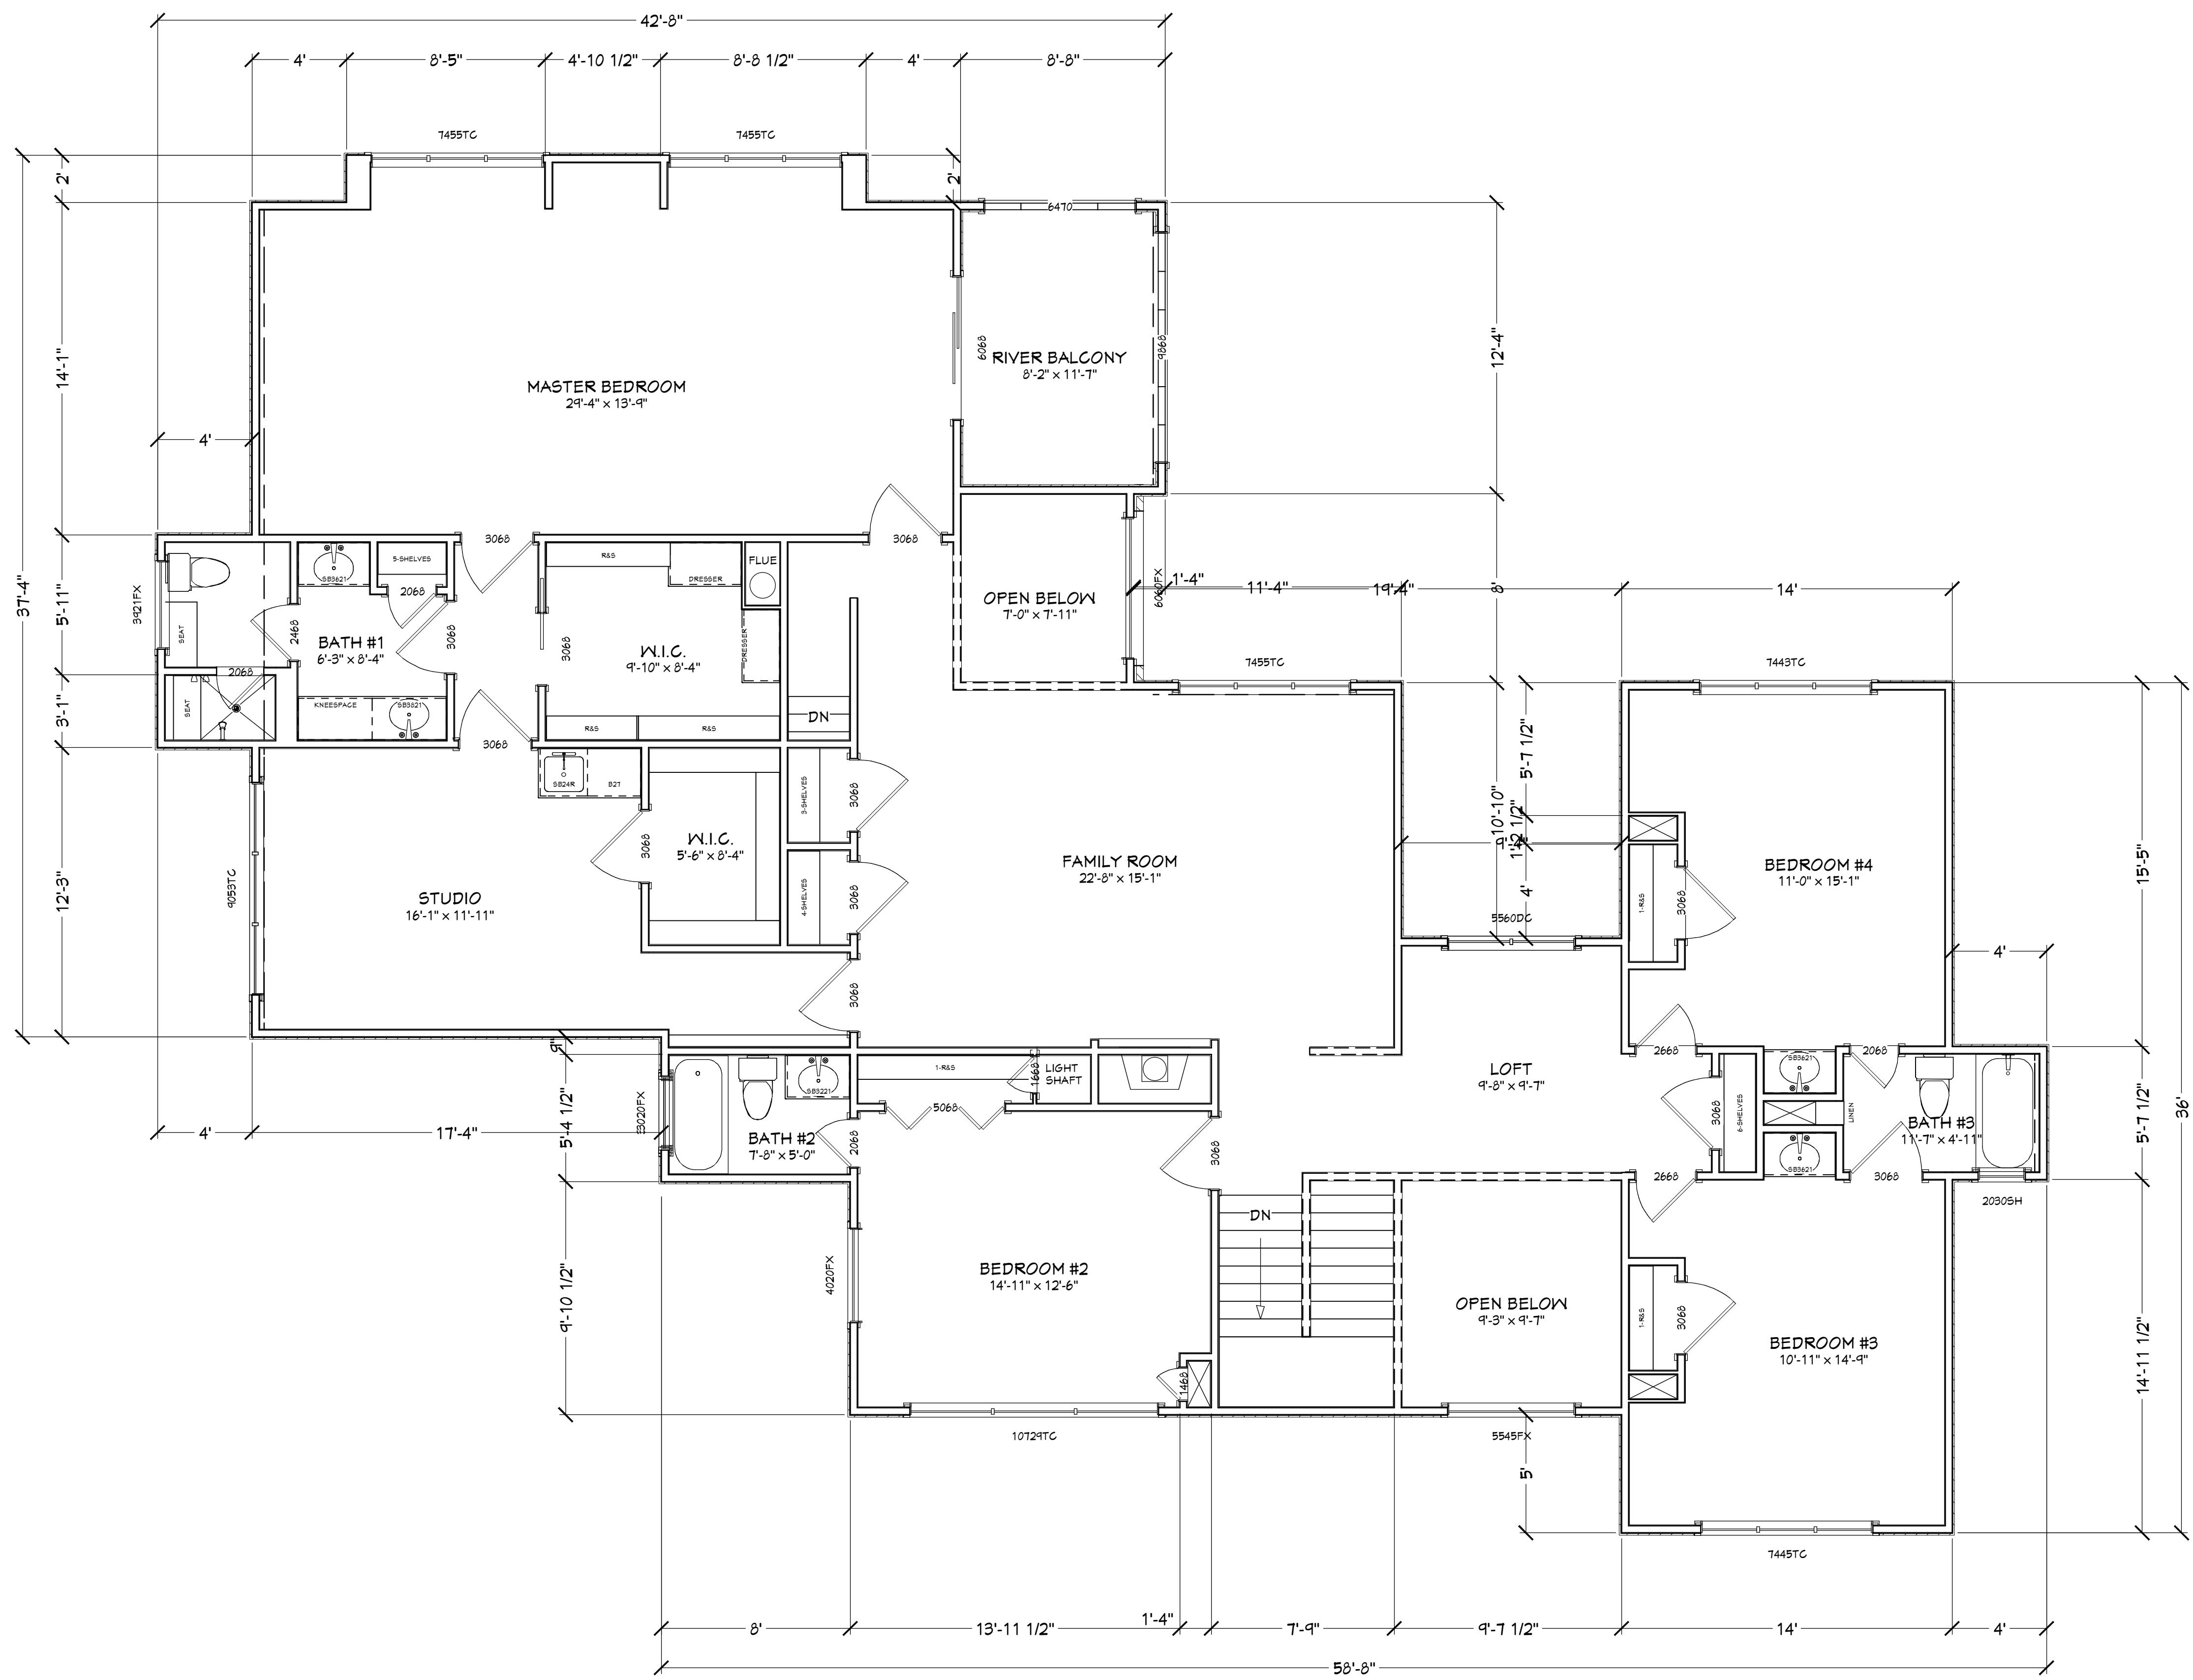

AS-BUILT 2ND FLOOR PLAN

PLAN #
3647

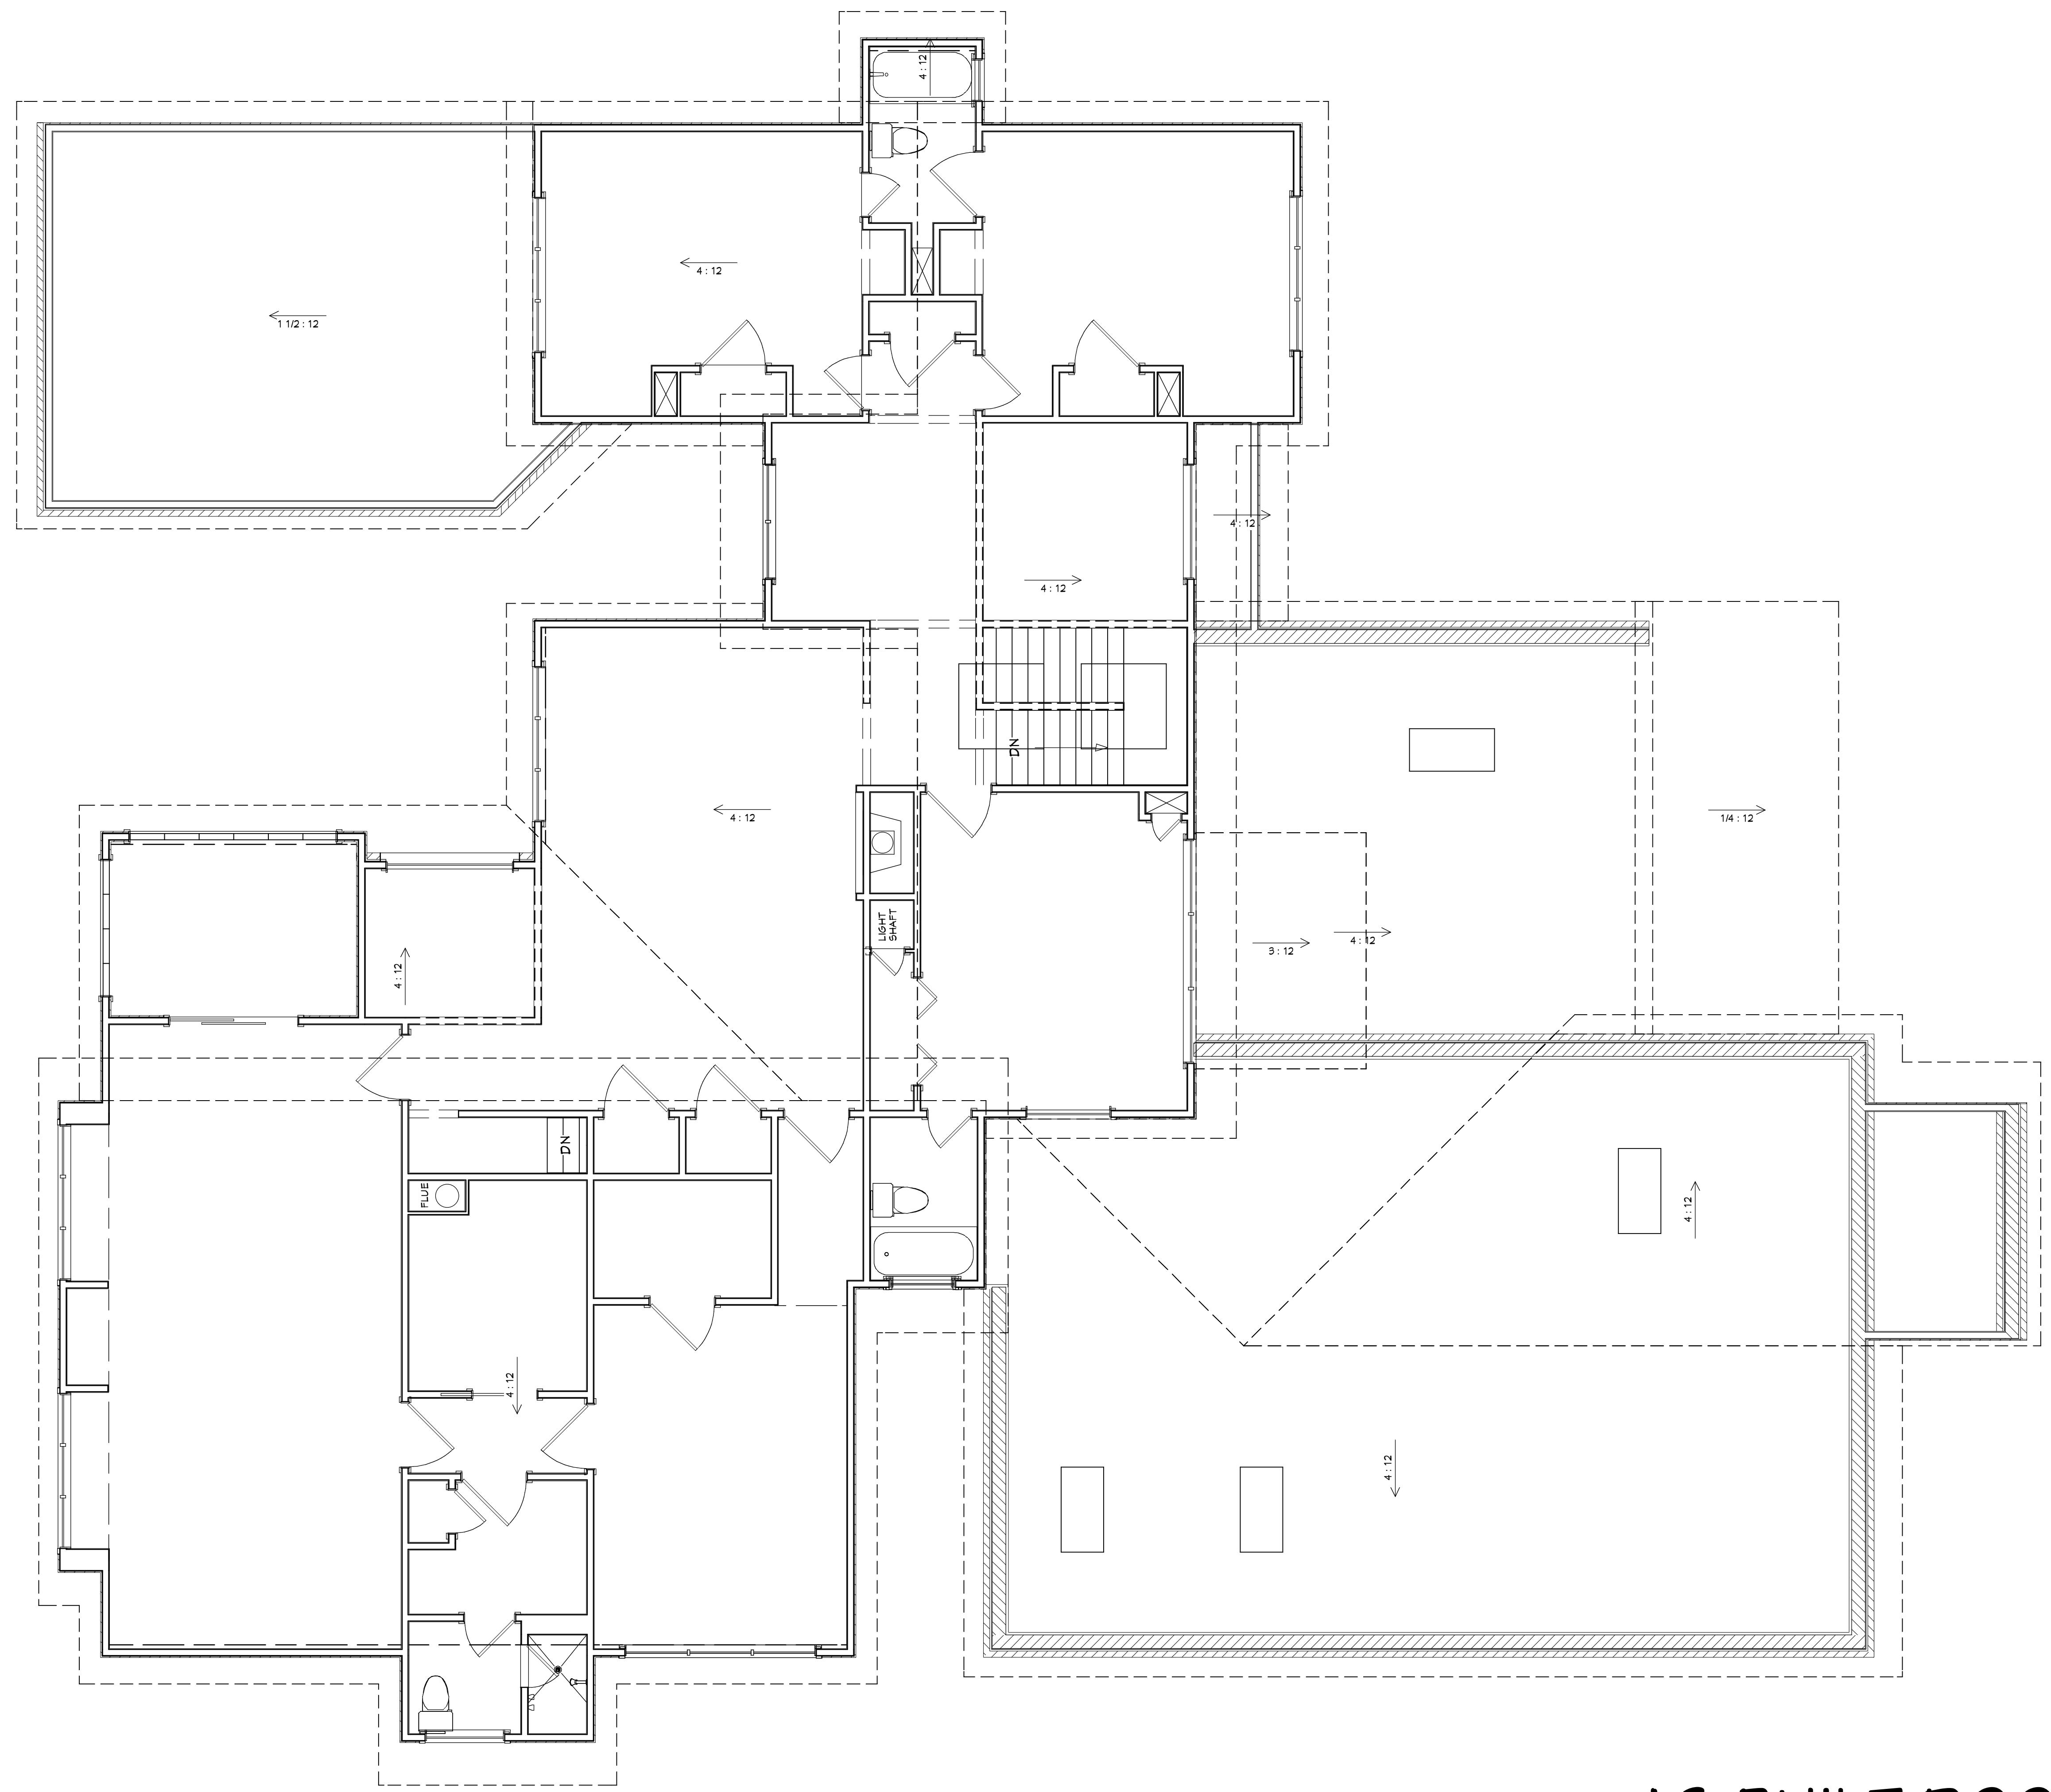

AS-BUILT ROOF PLAN

COPYRIGHT 2015 - DESIGNS FOR LIVING, LLC. Under Federal Statute HR 5490 of the Architectural Drawing Act & Title 17 specific copyright laws apply to all published works of Designs for Living, LLC, herein referred to as Designer. It is unlawful for anyone to copy these drawings, either in whole or in part, without the express written permission of the designer! The use of any plans, specifications, electronic or hard copy prints shall be restricted to the original site for which they were prepared and publication thereof is expressly limited to such use. Title to all works, specifically all drawings, specifications and modified derivatives of any blueprints, series, drawings or specifications remain the designer's without prejudice. VISUAL CONTACT with any of these drawings, or their purchase, constitutes prima facie evidence of the acceptance of these restrictions! This has held precedent in the North Florida Court system! Any and all violations WILL result in legal action being taken and litigated damages to the full extent allowed by law! No exceptions and no excuses! Contractor &/or owner shall verify all dimensions, details, specifications prior to construction. Every attempt has been made to avoid mistakes. The contractor and the owners also fully acknowledge that they have full copyright release approval and liability for errors in the drawings. C. Nor. R.E. Chip Mitchell shall not be liable for error for copyright infringement or other errors after delivery via email or drawings, including after construction has begun!

BUILT BY:	Alexis Builders, Inc.
PROJECT DESCRIPTION:	THE MERRITT FAMILY HOME 3647 WESTOVER ROAD FLEMING ISLAND, FL 32003
DATE:	10/20/2015
SCALE:	1/4" = 1'-0"
SHEET:	A-6
NO.	DESCRIPTION
	BY DATE

Designs for Living, LLC
RESIDENTIAL DESIGN & CONSULTING
SERVING N/E FLORIDA SINCE 1969
904-730-7135

PLAN #
3647

NO.	DESCRIPTION	BY	DATE

BUILT BY:
Alexis Builders, Inc.
5663 Baxter Lake Drive
Jacksonville, FL 32258
CGC062236

PROJECT DESCRIPTION:
THE MERRITT FAMILY HOME
3647 WESTOVER ROAD
FLEMING ISLAND, FL 32003


Bid Drawings provided by:
Designs for Living, LLC
RESIDENTIAL DESIGN & CONSULTING
SERVING N/E FLORIDA SINCE 1978
904-730-7135

DATE: 10/20/2015
SCALE: 1/4" = 1'-0"
SHEET: A-7

COPYRIGHT 2015 - DESIGNS FOR LIVING, LLC. Under Federal Statute HR 5490 of the Architectural Drawing Act & Title 17 specific copyright laws apply to all published works of Designs for Living, LLC, herein referred to as Designer. It is unlawful for anyone to copy these drawings, either in whole or in part, without the express written permission of the Designer! The use of any plans, specifications, electronic or hard copy prints shall be restricted to the original site for which they were prepared and publication thereof is expressly limited to such use. Title to all works, specifically all drawings, specifications and modified derivatives of any blueprints, series, drawings or specifications remain the Designers without prejudice. VISUAL CONTACT with any of these drawings, or their purchase, constitutes prima facie evidence of the acceptance of these restrictions! This has held precedent in the North Florida Court system! Any and all violations WILL result in legal action being taken and litigated damages to the full extent allowed by law! No exceptions and no excuses! Contractor &/or owner shall verify all dimensions, details & specifications prior to construction. Every attempt has been made to avoid mistakes. The contractor and the owners also fully acknowledge that they have fully acknowledged that they have full copyright release approval and that they have fully acknowledged that they have full copyright release approval after construction has begun!



Exterior Elevation Left

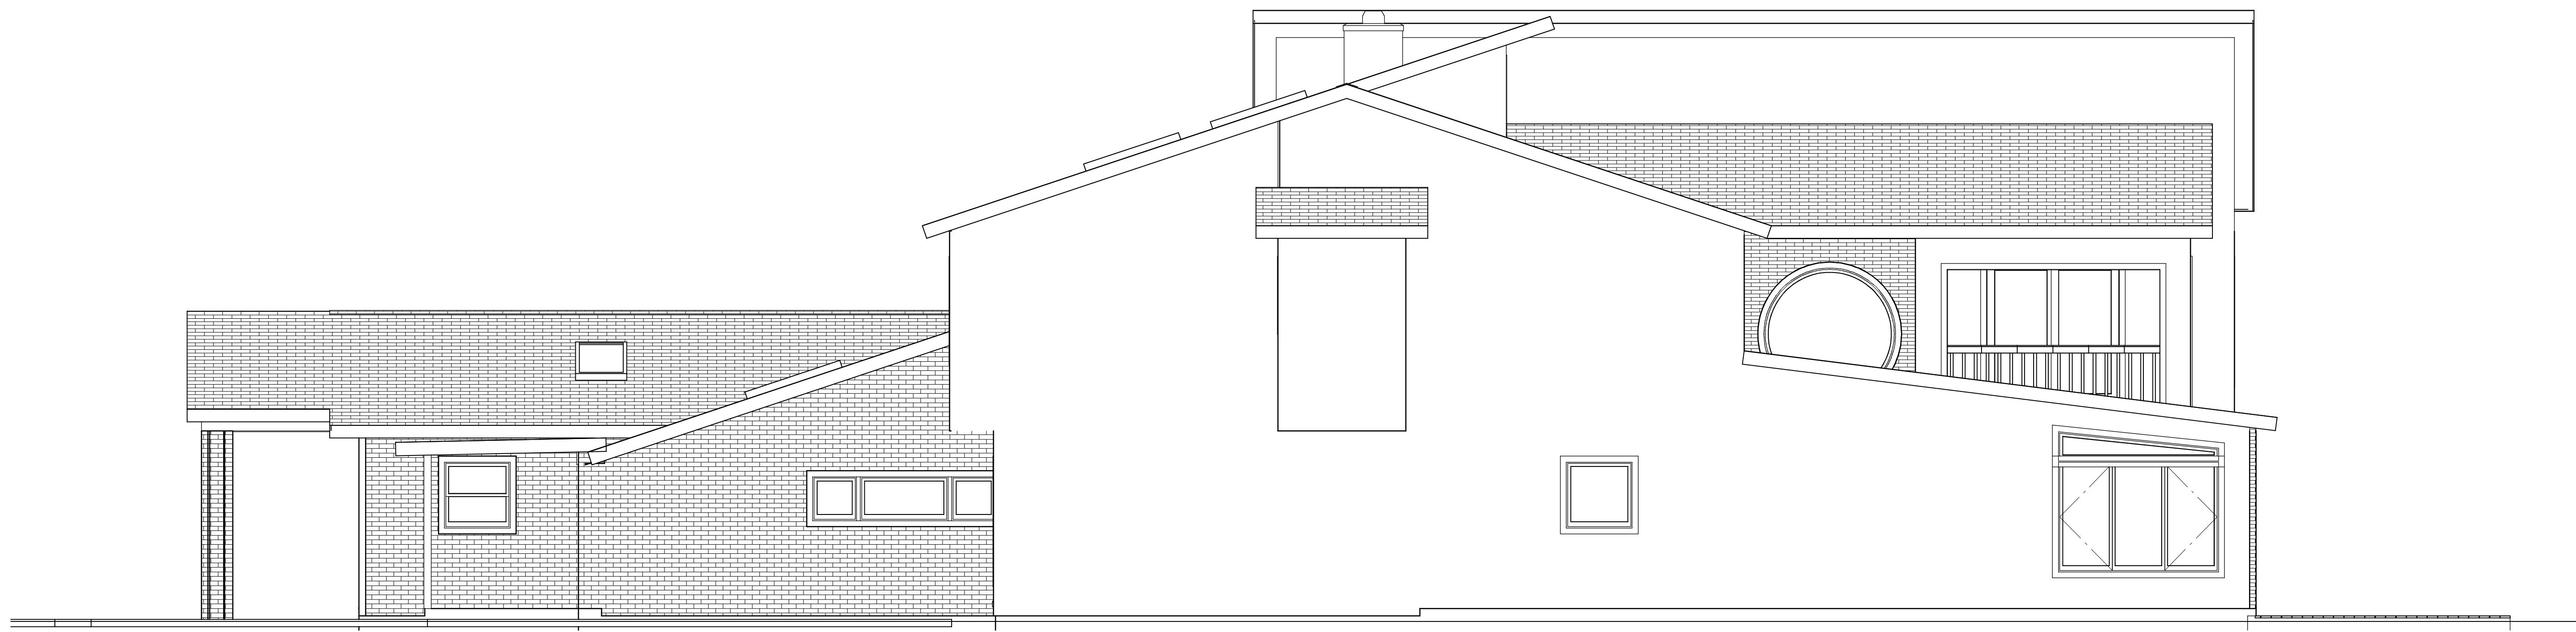

Exterior Elevation Right

AS-BUILT SIDE ELEVATIONS

PLAN #
3647



Exterior Elevation Front



Exterior Elevation Back

AS-BUILT FRONT/REAR ELEVATIONS

COPYRIGHT 2015 - DESIGNS FOR LIVING, LLC. Under Federal Statute HR 5490 of the Architectural Drawing Act & Title 17 specific copyright laws apply to all published works of Designs for Living, LLC, herein referred to as Designer. It is unlawful for anyone to copy these drawings, either in whole or in part, without the express written permission of the designer! The use of any plans, specifications, electronic or hard copy prints shall be restricted to the original site for which they were prepared and publication thereof is expressly limited to such use. Title to all works, specifically all drawings and modified derivatives of any blueprints, series, drawings or specifications remain the designer's without prejudice. VISUAL CONTACT with any of these drawings, or their purchase, constitutes prima facie evidence of the acceptance of these restrictions! This has held precedent in the North Florida Court system! Any and all violations WILL result in legal action being taken and litigated damages to the full extent allowed by law! No exceptions and no excuses! Contractor &/or owner shall verify all dimensions, details & specifications prior to construction. Every attempt has been made to avoid mistakes. The contractor and the owners also fully acknowledge that they have fully acknowledged that they have full copyright release approval and that they have fully acknowledged that they have begun!

NO.	DESCRIPTION	BY	DATE

BUILT BY:	Alexis Builders, Inc. 5663 Baxter Lake Drive Jacksonville, FL 32258 CGC062236
-----------	--

PROJECT DESCRIPTION:	THE MERRITT FAMILY HOME 3647 WESTOVER ROAD FLEMING ISLAND, FL 32003
----------------------	---

Bid Drawings provided by:	Designs for Living, LLC RESIDENTIAL DESIGN & CONSULTING SERVING N/E FLORIDA SINCE 1978 904-730-7135
---------------------------	--

DATE:	10/20/2015
SCALE:	1/4" = 1'-0"
SHEET:	A-8

PLAN #
3647

NO.	DESCRIPTION	BY	DATE

BUILT BY:
Alexis Builders, Inc.
5663 Baxter Lake Drive
Jacksonville, FL 32258
CGC062236

PROJECT DESCRIPTION:
THE MERRITT FAMILY HOME
3647 WESTOVER ROAD
FLEMING ISLAND, FL 32003



Bid Drawings provided by:
Designs for Living, LLC
RESIDENTIAL DESIGN & CONSULTING
SERVING N/E FLORIDA SINCE 1978
904-730-7135

DATE:
10/20/2015

SCALE:
N.T.S.

SHEET:
A-9

COPYRIGHT 2015 - DESIGNS FOR LIVING, LLC. Under Federal Statute HR 5490 of the Architectural Drawing Act & Title 17 specific copyright laws apply to all published works of Designs for Living, LLC, herein referred to as Designer. It is unlawful for anyone to copy these drawings, either in whole or in part, without the express written permission of the designer! The use of any plans, specifications, electronic or hard copy prints shall be restricted to the original site for which they were prepared and publication thereof is expressly limited to such use. Title to all works, specifically all drawings, specifications and modifications thereto is retained by the designer. Any and all violations WILL result in legal action being taken and drawings or specifications remain the designers without prejudice. VISUAL CONTACT with any of these drawings, or their purchase, constitutes prima facie evidence of the acceptance of these restrictions! This has held precedent in the North Florida Court system! Any and all violations WILL result in legal action being taken and the contractor and the owners also fully acknowledge that they have full copyright release approval and mitigated damages to the full extent allowed by law! No exceptions and no excuses! Contractor &/or owner shall verify all dimensions, details & specifications prior to construction. Every attempt has been made to avoid mistakes. The contractor and the owners also fully acknowledge that they have full copyright release approval and mitigated damages to the full extent allowed by law! No exceptions and no excuses! Contractor &/or owner shall not be liable for error for copyright infringement or other errors after delivery via email or drawings, including after construction has begun!

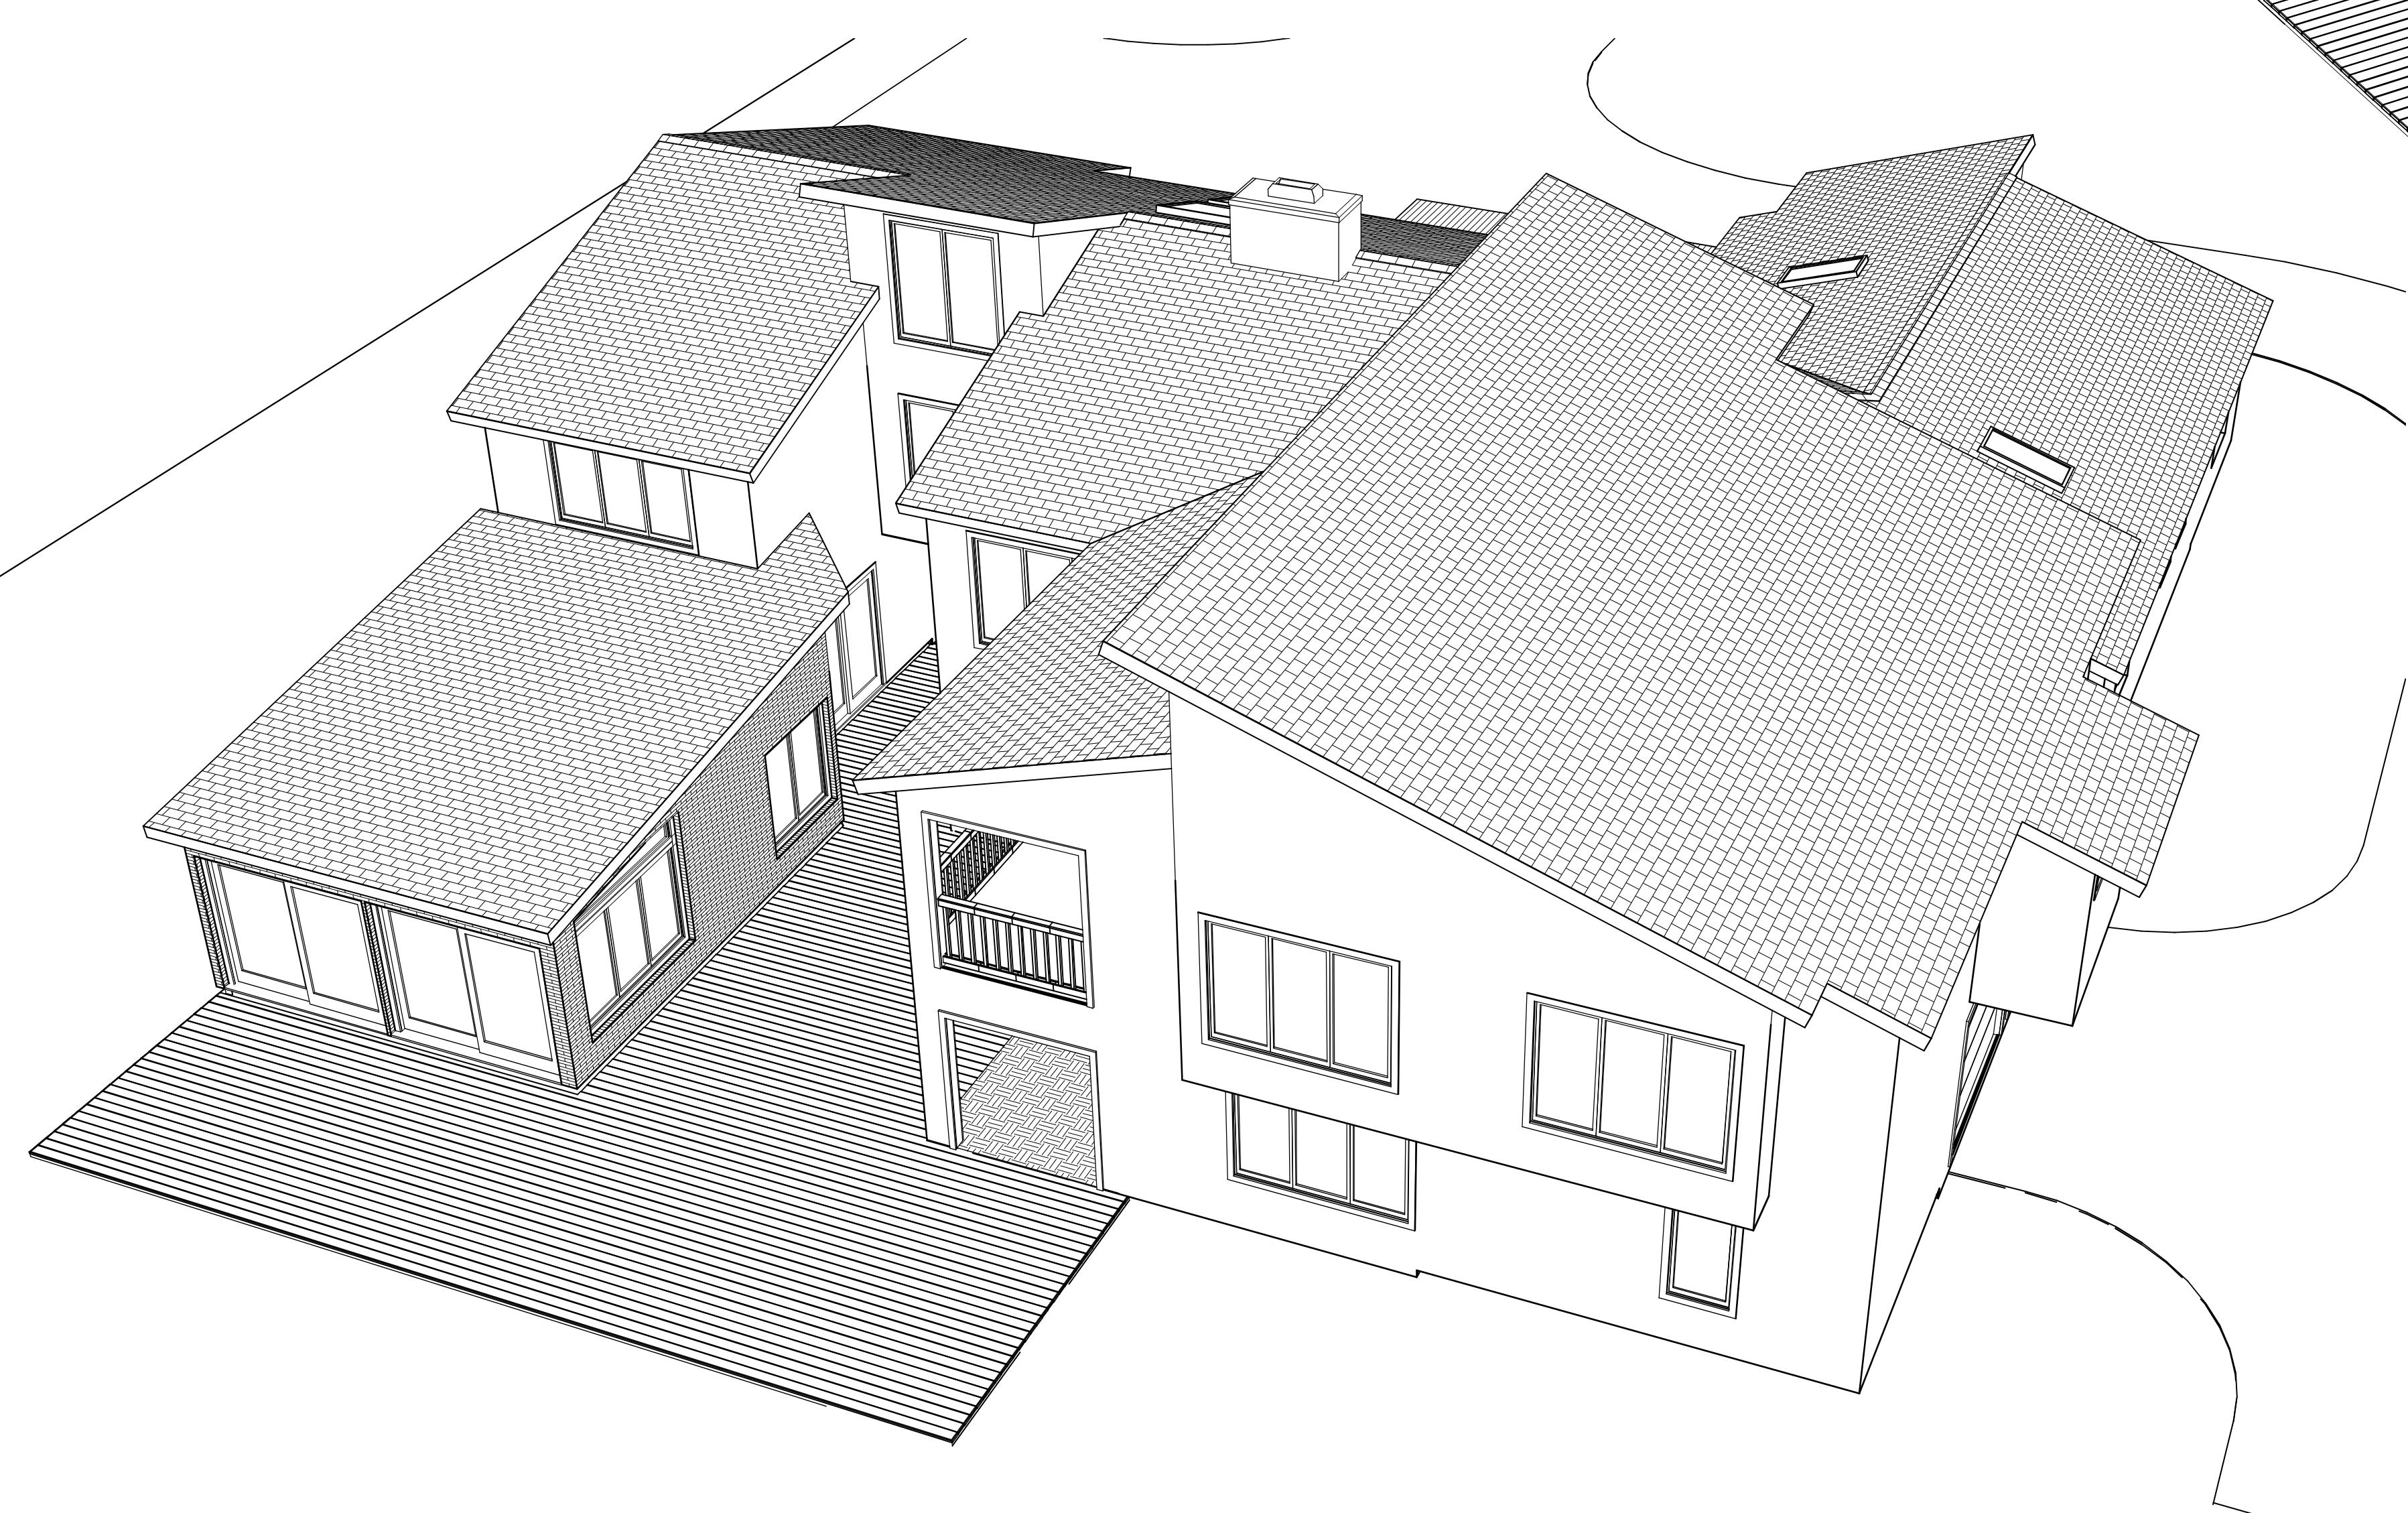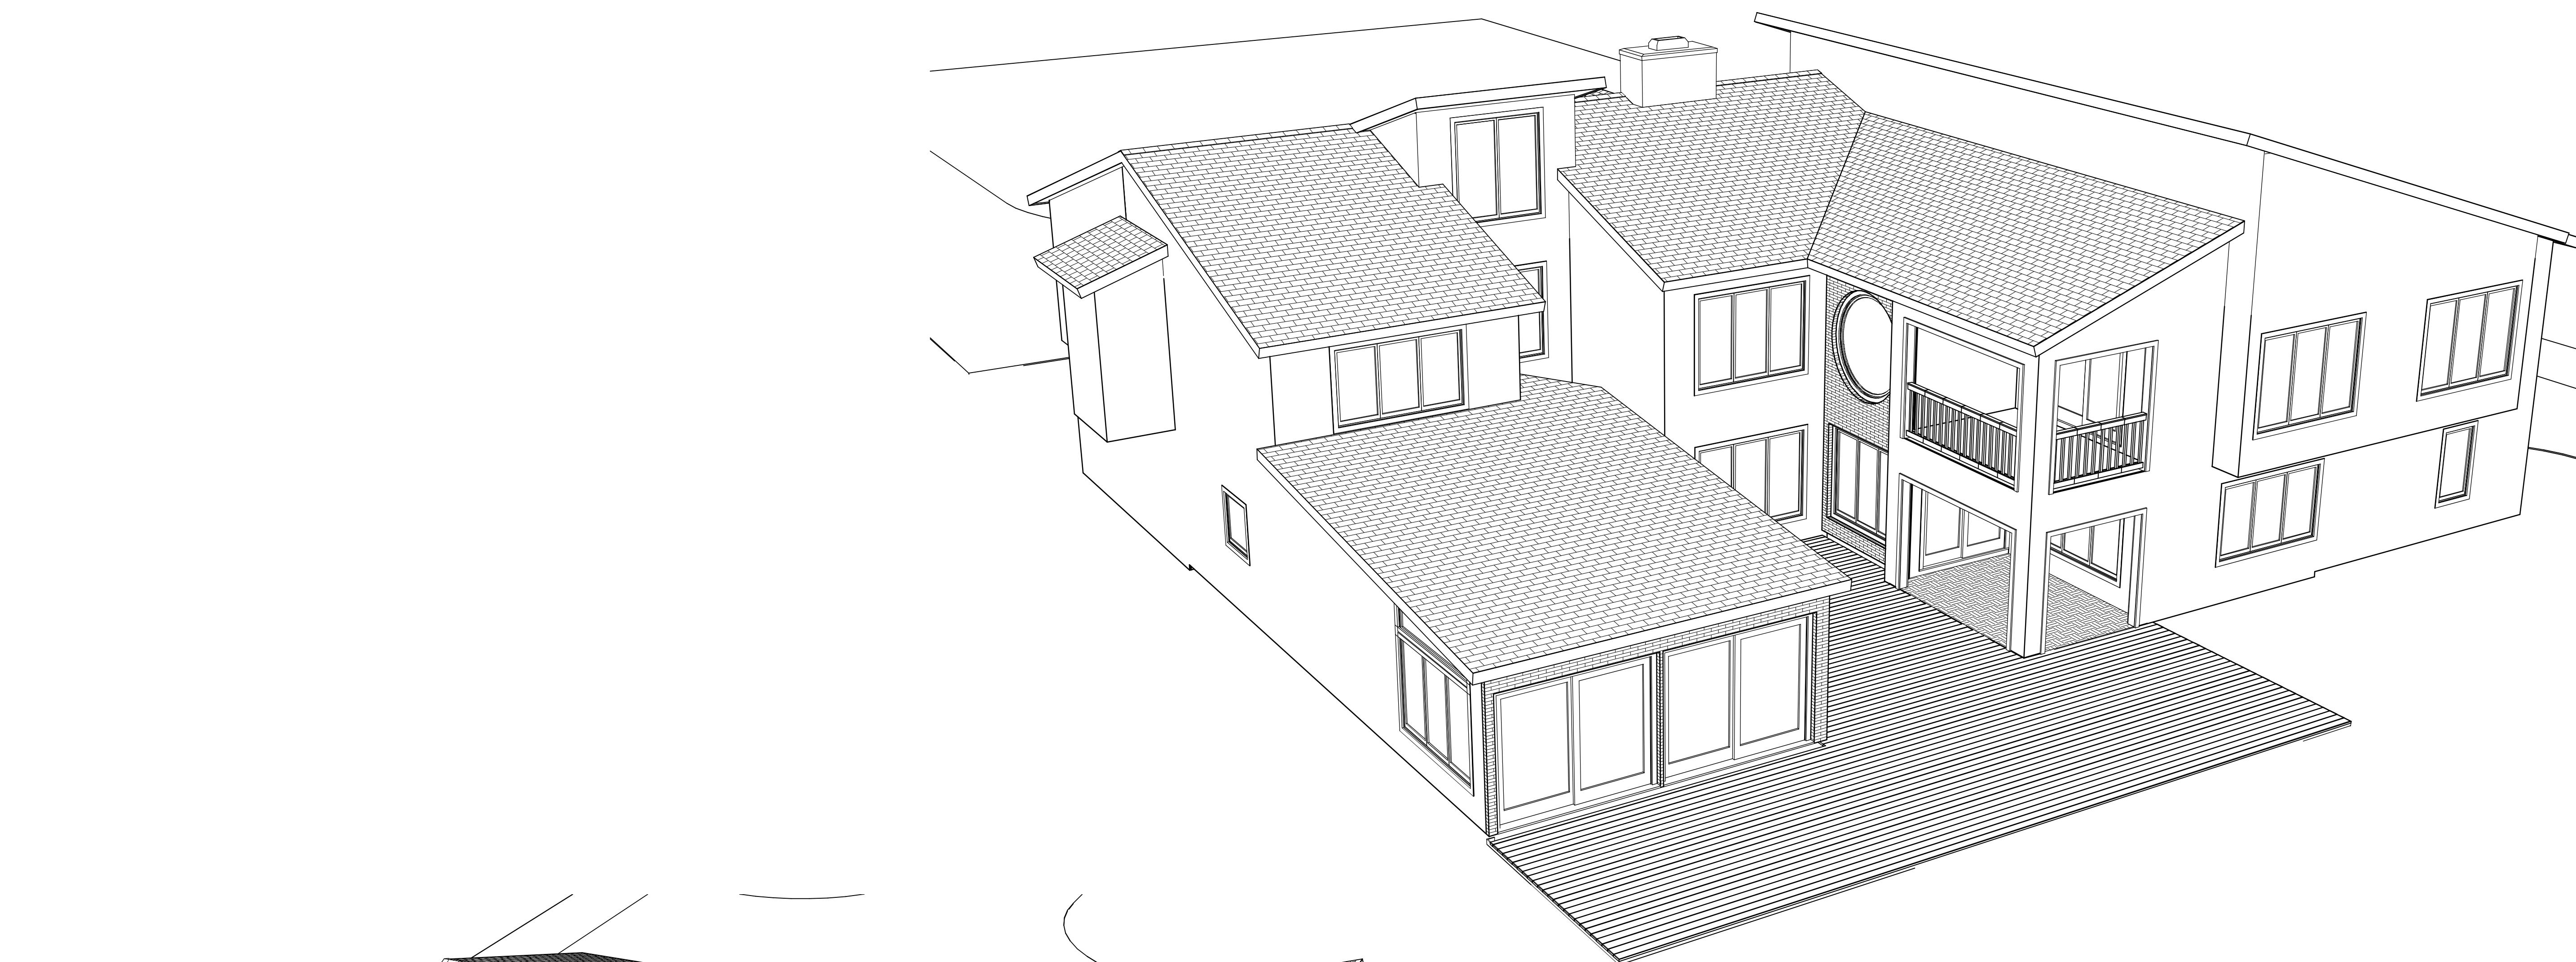

AS-BUILT ISOMETRICS

PLAN # 3647


BUILT BY:
Alexis Builders, Inc.
5663 Baxter Lake Drive
Jacksonville, FL 32258
CGC062236

PROJECT DESCRIPTION:
THE MERRITT FAMILY HOME
3647 WESTOVER ROAD
FLEMING ISLAND, FL 32003


Bid Drawings provided by:
Designs for Living, LLC
RESIDENTIAL DESIGN & CONSULTING
SERVING N/E FLORIDA SINCE 1978
904-730-7135

DATE:	10/20/2015
SCALE:	1/4" = 1'-0"
SHEET:	A-10

COPYRIGHT 2015 - DESIGNS FOR LIVING, LLC. Under Federal Statute HR 5490 of the Architectural Drawing Act & Title 17 specific tract copyright laws apply to all published works of Designs for Living, LLC, herein referred to as Designer. It is unlawful for anyone to copy these drawings, either in whole or in part, without the express written permission of the designer! The use of any plans, specifications, electronic or hard copy prints shall be restricted to the original site for which they were prepared and publication thereof is expressly limited to such use. Title to all works, specifically all drawings and modified derivatives of any blueprints, series, drawings or specifications remain the designer's without prejudice. VISUAL CONTACT with any of these drawings, or their purchase, constitutes prima facie evidence of the acceptance of these restrictions! This has held precedent in the North Florida Court system! Any and all violations WILL result in legal action being taken and litigated damages to the full extent allowed by law! No exceptions and no excuse! Contractor &/or owner shall verify all dimensions, details & specifications prior to construction. Every attempt has been made to avoid mistakes. The contractor and the owners also fully acknowledge that they have full copyright release approval and liability released.

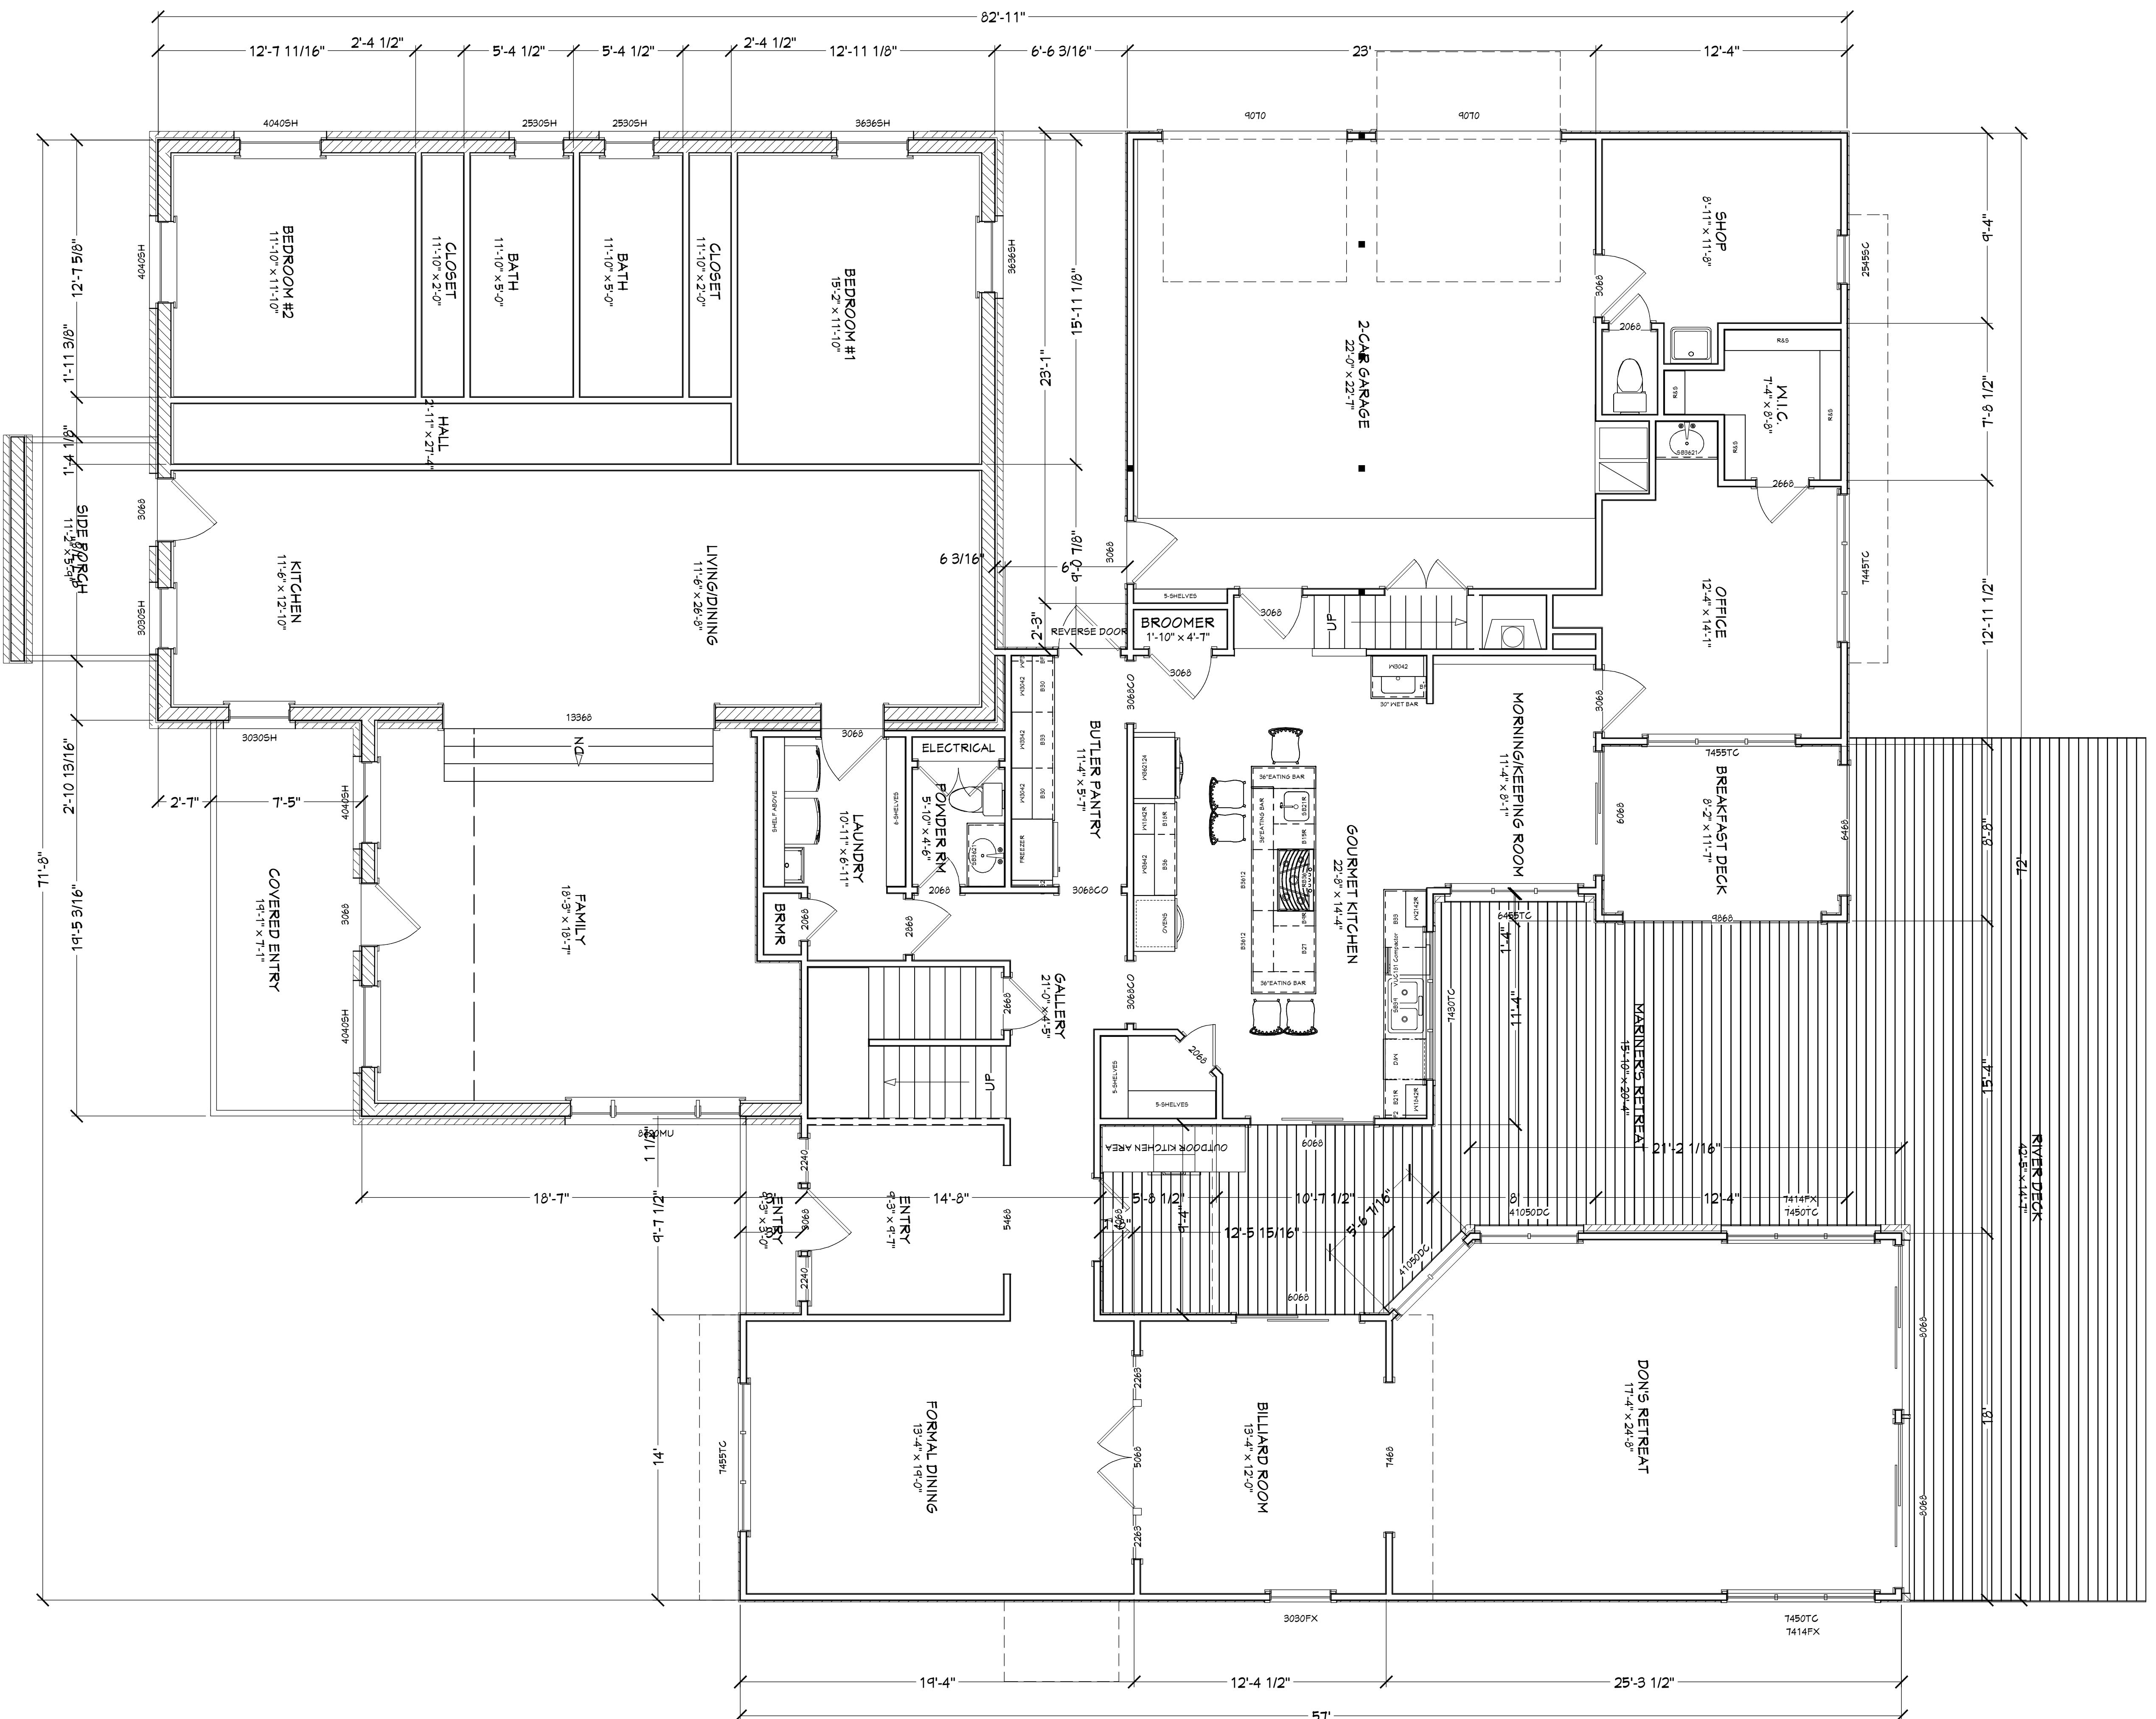

PLAN # 3647

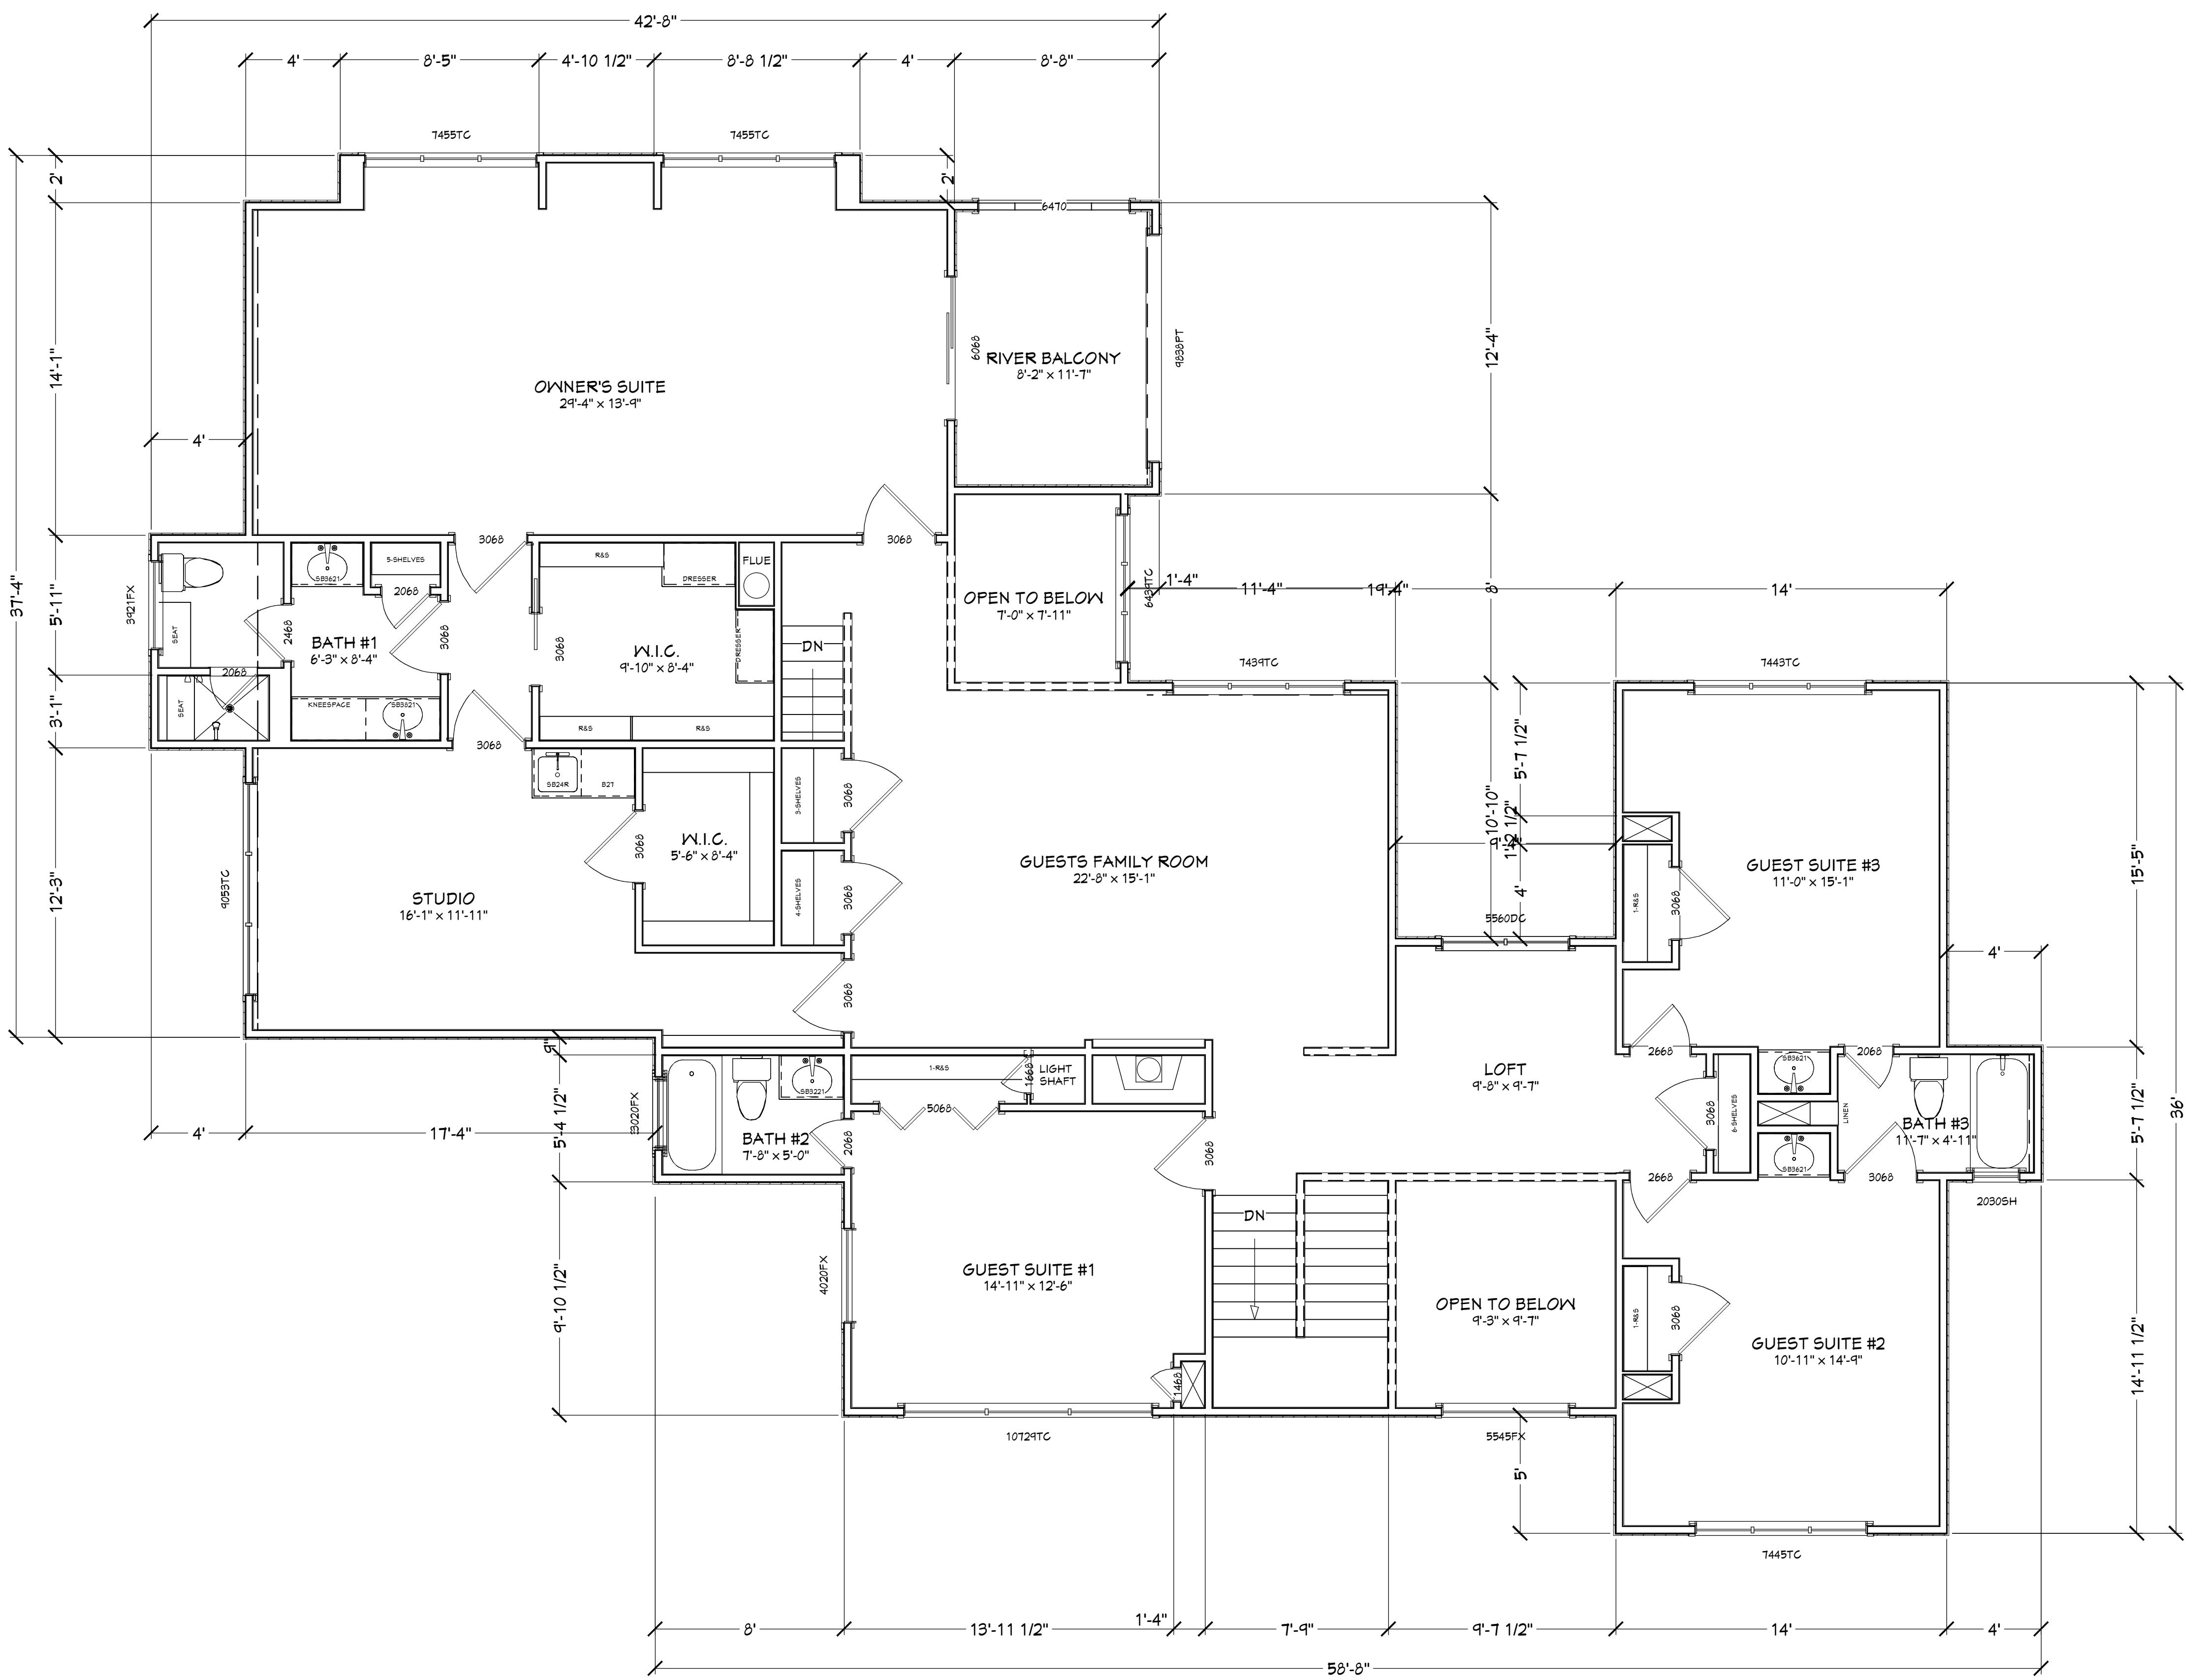

COPYRIGHT 2015 - DESIGNS FOR LIVING, LLC. Under Federal Statute HR 5490 of the Architectural Drawing Act & Title 17 specific, tacit copyright laws apply to all published works of Designs for Living, LLC, herein referred to as Designer. It is unlawful for anyone to copy these drawings, either in whole or in part, without the express written permission of the designer! The use of any plans, specifications, electronic or hard copy prints shall be restricted to the original site for which they were prepared and publication thereof is expressly limited to such use. Title to all works, specifically all drawings, specifications, and modified derivatives of any blueprints, series, drawings, or specifications remain the designer's without prejudice. VISUAL CONTACT with any of these drawings, or their purchase, constitutes prima facie evidence of the acceptance of these restrictions! This has held precedent in the North Florida Court system! Any and all violations WILL result in legal action being taken and litigated damages to the full extent allowed by law! No exceptions and no excuse! Contractor &/or owner shall verify all dimensions, details, specifications prior to construction. Every attempt has been made to avoid mistakes. The contractor and the owners also fully acknowledge that they have full copyright release approval and liability released.

Designs for Living, LLC
RESIDENTIAL DESIGN & CONSULTING
SERVING N/E FLORIDA SINCE 1978
904-730-7135

PROJECT DESCRIPTION:
**THE MERRITT FAMILY HOME
3647 WESTOVER ROAD
FLEMING ISLAND, FL 32003**

Bid Drawings provided by:
**Designs for Living, LLC
RESIDENTIAL DESIGN & CONSULTING
SERVING N/E FLORIDA SINCE 1978
904-730-7135**

DATE:
10/20/2015

SCALE:
1/4" = 1'-0"

SHEET:
A-11

PLAN #
3647


NO.	DESCRIPTION	BY	DATE

BUILT BY:
Alexis Builders, Inc.
5663 Baxter Lake Drive
Jacksonville, FL 32258
CGC062236

PROJECT DESCRIPTION:
THE MERRITT FAMILY HOME
3647 WESTOVER ROAD
FLEMING ISLAND, FL 32003

Bid Drawings provided by:
Designs for Living, LLC
RESIDENTIAL DESIGN & CONSULTING
SERVING N/E FLORIDA SINCE 1978
904-730-7135

DATE:
10/20/2015
SCALE:
1/4" = 1'-0"
SHEET:
A-12

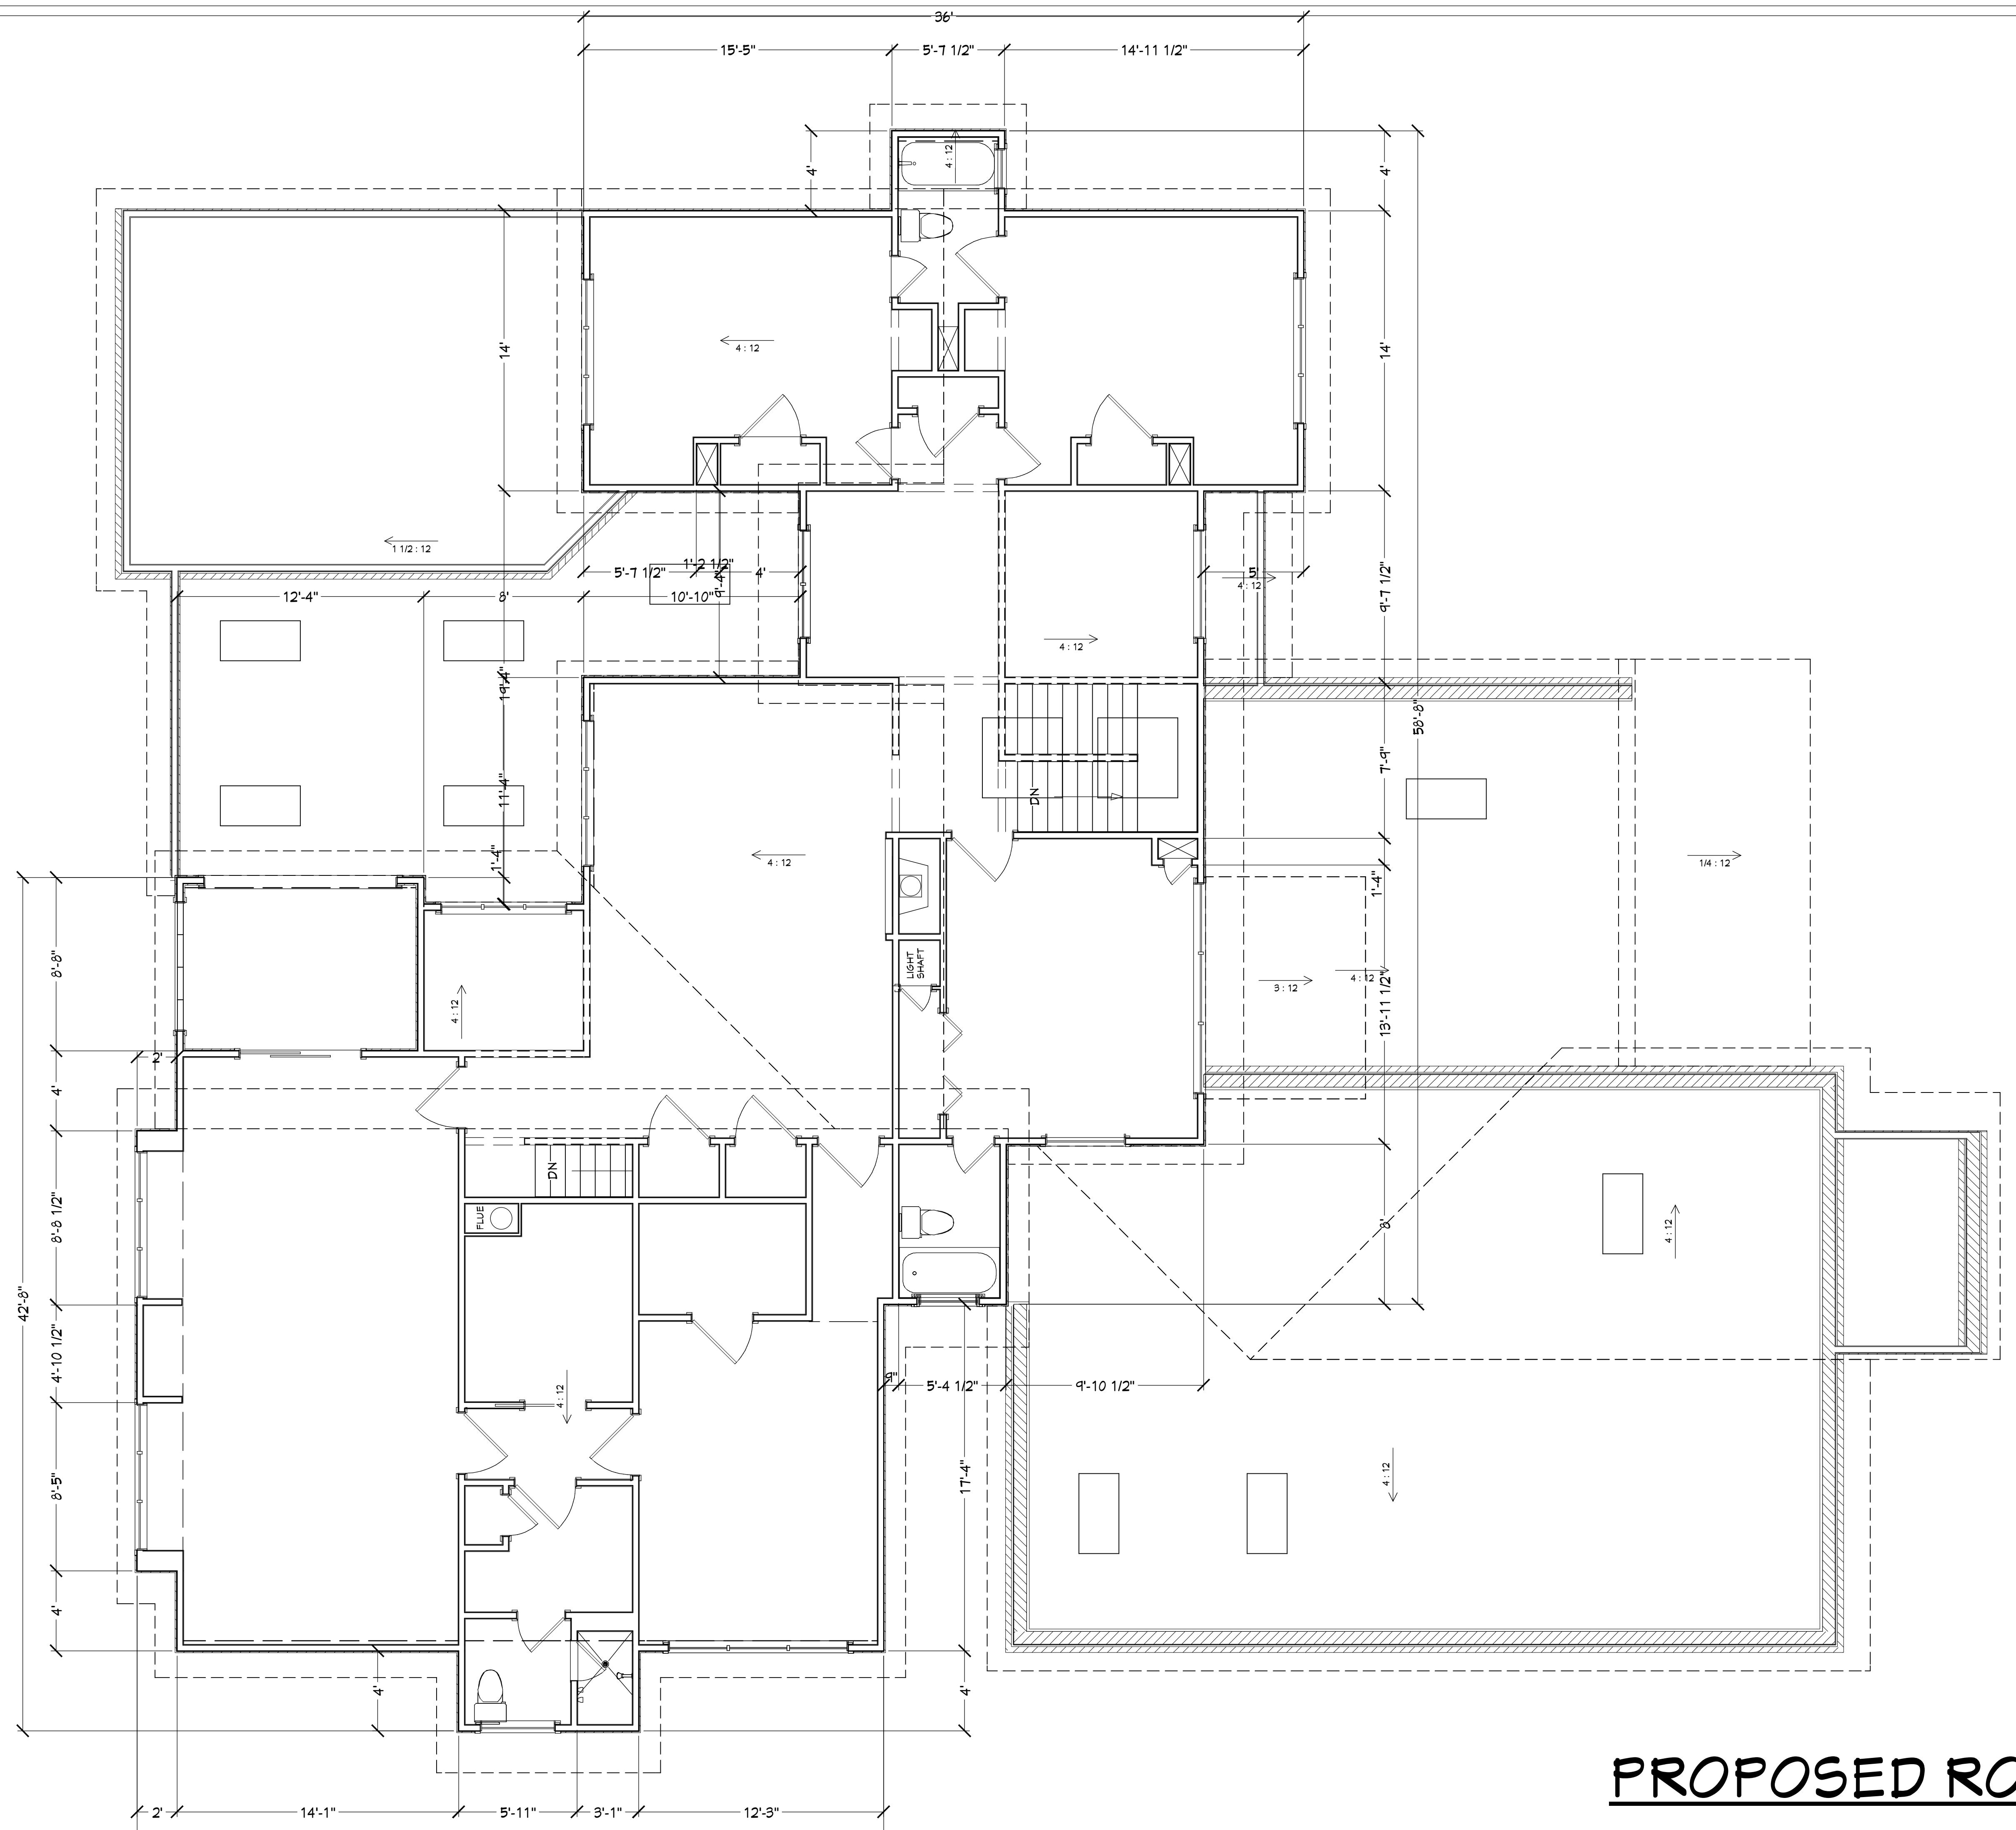

COPYRIGHT 2015 - DESIGNS FOR LIVING, LLC. Under Federal Statute HR 5490 of the Architectural Drawing Act & Title 17 specific copyright laws apply to all published works of Designs for Living, LLC, herein referred to as Designer. It is unlawful for anyone to copy these drawings, either in whole or in part, without the express written permission of the designer! The use of any plans, specifications, electronic or hard copy prints shall be restricted to the original site for which they were prepared and publication thereof is expressly limited to such use. Tie in to works, specifically all drawings, and modified derivatives of any blueprints, series, drawings or specifications remain the Designers without prejudice. VISUAL CONTACT with any of these drawings, or their purchase, constitutes prima facie evidence of the acceptance of these restrictions! This has held precedent in the North Florida Court system! Any and all violations WILL result in legal action being taken and litigated damages to the full extent allowed by law! No exceptions and no excuses! Contractor &/or owner shall verify all dimensions, details & specifications prior to construction. Every attempt has been made to avoid mistakes. The contractor and the owners also fully acknowledge that they have full copyright release approval and liability released for any errors after delivery via email of drawings, including after construction has begun!

PLAN #
3647

NO.	DESCRIPTION	BY	DATE

BUILT BY:
Alexis Builders, Inc.
5663 Baxter Lake Drive
Jacksonville, FL 32258
CGC062236

PROJECT DESCRIPTION:
THE MERRITT FAMILY HOME
3647 WESTOVER ROAD
FLEMING ISLAND, FL 32003

Bid Drawings provided by:
Designs for Living, LLC
RESIDENTIAL DESIGN & CONSULTING
SERVING N/E FLORIDA SINCE 1978
904-730-7135

DATE:
10/20/2015

SCALE:
1/4" = 1'-0"

SHEET:
A-13



Exterior Elevation Back



PROPOSED ELEVATIONS

COPYRIGHT 2015 - DESIGNS FOR LIVING, LLC. Under Federal Statute HR 5490 of the Architectural Drawing Act & Title 17 specific copyright laws apply to all published works of Designs for Living, LLC, herein referred to as Designer. It is unlawful for anyone to copy these drawings, either in whole or in part, without the express written permission of the Designer! The use of any plans, specifications, electronic or hard copy prints shall be restricted to the original site for which they were prepared and publication thereof is expressly limited to such use. Title to all works, specifically all drawings and modified derivatives of any blueprints, series, drawings or specifications remain the Designers without prejudice. VISUAL CONTACT with any of these drawings, or their purchase, constitutes prima facie evidence of the acceptance of these restrictions! This has held precedent in the North Florida Court system! Any and all violations WILL result in legal action being taken and litigated damages to the full extent allowed by law! No exceptions and no excuses! Contractor &/or owner shall verify all dimensions, details & specifications prior to construction. Every attempt has been made to avoid mistakes. The contractor and the owners also fully acknowledge that they have full copyright release approval and that they have fully acknowledged that they have fully acknowledged that they have full copyright release approval and that they have fully acknowledged that they have begun!