


BATIER INVESTMENT S.A. RESERVES THE OWNERSHIP OF THIS DOCUMENT. IT IS PROHIBITED TO REPRODUCE, MODIFY OR TRANSFER WITHOUT PRIOR WRITTEN AUTHORIZATION.

	1	2	3	4	5	6	7	8																																												
A																																																				
B	 VOLTA www.VoltaESD.com																																																			
C																																																				
D	Client: - Project: - Volta D2 Description Document: - 73120 ELECTRICAL DIAGRAM mSafe C1D2 Document Number: - 50000000000000073120 ZPL Revision: - 2																																																			
E	Installation Place -																																																			
F	<table border="1"><thead><tr><th>REV</th><th>DESCRIPTION</th><th>DATE</th><th>PROJ.</th><th>DW.</th><th>APR.</th></tr></thead><tbody><tr><td>-</td><td>-</td><td>-</td><td>-</td><td>-</td><td>-</td></tr><tr><td>2</td><td>Signal Duplicator (In NAM)</td><td>01/04/25</td><td>MPV</td><td>-</td><td>-</td></tr><tr><td>1</td><td>11M01;05XP3;AWG WIRES;ASBUILT(In Factory)</td><td>24/02/25</td><td>MPV</td><td>MMR</td><td>MPV</td></tr><tr><td>0</td><td>As Built (In Factory)</td><td>16/05/24</td><td>MPV</td><td>NBG</td><td>MPV</td></tr></tbody></table>					REV	DESCRIPTION	DATE	PROJ.	DW.	APR.	-	-	-	-	-	-	2	Signal Duplicator (In NAM)	01/04/25	MPV	-	-	1	11M01;05XP3;AWG WIRES;ASBUILT(In Factory)	24/02/25	MPV	MMR	MPV	0	As Built (In Factory)	16/05/24	MPV	NBG	MPV	 VOLTA www.VoltaESD.com			<table border="1"><tr><td>DOC NUMBER:</td><td>50000000000000073120</td><td>GRAL REV:</td><td>2</td></tr><tr><td>TITLE:</td><td>Functional Diagram – mSafe C1D2 P&ID + Functional -</td><td>REV:</td><td>2</td></tr><tr><td colspan="2"></td><td>CONT:</td><td>05</td></tr></table>		DOC NUMBER:	50000000000000073120	GRAL REV:	2	TITLE:	Functional Diagram – mSafe C1D2 P&ID + Functional -	REV:	2			CONT:	05
REV	DESCRIPTION	DATE	PROJ.	DW.	APR.																																															
-	-	-	-	-	-																																															
2	Signal Duplicator (In NAM)	01/04/25	MPV	-	-																																															
1	11M01;05XP3;AWG WIRES;ASBUILT(In Factory)	24/02/25	MPV	MMR	MPV																																															
0	As Built (In Factory)	16/05/24	MPV	NBG	MPV																																															
DOC NUMBER:	50000000000000073120	GRAL REV:	2																																																	
TITLE:	Functional Diagram – mSafe C1D2 P&ID + Functional -	REV:	2																																																	
		CONT:	05																																																	

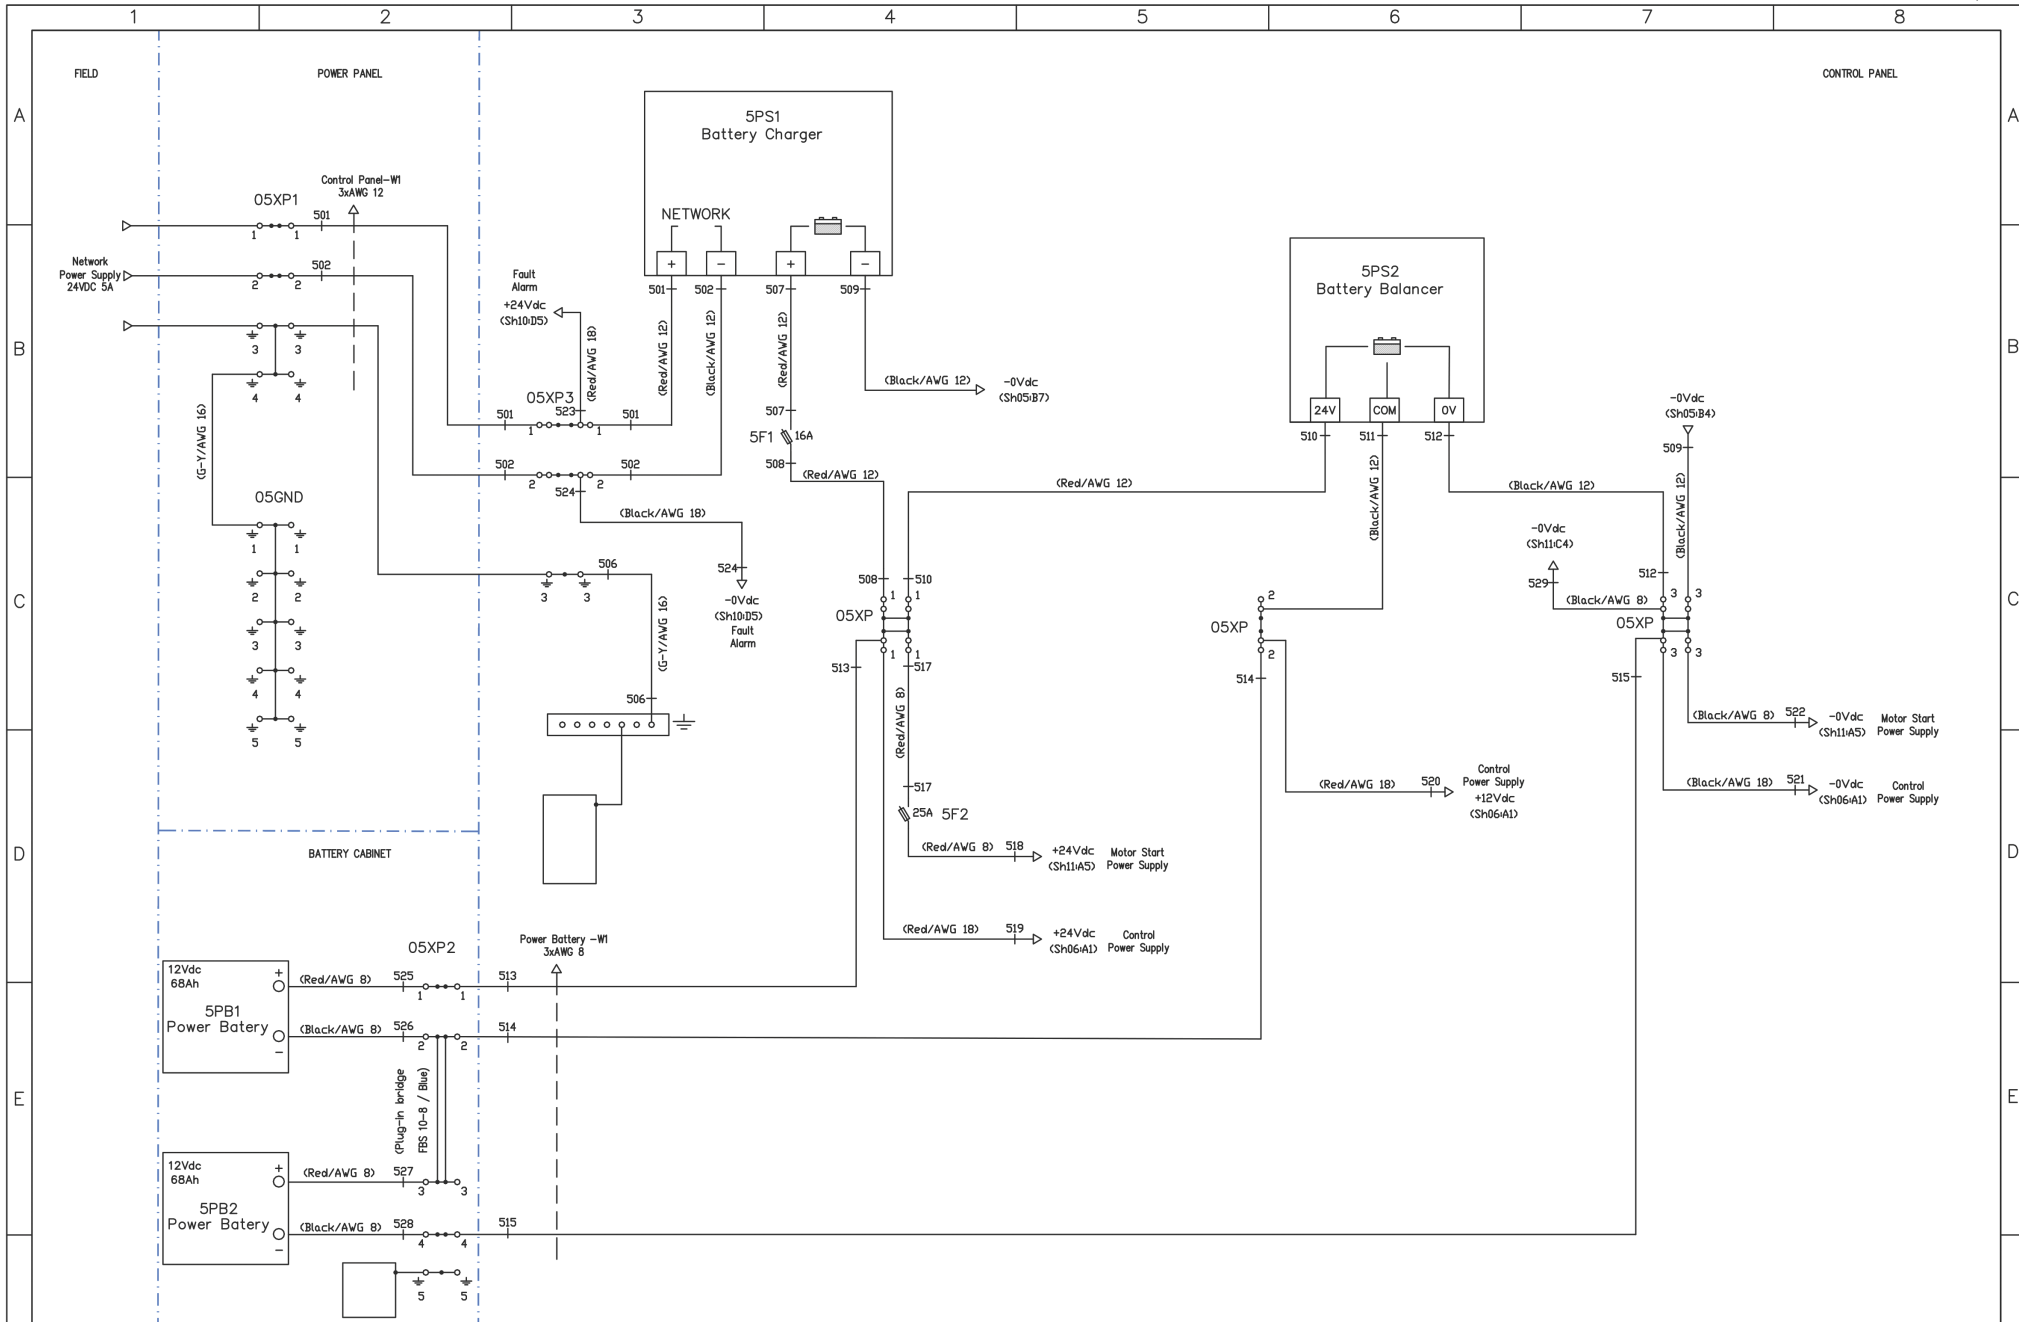


BATTER INVESTMENT S.A. RESERVES THE OWNERSHIP OF THIS DOCUMENT. IT IS PROHIBITED TO REPRODUCE, MODIFY OR TRANSFER WITHOUT PRIOR WRITTEN AUTHORIZATION.

REV	DESCRIPTION	DATE	PROJ.	DW.	APR.
2	Signal Duplicator (In NAM)	01/04/25	MPV	—	—
1	11M01;05XP3;AWG WIRES;ASBUILT(In Factory)	24/02/25	MPV	MMR	MPV
0	As Built (In Factory)	16/05/24	MPV	NBG	MPV

PROJECT: Volita D2
CODE: 73120-1
CLIENT:



DOC NUMBER:	5000000000000073120	GRAL REV:	2
TITLE:	Functional Diagram – mSafe C1D2 Battery Chargers and Power Circuits Power Supply	REV:	2
CONT:	06		

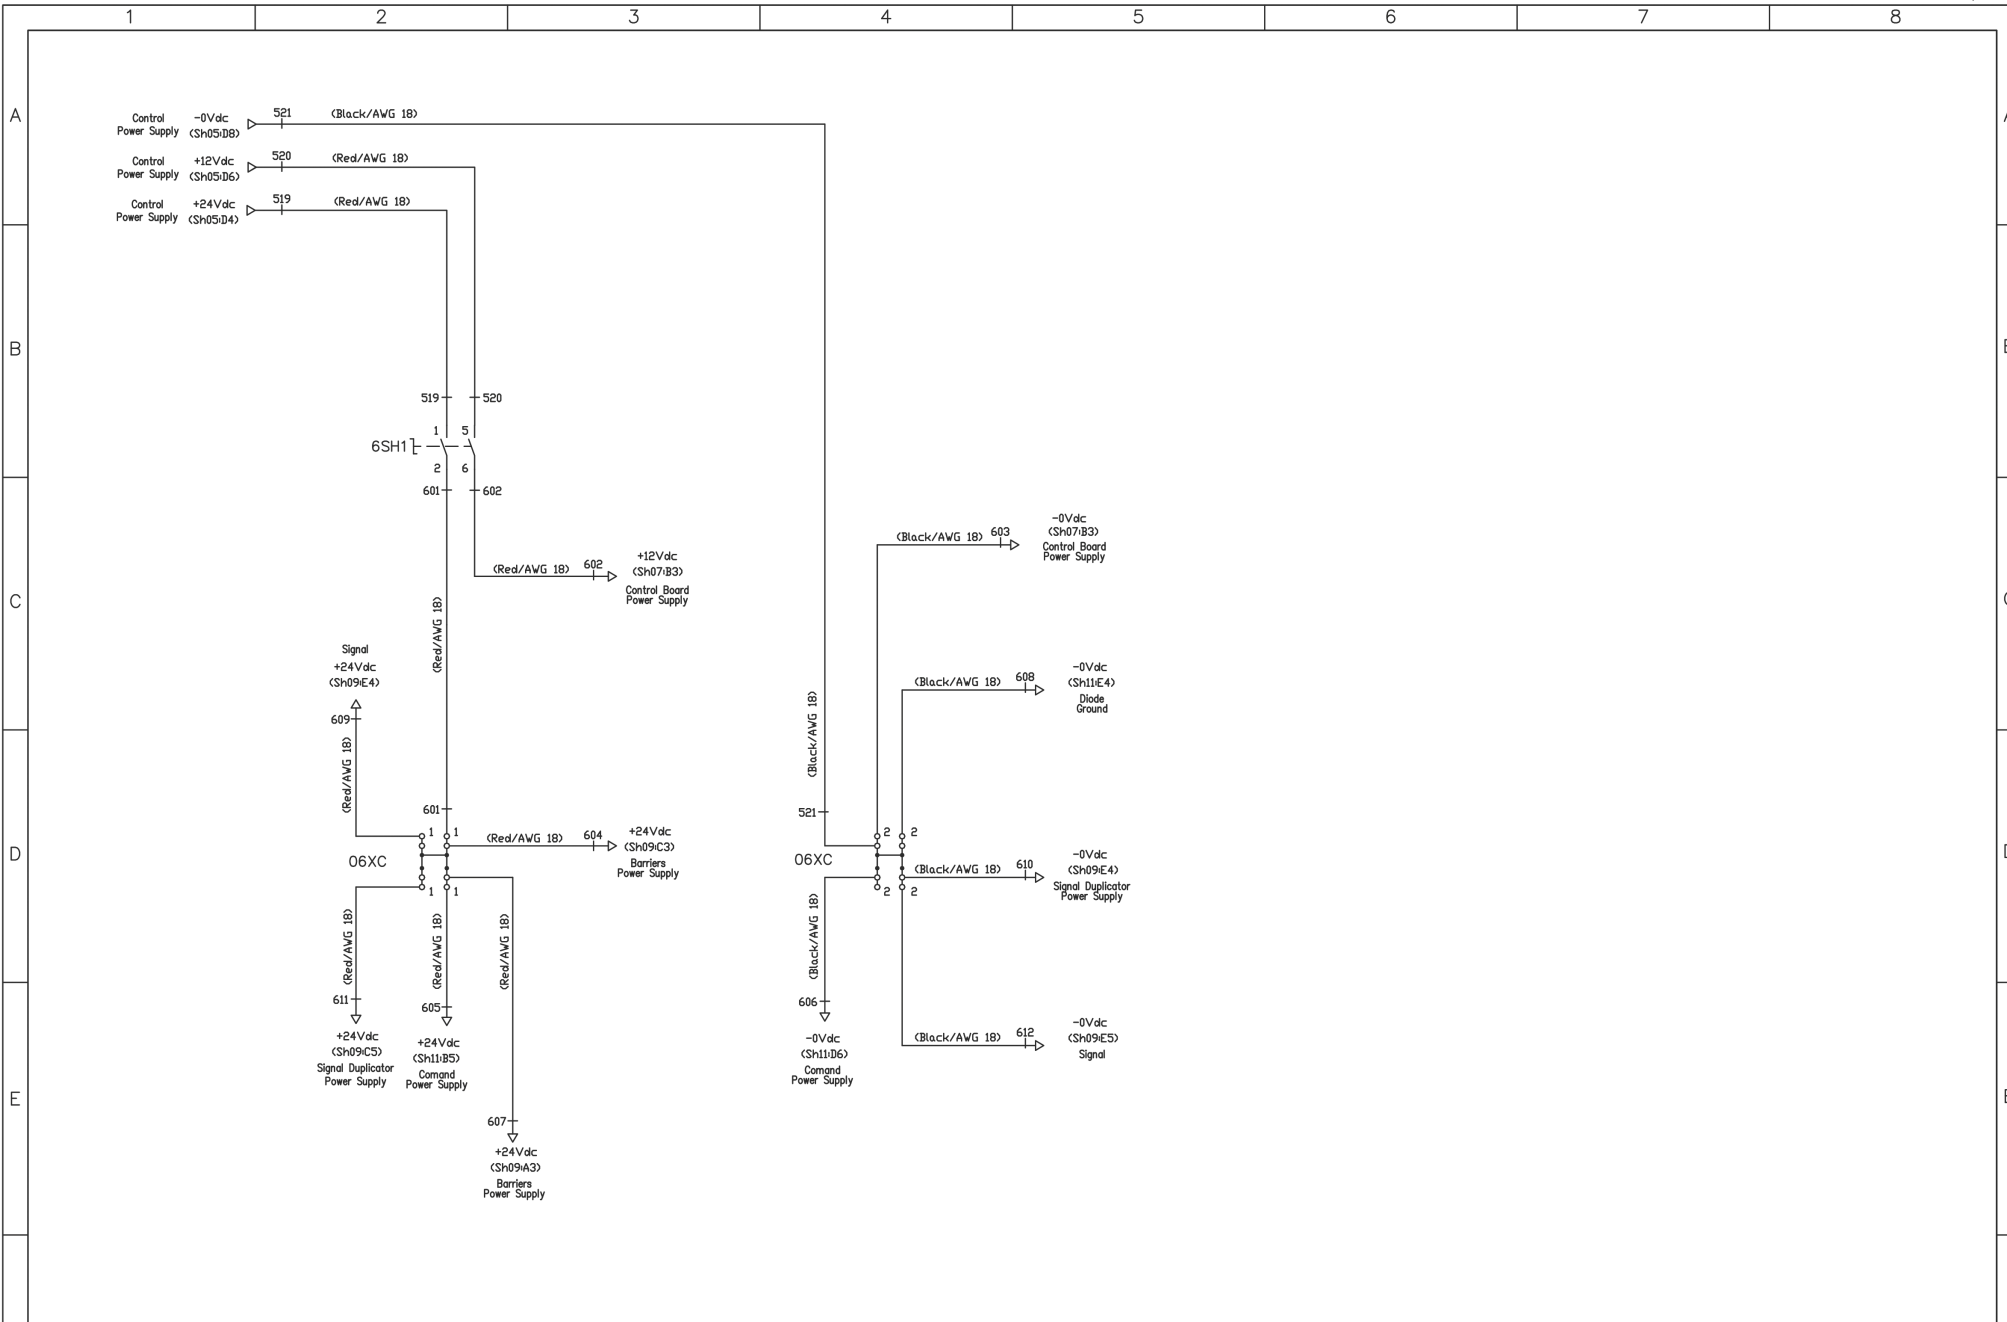

BATFER INVESTMENT S.A. RESERVES THE OWNERSHIP OF THIS DOCUMENT. IT IS PROHIBITED TO REPRODUCE, MODIFY OR TRANSFER WITHOUT PRIOR WRITTEN AUTHORIZATION.


2	Signal Duplicator (In NAM)	01/04/25	MPV	---	---
1	11M01;05XP3;AWG WIRES;ASBUILT(In Factory)	24/02/25	MPV	MMR	MPV
0	As Built (In Factory)	16/05/24	MPV	NBG	MPV
REV	DESCRIPTION	DATE	PROJ.	DW.	APR.

PROJECT: Volta D2
CODE: 73120-1
CLIENT:



DOC NUMBER:	5000000000000073120	GRAL REV:	2
TITLE:	Functional Diagram - mSafe C1D2 Control Voltage Distribution	REV:	2
CONT:	07		



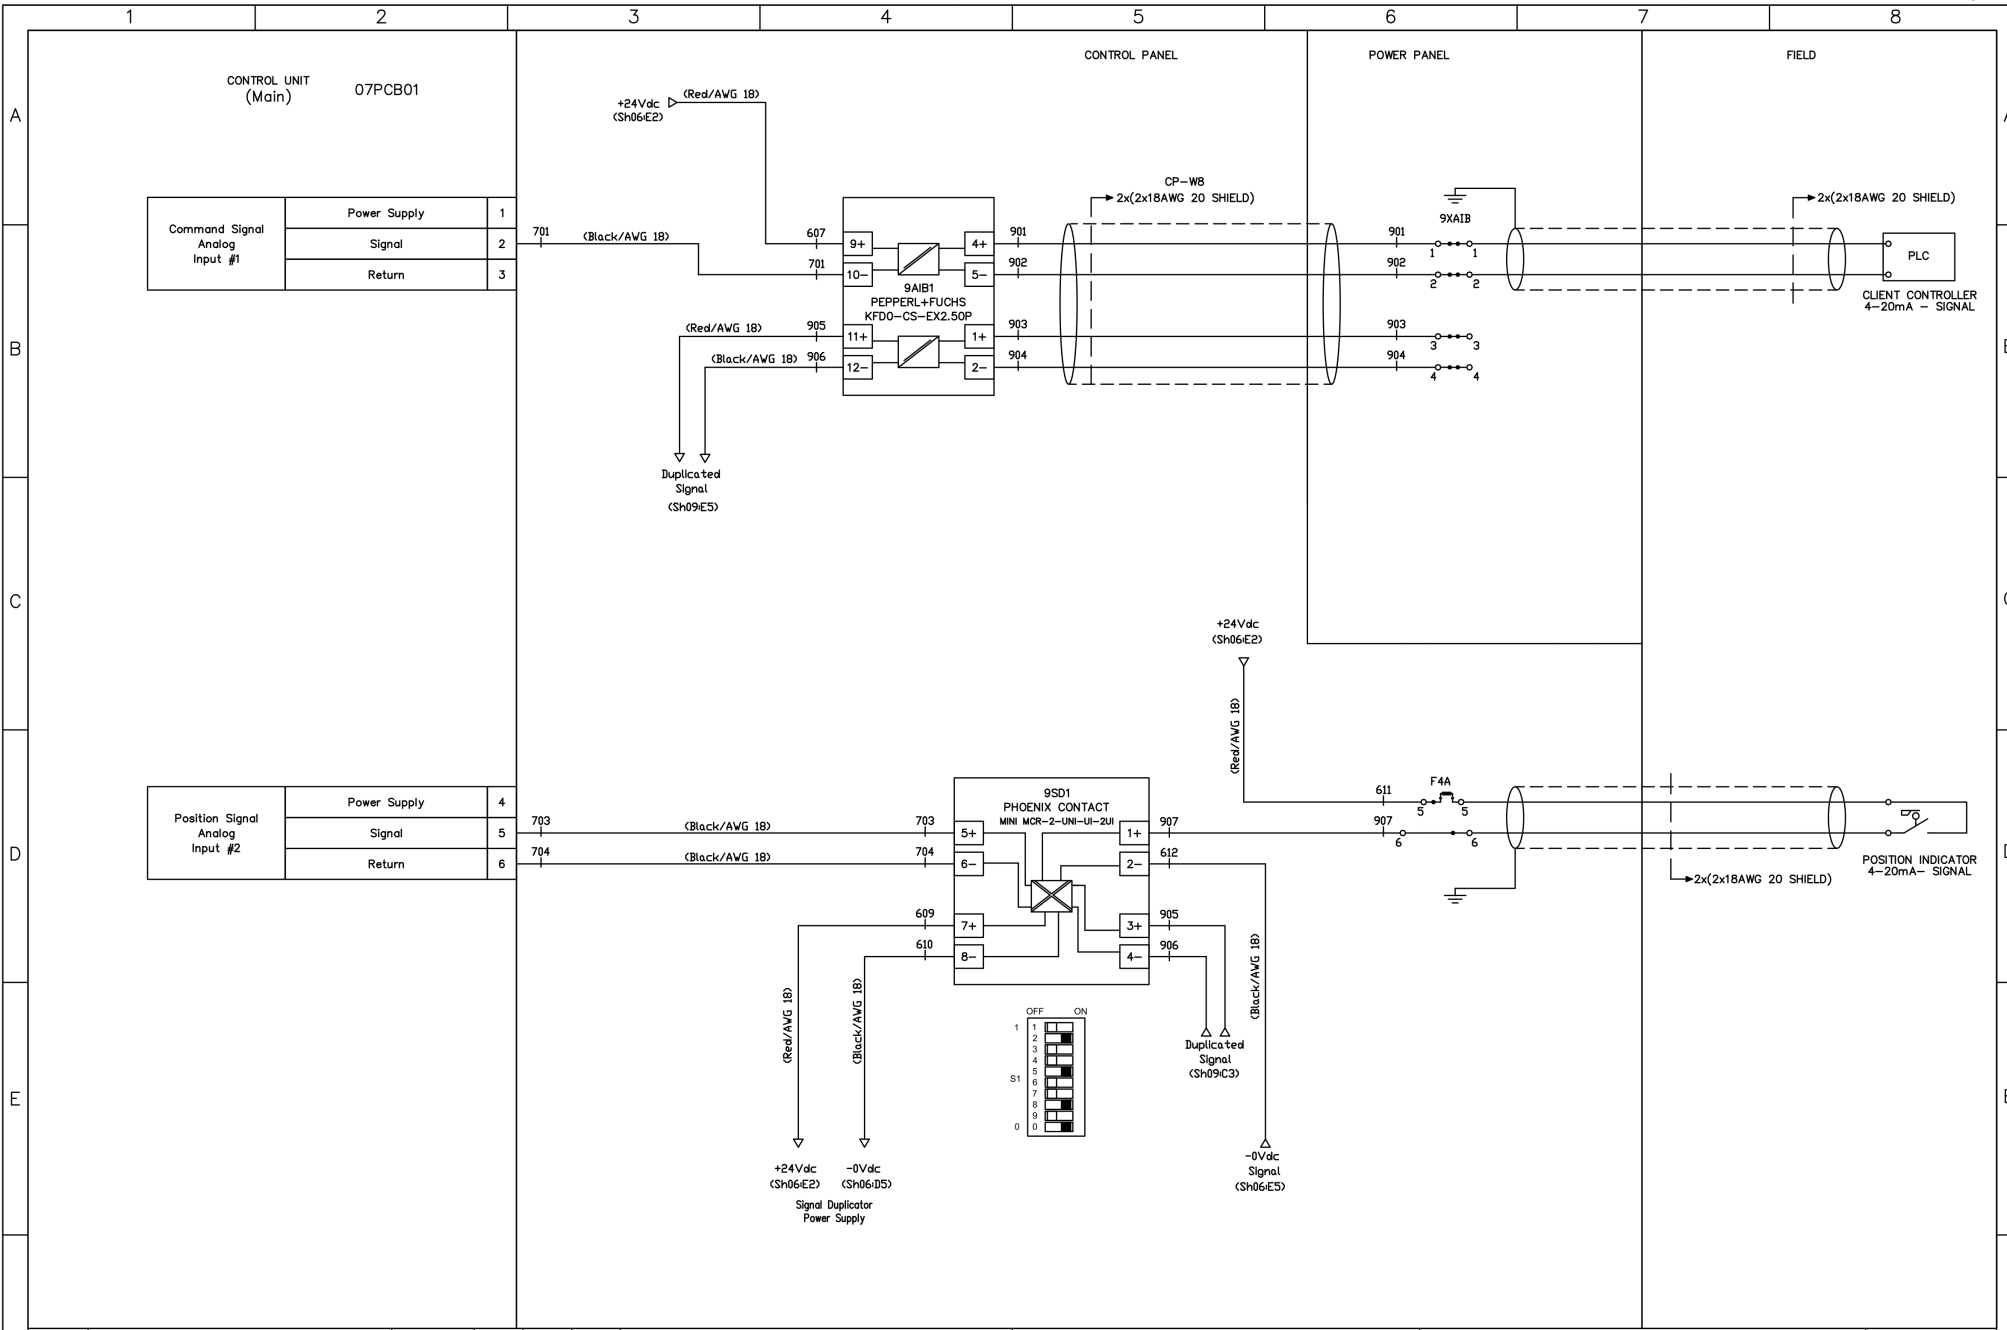


BATFER INVESTMENT S.A. RESERVES THE OWNERSHIP OF THIS DOCUMENT. IT IS PROHIBITED TO REPRODUCE, MODIFY OR TRANSFER WITHOUT PRIOR WRITTEN AUTHORIZATION.

REV	DESCRIPTION	DATE	PROJ.	DW.	APR.
2	Signal Duplicator (In NAM)	01/04/25	MPV	---	---
1	11M01;05XP3;AWG WIRES;ASBUILT(In Factory)	24/02/25	MPV	MMR	MPV
0	As Built (In Factory)	16/05/24	MPV	NBG	MPV

PROJECT: Volta D2
CODE: 73120-1
CLIENT:



DOC NUMBER: 5000000000000073120	GRAL REV: 2
TITLE: Functional Diagram - mSafe C1D2 Analog Inputs Main Board	REV: 2
	CONT: 10

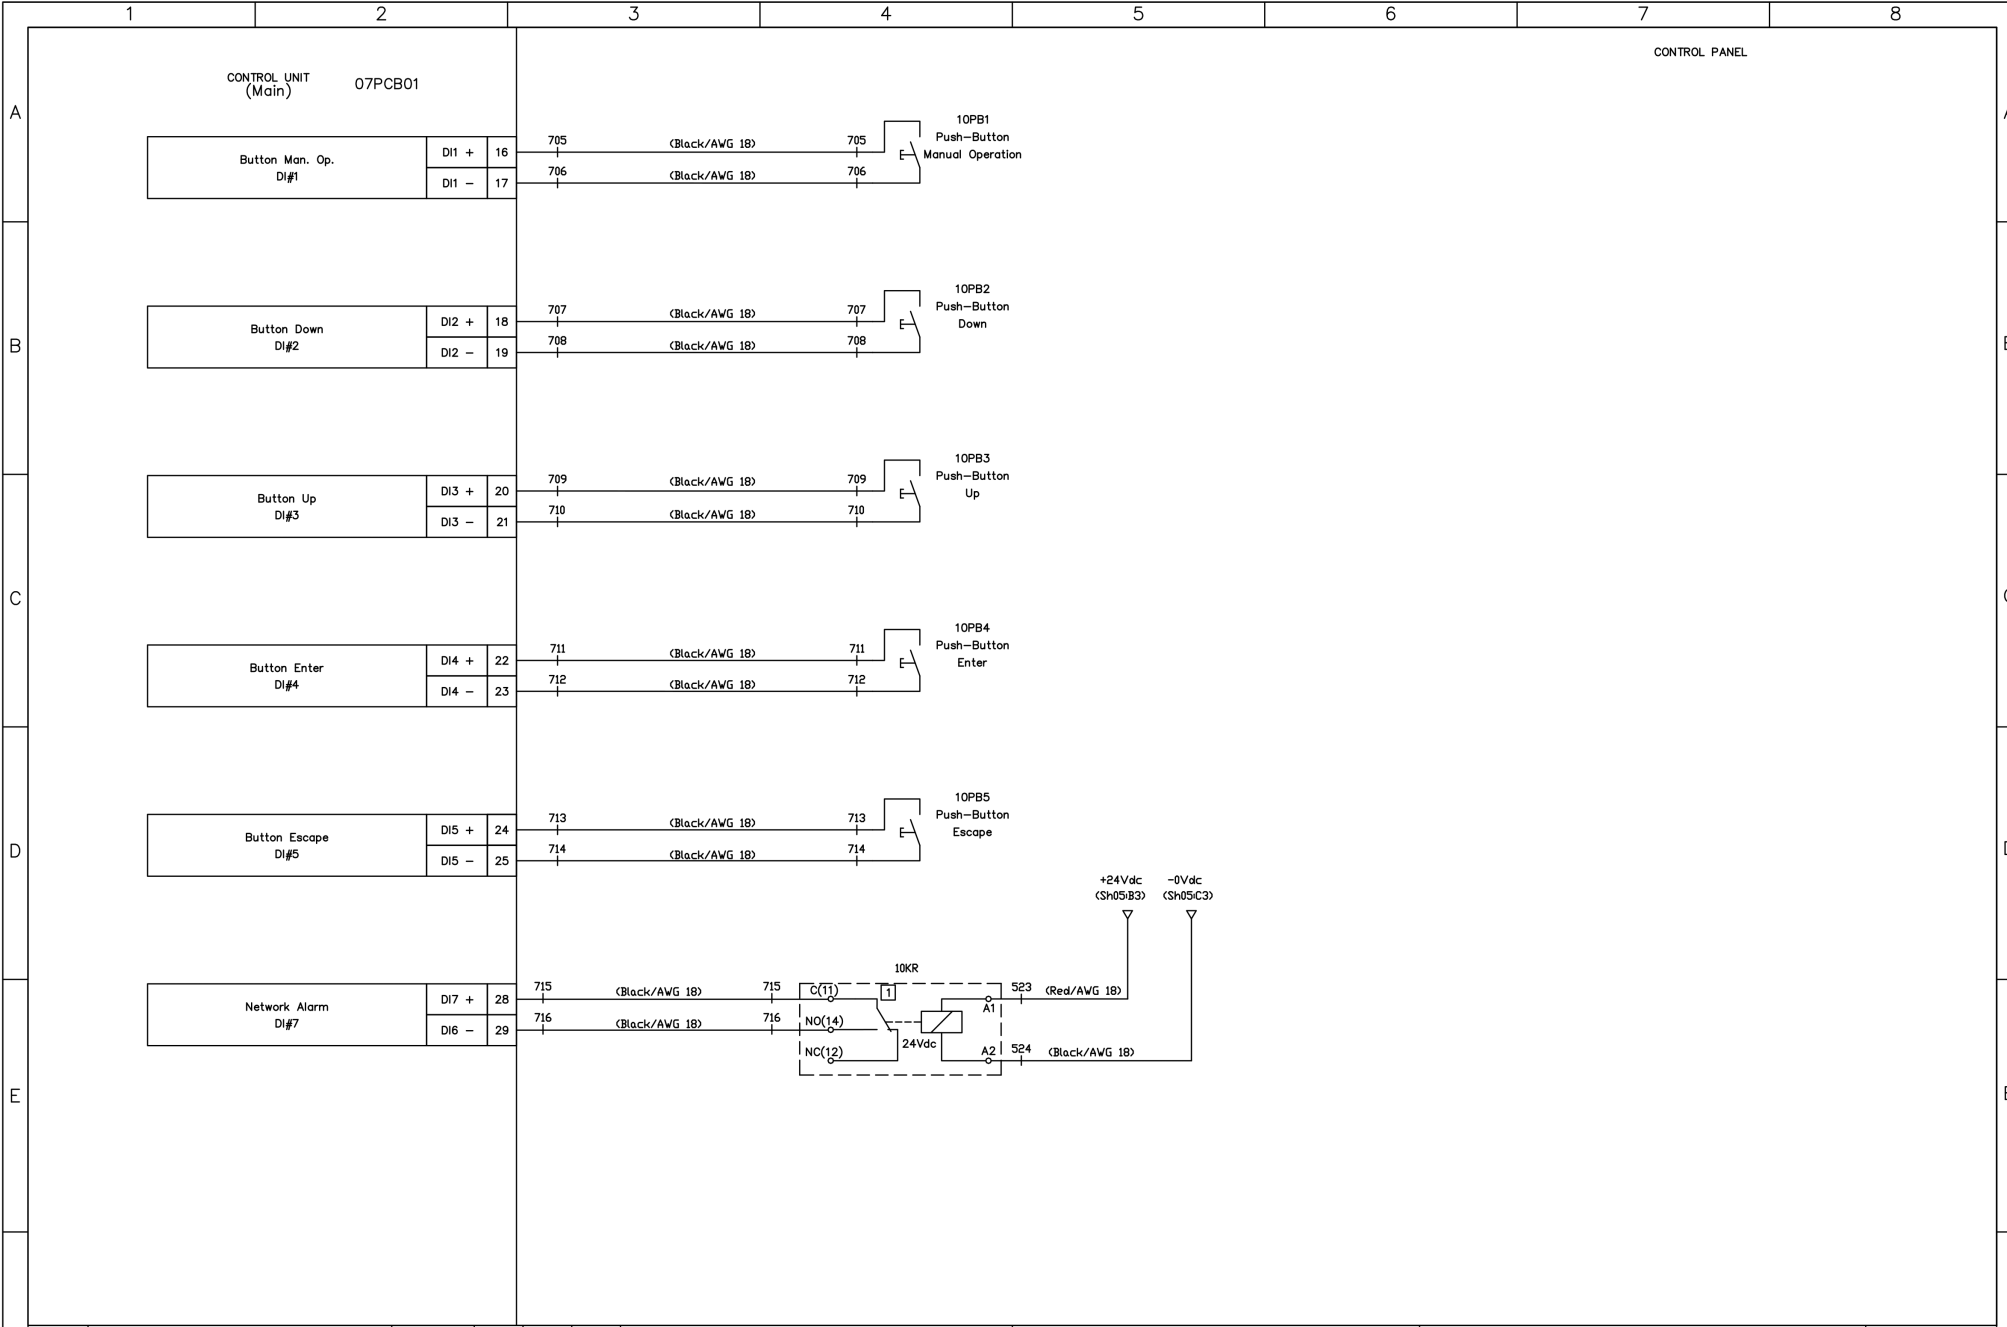


BATFER INVESTMENT S.A. RESERVES THE OWNERSHIP OF THIS DOCUMENT. IT IS PROHIBITED TO REPRODUCE, MODIFY OR TRANSFER WITHOUT PRIOR WRITTEN AUTHORIZATION.

-	-	-	-	-	-	PROJECT: Volta D2
2	Signal Duplicator (In NAM)	01/04/25	MPV	-	-	CODE: 73120-1
1	11M01;05XP3;AWG WIRES;ASBUILT(In Factory)	24/02/25	MPV	MMR	MPV	CLIENT:
0	As Built (In Factory)	16/05/24	MPV	NBG	MPV	
REV	DESCRIPTION	DATE	PROJ.	DW.	APR.	



DOC NUMBER:	5000000000000073120	GRAL REV:	2
TITLE:	Functional Diagram - mSafe C1D2 Digital Inputs Main Board	REV:	05 2
CONT:			11

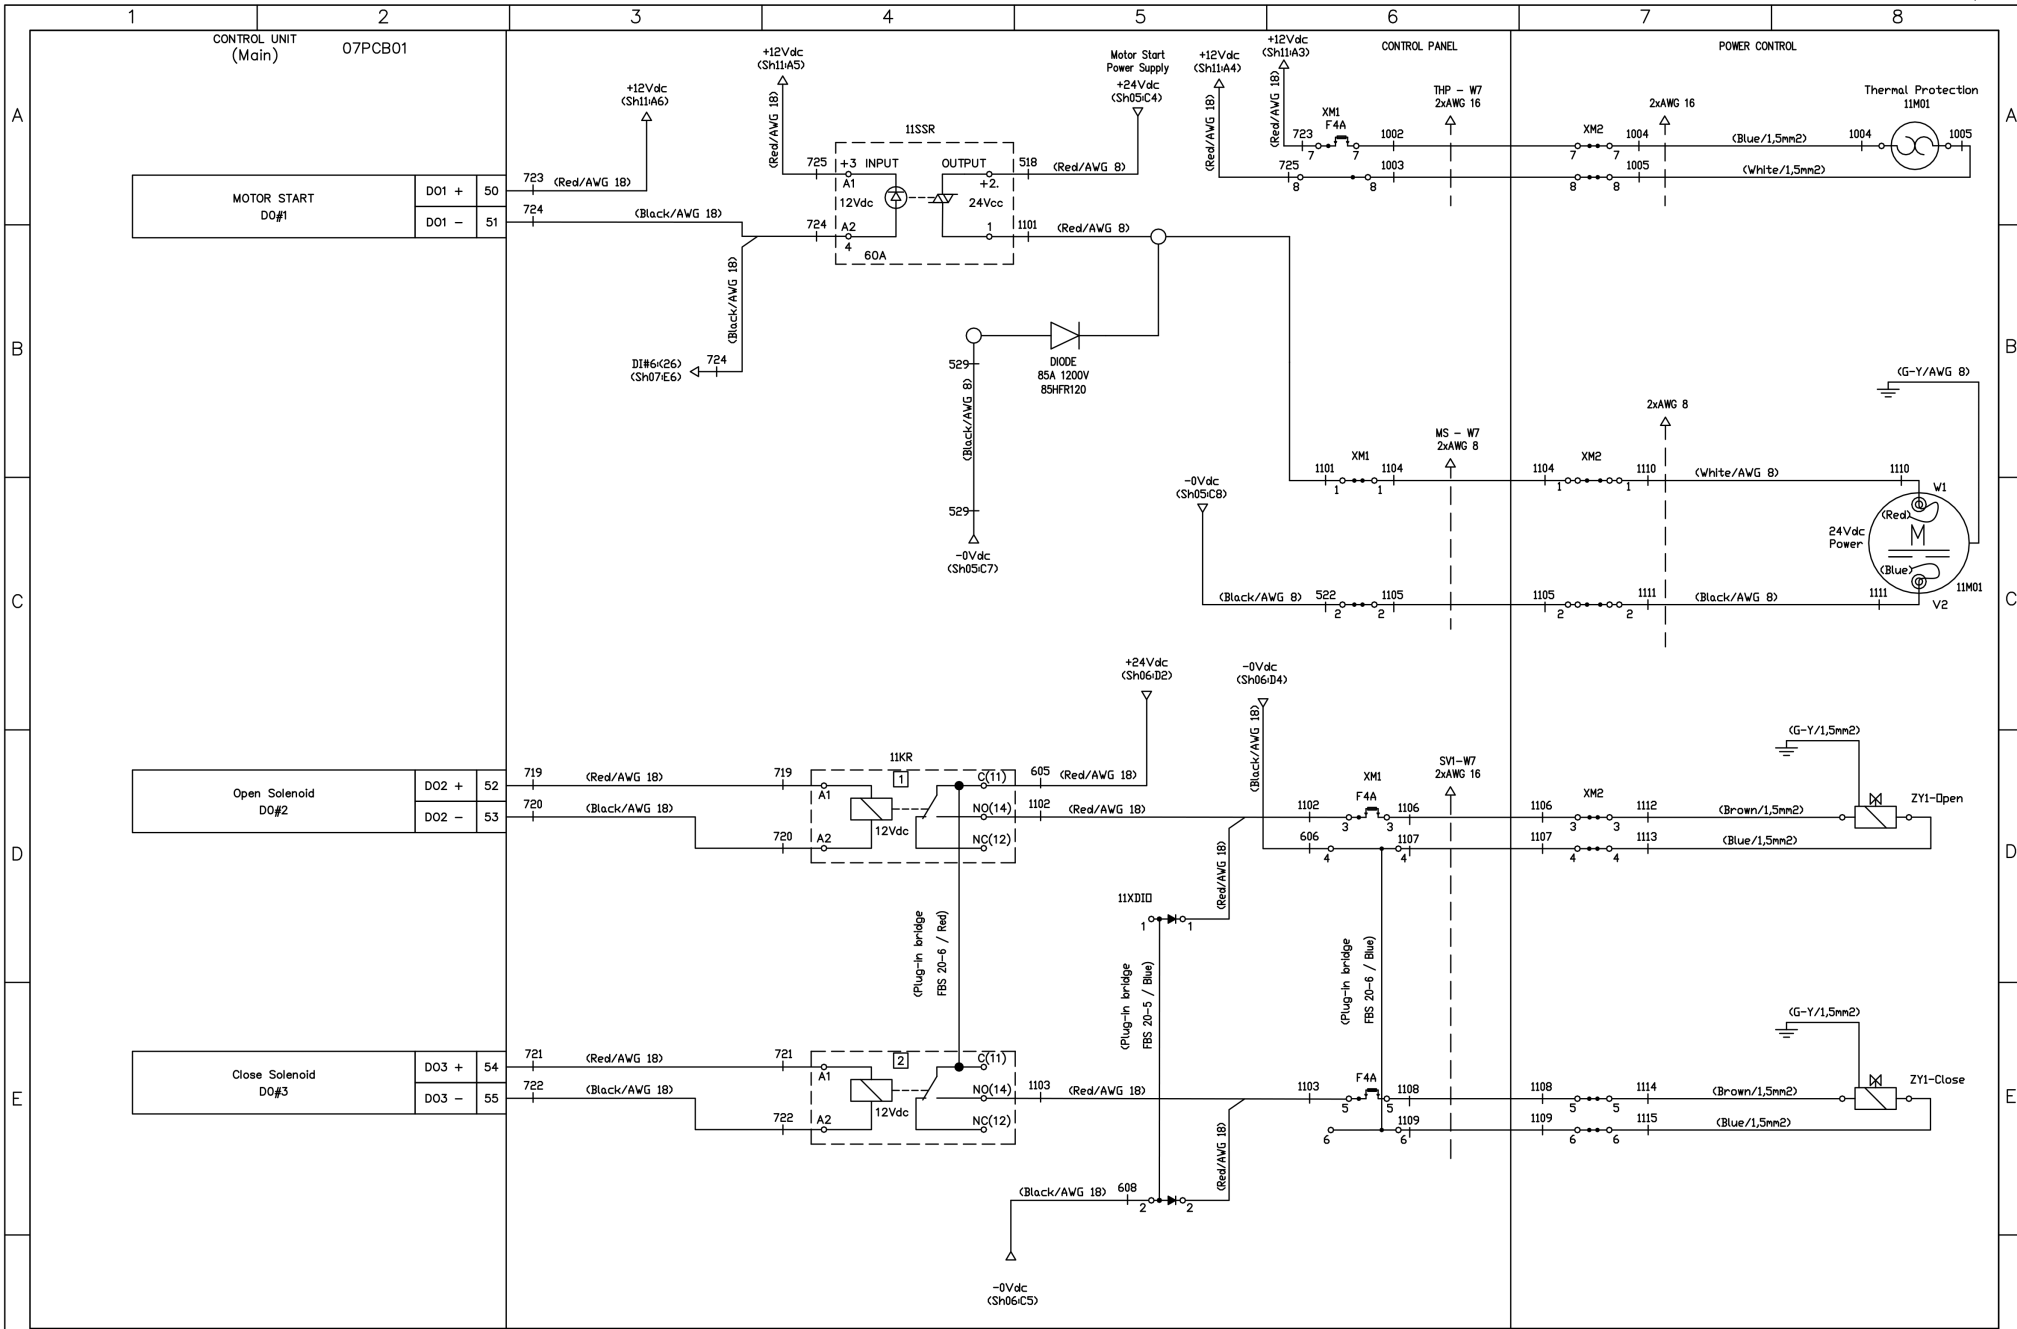


2	Signal Duplicator (In NAM)	01/04/25	MPV	---	---
1	11M01;05XP3;AWG WIRES;ASBUILT(In Factory)	24/02/25	MPV	MMR	MPV
0	As Built (In Factory)	16/05/24	MPV	NBG	MPV
REV	DESCRIPTION	DATE	PROJ.	DW.	APR.

PROJECT: Volta D2
CODE: 73120-1
CLIENT:



DOC NUMBER: 5000000000000073120
TITLE: Functional Diagram - mSafe C1D2
Digital Outputs
Motor and Valves Commands

GRAL REV: 2	REV: 2
06	12
CONT:	

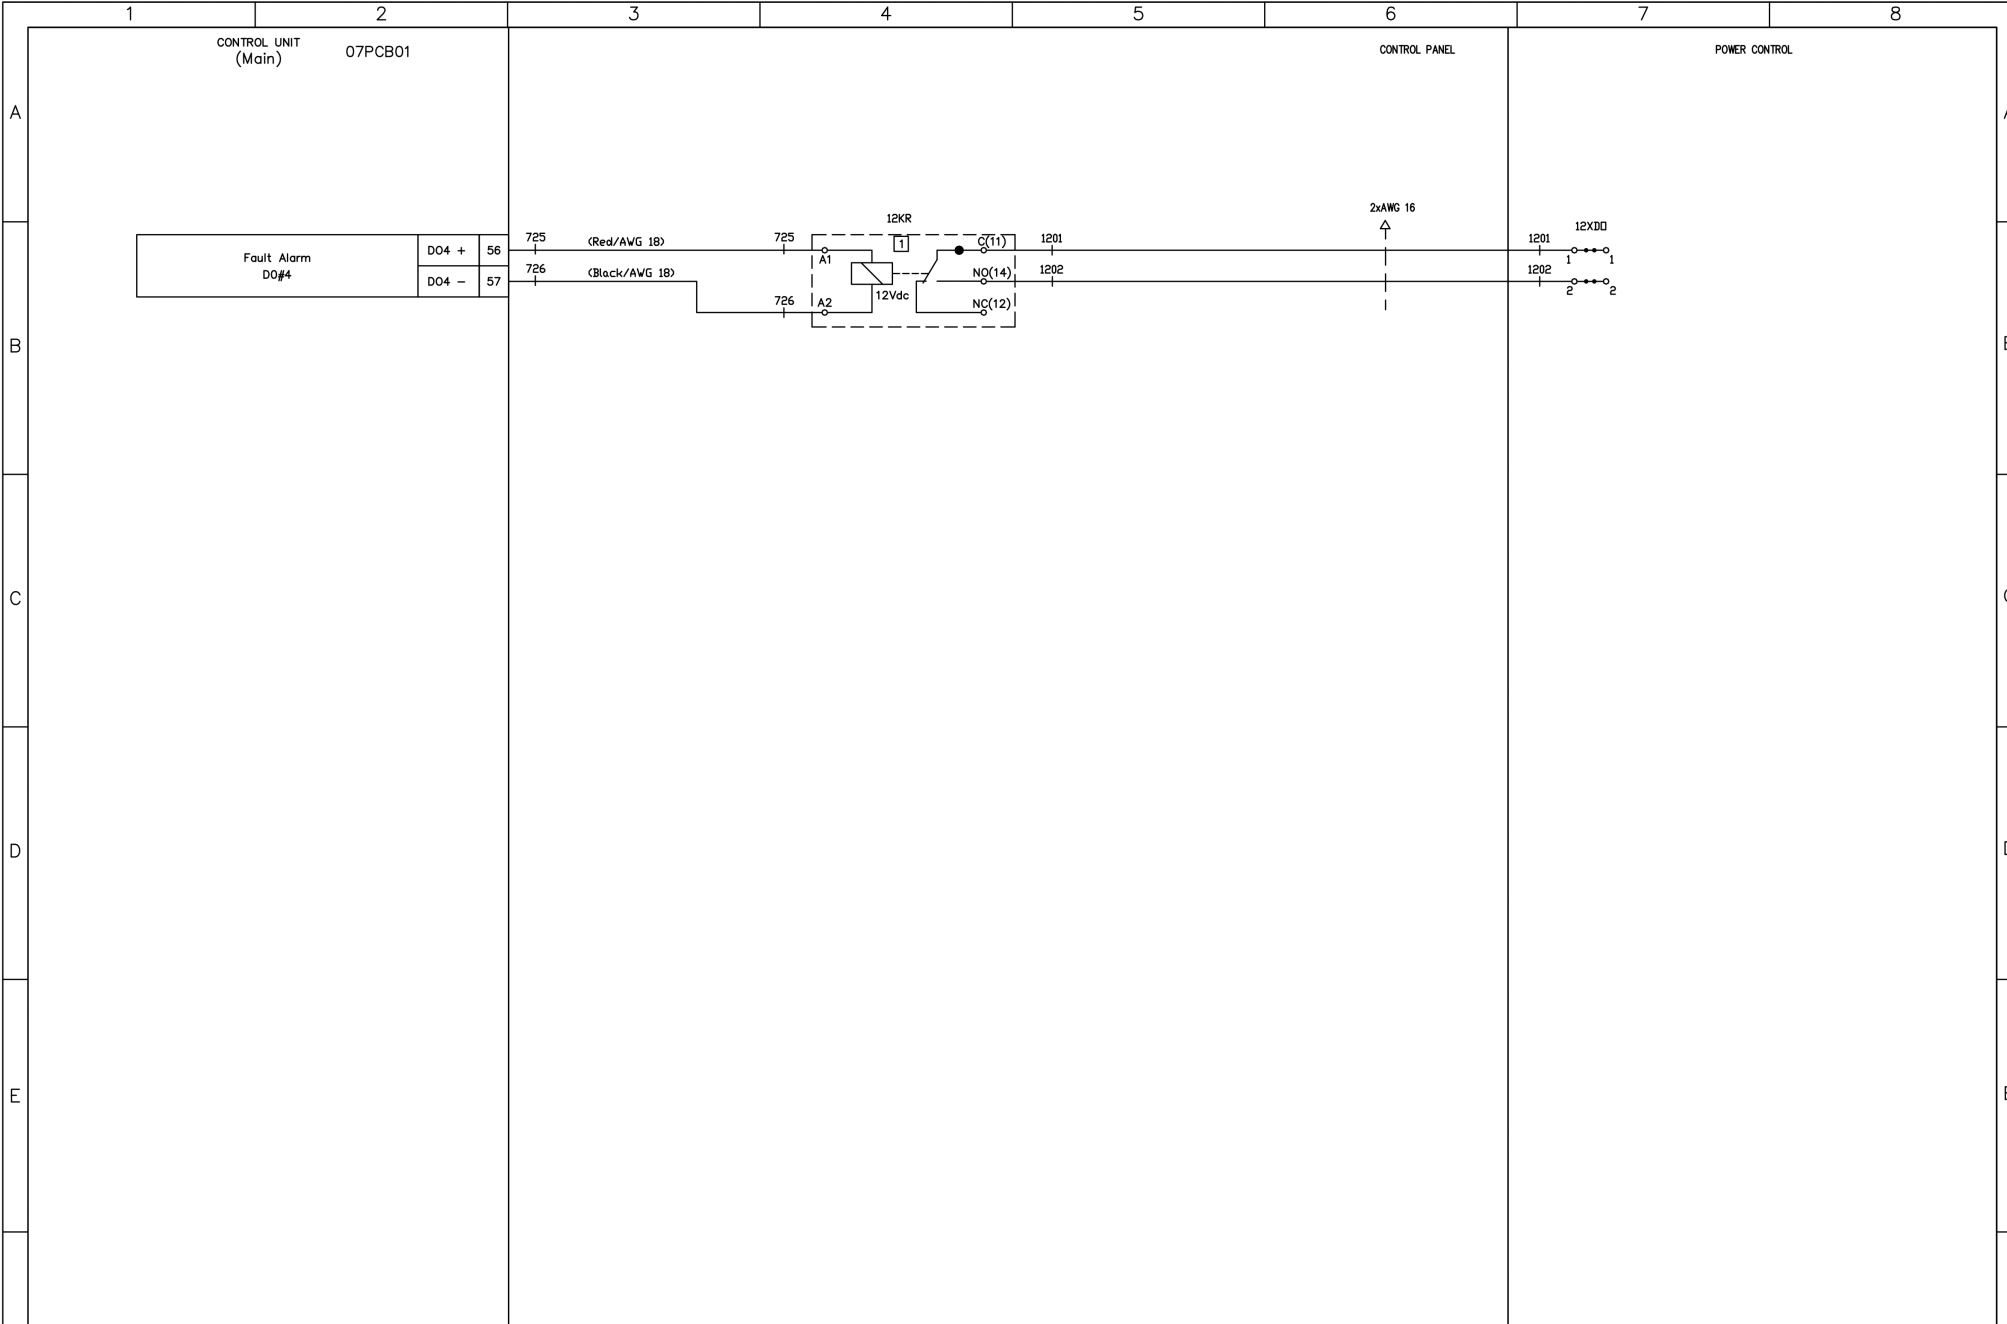

BATFER INVESTMENT S.A. RESERVES THE OWNERSHIP OF THIS DOCUMENT. IT IS PROHIBITED TO REPRODUCE, MODIFY OR TRANSFER WITHOUT PRIOR WRITTEN AUTHORIZATION.

-	-	-	-	-	-	PROJECT: Volta D2
2	Signal Duplicator (In NAM)	01/04/25	MPV	-	-	CODE: 73120-1
1	11M01;05XP3;AWG WIRES;ASBUILT(In Factory)	24/02/25	MPV	MMR	MPV	CLIENT:
0	As Built (In Factory)	16/05/24	MPV	NBG	MPV	
REV	DESCRIPTION	DATE	PROJ.	DW.	APR.	



DOC NUMBER:	5000000000000073120	GRAL REV:	2
TITLE:	Functional Diagram - mSafe C1D2 Digital Outputs Motor and Valves Commands	REV:	2
CONT:	-		