

GENERAL NOTES

1. SOIL BEARING-3000 PSF VIRGIN TO BE VERIFIED IN FIELD BY CONTRACTOR.
2. CONCRETE-3000 PSI @ 28 DAYS PER ACI-318
3. WELDED WIRE FABRIC-ASTM-A185
4. REINFORCING STEEL-ASTM A615 GRADE 60
5. MASONRY-C90 PER ACI 530
6. GROUT-2000 PSI @ 28 DAYS
7. CONTROL JOINTS-400 SQ FT (MAX)
8. STRUCTURAL STEEL-ASTM A-36 PER AISC CODE
9. STEEL JOIST-"K" SERIES PER SJI CODE
10. METAL DECK-PER SDI CODE
11. WELDING-E70XX PER AWS
12. CONTRACTOR IS RESPONSIBLE FOR DESIGN AND ERECTION OF ALL SHORING AND BRACING

FOUNDATION SCHEDULE

MARK	SIZE	REINFORCING
F1	3'-0X3'-0X3'-0	BULK CONC. FTG.
F2	4'-0X4'-0X1'-0	4-#5 EW BOTTOM
F3	5'-0X5'-0X1'-0	5-#5 EW BOTTOM
F4	5'-6X5'-6X1'-2	6-#5 EW BOTTOM
F5	6'-0X6'-0X1'-2	7-#5 EW BOTTOM

FOUNDATION PLAN


(EL.) = DENOTES TOP OF FTG. EL. IN PLAN
SF = DENOTES STEP FTG. IN PLAN

SEAL

ROBERT R ROSEN ASSOCIATES
PROFESSIONAL ENGINEERS
1705 BUTLER PIKE CONSHOHOCKEN PA 19428
A PROFESSIONAL SERVICE CORPORATION









PROJECT
VISITING NURSES ASSOCIATION OF POTTSTOWN
1963 E. HIGH ST.
LOWER POTTSGROVE TWP., POTTSTOWN, PA. S-1


date 10/30/96 job # 96424 scale 1/4"=1'-0" drawn by JSM rev date 11/6/96 sheet # 9 of 14

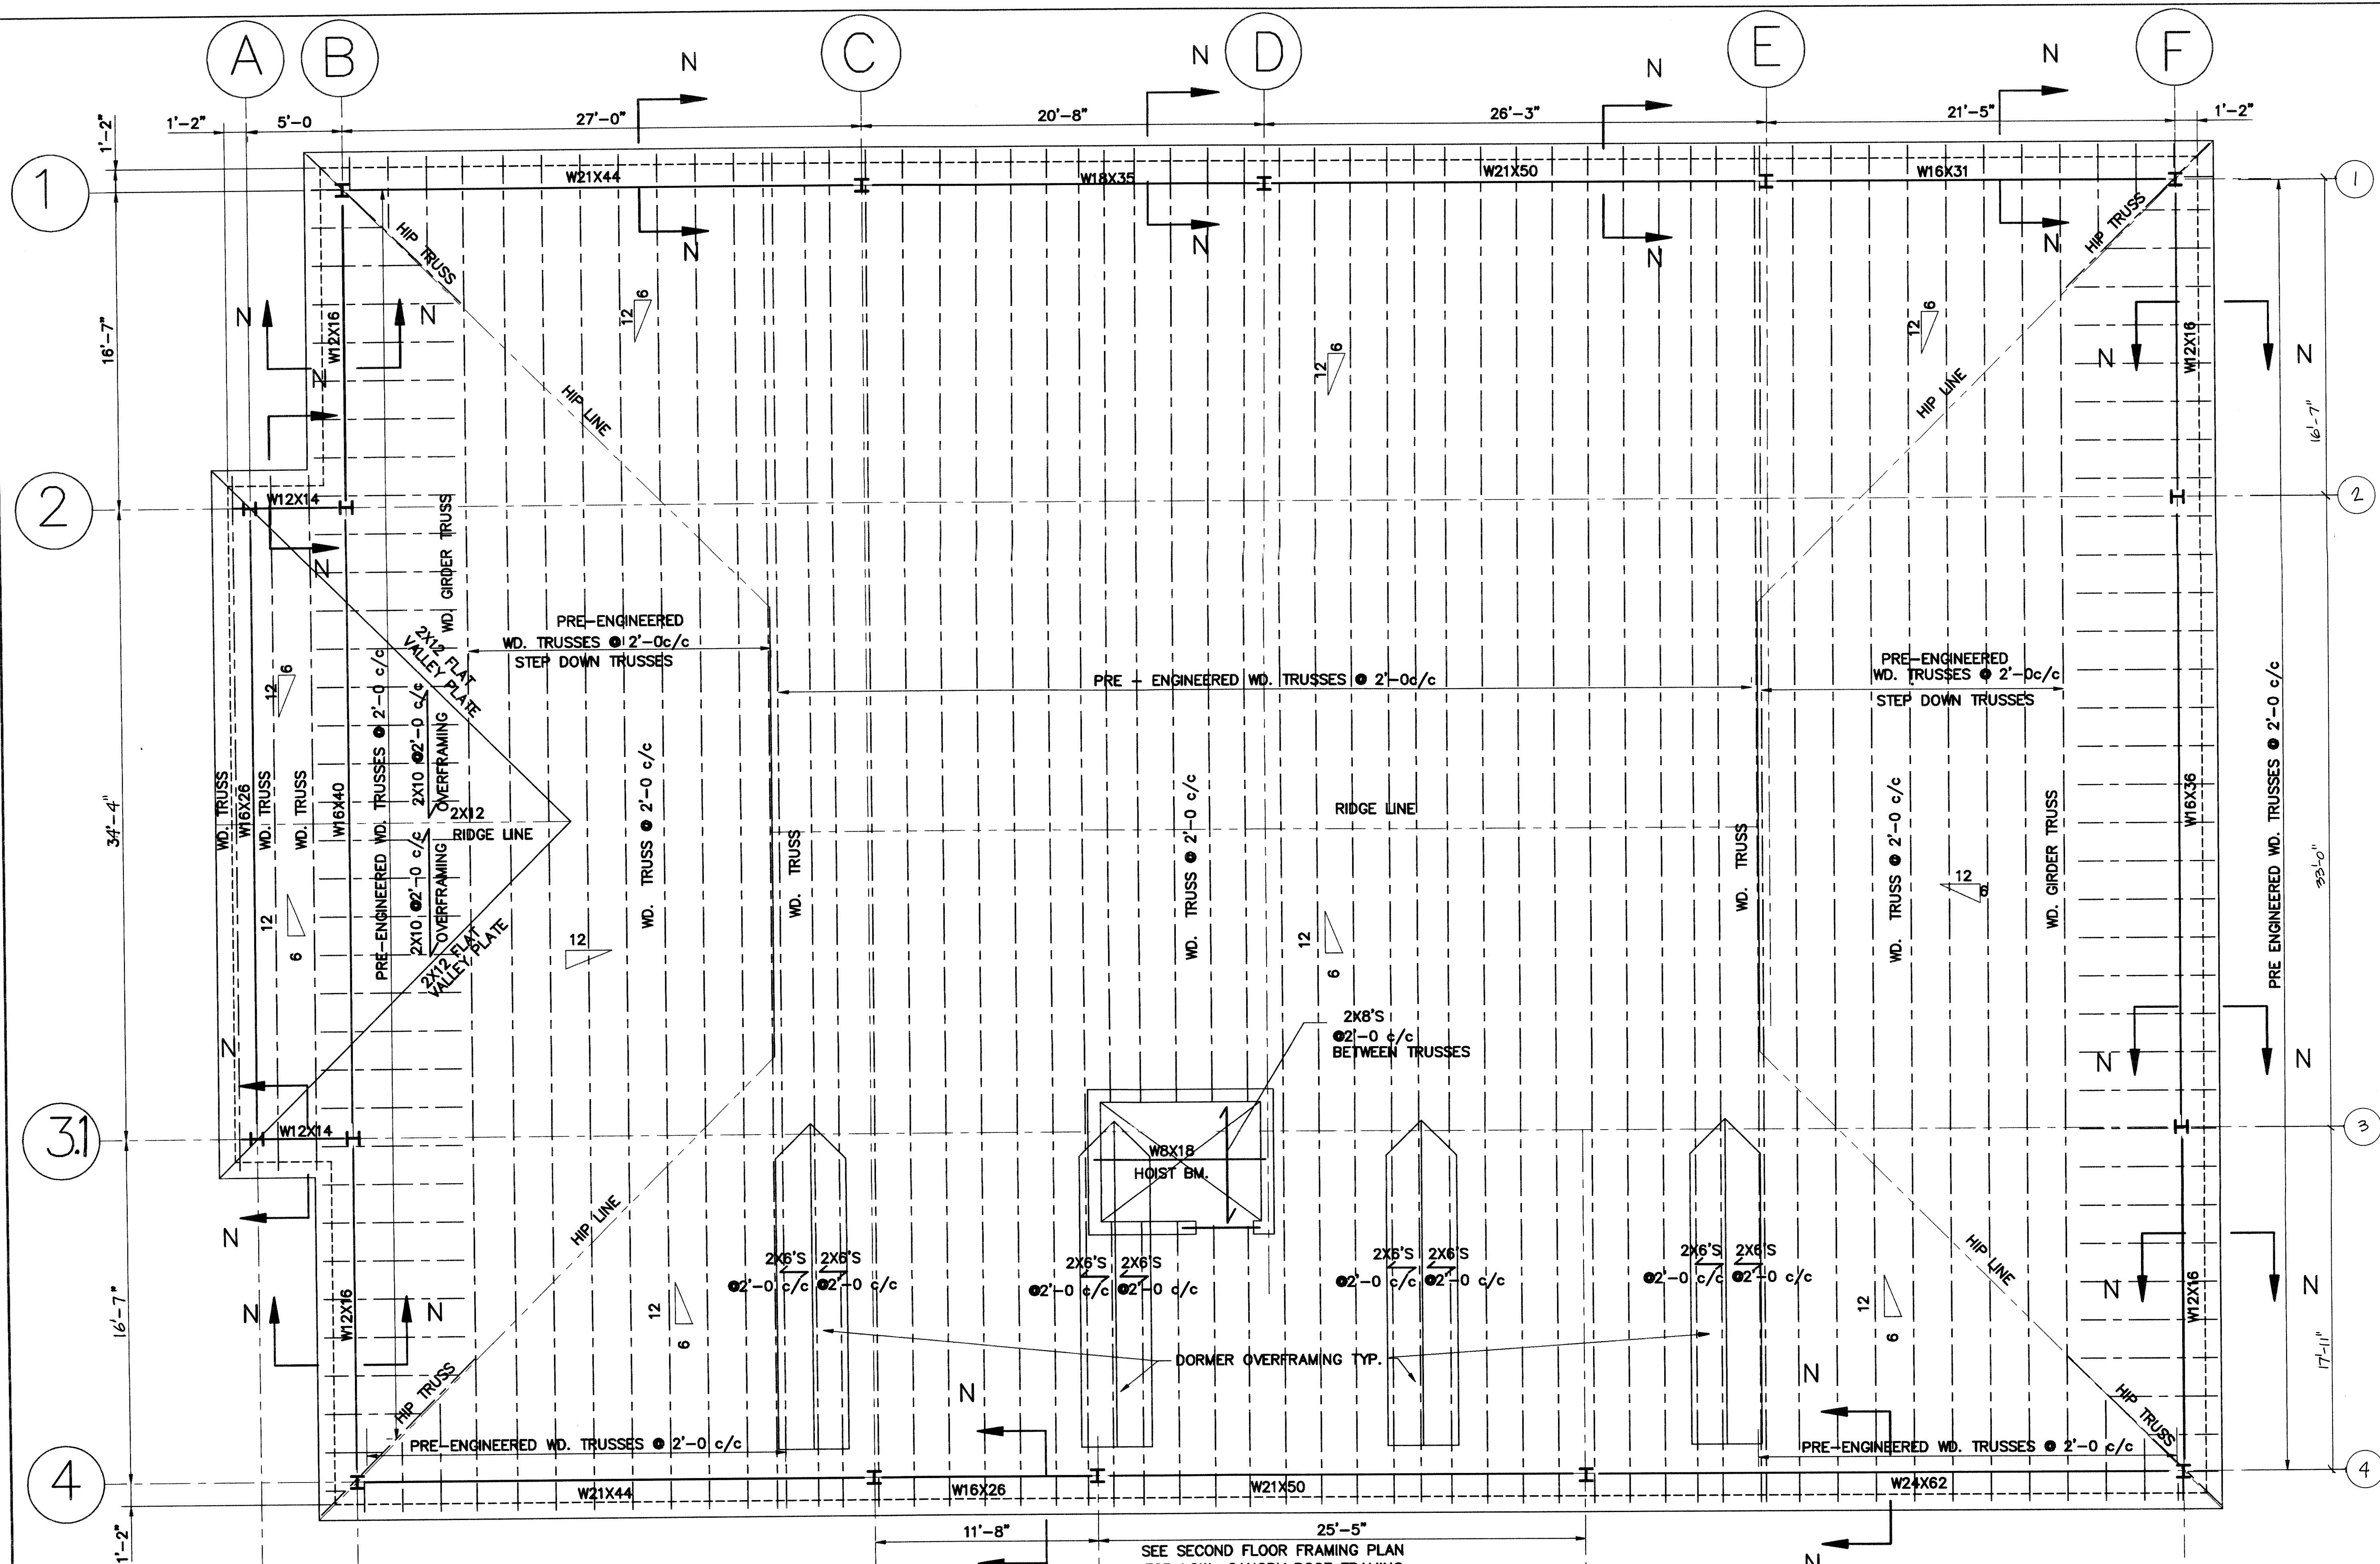


ROOF FRAMING PLAN

ROBERT R ROSEN ASSOCIATES PROFESSIONAL ENGINEERS 1705 BUTLER PIKE CONSHOHOCKEN PA 19428 A PROFESSIONAL SERVICE CORPORATION PROJECT VISITING NURSES ASSOCIATION OF POTTSTOWN 1963 E. HIGH ST. LOWER POTTSCROVE TWP., POTTSTOWN, PA.											
						date 10/30/95 job # 96424		scale 1/4"=1'-0" drawn by JSM		rev date 11/6/95 sheet # 11 of 14	
						S-3					

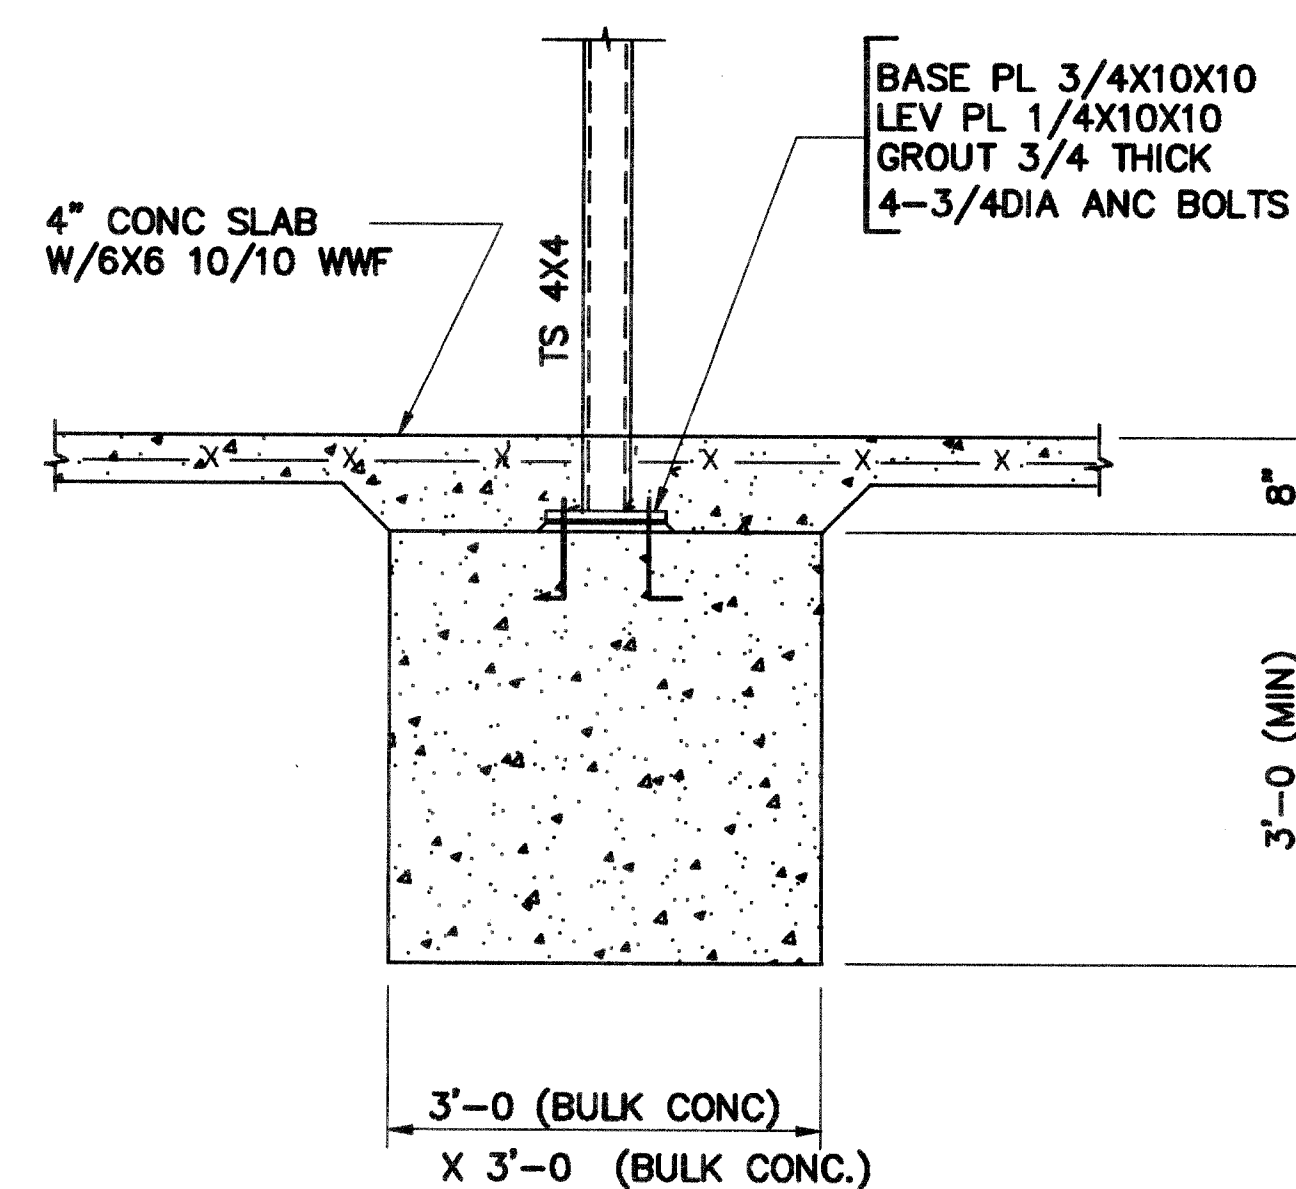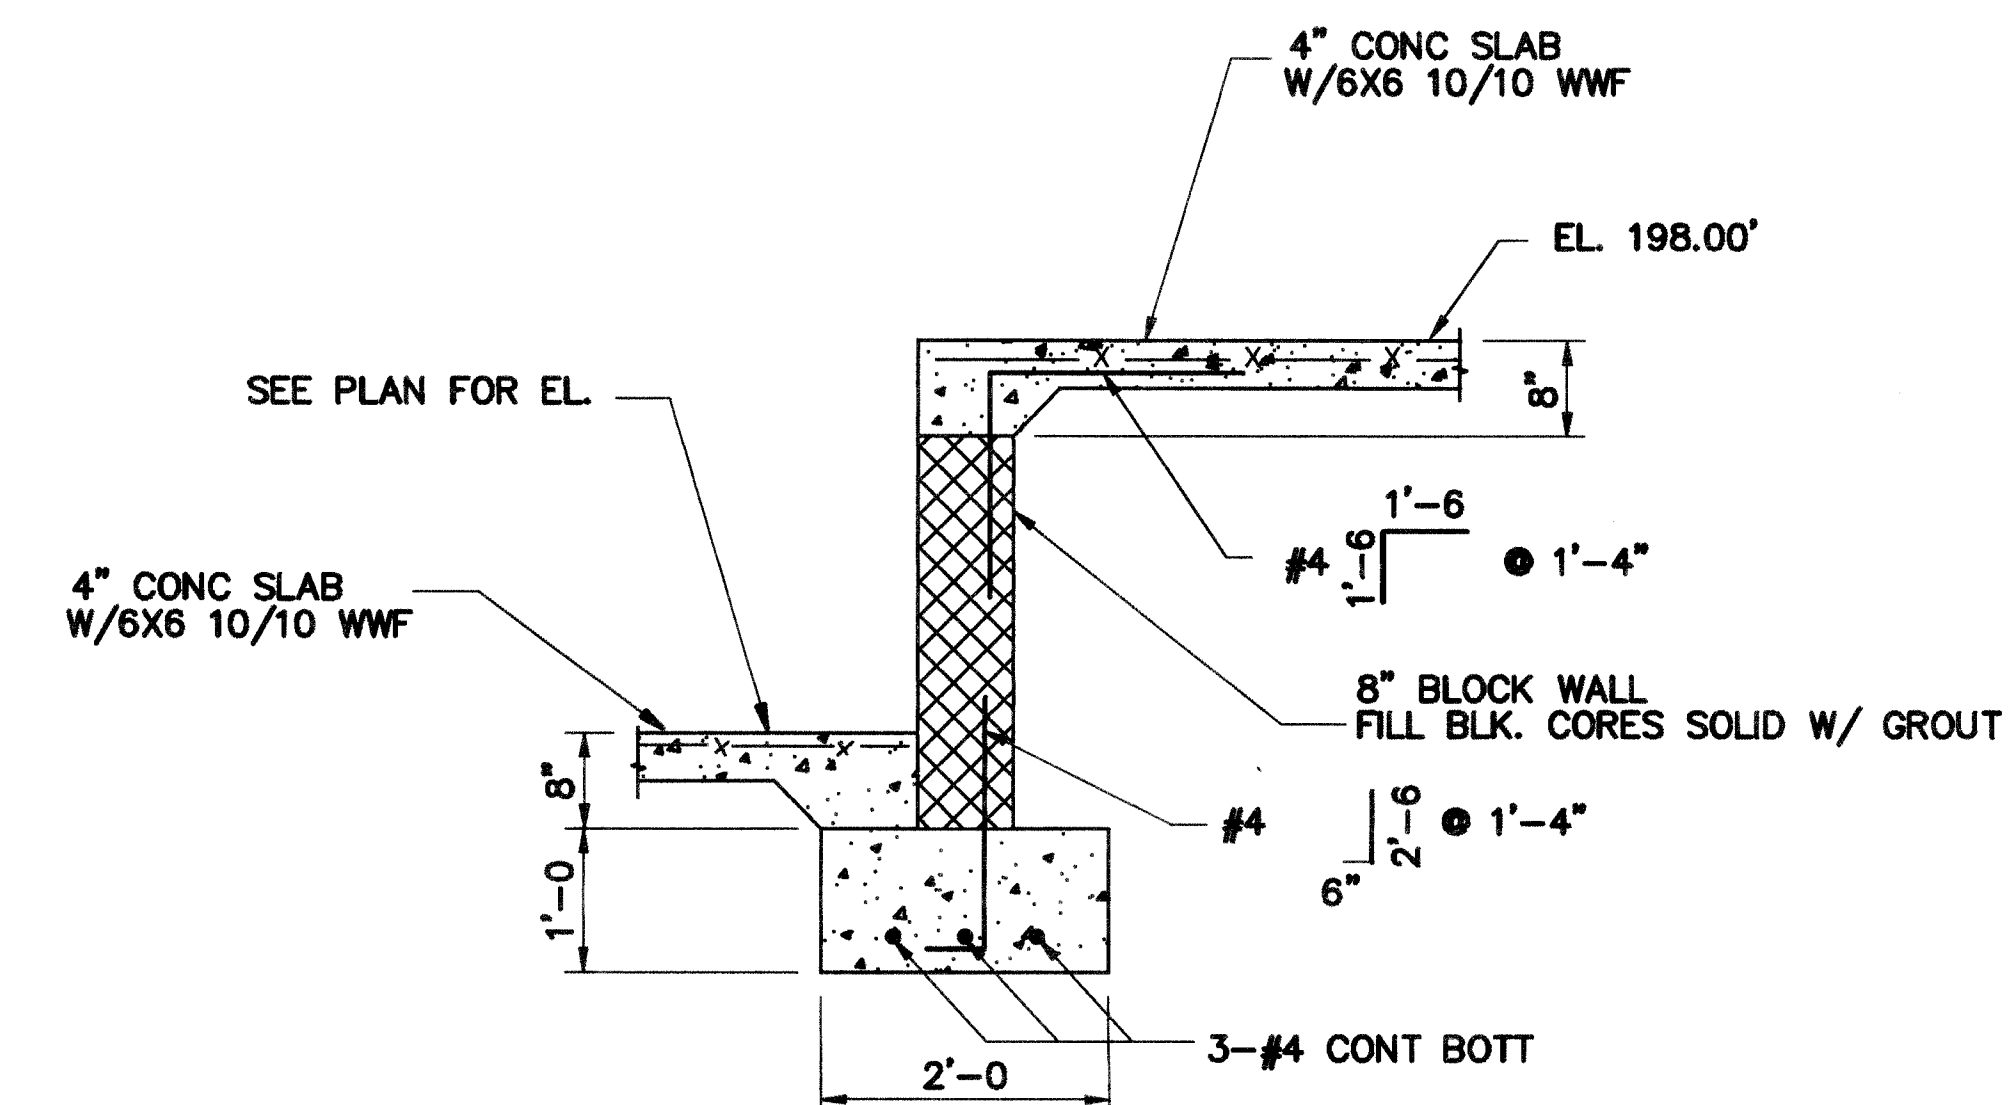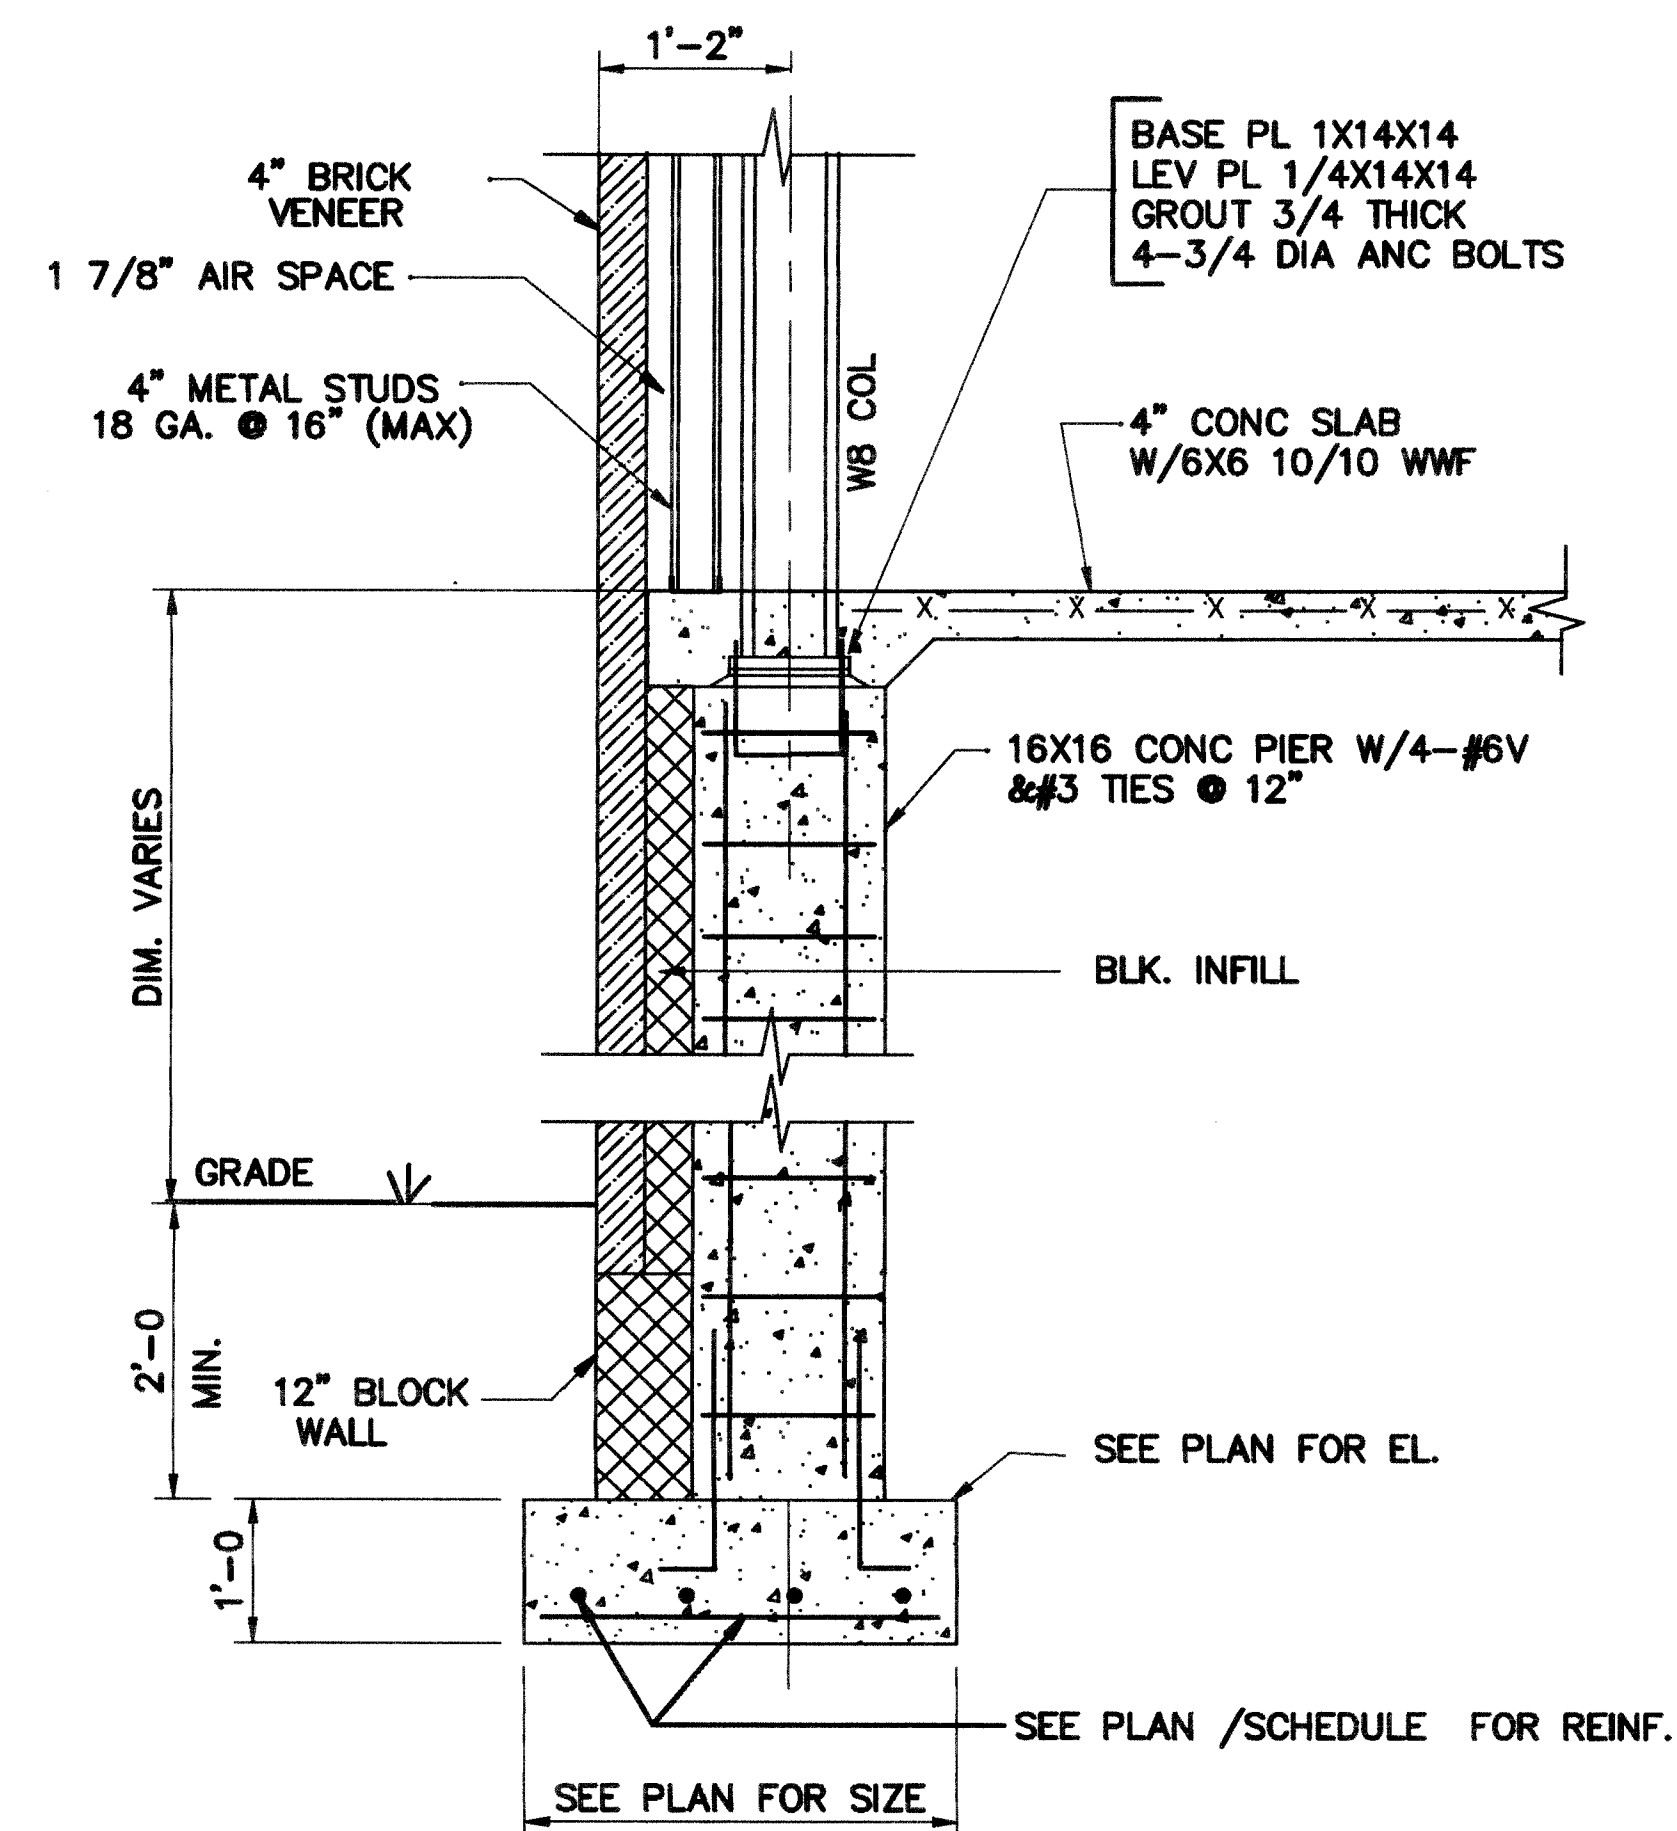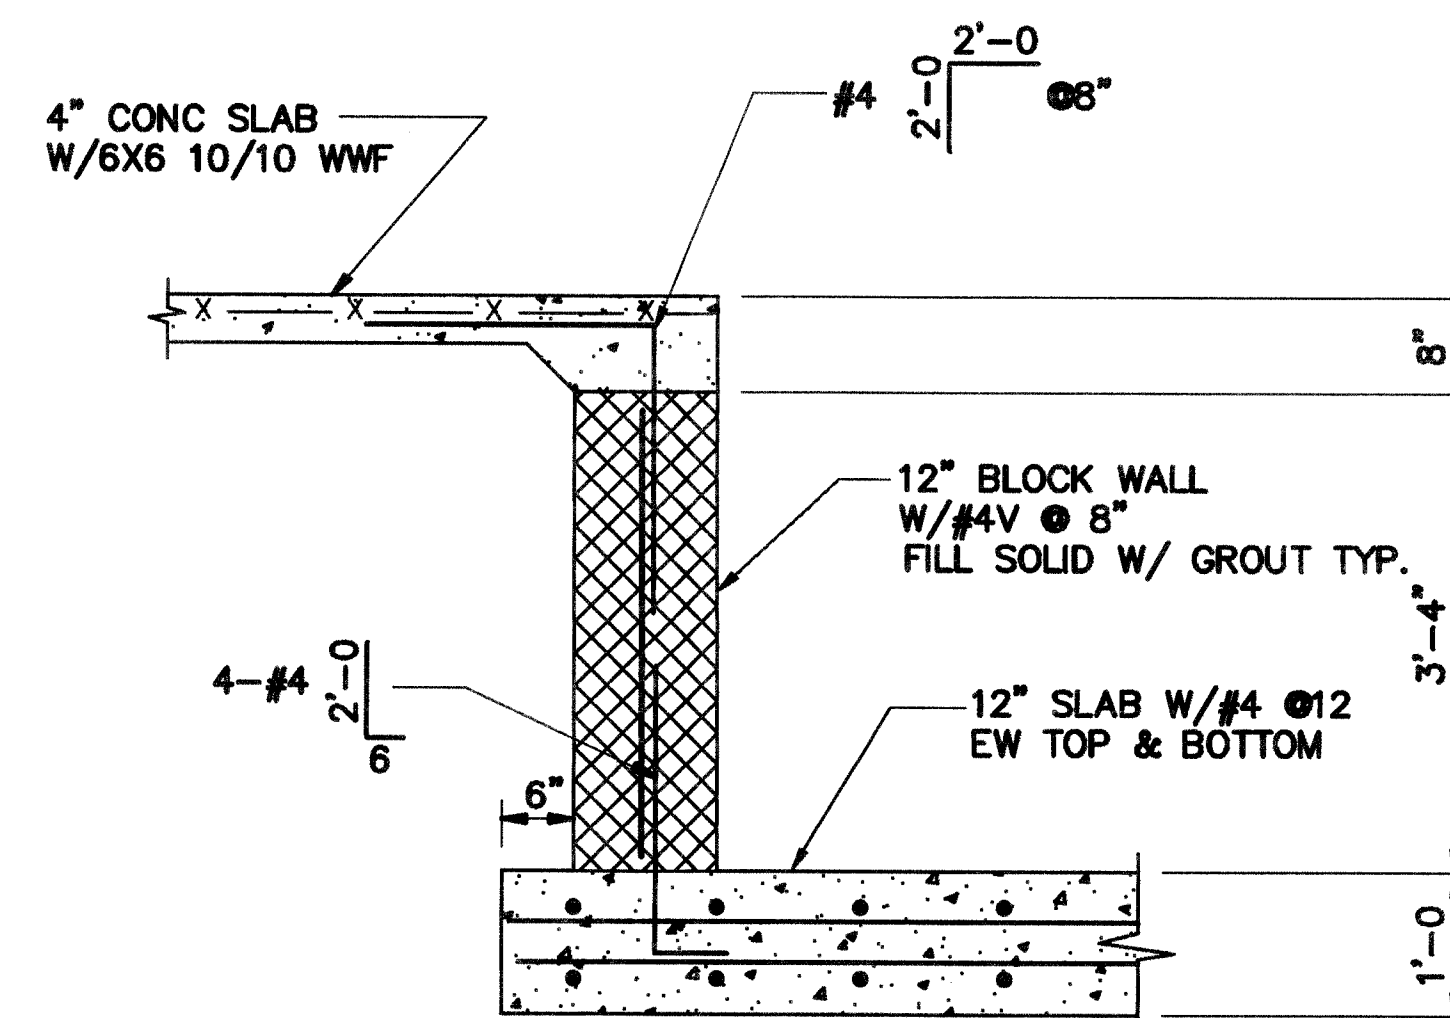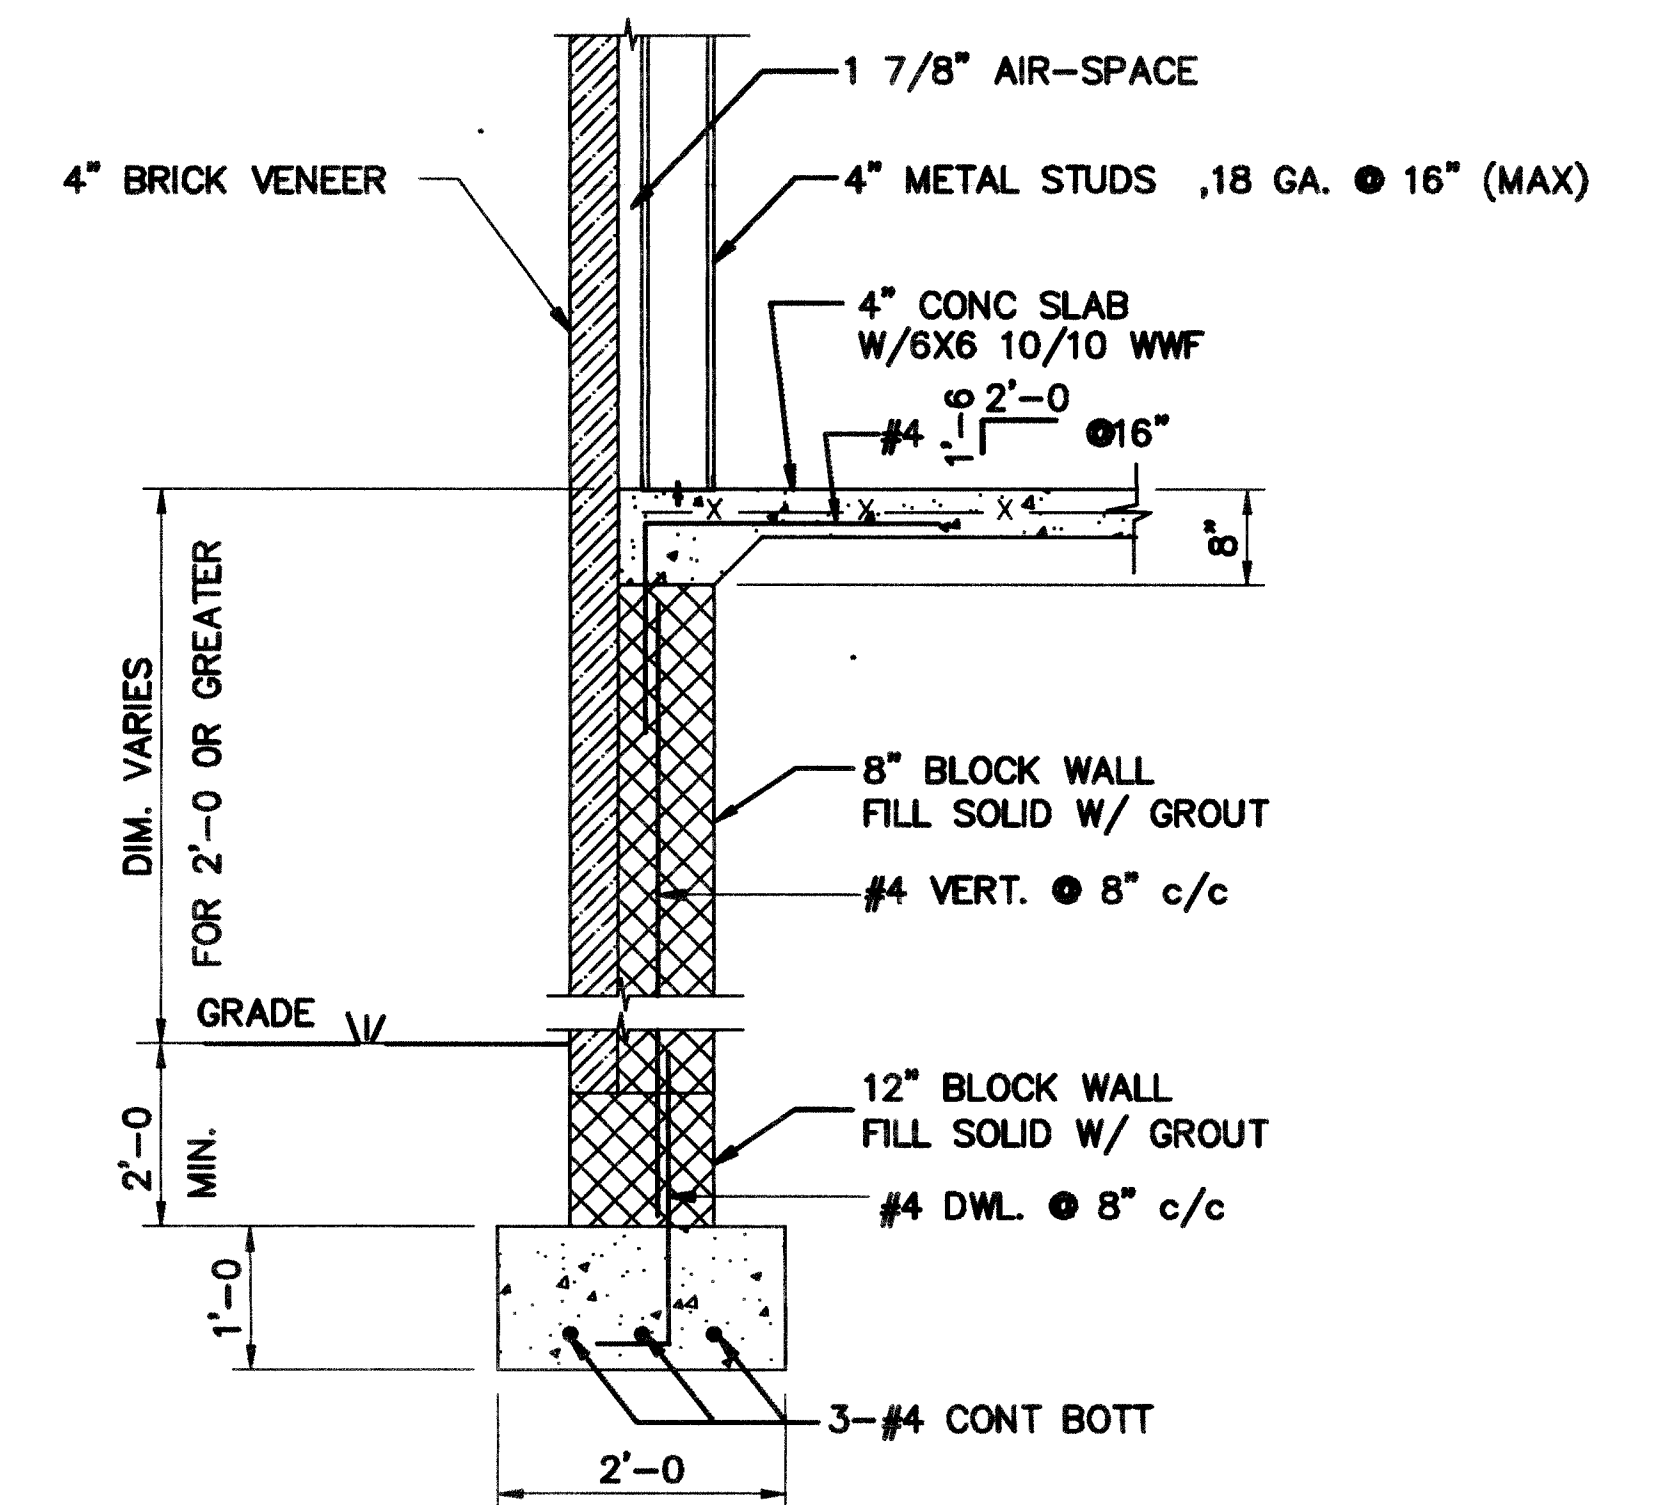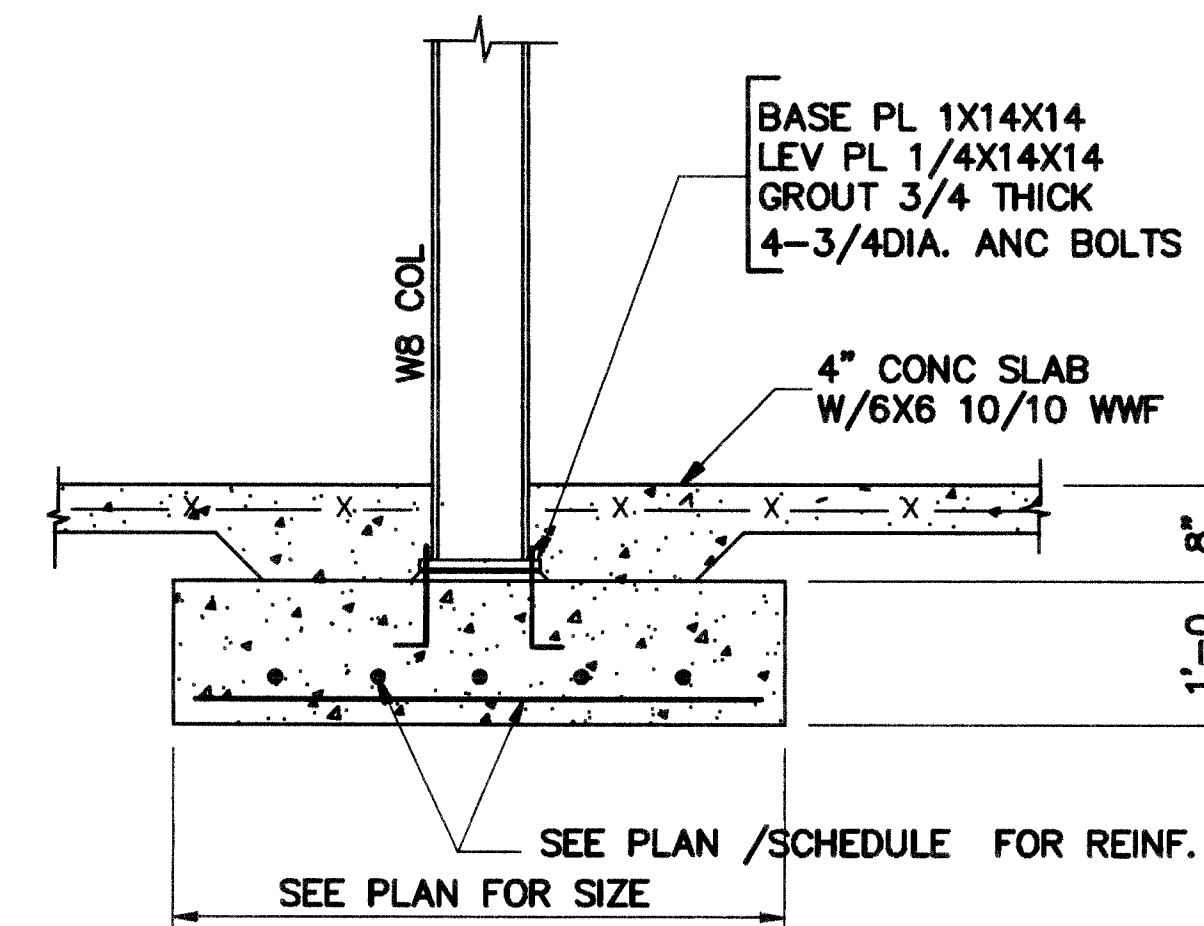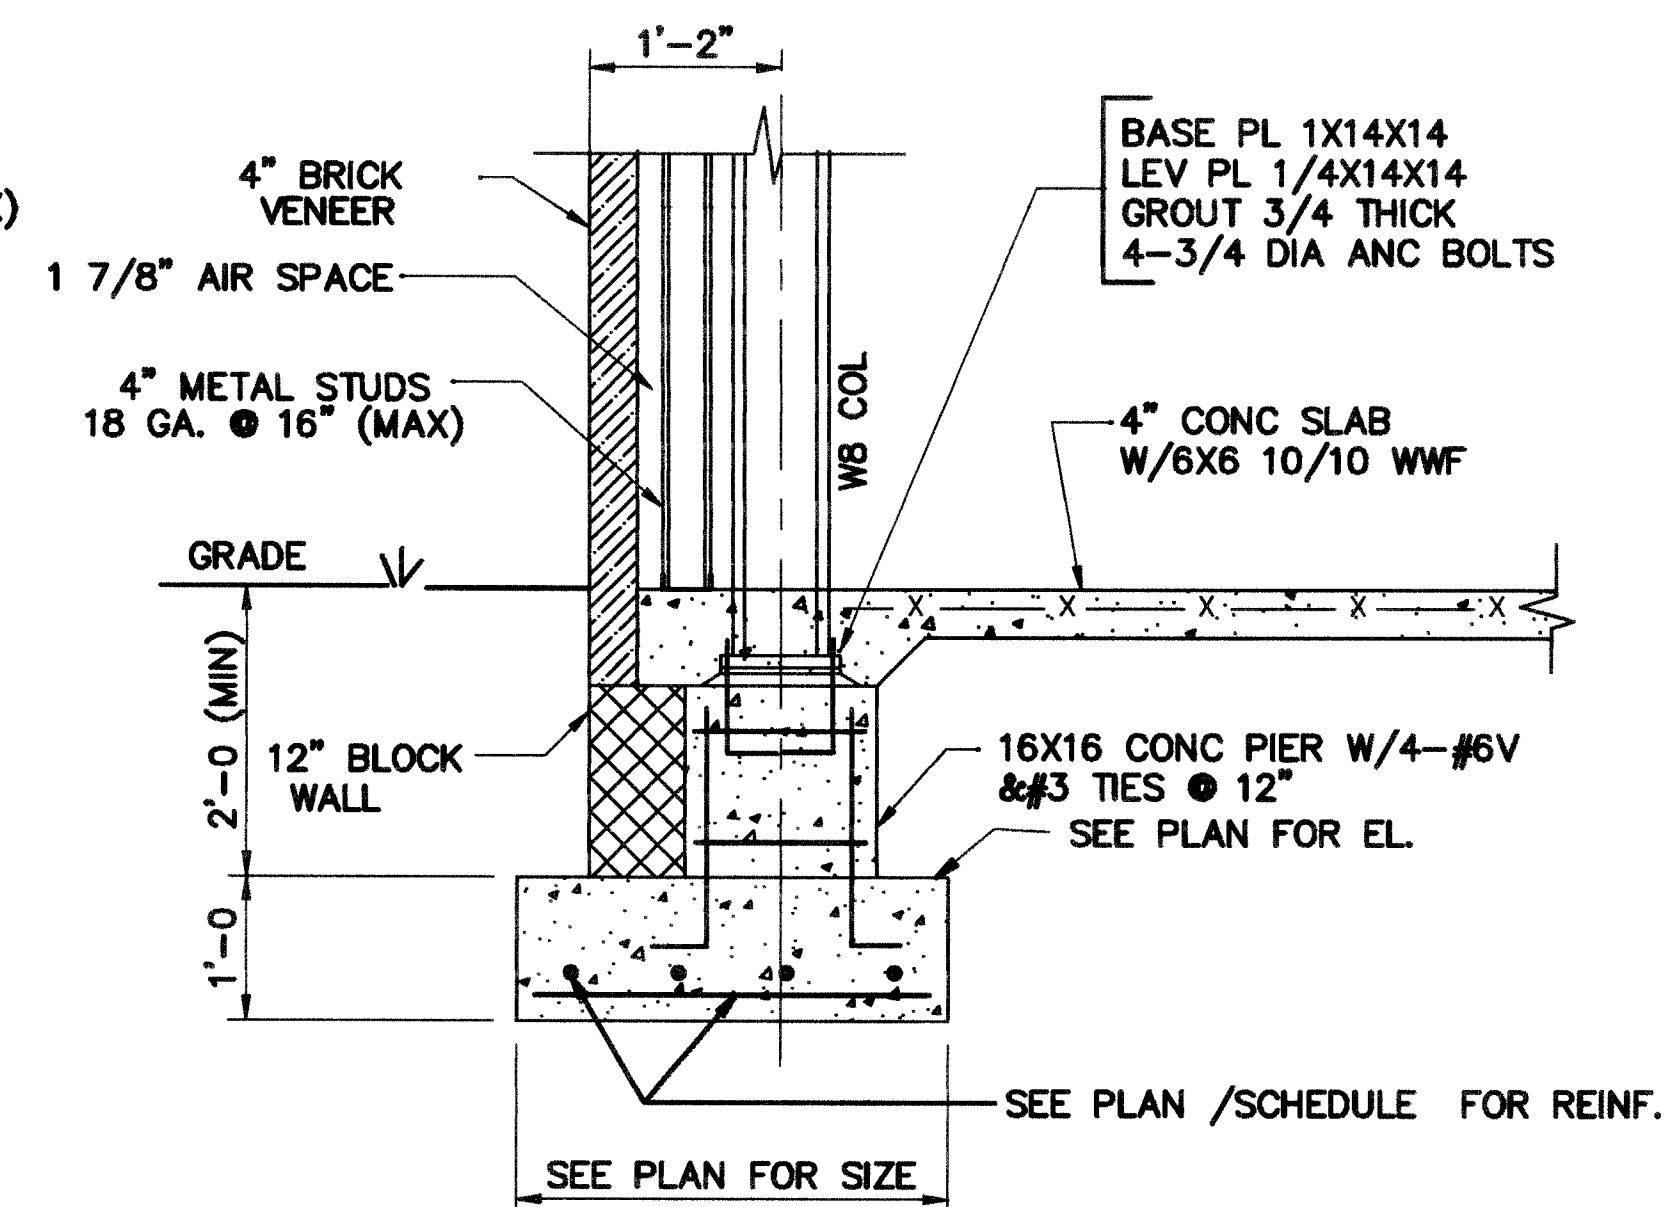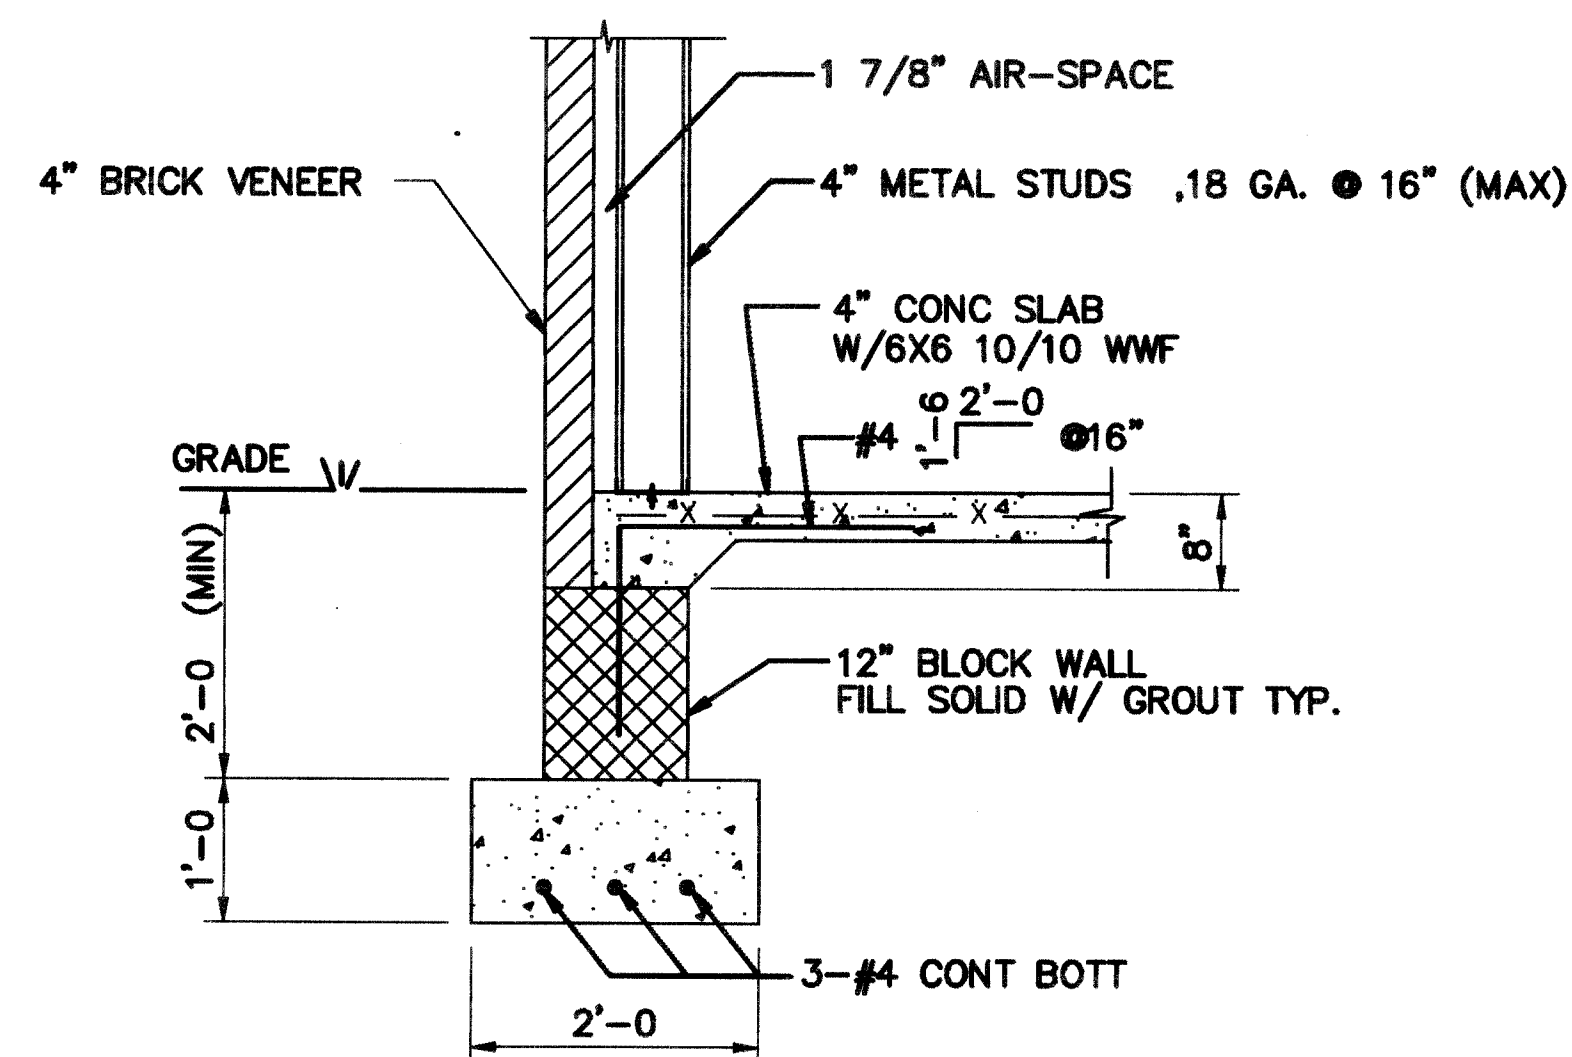


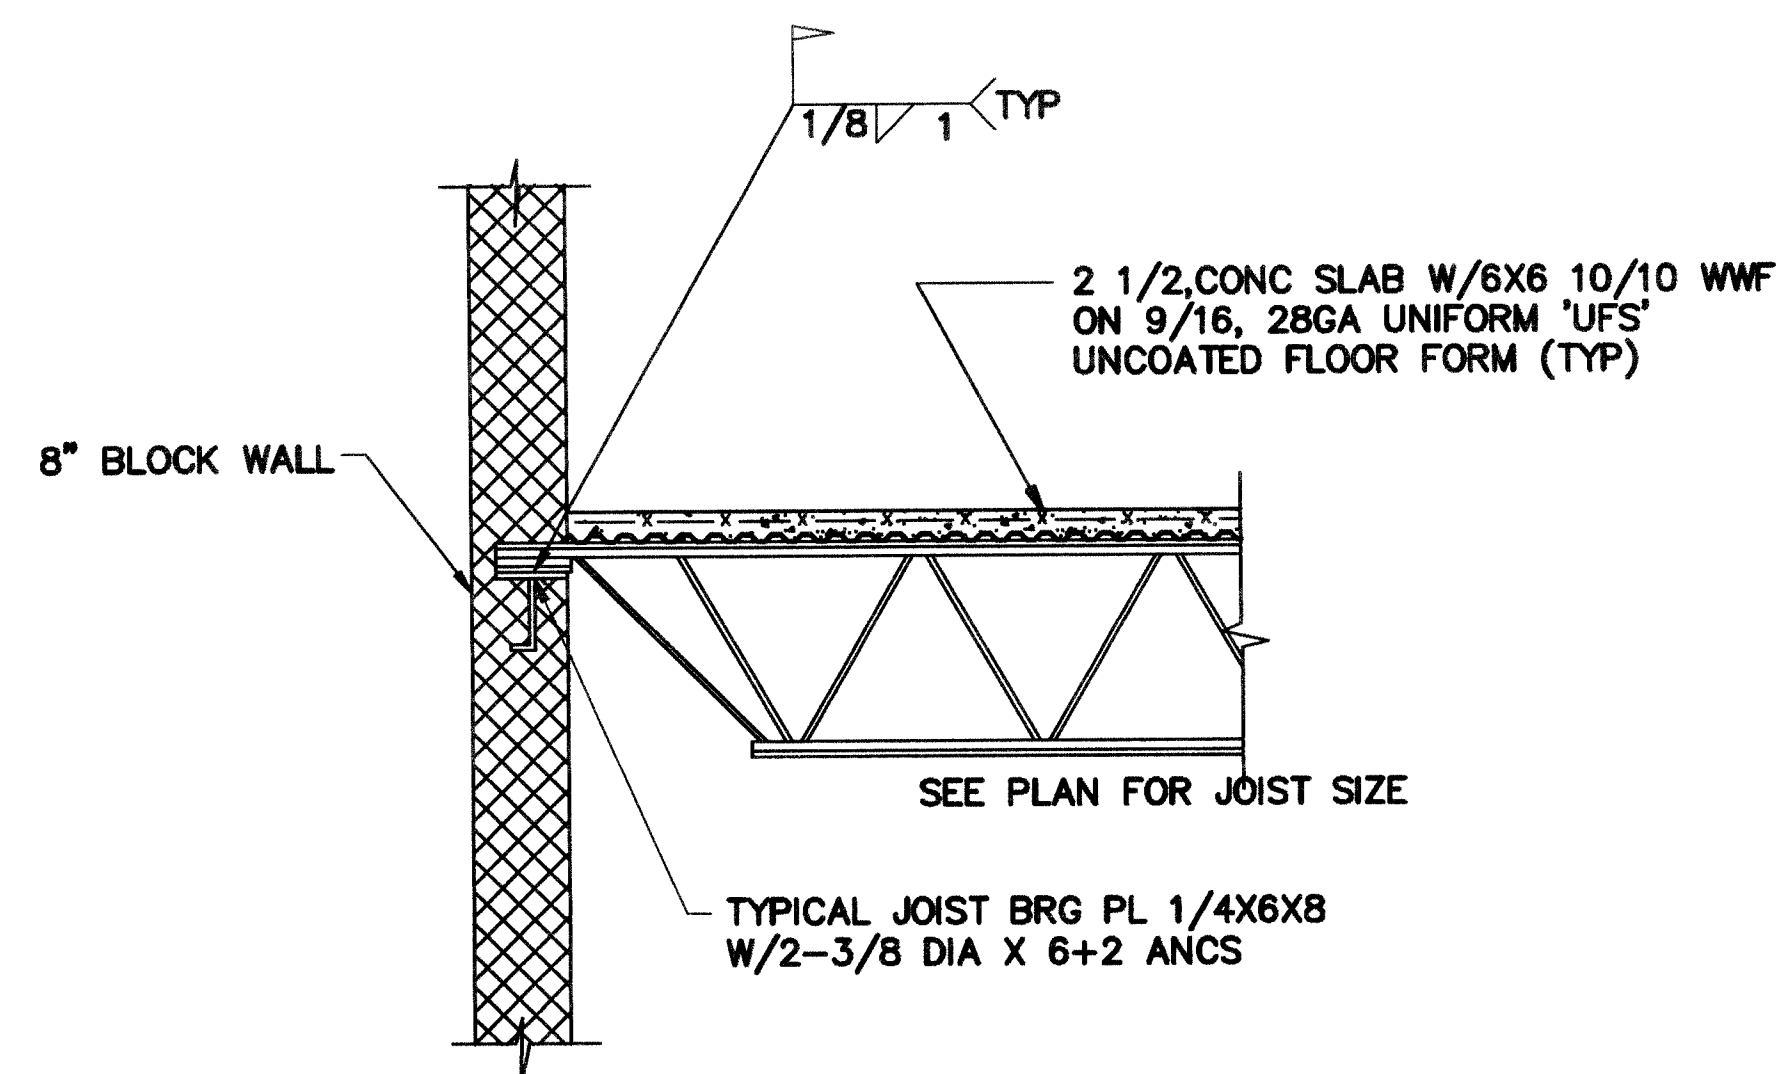


SECTION A-A

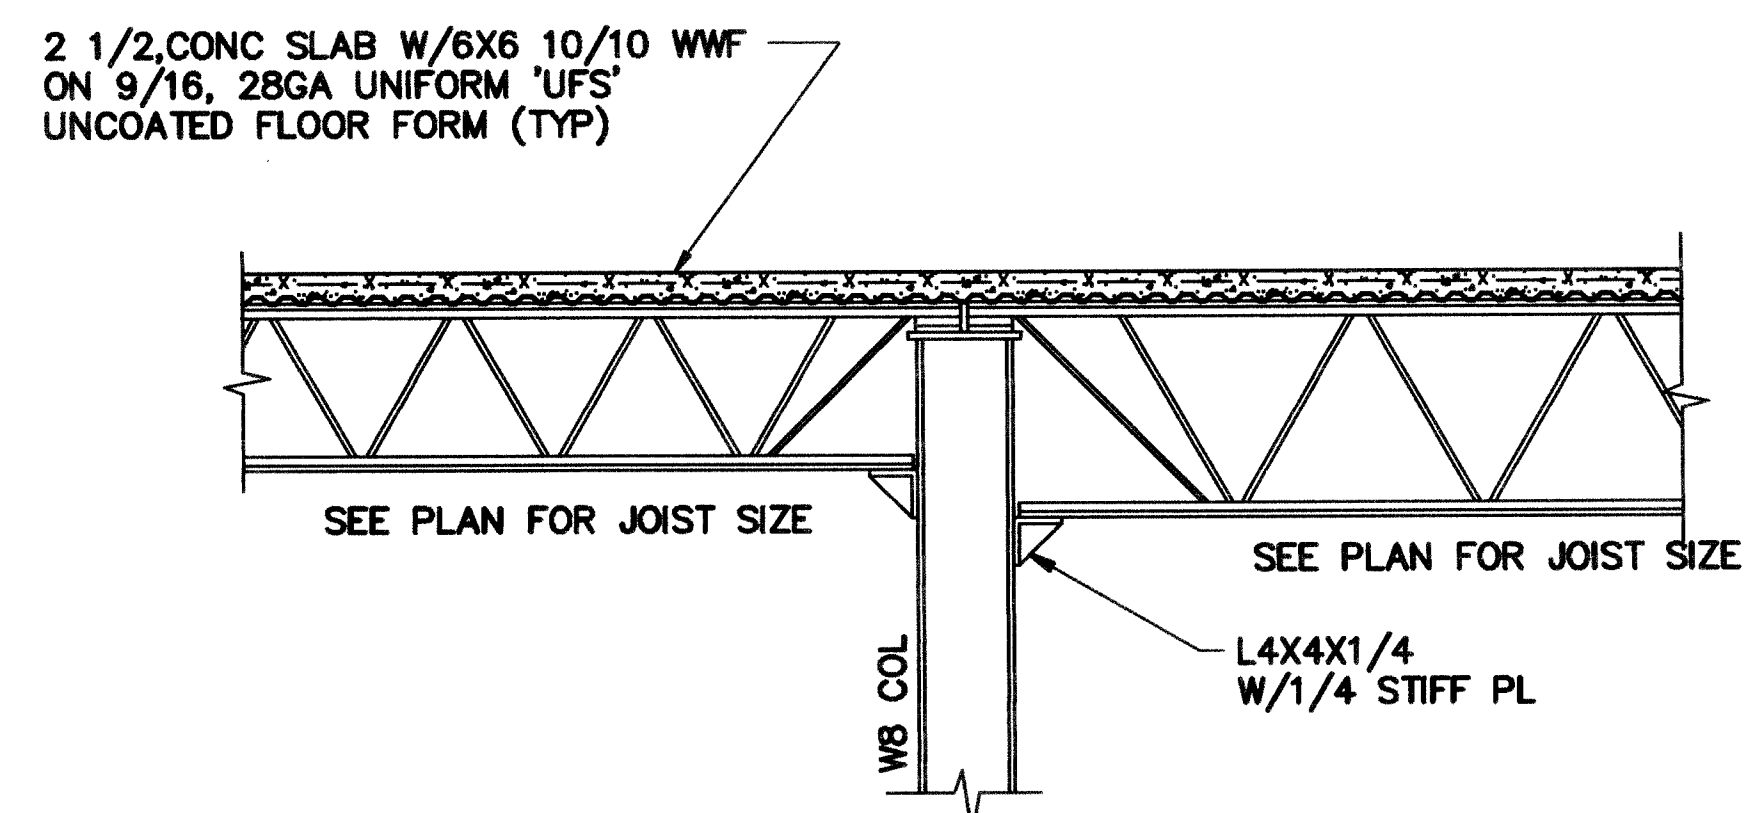


SECTION B-B

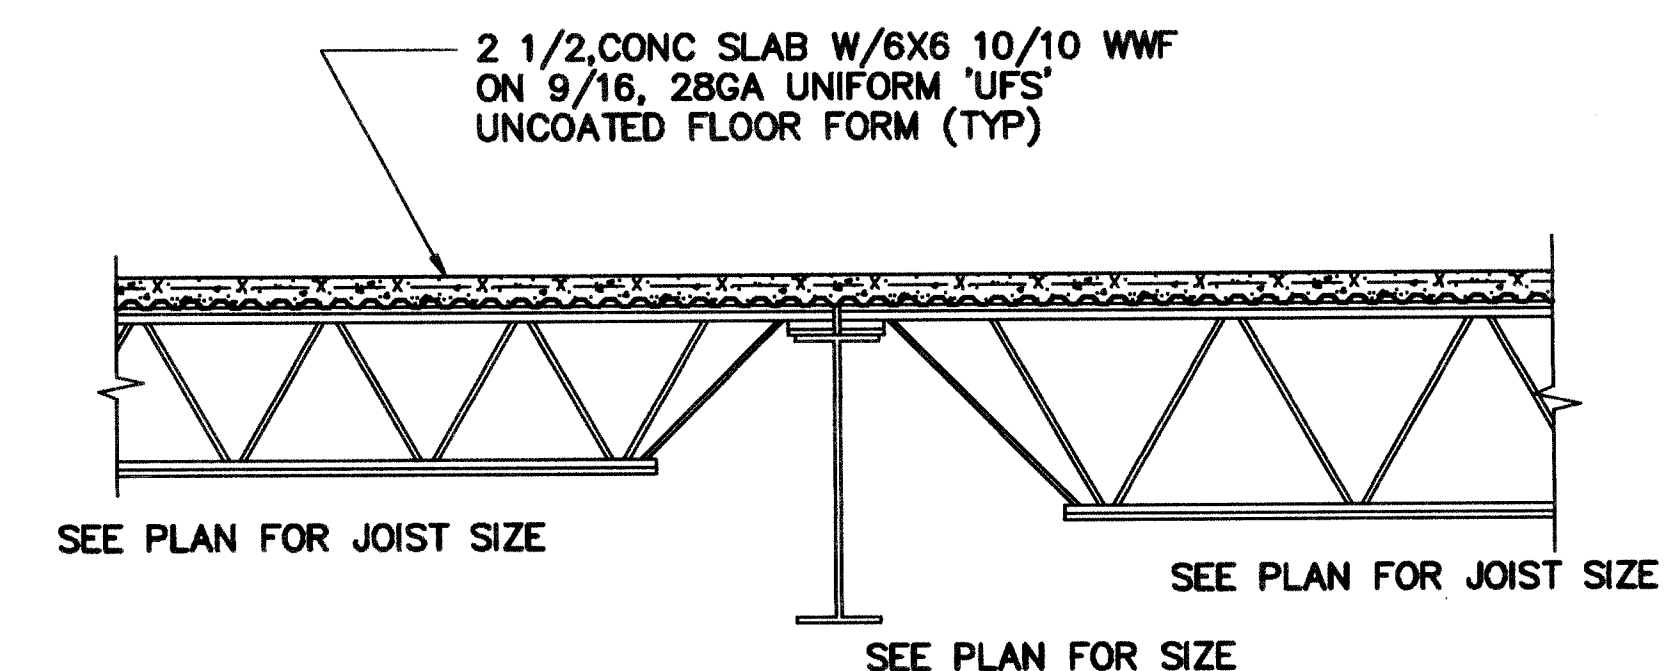


SECTION C-C

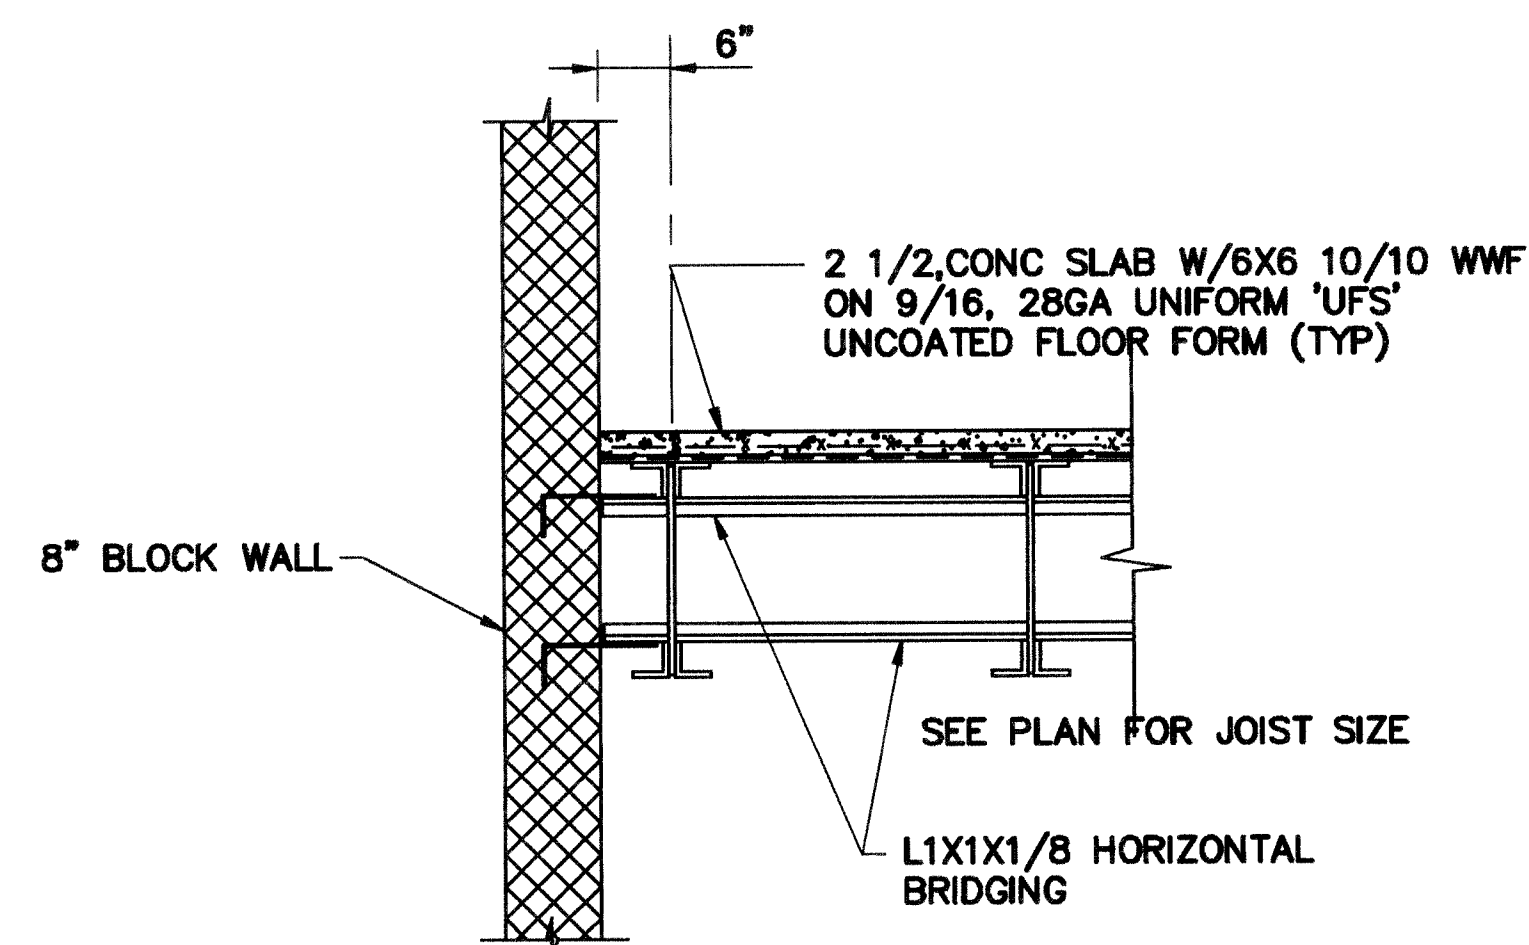


SECTION D-D

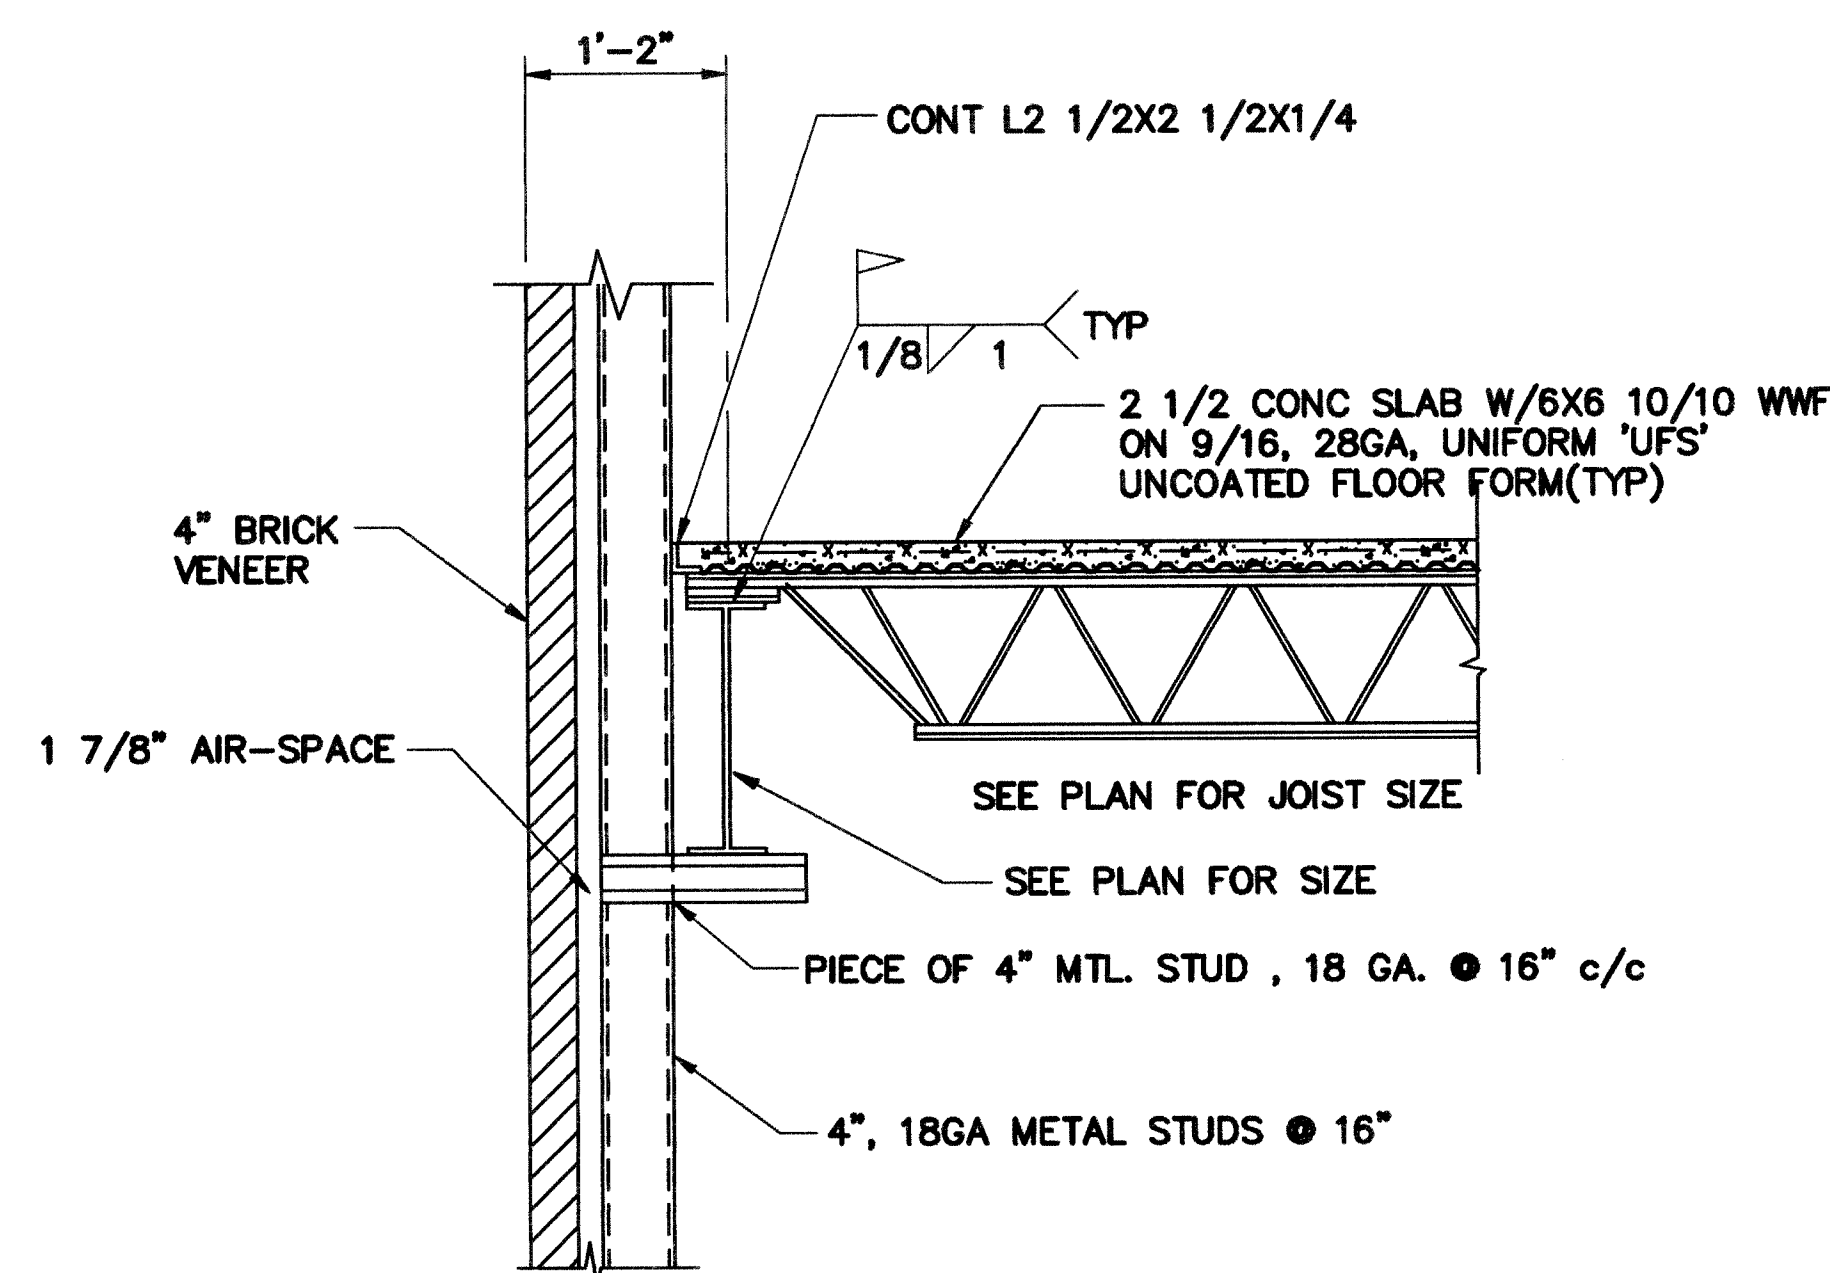


SECTION E-E

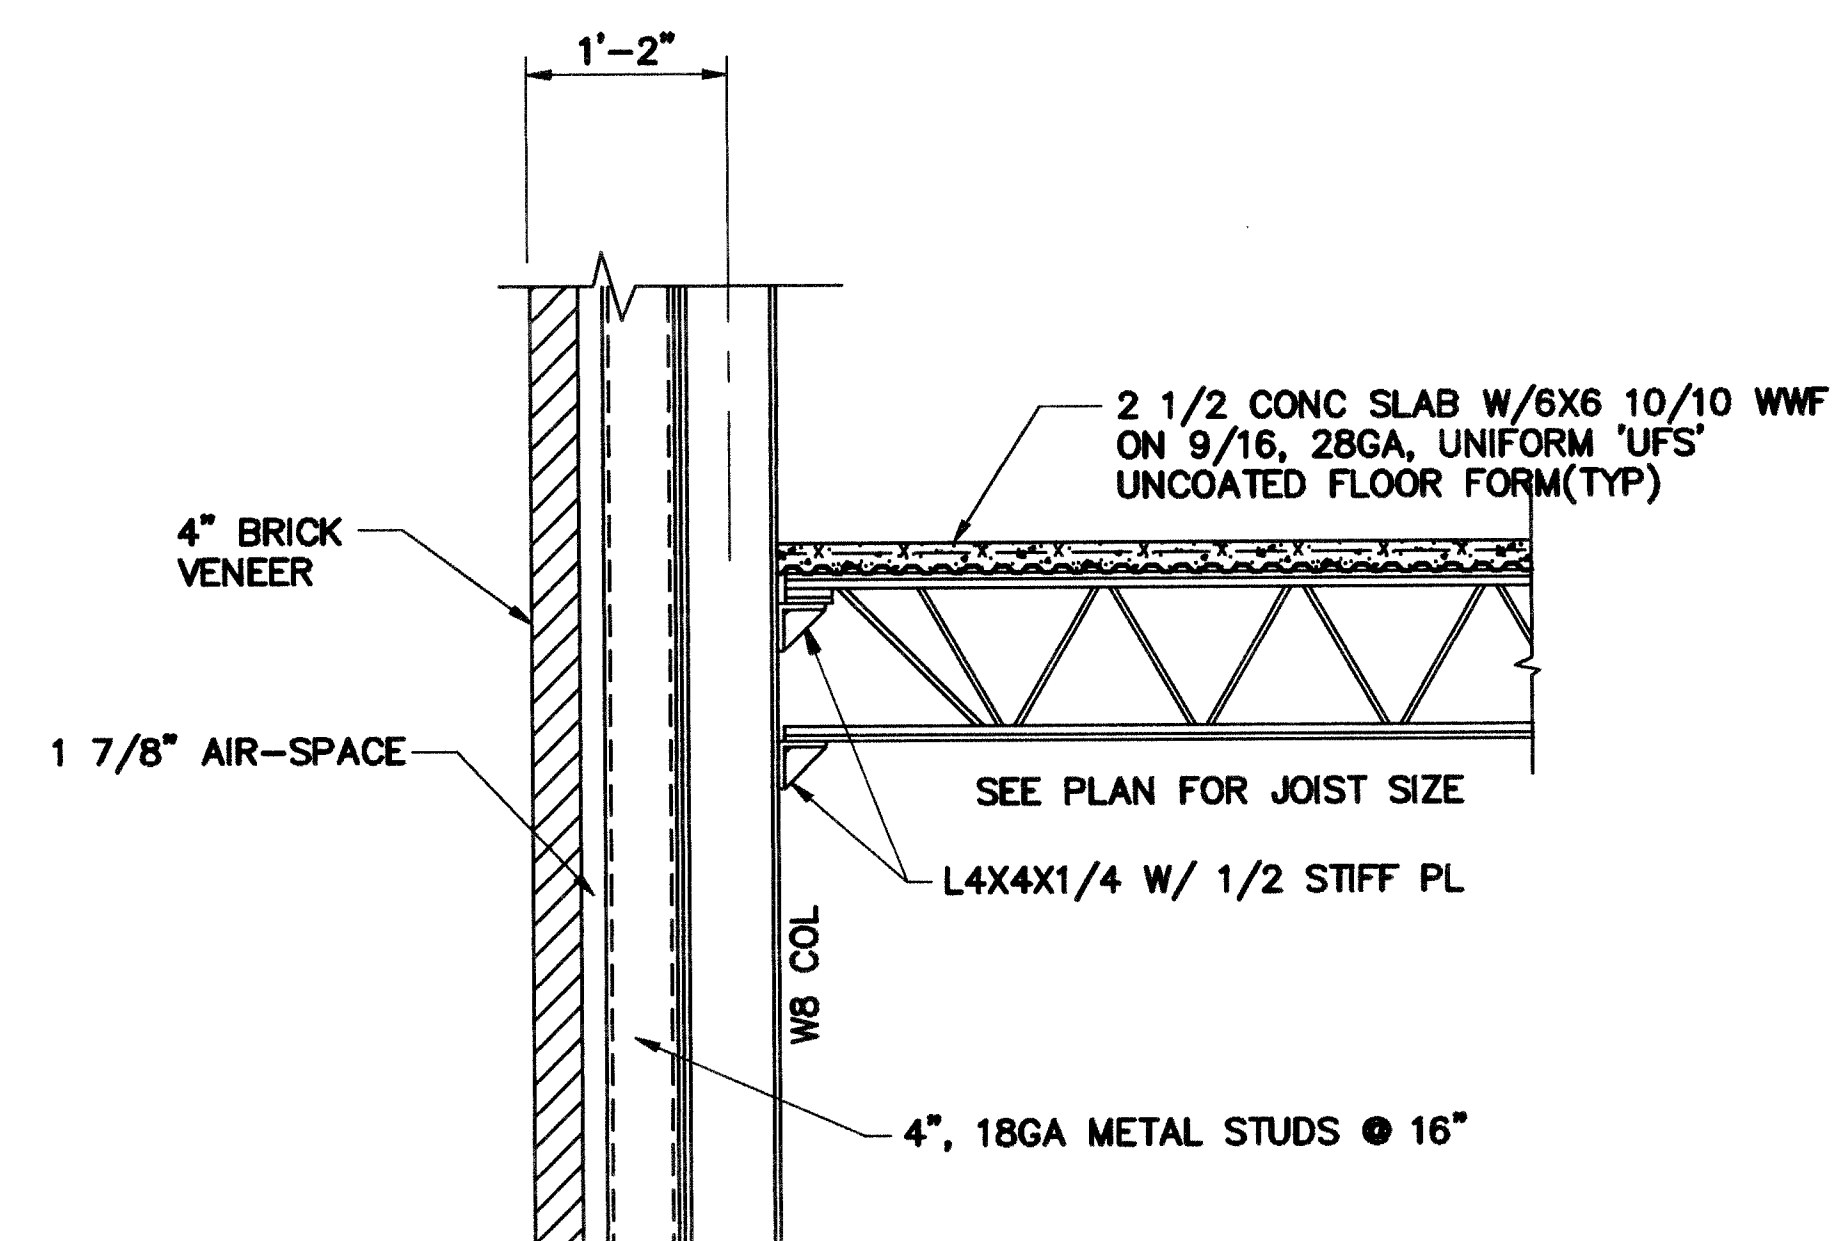

SECTION F-F

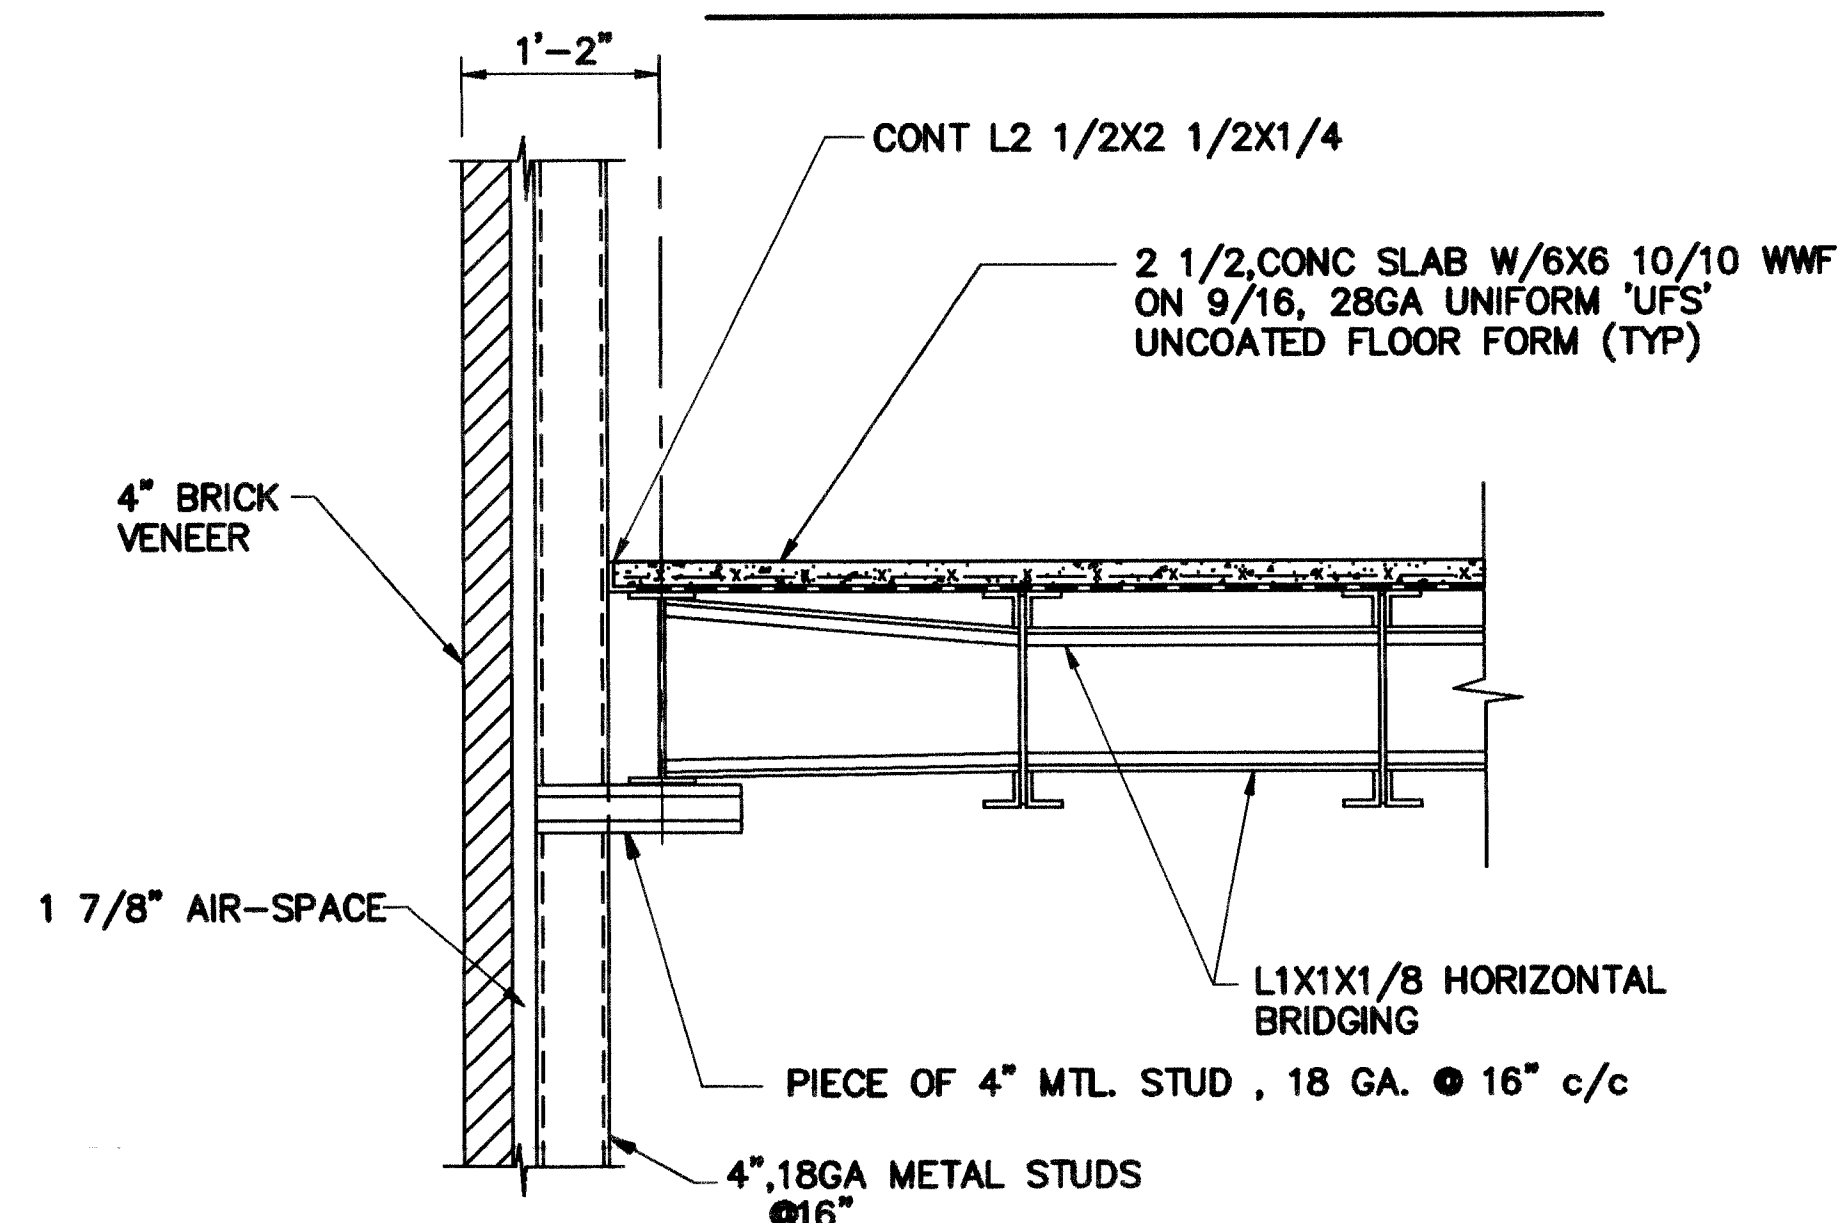


SECTION G-G

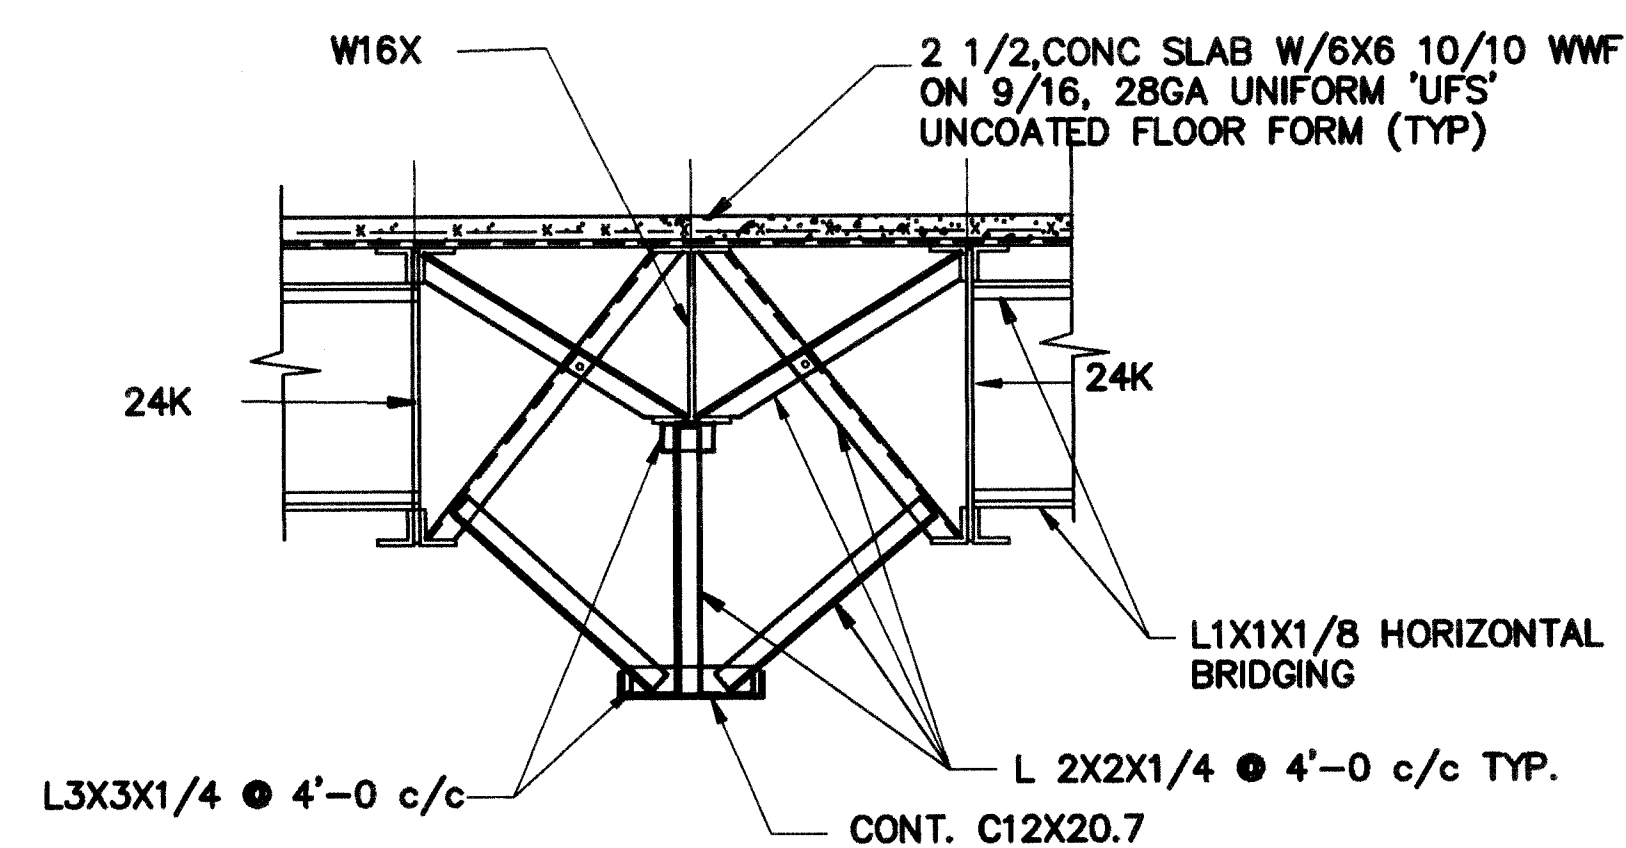


SECTION H-H

SECTION • FOLDING PARTITION


SEAL					
ROBERT R ROSEN ASSOCIATES PROFESSIONAL ENGINEERS 1705 BUTLER PIKE CONSHOHOCKEN PA 19428 A PROFESSIONAL SERVICE CORPORATION					
PROJECT VISITING NURSES ASSOCIATION OF POTTSTOWN 1963 E. HIGH STREET LOWER POTTSGROVE TWP. , POTTSTOWN, PA.					
S-5					
date 10/30/95	job # 96424	scale 3/4" = 1'-0"	drawn by JSM	rev date 11/6/95	sheet # 13 of 14

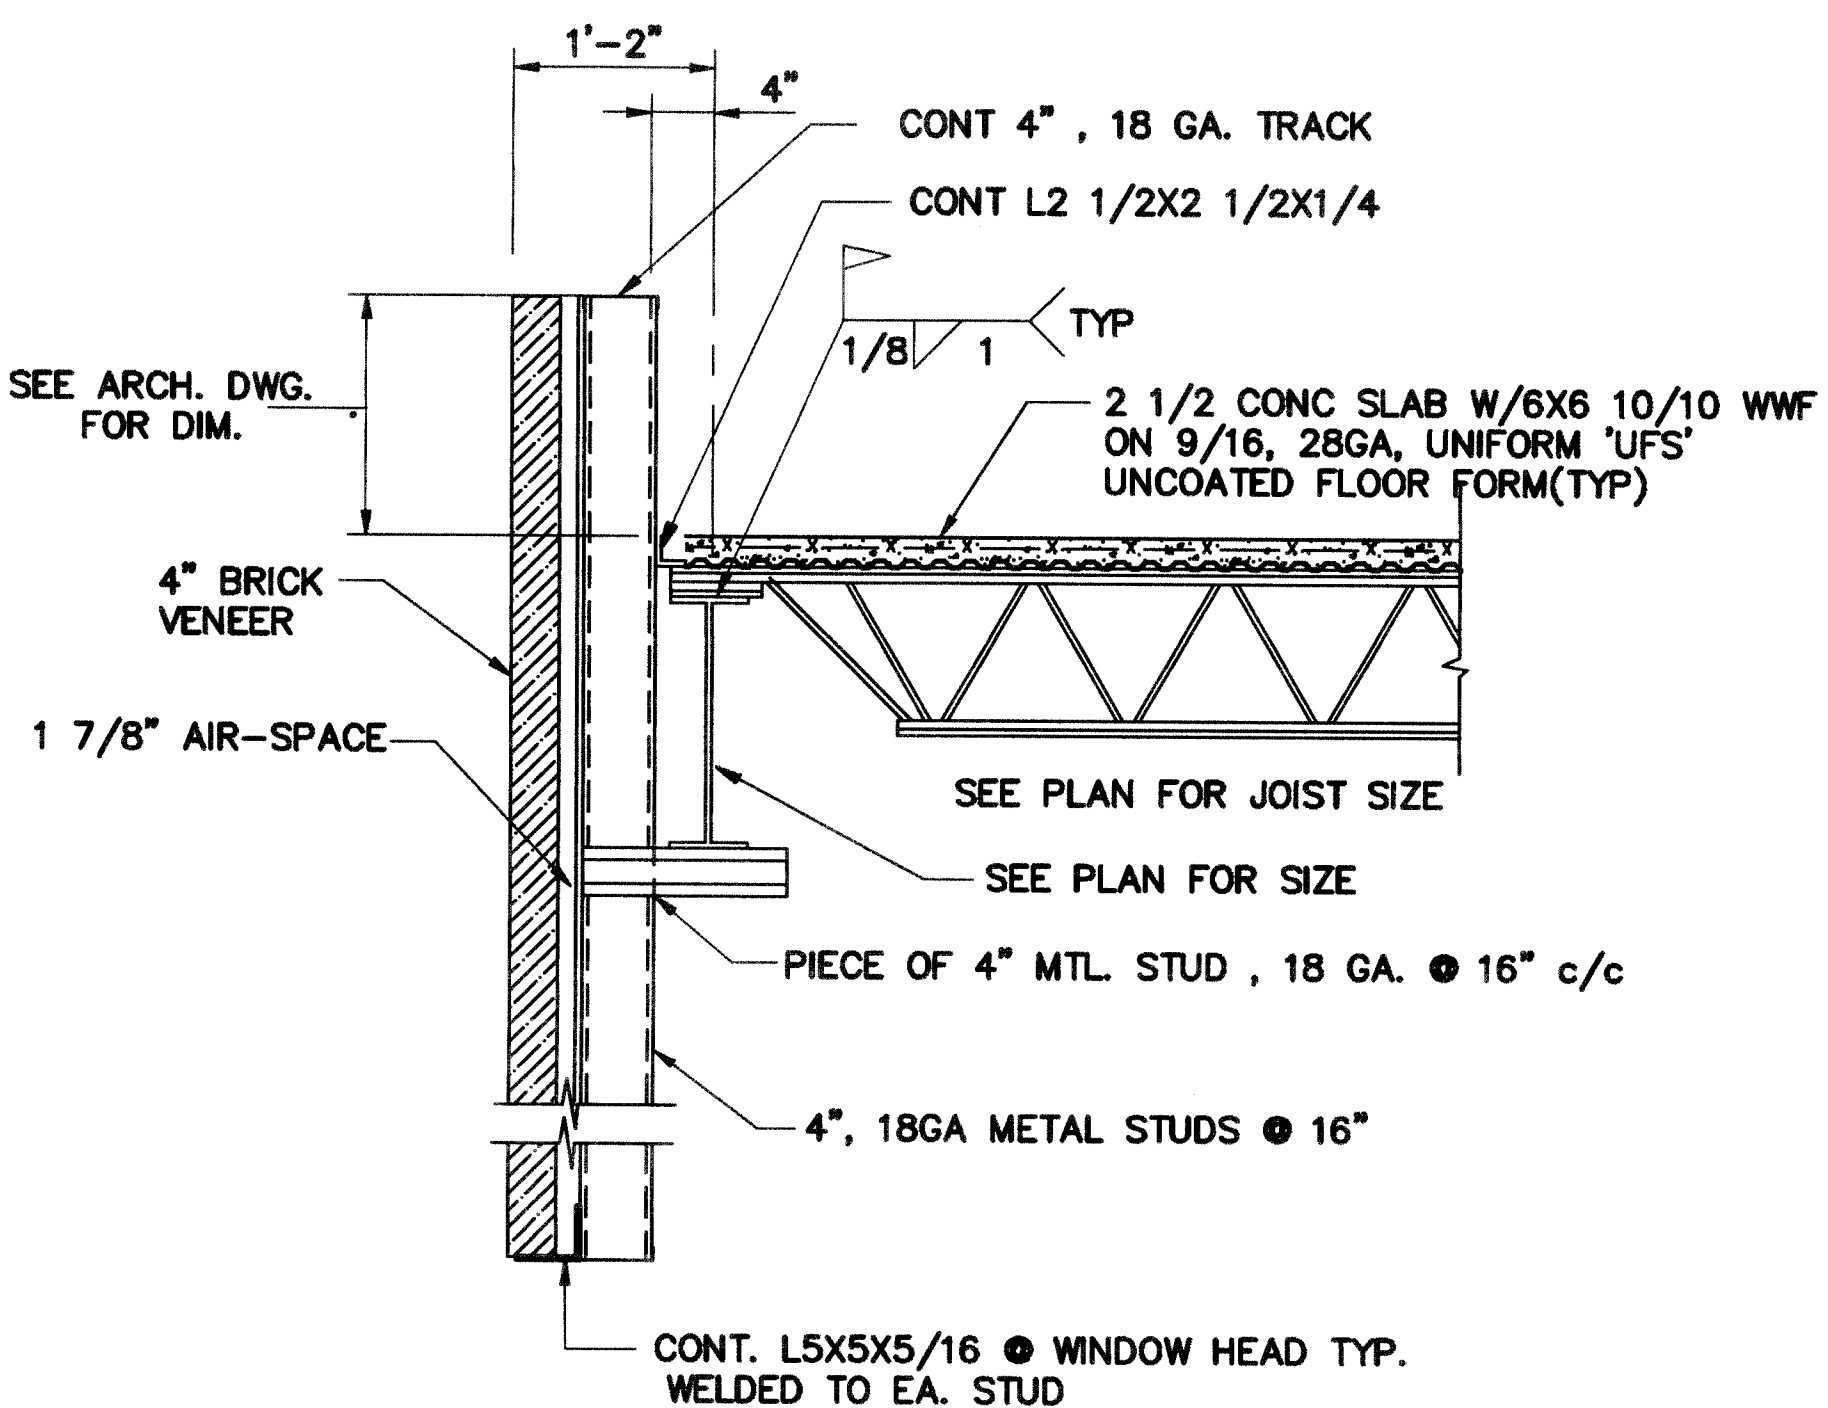


SECTION J-J

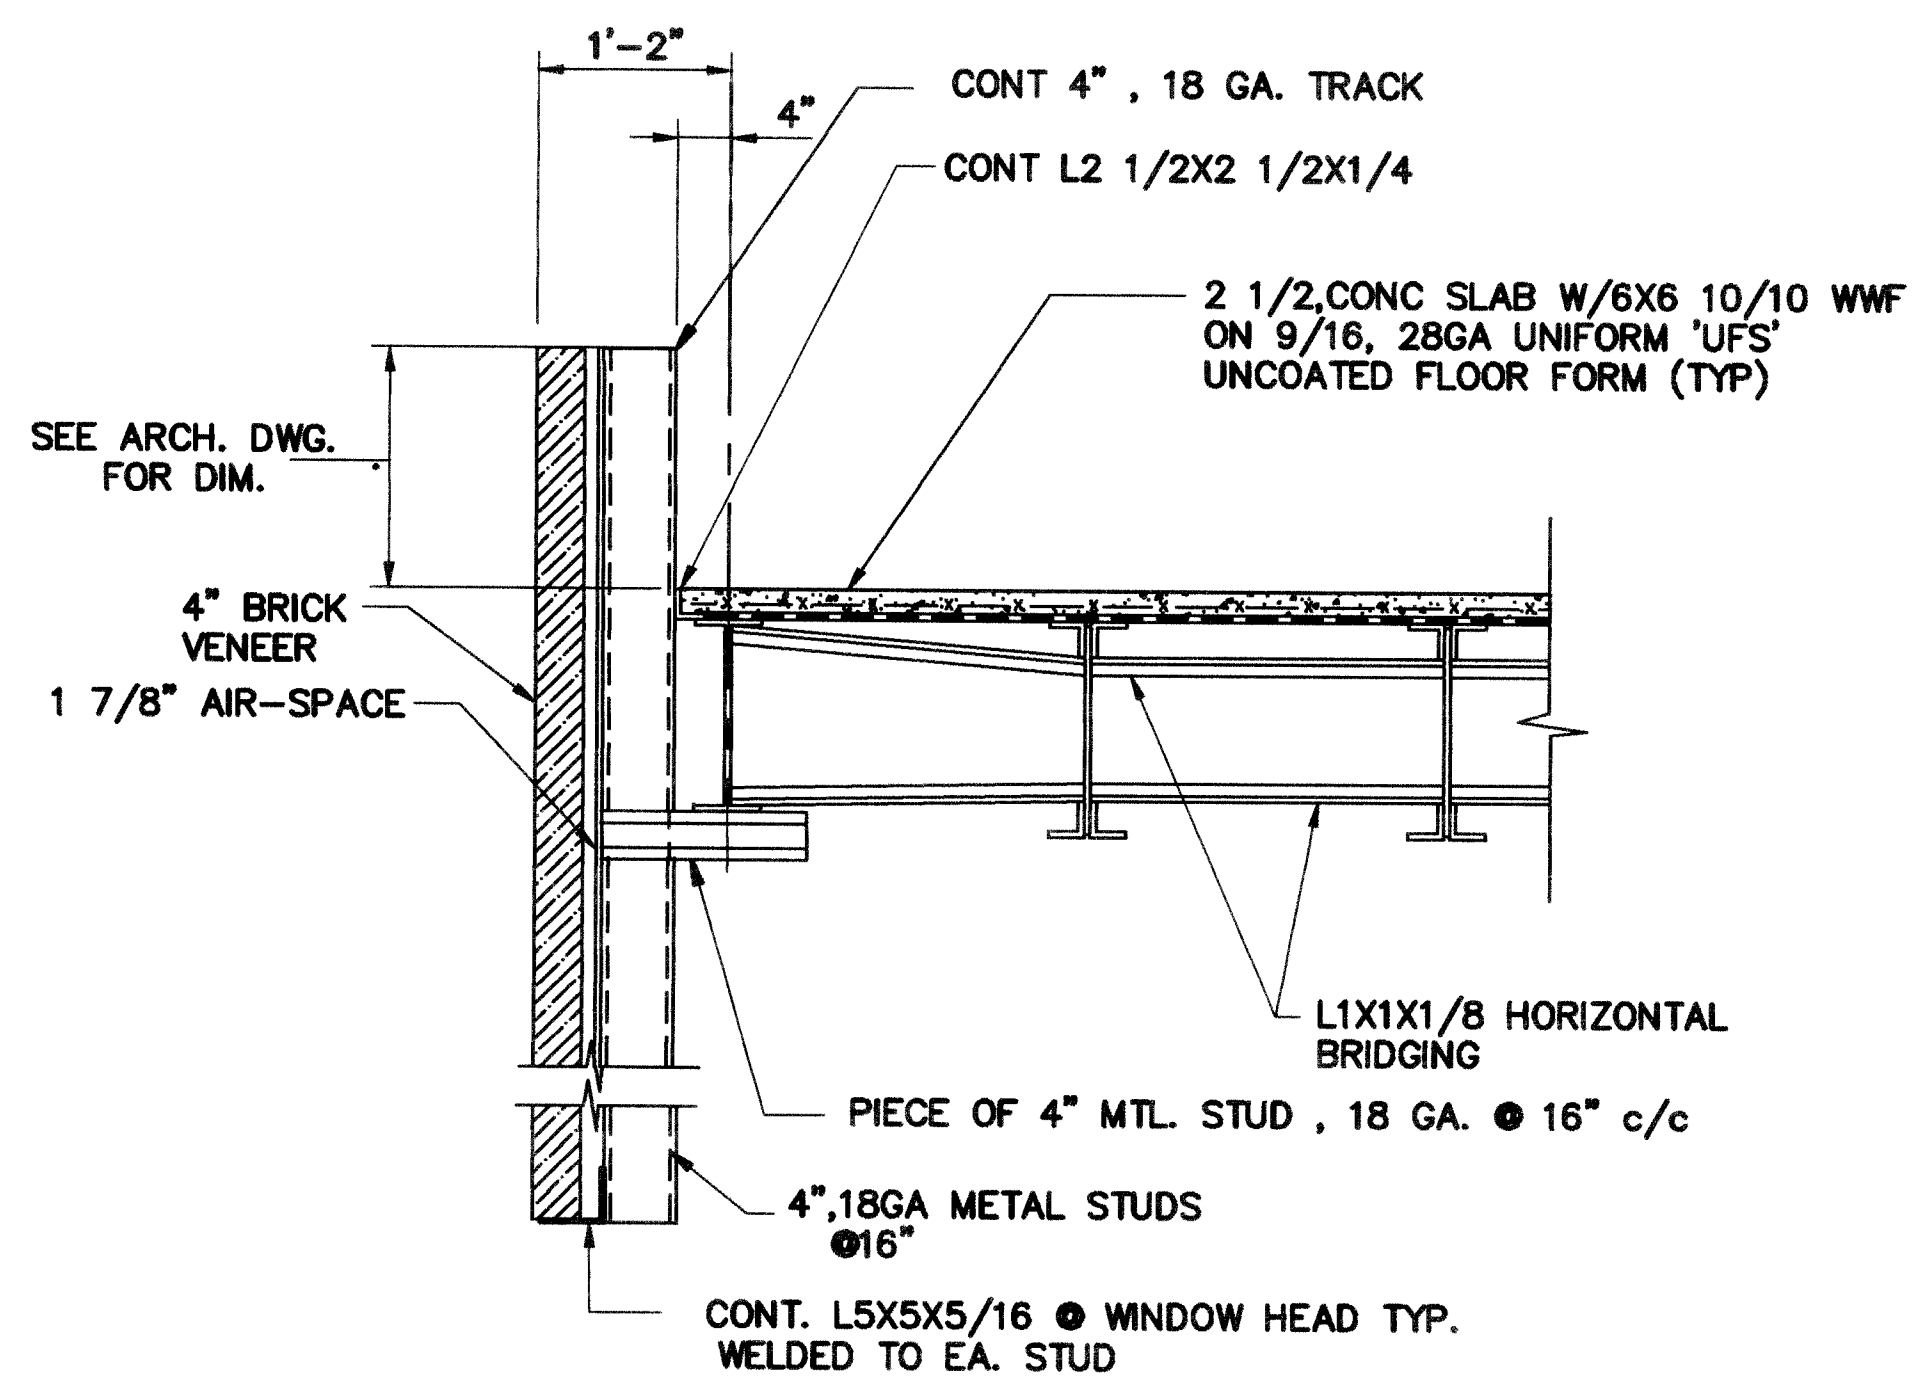


SECTION K-K

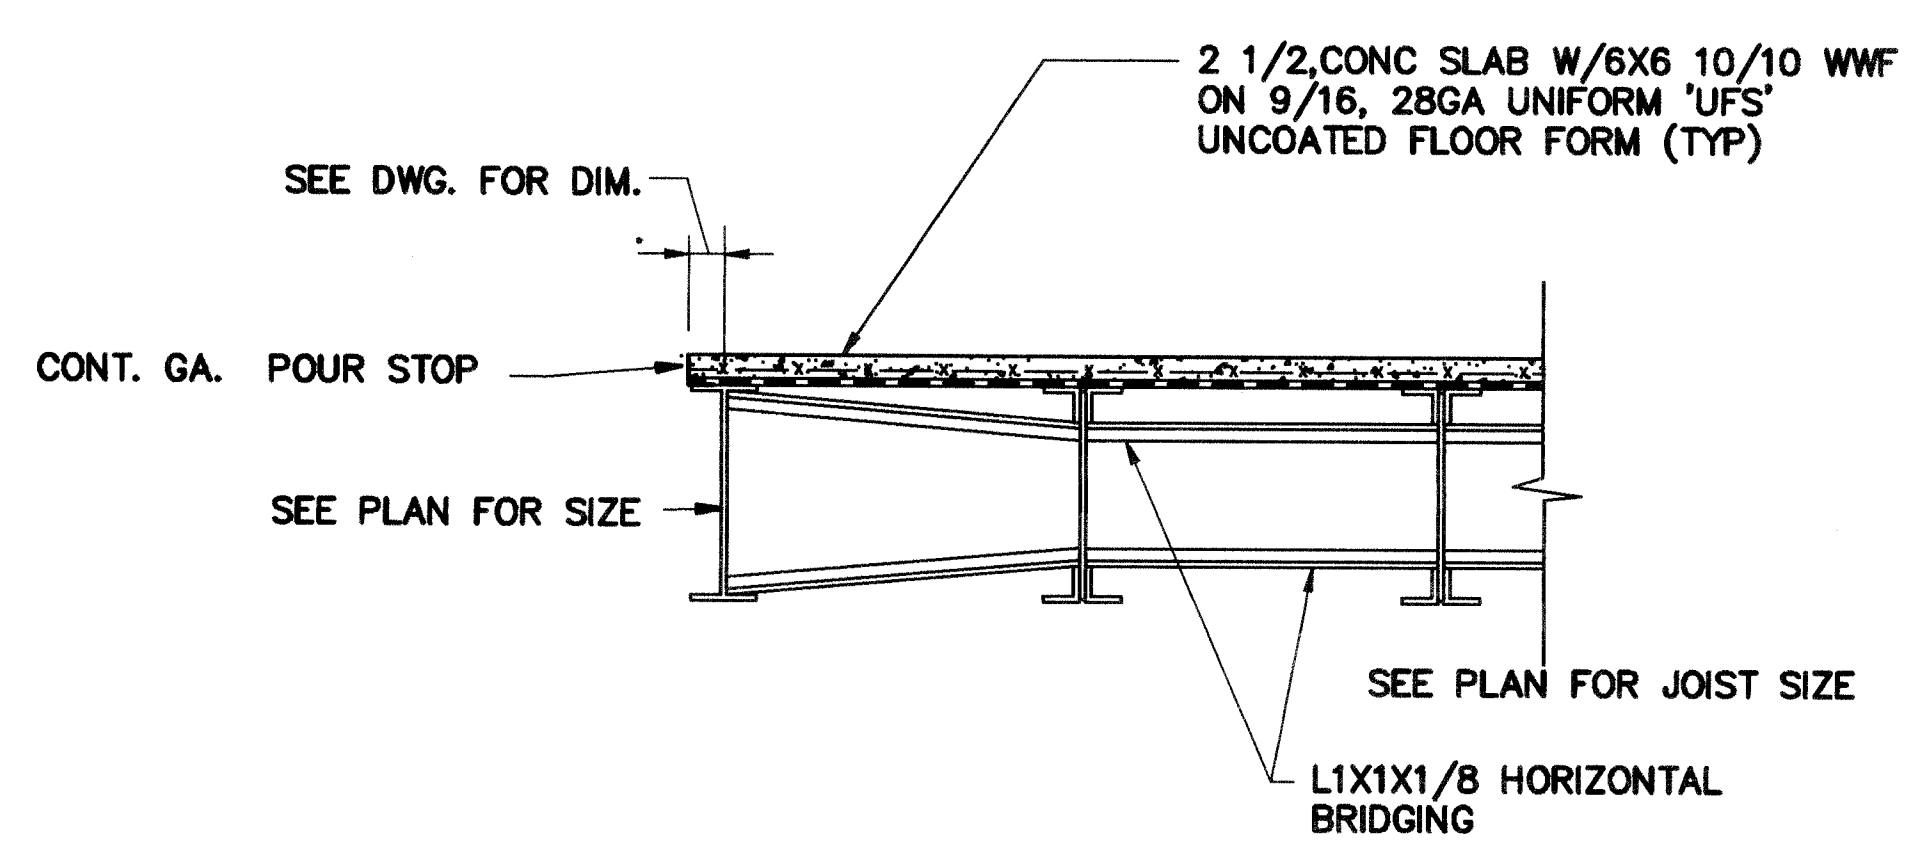


SECTION L-L

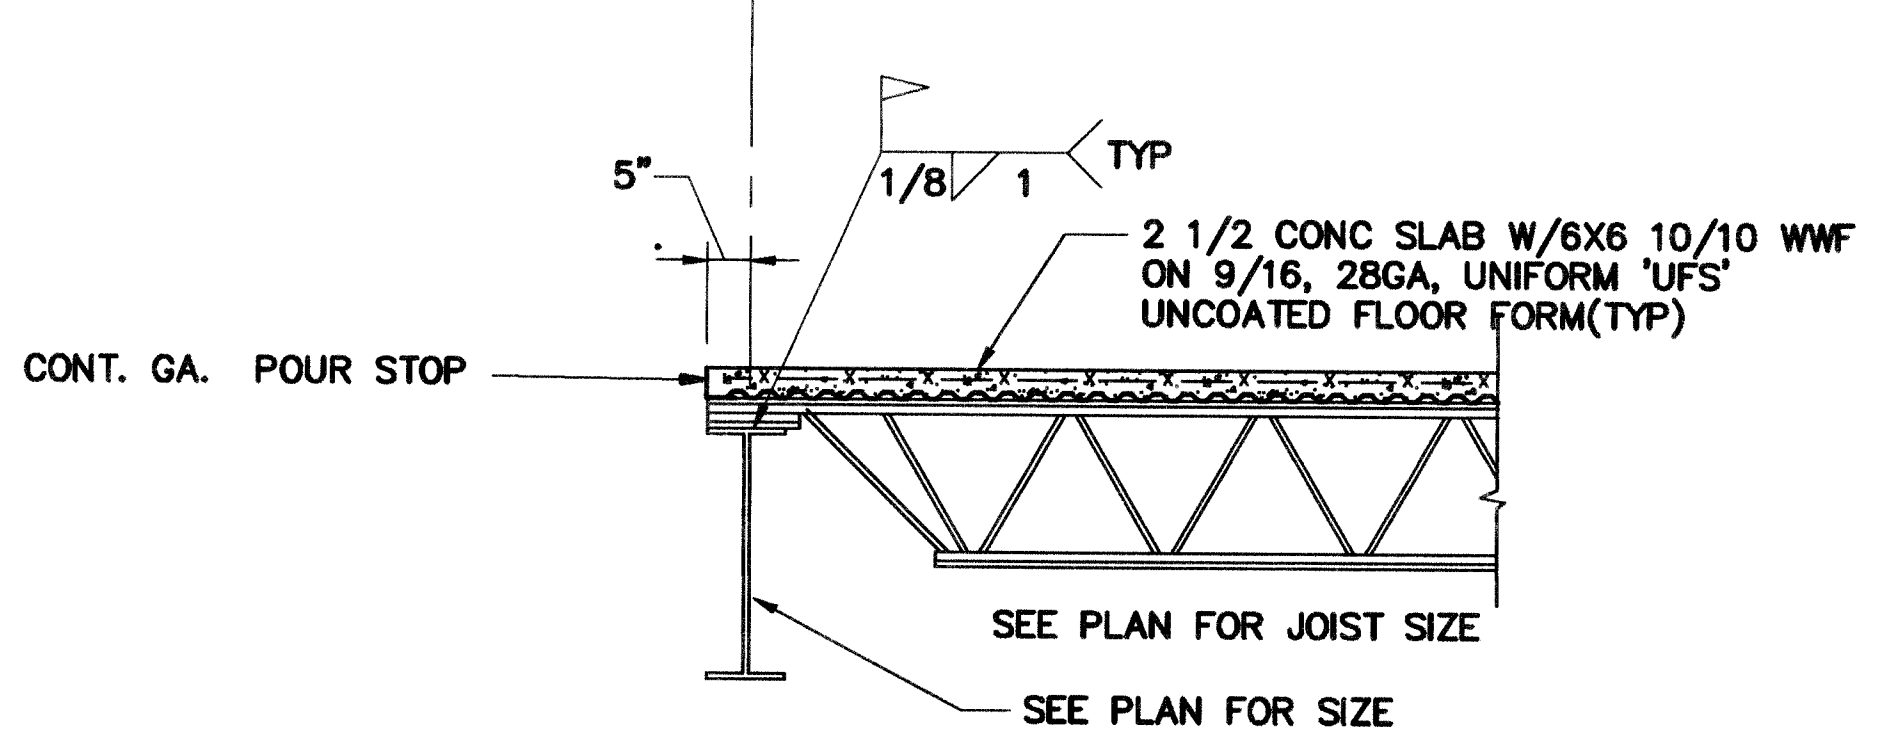


SECTION M-M

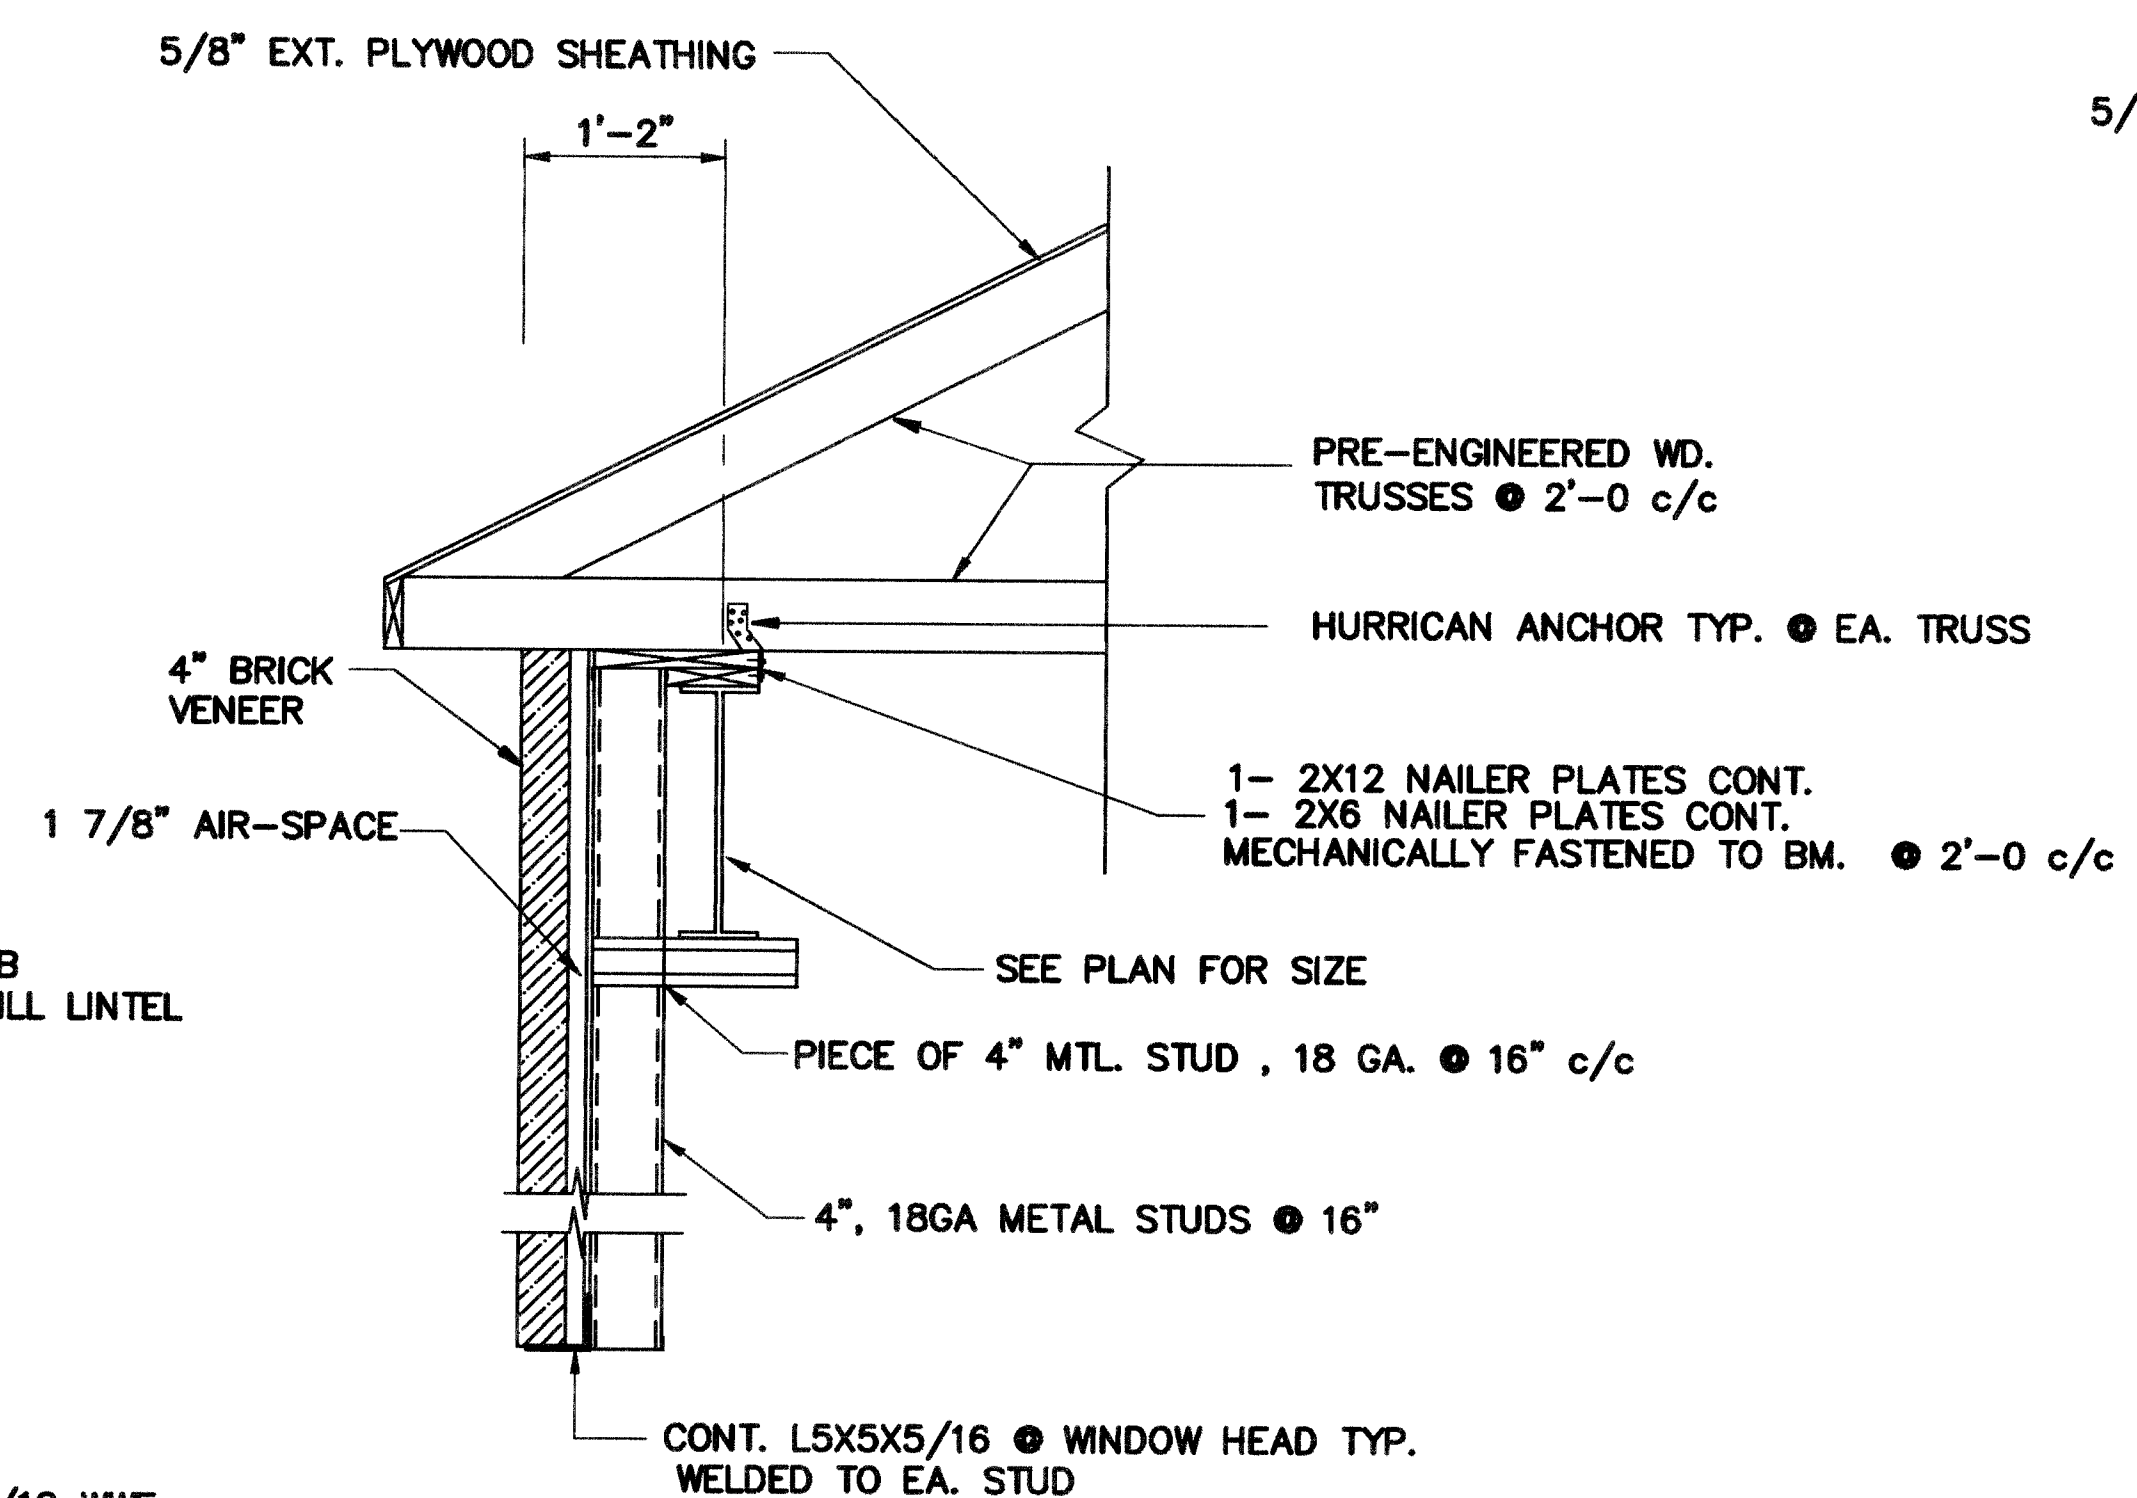

SECTION N-N

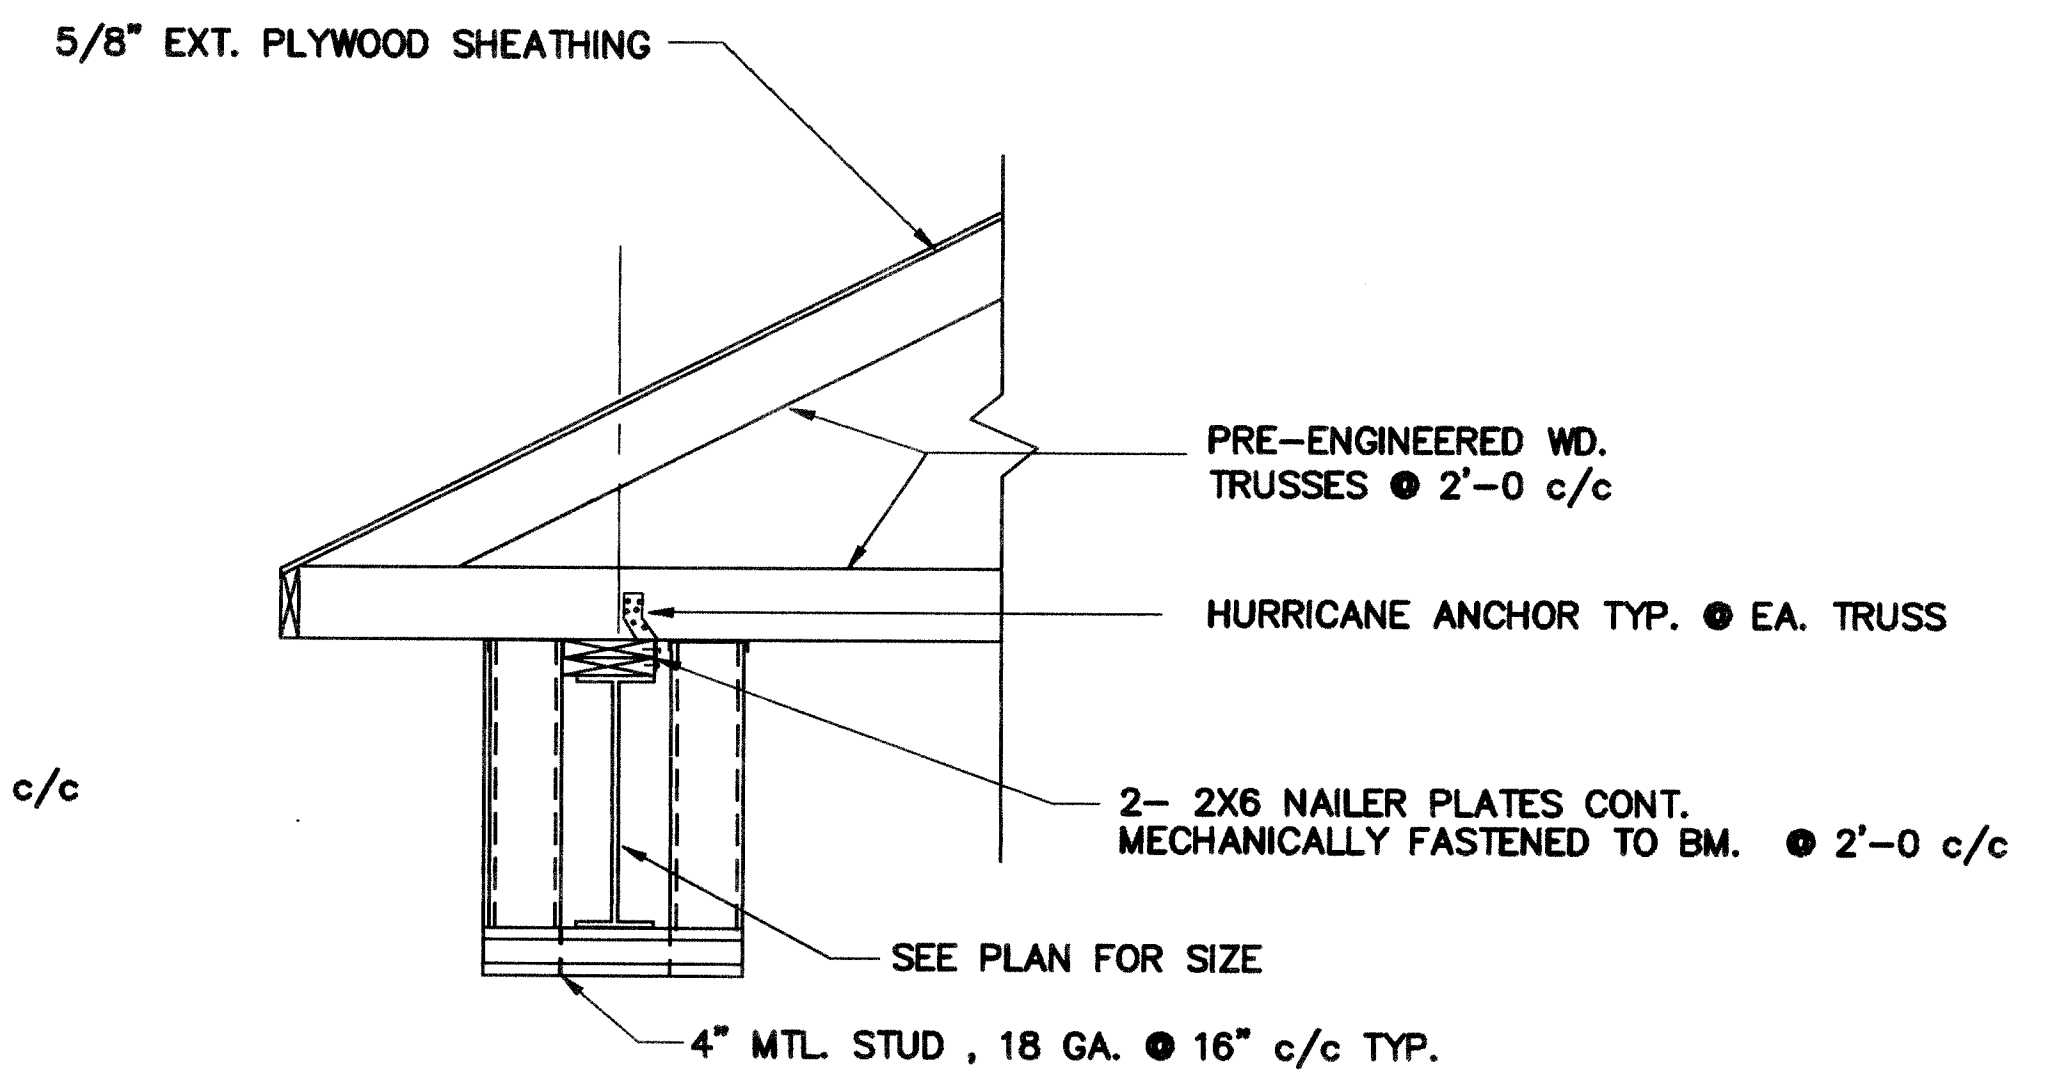

SECTION O-O

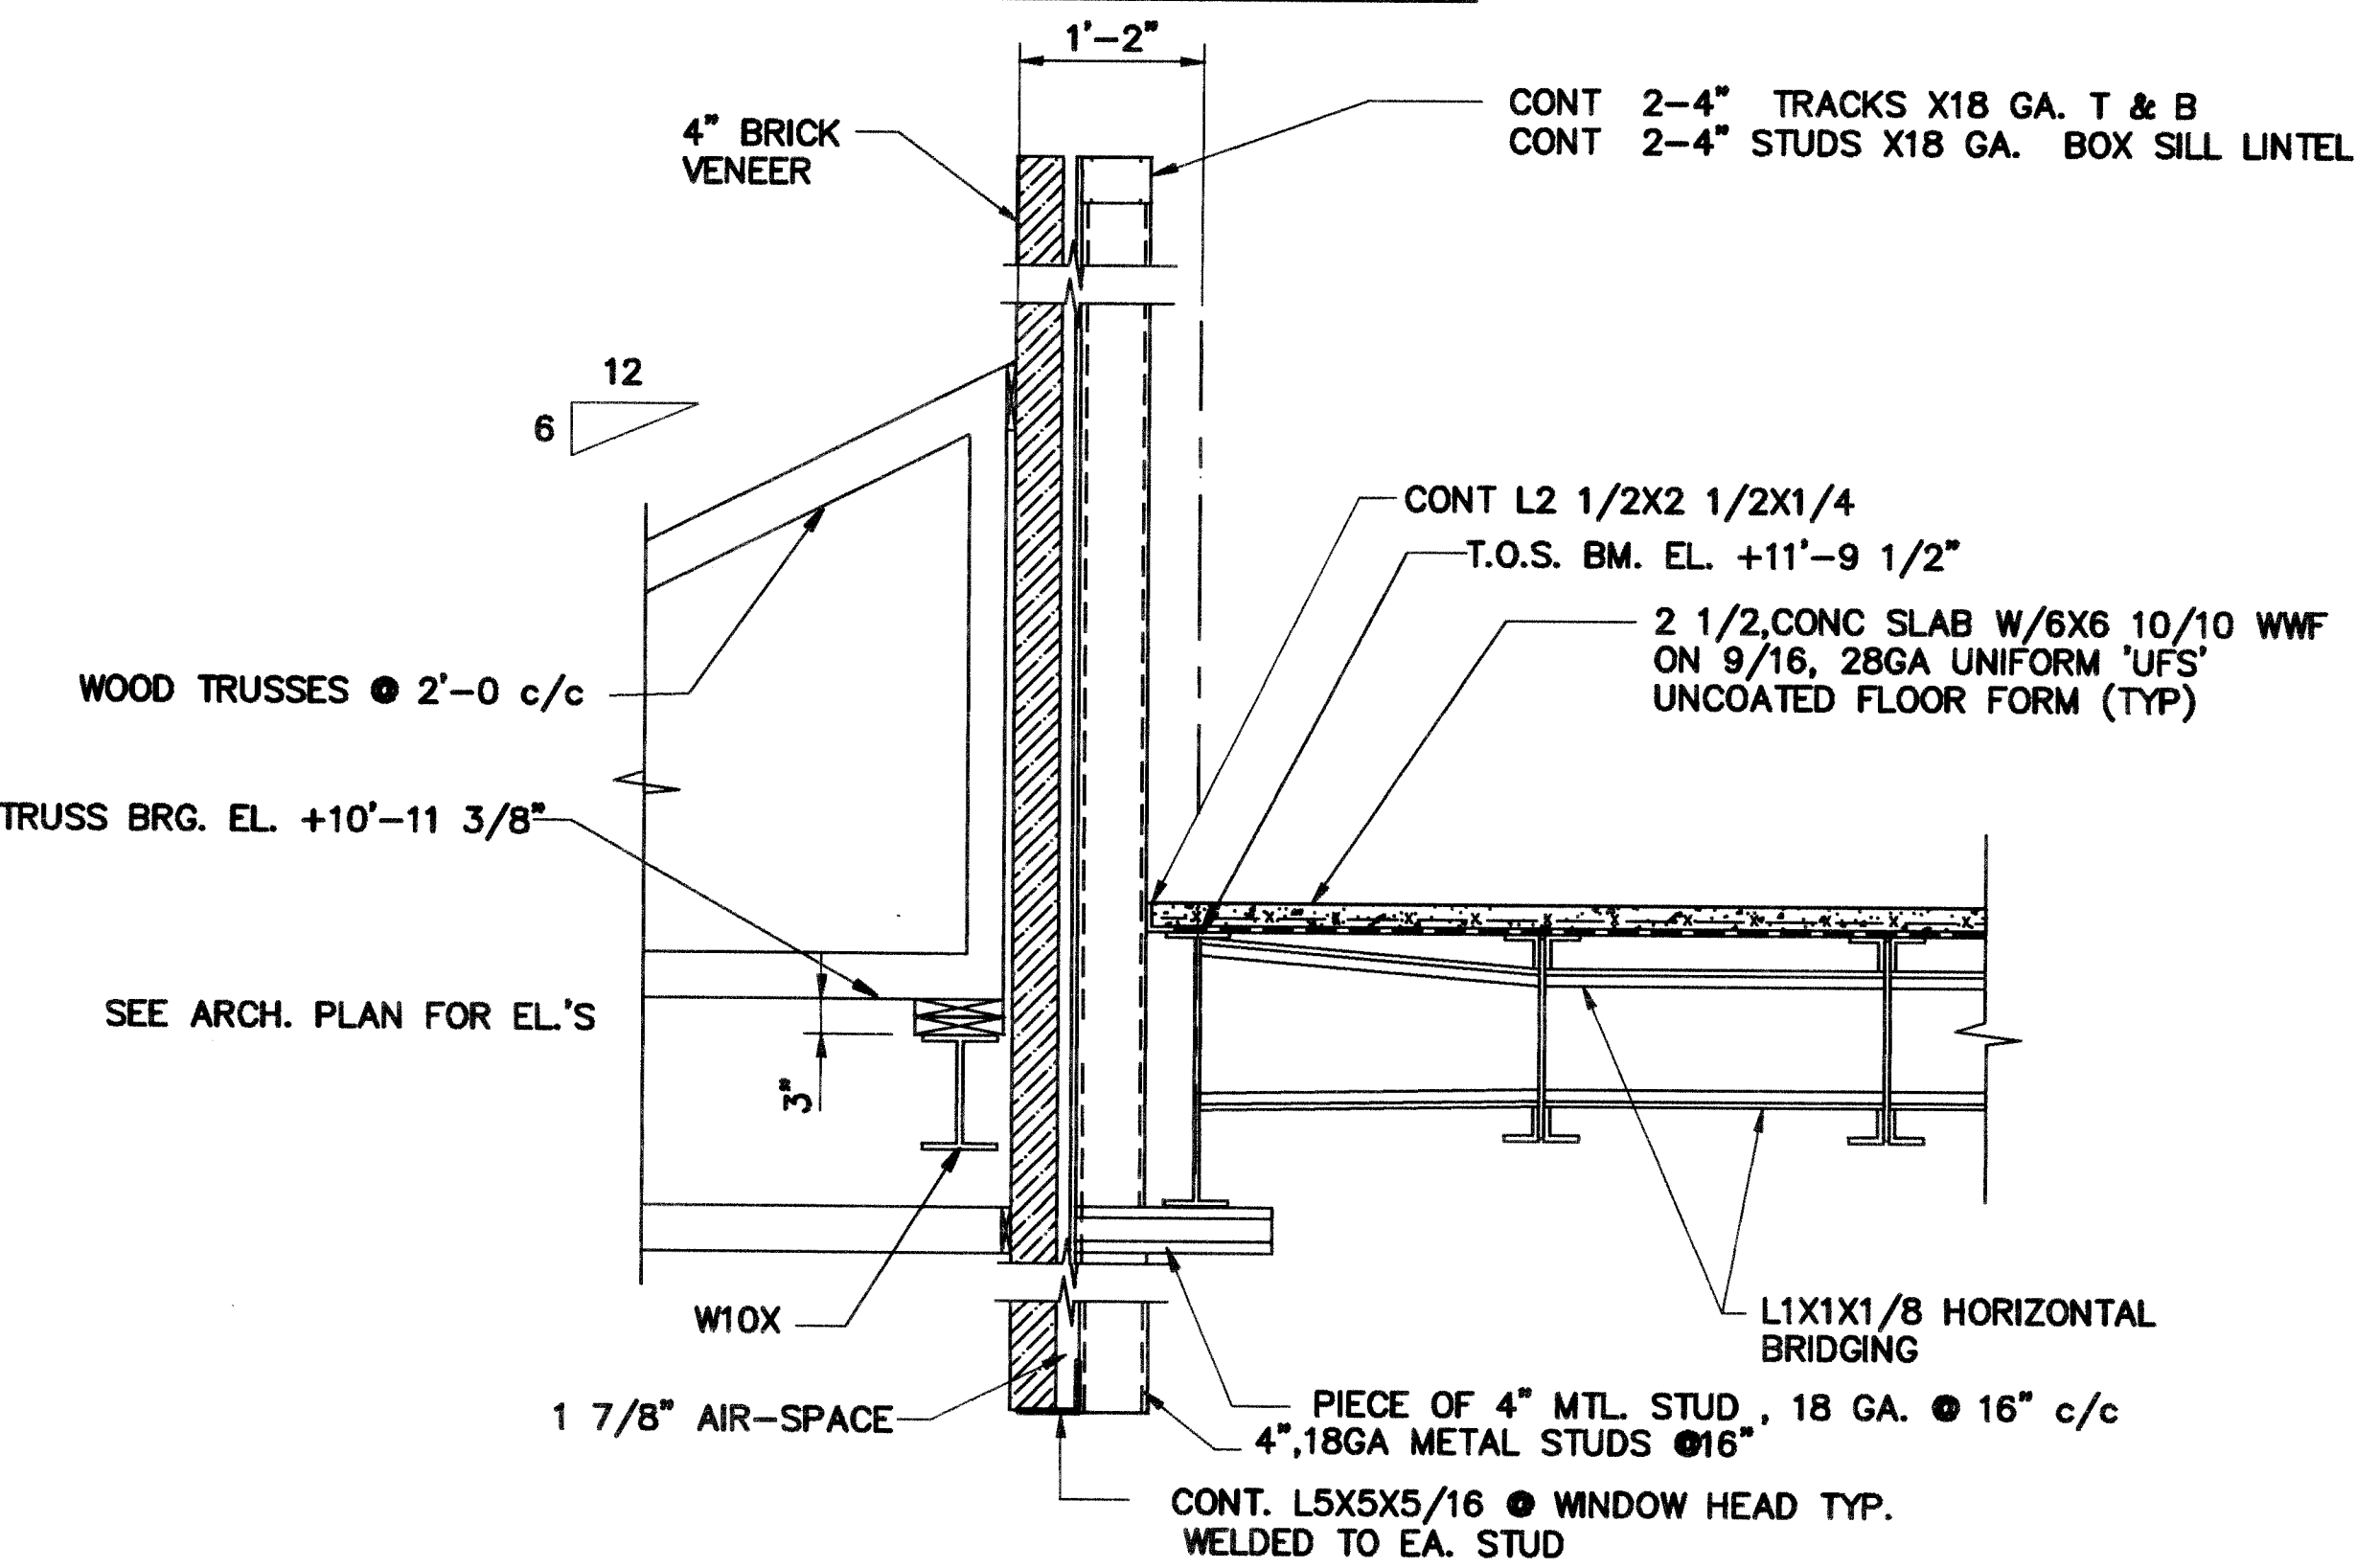

SECTION P-P