


Flagged Wetland Boundary  
(Ref. O.R.A.D. #103-0787)

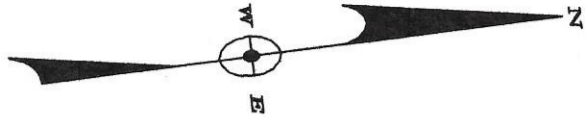

LOT 5

N08°45'36"W  
162.04'

100' Buffer Zone  
No work will be done  
inside the 100' Buffer Zone.

S87°11'37"W  
71.39'

S87°47'43"W  
153.80'

RESIDENCE R  
RESIDENCE A

S05°33'21"W  
133.62'

LOT 3

N80°37'56"E  
164.37'

DRAINAGE  
EASEMENT

20'  
13' 7'

S34°26'39"E  
40.00'

N55°33'21"E  
22.20'

Willow Lane

Concrete  
Foundation

36.8'

65.0'

181.15  
Top of  
Foundation

36.75'

61.4'

L=43.28'  
R=31.00'

S44°26'39"E  
28.32'

AS-BUILT FOUNDATION PLAN  
7 WILLOW LANE (LOT 4)  
BEDFORD, MA

Prepared By  
LeBlanc Survey Associates, Inc.  
161 Holten Street  
Danvers, Ma 01923  
(978) 774-6012

May 4, 2018 Scale 1"=30'

HOR. SCALE IN FEET

