



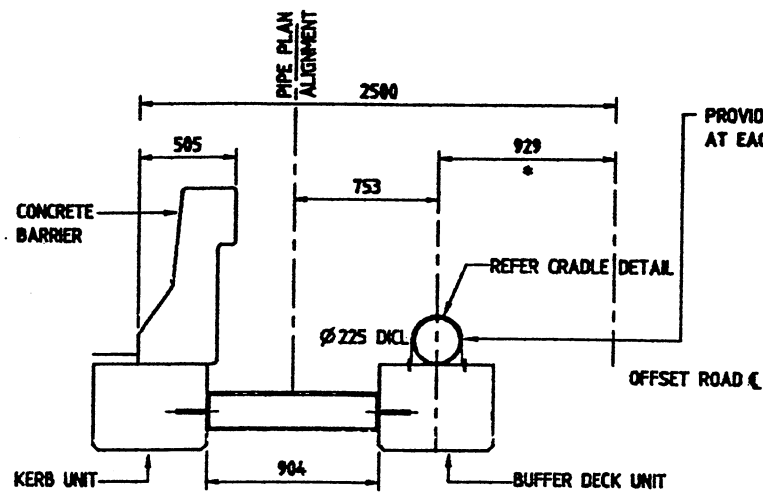


BRIDGE PIPE LOCATION


* NOTE: CHECK AS CONSTRUCTED DIMENSIONS

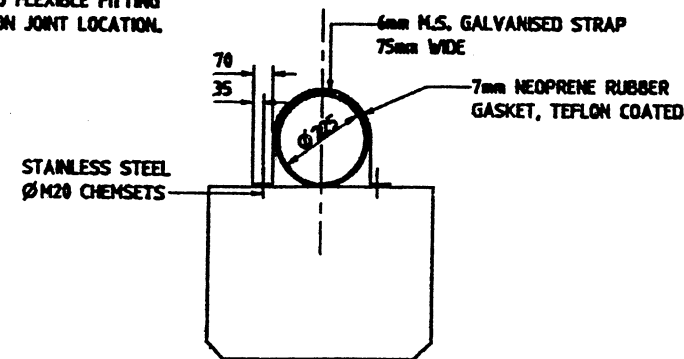


CRADLE DETAIL

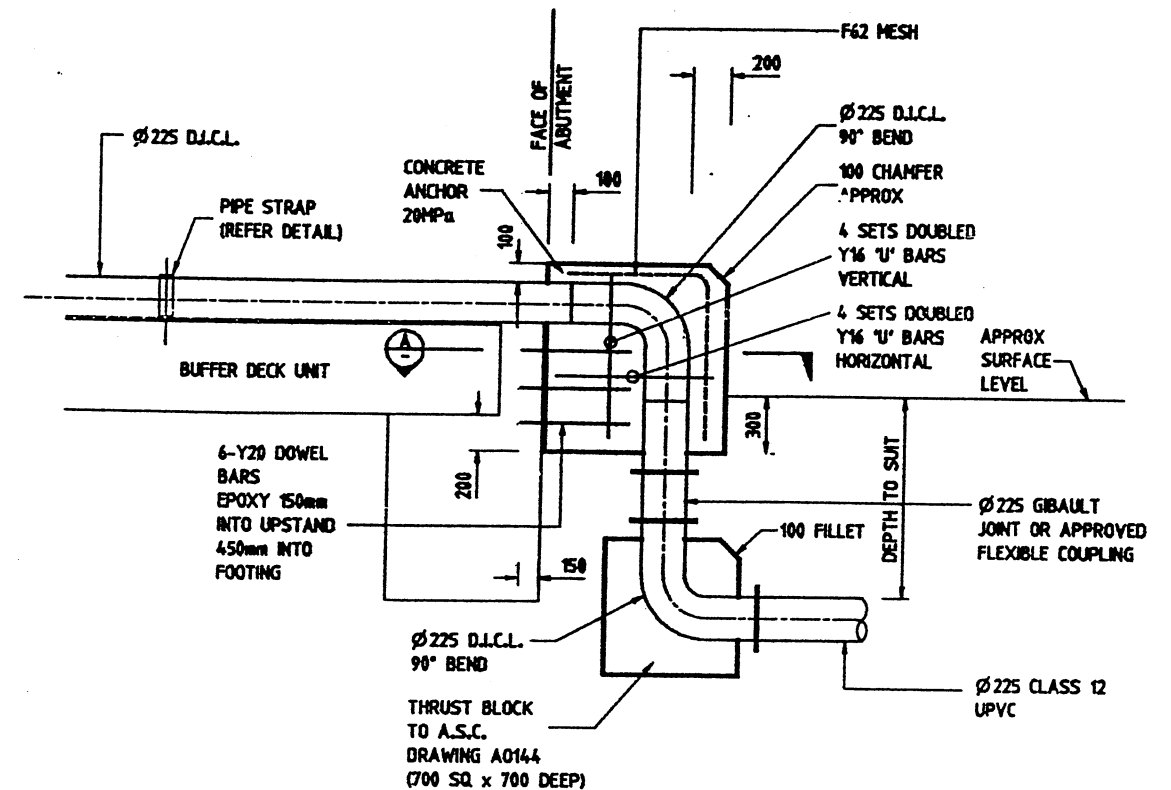

ELEVATION OF PIPE DETAIL TO BRIDGE ABUTMENT

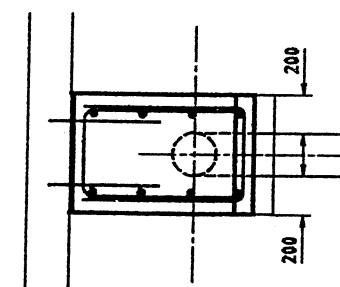

SECTION A-A

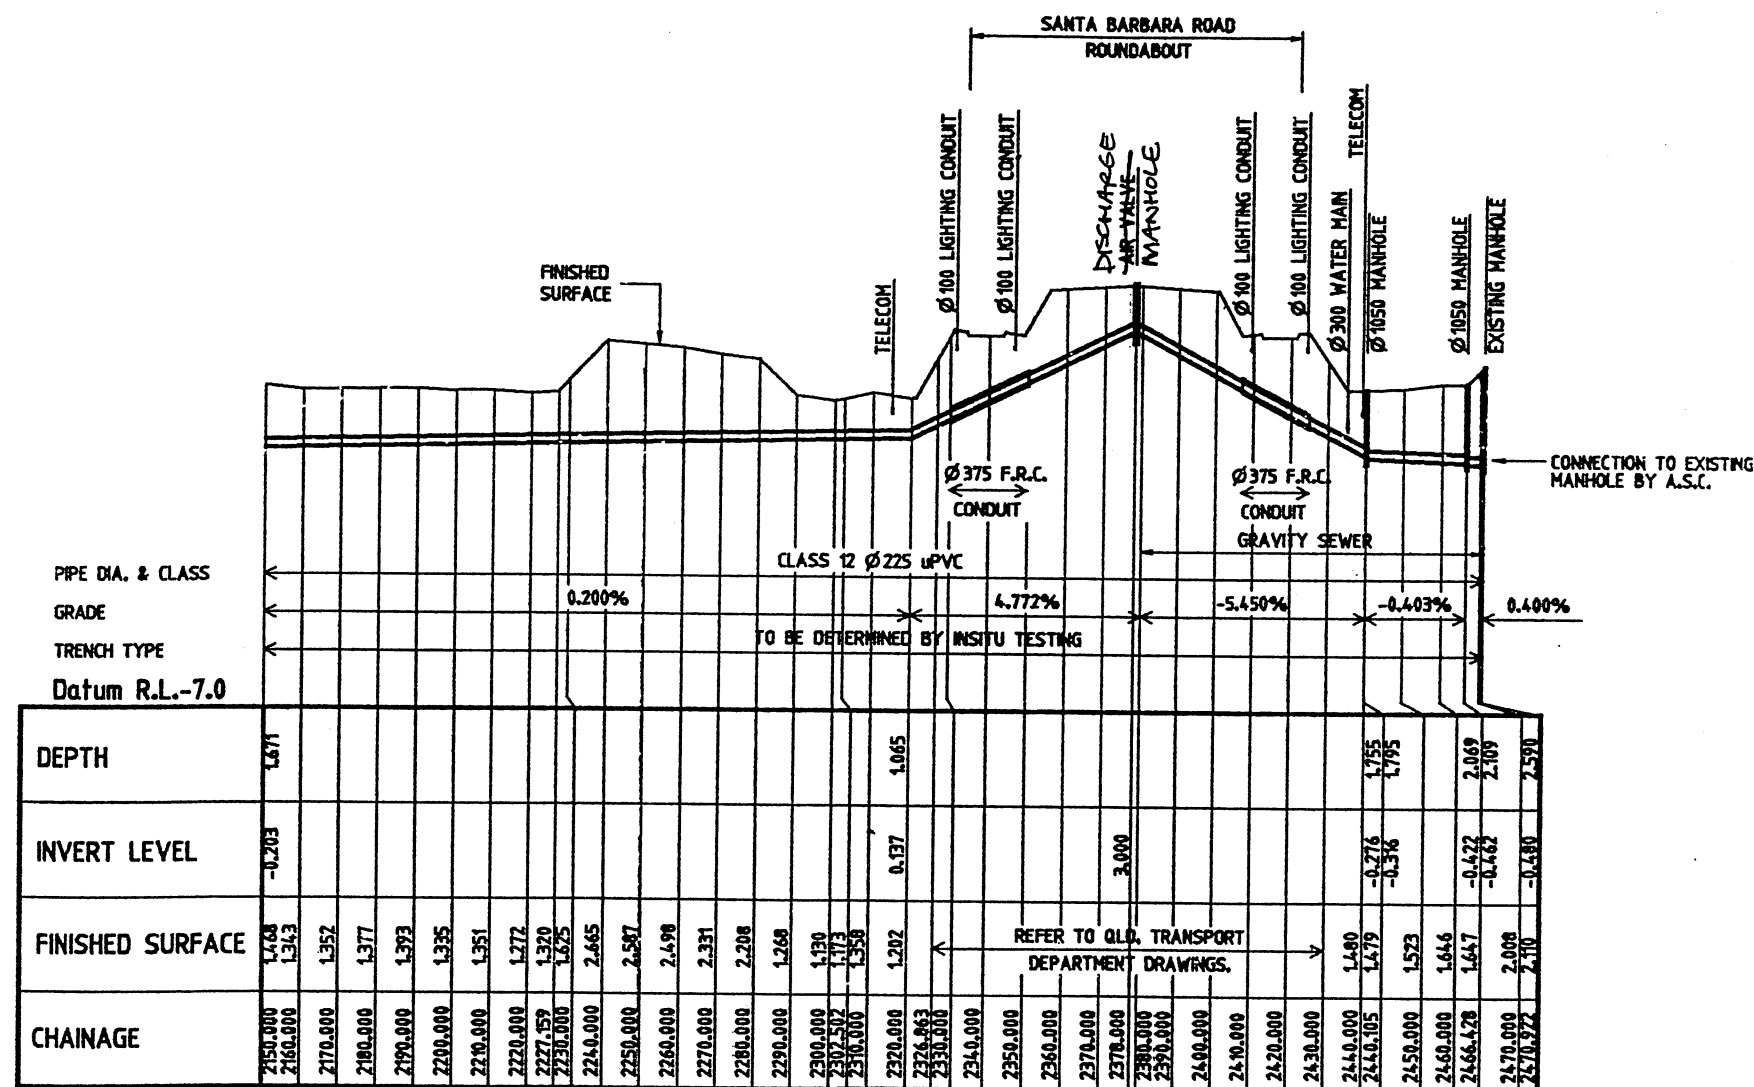

CH.2150.000 - CH.2470.922

THIS DRAWING HAS BEEN CO-ORDINATED WITH CURRENT DOCUMENTATION FROM: ☐ SURVEY ☐ DESIGN ☐ CIVIL ☐ MECHANICAL ☐ ELECTRICAL ☐ ARCHITECTURAL ☐ STRUCTURAL ☐ ENVIRONMENTAL AT ☐ TENDER STAGE ☐ APPROVED ☐ DATE ☐ AT ☐ CONSTRUCTION STAGE ☐ APPROVED ☐ DATE ☐		SURVEYOR JOHN MARENDY & ASSOCIATES CLIENT VANWELL PTY. LTD.		PROJECT OYSTER COVE EXTERNAL SEWER CIVIL ENGINEERING WORKS		Weathered Howe 100 LEACHWAY STREET BUNNINGS NSW 1510 PHONE (02) 851 8888 FAX (02) 851 4317 GLEN DRIVE LEVEL 2, SCHWABER PLACE 131 SCHWABER STREET BUNNINGS NSW 1510 PHONE (02) 851 8888 FAX (02) 851 4317 A.C.N. 00 001 000		FILE LONGITUDINAL SECTION AND DETAILS SHEET 3 OF 7 APPROVED [Signature] REVISION [Signature] DESIGNED D.V.A. DRAWN C.C.S. DATE FEB. 1995 DRAWING NUMBER G3423E-C-08 REMARK A SCALE 1:1000 & 1:100	
--	--	--	--	--	--	--	--	---	--