


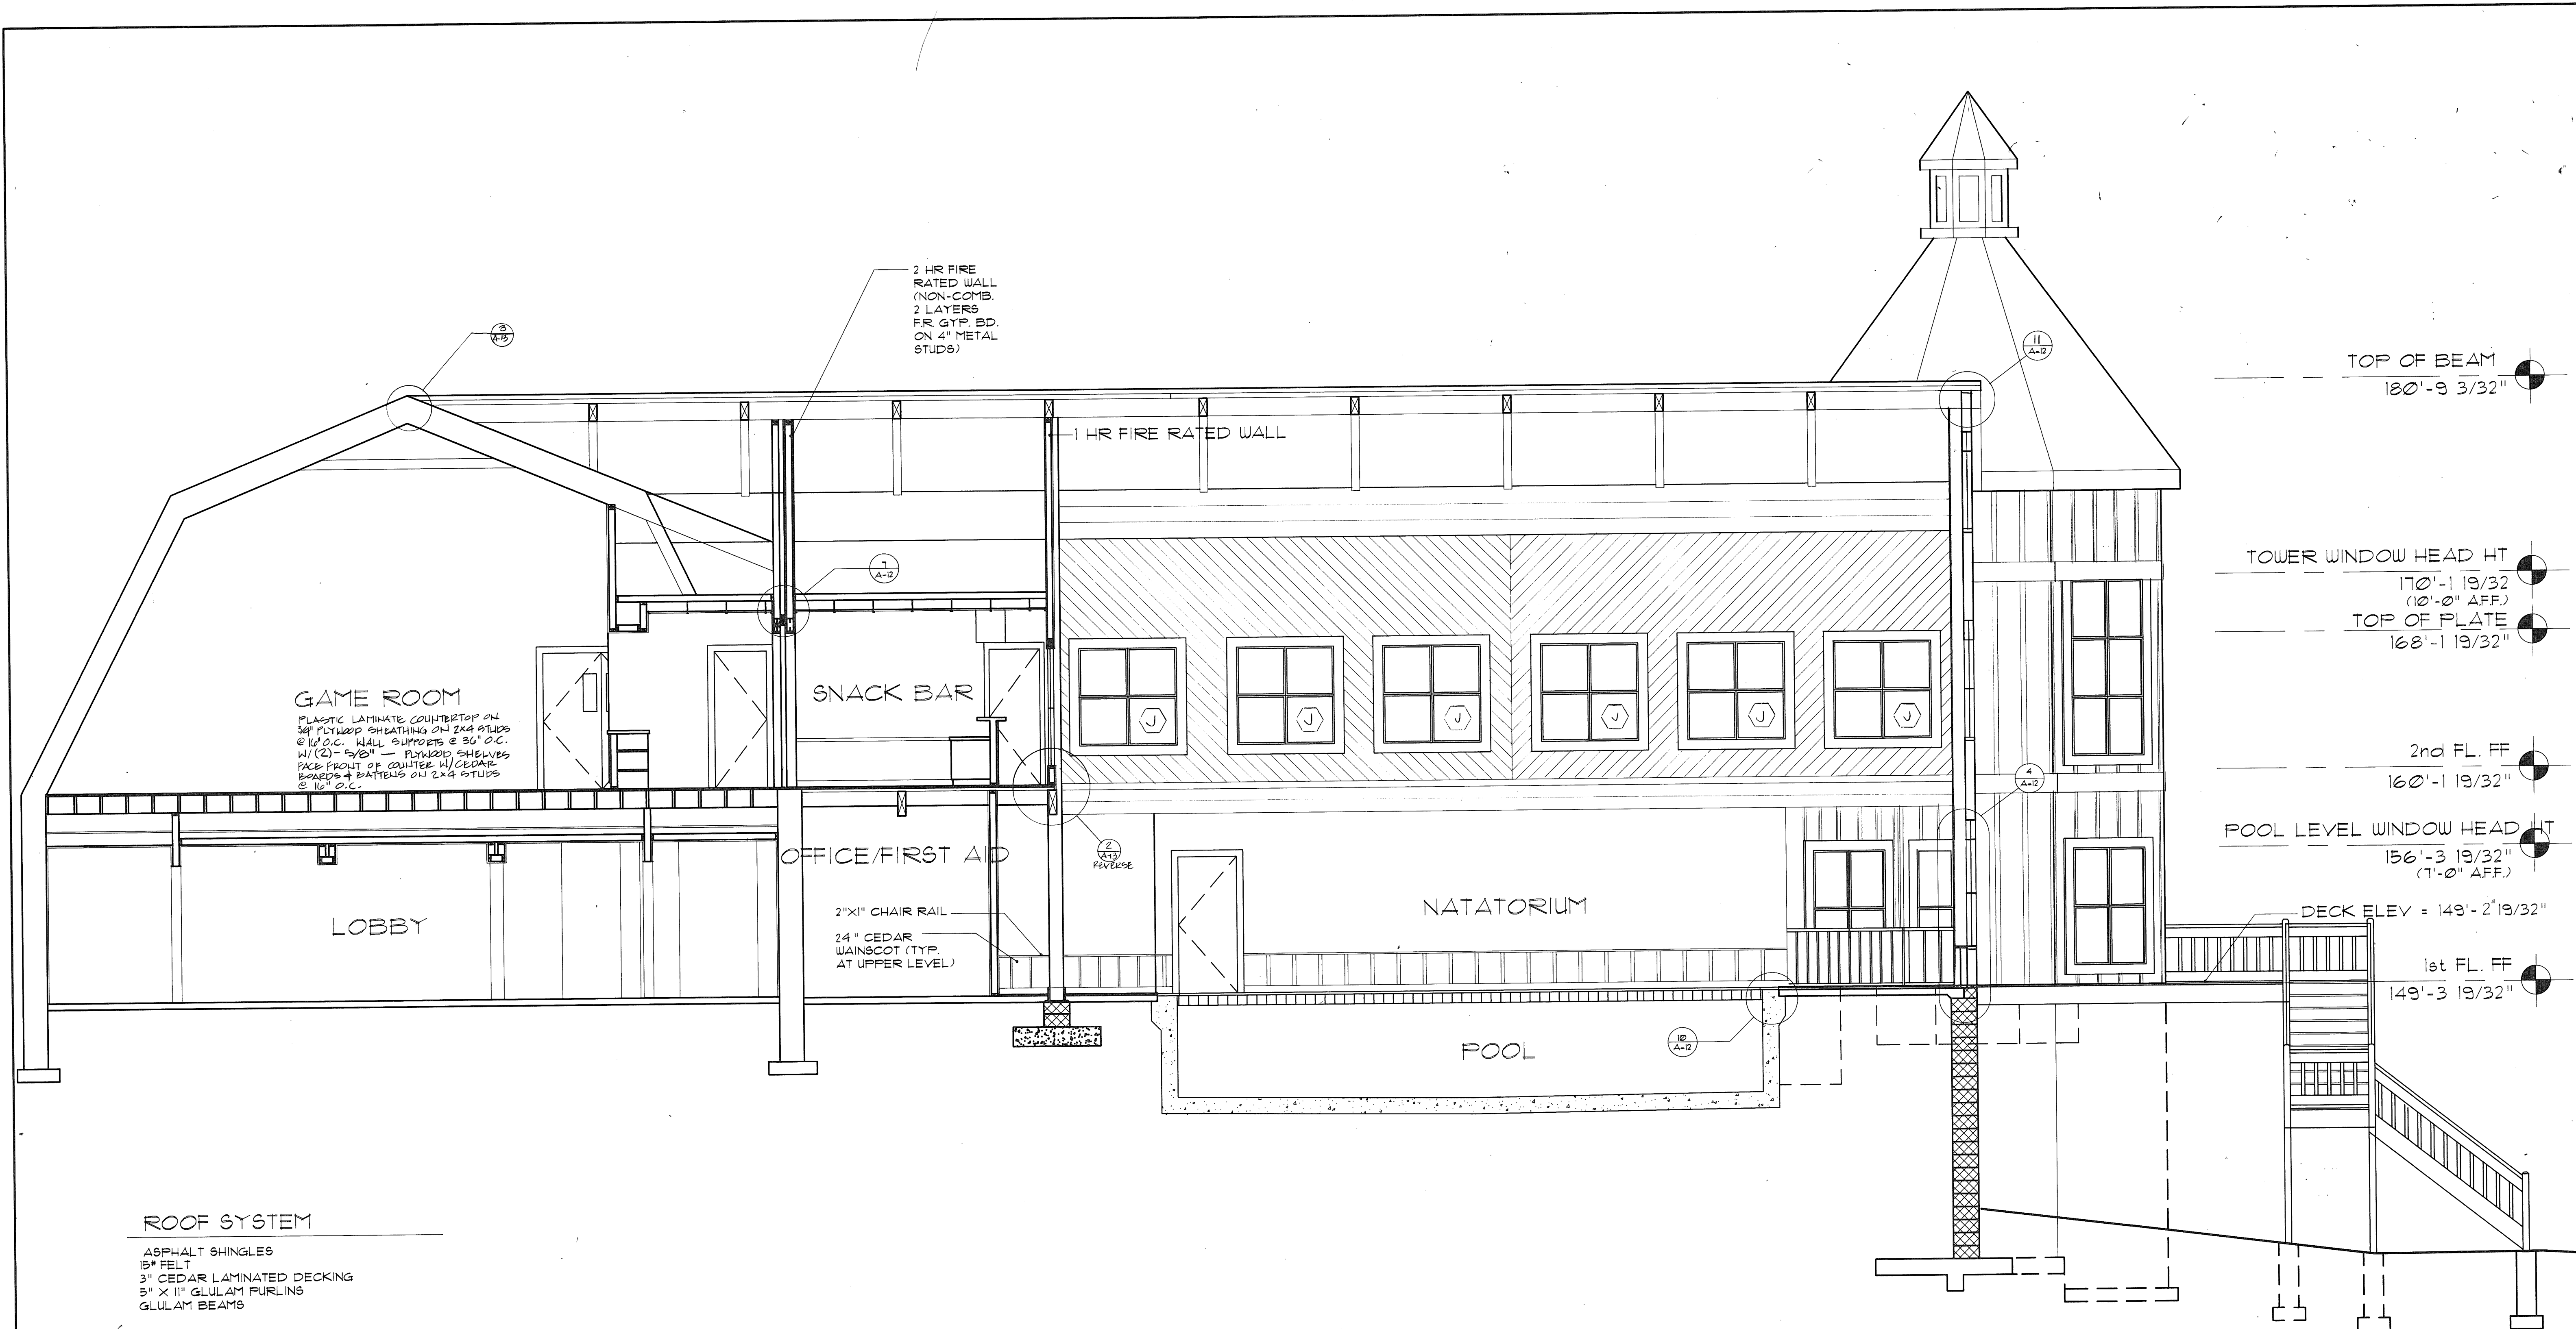

ROOF SYSTEM

ASPHALT SHINGLES
15" FELT
3" CEDAR LAMINATED DECKING
5" X 11" GLULAM PURLINS
GLULAM BEAMS

WALL SYSTEM


CEDAR BOARDS
CEDAR BATTENS
5/8" PLYWOOD SHEATHING
SPRAY-ON INSULATION
5/8" GYPSUM BOARD

FOUNDATION SYSTEM

IVANY BLOCK FOUNDATION WALL
STEEL REINFORCING
CONCRETE FOOTINGS
IVANY BLOCK PIERS

BUILDING SECTION A-A

AS-BUILT 6-26-92

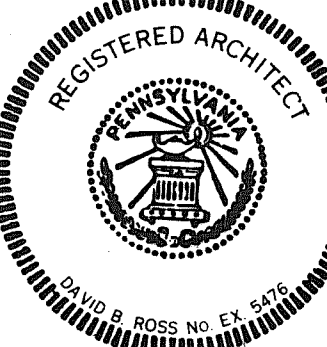PROJECT MGR.	DESIGNER	BUILDING SECTION		REVISIONS
W.L.H.	J.R.M.	COMMUNITY CLUBHOUSE		
DRAWN BY	CHECKED BY			
J.S./J.R.M.		HEMLOCK FARMS COMMUNITY ASSOCIATION		DATE 21 JUNE 1991
		HAWLEY PIKE COUNTY PA		SCALE 4" = 1'
		R.K.R. Hess Associates Surveyors, Planners, Engineers, Architects Landscape Architects, and Environmentalists 112 N. Courtland St., P.O. Box 268, E. Stroudsburg, Pa. 18301 Telephone (717) 421-1550 Fax (717) 421-8720		PROJECT NO. 90244.01
				DRAWING NO. 244019V1
				A10 of 16