

ROOF SYSTEM

ASPHALT SHINGLES
15# FELT
3" CEDAR LAMINATED DECKING
5" X 11" GLULAM PURLINS
GLULAM BEAMS

WALL SYSTEM


CEDAR BOARDS
CEDAR BATTENS
5/8" PLYWOOD SHEATHING
SPRAY-ON INSULATION
5/8" GYPSUM BOARD

FOUNDATION SYSTEM

IVANY BLOCK FOUNDATION WALL
STEEL REINFORCING
CONCRETE FOOTINGS
IVANY BLOCK PIERS

DECK SYSTEM

2 X 6 TREATED DECKING
15# FELT
3" CEDAR LAMINATED DECKING
5" X 11" GLULAM PURLINS
GLULAM BEAMS
SLOPED RIGID INSULATION
MEMBRANE ROOFING

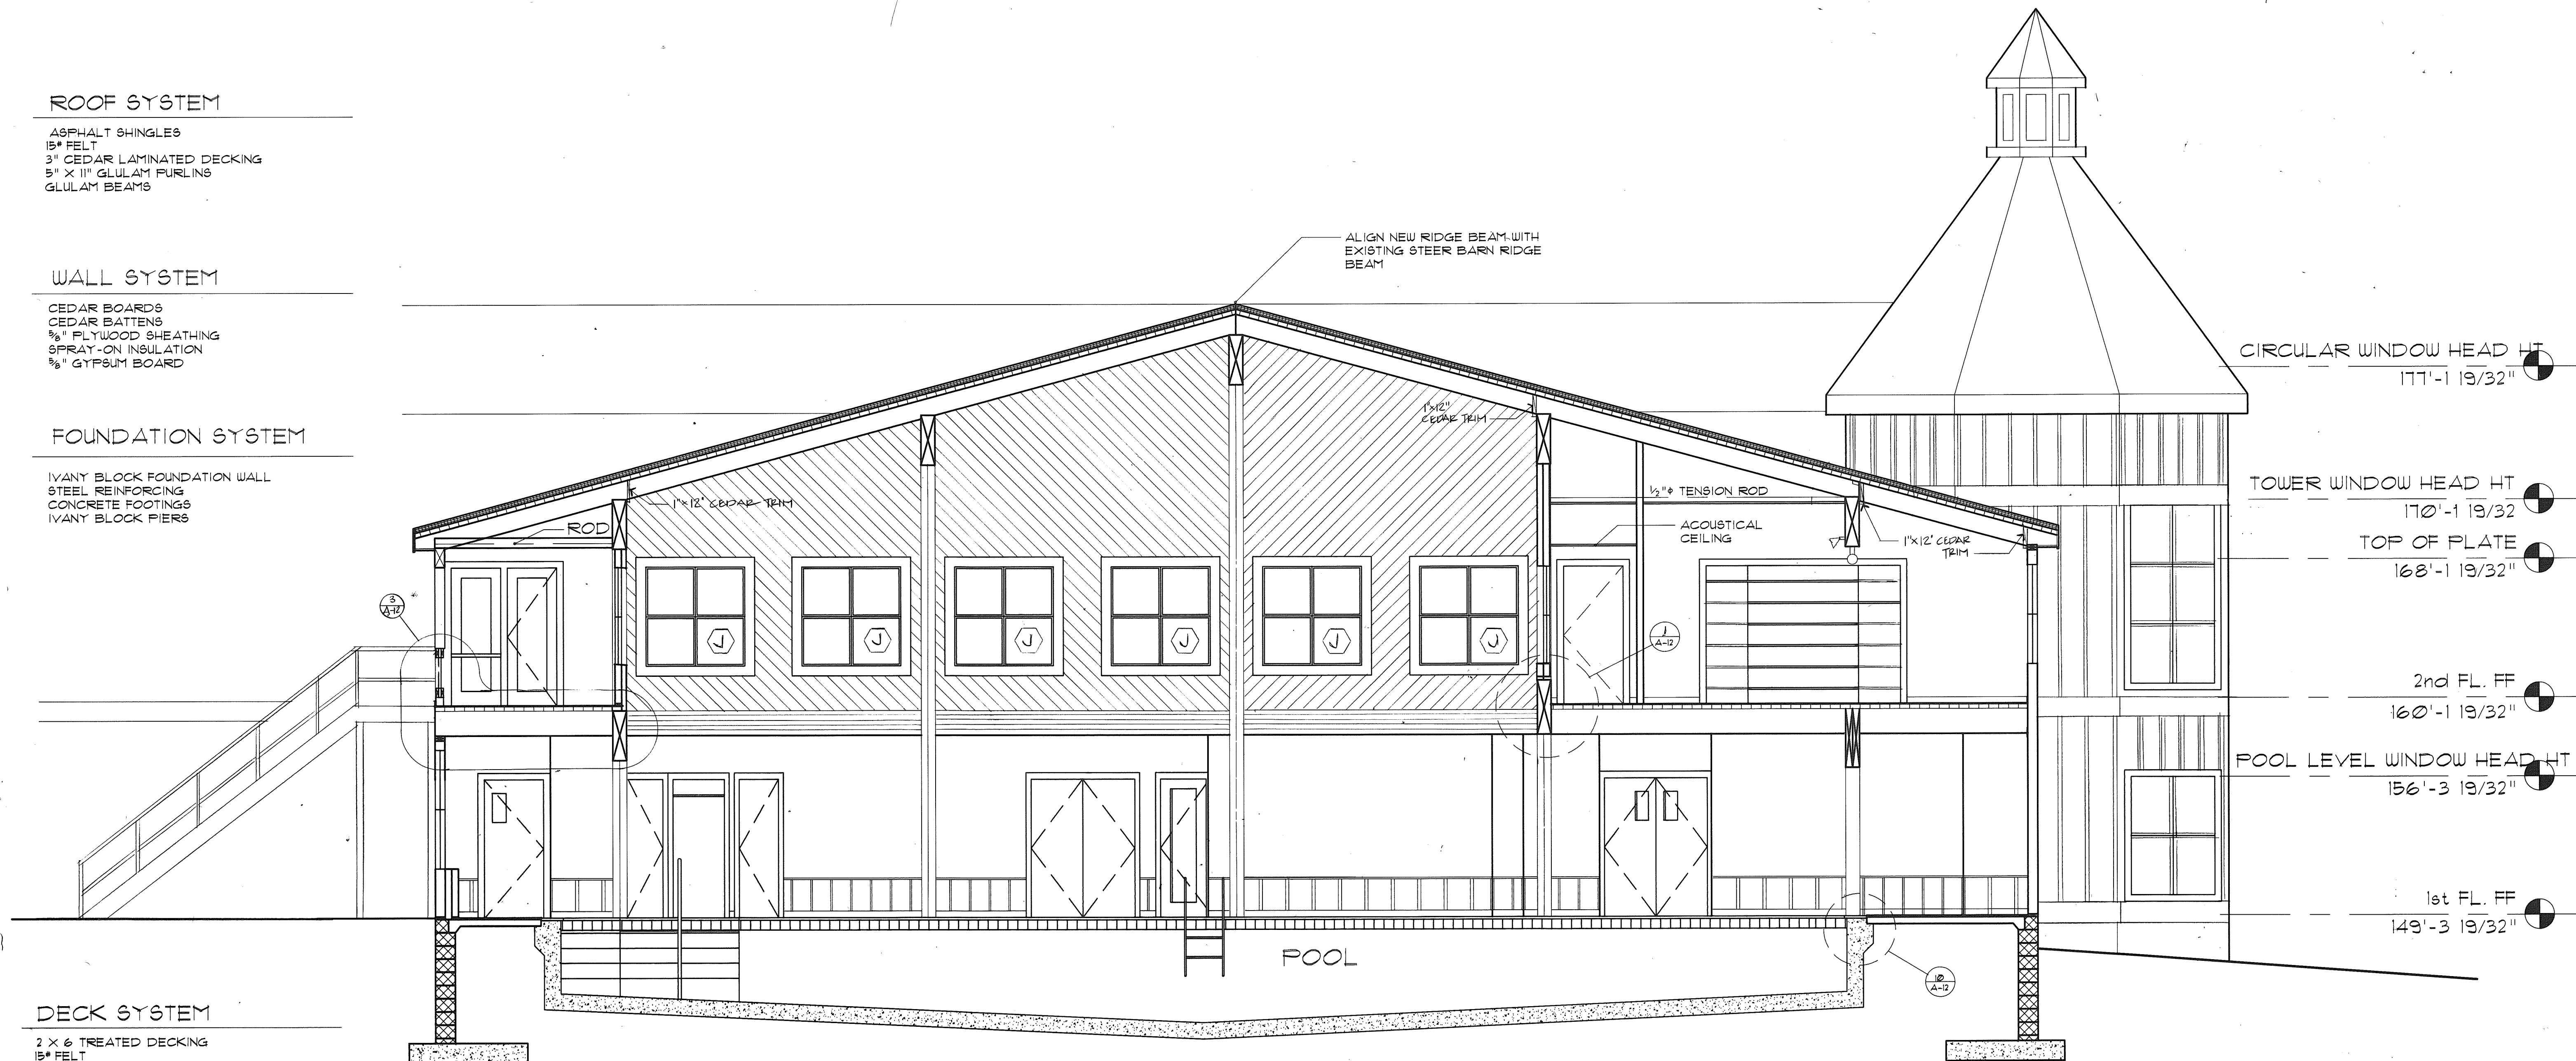

BUILDING SECTION B-B

AS-BUILT 6-26-92

PROJECT MGR.		DESIGNER		BUILDING SECTION		REVISIONS	
WJLH		EC		COMMUNITY CLUBHOUSE			
DRAWN BY JS/JRM		CHECKED BY		HEMLOCK FARMS COMMUNITY ASSOCIATION		DATE 21 JUNE 1991	
				HAWLEY PIKE COUNTY PA		SCALE 4' = 1"	
				R.K.R. Hess Associates		PROJECT NO. 9024401	
				Surveyors, Planners, Engineers, Architects		DRAWING NO. 244019V2	
				112 N. Courtland St. P.O. Box 268, E. Stroudsburg, Pa. 18301		A-116 16	
				Telephone (717) 421-1550 Fax (717) 421-8720			