


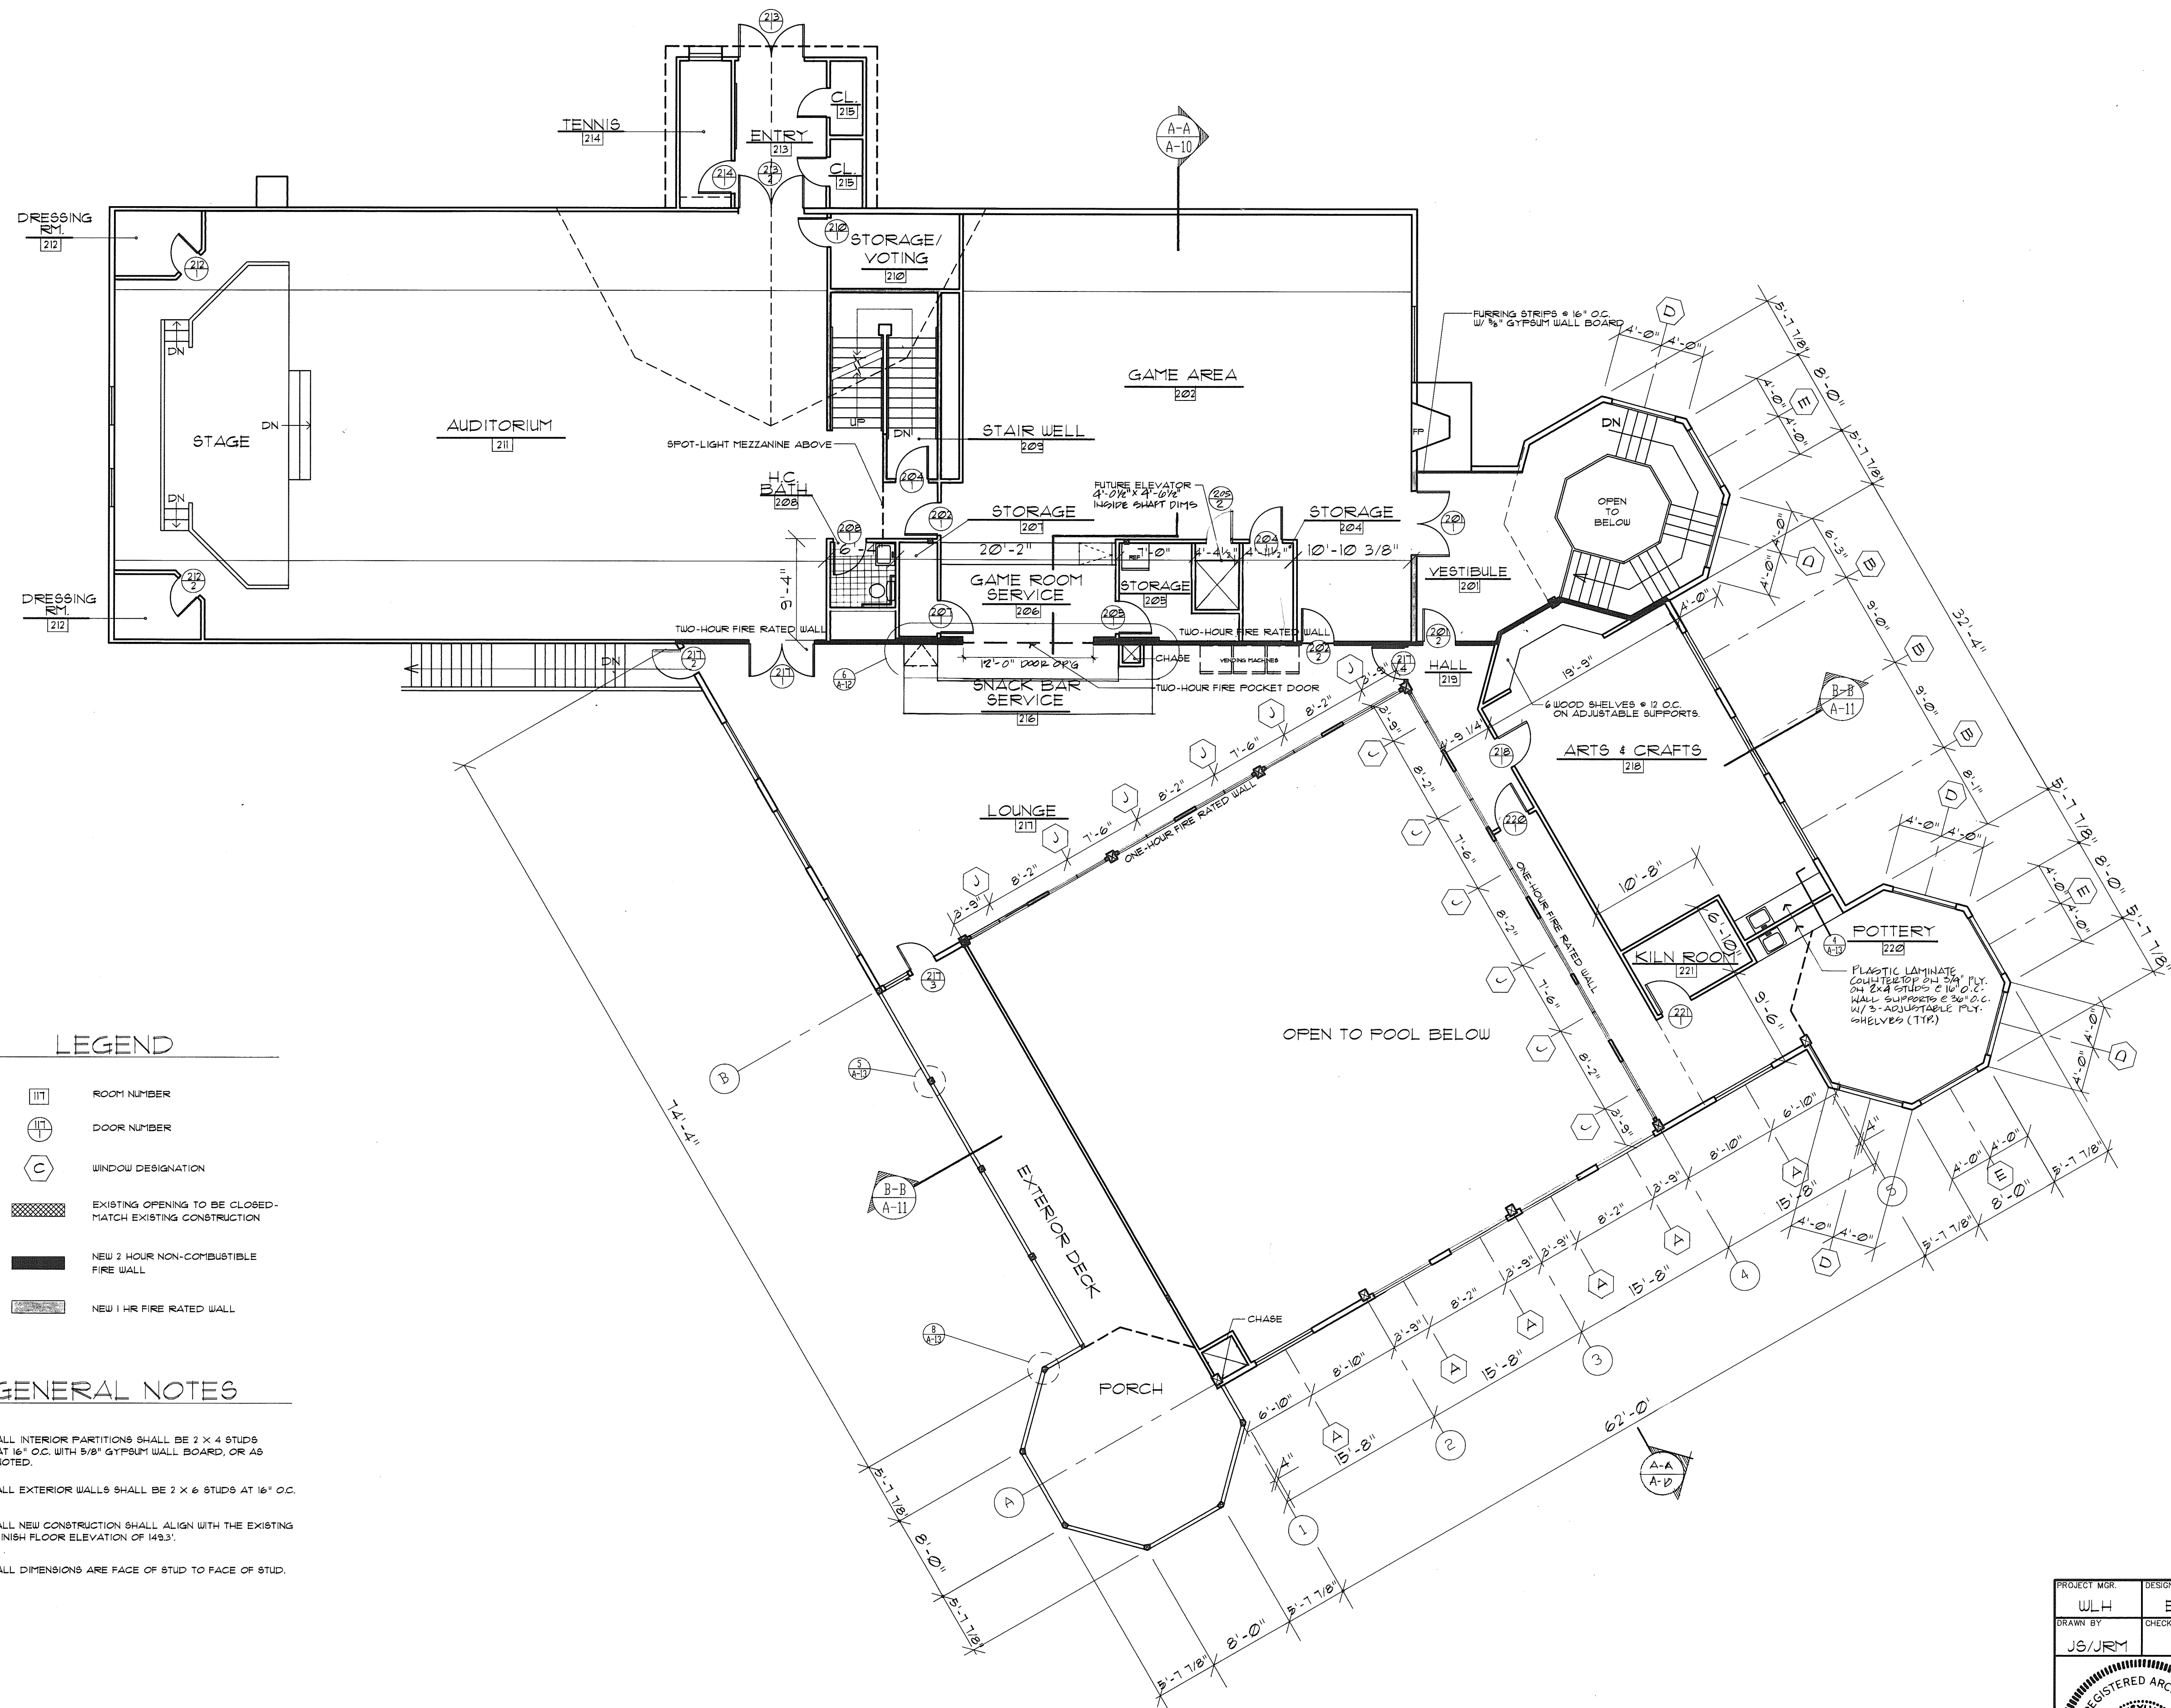

# LEGEND

- ROOM NUMBER
- DOOR NUMBER
- WINDOW DESIGNATION
- EXISTING OPENING TO BE CLOSED - MATCH EXISTING CONSTRUCTION
- NEW 2 HOUR NON-COMBUSTIBLE FIRE WALL
- NEW 1 HR FIRE RATED WALL

# GENERAL NOTES

- ALL INTERIOR PARTITIONS SHALL BE 2 X 4 STUDS AT 16" O.C. WITH 5/8" GYPSUM WALL BOARD, OR AS NOTED.
- ALL EXTERIOR WALLS SHALL BE 2 X 6 STUDS AT 16" O.C.
- ALL NEW CONSTRUCTION SHALL ALIGN WITH THE EXISTING FINISH FLOOR ELEVATION OF 149.3'.
- ALL DIMENSIONS ARE FACE OF STUD TO FACE OF STUD.

AS-BUILT 6-26-92

| PROJECT MGR | DESIGNER   | SECOND FLOOR PLAN                   |  | REVISIONS    |
|-------------|------------|-------------------------------------|--|--------------|
| WLH         | EC         | COMMUNITY CLUBHOUSE                 |  |              |
| DRAWN BY    | CHECKED BY | HEMLOCK FARMS COMMUNITY ASSOCIATION |  |              |
| JS/JRM      |            | HAWLEY PIKE COUNTY PA               |  |              |
|             |            | DATE                                |  | 21 JUNE 1991 |
|             |            | SCALE                               |  | AS SHOWN     |
|             |            | PROJECT NO.                         |  | 9024401      |
|             |            | DRAWING NO.                         |  | 2440FF2      |
|             |            | DRAWING NO.                         |  | A6 OF 16     |