



- CONSTRUCTION LEGEND**
- 1. MATERIALS LEGEND**
- CONCRETE WALLS
  - CONCRETE BLOCK WALLS
  - FRAME WALLS
  - BEARING WALLS
- 2. GENERAL NOTES**
- \* DIMENSIONS ON STRUCTURAL SHEET TO FACE OF DRYWALL
  - CLOUDED AREA INDICATES CHANGES TO THE PLANS

LOWER LEVEL (STRUCTURAL) FLOOR PLAN SCALE: 1/4"=1'-0"

**Matthews Const.**
  
 GENERAL CONTRACTOR

CONSTRUCTION DRAWINGS BY:
   
**H.G. McCULLOUGH DESIGNERS, Inc.**
  
 2146 Glenview Drive, Evansville, IN 47720
   
 Telephone: 812.426.0774
   
 Fax: 812.426.0774
   
 www.hgmcclough.com


Designed For:
   
**Underwood**
  
 RETREAT

Date: 08-06-15
   
 Plan Number: #14082-4

9800 Westport Drive, Ste. 200, Indianapolis, IN 46256
   
 317.558.8759 P. 317.558.8760 F. garynancedesign.com
   
 garynancedesign.com
   
 These design concepts are the property of Gary Nance Design
   
 and may not be used without approval from Gary Nance Design

Architectural Concepts By
   
  
**GARY NANCE DESIGN**

SHEET NUMBER
   
 2

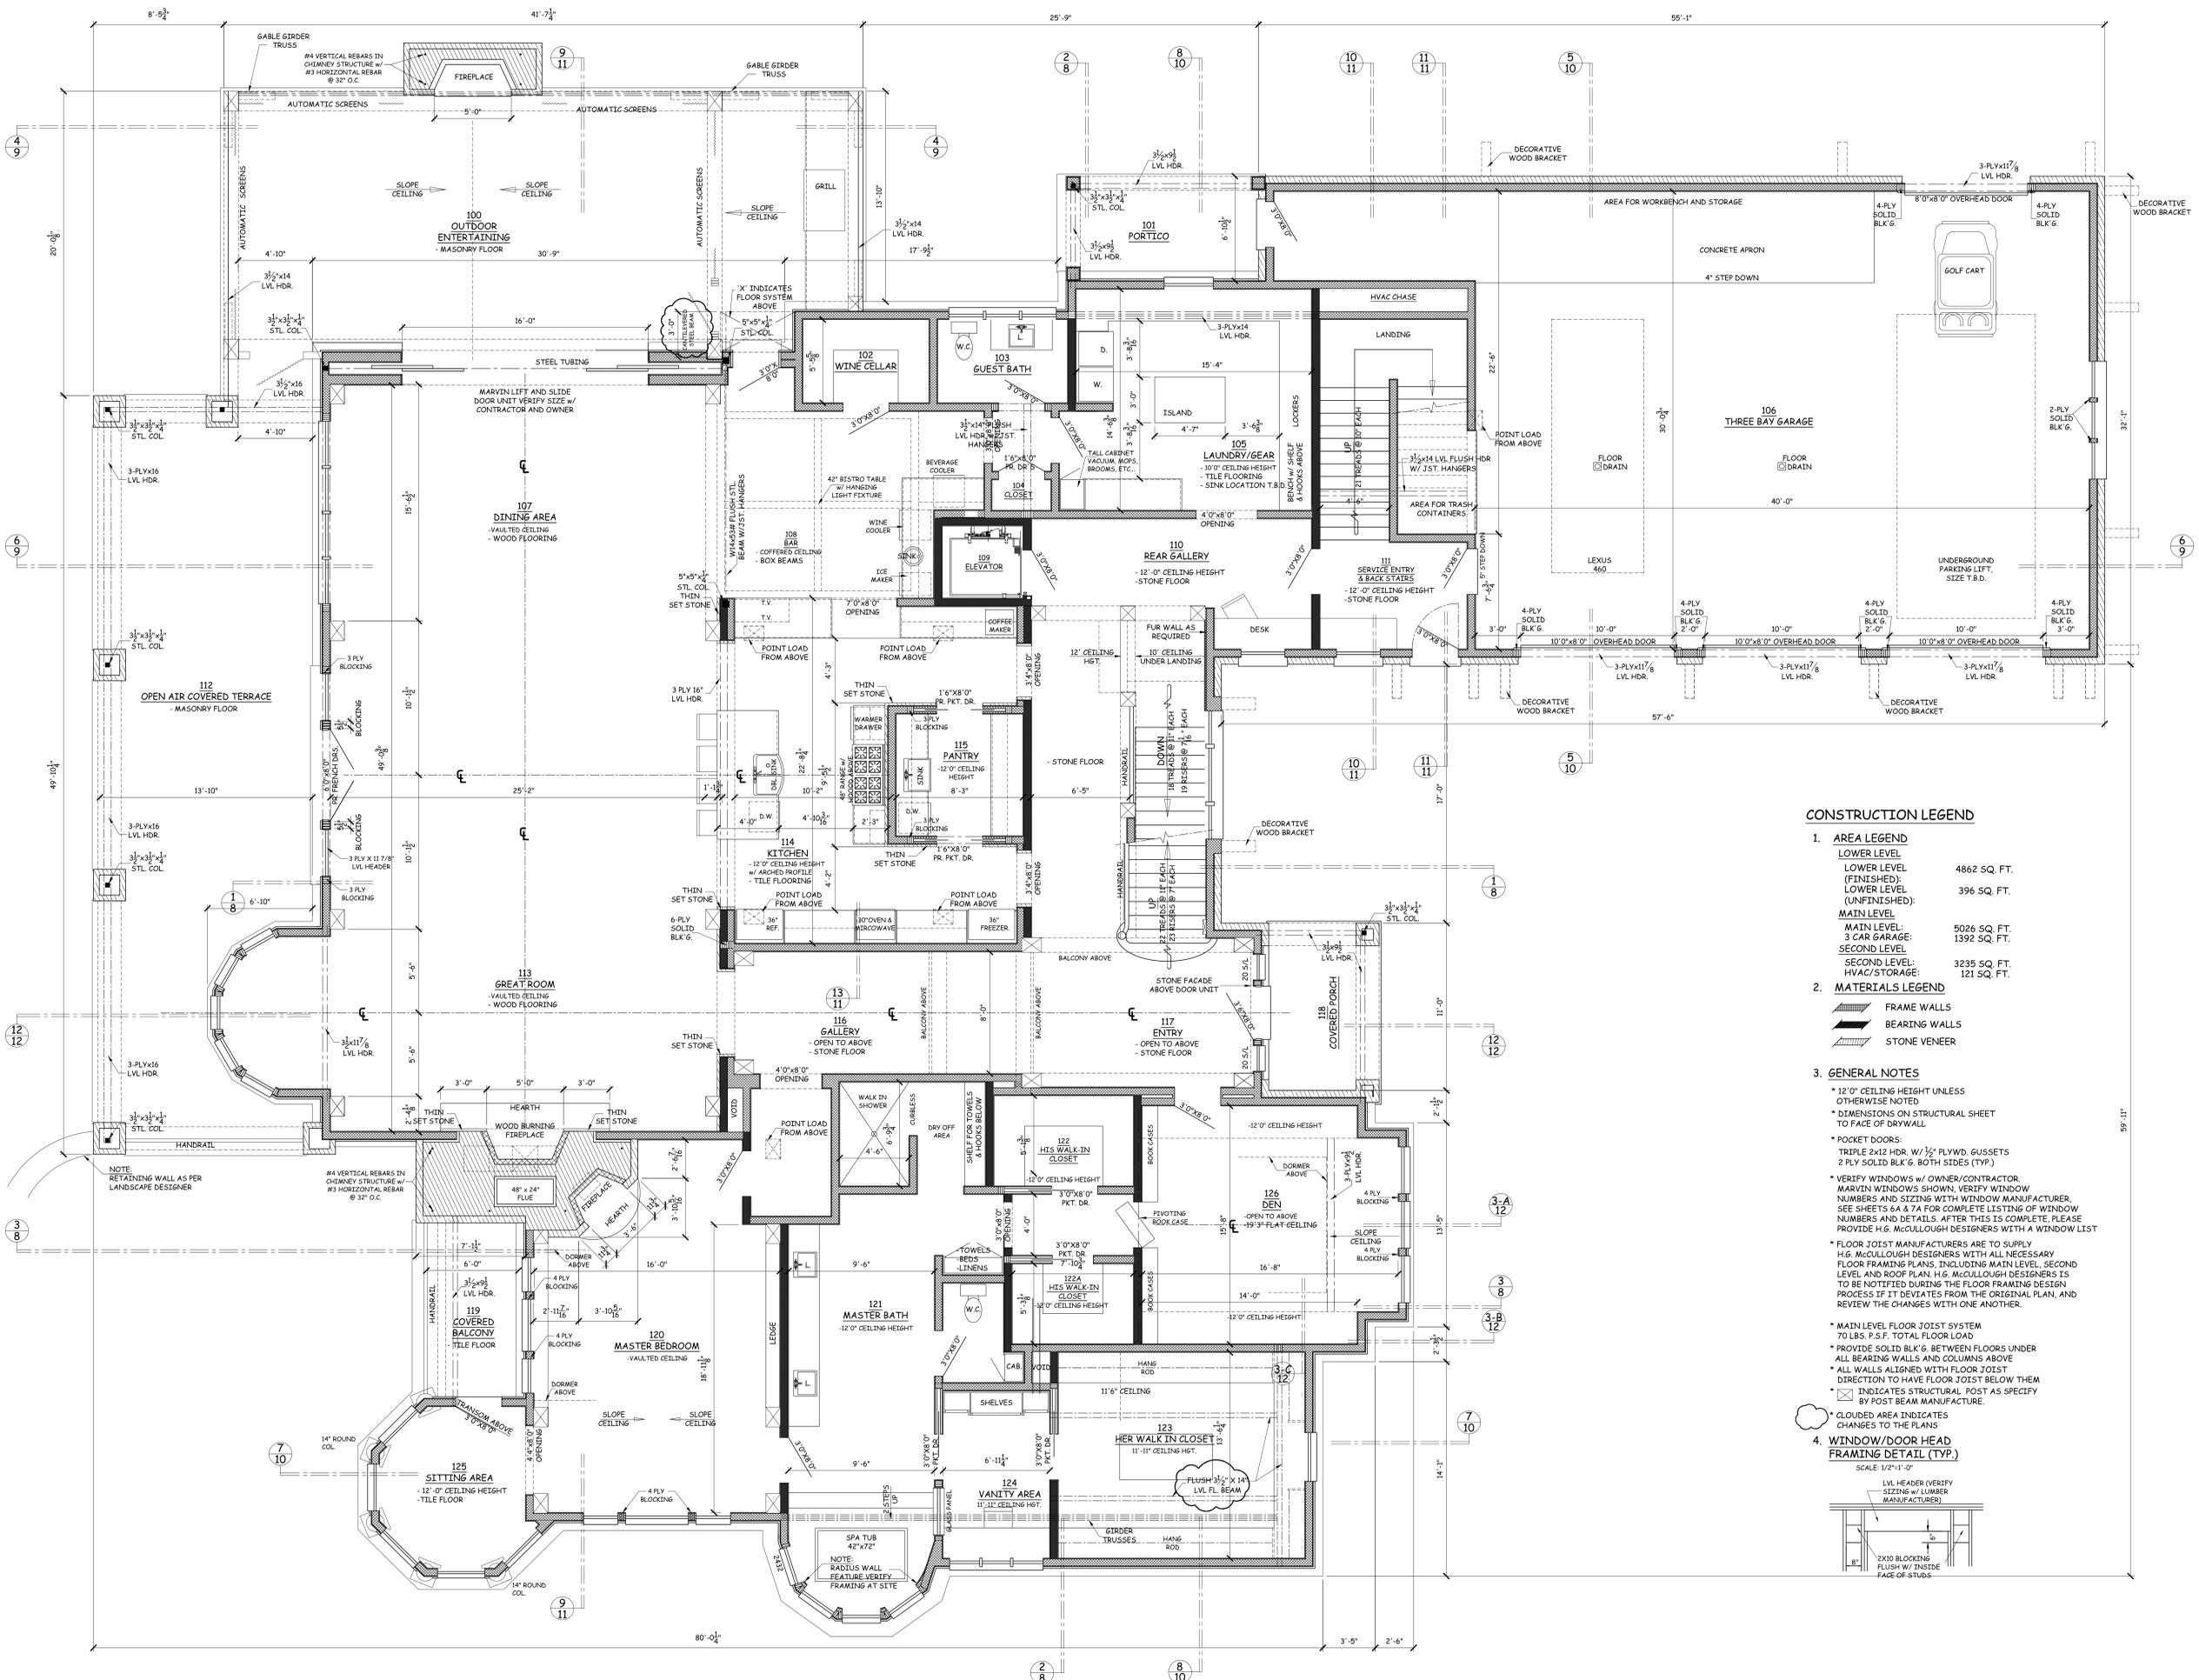


**CONSTRUCTION LEGEND**

- AREA LEGEND**
  - LOWER LEVEL: 4862 SQ. FT.
  - LOWER LEVEL (FINISHED): 396 SQ. FT.
  - LOWER LEVEL (UNFINISHED): 396 SQ. FT.
  - MAIN LEVEL: 5026 SQ. FT.
  - 3 CAR GARAGE: 1392 SQ. FT.
  - SECOND LEVEL: 3235 SQ. FT.
  - HVAC/STORAGE: 121 SQ. FT.
- MATERIALS LEGEND**
  - FRAME WALLS
  - BEARING WALLS
  - STONE VENEER


- GENERAL NOTES**
  - \* 12'-0" CEILING HEIGHT UNLESS OTHERWISE NOTED
  - \* DIMENSIONS ON STRUCTURAL SHEET TO FACE OF DRYWALL
  - \* POCKET DOORS: TRIPLE 2x12 HDR. W/ 1/2" PLYWOOD GUSSETS 2 PLY SOLID BLK'G. BOTH SIDES (TYP.)
  - \* VERIFY WINDOWS w/ OWNER/CONTRACTOR. MARVIN WINDOWS SHOWN. VERIFY WINDOW NUMBERS AND SIZING WITH WINDOW MANUFACTURER. SEE SHEETS 6A & 7A FOR COMPLETE LISTING OF WINDOW NUMBERS AND DETAILS. AFTER THIS IS COMPLETE, PLEASE PROVIDE H.G. McCULLOUGH DESIGNERS WITH A WINDOW LIST
  - \* FLOOR JOIST MANUFACTURERS ARE TO SUPPLY H.G. McCULLOUGH DESIGNERS WITH ALL NECESSARY FLOOR FRAMING PLANS, INCLUDING MAIN LEVEL, SECOND LEVEL AND ROOF PLAN. H.G. McCULLOUGH DESIGNERS IS TO BE NOTIFIED DURING THE FLOOR FRAMING DESIGN PROCESS IF IT DEVIATES FROM THE ORIGINAL PLAN, AND REVIEW THE CHANGES WITH ONE ANOTHER.
  - \* MAIN LEVEL FLOOR JOIST SYSTEM TO LBS. P.S.F. TOTAL FLOOR LOAD
  - \* PROVIDE SOLID BLK'G. BETWEEN FLOORS UNDER ALL BEARING WALLS AND COLUMNS ABOVE
  - \* ALL WALLS ALIGNED WITH FLOOR JOIST DIRECTION TO HAVE FLOOR JOIST BELOW THEM
  - \* INDICATES STRUCTURAL POST AS SPECIFY BY POST BEAM MANUFACTURE
  - \* CLOUDED AREA INDICATES CHANGES TO THE PLANS

**4. WINDOW/DOOR HEAD FRAMING DETAIL (TYP.)**

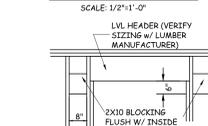

**MAIN LEVEL (STRUCTURAL) FLOOR PLAN** SCALE: 1/4"=1'-0"

Common Ground  
**Matthew** CONST. GENERAL CONTRACTOR  
 CONSTRUCTION DRAWINGS BY:  
**H.G. McCULLOUGH DESIGNERS, INC.**  
 9800 Westpoint Drive, Ste. 200, Indianapolis, IN 46256  
 317.558.8759 P. 317.558.8760 F. garynancedesign.com  
 garynancedesign.com  
 These design concepts are the property of Gary Nance Design and may not be used without approval from Gary Nance Design  
 Designed For:  
**Underwood**  
 RETREAT  
 Date: 06-06-15  
 Plan Number: #14082-4  
 Architectural Concepts By  
**GARY NANCE DESIGN**  
 SHEET NUMBER  
 3

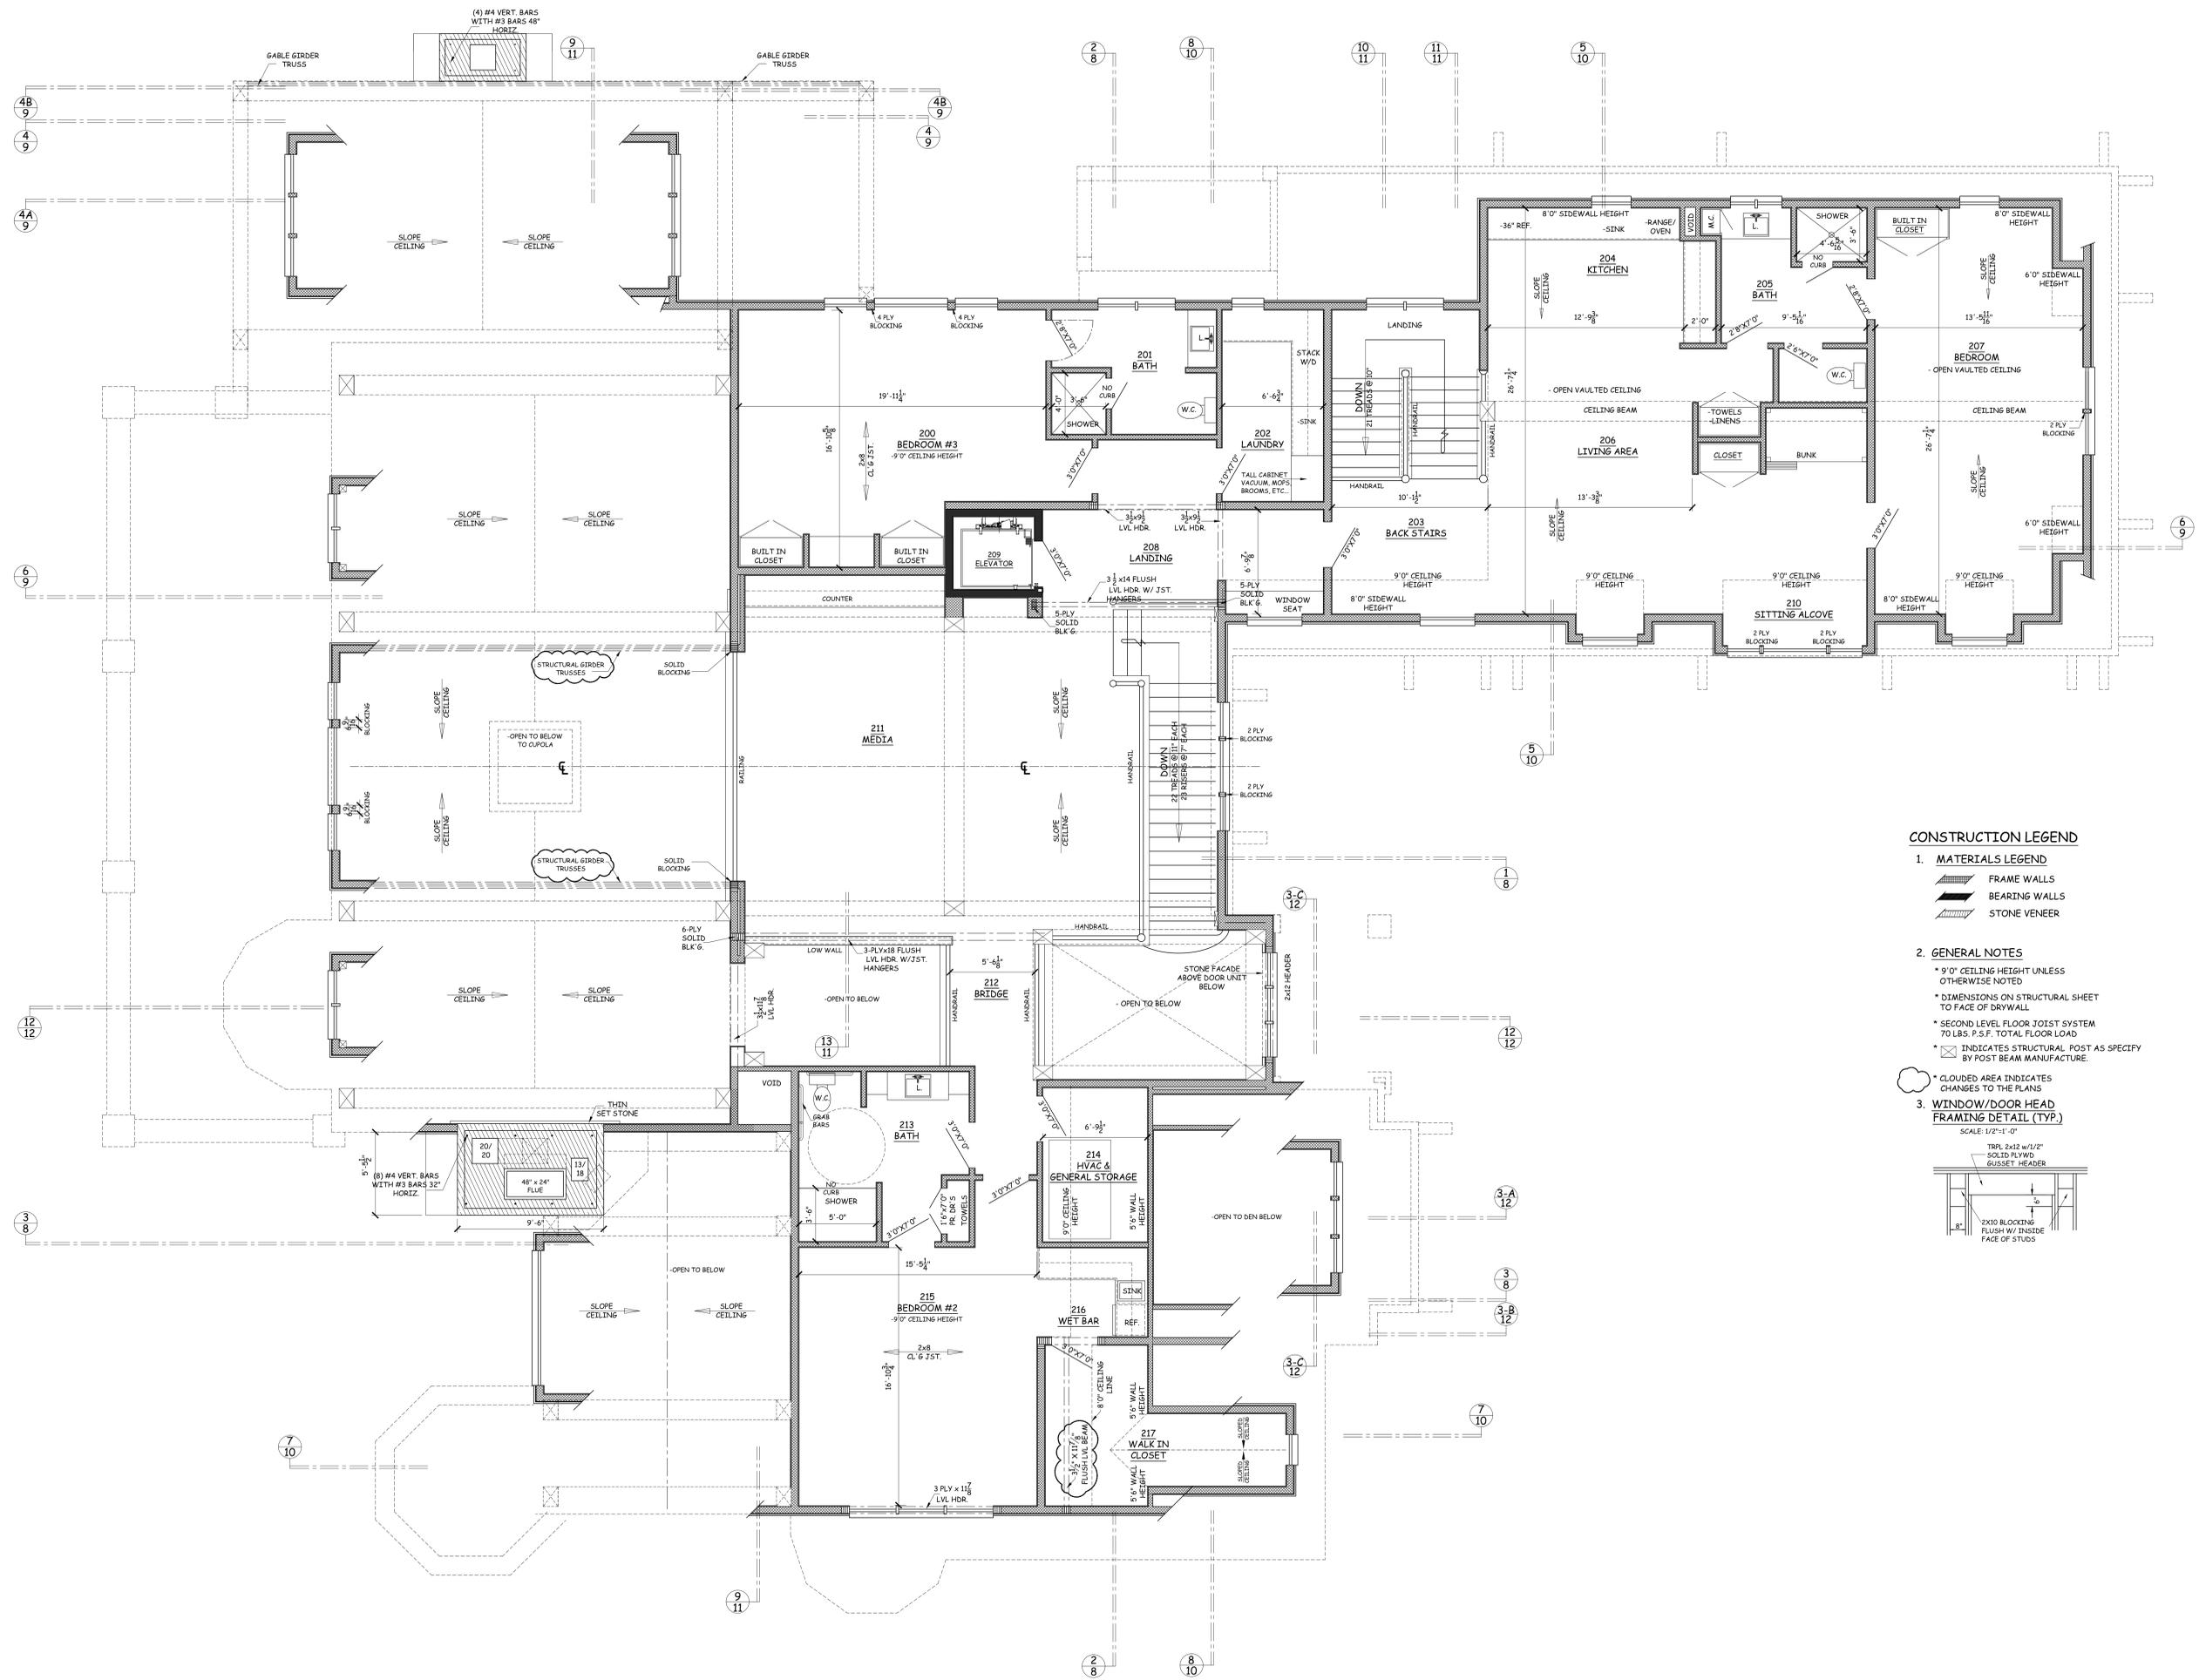


**CONSTRUCTION LEGEND**

- 1. MATERIALS LEGEND**
- FRAME WALLS
  - BEARING WALLS
  - STONE VENEER

**2. GENERAL NOTES**

- \* 9'0" CEILING HEIGHT UNLESS OTHERWISE NOTED
- \* DIMENSIONS ON STRUCTURAL SHEET TO FACE OF BRW WALL
- \* SECOND LEVEL FLOOR JOIST SYSTEM 70 LBS. P.S.F. TOTAL FLOOR LOAD
- \* INDICATES STRUCTURAL POST AS SPECIFY BY POST BEAM MANUFACTURE.

**3. WINDOW/DOOR HEAD FRAMING DETAIL (TYP.)**

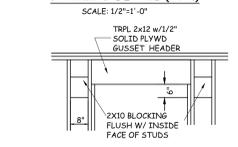

**SECOND LEVEL (STRUCTURAL) FLOOR PLAN SCALE: 1/4"=1'-0"**



CONSTRUCTION DRAWINGS BY:  
**H. G. McCULLOUGH DESIGNERS, INC.**  
 2146 Glenview Drive, Evansville, IN 47720  
 Telephone: 812.428.8074  
 Email: hgmccullough.com

Designed For:  
**Underwood RETREAT**  
 Date: 06-06-15  
 Plan number: #140824

9800 Westport Drive, Ste. 200, Indianapolis, IN 46256  
 317.558.8759 P. 317.558.8760 F. garynancedesign.com  
 garynancedesign.com  
 These design concepts are the property of Gary Nance Design and may not be used without approval from Gary Nance Design

Architectural Concepts By  
**GARY NANCE DESIGN**