






PROFILE

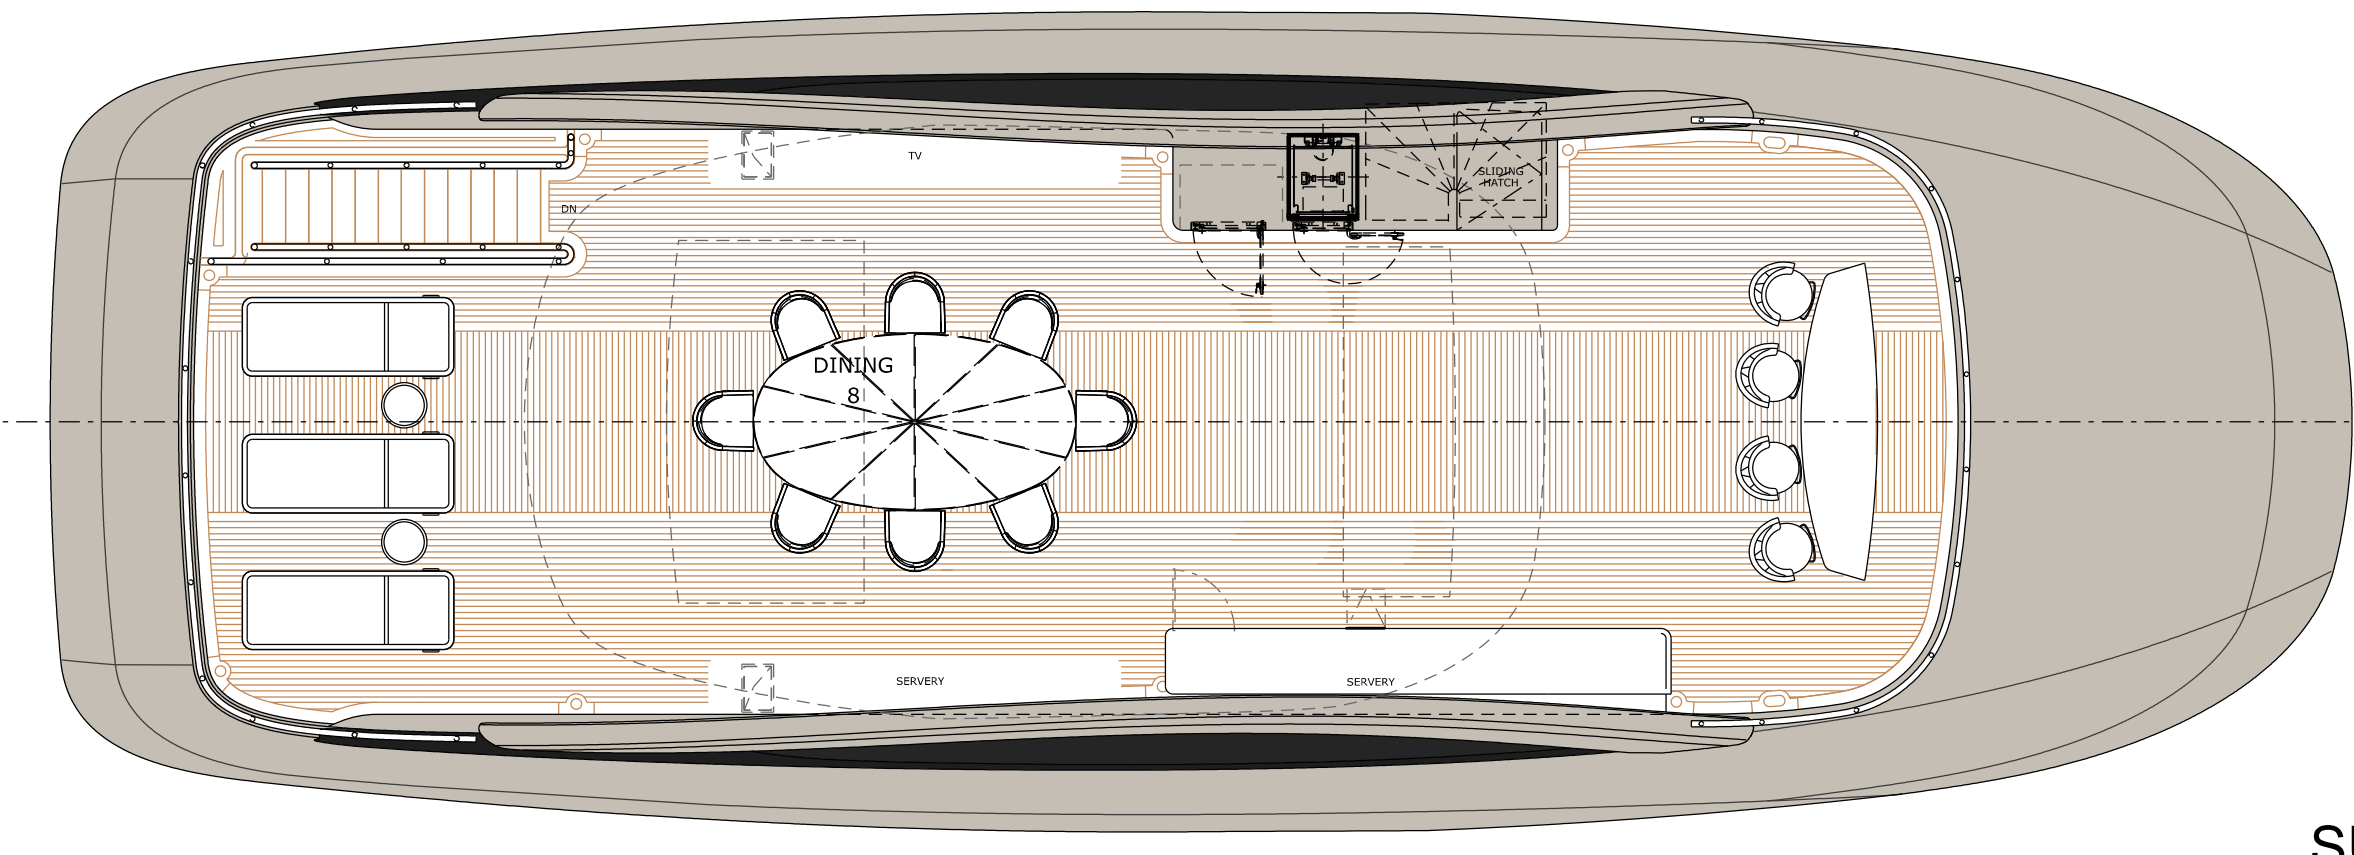


SUN DECK

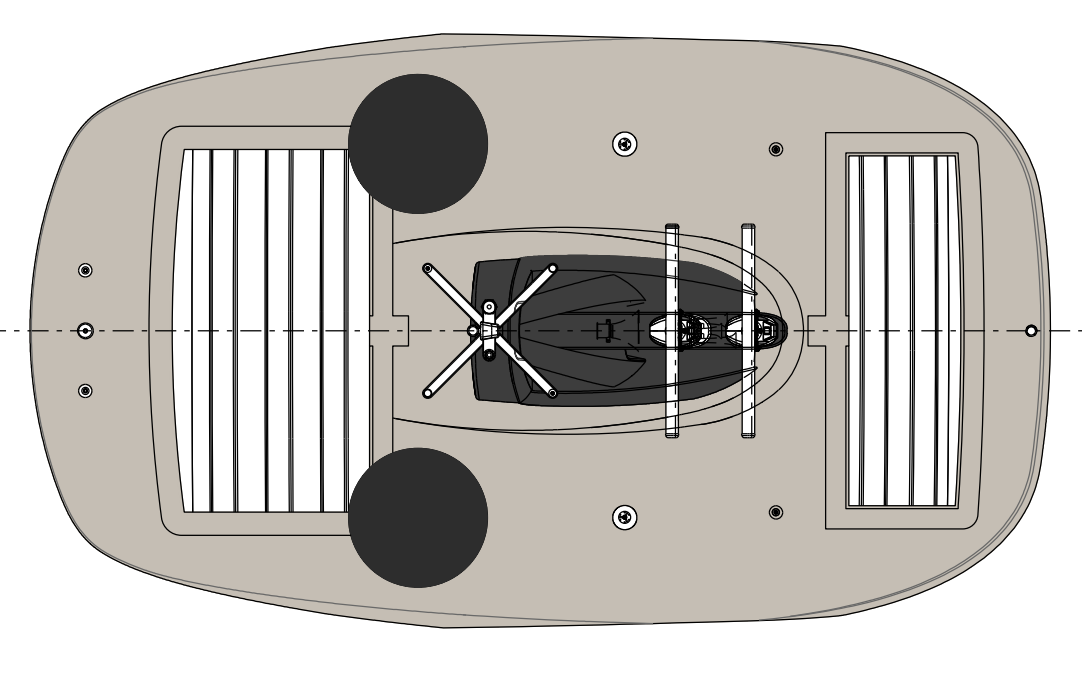

TOP

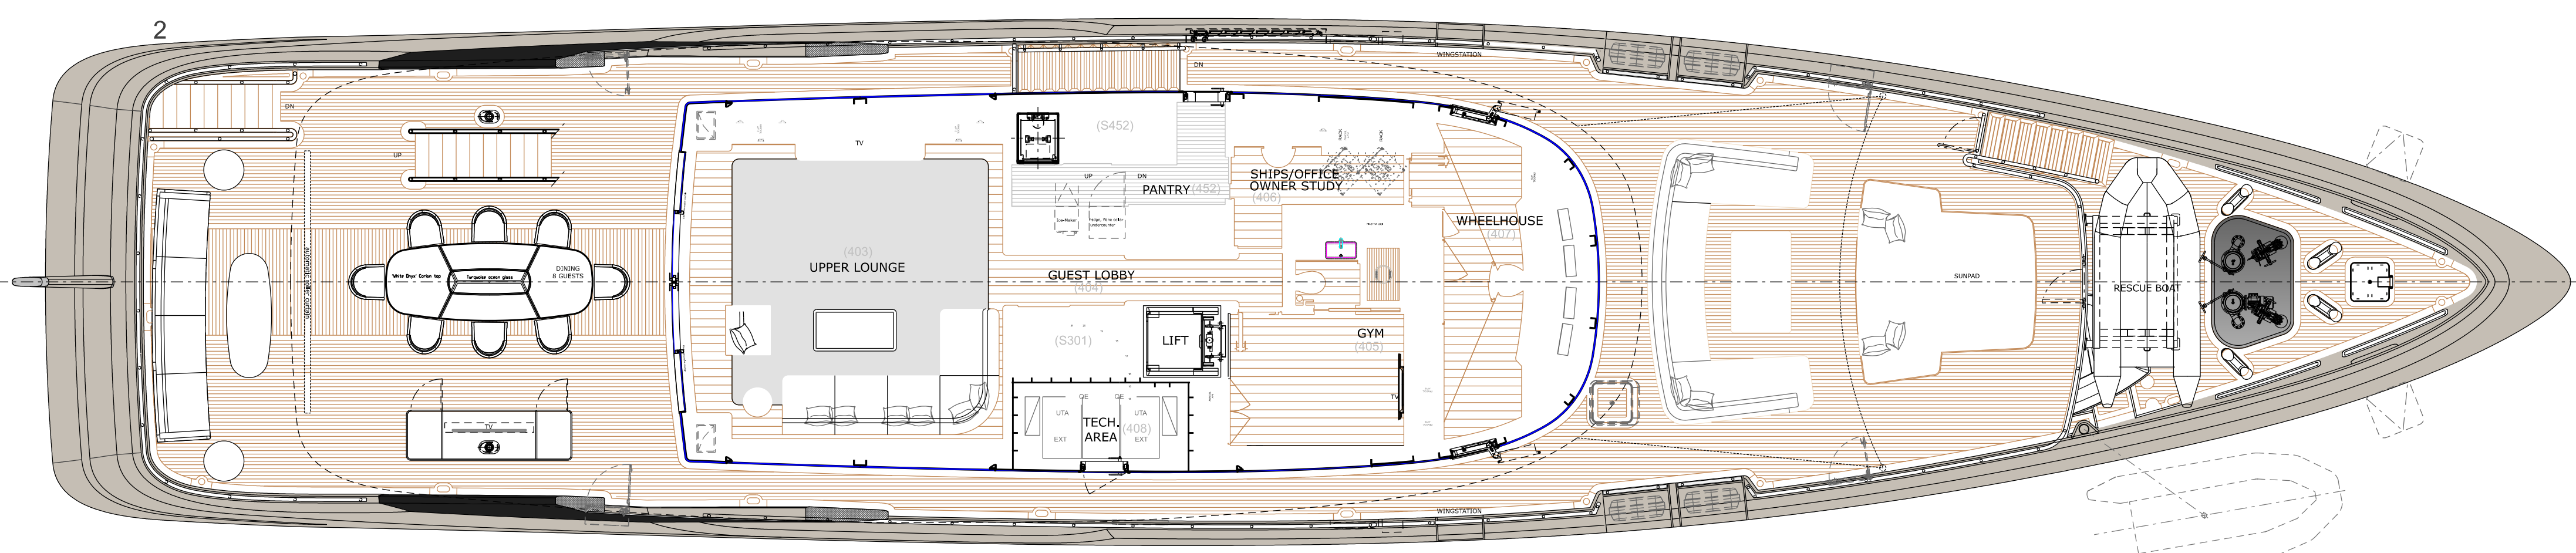


UPPER DECK

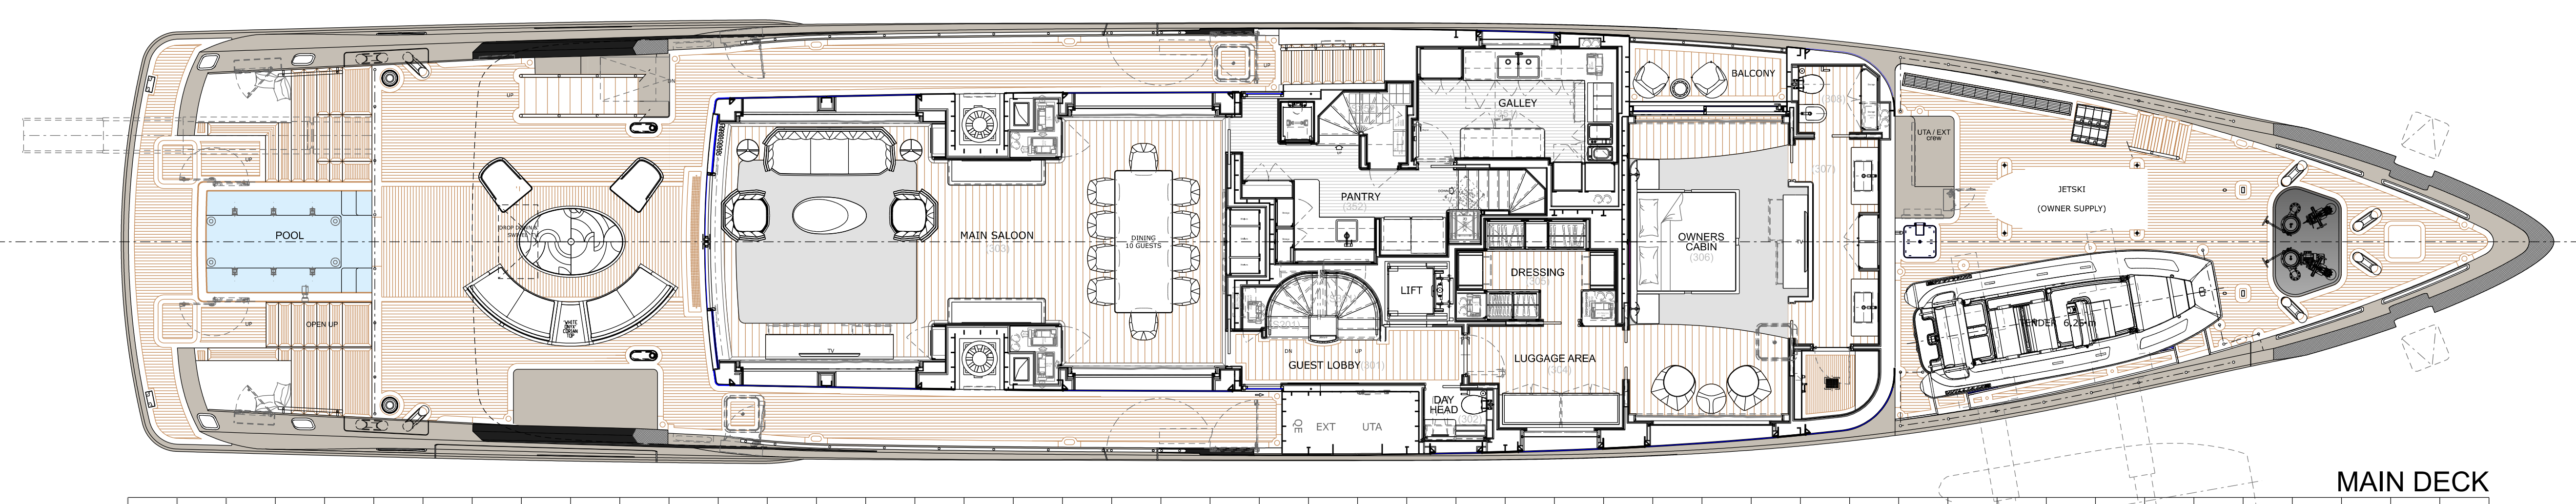

MAIN DECK



LOWER DECK

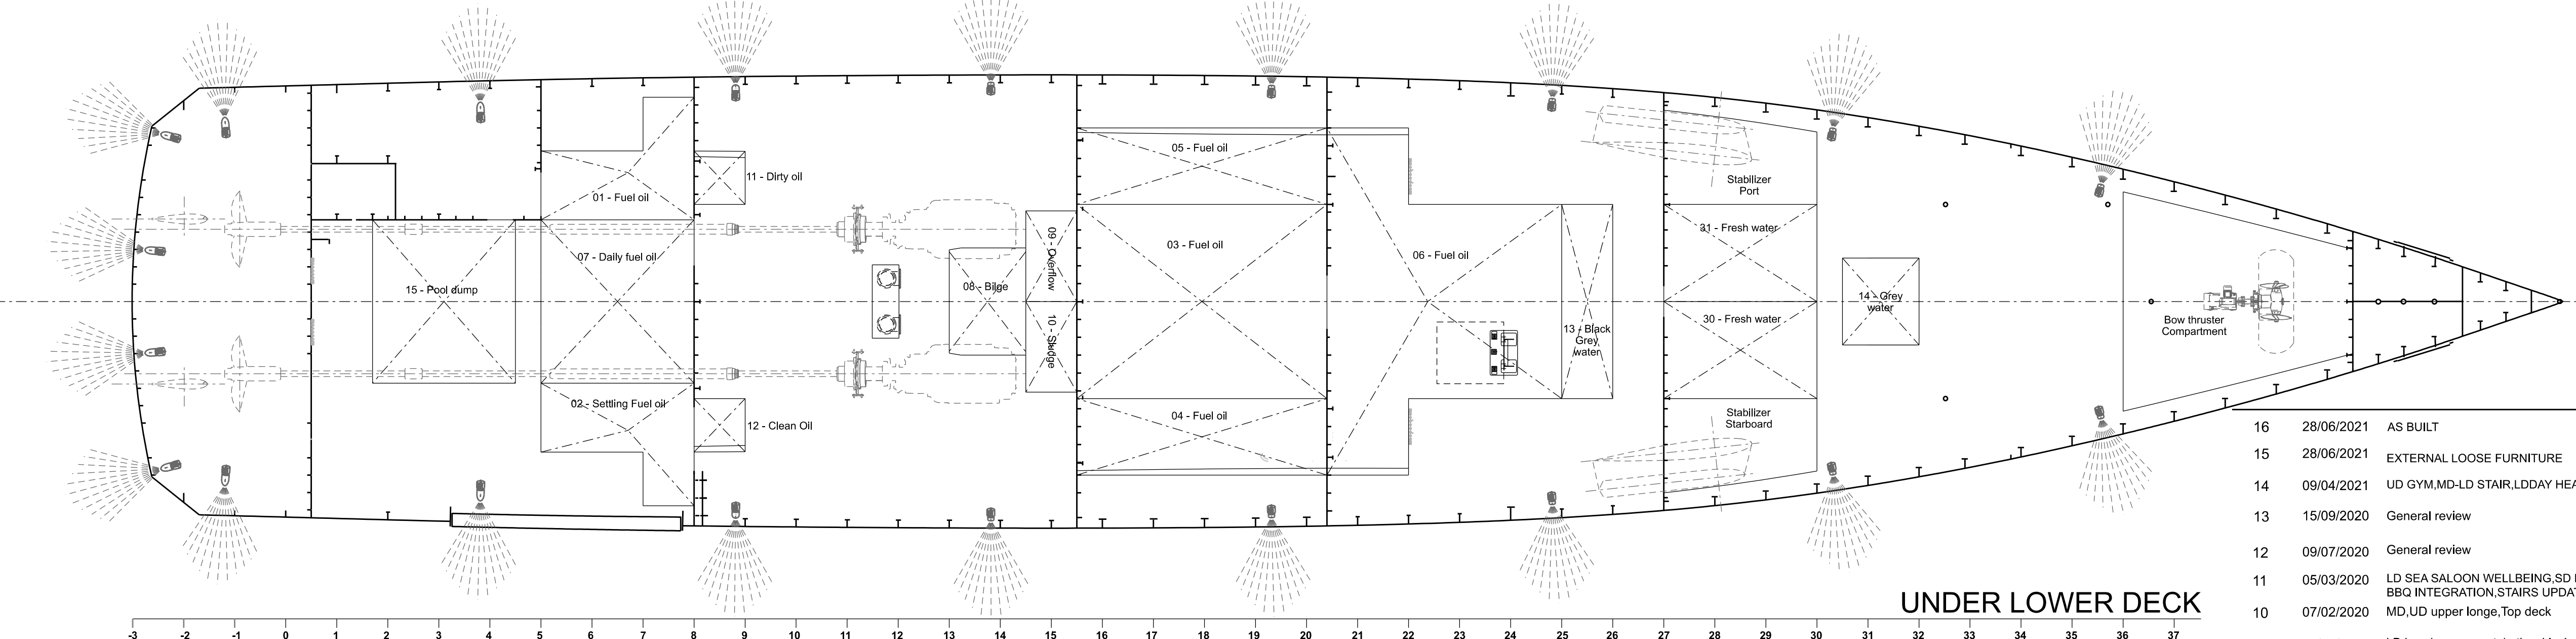

UNDER LOWER DECK

Rev./Upd.	Date	Descrizione Aggiornamento/Update Description	Drawn by	Checked by	Approved by
16	28/06/2021	AS BUILT			A.Sartorio
15	28/06/2021	EXTERNAL LOOSE FURNITURE			A.Sartorio
14	09/04/2021	UD GYM/MID-LD STARBOARD HEAD			A.Sartorio
13	15/09/2020	General review			A.Sartorio
12	09/07/2020	General review			A.Sartorio
11	05/03/2020	LD SEA SALOON WELL BEING SD BAR PROPOSALS BBO INTEGRATION STAIRS UPDATE			A.Sartorio
10	07/02/2020	MD/LD upper lounge, Top deck			A.Sartorio
09	23/01/2020	LD beach area, guest bath cabin, 4 crew mess corridor, escape, new deck officer cabins			A.Sartorio


RWD

344 BENNETT BLVD NEW YORK, NY 10017
 212 692 1000
 WWW.RWDDESIGN.COM

GENERAL ARRANGEMENT OPTION VERSION 3
 1/75 @ A0
 20th FEBRUARY 2019

344-BENNETT-030
 D-2019-030E-2019

MAIN DIMENSIONS		MAIN CHARACTERISTICS	
LOA	49.9 m	HULL	steel
Lwl	47.5 m about	SVR	aluminum
BOA	9.2 m	PROPULSION TYPE	mechanical shaft line
B	8.9 m	CREW NUMBER (max)	10
GT	499 about	GUEST NUMBER (max)	10

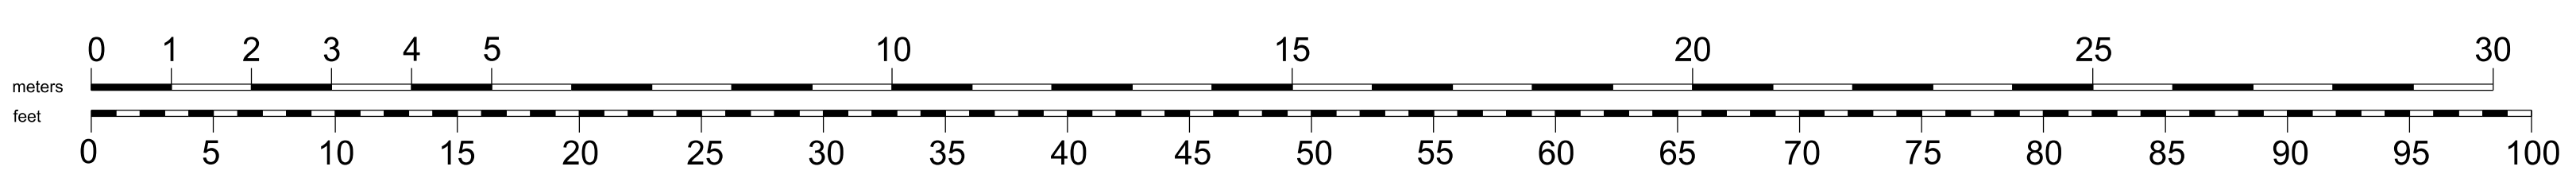

NOTE: ALL THE A/V EQUIPMENT AND DOMESTIC APPLIANCES SHOWN ON THIS GENERAL ARRANGEMENT PLAN REFER TO AN ALLOWANCE AND HAVE NOT TO BE REGARDED AS CONTRACTUAL ITEMS.

1:75

NEW MOTOR YACHT 50 m

GENERAL ARRANGEMENT
Piano Generale

Rev. 16
 Date 28/06/2021
 Description AS BUILT
 Drawn by
 Checked by
 Approved by A.Sartorio

Project: 344-BENNETT-030
 Date: 28/06/2021
 Scale: 1:75
 Author: A.Sartorio
 Designer: A.Sartorio
 Approver: A.Sartorio
 Publisher: A.Sartorio

FB602 602-0101 16 1/1 602-0101.dgn 04/07/2019

TEC-PRB