KEYED NOTES REMOVE ELECTRICAL PANEL AND ANY CONDUITS, AS SHOWN IN ELECTRICAL PLANS. PREPARE WALL FOR NEW FINISHES EXISTING SINK, REMOVE AND DISPOSE EXISTING FAUCET, REMOVE AND DISPOSE EXISTING FOOT PEDALS, REMOVE AND DISPOSE EXISTING MEDICAL GASES (WALL MOUNTED), PROTECT IN PLACE REMOVE AND DISPOSE EXISTING PLASTIC LAMINATE COUNTERTOP, PREPARE FOR NEW COUNTERTOP (SEE PLANS) REMOVE AND DISPOSE EXISTING BASE CABINETS AND / OR UPPER CABINETS, PREPARE WALLS FOR NEW CABINETS (SEE PLANS) REMOVE AND DISPOSE EXISTING CEILING TILES AND CEILING GRIDS, PREPARE FOR NEW REMOVE, SALVAGE AND REINSTALL DIFFUSERS AND FIRE SPRINKLER HEADS AS NEEDED, PROTECT EXISTING METAL STRUT SYSTEM ABOVE CEILING, PREPARE STRUCTURE FOR NEW METAL STRUT SYSTEM REMOVE AND DISPOSE EXISTING WALL PROTECTION AND CORNER GUARDS AROUND THIS ROOM, PROTECT WALLS FOR FUTURE FINISHES, REPAIR AS NEEDED PRIOR TO NEW INSTALLATION DEMO FLOOR COVERING SLAB LEVELING WORK IN THIS AREA, REFER TO STRUCTURAL AND CARESTREAM DRAWINGS FOR ADDITIONAL INFORMATION EXISTING TABLE ANCHOR SYSTEM TO BE REMOVED, PATCH AND FILL AS NEEDED FOR FUTURE EXISTING FLOOR ELECTRICAL BOX TO BE REMOVED, PATCH AND FILL AS NEEDED FOR FUTURE EXISTING SOAP DISPENSER, REMOVE AND SALVAGE FOR REUSE, RETURN TO OWNER, REPAIR AND REPAINT WALL AS REQUIRED EXISTING PAPER TOWEL DISPENSER, REMOVE AND SALVAGE FOR REUSE, RETURN TO OWNER, REPAIR AND REPAINT WALL AS REQUIRED EXISTING APRON RACK, REMOVE AND SALVAGE FOR REUSE, RETURN TO OWNER, REPAIR AND REPAINT WALL AS REQUIRED EXISTING PATIENT TRANSFER BOARD, REMOVE AND SALVAGE FOR REUSE, RETURN TO OWNER, REPAIR AND REPAINT WALL AS REQUIRED

GENERAL DEMOLITION NOTES

- . FIELD VERIFY DIMENSIONS AND CONDITIONS INCLUDING EXISTING UTILITIES PRIOR TO BIDDING. BRING DIFFERING DIMENSIONS AND CONDITIONS TO ARCHITECT'S ATTENTION
- A HAZARDOUS MATERIAL SURVEY IS AVAILABLE FROM THE OWNER. ABATEMENT MUST BE COMPLETED PRIOR TO DEMOLITION OF BUILDINGS OR BUILDING ELEMENTS.
- PROVIDE DUSTPROOF ENCLOSURES AT PERIMETER OF CONSTRUCTION & DEMOLITION
- FOR PROTECTION OF ADJACENT SPACES. COORDINATE MAINTENANCE OF FIRE EGRESS FOR OCCUPANTS IN EXISTING BUILDING
- WITH THE OWNER AND FIRE MARSHAL. PROVIDE NECESSARY TEMPORARY WALLS OR ENCLOSURES, EMERGENCY LIGHTS, ETC., FOR THE DURATION OF CONSTRUCTION.
- BRING TO ARCHITECT'S ATTENTION EXISTING CONDITIONS THAT PRESENT ANY CODE VIOLATIONS, INCORRECT CONSTRUCTION OR SAFETY PROBLEMS.
- MAINTAIN EXISTING FIRE RATINGS, AND ASSOCIATED FIRE PROTECTION SYSTEMS (I.E. FIRE SPRINKLERS AND FIRE ALARM SYSTEMS) THROUGHOUT CONSTRUCTION. COORDINATE ANY INTERRUPTION TO THESE SYSTEMS WITH THE OWNER AND FIRE MARSHAL. PROVIDE FIRE WATCH REQUIREMENTS ASSOCIATED WITH INTERRUPTIONS TO THESE SYSTEMS.
- PROTECT EXISTING STRUCTURE, FINISHES, AND SITE ELEMENTS NOT SCHEDULED FOR DEMOLITION. RESTORE DAMAGED ITEMS TO THEIR ORIGINAL CONDITION OR REPLACE AT CONTRACTOR'S EXPENSE.
- REMOVE AND DISPOSE SELECTIVE DEMOLITION MATERIAL PER CITY REQUIREMENTS.
- SALVAGE MATERIAL WHERE INDICATED. REMOVE ITEMS FROM CURRENT LOCATIONS & PREPARE FOR TRANSPORT BY THE OWNER.

GENERAL PLAN DEMOLITION NOTES

1. REFER TO ELECTRICAL AND MECHANICAL PLANS FOR REQUIRED ADDITIONAL DEMOLITION


- 2. MAINTAIN EXISTING FIRE RATINGS THROUGHOUT CONSTRUCTION
- 3. DO NOT DISTURB EXISTING FIRE RATED ELEMENTS INCLUDING FIREPROOFING. PATCH/REPAIR DAMAGED OR DISTURBED ITEMS.
- 4. AFTER DEMOLITION, PRIOR TO FINISH, PATCH AND REPAIR EXISTING WALLS TO
- PROVIDE SMOOTH SURFACE SUITABLE FOR PAINTING OR WALL COVERING. 5. PATCH & LEVEL EXISTING CONCRETE SLABS FOR NEW FINISHES WITH FLOOR LEVELING
- 6. FIELD VERIFY AND COORDINATE SAW CUTTING OF THE CONCRETE FLOOR SLAB WITH PLUMBING AND ELECTRICAL.
- 7. REPLACE SLAB AND TRENCH BY COMPACTING CLEAN GRAVEL IN 8 INCH LIFTS. DRILL #4 EPOXY-COATED REBAR INTO EXISTING SLAB @ 12 INCHES OC. POUR SLAB TO PROVIDE
- 8. WHERE ELECTRICAL CIRCUIT CONTINUITY IS INTERRUPTED, BUT MUST BE MAINTAINED,
- 9. REMOVE ELECTRICAL BOXES BEHIND RELOCATED MILLWORK AND CAP AS REQUIRED.


MAKE NECESSARY MODIFICATIONS TO MAINTAIN CIRCUIT INTEGRITY.

DEMOLITION LEGEND

10. CAP EXISTING DUCT WORK FOR DUST CONTROL.

COMPOUND.

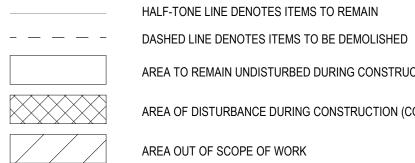

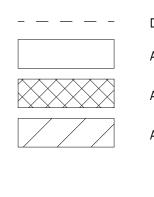



AREA TO REMAIN UNDISTURBED DURING CONSTRUCTION AREA OF DISTURBANCE DURING CONSTRUCTION (COORDINATE W. OWNER)





X-RAY ROOM ENTRANCE (Existing signage to remain)

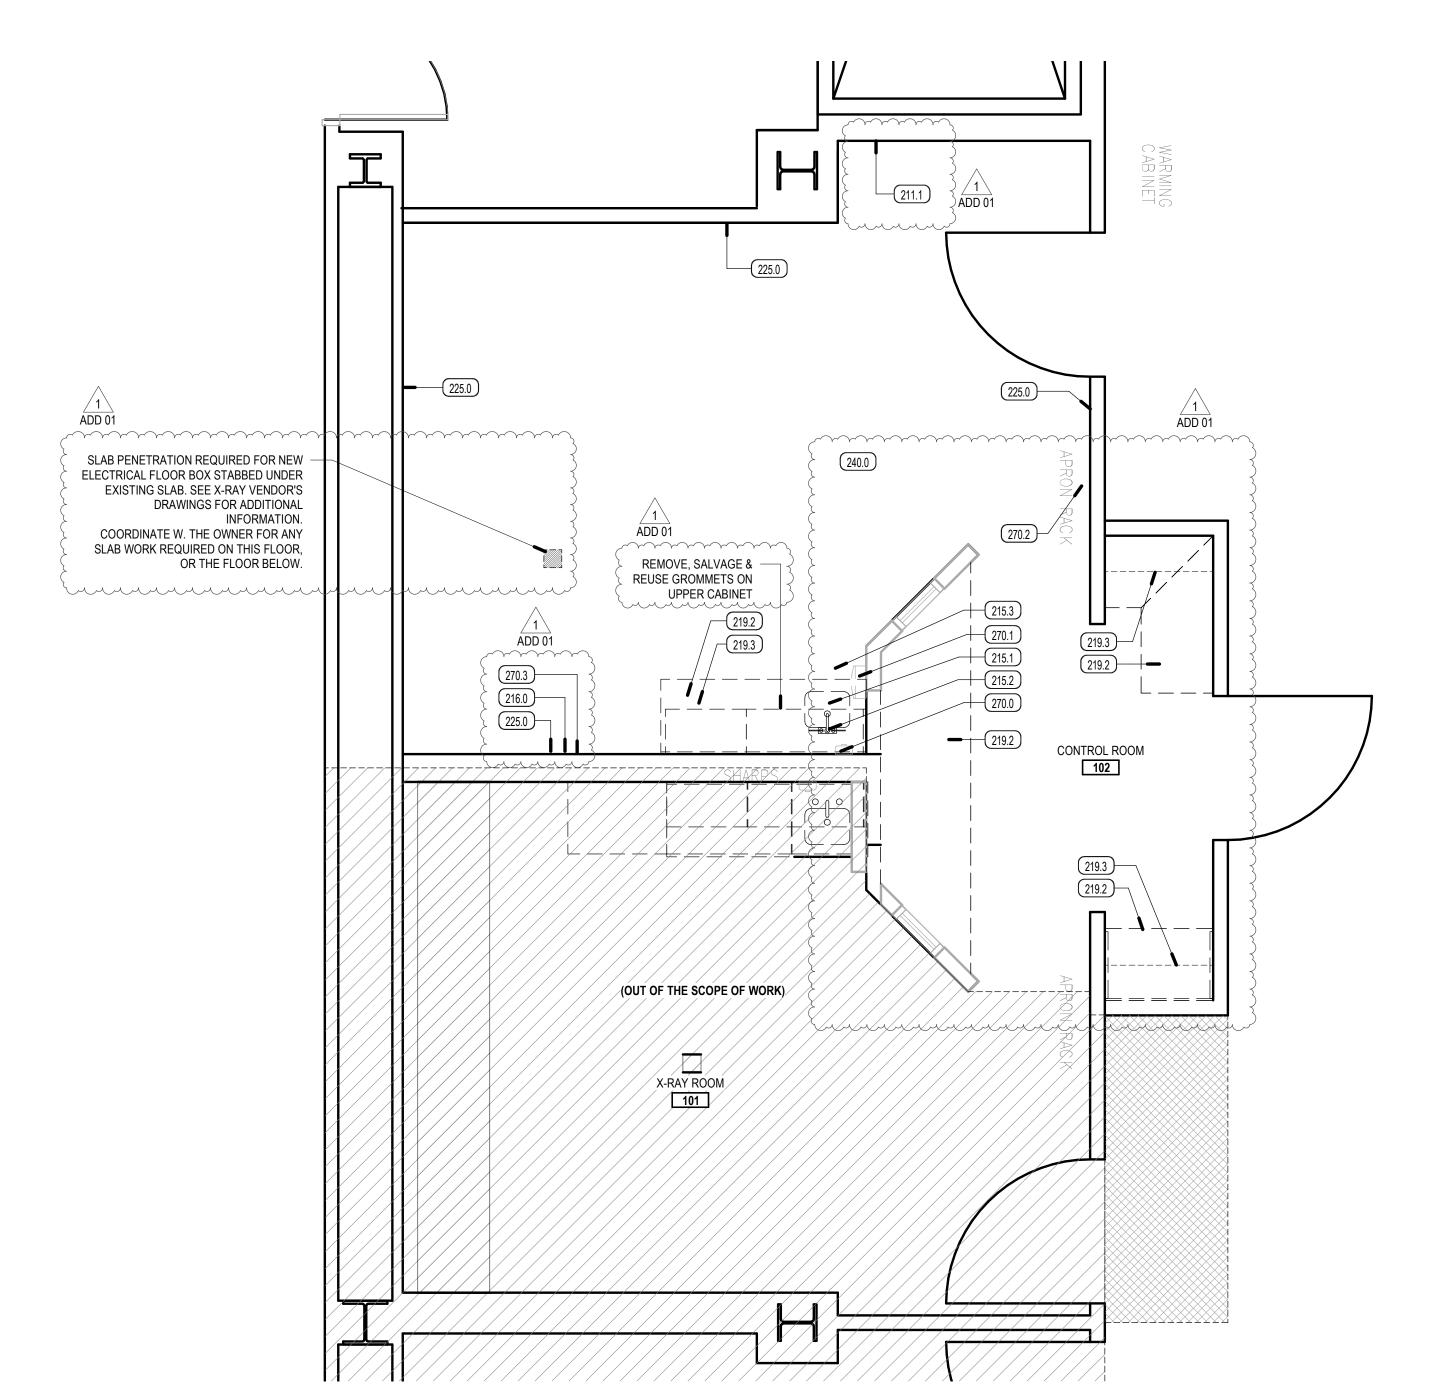


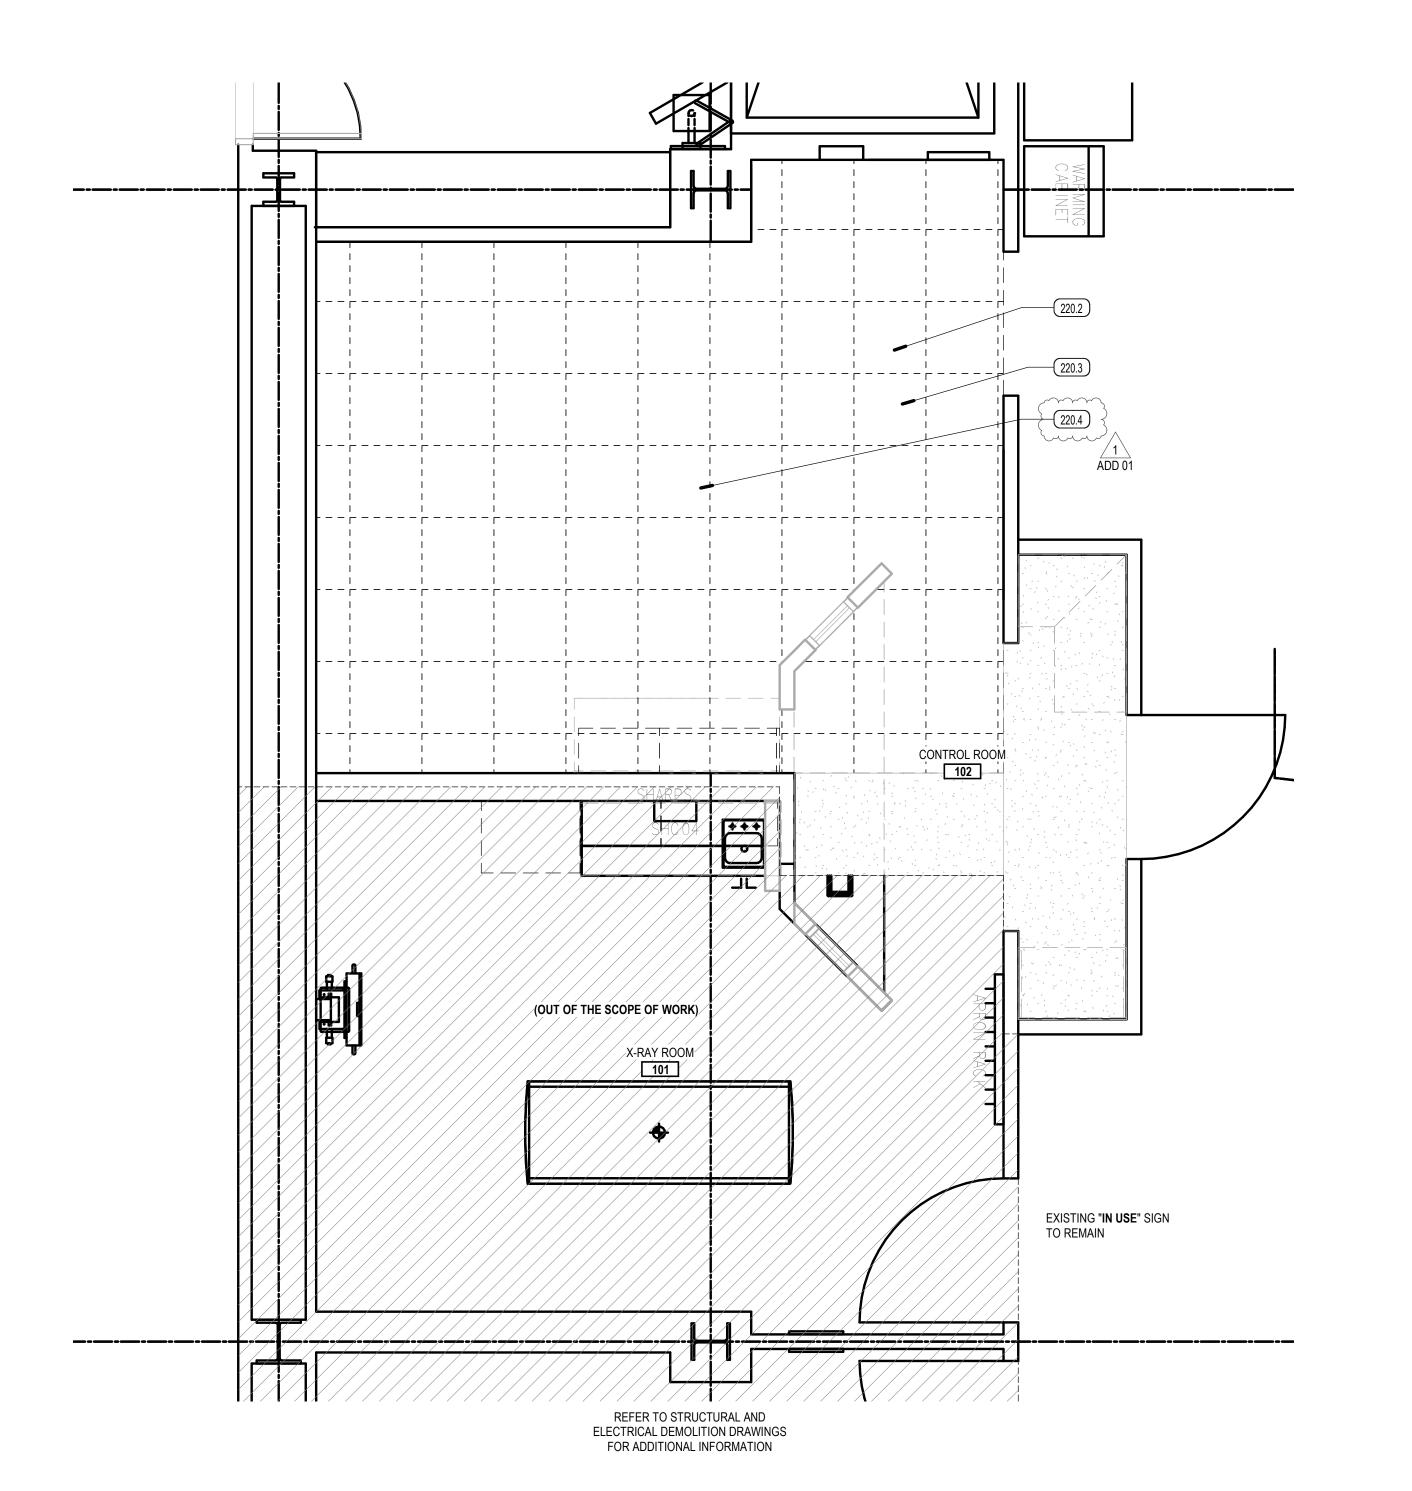

A1 DEMO PLAN - ENLARGED

A4 DEMO REFLECTED CEILING PLAN - ENLARGED

SCALE: 3/8" = 1'-0"

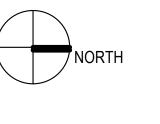

524 SOUTH 600 EAST SALT LAKE CITY, UT 84102

PINEGAR

DATE DESCRIPTION


	KEYED NOTES
Y VALUE	KEYNOTE TEXT
5.2	REINFORCED CONCRETE SLAB ON GRADE, 15" THICK, TO MATCH EXISTING
5.1	MILLWORK, WALL MOUNTED BASE CABINET WITH BLOCKING
5.2	MILLWORK, WALL MOUNTED UPPER CABINET WITH BLOCKING
5.0	COUNTERTOP, PLASTIC LAMINATE
5.1	COUNTERTOP, SOLID SURFACE
' .0	SOLID SURFACE INTEGRATED SINK
5.0	REPAIR AND PREPARE WALL FOR NEW PAINT, AS NEEDED (AT EXISTING TALL CABINET)
0.0	PAINT EXISTING DOOR/WINDOW FRAME
0.1	FAUCET

GENERAL NOTES


- 1. IT IS THE CONTRACTORS RESPONSIBILITY TO REVIEW AND COORDINATE THE WORK OF ALL SUB-CONTRACTORS, TRADES AND SUPPLIERS WITH THE REQUIREMENTS OF THE CONTRACT DOCUMENTS BEFORE COMMENCING CONSTRUCTION, AND TO ASSURE THAT ALL PARTIES ARE AWARE OF ALL REQUIREMENTS, REGARDLESS OF WHERE THE REQUIREMENTS OCCUR IN THE CONTRACT DOCUMENTS, WHICH MIGHT AFFECT THE WORK OF THAT PARTY.
- 2. AS PART OF THE CONTRACTOR'S RESPONSIBILITY TO COORDINATE THE WORK OF ALL SUB-CONTRACTORS, TRADES AND SUPPLIERS, THE CONTRACTOR SHALL ENDEAVOR TO IDENTIFY AND NOTIFY THE ARCHITECT OF ANY CONFLICTS BETWEEN THE WORK OF DIFFERENT PARTIES AT THE EARLIEST POSSIBLE DATE SO AS TO ALLOW REASONABLE AND ADEQUATE TIME FOR THE CONFLICT TO BE RESOLVED WITHOUT DELAYING THE WORK. ALL DEVIATIONS FROM THAT WHICH IS REQUIRED BY THE CONTRACT DOCUMENTS MUST BE APPROVED IN ADVANCE BY THE ARCHITECT.
- 3. THE ARCHITECTURAL DRAWINGS ESTABLISH AND COORDINATE THE FINISHED APPEARANCE AND EXACT LOCATION OF ALL EXPOSED ELEMENTS OF THE WORK OF ALL THE TRADES, INCLUDING THAT WORK WHICH IS ILLUSTRATED PRIMARILY ON DRAWINGS OF OTHER DISCIPLINES. QUANTITIES ARE TO BE PROVIDED AS SHOWN ON DRAWINGS OF OTHER DISCIPLINES BUT LOCATIONS SHOWN ON OTHER DRAWINGS ARE SCHEMATIC, UNLESS OTHERWISE NOTED ON THE ARCHITECTURAL DRAWINGS. THE ARCHITECTURAL DRAWINGS TAKE PRECEDENCE FOR THE FINISHED APPEARANCE AND EXACT LOCATION OF ALL PARTS OF THE WORK.
- 4. EXCEPT WHERE DIRECTED TO PLACE ITEMS OF WORK AT THE APPROXIMATE LOCATION SHOWN; DO NOT SCALE DRAWINGS FOR DIMENSIONAL INFORMATION. ALL ELEMENTS OF THE DRAWINGS MAY NOT BE DRAWN TO EXACT SCALE. ALL DIMENSIONS REQUIRED ARE SHOWN OR MAY BE DERIVED FROM THOSE SHOWN ON THE FLOOR PLANS, DETAIL PLANS, ELEVATIONS, SECTIONS, DETAILS, SCHEDULES AND SPECIFICATIONS. IF DIMENSIONS ARE NOT PRESENT, THE ARCHITECT IS TO BE NOTIFIED SO THAT A CLARIFICATION CAN BE ISSUED.
- 5. CONTRACTOR TO FOLLOW CURRENT ANSI 117-1 STANDARDS AS REPRESENTED ON SHEET G301, GENERAL ACCESSIBILITY GUIDELINES. NOTIFY ARCHITECT IF THE DESIGN DRAWINGS CONFLICT WITH THIS SHEET.

DIMENSION NOTES

- 1. ALL DIMENSIONS ARE TO CENTER OF STUD WALL OR FACE OF CONCRETE, MASONRY OR ROUGH OPENING UNLESS NOTED OTHERWISE. WHERE THE END OF A WALL IS INDICATED THE DIMENSION IS TO THE FINISH SURFACE OF THE WALL END.
- 2. UNLESS DIMENSIONED OTHERWISE, THE DIMENSION FROM THE BUCK OF A DOOR FRAME IS TO BE 4" TO THE WALL CORNER.
- 3. EXCEPT WHERE DIRECTED TO PLACE ITEMS OF WORK AT THE APPROXIMATE LOCATION SHOWN, DO NOT SCALE DRAWINGS FOR DIMENSIONAL INFORMATION. ALL ELEMENTS OF THE DRAWINGS MAY NOT BE DRAWN TO EXACT SCALE. ALL DIMENSIONS REQUIRED ARE SHOWN OR MAY BE DERIVED FROM THOSE SHOWN ON THE FLOOR PLANS, DETAIL PLANS, ELEVATIONS, SECTIONS, DETAILS, SCHEDULES AND SPECIFICATIONS. IF DIMENSIONS ARE NOT PRESENT, THE ARCHITECT IS TO BE NOTIFIED SO THAT A CLARIFICATION CAN BE ISSUED

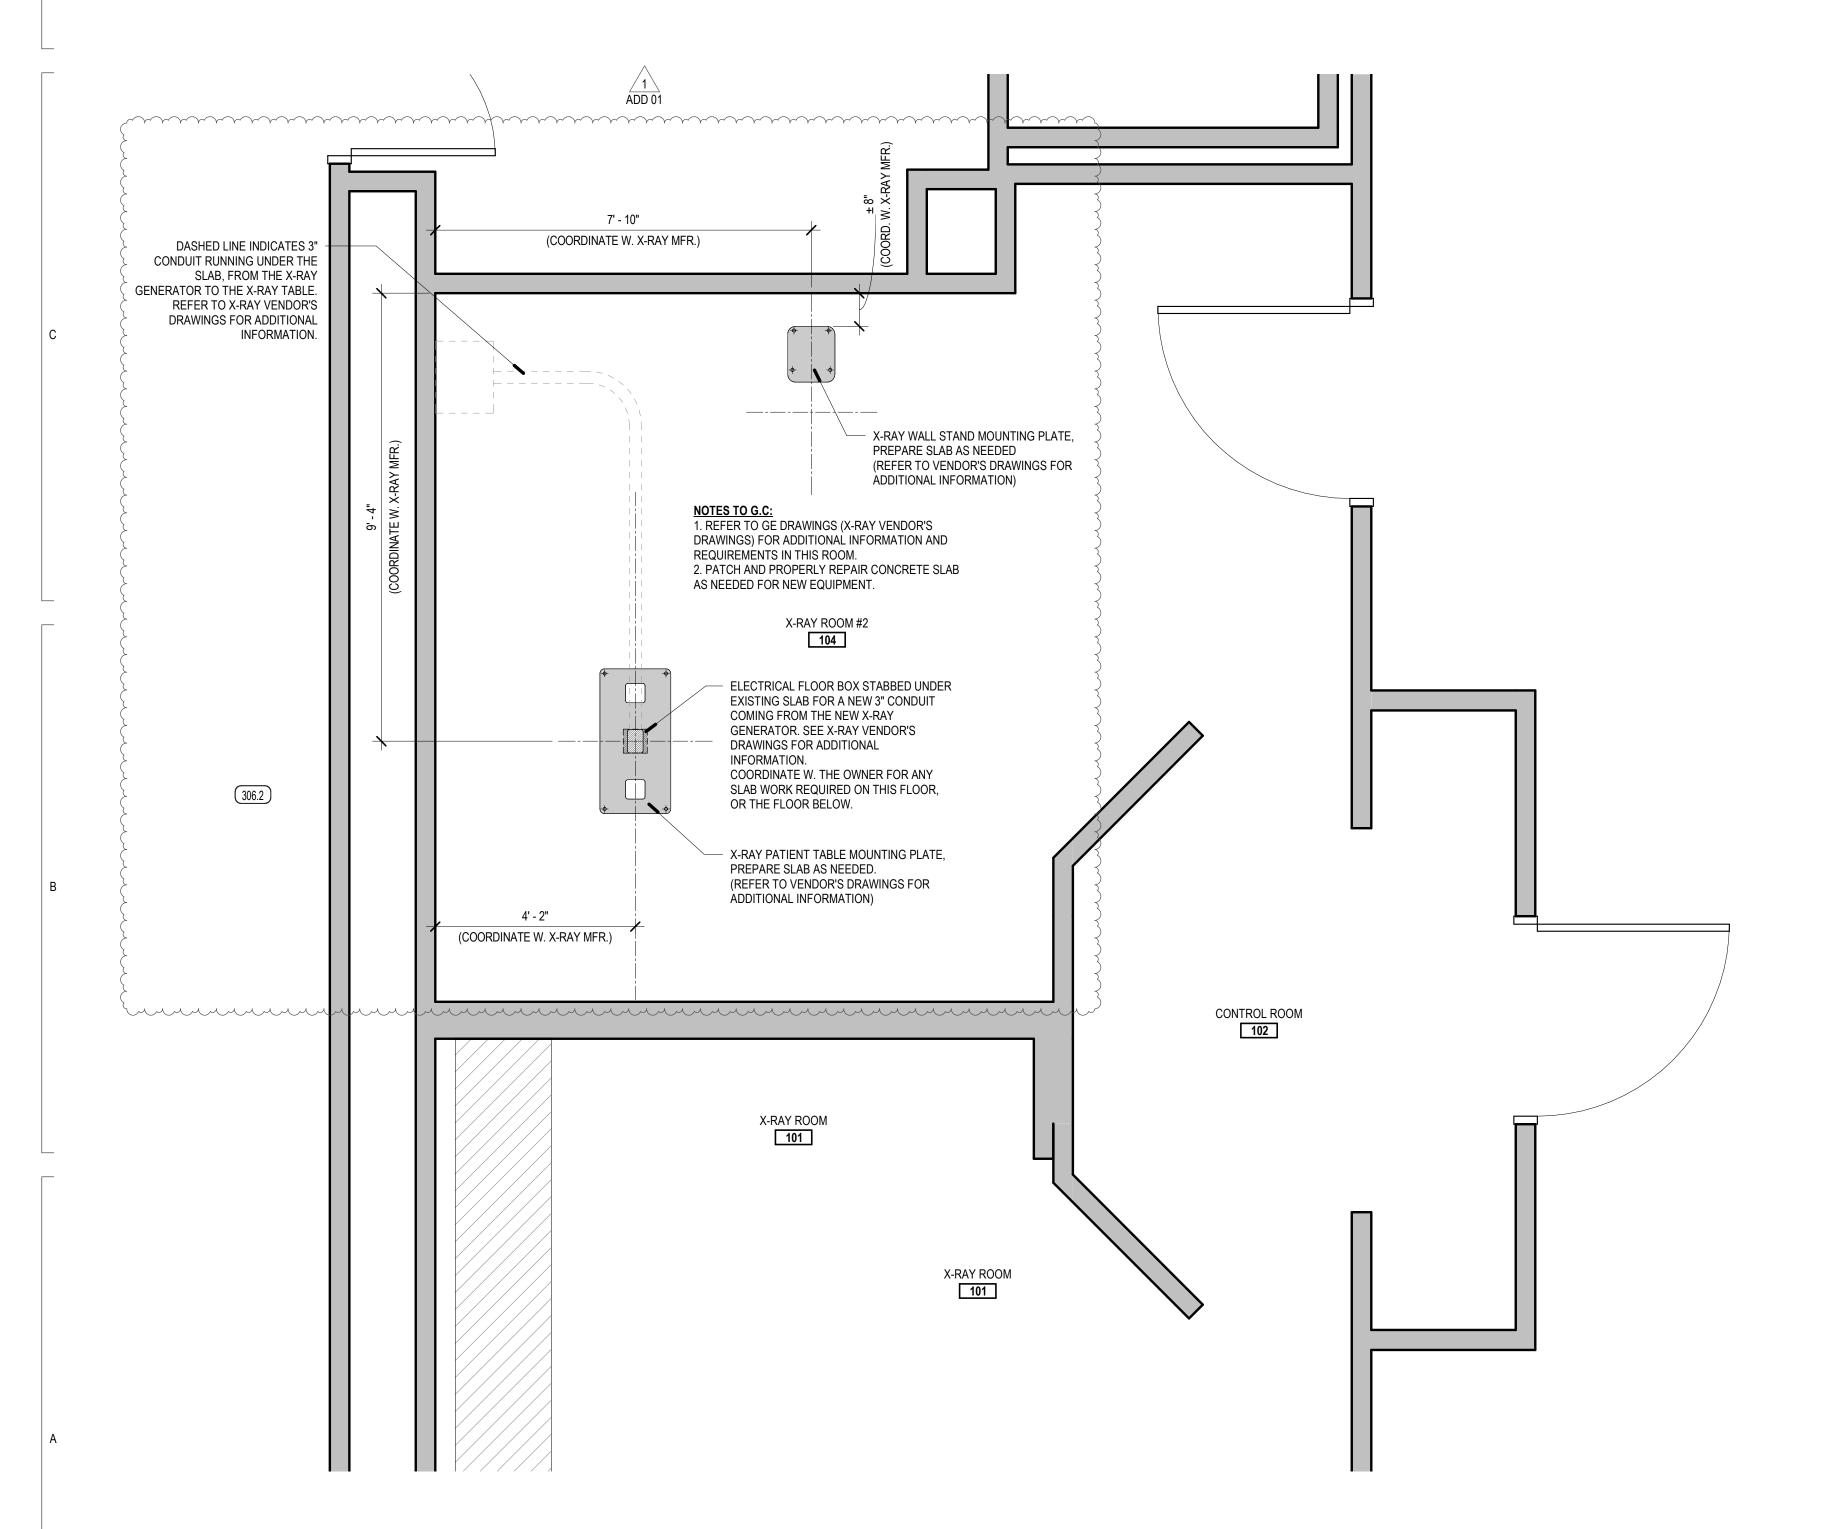




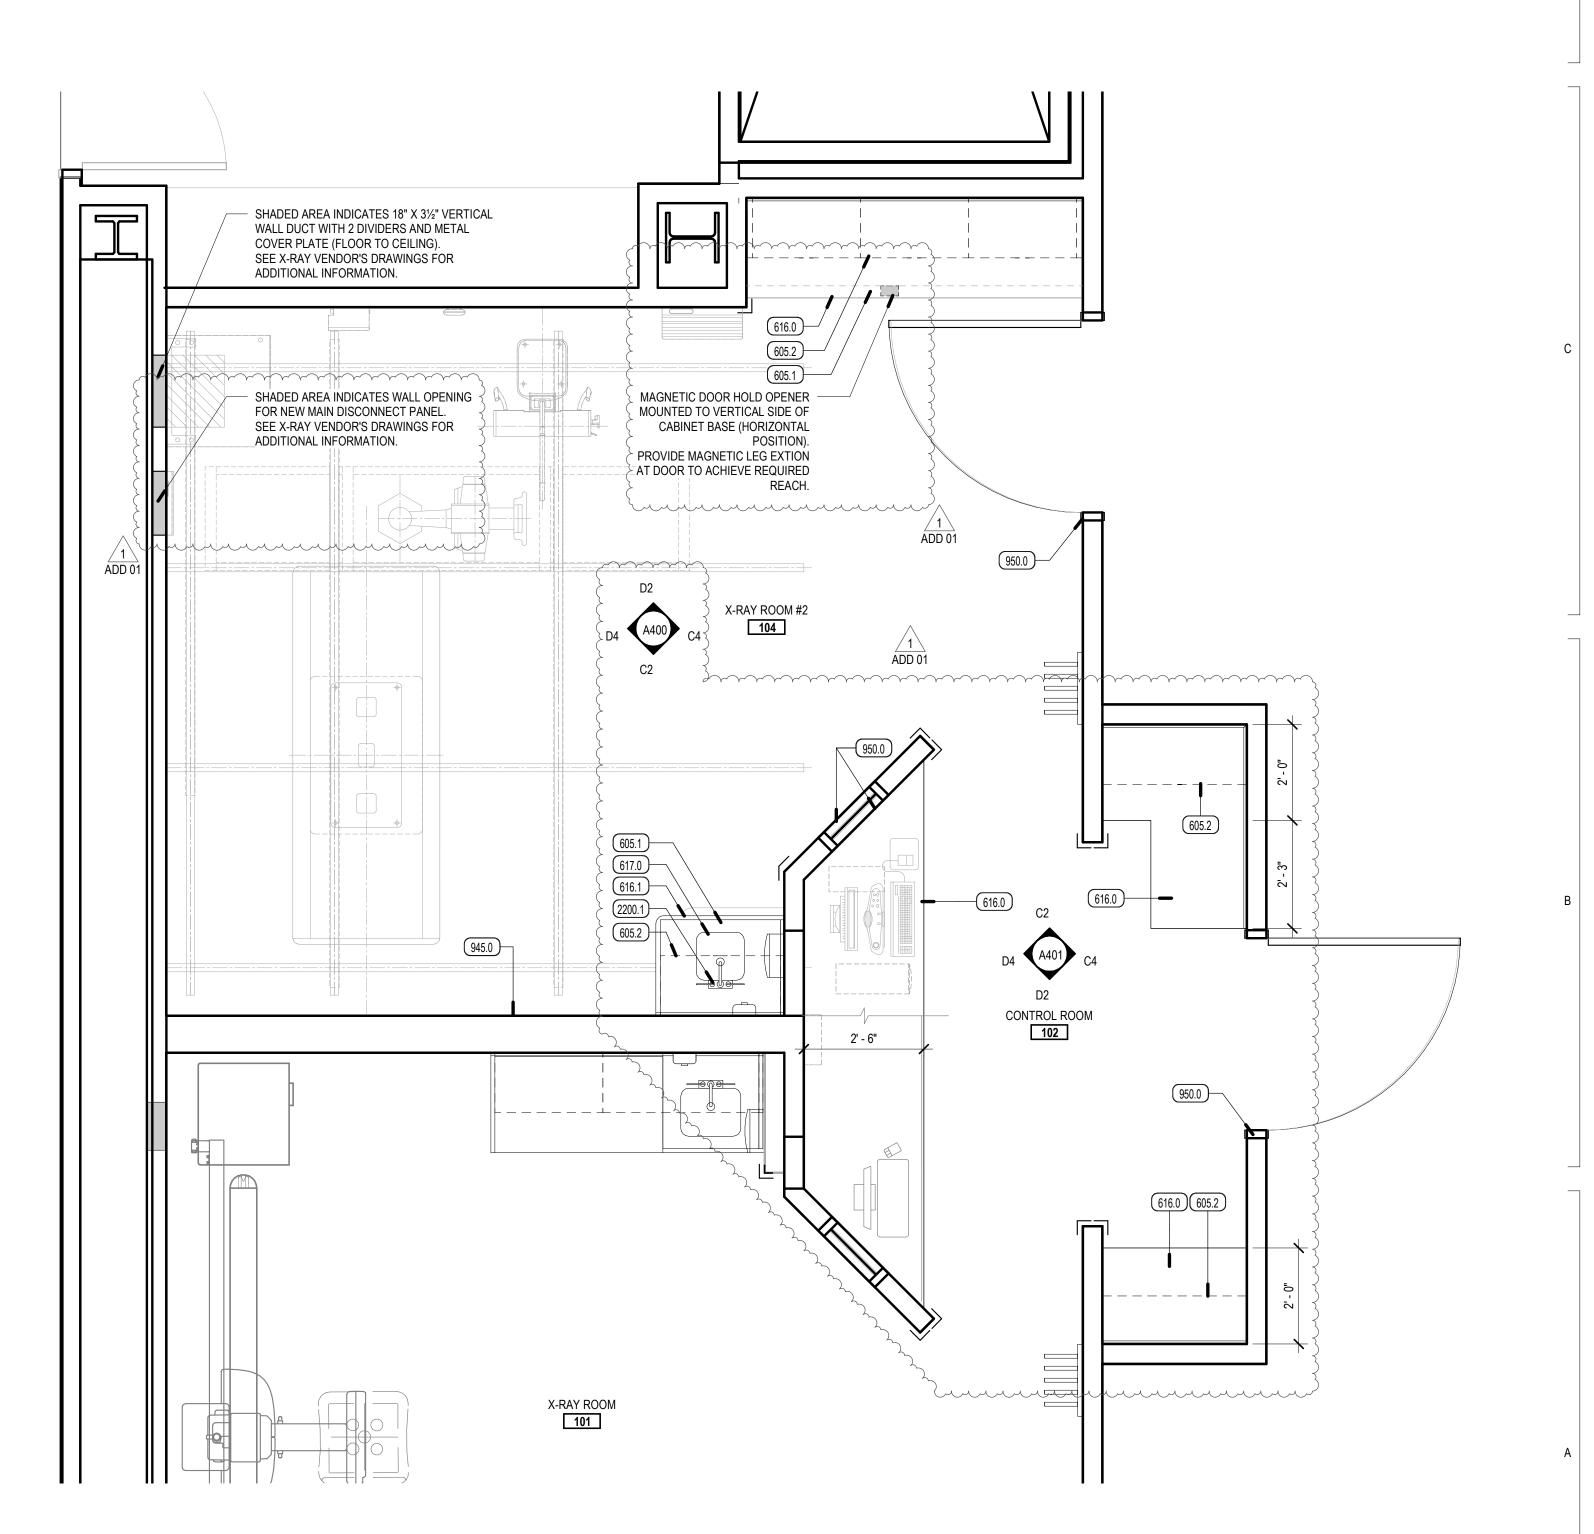

A5 LL-1 ANNOTATED & DIMENSION PLAN - ENLARGED

SCALE: 1/2" = 1'-0"

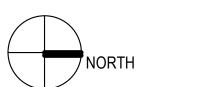

524 SOUTH 600 EAST SALT LAKE CITY, UT 84102



REV DATE DESCRIPTION

IMC EMERGEN PLAN - ENLARGED A110.1

LEGEND - FINISH												
MARK	PRODUCT DESCRIPTION	MANUFACTURER	NAME	COLOR	COMMENTS							
FLOOR												
F1	LINOLEUM	MANNINGTON	BIOSPEC SR 67361	SANDRIFT	MAIN COLOR							
F2	LINOLEUM	MANNINGTON	BIOSPEC SR 67203	FLAX	ACCENT COLOR (AT X-RAY AREA)							
F3	LINOLEUM	MANNINGTON	BIOSPEC SR 67369	BEDROCK	ACCENT COLOR (AT DOOR & AROUND X-RAY)							
B1	LINOLEUM	MANNINGTON		SANDRIFT / FLAX / BEDROCK	4" COVED - CARRY OVER SAME COLOR AS FLOORING WHERE IT OCCURRS							
Paint P1	LATEX PAINT - EGGSHELL	SHERWIN WILLIAMS		PURE WHITE SW 7005	BASE COLOR							
P2	LATEX PAINT - EGGSHELL	SHERWIN WILLIAMS		AUSTERE GRAY SW6184	ACCENT COLOR							
P3	LATEX PAINT - EGGSHELL	SHERWIN WILLIAMS		PORPOISE SW7047	DOOR FRAME & WINDOW FRAME							
SURFACE			· · · · · · · · · · · · · · · · · · ·									
PL1	PLASTIC LAMINATE	WILSONART	PREMIUM LAMINATE	8213K-28 PHANTOM COCOA	GLOSS LINE FINISH - VERTICAL SURFACES (SEE PLA							
PL2	PLASTIC LAMINATE	PIONITE	IL PALIO PAPEL	AV981 SUEDE	HORIZONTAL SURFACES (SEE PLANS)							
SS1	SOLID SURFACE - CORIAN	DUPONT	CORIAN	CONCRETE	SEE PLANS							


GENERAL FINISH NOTES


- 1. ALL FLOOR TRANSITIONS TO BE LOCATED AT CENTER OF DOOR, U.N.O.
- 2. FIELD VERIFY ALL DIMENSIONS BEFORE FABRICATION OF MILLWORK.
- 3. COORDINATE ALL MILLWORK WITH APPLIANCES BEFORE FABRICATION.
- 4. AT SOFFITS RECEIVING COLOR- PAINT ALL SIDES OF SOFFIT.

8. GYPSUM BOARD SOFFITS TO BE PAINTED WHITE.

- 5. ALL WOOD TRIM TO BE STAINED TO MATCH DOOR STAIN. 6. ALL COUNTERTOP, BACKSPLASHES, AND EDGE BANDING TO HAVE COORDINATING
- FINISHES.
- 7. PROVIDE A SMOOTH TRANSITION AT ALL FLOOR MATERIALS CONTRACTOR TO INSTALL ALL FLOOR FINISHES AT SAME LEVEL, DESPITE DIFFERENT THICKNESS.
- PROVIDE FLOOR TRANSITION WHERE OCCURS.
- 9. ALL EXPOSED CEILINGS TO BE PAINTED (WHERE OCCURS). REFER TO REFLECTED CEILING PLANS. COORDINATE WITH ARCHITECT FOR PAINT COLOR.

FINISH PLAN SYMBOLS

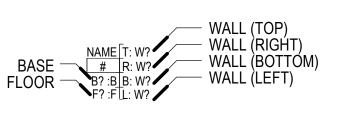

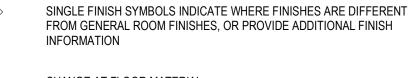

CHANGE AT FLOOR MATERIAL

SIGNAGE TAG- SEE SIGNAGE SHEETS FOR DETAILS

GENERAL CEILING NOTES

- 1. REFER TO DETAIL A2/A500 FOR TYPICAL CEILING SUSPENSION & SEISMIC BRACING
- 2. REFER TO DETAIL A3/A500 FOR TYPICAL SUSPENDED GYP. BOARD CEILINGS
- 3. ALL UNIDENTIFIED CEILING TYPES ON THE PLANS SHALL BE TYPE " A" AT 9'-0" A.F.F.
- 4. GRID SUSPENSION SYSTEMS SHALL BE CENTERED WITHIN AREAS INDICATED, UNLESS NOTED OTHERWISE
- 5. PAINT BLACK ALL EXPOSED STRUCTURE, MECHANICAL, DUCTS, ELECTRICAL WORK, PIPING, ETC.
- 6. REFER TO ARCHITECTURAL DRAWINGS FOR LOCATION OF MECHANICAL GRILLES, AND TO MECHANICAL DRAWINGS FOR QUANTITIES AND TYPES
- 7. REFER TO ARCHITECTURAL DRAWINGS FOR LOCATIONS OF LIGHT FIXTURES AND TO ELECTRICAL DRAWINGS FOR QUANTITY AND TYPES
- 8. MECHANICAL AND ELECTRICAL CONTRACTORS TO COORDINATE WORK
- ALL CEILING HEIGHTS ARE ELEVATION ABOVE TOP OF CONCRETE FLOOR SLAB

WITH SPRINKLER CONTRACTOR TO AVOID CONFLICTS IN FIELD

KEYED NOTES								
KEY VALUE	KEYNOTE TEXT							
900.1	NON-STRUCTURAL METAL STUD FRAMING WALL WITH (1) LAYER OF GYPSUM BOARD ON EACH SIDE. PREPARE FOR NEW FINISHES							
914.2	SCHEDULED PAINT, EXISTING CEILING / SOFFIT. REPAIR, PATCH AND PREPARE EXISTING CEILING / SOFFIT FOR NEW PAINT							

CEILING LEGEND

A- SUSPENDED 2' X 2' ACOUSTICAL LAY-IN TILE CEILING

CEILING SYMBOLS

FI FCTRICAL

ELECTRICAL	
	2'X4' FLUORESCENT FIXTURE
	2'X2' FLUORESCENT FIXTURE
	1'X4' FLUORESCENT FIXTURE
——	FLUORESCENT STRIP FIXTURE
0	RECESSED DOWN LIGHT
\Diamond	WALL WASH
<u> </u>	1'X4' FLUORESCENT FIXTURE
\otimes	EXIT SIGN, SINGLE-SIDED
\otimes	EXIT SIGN, DOUBLE-SIDED
F	FIRE ALARM
S	SPEAKER

MECHANICAL	
	SUPPLY GRILLE
	RETURN GRILLE
	EXHAUST GRILLE
	LINEAR DIFFUSER
\otimes	SPRINKLER HEAD - CEILING MOUNT
<u>\bigcup</u>	SPRINKLER HEAD - WALL MOUNT

SMOKE DETECTOR

WIRELESS INTERNET

REV DATE DESCRIPTION


524 SOUTH 600 EAST SALT LAKE CITY, UT 84102

06/08/2020


DEPARTMENT IMC EMERGENCY


INTERMOUNTAIN HEALTHCA 5125 SOUTH COTTONWOOD


LEVEL LL-1 REFLECTED CEILING PLAN + FINISH PLAN - ENLARGED A110.2

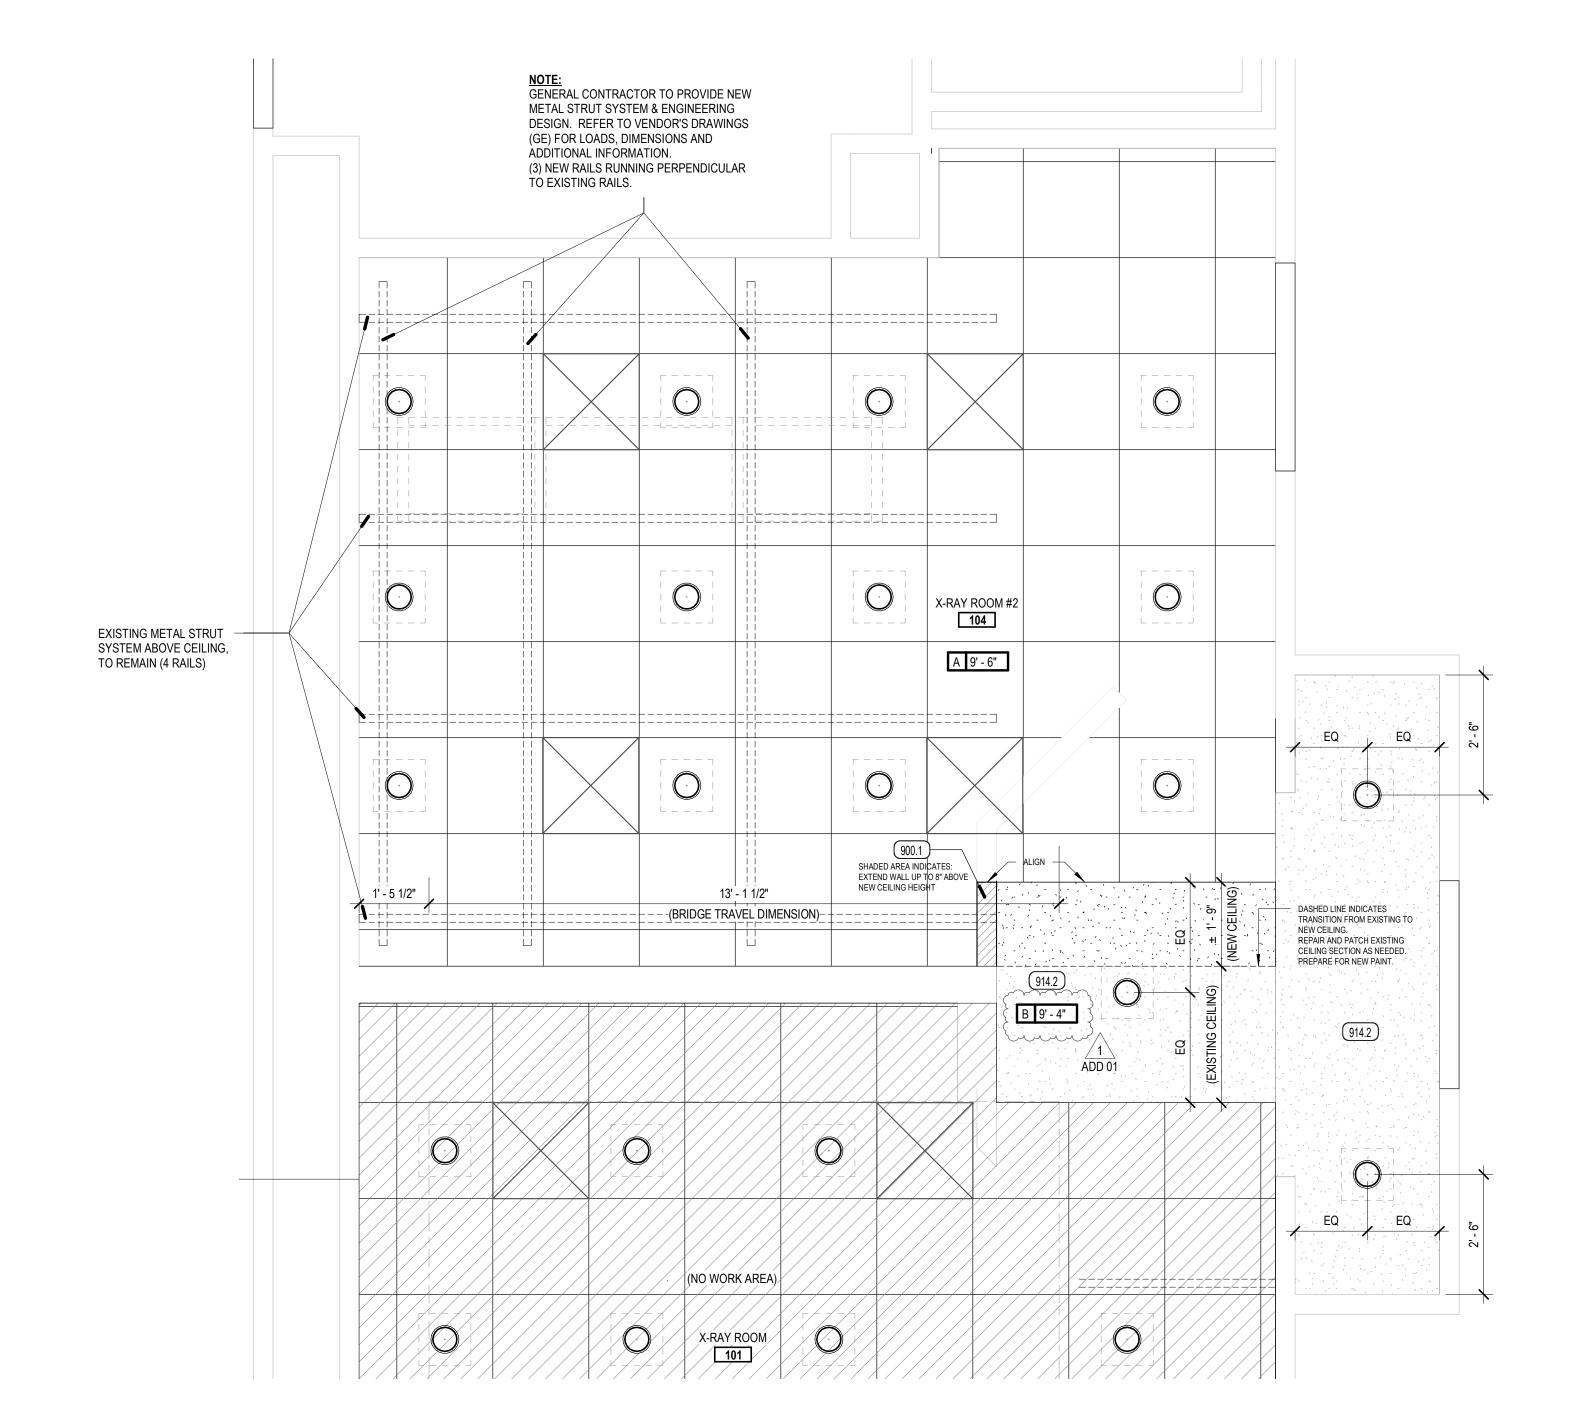



A2 REFLECTED CEILING PLAN - ENLARGED

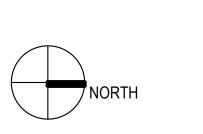

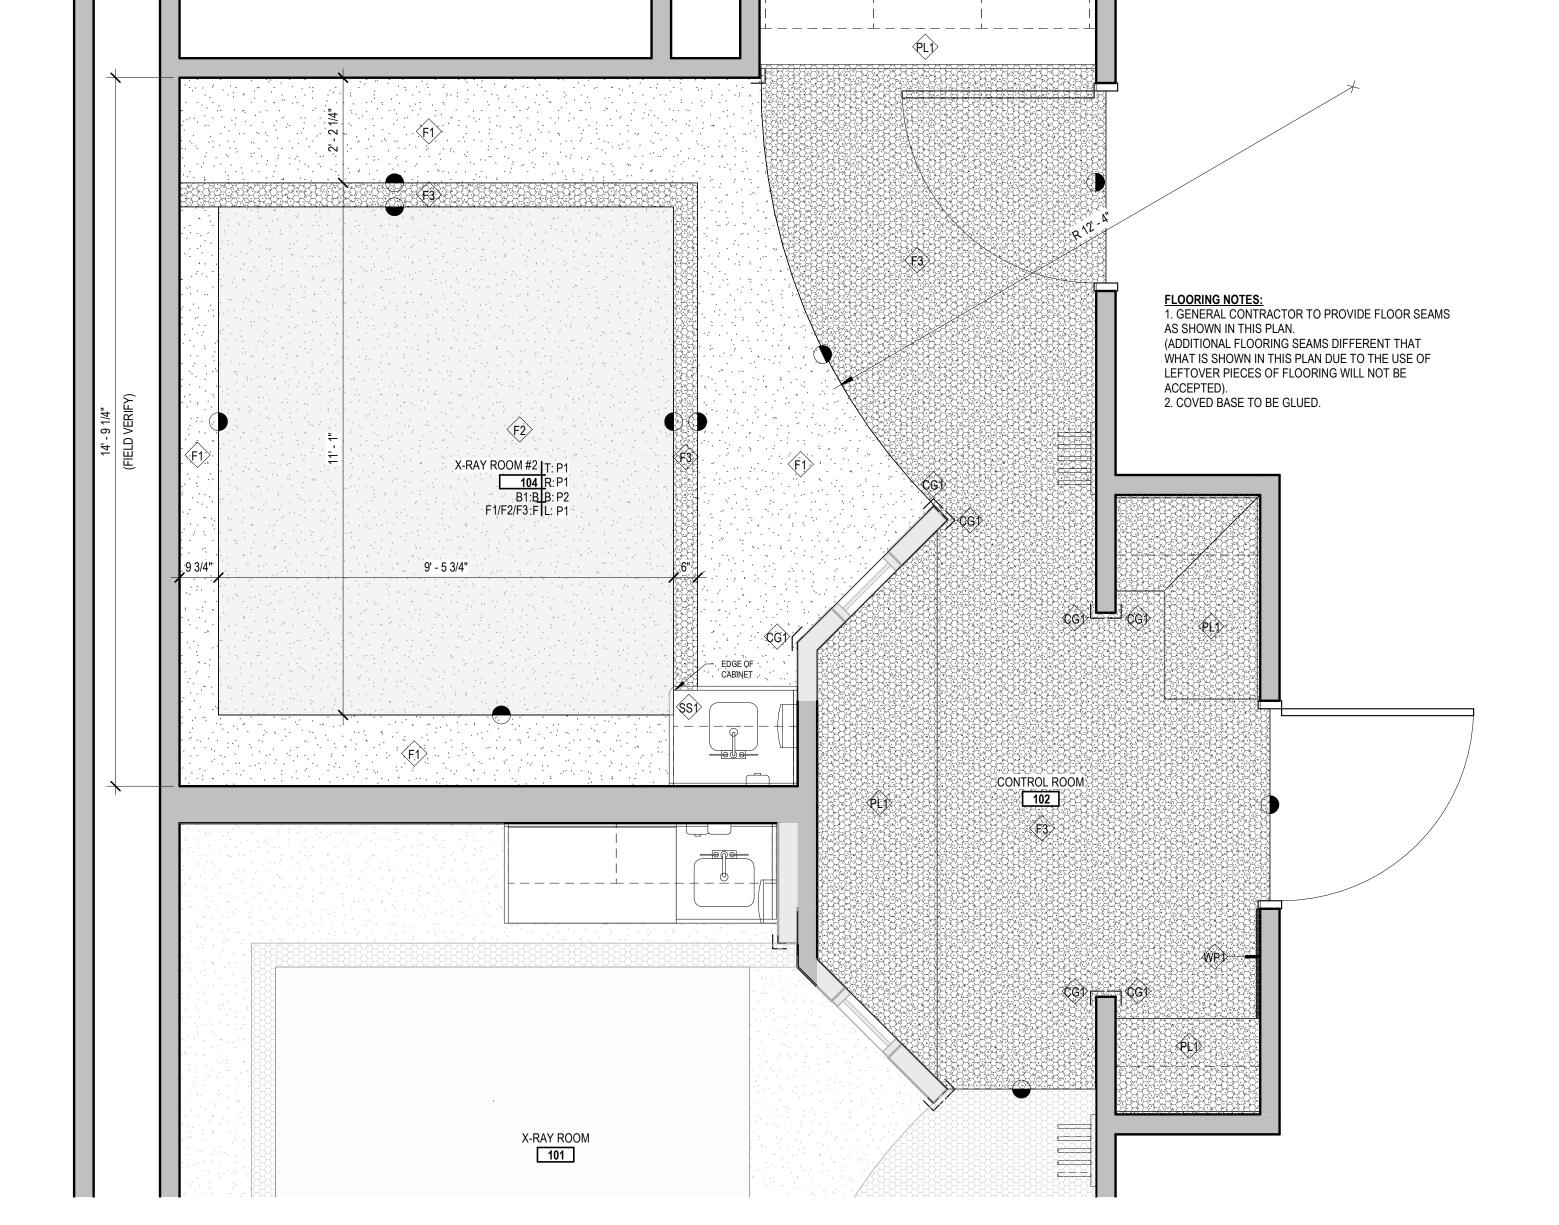


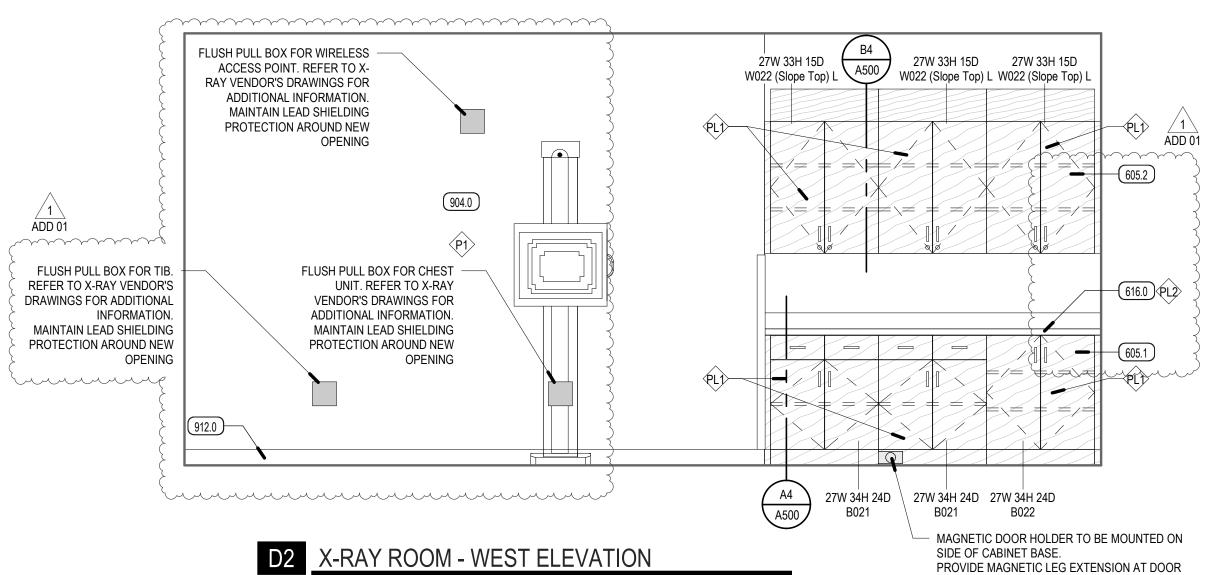

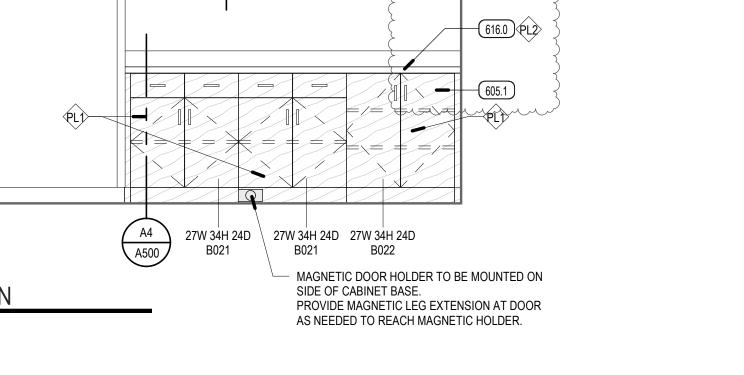


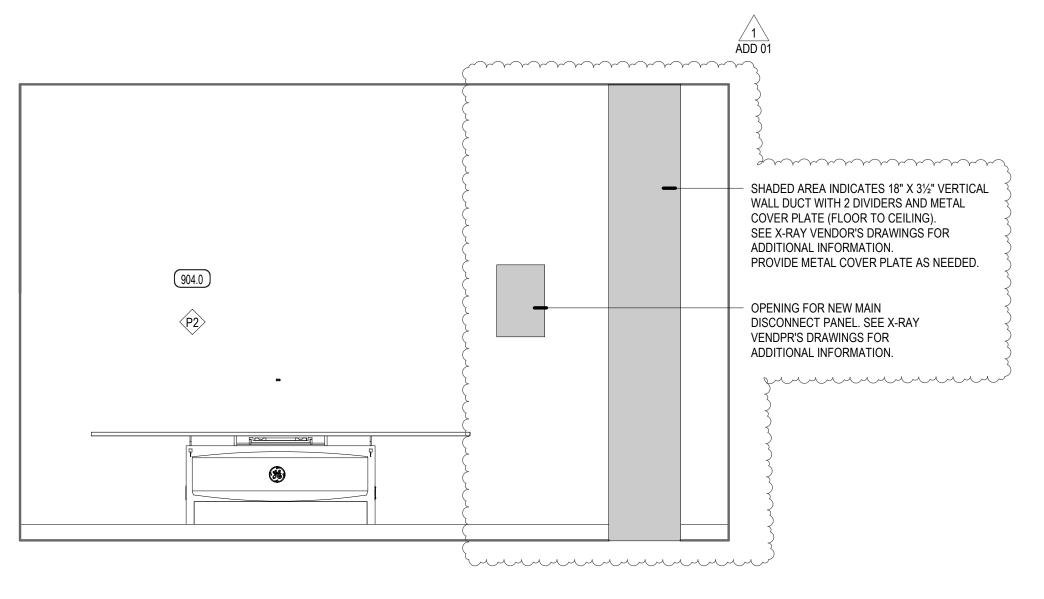



D4 X-RAY ROOM - SOUTH ELEVATION

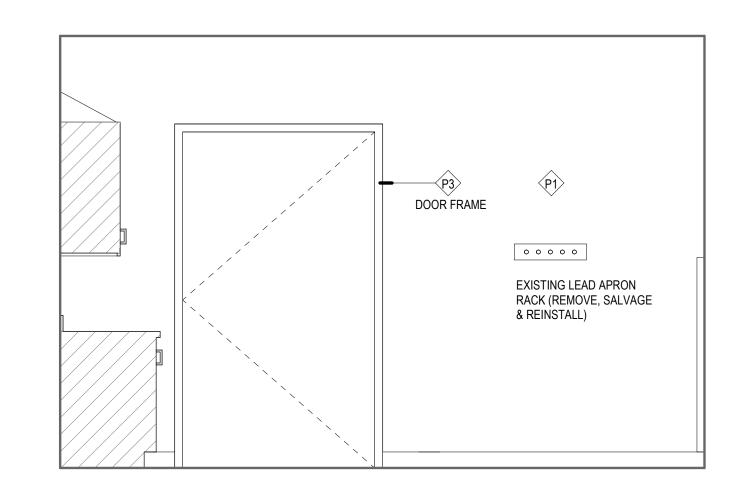

C4 X-RAY ROOM - NORTH ELEVATION

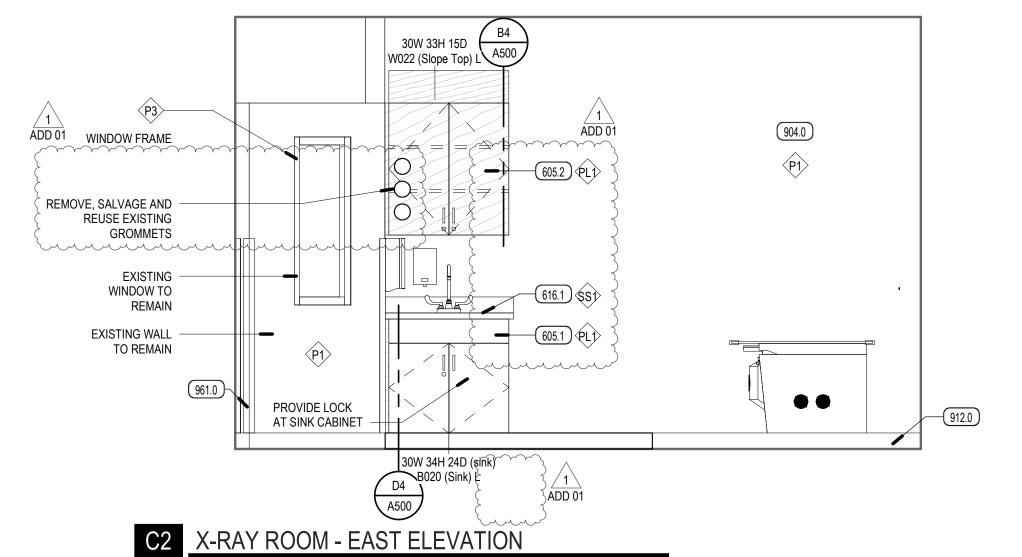

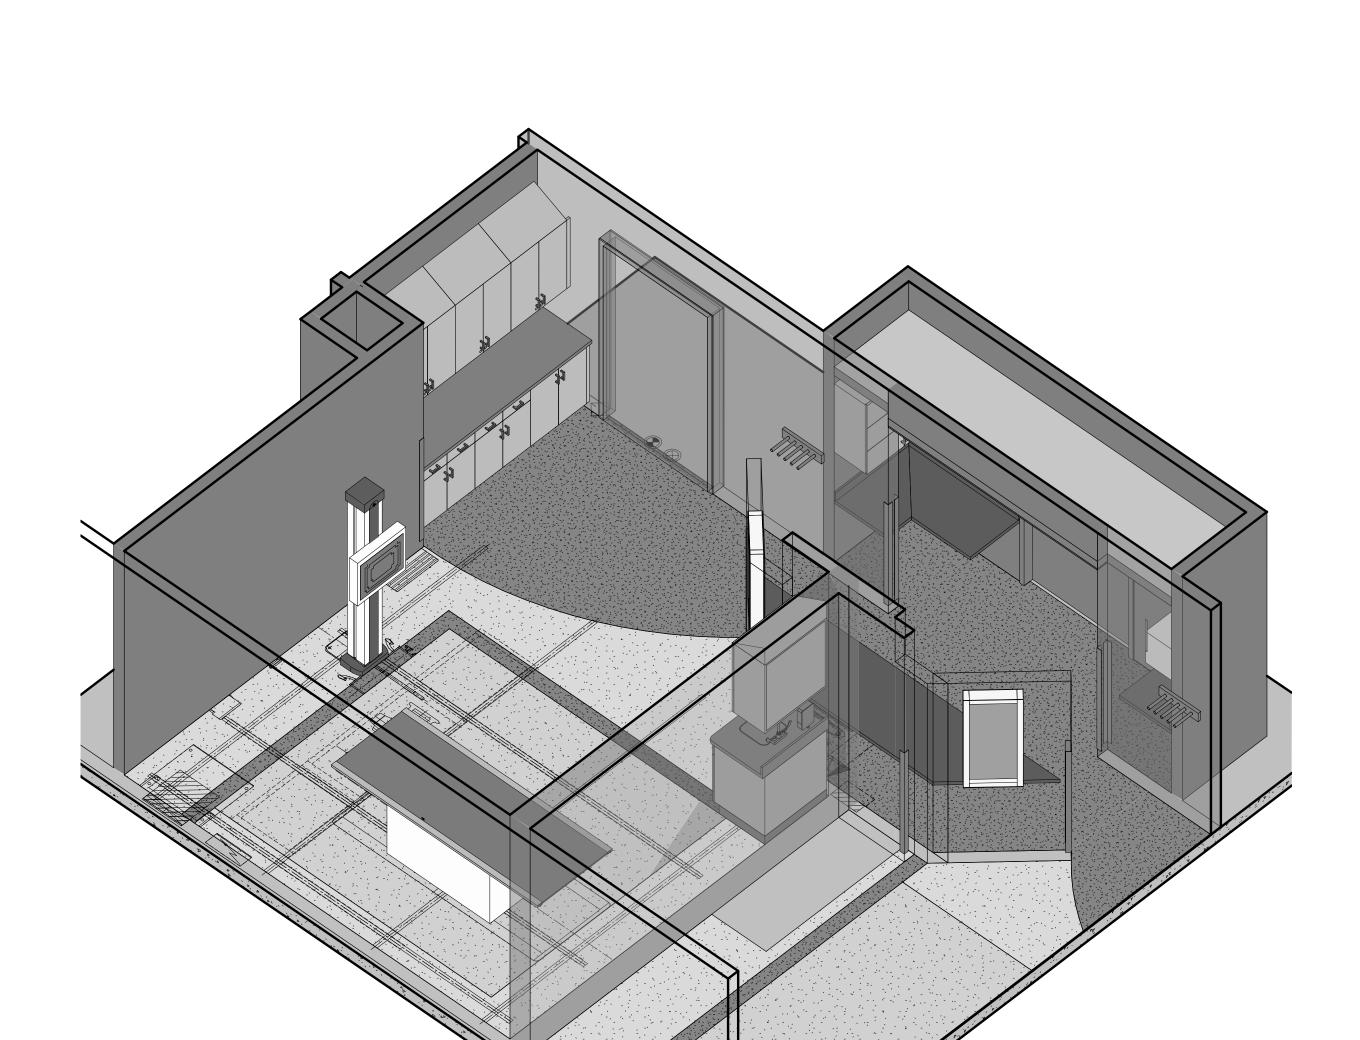

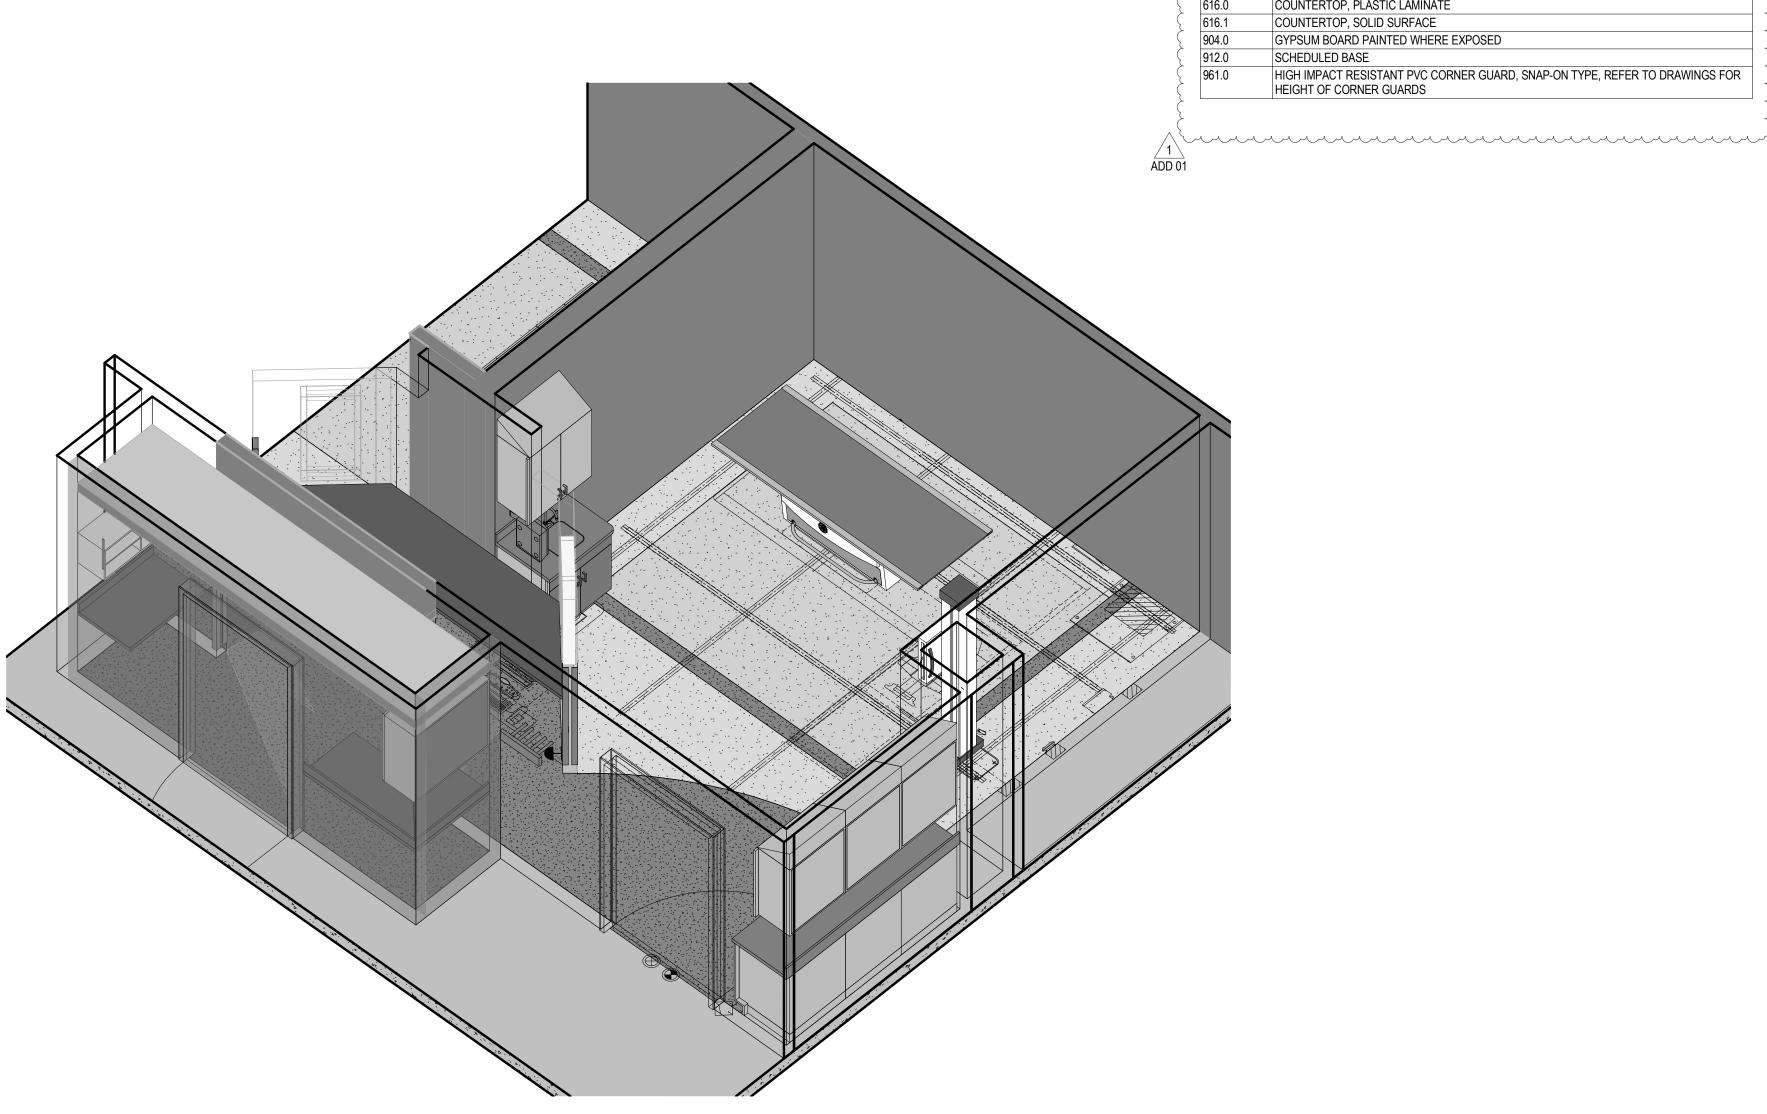

ARCHITECTURAL MILLWORK KEY - ACCESSORY (IF NOTED) - ONE ADJUSTABLE SHELF ONE DOOR ONE DRAWER

BASE CABINET *


ACCESSORY (IF NOTED)

ONE ADJUSTÀBLE SHELF

TWO DOORS

ZERO DRAWERS

WALL CABINET *

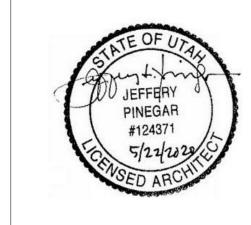

REV DATE DESCRIPTION

20370

06/08/2020

06-20-2020

524 SOUTH 600 EAST SALT LAKE CITY, UT 84102

_T 0 2 5 L__ ACCESSORY (IF NOTED) FIVE ADJUSTABLE SHELVES TWO DOORS ZERO DRAWERS TALL CABINET * SB DENOTES SINK BASE CABINET

TW DENOTES TALL WARDROBE CABINET FMD DENOTES FRAMED PERFORATED METAL PANEL DOOR

FGD DENOTES FRAMED GLASS PANEL DOOR ** NOTE: DENOTES LOCKS AT DOOR (S) / DRAWER (S)

F DENOTES FILE DRAWER (S)

CABINET MEASUREMENTS SHOWN ARE ACTUAL SIZES. BASE CABINET HEIGHTS ALLOW FOR A COUNTERTOP 1 1/2" THICK. CABINET DEPTHS ARE MEASURED FROM THE BACK TO THE FACE OF THE DOOR OR DRAWER FRONT (WHERE APPLICABLE)

MILLWORK LEGEND


- MILLWORK DIMENSION NUMBERS ARE WIDTH X HEIGHT X DEPTH.
- 2. ALL MILLWORK DIMENSIONED FROM BASE TO TOP OF IDENTIFIED COUNTERTOP, TYP
- 3. CABINET DEPTHES ARE MEASURED FROM THE WALL TO THE FACE OF THE DOOR OR DRAWER FRONT (WHERE APPLICABLE).
- 4. PROVIDE BASE AT ALL CABINET TOE SPACE, UNLESS NOTED OTHERWISE.
- 5. PROVIDE GROMMET WHERE "G" IS LABELED ON PLANS OR ELEVATIONS.
- 6. ALL COUNTERTOPS TO HAVE A 4" BACKSPLASH, UNLESS NOTED OTHERWISE, TO MATCH
- COUNTERTOP, ON BACK AND SIDE WALLS.
- 7. PROVIDE FILLER PANELS TO SEAL SIDES AND TOPS OF ALL CABINETS PLACED AT AN ANGLE TO ADJACENT WALL(S).
- 8. ALL MILLWORK TO FINISHED ON ENDS, TYP.
- 9. CONTRACTOR TO PROVIDE BLOCKING BEHIND ALL CABINETS, COAT RACKS, PENCIL SHARPENER BLOCKS, T.V. BRACKETS AND PROJECTION SCREENS AS WELL AS ALL WALL MOUNTED ACCESSORIES, INCLUDING WHITE BOARDS, TACKBOARDS, TOILET AND URINAL PARTITIONS AND TOILET ROOM ACCESSORIES, ETC.... NOTE: ONLY 2X WOOD BLOCKING IS ACCESPTABLE BEHIND MILLWORK AND TOILET ROOM PARTITIONS.
- 10. REFER TO SHEET A110.2 FOR FINISH COLORS ON ALL MILLWORK AND CASEWORK.

KEYED NOTES DATE: KEYNOTE TEXT MILLWORK, WALL MOUNTED BASE CABINET WITH BLOCKING MILLWORK, WALL MOUNTED UPPER CABINET WITH BLOCKING COUNTERTOP, PLASTIC LAMINATE DE COUNTERTOP, SOLID SURFACE


(EMERGEN

A2 X-RAY ROOM - 3D VIEW 1


A4 X-RAY ROOM - 3D VIEW 2

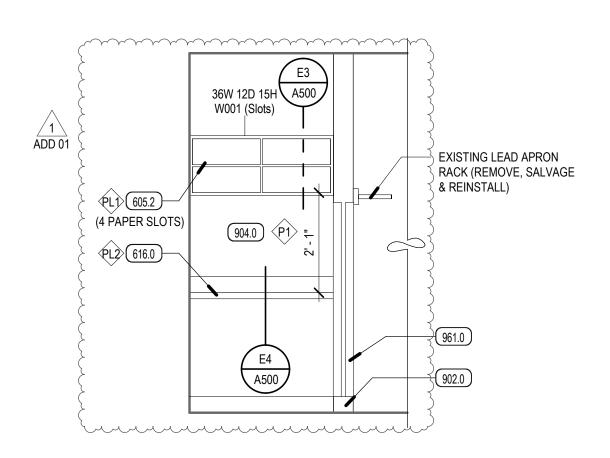


D2 CONTROL ROOM - WEST ELEVATION

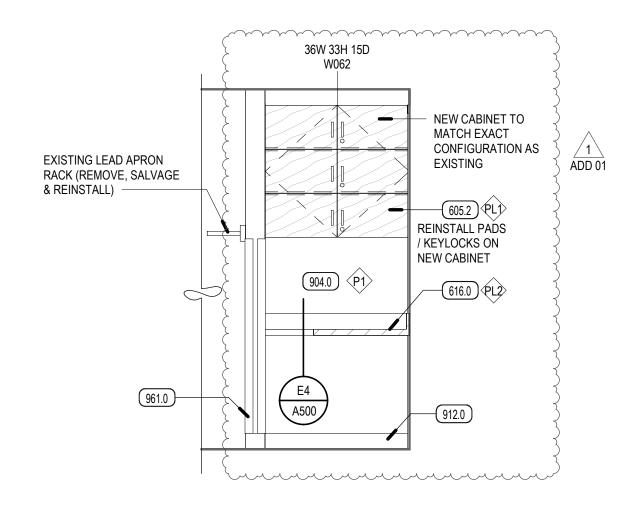

C2 CONTROL ROOM - EAST ELEVATION

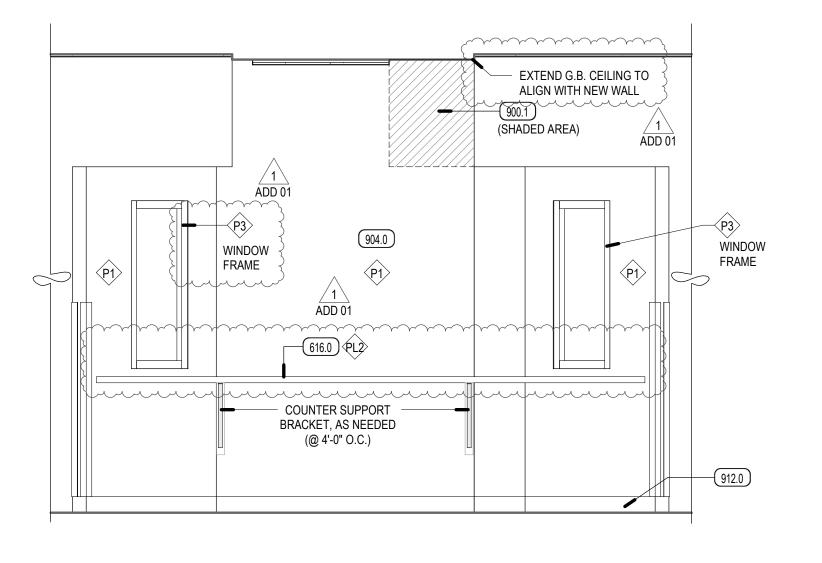



D4 CONTROL ROOM - SOUTH ELEVATION

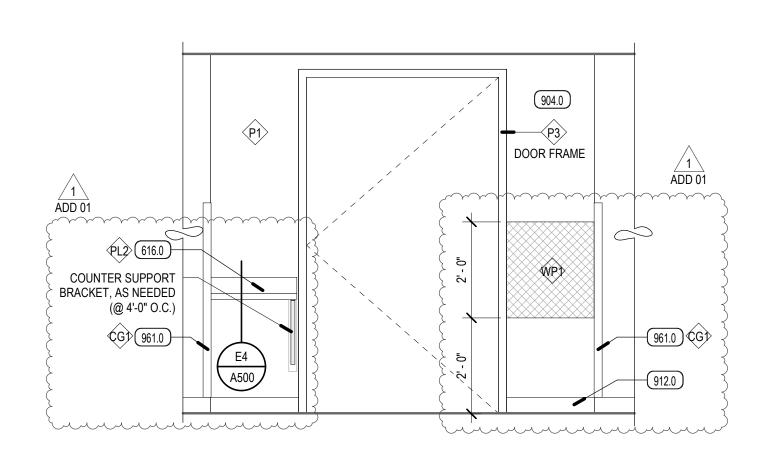

C4 CONTROL ROOM - NORTH ELEVATION

ARCHITECTURAL MILLWORK KEY

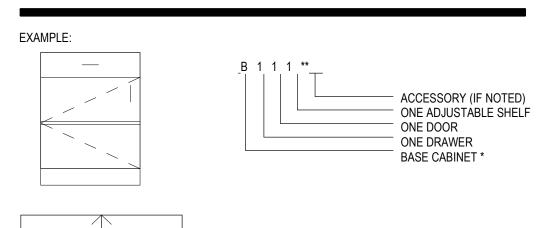

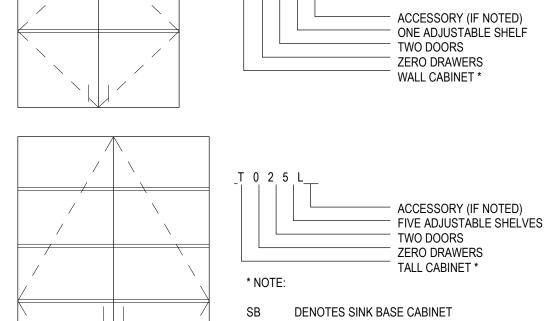

SB DENOTES SINK BASE CABINET

TW DENOTES TALL WARDROBE CABINET

FMD DENOTES FRAMED PERFORATED METAL PANEL DOOR

FGD DENOTES FRAMED GLASS PANEL DOOR

** NOTE:

L DENOTES LOCKS AT DOOR (S) / DRAWER (S)

F DENOTES FILE DRAWER (S)

CABINET MEASUREMENTS SHOWN ARE ACTUAL SIZES. BASE CABINET HEIGHTS ALLOW FOR A COUNTERTOP 1 1/2" THICK. CABINET DEPTHS ARE MEASURED FROM THE BACK TO THE FACE OF THE DOOR OR DRAWER FRONT (WHERE APPLICABLE)

MILLWORK LEGEND

- 1. MILLWORK DIMENSION NUMBERS ARE WIDTH X HEIGHT X DEPTH.
- 2. ALL MILLWORK DIMENSIONED FROM BASE TO TOP OF IDENTIFIED COUNTERTOP, TYP
- CABINET DEPTHES ARE MEASURED FROM THE WALL TO THE FACE OF THE DOOR OR DRAWER FRONT (WHERE APPLICABLE).
- 4. PROVIDE BASE AT ALL CABINET TOE SPACE, UNLESS NOTED OTHERWISE.
- PROVIDE GROMMET WHERE "G" IS LABELED ON PLANS OR ELEVATIONS.
- 6. ALL COUNTERTOPS TO HAVE A 4" BACKSPLASH, UNLESS NOTED OTHERWISE, TO MATCH
- PROVIDE FILLER PANELS TO SEAL SIDES AND TOPS OF ALL CABINETS PLACED AT AN ANGLE TO ADJACENT WALL(S).
- 8. ALL MILLWORK TO FINISHED ON ENDS, TYP.

COUNTERTOP, ON BACK AND SIDE WALLS.

- 9. CONTRACTOR TO PROVIDE BLOCKING BEHIND ALL CABINETS, COAT RACKS, PENCIL SHARPENER BLOCKS, T.V. BRACKETS AND PROJECTION SCREENS AS WELL AS ALL WALL MOUNTED ACCESSORIES, INCLUDING WHITE BOARDS, TACKBOARDS, TOILET AND URINAL PARTITIONS AND TOILET ROOM ACCESSORIES, ETC.... NOTE: ONLY 2X WOOD BLOCKING IS ACCESPTABLE BEHIND MILLWORK AND TOILET ROOM PARTITIONS.
- 10. REFER TO SHEET A110.2 FOR FINISH COLORS ON ALL MILLWORK AND CASEWORK.


/1 ADD 01

KEYED NOTES										
KEY VALUE KEYNOTE TEXT										
605.2	MILLWORK, WALL MOUNTED UPPER CABINET WITH BLOCKING									
616.0	COUNTERTOP, PLASTIC LAMINATE									
900.1	NON-STRUCTURAL METAL STUD FRAMING WALL WITH (1) LAYER OF GYPSUM BOARD ON EACH SIDE. PREPARE FOR NEW FINISHES									
902.0	1-5/8" METAL STUD FRAMING									
904.0	GYPSUM BOARD PAINTED WHERE EXPOSED									
912.0	SCHEDULED BASE									
961.0	HIGH IMPACT RESISTANT PVC CORNER GUARD, SNAP-ON TYPE, REFER TO DRAWINGS FOR HEIGHT OF CORNER GUARDS									

ARCHITECTURE

524 SOUTH 600 EAST
SALT LAKE CITY, UT 84102

801.575.880
VCBO.COI

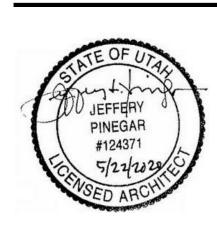

 REV
 DATE
 DESCRIPTION

 1
 06-20-2020
 ADD 01

 VCBO NUMBER:
 20370

 DATE:
 06/08/2020

ADE

ARTMENT - X-RAY #2 - UPGRADE

IMC EMERGENCY DEPARTMENT - X-

NTERMOUNTAIN HEALTHCARE

X-RAY ROOM - INTERIOR ELEVATIONS + 3D VIEWS

PARTITION + FRAMING GENERAL NOTES

FRAMED WALL PARTITIONS

PARTITION TYPE INDICATIONS ARE INDEPENDENT OF APPLIED FINISHES. SEE FINISH SHEETS AND INTERIOR ELEVATIONS FOR WALL FINISHES INCLUDING TILE COURSING AND LAYOUT AND/OR THE DESIGNATIONS ON THE PLANS FOR ADDITIONAL INFORMATION REGARDING APPLIED FINISHES.

WHERE PARTITION TYPE DESIGNATION ON FLOOR PLANS IS INTERRUPTED BY DOOR OPENING GLAZED PARTITION, ETC., CONSTRUCTION ABOVE INTERRUPTION (AND WHERE APPLICABLE BELOW) IS TO BE THE SAME AS THAT DESIGNATED FOR THE PARTITION IN WHICH THE INTERRUPTION

THE MINIMUM REQUIREMENTS FOR CONSTRUCTION OF EACH PARTITION TYPE AS EXPRESSED BY THE INDICATED REFERENCE ARE INCORPORATED BY REFERENCE AND ARE APPLICABLE TO THE WORK OF THIS PROJECT. HOWEVER, ADDITIONAL AND/OR MORE RESTRICTIVE REQUIREMENTS MAY

BE INDICATED BY THE SPECIFICATIONS AND DRAWINGS. SUCH REQUIREMENTS ALSO APPLY AND SHALL GOVERN. SUCH REQUIREMENTS INCLUDE BUT ARE NOT LIMITED TO:

USE 16" OC MAX STUD SPACING UNLESS NOTED OTHERWISE IN THESE DOCUMENTS. THE SPACING STATED BY THE REFERENCED APPROVAL OR EST REPORT IS THE MAX SPACING IF ALLOWED IN THESE DOCUMENTS. USE STUDS OF GAUGE INDICATED ON THE DRAWINGS OR IN THE SPECIFICATIONS. THE GAUGE STATED BY THE REFERENCED APPROVAL OR TEST REPORT IS THE MINIMUM GAUGE TESTED, 20

GA (30 MILS) IS THE MINIMUM ALLOWED IN THESE DOCUMENTS.

USE STUDS OF DEPTH INDICATED BY THIS SET OF DOCUMENTS. THE DEPTH STATED BY THE REFERENCED APPROVAL OR TEST REPORT IS THE MINIMUM DEPTH TESTED DEPTH ALLOWED IN THESE DOCUMENTS. SEE STRUCTURAL DOCUMENTS FOR ADDITIONAL INFORMATION PERTAINING TO THE CONSTRUCTION OF CONCRETE, MASONRY AND STUD WALLS

PROVIDE FIRE RATED CONSTRUCTION ASSEMBLIES WHERE INDICATED ON SHEETS G100's AND

ALL DIMENSIONS ARE CENTER OF STUD OR FACE OF CONCRETE, MASONRY OR ROUGH OPENING UNLESS NOTED OTHERWISE. FACE OF FINISHED WALL WILL BE NOTED AS FOW.

AT ALL INTERIOR WALLS, STUDS, INSULATION AND GYPSUM BOARD ARE TO EXTEND TO THE DECK ABOVE. UNLESS NOTED OTHERWISE.

 WALL TYPES NOT NOTED ARE ASSUMED TO MATCH ADJACENT ROOMS. SEE SHEETS FOR FINISHES, NOTIFY ARCHITECT OF ANY DISCREPANCIES.

ALL METAL STUD PARTITIONS ARE CONSIDERED ACOUSTIC PARTITIONS AND ARE TO RECEIVE A TYPE 1 SOUND ATTENUATION BLANKET. THICKNESS TO MATCH STUD DEPTH. UNLESS NOTED

10. REFER TO SHEET <u>AXXX</u> FOR TYPICAL INTERIOR WALL CONDITIONS ASSOCIATED WITH ALL METAL STUD PARTITIONS.

. PROVIDE CONTROL JOINTS IN METAL FRAMED WALLS AT APPROXIMATELY 30 FEET ON CENTER. LOCATE AT CORNER ABOVE DOORS OR INSIDE CORNER OF PILASTERS OR OTHER INCONSPICUOUS LOCATION WHERE POSSIBLE. CONSULT WITH ARCHITECT PRIOR TO COMMENCING FRAMING. INSTALL PER DETAILS XX, XX AND XX/ AXXX FOR CONTROL JOINTS.

2. AT WALL OPENINGS FOR PENETRATION OF PIPES, DUCTS, DEVICES, ETC., GYPSUM BOARD IS TO BE CUT TO MATCH THE SHAPE AND DIMENSION OF THE PENETRATING OBJECT AND THE GAP BETWEEN THE OBJECT AND THE WALL IS TO BE SEALED W/ ACOUSTICAL OR FIRE SEALANT ON ALL SIDES WITH A 3/4" JOINT AT ALL SIDES, MAXIMUM. THE OPENING FOR DUCTS OR LARGE PENETRATIONS SHALL BE FRAMED WITH A HEADER, ADD AN ANGLED CORNER BRACE IF THE GAP EXCEEDS 3" FROM FRAMING

B. PROVIDE BLOCKING / BACKING FOR ALL WALL MOUNTED EQUIPMENT. SEE FLOOR PLANS AND INTERIOR ELEVATIONS FOR CABINETS, GRAB BARS ETC. INSTALL BLOCKING AS DETAILED OR AS REQUIRED TO MOUNT SUCH DEVICES. ALL BLOCKING IS TO BE FIRE RETARDANT TREATED. INSTALL

I. WHERE THERE IS LIMITED WATER EXPOSURE: INSTALL ONE LAYER OF 5/8" TYPE X WATER RESISTANT GYPSUM BOARD PER ASTM C1396 (WHERE GYPSUM BOARD OCCURS) OF BASIC PARTITION AT THE FOLLOWING LOCATIONS:

a. WITHIN 2 FEET HORIZONTALLY AND 4 FEET VERTICALLY OF JANITORS SINKS b. AT OTHER LOCATIONS, I.E. TOILET ROOMS AND KITCHENS, AND AS INDICATED ON THE ARCHITECTURAL FINISH PLANS AND ELEVATIONS.

15. INSTALL ONE LAYER OF 5/8" GLASS MAT TILE BACKER BOARD IN LIEU OF GYPSUM BOARD (WHERE GYPSUM BOARD OCCURS) OF BASIC PARTITION WHERE THERE IS NO FIRE RATING AND OVER GYPSUM BOARD FACE LAYER AT FIRE RATED PARTITIONS AT THE FOLLOWING LOCATIONS.

16. AT WET LOCATIONS, SUCH AS SHOWER STALLS AND TUB SURROUNDS.

a. WHERE CERAMIC TILE FINISHES ARE INDICATED PER THE FINISH PLANS AND/OR INTERIOR ELEVATIONS.

b. AT OTHER LOCATIONS AS INDICATED BY THE ARCHITECTURAL FINISH PLANS AND ELEVATIONS WHERE NEW WALLS OR FURRING ARE INDICATED TO BE DIMENSIONED OFF OF AN EXISTING WALL, THE NEW WALL SHALL BE STRAIGHT AND PLUMB REGARDLESS OF THE CONDITION OF THE EXISTING

18. ALL EXTERIOR STUD WALLS TO HAVE CONTINUOUS INSULATION, VAPOR BARRIER AND AIR INFILTRATION BARRIER FOR THE FULL HEIGHT AND LENGTH OF THE WALL, SEAL ALL PENETRATIONS.

SEE DETAILS ON SHEET AXXX FOR TYPICAL TOP OF WALL CONDITION 19. THE AIR INFILTRATION BARRIER IS TO WRAP INTO ALL WINDOW AND DOOR OPENINGS.

20. SEE DETAIL XX AND XX ON SHEET AXXX FOR TYPICAL FIRE EXTINGUISHER CABINET INSTALLATION

MASONRY OR CONCRETE WALLS

SEE STRUCTURAL PLANS FOR ADDITIONAL CONCRETE AND MASONRY WALL INFORMATION.

2. SEE EXTERIOR ELEVATIONS FOR COURSING, MASONRY TYPES AND METAL PANEL ORIENTATION PER XX ELEVATION SHEETS.

3. ALL MASONRY WALLS ARE TO BE REINFORCED AND ARE TO BE SET ON REINFORCED FOOTINGS. SEE THE XX ELEVATION SHEETS FOR LOCATION OF CONTROL JOINTS. WHERE NOT NOTED, CONTROL JOINTS TO BE LOCATED AS PER THE REQUIREMENTS FOUND IN THE STRUCTURAL DOCUMENTS BUT ARE NOT TO EXCEED 30' OC. SEE THE STRUCTURAL DRAWINGS FOR REINFORCING AND OTHER DETAILS PERTAINING TO MASONRY WALLS. IF NOT OTHERWISE NOTED, LOCATE CONTROL JOINTS AT CORNER ABOVE DOORS, INSIDE CORNER OF PILASTERS OR OTHER INCONSPICUOUS LOCATION WHERE POSSIBLE. CONSULT WITH ARCHITECT PRIOR TO INSTALLING PER DETAIL XX/ AXXX.

4. SEE IBC 2009, CHAPTER 7 FOR FIRE RESISTIVE REQUIREMENTS ON NEW CONCRETE AND CONCRETI MASONRY UNIT WALLS.

 CMU WALLS (IBC TABLE 720.1(2), ITEM 3) CAST IN PLACE CONCRETE WALLS (IBC TABLE 721.2.1.2(1))

5. REFER TO DETAIL SHEET AXXX FOR TYPICAL WALL CONDITIONS ASSOCIATED WITH ALL AND MASONRY PARTITIONS.

6. AT WALL OPENINGS FOR PENETRATION OF PIPES, DUCTS, DEVICES, ETC., MASONRY IS TO BE CUT TO MATCH THE SHAPE AND DIMENSION OF THE PENETRATING OBJECT AND THE GAP BETWEEN THE OBJECT AND THE WALL IS TO BE SEALED W/ ACOUSTICAL OR FIRE SEALANT ON ALL SIDES WITH A 3/4" JOINT AT ALL SIDES, MAXIMUM.

PROTECTION OF MASONRY: DURING CONSTRUCTION, COVER TOPS OF WALLS, PROJECTIONS, AND SILLS WITH WATERPROOF SHEETING AT END OF EACH DAY'S WORK, EXCEPT WHEN THE AMBIENT TEMPERATURE IS EXPECTED TO REMAIN ABOVE 65 DEG F AND NO PRECIPITATION IS FORECAST FOR THE NEXT 24 HOURS. (THIS IS TO PREVENT CONDENSATION FROM COVERED WALLS CAUSING A MOISTURE PROBLEM.) COVER PARTIALLY COMPLETED MASONRY EACH DAY THAT CONSTRUCTION IS NOT IN PROGRESS. WALLS ARE TO BE PROTECTED UNTIL THEY ARE PERMANENTLY PROTECTED BY THE ROOFING MEMBRANE OVER THE CAP PLATE. THE GENERAL CONTRACTOR IS TO PROVIDE TEMPORARY PROTECTION IMMEDIATELY FOLLOWING THE TOPPING OUT OF EACH SECTION OF WALL BY INSTALLING WATERPROOF SHEETING OVER A CONTINUOUS CAP PLATE UNTIL THE ROOFING MEMBRANE IS INSTALLED. A SOLID GROUTED TOP BOND BEAM SHALL NOT BE CONSIDERED ADEQUATE PROTECTION FOR THE WALL.

8. IT IS ACCEPTABLE TO PLACE NON-INTEGRAL COLORED CMU IN PORTIONS OF WALLS INDICATED TO BE CONSTRUCTED OF INTEGRAL COLOR CMU IF THE DOCUMENTS SHOW THESE PORTIONS OF WALL PAINTED OR COVERED WITH TILE, STUD FURRING, ABOVE CEILINGS OR UNDER ROOFING MEMBRANE. IT IS NOT ACCEPTABLE TO UTILIZE NON INTEGRAL COLORED CMU BEHIND CABINETS, FURNISHINGS AND EQUIPMENT INCLUDING BUT NOT LIMITED TO CLIMBING WALLS AND LOCKERS.

9. AT ALL SPLIT FACE AND PAINTED CMU THE HORIZONTAL AND VERTICAL MORTAR JOINTS ARE TO BE CONCAVE. AT ALL HONED BLOCK THE HORIZONTAL MORTAR JOINT IS TO BE A WEATHERED JOINT AND ALL VERTICAL JOINTS ARE TO BE RAKED.

10. PROVIDE A 3/4" CHAMFER ALL INTERIOR EXPOSED VERTICAL MASONRY CORNERS FROM 8" AFF TO BOTTOM OF MASONRY LINTEL OR IF NO LINTEL EXISTS, STOP CHAMFER @ FIRST MASONRY JOINT BELOW CEILING. NOTE THAT THIS CHAMFER IS NOT TO BE PROVIDED AT CORNERS SHOWN IN THESE DOCUMENTS AS COVERED WITH WALL TILE. SEE DETAIL

11. **PROVIDE SPECIAL SHAPES**, SUCH AS "U" SHAPED CHANNEL FOR LINTELS OR HEADERS AND CAPPING UNITS FOR SASH AND OTHER SPECIAL CONDITIONS.

12. WHERE SPLIT FACE BLOCK IS SHOWN EXTENDING TO THE TOP OF A PARAPET, PROVIDE AN INTEGRAL COLOR SMOOTH FACE BLOCK AT THE TOP COURSE TO ALLOW THE CAP FLASHING TO FIT TIGHT AGAINST THE WALL.

13. CONTRACTOR TO COORDINATE AND PROVIDE SMOOTH MASONRY AT ALL FLASHING, REGLETS, GUTTERS, EDGES OF CEILING AND BASE AND OTHER ITEMS REQUIRING A SMOOTH FINISH THAT ARE HIDDEN. AT VISIBLE LOCATIONS SUCH AS DOOR AND WINDOW FRAMES, PERPENDICULAR WALLS, GRIND SPLIT FACED BLOCK PER DETAIL XX/ AXXX.

SALT LAKE CITY, UT 84102



06/08/2020

TAIN COT

Ш

9

ME

NTERIOR FRAMING. **CEILING DETAILS & CASEWORK DETAILS**

ENSTRUCT BEACHAGE

ENSTRUCT

ENSTRUC

(E)W24x76

A5 LEVEL 01 FLOOR FRAMING PLAN
S-101 SCALE: 1/4" = 1'-0"

(E-VELEO FLOOR SLAS (EXBITING)


S-101 SCALE: 1/4" = 1'-0"

IMC EMERGENC
INTERMOUNTAIN HEALTHCARE
5125 SOUTH COTTONWOOD STR
PERMIT SET / BID SET

524 SOUTH 600 EAST 801.575.8800 SALT LAKE CITY, UT 84102 VCBO.COM


S-10²


524 SOUTH 600 EAST 801.575.8800 SALT LAKE CITY, UT 84102 VCBO.COM

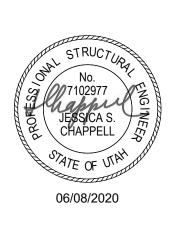

REVDATEDESCRIPTION16/17/20Addendum 01

DETAILS REMOVED

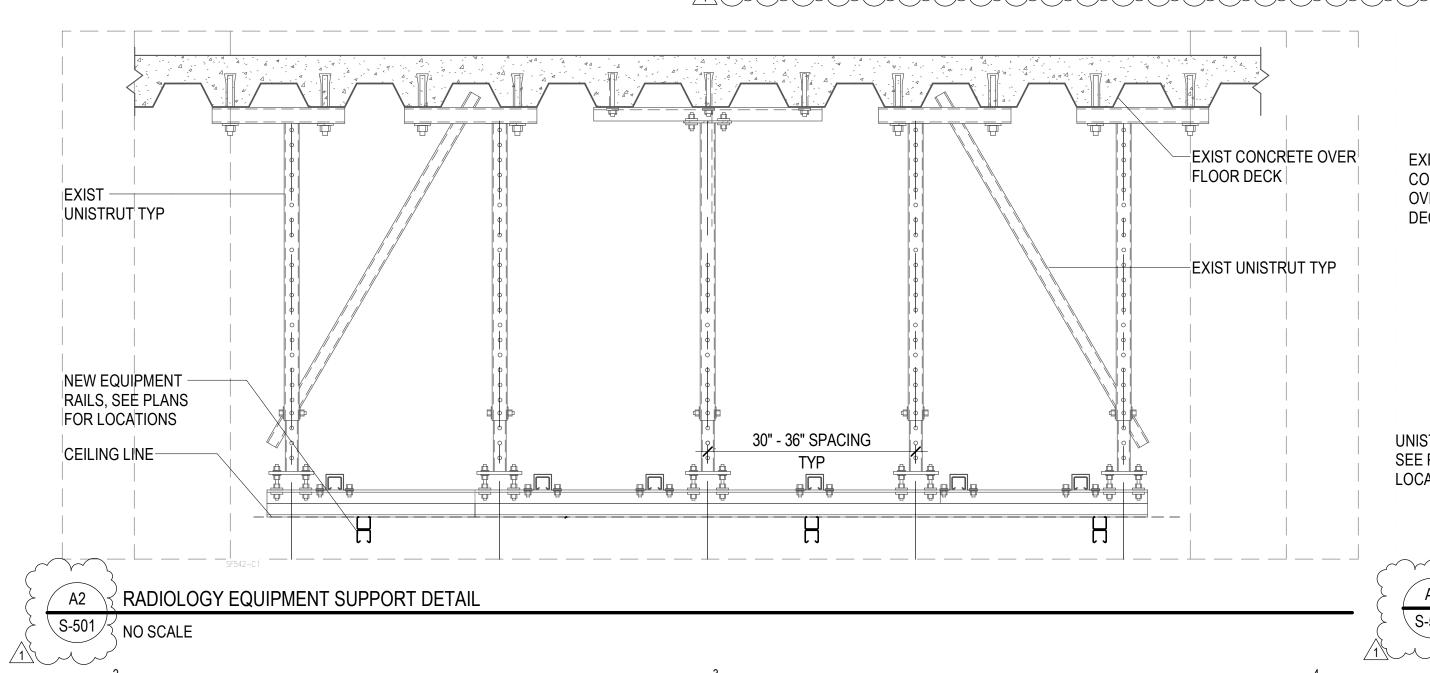

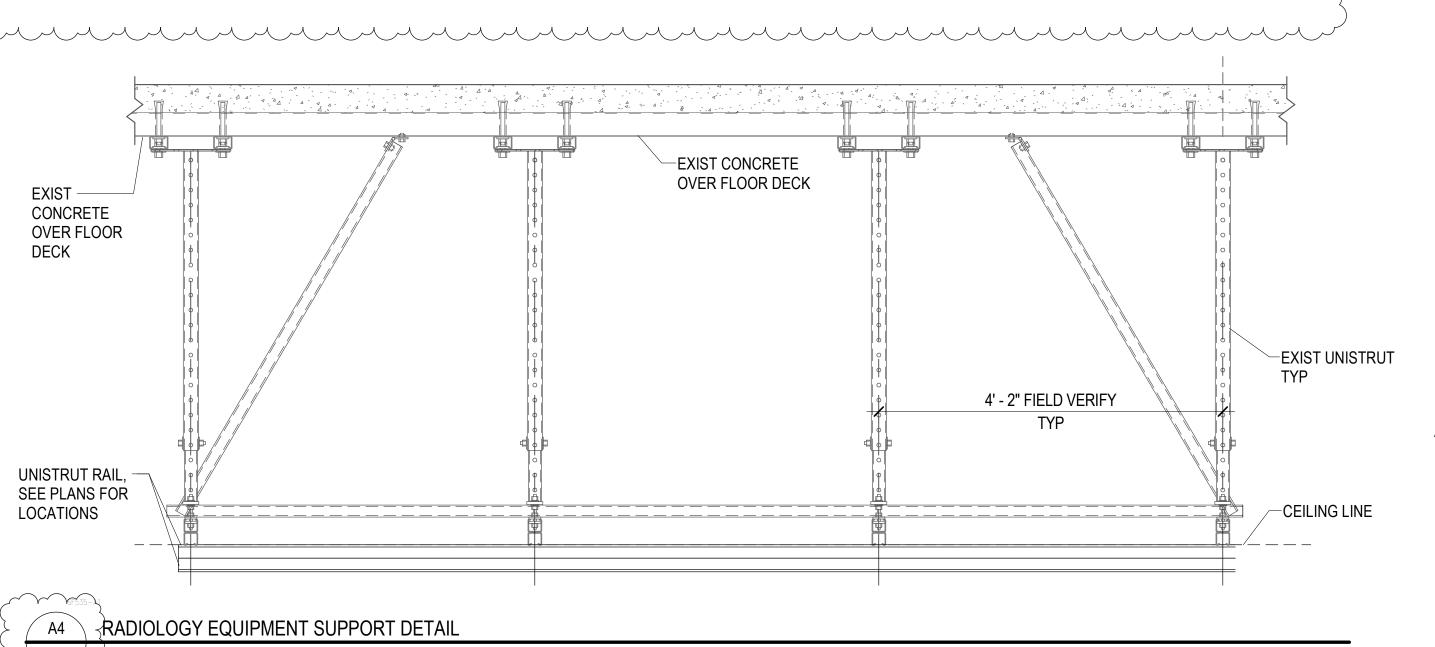

MC

EMERGEN



Salt Lake City | Phoenix | St. Louis | Baltimore [p] 800-678-7077 www.spectrum-engineers.com

Electrical Addendum #1

Date: June 16, 2020

To: Carlos Liñan From: Jason Worthen

Company: VCBO Architects **Email:** jrw@spectrum-engineers.com

Job: IMC Emergency Department X-Ray #2 Phone: 801-401-8442

Job No: 200310 Re: Electrical Addendum

Cc:

This Addendum shall be considered part of the Contract Documents and Project Manual for the above mentioned project as though it had been issued at the same time and shall be incorporated integrally therewith. Where provisions of the following supplementary data differ from those of the original Contract Documents and Project Manual, the Addendum shall govern and take precedence.

Electrical Addendum

Questions

1. The power demo plan shows the location of the existing x ray 100 amp power feed to a main breaker box that is to be removed.

This is correct.

2. The new power plan shows the location of the new X ray 80 amp power feed box.

This is correct.

3.Can the existing power feed be spliced in a junction box and extended to the new location or is this not an option?

A new power run would is preferred.

4.If the power feed needs a complete new wire run, where does it originate from so we can get a distance?

Power is fed from the floor above. Refer to the attached sheet EP100.

5. The lighting plan shows DX2 recess fixtures in the x ray room. The entry to the x ray room shows (2) recess can symbols that are not marked. Are these existing or are they new?

These are two new DX-2 fixtures. There is one existing to remain fixture above the control desk for the other X-Ray room as well.


Salt Lake City | Phoenix | St. Louis | Baltimore [p] 800-678-7077 www.spectrum-engineers.com

Drawings


- 1. <u>EP100</u> L-1 Power Plan
 - a. Added sheet to show location of existing distribution panels feeding X-Ray equipment.
- 2. <u>EP101</u> Electrical Plans
 - a. Added fixture tags to two can lights.
 - b. Changed X-Ray in use sign to new.
- 3. EL601 Lighting Schedules
 - a. Removed other fixture options so we will match the existing X-Ray room.
 - b. Added the X-Ray in use sign.

END OF ADDENDUM

Attachments: EP100, EP101, EL601

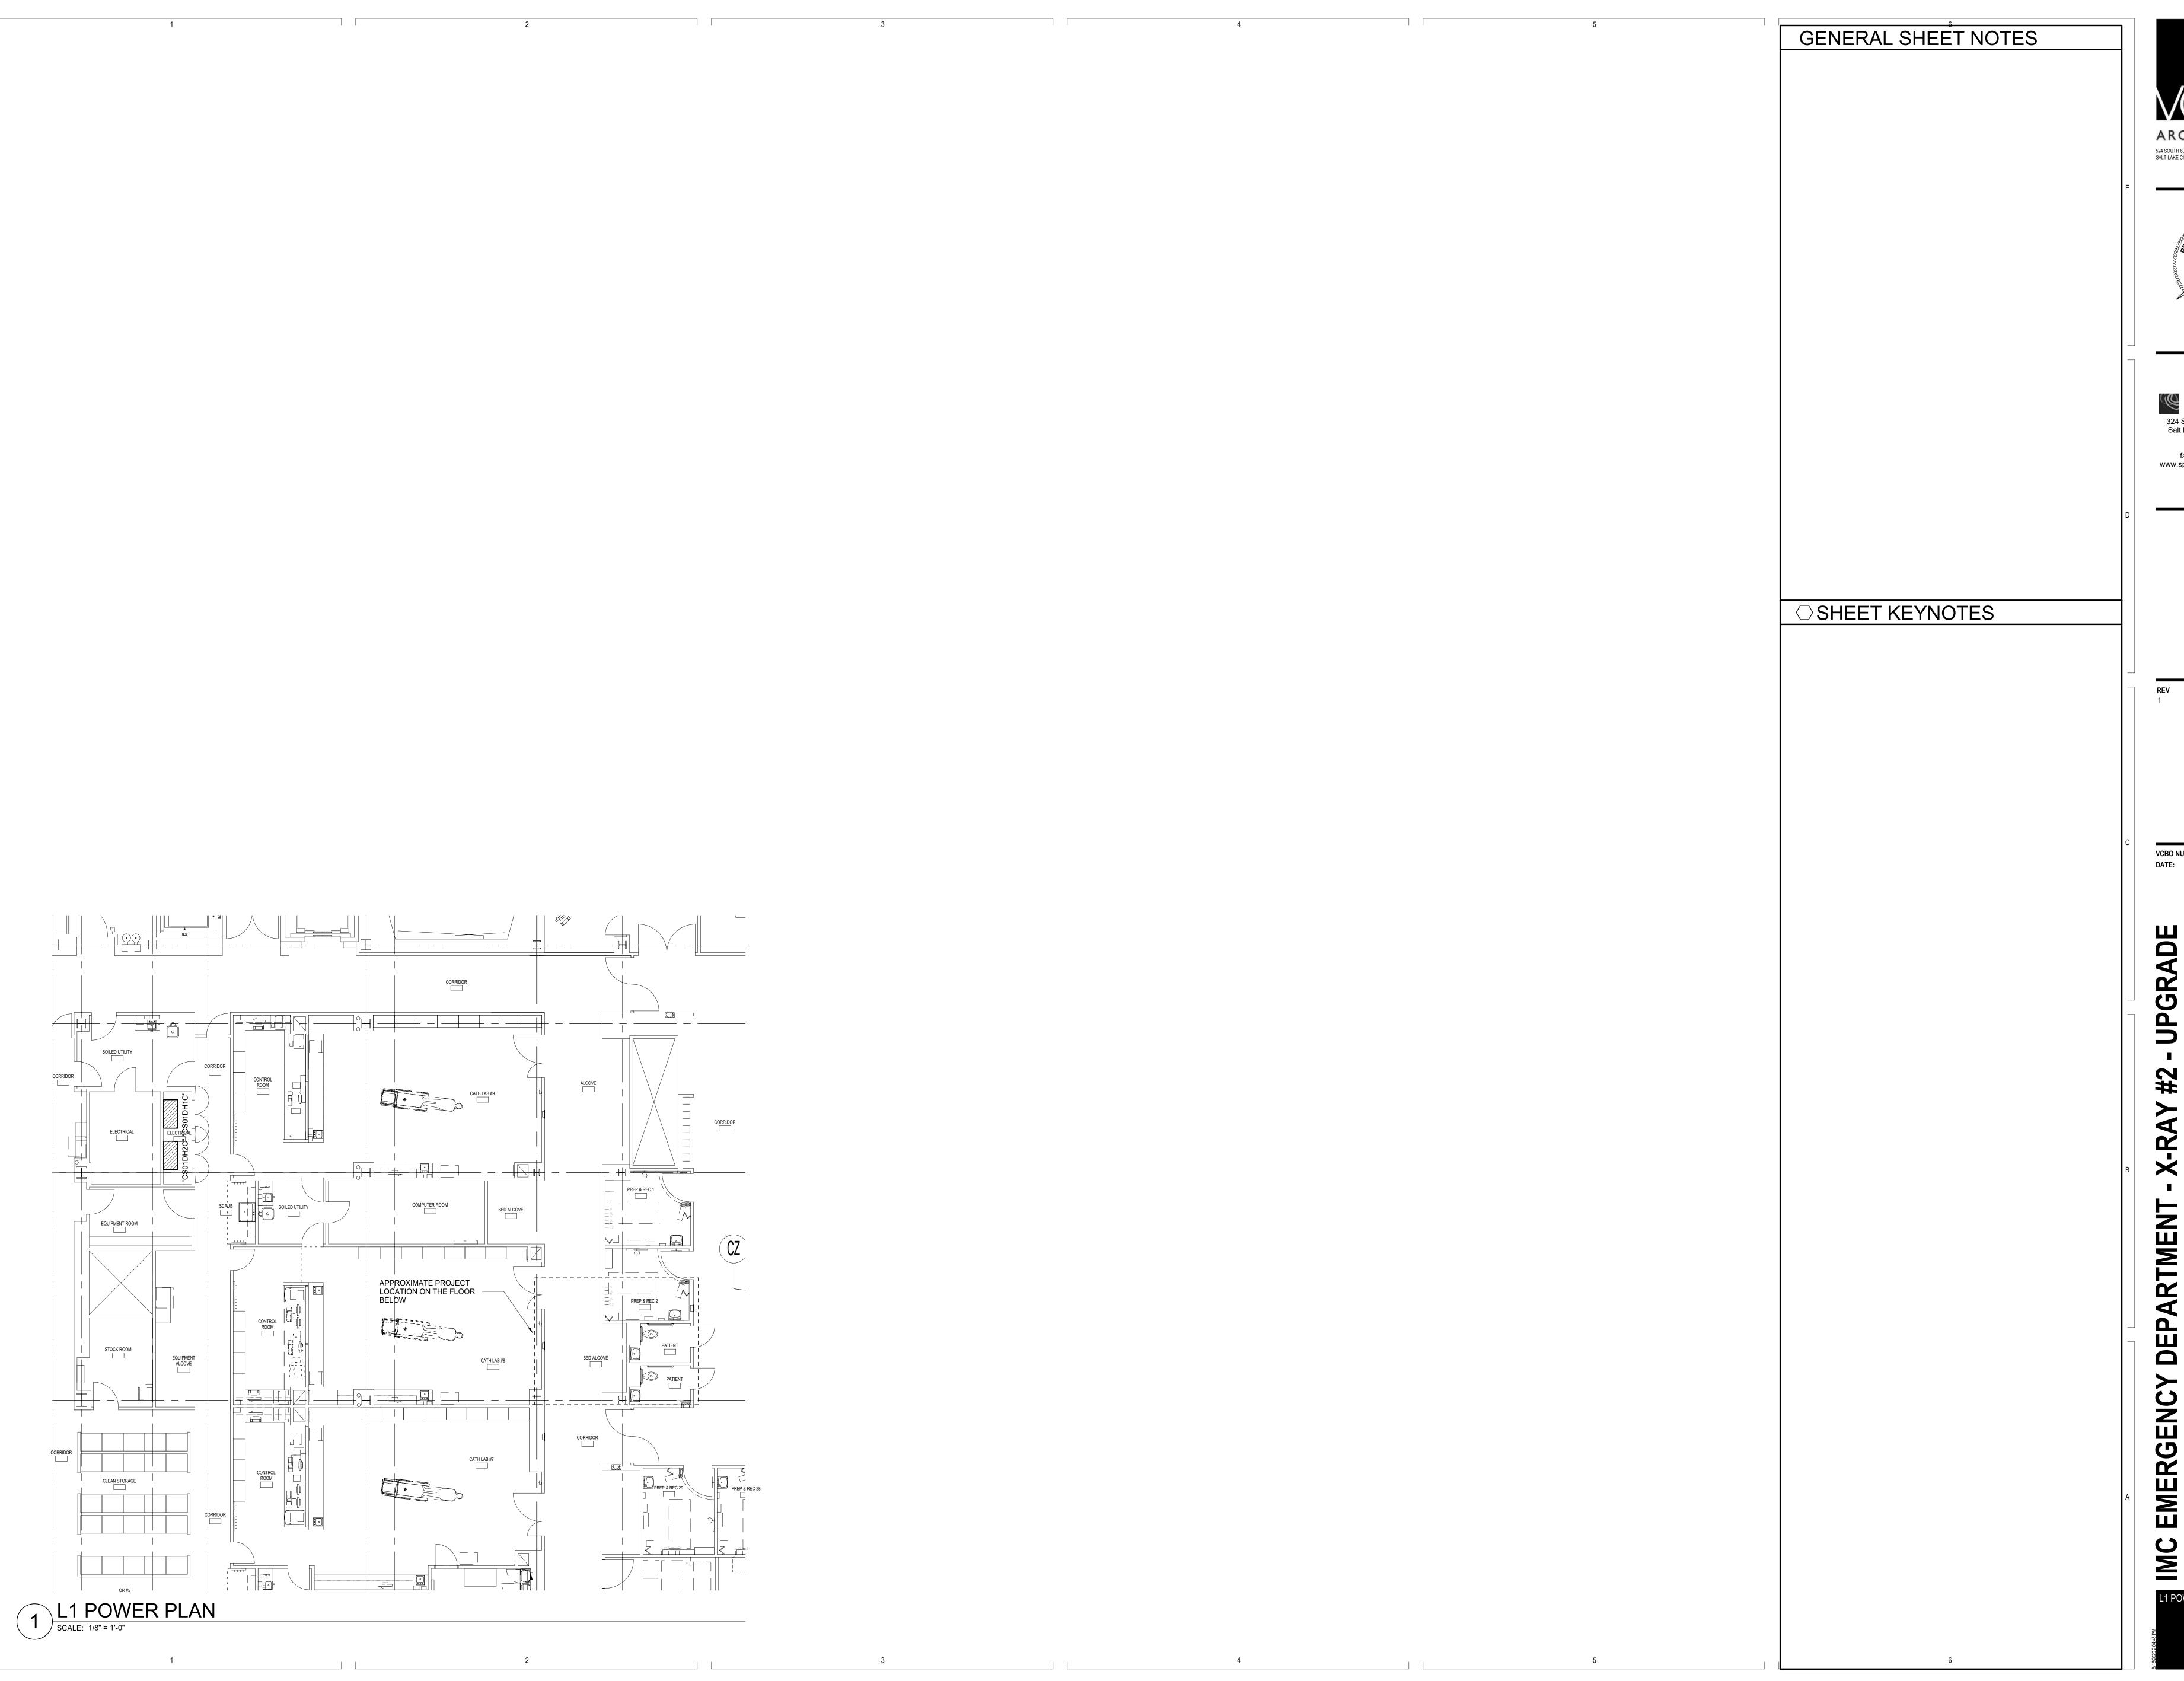


524 SOUTH 600 EAST SALT LAKE CITY, UT 84102

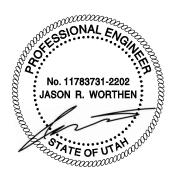


324 S. State St., Suite 400 Salt Lake City, UT 84111 800-678-7077 801-328-5151 fax: 801-328-5155 www.spectrum-engineers.com


REV DATE DESCRIPTION

FP100

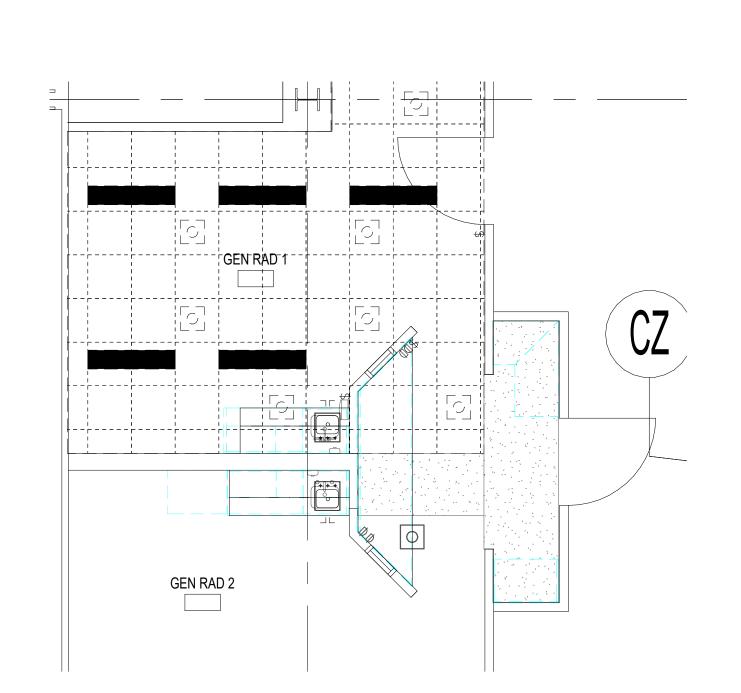


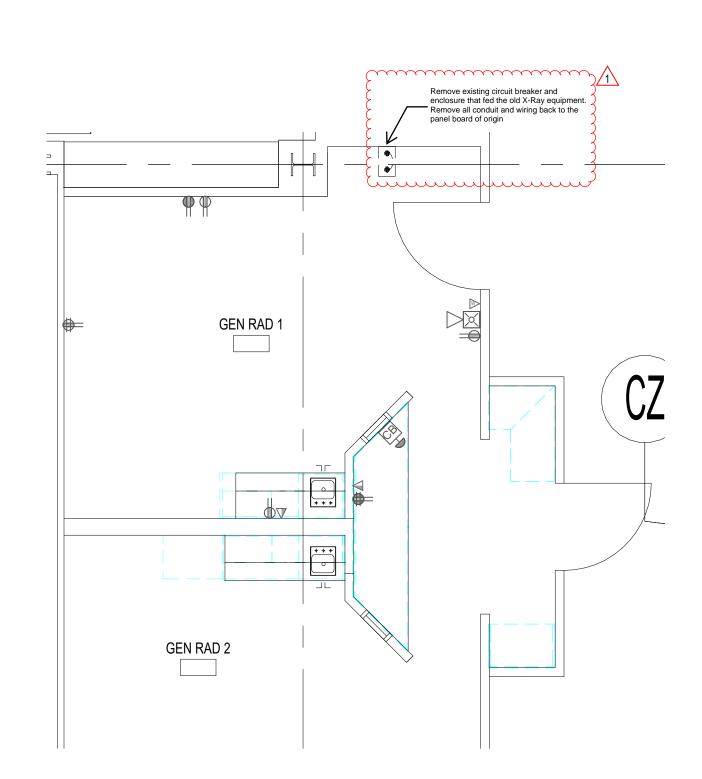

3 LL-1 CEILING DEMOLITION PLAN SCALE: 1/4" = 1'-0"

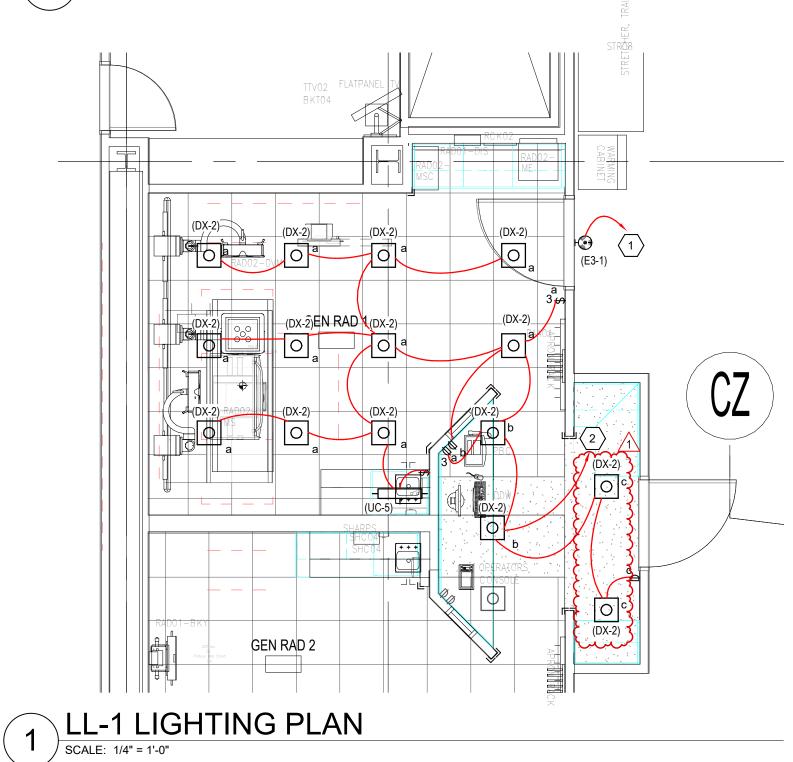



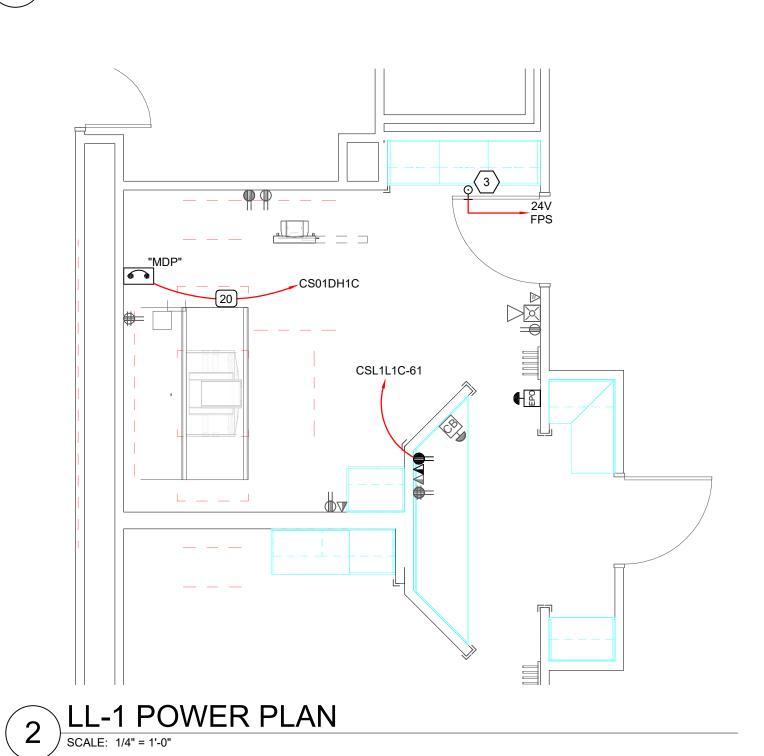

GENERAL SHEET NOTES

- 1 UNLESS NOTED OTHERWISE REMOVE ALL LIGHTING FIXTURES DEVICES AND EQUIPMENT SHOWN DASHED. REMOVE CONDUIT AND WIRING BACK TO PANELBOARD OF ORIGIN OR TO FIRST ACTIVE DEVICE THAT REMAINS.
- 2 SALVAGE ALL LIGHT FIXTURES, TWIST-LOCK RECEPTACLES AND WALLPLATES, CEILING SPEAKERS AND SECURITY AND FIRE ALARM DEVICES TO OWNER. PROTECT SALVAGED EQUIPMENT FROM DAMAGE.
- 3 PRIOR TO SUBMITTING BID, VISIT THE SITE AND FIELD VERIFY THE EXTENT OF ELECTRICAL DEMOLITION WORK TO MEET THE INTENT OF THE BID DOCUMENTS AND INCLUDE ALL COSTS IN BID.
- PRIOR TO REMOVAL OF ANY ELECTRICAL EQUIPMENT OR WIRING, FIELD VERIFY THAT THE EQUIPMENT OR WIRING IS INACTIVE OR NO LONGER IN USE.
- REMOVE ALL DEVICES, RACEWAYS AND WIRING FROM WALLS TO BE REMOVED. WHERE ACTIVE RACEWAYS OCCUR IN WALLS TO BE REMOVED, RE-ROUTE THE RACEWAY WITH ASSOCIATED WIRING TO KEEP THE CIRCUIT OPERATIONAL.
- 6 REMOVE ALL FIRE ALARM DEVICES WHERE EXISTING WALLS AND CEILINGS ARE BEING REMOVED, WITH ASSOCIATED CONDUIT AND WIRING. EXISTING FIRE ALARM DEVICES AND SYSTEM NOT INDICATED FOR REMOVAL SHALL REMAIN ACTIVE THROUGHOUT DEMOLITION AND CONSTRUCTION UNTIL THE NEW SYSTEM IS TESTED AND OPERATIONAL. MAINTAIN ALL CLASS A FIRE ALARM INITIATING AND INDICATING LOOPS WHERE EXISTING DEVICES ARE REMOVED.
- 7 REMOVE ALL ABANDONED RACEWAY, CONDUIT, WIRING AND CABLING WHETHER ABANDONED PREVIOUS TO THIS PROJECT OR AS A RESULT OF THIS PROJECT. NOT ALL ABANDONED ITEMS ARE SHOWN ON THESE PLANS AND FIELD VERIFICATION OF DEMOLITION SCOPE EXTENT IS REQUIRED.
- 8 DEVICES MARKED "RR" ARE TO BE REMOVED AND RELOCATED PER NEW PLANS. EXTEND CIRCUITING AS REQUIRED FOR RELOCATION.
- 9 REFER TO ARCHITECTURAL DRAWINGS FOR REMOVAL OF MOTORS, CONDUIT, CONDUCTOR AND CONTROL WIRING ASSOCIATED WITH EXISTING MOTORIZED DOORS, PARTITIONS AND LIGHTING.
- 10 PROVIDE DEDICATED NEUTRALS FOR ALL BRANCH CIRCUITS.
- 11 PROVIDE NEW TYPED PANEL SCHEDULE FOR ALL PANELS AFFECTED BY PROJECT.
- 12 REFER TO THE GE X-RAY DRAWINGS FOR ADDITIONAL CONTRACTOR RESPONSIBILITIES.







○ SHEET KEYNOTES

1 CONNECT TO THE EXISTING LIGHTING CIRCUIT THAT PREVIOUSLY FED THE X-RAY IN USE SIGN.

- 2 CONNECT TO THE LIGHTING CIRCUIT THAT PREVIOUSLY FED THIS SPACE.
- 3 PROVIDE A MAG HOLD OPEN FOR THE DOOR, MOUNTED HORIZONTALLY IN THE TOEKICK OF THE CABINETS.

06/16/20 Addendum #1

20370 06/08/2020

RADE

DEPARTMENT - X-RAY #2 - UPGRADE

EMERGENCY DEPARTMENT -)
OUNTAIN HEALTHCARE
OUTH COTTONWOOD STREET, MURRAY UT 84107

ELECTRICAL PLANS

ELECTRICAL PLANS

EP101

						INT	ERI	<u>OR l</u>	<u> IG</u>	HTING F	IXTL	JRE :	<u>SCH</u>	EDI	ULE	- -					
				A	BBF	REV	IATI	ONS											GENEF	RAL NOTE	S
	ARHR - / DL - II EQC - E F - F - F HLD - HS - F GRS -	AIR RETURN DAMP LOCA EARTHQUAI FUSING HINGED ANI HOUSE SIDI PHOTOCELI QUARTZ RESTATIC WIRE GUAR WET LOCAT	N AND HEAT ATION KE CLIPS D LATCHED E SHIELD L SWITCH ESTRIKE RD FION				BL - SL - GL - PW - EA - S - GS - C BA - SCBA - CCA - FS 209D TP - FL - R - M -	MATTE WHIT BLACK SILVER GOLD CLEAR PAINTED WH EXTRUDED A STEEL GALVANIZED CAST COLOR BY AI STANDARD O ARCHITECT CUSTOM COI ARCHITECT MEETS FEDE STANDARD 2 THERMALLY PROTECTED FLUSH REGRESS MITERED	ITE LUMINUM STEEL RCHITECT COLOR BY LOR BY RAL 09D	GC - GLASS (CI GO - GLASS (O GF - GLASS (FI SGL - SOFT GLO HPL - HIGH PER DO - DROP OP CGL - CONVEX (S S - SATIN LEN	#THICK #THICK (OPAL) LEAR) PAL) ROSTED) DW LENS FORMANCE LE AL GLASS LENS NS	ENS	OP SP SS D SC PR DS LI IR SL CA	- SPEC - SEMI DIFFU - SPEC - PRISM - FULL - DIFFU - LOW I - IRIDE: - SILVE - GOLD - CLEAI	E/OPEN EULAR SPECULAR JSE (WHITE ULAR (COL MATIC DEPTH REI JSE (SEMI S IRIDESCEN SCENT ER) R ALZAK	E ENAMEL LORED) FLECTOR SPECULA IT	2. R) SILVER 3. 4. 5. 6. 7. 8.	FOR EACH FAILURE AND EMPLOYER FOR EACH FINSTALLINGHTING	ACTOR ALLOWANCE PRICES ED, CONTRACTOR AND ELEC INCE AND REPORT ANY PRO INCE PRICE MAY OR MAY NO INCLUDE ANY TAXES. FUTIONS AND/OR EQUAL FIX I, THEY MUST BE SUBMITTED O BID OPENING. S MUST BE PROVIDED FOR IN O RELEASING FIXTURES. FURES SHALL BE LISTED AND ON. FHE PROPER MOUNTING KIT ATION AS SHOWN AT EACH OF WITH THE "INTERIOR LIGHT OF SPECIFICATIONS FOR IMAGE OF STIXTURES, DRIVERS, AND OUT OF STIXTURES TO BE EITHER	WITHIN 48 BUSINESS HOURTHIN 48 BUSINESS HOUREMENT MAY DISQUARE PURTHER INPUT FROM THE PURTHER INPUT FROM THE PURTHER INPUT FROM THE PURTHER INPUT FROM THE PURTHER MUST RECEIVE AND ANY AND ALL FIXTURES OF ACCESSORIES TO LOCATION ON THE DRAY ING" SECTION OF THE SECONTANT TECHNICAL RELAMPS.	EURS OF THE BID DATA LIFY THE PRODUCTS FOR FIXTURE AND THE CONTRACTOR OF THIS JOB WAS HALL VERIFY THIS ER BEFORE THE BID. FREIGHT AS NOTED, PPROVAL PRIOR TO LESS THAN 2 WEEKS UPON A/E REQUEST INTENDED USE AND FACILITATE WINGS. PECIFICATIONS. EQUIREMENTS FOR
~~~~				AL SIZE		<del>~~</del>	~~~	~~~		<b>Z</b> 0	<del>~~~</del>	<del>~~~</del>		<b>~~~</b>	<del></del>	~~~	<u></u>	AFFROV	MANUFACTURER (CATALOG SERIES)		
ID	DESCRIPTION	LENGTH	DEРТН	неіснт	DIAMETER/ APERTURE	MOUNTING	ТУРЕ	COLOR TEMP	CRI	DRIVER CONFIGURATI	VOLTAGE	WATTS	FINISH	FIXTURE LUMENS	DIFFUSER/LENS	REFLECTOR	SNOILdo	NOTES	OPTION 1	OPTION 2	OPTION 3
(DX-2)	6" ROUND, RECESSED LED DOWNLIGHT, SEMI-SPECULAR REFLECTOR, WHITE TRIM FINISH	-	-	-	0' - 6"	CR	LED	3500K		0-10V DIMMING (10%)	120/277	23	-	2000			-		PORTFOLIO (LD6B20D010/EU6B10208 035/6LBW2H HB26)		
(E3-1)	X-RAY IN USE LIGHT	-	-	-	-	UNV	LED	RED		NO DIMMING	120/277	5		0					EVENLITE (DCG-AC-1-WW-**-RD-W-X RAY IN USE)		
(UC-5)	24" LED UNDERCABINET LIGHT	2' - 0"	-	-	-	S	LED	3500K		ELV DIMMING	120/277	8		600					KENALL (AUCLED-1-MW-11L35K-2 4-277)		











- UPGRADE

INTERIOR LIGHTING FIXTURE SCHEDULE

**DEPARTMENT** IMC EMERGENCY