

Issued No.	Date	Description
1	09.21.23	PLAN REVIEW
2	02.29.24	PLAN REVIEW

Revision No.	Date	Description
2	02.01.24	PLAN REVIEW/REDESIGN


SAA Project No. 2022-11

Drawing Title

OPENING DETAILS

Sheet Number

**AE581**

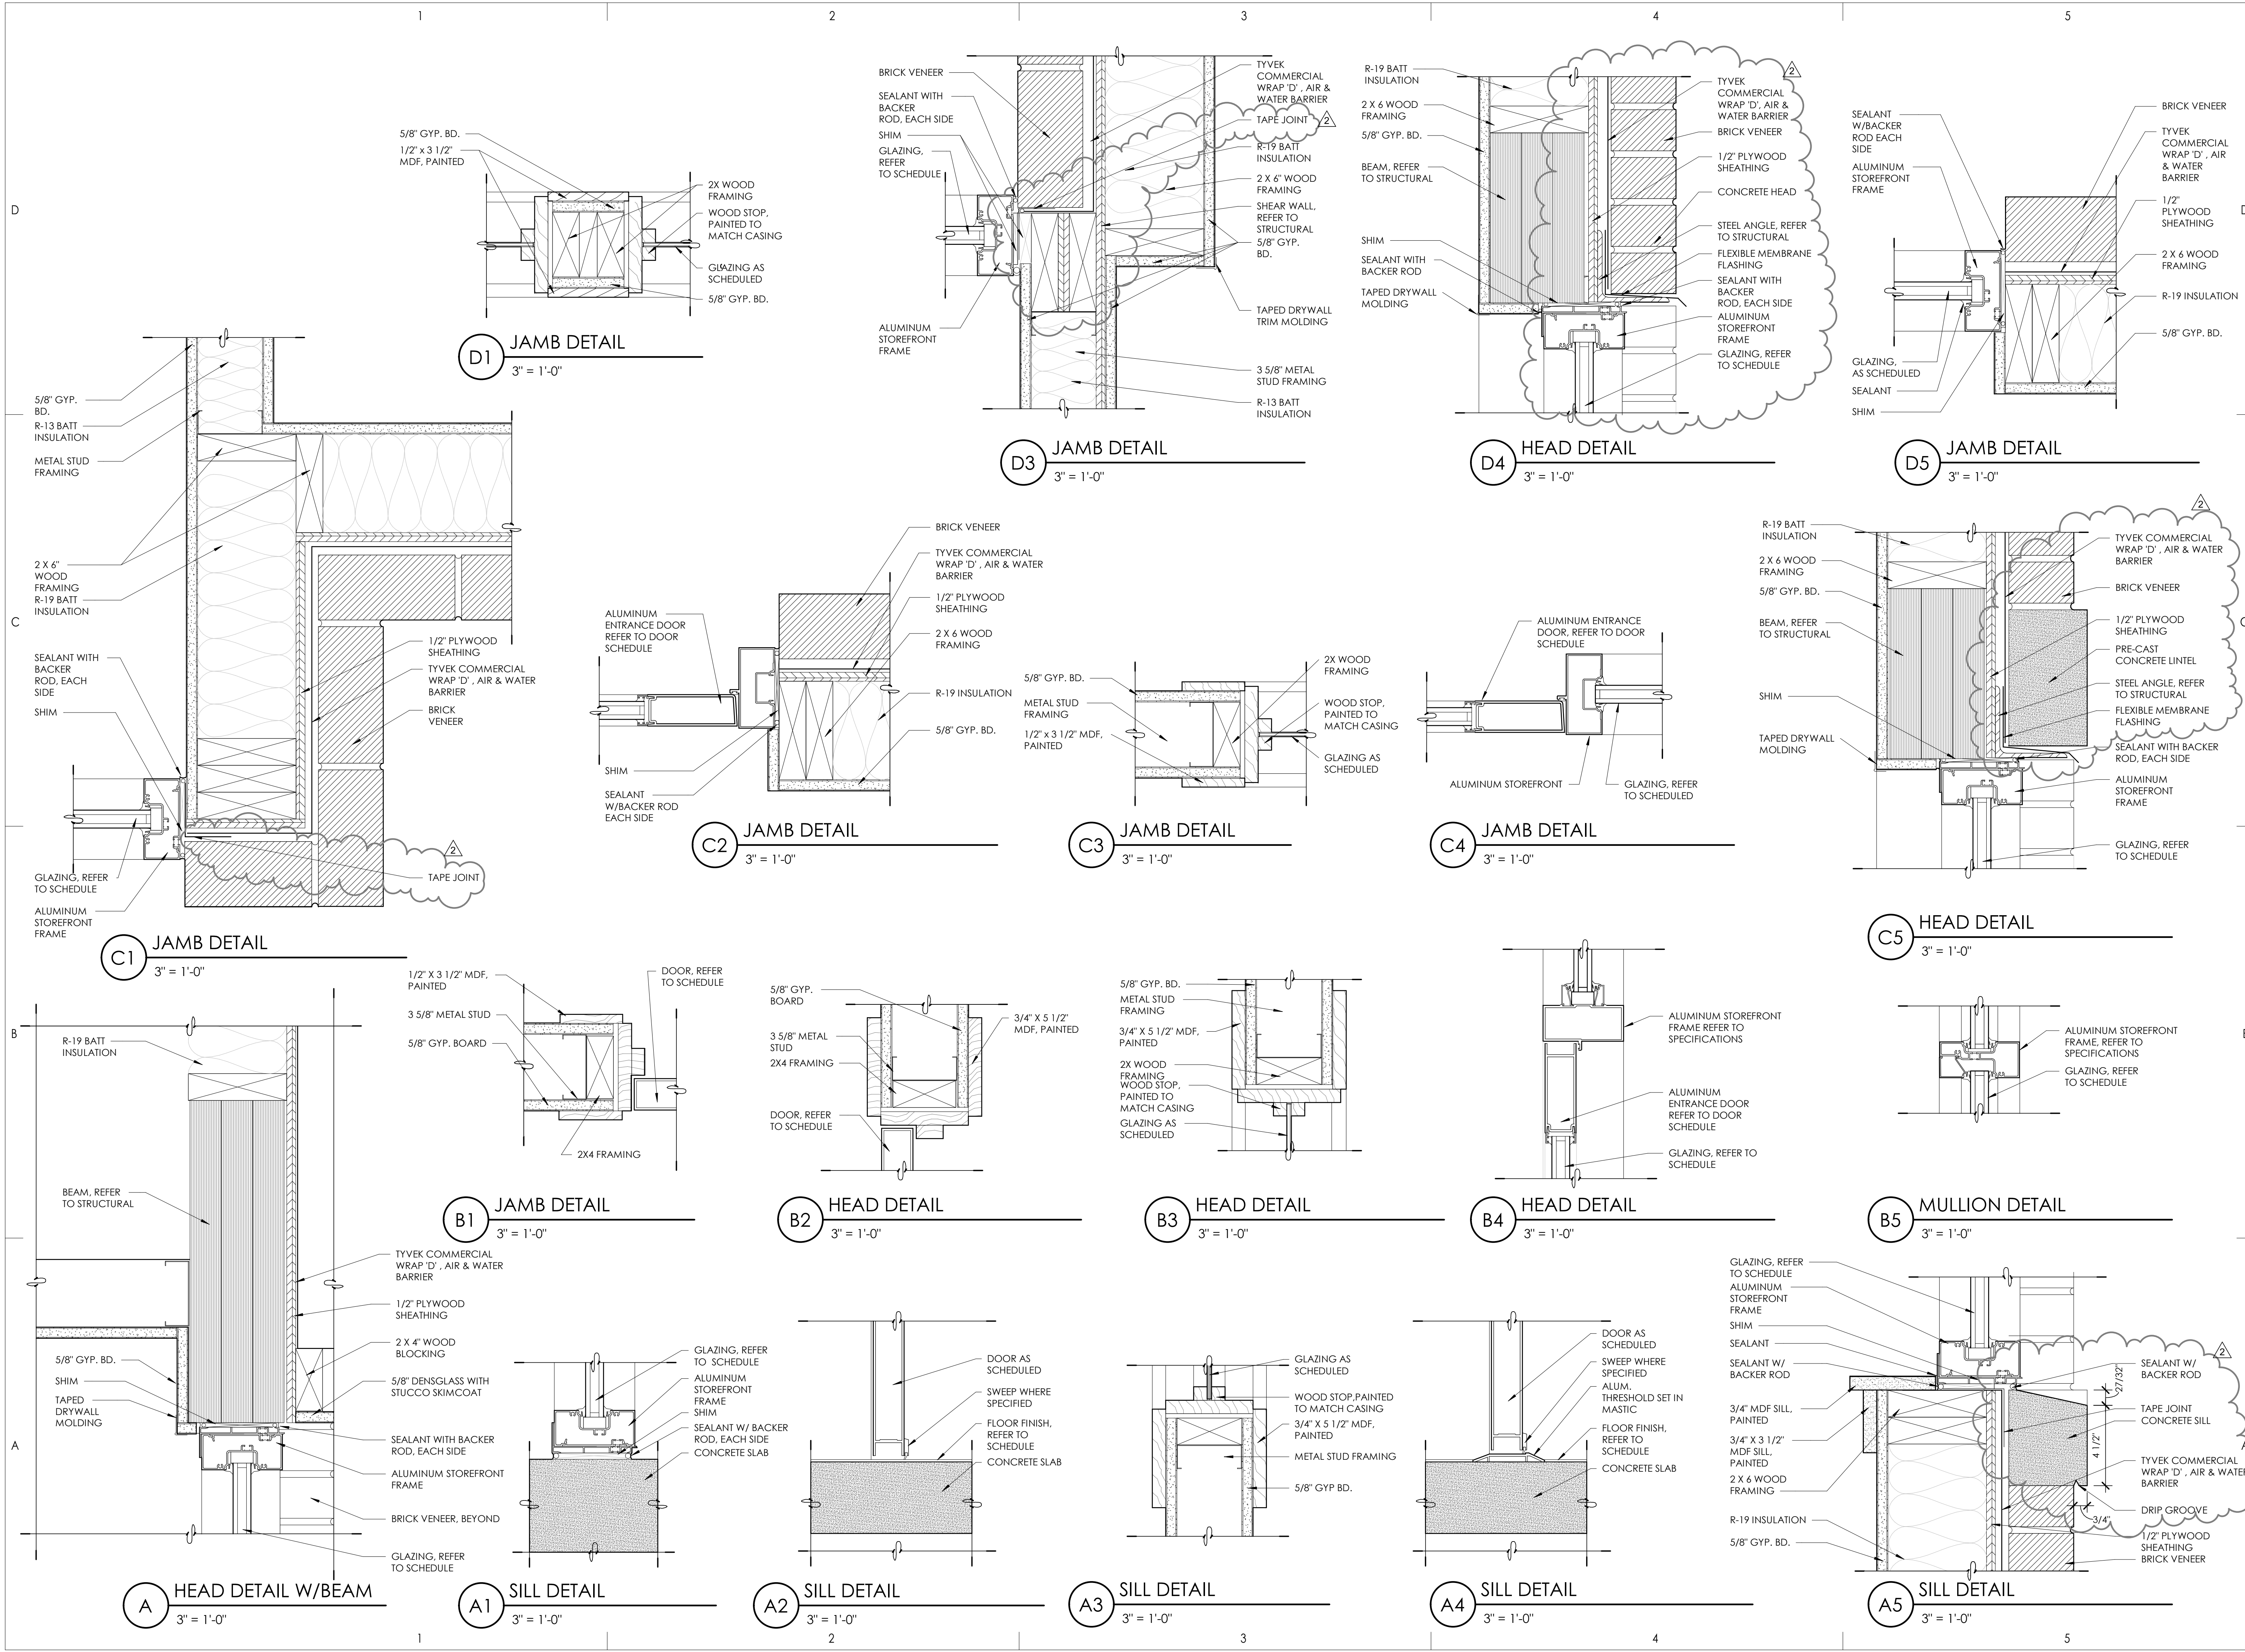

**AE581**



Consultant

**JONES & ASSOCIATES**  
CONSULTING ENGINEERS  
6080 S FASHION POINT DRIVE  
SOUTH OGDEN, UT 84405

Project Name

Issued	No.	Date	Description
	1	09.21.23	PLAN REVIEW
	2	02.29.24	PLAN REVIEW


Revision	No.	Date	Description
	2	02.01.24	PLAN REVIEW/REDESIGN

SAA Project No. 2022-11  
Drawing Title


OPENING DETAILS

Sheet Number


**AE582**

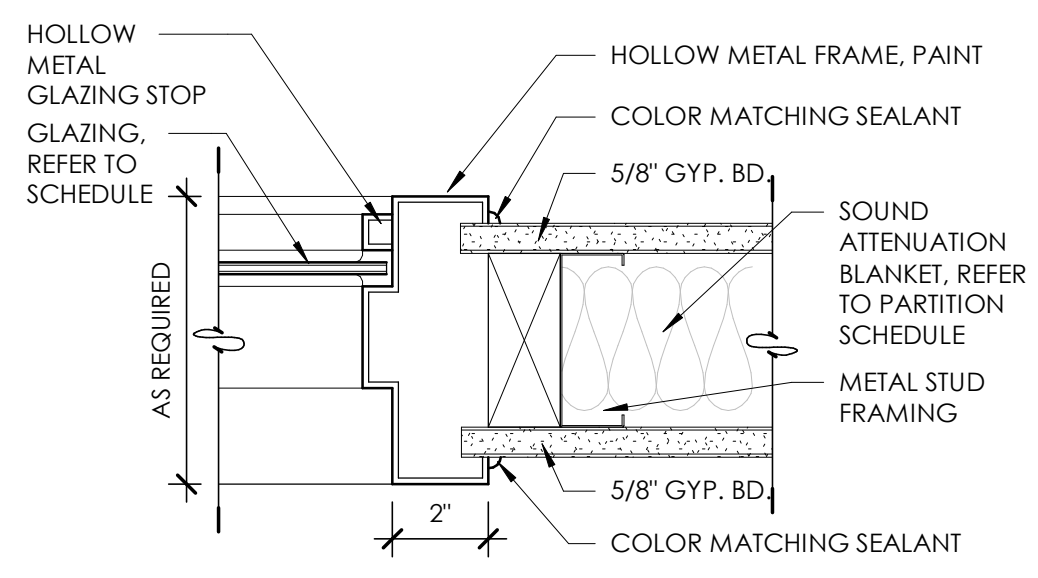


**D2** HM HEAD/JAMB DETAIL  
3" = 1'-0"

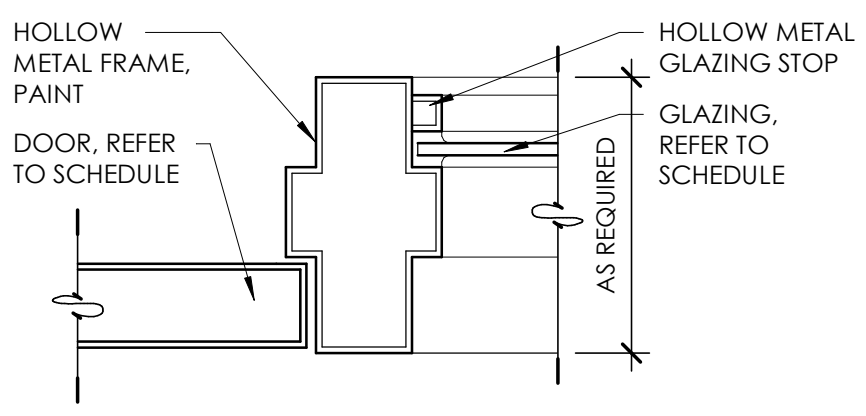


**C2** HM MULLION DETAIL  
3" = 1'-0"

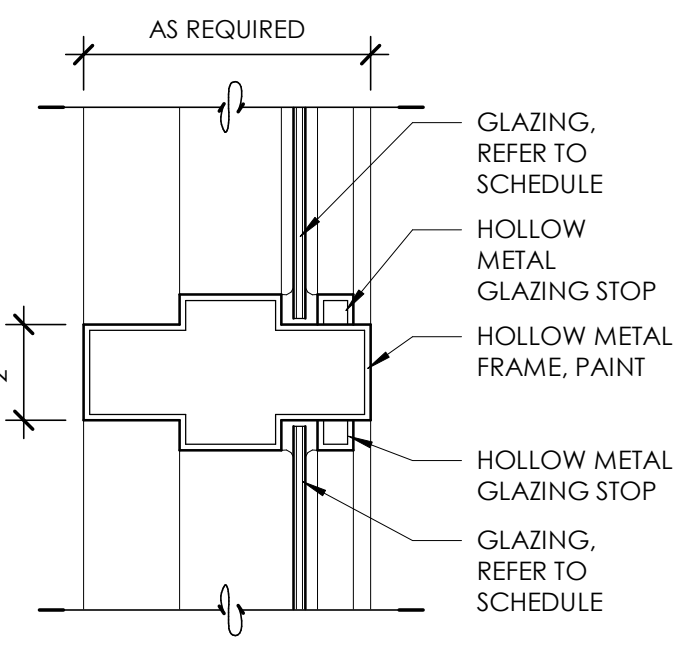


**B2** HM MULLION DETAIL  
3" = 1'-0"

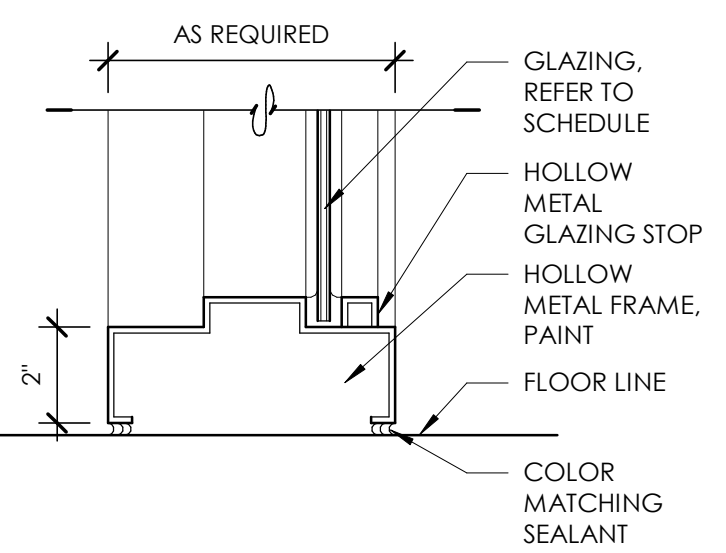


**A2** HM SILL DETAIL  
3" = 1'-0"

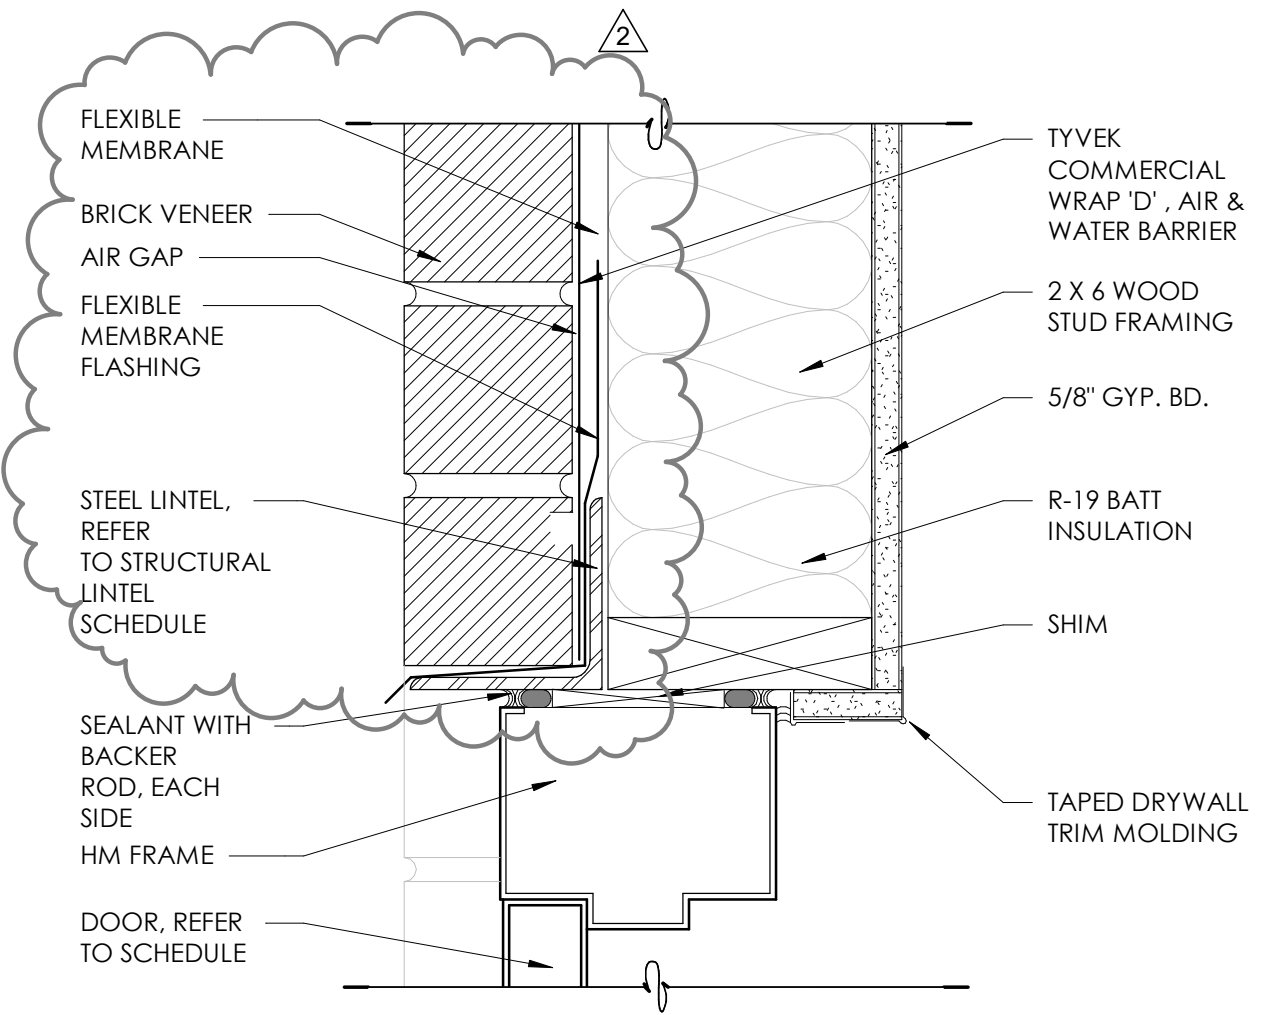


**C3** HM HEAD  
3" = 1'-0"

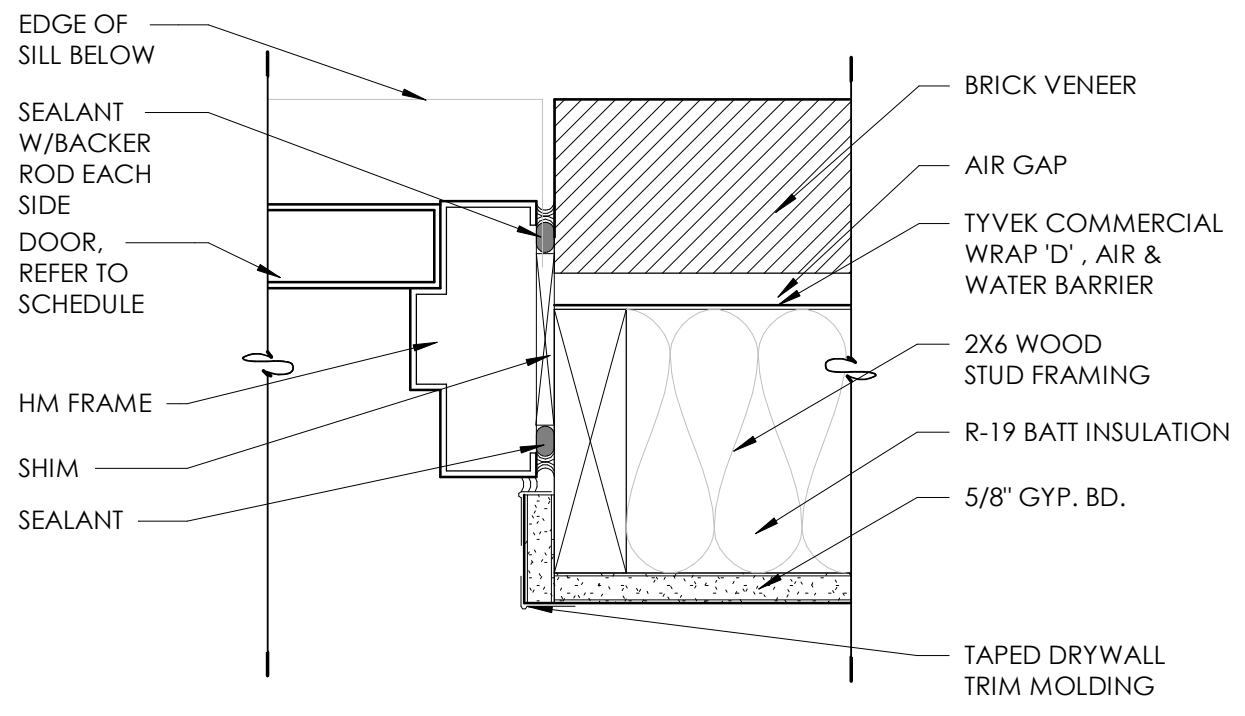


**B3** HM JAMB  
3" = 1'-0"

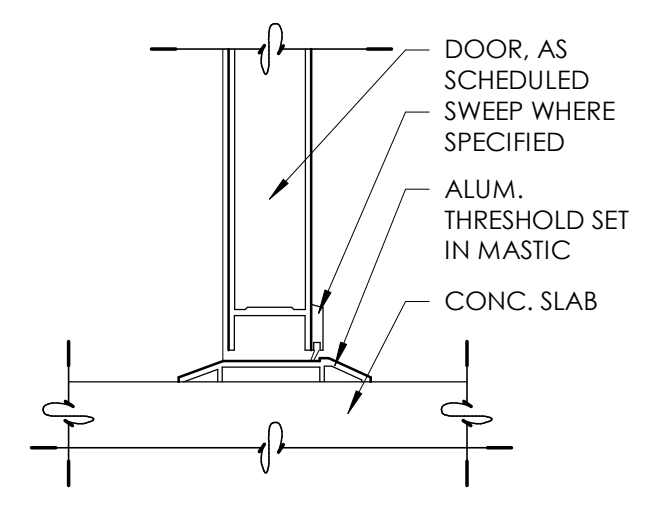


**A3** HM SILL  
3" = 1'-0"

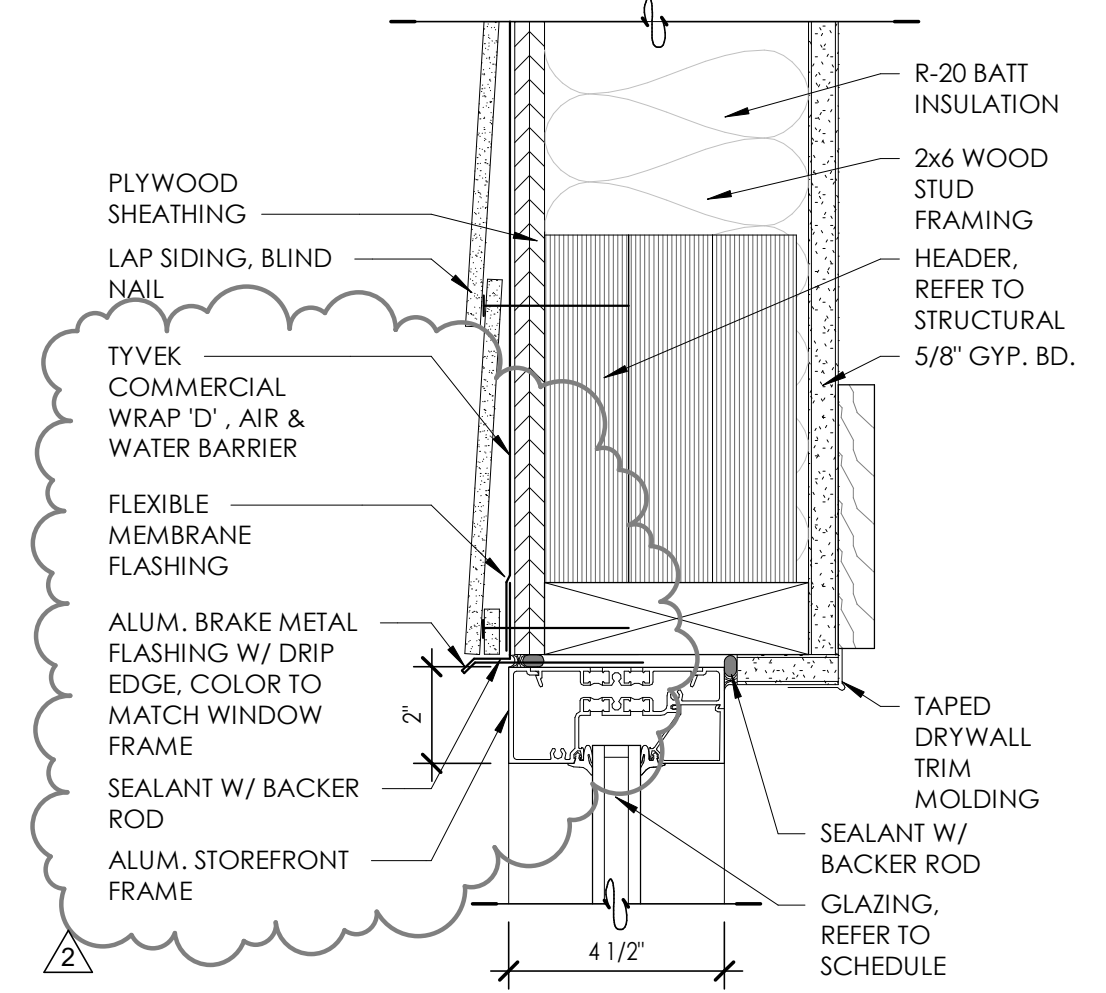

**C5** HEAD DETAIL  
3" = 1'-0"

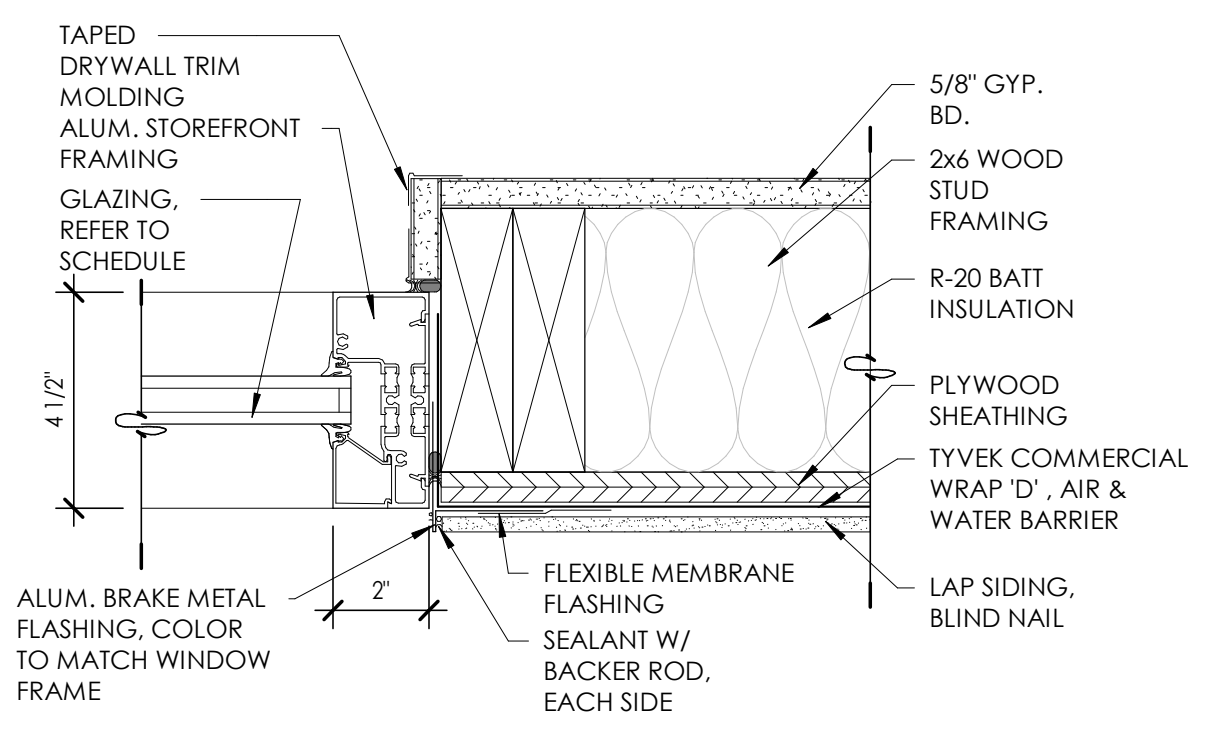

**B5** JAMB DETAIL  
3" = 1'-0"

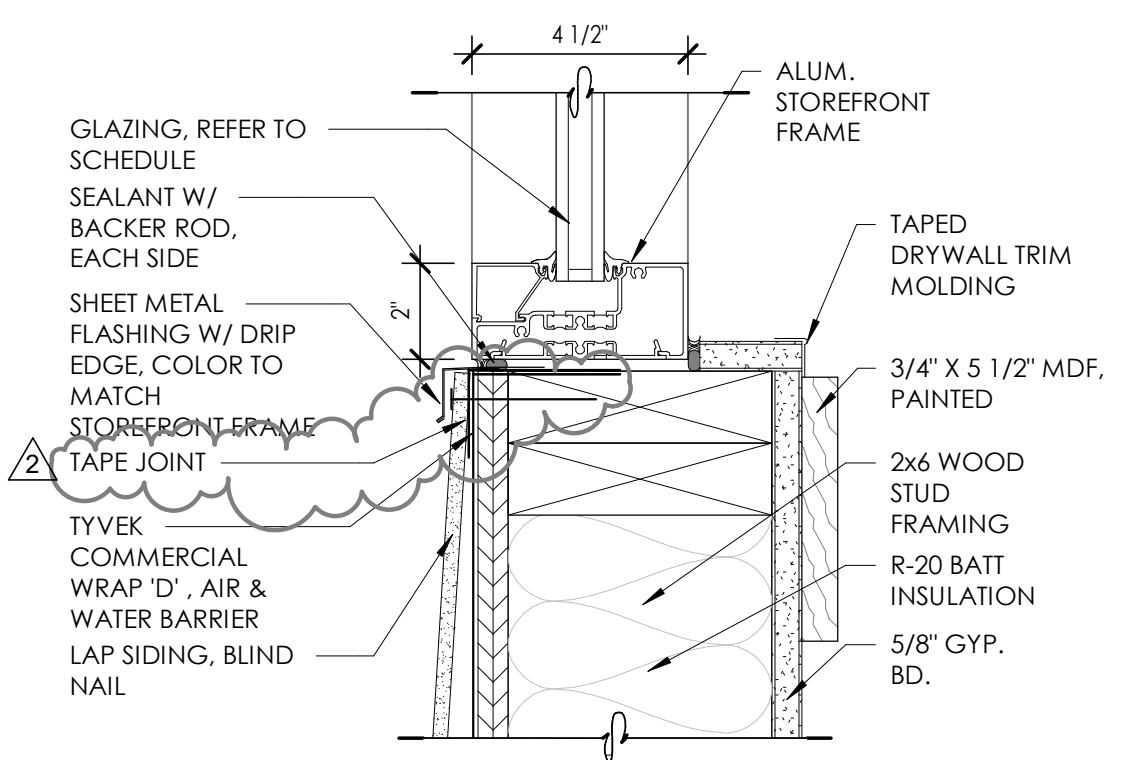

**A5** SILL DETAIL  
3" = 1'-0"

DOOR SCHEDULE																	
DOOR #	ROOM NAME	DOOR TYPE	DOOR			MTRL	FINISH	GLAZE	FRAME TYPE	FRAME			HRDWR. GROUP	FIRE RATING	COMMENTS	DOOR #	
			WIDTH	HEIGHT	THICK					MTRL	FINISH	HEAD DETAIL					JAMB DETAIL
101A	ENTRY	OMITTED	3'-0"	7'-0"	1 3/4"	ALUM	CLEAR	GL-3	OMITTED	ALUM	CLEAR	-	-	-	5	-	101A
101B	OMITTED	A	0"	0"	0"	-	-	-	OMITTED	-	-	-	-	-	-	-	101B
102A	MEN	B	3'-0"	7'-0"	1 3/8"	WD	PNT	-	A	WD	PNT	B2/AE581	B1/AE581	-	3	-	102A
102A	WOMEN	B	3'-0"	7'-0"	1 3/8"	WD	PNT	-	A	WD	PNT	B2/AE581	B1/AE581	-	3	-	102A
104A	OMITTED	0"	0"	0"	-	-	-	OMITTED	-	-	-	-	-	-	-	-	104A
106A	OFFICE	B	3'-0"	7'-0"	1 3/8"	WD	PNT	-	A	WD	PNT	B2/AE581	B1/AE581	-	1	-	106A
107A	OFFICE	B	3'-0"	7'-0"	1 3/8"	WD	PNT	-	A	WD	PNT	B2/AE581	B1/AE581	-	1	-	107A
108A	OFFICE	B	3'-0"	7'-0"	1 3/8"	WD	PNT	-	A	WD	PNT	B2/AE581	B1/AE581	-	1	-	108A
109A	STORAGE	B	3'-0"	7'-0"	1 3/8"	WD	PNT	-	A	WD	PNT	B2/AE581	B1/AE581	-	4	-	109A
110A	OFFICE	B	3'-0"	7'-0"	1 3/8"	WD	PNT	-	A	WD	PNT	B2/AE581	B1/AE581	-	1	-	110A
111A	OFFICE	B	3'-0"	7'-0"	1 3/8"	WD	PNT	-	A	WD	PNT	B2/AE581	B1/AE581	-	1	-	111A
112A	OFFICE	B	3'-0"	7'-0"	1 3/8"	WD	PNT	-	A	WD	PNT	B2/AE581	B1/AE581	-	1	-	112A
113A	OFFICE	B	3'-0"	7'-0"	1 3/8"	WD	PNT	-	A	WD	PNT	B2/AE581	B1/AE581	-	1	-	113A
114A	OMITTED	0"	0"	0"	-	-	-	OMITTED	-	-	-	-	-	-	-	-	114A
114B	STAIR B	C	3'-0"	7'-0"	1 3/4"	HM	PNT	B	HM	PNT	C3/AE582	B3/AE582	A3/AE582	6	1HR	114B	
202A	GPS STORAGE	B	3'-0"	7'-0"	1 3/8"	WD	PNT	-	A	WD	PNT	B2/AE581	B1/AE581	-	4	-	202A
203A	MEN	B	3'-0"	7'-0"	1 3/8"	WD	PNT	-	A	WD	PNT	B2/AE581	B1/AE581	-	3	-	203A
204A	WOMEN	B	3'-0"	7'-0"	1 3/8"	WD	PNT	-	A	WD	PNT	B2/AE581	B1/AE581	-	3	-	204A
206A	MECH	B	3'-0"	7'-0"	1 3/8"	WD	PNT	-	A	WD	PNT	B2/AE581	B1/AE581	-	1	-	206A
207A	OFFICE	B	3'-0"	7'-0"	1 3/8"	WD	PNT	-	A	WD	PNT	B2/AE581	B1/AE581	-	1	-	207A
208A	OFFICE	B	3'-0"	7'-0"	1 3/8"	WD	PNT	-	A	WD	PNT	B2/AE581	B1/AE581	-	1	-	208A
209A	OFFICE	B	3'-0"	7'-0"	1 3/8"	WD	PNT	-	A	WD	PNT	B2/AE581	B1/AE581	-	1	-	209A
211A	OFFICE	B	3'-0"	7'-0"	1 3/8"	WD	PNT	-	A	WD	PNT	B2/AE581	B1/AE581	-	1	-	211A
212A	OFFICE	B	3'-0"	7'-0"	1 3/8"	WD	PNT	-	A	WD	PNT	B2/AE581	B1/AE581	-	1	-	212A
213A	OFFICE	B	3'-0"	7'-0"	1 3/8"	WD	PNT	-	A	WD	PNT	B2/AE581	B1/AE581	-	1	-	213A
214A	OFFICE	B	3'-0"	7'-0"	1 3/8"	WD	PNT	-	A	WD	PNT	B2/AE581	B1/AE581	-	1	-	214A

PANEL SCHEDULE		
MARK	GLASS TYPE	COMMENTS
GL-1	1/4" - CLEAR	
GL-2	1/4" - CLEAR TEMPERED	
GL-3	1" INSUL - LOW E - TEMPERED	SOLARBAN 60 (2) CLEAR + CLEAR U: 0.29; SHGC: 0.39
GL-4	1" INSUL-LOW E	SOLARBAN 60 (2) CLEAR + CLEAR U: 0.29; SHGC: 0.39

**HARDWARE SCHEDULE**

Hardware Grade: Meet ANSI / BHMA A156.3, Series 4000, Grade 2  
 Hardware Finish: US26D (Satin Chrome)  
 Lever: Provide lever meeting accessibility requirements  
 Hardware Accessibility Requirements: Meet 2009 ANSI / ICC A117.1 & 2010 ADA standards for accessible design  
 Hardware Requirements: Meet 2009 ANSI / ICC A117.1

**GROUP 1**  
 Function: Passage  
 Hinges  
 Door Stop- wall mount, where applicable  
 Silencers

**GROUP 2**  
 Function: Passage  
 Closure  
 Hinges  
 Door Stop- wall mount, where applicable  
 Silencers

**GROUP 3**  
 Function: Privacy lock  
 Closure  
 Kickplate  
 Hinges  
 Door Stop- Wall mount  
 Silencers

**GROUP 4**  
 Function: Office lock  
 Hinges  
 Door Stop- wall mount  
 Silencers

**GROUP 5**  
 Provided by Storefront Manufacturer  
 (Key as required by Owner)




**GROUP 6**  
 Function: Entry  
 Exit Panic Device w/ Level  
 Exterior cylinder night latch (part of panic device)  
 Closure  
 Hinges  
 Threshold  
 Weatherstripping

**GROUP 7**  
 OMITTED

**GENERAL NOTES**

ALL EXTERIOR STOREFRONTS, WINDOWS AND DOORS MUST HAVE A NFRC OR EQUAL CERTIFICATE

ALL DOORS LOCATED ON AN ACCESSIBLE ROUTE OR CIRCULATION PATH MUST BE TESTED FOR A MAX OPENING FORCE OF 5 LBS.

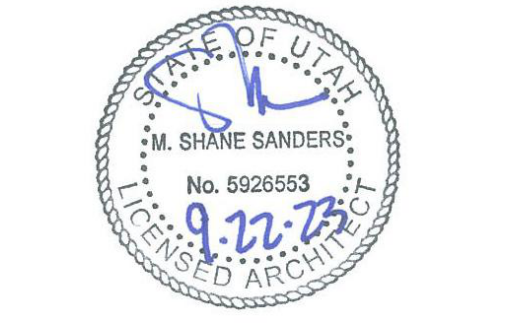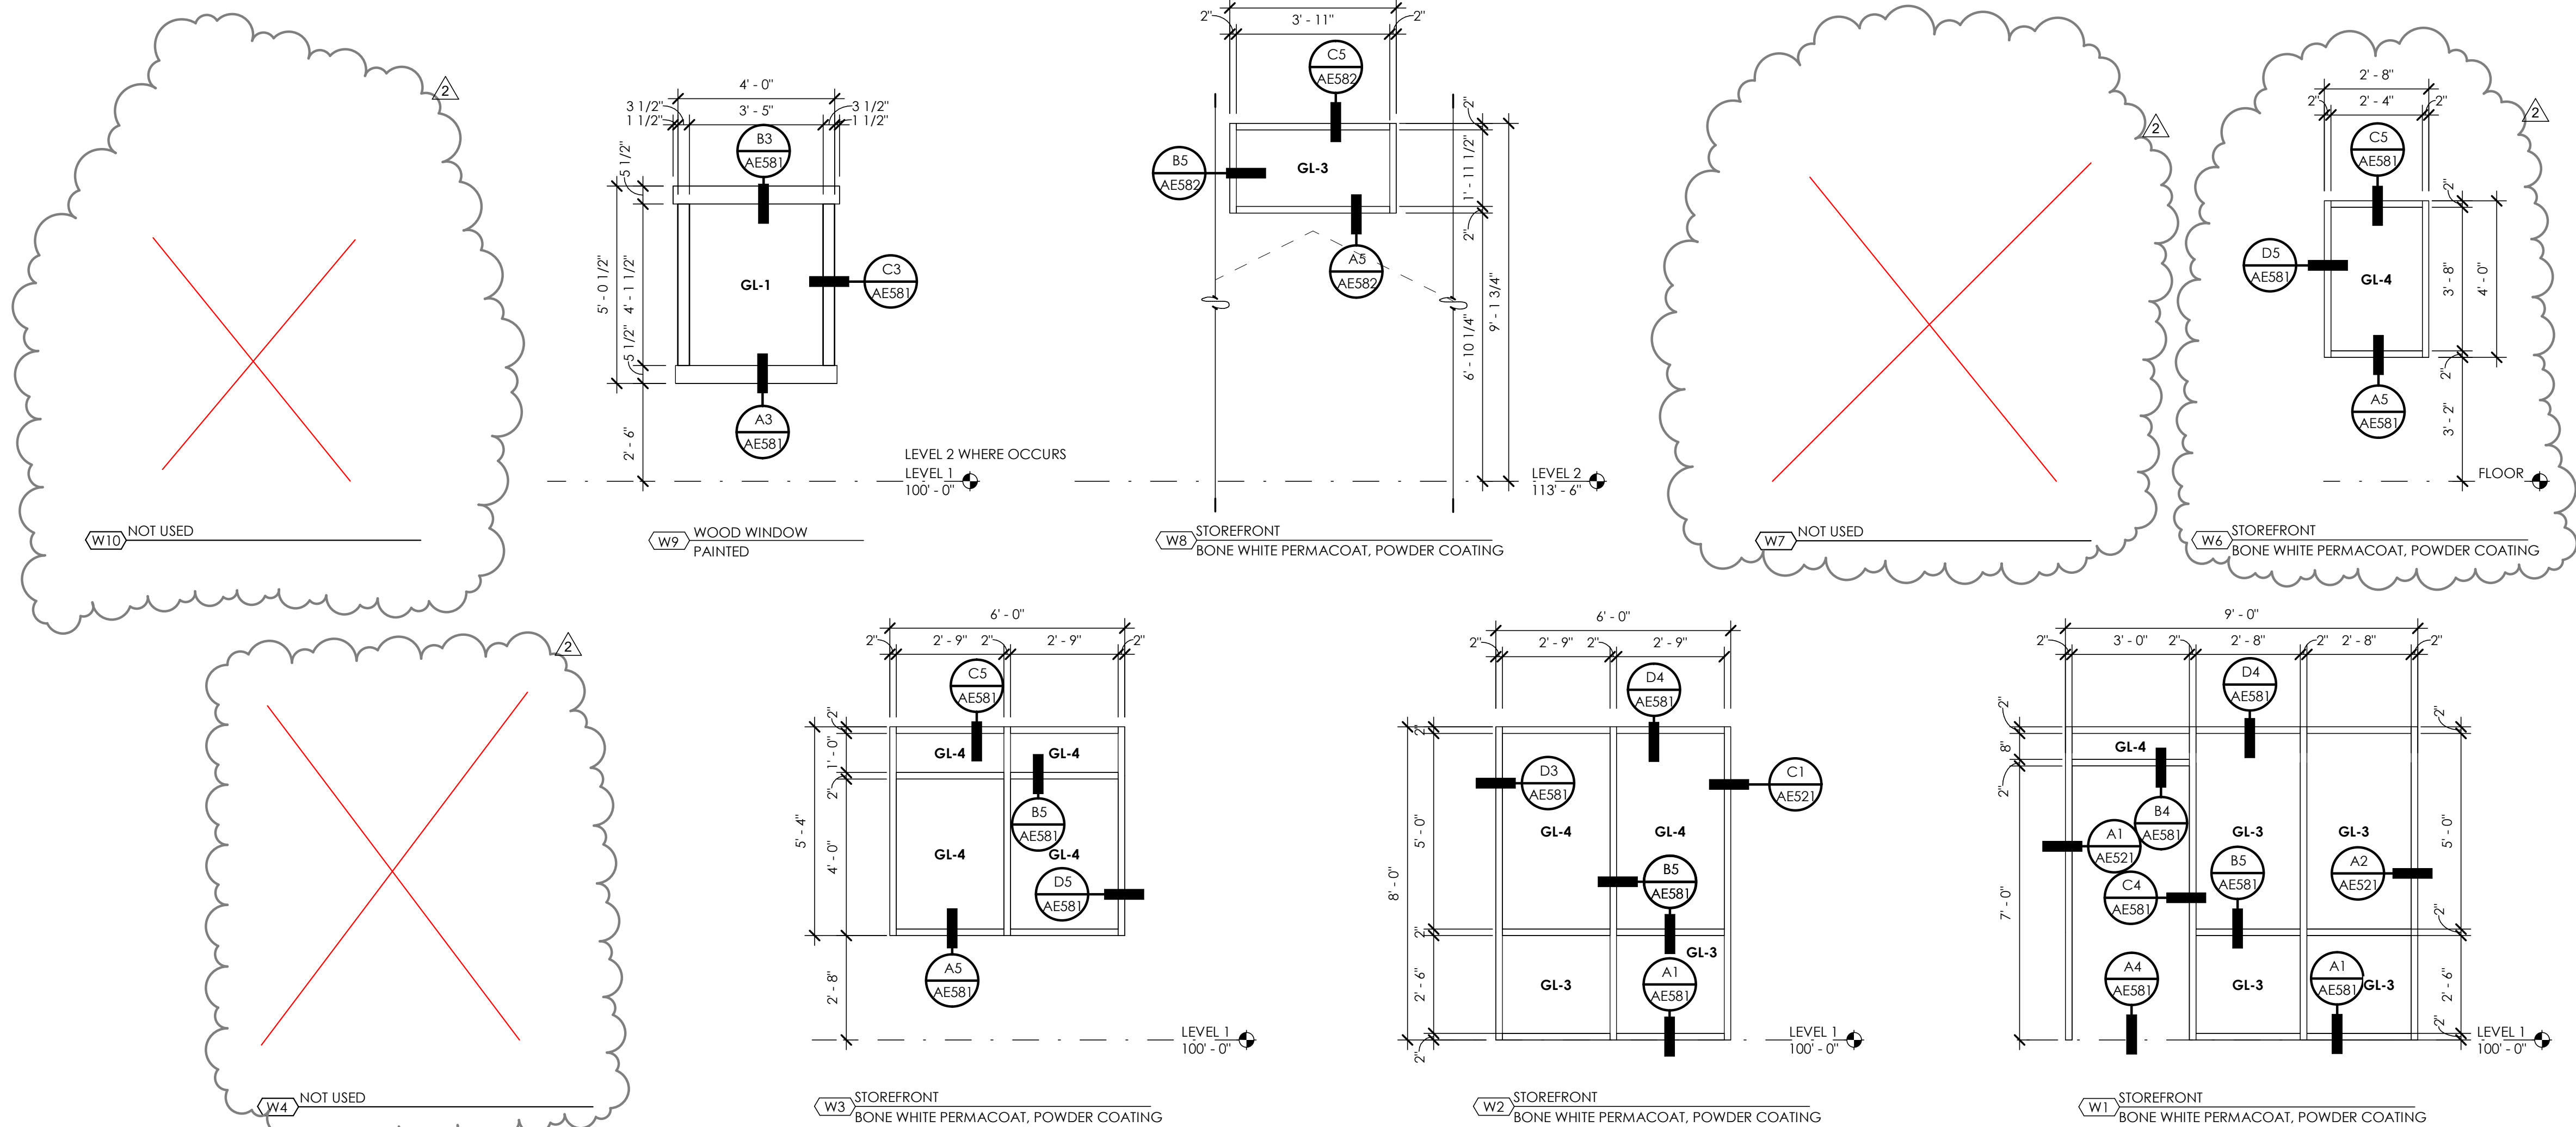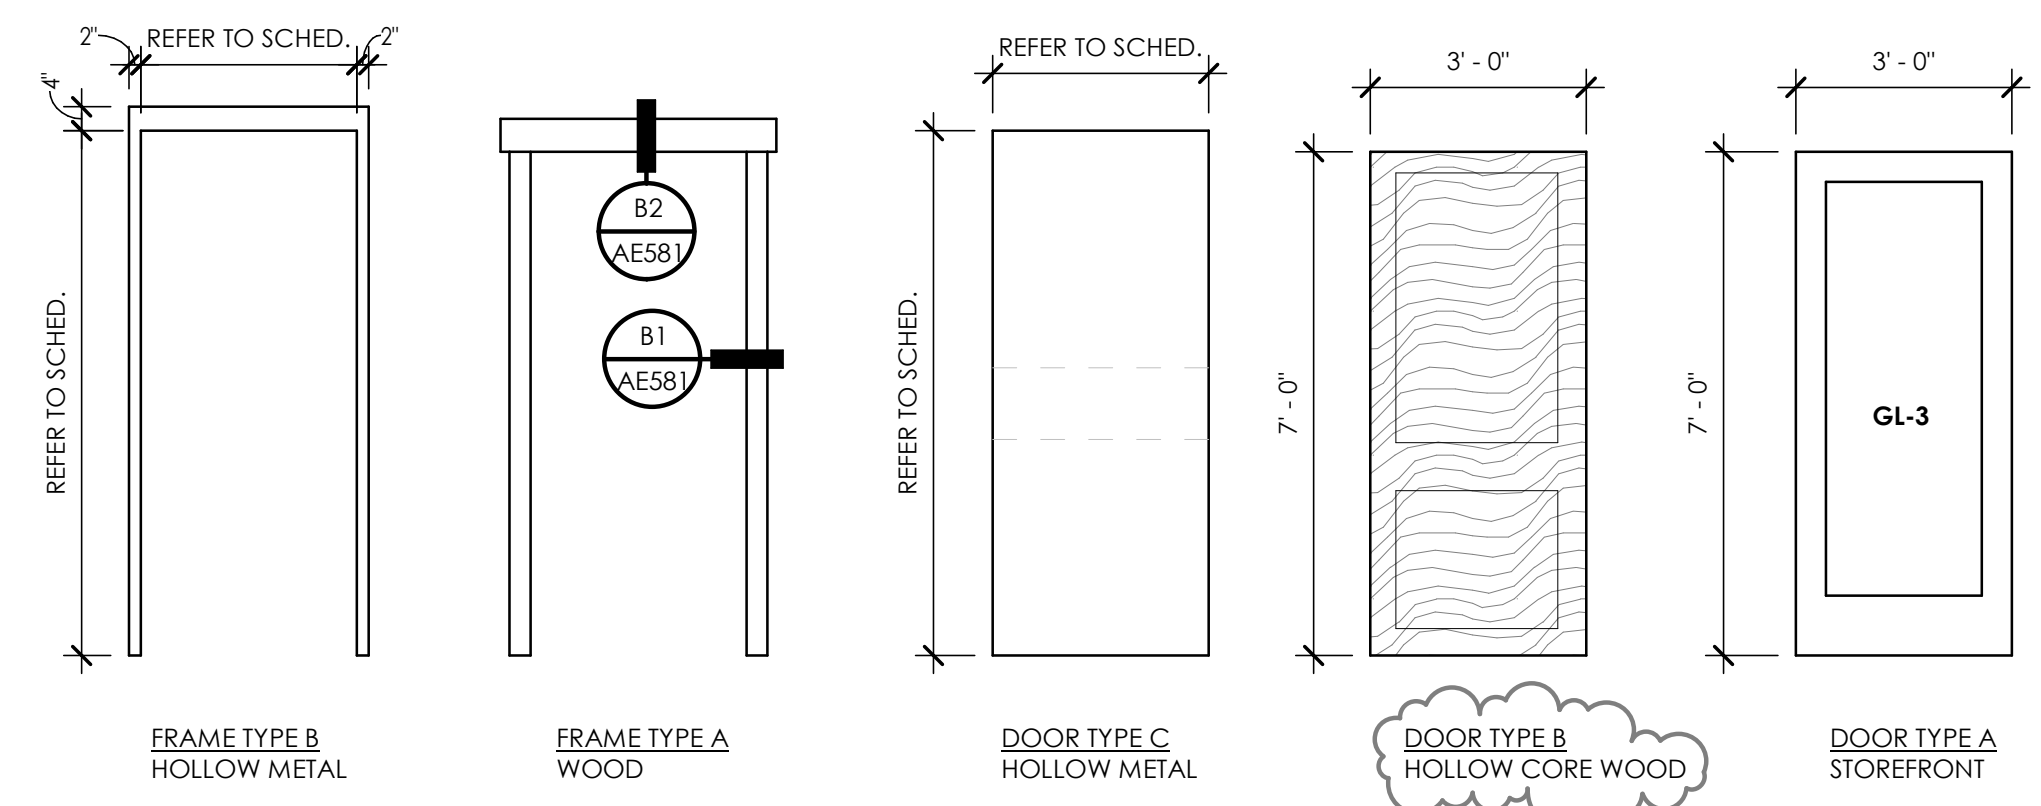

Consultant

**JONES & ASSOCIATES**  
 CONSULTING ENGINEERS  
 6080 S FASHION POINT DRIVE  
 SOUTH OGDEN, UT 84405

Issued		
No.	Date	Description
1	09.21.23	PLAN REVIEW
2	02.29.24	PLAN REVIEW

Revision		
No.	Date	Description
1	10.30.23	ADDENDUM #1
2	02.01.24	PLAN REVIEW/REDESIGN

SAA Project No. 2022-11  
 Drawing Title

**DOOR SCHEDULE, FRAME TYPES & OPENING DETAILS**

Sheet Number

**AE601**

Consultant

Project Name

Issued	No.	Date	Description
1	09.21.23	PLAN REVIEW	
2	02.29.24	PLAN REVIEW	














Revision	No.	Date	Description
1	10.30.23	ADDENDUM #1	
2	02.01.24	PLAN REVIEW/REDESIGN	

SA Project No. 2022-11  
Drawing Title

PARTITION TYPES

Sheet Number

**AE661**

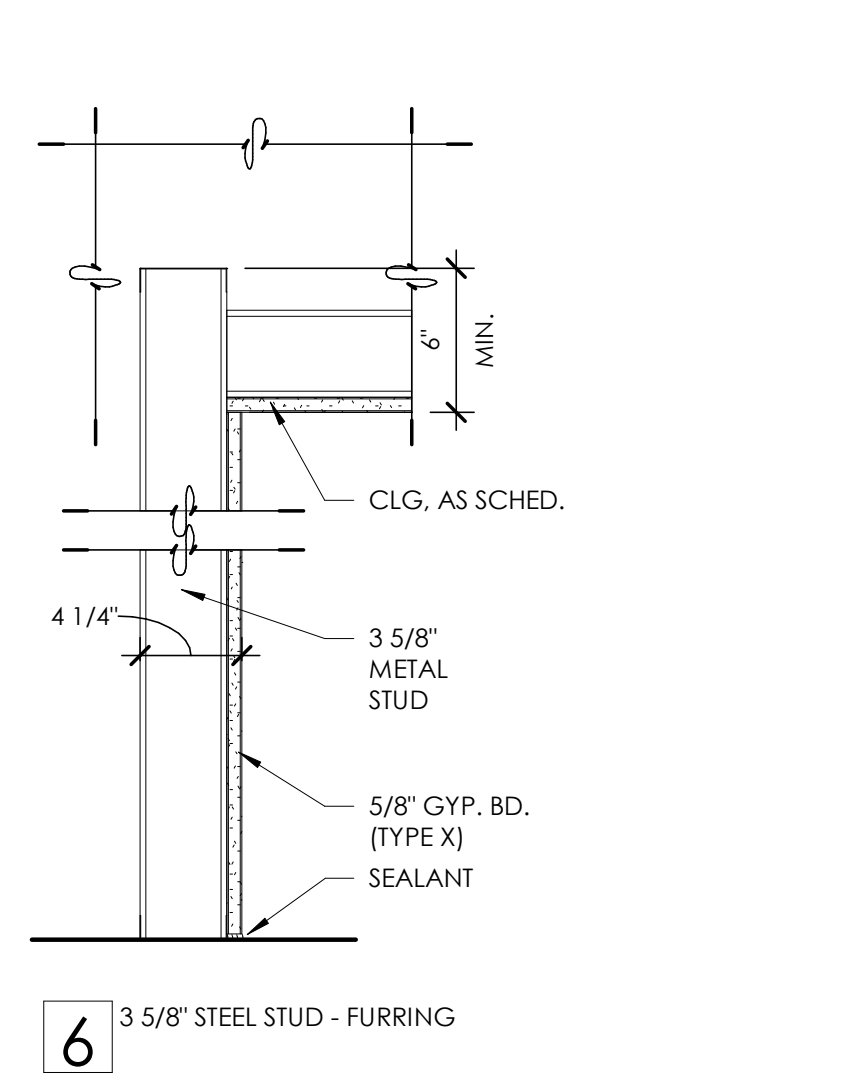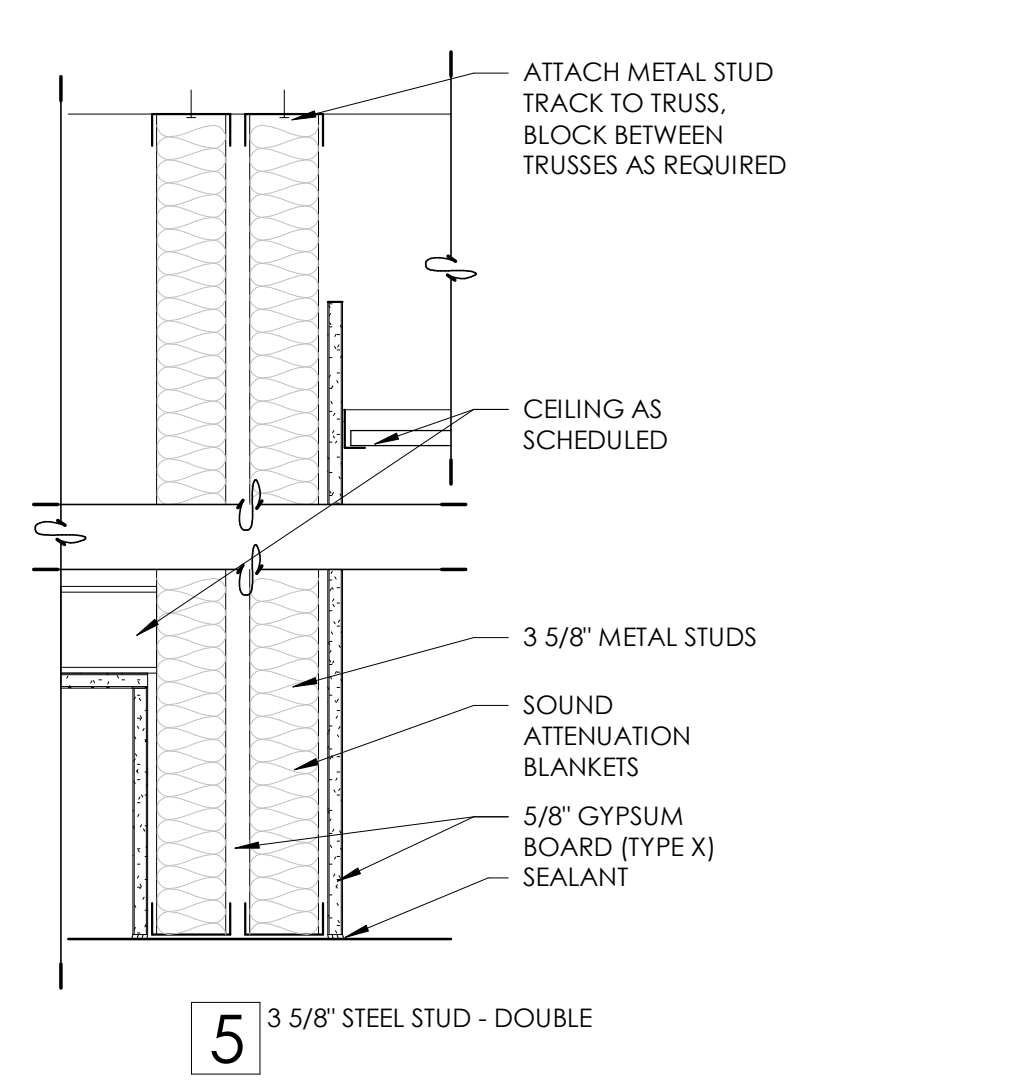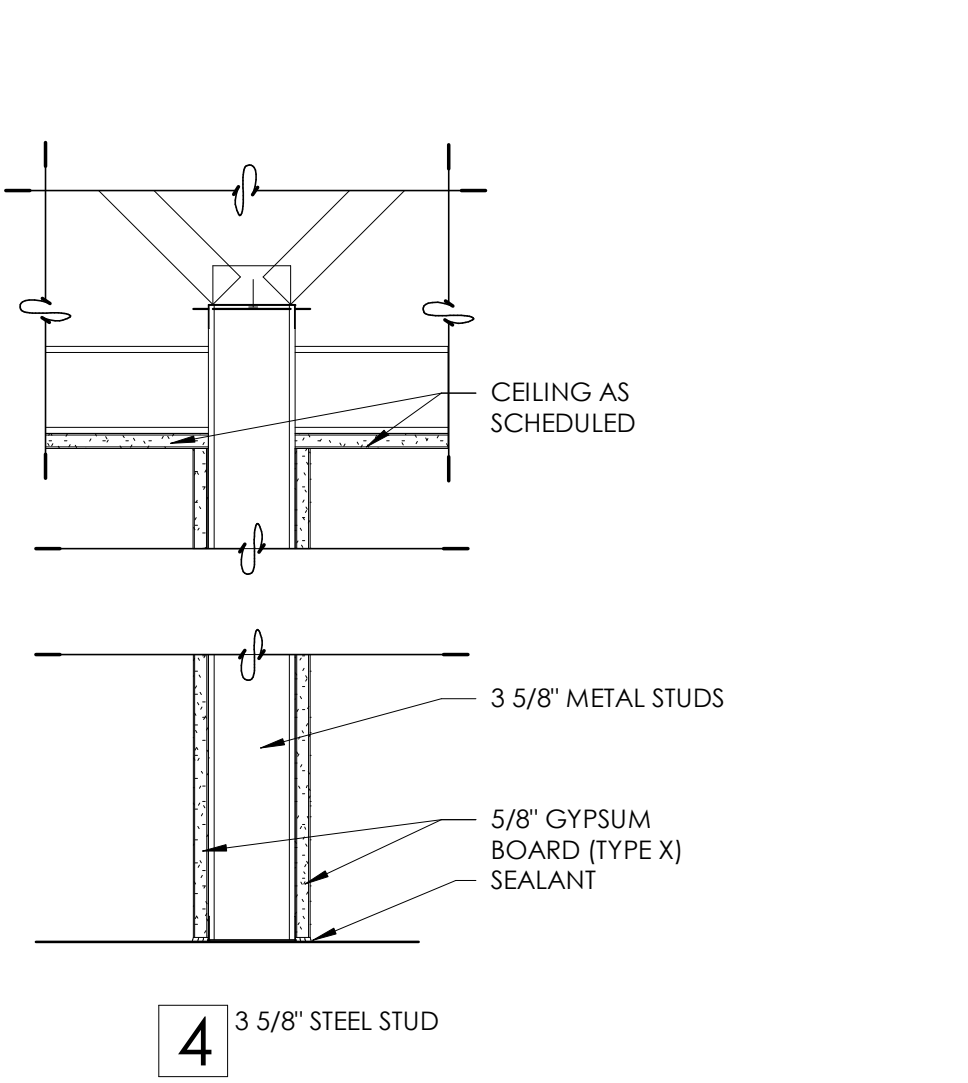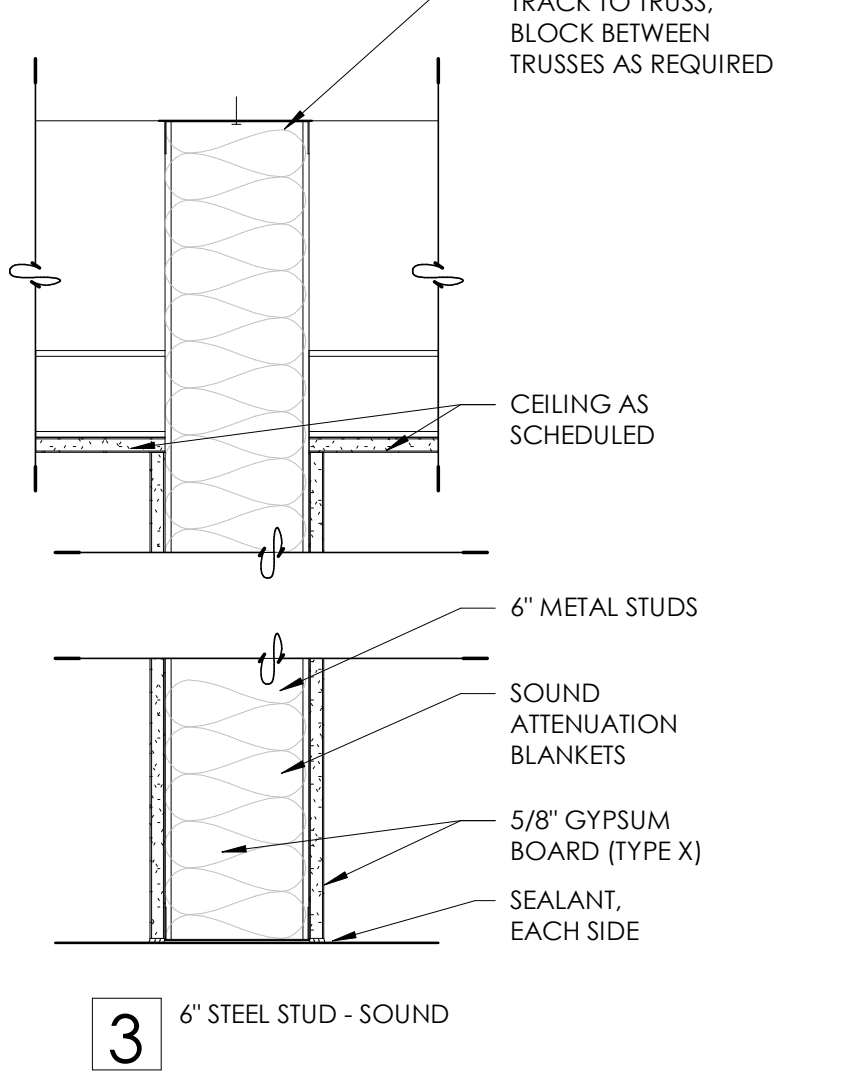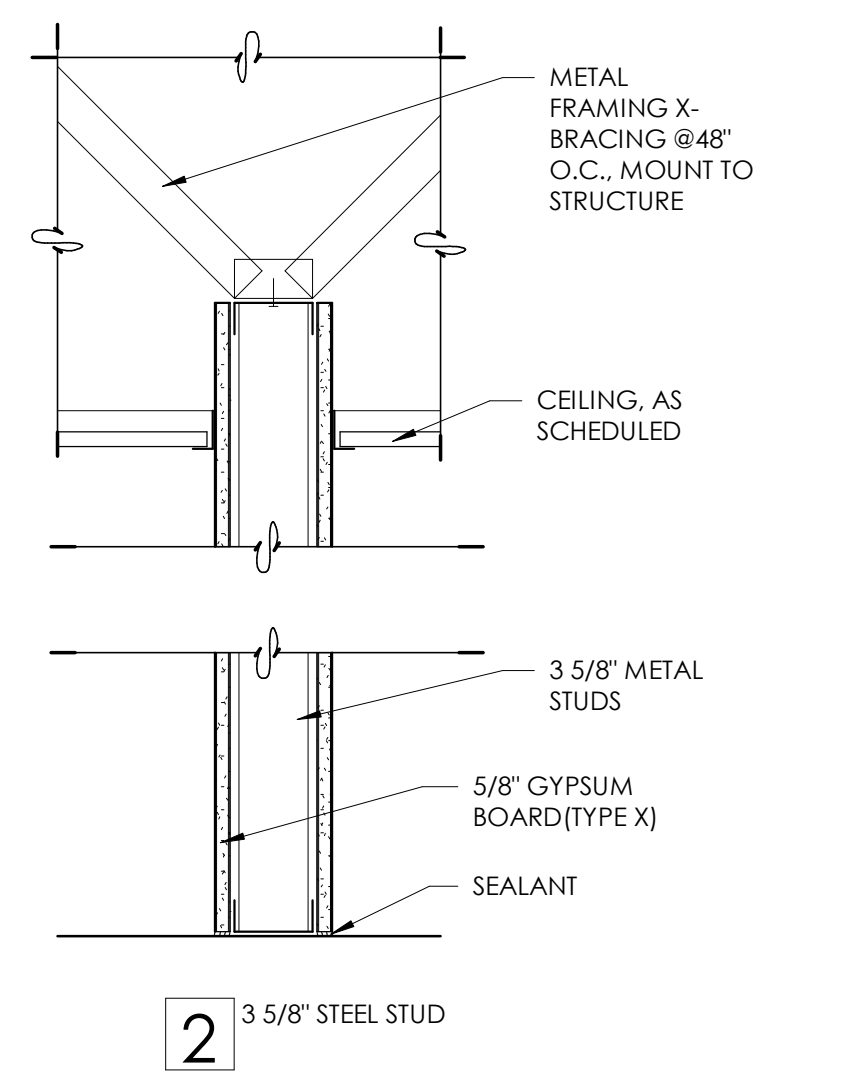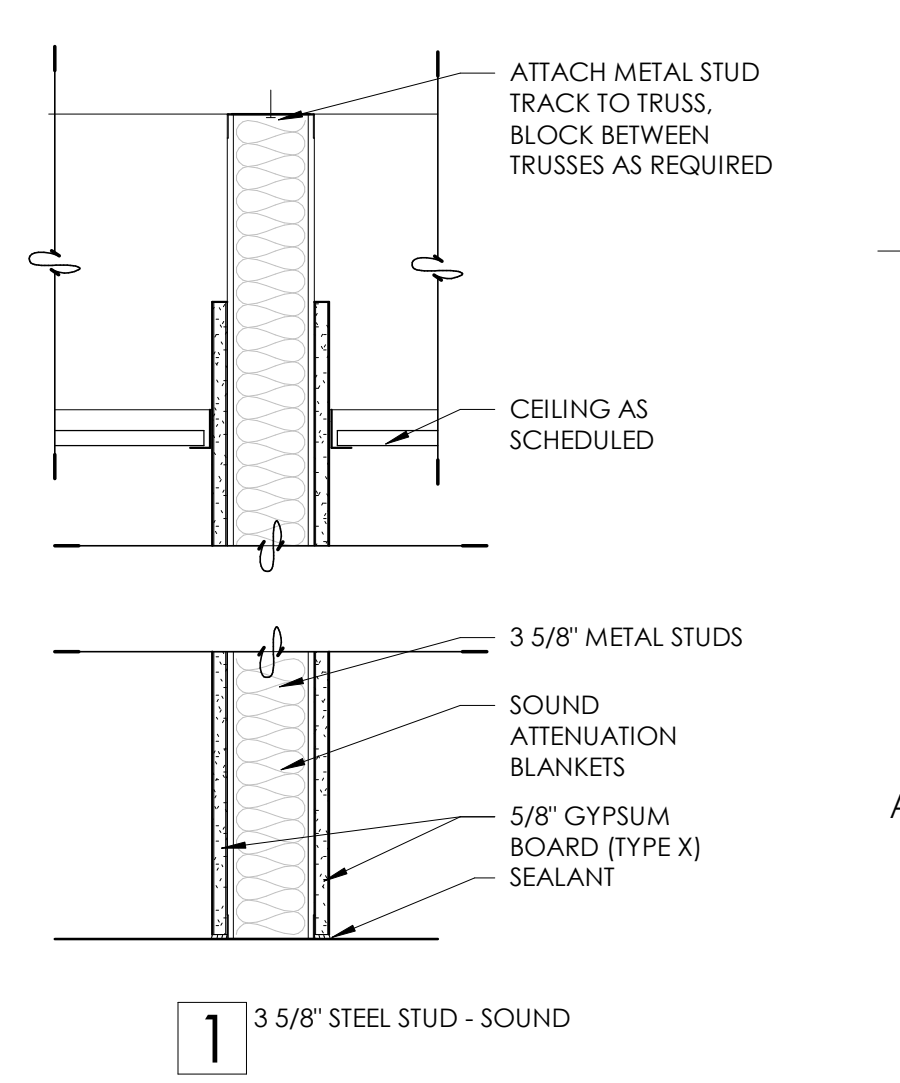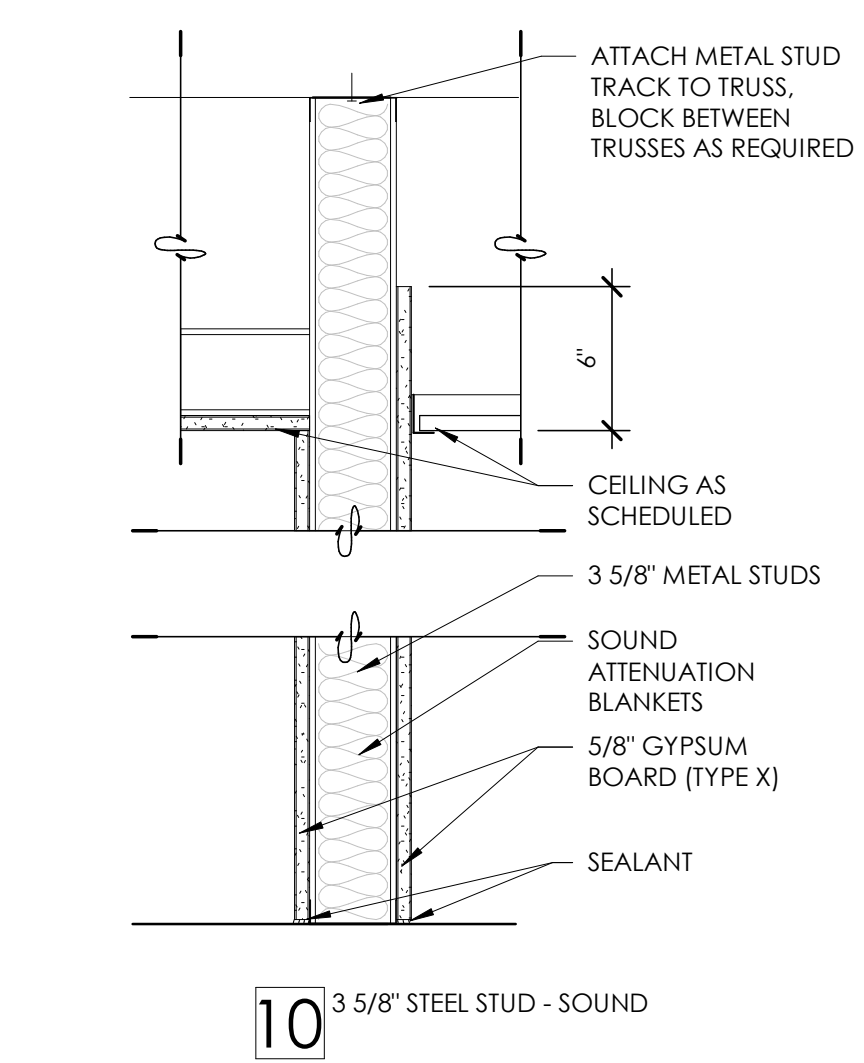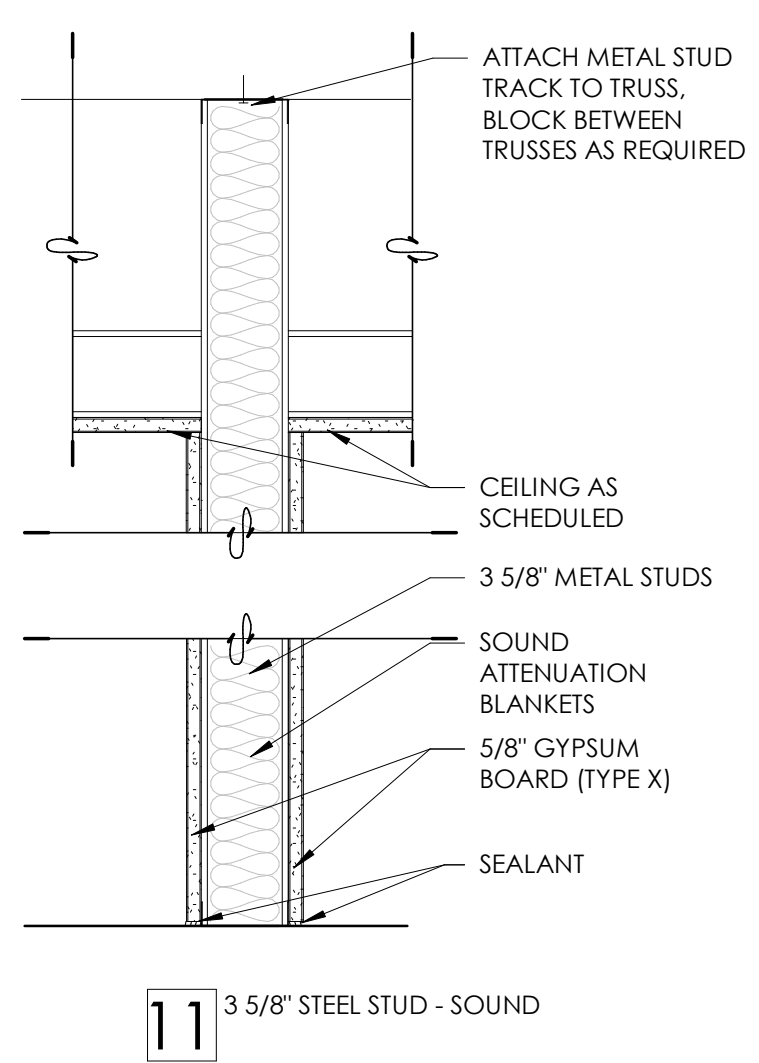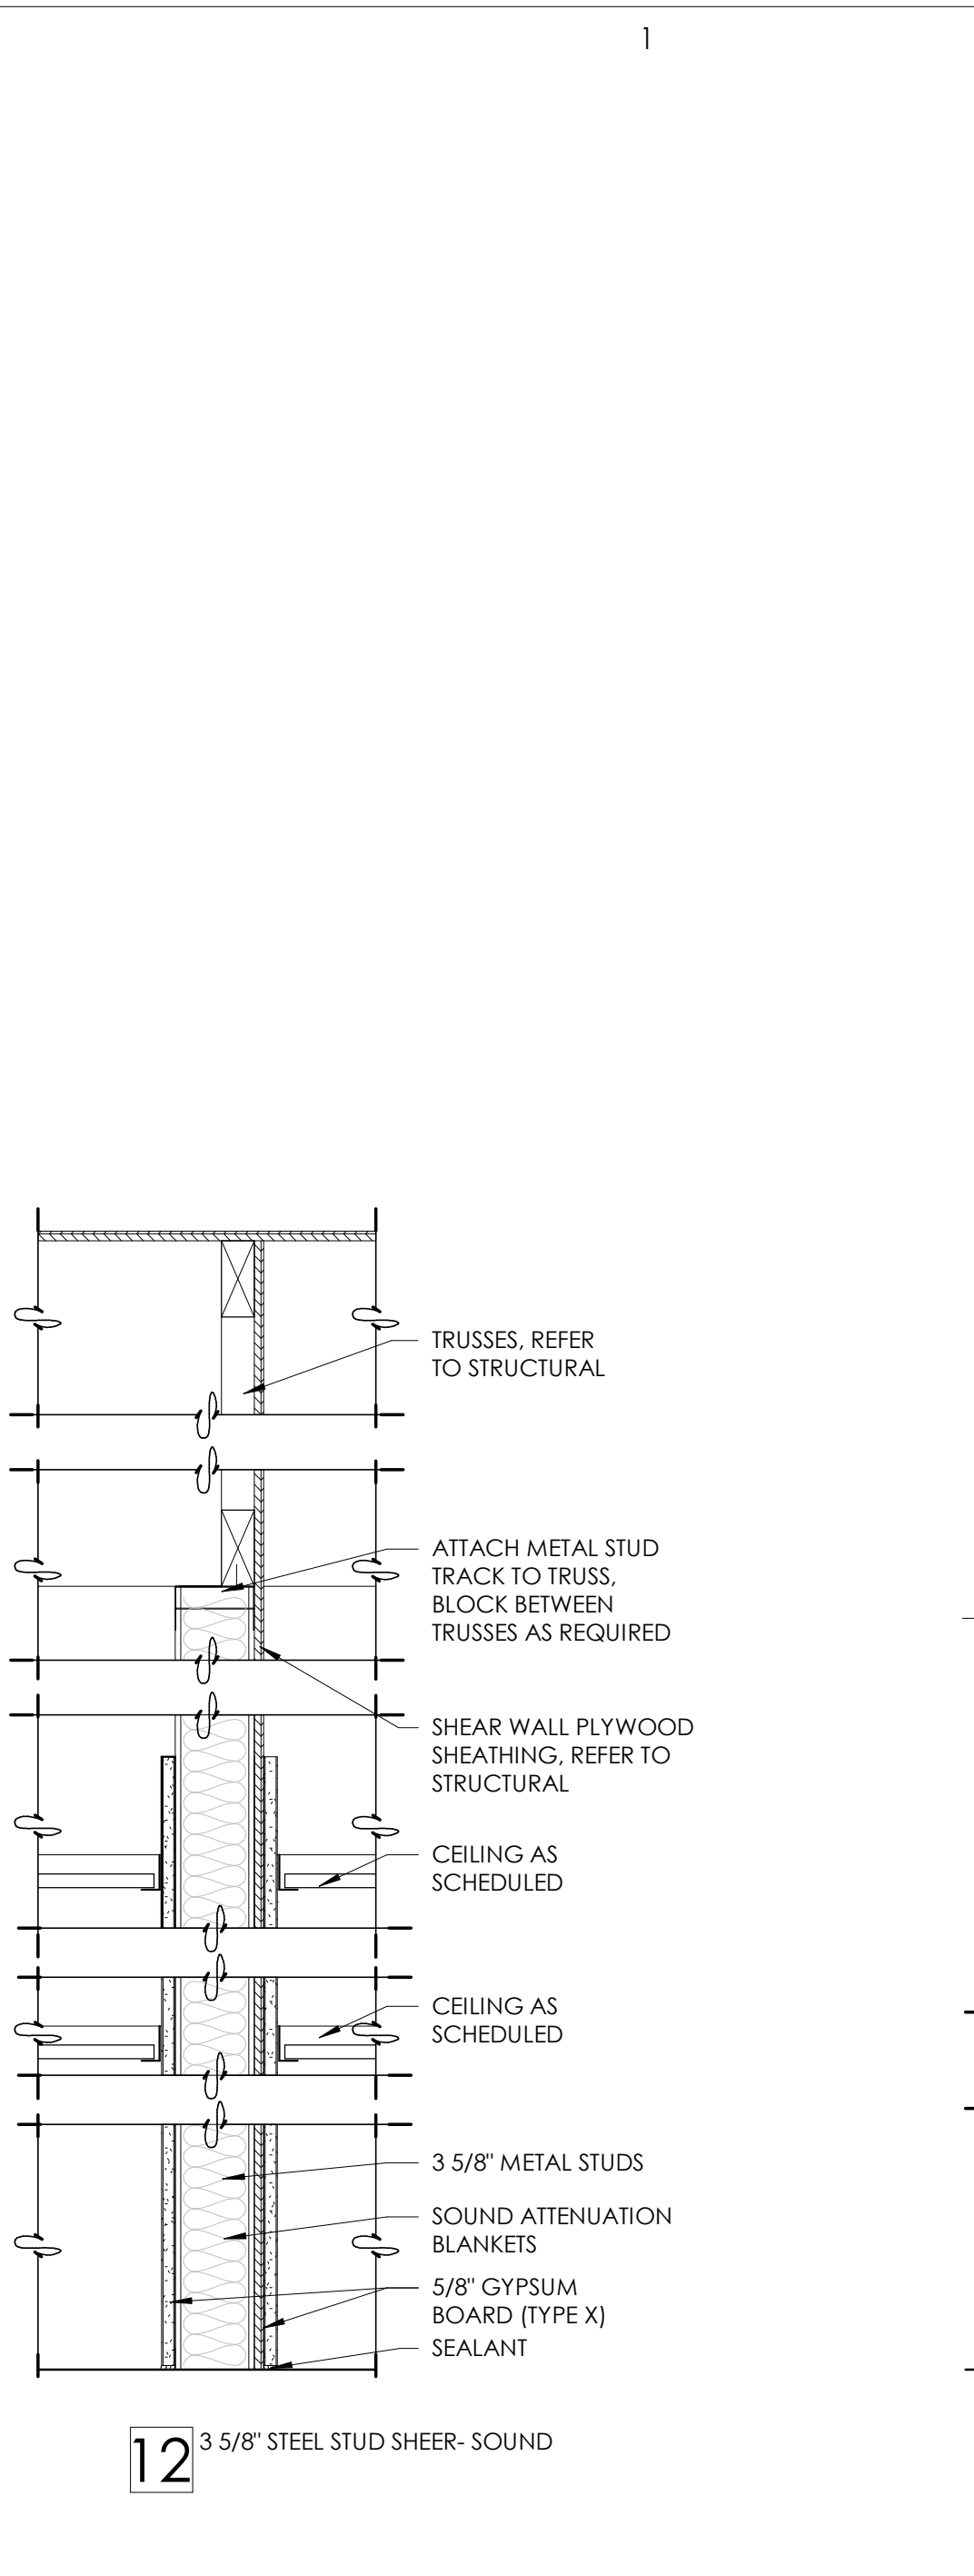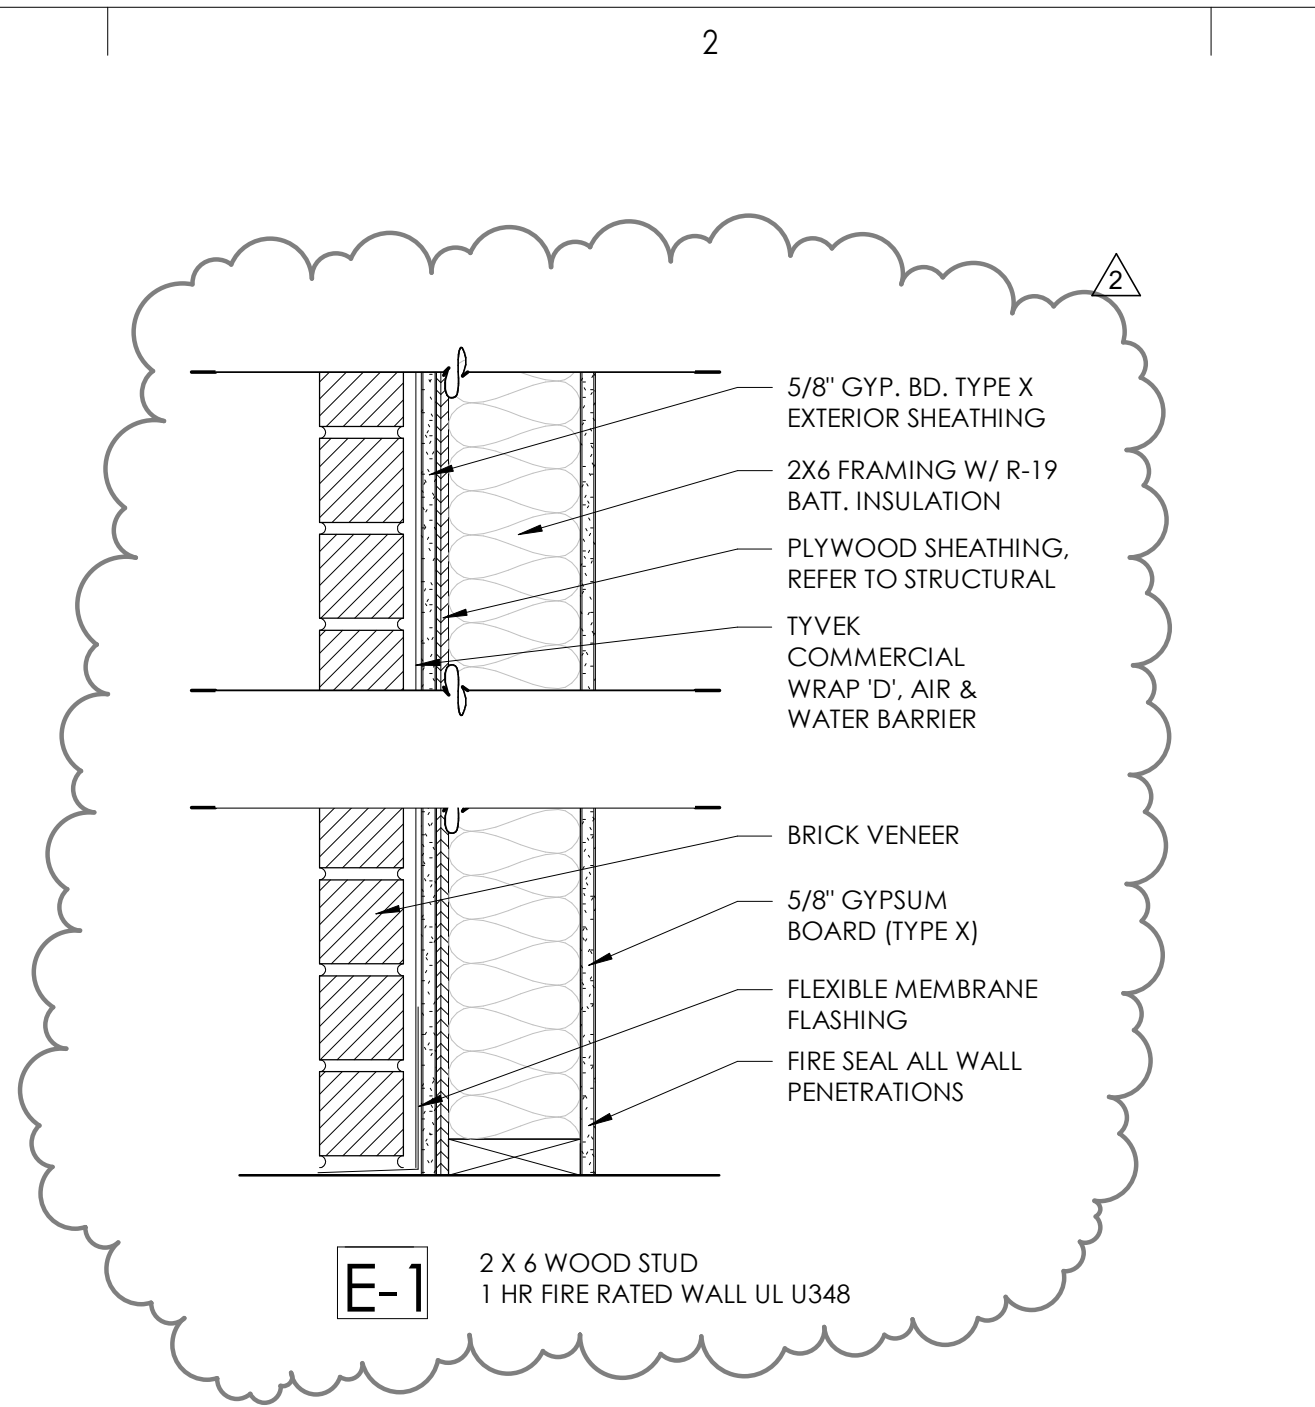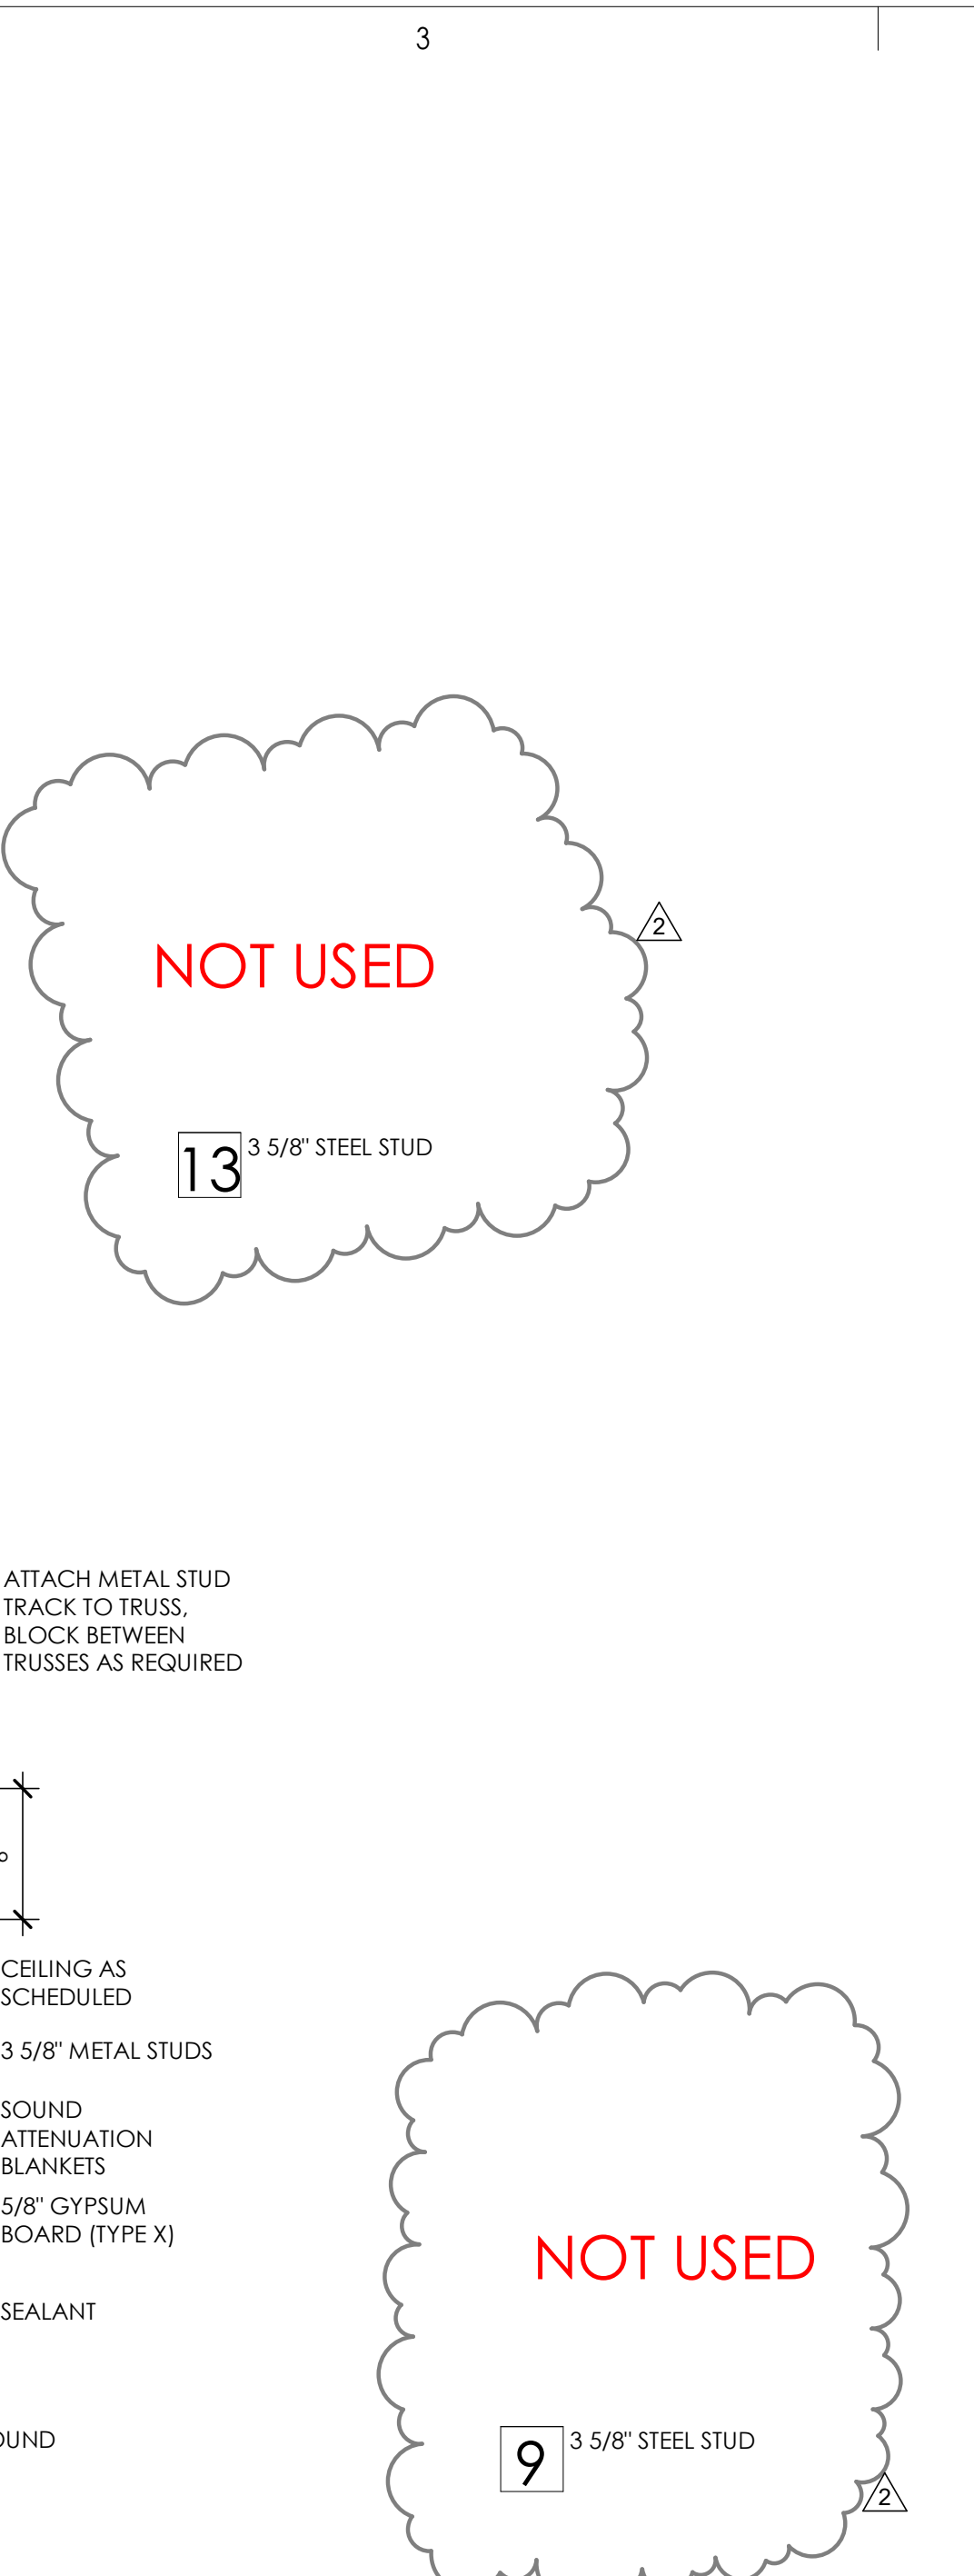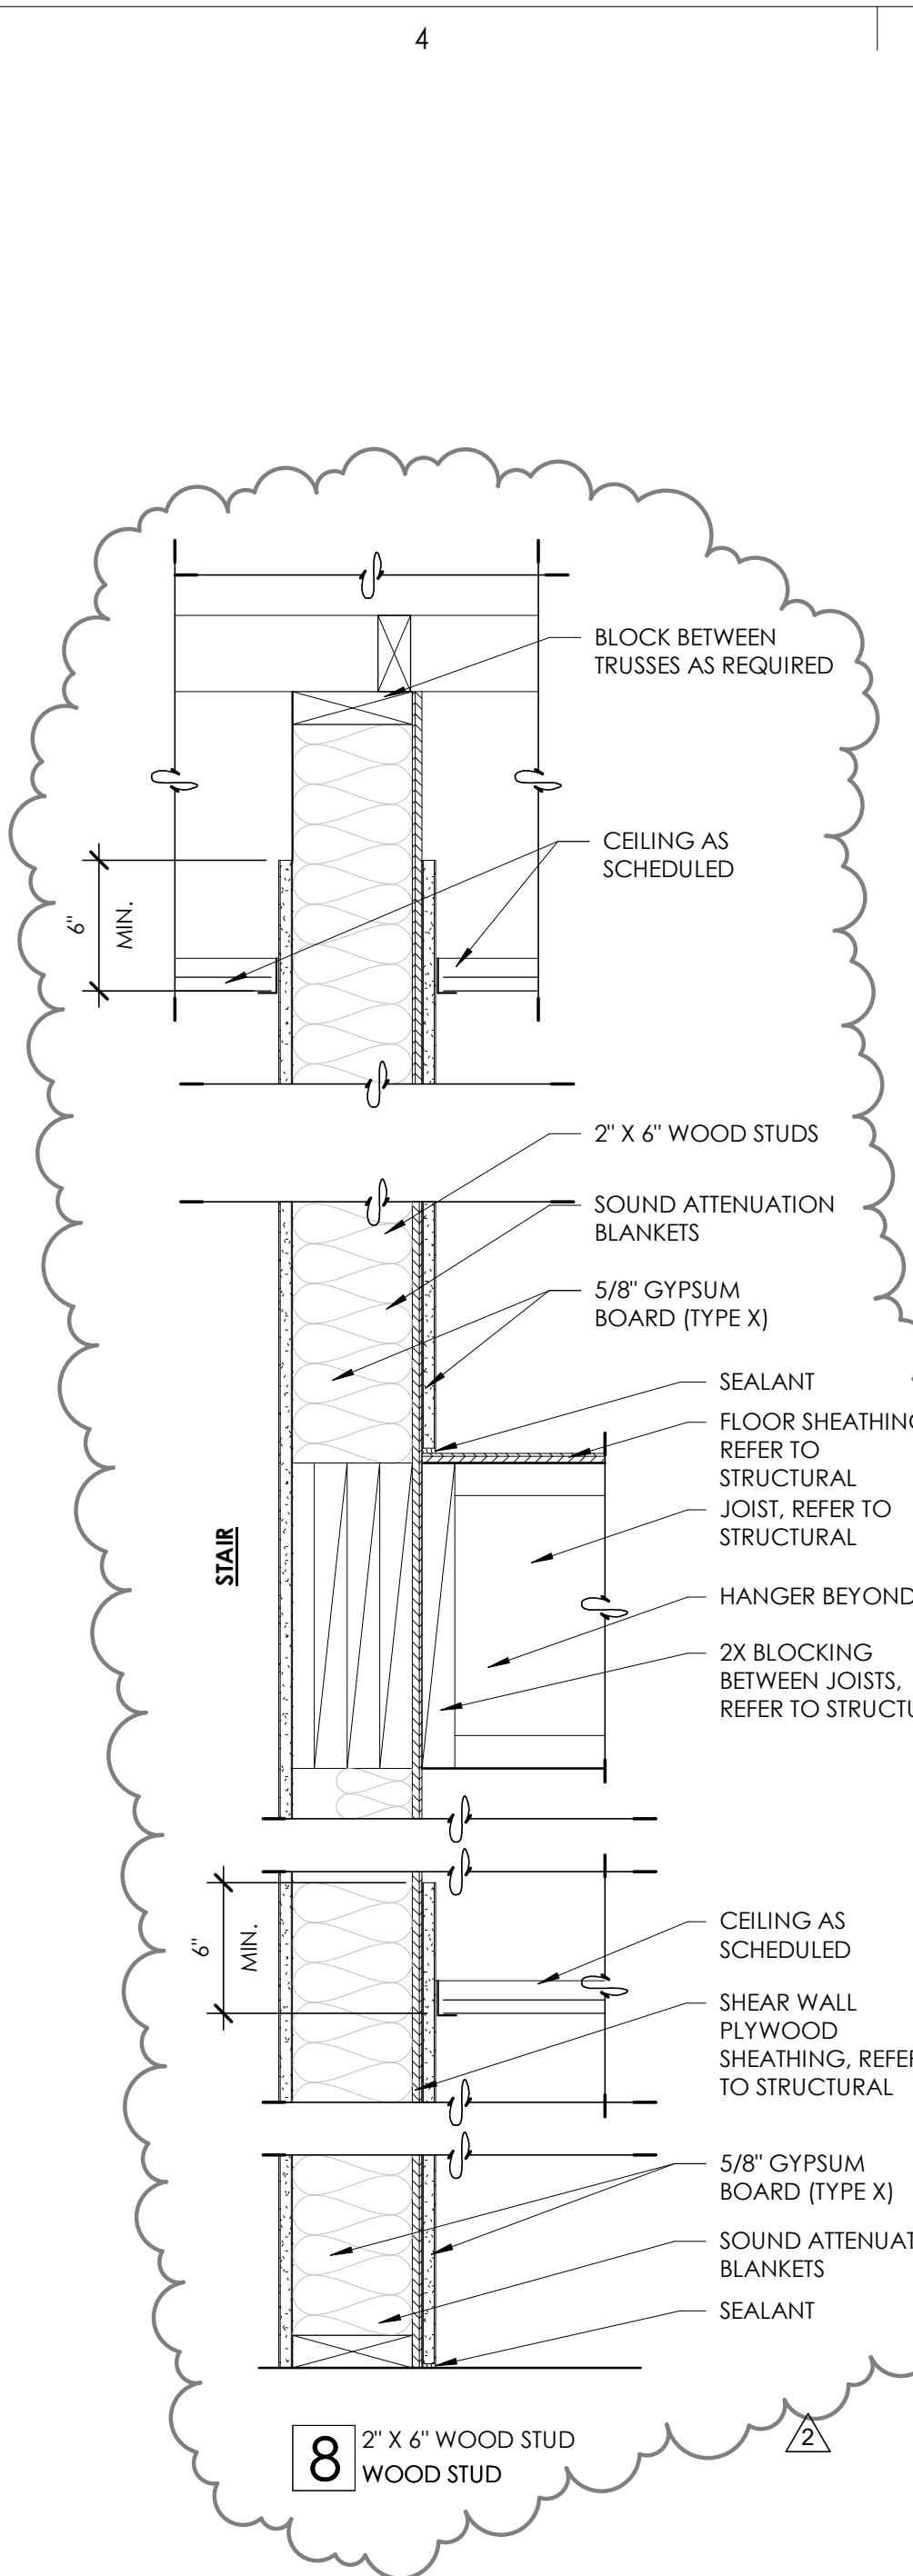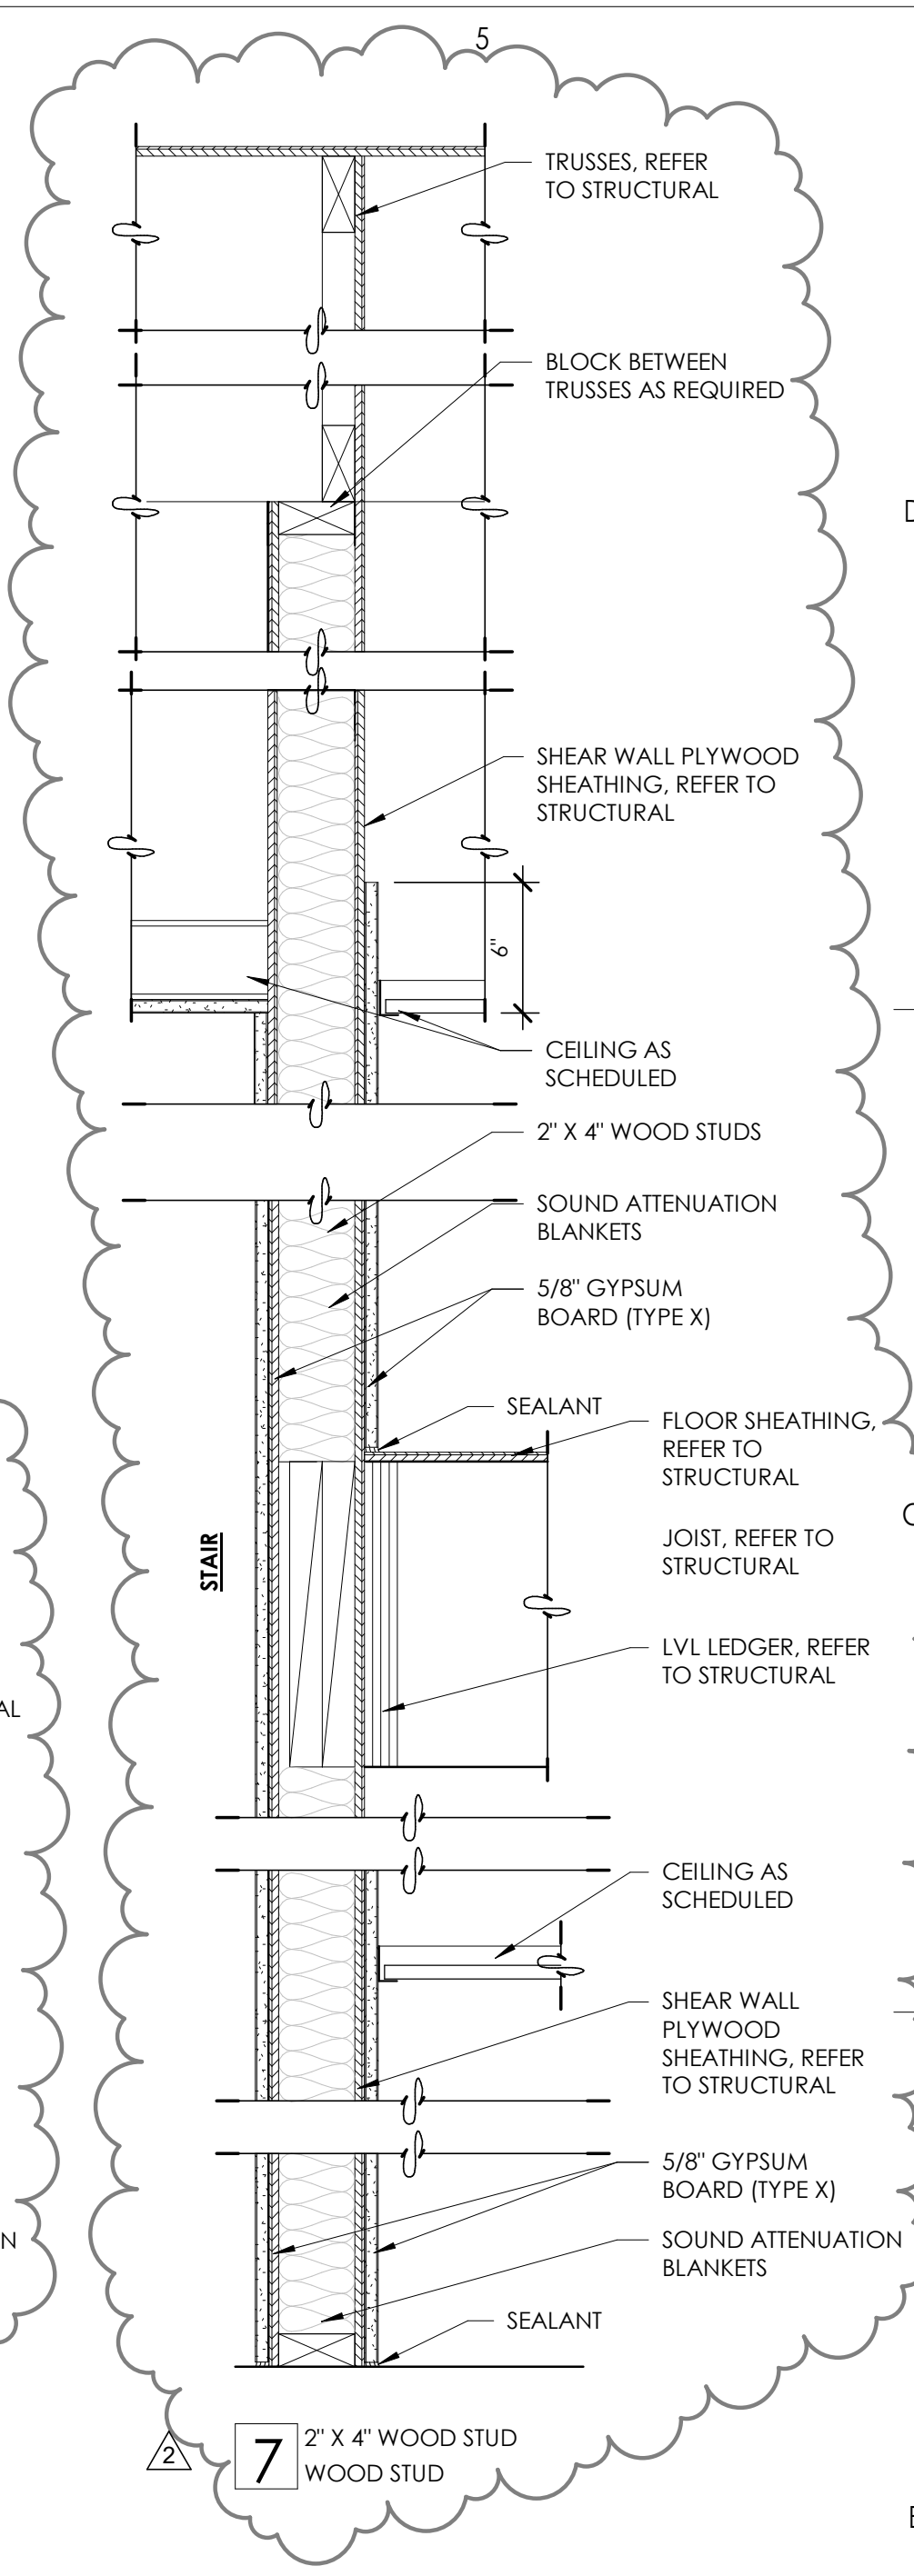




SOILS CONSTRUCTION (1705.6)			
TYPE	SPECIAL INSPECTION FREQUENCY		REMARKS
	CONT.	PERIODIC	
VERIFY MATERIALS BELOW SHALLOW FOUNDATIONS ARE ADEQUATE TO ACHIEVE THE DESIGN BEARING CAPACITY	--	X	VERIFY STRUCTURAL FILL IS PLACED (INCLUDING DEPTH AND LIFTS) IN CONFORMANCE WITH THE CONTRACT DRAWINGS (IF REQUIRED) OR THAT THE NATIVE GROUND MEETS THE ASSUMPTIONS OF THE GEOTECHNICAL REPORT AND CONTRACT DRAWINGS.
VERIFY EXCAVATIONS ARE EXTENDED TO PROPER DEPTH AND HAVE REACHED PROPER MATERIAL	--	X	VERIFY FROST DEPTH IS ACHIEVED AND FOOTING AND SLAB DEPTHS MEET THE REQUIREMENTS OF THE CONTRACT DRAWINGS WHERE INDICATED, INCLUDING FOOTING STEPS.
PERFORM CLASSIFICATION AND TESTING OF COMPACTED FILL MATERIALS	--	X	VERIFY FILL MATERIAL IS IN CONFORMANCE WITH THE SPECIFIED FILL MATERIAL TYPE
VERIFY USE OF PROPER MATERIALS, DENSITIES AND LIFT THICKNESSES DURING PLACEMENT AND COMPACTION OF COMPACTED FILL.	X	--	VERIFY FILL MATERIAL PLACED AND COMPACTED IN ACCORDANCE WITH THE SPECIFIED REQUIREMENTS; THE MAXIMUM LIFT THICKNESS AND THE IN-PLACE DRY DENSITY CONFORMS WITH THE DRAWINGS AND SPECIFICATIONS. WHEN A GEOTECHNICAL REPORT IS NOT PRESENT, IN-PLACE DRY DENSITY OF COMPACTED FILL SHALL BE NOT LESS THAN 90 PERCENT OF THE MAXIMUM DRY DENSITY AT OPTIMUM MOISTURE CONTENT DETERMINED IN ACCORDANCE WITH ASTM D1557
PRIOR TO PLACEMENT OF COMPACTED FILL, INSPECT SUBGRADE AND VERIFY THAT SITE HAS BEEN PREPARED PROPERLY.	--	X	VERIFY SITE PREPARATION MEETS SPECIFIED REQUIREMENTS, INCLUDING PROPER EXCAVATION DEPTH, REMOVAL OF ALL DELETERIOUS MATERIALS, AND ANY OTHER SPECIFIC REQUIREMENTS DEEMED NECESSARY BY THE SOILS ENGINEER.

CONCRETE CONSTRUCTION (1705.3)				
TYPE	SPECIAL INSPECTION FREQUENCY		REMARKS	REF. STANDARD
	CONT.	PERIODIC		
INSPECT REINFORCEMENT, INCLUDING PRESTRESSING TENDONS, AND VERIFY PLACEMENT.	--	X	VERIFY REINFORCING IS OF SPECIFIED TYPE, GRADE, AND SIZE; REQUIRED EMBEDMENT LENGTHS, LAP LENGTHS, AND SPLICES ARE ACHIEVED AND STAGGERED, OFFSET OR SPACED AS INDICATED; REINFORCEMENT IS FREE OF ICE, MUD, OIL, EXCESSIVE RUST OR OTHER DELETERIOUS MATERIAL; REINFORCING SPLICES ARE IN CONFORMANCE WITH THE CONTRACT DOCUMENTS OR THE MANUFACTURERS RECOMMENDATIONS (FOR MECHANICAL SPLICES); TIES, HOOKS, BENDS, AND SUPPLEMENTAL REINFORCING IS PROPERLY PLACED AND COVER TOLERANCES ARE ACHIEVED.	19C1908.4 ACI 318 CH. 20, 25.2, 25.3, 26.6.1-26.6.3
REINFORCING BAR WELDING:				
VERIFY WELDABILITY OF REINFORCING BARS OTHER THAN ASTM A706	--	X	VERIFY MILL TEST REPORT OF MATERIAL PROPERTIES FOR A706 BAR THAT DEMONSTRATE CONFORMANCE TO THE REQUIREMENTS OF AWS D1.4	AWS D1.4 ACI 318: 26.6.4
INSPECT SINGLE-PASS FILLET WELDS, MAXIMUM $\frac{1}{8}$ "		X		
INSPECT ALL OTHER WELDS	X			
INSPECT ANCHORS CAST IN CONCRETE	--	X	VERIFY PLACEMENT PRIOR TO AND DURING CONCRETE PLACEMENT. INSPECTION SHALL OCCUR FOR CONDITIONS THAT INCLUDE, BUT ARE NOT LIMITED TO, BRACED FRAMES, MOMENT FRAMES, TENSION HOLDDOWNS, CANTILEVERED COLUMNS.	ACI 318: 17.8.2
INSPECT ANCHORS POST-INSTALLED IN HARDENED CONCRETE MEMBERS				
ADHESIVE ANCHORS INSTALLED IN HORIZONTALLY OR UPWARDLY INCLINED ORIENTATIONS TO RESIST SUSTAINED TENSION LOADS.	X		INSPECTOR SHALL BE QUALIFIED AND SHALL VERIFY EMBEDMENT DEPTHS AND INSTALLATION PROCEDURES CONFORM TO MANUFACTURERS RECOMMENDATIONS	ACI 318: 17.8.2.4
MECHANICAL ANCHORS AND ADHESIVE ANCHORS NOT DEFINED ABOVE		X	VERIFY EMBEDMENT DEPTHS AND INSTALLATION PROCEDURES CONFORM TO MANUFACTURERS RECOMMENDATIONS	ACI 318: 17.8.2
VERIFY USE OF REQUIRED DESIGN MIX	--	X	VERIFY MIX DESIGN MEETS SPECIFIED STRENGTH AND EXPOSURE CLASS REQUIREMENTS	IBC 1904.1, 1904.2, 1908.2, 1908.3 ACI 318: CH. 19, 26.4.3, 26.4.4
PRIOR TO CONCRETE PLACEMENT, FABRICATE SPECIMENS FOR STRENGTH TESTS, PERFORM SLUMP AND AIR CONTENT TESTS, AND DETERMINE THE TEMPERATURE OF THE CONCRETE.	X	--	FABRICATE SPECIMENS IN ACCORDANCE WITH REFERENCED STANDARDS	IBC 1908.10 ASTM C172, ASTM C31, ACI 318: 26.5, 26.12
INSPECT CONCRETE AND SHOTCRETE PLACEMENT FOR PROPER APPLICATION TECHNIQUES.	X	--	VERIFY DEBRIS AND ICE IS REMOVED FROM SPACES TO BE OCCUPIED BY CONCRETE. PLACEMENT IS AT A RATE TO PROVIDE SUFFICIENT WORK TIMES AND TO AVOID SEGREGATION OR LOSS OF MATERIAL. VERIFY SUITABLE MEANS TO ACHIEVE PROPER CONSOLIDATION ARE USED.	IBC 1908.6, 1908.7, 1908.8 ACI 318: 26.5
VERIFY MAINTENANCE OF SPECIFIED CURING TEMPERATURE AND TECHNIQUES.	--	X	VERIFY CONCRETE MAINTAIN A TEMPERATURE OF AT LEAST 50°F FOR THE FIRST 7 DAYS UNLESS HIGH-EARLY-STRENGTH OR ACCELERATED CURING IS USED; FORMS, FILLERS, AND GROUND IS FREE FROM FROST AND ICE AND CONCRETE MATERIALS ARE PROTECTED FROM FREEZING AT TIME OF PLACEMENT AND CURING; ADEQUATE PROCEDURES ARE TAKEN TO LIMIT TEMPERATURES AND EVAPORATION DURING HOT WEATHER CONCRETE PLACEMENT.	IBC 1908.9 ACI 318: 26.5.3-26.5.5
VERIFY IN-SITU CONCRETE STRENGTH, PRIOR TO STRESSING OF TENDONS IN POST-TENSIONED CONCRETE AND PRIOR TO REMOVAL OF SHORES AND FORMS FROM BEAMS AND STRUCTURAL SLABS.	--	X	FORMWORK SHALL NOT BE REMOVED FROM BEAMS OR SLABS UNTIL AN ESTIMATE OF IN-PLACE CONCRETE STRENGTH HAS BEEN VERIFIED BY TESTING OR OTHER PROCEDURES	ACI 318: 26.11.2
INSPECT FORMWORK FOR SHAPE, LOCATION AND DIMENSIONS OF THE CONCRETE MEMBER BEING FORMED.	-	X	VERIFY FORMWORK IS BRACED OR TIED TOGETHER TO MAINTAIN POSITION AND SHAPE AND IS SUFFICIENTLY TIGHT TO INHIBIT LEAKAGE OF PASTE OR MORTAR	ACI 318: 26.11.1,2(b)

WOOD CONSTRUCTION (1705.5, 1705.11.1, 1705.12.2)				
TYPE	SPECIAL INSPECTION FREQUENCY		REMARKS	IBC REFERENCE
	CONT.	PERIODIC		
PREFABRICATED WOOD STRUCTURAL ELEMENTS				
SHOP FABRICATED TRUSSES	--	X	VERIFY THAT DETAILED FABRICATION AND QUALITY CONTROL PROCEDURES EXIST THAT PROVIDE A BASIS FOR INSPECTION CONTROL AND WORKMANSHIP WITH PERIODIC EVALUATION BY AN APPROVED AGENCY OR THE BUILDING OFFICIAL. THE FABRICATOR SHALL PROVIDE A CERTIFICATE OF COMPLIANCE UPON REQUEST	1704.2.5, 1705.5
WOOD DIAPHRAGMS AND WOOD SHEARWALLS INCLUDING NAILING, BOLTING, ANCHORING, AND OTHER FASTENING ELEMENTS WHICH ARE PART OF THE LATERAL FORCE RESISTING SYSTEM	--	X	VERIFY THE NOMINAL SIZE OF FRAMING MEMBERS AT ADJOINING PANEL EDGES; THE WOOD PANEL SHEATHING GRADE AND THICKNESS; NAIL OR STAPLE DIAMETER AND LENGTH; THE NUMBER OF FASTENER LINES AND THE SPACING BETWEEN FASTENERS IN EACH LINE; HOLD-DOWNS AND ANCHORS, ANCHOR BOLT SIZE AND SPACING, OTHER STRAP, DRAG STRUT, BRACE AND CLIP ELEMENTS AND OTHER COMPONENTS OF THE LATERAL FORCE LOAD PATH. NOTE: NOT REQUIRED WHEN EDGE FASTENER SPACING OF THE DIAPHRAGM OR SHEARWALL SHEATHING IS MORE THAN 4 INCHES ON CENTER	1705.5.1, 1705.11.1, 1705.12.2

STRUCTURAL OBSERVATIONS (1704.6) (NOT REQUIRED)	
STRUCTURAL OBSERVATIONS, WHEN REQUIRED, SHALL BE MADE BY THE ENGINEER OF RECORD OR BY A REGISTERED DESIGN PROFESSIONAL AS APPROVED BY THE ENGINEER OF RECORD. STRUCTURAL OBSERVATIONS DO NOT INCLUDE OR WAIVE THE RESPONSIBILITY FOR SPECIAL INSPECTIONS AS NOTED IN THESE DRAWINGS. THE FOLLOWING SECTIONS INDICATE STAGES OF CONSTRUCTION THAT THE STRUCTURAL OBSERVER SHALL BE NOTIFIED. AT THE CONCLUSION OF THE PROJECT, THE STRUCTURAL OBSERVER SHALL SUBMIT A WRITTEN STATEMENT TO THE BUILDING OFFICIAL INDICATING THAT SITE VISITS HAVE BEEN MADE AND IDENTIFY ANY REPORTED DEFICIENCIES THAT, TO THE BEST OF THE STRUCTURAL OBSERVERS KNOWLEDGE, HAVE NOT BEEN RESOLVED.	
CONTRACTOR TO NOTIFY ENGINEER OF RECORD AT THE FOLLOWING STAGES:	
CONCRETE	
FOOTINGS AND CONCRETE FOUNDATION WALLS	PRIOR TO POURING CONCRETE
WOOD	
WOOD SHEAR WALLS	PRIOR TO COVERING UP WALLS
WOOD ROOF SHEATHING	PRIOR TO COVERING UP WITH ROOFING
DEFERRED SUBMITTALS	
DEFERRED SUBMITTALS LISTED BELOW SHALL BE SUBMITTED TO THE ENGINEER OF RECORD, ARCHITECT, AND BUILDING OFFICIAL FOR THEIR REVIEW AND APPROVAL TO ENSURE CONFORMANCE TO THE DESIGN AND SPECIFICATIONS OF THE BUILDING.	
DEFERRED STRUCTURAL SUBMITTALS FOR THIS PROJECT ARE:	
PREFABRICATED METAL PLATE WOOD TRUSSES	

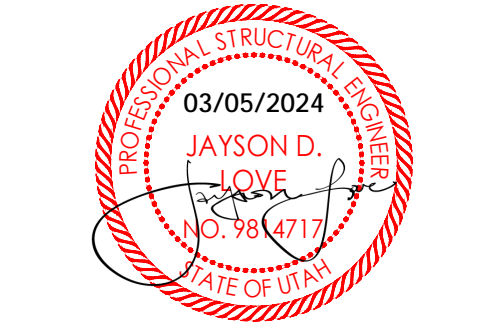

**JONES & ASSOCIATES**  
 CONSULTING ENGINEERS  
 6080 S FASHION POINT DRIVE  
 SOUTH OGDEN, UT 84405

Issued		
No.	Date	Description
1	09.21.23	PERMIT SET
2	02.29.23	PLAN REVIEW

Revision		
No.	Date	Description

SAA Project No. 2022-11  
 Drawing Title

SPECIAL INSPECTIONS

Sheet Number  
**S002**

CONCRETE FOOTING SCHEDULE												
MARK	WIDTH	LENGTH	THICK	REINFORCING CROSSWISE				REINFORCING LENGTHWISE				REMARKS
				NO.	SIZE #	LENGTH	SPACING	NO.	SIZE #	LENGTH	SPACING	
FC2.0	2'-0"	CONT.	12"	NONE	--	--	--	2	#5	CONT.	EVEN	TOP AND BOTTOM
FC4.0	4'-0"	CONT.	24"	REQD	#5	3'-6"	12"	4	#5	CONT.	EVEN	TOP AND BOTTOM
FS3.0	3'-0"	3'-0"	12"	3	#5	2'-6"	EVEN	3	#5	2'-6"	EVEN	
FS4.0	4'-0"	4'-0"	12"	4	#5	3'-6"	EVEN	4	#5	3'-6"	EVEN	
FS5.0	5'-0"	5'-0"	14"	5	#5	4'-6"	EVEN	5	#5	4'-6"	EVEN	

NOTES:  
 1. PLACE ALL FOOTINGS REINFORCING 3" FROM BOTTOM OF FOOTING WITH 3" CLEAR ON SIDES UNLESS NOTED OTHERWISE.  
 2. FOOTINGS MUST BEAR ON COMPACTED STRUCTURAL FILL AS INDICATED IN THE GEOTECHNICAL REPORT.


CONCRETE PIER SCHEDULE					
MARK	PIER SIZE	VERTICAL REINFORCEMENT	STRUCTURAL TIES	STYLE	COMMENTS
CP24X24	24"X24"	(12) #5	#3 AT 8" O.C. WITH (3) TIES IN THE TOP 5 INCHES		

**NOTES AND SYMBOLS LEGEND**

- XX  
SXXX INDICATES DETAIL REFERENCE NUMBER
- FX.X  
XX.X INDICATES SHEET REFERENCE NUMBER
- CP-X INDICATES CONCRETE PIER, SEE CONCRETE PIER SCHEDULE ON THIS SHEET.
- CW-XX INDICATES CONCRET WALL, SEE CONCRETE WALL SCHEDULE ON SHEETS S601
- FCXX INDICATES CONTINUOUS FOOTING CALLOUT, SEE FOOTING SCHEDULE ON THIS SHEET
- FSX.X INDICATES SPOT FOOTING CALLOUT, SEE FOOTING SCHEDULE ON THIS SHEET
- INDICATES DEPRESSED FOUNDATION AT OPENINGS
- S S INDICATES STEP IN FOOTING, SEE TYPICAL FOOTING STEP DETAIL 1/S501
- INDICATES STEP IN FLOOR ELEVATION AS INDICATED ON PLAN
- X INDICATES HOLDDOWN ANCHOR OR STRAP, SEE SCHEDULE ON SHEET S601


**FOOTING AND FOUNDATION NOTES**

1. COORDINATE LOCATION OF SLOPED SLABS, DEPRESSED, SLABS, FLOOR DRAINS, ETC. WITH ARCHITECTURAL AND MECHANICAL DRAWINGS. SEE ARCHITECTURAL DRAWINGS FOR DIMENSIONS TO ALL STEEL COLUMN.
2. SEE ARCHITECTURAL AND CIVIL DRAWINGS FOR EXTERIOR CONCRETE WORK AT DOORS SIDEWALKS, ETC.
3. SEE ARCHITECTURAL DRAWINGS FOR CONTROL JOINT LOCATIONS. REFER TO DETAIL 8/S501 FOR CONTROL JOINT REQUIREMENTS AND SHEET S001.
4. SEE FOUNDATION AND EARTHWORK NOTES ON SHEET S001 FOR MINIMUM FILL REQUIRED BENEATH FOOTINGS.
5. SEE DETAIL 2/S501 AND 3/S501 FOR CONDITION WHERE BURIED PIPES RUN PARALLEL AND PERPENDICULAR TO FOOTINGS.
6. SEE DETAIL 4/S501 FOR TYPICAL CONCRETE WALL CORNER REINFORCING ANCHOR BOLT SIZE AND SPACING FOR BEARING WALLS (NON-SHEAR WALLS) SHALL BE 5/8" DIA. AT 32" O.C.
7. SEE DETAIL 5/S501 FOR SLAB REINFORCING WHERE CONTROL JOINTS ARE DISCONTINUOUS.
8. CARRY ALL COLUMN LOADS DOWN TO FOOTING OR FOUNDATION WALL. SEE SHEET S601 FOR TYPICAL CONCRETE WALL SCHEDULE
9. ALL EXTERIOR WOOD WALLS TO BE SHEATHED PER SW-1 IN THE SHEARWALL SCHEDULE SHOWN ON SHEET S601 UNLESS NOTED OTHERWISE.
10. ALL FOUNDATION WALLS SHALL BE CW-10A, SEE SCHEDULE ON SHEET S601

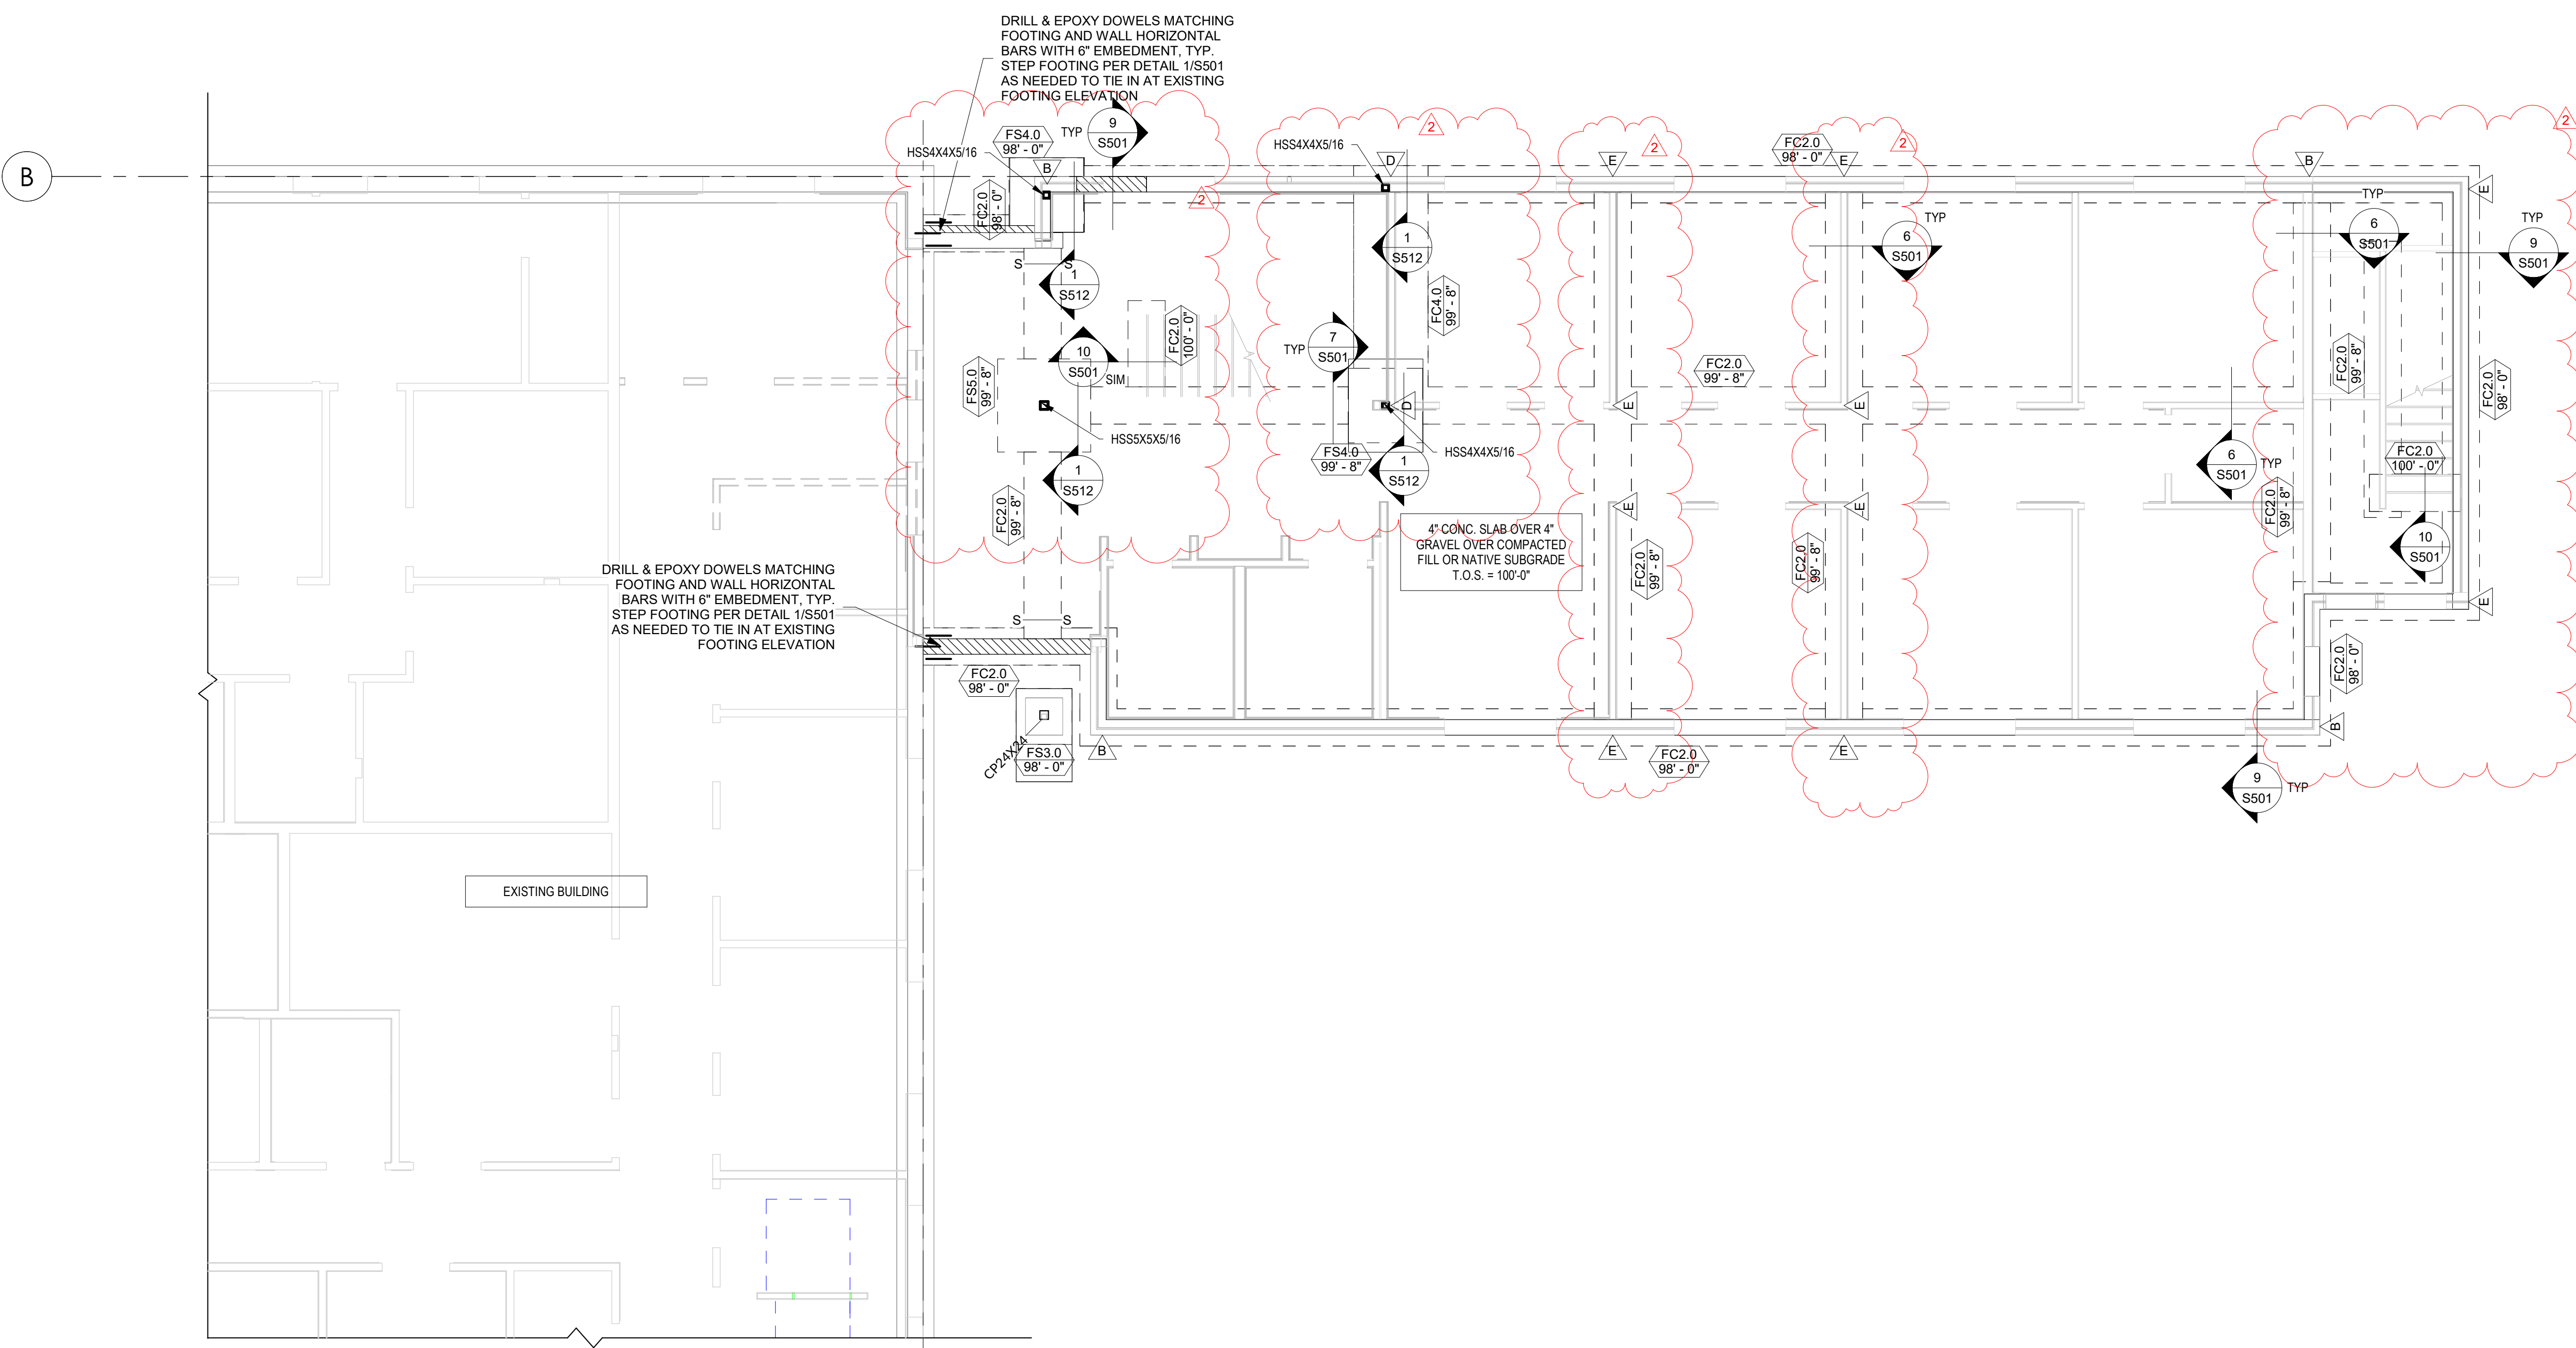

**FOOTING AND FOUNDATION PLAN**  
 SCALE: 3/16" = 1'-0"

1  
S101

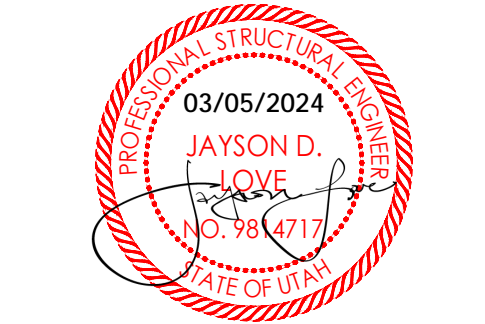

**JONES & ASSOCIATES**  
 CONSULTING ENGINEERS  
 6080 S FASHION POINT DRIVE  
 SOUTH OGDEN, UT 84405

Project Name

No.	Date	Description
1	09.21.23	PERMIT SET
2	02.29.23	PLAN REVIEW

No.	Date	Description
1	10.30.23	ADDENDUM #1
2	02.29.23	PLAN REVIEW/REDESIGN

SAA Project No. 2022-11  
 Drawing Title

**FOOTING FOUNDATION PLAN**

Sheet Number

**S101**

**NOTES AND SYMBOLS LEGEND**


- XX INDICATES DETAIL REFERENCE NUMBER
- SXXX INDICATES SHEET REFERENCE NUMBER
- FB-X INDICATES FLOOR BEAM, SEE FLOOR BEAM SCHEDULE THIS SHEET
- HDR INDICATES WOOD HEADER, SEE HEADER SCHEDULE ON SHEET 5602
- (X) B INDICATES MINIMUM NUMBER OF BEARING STUDS REQUIRED FOR BUILT UP POST, MATCH STUD DEPTH WITH WALL STUD DEPTH, ALL POSTS, AND BUILT UP POSTS SHALL EXTEND TO THE FOUNDATION (UNO) SEE DETAIL 4/5521 IF GREATER NUMBER OF BEARING STUDS IS REQUIRED BY HOLDDOWN POST, THAT NUMBER OF STUDS SHALL BE USED, THEY NEED NOT BE ADDITIVE.
- X INDICATES HOLDDOWN, SEE SCHEDULE ON SHEET 5601

**FLOOR FRAMING NOTES**

1. VERIFY ALL FLOOR OPENINGS FOR MECHANICAL SHAFTS, STAIRS, ETC. WITH ARCHITECTURAL AND MECHANICAL DRAWINGS.
2. SEE ARCHITECTURAL DRAWINGS FOR DIMENSIONS TO ALL STEEL COLUMNS.
3. FLOOR SHEATHING SHALL BE T&G GLUED AND NAILED WITH 10d NAILS AT 6" O.C. AT ALL PANEL ENDS, SUPPORTED EDGES AND ALL BLOCKING; 10d NAILS AT 12" O.C. ALONG INTERMEDIATE FRAMING MEMBERS. GLUE WITH GLUE CONFORMING TO AFG-01 ACCORDING TO APA SPECIFICATIONS. SEE SCHEDULE ON SHEET 5602.
4. BLOCK JOISTS SOLID AT ALL BEARING POINTS.
5. ALL INTERIOR BEARING WALLS AND SHEARWALL 3.5/8" METAL STUDS 362S162-33 AT 16" O.C. WITH 362T150-33 TOP AND BOTTOM TRACKS WITH BRIDGING AT MID HEIGHT (UNO).
6. ALL EXTERIOR BEARING WALLS AND SHEARWALL ARE 2X6 AT 16" O.C. (UNO)
7. PROVIDE SQUASH BLOCKING AT ALL POINT LOADS THROUGH FLOOR
8. ALL LVL BEAMS SHALL BE 2.0E AND 1-3/4" WIDE UNO
9. CONNECT 4-PLY AND GREATER BEAMS WITH (2) ROWS 1/2" THRU BOLTS @ 12" O.C. (SEE MANUFACTURERS SPECIFICATIONS).
10. CARRY ALL COLUMN LOADS DOWN TO FOOTING OR FOUNDATION WALL.
11. PROVIDE SOLID BLOCKING OR SQUASH BLOCKS IN JOIST SPACE AT ALL COLUMN LOCATIONS.
12. SEE "MINIMUM NAILING" SCHEDULE ON SHEET 5602 FOR TYPICAL NAILING FOR VARIOUS FRAMAING CONDITIONS.
13. SEE DETAIL 4/5521 FOR TYPICAL MULTI-PLY HEADERS, JAMBS, POSTS, AND BEAMS (UNO).
14. SEE DETAIL 1/5521 FOR TYPICAL TOP PLATE SPLICE AT PIPE.
15. SEE DETAIL 2/5521 FOR TYPICAL TOP PLATE LAP SPLICE DETAIL
16. SEE DETAIL 3/5521 FOR TYPICAL OPENINGS IN ROOF/FLOOR TRUSSES/JOISTS.
17. SEE DETAIL 5/5521 FOR HEADERS GREATER THAN 6'-0".
18. SEE VENEER LINTEL SCHEDULE ON SHEET 5601 FOR STEEL LINTELS AT OPENINGS IN MASONRY VENEER.
19. SEE WOOD HEADER BEARING SCHEDULE ON SHEET 5601 FOR TYPICAL HEADER SIZES AND BEARING AND KING STUD REQUIREMENTS.
20. SEE DETAILS 6 AND 7 OF SHEET 5521 FOR TYPICAL BEAM CONNECTIONS


**FLOOR BEAM SCHEDULE**

MARK	TYPE
FB-1	(3) 1.34" x 14" LVL
FB-2	(2) 1.34" x 14" LVL
FB-3	(3) 1.34" x 16" LVL
FB-4	(2) 1.34x11 7/8 LVL

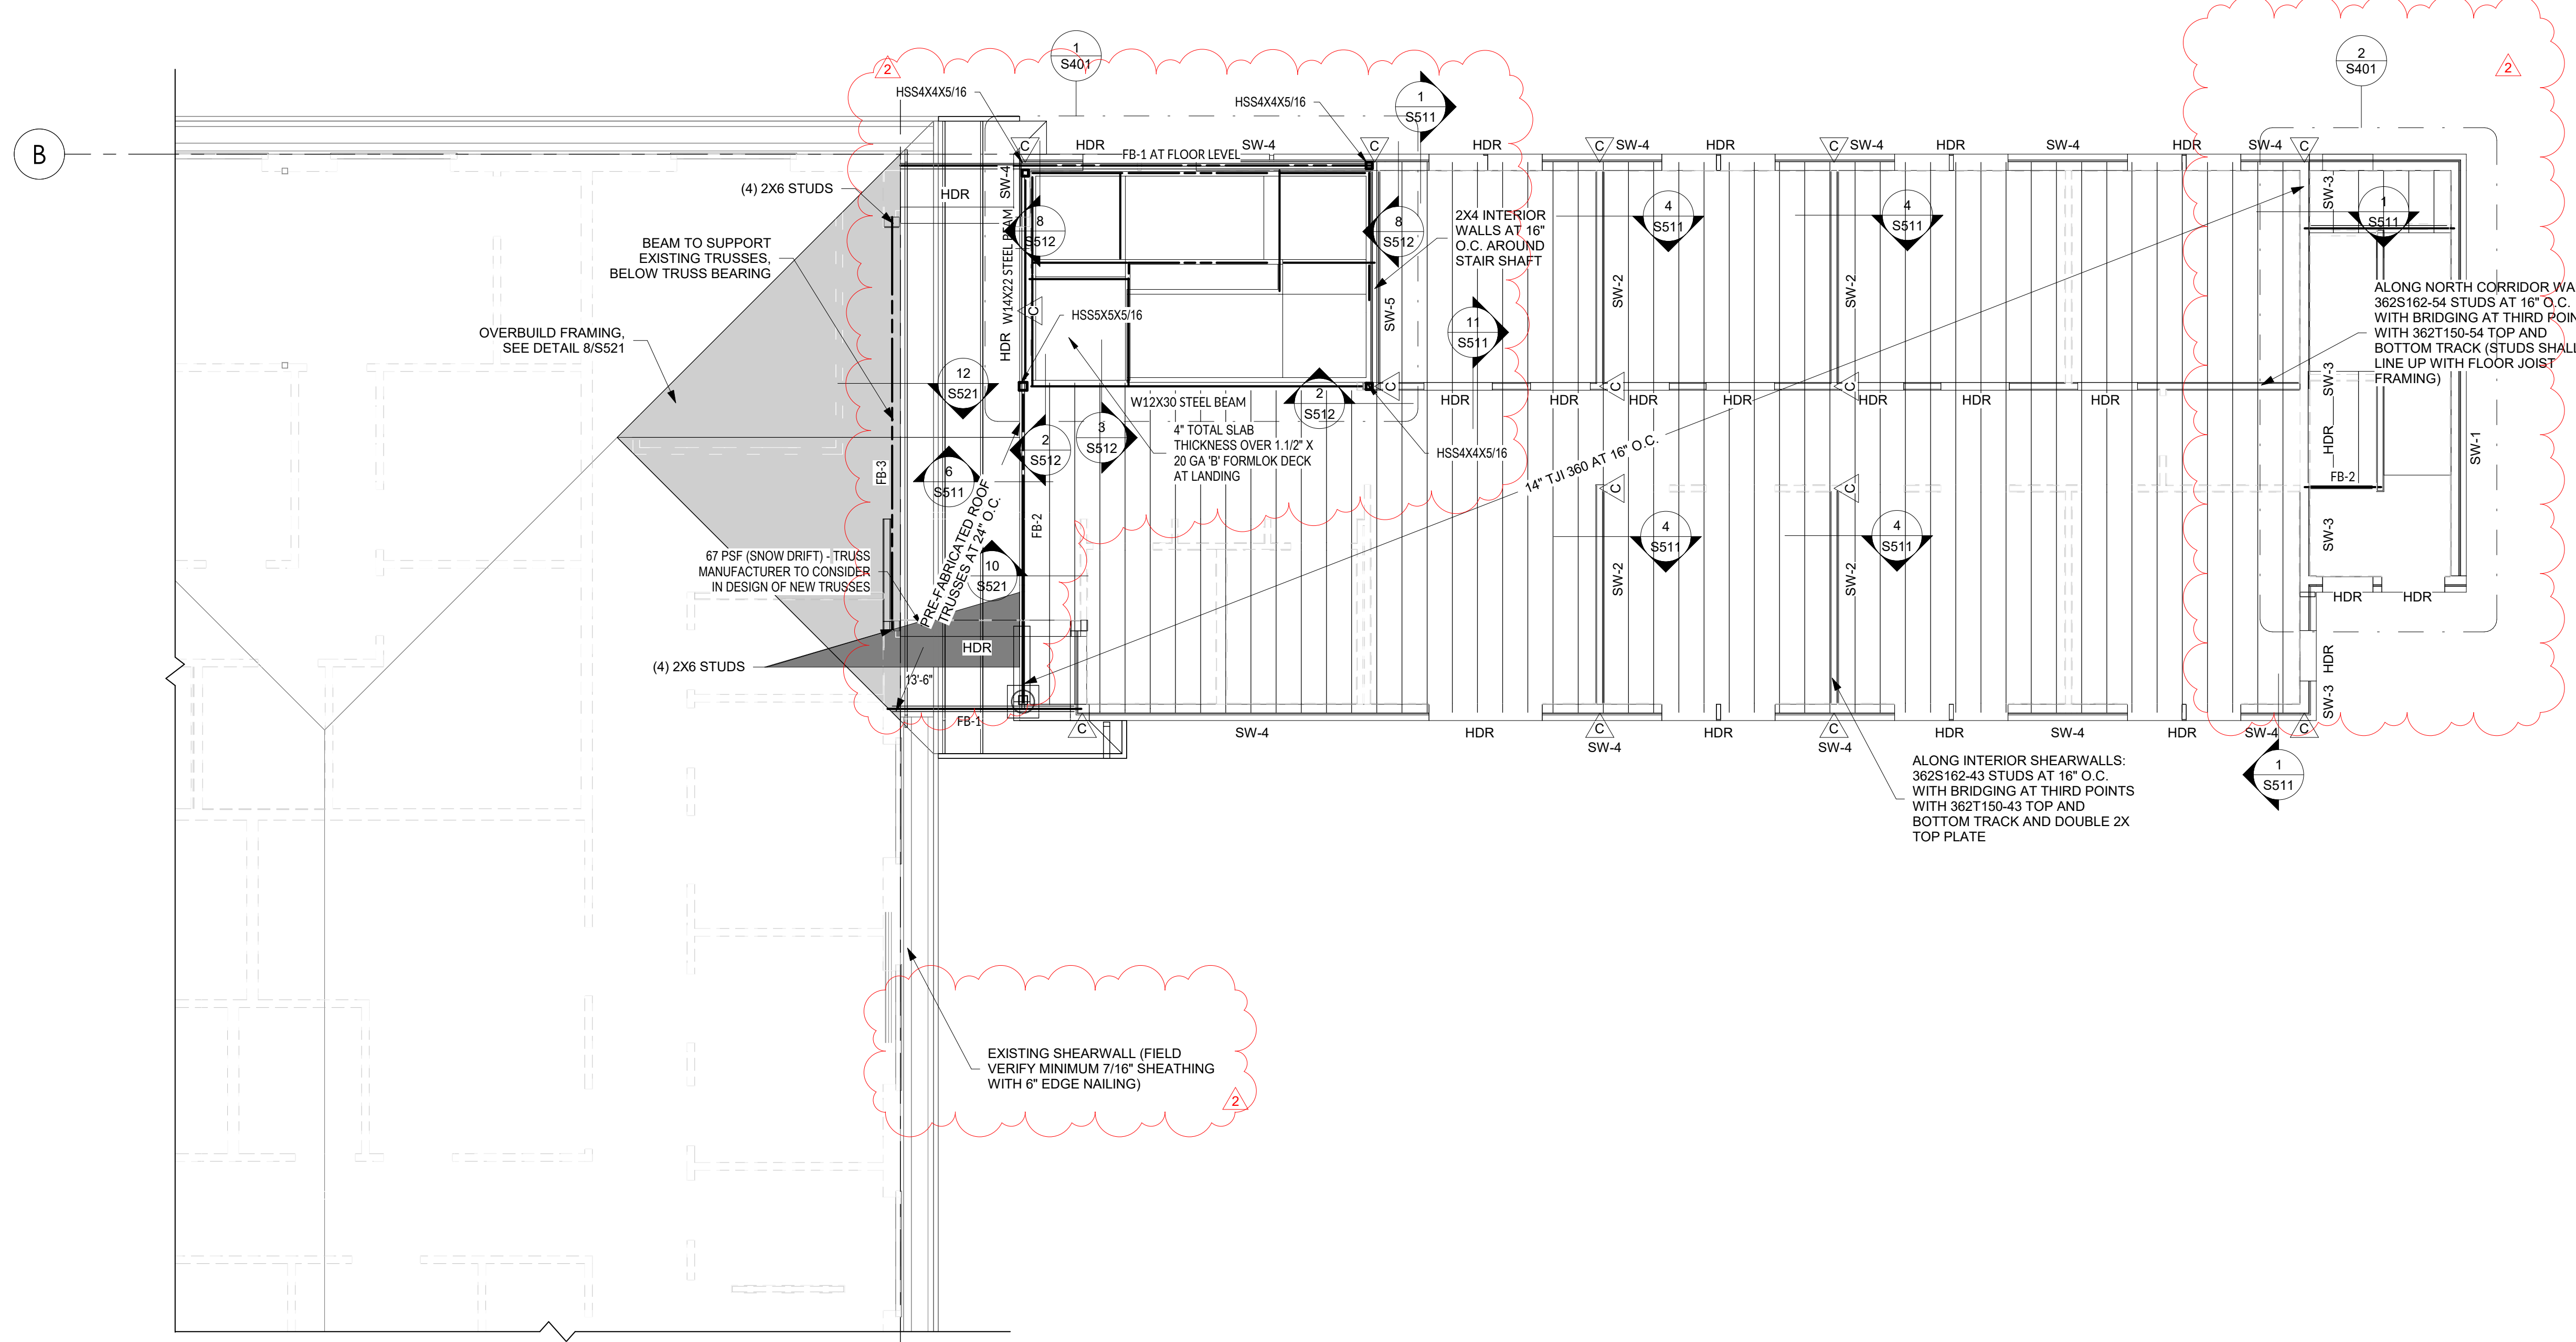

**SECOND FLOOR FRAMING PLAN**  
SCALE: 3/16" = 1'-0"

1  
S111

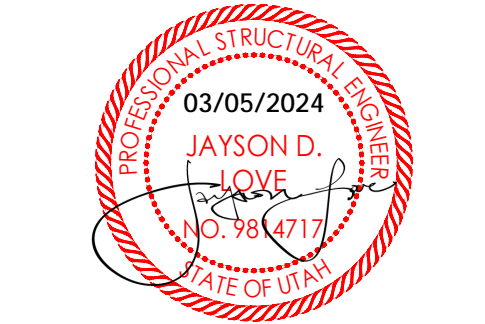

**JONES & ASSOCIATES**  
CONSULTING ENGINEERS  
6080 S FASHION POINT DRIVE  
SOUTH OGDEN, UT 84405

Project Name

No.	Date	Description
1	09.21.23	PERMIT SET
2	02.29.23	PLAN REVIEW

Revision

No.	Date	Description
1	10.30.23	ADDENDUM #1
2	02.29.23	PLAN REVIEW/REDESIGN

SAA Project No. 2022-11  
Drawing Title

**FLOOR FRAMING PLAN**

Sheet Number  
**S111**




### NOTES AND SYMBOLS LEGEND

- XX  
SXXX INDICATES DETAIL REFERENCE NUMBER
- INDICATES SHEET REFERENCE NUMBER
- SW-X INDICATES SHEARWALL CALLOUT, SEE SHEARWALL SCHEDULE ON SHEET S601
- HDR INDICATES WOOD HEADER, SEE HEADER SCHEDULE ON SHEET S601
- INDICATES NON-BEARING WALLS


### ROOF FRAMING NOTES

1. VERIFY ALL ROOF OPENINGS FOR MECHANICAL SHAFTS, STAIRS, ETC. WITH ARCHITECTURAL AND MECHANICAL DRAWINGS.
2. SEE ARCHITECTURAL DRAWINGS FOR DIMENSIONS TO ALL STEEL COLUMNS.
3. ROOF SHEATHING SHALL BE NAILED WITH 8d NAILS AT 6" O.C. AT ALL PANEL ENDS, SUPPORTED EDGES AND ALL BLOCKING, 8d NAILS AT 12" O.C. ALONG INTERMEDIATE FRAMING MEMBERS, PROVIDE 1/8" GAP BETWEEN ALL PANELS. SHEATH ROOF PRIOR TO CONSTRUCTING OVERBUILDS. ROOF SHEATHING SHALL EXTEND BENEATH ALL OVERBUILDS.
4. BLOCK JOISTS SOLID AT ALL BEARING POINTS.
5. ALL INTERIOR BEARING WALLS AND SHEARWALL 3.5/8" METAL STUDS 362S162-33 AT 16" O.C. WITH 362T150-33 TOP AND BOTTOM TRACKS WITH BRIDGING AT MID HEIGHT (UNO).
6. ALL EXTERIOR BEARING WALLS ARE 2X6 AT 16" O.C. UNO.
7. ALL EXTERIOR WALLS SHALL BE SHEATHED AS SW-1, UNO. SEE SHEARWALL SCHEDULE ON SHEET S602.
8. PROVIDE SQUASH BLOCKING AT ALL POINT LOADS THROUGH FLOOR.
9. ALL LVL BEAMS SHALL BE 2.0 E AND 1-3/4" WIDE UNO
10. CONNECT 4-PLY AND GREATER LVL BEAMS WITH (2) ROWS 1/2" THRU BOLTS @ 12" O.C. (SEE MANUFACTURERS SPECIFICATIONS).
11. CARRY ALL COLUMN LOADS DOWN TO FOOTING OR FOUNDATION WALL
12. PROVIDE SOLID BLOCKING OR SQUASH BLOCKS IN JOIST SPACE AT ALL COLUMN LOCATIONS.
13. SEE 'MINIMUM NAILING' SCHEDULE ON SHEET S6.02 FOR TYPICAL NAILING FOR VARIOUS FRAMING CONDITIONS
14. SEE DETAIL 1/S521 FOR TYPICAL TOP PLATE SPLICE AT PIPE
15. SEE DETAIL 2/S521 FOR TYPICAL TOP PLATE LAP SPLICE DETAIL
16. SEE DETAIL 3/S521 FOR TYPICAL OPENINGS IN ROOF/FLOOR TRUSSES/JOISTS.
17. SEE DETAIL 4/S521 FOR TYPICAL MULTI-PLY HEADERS, JAMBS, POSTS, AND BEAMS (UNO)
18. SEE DETAILS 6 AND 7 ON SHEET S521 FOR TYPICAL BEAM CONNECTIONS
19. SEE DETAIL 8/S521 FOR HEADERS GREATER THAN 6'-0"
20. SEE VENEER LINTEL SCHEDULE ON SHEET S601 FOR STEEL LINTELS AT OPENINGS IN MASONRY VENEER
21. SEE HEADER BEARING SCHEDULE ON SHEET S601 FOR TYPICAL BEARING AND KING STUD REQUIREMENTS.
22. ALL BEAMS SHALL BE SUPPORTED BY A MINIMUM OF (2) 2X6 BEARING STUDS.

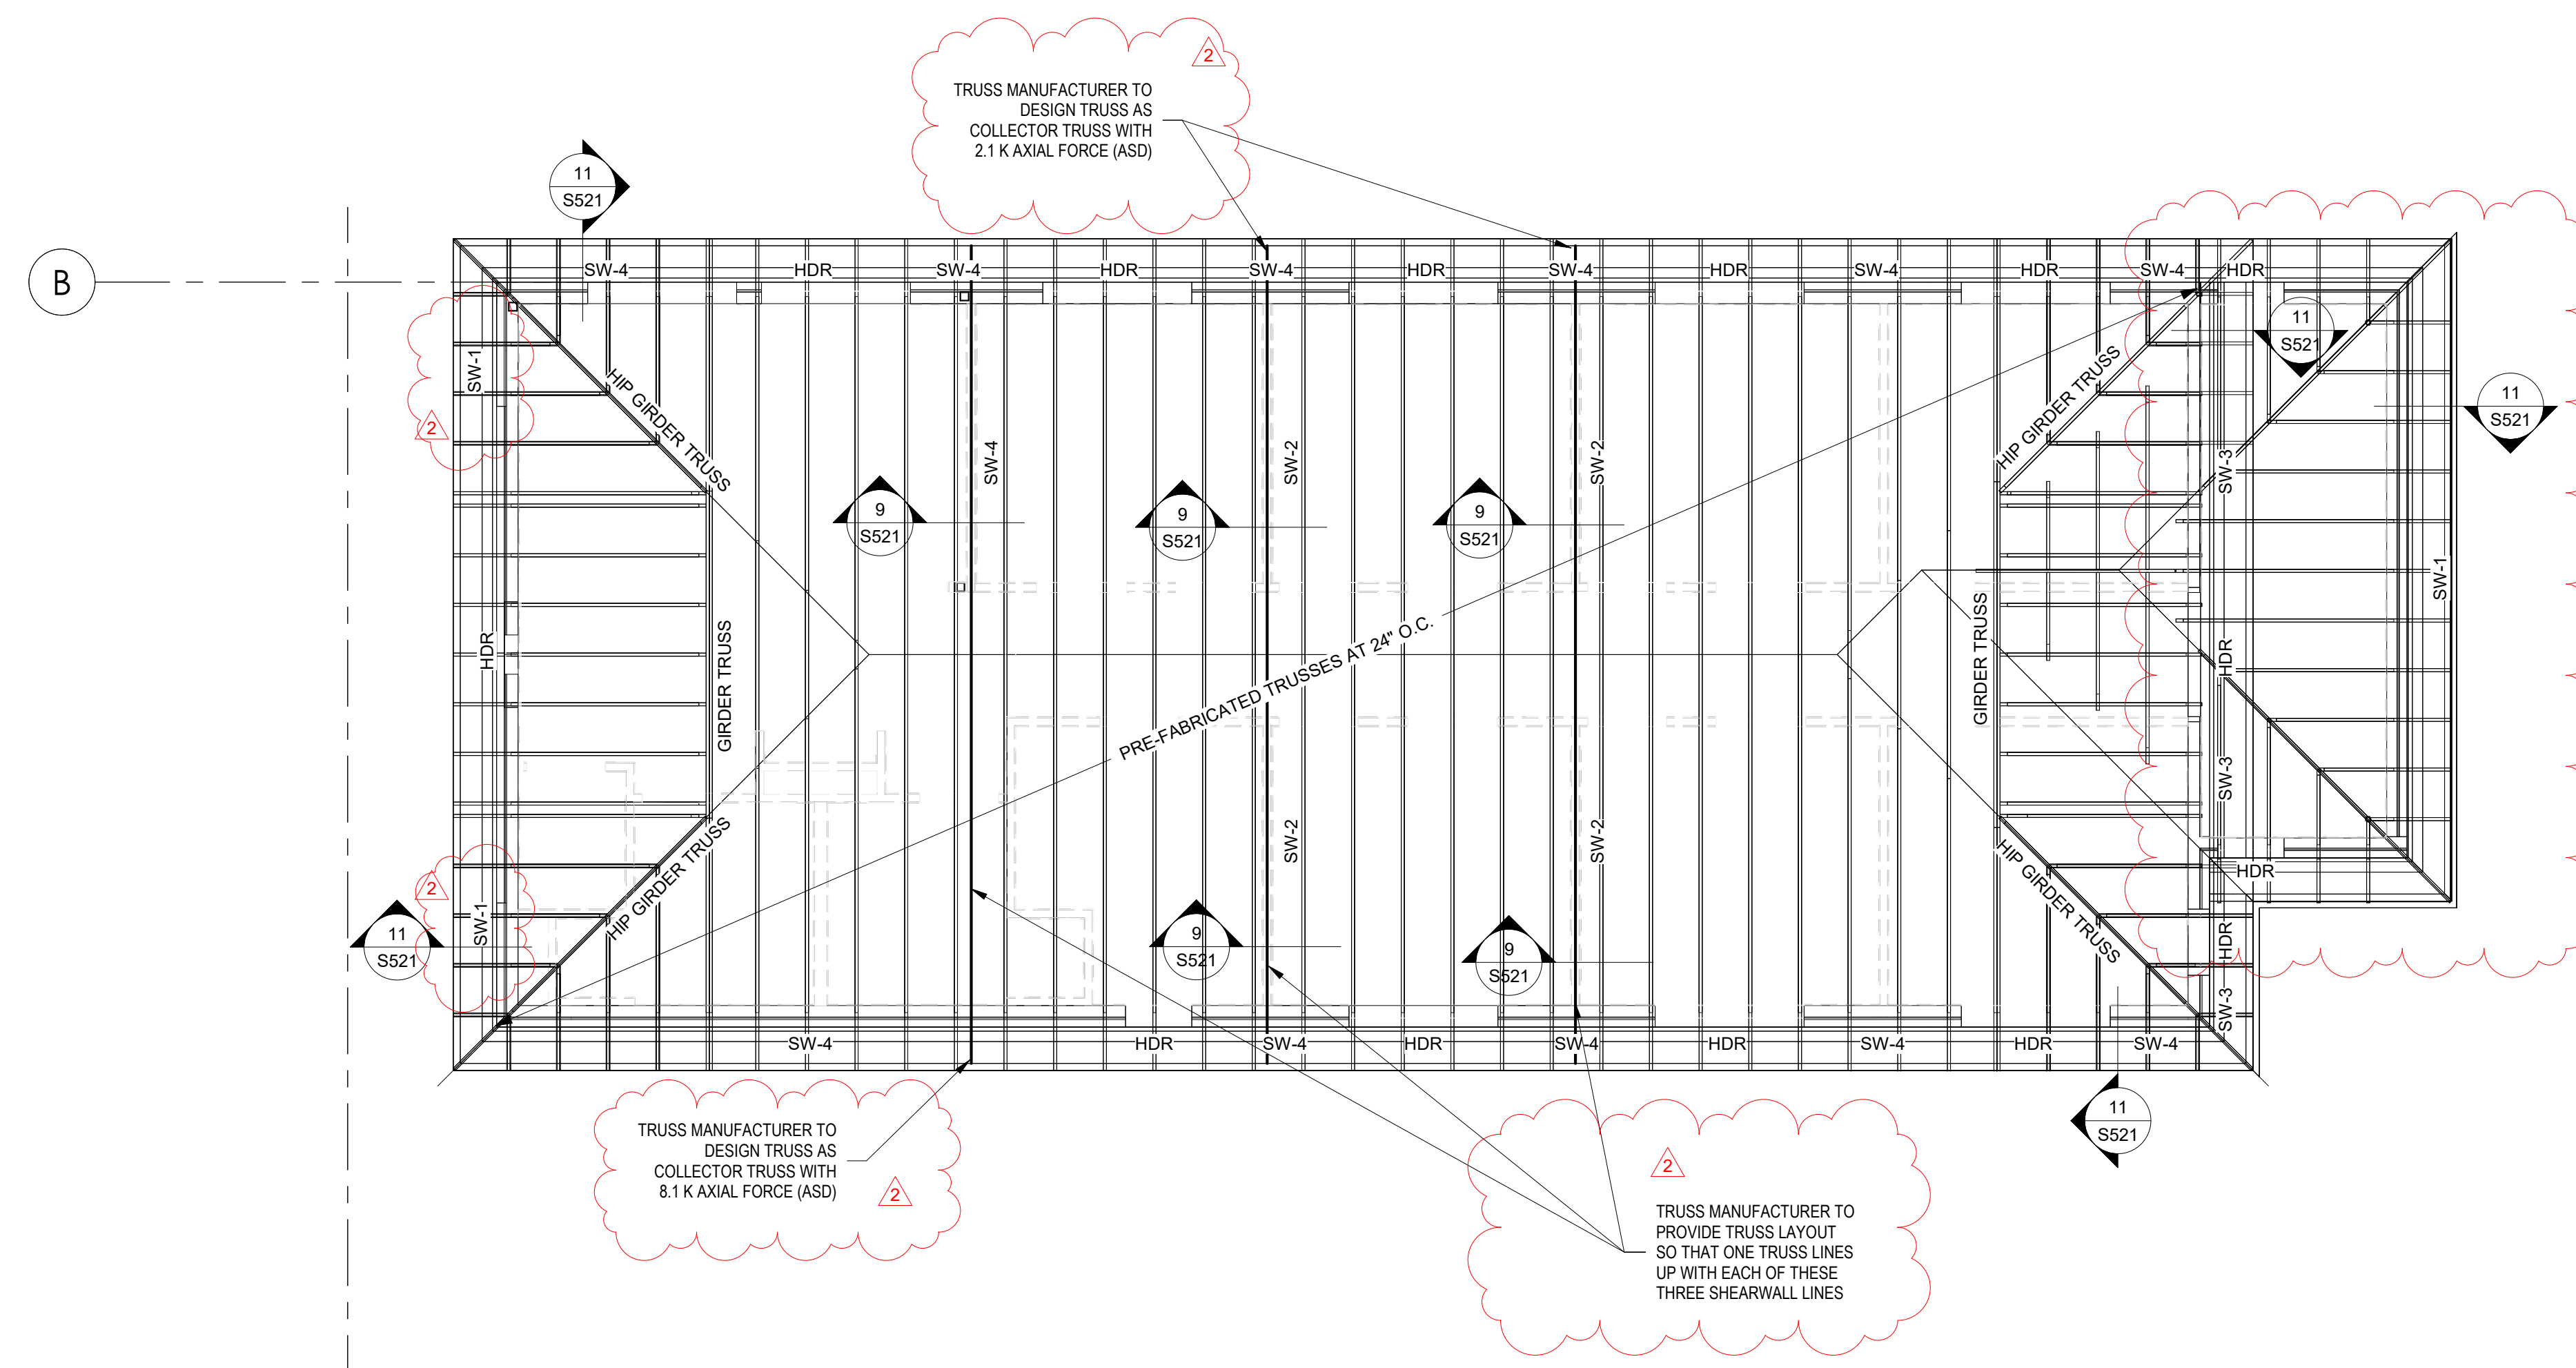

**ROOF FRAMING PLAN**  
SCALE: 3/16" = 1'-0"

1  
S121

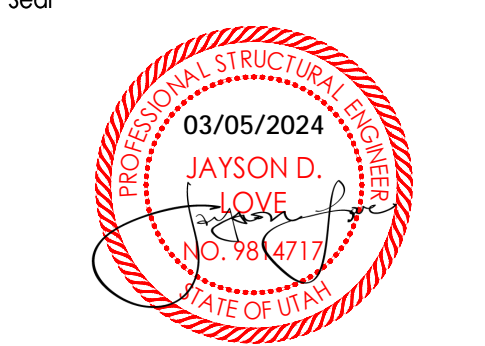

Consultant

**SILVERPEAK ENGINEERING**  
177 E. ANTELOPE DR. STE. B  
LAYTON, UT 84041  
(801) 499-5054  
SP PROJECT#: 23-165

**JONES & ASSOCIATES**  
CONSULTING ENGINEERS  
6080 S FASHION POINT DRIVE  
SOUTH OGDEN, UT 84405

Project Name


Issued No.	Date	Description
1	09.21.23	PERMIT SET
2	02.29.23	PLAN REVIEW

Revision No.	Date	Description
1	10.30.23	ADDENDUM #1
2	02.29.23	PLAN REVIEW/REDESIGN

SAA Project No. 2022-11  
Drawing Title

ROOF FRAMING PLAN

Sheet Number  
**S121**

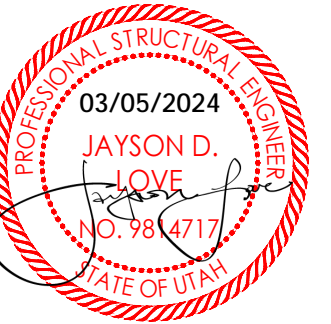

Project Name

Issued No.	Date	Description
1	09.21.23	PERMIT SET
2	02.29.23	PLAN REVIEW

Revision No.	Date	Description
2	02.29.23	PLAN REVIEW/REDESIGN

SAA Project No. 2022-11  
Drawing Title


ENLARGED STAIR PLAN

Sheet Number


**S401**

**FLOOR BEAM SCHEDULE**


MARK	TYPE
FB-1	(3) 1.34" x 14" LVL
FB-2	(2) 1.34" x 14" LVL
FB-3	(8) 1.34" x 16" LVL
FB-4	(2) 1.34x11 7/8 LVL

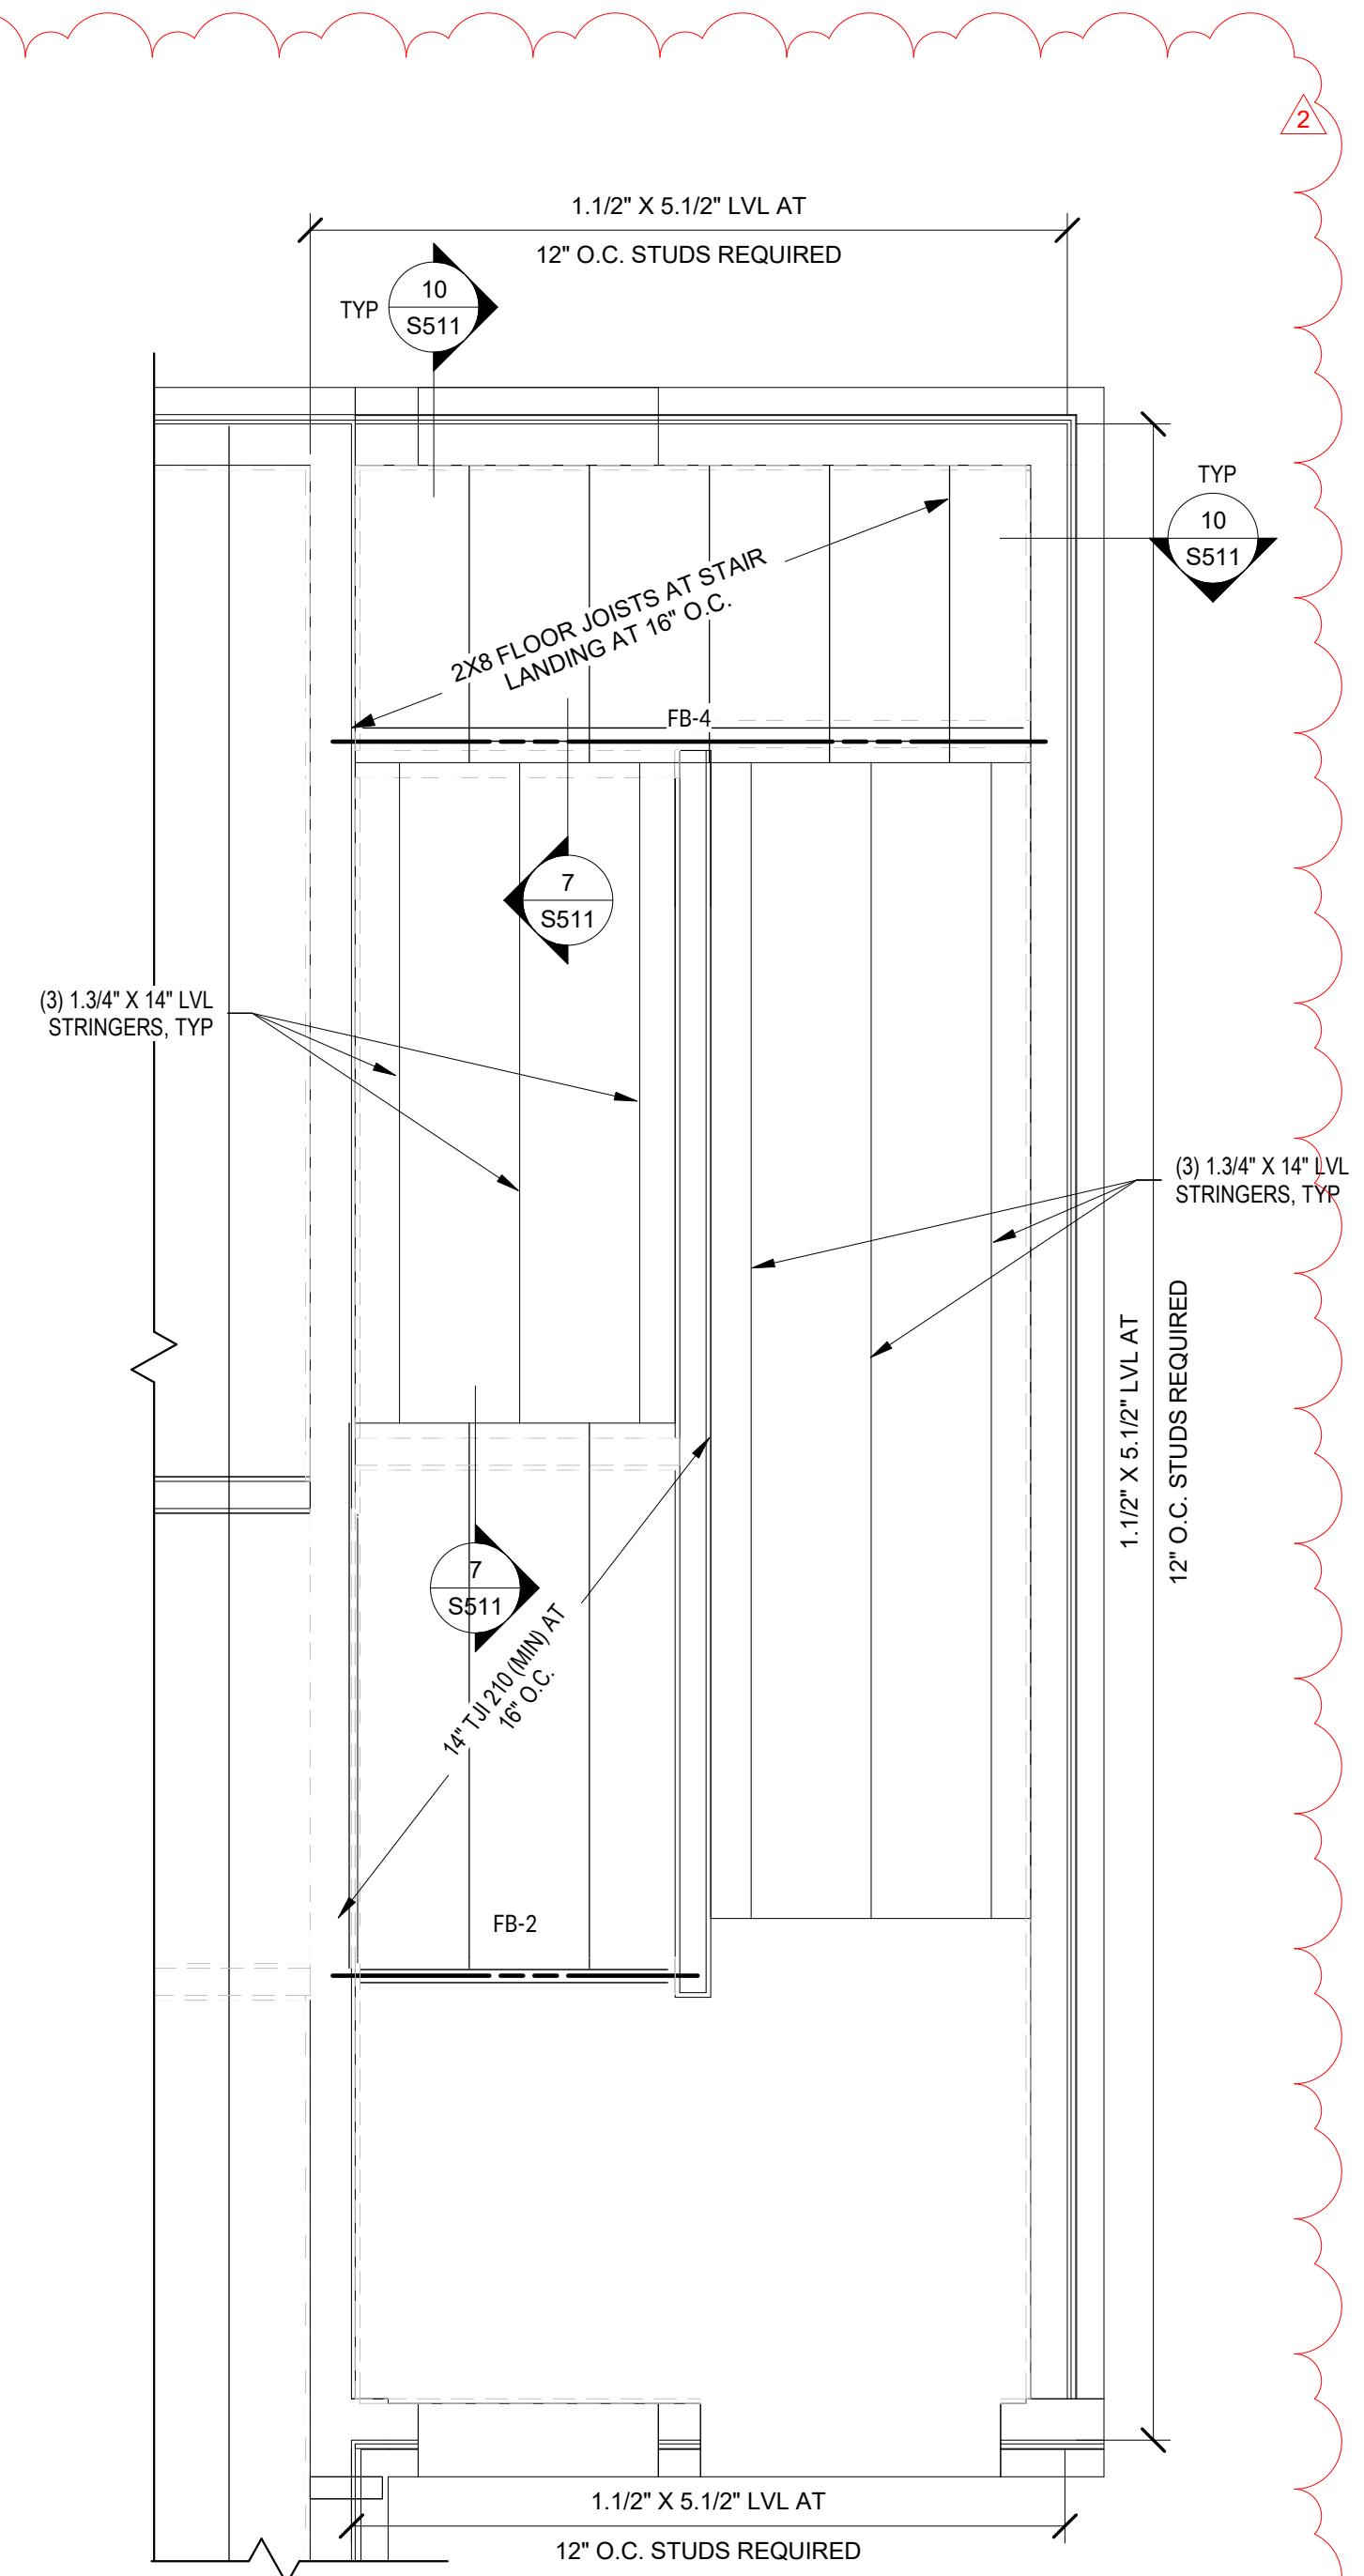

**ENLARGED STAIR 'B' FRAMING PLAN**  
SCALE: 1/2" = 1'-0"  
2  
S401

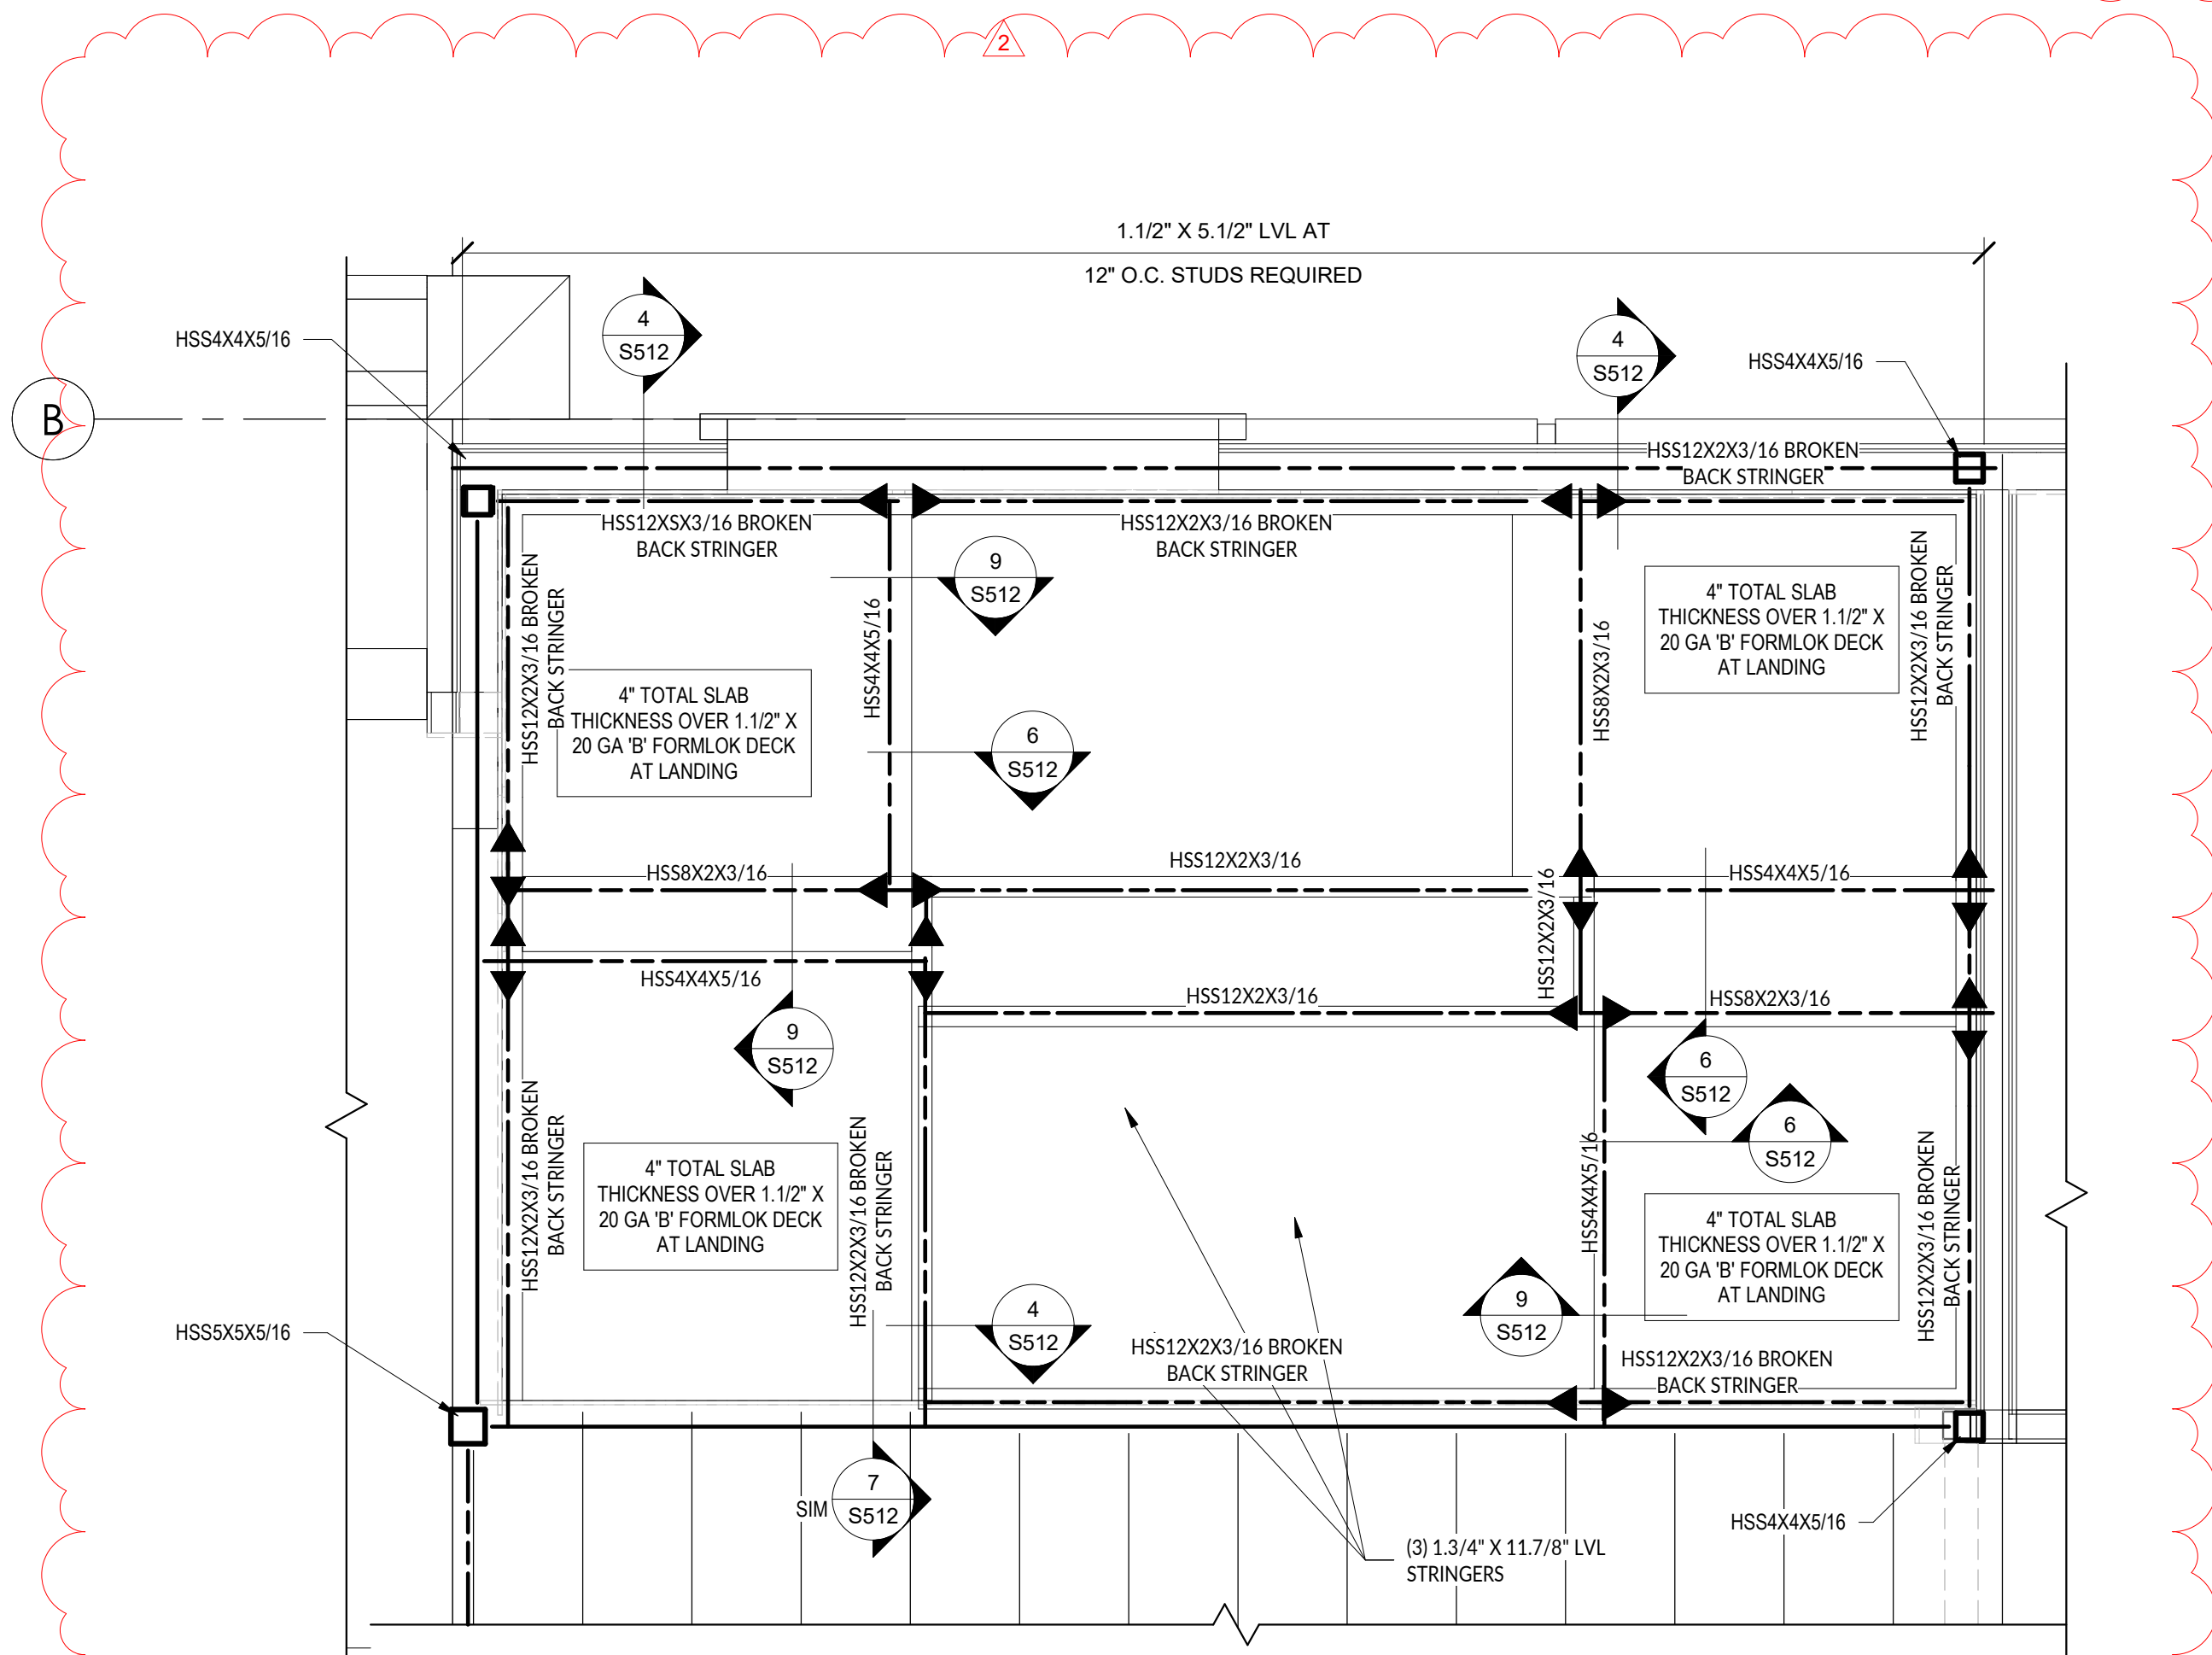


**ENLARGED STAIR 'A' FRAMING PLAN**  
SCALE: 1/2" = 1'-0"  
1  
S401

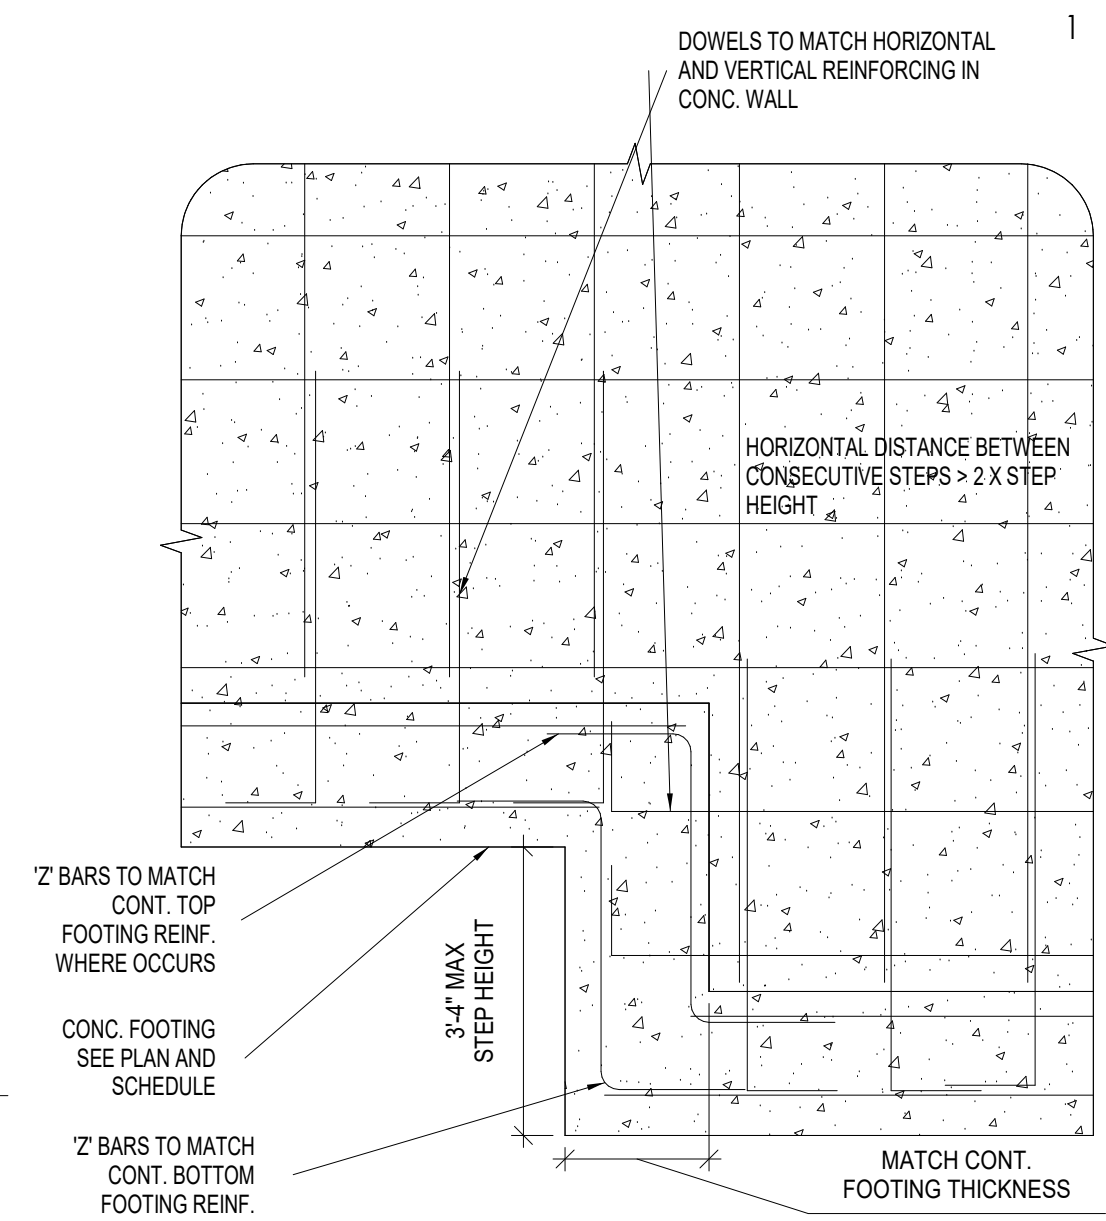


**TYPICAL FOOTING STEP DETAIL**  
NOT TO SCALE

1  
S501

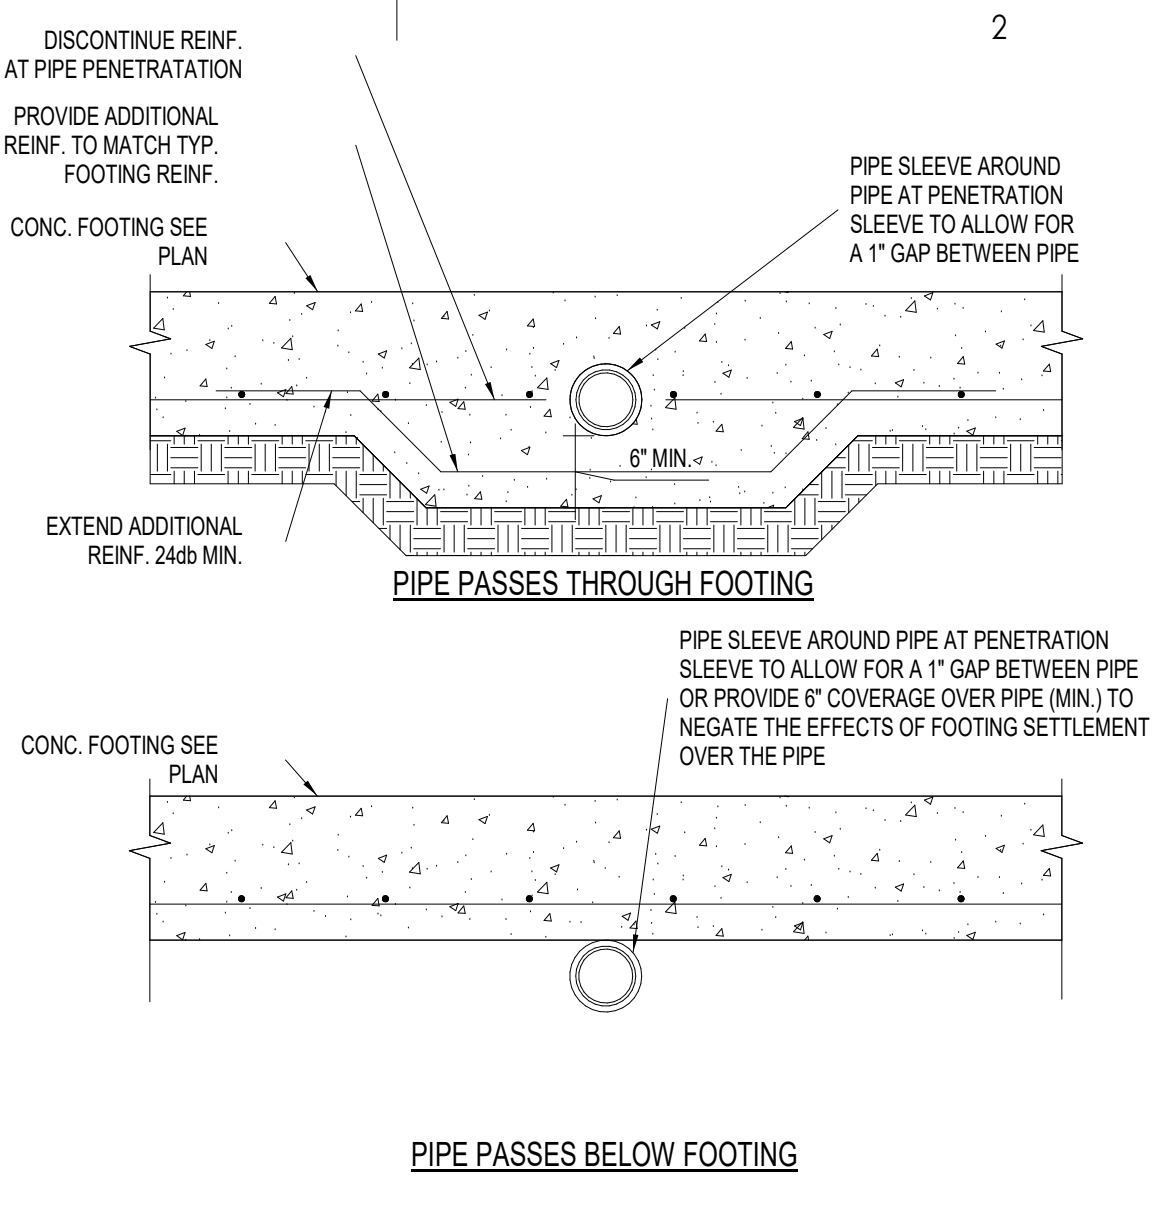


**TYPICAL FOOTING PENETRATION**  
NOT TO SCALE

2  
S501

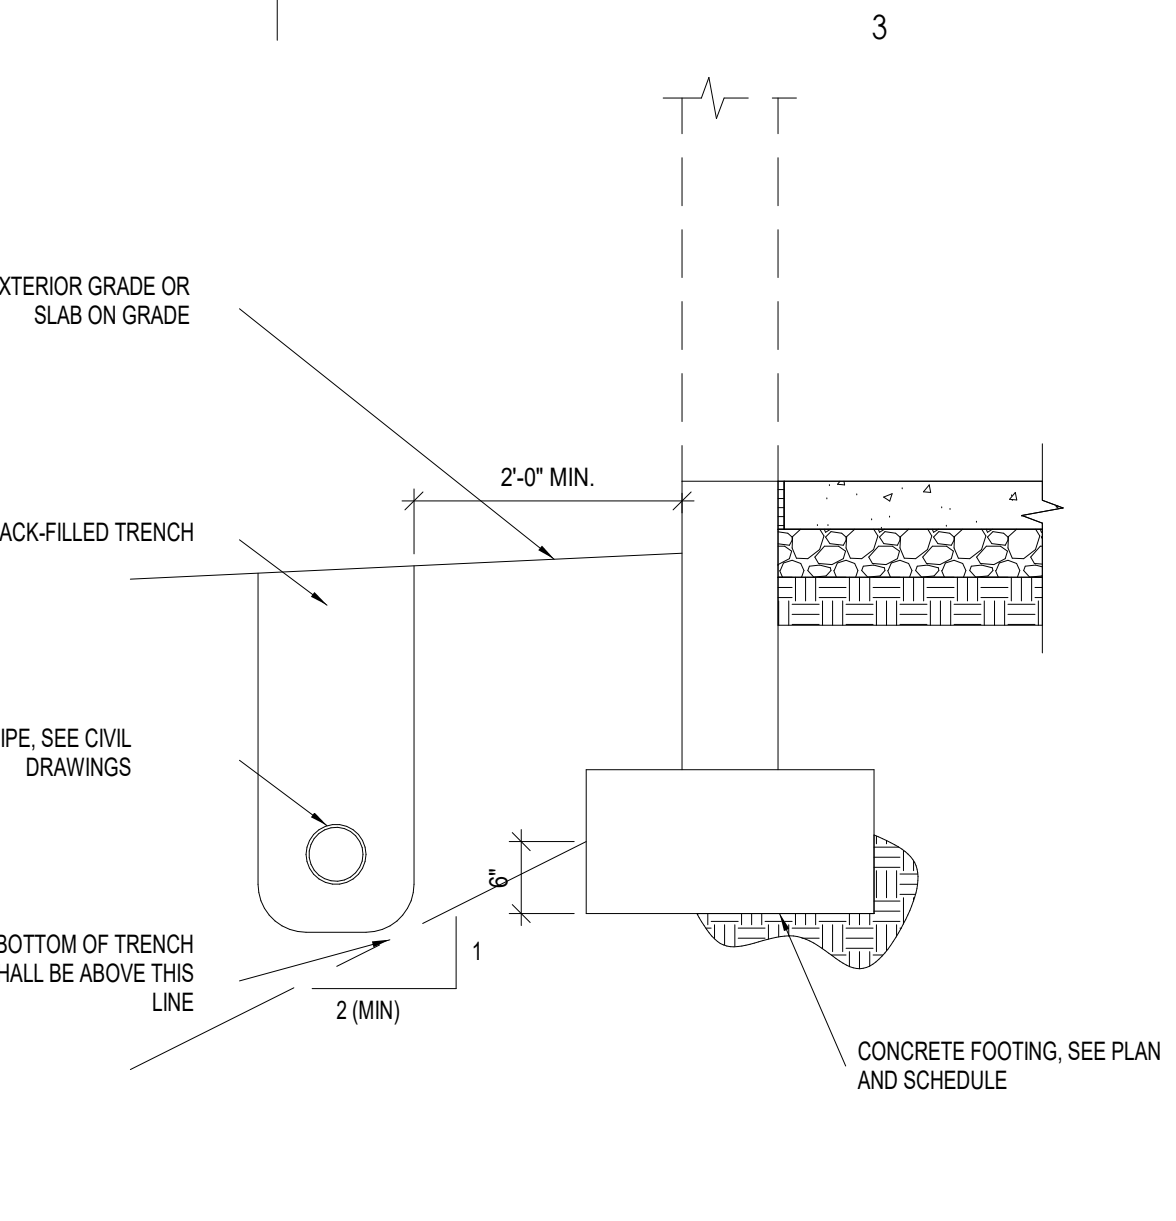


**PIPE PARALLEL TO FOOTING DETAIL**  
NOT TO SCALE

3  
S501

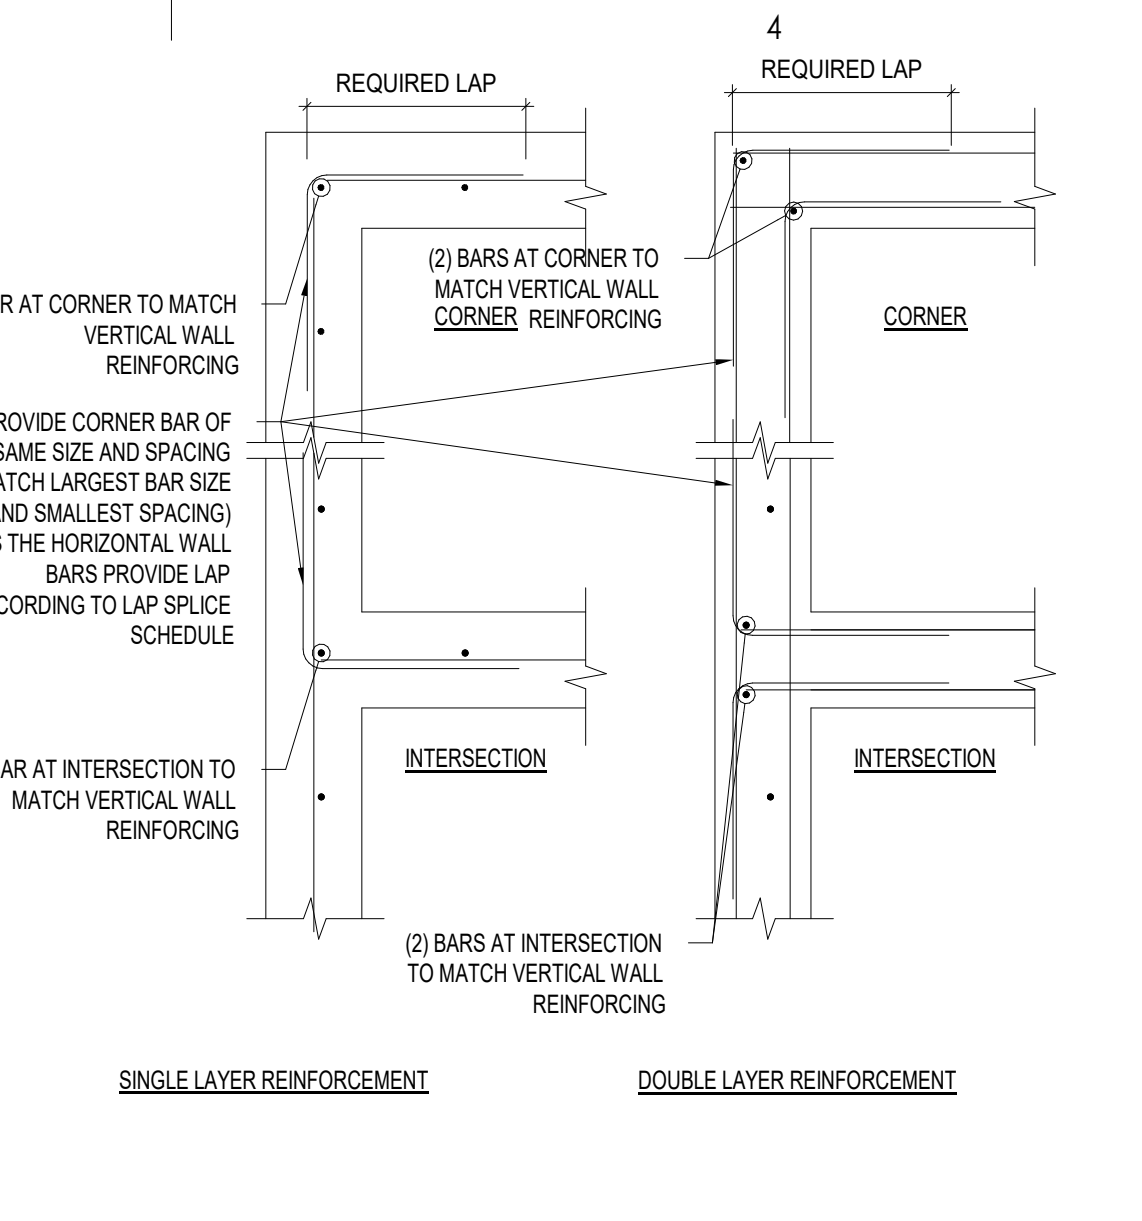


**TYPICAL CORNER REINFORCEMENT**  
NOT TO SCALE

4  
S501

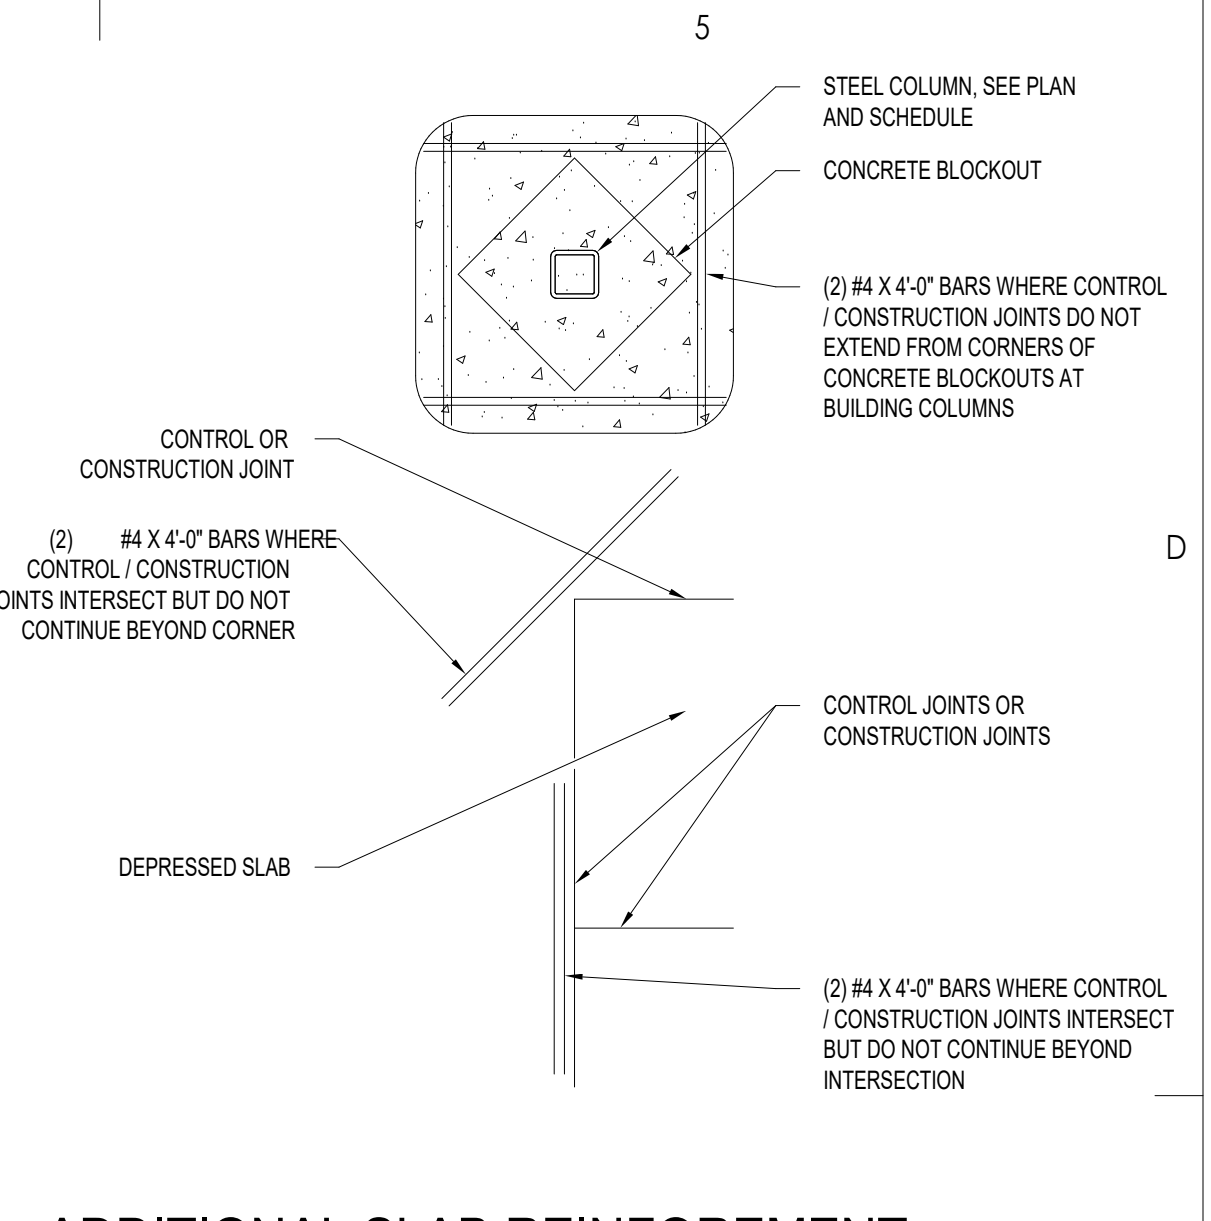


**ADDITIONAL SLAB REINFORCEMENT DETAIL**  
NOT TO SCALE

5  
S501

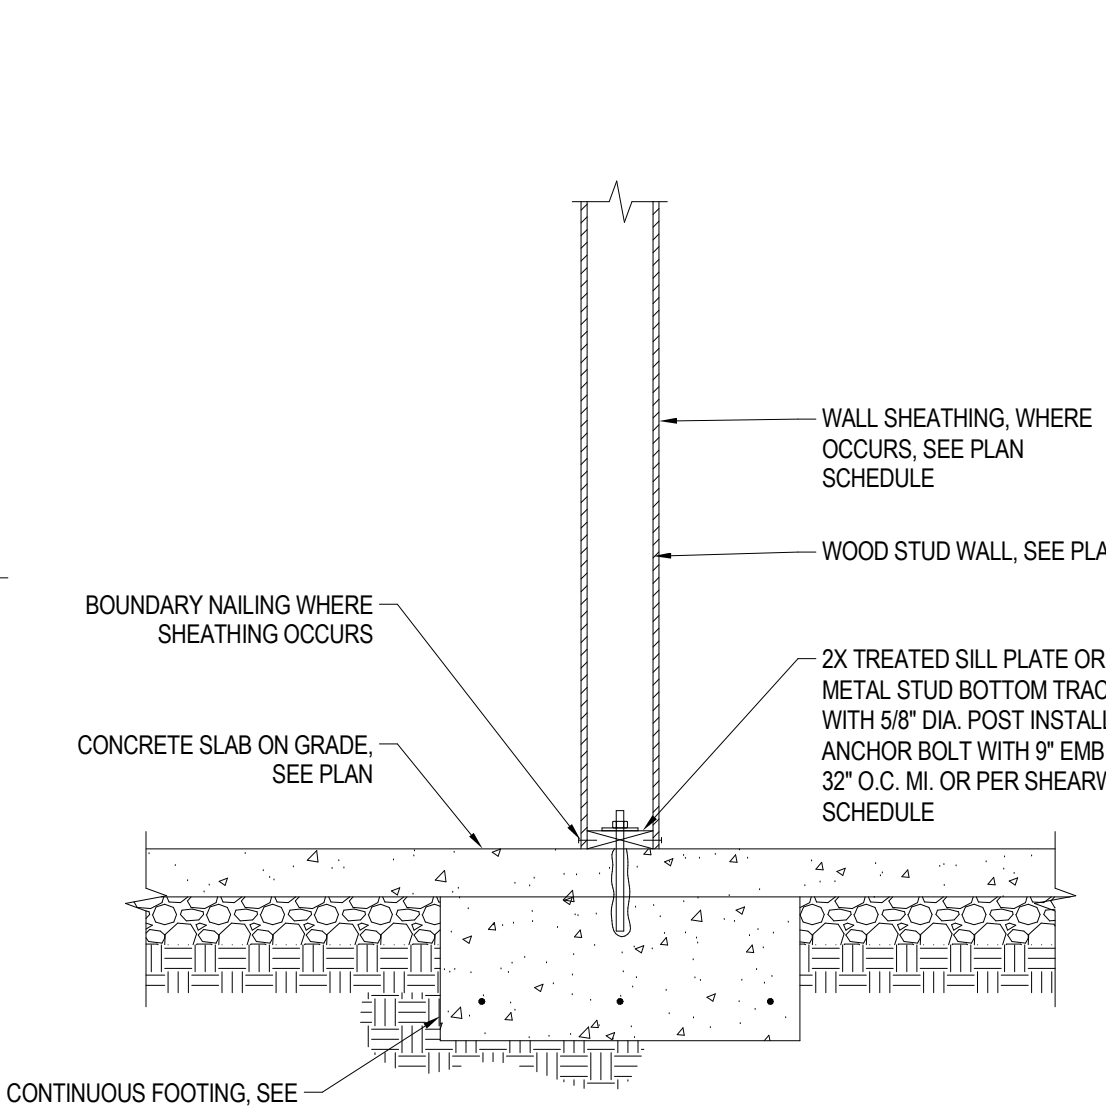


**INTERIOR FOOTING DETAIL**  
NOT TO SCALE

6  
S501

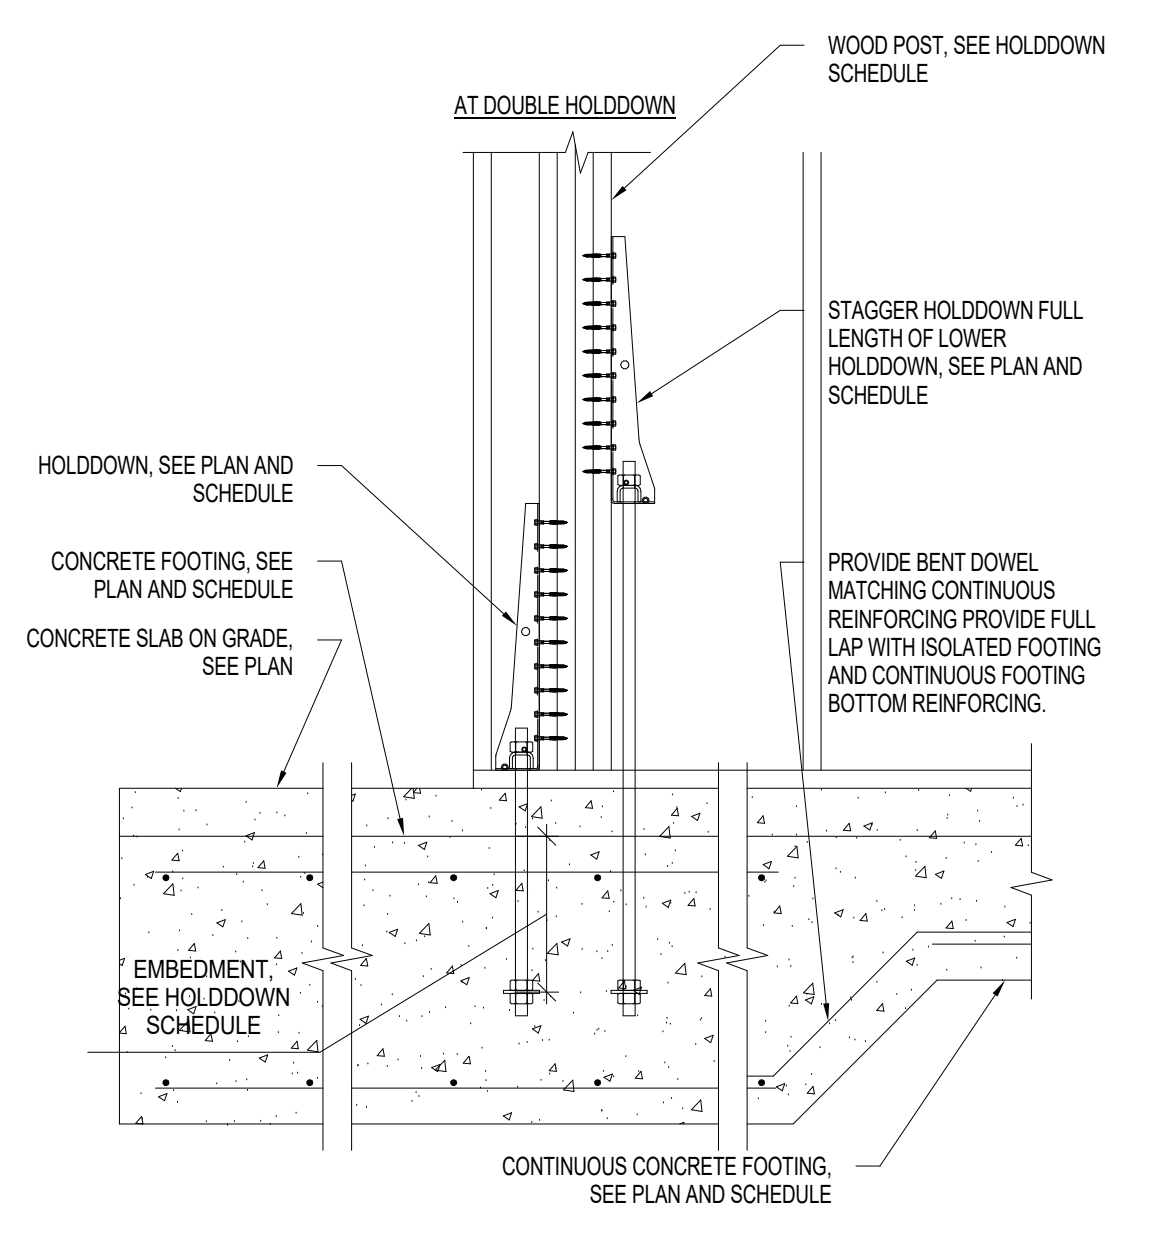


**HOLDDOWN AT INTERIOR FOOTING**  
NOT TO SCALE

7  
S501

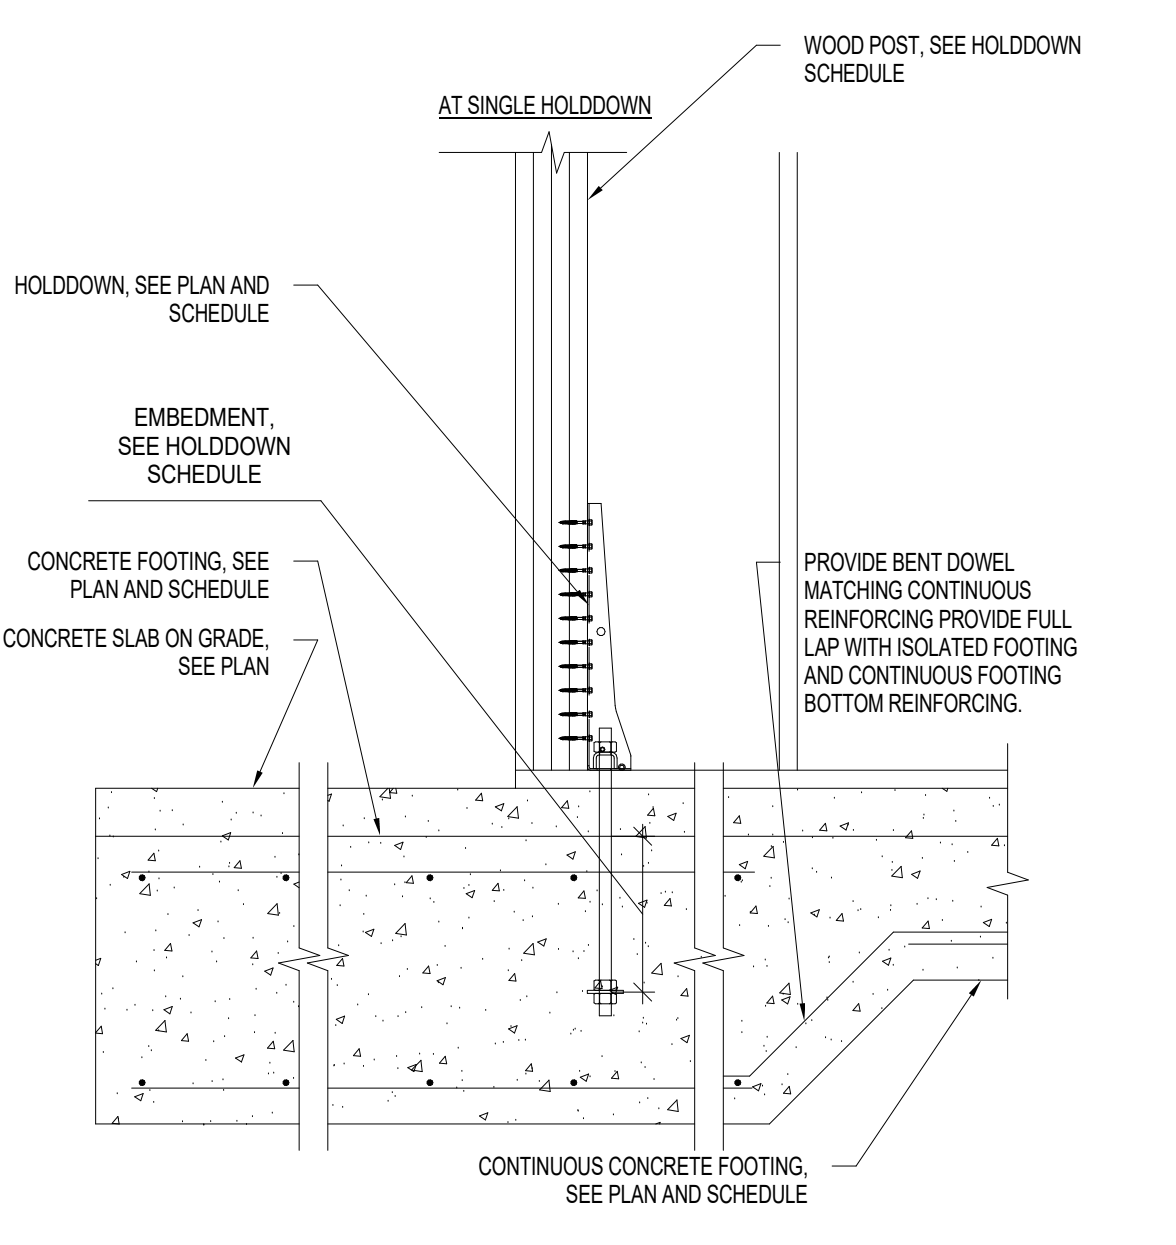


**CONTROL AND ISOLATION JOINTS**  
NOT TO SCALE

8  
S501

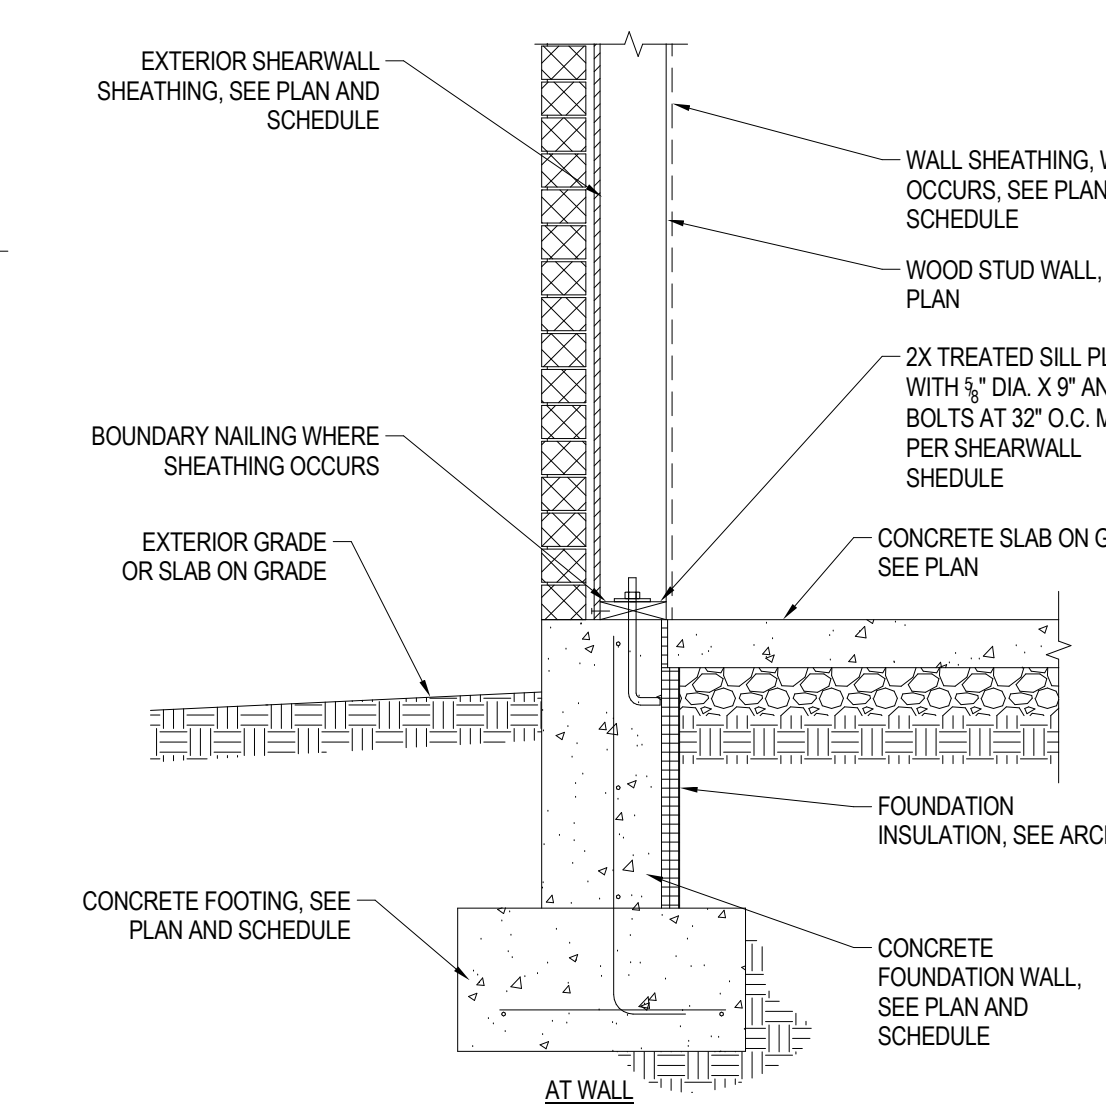


**EXTERIOR WALL FOOTING DETAIL AT 10 IN. WALL**  
NOT TO SCALE

9  
S501

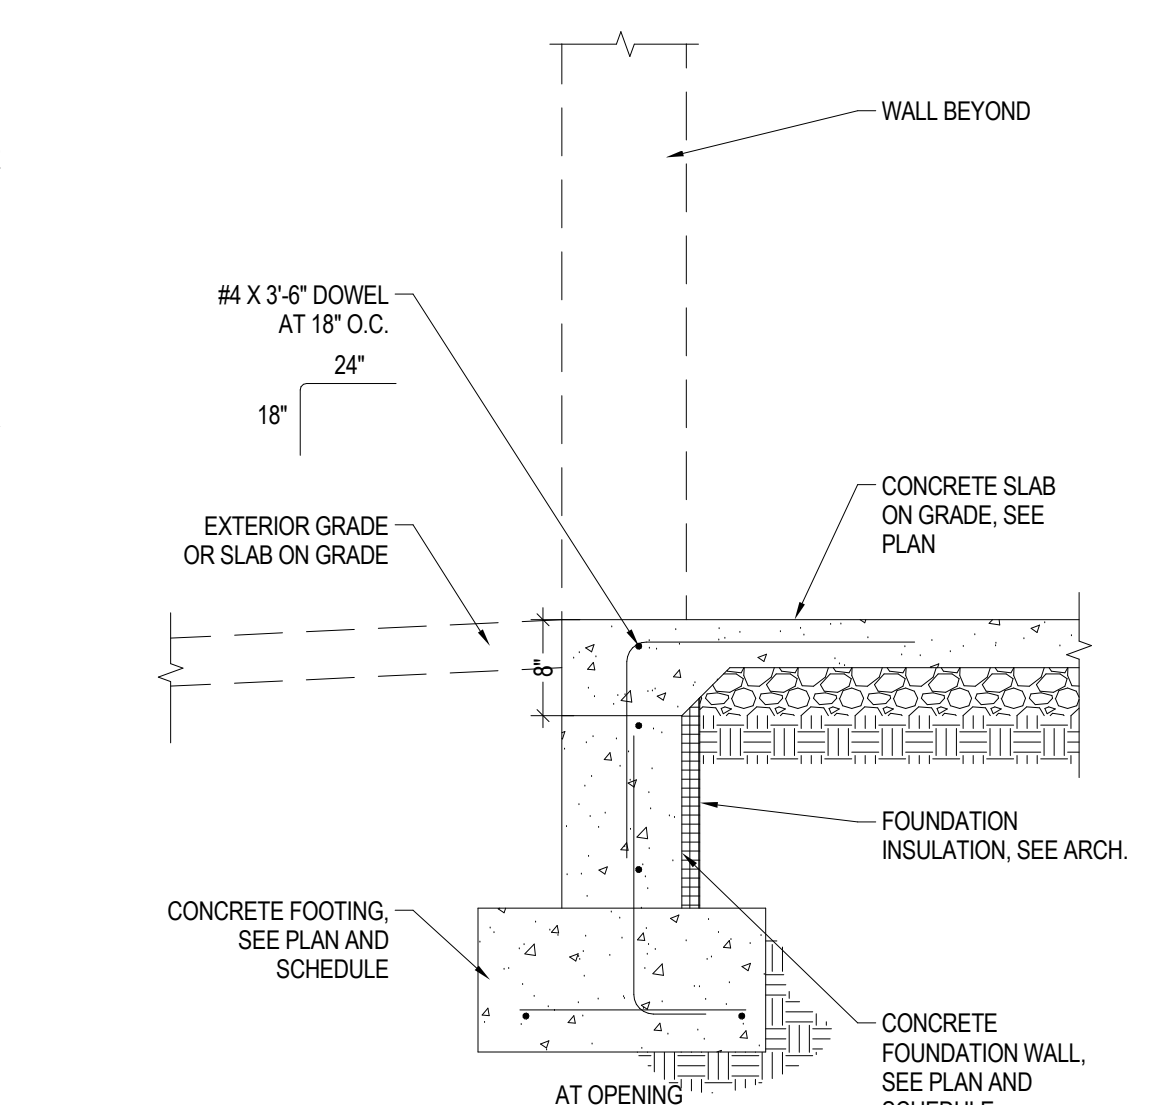


**STAIR TO FOOTING DETAIL**  
NOT TO SCALE

10  
S501

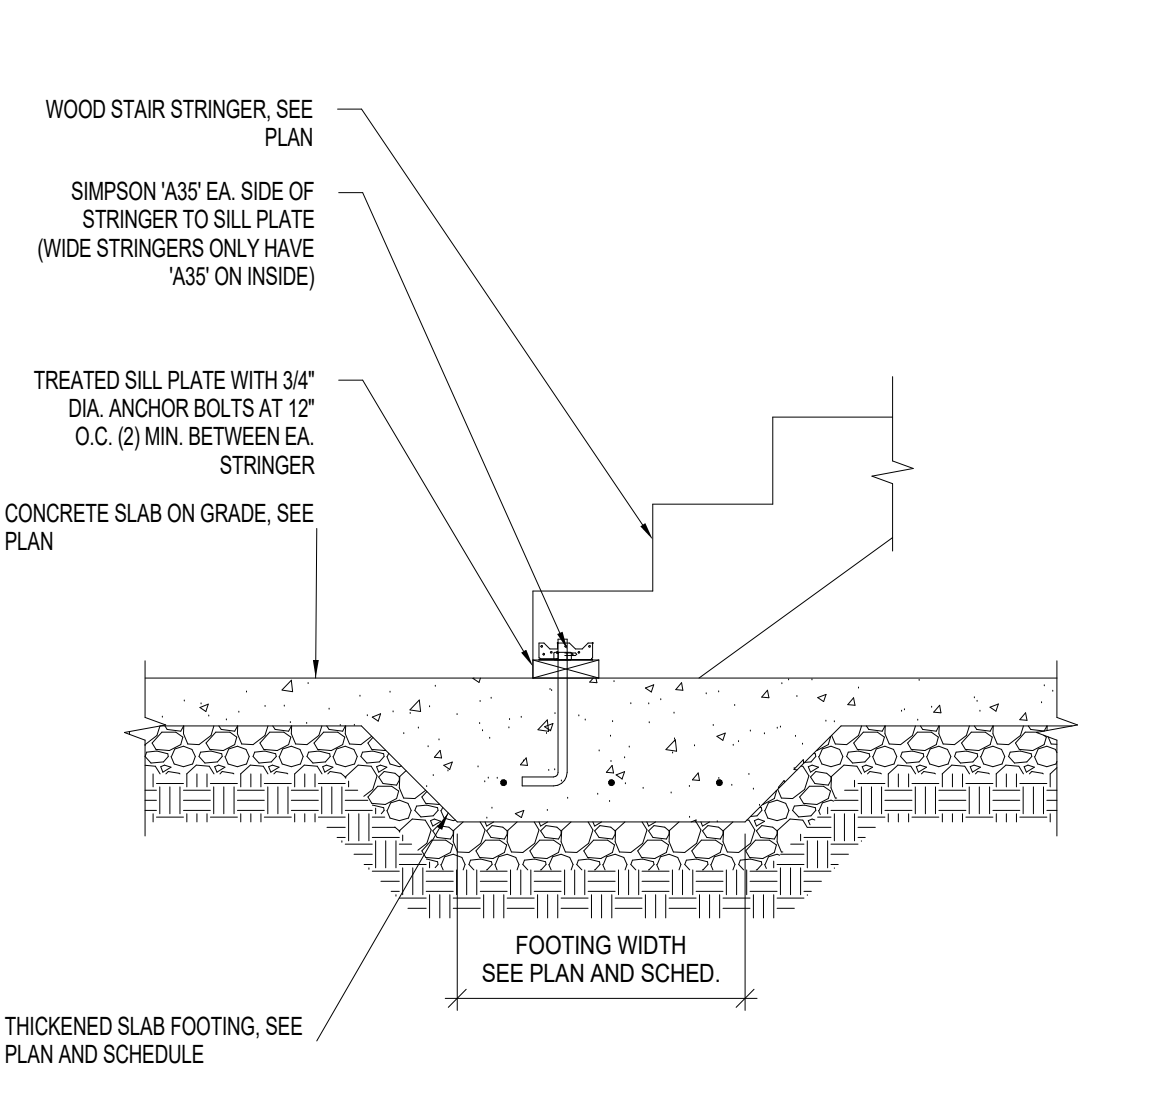


**CONTROL AND ISOLATION JOINTS**  
NOT TO SCALE

8  
S501

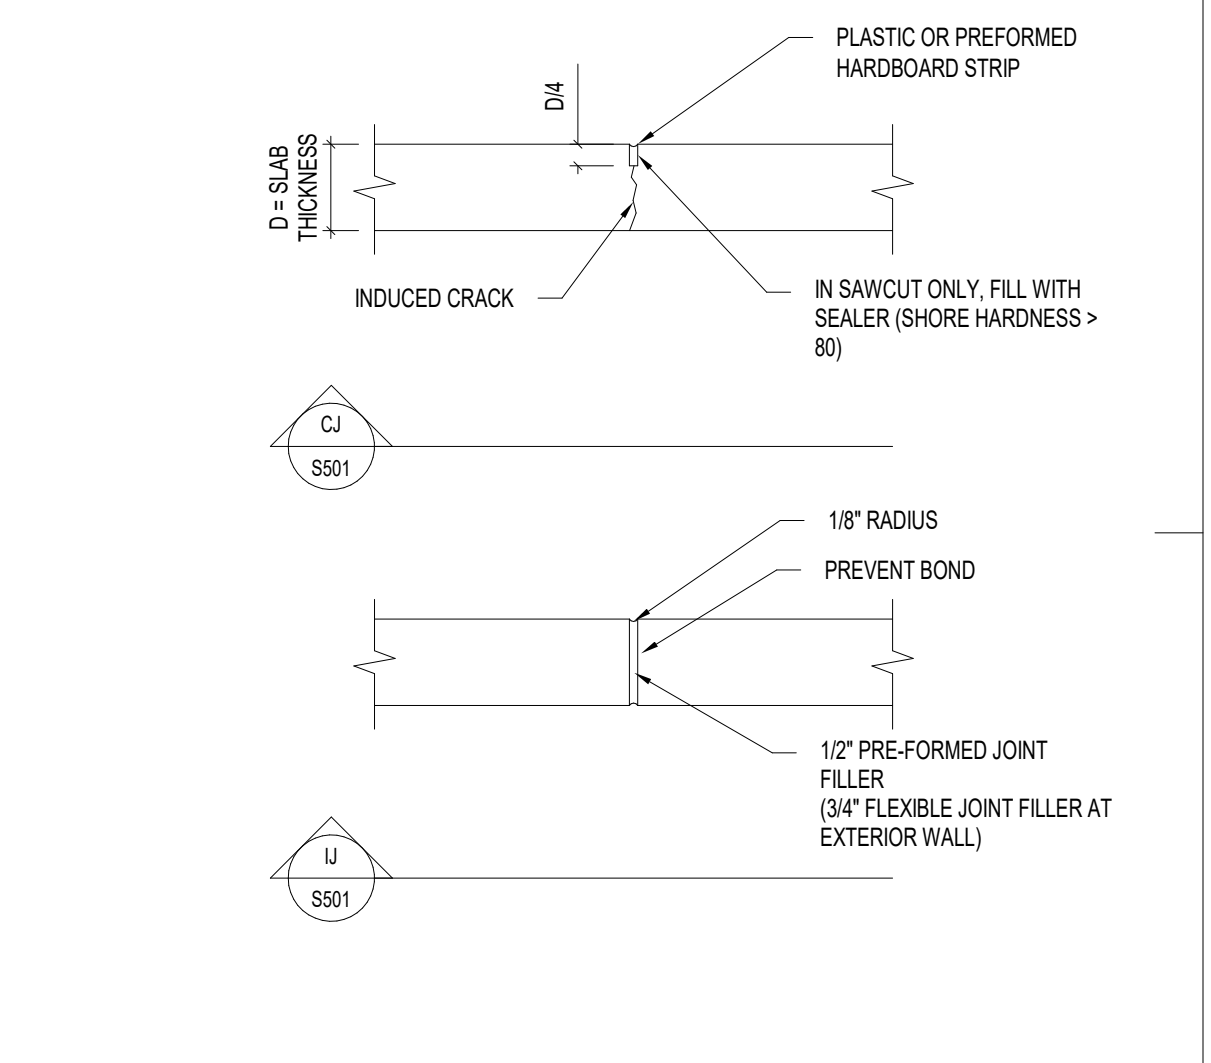

**CONTROL AND ISOLATION JOINTS**  
NOT TO SCALE

8  
S501

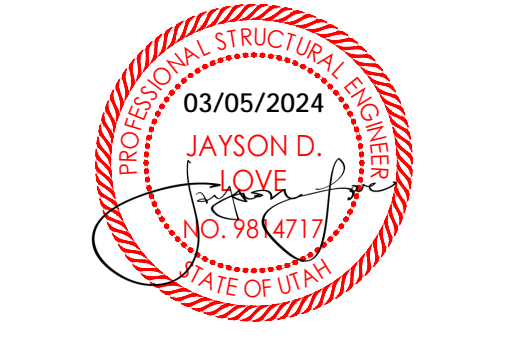

**JONES & ASSOCIATES**  
CONSULTING ENGINEERS  
6080 S FASHION POINT DRIVE  
SOUTH OGDEN, UT 84405

Project Name

Issued No.	Date	Description
1	09.21.23	PERMIT SET
2	02.29.23	PLAN REVIEW


Revision

No.	Date	Description

SAA Project No. 2022-11  
Drawing Title


**FOOTING AND FOUNDATION DETAILS**

Sheet Number  
**S501**

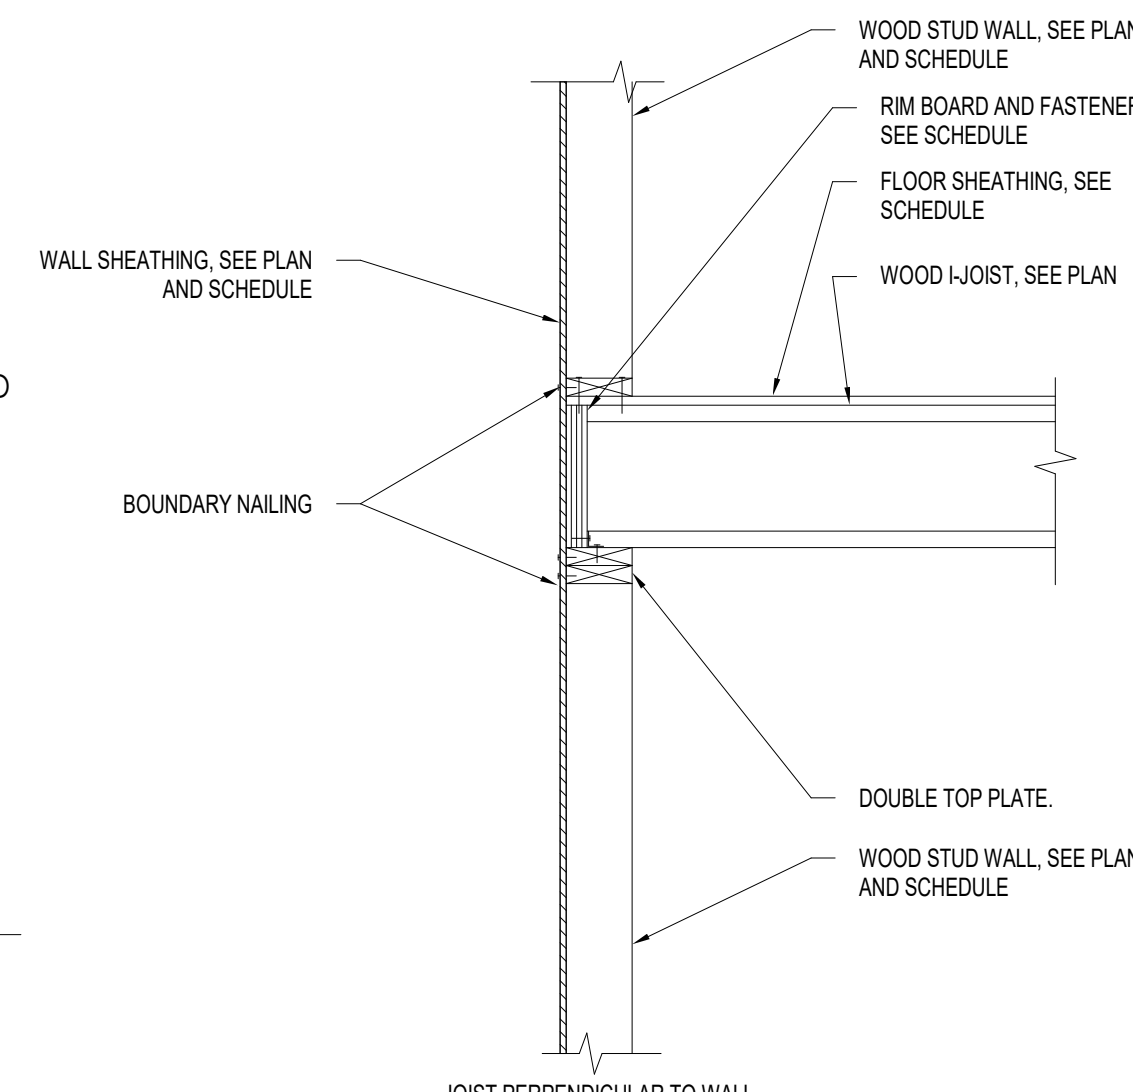


**FLOOR I-JOIST TO WALL DETAIL**  
NOT TO SCALE

1  
S511

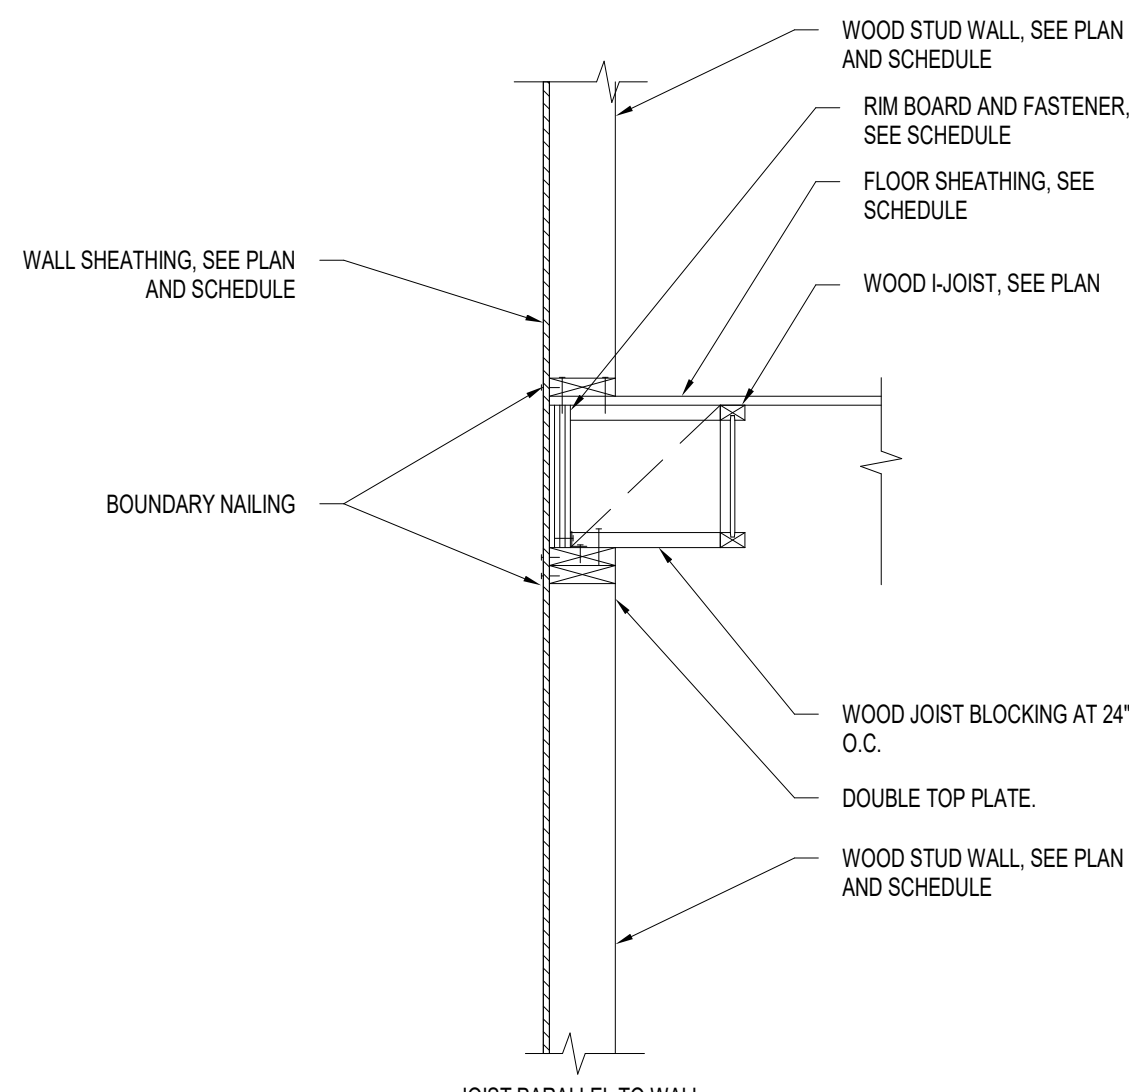




**JOISTS AT FLUSH BEAM**  
NOT TO SCALE

2  
S511

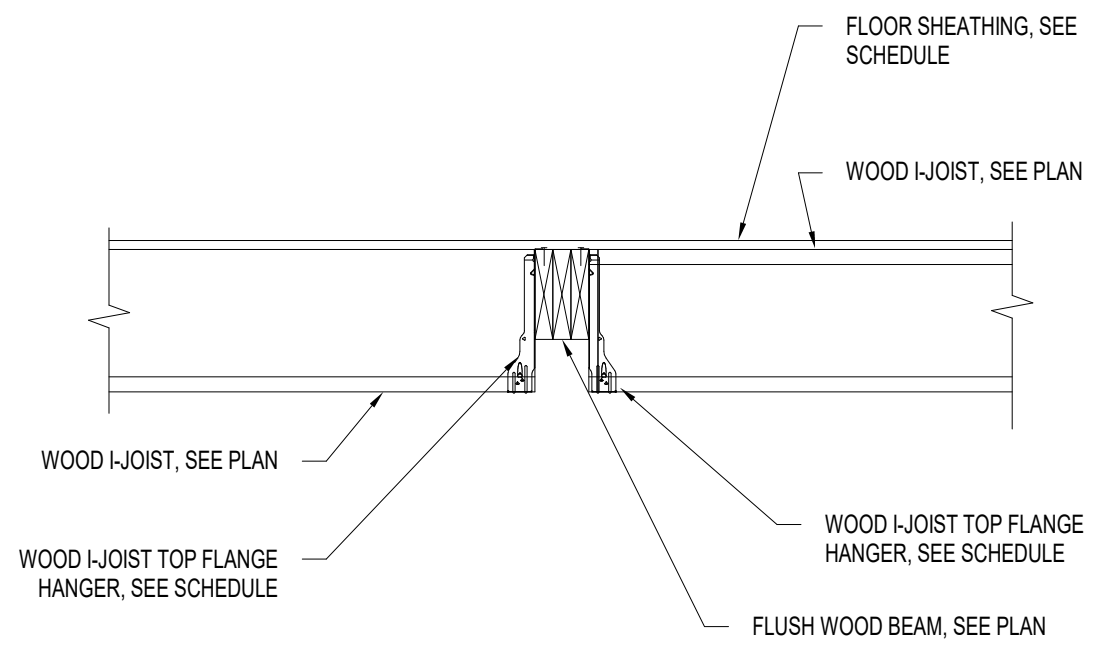


**JOISTS AT BEARING WALL (AT WOOD WALLS)**  
NOT TO SCALE

3  
S511

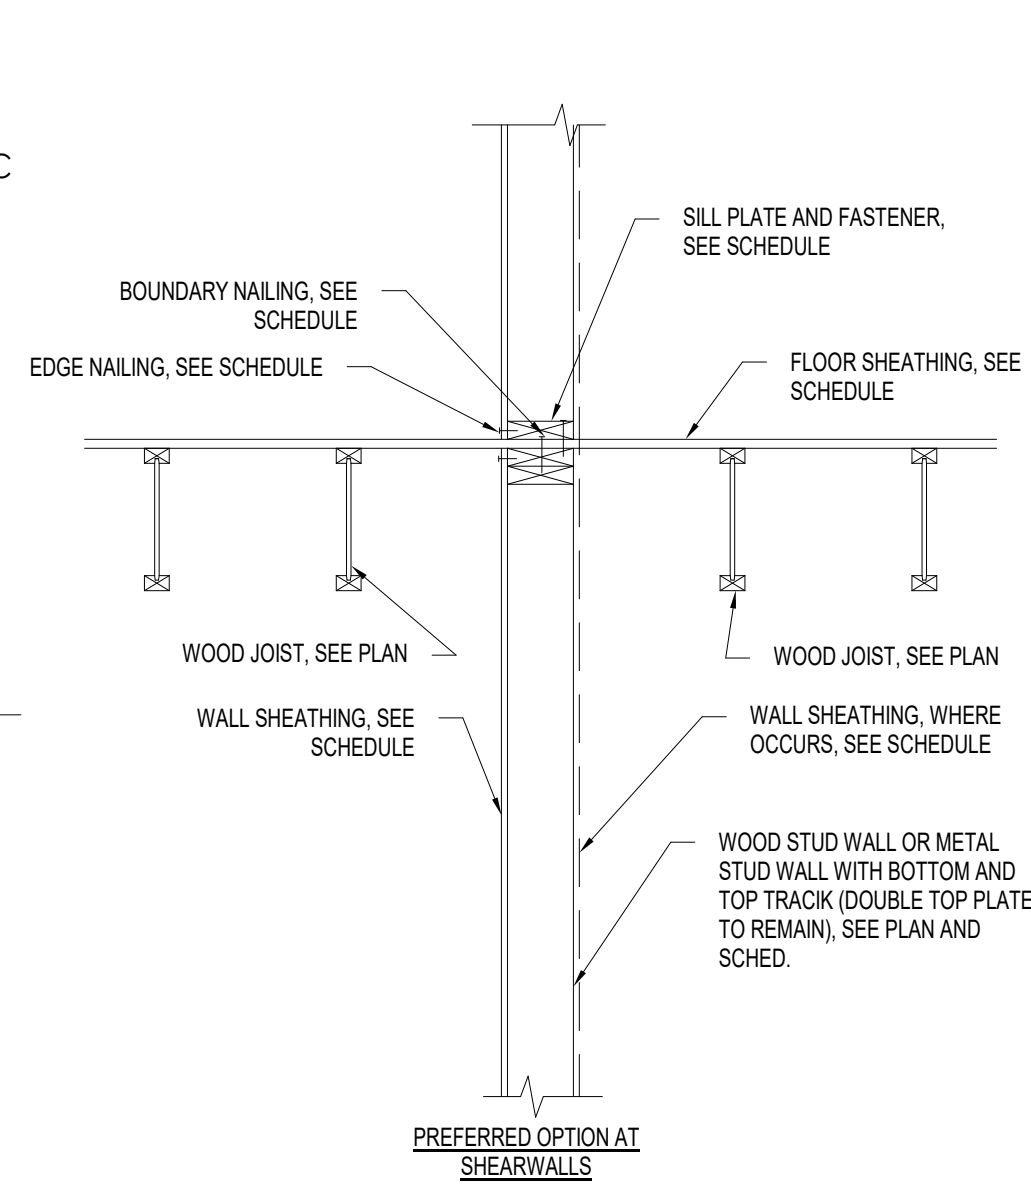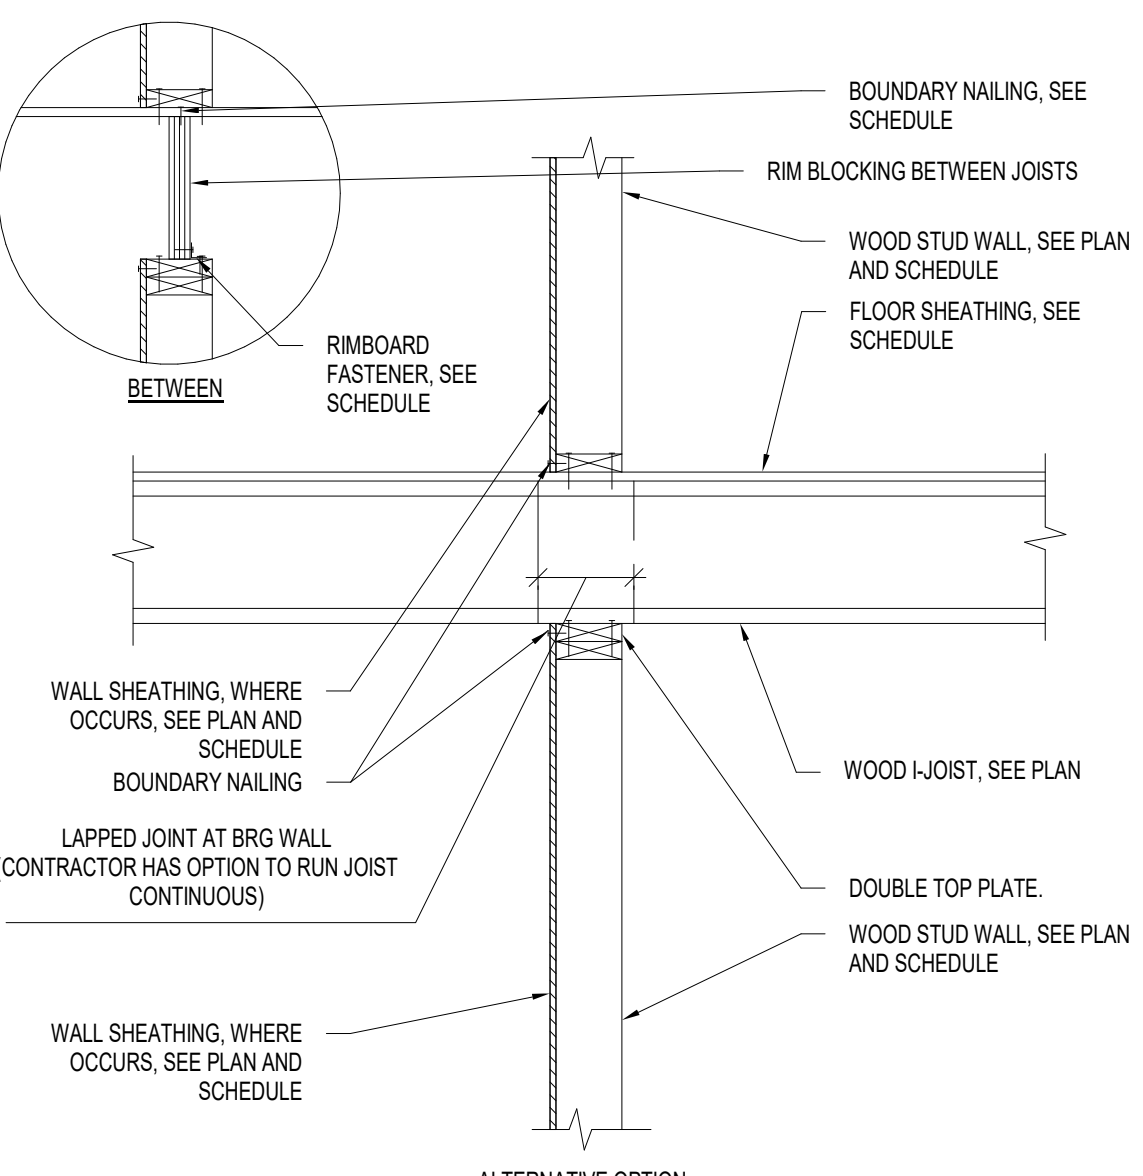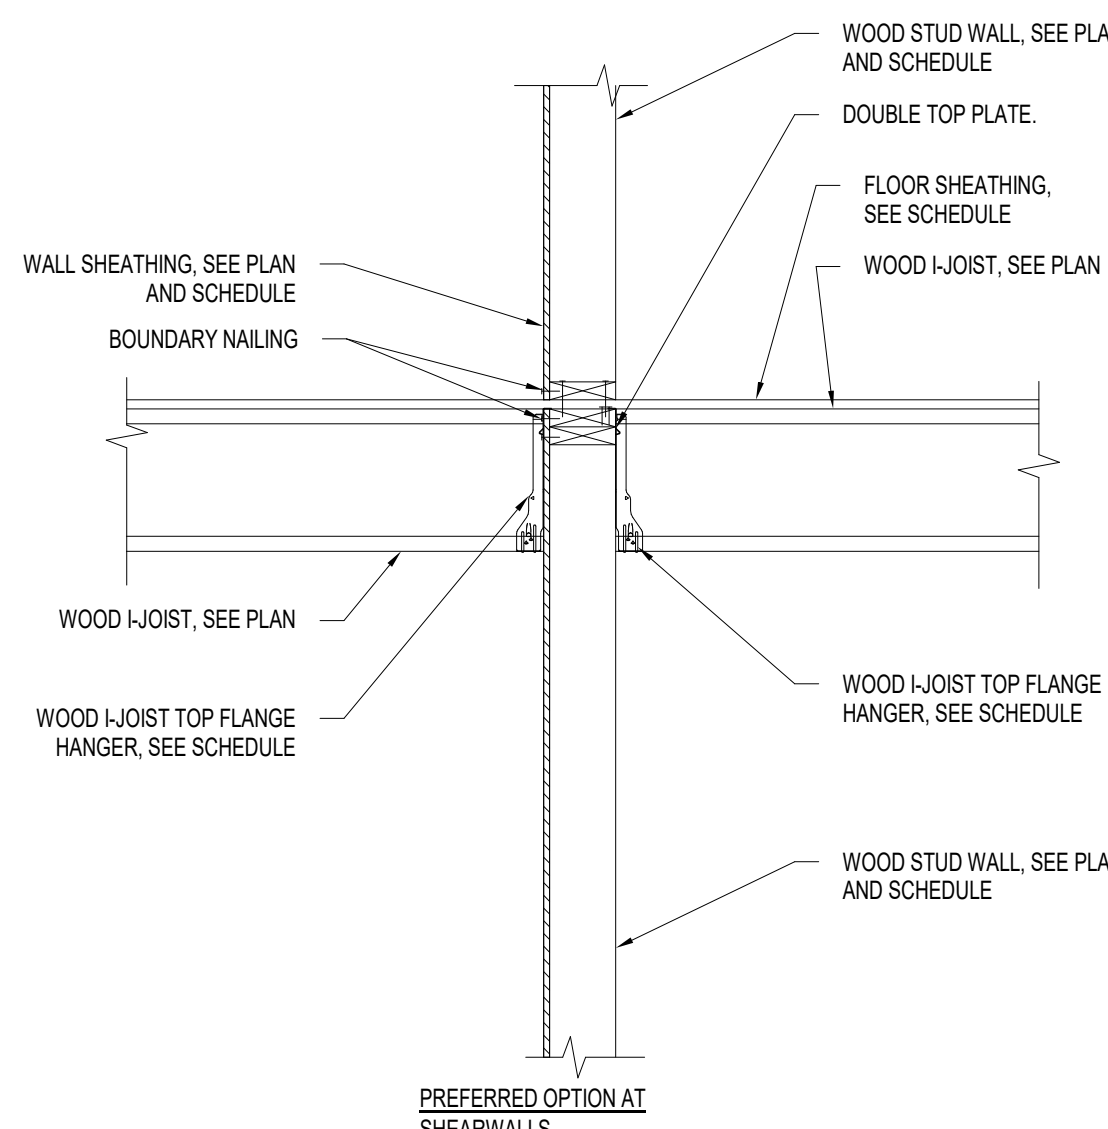


**JOISTS AT SHEARWALL**  
NOT TO SCALE

4  
S511

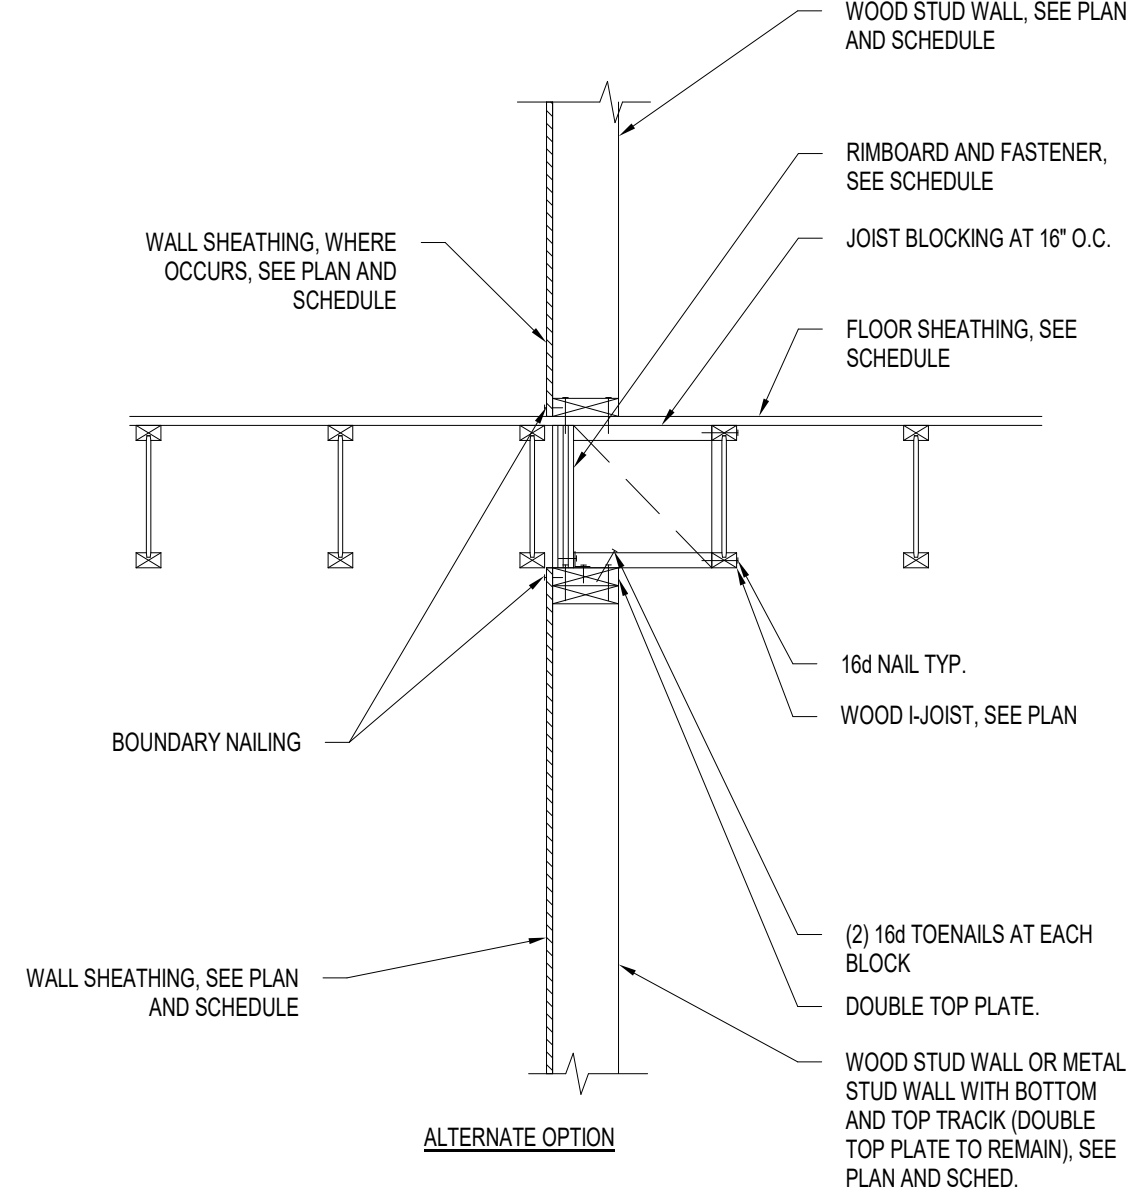


**FLUSH FRAMING TO BEAM DETAIL**  
NOT TO SCALE

5  
S511

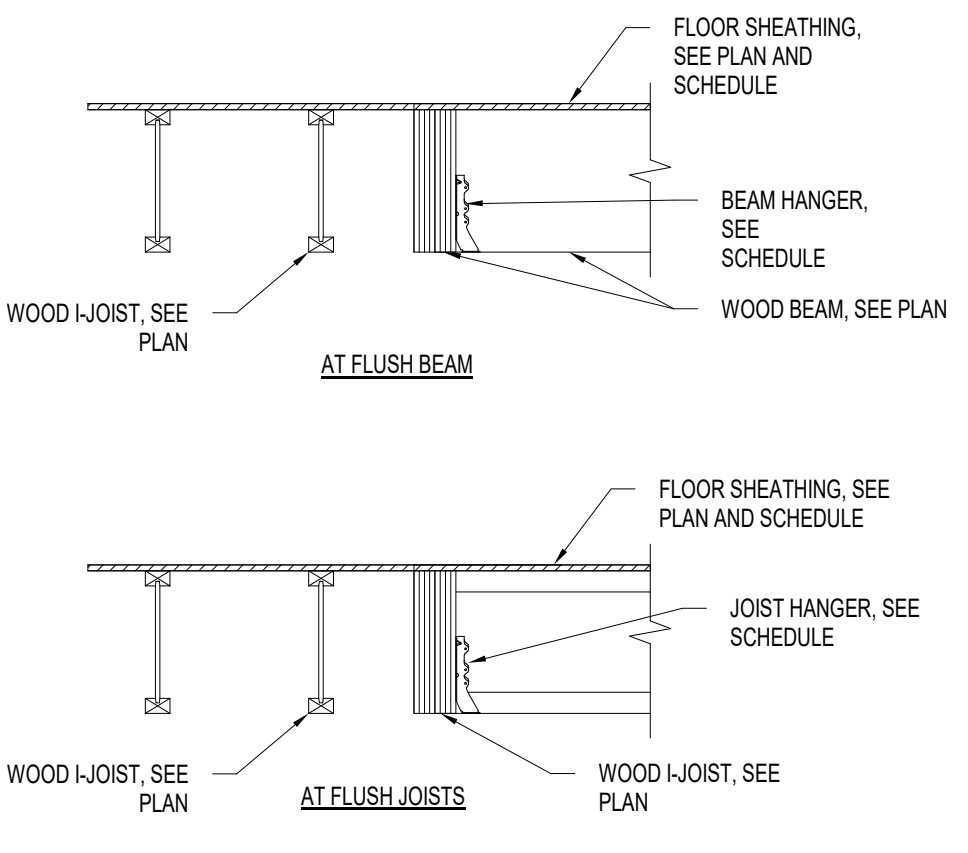



**WOOD BEAM AT DISCONTINUOUS SHEARWALL**  
NOT TO SCALE

6  
S511

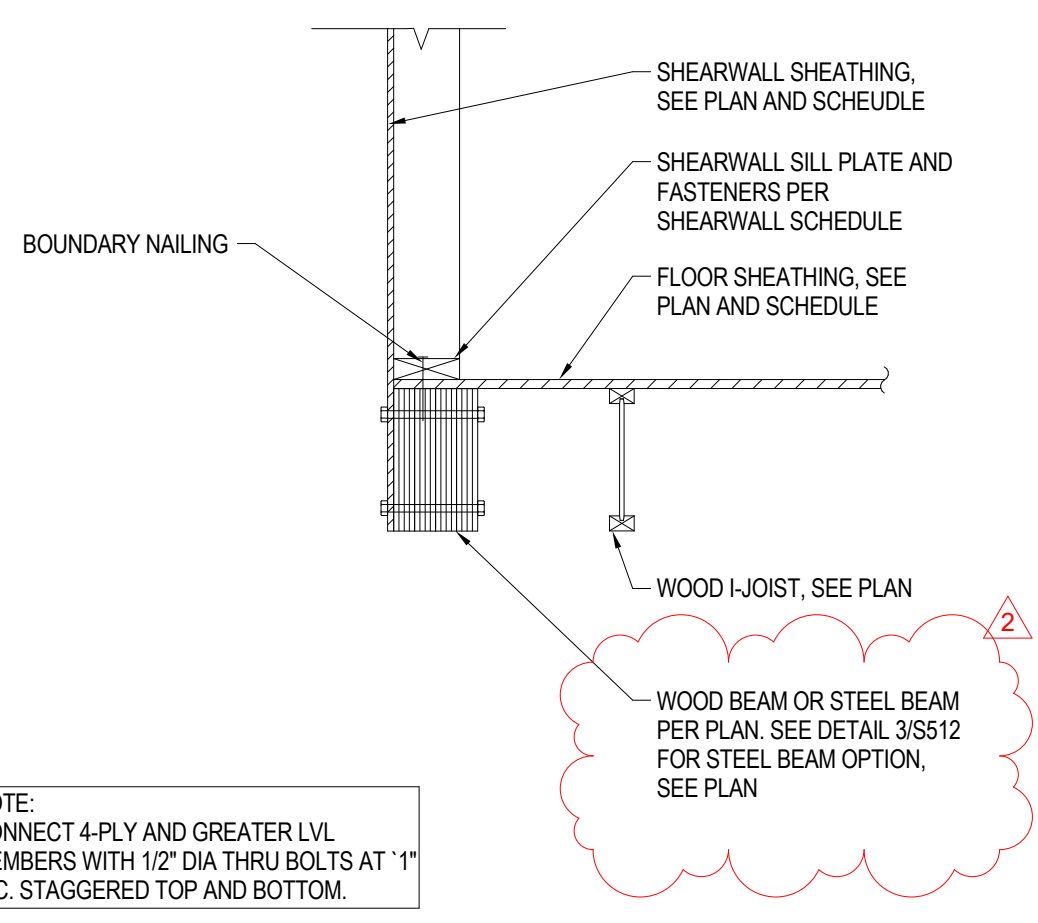

**STAIR STRINGER FRAMING**  
NOT TO SCALE

7  
S511

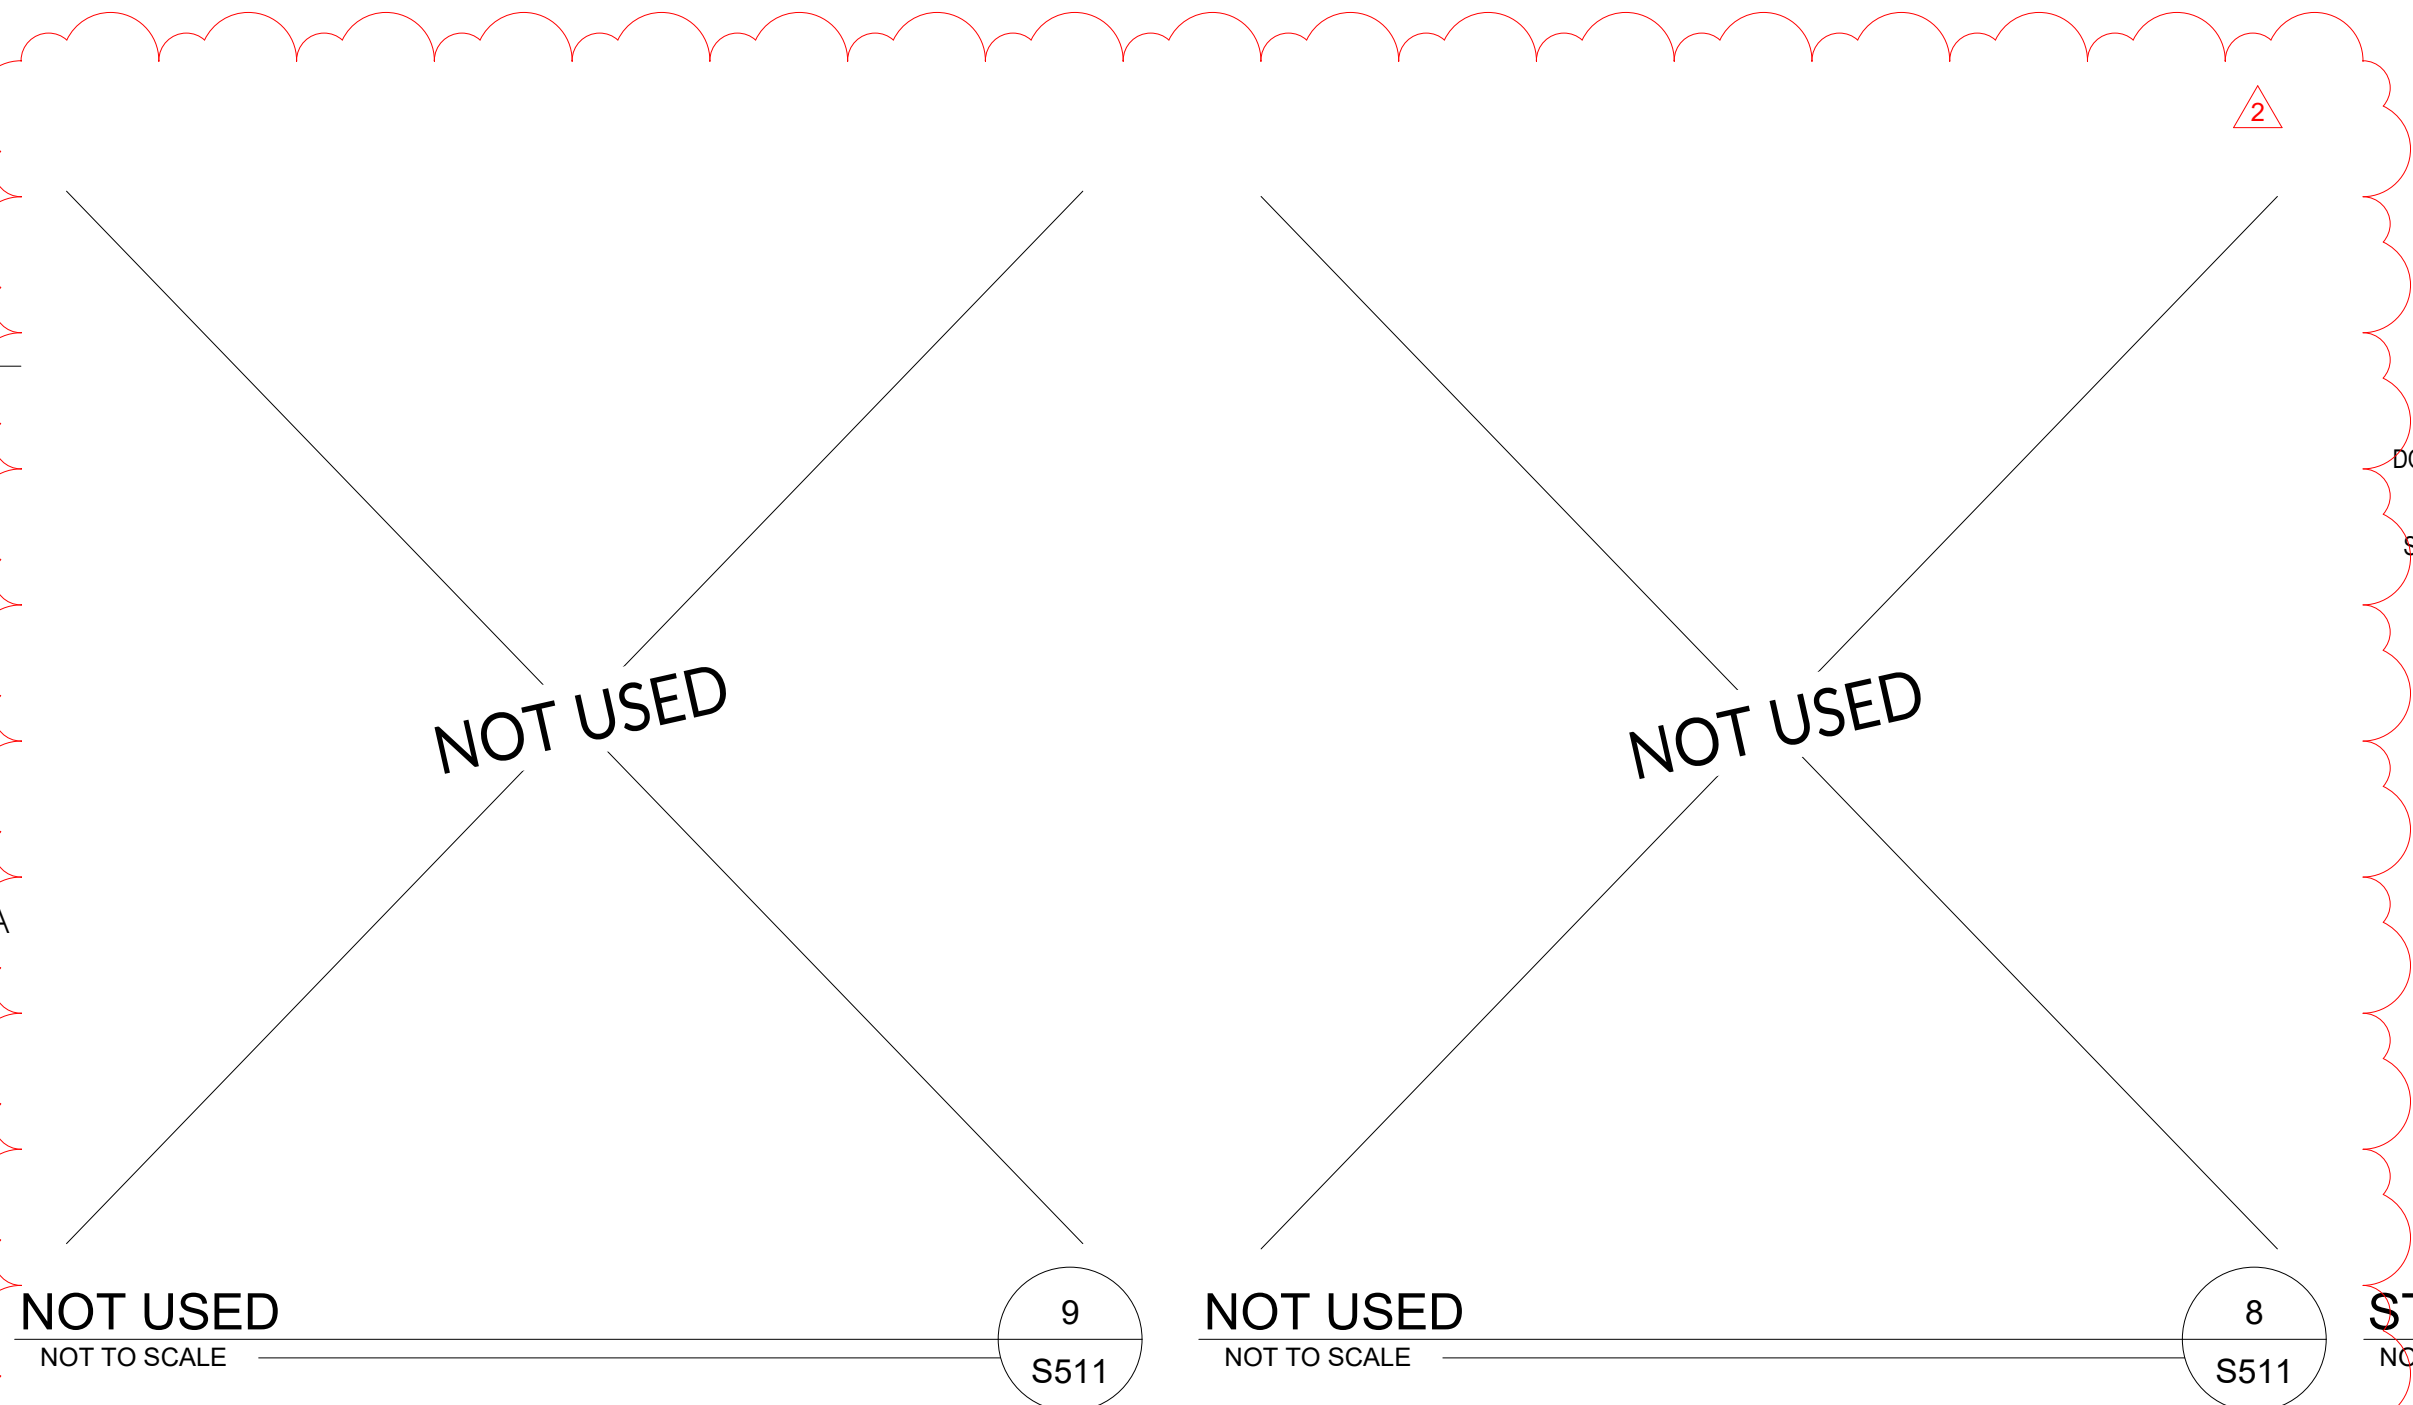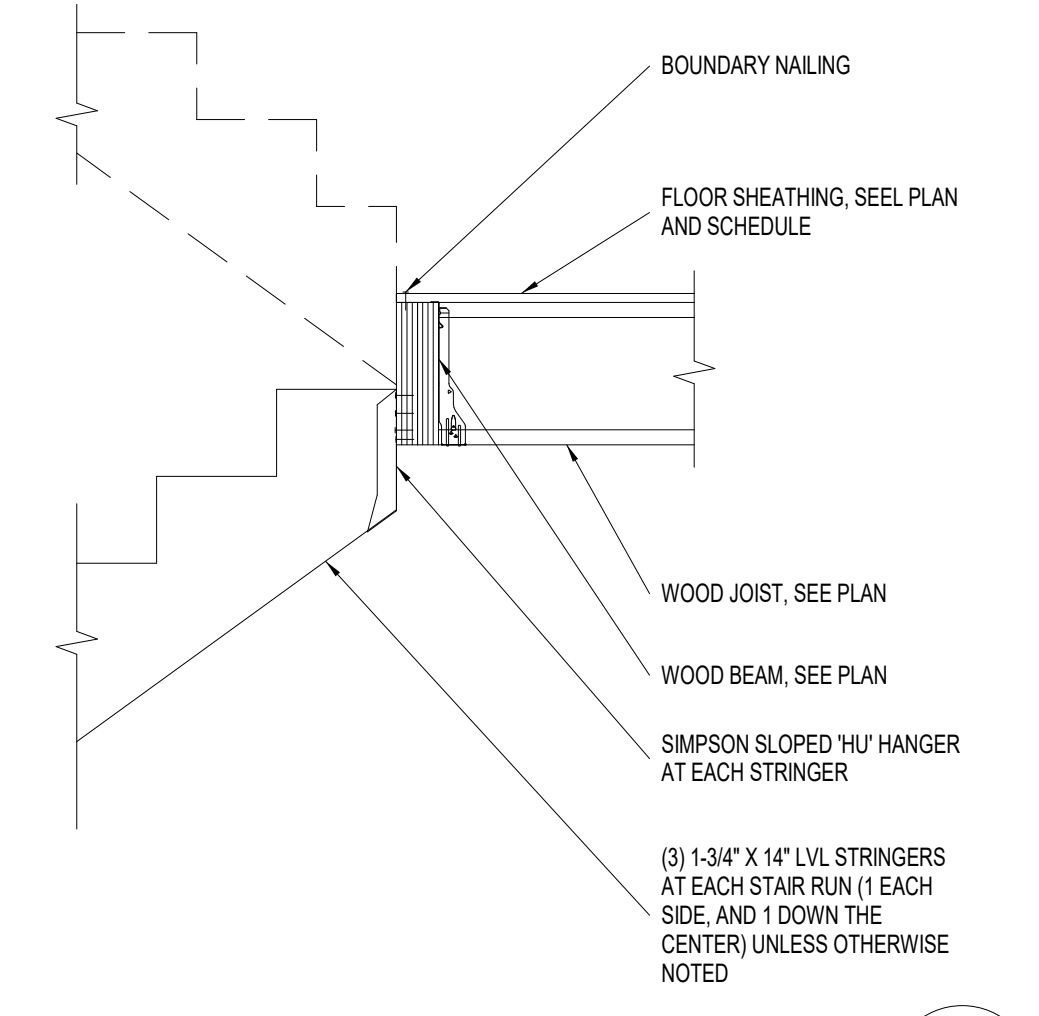


**NOT USED**  
NOT TO SCALE

9  
S511


**NOT USED**  
NOT TO SCALE

8  
S511

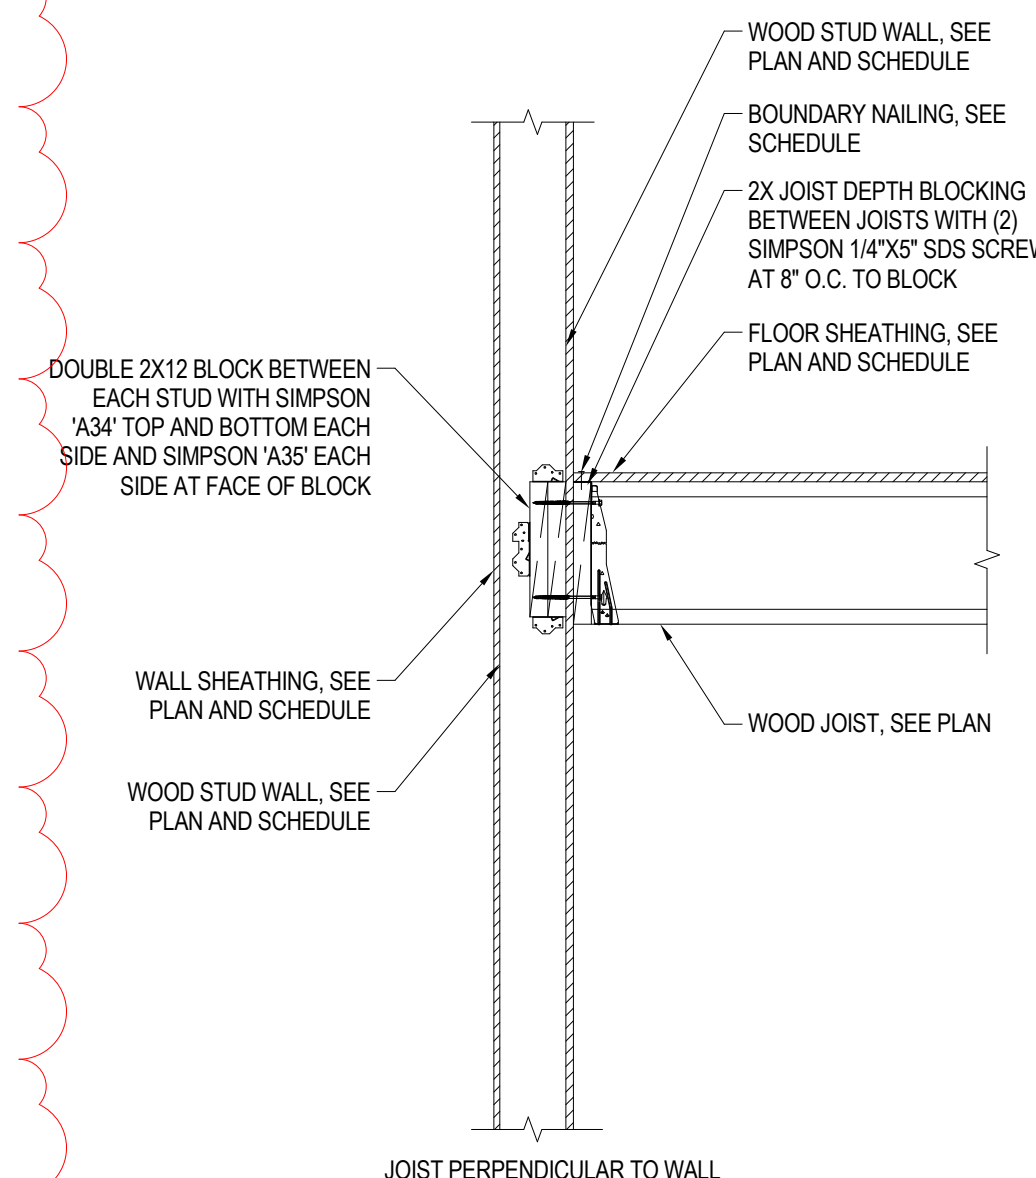



**STAIR LANDING JOIST TO WALL DETAIL**  
NOT TO SCALE

10  
S511

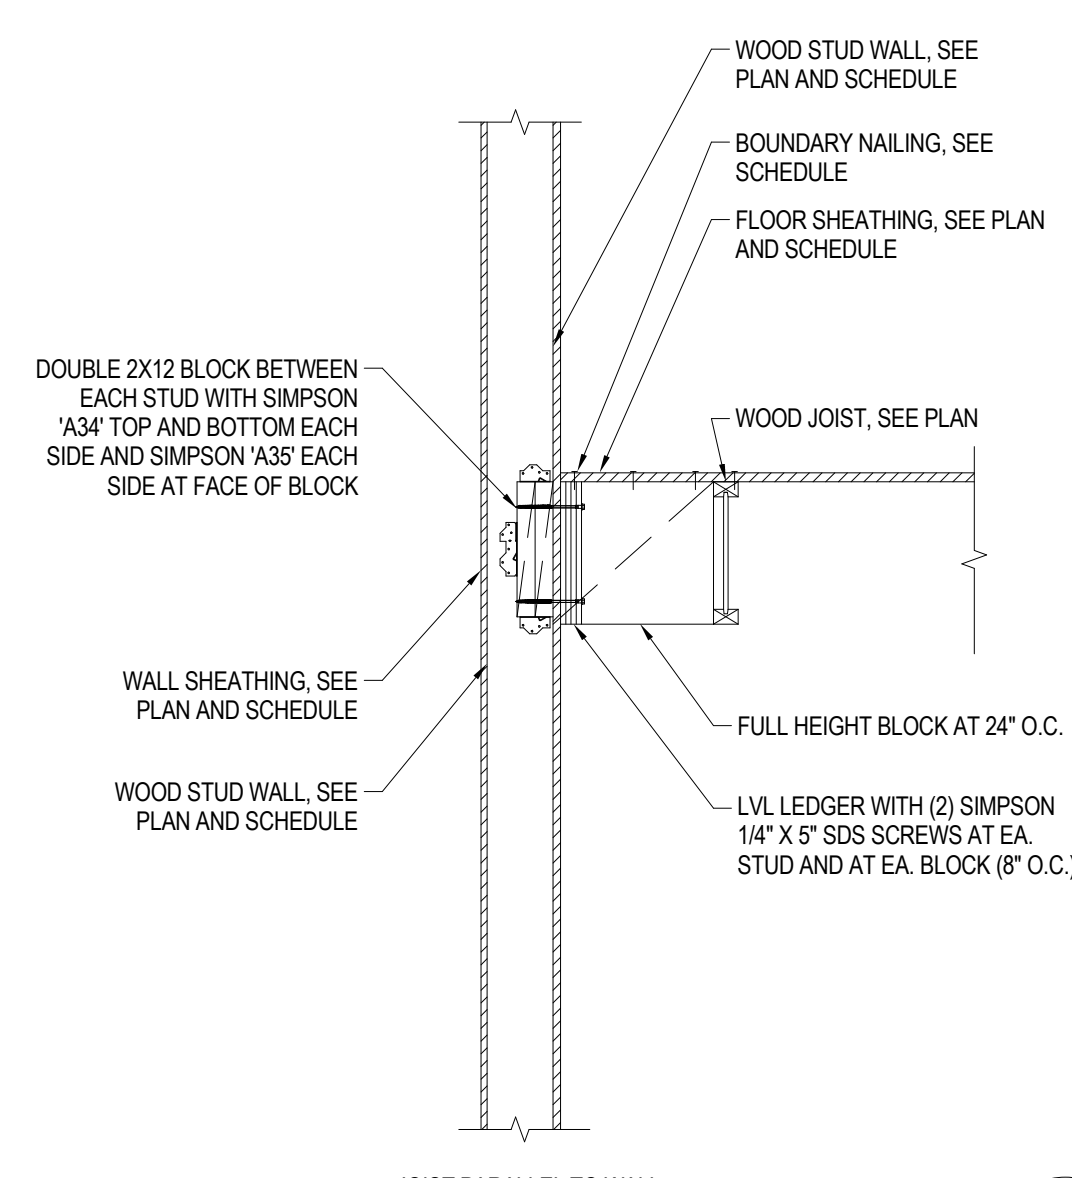

**METAL STUD JOISTS TO WALL DETAIL**  
NOT TO SCALE

11  
S511

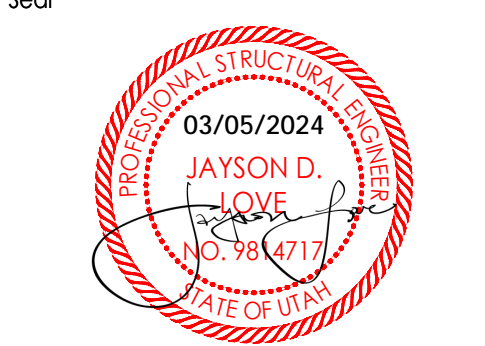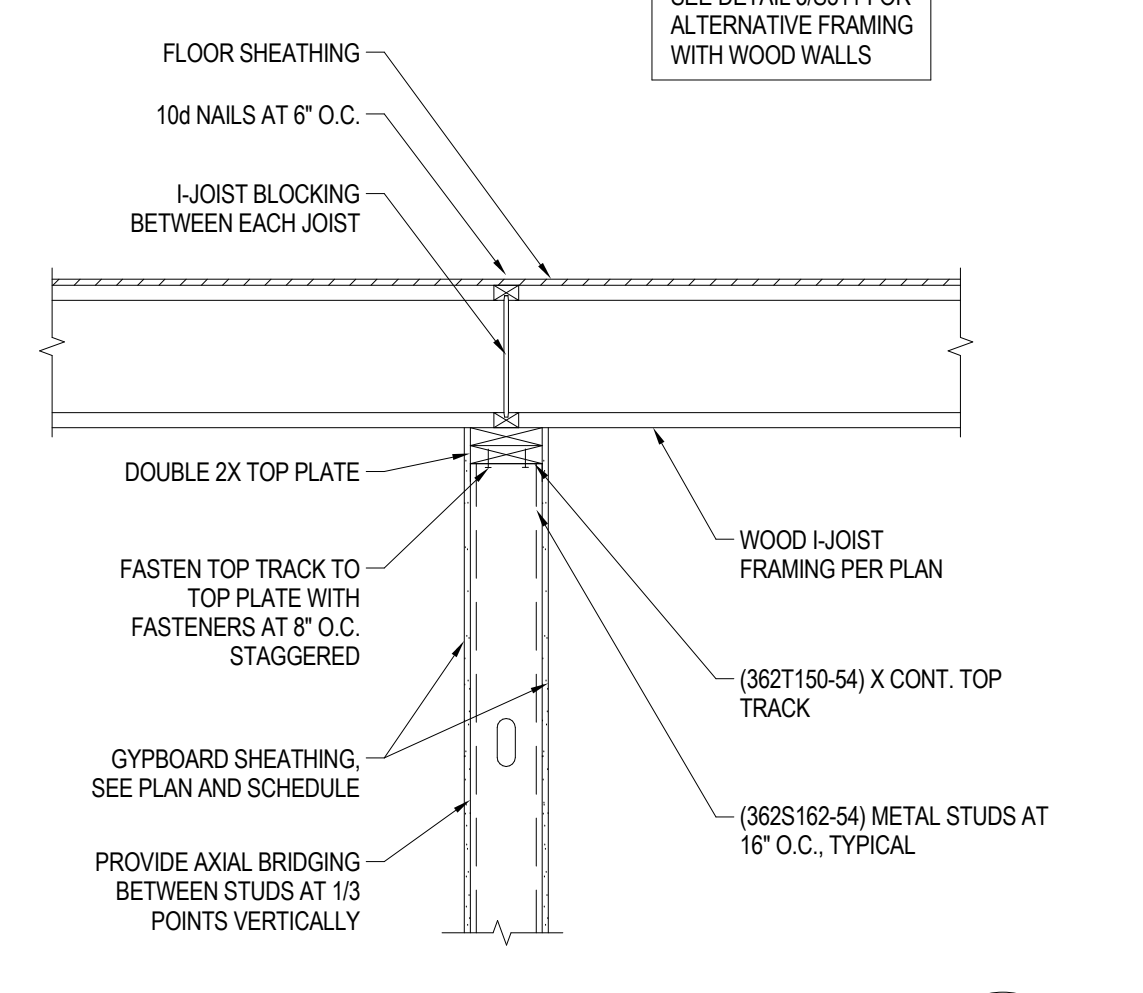

**JONES & ASSOCIATES**  
CONSULTING ENGINEERS  
6080 S FASHION POINT DRIVE  
SOUTH OGDEN, UT 84405


Project Name  
SAA Project No. 2022-11  
Drawing Title

Issued No.	Date	Description
1	09.21.23	PERMIT SET
2	02.29.23	PLAN REVIEW

Revision No.	Date	Description
1	10.30.23	ADDENDUM #1
2	02.29.23	PLAN REVIEW/REDESIGN


**FLOOR FRAMING DETAILS**

Sheet Number  
**S511**

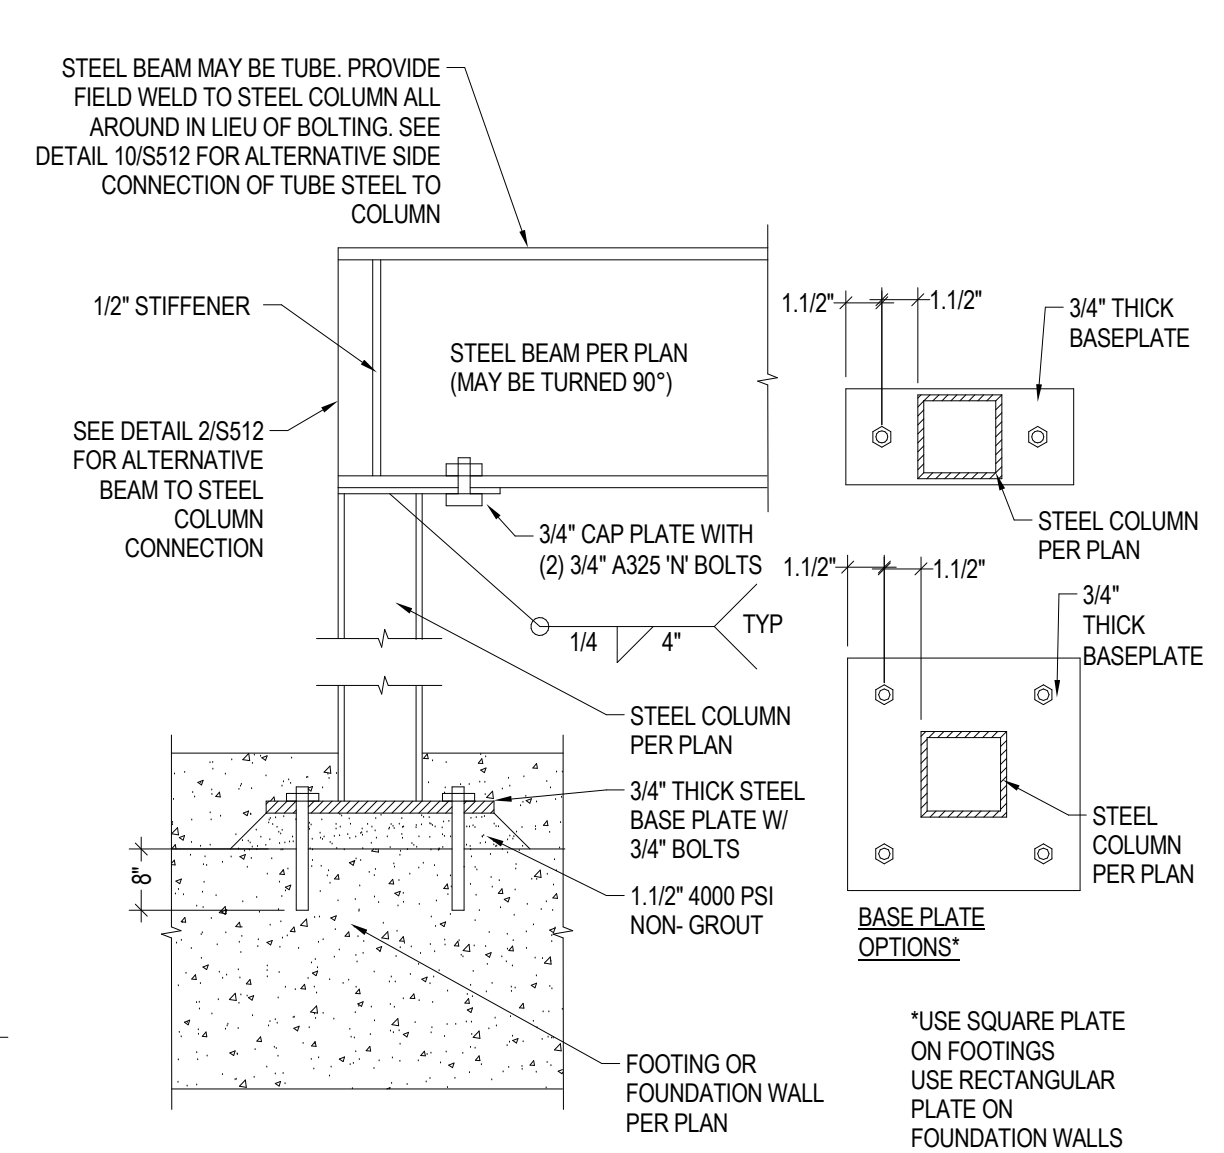

**STEEL COLUMN DETAIL**  
NOT TO SCALE

1  
S512

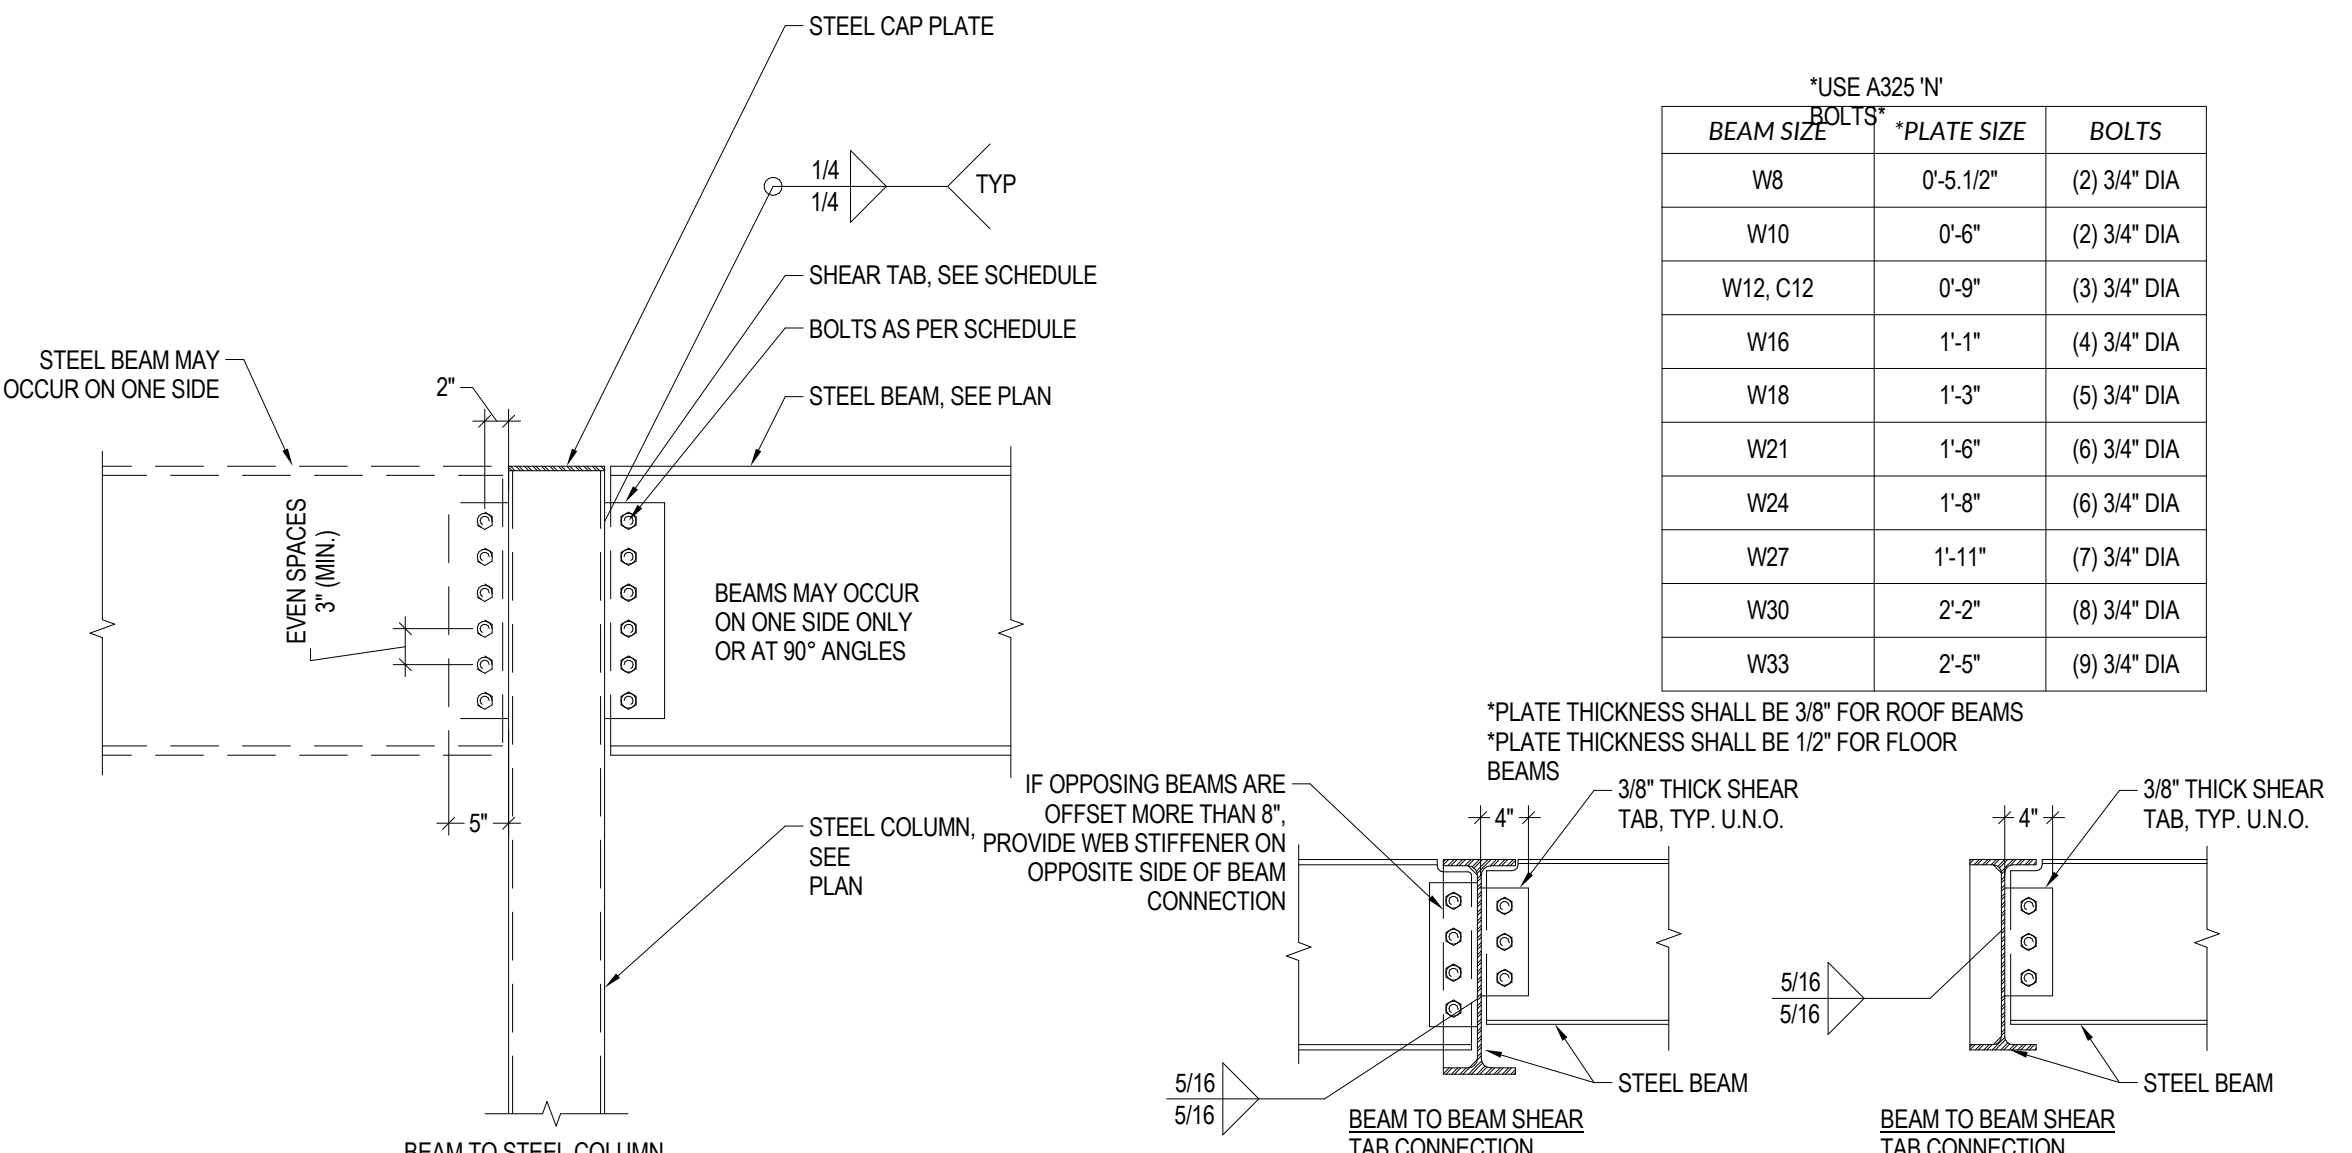


**STEEL BEAM BOLT DETAILS**  
NOT TO SCALE

2  
S512


BEAM SIZE	*PLATE SIZE	BOLTS
WB	0'-5.1/2"	(2) 3/4" DIA
W10	0'-6"	(2) 3/4" DIA
W12, C12	0'-9"	(3) 3/4" DIA
W16	1'-1"	(4) 3/4" DIA
W18	1'-3"	(5) 3/4" DIA
W21	1'-6"	(6) 3/4" DIA
W24	1'-8"	(6) 3/4" DIA
W27	1'-11"	(7) 3/4" DIA
W30	2'-2"	(8) 3/4" DIA
W33	2'-5"	(9) 3/4" DIA

\*USE A325 'N' BOLTS

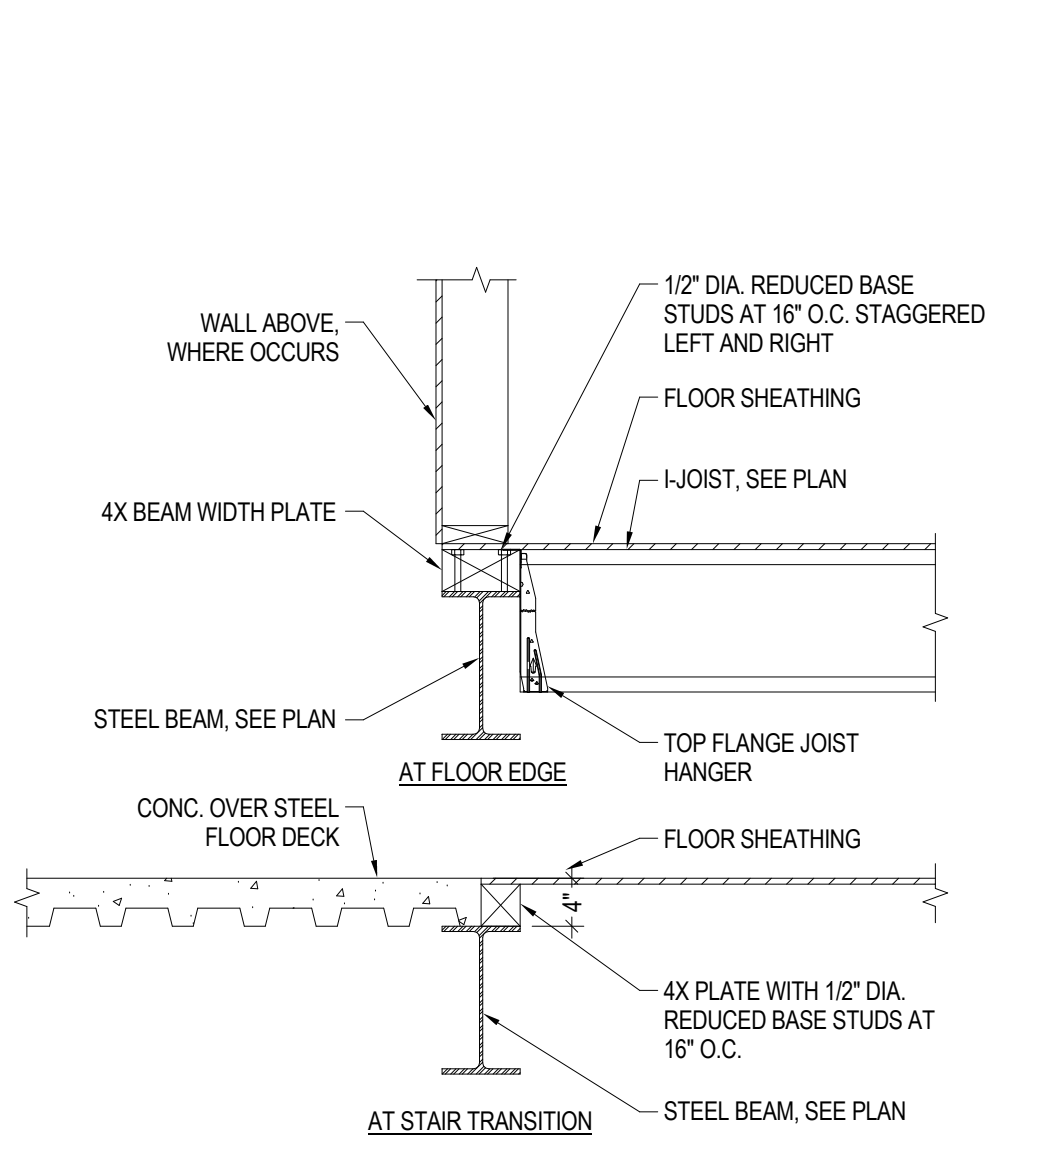


**STEEL BEAM AT FLOOR DETAIL**  
NOT TO SCALE

3  
S512

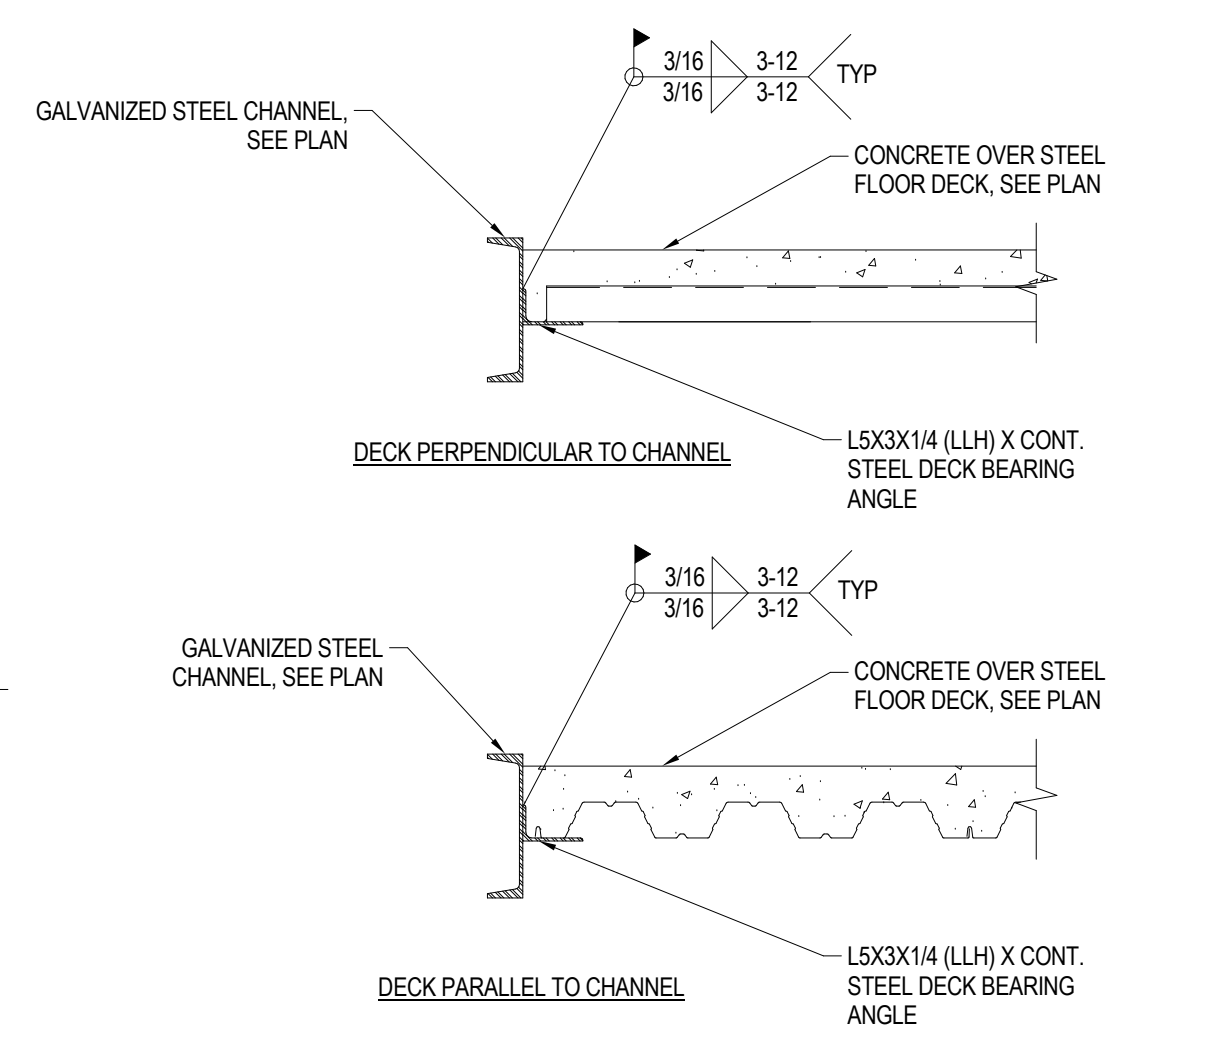


**TYPICAL CONCRETE SLAB TO STEEL CHANNEL AND TUBE STEEL BEAM**  
NOT TO SCALE

4  
S512

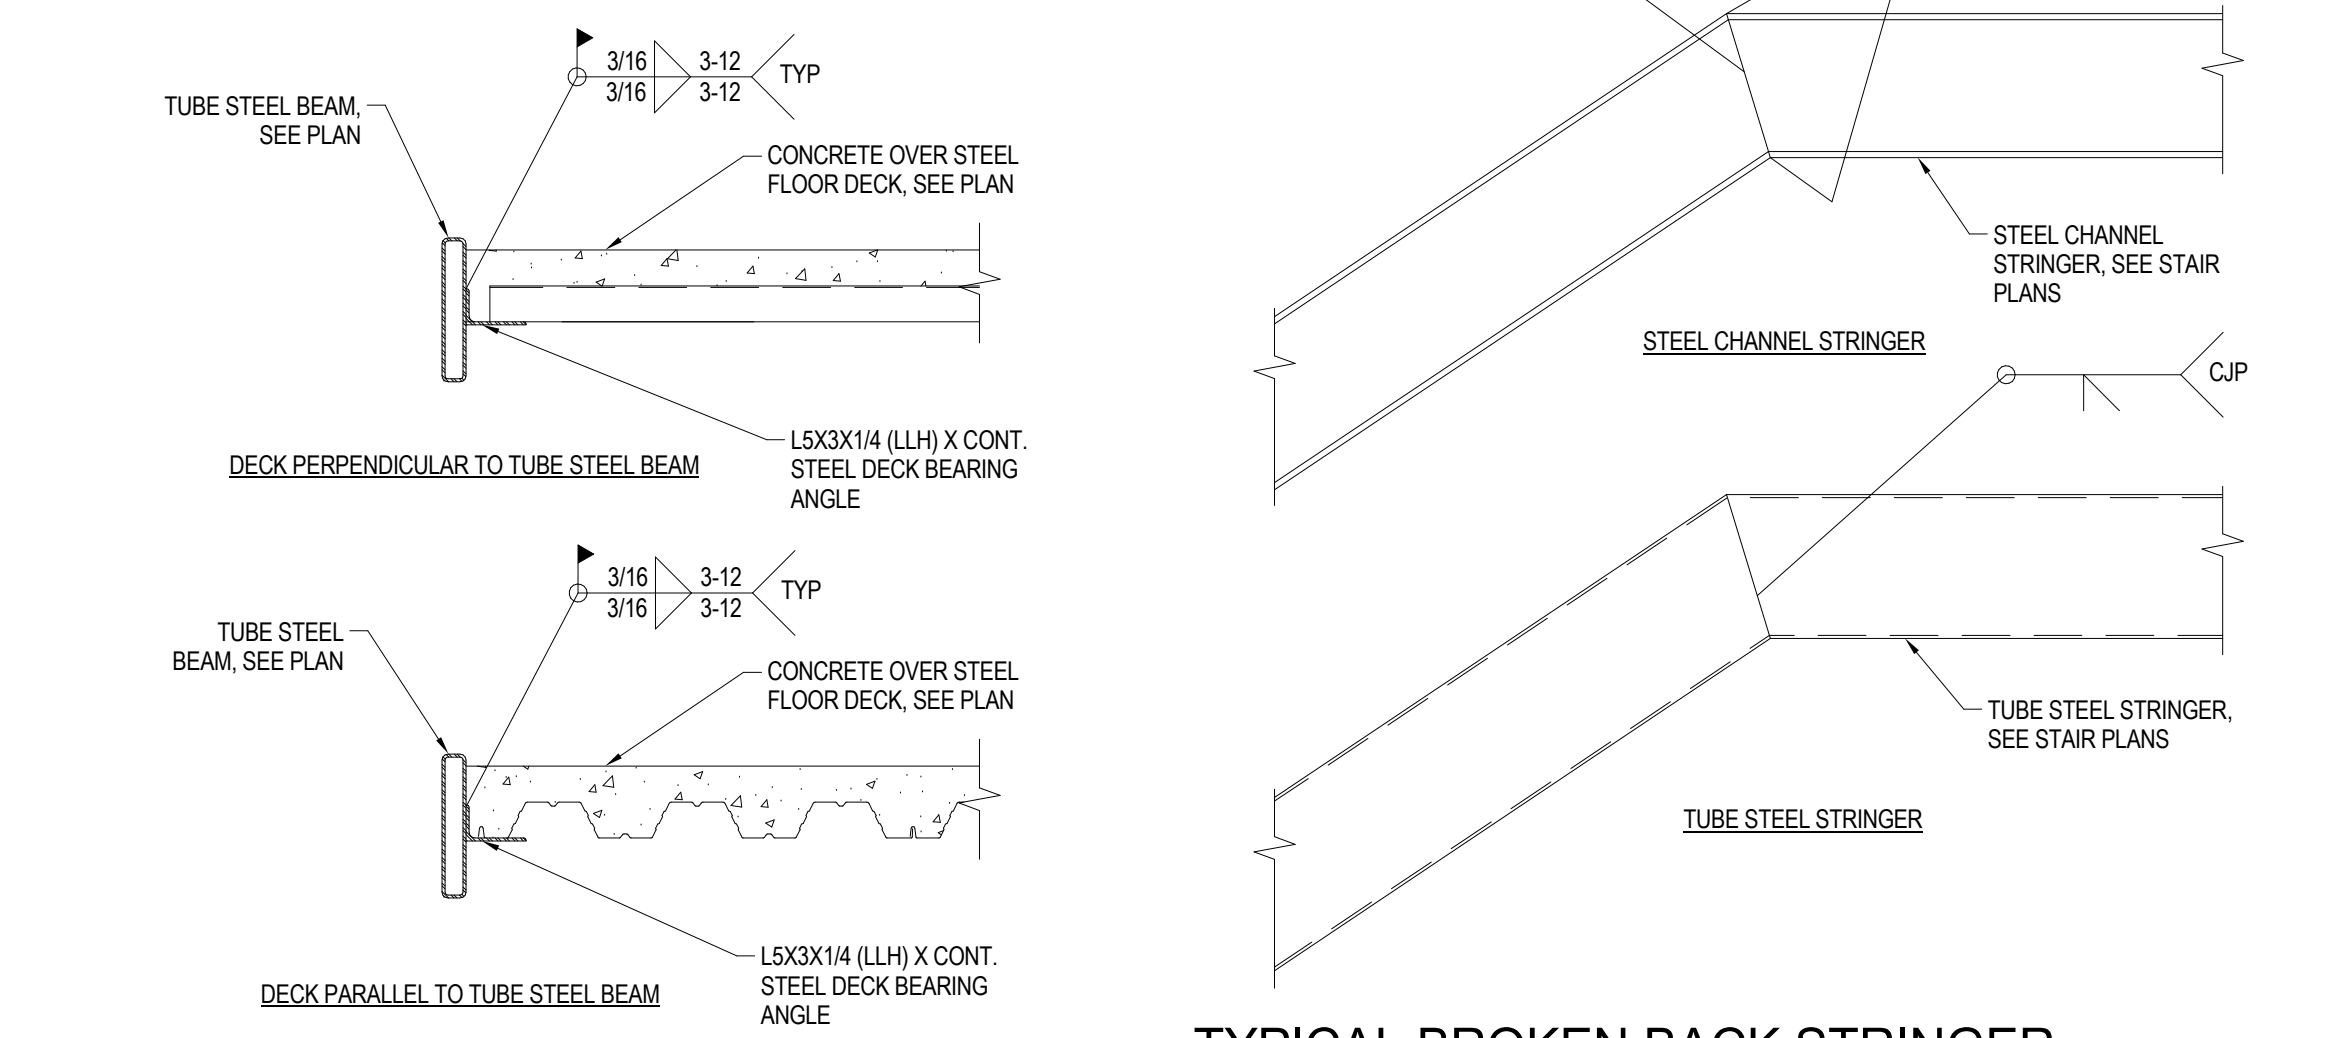


**TYPICAL BROKEN BACK STRINGER CONNECTION DETAIL**  
NOT TO SCALE

5  
S512

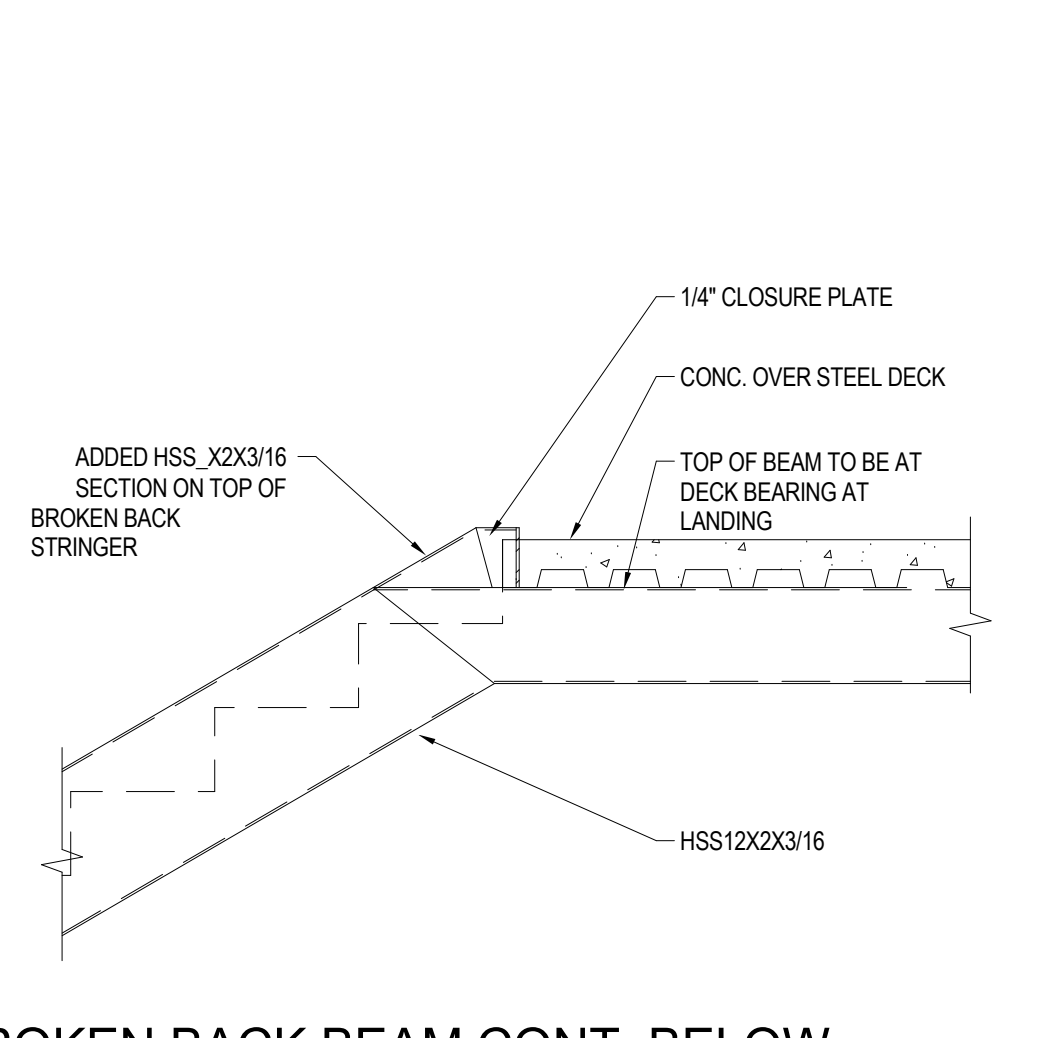


**BROKEN BACK BEAM CONT. BELOW LANDING**  
NOT TO SCALE

6  
S512

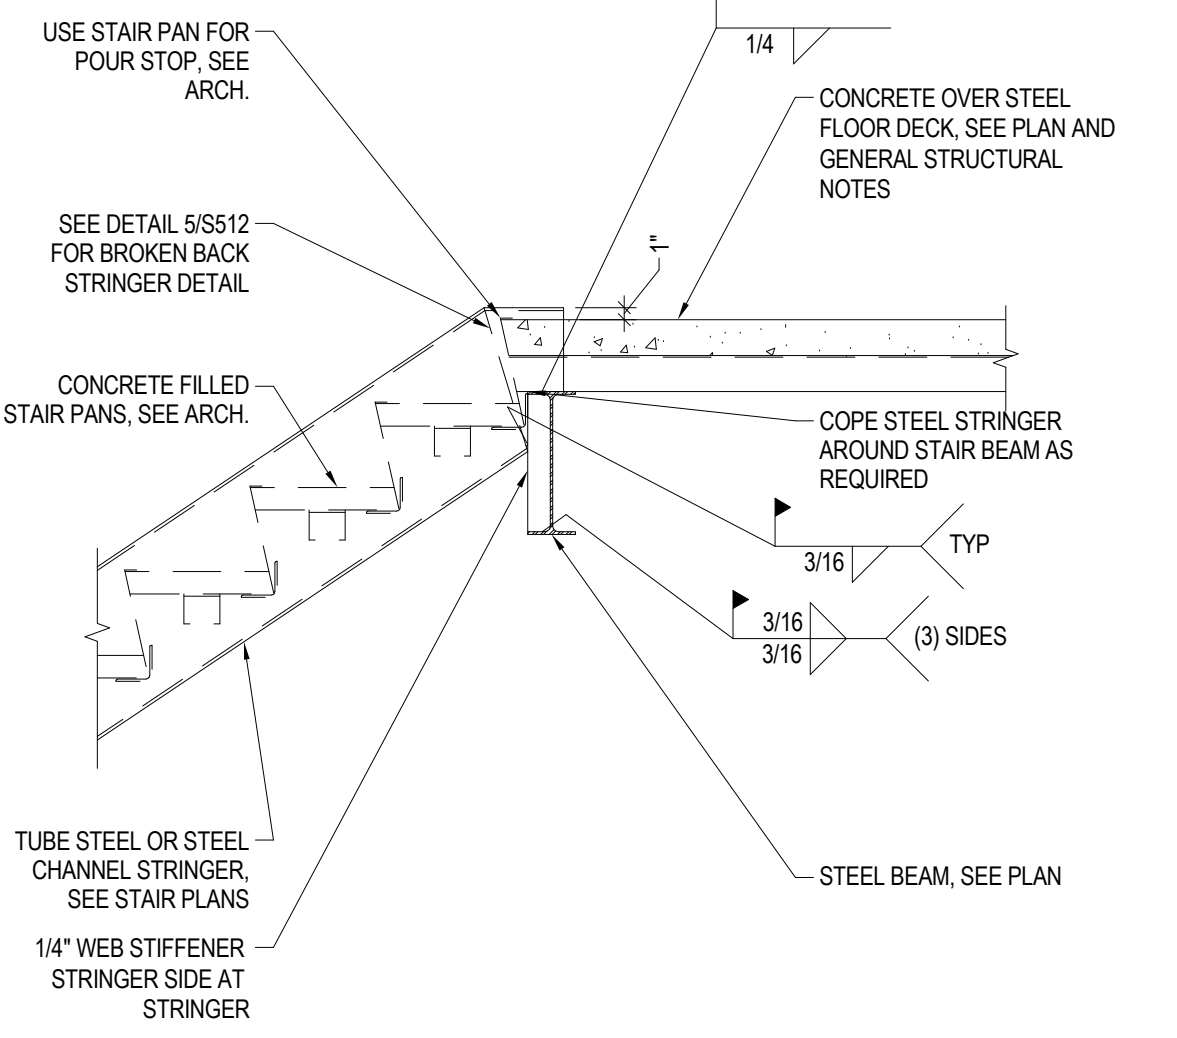


**TYPICAL STEEL STRINGER FRAMING**  
NOT TO SCALE

7  
S512

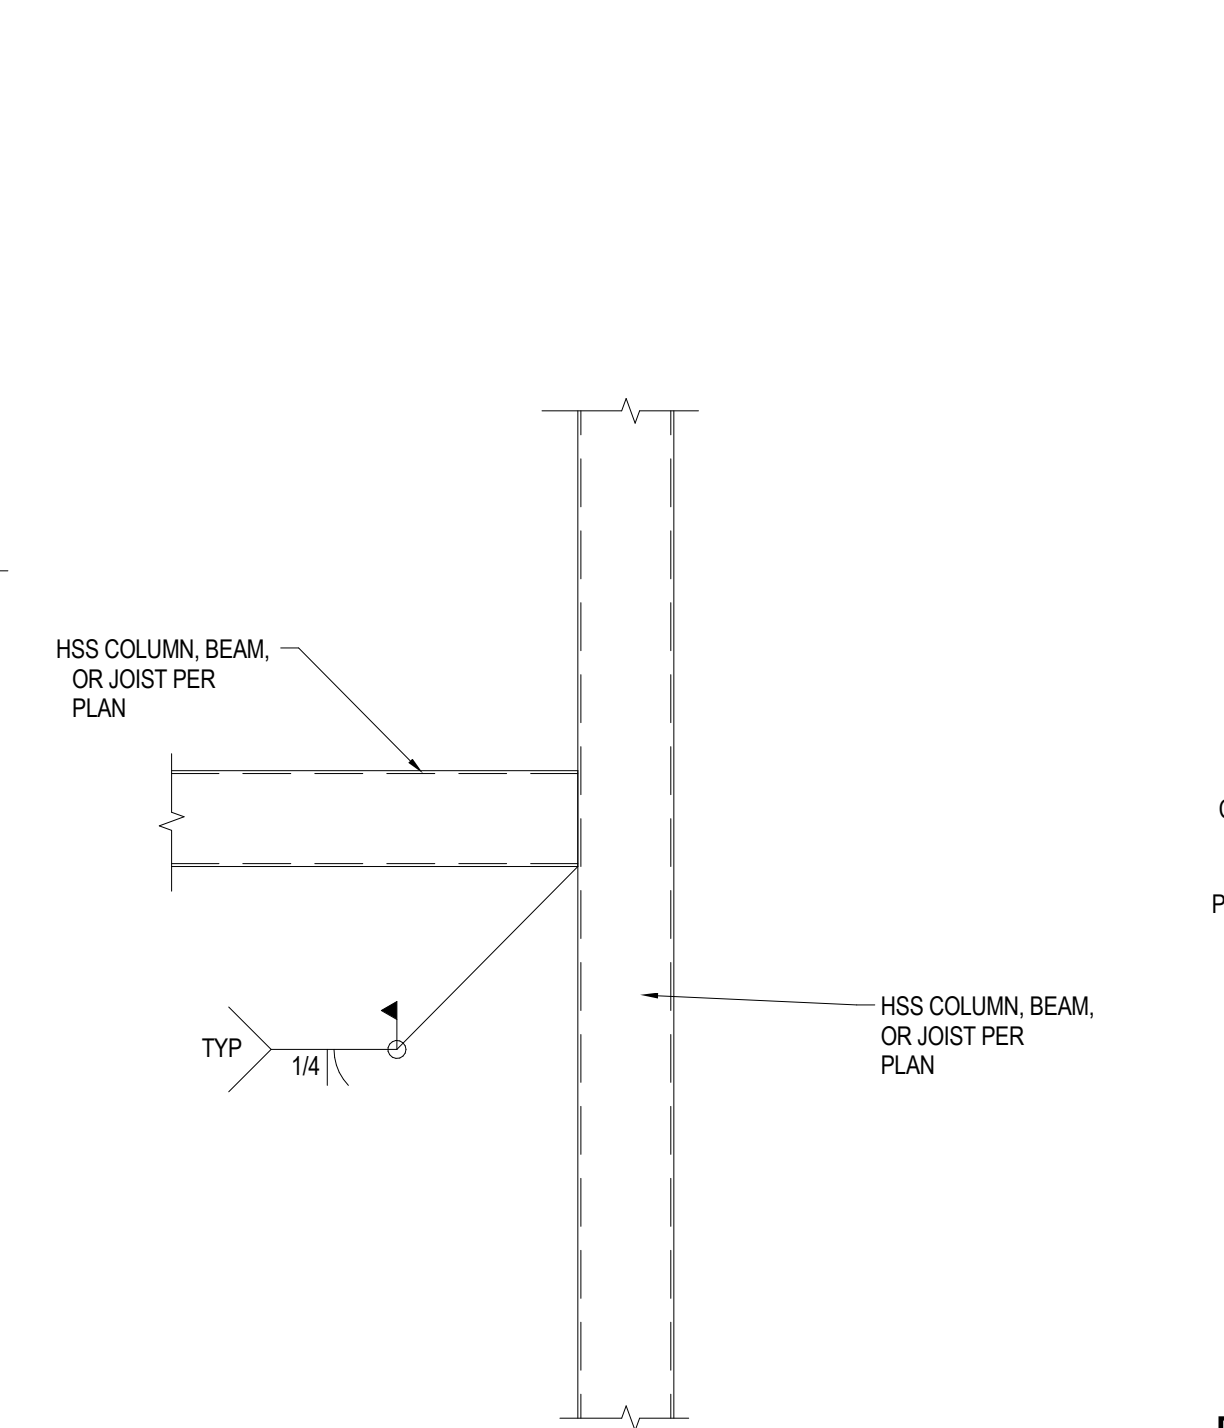


**HSS TO HSS CONNECTION**  
NOT TO SCALE

8  
S512

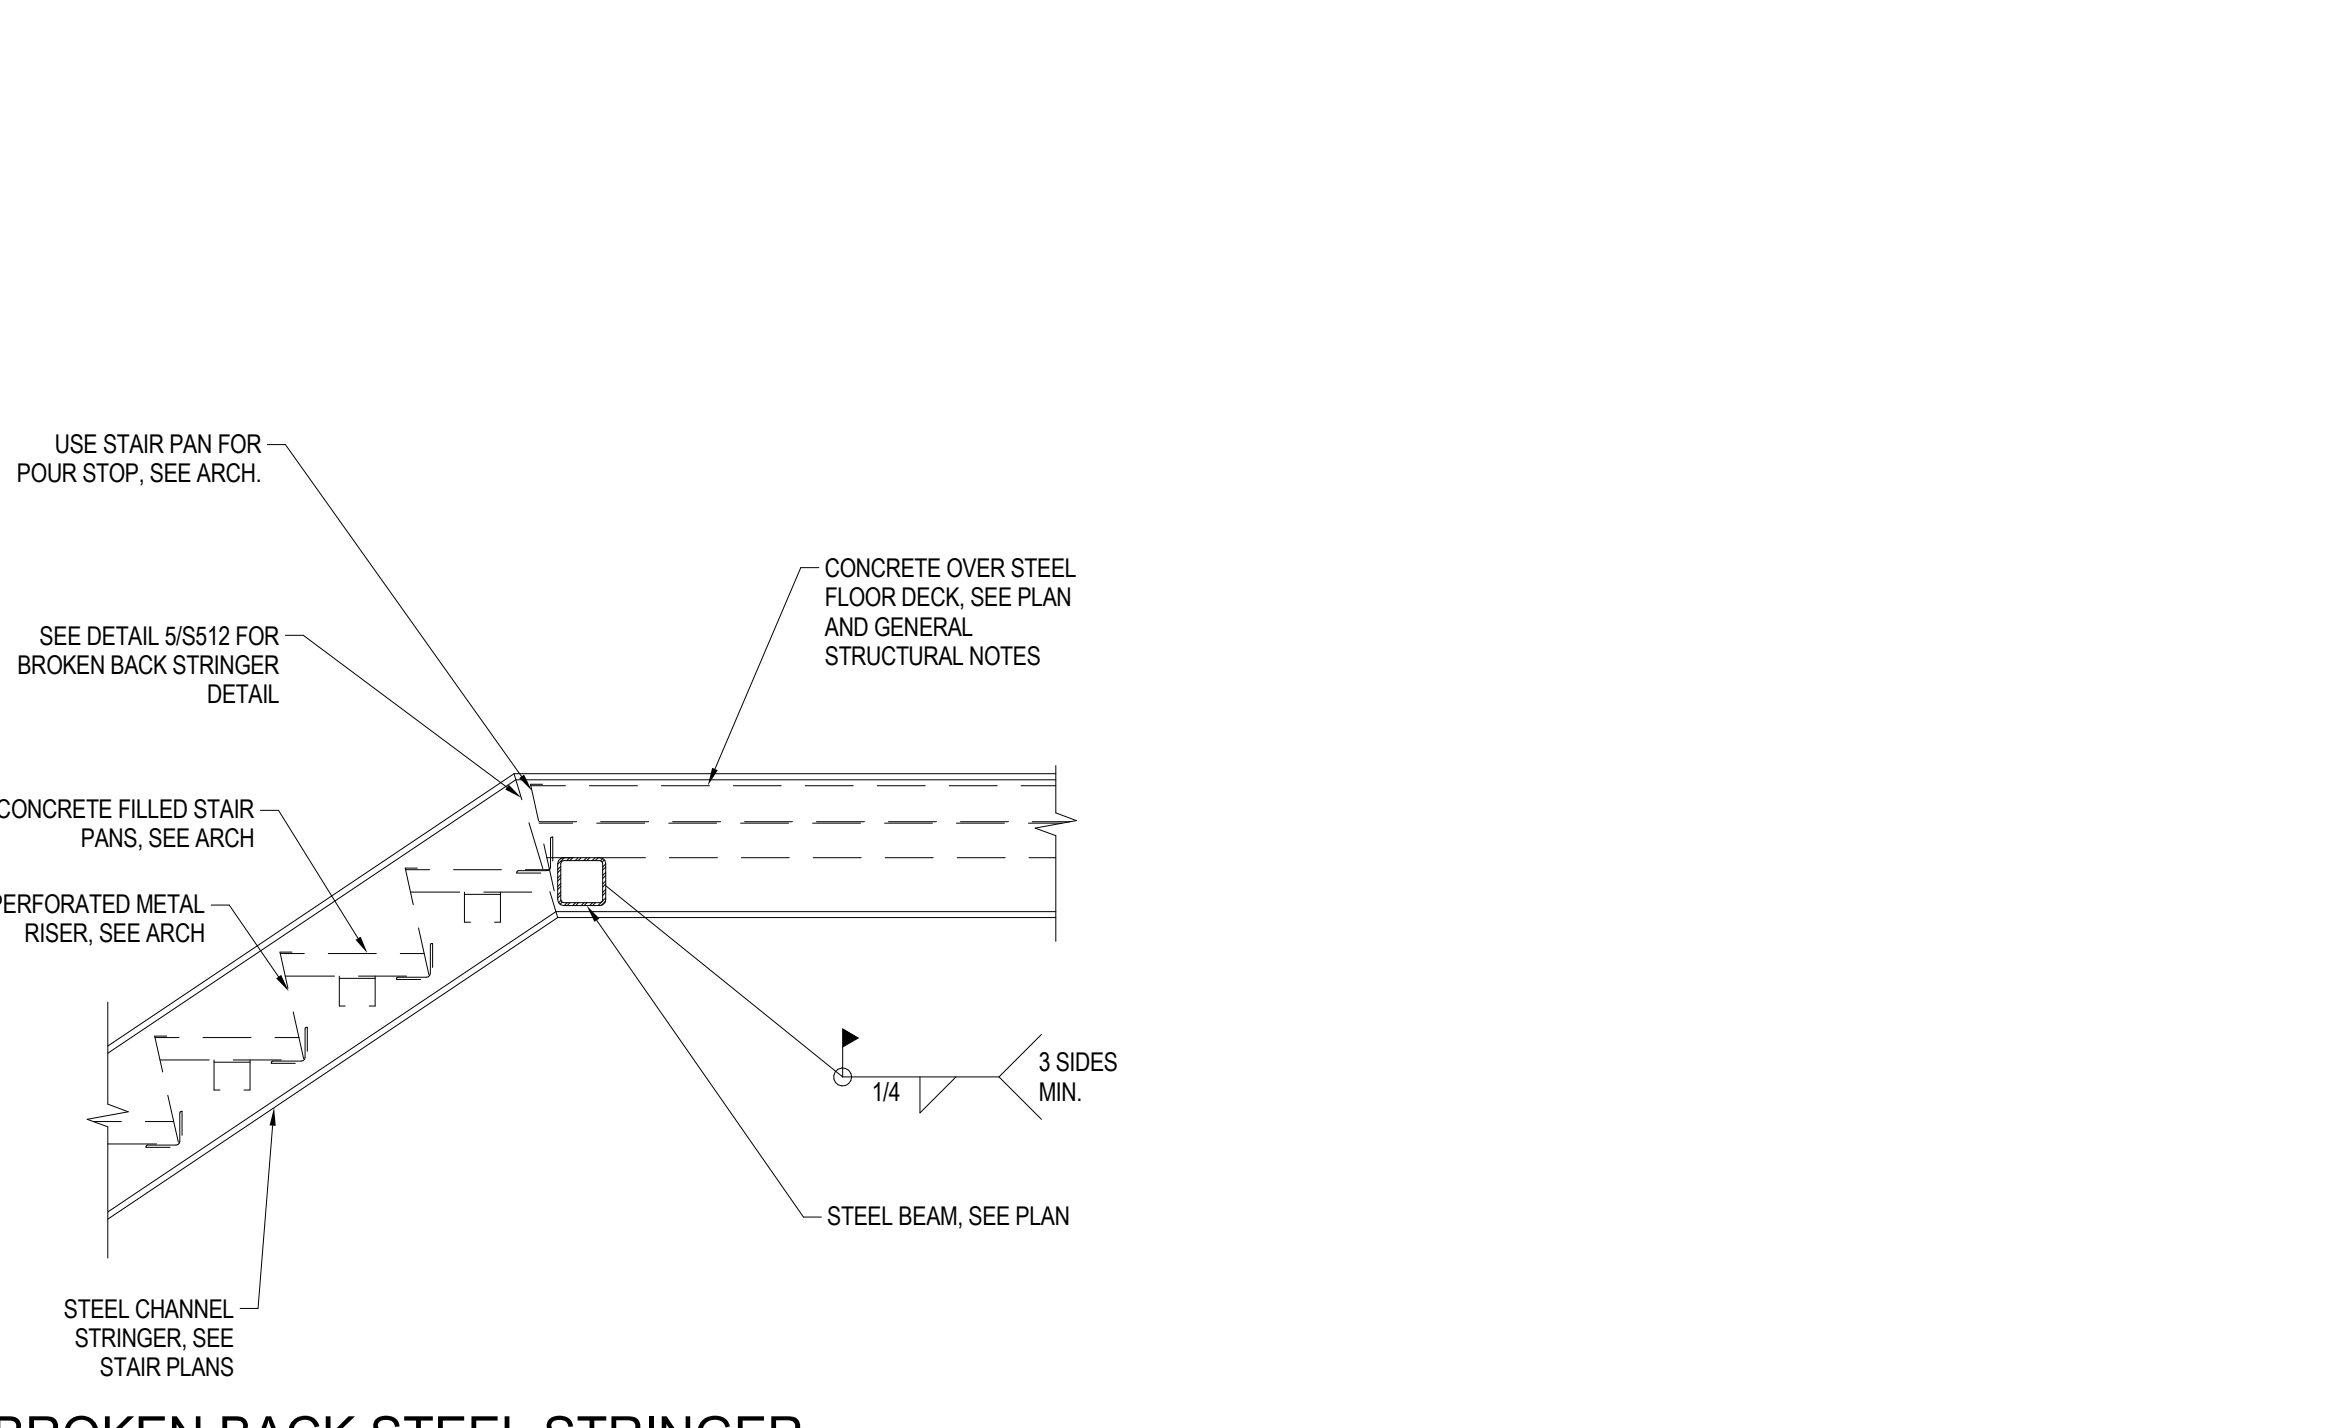

**BROKEN BACK STEEL STRINGER FRAMING**  
NOT TO SCALE

9  
S512

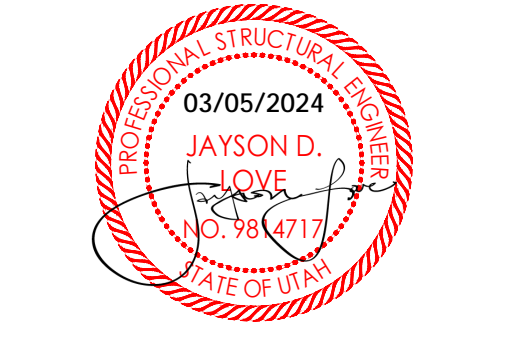

**JONES & ASSOCIATES**  
CONSULTING ENGINEERS  
6080 S FASHION POINT DRIVE  
SOUTH OGDEN, UT 84405

Project Name

Issued	No.	Date	Description
	1	09.21.23	PERMIT SET
	2	02.29.23	PLAN REVIEW


  

Revision	No.	Date	Description
	2	02.29.23	PLAN REVIEW/REDESIGN


SAA Project No. 2022-11  
Drawing Title

**FLOOR FRAMING DETAILS**

Sheet Number  
**S512**

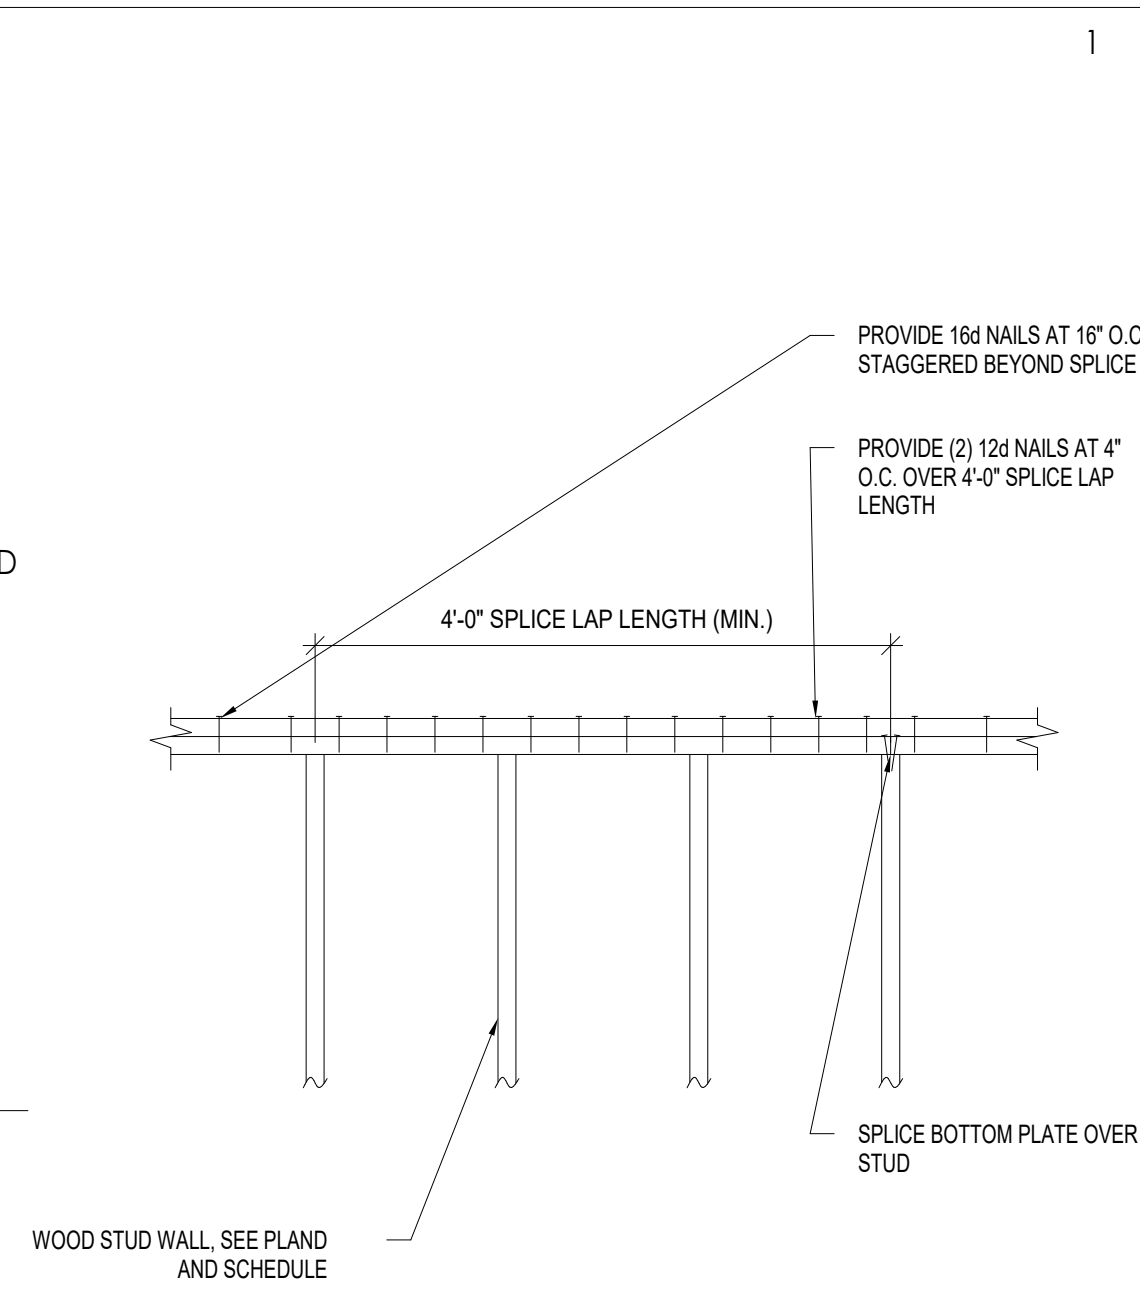


**TYPICAL TOP PLATE SPLICE DETAIL**  
NOT TO SCALE

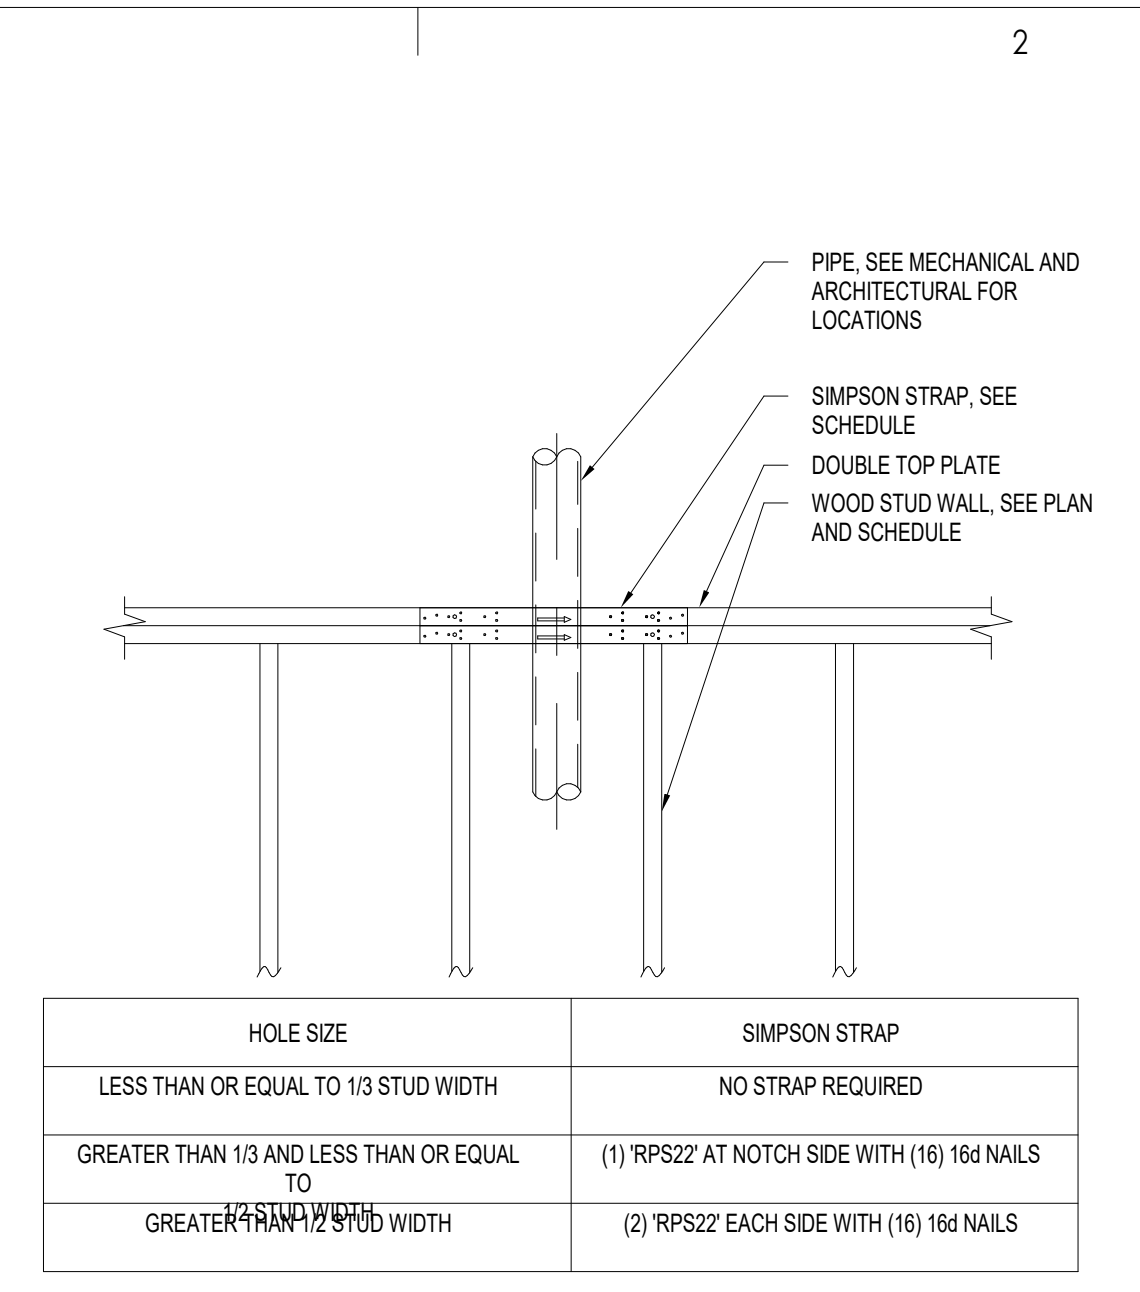


**TYPICAL TOP PLATE SPLICE AT PIPE**  
NOT TO SCALE


HOLE SIZE	SIMPSON STRAP
LESS THAN OR EQUAL TO 1/3 STUD WIDTH	NO STRAP REQUIRED
GREATER THAN 1/3 AND LESS THAN OR EQUAL TO 1/2 STUD WIDTH	(1) RPS22 AT NOTCH SIDE WITH (16) 16d NAILS
GREATER THAN 1/2 STUD WIDTH	(2) RPS22 EACH SIDE WITH (16) 16d NAILS

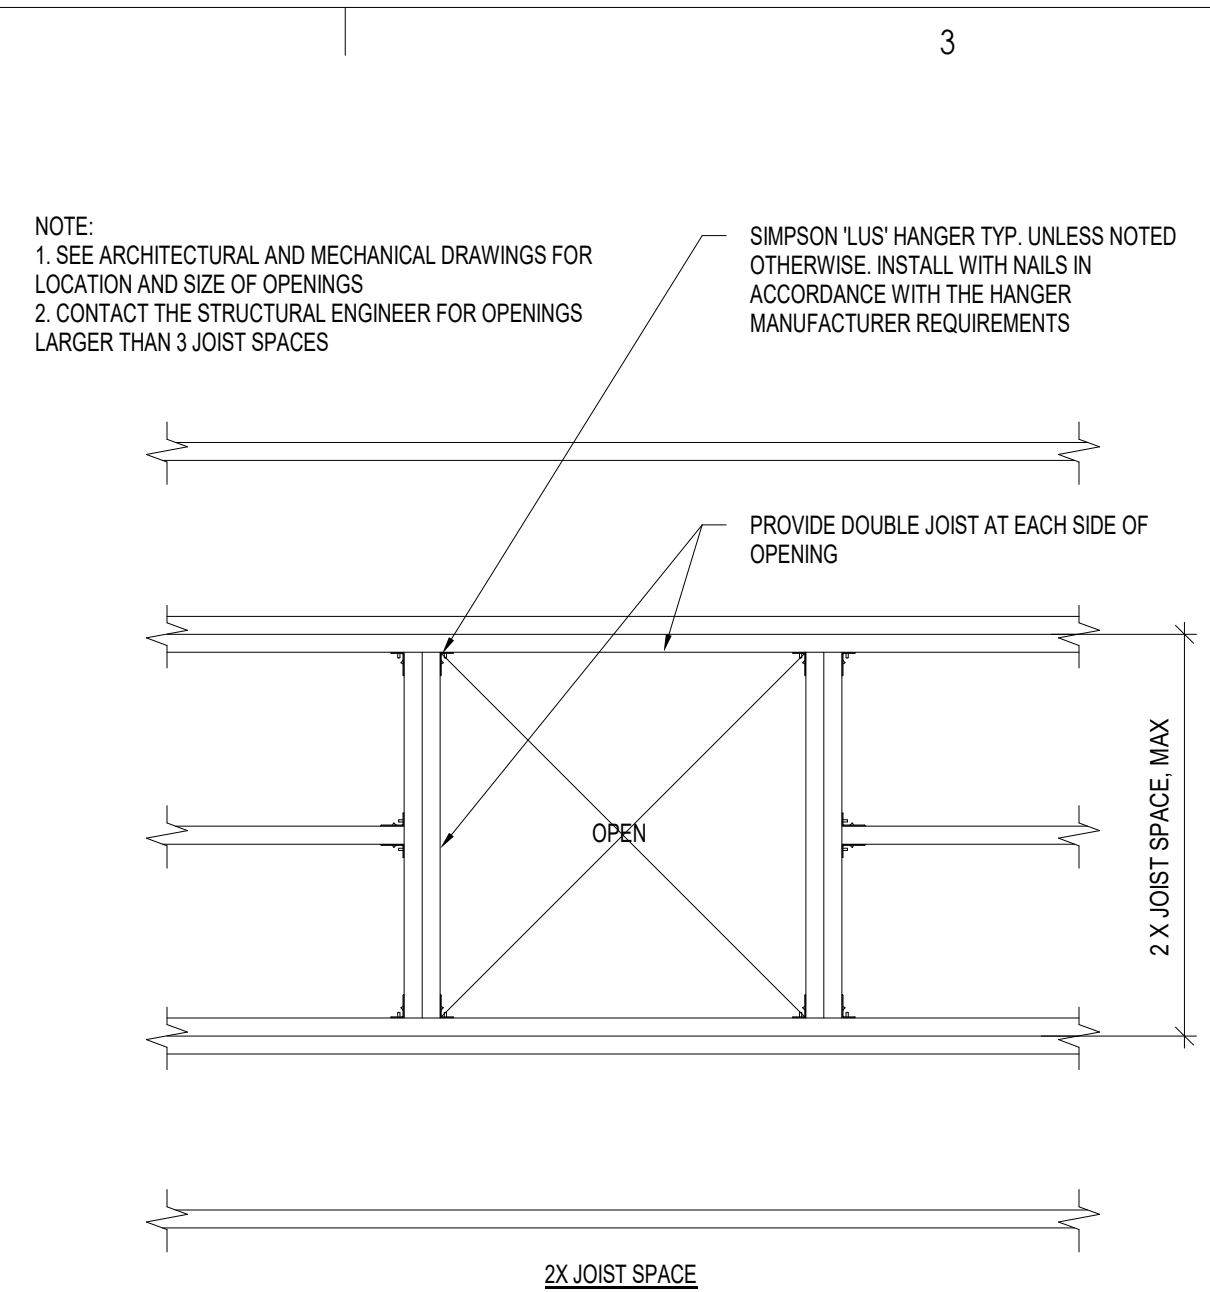

**TYPICAL OPENING AT TRUSSES AND JOISTS**  
NOT TO SCALE

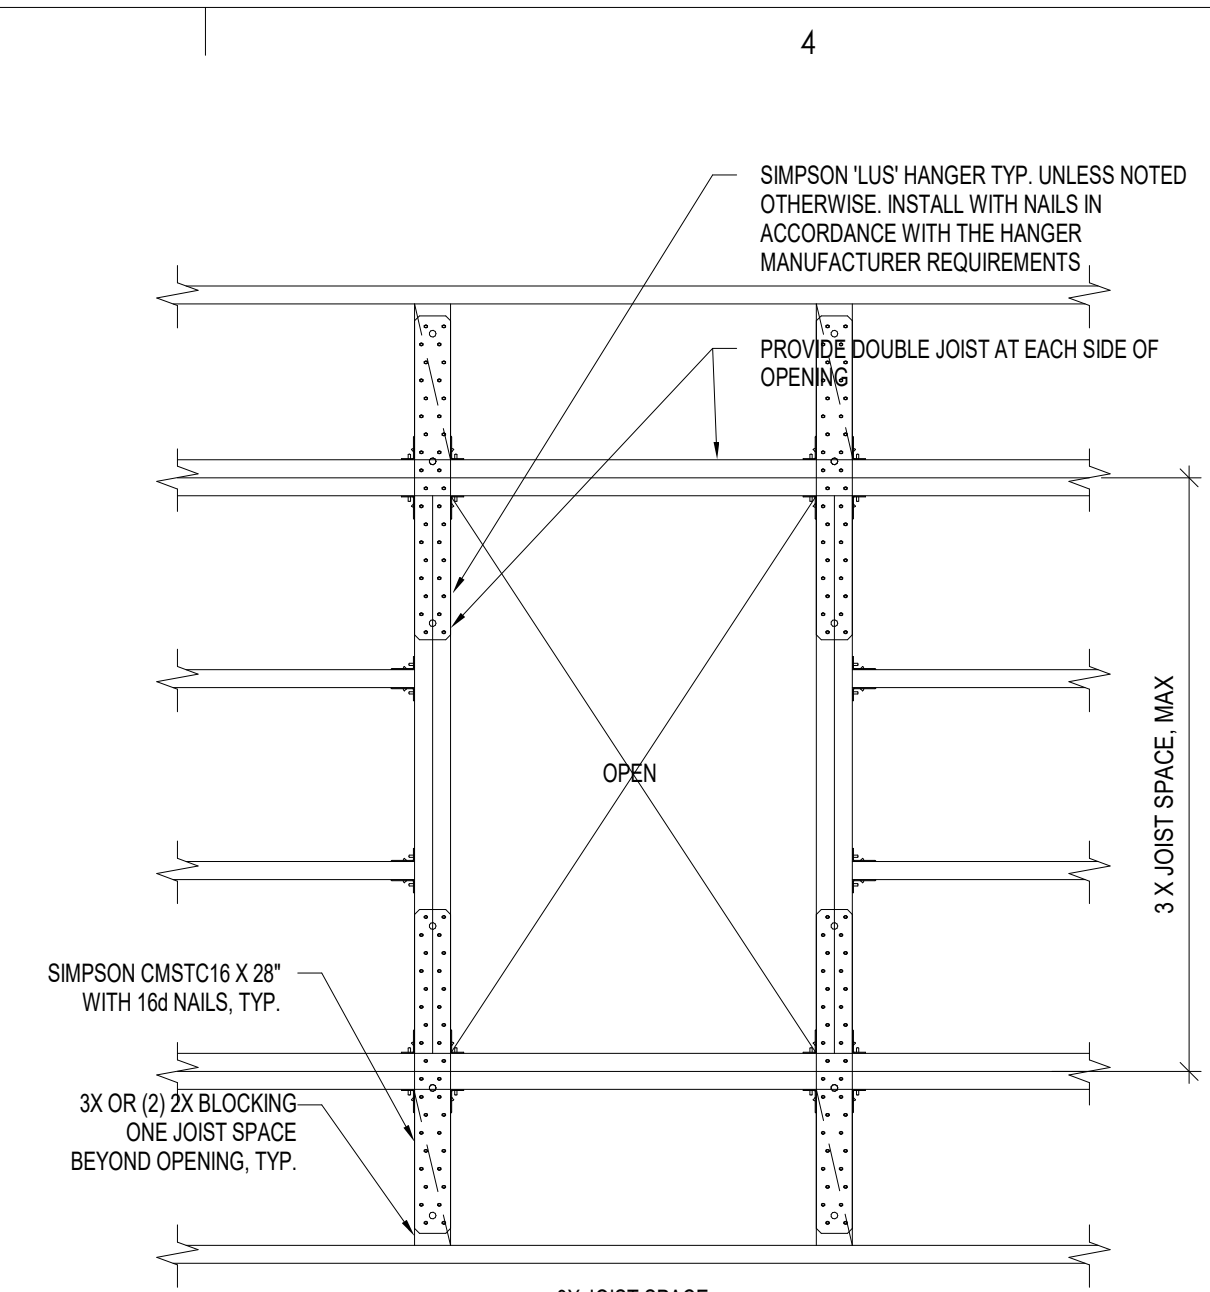


**MULTI-PLY (BUILT-UP) MEMBER**  
NOT TO SCALE

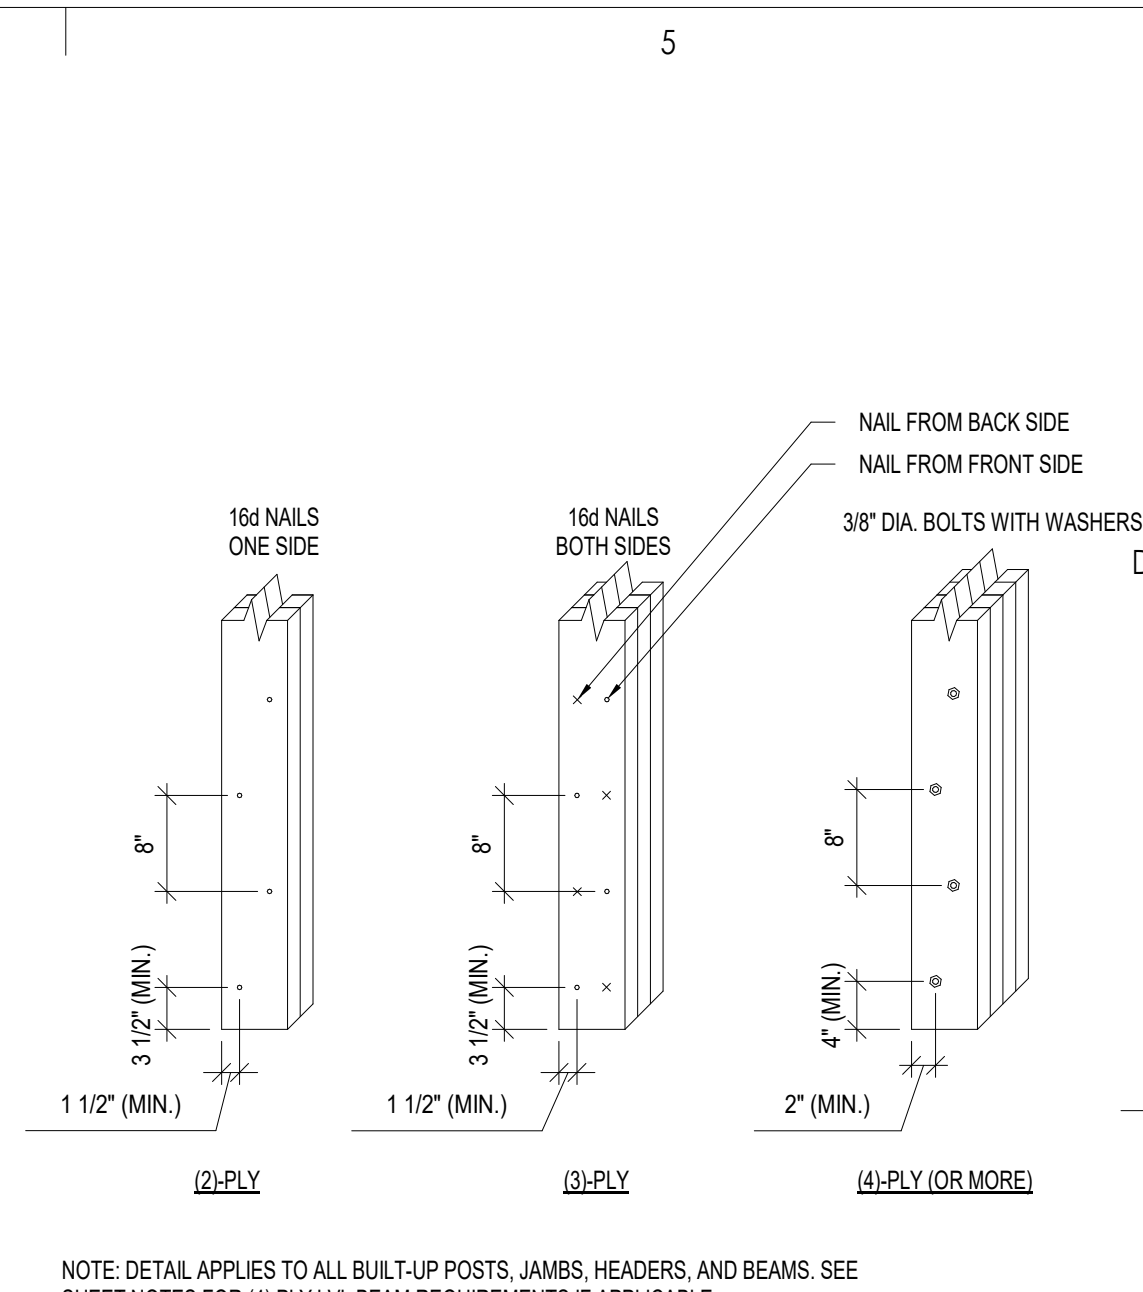


**MULTI-PLY (BUILT-UP) MEMBER**  
NOT TO SCALE


NOTE: DETAIL APPLIES TO ALL BUILT-UP POSTS, JAMBS, HEADERS, AND BEAMS. SEE SHEET NOTES FOR (4) PLY LVL BEAM REQUIREMENTS IF APPLICABLE.

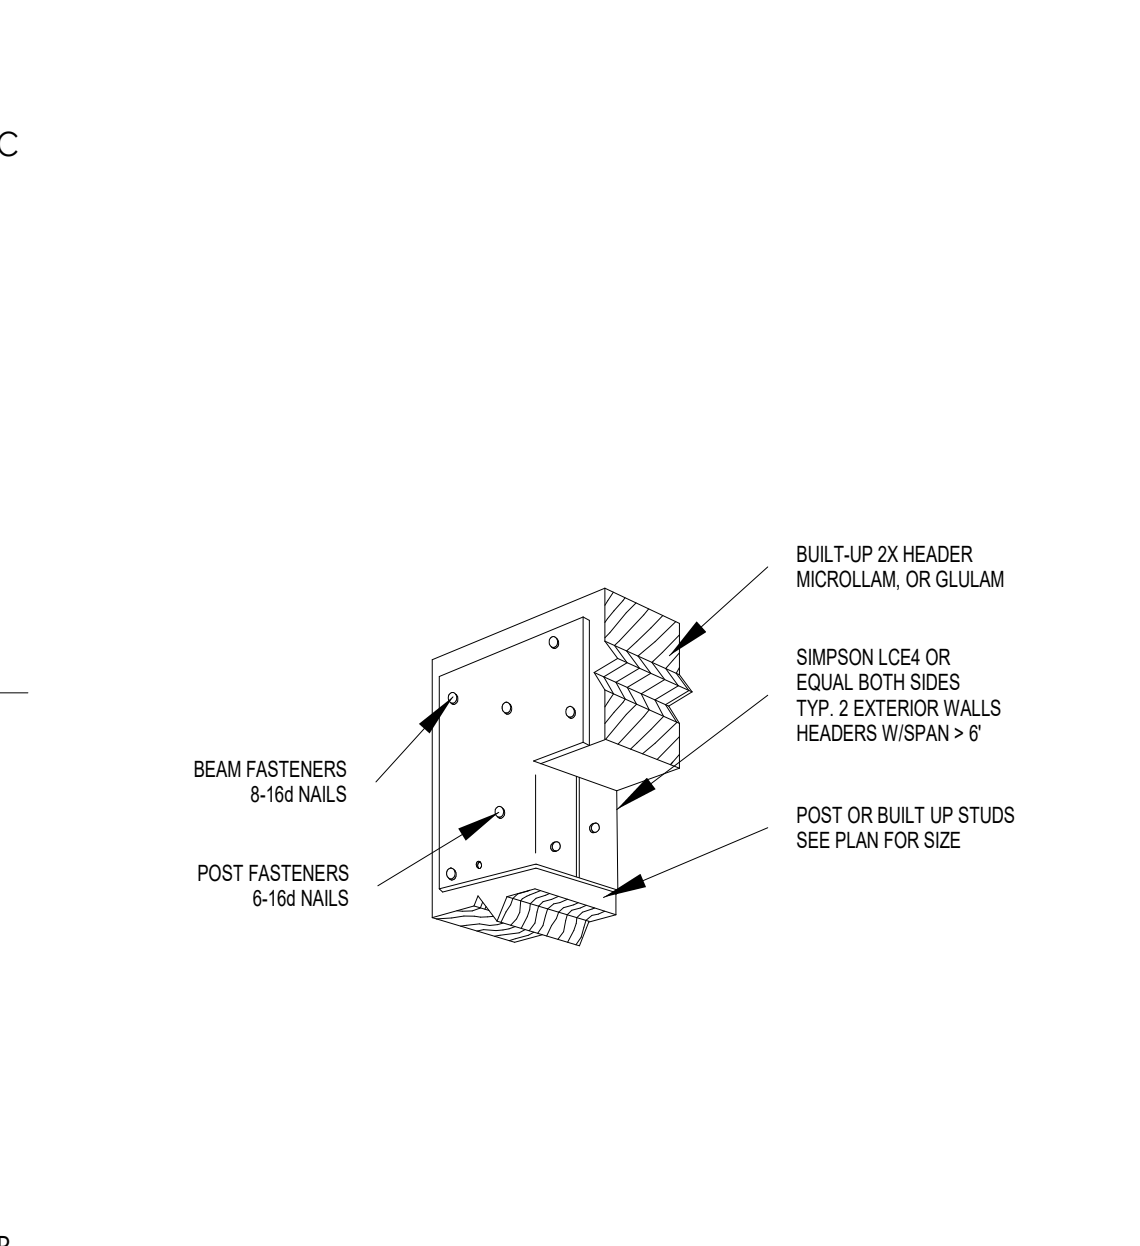


**HEADER GREATER THAN 6 FT DETAIL**  
NOT TO SCALE

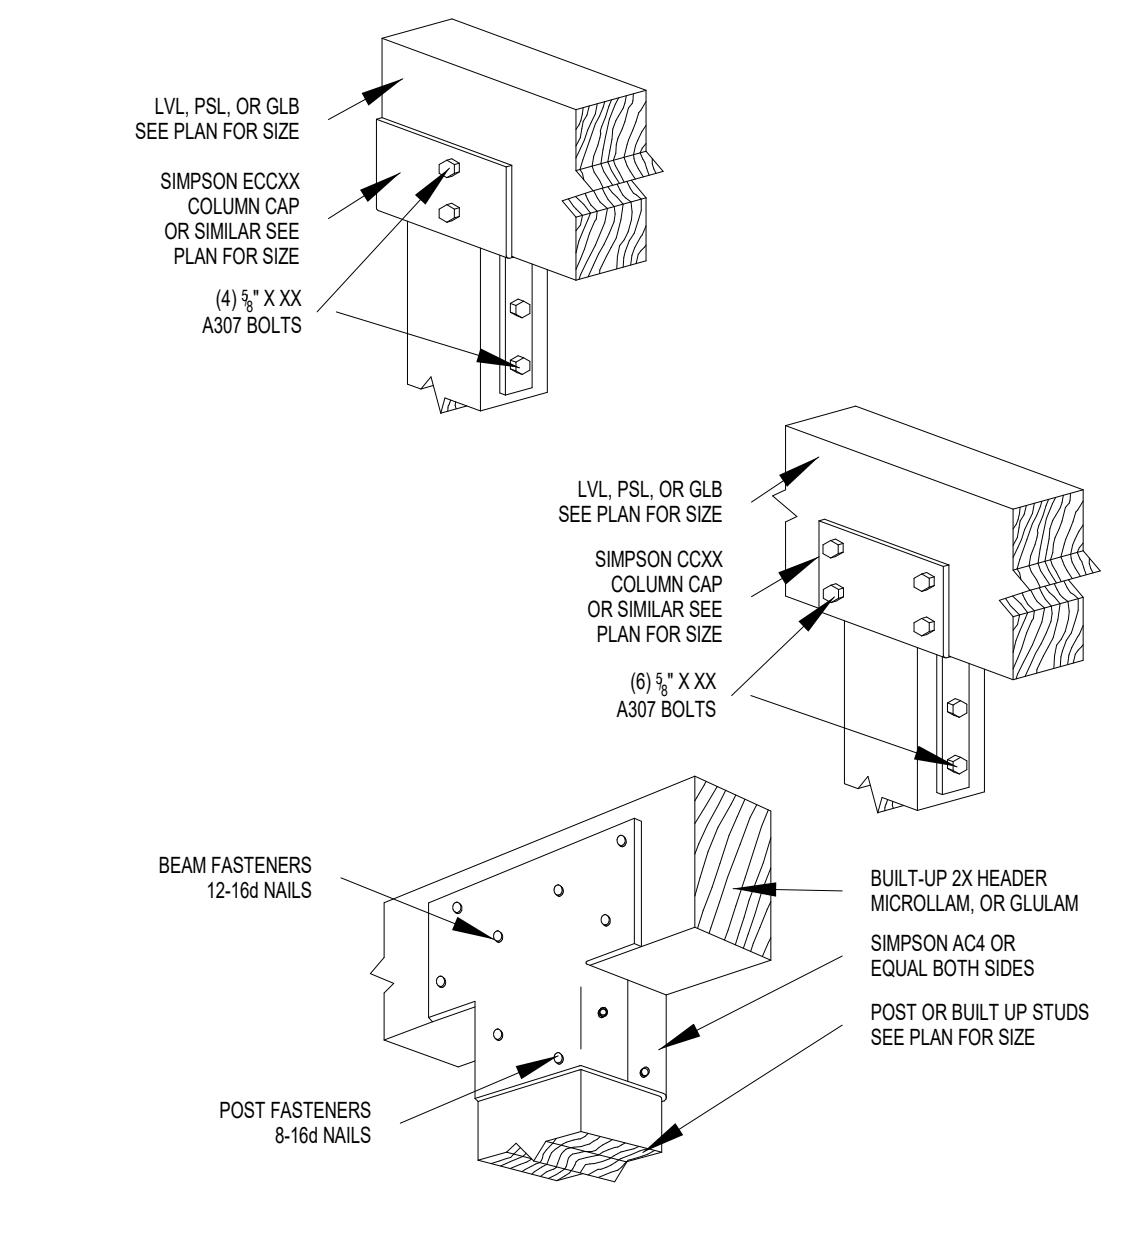

**TYPICAL BEAM CONNECTION DETAILS**  
NOT TO SCALE

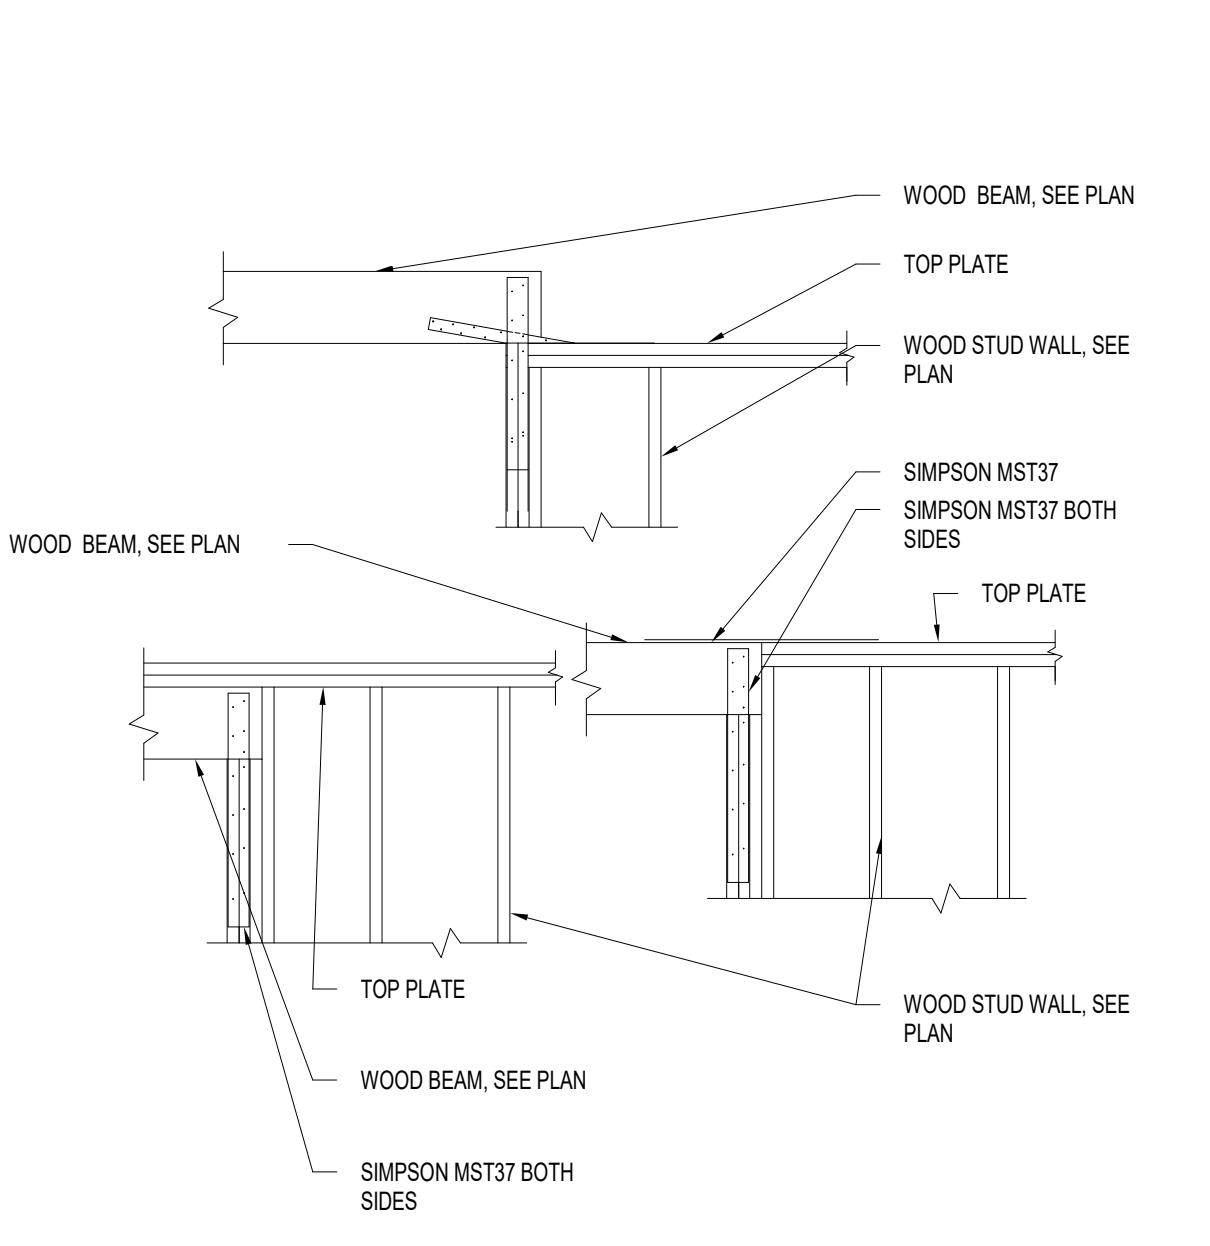


**BEAM CONNECTIONS**  
NOT TO SCALE

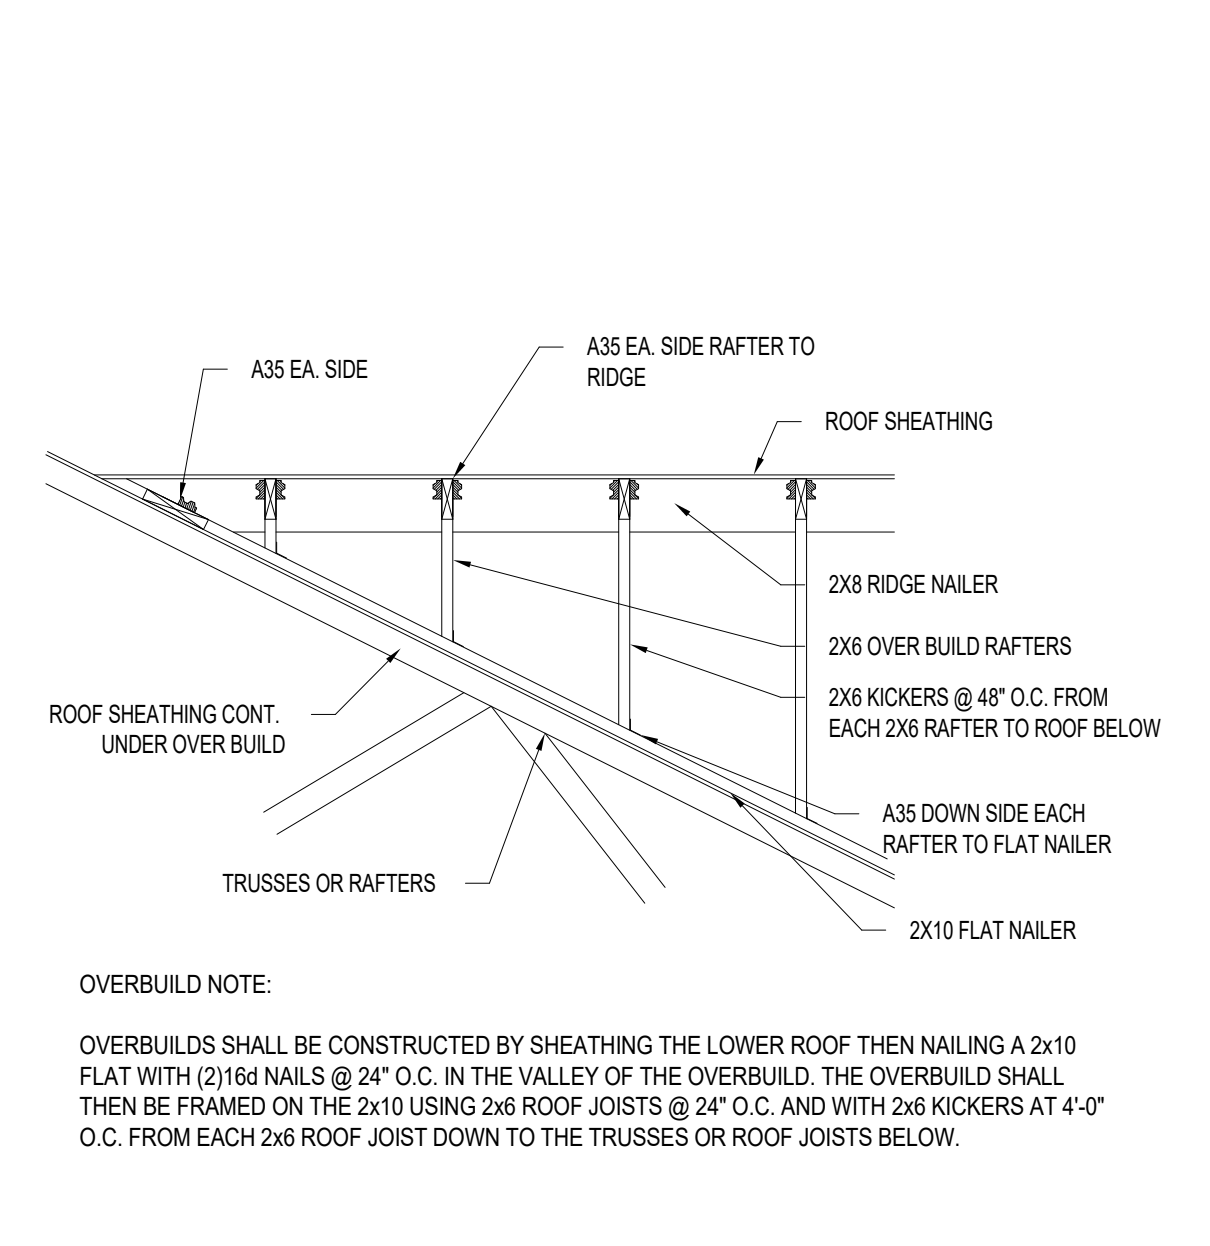


**OVERBUILD DETAIL**  
NOT TO SCALE


OVERBUILD NOTE:  
OVERBUILDS SHALL BE CONSTRUCTED BY SHEATHING THE LOWER ROOF THEN NAILING A 2x10 FLAT WITH (2)16d NAILS @ 24" O.C. IN THE VALLEY OF THE OVERBUILD. THE OVERBUILD SHALL THEN BE FRAMED ON THE 2x10 USING 2x6 ROOF JOISTS @ 24" O.C. AND WITH 2x6 KICKERS AT 4'-0" O.C. FROM EACH 2x6 ROOF JOIST DOWN TO THE TRUSSES OR ROOF JOISTS BELOW.

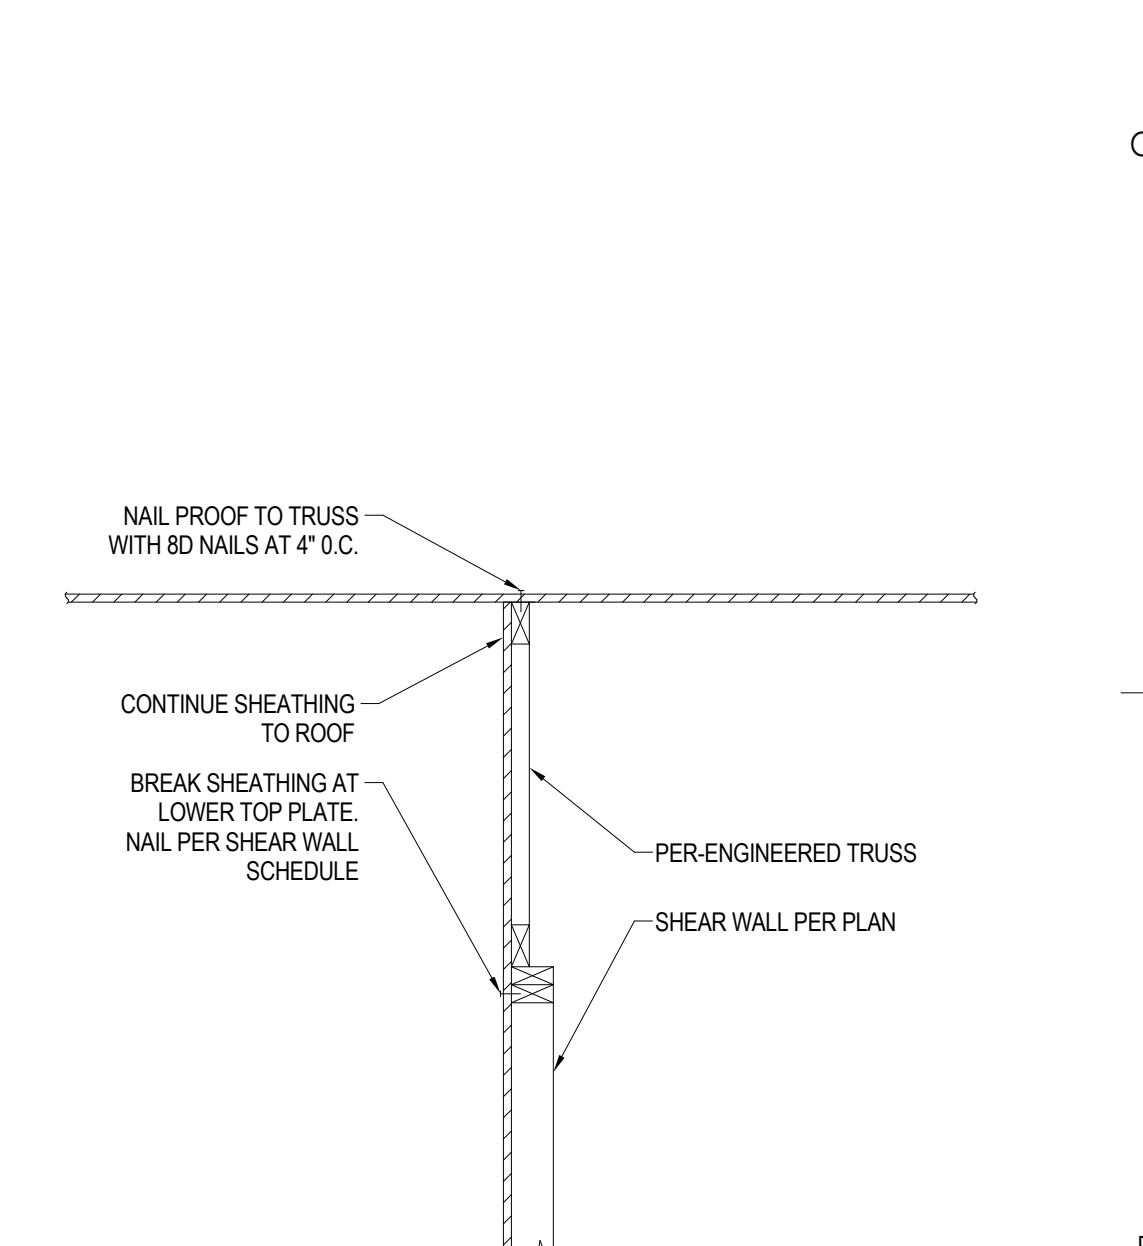


**INTERIOR SHEARWALL CONNECTION**  
NOT TO SCALE

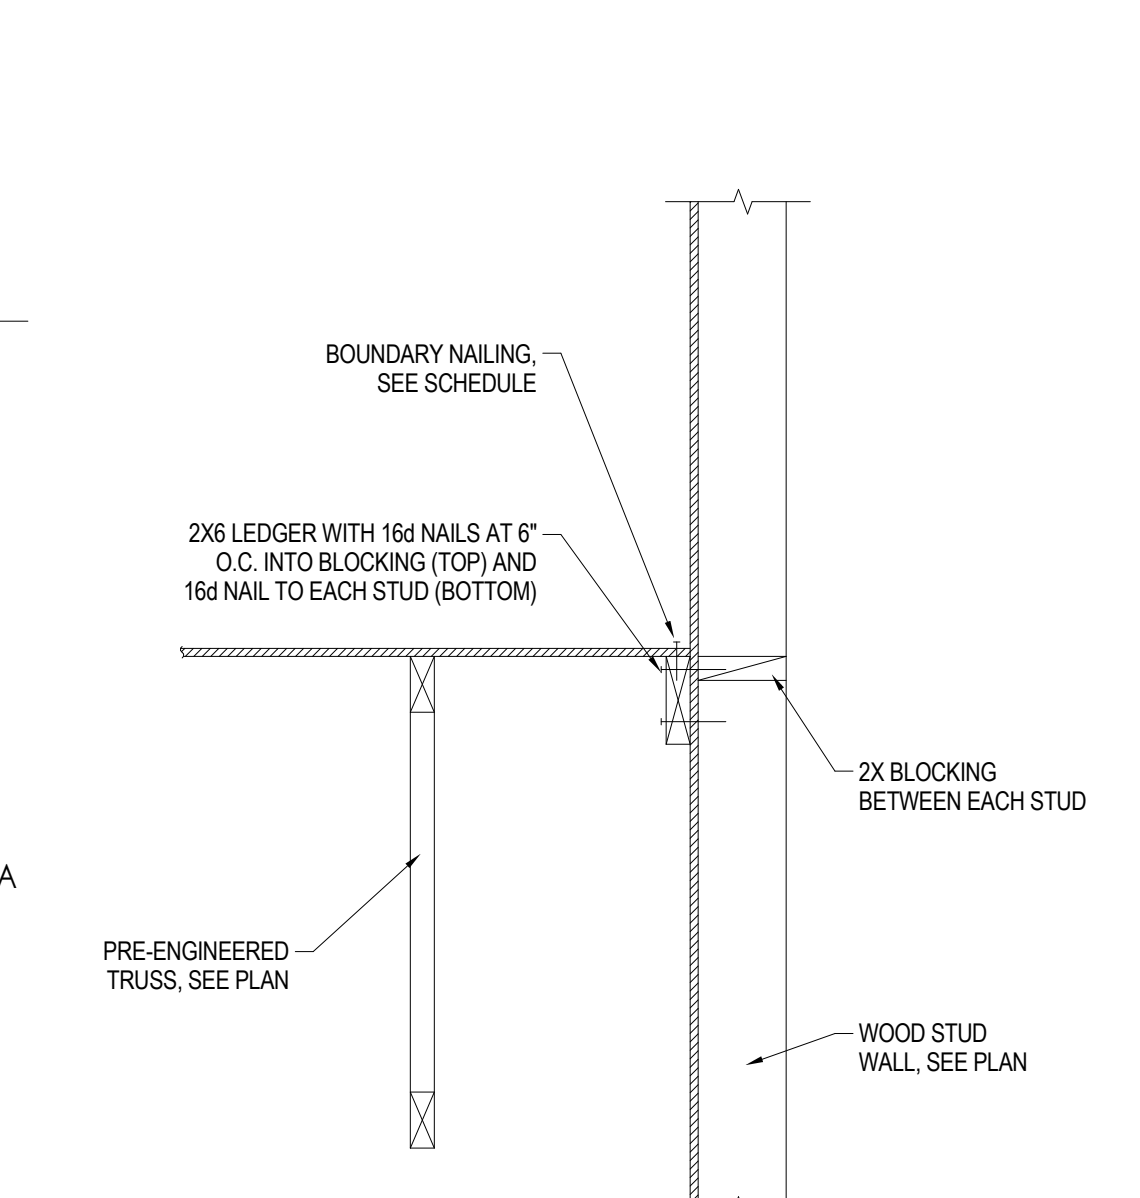


**SHEAR TRANSFER DETAIL**  
NOT TO SCALE

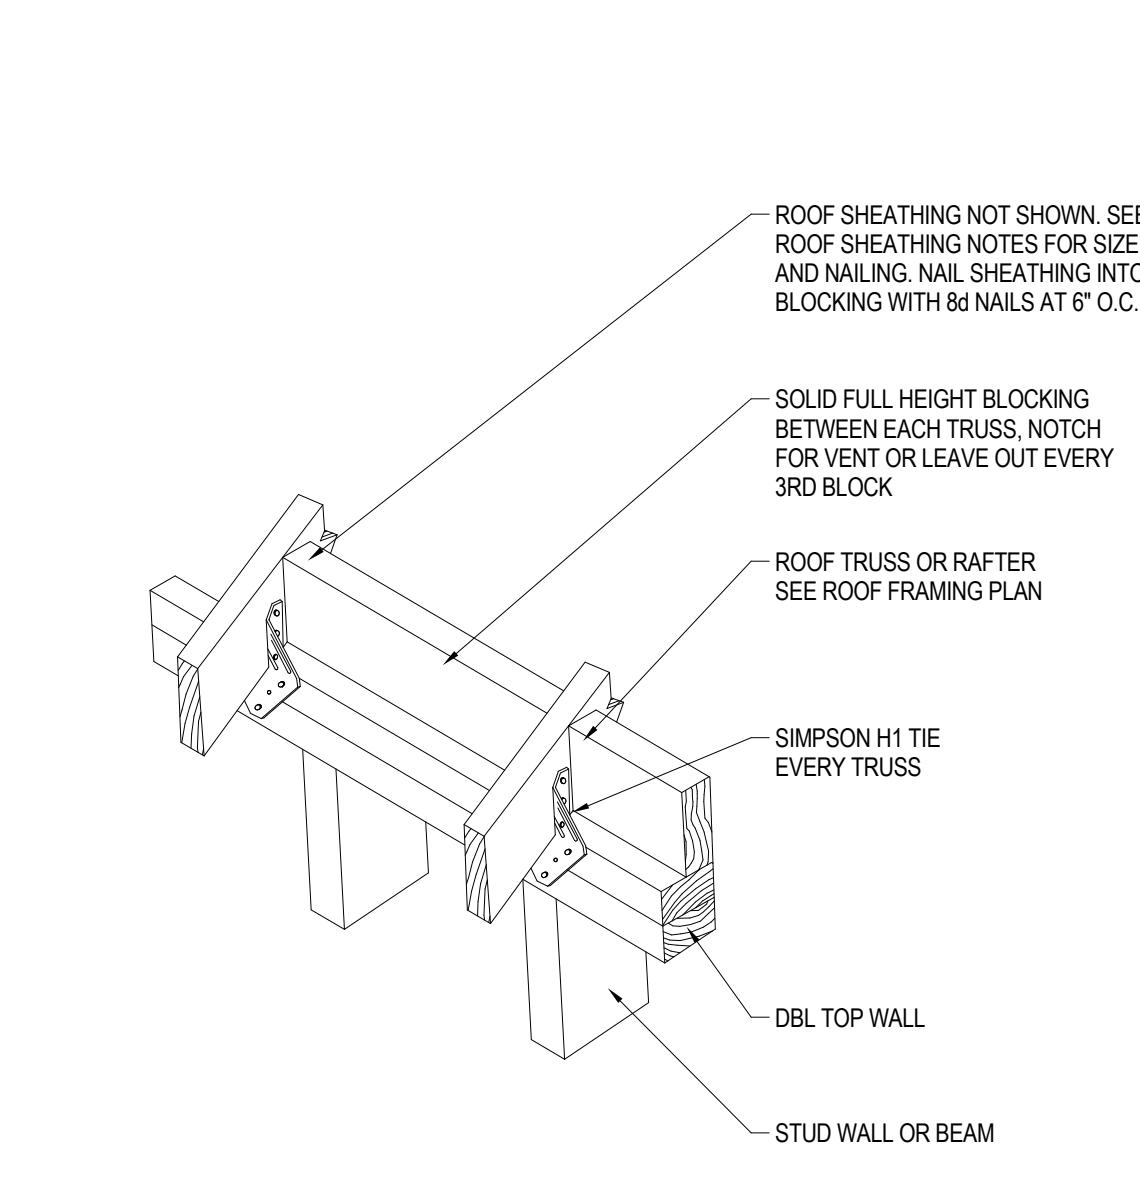


**ROOF FRAMING CONNECTION DETAIL OPTIONS**  
NOT TO SCALE

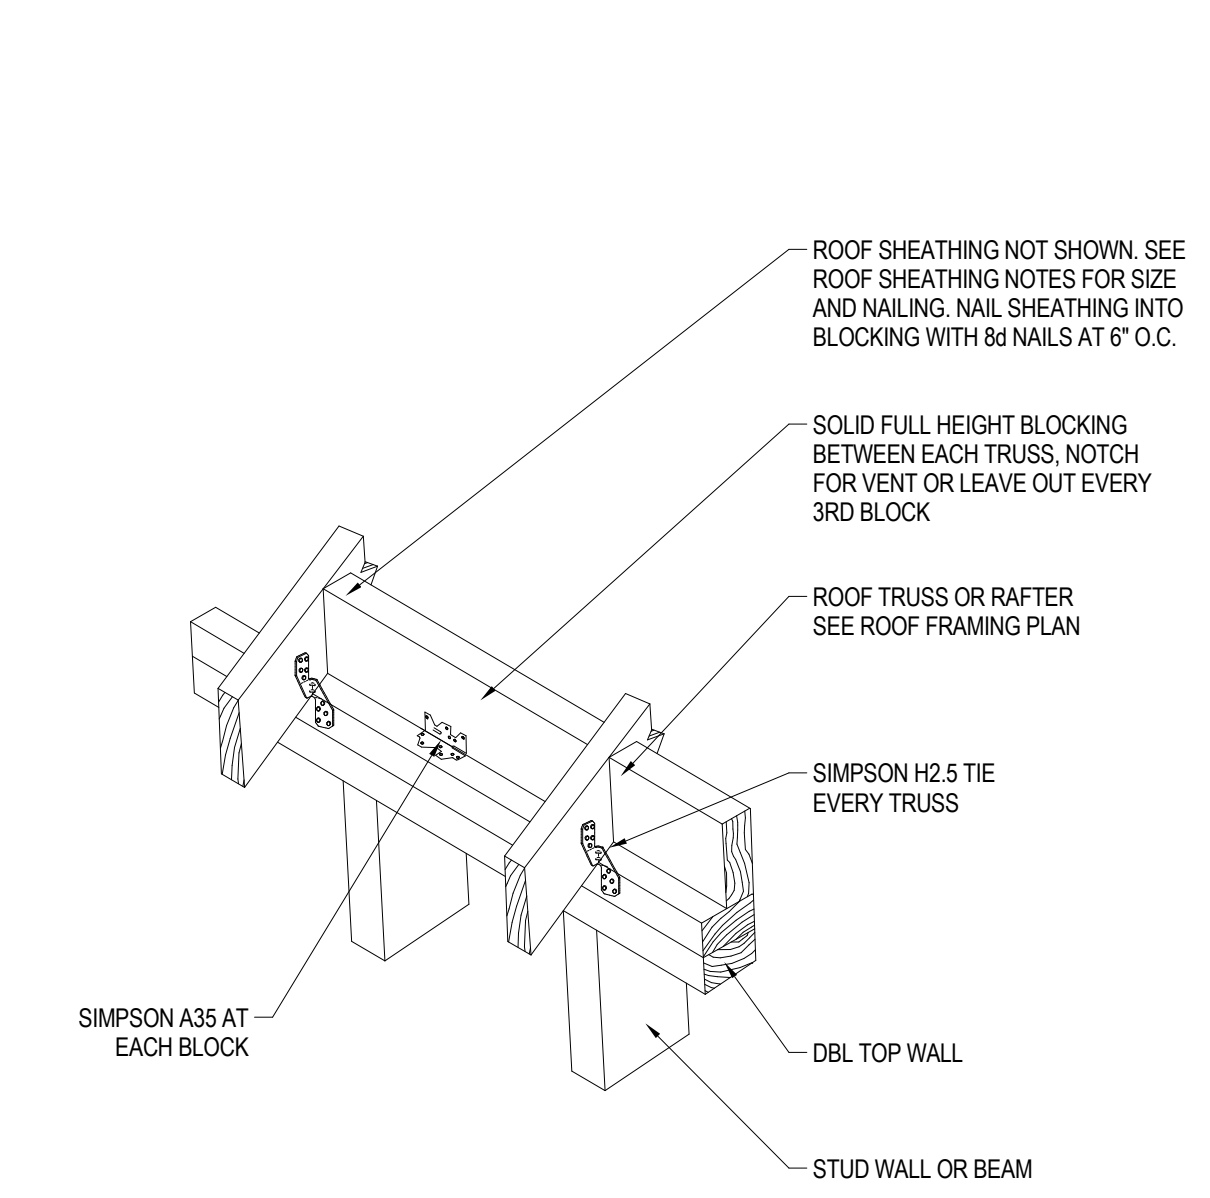


**ROOF FRAMING CONNECTION DETAIL OPTIONS**  
NOT TO SCALE

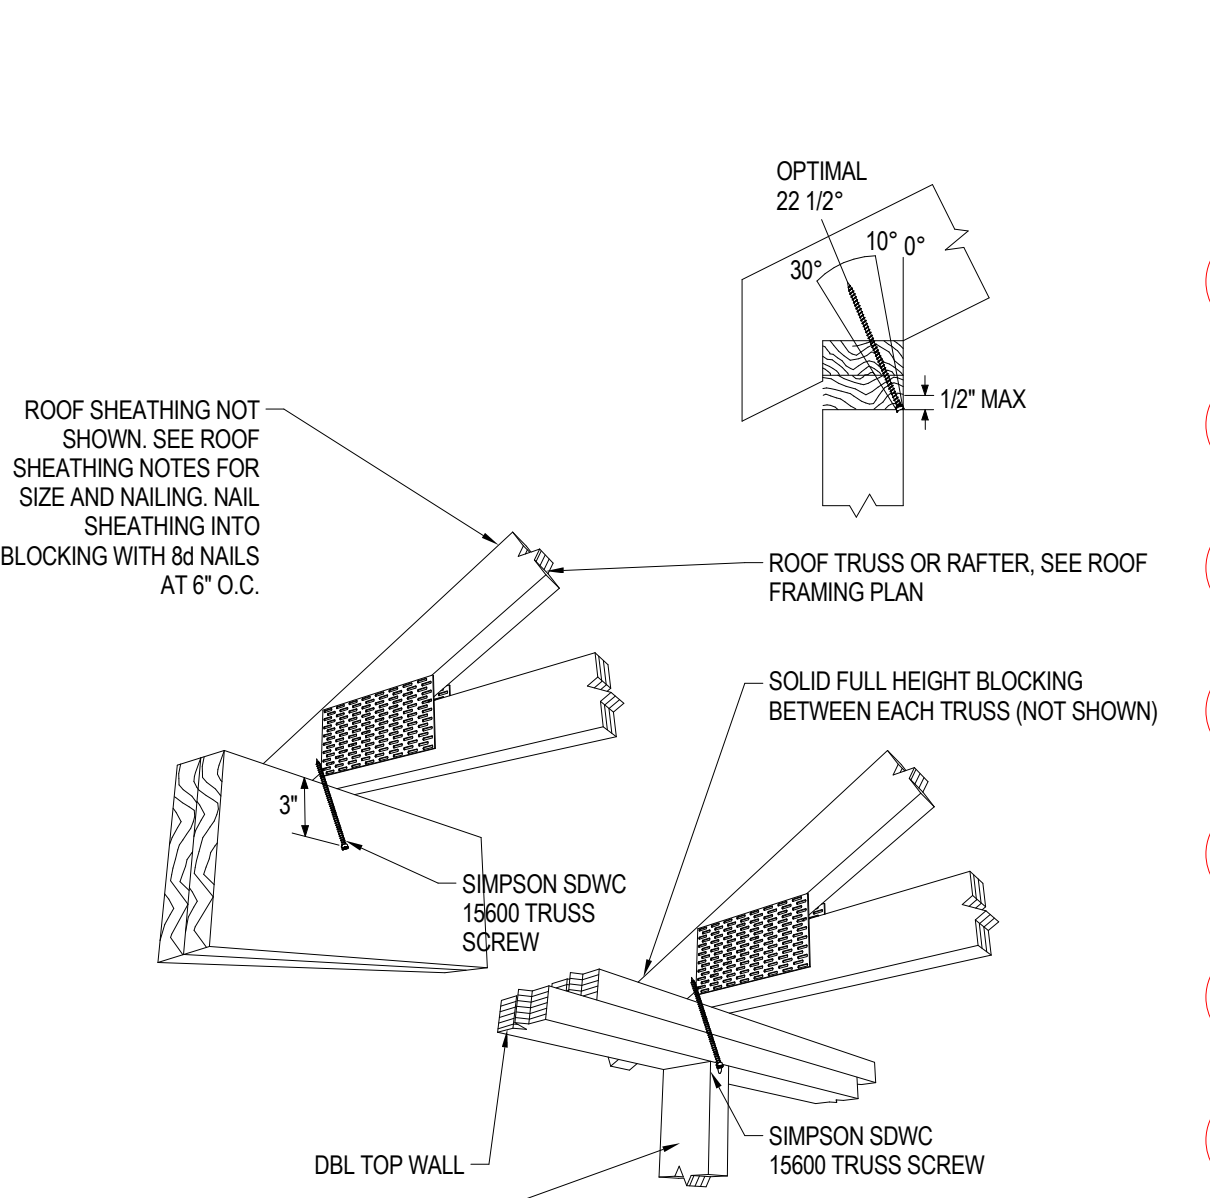

**EXISTING TRUSSES TO NEW BEAM**  
NOT TO SCALE

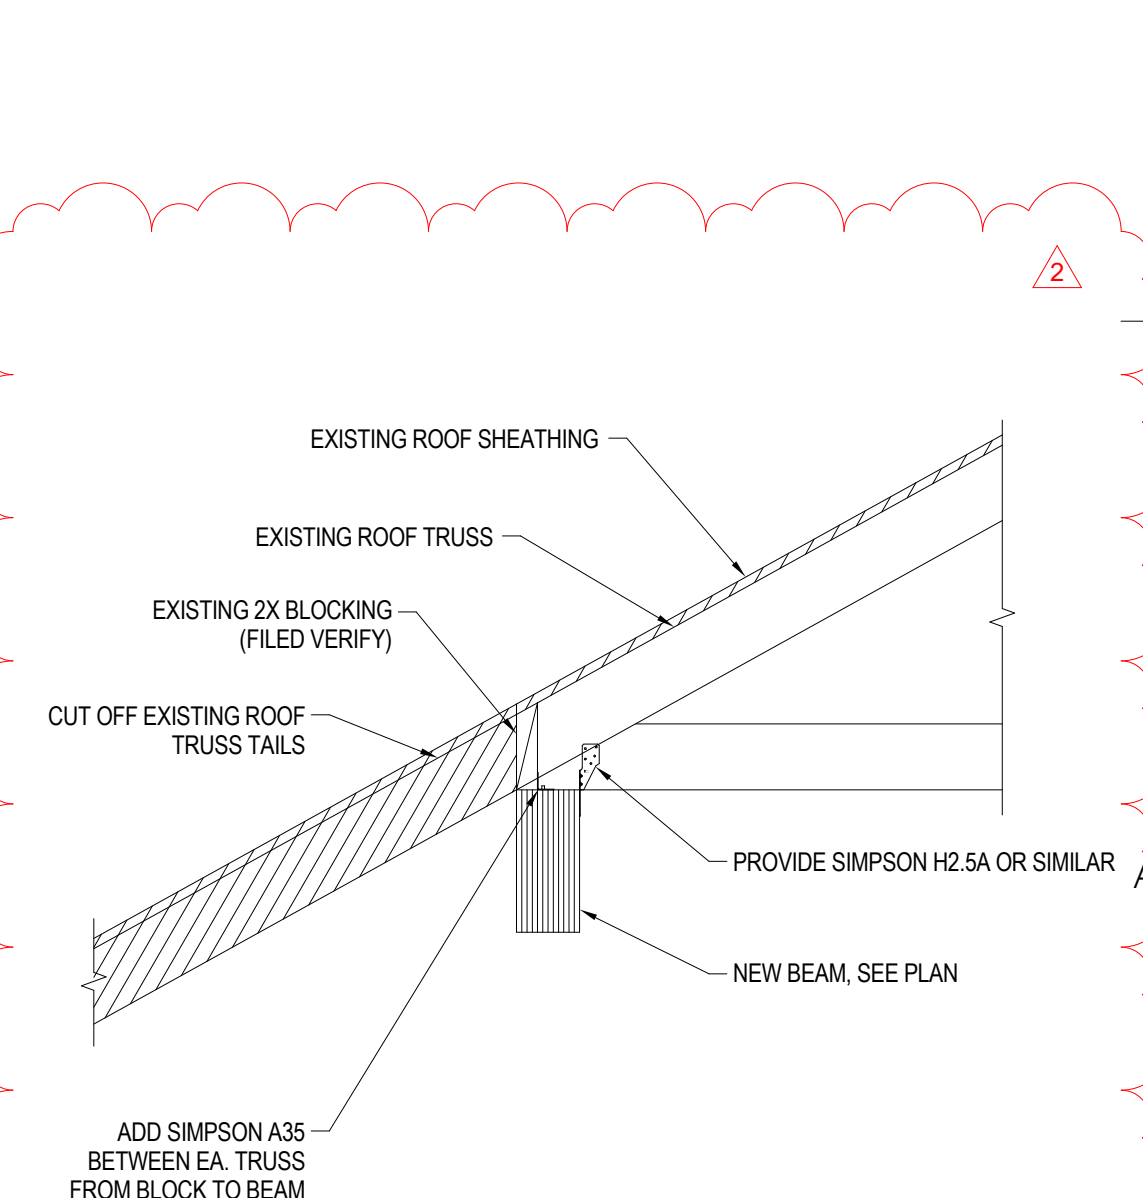

**EXISTING TRUSSES TO NEW BEAM**  
NOT TO SCALE

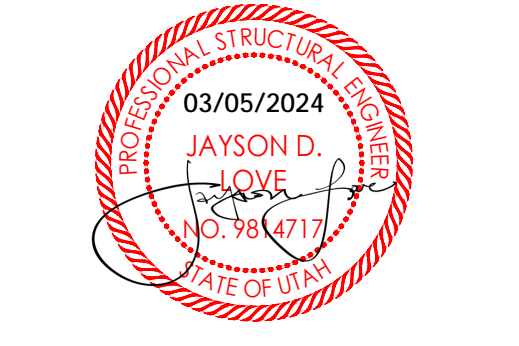

**JONES & ASSOCIATES**  
CONSULTING ENGINEERS  
6080 S FASHION POINT DRIVE  
SOUTH OGDEN, UT 84405

Project Name

Issued No.	Date	Description
1	09.21.23	PERMIT SET
2	02.29.23	PLAN REVIEW

Revision No.	Date	Description
1	02.29.23	PLAN REVIEW/REDESIGN

SAA Project No. 2022-11  
Drawing Title  
**ROOF FRAMING DETAILS**  
Sheet Number **S521**

### MINIMUM NAILING SCHEDULE

"CONNECTION"	"NAILING"
1. JOIST TO SILL GIRDER, TOENAIL.....	3-8D
2. BRIDGING TO JOIST, TOENAIL EA. END.....	2-8D
3. SOLE PLATE TO JOIST OR BLOCKING, FACE NAIL.....	6D AT 16" O.C.
4. TOP PLATE TO STUD, END NAIL.....	2-16D
5. STUD TO SOLE PLATE.....	4-8D TOENAIL 2-6D END WALL
6. DOUBLE STUDS, FACE NAIL.....	16D AT 24" O.C.
7. DOUBLE TOP PLATES, FACE NAIL.....	16D AT 16" O.C.
8. TOP PLATES, LAPS AND INTERSECTIONS, FACE NAIL.....	2-16D
9. CONTINUOUS HEADERS TWO PIECES, ALONG EA. EDGE.....	16D AT 16" O.C.
10. CEILING JOISTS TO PLATE, TOENAIL.....	3-8D
11. CONTINUOUS HEADERS TO STUD, TOENAIL.....	4-8D
12. CEILING JOISTS, LAPS OVER PARTITIONS, FACE NAIL.....	3-16D
13. CEILING JOISTS TO PARALLEL RAFTERS, FACE NAIL.....	3-16D
14. RAFTER TO PLATE, TOENAIL.....	3-8D
15. BUILT-UP CORNER STUDS.....	16 AT 24" O.C.
16. BUILT-UP GIRDER AND BEAMS.....	20D AT 32" O.C. 1/8 STAGGERED 2-20D AT ENDS AND SPLICES

### SHEARWALL SCHEDULE

MARK	SHEATHING	EDGE	FIELD	DIA.	SPACING	SIZE	FASTENERS	RIM BOARD/BLOCKING		
								FASTENER	SPACING	NOTES
SW-1	7/16" OSB ON SIDE	8d AT 6" O.C.	8d AT 12" O.C.	5/8"	32" O.C.	2X	16d AT 6" O.C.	SIMPSON 'A35' WITH (12)	32" O.C.	1, 2, 3, 4, 5
SW-2	7/16" OSB ON SIDE	8d AT 4" O.C.			32" O.C.	2X	16d AT 6" O.C.	8d AT 12" O.C.	16" O.C.	1, 2, 3, 4, 5
SW-3	7/16" OSB ON SIDE	8d AT 3" O.C.			32" O.C.	3X	16d AT 4" O.C.	16" O.C.	1, 2, 3, 4, 5, 6	
SW-4	7/16" OSB ON SIDE	8d AT 2" O.C.			16" O.C.	3X	16d AT 4" O.C.	RIMBOARD TO TOP	12" O.C.	1, 2, 3, 4, 5, 6
SW-5	7/16" OSB BOTH SIDE	8d AT 3" O.C.			16" O.C.	3X	1/4" X 3-1/2" SDS WOOD SCREWS AT 8" O.C.	PLATE	8" O.C.	1, 2, 3, 4, 5, 6, 7

NOTES:  
1. APPLY 7/16" APA OSB OVER DOUGLAS FIR OR SOUTHERN PINE FRAMING SPACED AT 16" O.C.  
2. NAIL OR STAPLE SHEATHING ALONG INTERMEDIATE STUDS AT 12" O.C.  
3. BLOCK ALL PANEL EDGES  
4. PROVIDE 3"X3"X1/4" PLATE WASHERS ON ANCHOR BOLTS (TYPICAL)  
5. ALL SHEATHING SHALL EXTEND CONTINUOUS FROM SILL PLATE TO ROOF OR FLOOR SHEATHING  
6. FRAMING AT ADJOINING PANELS SHALL BE 3" NOMINAL OR (2) 2X NAILED TOGETHER WITH (2) TOWS OF 16d COMMON NAILS AT 12" O.C.  
7. OFFSET PANEL JOINTS TO AVOID SPLITTING THE STUDS  
8. INSTALL SIMPSON LCE4 CONNECTORS ON EACH CORNER OF WINDOWS NOTED AS LCE4.  
9. WHERE PANELS ARE APPLIED TO BOTH FACES OF A SHEARWALL AND EDGE NAILING IS LESS THAN 6" O.C. OR LESS THAN 2" O.C. FOR A PANEL ON ONE SIDE, PANEL JOINTS SHALL BE OFFSET TO FALL ON DIFFERENT FRAMING. ALTERNATIVELY, THE WIDTH OF THE NAILED FACE OF FRAMING MEMBERS SHALL BE E3" NOMINAL OR GREATER AT ADJOINING PANEL EDGES AND NAILING SHALL BE STAGGERED.  
10. NAILS SHALL BE PLACED NOT LESS THAN 1/2" FROM EDGE OF PANEL AND DRIVEN SO THAT THEIR HEAD OR CROWN IS FLUSH WITH THE SURFACE OF THE SHEATHING  
11. USE COMMON NAILS AT SILL PLATE USE HOT-DIPPED OR TUMBLED GALVANIZED NAILS IN ACCORDANCE WITH IBC 2304.10.  
12. IF SHEATHING OCCURS AT METAL STUDS, USE THE SAME SPACING OF FASTENERS BUT SUBSTITUTE WITH #8 SCREWS. MINIMUM STUD GAGE SHALL BE 43 MILS (18 GAGE)

### FLOOR AND ROOF SHEATHING SCHEDULE

LOCATION	THICKNESS	NAIL SIZE	EDGE NAIL	FIELD NAIL	BOUNDARY NAIL	EDGE BLOCK	COMMENTS
FLOOR	15/32"	10d	6"	12"	6"	NO	
ROOF	23/32"	10d	6"	12"	6"	NO	

NOTES:  
1. MINIMUM NAIL PENETRATION INTO FRAMING: 10d-1.5/8"  
2. USE COMMON NAILS (10d DIAMETER = 0.148")  
3. ALL WOOD FLOOR SHEATHING SHALL BE GLUED AND NAILED  
4. PROVIDE (2) ROWS OF BOUNDARY NAILING STAGGERED OVER INTERIOR SHEAR WALL AT FLOOR ROOF  
5. SEE GENERAL STRUCTURAL NOTES FOR ADDITIONAL REQUIREMENTS: 2



### HEADER BEARING SCHEDULE

LEVEL	HEADER SPAN	HEADER	JAMB		CONDITION	REMARKS
			BEARING STUDS	KING STUDS		
ROOF	0'-0" TO 6'-0"	(2) 1.34" X 9.1/2" LVL	(2) 2X6	(2) 2X6	EXTERIOR	USE LCE4 AT EACH SIDE OF HEADER SEE DETAIL 5/SS21
2ND	0'-0" TO 6'-0"	(2) 1.34" X 9.1/2" LVL	(2) STUDS	(1) 2X6	EXTERIOR	USE LCE4 AT EACH SIDE OF HEADER SEE DETAIL 5/SS21
	0'-0" TO 4'-0"	(2) 2X10	(2) STUDS	(1) STUD	INTERIOR	FOR WOOD STUD WALL OPTIONS
2ND	0'-0" TO 4'-0"	(2) 600S162-54 STUDS (MIN.) WITH TOP AND BOTTOM TRACK MATCHING TYPICAL WALL TRACKS	(2) STUDS	(1) STUD	INTERIOR	FOR METAL STUD WALL OPTIONS

### CONCRETE REINFORCING BAR LAP SPLICE SCHEDULE (ACI 318-14)

BAR SIZE	FC = 3,000 PSI			FC = 4,000 PSI & FC = 4,500 PSI			FC = 5,000 PSI			FC = 6,000 PSI		
	ld & ls	CLASS A	CLASS B	ld & ls	CLASS A	CLASS B	ld & ls	CLASS A	CLASS B	ld & ls	CLASS A	CLASS B
	CLASS A	CLASS B	CLASS A	CLASS B	CLASS A	CLASS B	CLASS A	CLASS B	CLASS A	CLASS B	CLASS A	CLASS B
#3	16"	21"	8"	14"	18"	7"	13"	17"	6"	12"	16"	6"
#4	22"	29"	11"	19"	25"	9"	17"	22"	8"	15"	20"	8"
#5	27"	35"	14"	24"	31"	12"	21"	27"	11"	19"	25"	10"
#6	33"	43"	16"	28"	36"	14"	25"	33"	13"	23"	30"	12"
#7	48"	62"	19"	42"	55"	17"	37"	48"	15"	34"	44"	14"
#8	55"	72"	22"	47"	61"	19"	42"	55"	17"	39"	51"	15"
#9	62"	81"	25"	53"	69"	21"	48"	62"	19"	44"	57"	17"
#10	68"	88"	27"	59"	77"	24"	53"	69"	21"	48"	62"	19"
#11	75"	95"	30"	65"	85"	26"	58"	75"	23"	53"	69"	21"

1. THIS SCHEDULE SHALL BE USED FOR ALL BAR SPLICES IN CONCRETE WALLS UNLESS OTHERWISE NOTED.  
2. FOR ALL LIGHTWEIGHT CONCRETE, ALL LENGTHS IN THE TABLE ABOVE SHALL BE MULTIPLIED BY 1.33  
3. FOR ALL EPOXY COATED BARS, MULTIPLY ld, lsh, AND ls BY 1.2. THE EPOXY BARS SHALL HAVE A CLEAR SPACING EQUAL TO OR GREATER THAN 6"db AND CLEAR COVER GREATER THAN 3"db, OTHERWISE LENGTHS SHALL BE MULTIPLIED BY 1.5  
4. BARS IN BEAMS OR SLABS THAT HAVE MORE THAN 12 INCHES OF FRESH CONCRETE BELOW ARE CONSIDERED TOP BARS. MULTIPLY ld AND ls BY 1.2  
5. CLASS A SPLICES MAY BE USED ONLY IN CASES WHERE 50% OR LESS OF THE BARS ARE SPLICED AT THE SAME LOCATION  
6. CLASS B SPLICES SHALL BE USED FOR ALL SPLICES UNLESS THE REQUIREMENTS OF CLASS A ARE MET.  
7. SPLICES FOR BUNDLED BARS:  
a. FOR BUNDLED BARS OF THREE OR LESS, MULTIPLY ls BY 1.2  
b. FOR BUNDLED BARS OF FOUR, MULTIPLY ls BY 1.33  
c. BUNDLED BARS GREATER THAN (4) BARS IS NOT PERMITTED  
d. ENTIRE BUNDLES SHALL NOT BE LAP SPLICED  
e. INDIVIDUAL BAR SPLICES WITHIN THE BUNDLE SHALL NOT OVERLAP  
8. TIES AND STIRRUPS SHALL NOT BE SPLICED  
9. HOOKED BARS (ldh):  
a. FOR HOOKED BARS THAT ARE ENCLOSED IN TIES OR STIRRUPS THAT ARE SPACED NO MORE THAN 3 TIMES THE HOOKED BAR DIAMETER (db) OVER THE LENGTH OF THE HOOK OR OVER THE HOOKED DEVELOPMENT LENGTH, HOOKED DEVELOPMENT LENGTH MAY BE REDUCED BY 80%  
b. FOR HOOKED BARS THAT WILL HAVE SIDE CONCRETE COVER (NORMAL TO PLANE OF HOOK) >= 2.1/2 INCHES AND 90-DEGREE HOOKS WITH COVER ON THE BAR EXTENSION BEYOND THE HOOK >= 2 INCHES, HOOKED DEVELOPMENT LENGTH MAY BE REDUCED BY 70%  
c. HOOKED BARS LOCATED AT THE END OF A MEMBER SHALL HAVE SIDE AND TOP/BOTTOM COVER GREATER THAN 2.1/2 INCHES OR SHALL HAVE TIES OR STIRRUPS AS DESCRIBED IN NOTE 9a WITH NO REDUCTION.  
10. HOOKED BAR DEVELOPMENT LENGTH SHALL CONFORM TO SECTION 25.4.4 OF THE ACI 318-14  
11. db = BAR DIAMETER; ld = DEVELOPMENT LENGTH; ldh = HOOKED BAR DEVELOPMENT LENGTH; ls = BAR LAP SPLICE LENGTH

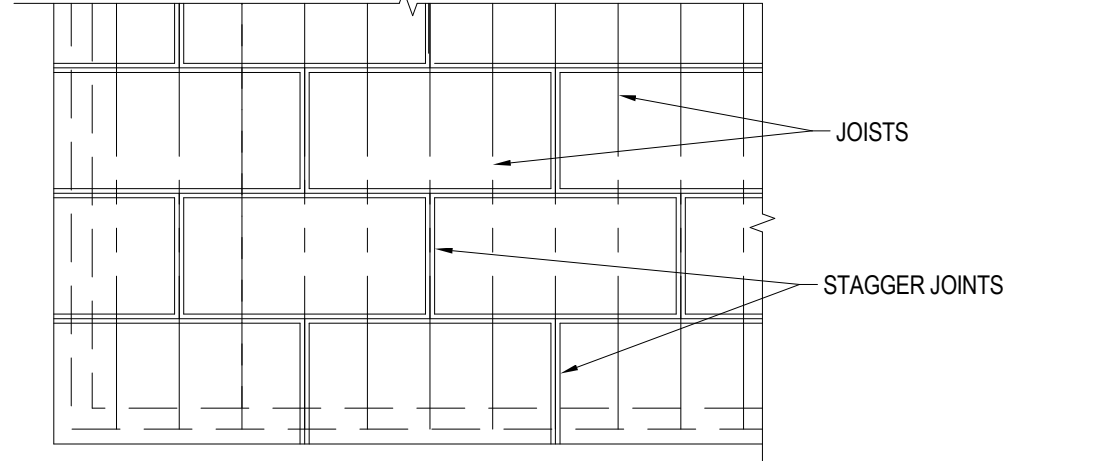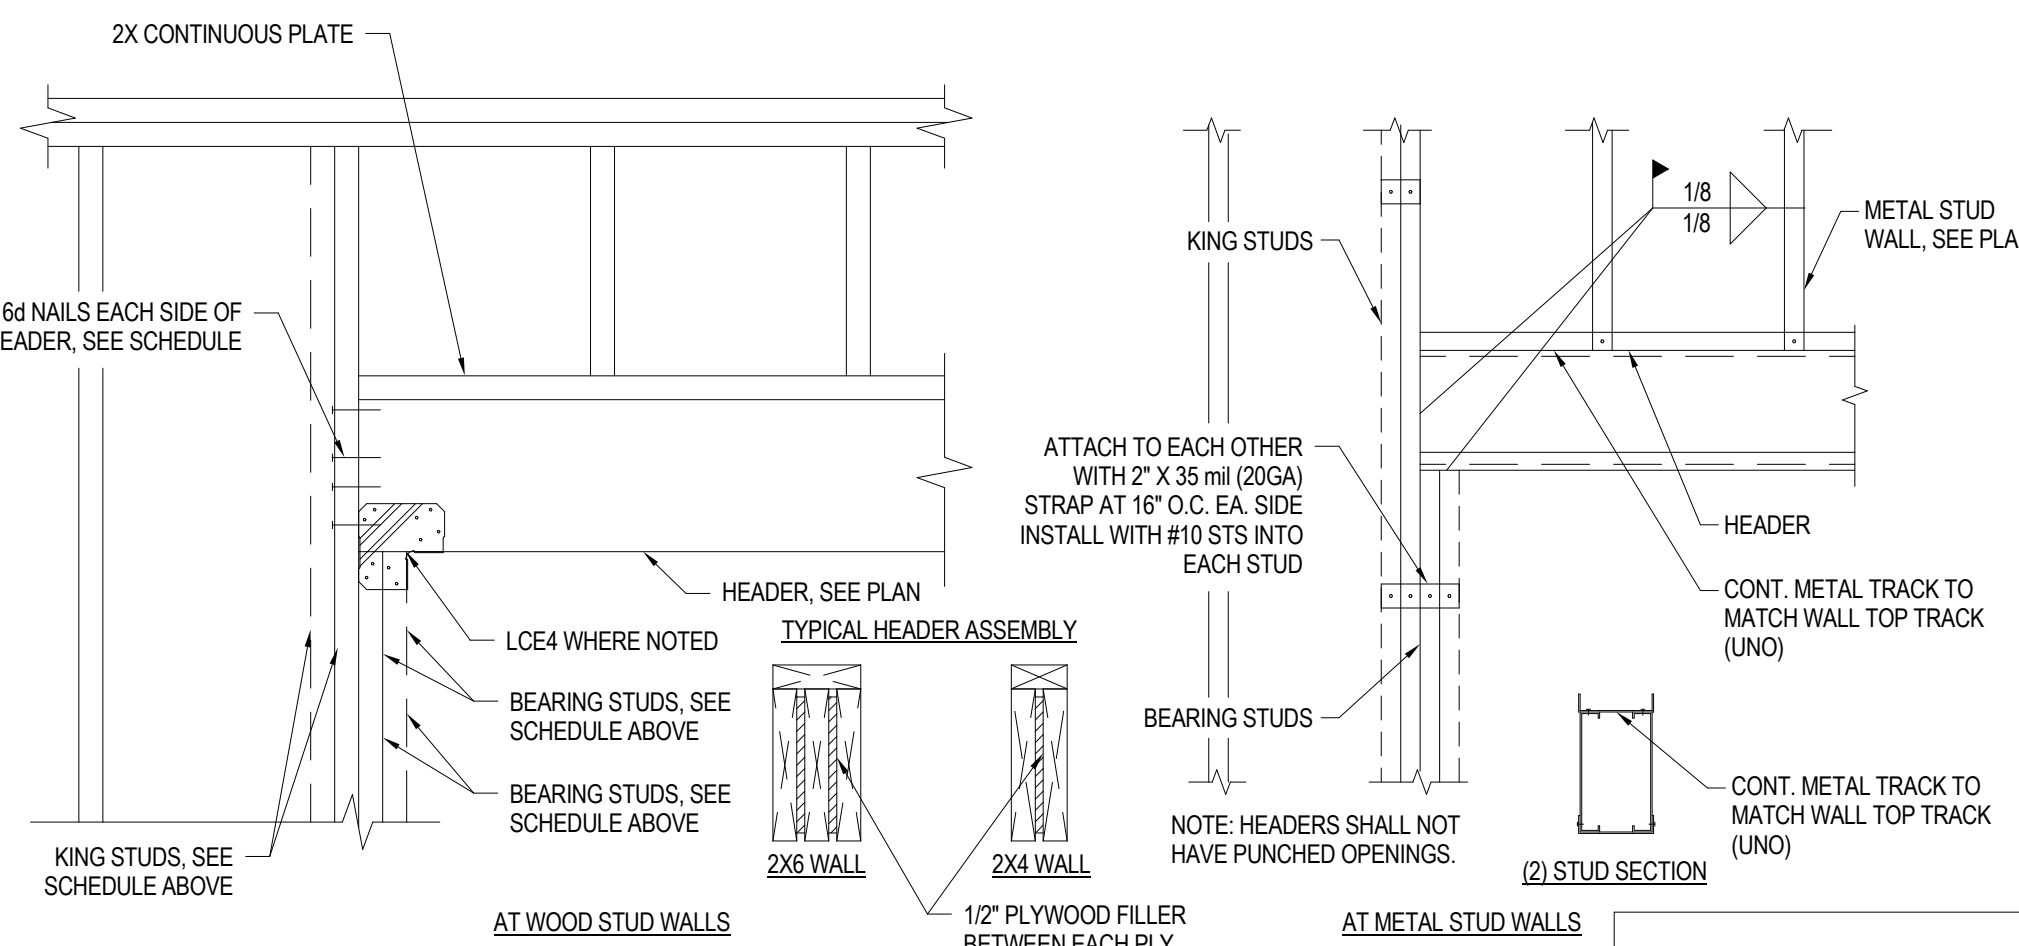

### STEEL VENEER LINTEL SCHEDULE


CLEAR OPENING	ANGLE SIZE
UP TO 5'-0"	4" X 4" X 1/4"
5'-1" TO 7'-0"	4" X 4" X 1/4"
7'-1" TO 9'-0"	6" X 4" X 1/4"
9'-1" TO 10'-0"	6" X 4" X 5/16"
10'-1" TO 11'-0"	6" X 4" X 3/8"
11'-1" TO 12'-0"	6" X 4" X 3/8"
12'-0" AND OVER	SPECIAL ANALYSIS REQUIRED

NOTES:  
1. ALL LINTELS SHALL BE LONG LEG UP  
2. LINTELS CARRY VENEER ONLY. WHERE FLOORS, ROOFS, OR CONCENTRATED LOADS OCCUR, FURTHER ANALYSIS IS NECESSARY

### HOLDDOWN SCHEDULE

MARK	SIMPSON HOLDDOWN TYPE	ANCHOR ROD DIAMETER	ANCHOR ROD EMBEDMENT INTO FOOTING	ANCHOR ROD EMBEDMENT INTO WALL / PIER	POST SIZE (BOUNDARY MEMBER)	BOUNDARY MEMBER FASTENERS	TYPE	LENGTH	FASTENERS	REMARKS
A	HSUB-SDS2.5	7/8"	9"	S87/8X24 WITH 18" EMBED	(3) 2X6 OR 4X6	(20) 1/4" X 2.1/2" SDS	CMST12	90"	(76) 0.148 X 3.1/4" NAILS	
B	HDU11-SDS2.5	1"	12"	18" INTO CONC. PIER	6X6 OR 4X8	(30) 1/4" X 2.1/2" SDS				
C					(2) 2X6 OR (2) 2X4		MSTC66	66"	(88) 0.148 X 3.1/4" NAILS	
D	HDU14-SDS2.5	1"	20"	MUST EMBED INTO FOOTING	6X6 OF 4X8	(36) 1/4" X 2.1/2" SDS				
E	HDU4-SDS2.5	5/8"	9"	S85/8X24 WITH 18" EMBED	(2) 2X6					

SRS HOLDDOWN SCHEDULE NOTES:  
1. ALL HOLDDOWNS SPECIFIED ARE SIMPSON-STRONG-TIE  
2. LAG SCREWS SHALL NOT BE USED.  
3. ANCHOR RODS SHALL BE ASTM F1554 GR. 36 OR A36 THREADED ROD AND SHALL HAVE A 1/4"X3"X3" PLATE WASHER WITH DOUBLE HEAVY HEX NUT AT THE END OF THE EMBEDMENT IN CONCRETE. FOR SIMPSON 'SB' TYPE ANCHOR BOLTS, USE ANCHORAGE ASSEMBLY SPECIFIED BY MANUFACTURER  
4. INCREASE FOOTING DEPTH WHERE EMBEDMENT LENGTH + 3" IS GREATER THAN SPECIFIED FOOTING DEPTH  
5. SEE DETAIL 10/SS01 FOR TYPICAL HOLDDOWN AT INTERIOR FOOTING  
6. ALL HOLDDOWN ANCHOR RODS SHALL BE CAST IN PLACE. DRILLING AND EPOXYING THE HOLDDOWN ANCHOR RODS IS NOT PERMITTED.  
7. ALL FLOORS, CONTRACTOR HAS OPTION TO USE ALTERNATIVE STRAP HOLDDOWN IN LIEU OF HDU STYLE HOLDDOWN  
8. SEE GENERAL STRUCTURAL NOTES FOR ADDITIONAL REQUIREMENTS

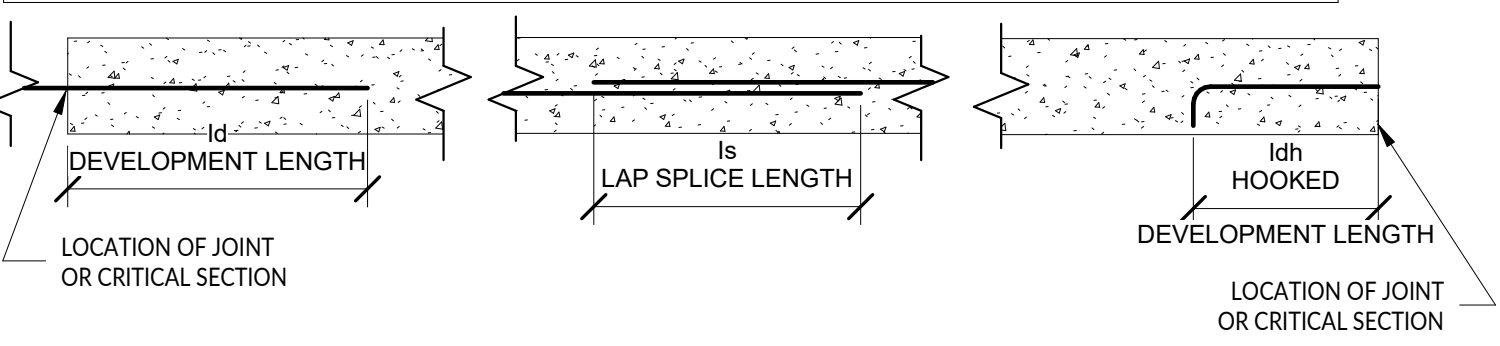

### CONCRETE FOOTING SCHEDULE




MARK	WIDTH	LENGTH	THICK	REINFORCING CROSSWISE				REINFORCING LENGTHWISE				REMARKS
				NO.	SIZE #	LENGTH	SPACING	NO.	SIZE #	LENGTH	SPACING	
FC2.0	2'-0"	CONT.	12"	NONE	-	-	-	2	#5	CONT.	EVEN	
FC4.0	4'-0"	CONT.	24"	REQD	#5	3'-6"	12"	4	#5	CONT.	EVEN	TOP AND BOTTOM
FS3.0	3'-0"	3'-0"	12"	3	#5	2'-6"	EVEN	3	#5	2'-6"	EVEN	
FS4.0	4'-0"	4'-0"	12"	4	#5	3'-6"	EVEN	4	#5	3'-6"	EVEN	
FS5.0	5'-0"	5'-0"	14"	5	#5	4'-6"	EVEN	5	#5	4'-6"	EVEN	

NOTES:  
1. PLACE ALL FOOTINGS REINFORCING 3" FROM BOTTOM OF FOOTING WITH 3" CLEAR ON SIDES UNLESS NOTED OTHERWISE.  
2. FOOTINGS MUST BEAR ON COMPACTED STRUCTURAL FILL AS INDICATED IN THE GEOTECHNICAL REPORT.

### CONCRETE WALL SCHEDULE

MARK	THICKNESS	REINFORCING			TYPE	COMMENTS
		VERTICAL	HORIZONTAL	TOP AND BOTTOM		
CW-10A	10"	#4 AT 16" O.C.	#5 AT 15" O.C.	(1)#4	A	

NOTE:  
1. SEE GENERAL STRUCTURAL NOTES FOR ADDITIONAL REQUIREMENTS

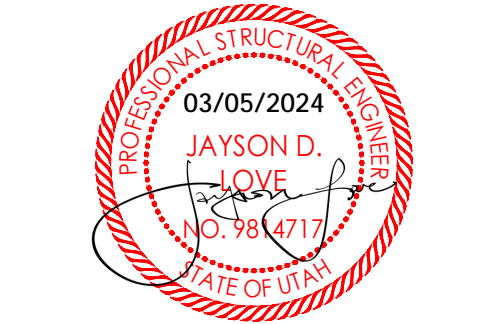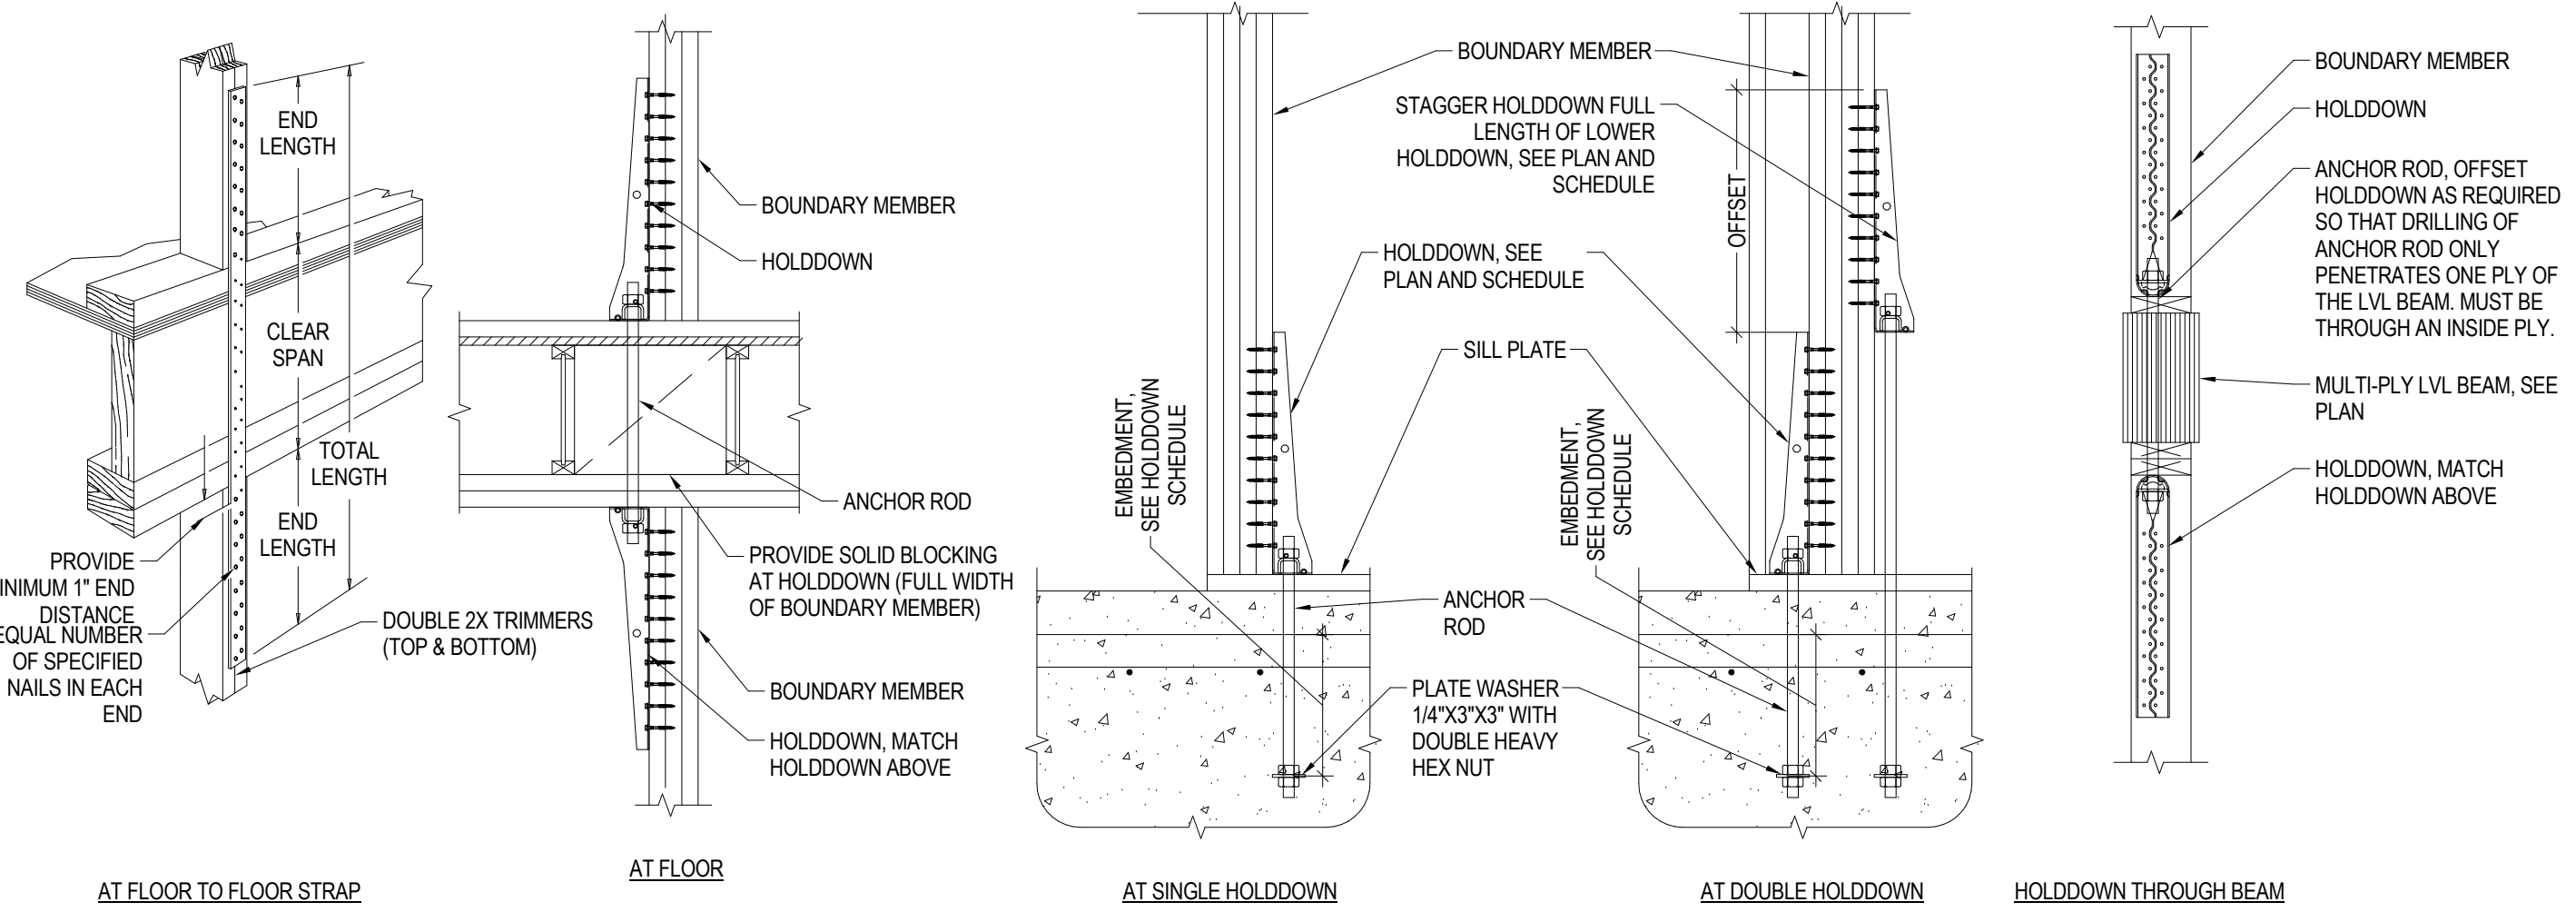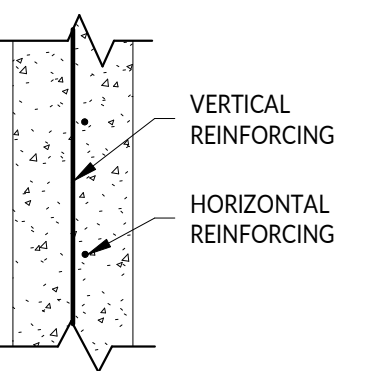

**JONES & ASSOCIATES**  
CONSULTING ENGINEERS  
6080 S FASHION POINT DRIVE  
SOUTH OGDEN, UT 84405

No.	Date	Description
1	09.21.23	PERMIT SET
2	02.29.23	PLAN REVIEW


  

No.	Date	Description
1	10.30.23	ADDENDUM #1
2	02.29.23	PLAN REVIEW/REDESIGN


SAA Project No. 2022-11  
Drawing Title

STRUCTURAL SCHEDULES


Sheet Number  
**S601**

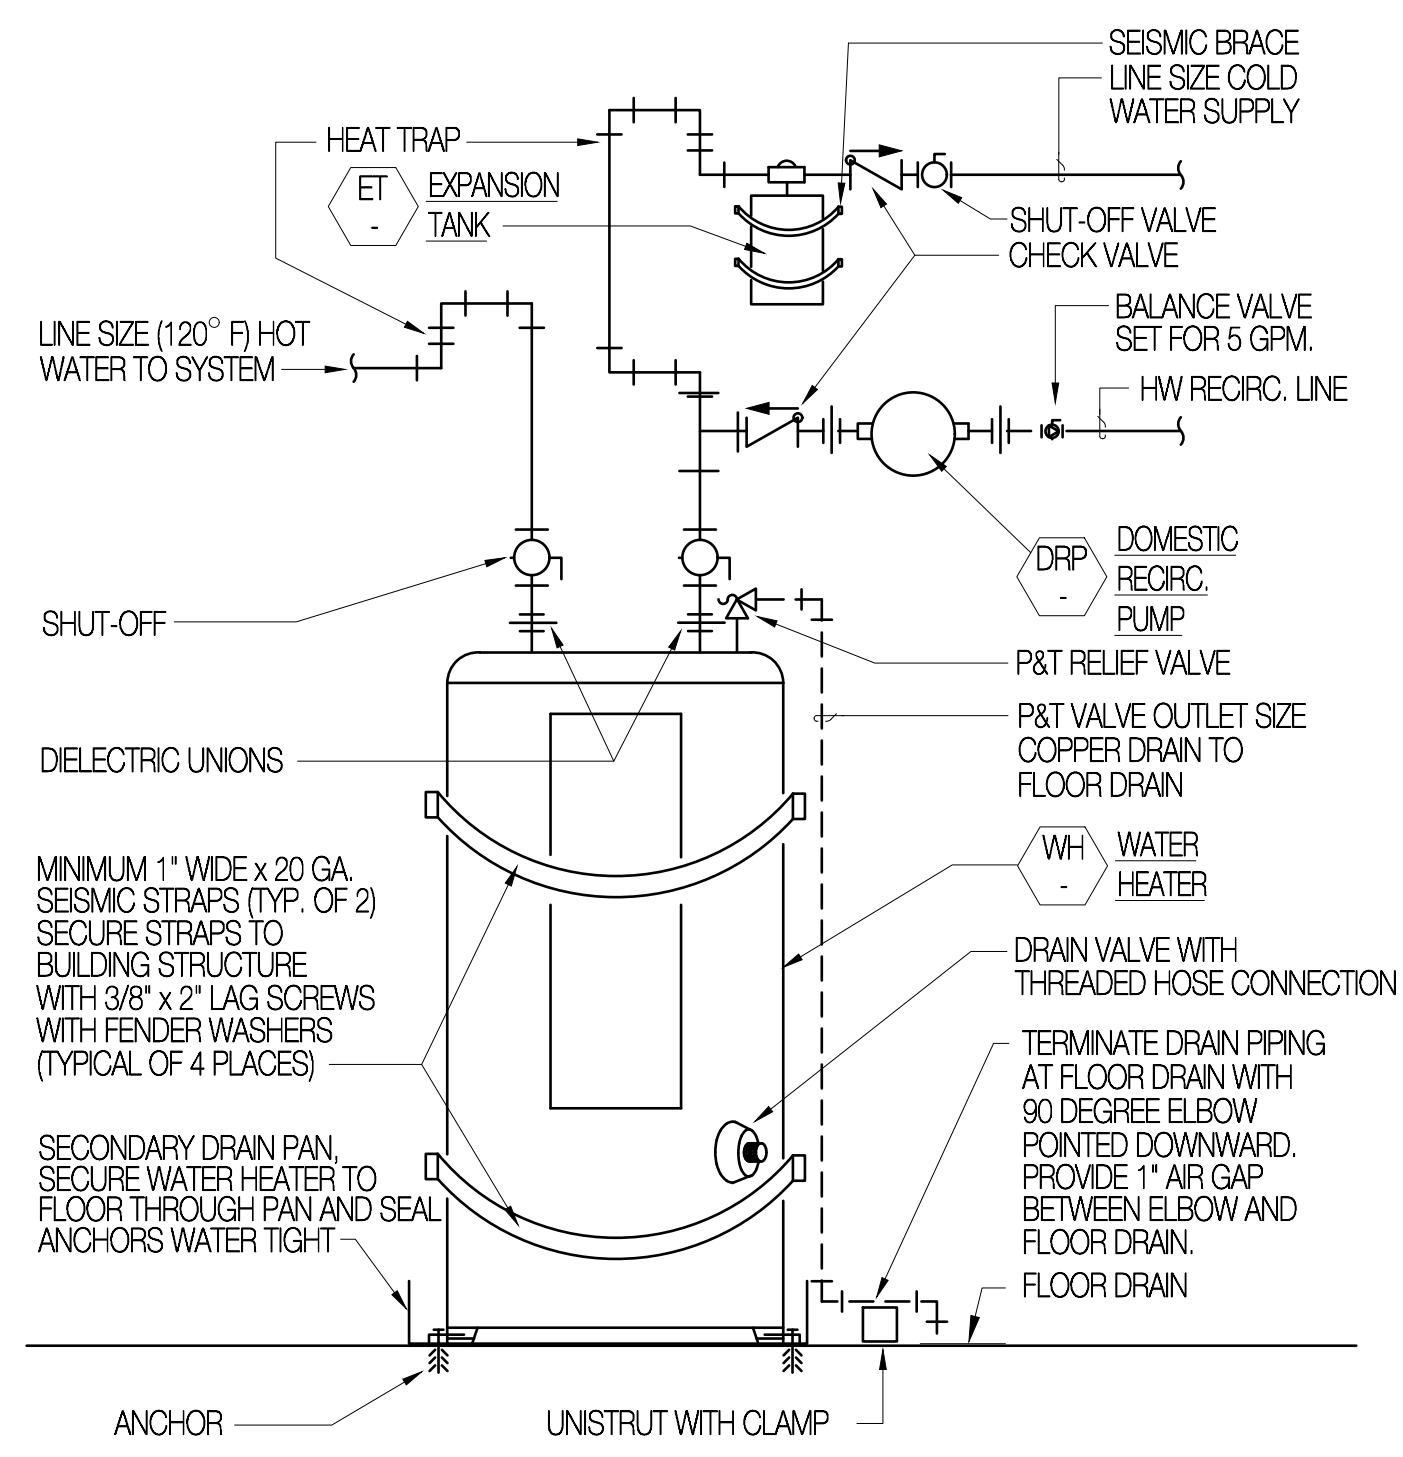


**5 WATER HEATER DETAIL**  
SCALE: NONE

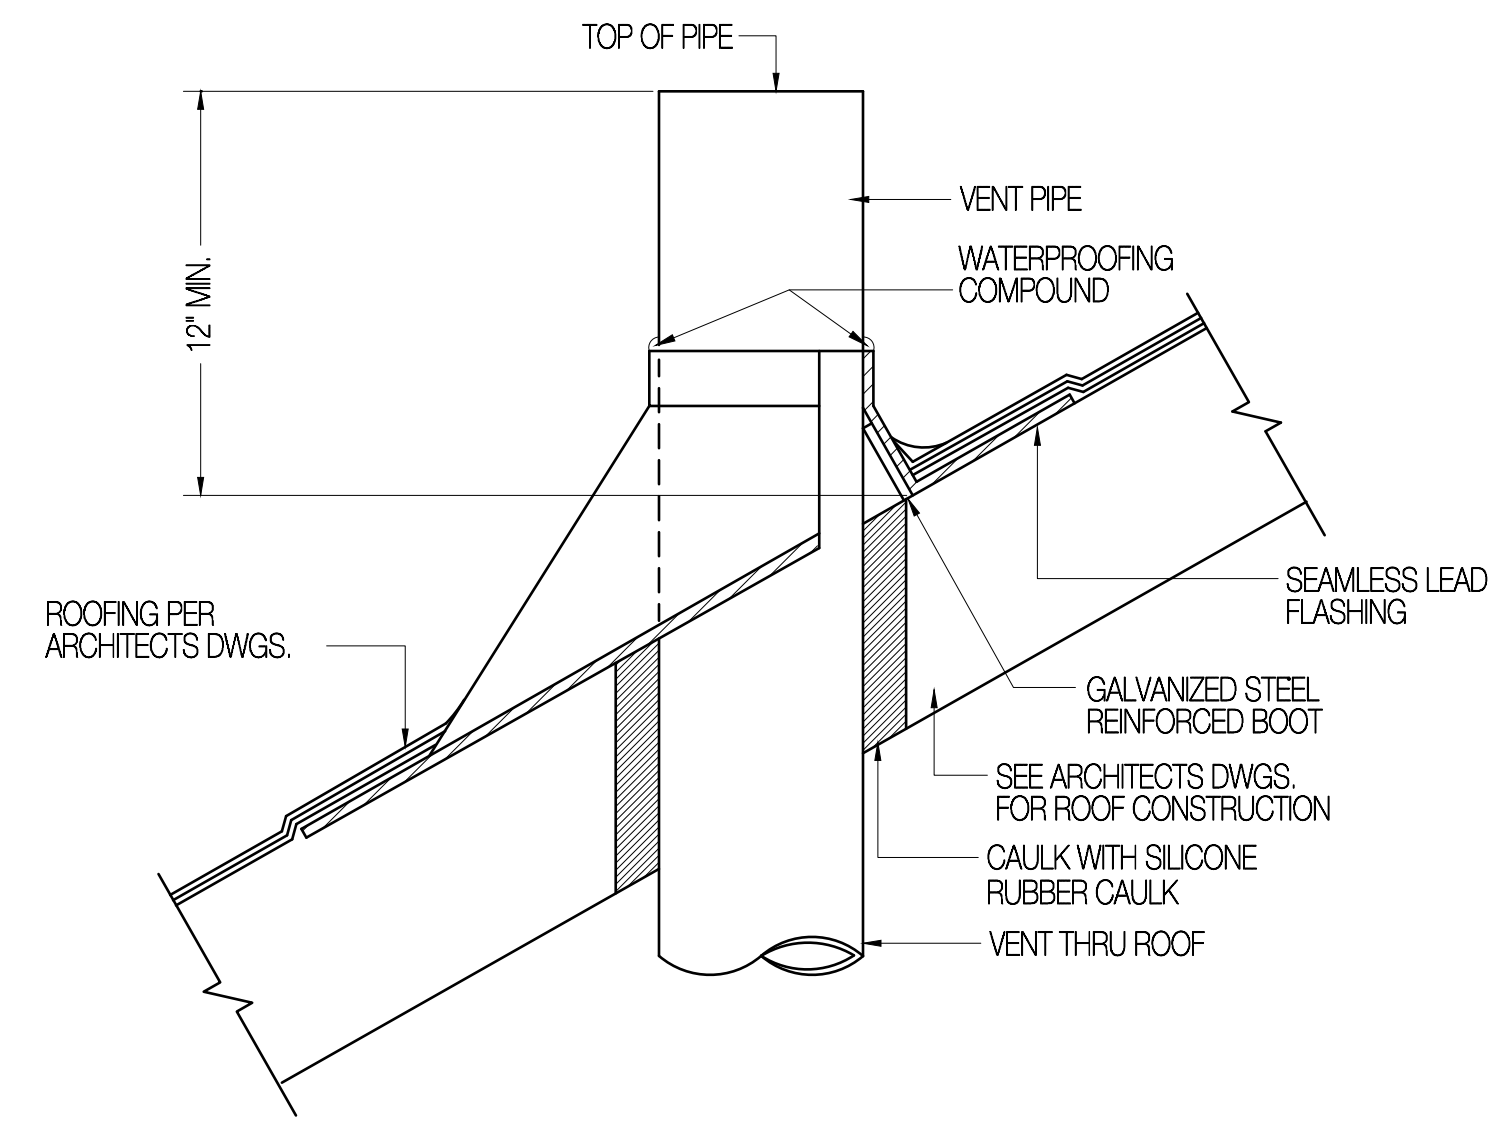


**6 VENT THROUGH ROOF DETAIL**  
SCALE: NONE

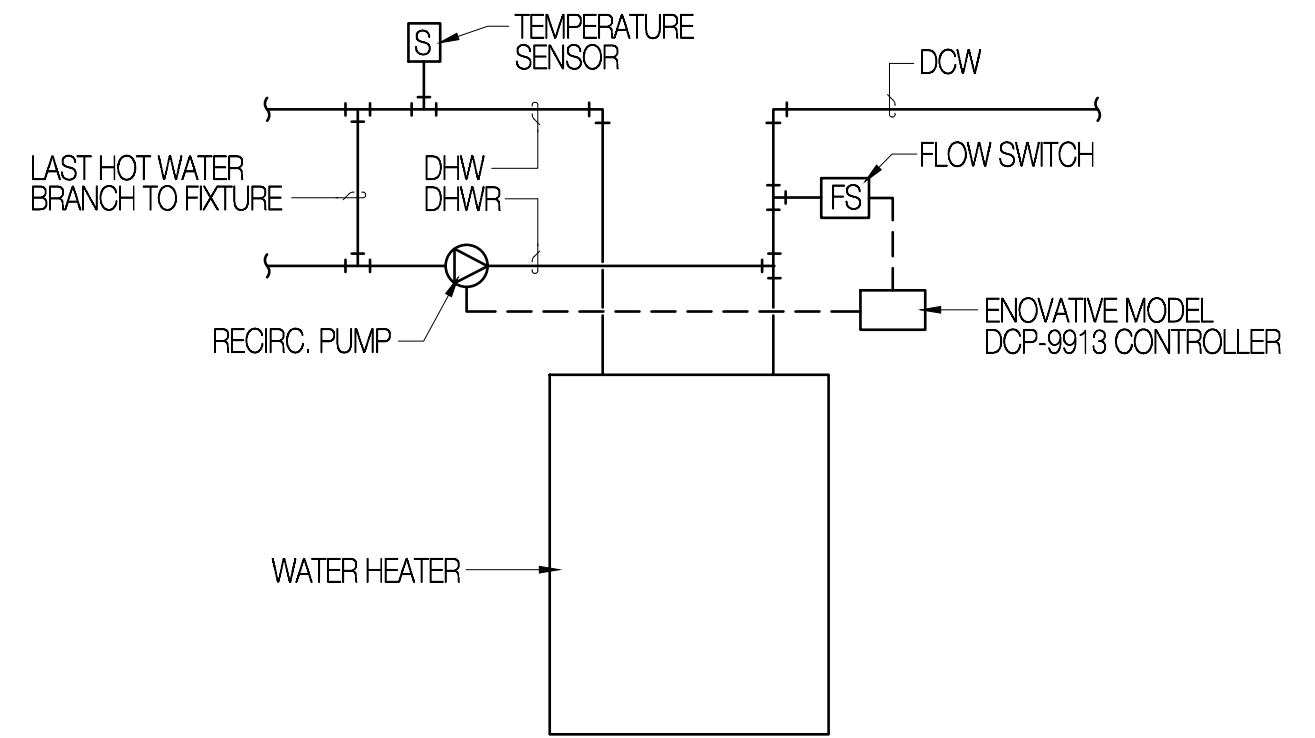

**DOMESTIC WATER RECIRC. CONTROL DIAGRAM**

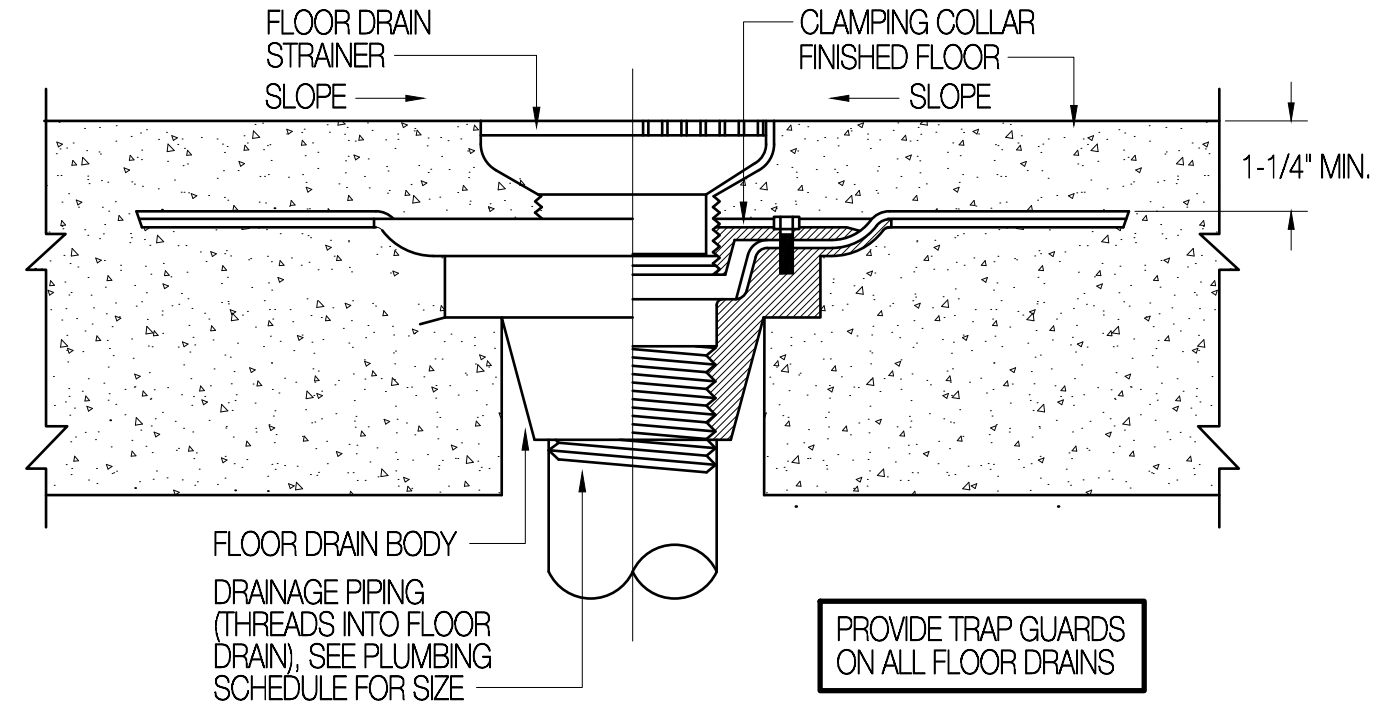


**1 FLOOR DRAIN DETAIL**  
SCALE: NONE

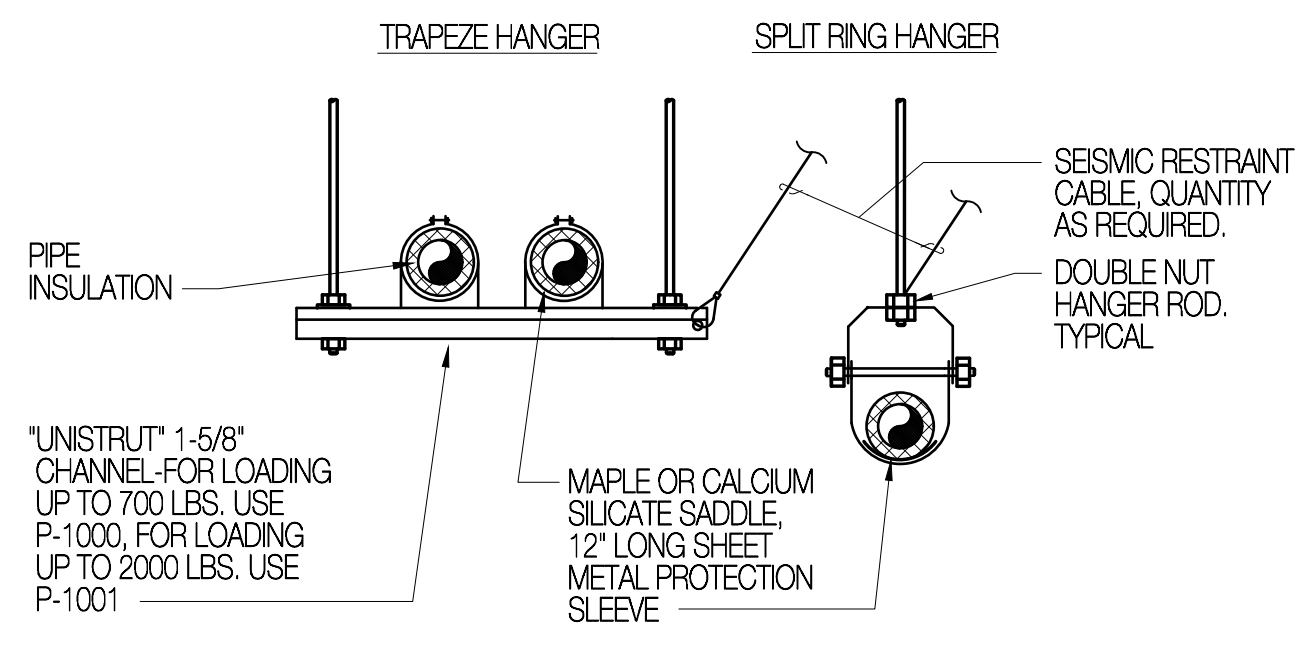


PIPE SIZE	MAX. SPACING	PIPE LOAD WEIGHT/FT. TOTAL	ROD SIZE
1" AND SMALLER	8	2.5/20	3/8"
1-1/4" - 2"	10	6/60	3/8"

HANGERS SIZES AND SPACING ARE FOR SINGLE PIPES. HANGER ROD LOADING FOR TRAPEZE HANGERS SHALL NOT EXCEED THE TOTAL LOADING INDICATED. IF SMALLER ROD SIZE IS USED, DECREASE MAXIMUM SPACING SO THAT TOTAL LOADING IS NOT EXCEEDED.

**2 PIPE HANGER DETAIL**  
SCALE: NONE

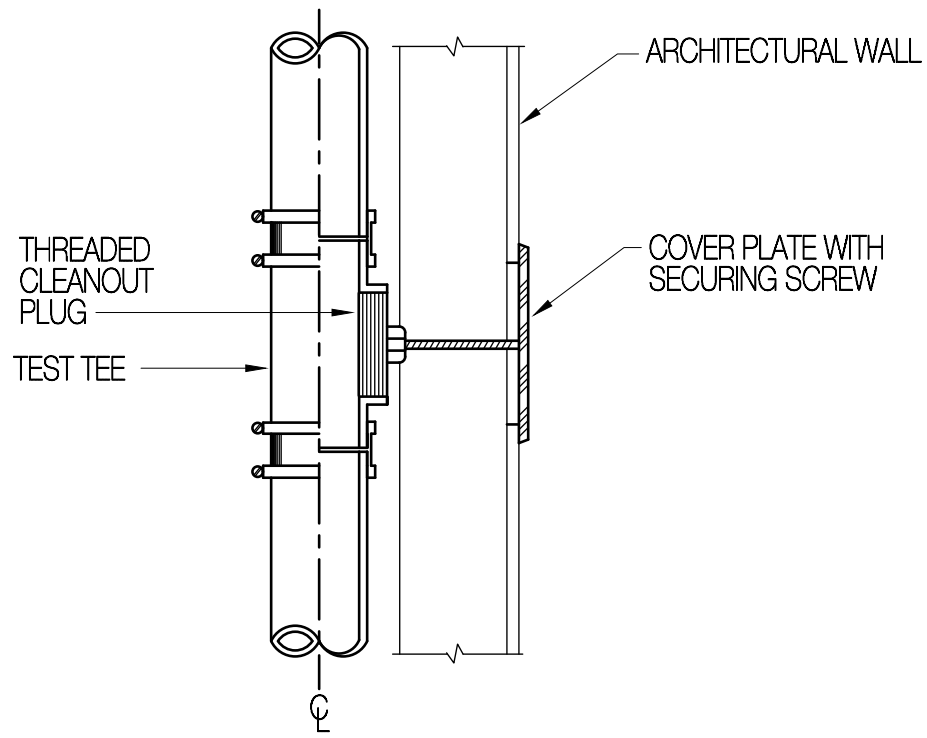

**3 WALL CLEANOUT DETAIL**  
SCALE: NONE

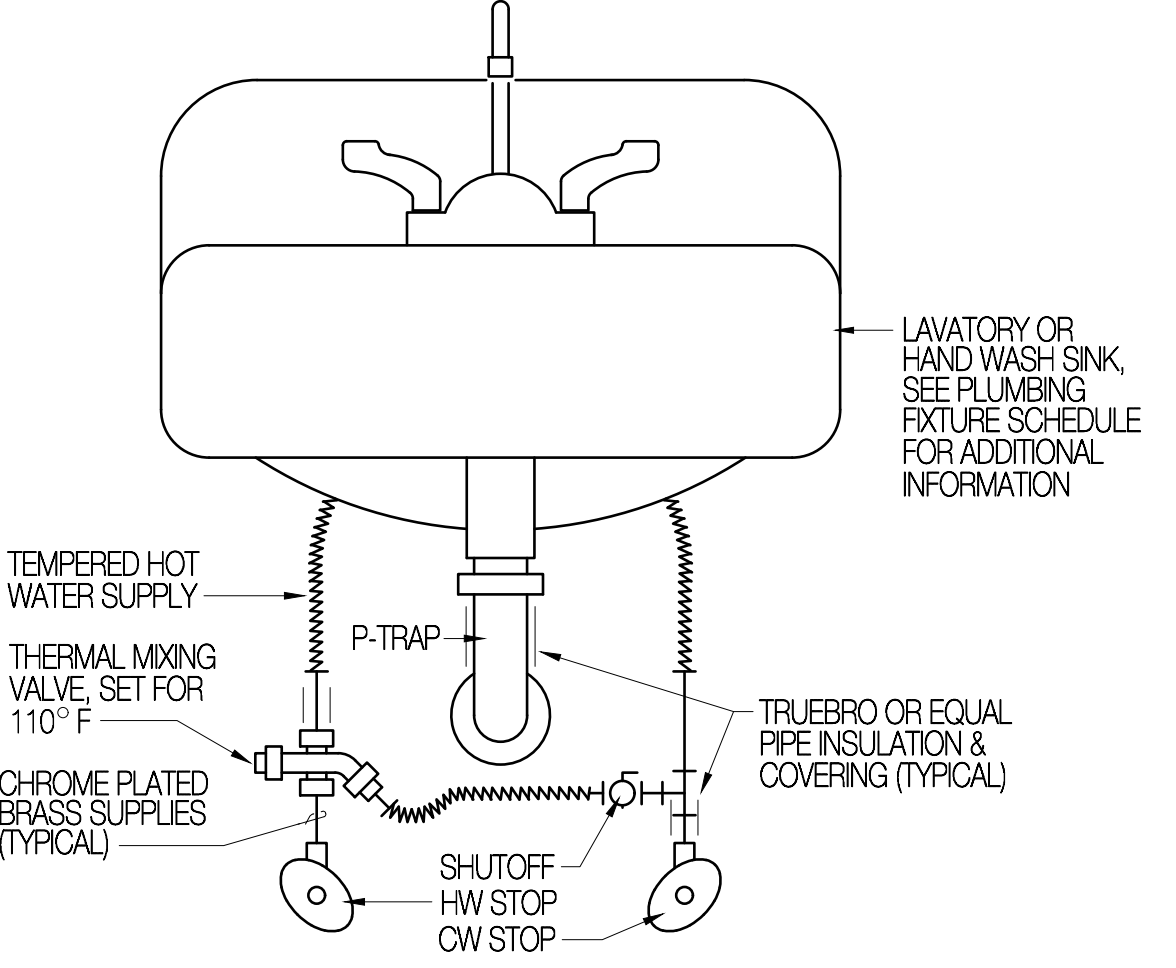

**4 TEMPERING VALVE DETAIL**  
SCALE: NONE

FD	FLOOR DRAIN	TEE	TEE IN PIPE
WCO	WALL CLEAN OUT	CV	BALL VALVE
DCW	DOMESTIC COLD WATER (DCW)	PC	PIPE CAP
DHW	DOMESTIC HOT WATER (DHW)	VD	VALVE IN DROP
DHWR	DOMESTIC HOT WATER RECIRC. (DHWR)	UN	UNION
W	WASTE (W)	VTR	VENT THROUGH ROOF
V	VENT (V)	A.F.F.	ABOVE FINISHED FLOOR
DRP	DROP IN PIPE	ELB	ELBOW IN PIPE
RI	RISE IN PIPE		

SYMBOL	DESCRIPTION	COLD	HOT	TRAP	WASTE	VENT	REMARKS
P-1	WATER CLOSET, FLOOR MOUNTED, FLUSH TANK, ADA HEIGHT	1/2"	-	INT.	3"	2"	-
P-2	LAVATORY, PORCELAIN, WALL MOUNTED, ADA COMPLIANT	1/2"	1/2"	1-1/4"	2"	1-1/2"	-
P-3	BREAKROOM SINK, SINGLE BOWL, SS, UNDERMOUNT, GOOSENECK FAUCET	1/2"	1/2"	1-1/2"	2"	1-1/2"	W / GARBAGE DISPOSAL
P-4	WATER COOLER, BI-LEVEL WITH BOTTLE FILLER	1/2"	-	1-1/2"	2"	1-1/2"	-
FD	FLOOR DRAIN, 6" DIAMETER GRATE	-	-	2"	2"	2"	-
SD	SHOWER DRAIN, 4" DIAMETER GRATE	-	-	2"	2"	2"	-
WCO	WALL CLEAN OUT	-	-	-	-	-	-

**GENERAL FIXTURE NOTES:**

- THE PLUMBING CONTRACTOR SHALL VERIFY THE REQUIREMENTS OF ALL PLUMBING EQUIPMENT AND THE RELATED ROUGH IN LOCATIONS WITH THE MECHANICAL AND ARCHITECTURAL PLANS AND SPECIFICATIONS. PROVIDE ALL ACCESSORIES AND OPTIONS REQUIRED TO PROVIDE THE OWNER A COMPLETELY FUNCTIONAL PLUMBING SYSTEM.
- ALL WALL HUNG PLUMBING FIXTURES SHALL BE SUPPORTED BY FLOOR MOUNTED CARRIERS (SMITH, JOSAM, MIFAB, OR WATTS) CARRIERS SHALL BE CONSTRUCTED UTILIZING ALL METAL COMPONENTS WITH SUPPORT FEET SECURELY ANCHORED TO FLOOR STRUCTURE. FIXTURE ARMS SHALL SUPPORT FIXTURE INDEPENDENT FROM WALL STRUCTURE.
- EACH INDIVIDUAL FIXTURE SUPPLY SHALL BE PROVIDED WITH A CHROME-PLATED QUARTER TURN STOP VALVE BRASS CRAFT MODEL KTOR, OR ENGINEER APPROVED EQUAL.
- FIXTURES AND ACCESSORIES SHALL BE AS SCHEDULED. EACH ITEM SHALL BE COMPLETE WITH CHROME-PLATED BRASS TRIM.
- ADA COMPLIANT FIXTURES SHALL BE INSTALLED WITH PRE-FORMED INSULATION AND PROTECTIVE COVERS ON P-TRAPS AND STOPS. COVERS TO BE MANUFACTURED BY BUCKROOS OR TRILEPRO.
- CAULK ALL FIXTURES TO THE WALL OR FLOOR WITH APPLICABLE SILICONE COMPOUND. UTILIZE MULTIPLE BEADS TO FILL GAPS AND FINISH TO SMOOTH, FILLETED EDGE. USE APPROPRIATE TOOLS TO PROVIDE PROFESSIONAL APPEARANCE.
- ALL PLUMBING SHALL BE INSTALLED TO CONFORM TO THE LATEST ADOPTED EDITION OF THE IDAHO PLUMBING CODE INCLUDING LOCAL AMENDMENTS. CONSULT AUTHORITIES HAVING JURISDICTION.
- ALL SINKS AND LAVATORIES WHERE HAND WASHING IS ANTICIPATED (FIXTURE P-2) SHALL BE PROTECTED WITH ASSE 1070 APPROVED TEMPERING VALVES PER DETAIL 4/P-000.

SYMBOL	NOMINAL INPUT (WATTS)	TANK VOLUME (GALLONS)	WATER CHARACTERISTICS			ELEC. CHARACTERISTICS			A.O. SMITH MODEL	REMARKS
			EWI °F	LWT °F	RECOVERY (GPH)	VOLTS	HZ	PHASE		
WH-1	4,500	40	40	122	21	240	60	1	HNT-40	-

SYMBOL	TANK VOLUME GAL.	ACCEPT VOLUME GAL.	DUTY	AMTROL MODEL	ARRANGEMENT	REMARKS
ET-1	0.9	2.1	DOMESTIC WATER	ST-5	VERTICAL	-

SYMBOL	GPM	FEET HEAD	ELEC. REQUIREMENTS			DUTY	TYPE	B&G SERIES	SIZE	REMARKS
			VOLTS	PH.	HZ.					
DRP-1	5	15	120	1	60	DOMESTIC HOT WATER RECIRC. WH-1	ALL BRONZE WET ROTOR	NBF	25	MEDIUM SPEED

SERVICE	MATERIAL	REMARKS
DCW / DHW / DHWR	TYPE L COPPER WITH WROUGHT COPPER FITTINGS	-
WASTE / VENT	SOLID CORE SCHEDULE 40 PVC WITH PVC DWV FITTINGS	-
NAT. GAS	SCHEDULE 40 BLACK STEEL WITH BLACK STEEL FITTINGS	-



Consultant

**JONES & ASSOCIATES**  
CONSULTING ENGINEERS  
6080 S FASHION POINT DRIVE  
SOUTH OGDEN, UT 84405

No.	Date	Description

No.	Date	Description
2	02.01.24	PLAN REVIEW/REDESIGN

SAA Project No. 2022-03

PLUMBING SYMBOL LEGEND, SCHEDS. AND DETAILS

Sheet Number  
**P-000**





## DRAWING NOTES

- 1 PIPE SUPPORT, SEE DETAIL 2/P-000.
- 2 FIELD VERIFY EXACT SIZE AND LOCATION OF EXISTING WASTE PIPING AND CONNECT NEW TO EXISTING UTILIZING LIKE MATERIALS.
- 3 FIELD VERIFY EXACT SIZE AND LOCATION OF EXISTING GAS PIPING AND CONNECT NEW TO EXISTING UTILIZING LIKE MATERIALS.
- 4 3" WASTE PIPING RISE TO FIXTURES ON SECOND FLOOR, SEE SECOND FLOOR PLUMBING PLAN THIS SHEET FOR CONTINUATION.
- 5 2" VENT PIPING RISE TO FIXTURES ON SECOND FLOOR, SEE SECOND FLOOR PLUMBING PLAN THIS SHEET FOR CONTINUATION.
- 6 3/4" DOMESTIC COLD, AND 3/4" GAS PIPING RISES TO SECOND FLOOR, SEE SECOND FLOOR PLUMBING PLAN THIS SHEET FOR CONTINUATION.
- 7 2" WASTE PIPING RISE TO FIXTURES ON SECOND FLOOR, SEE SECOND FLOOR PLUMBING PLAN THIS SHEET FOR CONTINUATION.
- 8 1/2" DOMESTIC COLD WATER PIPING DROP TO FIXTURES ON BOTH FLOORS. TERMINATE PIPING AT REQUIRED FIXTURE ROUGH-IN HEIGHT WITH QUARTER TURN STOP AND ESCUTCHEON AS REQUIRED BY SPECIFICATION.
- 9 1/2" DOMESTIC COLD WATER AND 1/2" DOMESTIC HOT WATER PIPING DROPS TO THERMOSTATIC MIXING VALVE. TERMINATE PIPING AT SHOWER VALVE ROUGH IN HEIGHT AND INSTALL VALVE WITH UNION CONNECTION AS REQUIRED BY SPECIFICATION.
- 10 1/2" (4 OZ.) GAS PIPING DROP TO FURNACE. TERMINATE GAS PIPING WITH DIRT LEG, SHUTOFF VALVE AND FLEXIBLE CONNECTION.
- 11 3/4" (4 OZ.) GAS PIPING DROP TO FURNACE. TERMINATE GAS PIPING WITH DIRT LEG, SHUTOFF VALVE AND FLEXIBLE CONNECTION.
- 12 3/4" DOMESTIC COLD, HOT, AND HOT WATER RECIRC. PIPING DROPS IN WALL TO FIXTURES. SEE WATER PIPING ISOMETRIC THIS SHEET FOR ADDITIONAL INFORMATION.
- 13 1/2" DOMESTIC HOT WATER AND 1/2" DOMESTIC COLD WATER PIPING DROPS TO FIXTURE. TERMINATE PIPING AT REQUIRED FIXTURE ROUGH-IN HEIGHT WITH QUARTER TURN STOP AND ESCUTCHEON AS REQUIRED BY SPECIFICATION.
- 14 EXTEND 1/2" DOMESTIC HOT WATER AND 1/2" DOMESTIC COLD WATER PIPING TO NEAREST UTILITY LOCATION AND CONNECT NEW TO EXISTING.
- 15 FIELD VERIFY EXACT SIZE AND LOCATION OF EXISTING WATER PIPING AND CONNECT NEW TO EXISTING UTILIZING LIKE MATERIALS.

## EQUIPMENT NOTES


- 50 WH 1 CEILING EXHAUST FAN      51 DRP 1 DOMESTIC RECIRC. PUMP

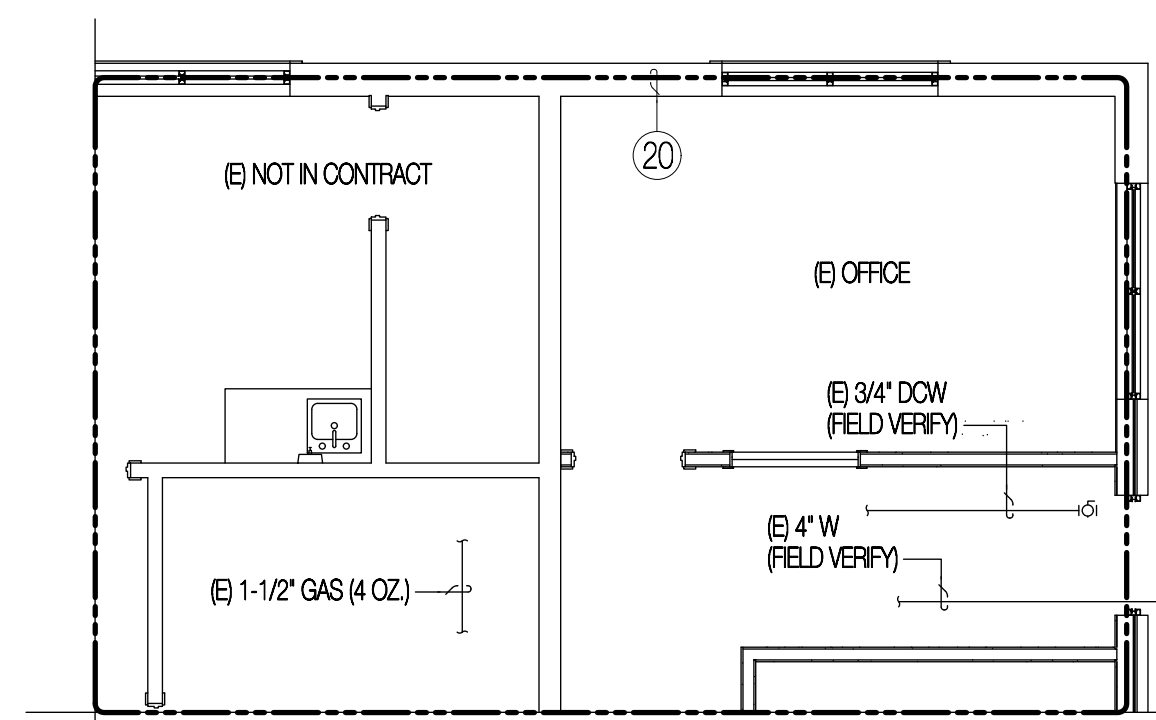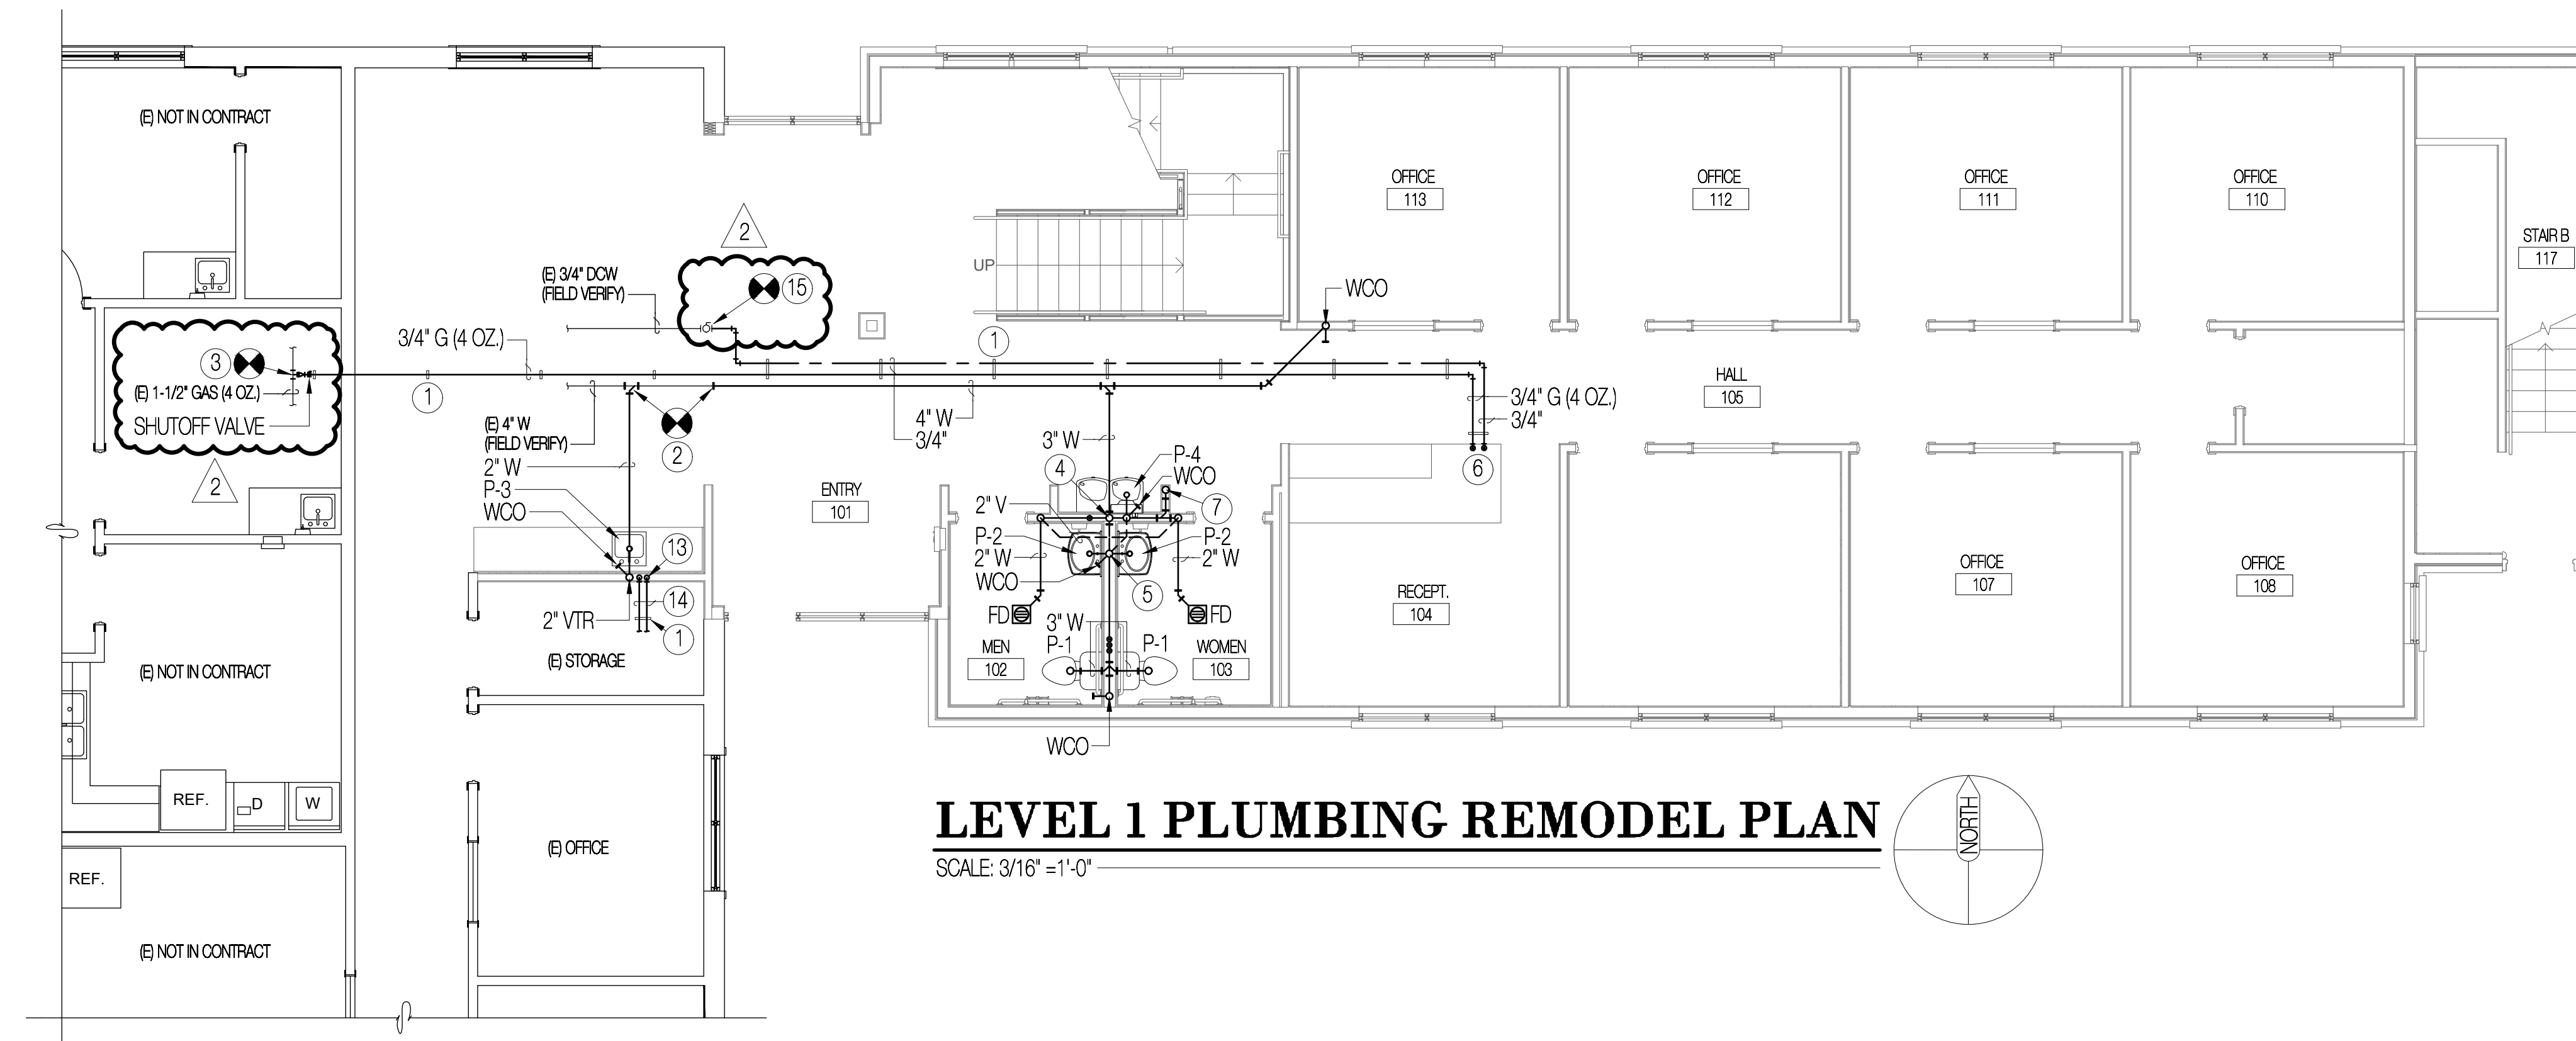

- 20 FIELD VERIFY EXACT SIZE AND LOCATION OF EXISTING HVAC AND PLUMBING UTILITIES AND MODIFY THE EXISTING UTILITIES AS REQUIRED TO SERVE THE REMODELED SPACE. DEMO PORTIONS OF THE EXISTING UTILITIES NOT REQUIRED TO REMAIN IN SERVICE.



## GENERAL DEMO. PLAN

SCALE: 3/16" = 1'-0"

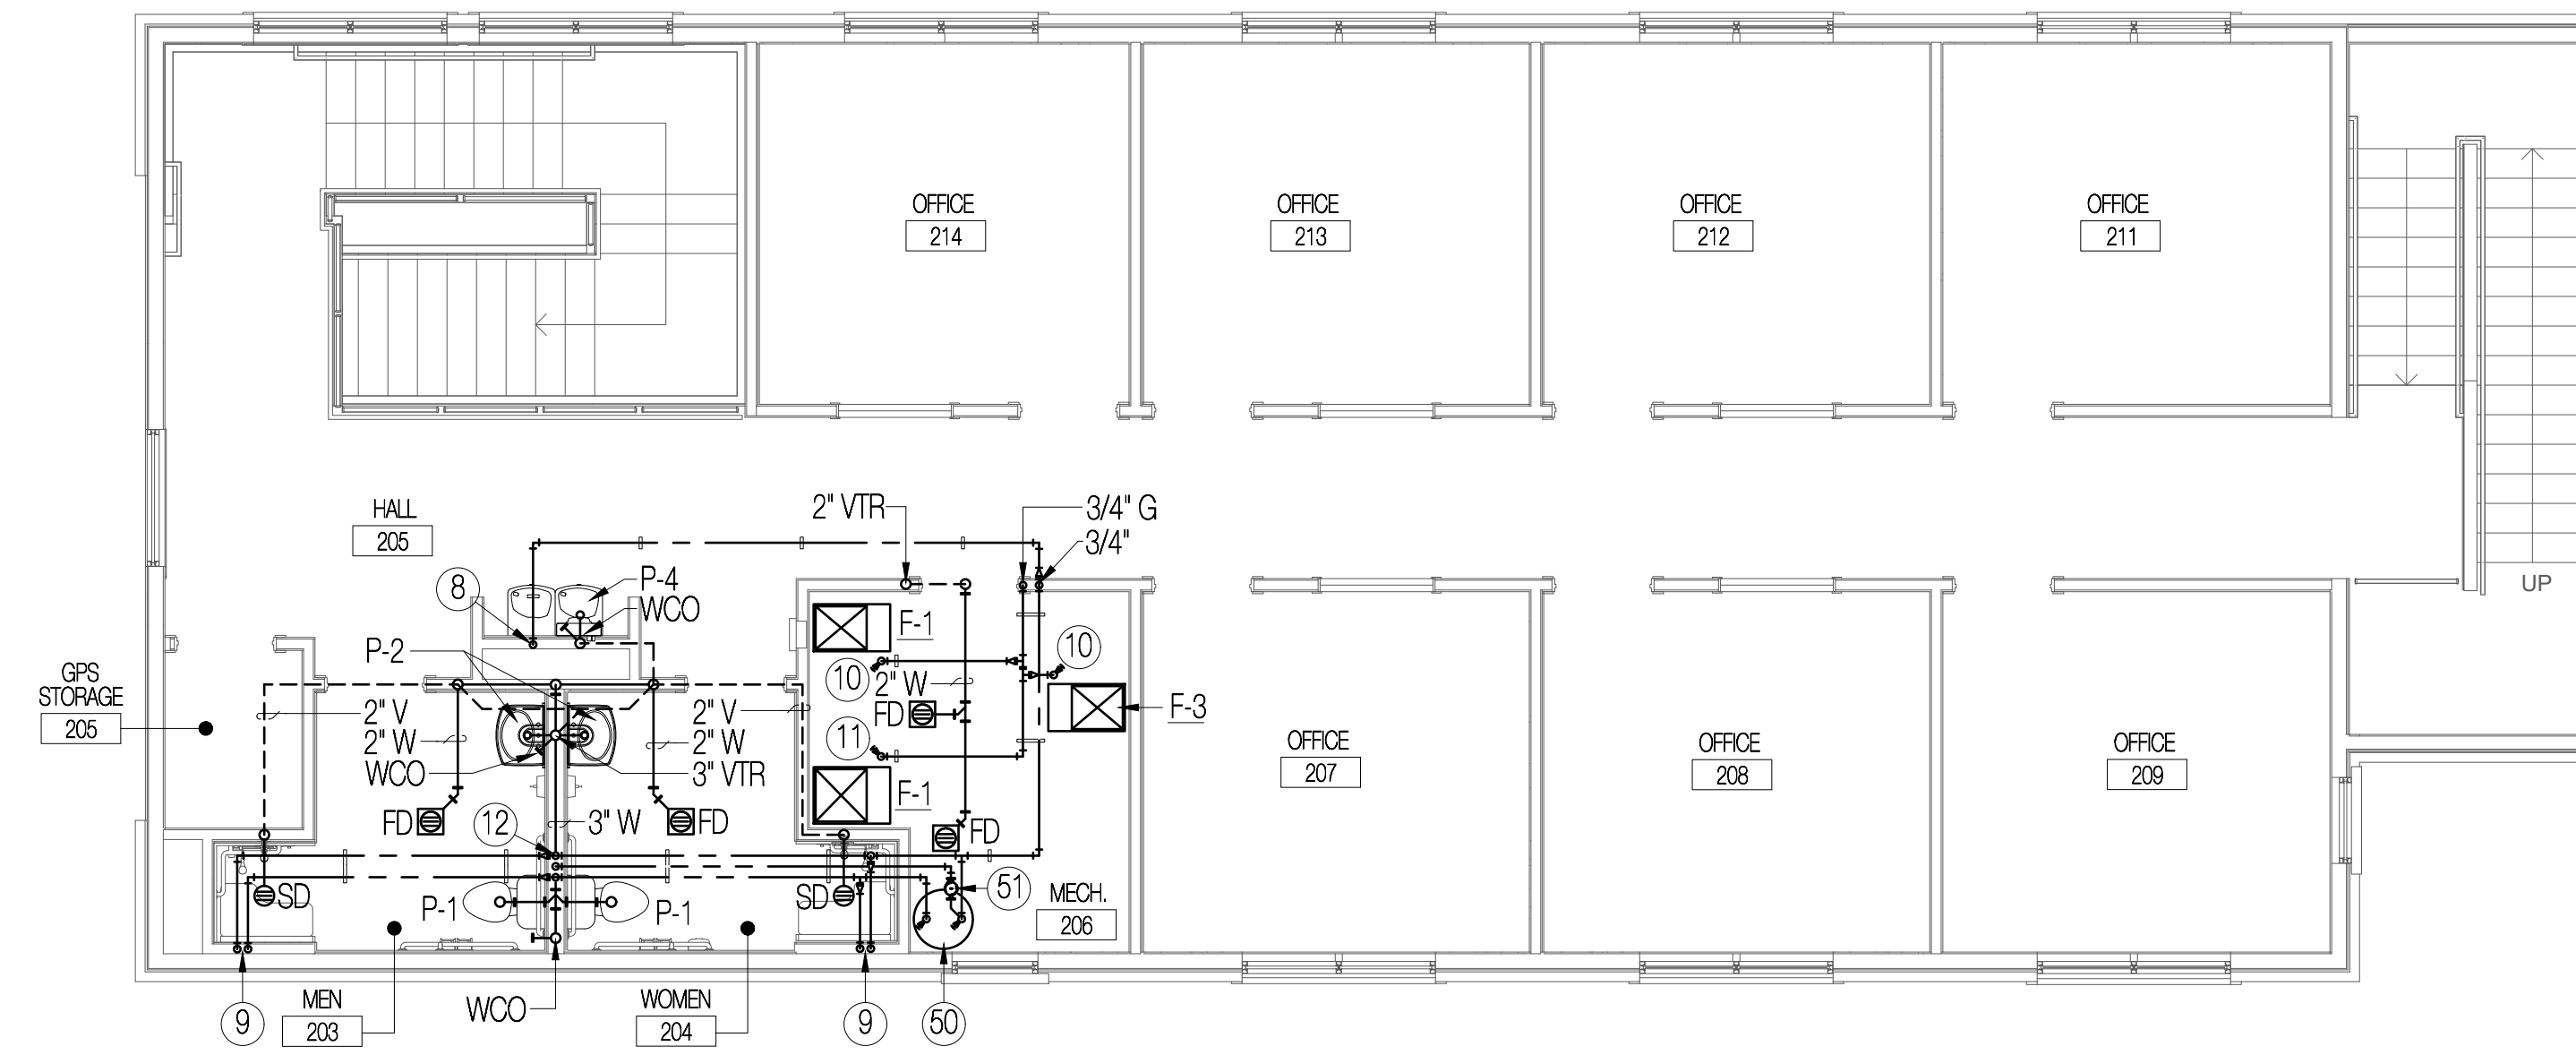

## LEVEL 2 PLUMBING PLAN

SCALE: 3/16" = 1'-0"

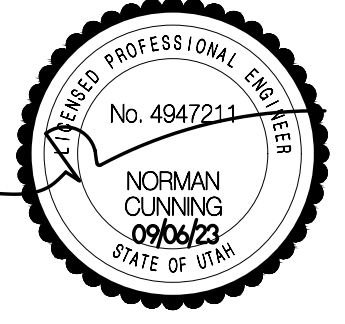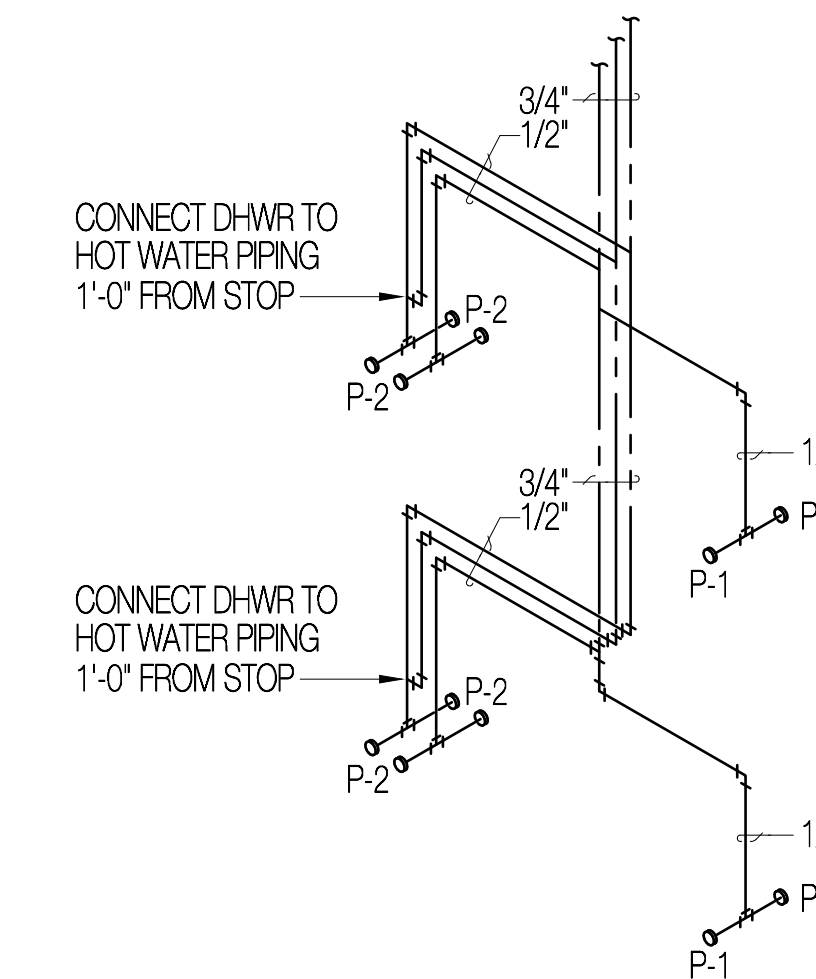

Consultant

Project Name

**JONES & ASSOCIATES**  
CONSULTING ENGINEERS  
6080 S FASHION POINT DRIVE  
SOUTH OGDEN, UT 84405

Issued No.	Date	Description

Revision No.	Date	Description
2	02.01.24	PLAN REVIEW/REDESIGN

SAA Project No. 2022-03

PLUMBING REMODEL PLANS AND DIAGRAMS

Sheet Number

**P-100**


### OUTSIDE AIR SCHEDULE

ROOM	AREA	CFM / SQ. FT.	PEOPLE / 1,000 SQ. FT.	# PEOPLE	CFM / PEOPLE	CFM	SERVED BY	ROOM	AREA	CFM / SQ. FT.	PEOPLE / 1,000 SQ. FT.	# PEOPLE	CFM / PEOPLE	CFM	SERVED BY
RECEPT. 104	200	0.06	10	3	5	27	F-1	HALL 205	345	0.12	-	-	-	42	F-2
OFFICE 106	135	0.06	5	1	5	14	-	OFFICE 211	135	0.06	5	1	5	14	-
OFFICE 107	135	0.06	5	1	5	14	-	OFFICE 212	135	0.06	5	1	5	14	-
OFFICE 108	135	0.06	5	1	5	14	-	OFFICE 213	135	0.06	5	1	5	14	-
OFFICE 110	135	0.06	5	1	5	14	-	OFFICE 214	135	0.06	5	1	5	14	-
OFFICE 111	135	0.06	5	1	5	14	-						100	TOTAL	
OFFICE 112	135	0.06	5	1	5	14	-	MEN 203	65	-	-	-	-	25	F-3
OFFICE 113	135	0.06	5	1	5	14	-	WOMEN 204	65	-	-	-	-	25	F-3
						125	TOTAL	OFFICE 207	135	0.06	5	1	5	14	-
								OFFICE 208	135	0.06	5	1	5	14	-
								OFFICE 209	135	0.06	5	1	5	14	-
													100	TOTAL	

Calculations based on Table 6-1 ASHRAE STANDARD 62.1-2010 AND 2021 INTERNATIONAL MECHANICAL CODE

### GENERAL NOTES

1. ALL DRAWINGS SHALL BE CONSIDERED PART OF THE CONTRACT DOCUMENTS. THE CONTRACTOR SHALL FIELD VERIFY ALL EXISTING CONDITIONS AND BE RESPONSIBLE FOR THE REVIEW AND COORDINATION OF ALL ASPECTS OF THE CONTRACT DOCUMENTS PRIOR TO SUBMITTING PRICING. ANY AND ALL DISCREPANCIES SHALL BE BROUGHT TO THE ATTENTION OF THE ENGINEER PRIOR TO ANY INSTALLATION SUCH THAT CLARIFICATIONS CAN BE ISSUED.
2. ANY WORK PERFORMED OR MATERIAL USED WHICH IS SHOWN TO BE IN CONFLICT WITH THE CONTRACT DRAWINGS, SPECIFICATIONS OR ANY APPLICABLE CODE OR GOVERNING REGULATION SHALL BE REMOVED AND REPLACED OR CORRECTED AT THE CONTRACTOR'S EXPENSE.
3. ALL SYMBOLS AND ABBREVIATIONS USED ON THE CONTRACT DRAWINGS ARE CONSIDERED CONSTRUCTION STANDARDS. IF CLARIFICATION IS REQUIRED, THE CONTRACTOR SHALL NOTIFY THE ENGINEER PRIOR TO PROCEEDING WITH ANY WORK.
4. DO NOT SCALE THE DRAWINGS. ALL EXISTING CONDITIONS AND DIMENSIONS SHALL BE VERIFIED BY THE CONTRACTOR AT THE JOB SITE PRIOR TO FABRICATION OF MATERIALS OR ERECTION OF ASSEMBLIES. IF DISCREPANCIES ARE ENCOUNTERED, THE ENGINEER SHALL BE NOTIFIED FOR CLARIFICATION.
5. THE CONTRACTOR SHALL FURNISH ALL MATERIALS, LABOR AND EQUIPMENT, TRANSPORTATION AND SERVICES REQUIRED FOR COMPLETION OF THE WORK. ALL WORK PERFORMED AND MATERIALS INSTALLED SHALL BE DONE IN STRICT COMPLIANCE WITH ALL LOCAL CODES AND GOVERNING REGULATIONS.
6. ALL PERMITS AND FEES WHICH ARE REQUIRED FOR THIS WORK SHALL BE SECURED AND PAID FOR BY THE MECHANICAL CONTRACTOR.
7. ALL PLUMBING AND MECHANICAL INSTALLATIONS SHALL ADHERE TO THE 2018 IECC INCLUDING: MINIMUM R-6 INSULATION ON ALL NON-ACOUSTICALLY LINED DUCTWORK; ACOUSTICAL LINER SHALL PROVIDE A MINIMUM OF R-8 INSULATING VALUE. ALL DOMESTIC WATER PIPING SHALL BE INSULATED WITH A MINIMUM 1" FIBERGLASS INSULATION.
8. MECHANICAL SYSTEMS HAVE BEEN DESIGNED IN ACCORDANCE WITH ASHRAE 183. DUCTWORK DESIGNED UTILIZING EQUAL FRICTION METHOD WITH A MAXIMUM PRESSURE DROP OF 0.08"/100 FT.
9. FIRE CALL ALL PENETRATIONS THROUGH FIRE RATED ASSEMBLIES PER DETAIL 1/M5-100.

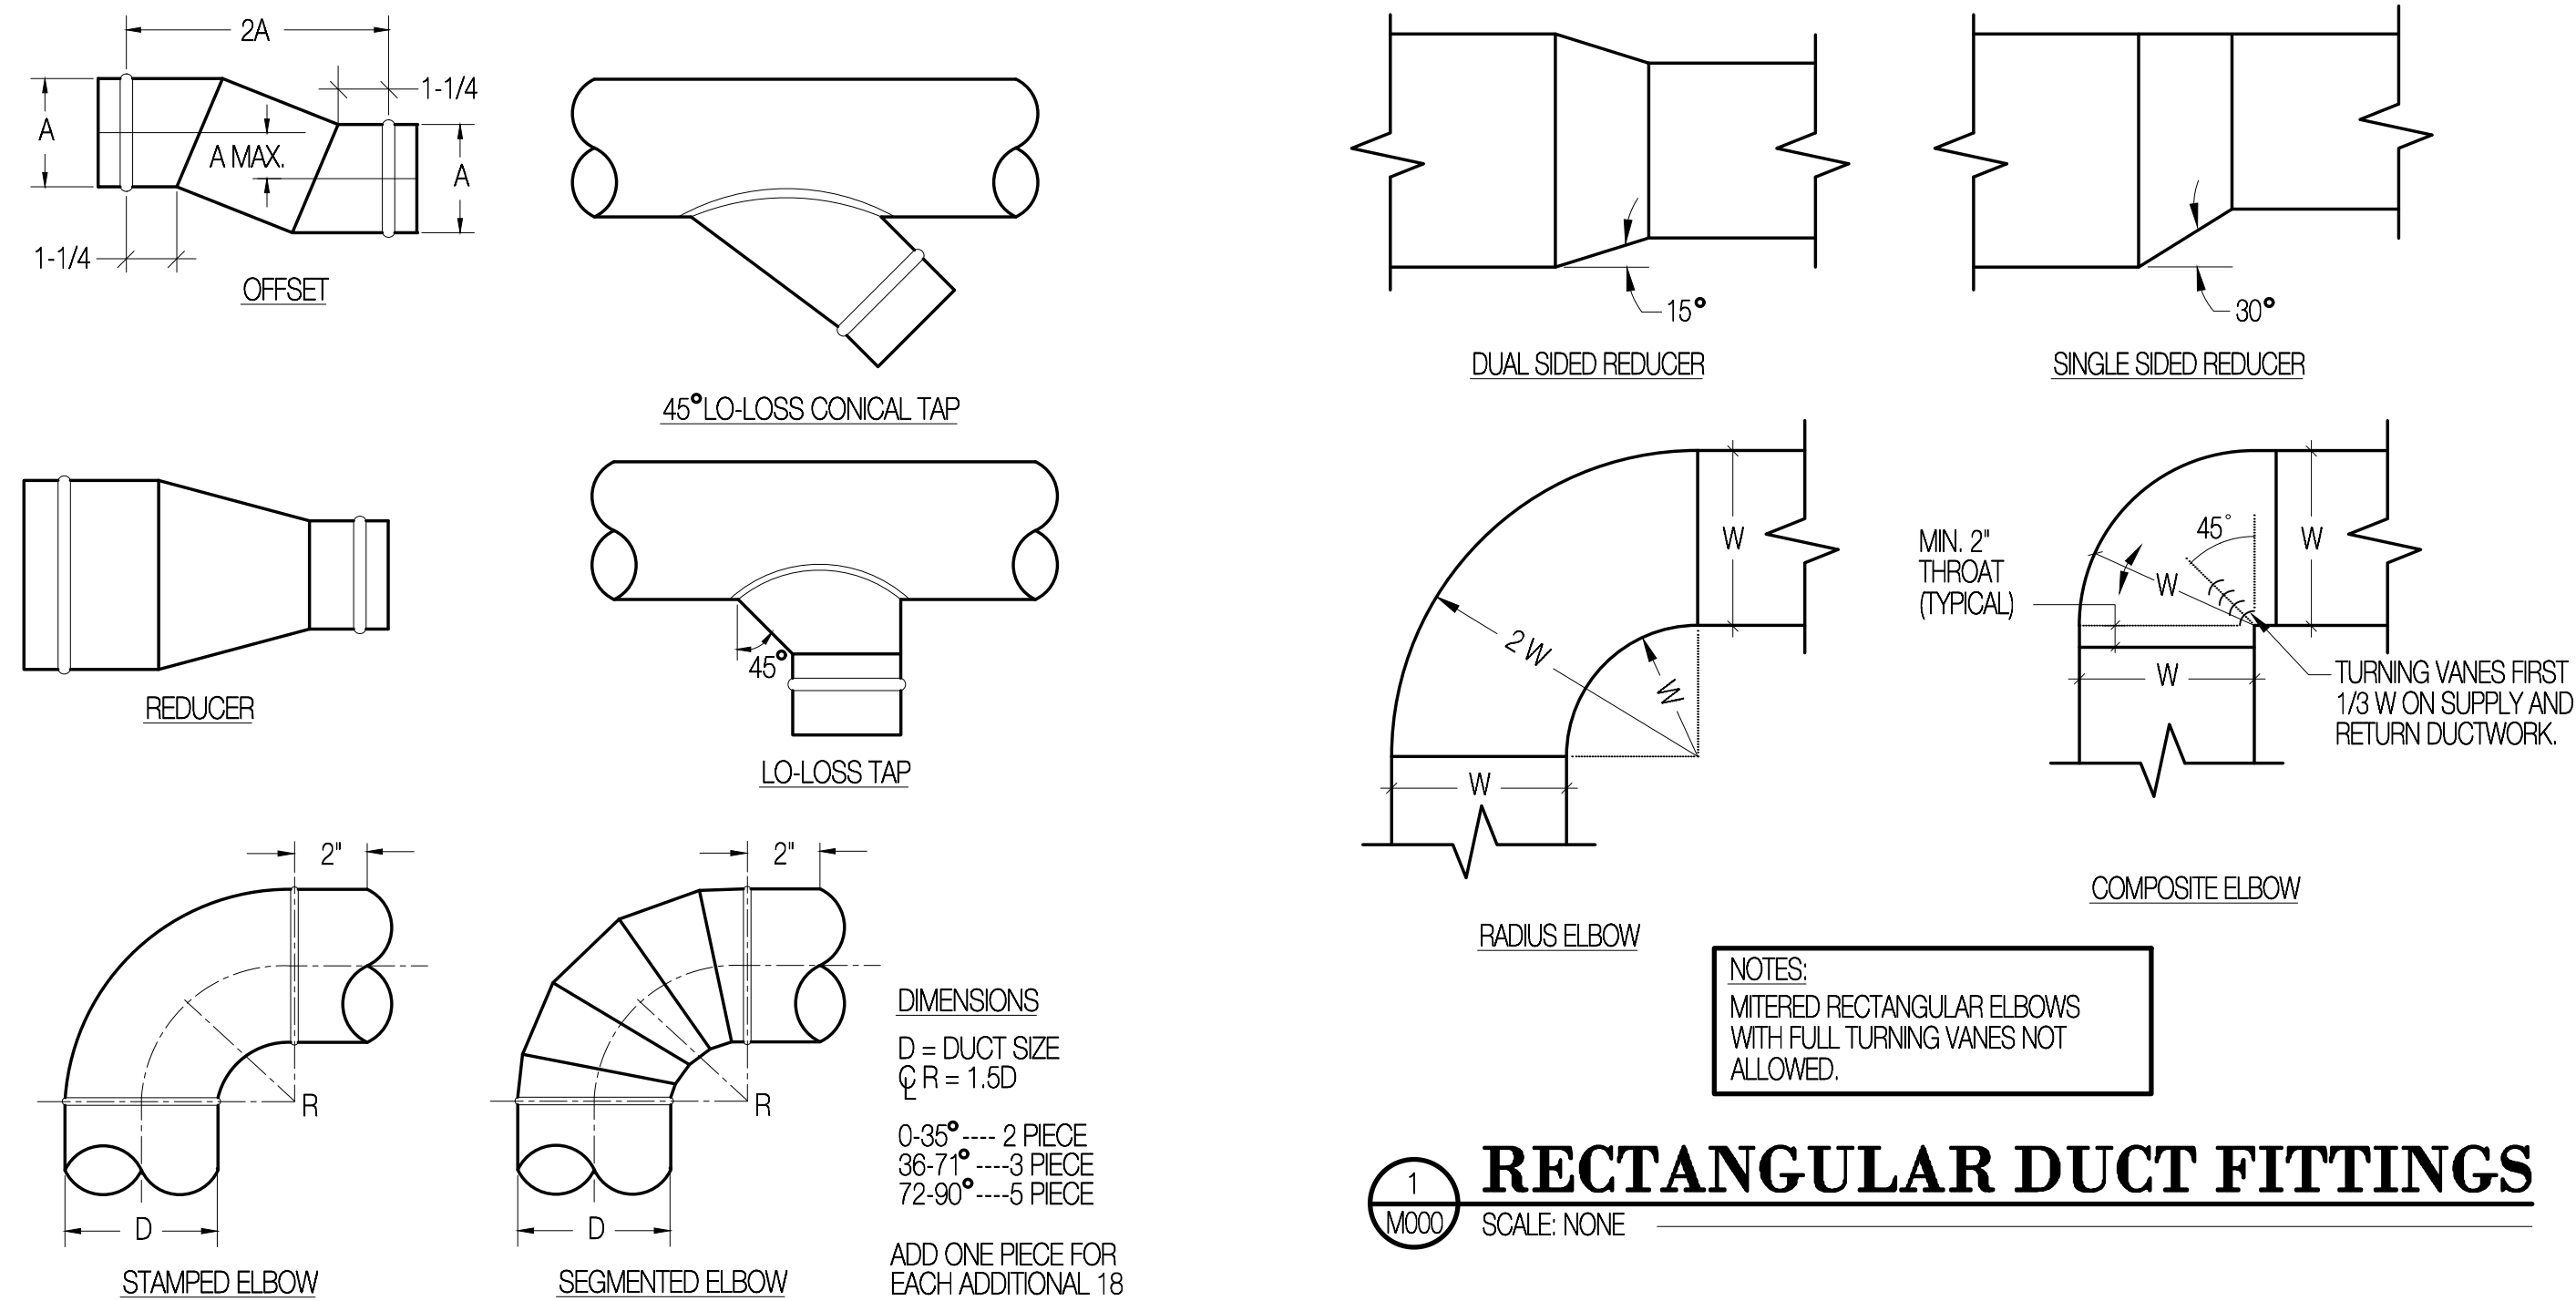

### SYMBOL LEGEND

☐	SUPPLY AIR DIFFUSER	⊖	THERMOSTAT	S.A.	SUPPLY AIR
☐	RETURN OR EXHAUST GRILLE	⊕	SENSOR	R.A.	RETURN AIR
▬	ACOUSTICALLY LINED DUCTWORK (INSIDE CLEAR DIMENSION)	→	SUPPLY AIR DIRECTION	NK	NECK
▬	SLOPE	←	RETURN AIR DIRECTION	⌒	ELBOW IN PIPE
▬	SLOPE IN DUCT. SEE SECTIONS FOR SLOPE DIRECTION	⌒	ABOVE FINISHED FLOOR	⌒	TEE IN PIPE
▬	RECTANGULAR SUPPLY AIR DUCT CROSS SECTION	A.F.F.	HIGH EFFICIENCY TAKEOFF	⌒	DROP IN PIPE
⊖	ROUND SUPPLY AIR DUCT CROSS SECTION	HET	ACOUSTICAL LINING	⌒	RISE IN PIPE
⊖	HAND DAMPER, SEE DETAIL 2/M-100	A.L.	OUTSIDE AIR	⌒	HAND DAMPER WITH REMOTE ACTUATOR, SEE DETAIL 5/M-400
⊖	RISE OR DROP IN DUCT	O.A.			

### FURNACES (F)

SYMBOL	INPUT HIGH / LOW (BTUH)	OUTPUT HIGH / LOW (BTUH) ①	MINIMUM DAT °F	MIN. CFM ①	MIN. E.S.P. IN. WG.	FAN SPEED	ELECTRICAL REQUIREMENTS					YORK MODEL (OR EQUAL)	REMARKS	
							VOLTS	PH.	HZ.	HP.	MCA			MOCP
F-1	100,000 / 65,000	96,000 / 62,000	95°F	1,750	0.65"	HIGH	120	1	60	1	14.1	20	TM9V100C20MP12C	5.0 TON COOLING CAPACITY
F-2	40,000 / 26,000	38,000 / 25,000	95°F	760	0.45"	HIGH	120	1	60	1/2	9.6	15	TM9V040A10MP12C	2.5 TON COOLING CAPACITY
F-3	40,000 / 26,000	38,000 / 25,000	95°F	730	0.45"	HIGH	120	1	60	1/2	9.6	15	TM9V040A10MP12C	2.5 TON COOLING CAPACITY

① CAPACITIES AT JOB SITE ELEVATION OF 4,600 FEET ABOVE SEA LEVEL.

### DX COOLING COILS (CC)

SYMBOL	TOTAL CAPACITY (BTUH) ①	SENSIBLE CAPACITY (BTUH) ①	LATENT CAPACITY (BTUH) ①	MINIMUM CFM	COIL E.A.T. DB°F / WB°F	MINIMUM AREA (SQ. FT.)	MAXIMUM ΔP IN. WG. ②	UNIT SERVED	REFRIG. TYPE	YORK MODEL (OR EQUAL)	REMARKS
CC-2	21,200	20,200	1,000	760	80°F / 62°F	3.7	0.17	F-2	R-410	XAFB24	NOMINAL 2.0 TON COIL
CC-3	21,200	20,200	1,000	730	80°F / 62°F	3.7	0.17	F-3	R-410	XAFB24	NOMINAL 2.0 TON COIL

① CAPACITIES AT JOB SITE ELEVATION.  
② WET COIL.

### AIR COOLED CONDENSING UNITS (CU)

SYMBOL	TOTAL CAPACITY (BTUH)	SENSIBLE CAPACITY (BTUH)	COND. COIL AREA	COND. COIL CFM	AMBIENT AIR TEMP. (F°)	ELECTRICAL REQUIREMENTS					UNIT SERVED	MIN. EFF. (SEER2)	REFRIG. TYPE	YORK MODEL (OR EQUAL)	REMARKS
						VOLTS	PH.	HZ.	MCA	MOCP					
CU-1	52,100	51,000	25.28	4,275	95°F	230	1	60	34.0	50	CC-1	15.2	R-410	YC2F60	NOMINAL 5.0 TON CONDENSING UNIT
CU-2	21,200	21,200	12.21	2,575	95°F	230	1	60	16.5	20	CC-2	15.2	R-410	YC2F24	NOM. 2.0 TON CONDENSING UNIT
CU-3	21,200	21,200	12.21	2,575	95°F	230	1	60	16.5	20	CC-3	15.2	R-410	YC2F24	NOM. 2.0 TON CONDENSING UNIT

① CAPACITIES AT JOB SITE ELEVATION.

### CEILING EXHAUST FANS (CEF)

SYMBOL	MINIMUM CFM	TOTAL STATIC PRESSURE IN. WG.	ELECTRICAL REQUIREMENTS				SERVICE	BROAN MODEL	REMARKS
			VOLTS	PH.	HZ.	WATTS			
CEF-1	80	0.375"	120	1	60	87	MEN 102	L100MG	-
CEF-2	80	0.375"	120	1	60	87	WOMEN 103	L100MG	-
CEF-3	80	0.375"	120	1	60	87	MEN 203	L100MG	-
CEF-4	80	0.375"	120	1	60	87	WOMEN 204	L100MG	-

① CAPACITIES AT JOB SITE ELEVATION.

### BASEBOARD RADIATION (BR)

SYMBOL	TYPE	LENGTH	ELECTRICAL REQUIREMENTS				INDECO MODEL	SERVICE	REMARKS
			VOLTS	PH.	HZ.	WATTS			
BR-1	ELEC.	39'	120	1	60	600	904U0800B	ENTRY 101	①

① PROVIDE WITH TAMPER PROOF THERMOSTAT AND BUILT IN DISCONNECT SWITCH.

### GRILLES AND DIFFUSERS

SYMBOL	CFM	NECK SIZE	FACE SIZE	KRUEGER MODEL	REMARKS
S-1	AS NOTED	AS NOTED	AS NOTED	1400	-
S-2	AS NOTED	AS NOTED	AS NOTED	SH	BEVELED DROP FACE / SURFACE MOUNT
S-3	AS NOTED	AS NOTED	AS NOTED	1900	-
R-1	AS NOTED	AS NOTED	AS NOTED	6490	-
R-2	AS NOTED	AS NOTED	AS NOTED	S85H	-

### LOUVERS (L)

SYMBOL	NOMINAL SIZE (W' x H')	MIN. FREE FACE AREA (SQ. FT.)	SERVICE	RUSKIN MODEL (OR EQUAL)	REMARKS
L-1	14" x 14"	0.78	OUTSIDE AIR	ELF-6375DX	PROVIDE WITH MATTE BLACK FINISH TO MATCH BUILDING FINISHES.

### CONTROL DAMPERS (CD)

SYMBOL	APPROX. SIZE	TYPE	RUSKIN MODEL	SERVICE	REMARKS
CD-1 THUR 3	8"	QUARTER TURN	CDR-25	FURNACE F-1 THRU 3 OUTSIDE AIR	WITH 24V ACTUATOR



Consultant

**JONES & ASSOCIATES**  
 CONSULTING ENGINEERS  
 6080 S FASHION POINT DRIVE  
 SOUTH OGDEN, UT 84405

Project Name

Issued No.	Date	Description

Revision No.	Date	Description
2	02.01.24	PLAN REVIEW/REDESIGN

SAA Project No. 2022-03  
Drawing Title

MECHANICAL SYM. LEGEND, SCHEDULES, AND DETAILS

Sheet Number


M-000

**DRAWING NOTES**

- 1 [S-3] 135 CFM, 2 @ 1/2" WIDE SLOT x 1'-6" LONG LINEAR DIFFUSER. PROVIDE DIFFUSER WITH 18"x6" ACOUSTICALLY LINED PLENUM WITH END TRANSITION TO FIT DIFFUSER NECK SIZE.
- 2 FLEXIBLE CONNECTION, TYPICAL.
- 3 [S-2] 90 CFM, 6" NK. S.A. DIFFUSER.
- 4 [S-2] 135 CFM, 8" NK. S.A. DIFFUSER.
- 5 [S-3] 200 CFM, 8" NK. S.A. DIFFUSER.
- 6 [S-1] 200 CFM, 8" NK. S.A. DIFFUSER.
- 7 [S-1] 145 CFM, 8" NK. S.A. DIFFUSER.
- 8 [R-1] 10"x22" NK. R.A. GRILLE WITH ACOUSTICALLY LINED PLENUM
- 9 [R-2] 10"x10" NK. R.A. GRILLE.
- 10 HIGH EFFICIENCY TAKEOFF, TYPICAL.
- 11 24"x12" RETURN AIR DUCT RISE TO SECOND FLOOR, SEE SECOND LEVEL HVAC PLAN THIS SHEET FOR CONTINUATION.
- 12 24"x12" SUPPLY AIR DUCT RISE TO SECOND FLOOR, SEE SECOND LEVEL HVAC PLAN THIS SHEET FOR CONTINUATION.
- 13 EXTEND 10"x8" RETURN DUCT OVER 24"x12" MAIN AND CUT 8"x12" HOLE IN BOTTOM OF TOP DUCT AND TOP OF BOTTOM DUCT. SECURE DUCTS TOGETHER AND SEAL AIR TIGHT.
- 14 PIPE SLEEVE AT REFRIGERATION PENETRATION AT WALL, SEE DETAIL 2/M-000.
- 15 EXTERIOR REFRIGERATION PIPE SUPPORT, SEE DETAIL 6/M-700.
- 16 REFRIGERATION PIPING FROM EXTERIOR CONDENSING UNITS TO INTERIOR COOLING COILS ON SECOND FLOOR. SEE SECOND FLOOR HVAC PLAN THIS SHEET FOR CONTINUATION.
- 17 PROVIDE AND INSTALL NEW BROAN MODEL 643 WALL CAP. PAINT WALL CAP WITH TWO COATS PRIMER AND TWO COATS PAINT, COLOR TO MATCH BUILDING EXTERIOR.
- 18 FIELD VERIFY EXACT SIZE AND LOCATION OF EXISTING SUPPLY AIR DUCTWORK AND CONNECT NEW TO EXISTING. SEAL ALL CONNECTIONS AIR TIGHT.
- 19 [S-2] 150 CFM, 8" NK. S.A. DIFFUSER.
- 20 3/8" LIQUID AND 3/4" SUCTION PIPING FROM EXTERIOR CONDENSING UNIT TO INTERIOR COOLING COIL.
- 21 3/8" LIQUID AND 1-1/8" SUCTION PIPING FROM EXTERIOR CONDENSING UNIT TO INTERIOR COOLING COIL.
- 22 REFRIGERATION PIPE SUPPORT, SEE DETAIL 2/M-700.
- 23 SEE LARGE SCALE MECHANICAL ROOM 206 PLAN SHEET M-400 FOR ADDITIONAL WORK IN THIS AREA.
- 24 PROVIDE AND INSTALL NEW WIRELESS TEMPERATURE SENSOR AT 48" A.F.F. SEE CONTROL DRAWINGS SHEET M-700 FOR ADDITIONAL INFORMATION.
- 25 PROVIDE AND INSTALL NEW THERMOSTAT, MOUNT THERMOSTAT AT 48" A.F.F. SEE CONTROL DRAWINGS FOR ADDITIONAL INFORMATION.

**EQUIPMENT NOTES**

- |                                |                                |
|--------------------------------|--------------------------------|
| 50 [CEF 1] CEILING EXHAUST FAN | 54 [CU 3] CONDENSING UNIT      |
| 51 [CEF 2] CEILING EXHAUST FAN | 55 [CEF 3] CEILING EXHAUST FAN |
| 52 [CU 1] CONDENSING UNIT      | 56 [CEF 4] CEILING EXHAUST FAN |
| 53 [CU 2] CONDENSING UNIT      | 57 [BR 1] BASEBOARD RADIATION  |

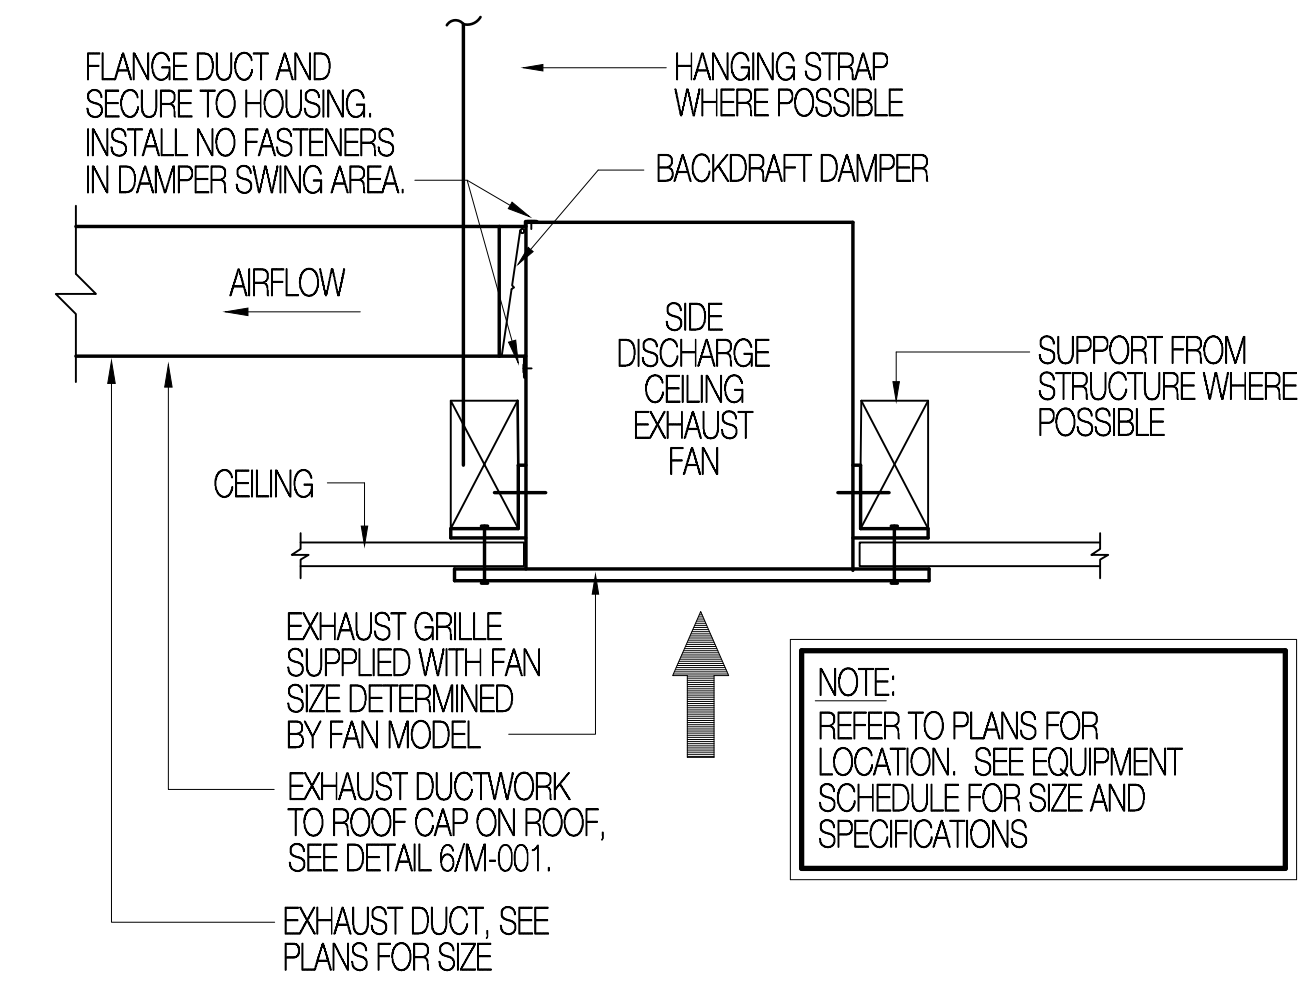

**1 CEILING EXHAUST FAN DETAIL**  
 SCALE: NONE

**JONES & ASSOCIATES**  
 CONSULTING ENGINEERS  
 6080 S FASHION POINT DRIVE  
 SOUTH OGDEN, UT 84405

Project Name

Issued No.	Date	Description

Revision


Revision No.	Date	Description
2	02.01.24	PLAN REVIEW/REDESIGN

SAA Project No. 2022-03  
 Drawing Title

MAIN FLOOR HVAC PLAN



Sheet Number

**M-100**

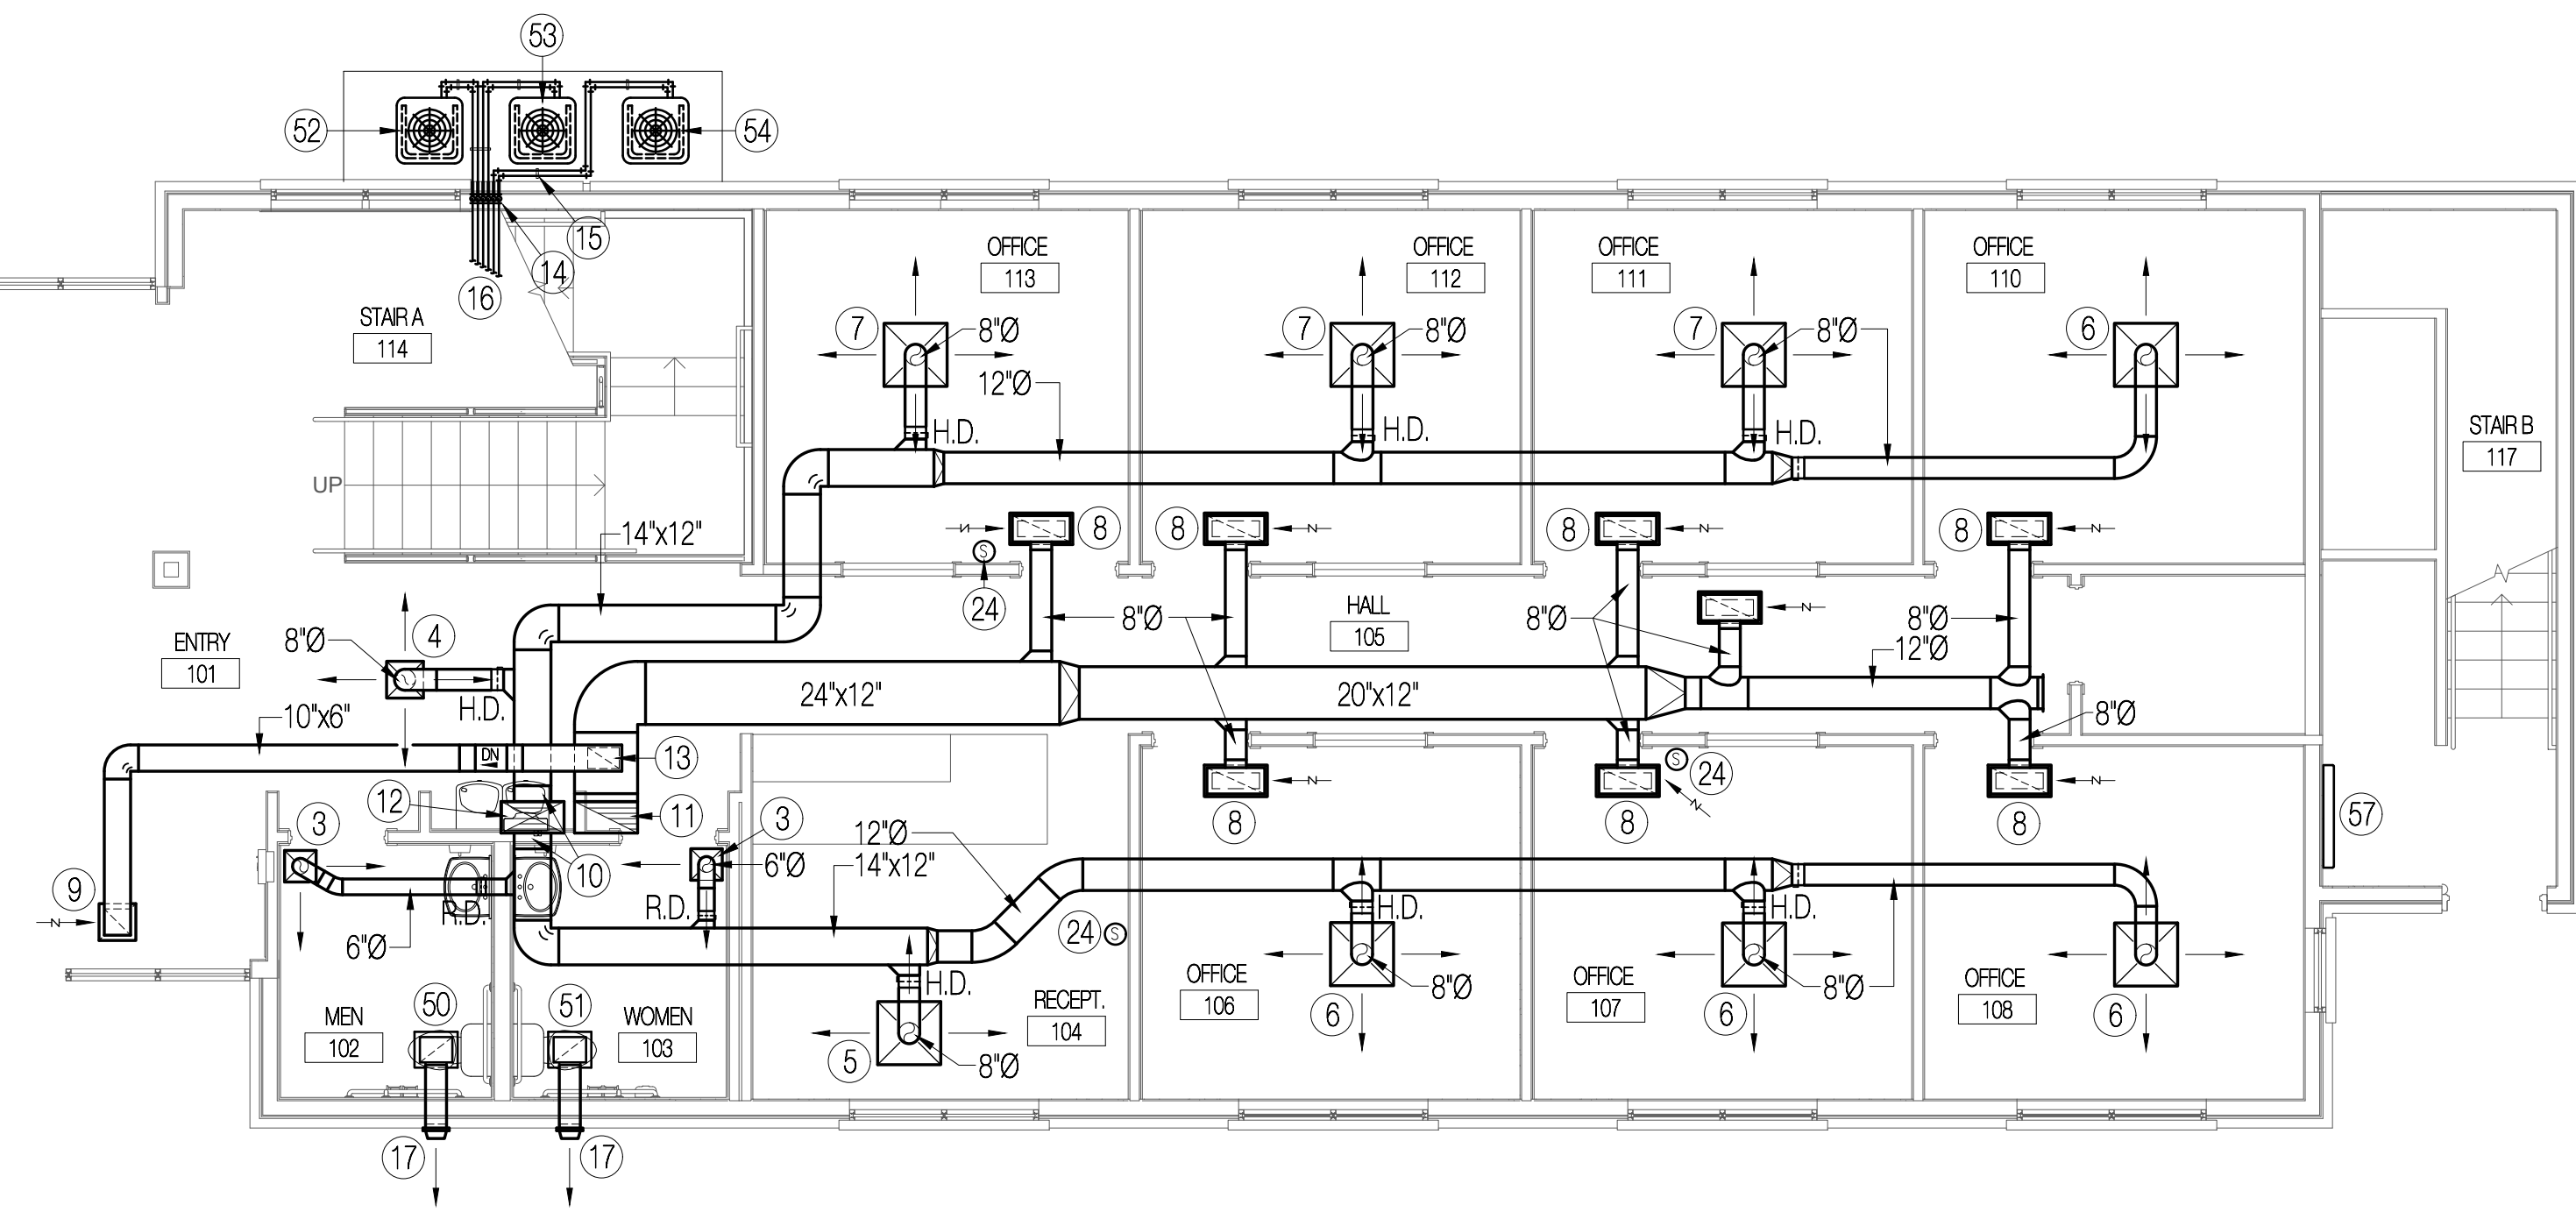



**LEVEL 1 HVAC REMODEL PLAN**

SCALE: 3/16" = 1'-0"

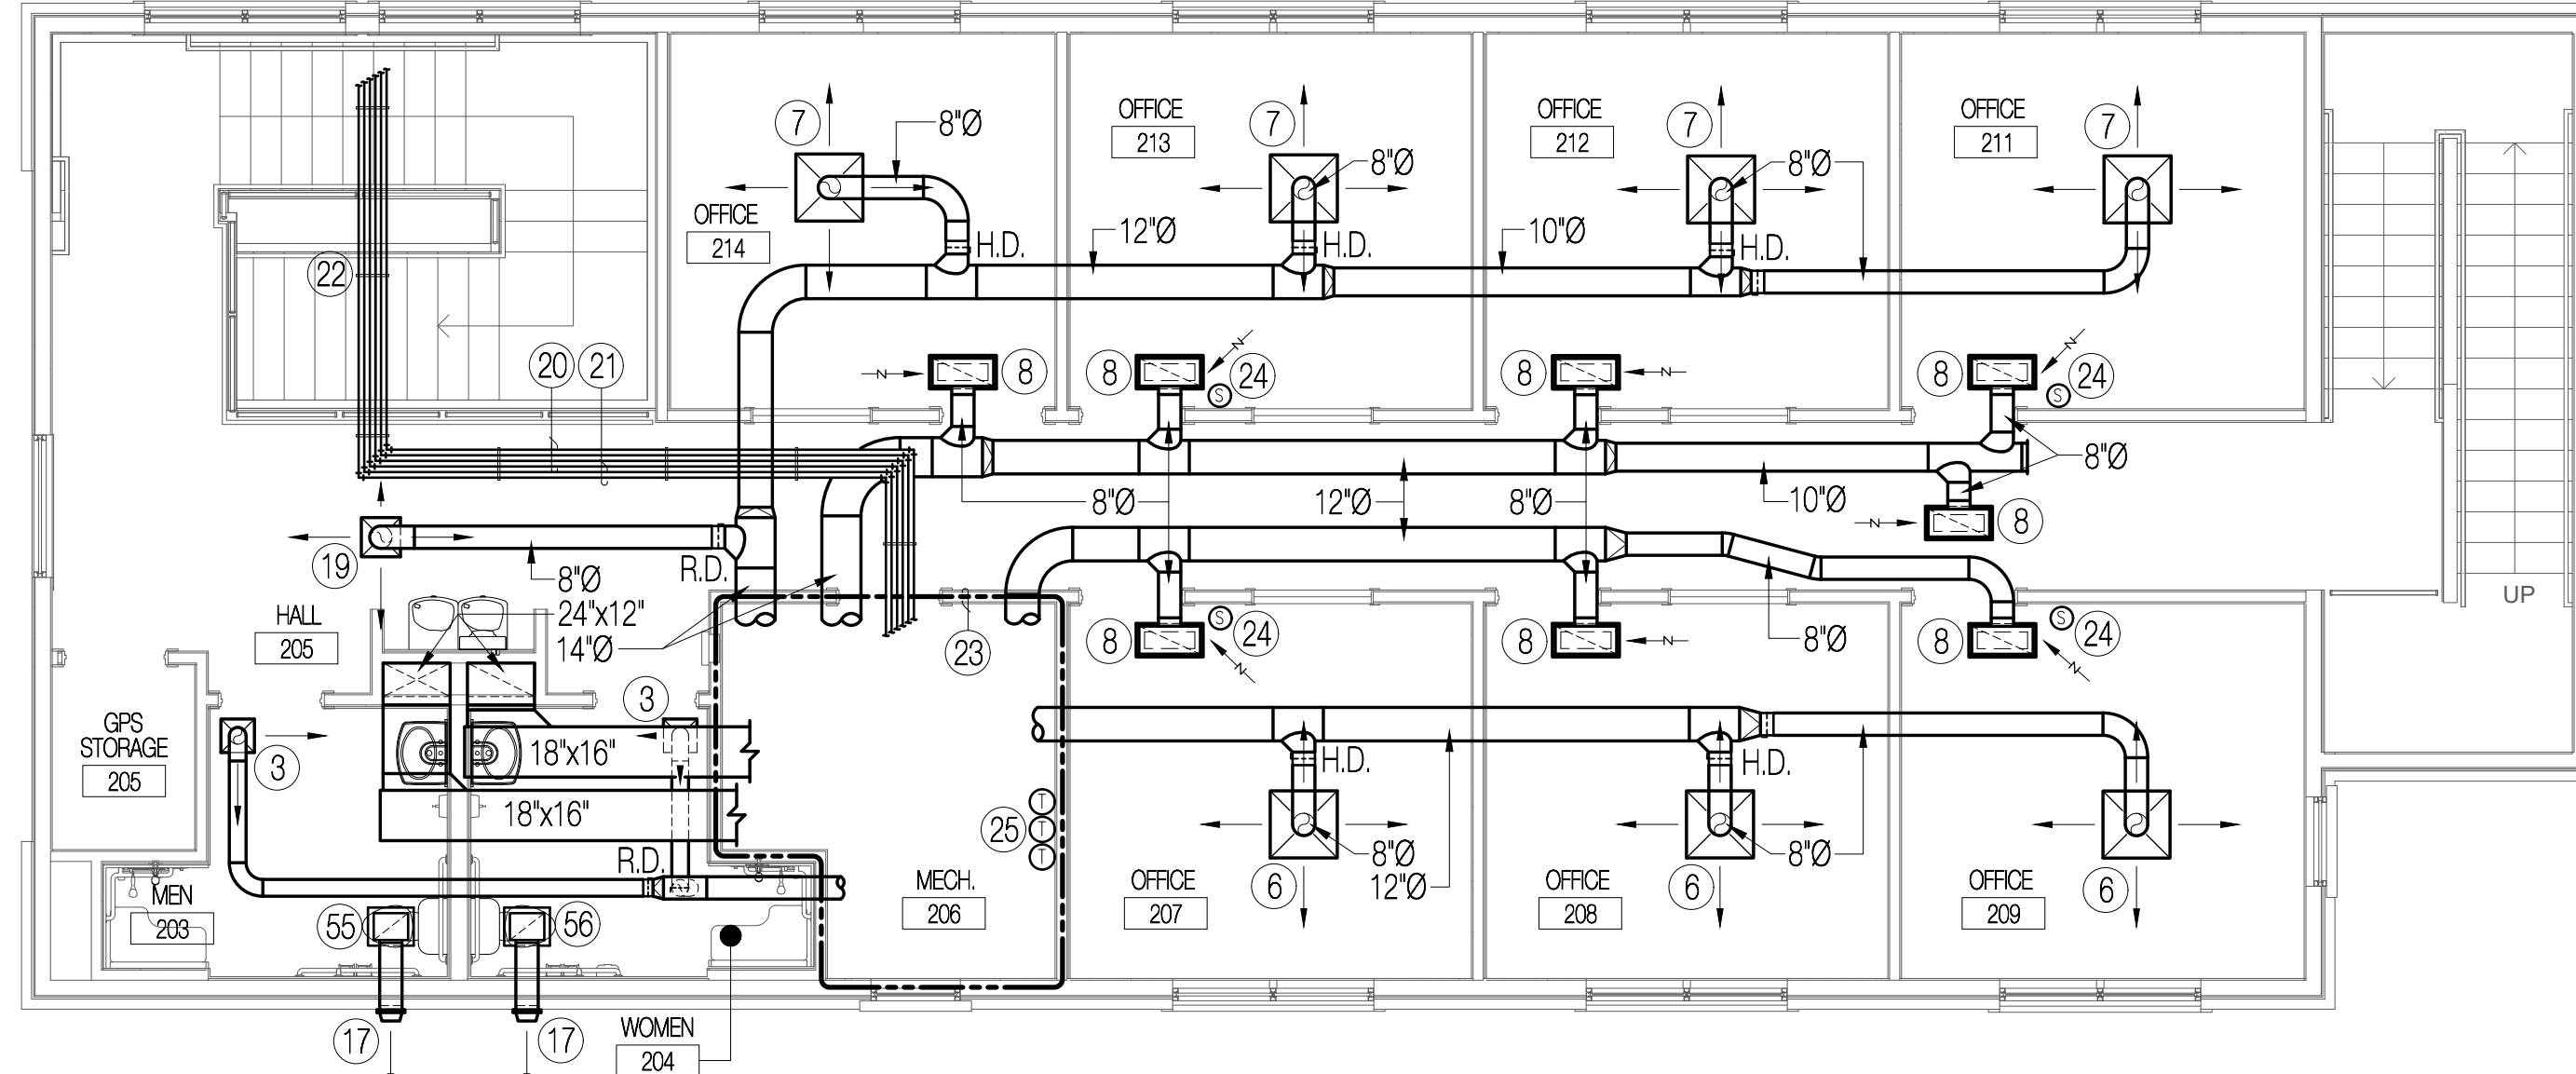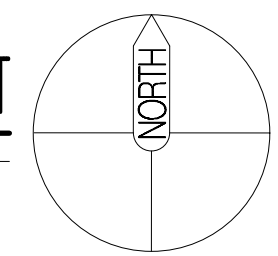

**LEVEL 2 HVAC PLAN**

SCALE: 3/16" = 1'-0"

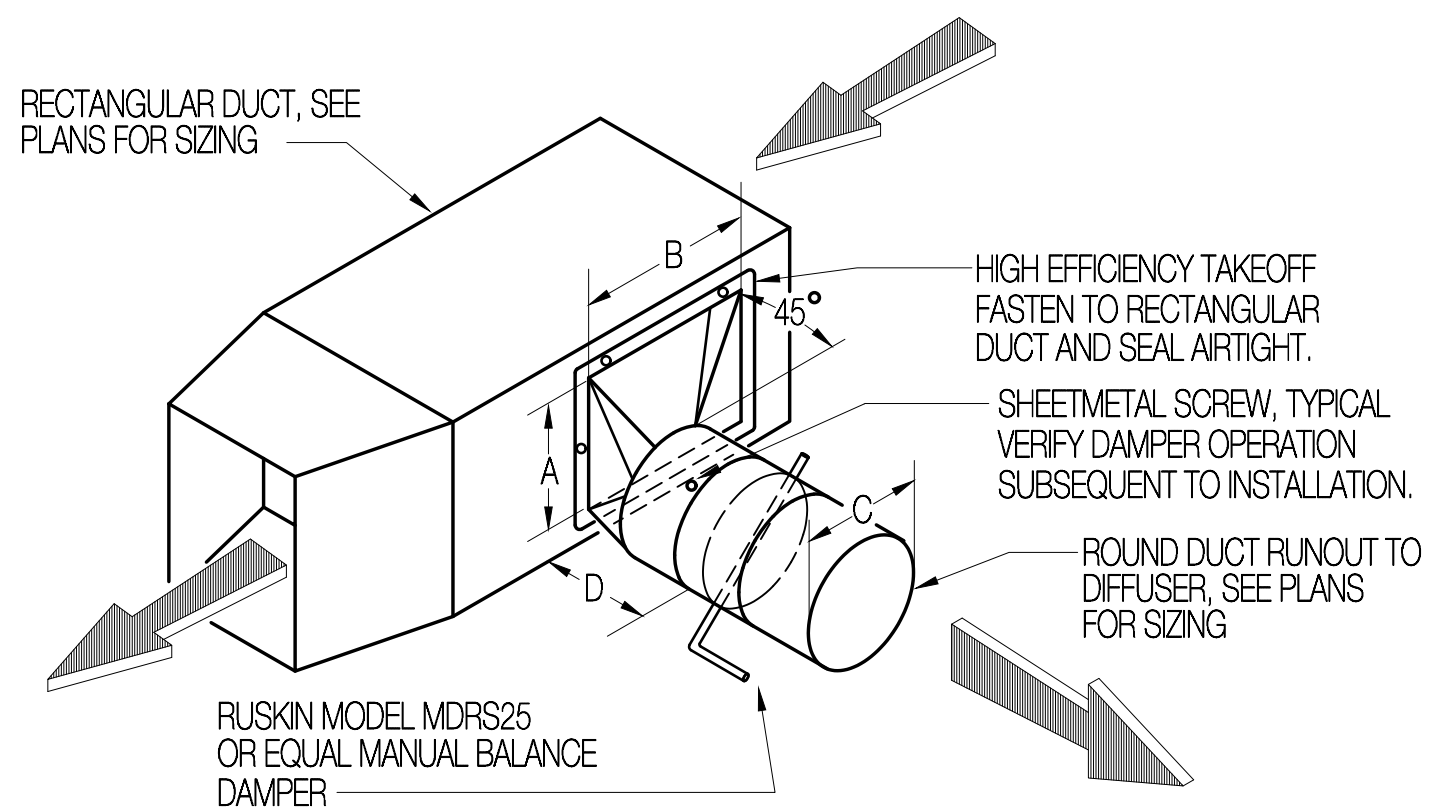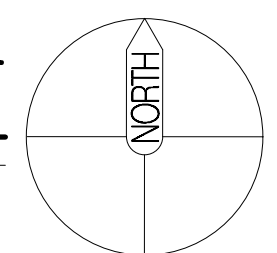


**HET DIMENSIONS**


BRANCH SIZE (C)	THROAT DIM.		MIN. AREA AxB
	A	B	
6"	8-1/4"	12"	3.5 X AREA OF C
8"	10-1/4"	14"	2.8 X AREA OF C
10"	12"	15"	2.3 X AREA OF C
12"	15"	18"	2.3 X AREA OF C

LENGTH D SHALL BE A MINIMUM OF 11"

**2 ROUND DUCT RUNOUT DETAIL**  
 SCALE: NONE

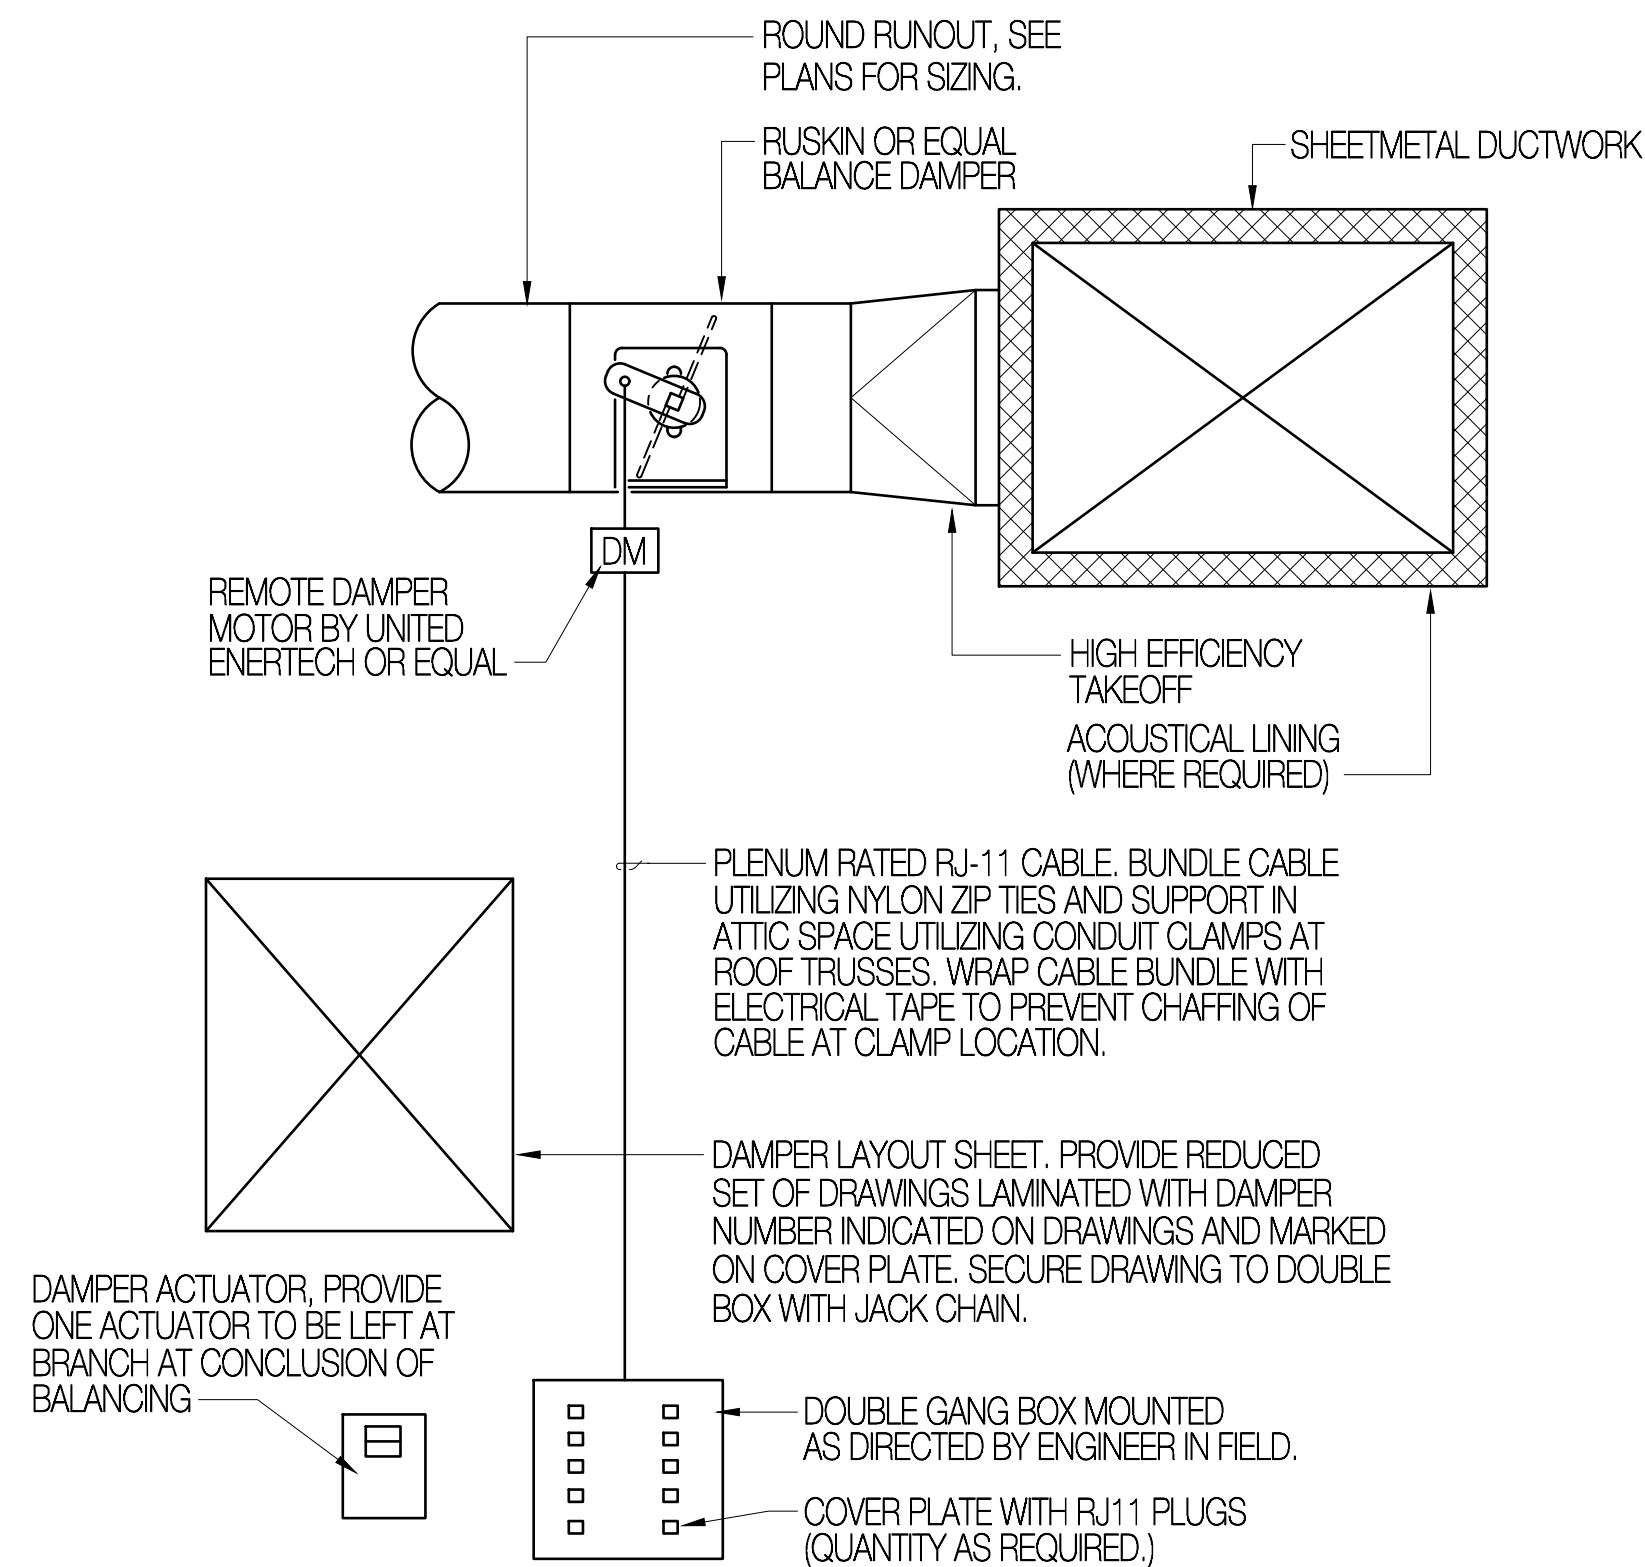


**5 REMOTE DAMPER CONTROLLER DETAIL**  
SCALE: NONE

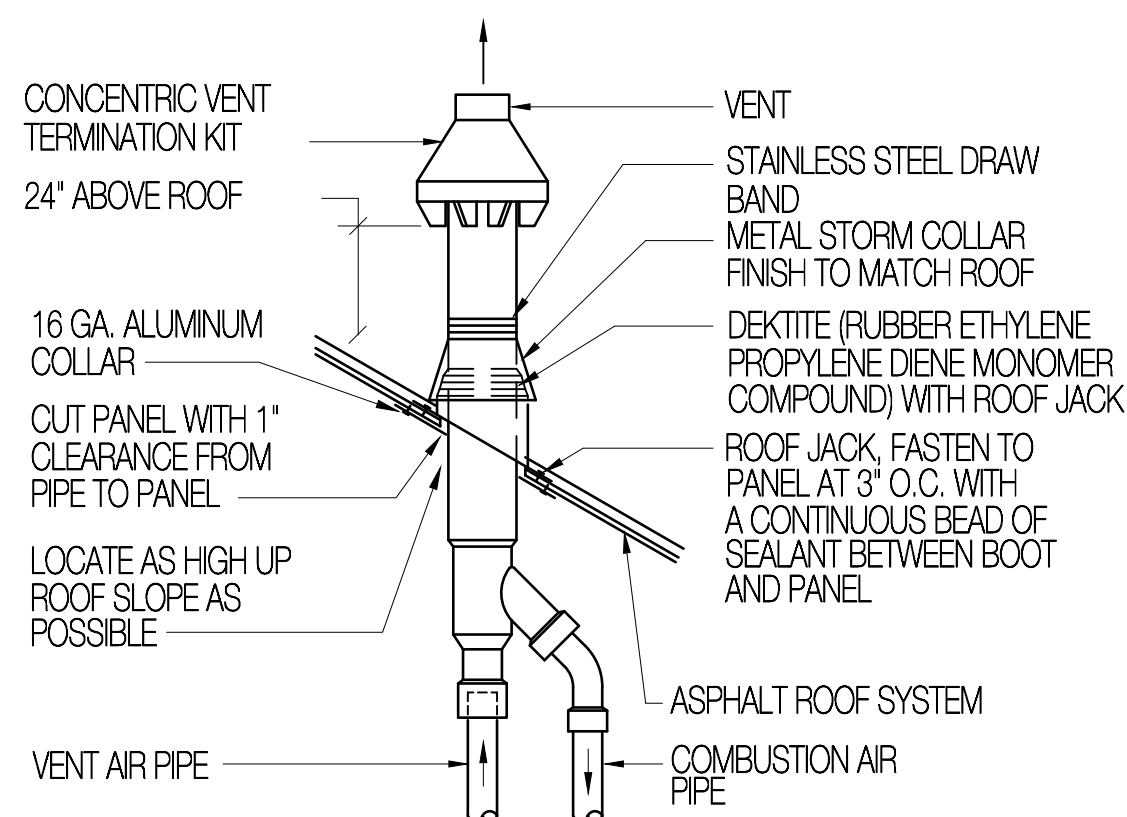


ALL VENT ASSEMBLIES TO BE EXTENDED OUT THE ROOF ON THE NORTH SIDE OF THE RIDGE. PAINT ALL VENT PIPING TO MATCH ROOF COLOR

**6 VENT ASSEMBLY KIT DETAIL**  
SCALE: NONE

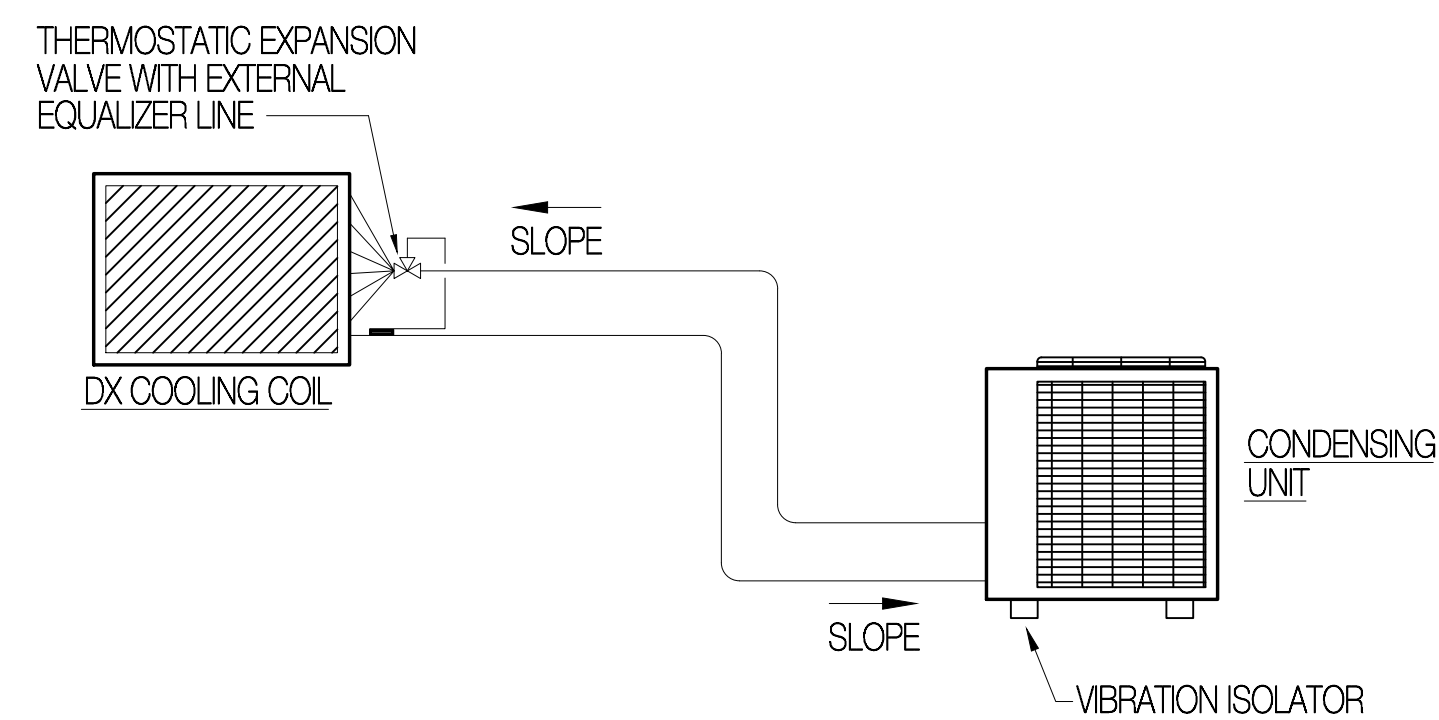

**7 REFRIG. PIPING SCHEMATIC**  
SCALE: NONE

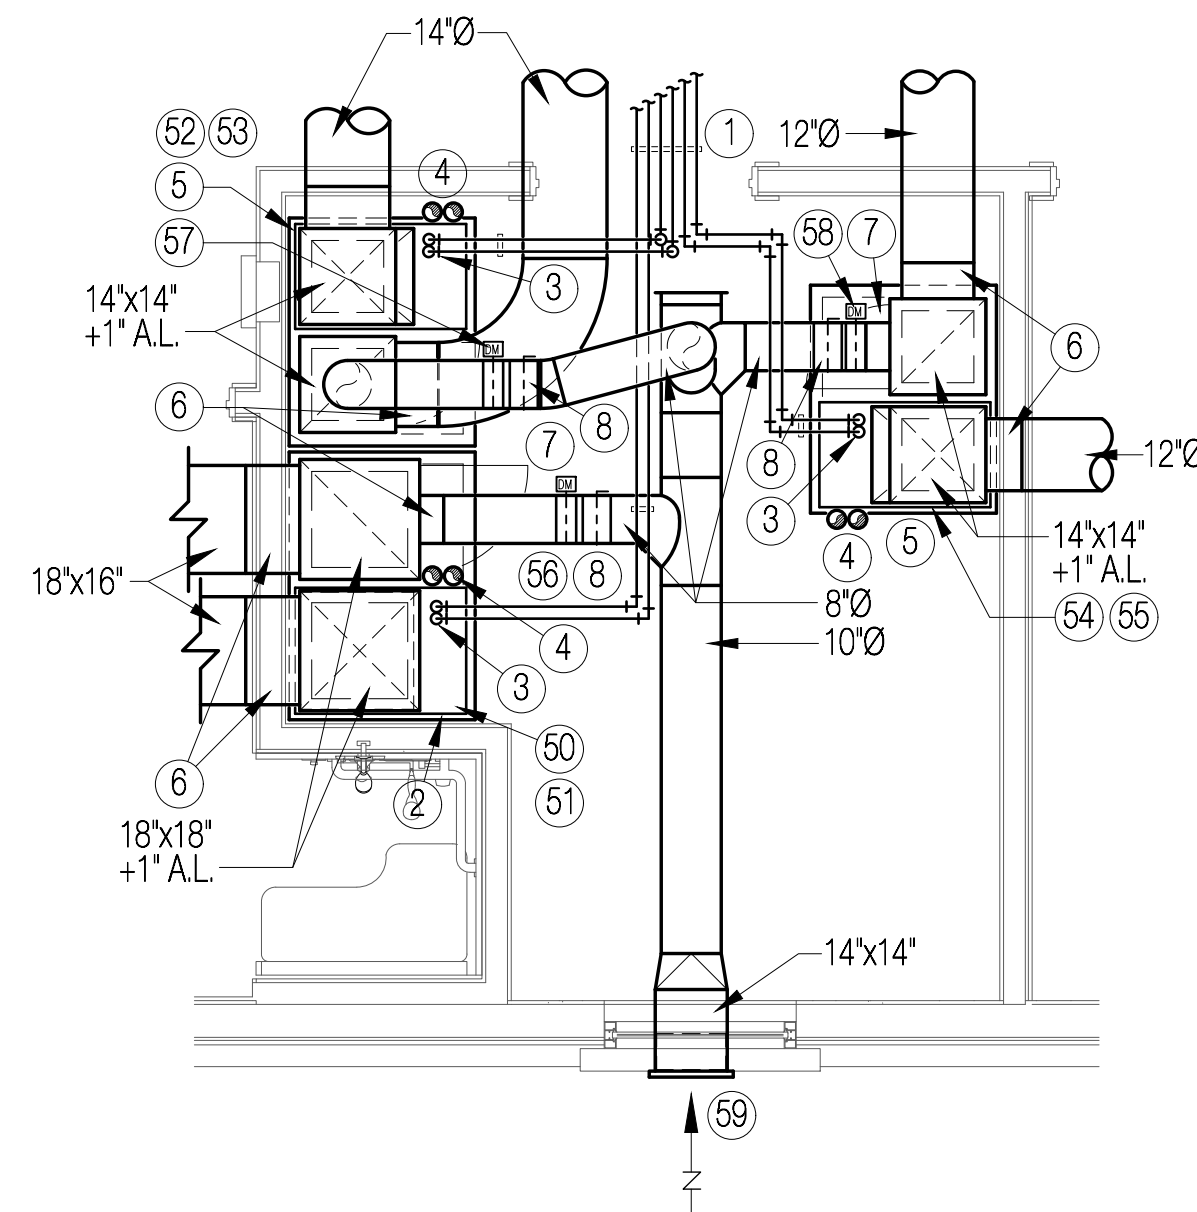


**LARGE SCALE MECH. RM. 206 PLAN**  
SCALE: 3/8" = 1'-0"

**DRAWING NOTES**

- REFRIGERATION PIPE SUPPORT, SEE DETAIL 6/M-102.
- 42"Wx30"Dx11"H +1" A.L. (FIELD VERIFY) RETURN AIR PLENUM BELOW FURNACE. PLENUM TO BE CONSTRUCTED WITH 1"x1"x1/8" BLACK ANGLE IRON FRAME COVERED WITH 22 GAUGE GALVANIZED SHEET METAL ALL AROUND. SHEET METAL TO BE SEALED AND FASTENED TO FRAME WITH POP RIVETS, TYPICAL ONE RIVET EVERY 6", SECURE FRAME TO FLOOR WITH 1/4" MASONRY ANCHORS AT 12" ON CENTER. SEAL PLENUM TO FLOOR AIRTIGHT.
- REFRIGERATION PIPING CONNECTION AT DX COOLING COIL, CONNECT PER DETAIL 5/M-700.
- 3"Ø VENT AND COMBUSTION AIR PIPING RISES TO CONCENTRIC VENT KIT ON ROOF, SEE DETAIL 6/M-400.
- 36"Wx30"Dx11"H +1" A.L. (FIELD VERIFY) RETURN AIR PLENUM BELOW FURNACE. PLENUM TO BE CONSTRUCTED WITH 1"x1"x1/8" BLACK ANGLE IRON FRAME COVERED WITH 22 GAUGE GALVANIZED SHEET METAL ALL AROUND. SHEET METAL TO BE SEALED AND FASTENED TO FRAME WITH POP RIVETS, TYPICAL ONE RIVET EVERY 6", SECURE FRAME TO FLOOR WITH 1/4" MASONRY ANCHORS AT 12" ON CENTER. SEAL PLENUM TO FLOOR AIRTIGHT.
- HIGH EFFICIENCY TAKEOFF, TYPICAL.
- FILTER HOLDING FRAME WITH ACCESS DOOR, SEE DETAIL 2/M-400 FOR ADDITIONAL INFORMATION.
- 8"Ø MANUAL OUTSIDE AIR DAMPER, BALANCE DAMPER TO 100 CFM.
- 8"Ø MANUAL OUTSIDE AIR DAMPER, BALANCE DAMPER TO 125 CFM.


**EQUIPMENT NOTES**

50	FURNACE	55	COOLING COIL
51	COOLING COIL	56	CONTROL DAMPER
52	FURNACE	57	CONTROL DAMPER
53	COOLING COIL	58	CONTROL DAMPER
54	FURNACE	59	LOUVER

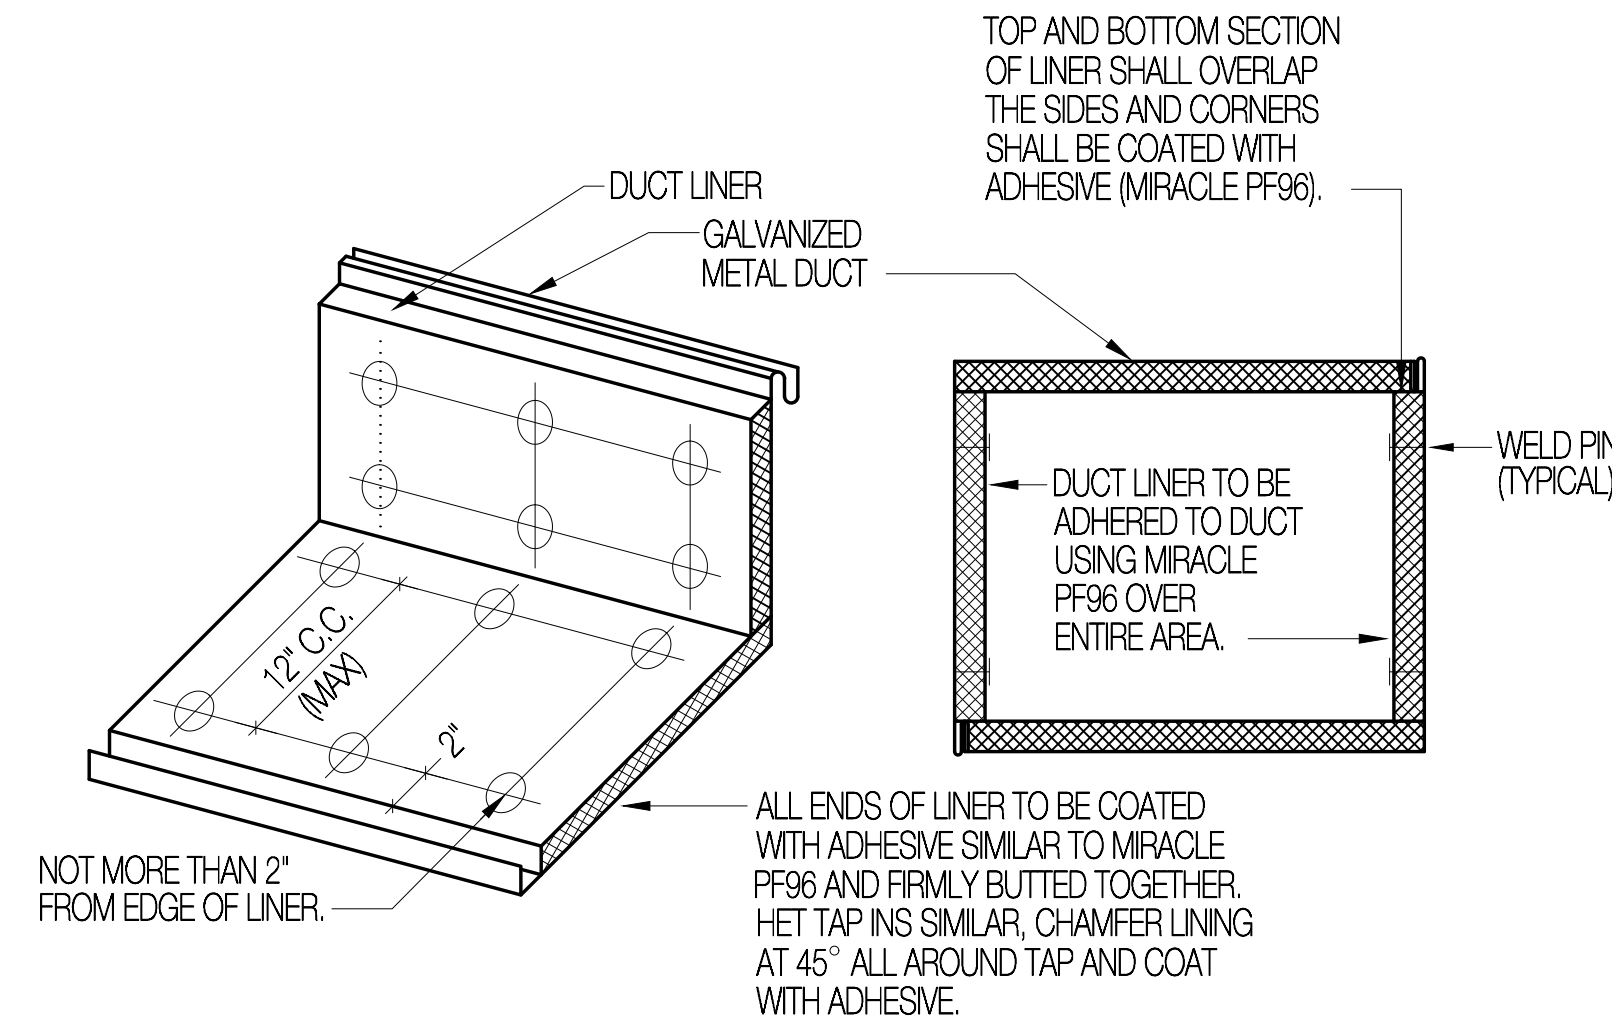


LINING FASTENERS:  
DURA DYNE MODEL CP WELD TYPE FASTENERS OR EQUIVALENT, ADHESIVE TYPE STICK CLIPS OR GRIP NAILS NOT ALLOWED.


**3 ACOUSTICAL LINER DETAIL**  
SCALE: NONE

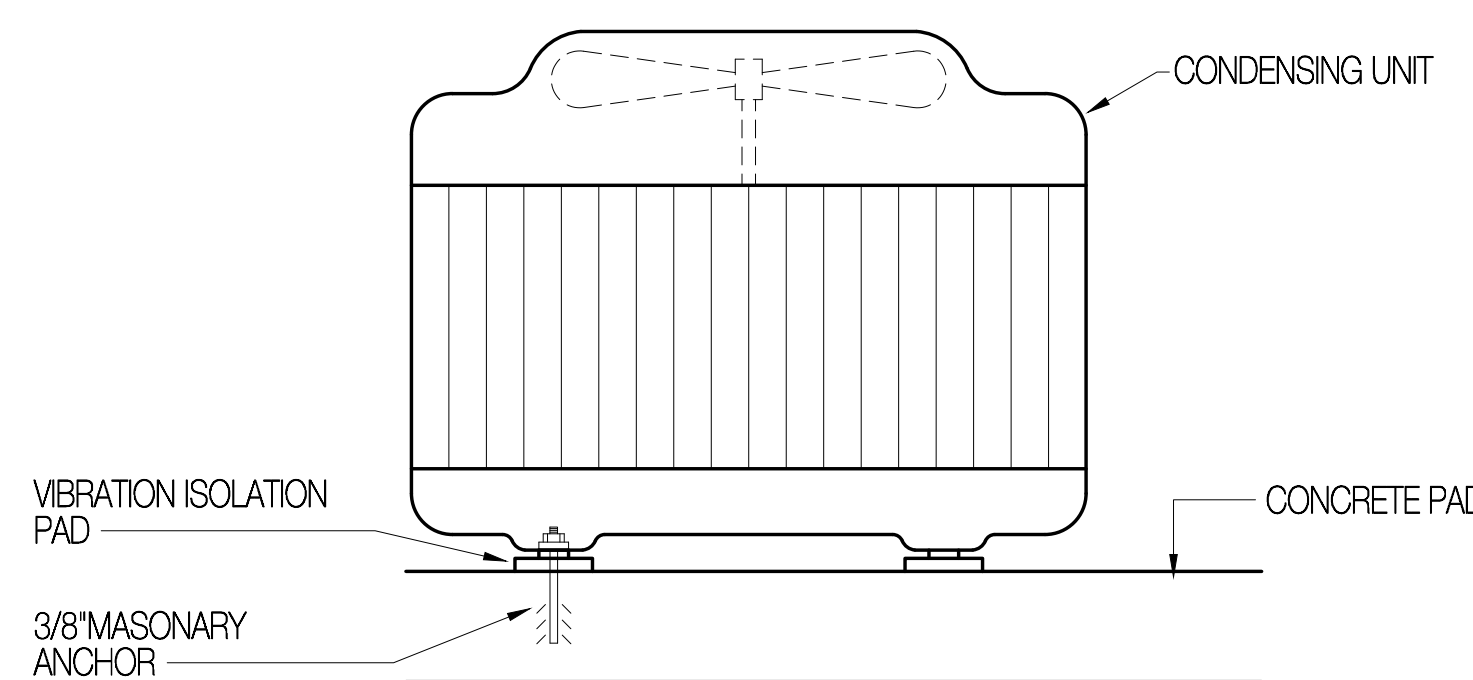

**4 CONDENSING UNIT MTG. DETAIL**  
SCALE: NONE

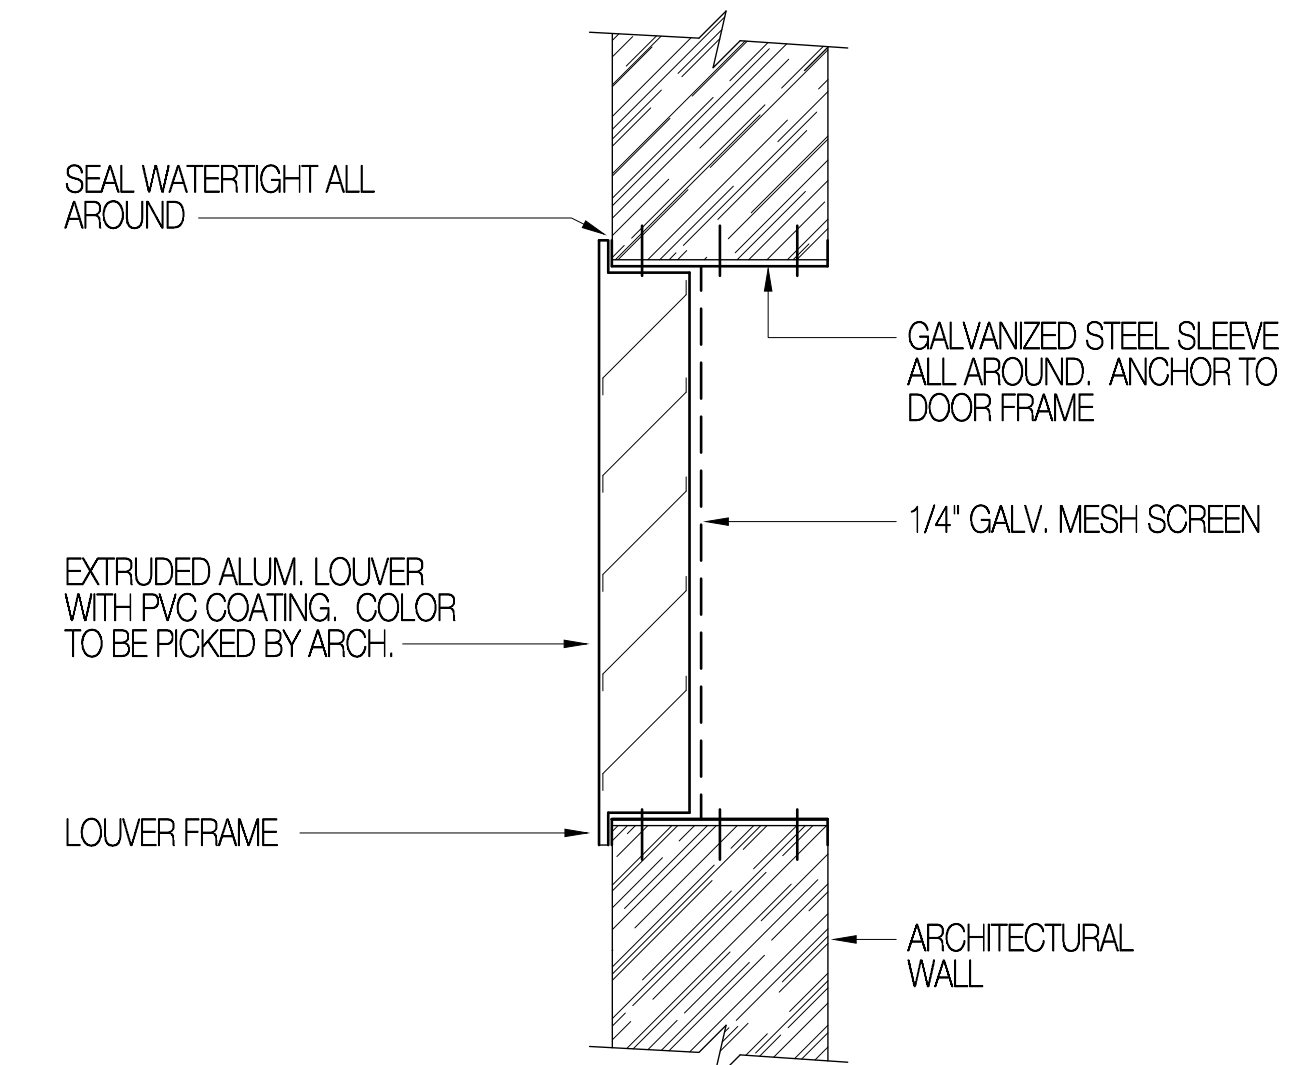



**1 LOUVER DETAIL**  
SCALE: NONE

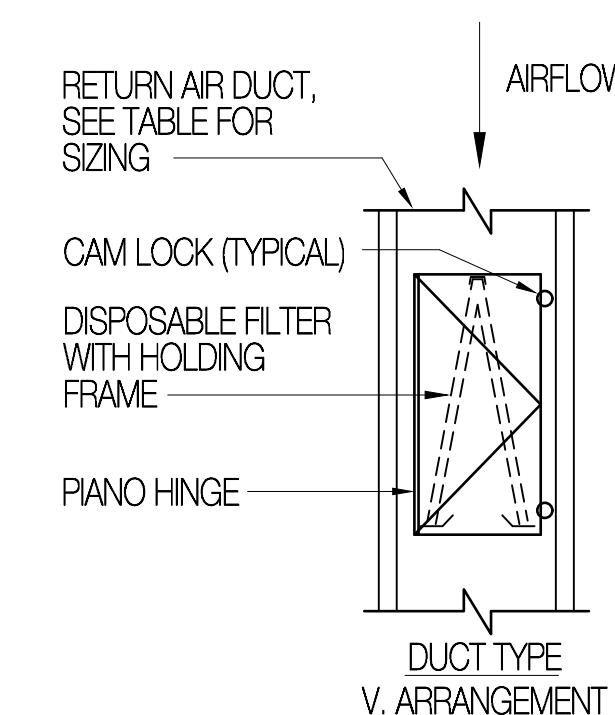

PROVIDE DOOR CLOSURE PIECES BETWEEN FILTER PLENUM AND FILTERS. FILTERS TO BE CENTERED ON FURNACE OPENINGS. FILTER VELOCITY SHALL NOT EXCEED 300 FPM.

FURNACE	CFM	DUCT SIZE	FILTER SIZE	ARRANGEMENT
F-1	1,750	18"x18"+1" A.L.	2-18"x24"	VEE
F-2	760	14"x14"+1" A.L.	2-14"x24"	VEE
F-3	730	14"x14"+1" A.L.	2-14"x24"	VEE

**2 RETURN AIR FILTER DETAIL**  
SCALE: NONE

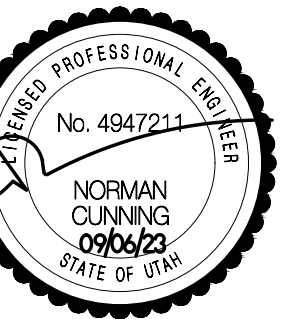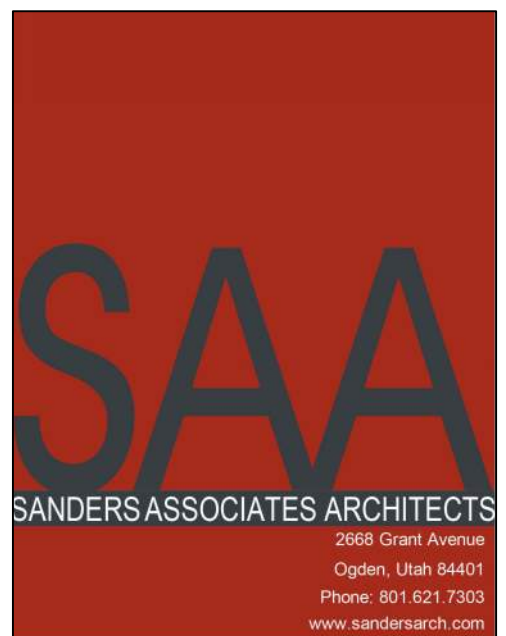

Consultant

**JONES & ASSOCIATES**  
CONSULTING ENGINEERS  
6080 S FASHION POINT DRIVE  
SOUTH OGDEN, UT 84405

Project Name

Issued	No.	Date	Description


Revision	No.	Date	Description
	2	02.01.24	PLAN REVIEW/REDESIGN

SAA Project No. 2022-03  
Drawing Title


LARGE SCALE MECH. PLANS AND DETAILS

Sheet Number


**M-400**

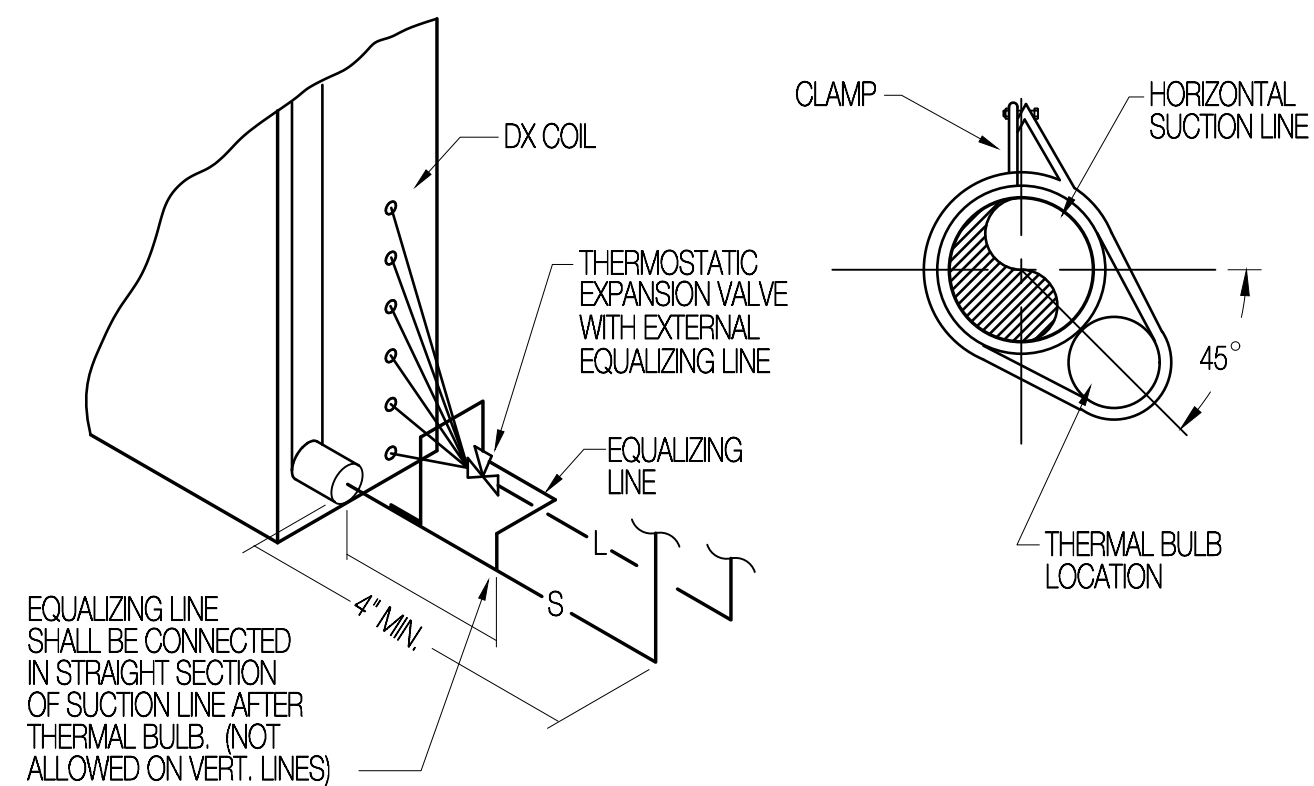


**5 DX COIL INSTALLATION DETAIL**  
SCALE: NONE

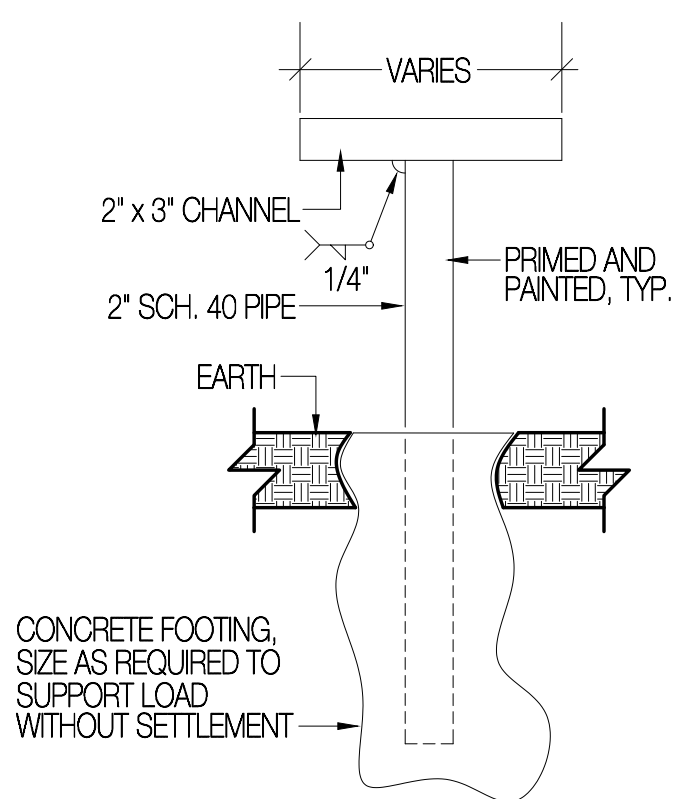


**6 EXTERIOR SUPPORT DETAIL**  
SCALE: NONE

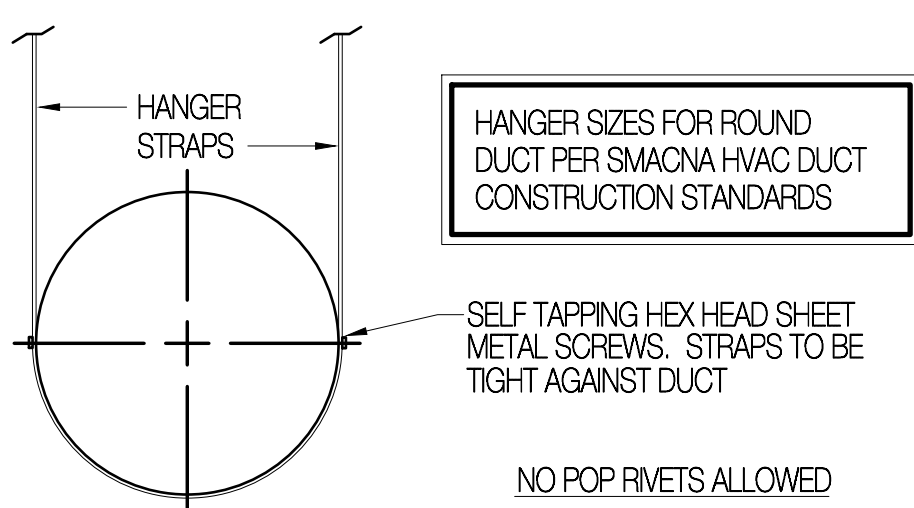


**7 RND. DUCT HANGER DETAIL**  
SCALE: NONE

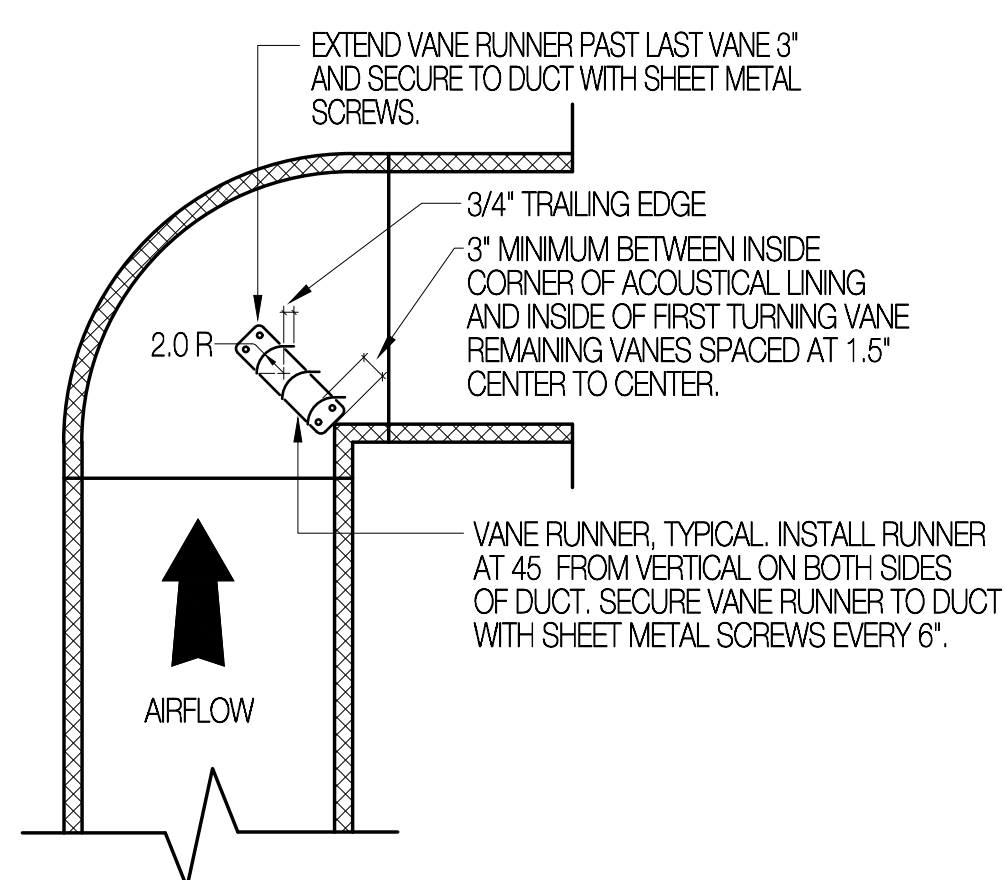


**8 TURNING VANE DETAIL**  
SCALE: NONE

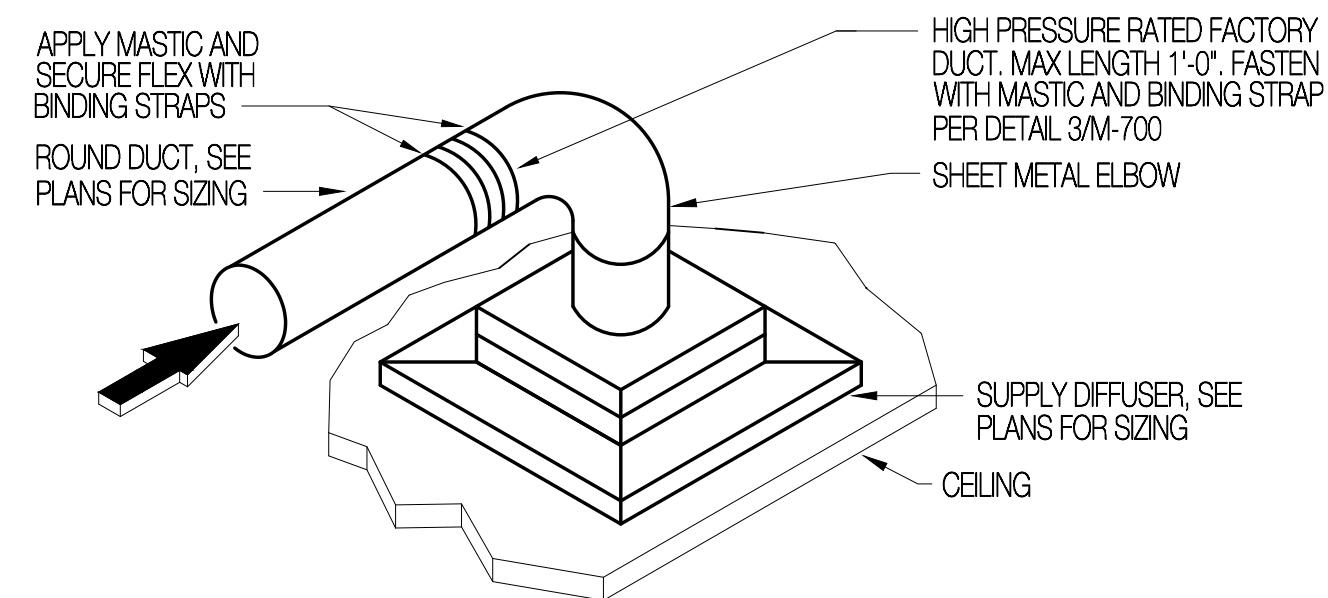


**1 DIFFUSER CONNECTION DETAIL**  
SCALE: NONE

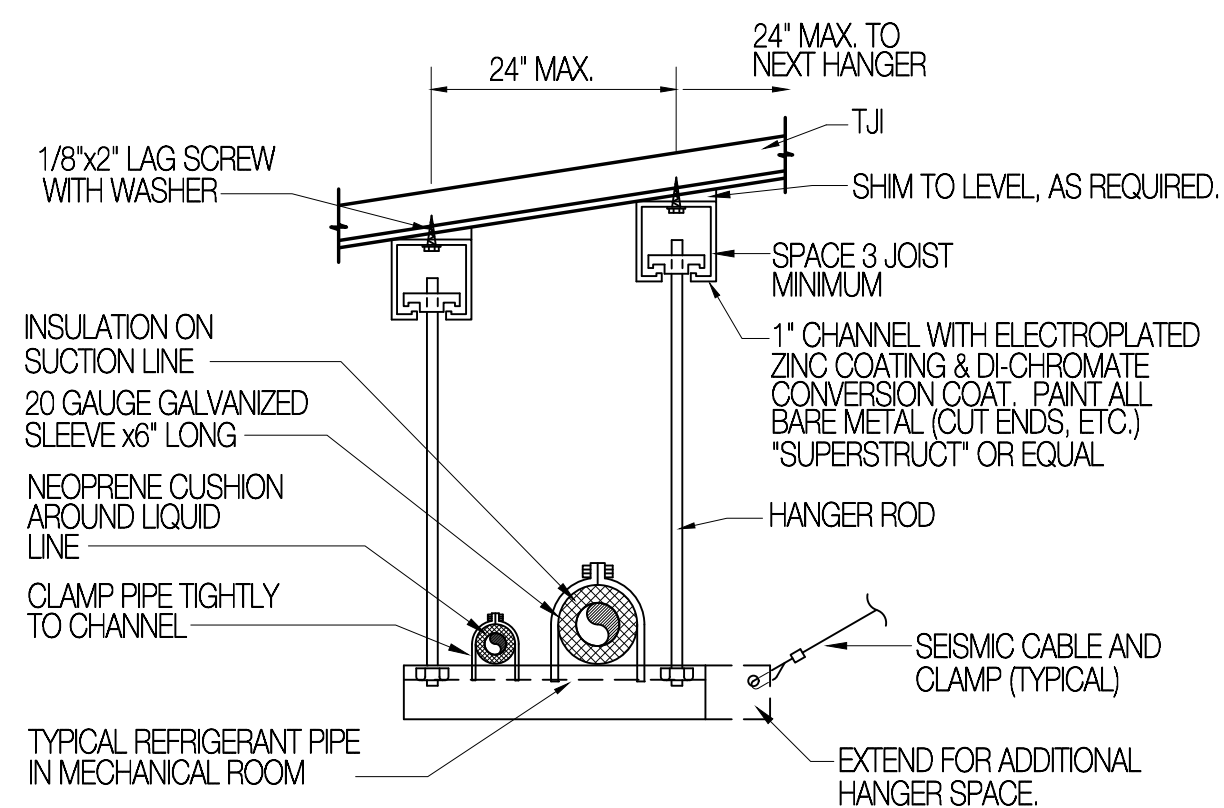

**2 REFRIGERANT PIPING SUPPORT FROM JOIST DETAIL**  
SCALE: NONE

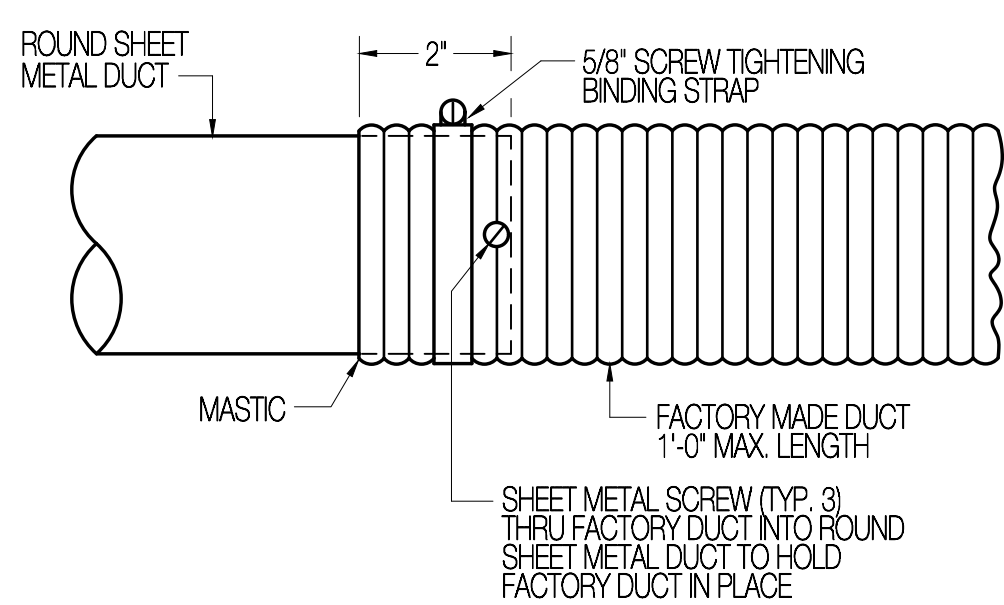


**3 FACTORY DUCT DETAIL**  
SCALE: NONE

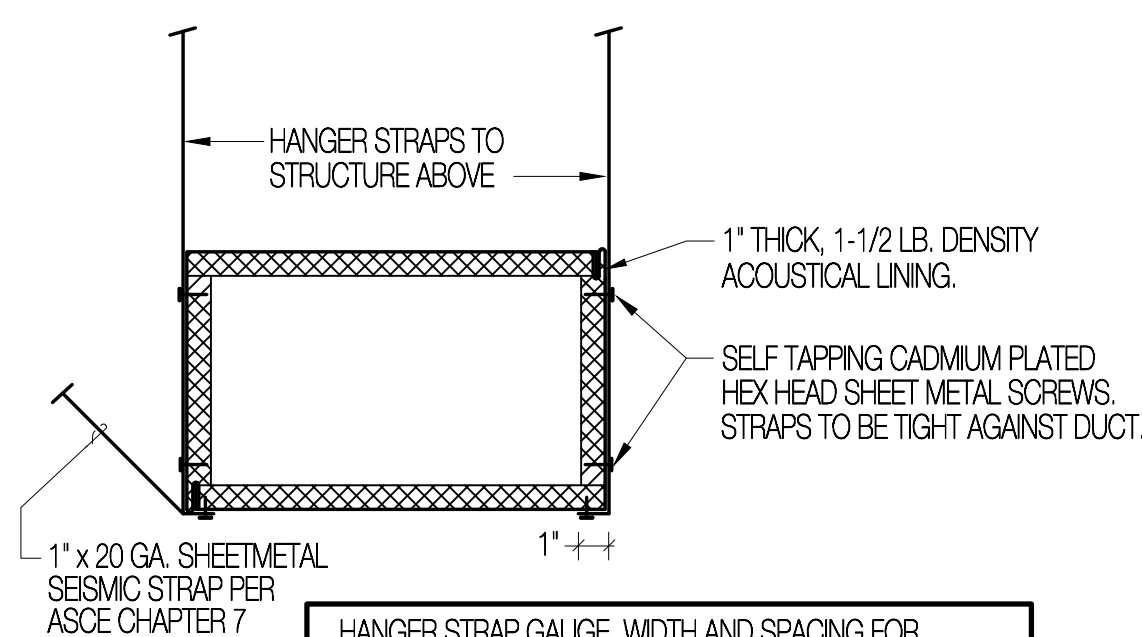

**4 RECT. DUCT HANGER DETAIL**  
SCALE: NONE

**GENERAL NOTES FOR MECHANICAL CONTROLS**

- ALL ELECTRICAL INSTALLATIONS, INCLUDING POWER DISTRIBUTION AND SPECIAL SYSTEMS, IS INCLUDED IN THE SCOPE OF THE GENERAL CONTRACT. RESPONSIBILITY FOR THE CONTROL WORK IS DIVIDED BETWEEN THE PROJECT ELECTRICIAN (DIV. 16000) AND A SPECIALTY CONTROLS CONTRACTOR (DIV. 23000).
- ALL ELECTRICAL WORK SHALL BE IN ACCORDANCE WITH DIVISION 26000 AND TO THE FULLEST EXTENT POSSIBLE, PRODUCTS AND PRACTICES SHALL BE SIMILAR FOR ALL INSTALLATIONS.
- THE ELECTRICIAN SHALL PROVIDE ALL POWER TO AND THROUGHOUT THE BUILDING, TO INCLUDE MOTOR CONTROL CENTERS, BREAKER PANELS AND ALL OTHER SYSTEMS DESIGNATED TO THE ELECTRICIANS.
- THE ELECTRICIAN SHALL RUN AND CONNECT ALL WIRING AND DEVICES 120 VOLTS AND ABOVE WHICH POWER MOTORS AND OTHER MECHANICAL DEVICES. WHERE CONTROL DEVICES ARE LOCATED IN POWER CIRCUIT, THE CONTROLS CONTRACTOR SHALL INTERRUPT THE CIRCUIT IN THE MECHANICAL EQUIPMENT JUNCTION BOX, WIRE THROUGH THE CONTROL DEVICE AND BACK TO THE JUNCTION BOX.
- THE CONTROLS CONTRACTOR SHALL PROVIDE SHOP DRAWINGS FOR CONTROL SYSTEM CIRCUITS.
- BREAKERS AND DISCONNECTS, AUXILIARY CONTACTS, STANDARD PILOT LIGHTS AND MAGNETIC STARTERS ARE THE RESPONSIBILITY OF DIVISION 26000.
- AUXILIARY RELAYS, LOW VOLTAGE TRANSFORMERS, CONTROL PANEL SWITCHES & DEVICES, THERMOSTATS, PRESSURE SWITCHES, ELECTRIC OPERATED VALVES, ETC., ARE THE RESPONSIBILITY OF DIVISION 23000.
- ANY QUESTION OF RESPONSIBILITY SHALL BE CLARIFIED BY THE GENERAL CONTRACTOR
- ALL WIRING SHALL TERMINATE AT LABELED TERMINAL STRIPS.
- ALL THERMOSTATS SHALL BE ENERGY STAR RATED WITH IAQ CAPABILITY.

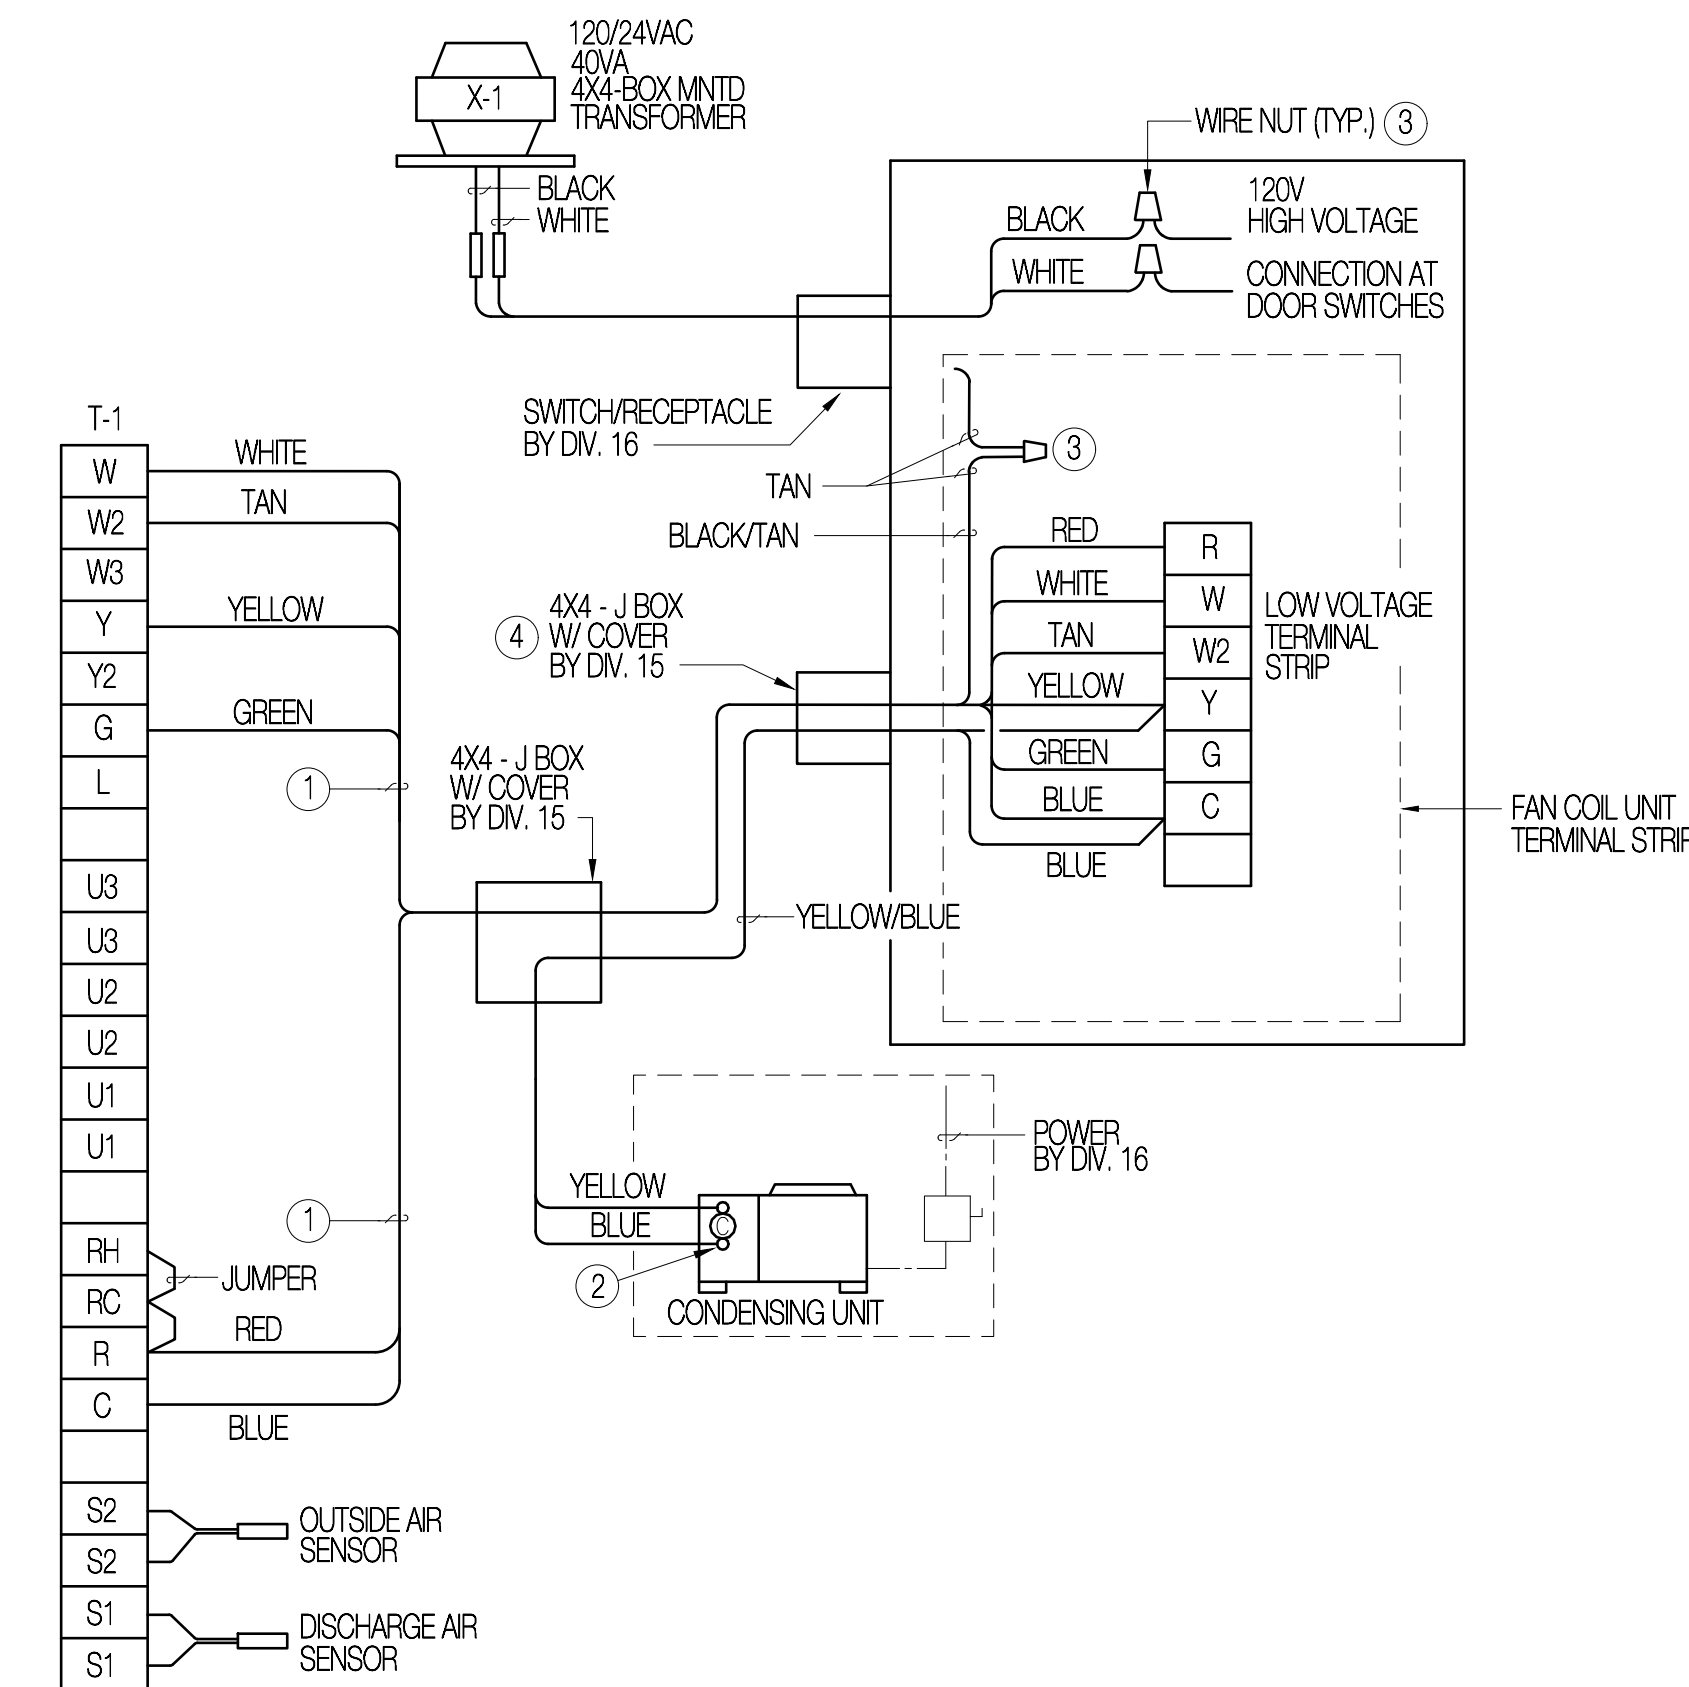


**DIAGRAM NOTES**

- THERMOSTAT CABLE- 8 CONDUCTOR- 18 AWG SOLID COPPER WIRE INSULATED WITH HIGH DENSITY POLYETHYLENE. CONDUCTORS SHALL BE ENCLOSED IN BROWN JACKETING. (NO 22 AWG CABLE ALLOWED).
- IF CONDENSING UNITS HAVE THEIR OWN POWER SUPPLY IT MAY BE NECESSARY TO ADD ADDITIONAL RELAYS IN CONDENSING UNIT TO PROPERLY INTERFACE CONTROLS.
- USE WIRE NUT CONNECTORS FOR SPLICING CONDUCTORS AND TYTON TYPE CRIMP CONNECTORS FOR TERMINAL CONNECTIONS. NO TERMINAL CONNECTORS REQUIRED AT THERMOSTAT.
- ALL WIRING TO BE PLENUM RATED.

**CONTROL EQUIPMENT**


SYMBOL	DESCRIPTION	HONEYWELL MODEL NO.
T-1	THERMOSTAT	TH8320R1003
WS-1	WIRELESS INDOOR TEMP. SENSOR	C7189R1004
OS-1	WIRELESS O.A. TEMP. SENSOR	C7089R1013
DS-1	DISCHARGE AIR TEMP. SENSOR	C7089R1013

**FURNACE CONTROL DIAGRAM**

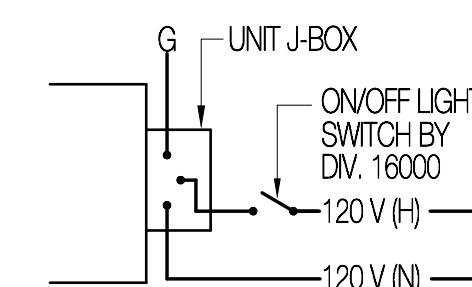

**CEILING EXHAUST FAN CONTROL DIAGRAM**

TYPICAL OF ALL CEILING EXHAUST FANS

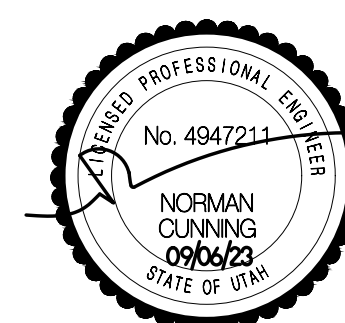

Consultant

**JONES & ASSOCIATES**  
CONSULTING ENGINEERS  
6080 S FASHION POINT DRIVE  
SOUTH OGDEN, UT 84405

Project Name

Issued No.	Date	Description

Revision No.	Date	Description
2	02.01.24	PLAN REVIEW/REDESIGN

SAA Project No. 2022-03

Drawing Title

MECHANICAL CONTROLS & DETAILS

Sheet Number

M-700

MECHANICAL SPECIFICATIONS

GENERAL CONDITIONS

DESCRIPTION OF PROJECT: The mechanical work described in these mechanical specifications is for a project located in Ogden, Utah. Design weather conditions are 95° db, 63° wb, and winter 1°F. Altitude readings, unless otherwise noted, are for an elevation of 4,500 feet above sea level. Make adjustment to manufacturer's performance data as needed.

CODES AND PERMITS, AUTHORITIES HAVING JURISDICTION:

- 2021 International Mechanical Code - (with Utah amendments)
2021 International Building Code - (with Utah amendments)
2021 International Plumbing Code - (with Utah amendments)
2021 International Energy Code - (with Utah amendments)
SMACNA Duct Design Standards
Locally enforced NFPA Codes
Local Fuel Utility Regulations
Local Power Utility Regulations
American Gas Association
ASTM B31.1 Piping

DEFINITION OF PLANS AND SPECIFICATIONS: The mechanical drawings at reduced scale show the general arrangement of piping, ductwork, equipment, etc., and shall be followed as closely as the actual building construction and the work of other trades will permit. The architectural and structural drawings shall be considered as part of the work insofar as these drawings furnish the Contractor with information relating to design and construction of the building. Architectural drawings shall take precedence over mechanical drawings. Request clarification and participate in resolution in the event of conflict.

- A. Because of the small scale of the mechanical drawings, it is not possible to indicate all offsets, fittings and accessories which may be required. Investigate the structural and finish conditions affecting the work and arrange the work accordingly, providing such extensions, fittings, valves and accessories to meet the conditions as may be required.
B. Examine the actual construction site prior to bidding and obtain an understanding of the conditions under which the work will be performed.
C. During construction, verify the dimensions governing the mechanical work at the building. No extra compensation shall be claimed or allowed because of differences between actual dimensions and those indicated on the drawings.

ALTERNATIVE CONSTRUCTION/SUBSTITUTION: The contract documents outline a way in which the Owner may be delivered a functional and reliable facility. Drawings and specifications describe reasonable engineering practice for the Contractor to follow.

- A. Coordination between trades may result in periodic needs to adjust the installation from that indicated, but in no case shall the intended function be compromised.
B. The Contractor may perceive some work methods which differ from those specified which could save time and effort. These may be presented to the Architect with a breakdown of possible cost savings for review.
C. Materials substitutions will generally be approved in a review process prior to bidding.

QUALITY OF MATERIALS AND EQUIPMENT:

- A. All equipment and materials shall be new, and shall be the standard products of manufacturers regularly engaged in the production of plumbing, heating, ventilating and air conditioning equipment, and shall be the manufacturer's latest design.

is to be the basis for the Contractor's bid. Provisions for substitute equipment are outlined in the General Conditions. All materials shall be produced by manufacturing plants located in the United States of America.

- B. Furnish and install all major items of equipment specified in the equipment schedules on the drawings complete with all accessories normally supplied with catalog items listed, and all other accessories necessary for a complete and satisfactory installation.

MANUFACTURER'S DIRECTIONS: Install all equipment in strict accordance with directions and recommendations furnished by the manufacturer. Where such directions are in conflict with the plans and specifications, report such conflicts to the Architect who shall direct adjustments as deemed necessary and desirable.

VALVES:

- DOMESTIC COLD WATER, DOMESTIC HOT WATER, DOMESTIC HOT WATER RETURN:
A. Ball Valves: Copper piping, 2-1/2" and Smaller: 475 psig WOG @ 250°F, bronze construction, soldered ends for 3/4" and smaller, threaded ends for 1" and larger, glass Reinforced PolyTetraFlouroEthylene (RPTFE) seat providing bubble tight leakage performance at 100 psig air pressure under water, full port stainless steel ball.
1. Manufacturers & Models: Provide ball valves from one of the manufacturers and model numbers listed below.

INSULATION:

- WATER PIPING (domestic cold & hot water, 1" thickness required.)
A. Preformed Fiberglass Piping Insulation: ASTM C 547. (Class 1 for use to 450°F (230°C); Class 2 for use to 650°F (345°C); Class 3 for use to 1200°F (650°C).
REFRIGERATION PIPING (1-1/2" thickness required on all refrigeration suction piping)
A. Flexible, Unicellular Pipe Insulation: Closed-cell elastomeric, preformed, with heat fusion or contact cement joining system.
1. All insulation exposed to sunlight or installed outdoors shall be protected with two coats of Armstrong Wb Armaflex Finish.
DUCTWORK (1-1/2" thickness for all non-acoustically lined ductwork in concealed spaces):
A. Flexible Fiberglass Ductwork Insulation: ASTM C 553, Type I - resilient, flexible; Class B-1 - 0.65 lbs/ft³; Class B-2 - 0.75 lbs/ft³; Class B-3 - 1.0 lbs/ft³; Class B-4 - 1.5 lbs/ft³; Class B-5 - 2.0 lbs/ft³; Class B-6 - 3.0 lbs/ft³; Type II - flexible; Class F-1 - 4.5 lbs/ft³; Type III - semirigid; Class F-2 - 4.5 lbs/ft³.

DOMESTIC WATER:

- A. Domestic Water:
1. Pipe Sizes 4" and Smaller: Copper tubing. Conform to ASTM B88, Type L, hard temper, copper tube; ASME B16.22 streamlined pattern wrought-copper fittings, with soldered joints using 95-5 tin/antimony bearing solders such as "Silvabrite."
2. Cross-linked polyethylene conforming to ASTM F877.

WASTE, DRAIN AND VENT PIPING:

- A. Sanitary Soil Drain, Waste and Vent Piping:
1. Piping and Fittings: Schedule 40 PVC pipe and fittings conforming to the requirements of ASTM D 2665. Pipe and fittings shall be produced domestically as supplied by Spears, or Charlotte Pipe and Fittings.

NATURAL GAS PIPING:

- A. Building Distribution Piping:

- 1. Pipe Size 2" and Smaller: Black steel pipe, Schedule 40; malleable-iron threaded fittings (exposed), welded fittings and joints (concealed).
B. Gas Cocks:
1. Gas Cocks 2" and Smaller: 150 psi non-shock WOG, bronze straightway cock, flat or square head, threaded ends.
2. Manufacturer: Subject to compliance with requirements, provide gas cocks of one of the following:
a. DeZurik Corp.
b. Jenkins Bros.
c. Lukenheimer Co.
d. NIBCO, Inc.
e. Powell (The Wm.) Co.
f. Rockwell International Flow Control Div.
g. Stockham Valves and Fittings.
h. Walworth Co.

COMBUSTION AIR & VENT PIPING:

- A. Air Piping - Schedule 40 pipe and fittings meeting requirements of ASTM D 1785, and ASTM D 2466.
B. Primer and Cement - Meet requirements of ASTM D 2564 and ASTM F 656.

EQUIPMENT SELECTION

The contractors shall select equipment based on the drawing schedules and requirements of these specifications. Any and all substitutions shall be presented during submittals for approval.

EXITURES AND TRIM: The model numbers listed below have been carefully selected to help bidders in the submittal process of selecting fixtures and trim. The completeness and accuracy of these numbers must be verified during the bidding process. Any discrepancies between the model numbers and the fixture, or trim descriptions noted by a manufacturer during the bidding process will be reported to the Architect / Engineer for clarification.

- 1. (P-1) ADA Compliant Fixture: (1.6 gal./flush)
a. Floor mounted, flush tank type, vitreous china, elongated bowl. Mounted so top of seat is 18" above finished floor.
b. Approved Manufacturers:
(1) Kohler - "Persuade" No. 3753
(2) American Standard - "Cadeo" No. 2514.101
(3) Gerber - "North Point ErgoHeight" No. 20-832.
2. (P-1) Seat:
a. (White) high impact plastic, open front, check hinge.
b. Approved Manufacturers: (Typical on standard use and ADA fixtures)
(1) Church No. 295C
(2) Beneke No. 527CH
(3) Bemis No. 1655-C
(4) Olsonite No. 95
B. Lavatory:
1. (P-2) ADA Fixture
a. Wall mounted, 18" x 20", vitreous china, front overflow, faucet holes on 4" centers, concealed arm carrier, mounted so bottom of lavatory is 29" above finished floor, furnish and install pre-formed insulation around P-trap and water supplies meet 25/50 flame/smoke rating.
b. Approved Manufacturers:
(1) Kohler "Kingston" No. K-2005
(2) American Standard "Lucerne" No. 0355.012
(3) Eljer "Delwyn" No. 051-1644.
(4) Crane "Harwich" No. 1-412-V.

- 2. (P-2) Faucet:
a. Two handle, 4" center set, renewable seats, indexed 4" wrist blade handles, aerator with 1.5 GPM flow control device, chrome plated, perforated strainer assembly, vandal proof.
b. Approved Manufacturers:
(1) Kohler "Triton" No. 7404
(2) American Standard "Heritage" No. 5402.172V
(3) Chicago Faucet No. 802A
3. (P-2) Pre-formed Insulation and Protective Cover:
a. Pre-formed foam or fiberglass insulation with two piece white PVC snap on cover with velcro closure, to fit P-trap and hot and cold water stops and supplies, meet 25/50 flame/smoke rating.
b. Approved Manufacturers:
(1) Buckaross, Inc.
(2) Trueborn
(3) or an engineer approved equivalent.
4. (P-2) Supplies with Stops:
a. Chrome plated quarter turn cast brass angle stop, brass stem, gasketed seat, flexible, chrome plated copper riser, chrome plated escutcheon, compression type connections.
b. Approved Manufacturers:
(1) Brass Craft
(2) Eastman
(3) McGuire
5. (P-2) P-Trap:
a. 17 gauge, tubular brass, chrome plated and chrome escutcheons.
b. Approved Manufacturers:
(1) Dearborn
(2) McGuire
(3) Jameco
(4) Sanitary Dash
6. (P-2) Strainer:
a. Drain with grid pattern strainer, cast brass, chrome plated. Provide offset type drain as required to maintain ADA clearances.
b. Approved Manufacturers:
(1) Kohler K-7715 (Offset type No. K-13885)
(2) Jameco
(3) Sanitary Dash
(4) McGuire
C. Sinks
1. (P-3) Breakroom Sink:
a. Single compartment, counter mounted, 14" x 14" x 7-1/2" deep, 18 gauge type 304 stainless steel, 3 faucet holes on 4" centers, self rimming, sound deadened.
b. Approved Manufacturers:
(1) Just No. SL-2017-A-GR
(2) Elkay No. LR-1720
2. (P-3) Faucet:
a. Underdeck mounted, 8" high rigid gooseneck spout, 2.5 gpm vandal proof aerator, 4" wing handles, supplies on 8" centers.
b. Approved Manufacturers:
(1) Chicago Faucet No. 786-HZFCCP.
(2) T & S Brass
3. (P-3) Supplies and Stops:
a. Chrome plated quarter turn cast brass angle stop, brass stem, gasketed seat, flexible chrome plated copper riser, chrome plated escutcheon, compression type connections.
b. Approved Manufacturers:
(1) Brass Craft

fasteners, anchors, rods, straps, trim and angles for support of ductwork.

GRILLES AND DIFFUSERS:

- A. Ceiling Supply Diffuser (S-1): Krueger series 1400, square face, four way blow/round neck, anti-smudge border, all steel, white baked on enamel, size as indicated on drawings.
B. Ceiling Supply Diffuser (S-2): Krueger series SH, square face, one, two three or four way blow as required. Square neck, beveled drop face, anti-smudge border, all steel, white baked on enamel, size as indicated on drawings.
C. Slot Diffuser (S-3): Krueger series 1900, 1/2" slot x 2 slot, adjustable vanes for varying volume and direction of throw. All aluminum extruded construction. White finish with black pattern controller.
D. Perforated Return Register / square neck (R-1): Krueger series 6490. Concealed hinge frame, sponge rubber gasket, white baked-on enamel, filter holding frame, color as selected by architect, size as indicated on drawing.
E. Return Grille (R-2): Krueger series 885H. Heavy duty steel construction, horizontal blades at 35° deflection with 1/2" spacing, mounting frame with concealed fasteners, sponge rubber gasket, white baked enamel finish, size as indicated on drawings.

MECHANICAL CONTROLS:

- CONTROL DAMPERS:
A. In supplying dampers, instruct the sheet metal workers in the proper installation of the dampers. Ductwork shall be reinforced and the damper properly supported without strain.
B. Protect all dampers mounted in a duct system which requires special treatment.
C. Provide damper operators with motors of proper size, so that the motors will operate against the static pressure of the systems. Provide each damper motor with a bracket for attaching to ductwork, building structure or equivalent. Damper motors in plenums shall be mounted on damper frames. Do not install motors in ducts. Modulating motors where indicated shall be provided with integral steps for both minimum and maximum stop.
D. Control dampers for outside air, relief air, exhaust air, ventilating air and other dampers exposed to weather temperatures in built-up systems. Low leakage type with spring loaded side seals, inflatable butyl or neoprene fabric edge seals, bronze or teflon bearings, reinforced galvanized steel blades. Parallel action. Air leakage not to exceed 10 CFM per square foot at 4" upstream static pressure.
1. Johnson "Proportion-Aire" D-1200/D-1300.
2. Ruskin CD50
3. Greenheck VCD-43

CONDUCTORS:

- A. Color coded and No. 16 and No. 12 AWG Type TWN, TFN, or THHN, stranded.
B. Thermostat Cable - 12 conductor or 8 conductor, 18AWG solid copper wire, insulated with high density polyethylene. Conductors parallel enclosed in brown PVC jacket (No 22 AWG cable allowed).

THERMOSTAT: (Furnace System)

- A. Programmable low voltage type provided with automatic change over feature for both heating and cooling stages, seven day program with two starts and stops per day, and provisions for damper operators. Thermostat and subbase compatible with heat pump operation.
B. Battery - Mallory MN1604 9 volt alkaline type or equal as approved by Engineer.
C. Approved Manufacturer & Model - 1. Honeywell TH8320

SENSORS:

- A. Wall - Honeywell 71891004 (wireless)
B. Outside and Discharge Air - Honeywell 7089R1013 (wireless)

TRANSFORMER:


- A. 120/240 volt, 38VA Honeywell AT72D1188, cover mount

D

C

B

A

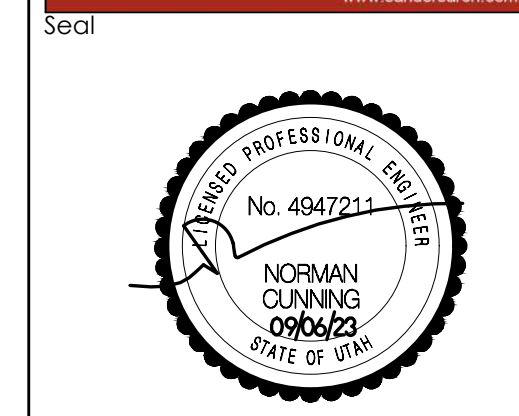

Consultant

JONES & ASSOCIATES CONSULTING ENGINEERS 6080 S FASHION POINT DRIVE SOUTH OGDEN, UT 84405

Table with columns: Issued No., Date, Description. Includes entries for 02.01.24 PLAN REVIEW/REDESIGN.

SAA Project No. 2022-03 Drawing Title

MECHANICAL SPECIFICATIONS

Sheet Number

MS-100


B. 120/24 volt, 50VA Honeywell AT87A1106, foot mount

**DAMPER ACTUATORS:**

- A. Electric type equipped for Class I wiring.
- B. Shall not consume power during UNOCCUPIED cycle or use chemicals or expandable media.
- C. Have built in spring return.
- D. Approved Manufacturer & Model -
  - 1. Honeywell MS7505A2030

**AIR SYSTEMS BALANCE:**

- A. Before any adjustments are made, check the systems for such items as dirty filters, duct leakage, filter leakage, damper leakage, equipment vibrations, correct damper operations, etc. Adjust all fan systems, major duct sections, registers, diffusers, etc., to deliver design air quantities within +5%. Individual air outlets, when one of three or more serve a space may have a tolerance of 10 percent from the average. Design static pressure is based on filters approximately 50% loaded with dirt. Pressure drop across filters during balancing shall be simulated to that condition. After balancing is completed check motor amperage with the filters clean.
- B. Adjust supply, and recirculation air systems towards air quantities shown on drawings. Establish a proper relationship between supply and exhaust. Follow proportional balance procedures outlined by AABC and/or SMACNA for such work.
- C. Distribution system shall be further adjusted to obtain uniform space temperatures free from objectionable drafts and noise within the capabilities of the system.

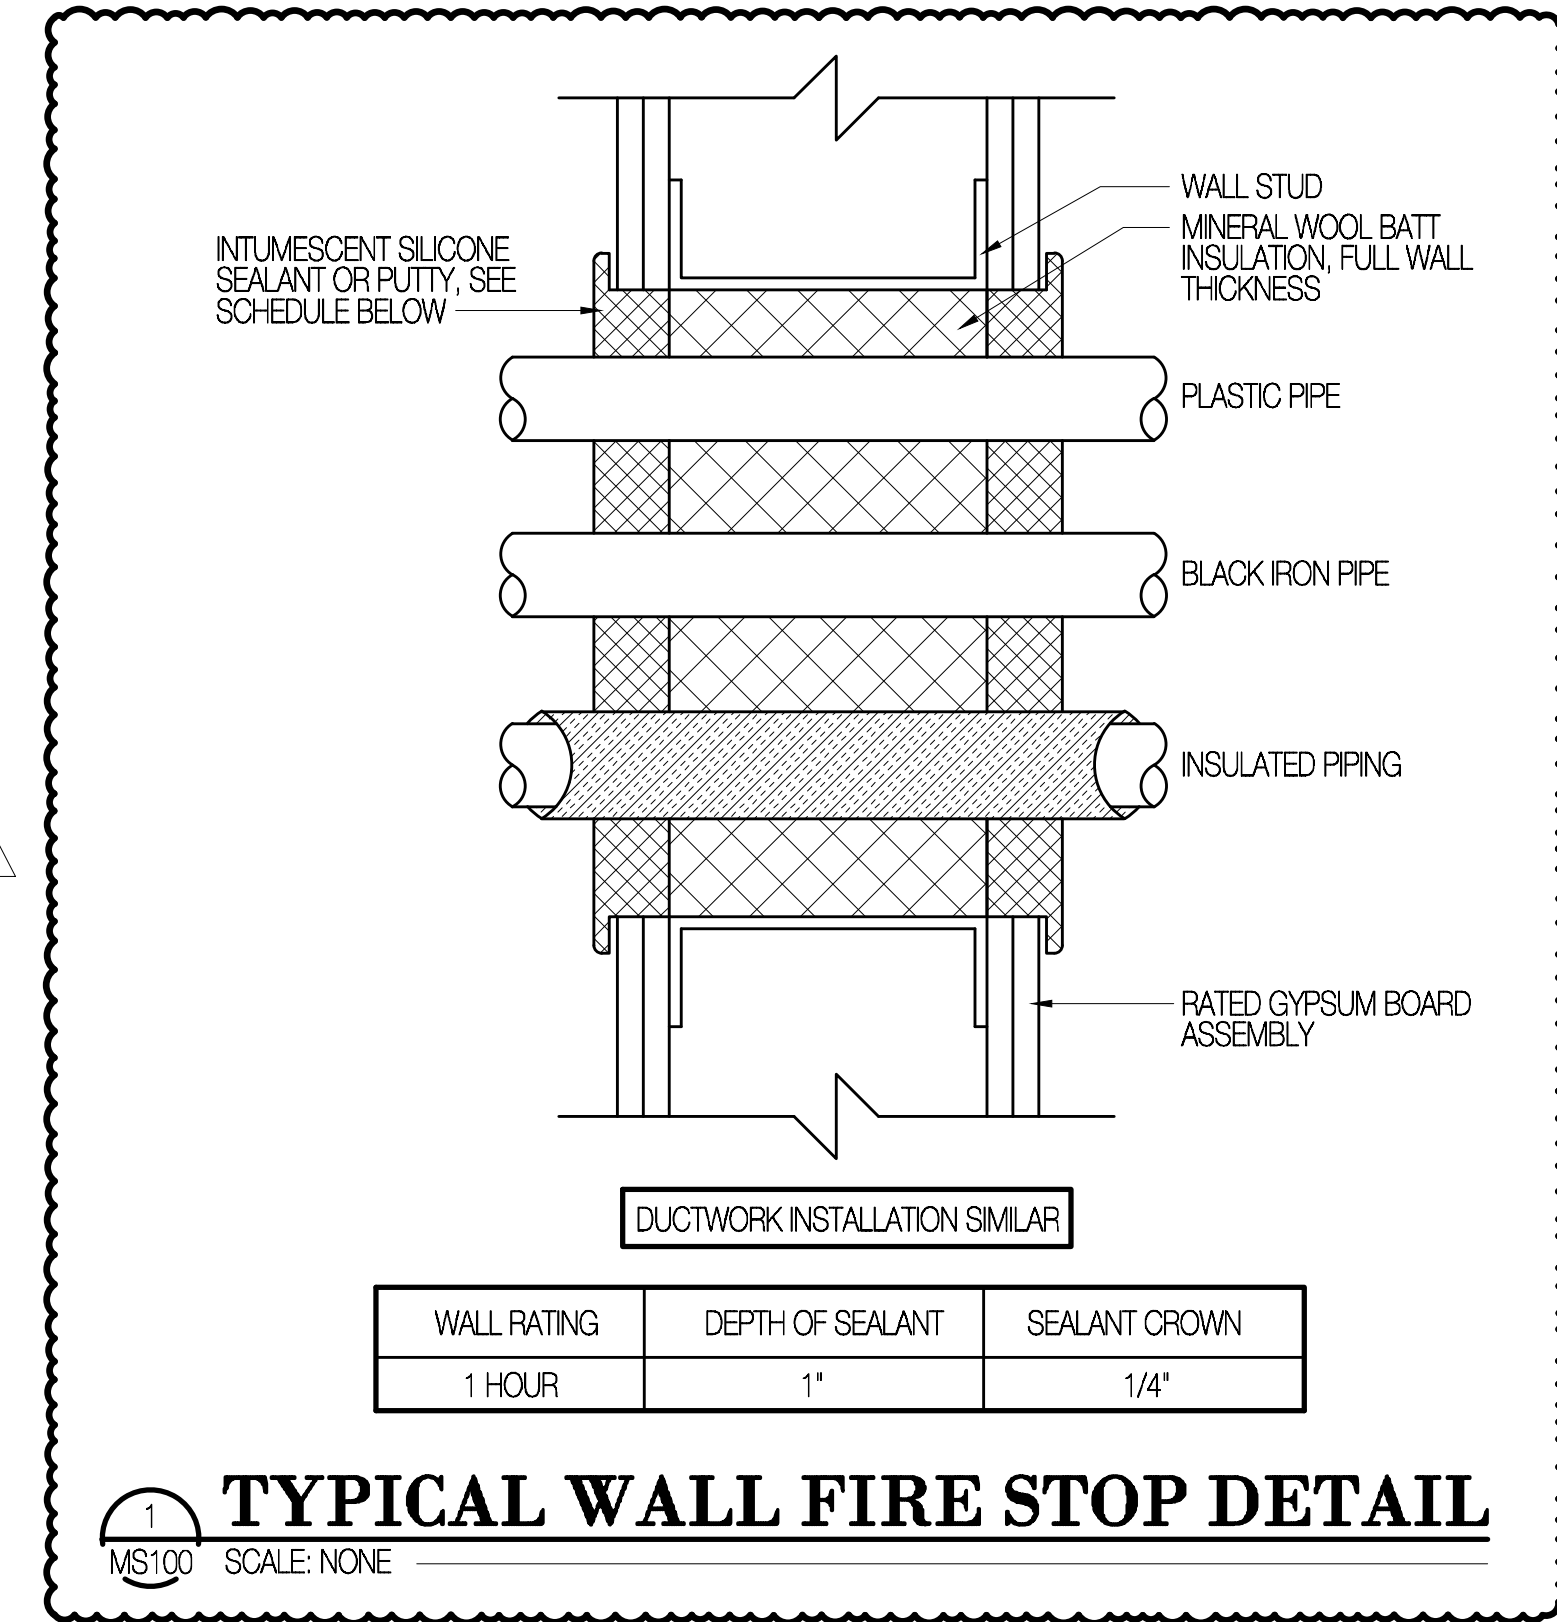

Consultant

**JONES & ASSOCIATES**  
 CONSULTING ENGINEERS  
 6080 S FASHION POINT DRIVE  
 SOUTH OGDEN, UT 84405

Project Name

Issued No.	Date	Description

Revision No.	Date	Description
2	02.01.24	PLAN REVIEW/REDESIGN

SAA Project No. 2022-03  
 Drawing Title

**MECHANICAL SPECIFICATIONS**

Sheet Number  
**MS-101**










TIME: 15 OCT 2013 - 12:25PM DAKOT - T:\085\2022\2488 JONES ASSOCIATES EXPANSION\01 DRAWINGS\04 ELECTRICAL\SINE SOURCE PROJECT\SHEETS\01 ELECTRICAL SITE PLANDWG  
 LAST SAVED: 26 Sep 23

- SHEET KEYED NOTES**
1. UPGRADE MODULAR METERING AND ASSOCIATED STAND PER ELECTRICAL ONE-LINE DIAGRAM.
  2. PROVIDE NEW FEEDER AS SHOWN ON EP601 - ELECTRICAL ONE-LINE DIAGRAM.
  3. CUT, PATCH AND REPAIR OR BORE UNDER EXISTING HARDSCAPE FOR NEW FEEDER INSTALLATION.
  4. PROVIDE NEW DISCONNECTS. SEE EP601 - ELECTRICAL ONE-LINE DIAGRAM. VERIFY LOCATION ON BUILDING WITH OWNER AND FIELD CONDITIONS.

- GENERAL SHEET NOTES**
1. EXISTING ITEMS TO BE REMOVED ARE INDICATED AS BOLD/DASHED. ITEMS TO REMAIN ARE SHOWN AS LIGHT/SOLID.
  2. CIRCUIT ROUTING IS SCHEMATIC UNLESS OTHERWISE NOTED.
  3. COORDINATE ALL UTILITY INSTALLATIONS WITH LOCAL UTILITY REPS.
  4. COMPLY WITH ALL UTILITY REQUIREMENTS FOR NEW UTILITY INSTALLATIONS.

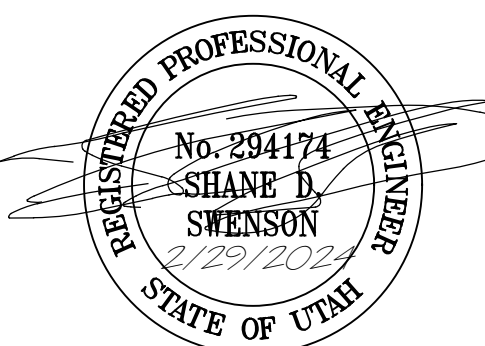

Consultant

**SINE SOURCE ENGINEERING**

15 W. Wall Linn St. Blvd  
 Suite 102  
 Ogden, UT 84401  
 Office: 435.767.1115  
 Fax: 435.767.3109  
 www.sinesource.com



Project Name  
**JONES AND ASSOCIATES  
 BUILDING ADDITION**

Issued

No.	Date	Description
1	09.21.23	PLAN REVIEW
2	02.29.24	PLAN REVIEW

Revision

No.	Date	Description

SAA Project No. 2022-03  
 Drawing Title

**ELECTRICAL SITE PLAN**

Sheet Number  
**ES101**

**1 ELECTRICAL SITE PLAN**  
 Scale: 1"=20'-0"

TIME: 15 OCT 2024 - 12:25PM DONALD J. PATTON - T:\JOBS\2023088 JONES ASSOCIATES EXPANSION\01 DRAWINGS\05 ELECTRICAL\INE SOURCE PROJECTS\ED101 ELECTRICAL DEMOLITION PLAN.DWG  
 LAST SAVED: 30 Aug 23

A B C D


1

2

3

4

5

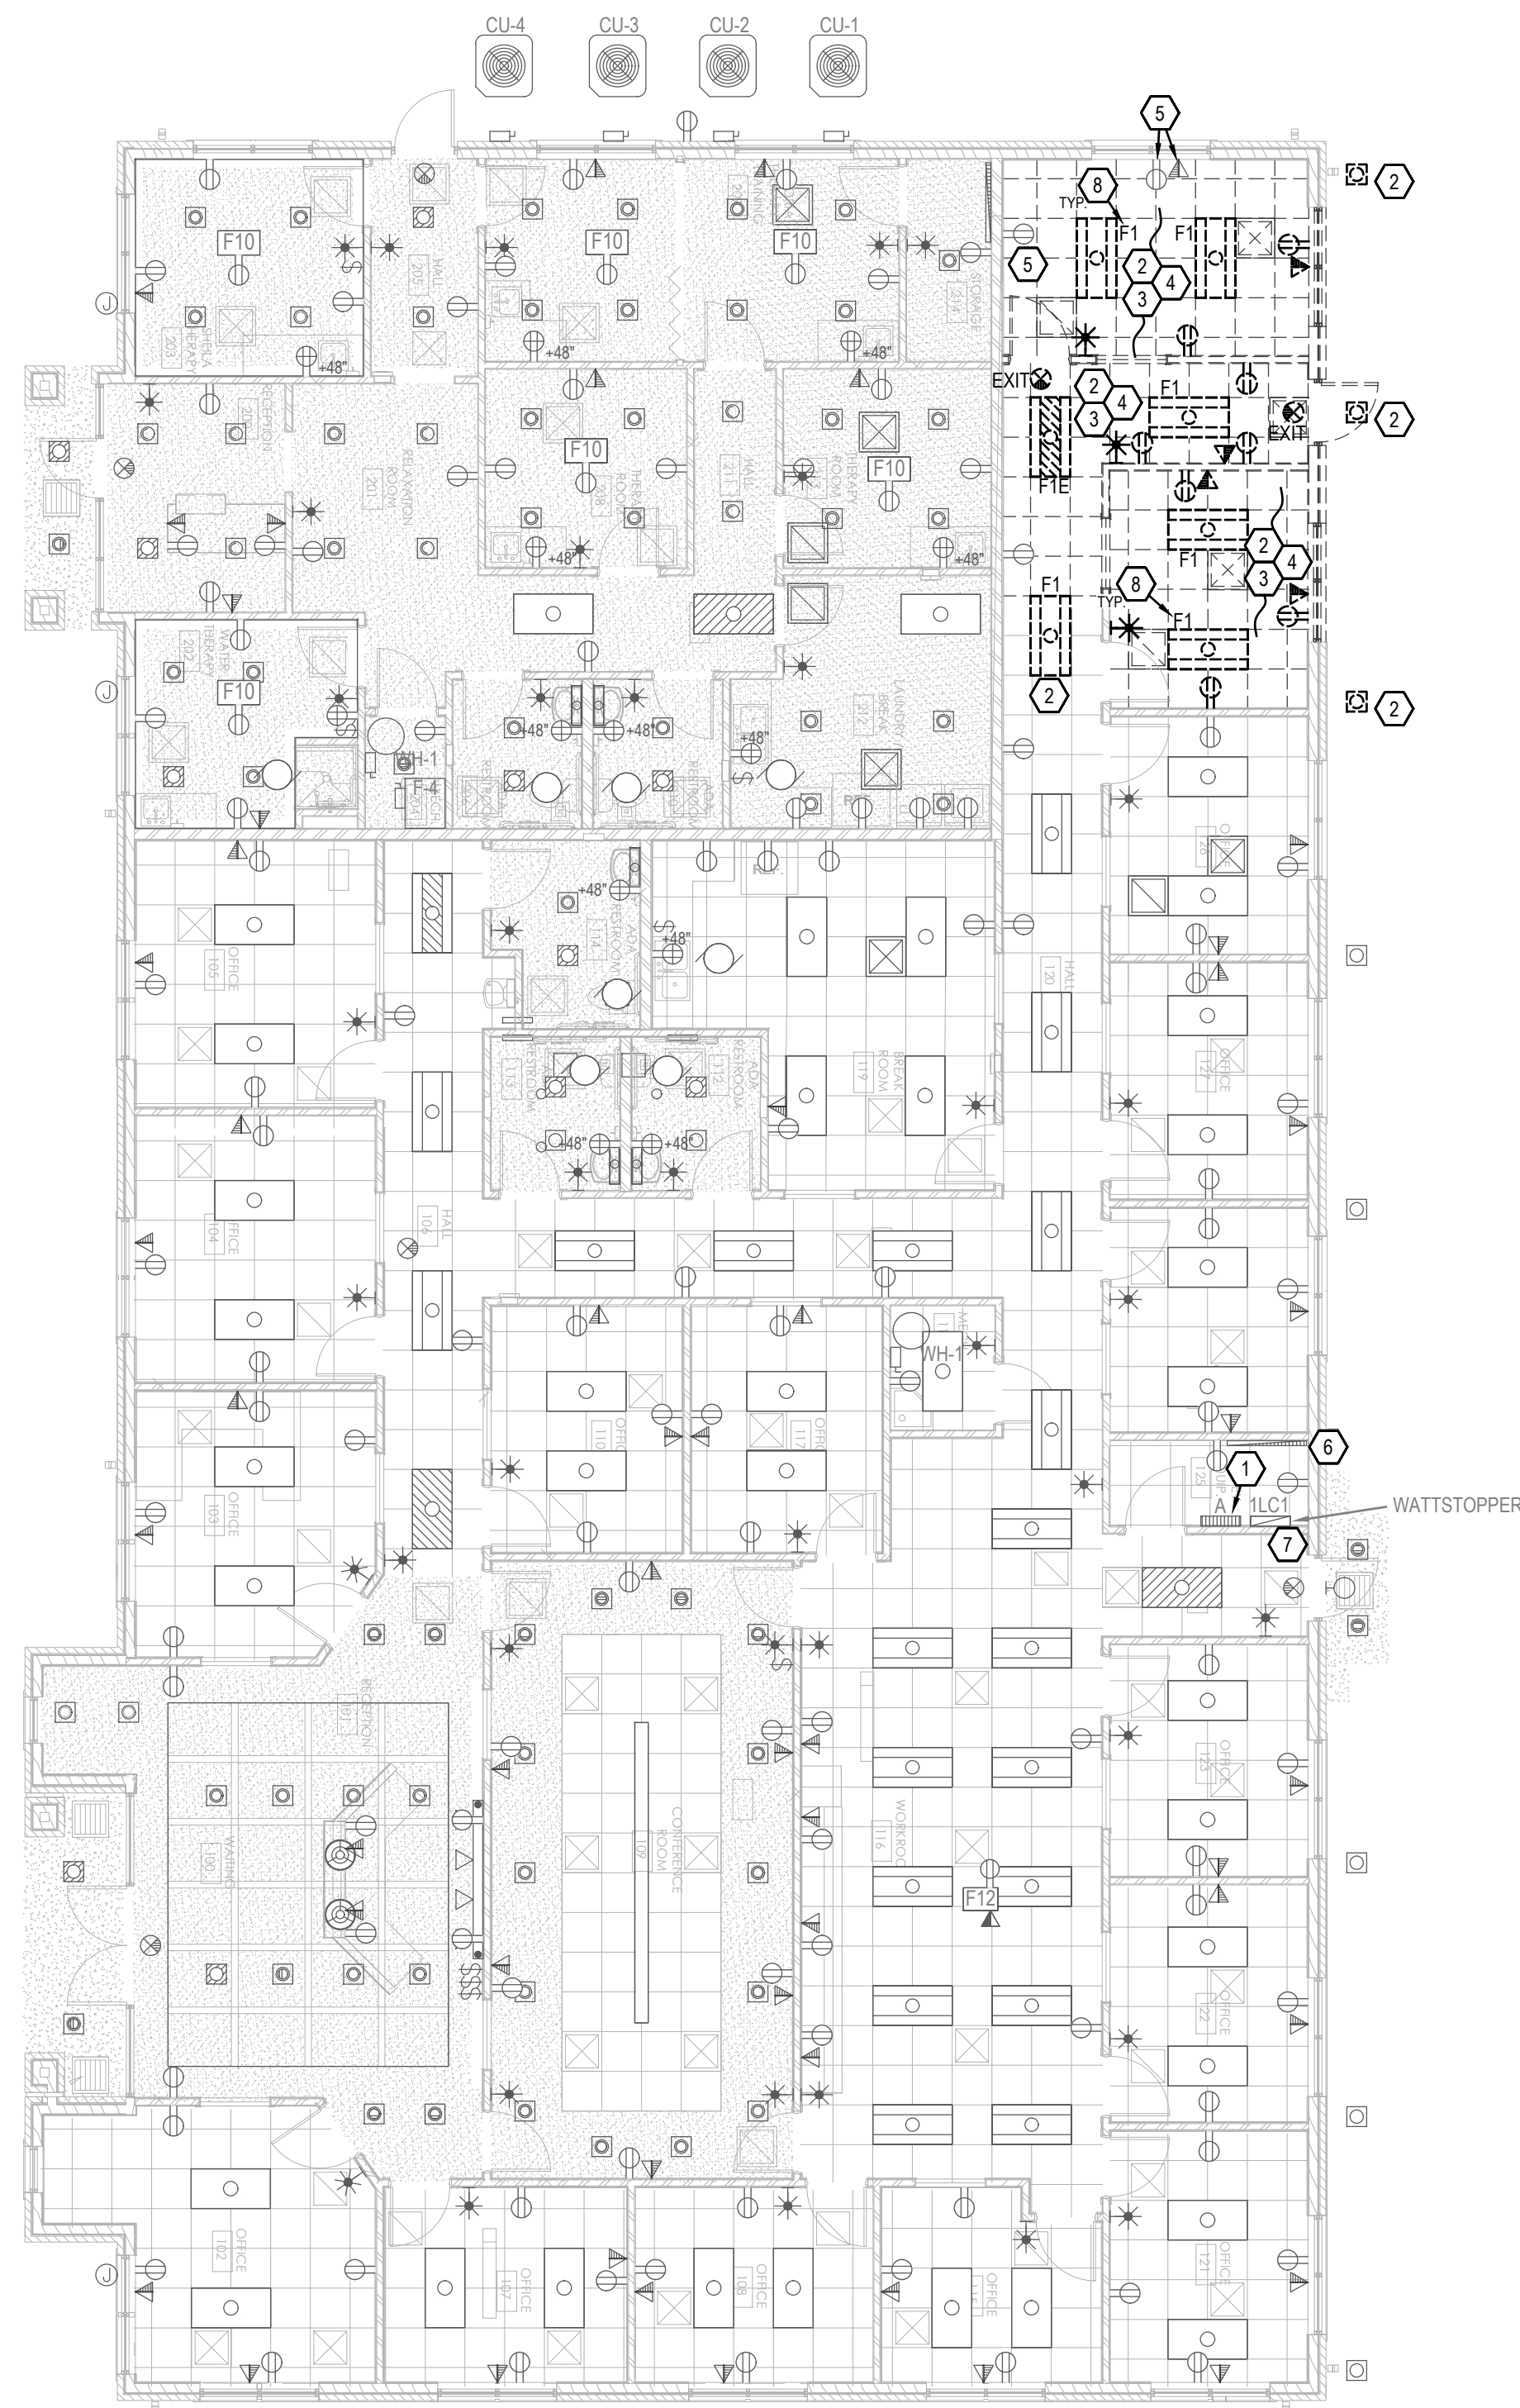

- GENERAL SHEET NOTES**
- DEMOLITION PLAN IS ENGINEER'S ATTEMPT TO ASSIST BIDDERS IN ESTIMATING REMOVAL COSTS OF EXISTING EQUIPMENT. PLAN IS NOT INTENDED TO BE ALL-INCLUSIVE, AND IT IS THE BIDDERS RESPONSIBILITY TO VERIFY ALL EXISTING EQUIPMENT AND DEVICES TO BE REMOVED PRIOR TO BIDDING.
  - EXISTING ITEMS TO BE REMOVED ARE INDICATED AS BOLD/DASHED. ITEMS TO REMAIN ARE SHOWN AS LIGHT/SOLID.
  - MAINTAIN CIRCUIT CONTINUITY FOR DEVICES DOWNSTREAM OF ITEMS TO BE REMOVED.
  - WHERE DEVICES ARE SHOWN TO BE REMOVED, COMPLETELY REMOVE ALL RACEWAYS, BOXES AND CONDUCTORS TO PANEL OR TO FIRST J-BOX TO REMAIN ACTIVE IN CIRCUIT PATH.

- SHEET KEYED NOTES**
- EXISTING DISTRIBUTION TO REMAIN.
  - REMOVE EXISTING FIXTURES AND/OR LIGHTING CONTROL AS INDICATED.
  - REMOVE EXISTING OUTLETS AS INDICATED.
  - REMOVE EXISTING COMMUNICATIONS DEVICES AS INDICATED.
  - REPLACE EXISTING DEVICES/COVERS INDICATED WITH NEW COMPLYING WITH THIS PROJECT'S SPECIFICATIONS.
  - EXISTING COMMUNICATIONS RACK TO REMAIN. EXPAND AS REQUIRED.
  - EXISTING WATTSTOPPER LPS LIGHTING RELAY PANEL TO REMAIN. INTEGRATE NEW DEVICES INTO EXISTING SYSTEM AS REQUIRED. PROVIDE ALL UPGRADES NEEDED.
  - EXISTING FIXTURE IDENTIFICATION. FOR USE IN RE-USING FIXTURES WHERE NOTED ON EL201 - LIGHTING PLANS.

1

**ELECTRICAL DEMOLITION PLAN**

SCALE: 1/8" = 1'-0"




1

2

3

4

5

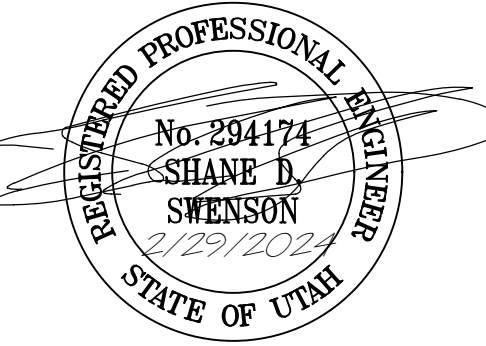

Consultant  
**SINE SOURCE ENGINEERING**  
 95 W. Hill Avenue Blvd  
 Suite 102  
 Ogden, UT 84201  
 Office: 435.767.1145  
 Fax: 435.767.3109  
 www.sineure.com

Project Name  
**JONES AND ASSOCIATES  
 BUILDING ADDITION**

Issued

No.	Date	Description
1	09.21.23	PLAN REVIEW
2	02.29.24	PLAN REVIEW

Revision


No.	Date	Description

SAA Project No. 2022-03  
 Drawing Title

**ELECTRICAL  
 DEMOLITION PLAN**

Sheet Number  
**ED101**

TIME: 15 OCT 2014 - 12:25PM DONALD J. PATTON - T:\JOBS\2023088 JONES ASSOCIATES EXPANSION\01 DRAWINGS\ELECTRICAL\SOURCE PROJECT\SHEETS\EL201 LIGHTING PLANS.DWG  
LAST SAVED: 29 Feb 24


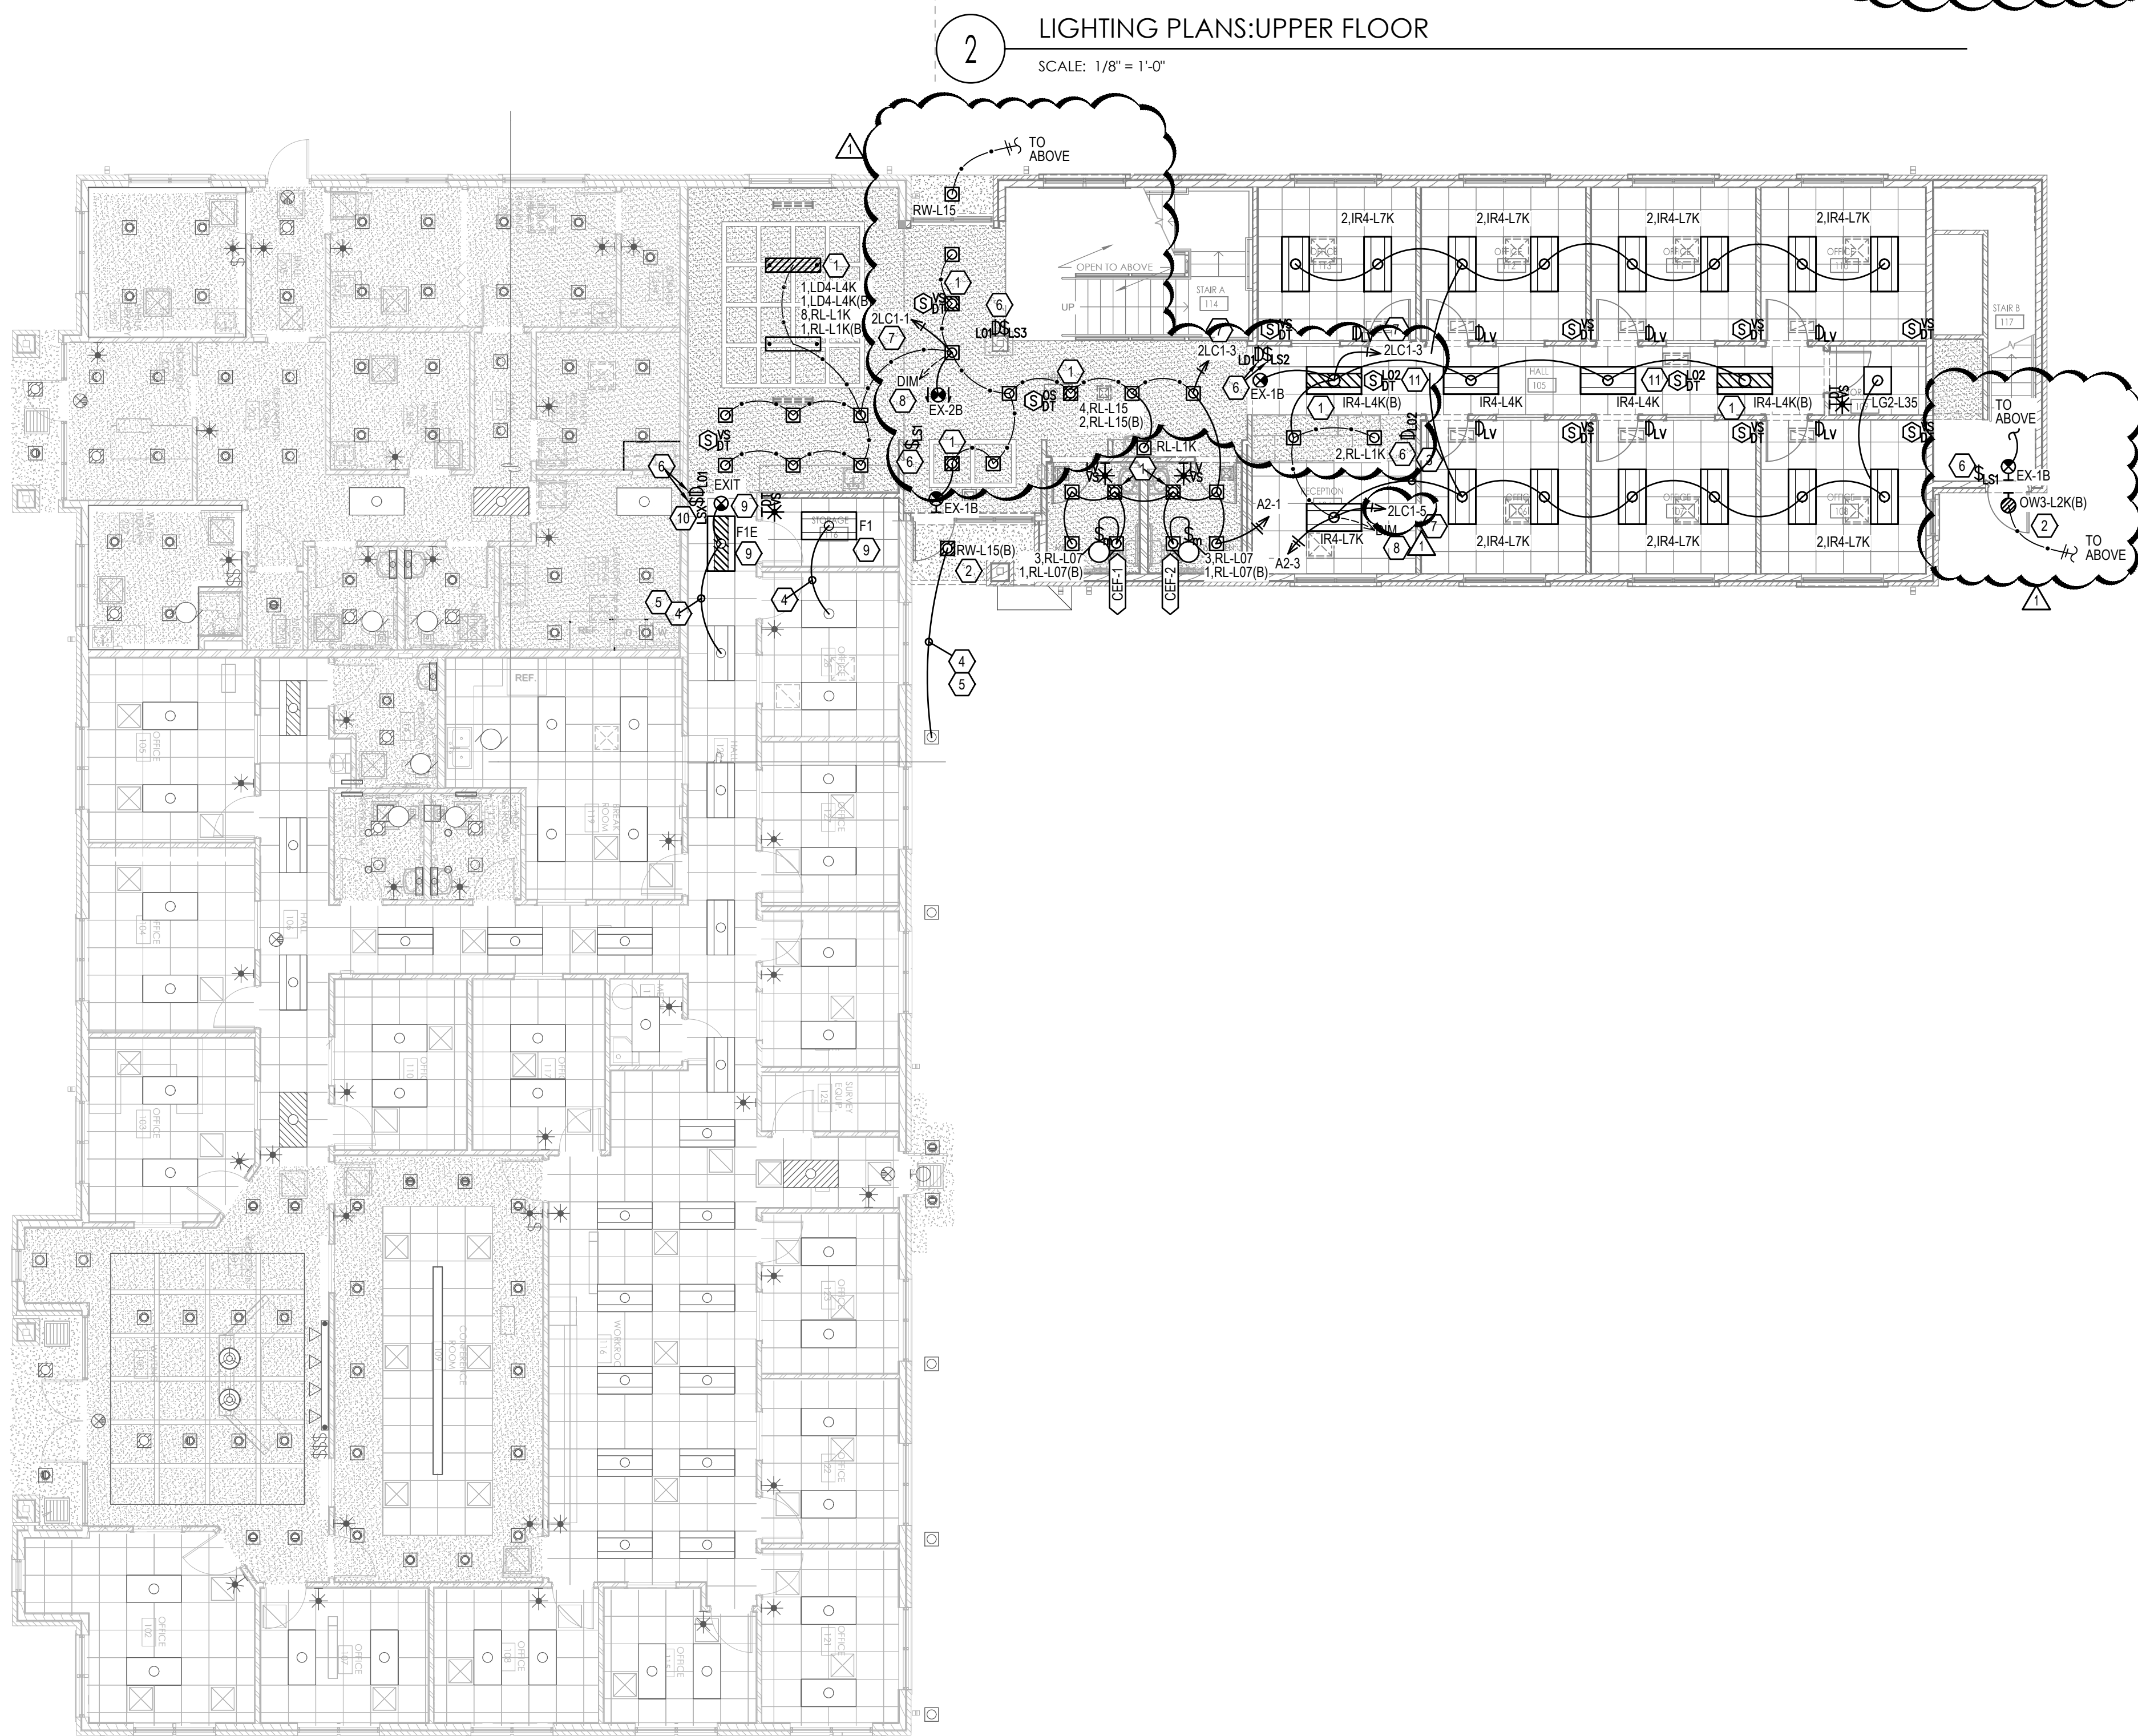


1 LIGHTING PLANS:MAIN  
SCALE: 1/8" = 1'-0"

2 LIGHTING PLANS:UPPER FLOOR  
SCALE: 1/8" = 1'-0"

- SHEET KEYED NOTES**
1. PROVIDE EM BATTERY BALLAST IN FIXTURES NOTED. CONNECT BATTERY TO UNSWITCHED CIRCUIT CONDUCTOR OF CIRCUIT SERVING FIXTURE. CONNECT LAMPS TO OPERATE WITH SWITCH(S) IN NORMAL MODE.
  2. PROVIDE COLD-WEATHER OR REMOTE EM BATTERY BACKUP FOR FIXTURES NOTED. CONNECT BATTERY TO UNSWITCHED CIRCUIT CONDUCTOR OF CIRCUIT SERVING FIXTURE. CONNECT LAMPS TO OPERATE WITH SWITCH(S) IN NORMAL MODE.
  3. CONNECT TO UNSWITCHED SOURCE CONDUCTOR.
  4. CONNECT TO EXISTING CIRCUIT INDICATED.
  5. CONNECT TO EXISTING LIGHTING CONTROL INDICATED.
  6. PROVIDE LIGHTING CONTROL OVERRIDE SWITCHES AT LOCATIONS INDICATED. PROVIDE CONTROL WIRING PER MANUFACTURER'S REQUIREMENTS. SEE DETAILS AND SCHEDULES FOR ADDITIONAL INFORMATION. ENGRAVE COVER PLATE WITH ZONES CONTROLLED. PROVIDE SEPARATE BUTTON LABELING FOR EACH ZONE INDICATED. MULTIPLE BUTTONS SHALL BE MOUNTED IN A SINGLE-GANG COVER.
  7. LIGHTING CONTROL PANEL SWITCH LESS. REFER TO LIGHTING CONTROL PANEL SCHEDULES AND DETAILS FOR ADDITIONAL INFORMATION. SWITCH LESS MAY BE ROUTED TO PANEL IN SAME CONDUITS AS CONSTANT POWER FEEDS. CONTRACTOR TO DERATE/UPSIZE CONDUCTORS & CONDUIT WHERE REQUIRED.
  8. PROVIDE DIMMING CONTROL TO RELAY PANEL. EXTEND TO ADDITIONAL FIXTURES IN SWITCH-GROUP PER MANUFACTURER'S WRITTEN INSTRUCTIONS.
  9. REINSTALL FIXTURE REMOVED DURING DEMOLITION. FIXTURE CALL OUT CORRESPONDS TO FIXTURE ID SHOWN ON DEMO PLAN AND IS NOT LISTED IN FIXTURE SCHEDULE.
  10. INTEGRATE NEW SWITCH INTO SWITCHING CONTROL.
  11. INTEGRATE SENSOR INDICATED INTO LIGHTING CONTROL SYSTEM.

- GENERAL SHEET NOTES**
1. ARCHITECTURAL CEILINGS SHOWN FOR CONTRACTOR CONVENIENCE IN BIDDING INSTALLATION REQUIREMENTS. REFER TO ARCHITECTURAL DRAWINGS FOR ADDITIONAL INFORMATION.
  2. CONTRACTOR TO FURNISH OCCUPANCY SENSORS WITH COVERAGE PATTERNS APPROPRIATE FOR THEIR INSTALLED LOCATIONS. COORDINATE WITH EQUIPMENT SUPPLIER PRIOR TO BID.
  3. CONNECT OCCUPANCY SENSORS TO ENABLE ALL SWITCHES IN CONTROLLED SPACE.
  4. CONNECT OCCUPANCY SENSORS, BATTERY BALLASTS, EXIT SIGNS, ETC. TO UNSWITCHED SOURCE CONDUCTOR.
  5. SEE POWER PLAN FOR ELECTRICAL DISTRIBUTION, EQUIPMENT AND LIGHTING RELAY PANEL LOCATIONS.
  6. EXISTING LIGHTING, ELECTRICAL AND ELECTRONIC DEVICES SHOWN LIGHT. NEW DEVICES SHOWN DARK.
  7. NEW DEVICES SHOWN ON EXISTING WALLS SHALL FINISH FLUSH WITH WALL UNLESS OTHERWISE NOTED. CUT, PATCH AND REPAIR SURFACES AS REQUIRED.
  8. ALL NEW LIGHTING CONTROLS (SWITCH, OCCUPANCY SENSORS, DIMMERS, ETC.) SHALL BE WATSTOPPER TO MATCH, AND INTEGRATE INTO EXISTING SYSTEM AND SHALL ALLOW SWITCHES AND SENSORS TO COMMUNICATE TO MEET MANUAL ON, AUTO OFF REQUIREMENTS OF ENERGY CODE.
  9. ALL EMERGENCY LIGHTING BATTERIES SHALL PROVIDE A MINIMUM OF 90 MINUTES ILLUMINATION PER NEC 700.12(A) AND IBC1006. SEE SPEC SECTION 265100 FOR ADDITIONAL REQUIREMENTS.

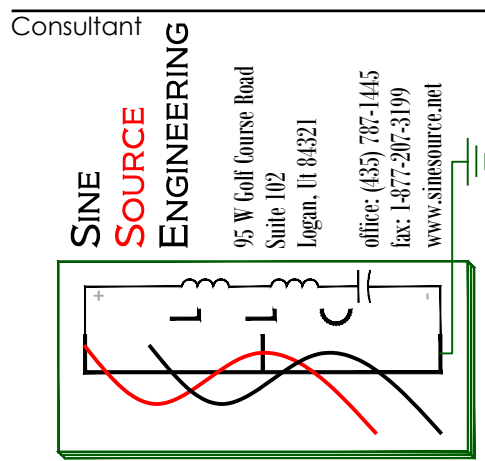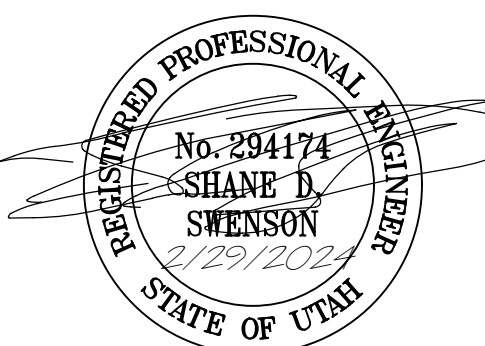

Project Name  
**JONES AND ASSOCIATES  
BUILDING ADDITION**

Issued

No.	Date	Description
1	09.21.23	PLAN REVIEW
2	02.29.24	PLAN REVIEW

Revision

No.	Date	Description
1	02.29.24	CITY REVIEW

SAA Project No. 2022-03  
Drawing Title

LIGHTING PLANS

Sheet Number  
**EL201**

LIGHT FIXTURE SCHEDULE											
TYPE	MANUFACTURER/CATALOG NO.	DESCRIPTION	MOUNTING	POWER	LAMPS	TYPE	MANUFACTURER/CATALOG NO.	DESCRIPTION	MOUNTING	POWER	LAMPS
EX- 1B	DUAL LITE LX-U-G-W-E-I SURE-LITES CCX7-0-70-G-WH-SD LIGHTOLIER LT-N-U-G-W-SD LITHONIA LOM S W 3 G 120/277 EL N SD OR EQUIVALENT	EXIT SIGN, SINGLE FACE; UNIVERSAL MOUNTING; WHITE, THERMOPLASTIC HOUSING; SELF DIAGNOSTICS; WIRE GUARD WHERE NOTED ON DRAWINGS	WALL OR CEILING 1-FACE	1.5W	LED	RL- L07 RL- L07(B)	LITHONIA LDN6-35-07-LO6-AR-LD-MVOLT-GZ1(-ELSD) OR EQUIVALENT	RECESSED CAN; LED LAMPING; CLEAR, OPEN, SEMI-SPECULAR CONE; 6" NOMINAL OPENING; SELF-FLANGED CONE; DIMMABLE; EM BATTERY WHERE NOTED ON DRAWINGS; TRIM EXTENDER WHERE REQUIRED	RECESS	8.9 W	1000 LUMEN NOMINAL LED 3500K
EX- 2B	DUAL LITE LX-U-G-W-E-I SURE-LITES CCX7-0-70-G-WH-SD LIGHTOLIER LT-N-U-G-W-SD LITHONIA LOM S W 3 G 120/277 EL N SD OR EQUIVALENT	EXIT SIGN, DOUBLE FACE; UNIVERSAL MOUNTING; WHITE, THERMOPLASTIC HOUSING; SELF DIAGNOSTICS; WIRE GUARD WHERE NOTED ON DRAWINGS	WALL OR CEILING 1-FACE	1.5W	LED	RL- L1K	LITHONIA LDN6-35-10-LO6-AR-LD-MVOLT-GZ1(-ELSD) OR EQUIVALENT	RECESSED CAN; LED LAMPING; CLEAR, OPEN, SEMI-SPECULAR CONE; 6" NOMINAL OPENING; SELF-FLANGED CONE; DIMMABLE; EM BATTERY WHERE NOTED ON DRAWINGS; TRIM EXTENDER WHERE REQUIRED	RECESS	12 W	1000 LUMEN NOMINAL LED 3500K
IR4- L4K(B)	LITHONIA SPX-2X4-7200LM-80CRI-35K-BFR-EDCB-MIN10-ZT-MVOLT(-E10WLCF)-MW OR EQUIVALENT	RECESSED, CENTER BASKET FLAT PANEL, MULTI-VOLT, ELECTRONIC, DIMMING, DRIVER; EM BATTERY PACK WHERE NOTED ON DRAWINGS;	RECESSED	53 W	7000 LUMEN NOMINAL LED 3500K	RL- L15 RL- L15(B)	LITHONIA LDN6-35-15-LO6-AR-LD-MVOLT-GZ1(-ELSD) OR EQUIVALENT	RECESSED CAN; LED LAMPING; CLEAR, OPEN, SEMI-SPECULAR CONE; 6" NOMINAL OPENING; SELF-FLANGED CONE; DIMMABLE; EM BATTERY WHERE NOTED ON DRAWINGS; TRIM EXTENDER WHERE REQUIRED	RECESS	17.5 W	1500 LUMEN NOMINAL LED 3500K
IR4- L7K	LITHONIA SPX-2X4-7200LM-80CRI-35K-BFR-EDCB-MIN10-ZT-MVOLT(-E10WLCF)-MW OR EQUIVALENT	RECESSED, CENTER BASKET FLAT PANEL, MULTI-VOLT, ELECTRONIC, DIMMING, DRIVER; EM BATTERY PACK WHERE NOTED ON DRAWINGS;	RECESSED	53 W	7000 LUMEN NOMINAL LED 3500K	RW- L1K	LITHONIA LDN6-40-10-LO6-AR-LD-MVOLT-GZ1(-ELSD) OR EQUIVALENT	RECESSED CAN; LED LAMPING; MULTI-VOLT, ELECTRONIC, DIMMABLE DRIVER; 6" NOMINAL OPENING; CLEAR, SEMI-SPECULAR CONE; WET LOCATION RATED; EM BATTERY WHERE (B) OPTION SHOWN ON DRAWINGS	RECESS	10.4 W	1000 LUMEN NOMINAL LED 4000K
LD4- L4K LD4- L4K(B)	ARCH LTG WORKS FBD-S4-HI-80-3500K-010V/1%-EXT-R-SCBA-UNV(-EMB)-* OR EQUIVALENT WITH PRIOR ARCHITECTURAL APPROVAL	SUSPENDED LINEAR, 1.75" MAX WIDTH, 3" MAX HEIGHT, MULTI-VOLT, ELECTRONIC, DIMMABLE (1%), DRIVER; INTEGRAL DRIVER; SUSPENSION LENGTH AS INDICATED ON ARCHITECTURAL DRAWINGS; CUSTOM COLOR AS SELECTED BY ARCHITECT; EM PROVISIONS WHERE (B) OPTION INDICATED ON DRAWINGS	CABLE SUSPENDED WOOD CEILING	37 W	4000 LUMEN NOMINAL LED 3500K	RW- L15 RW- L15(B)	LITHONIA LDN6-40-15-LO6-AR-LD-MVOLT-GZ1(-ELSD) OR EQUIVALENT	RECESSED CAN; LED LAMPING; MULTI-VOLT, ELECTRONIC, DIMMABLE DRIVER; 6" NOMINAL OPENING; CLEAR, SEMI-SPECULAR CONE; WET LOCATION RATED; EM BATTERY WHERE (B) OPTION SHOWN ON DRAWINGS	RECESS	17.5 W	1500 LUMEN NOMINAL LED 4000K
LG2- L35 LG2- L35(B)	LITHONIA SPX-2X2-3400LM-80CRI-35K-BFR-MPL-MIN10-ZT-MVOLT(-E10WLCF)-MW OR EQUIVALENT	RECESSED, FLAT PANEL, MULTI-VOLT, ELECTRONIC, DIMMING, DRIVER; EM BATTERY PACK WHERE NOTED ON DRAWINGS;	RECESSED	23 W	3500 LUMEN NOMINAL LED 3500K	S4- L5K S4- L5K(B)	LITHONIA CLX-148-5000LM-SEF-FDL-MVOLT-GZ10-35K-80CRI-(PS1050)-SCBA HE WILLIAMS 75-4-L50-840-DIM-UNV OR EQUIVALENT	LED STRIP FIXTURE; MULTI-VOLT, ELECTRONIC, DIMMABLE DRIVER; DIFFUSE LENS; EM BATTERY WHERE NOTED ON DRAWINGS	SURFACE OR CABLE SUSPENDED WHERE NOTED	35 W	5000 LUMEN NOMINAL LED 3500K
OW3- L2K OW3- L2K(B)	LITHONIA WDG2-LED-P2-40K-80CRI-FW-MVOLT-(-E20WC)-SCBA OR EQUIVALENT	EXTERIOR WALL FIXTURE; LED LAMPING, TYPE 3 OPTICAL DISTRIBUTION; MULTI-VOLT, ELECTRONIC, DIMMABLE DRIVER; INTEGRAL BATTERY WHERE (B) OPTION INDICATED ON LTG PLAN;	WALL	15 W	2000 LUMEN NOMINAL LED 4000K						

NOTES  
1- CONTRACTOR SHALL VERIFY COLOR TEMPERATURE FOR INTERIOR AND EXTERIOR FIXTURES WITH EXISTING LIGHTING COLOR TEMPERATURE PRIOR TO FIXTURE RELEASE

LIGHT FIXTURE ACCESSORY APPEND									
B	AS SPECIFIED	APPENDED TO FIXTURE TYPE: 1100 LUMEN EM BATTERY SUPPLY	AS SPECIFIED	N/A	PER FIXTURE TYPE				
NOTES	FIXTURE APPENDS ARE ADDED TO STANDARD FIXTURE TYPES. APPENDS ARE INTENDED TO MODIFY FIXTURE CATALOG NUMBERS GIVEN ABOVE AS NOTED IN APPEND DESCRIPTION								

NOTES  
FIXTURE APPENDS ARE ADDED TO STANDARD FIXTURE TYPES. APPENDS ARE INTENDED TO MODIFY FIXTURE CATALOG NUMBERS GIVEN ABOVE AS NOTED IN APPEND DESCRIPTION



RELAY PANEL SCHEDULE									
RELAY PANEL	FEEDS	REMARKS	LOCATION	MOUNTING					
ZLC1	INDIVIDUAL MAIN LUGS MAIN BKR	-PANEL TO BE WATTSTOPPER TO MATCH EXISTING -PROVIDE DIMMING CONTROL WIRING PER LOAD TYPE THROUGHOUT CIRCUIT	L2 HALL	FLUSH SURFACE					
X NEW EXISTING	MAX VOLTAGE 240 MAX PHASE 1								

No.	RELAY	CONTROLLED CKT	CONTROL ZONE	CONTROL TYPE (SEE SCHEDULE)	DIMMING* (SEE SCHED)	No.	No.	CONTROL TYPE (SEE SCHEDULE)	DIMMING* (SEE SCHED)	CONTROL ZONE	CONTROLLED CKT	RELAY	No.
1	20	A2-1	LOBBY	T1.B1.SS	D1	1	2	T1.B1.SS.03.S4	N/A	L2 HALL	A2-5	20	1 2
3	20	A2-3	L1 HALL	T1.B1.SS.02.S2	N/A	3	4	T1.B1.SS.01.S3	N/A	N STAIR	A2-5	20	1 4
5	20	A2-3	RECEPTION	T1.B1.SS	D2	5	6	T1.B1.SS.01.S1	N/A	E STAIR	A2-5	20	1 6
7	20	SPA RE				7	8	T2.B1.SS.P1	FUTURE	ADTN EXT	A2-9	20	1 8
9	20	SPA RE				9	10				SPA RE	20	1 10
11	20	SPA RE				11	12				SPA RE	20	1 12




CLK = TIMECLOCK  
SW = SWITCH (1, 3, OR 4)  
OVER = 2-HOUR TIMED OVERRIDE ON PHOTO = PHOTOCELL

DETAIL KEYED NOTES

- PROVIDE LIGHTING CONTROL PANEL WITH ALL OPTIONS NECESSARY TO PROVIDE CONTROLS AS SHOWN AND SPECIFIED.
- SEE LIGHTING PLANS ON ELXXX SERIES SHEETS FOR DIGITAL, ADDRESSABLE SWITCH LOCATIONS. PROGRAM FOR CONTROL AS SCHEDULED. PROVIDE ENGRAVED COVER PLATES AS DESCRIBED ON ELXXX SHEETS. (\*) INDICATES CONTROL TYPE.
- COORDINATE CONNECTIONS WITH OWNER'S SECURITY SYSTEM PROVIDER.
- PROVIDE CONTROL WIRING PER EQUIPMENT REQUIREMENTS.
- PROVIDE HOME-RUN OR DAISY CHAIN WIRING PER EQUIPMENT REQUIREMENTS.
- PROVIDE INTERIOR AND/OR EXTERIOR PHOTOCELLS. REFER TO LIGHTING PLAN FOR INTERIOR COUNTS AND LOCATIONS. PROVIDE (1) EXTERIOR SENSOR ROOF MOUNTED PER MANUFACTURER RECOMMENDATIONS. (\*) INDICATES CONTROL TYPE.
- REFER TO LIGHTING PLANS FOR SWITCHING GROUPS/HOME RUNS.
- PROVIDE CONSTANT POWER TO EXIT SIGNS, EM BALLASTS, NIGHT-LIGHTS, OCCUPANCY SENSORS, ETC.
- PROVIDE LAN CONNECTION TO CONTROL PANEL FOR REMOTE OWNER CONTROL. PROVIDE ALL HARDWARE/PROGRAMMING REQUIRED FOR SYSTEM INTERFACES AS SPECIFIED.
- PROVIDE OCCUPANCY SENSORS/RELAYS COMPATIBLE WITH LIGHTING CONTROL SYSTEM. SENSORS MAY BE USED FOR LOCAL AND SYSTEM CONTROL. (\*) INDICATES CONTROL TYPE.
- REFER TO LIGHTING PLANS FOR DIMMING GROUPS/HOME-RUNS. INCLUDE DIMMING CONTROL WIRE PER SYSTEM/FIXTURE REQUIREMENTS.
- INTEGRATE NEW SYSTEM INTO EXISTING SYSTEM AS REQUIRED.

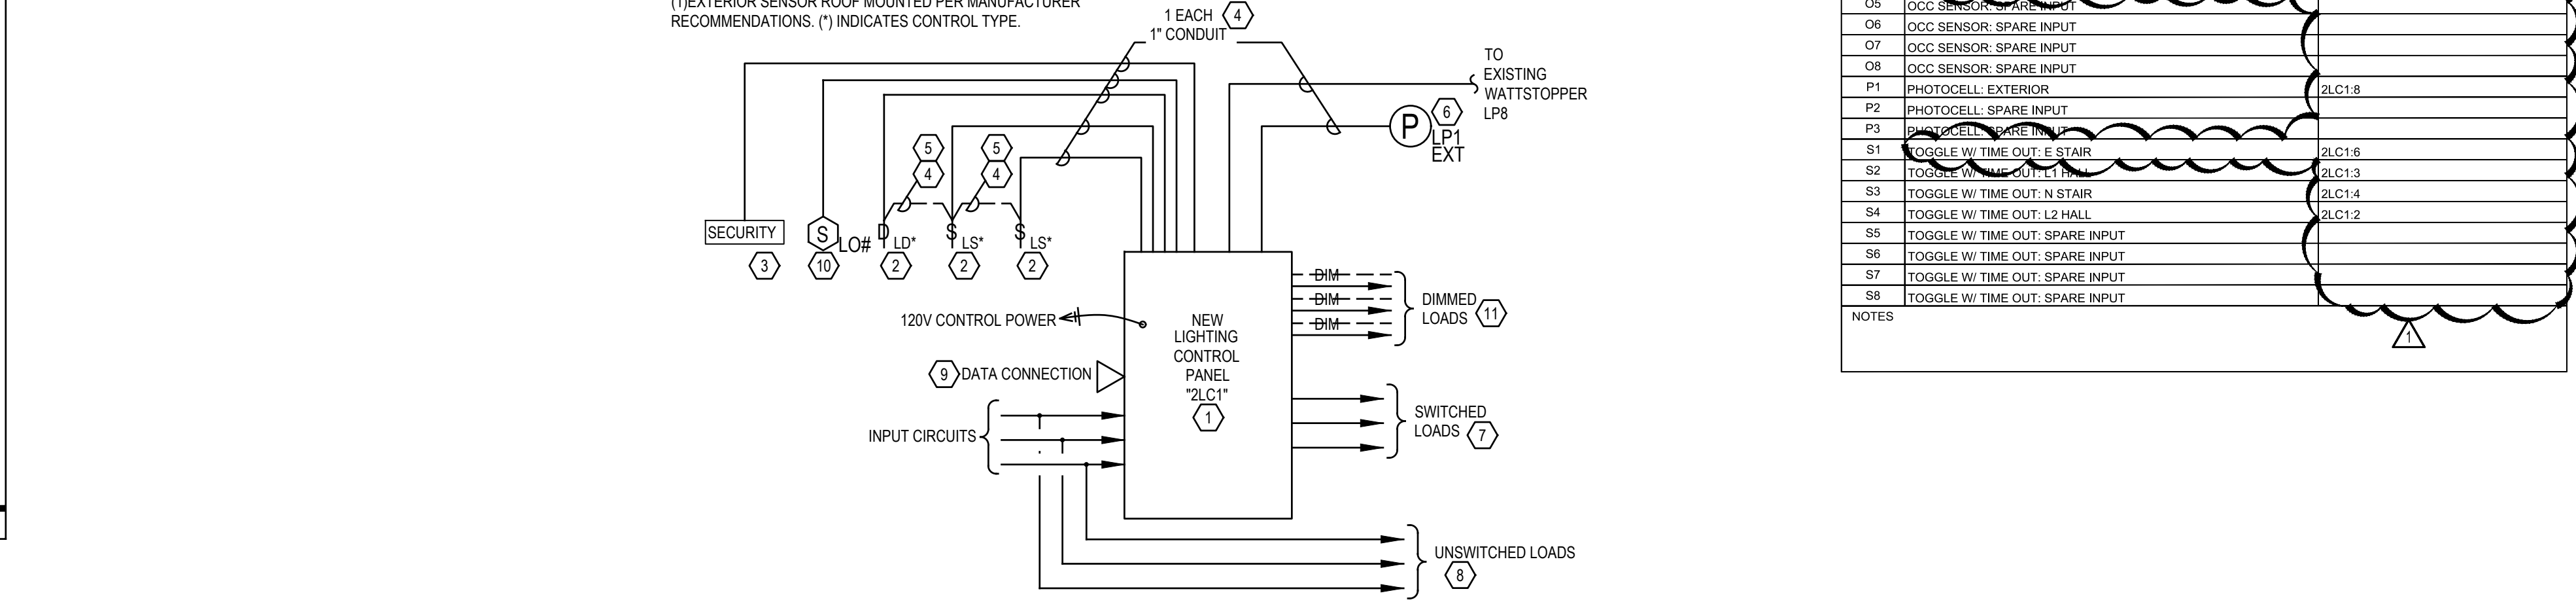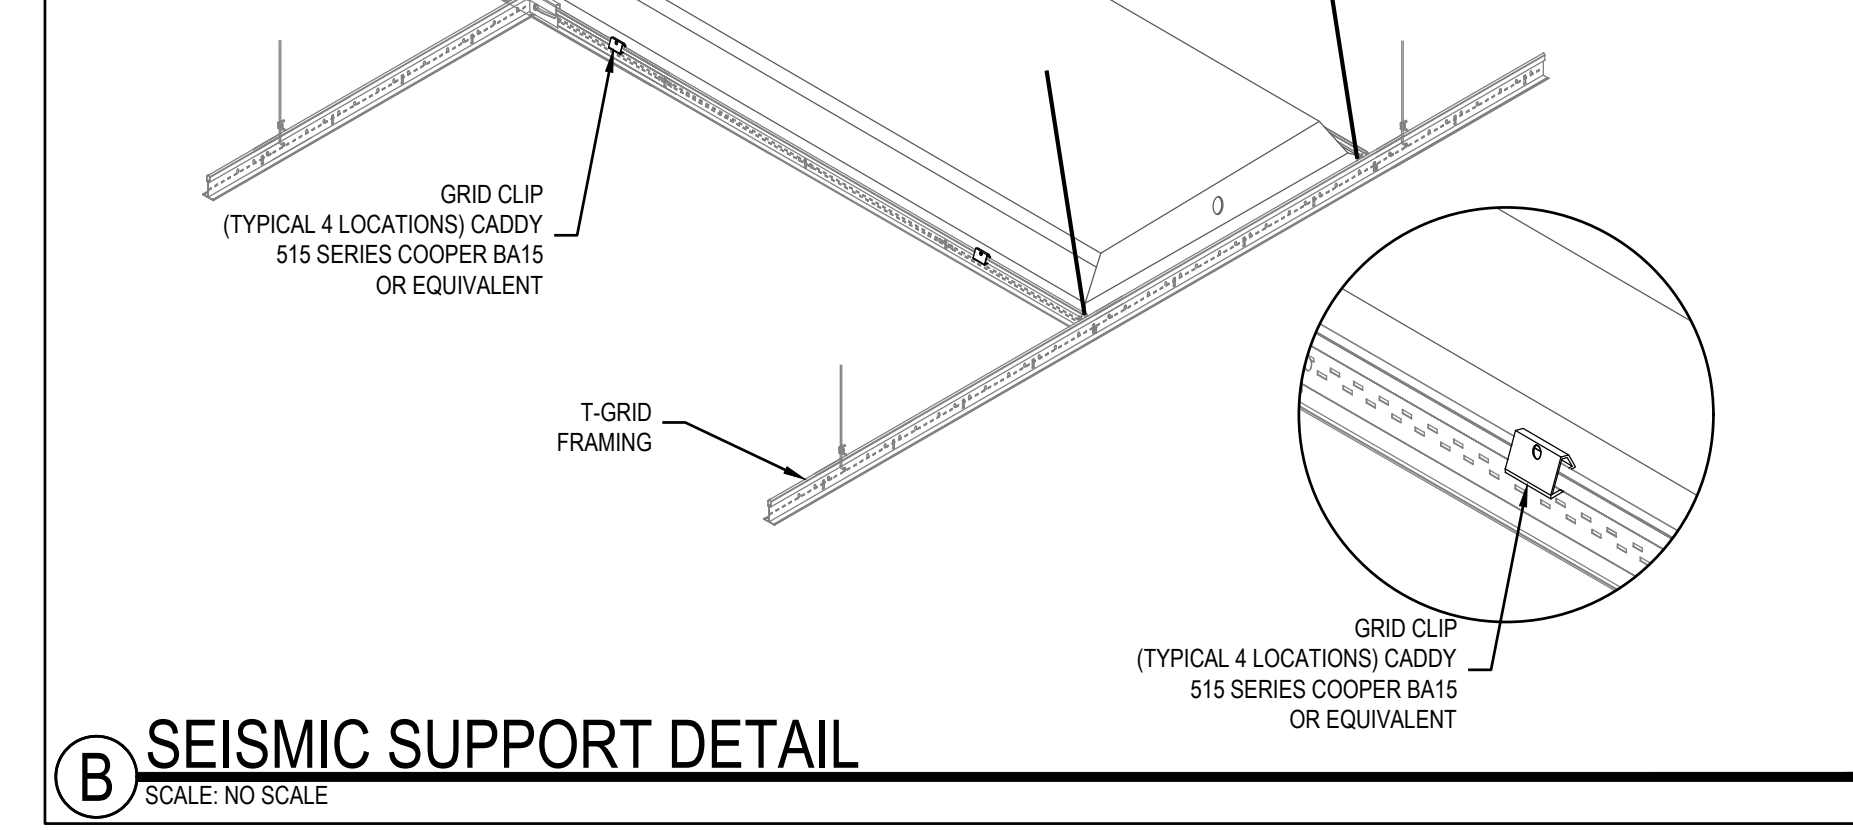

LIGHTING CONTROL INPUT SCHEDULE		
TYPE	DESCRIPTION	CONTROLLED RELAY
T1	INTERIOR TIMECLOCK ON/OFF (SCHEDULE PER OWNER)	ZLC1:1-6,8
T2	EXTERIOR TIMECLOCK ON/OFF (ON AT DUSK, OFF PER OWNER)	ZLC1:8
SS	SECURITY SYSTEM INTERFACE	ZLC1:1-6,8
B1	BLINK WARNING	
D1	TOGGLE W/ TIME OUT + DIMMING; LOBBY	ZLC1:1
D2	TOGGLE W/ TIME OUT + DIMMING; RECEPTION	ZLC1:5
D3	TOGGLE W/ TIME OUT + DIMMING; SPARE INPUT	
D4	TOGGLE W/ TIME OUT + DIMMING; SPARE INPUT	
D5	TOGGLE W/ TIME OUT + DIMMING; SPARE INPUT	
D6	TOGGLE W/ TIME OUT + DIMMING; SPARE INPUT	
D7	TOGGLE W/ TIME OUT + DIMMING; SPARE INPUT	
D8	TOGGLE W/ TIME OUT + DIMMING; SPARE INPUT	
O1	OCC SENSOR; N STAIR	ZLC1:4
O2	OCC SENSOR; L1 HALL	ZLC1:3
O3	OCC SENSOR; E STAIR	ZLC1:2
O4	OCC SENSOR; E STAIR	ZLC1:6
O5	OCC SENSOR; SPARE INPUT	
O6	OCC SENSOR; SPARE INPUT	
O7	OCC SENSOR; SPARE INPUT	
O8	OCC SENSOR; SPARE INPUT	
P1	PHOTOCELL; EXTERIOR	ZLC1:8
P2	PHOTOCELL; SPARE INPUT	
P3	PHOTOCELL; SPARE INPUT	
S1	TOGGLE W/ TIME OUT; E STAIR	ZLC1:6
S2	TOGGLE W/ TIME OUT; L1 HALL	ZLC1:3
S3	TOGGLE W/ TIME OUT; N STAIR	ZLC1:4
S4	TOGGLE W/ TIME OUT; L2 HALL	ZLC1:2
S5	TOGGLE W/ TIME OUT; SPARE INPUT	
S6	TOGGLE W/ TIME OUT; SPARE INPUT	
S7	TOGGLE W/ TIME OUT; SPARE INPUT	
S8	TOGGLE W/ TIME OUT; SPARE INPUT	

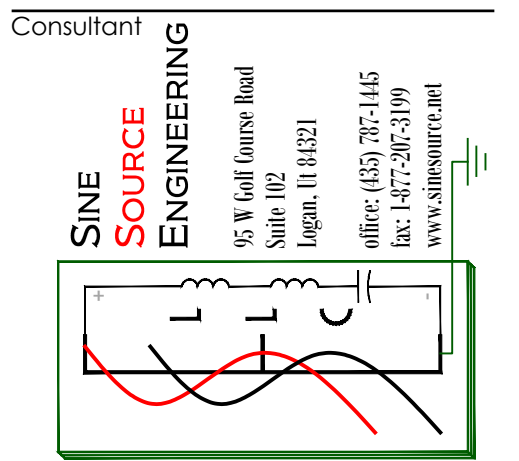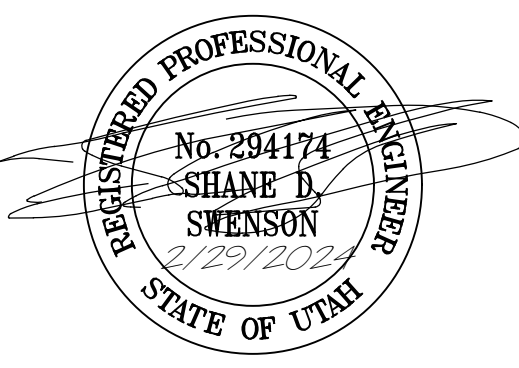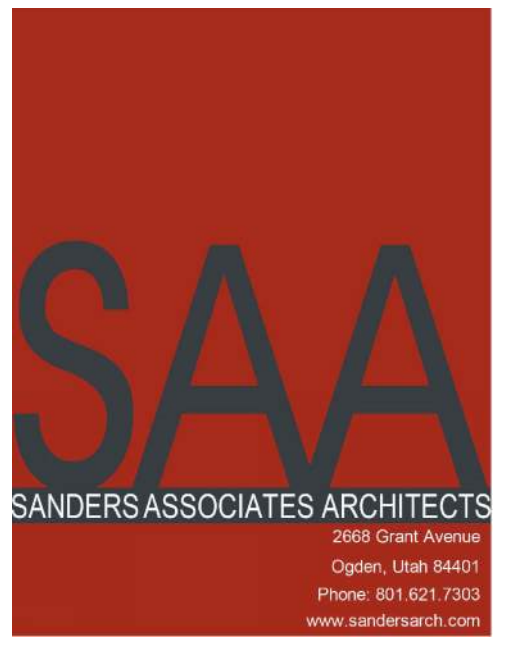

**JONES AND ASSOCIATES**  
BUILDING ADDITION

Project Name

Issued	No.	Date	Description
	1	09.21.23	PLAN REVIEW
	2	02.29.24	PLAN REVIEW

Revision

No.	Date	Description
1	02.29.24	CITY REVIEW

SAA Project No. 2022-03  
Drawing Title


**LIGHTING DETAILS**

Sheet Number


**EL501**

TIME: 15 OCT 2014 - 12:25PM DONALD J. PATTON - TJ00852023068 JONES ASSOCIATES EXPANSION001 DRAWINGS005 ELECTRICALSINE SOURCE PROJECTSHEETS/EL501 LIGHTING DETAILS.DWG LAST SAVED: 20 FEB 24

TIME: 15 OCT 2014 - 12:25PM DONALD J. PATTON - T:\JOBS\2023088 JONES ASSOCIATES EXPANSION\01 DRAWINGS\05 ELECTRICAL\SOURCE PROJECTS\EP301 POWER PLANS.DWG  
 LAST SAVED: 29 Feb 24

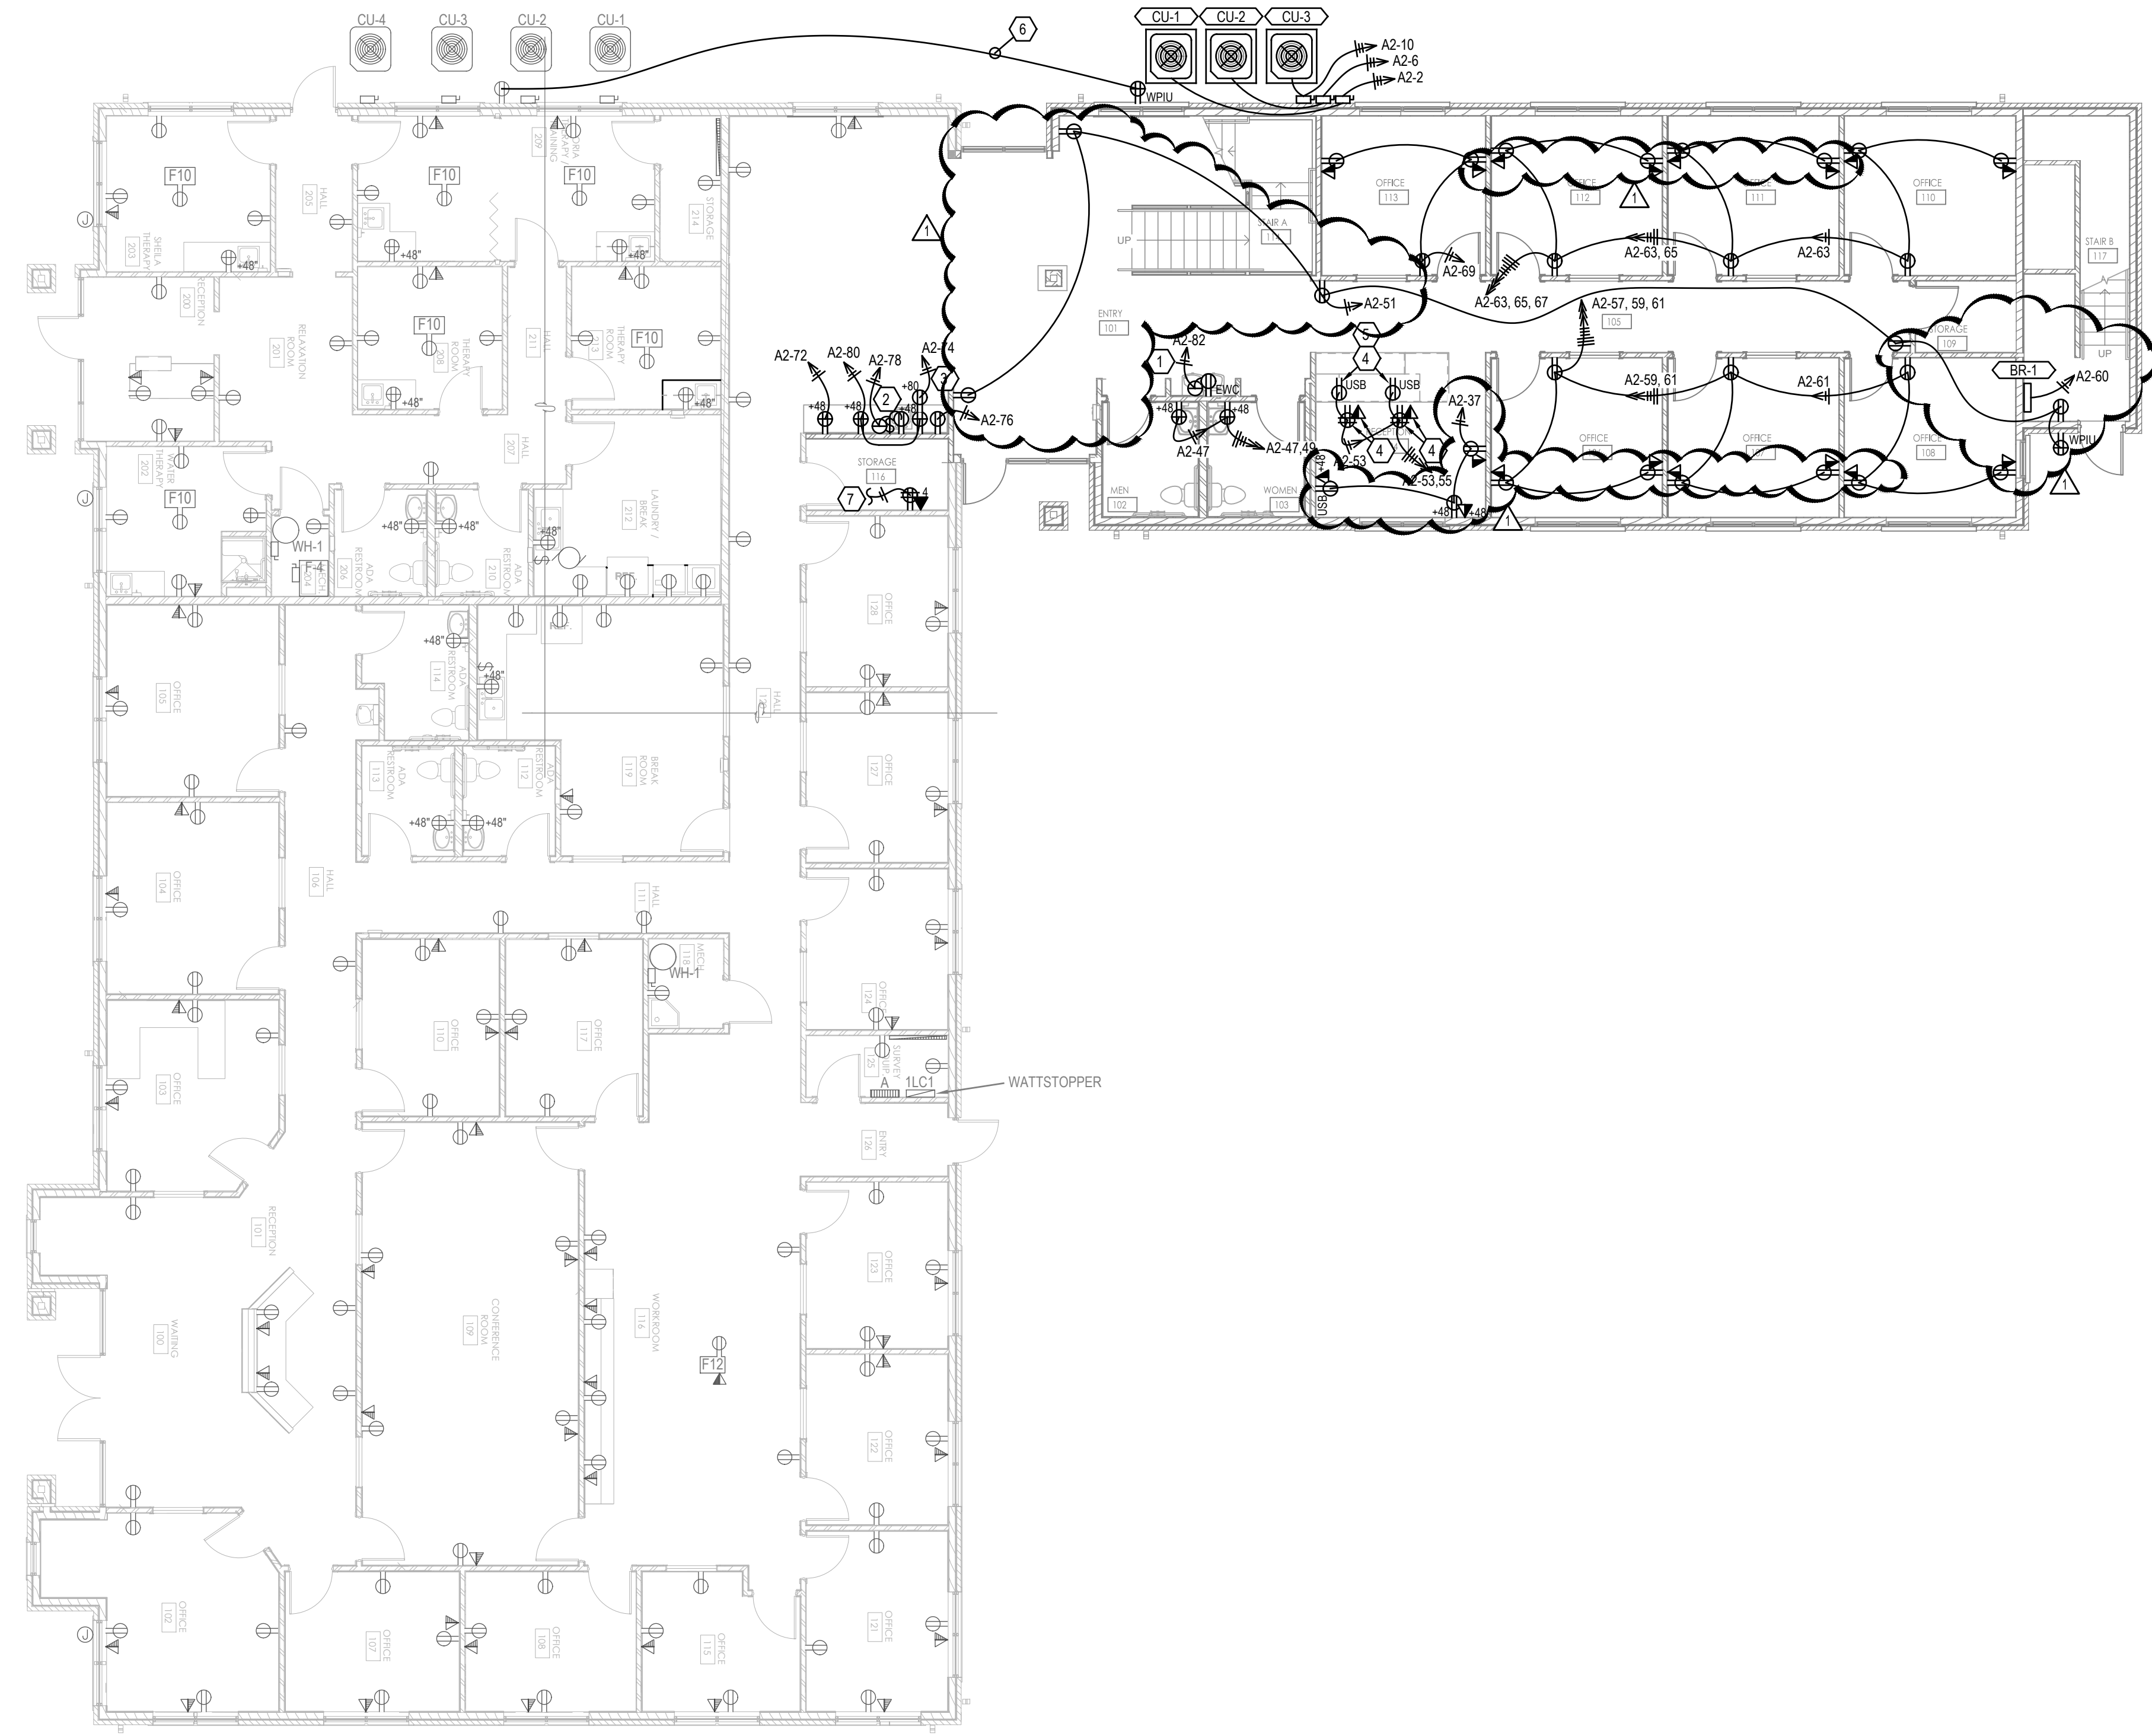


**1** POWER PLANS: MAIN FLOOR  
 SCALE: 1/8" = 1'-0"

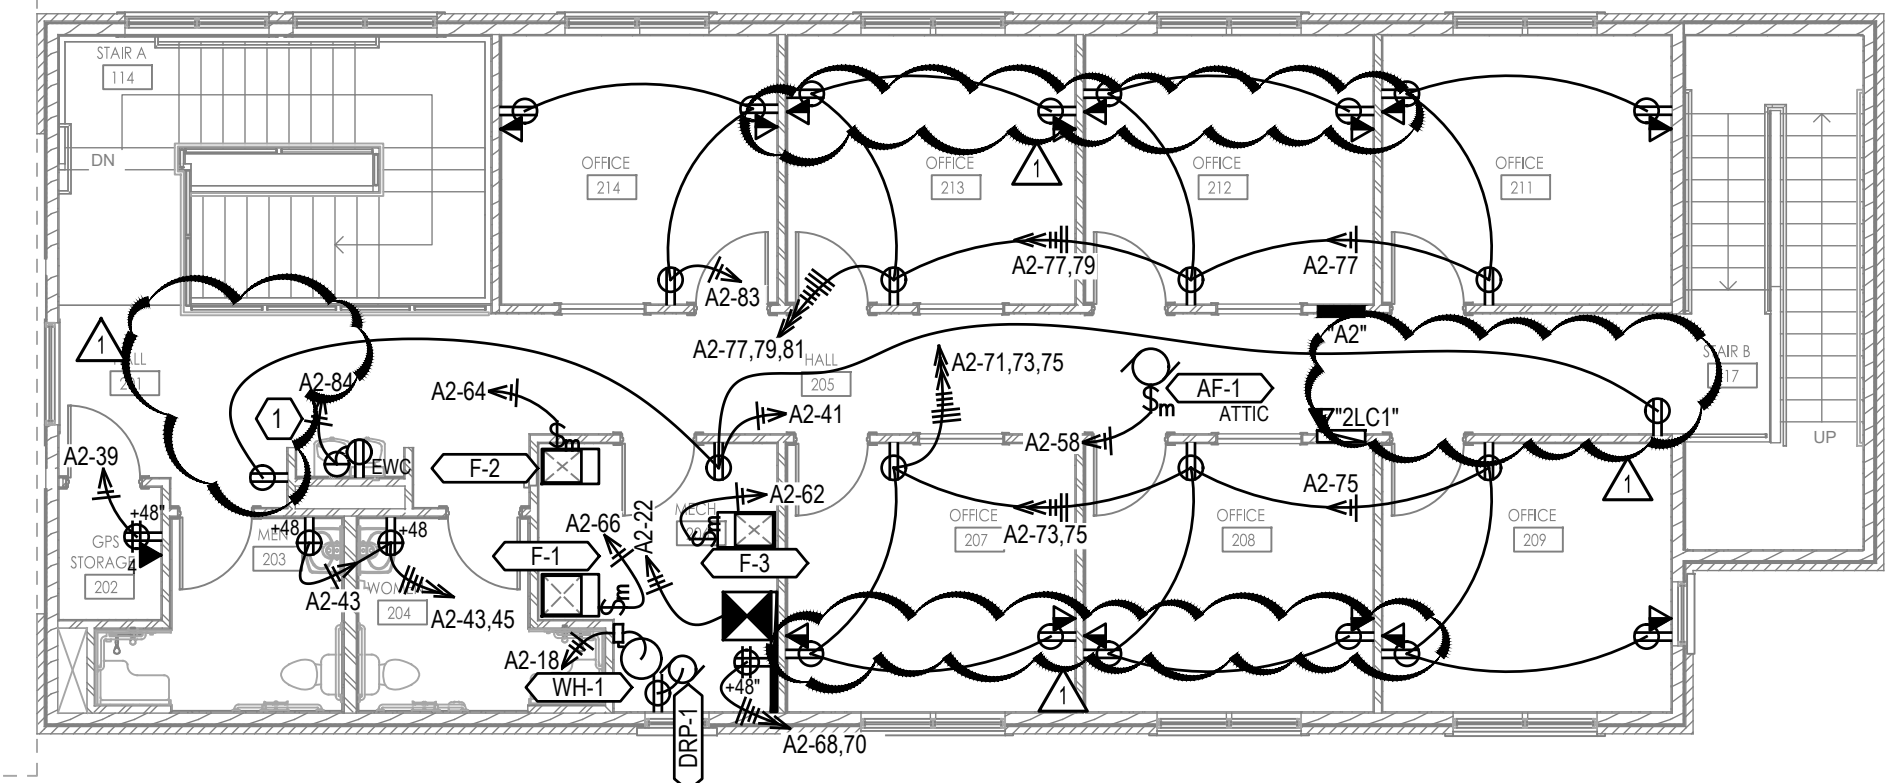

**2** POWER PLANS: UPPER FLOOR  
 SCALE: 1/8" = 1'-0"

- SHEET KEYED NOTES**
1. MOUNT EWC OUTLET BEHIND COOLER COVER. ROUTE CIRCUIT THROUGH FACELESS GFCI (LEVITON 7590 OR EQUIVALENT) MOUNTED BELOW COOLER COVER PER DETAIL D1EP501.
  2. PROVIDE SWITCHED RECEPTACLE UNDER BASIN FOR DISPOSAL. DISPOSAL BY OTHERS. COORDINATE DISPOSAL CORD WITH PLUMBING CONTRACTOR AND PROVIDE AND/OR INSTALL CORD AS REQUIRED. ROUTE CIRCUIT THROUGH FACELESS GFCI (LEVITON 7590 OR EQUIVALENT) MOUNTED ABOVE COUNTER LEVEL WITH COUNTER-TOP OUTLETS. LABEL GFCI FOR APPLIANCE SERVED.
  3. PROVIDE POWER TO MICROWAVE. MOUNT OUTLET IN LOWER CORNER OF UPPER CABINET PER DETAIL B1EP501.
  4. OUTLETS MOUNTED IN MILLWORK. COORDINATE WITH CABINET SUPPLIER.
  5. MOUNT OUTLET HORIZONTAL IN RISER BETWEEN UPPER AND LOWER COUNTERS. SEE ARCHITECTURAL DETAILS FOR ADDITIONAL INFORMATION.
  6. CONNECT TO EXISTING CIRCUIT INDICATED.
  7. CONNECT TO EXISTING CIRCUIT PREVIOUSLY SERVING SPACE.

- GENERAL SHEET NOTES**
1. COORDINATE ALL SWITCH, OUTLET, LIGHT AND OTHER DEVICE LOCATIONS WITH ARCHITECTURAL ELEMENTS (CABINETS, WINDOWS ETC.) PRIOR TO ROUGH-IN. REVIEW ARCHITECTURAL INTERIOR ELEVATIONS PRIOR TO ROUGH-IN OF EACH AREA FOR ADDITIONAL INFORMATION.
  2. SEE SYMBOL SCHEDULE AND COMMUNICATIONS RACEWAY SCHEDULE FOR COMMUNICATIONS ROUGH-IN REQUIREMENTS.
  3. EXISTING LIGHTING, ELECTRICAL AND ELECTRONIC DEVICES SHOWN LIGHT. NEW DEVICES SHOWN DARK.
  4. NEW DEVICES SHOWN ON EXISTING WALLS SHALL FINISH FLUSH WITH WALL UNLESS OTHERWISE NOTED. CUT, PATCH AND REPAIR SURFACES AS REQUIRED.
  5. SURFACE MOUNTED CONDUITS RAN ON ROOF-TOP OR WITHIN 36" OF ROOF-TOP NOT ALLOWED.

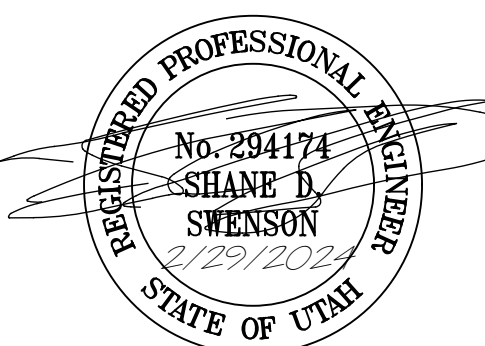

Consultant  
**SINE SOURCE ENGINEERING**  
 15 W. Wall Avenue Blvd  
 Suite 102  
 Engen, UT 84021  
 office: (435) 707-1115  
 fax: (435) 707-3109  
 www.sinesource.com

Project Name  
**JONES AND ASSOCIATES**  
**BUILDING ADDITION**

Issued		
No.	Date	Description
1	09.21.23	PLAN REVIEW
2	02.29.24	PLAN REVIEW


Revision		
No.	Date	Description
1	02.29.2024	CITY REVIEW

SAA Project No. 2022-03  
 Drawing Title


**POWER PLANS**

Sheet Number  
**EP301**

TIME: 15 OCT 2024 - 12:25PM DONALD J. PATTON - T:\JOBS\2023088 JONES ASSOCIATES EXPANSION\01 DRAWINGS\05 ELECTRICAL\SOURCE PROJECTS\ET401 ELECTRONIC SYSTEMS PLANS.DWG  
 LAST SAVED: 29 Feb 24

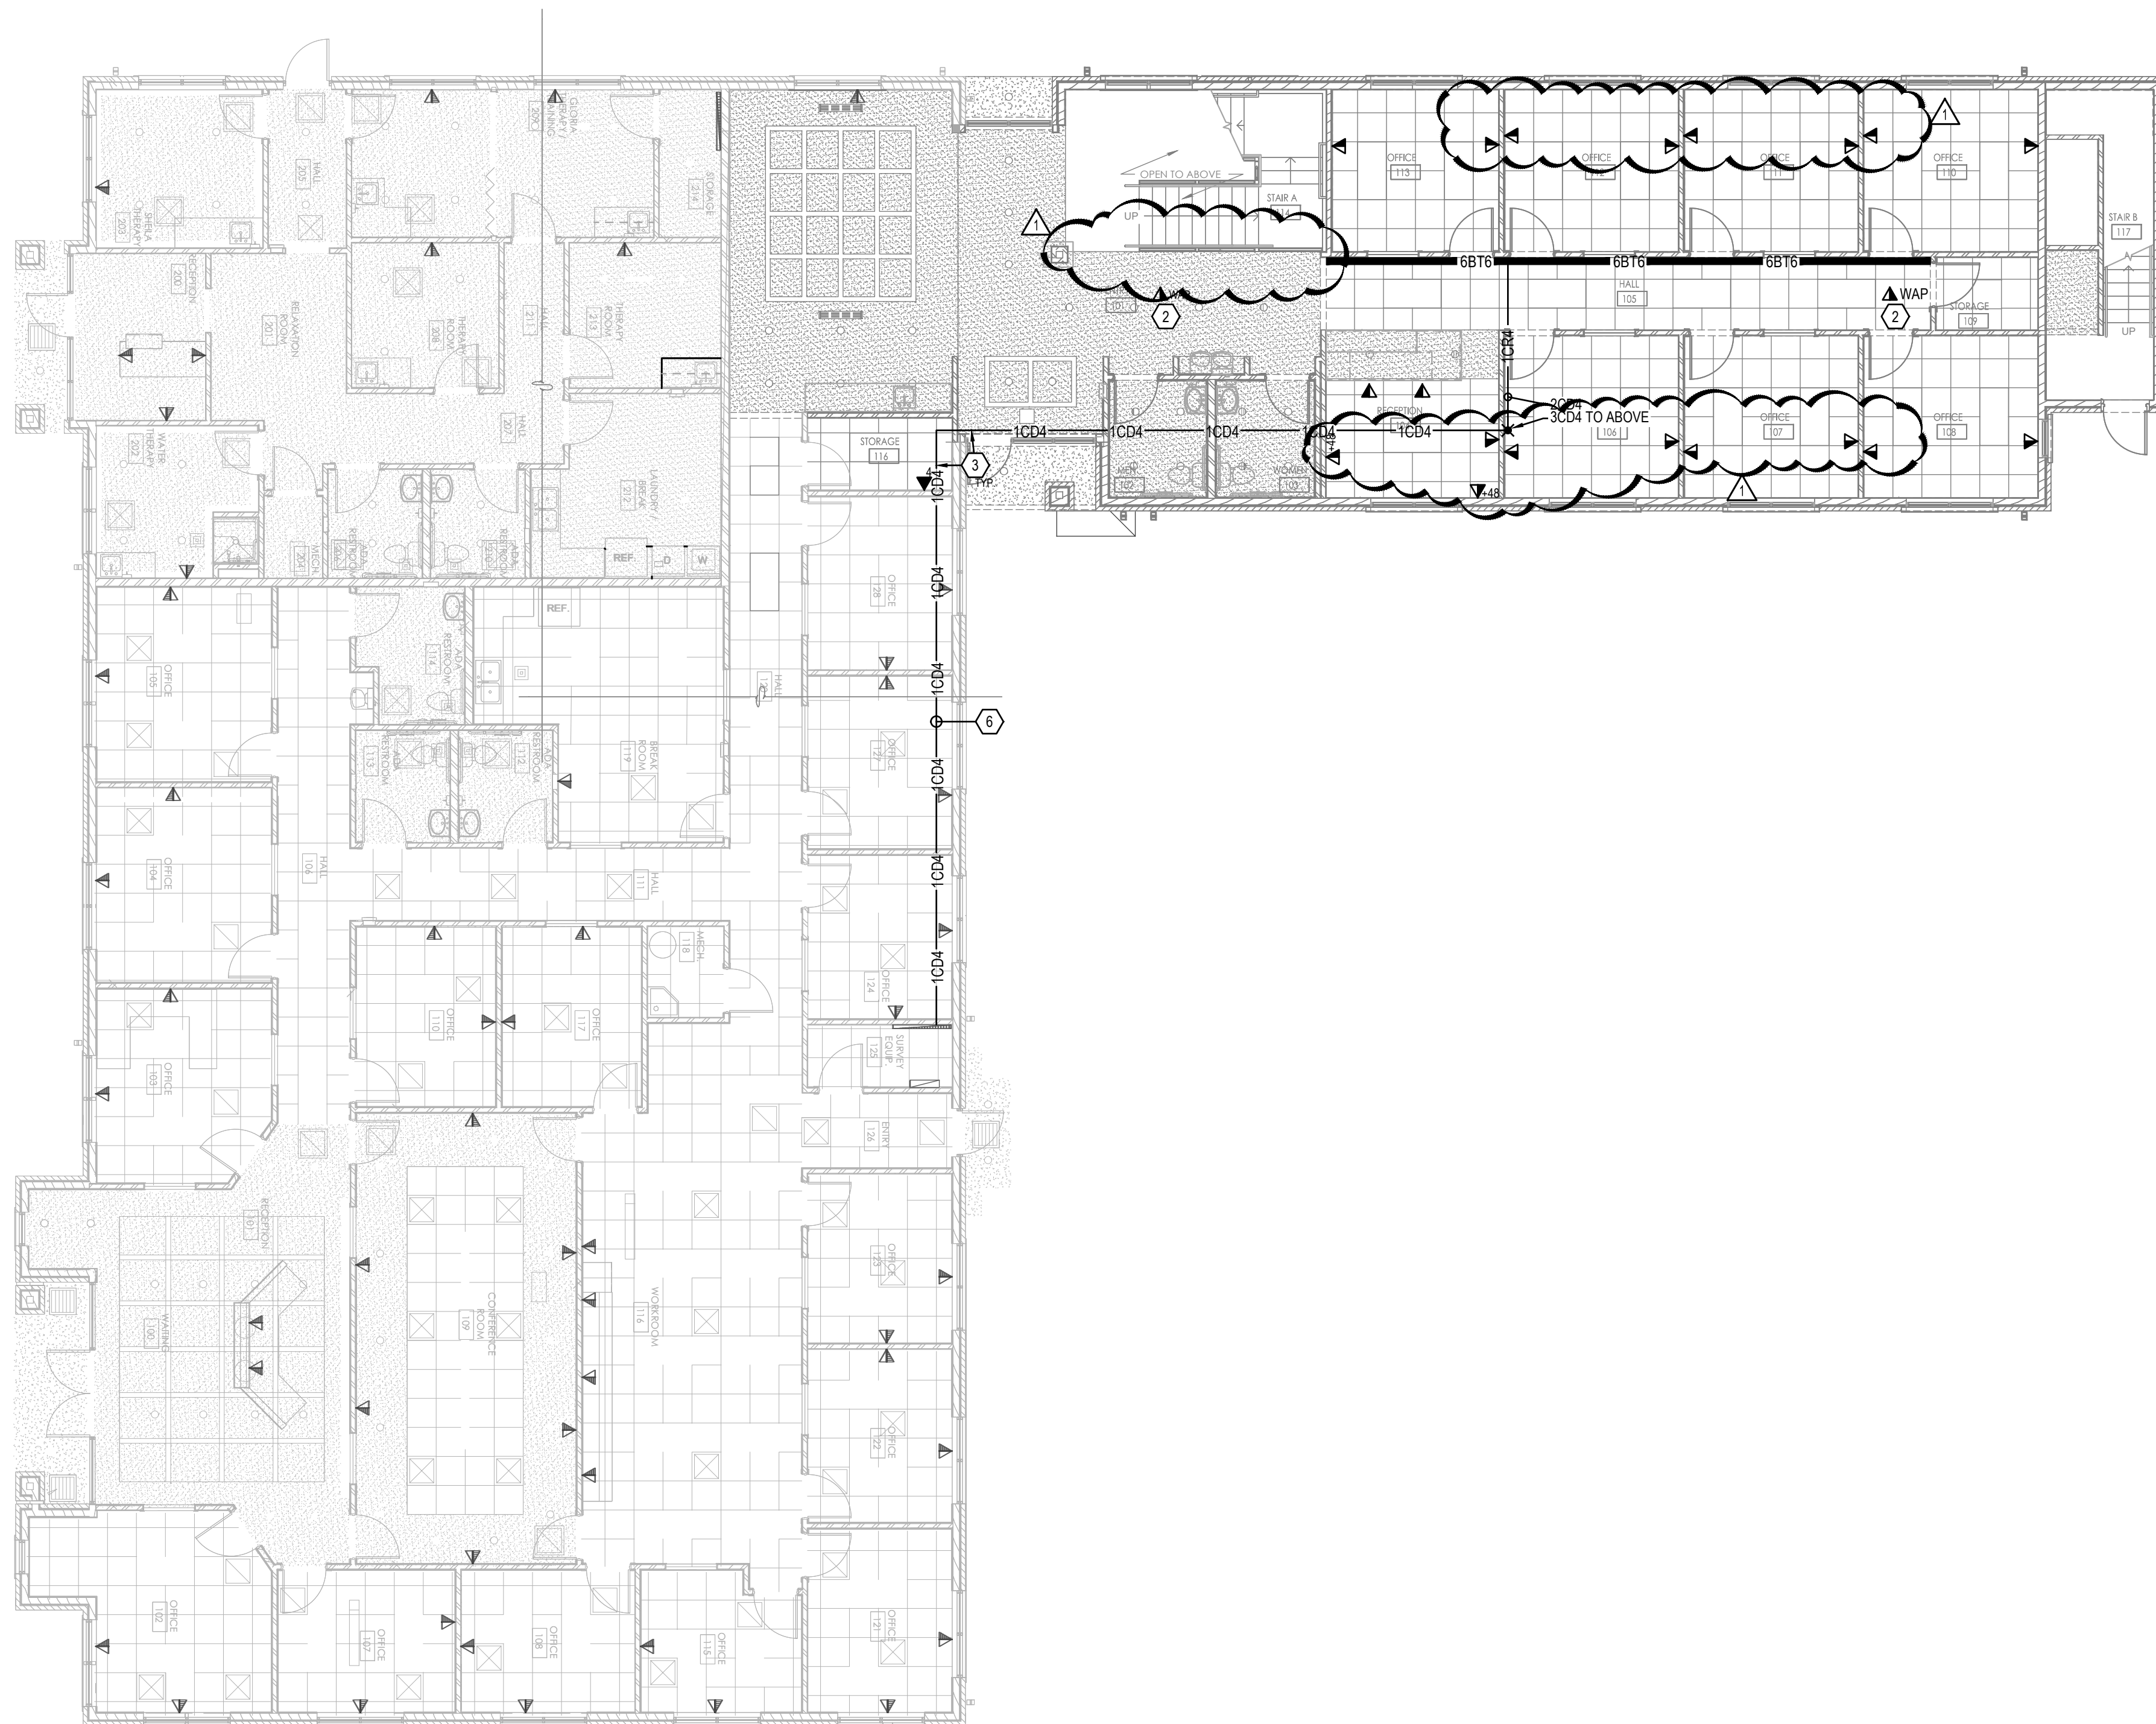

**1** ELECTRONIC SYSTEMS PLAN: MAIN FLOOR  
 SCALE: 1/8" = 1'-0"

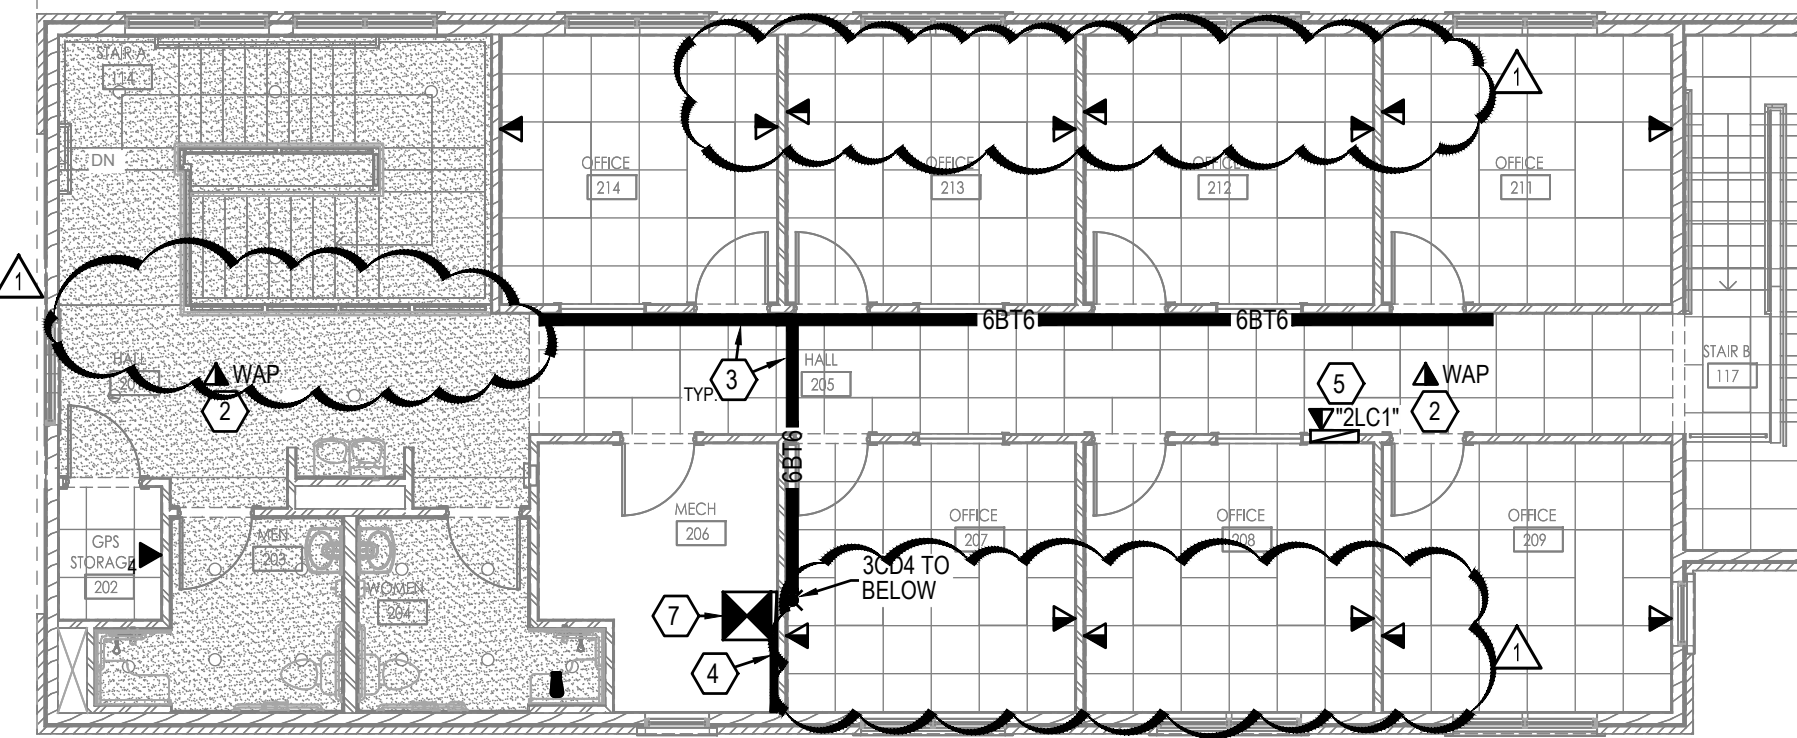


**2** ELECTRONIC SYSTEMS PLAN: UPPER FLOOR  
 SCALE: 1/8" = 1'-0"

- SHEET KEYED NOTES**
1. PROVIDE ROUGH-IN FOR FUTURE CONNECTIONS OUTLET.
  2. PROVIDE CEILING OUTLET FOR WIRELESS ACCESS POINT. COORDINATE WITH OWNERS I.T. PERSONNEL PRIOR TO ROUGH-IN.
  3. PROPOSED ROUTING OF COMMUNICATIONS RACEWAYS.
  4. PROVIDE 4x8' PLYWOOD BACKBOARD MOUNTED VERTICALLY ALONG WALL INDICATED.
  5. PROVIDE DATA CONNECTION TO LIGHTING CONTROL PANEL AS REQUIRED.
  6. PROVIDE 4" CONDUIT WITH 1" INNERDUCT TO EXISTING RACK. PROVIDE FIBER TERMINAL CONDUITS IN NEW AND EXISTING RACKS WITH 2 PAIR, SINGLE MODE FIBER BETWEEN RACKS.
  7. PROVIDE 60" WALL MOUNT DATA RACK. PROVIDE 48-PORT PATCH PANELS (AS NEEDED) UFFER CABLES + 50% SPARE CAPACITY). PROVIDE 2KVA, RACK MOUNT UPS.

- GENERAL SHEET NOTES**
1. ARCHITECTURAL CEILINGS SHOWN FOR CONTRACTOR CONVENIENCE IN BIDDING INSTALLATION REQUIREMENTS. REFER TO ARCHITECTURAL DRAWINGS FOR ADDITIONAL INFORMATION.
  2. PROVIDE COMMUNICATIONS OUTLET BOX AS SCHEDULED WITH 1.25" CONDUIT TO COMMUNICATIONS RACEWAY FOR EACH COMMUNICATIONS OUTLET SHOWN.
  3. SEE SYMBOL SCHEDULE AND COMMUNICATIONS RACEWAY SCHEDULE FOR COMMUNICATIONS BOXES, RACEWAYS, AND CABLING REQUIREMENTS.
  4. PROVIDE INDUSTRY STANDARD CADDIE CLIPS 4" ON CENTER FROM OUTLET CONDUIT STUBS TO CABLE TRAYS. COMPLY WITH TIA/EIA CATEGORY 6A STANDARDS FOR COMMUNICATIONS RACEWAY INSTALLATIONS.
  5. NEW DEVICES SHOWN ON EXISTING WALLS SHALL FINISH FLUSH WITH WALL UNLESS OTHERWISE NOTED. CUT, PATCH AND REPAIR SURFACES AS REQUIRED.

**COMMUNICATIONS RACEWAY SCHEDULE**

SYMBOL	DESCRIPTION	MANUFACTURER	MODEL	ACCESSORIES
xCDy	CONDUIT; QUANTITY "X", DIAMETER "Y" AS INDICATED ON SYMBOL SCHEDULE	AS SPECIFIED		INSULATED THROAT CONNECTORS ON ALL ENDS; PULL STRING
CMJ	CABLE HOOKS; 4"; RETAINING CLIP QUANTITY AS REQUIRED FOR CURRENT CABLING PLUS 50% SPARE CAPACITY	COOPER B-LINE	BCH64 SERIES (OR EQUIVALENT)	RETAINER (BCHR64) OTHER ACCESSORIES AS REQUIRED
xBTy	X"W X Y"D STEEL WIRE MESH TRAY MAXIMUM 6" SUPPORT SPACING (MIN 83 LBS/FT LOAD CAPACITY)	COOPER	FT(X)Y(-)EG SERIES (OR EQUIVALENT)	ACCESSORIES AS REQUIRED
COMM OUTLET BOX	5" SQUARE X 2 7/8" DEEP 3/4" MUD RING (1 OR 2-GANG AS NOTED)	STEEL CITY	82181T-1 SERIES 82C-G-3/4 (OR EQUIVALENT)	

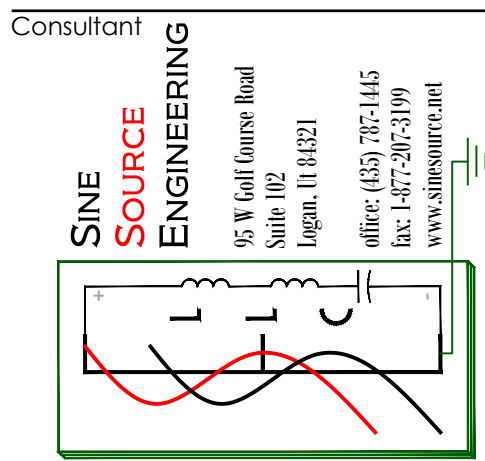

Project Name  
**JONES AND ASSOCIATES**  
 BUILDING ADDITION

Issued

No.	Date	Description
1	09.21.23	PLAN REVIEW
2	02.29.24	PLAN REVIEW


Revision

No.	Date	Description
1	02.29.2024	CITY REVIEW


SAA Project No. 2022-03  
 Drawing Title

**ELECTRONIC SYSTEMS PLANS**

Sheet Number  
**ET401**

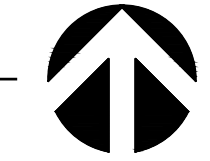




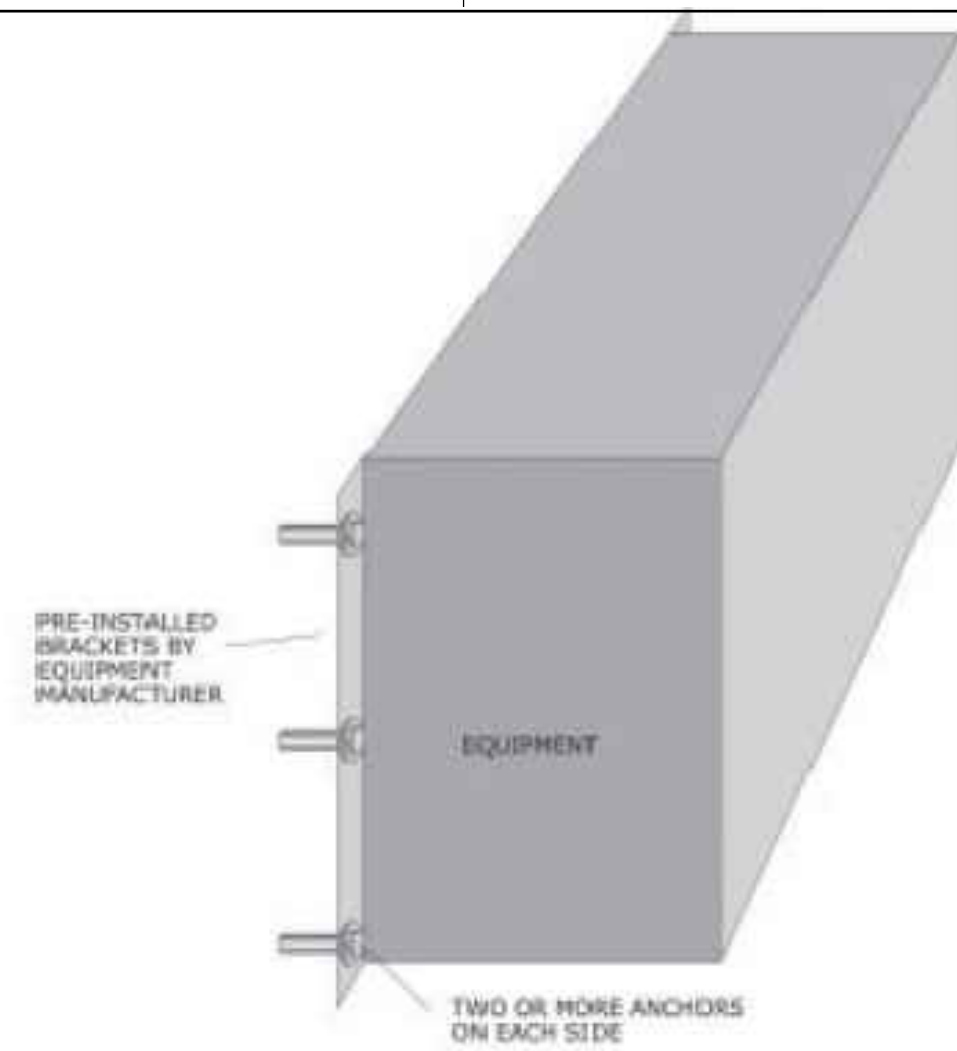


Direct attachment to a wall.

**H SEISMIC SUPPORT: EQUIPMENT TO WALL**  
SCALE: NO SCALE

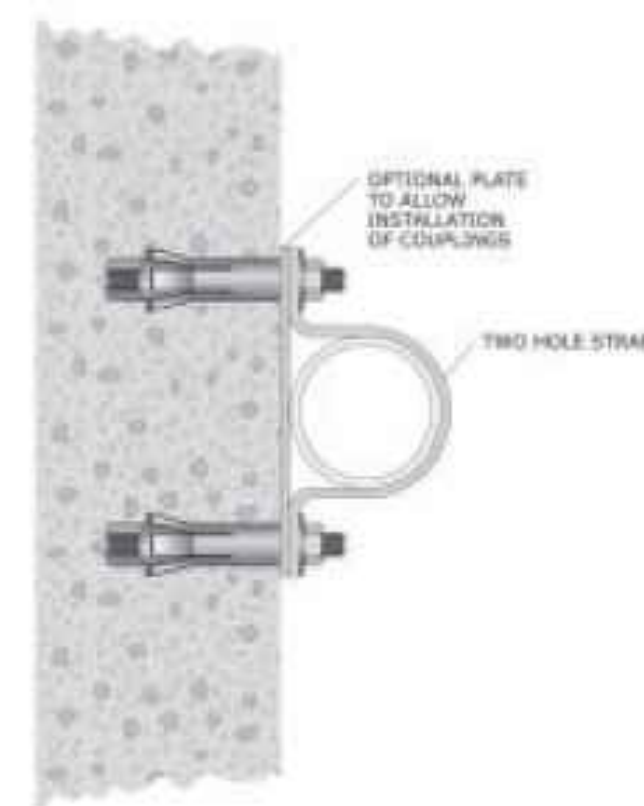


Direct attachment

**G SEISMIC SUPPORT: RACEWAY TO WALL**  
SCALE: NO SCALE

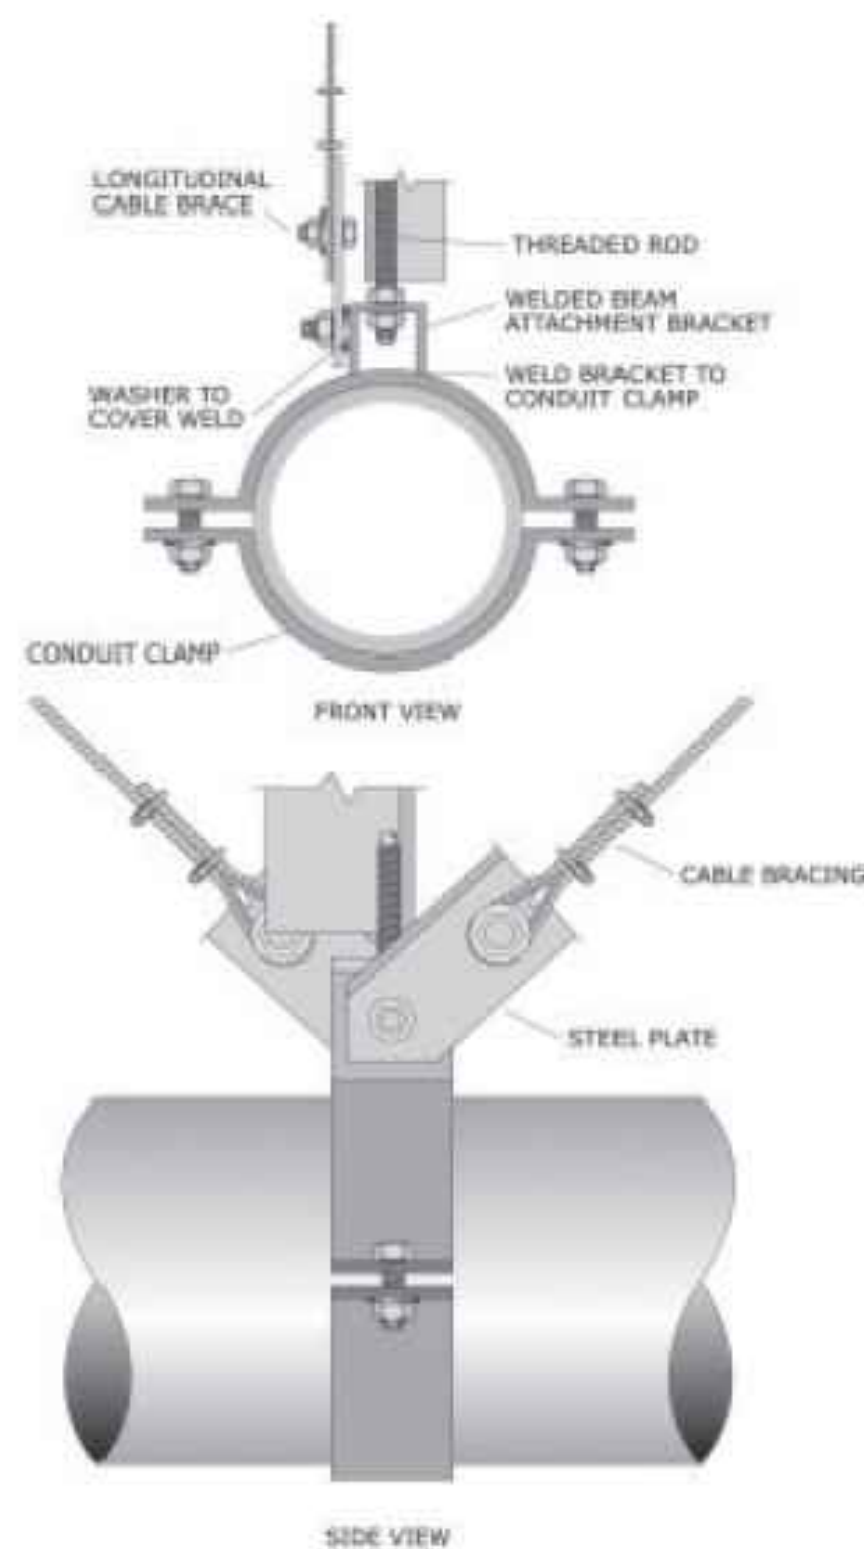

Conduit clamp supports with longitudinal cable lateral support and hanger rod.

**F SEISMIC SUPPORT: SUSPENDED RACEWAY**  
SCALE: NO SCALE

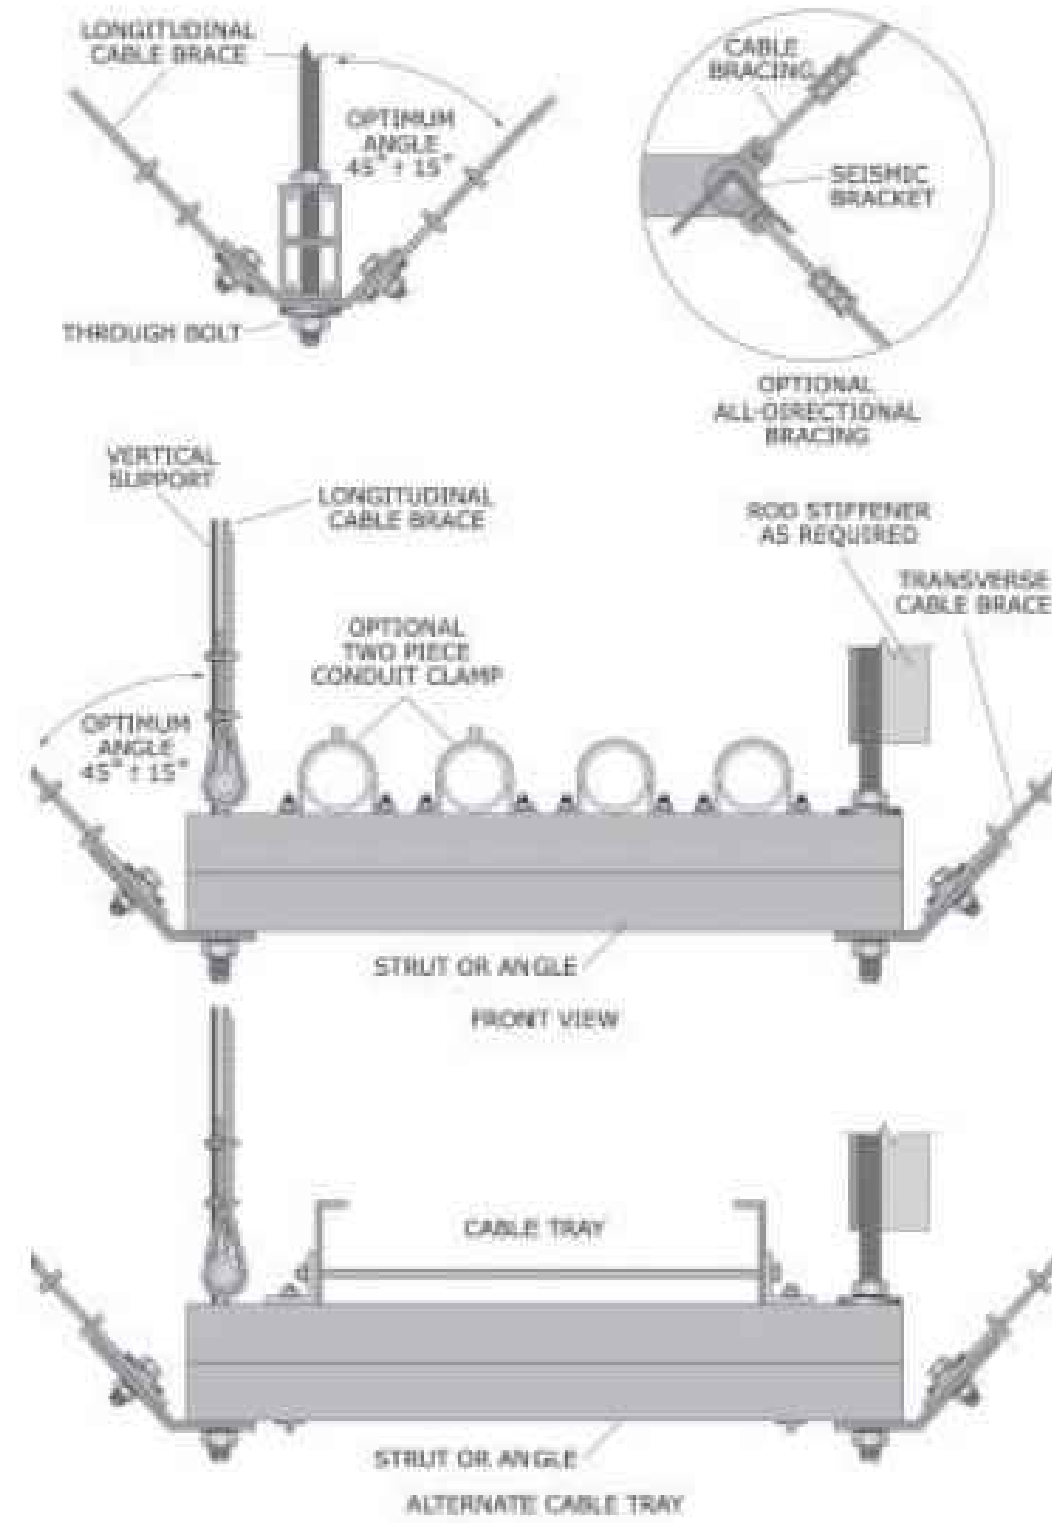


Trapeze support with cable lateral supports.


**E SEISMIC SUPPORT: RACEWAY TRAPEZE**  
SCALE: NO SCALE

**DETAIL KEYED NOTES**

1. VERIFY OUTLET LOCATION WITH MANUFACTURER'S REQUIREMENTS AND FIELD CONDITIONS TO BE CONCEALED WITH COVER INSTALLED.
2. FACELESS GFCI - HORIZONTAL, FLUSH-MOUNT IMMEDIATELY BELOW COOLER COVER TO BE ACCESSIBLE WITH COVER IN PLACE. CONNECT OUTLETS TO LOAD-SIDE OF GFCI.

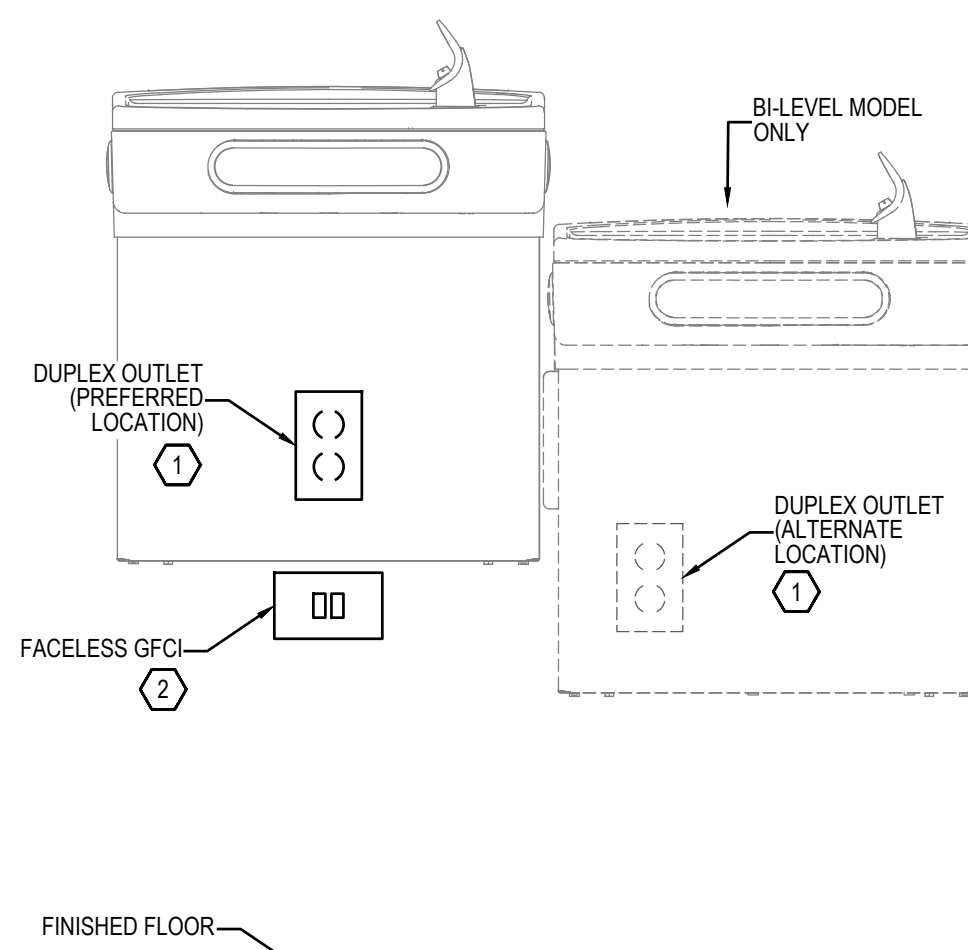

**D DRINKING FOUNTAIN ELECTRICAL DETAIL**  
SCALE: NO SCALE

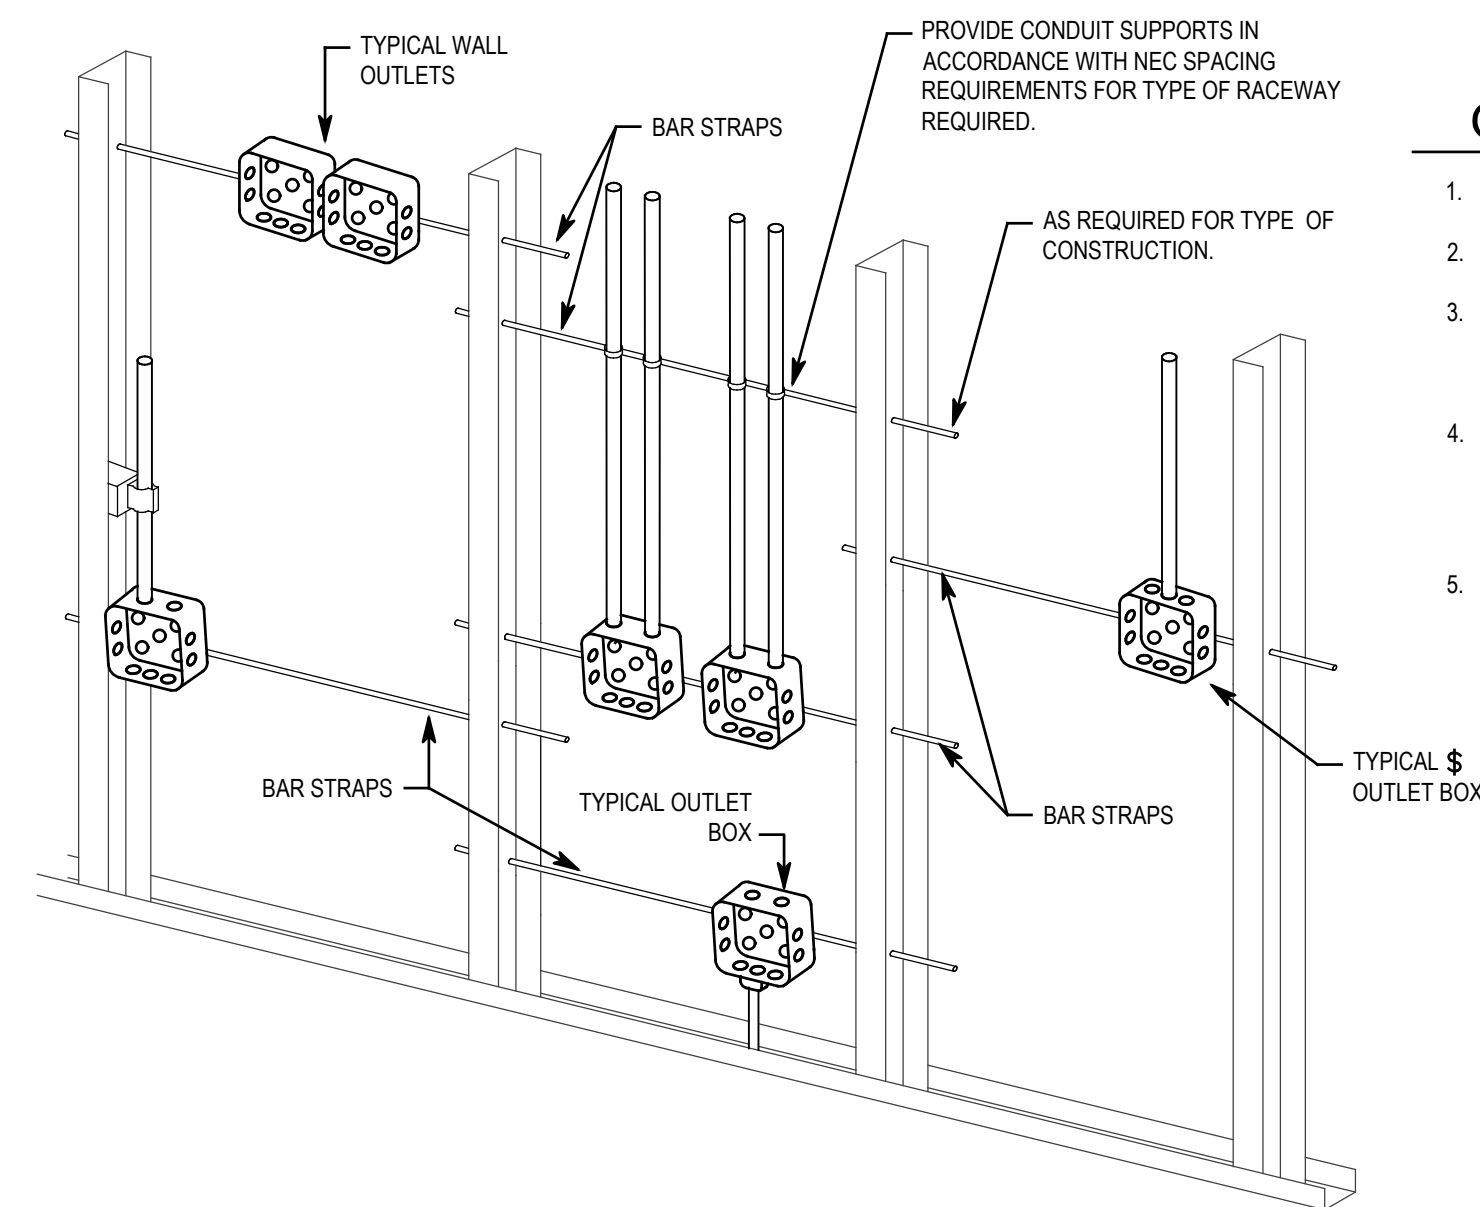




**GENERAL NOTES**

1. TYPICAL FOR WOOD AND METAL STUD ROUGH-IN.
2. PLASTER RINGS NOT SHOWN.
3. LOCATE ALL OUTLET BOXES IN ACCORDANCE WITH ARCHITECTURAL AND MECHANICAL DRAWINGS AND WITH ALL APPLICABLE SHOP DRAWINGS.
4. OUTLETS ON OPPOSITE SIDES OF WALLS OR PARTITIONS IN THE SAME STUD SPACE IN A RATED FIRE SEPARATION WALL MUST BE SEPARATED BY A MINIMUM OF 24" HORIZONTAL DISTANCE.
5. IN NON-RATED WALLS, OUTLETS ON OPPOSITE SIDES OF WALLS OR PARTITIONS MUST BE SEPARATED BY 16" FOR SOUND ATTENUATION.

**B MICROWAVE INSTALLATION DETAIL**  
SCALE: NO SCALE

**DETAIL NOTES**

1. BY OTHERS
2. DRILL CORD HOLE SIZED PER MICROWAVE PLUG END IN BACK COVER OF CABINET. LEFT OR RIGHT SIDE PER FIELD CONDITIONS.
3. COIL CORD ON TOP OF MICROWAVE BETWEEN APPLIANCE AND CABINET.
4. LOCATE OUTLET FLUSH IN BACK OF CABINET. LOCATE CABINET TO ALLOW FLEXIBLE CORD BEND RADIUS BEFORE ENTRY HOLE PER NEC REQUIREMENTS.

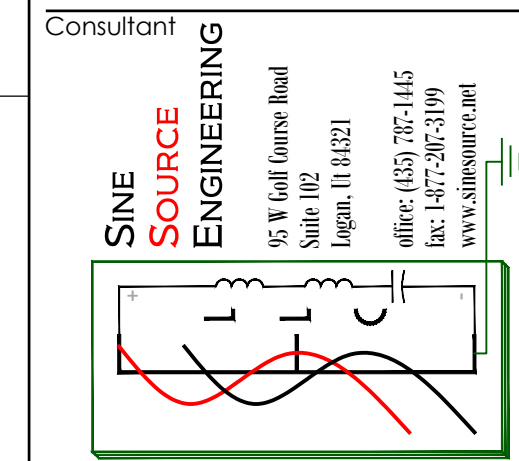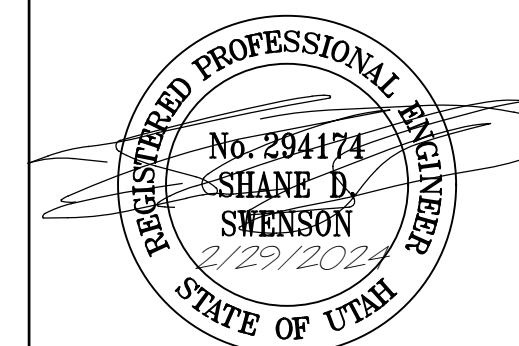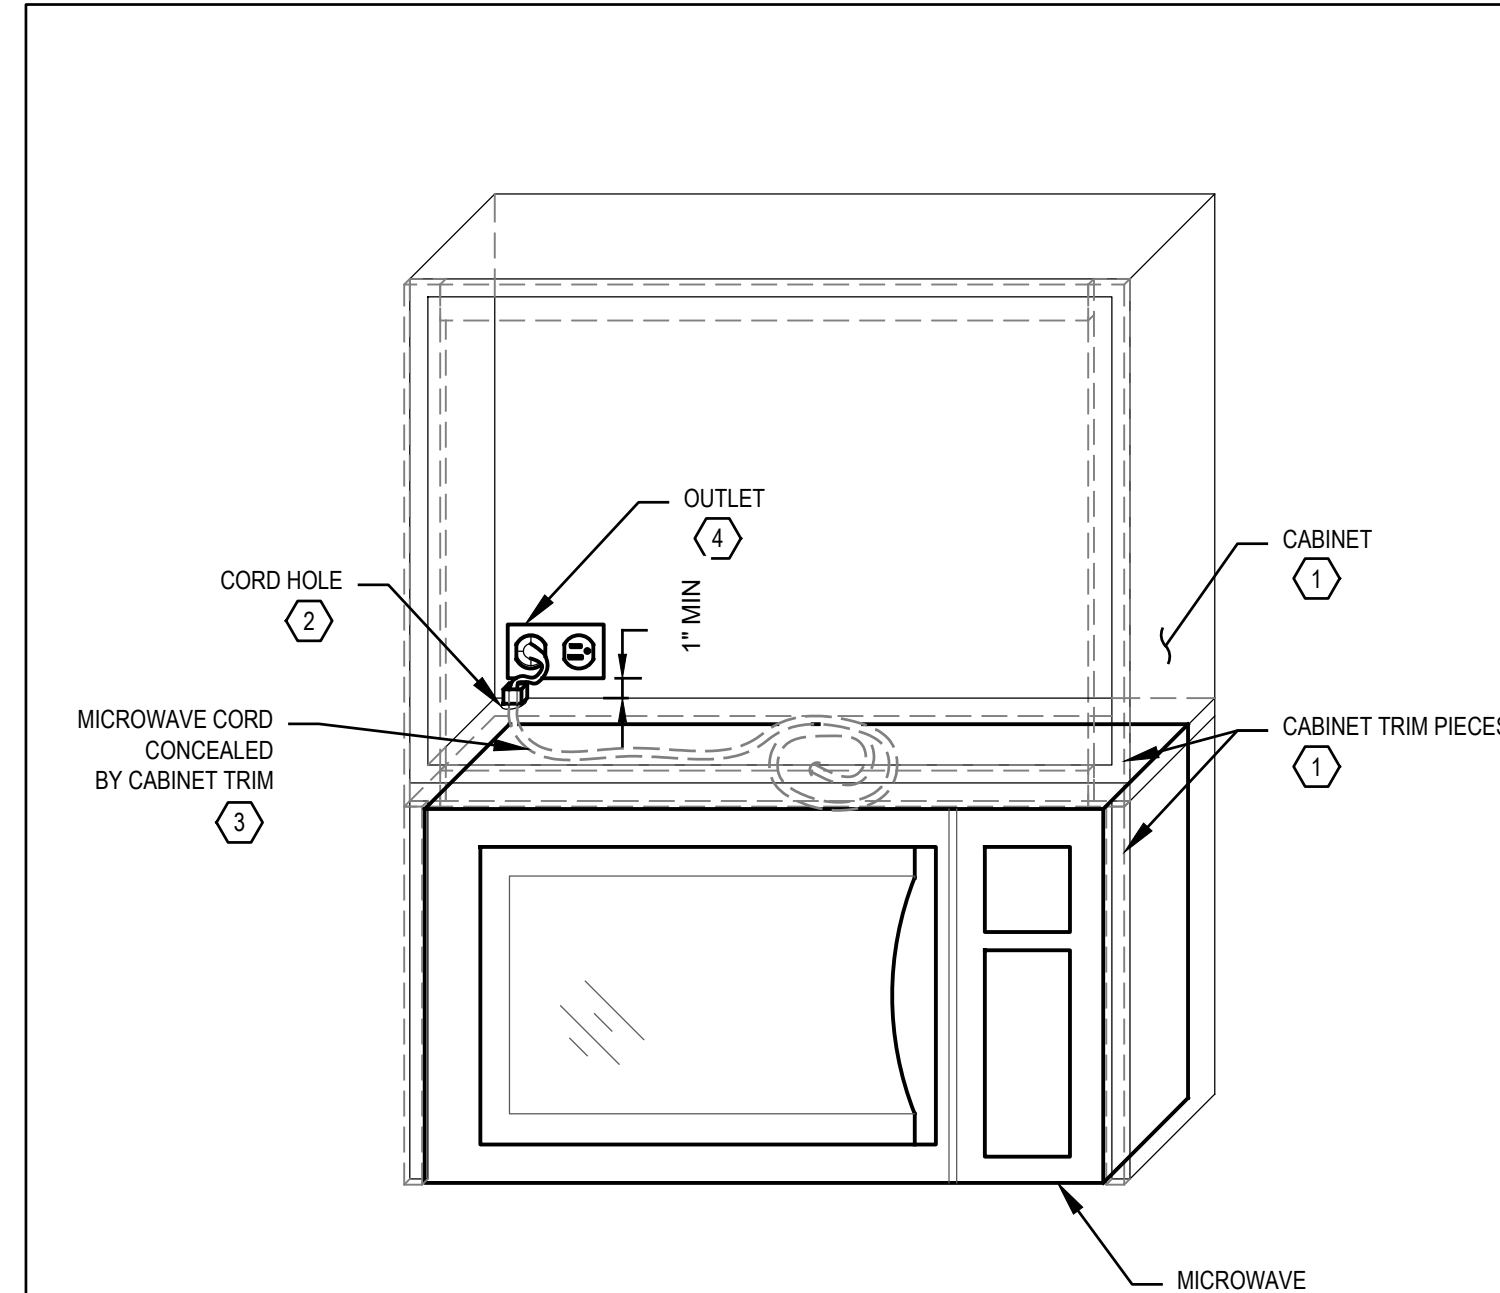

**JONES AND ASSOCIATES**  
 BUILDING ADDITION

Project Name

No.	Date	Description
1	09.21.23	PLAN REVIEW
2	02.29.24	PLAN REVIEW

Revision

No.	Date	Description

SAA Project No. 2022-03  
Drawing Title

**ELECTRICAL DETAILS**

Sheet Number

**EP501**

TIME: 15 OCT 2013 - 12:25PM DAKOT - T:\0882023888 JONES ASSOCIATES EXPANSION\01 DRAWINGS\06 ELECTRICAL\SINE SOURCE PROJECT\SHEETS\EP501 ELECTRICAL DETAILS.DWG  
 LAST SAVED: 31 Aug 23

