
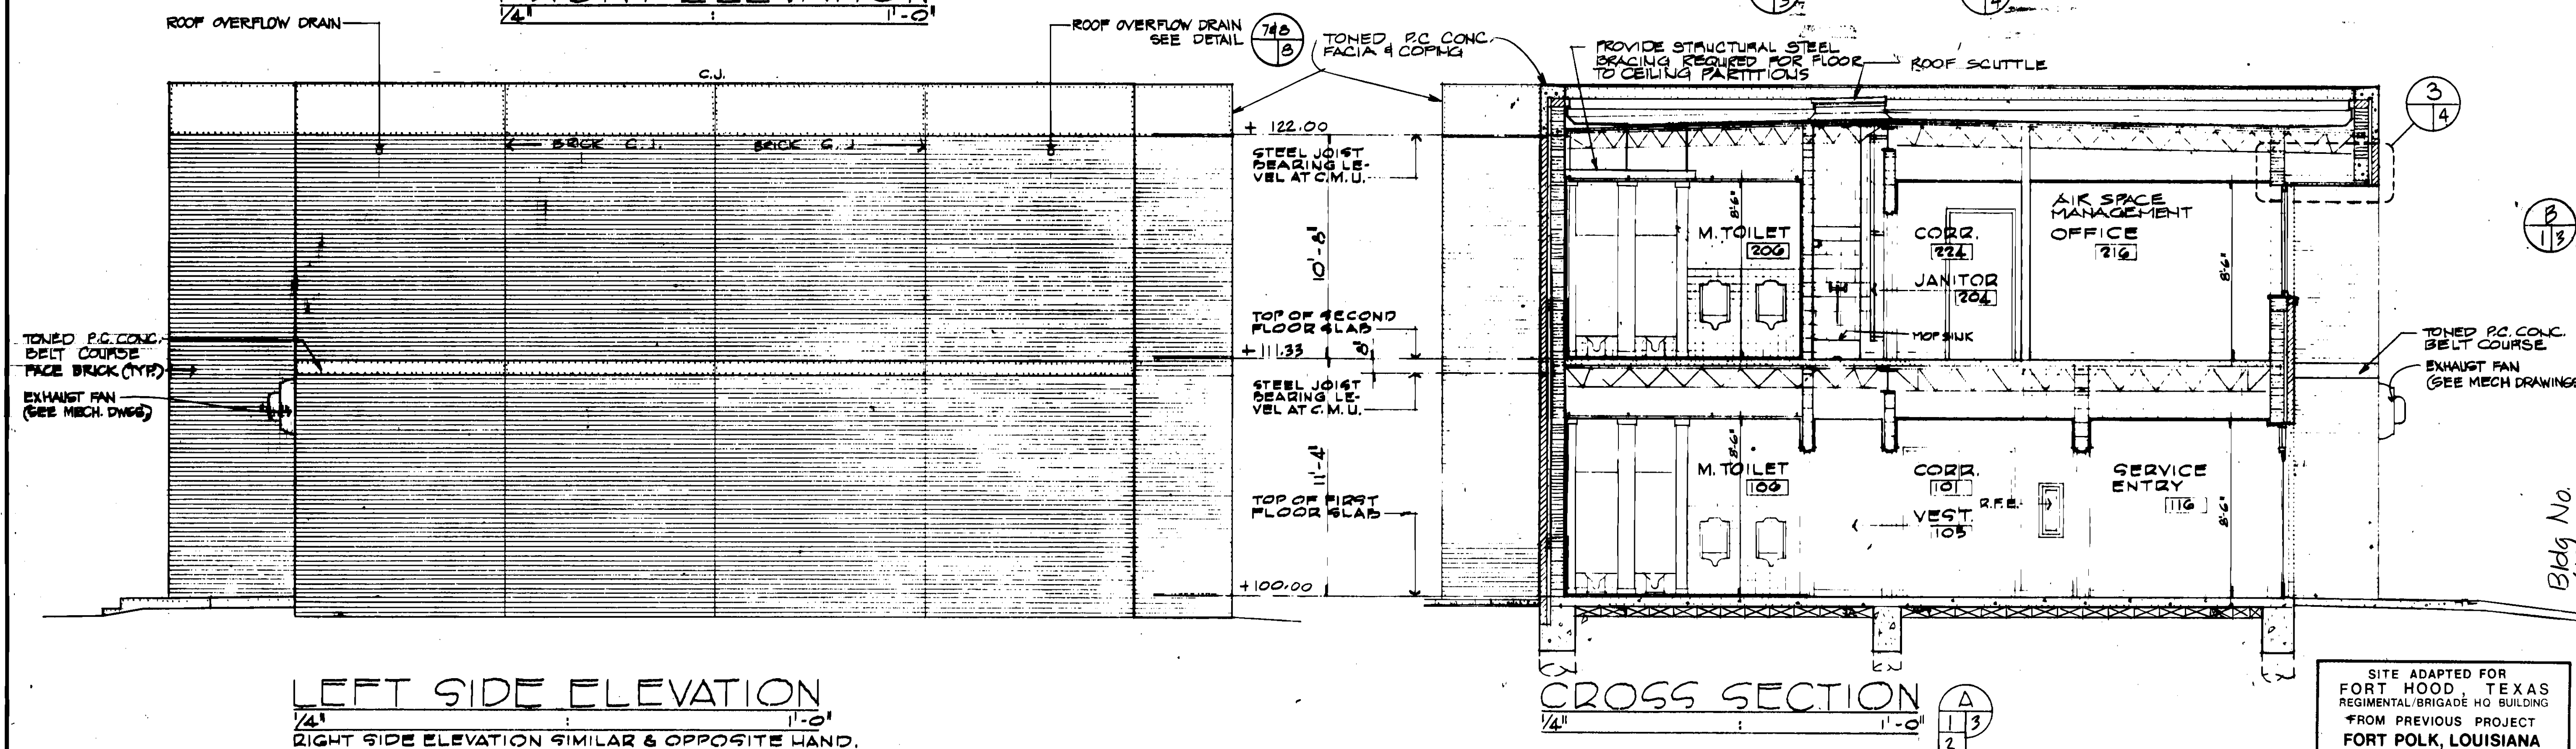
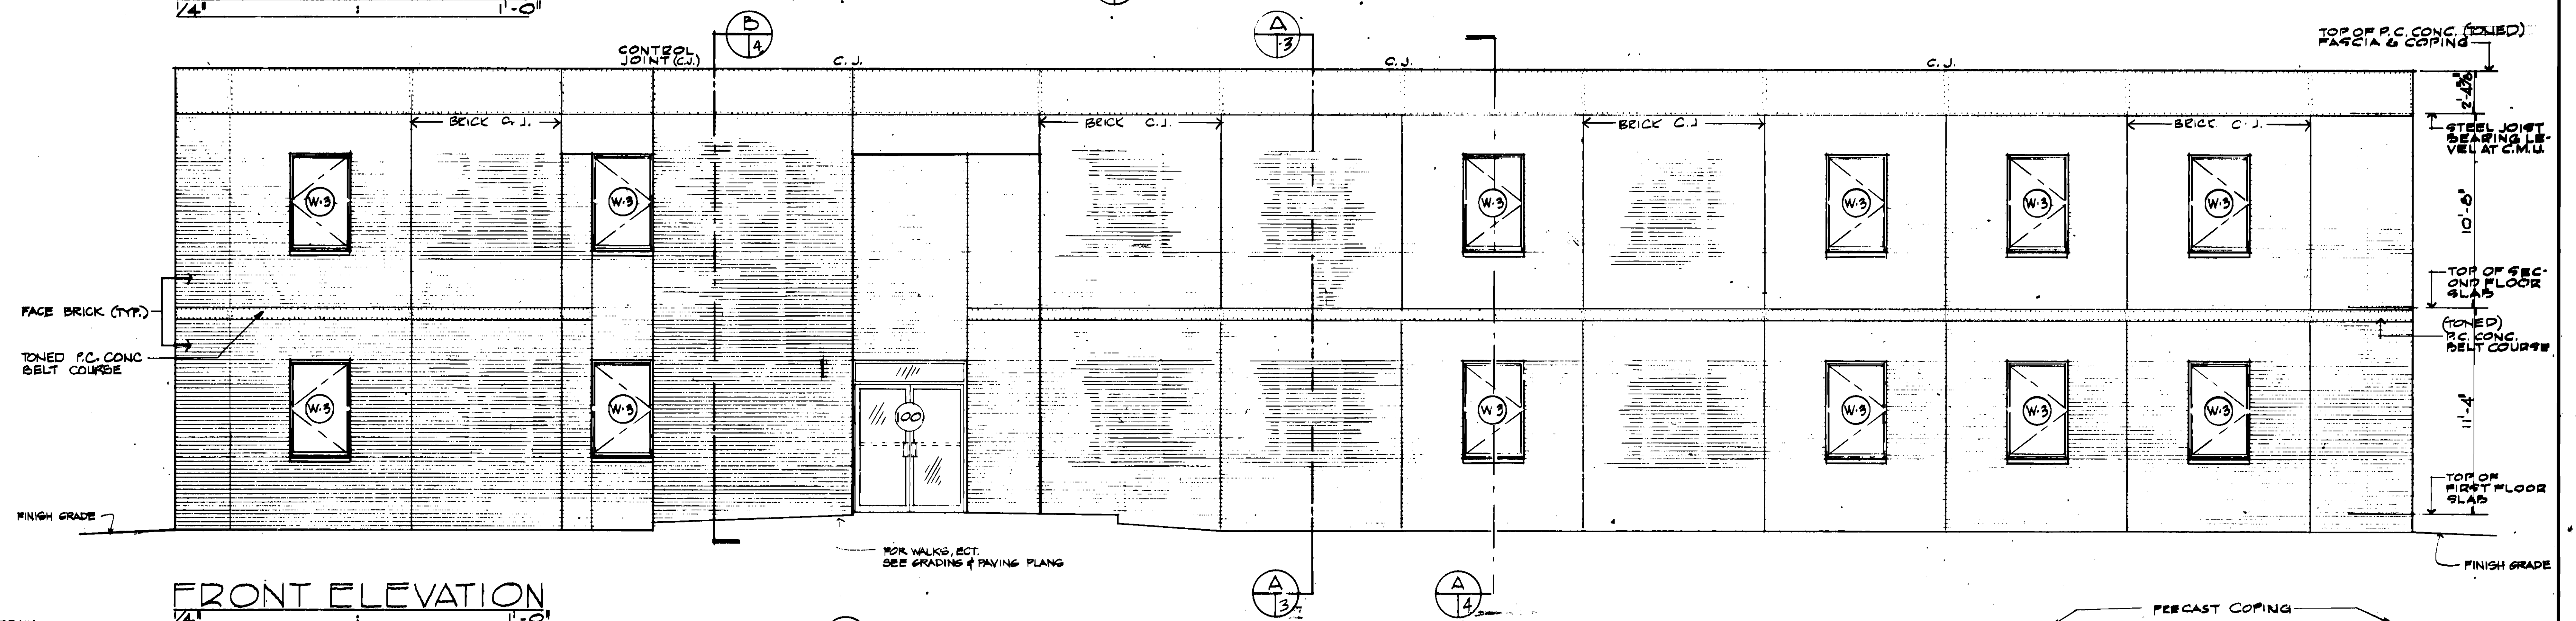


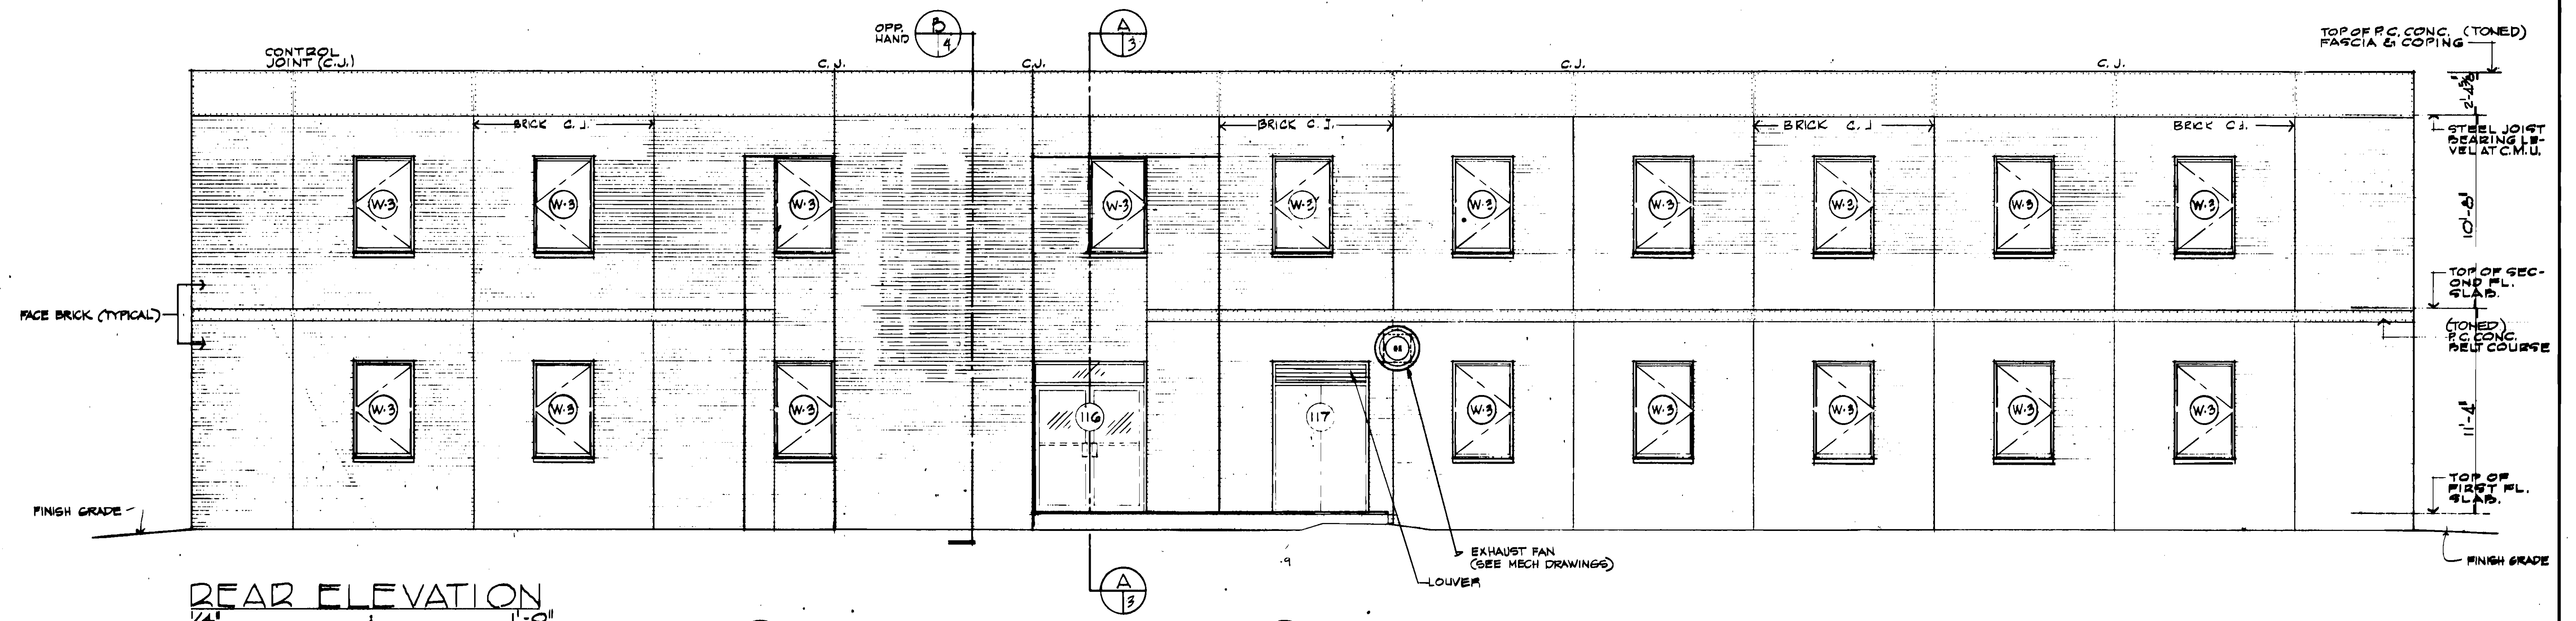

CROSS SECTION THRU CHILLER PAD FENCE

GRAPHIC SCALE

1/4" = 1'-0"

THE MCGINTY PARTNERSHIP ARCHITECTS, INC.

U.S. ARMY ENGINEER DISTRICT, FORT WORTH

REGIMENTAL/BRIGADE HQ BUILDING

ITEM NO. 483

ELEVATIONS & CROSS SECTION

DATE: JUNE 1964

CONTRACT NO. DAC63-84-C-0168

DRAWING NUMBER 000 14 40

SHEET NO. 27

SEQUENCE NO. 27

DRAWING OF WORK AS-BUILT