

In the Planning and Environment Court

No 2916/24

Held at: Brisbane

Between: **David Manteit**

Appellant

And: **Brisbane City Council**

Respondent

### AFFIDAVIT

David Manteit of 82 Rowe Tce Darra, developer, under oath/affirmation says –

See statement below numbering 1-10 re statement particulars.

Exhibit "A" Extracts of plan of Council Upslope stormwater decided code assessable approved cases 1/1/24-12/11/24, pages 6-30.

Signed:



Taken by:

Alessandra Lucia Raj  
JP (Qual)

Deponent

 **DAVID MANTEIT**

Justice of the Peace

Sworn and affirmed by

on 20/4/24 at RICHMOND in the presence of:

Deponent



Justice of the Peace



AFFIDAVIT

David Manteit  
82 Rowe Tce Darra 4076  
0424 739 923



**Statement particulars –**

“Applicant” - in the original Development application

“Appellant” – in the appeal

1. David Manteit has audited the Brisbane City Council public files of around 500 approved/decided Development cases on Brisbane City Council website Development I, based on certain parameters from around 1/1/24 to 12-11-24.

Parameters –

Decided 1/1/24 to 12/11/24.

Type - Reconfigure a Lot

Code Assessment

To the best of my knowlegde I have examined every approved plan and every pertinent condition of those 500 Council reconfigure a lot approvals.

To the best of my knowledge only one case in the 500 cases had Council imposed a condition **“the site must be filled..... to achieve / enable lawful point of discharge....”**

That case in mention is the subject case, being 124 Ashridge Rd Darra – three time mentioned and requested by Brisbane City Council in the conditions S12,17.18. Nobody except Council knows why those statements and requests have been made by Council to the applicant, as Council refuse to supply such information to the applicant.


There are obvious (in my view) and intentional (in my view) blunders in the fill assumptions by Council in the subject case. Council should be held accountable. In addition this opinion of the writer reflects the orders requested to the Planning Court by the Appellant.


2. I have also singled out cases with Upslope properties stormwater pipe conditions requested by Council. I found 18 cases. I am not aware of any other cases than the 18 cases, to the best of my knowledge. I attach copies of approved plans. below , of extracts of these plans.

These 18 cases all had the following parameters -

- Reconfigure a lot (Subdivision)
- Decided
- Code Assessment.
- Upslope stormwater condition to build a minimum 225mm pipe to rear neighbours.

3. There are two other files I placed in the report, 22 Darra Ave Darra and 143 Wakefield St Bald

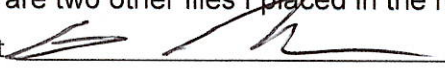Deponent 

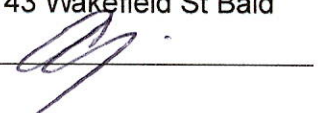Justice of the Peace 

Hills. These other files are also pertinent, since in these cases the applicant was also required to build an Upslope 225mm stormwater pipe, Code Assessable.

In addition, Joel Wake was the Development officer for 143 Wakefield St Bald Hills.

In the case of 143 Wakefield St Bald Hills, approved 4/4/18, I have lectured on the details of this case to my students of Subdivision Millions Meetup Group, of which I have around 600 members,

In the case of 22 Darra Ave Darra, the owner, Ms Pei Huang, I met with in relation with my normal business Subdivision Services. She asked me to examine the case, including Stormwater requirements. Council placed an Upslope stormwater condition on the site without an information request to Pei Huang. I subsequently had discussions with Civil Works who filed a representation to remove the condition, but was unsuccessful.

4. I am qualified to make plans and discuss stormwater matters. I have completed around 20 subdivisions and 60 as constructed stormwater lawful point of discharge jobs and prepare my own subdivision plans in degrees, minutes, seconds, millimetres, converted from chains.

I have prepared another affidavit for this Court Case demonstrating 8 approved subdivision Council plans, including 8 cases for my own business. All approved by Brisbane City Council and Ipswich City Council. I have completed around 60 lawful point of discharge situations with my own bare hands. I have assisted the licenced plumber and have installed every pipe on those cases including 225mm stormwater pipes through two houses in one case. I do this so nothing goes wrong.

I have installed live manholes with the plumber and 225mm upslope stormwater pipes and 150mm stormwater pipes.

Every single Council case has a n as constructed stormwater condition and requires As Constructed plans and RPEQ sign off for lawful point of discharge. Otherwise the case is not plan sealed.

5. There were around 18 "Upslope stormwater" files examined by David Manteit. No case had a **red stormwater line and pits drawn by Council, except the subject case of 124 Ashridge Rd Darra.**

**124 Ashridge Rd Darra case had drawn by Council –**

**4 pits**

**Multiple kerb adaptors**

**150 pipe notation for Ashridge Rd lots**

**55 metres of 225mm pipe**

**900mm easement**

**BSD 811 Non-compliant sham triangle, thereby mischievously reducing the line from 61 metres**

**Red stamp stating "Markups indicative only"**


**Pipe conflicting with the zone of influence of retaining wall, UU owned sewer pipe,**

**Inspection outlet**


Deponent




Justice of the Peace

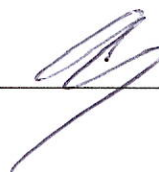

### Council approved drawing

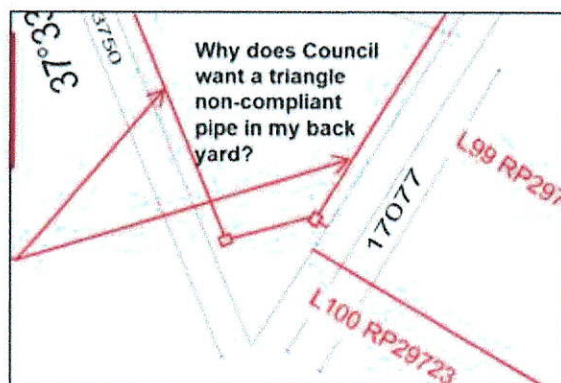

### Council BSD 8111 standard drawing says "keep 600mm from boundary."

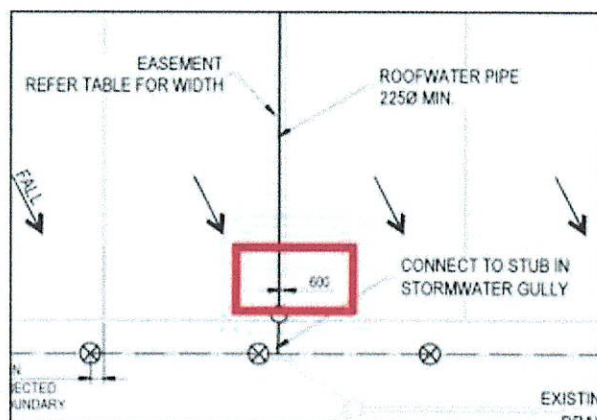

6. For the sake of clarity I mention that I have observed scores of Consultant mistakes in the 500 case. Since I am not paid to do so, I will not reveal all these mistakes. However, I do note the mentionings of mistakes by WC Designs in the case of 19 Idriess St Oxley.

Note that Council have not really designed this job from scratch like in 124 Ashridge Rd Darra, but merely picked up the non-requirement for upstream pipe for No. 25, including a mistake to design a 100mm pipe instead of 225 mm pipe.


Council still placed a condition for the applicant to design.

7. Margaret Orr, Team Leader of Brisbane City Council, on 3/10/24 said in a letter to David Manteit, the applicant, in writing, "assessed by Council's Development Services Team against the requirements of the Brisbane City Plan 2014"

Deponent 

Justice of the Peace 

In my view these statements are totally incorrect.

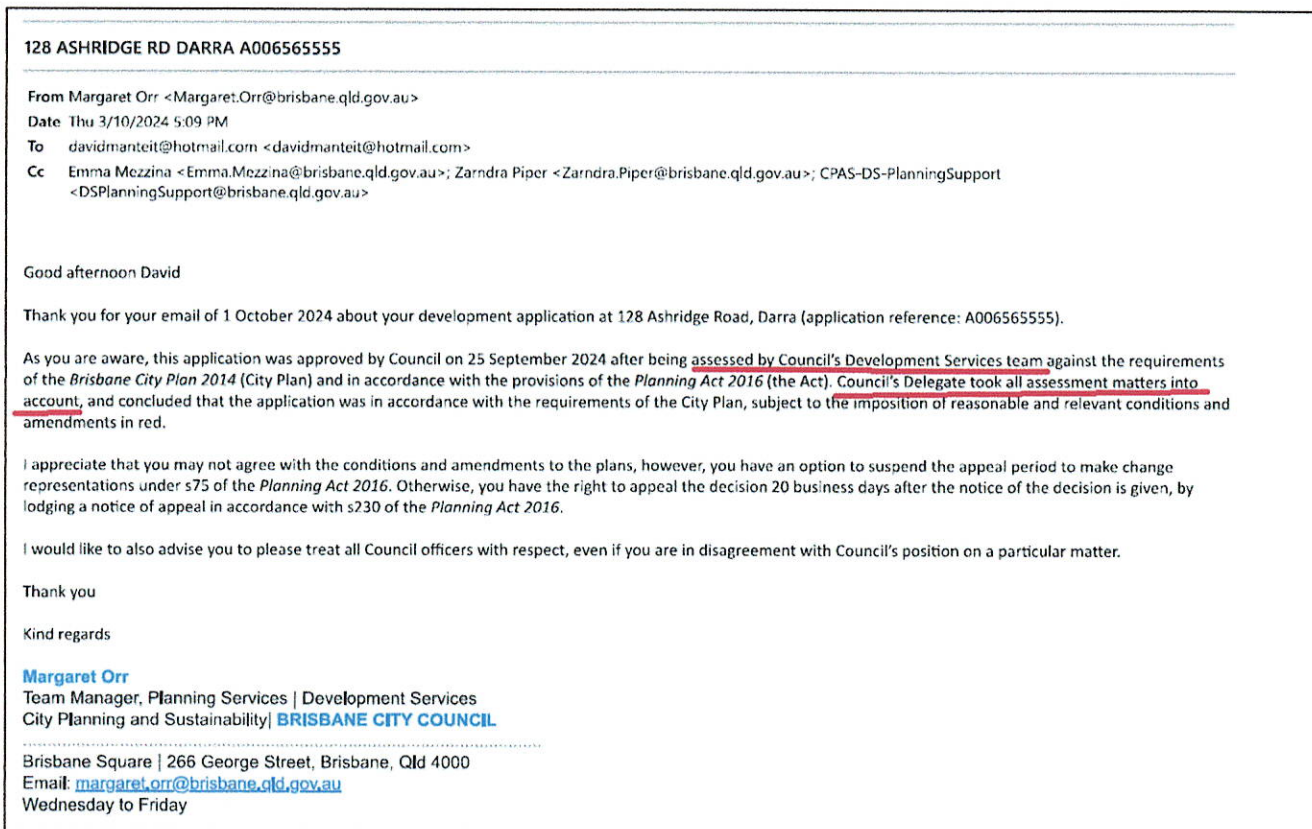

### Letter to David Manteit from Maragert Orr of Council on 3/10/24

Margaret Orr also said on 3/10/24 that the "The delegate (Joel Wake) had taken all assessment matters into account"

I believe this statement to be totally incorrect.

Development Services Team –

Margaret Orr – Team leader

Scott Ruhland  
 Joel Wake  
 Tom Gibbs - engineer  
 Zarndra Piper  
 Lucy Ting - engineer

The abovementioned persons are also listed on Council Development I as the Project Team for the subject case.

Deponent 

Justice of the Peace 

8. The abovementioned persons refuse to supply information to David Manteit regarding the red lines on the approval dated 25/9/24. This is despite many requests on writing.

9. I hold the above persons responsible for their refusal to supply information on the information on the red line and conditions, since I cannot build the red line and fill conditions.

10. The case of 124 Ashridge Rd Darra is the only case of 500 cases that Council has -

- designed stormwater pipes and placed a red line on the approved plan with pits, kerb crissing and locations and kerb adaptors.

- designed fill three times for the site for Lawful Point of Discharge and Upstream properties.

In my view, these persons are personally responsible for my holding costs and specific performance if their calculations are incorrect.

11. These persons had the chance to make an information request to David Manteit after the Properly made date of 23/7/24 to avoid any legal obligation or damages to David Manteit but they chose not to, Hence these persons are personally responsible for -

- specific performance
- holding costs
- damages
- loss of profits.

This is on the basis that the red line and the requirements of fill are subsequently proven to be incorrect, or not required.

This is the only case known where Council is the designer and author of a red line and fill design and conditions in approximately 500 cases this calendar year.

Deponent



Justice of the Peace





This and the following 23 pages is the exhibit  
marked 'A' referred to in the affidavit of  
DAVID JOHN LESLIE MANTEIT  
sworn/affirmed before me this 30/11/24  
Alessandra Lucia Raj JP (Qual) Reg No. 3044


Page 6 of 30

**David Manteit V Brisbane City Council 2916/24**


**Exhibit "A" Extracts of plan of Council Upslope stormwater, reconfigure a lot, decided, code assessable, approved cases 1/1/24-12/11/24.**

| Site                                                                                                                                                     | Date decided | Council drew red stormwater line | Council said "fill the site" |
|----------------------------------------------------------------------------------------------------------------------------------------------------------|--------------|----------------------------------|------------------------------|
| 128 Ashridge Rd Darra                                                                                                                                    |              | Yes                              | Yes                          |
| 143 Wakefield St Bald Hills                                                                                                                              |              | No                               | No                           |
| 22 Darra Ave Darra                                                                                                                                       |              | No                               | No                           |
| 19 Dorothea St Cannon Hill                                                                                                                               |              | No                               | No                           |
| 696 Robinson Rd Geebung                                                                                                                                  |              | No                               | No                           |
| 17 Idriess St Oxley                                                                                                                                      |              | No                               | No                           |
| 28 Roderick St Wavell Heights                                                                                                                            |              | No                               | No                           |
| 27 Lilac St Inala                                                                                                                                        |              | No                               | No                           |
| 22 Troutsbridge St Mount Gravatt East                                                                                                                    |              | No                               | No                           |
| 125 Ness Rd Salisbury                                                                                                                                    |              | No                               | No                           |
| 22 Charlie St Zillmere                                                                                                                                   |              | No                               | No                           |
| 25 Highgate St Coopers Plains                                                                                                                            |              | No                               | No                           |
| 28 Montrose St Taringa                                                                                                                                   |              | No                               | No                           |
| 84 Crowley St Zillmere                                                                                                                                   |              | No                               | No                           |
| 15 Orville St Geebung                                                                                                                                    |              | No                               | No                           |
| 3 Exley St Kedron                                                                                                                                        |              | No                               | No                           |
| 32 Tarm St Wavell Heights                                                                                                                                |              | No                               | No                           |
| 37 Edith St Synnybank                                                                                                                                    |              | No                               | No                           |
| 111 Dixon St Sunnybank                                                                                                                                   |              | No                               | No                           |
| 24 Annear St Acacia Ridge                                                                                                                                |              | No                               | No                           |
| 79 Rowe Tce Darra                                                                                                                                        |              | No                               | No                           |
| <b>Notes</b>                                                                                                                                             |              |                                  |                              |
| Around 500 subdivision approvals were examined upon which the above were found to have an Upslope stormwater drain connection condition in the approval. |              |                                  |                              |

**Above – report by David Manteit on Brisbane City Council "Upslope stormwater " reconfigure a lot, code assessable decided approvals decided 1/1/24 – 12/11/24.**

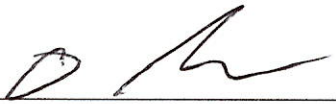Deponent 

Justice of the Peace 

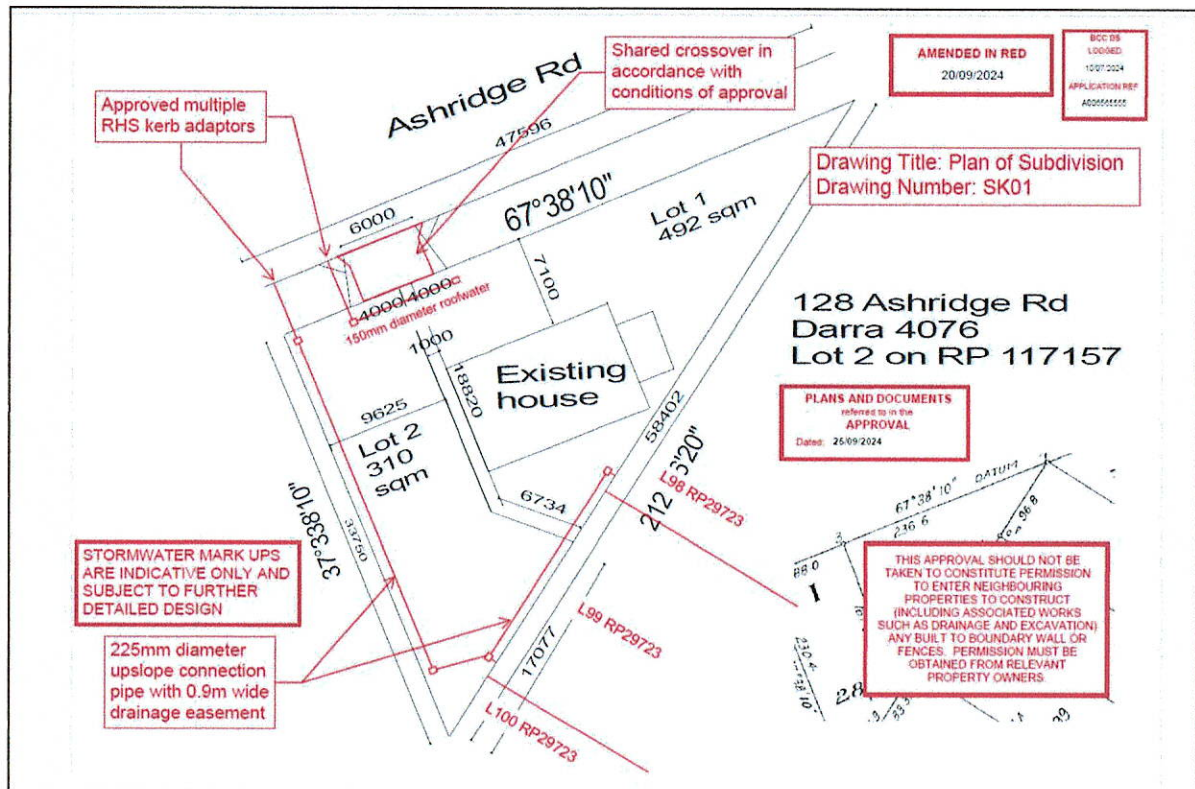


Above – Approved plan of 124 Ashridge Rd Darra with red stormwater lines and fill conditions designed by Council and the “Delegate and the “Development Assessment Officers”

Deponent 

Justice of the Peace 

Deponent


## Justice of the Peace

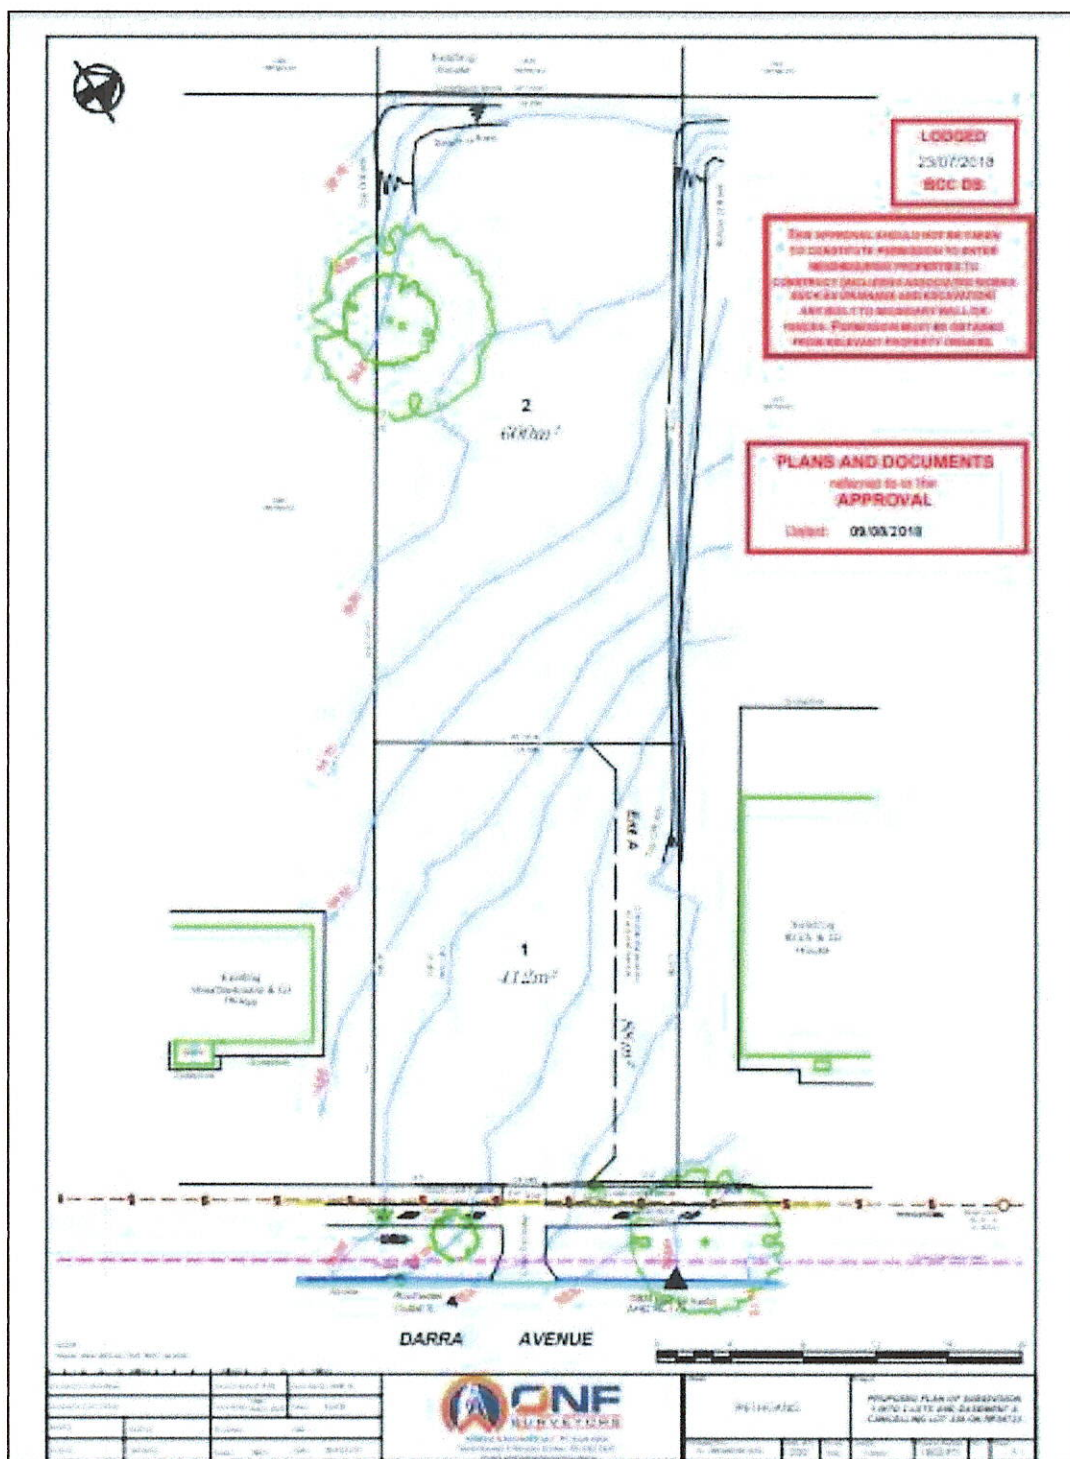

Approved plan of Upslope condition property – No Council red line or “fill the site” condition  
22 Darra Ave Darra

Deponent 

Justice of the Peace 

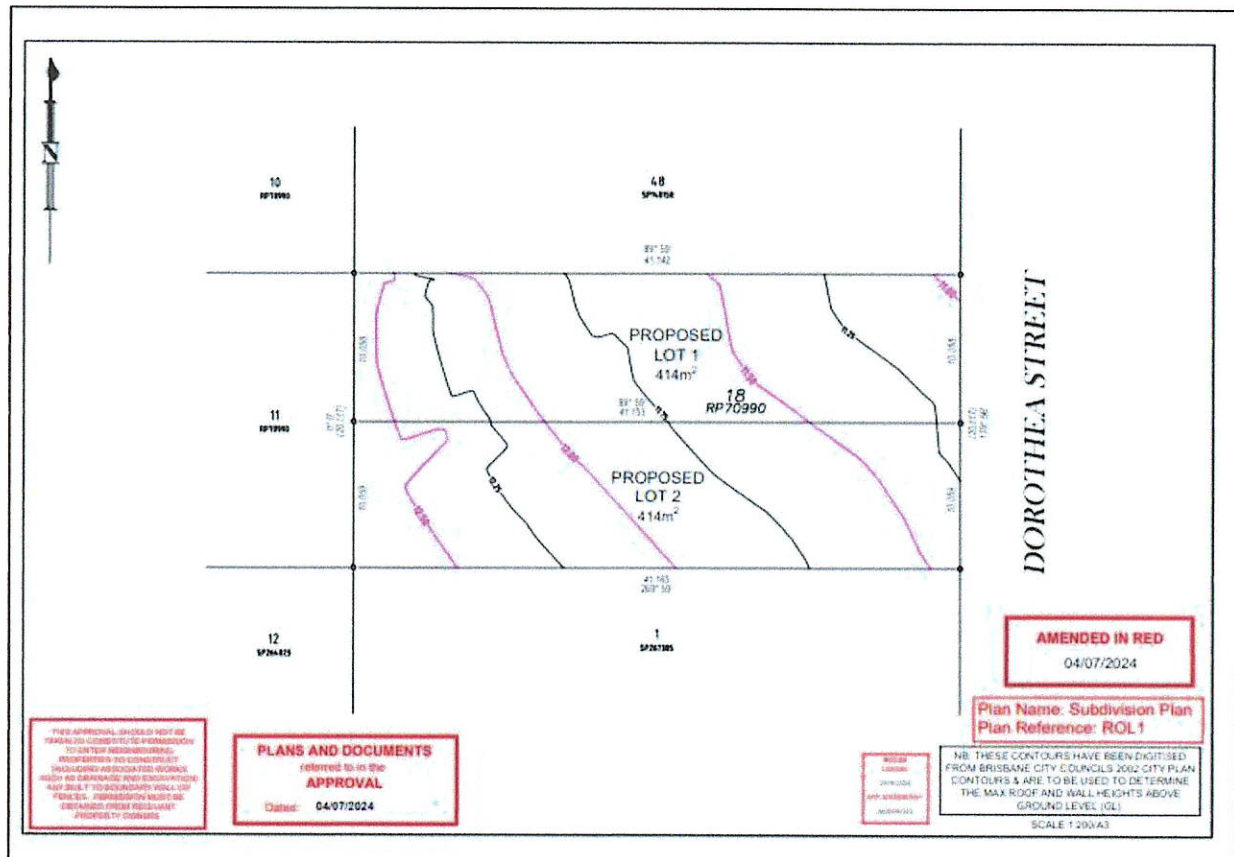


Approved plan of Upslope condition property – No Council red line or “fill the site” condition  
19 Dorothea St Camp Hill

Deponent

*[Signature]*

Justice of the Peace

*[Signature]*

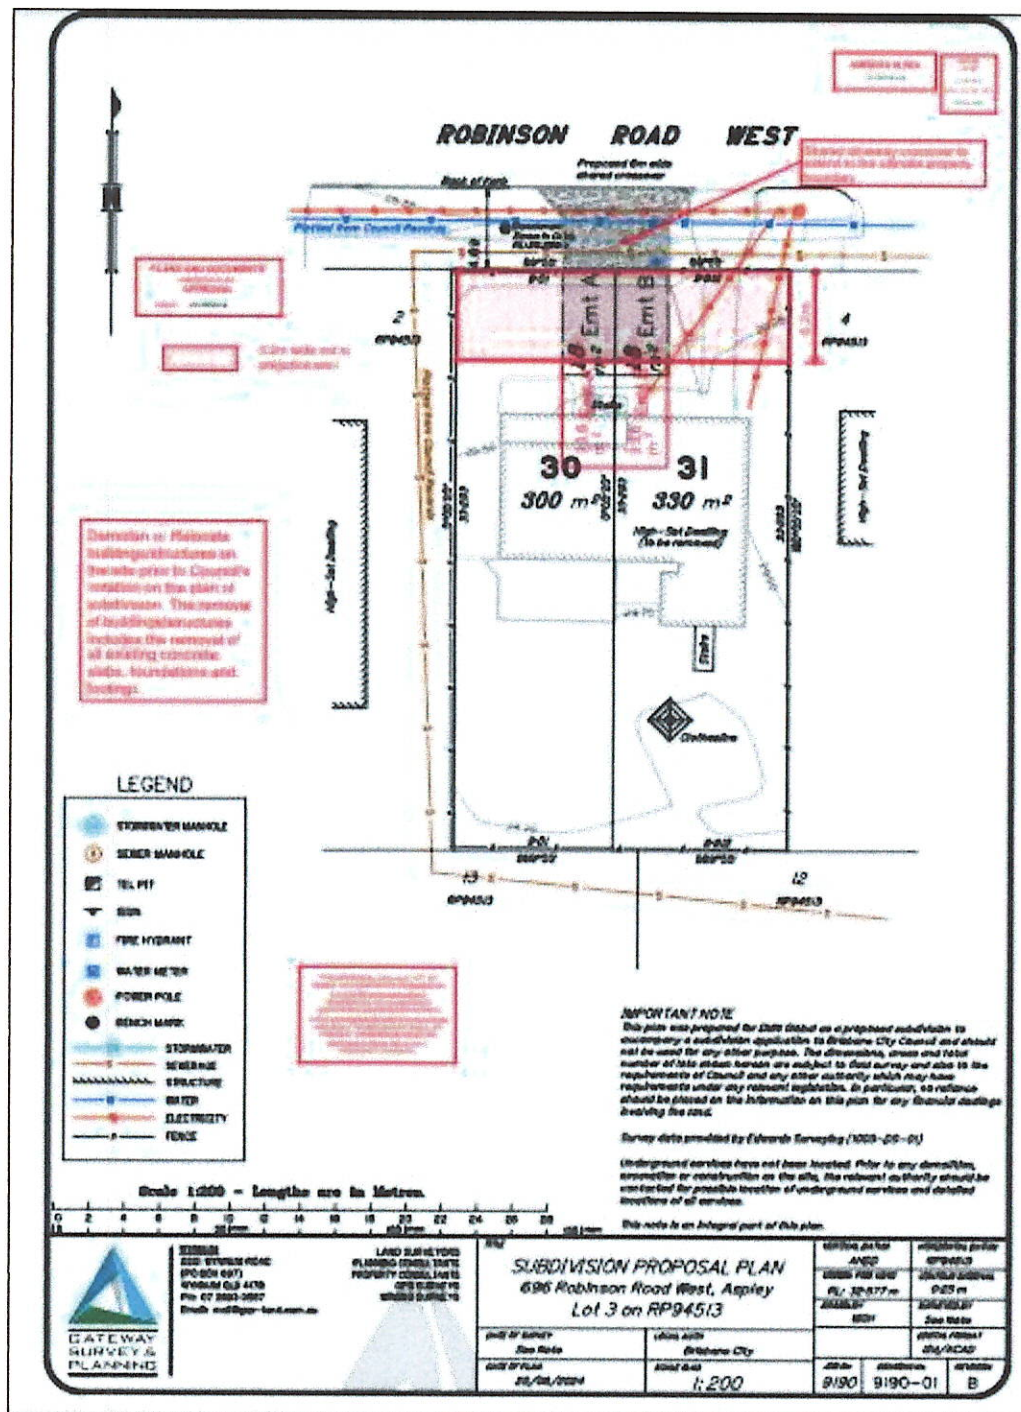


**Approved plan of Upslope condition property – No Council red line or “fill the site” condition**  
**696 Robinson Rd West Aspley**

Deponent

Justice of the Peace

Deponent


## Justice of the Peace

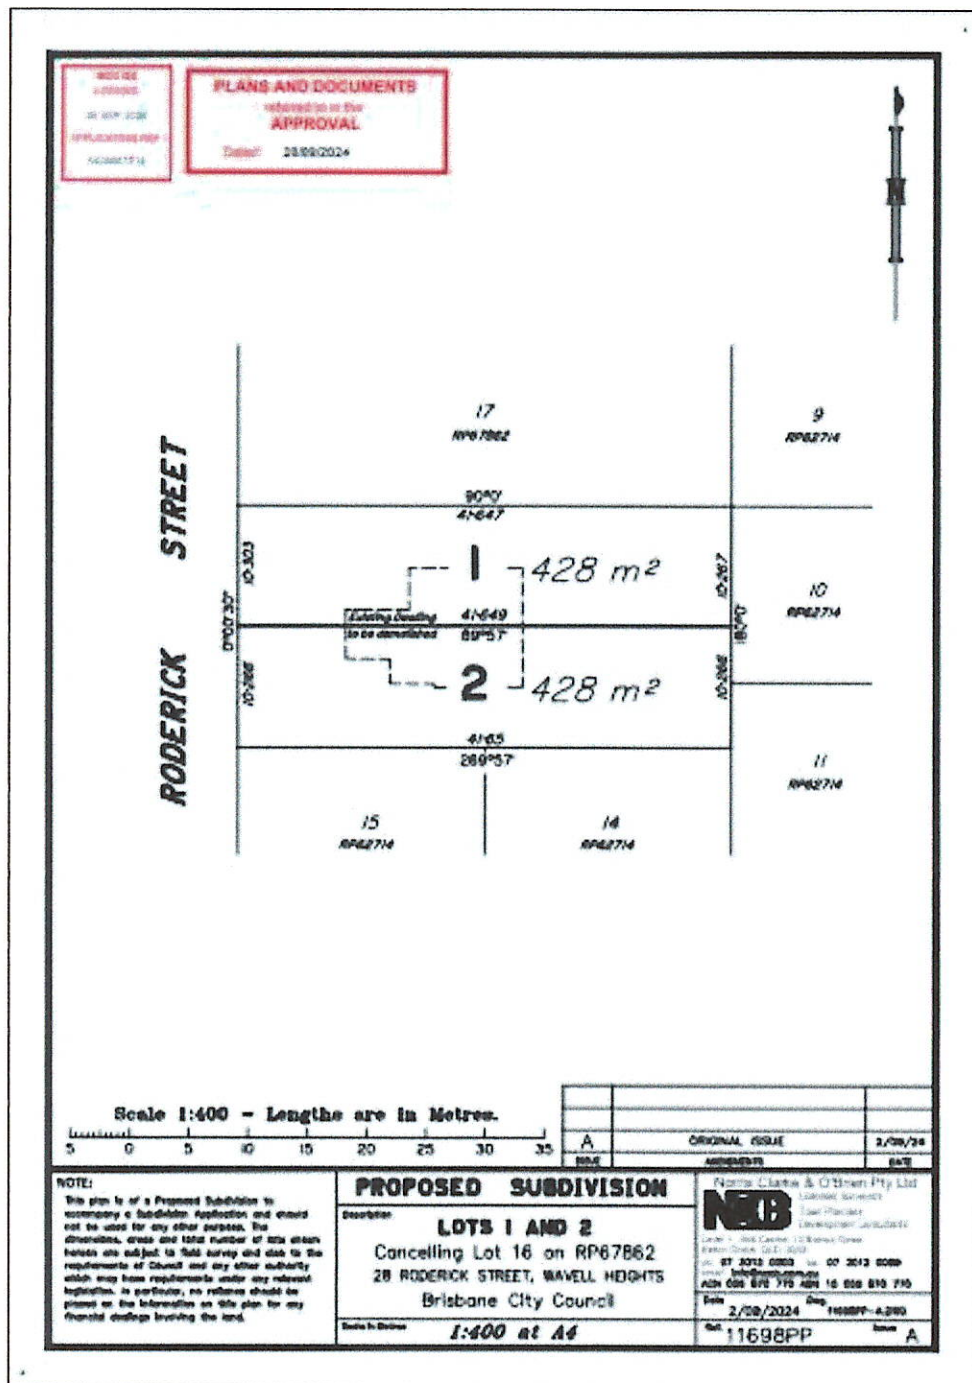

Approved plan of Upslope condition property – No Council red line or “fill the site” condition  
28 Roderick St Wavell Heights

Deponent

Justice of the Peace

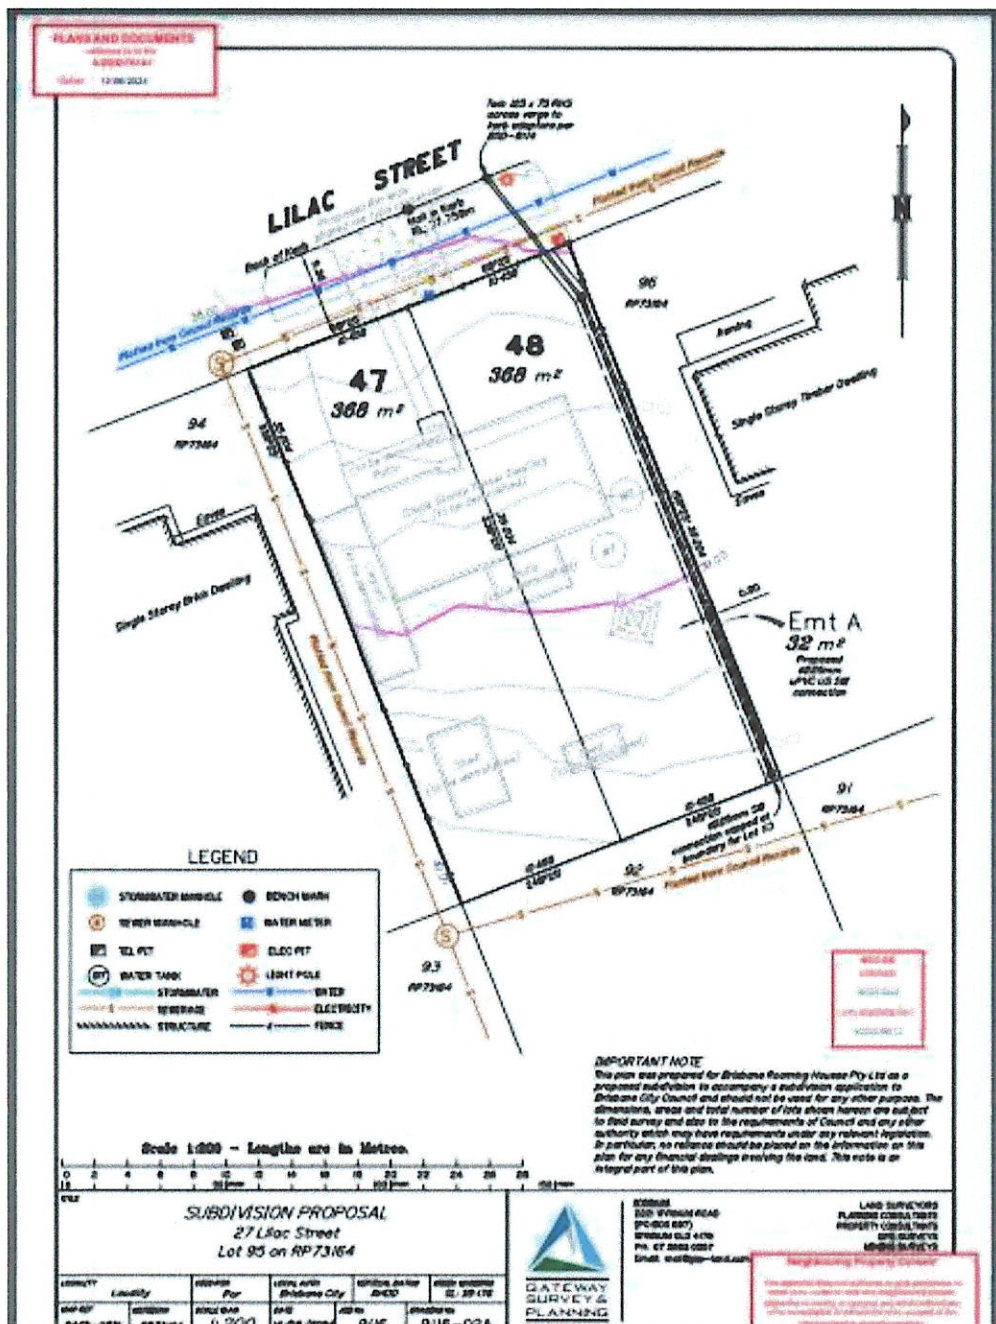


Approved plan of Upslope condition property – No Council red line or “fill the site” condition  
27 Lilac St Inala.

Deponent

*[Signature]*

Justice of the Peace


*[Signature]*

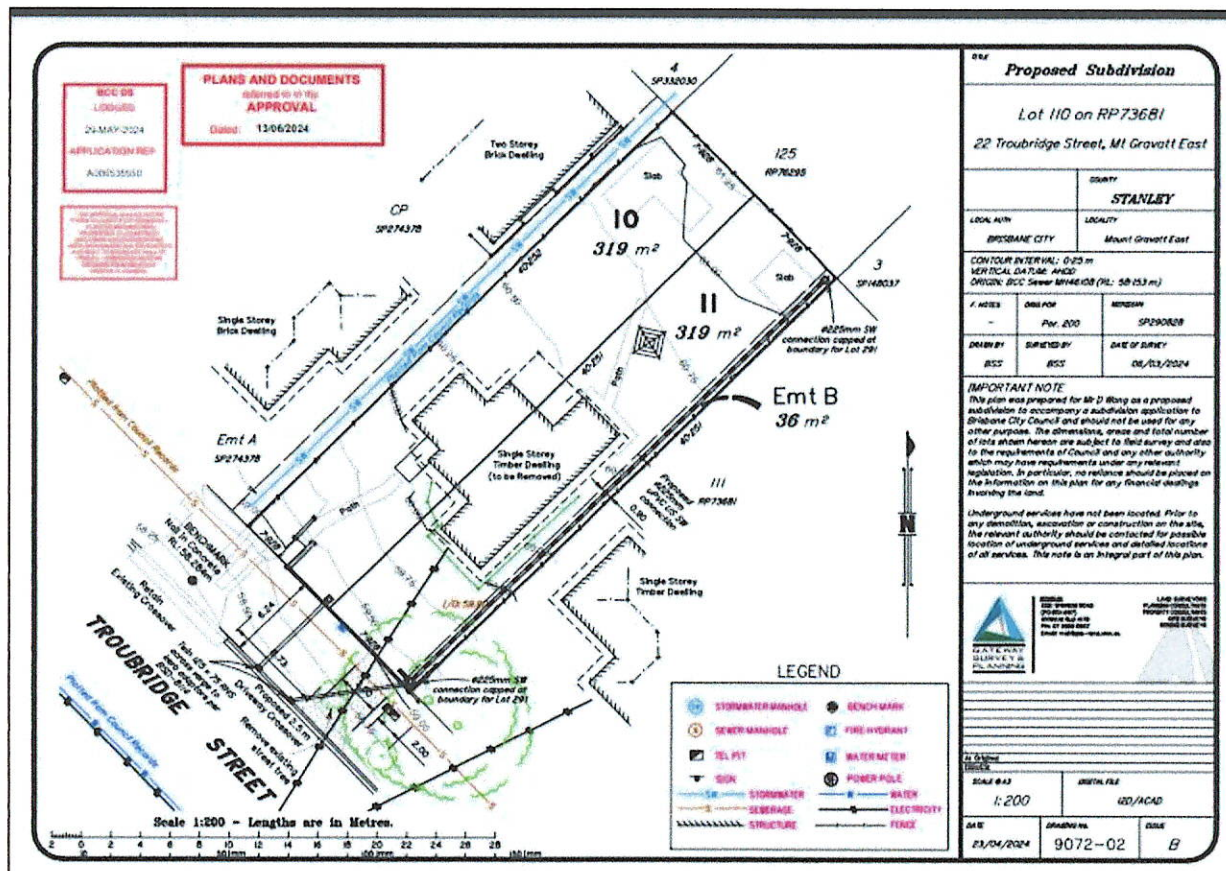

Approved plan of Upslope condition property – No Council red line or “fill the site” condition  
27 Lilac St Inala.

Deponent

Justice of the Peace

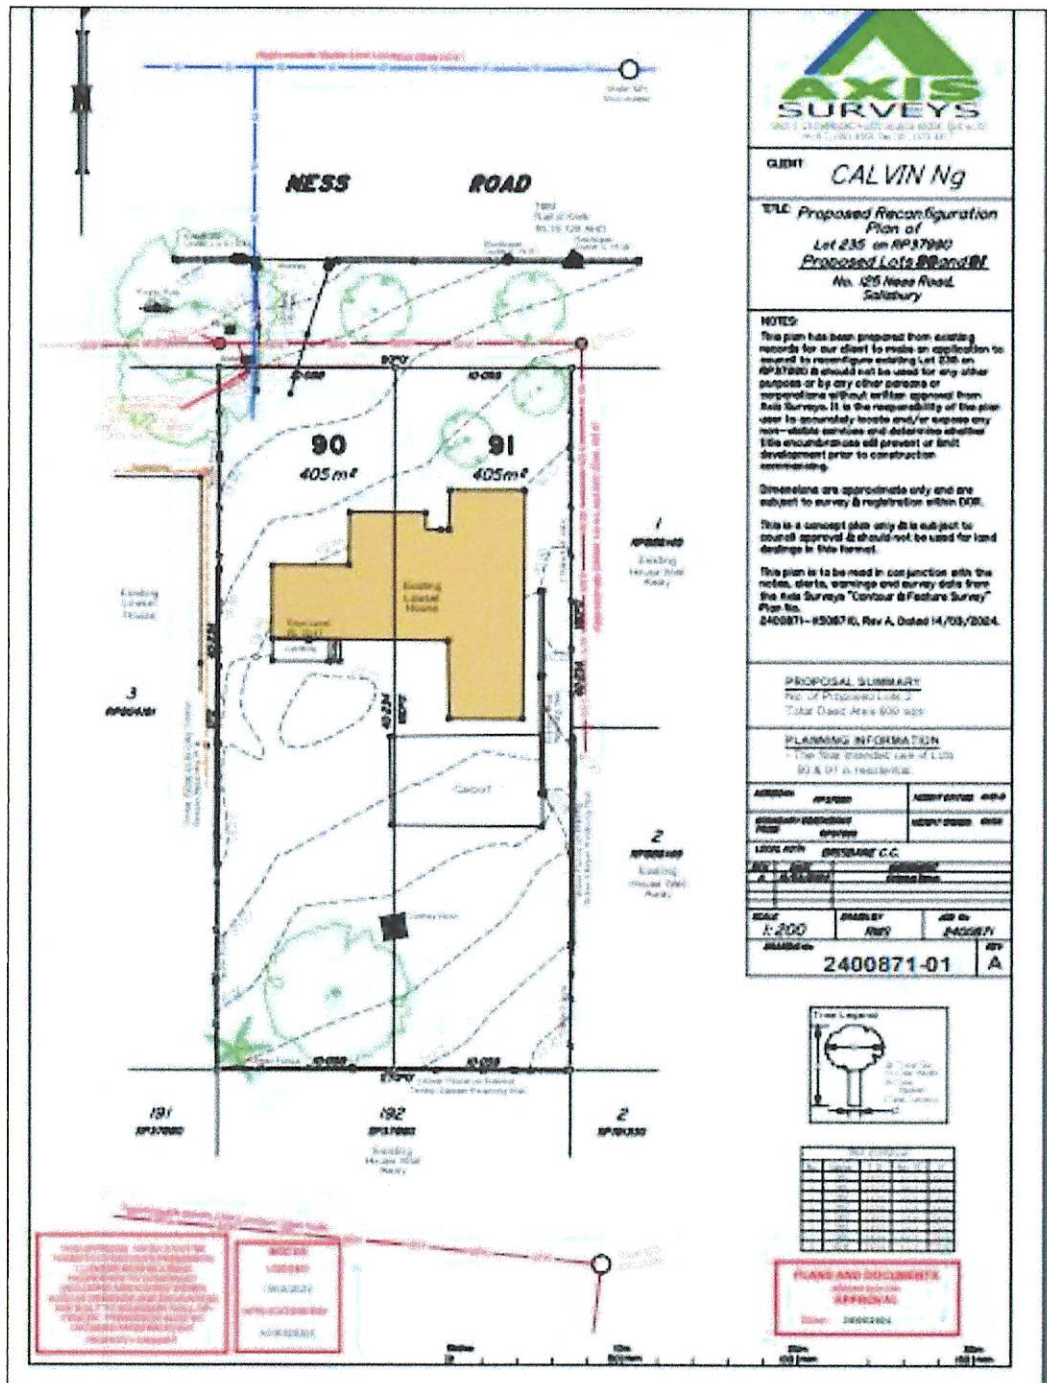

Approved plan of Upslope condition property – No Council red line or “fill the site” condition  
 125 Ness Rd Salisbury


Deponent

Justice of the Peace

**Approved plan of Upslope condition property – No Council red line or “fill the site” condition**  
**22 Charlie St Zillmere**

Deponent

## Justice of the Peace

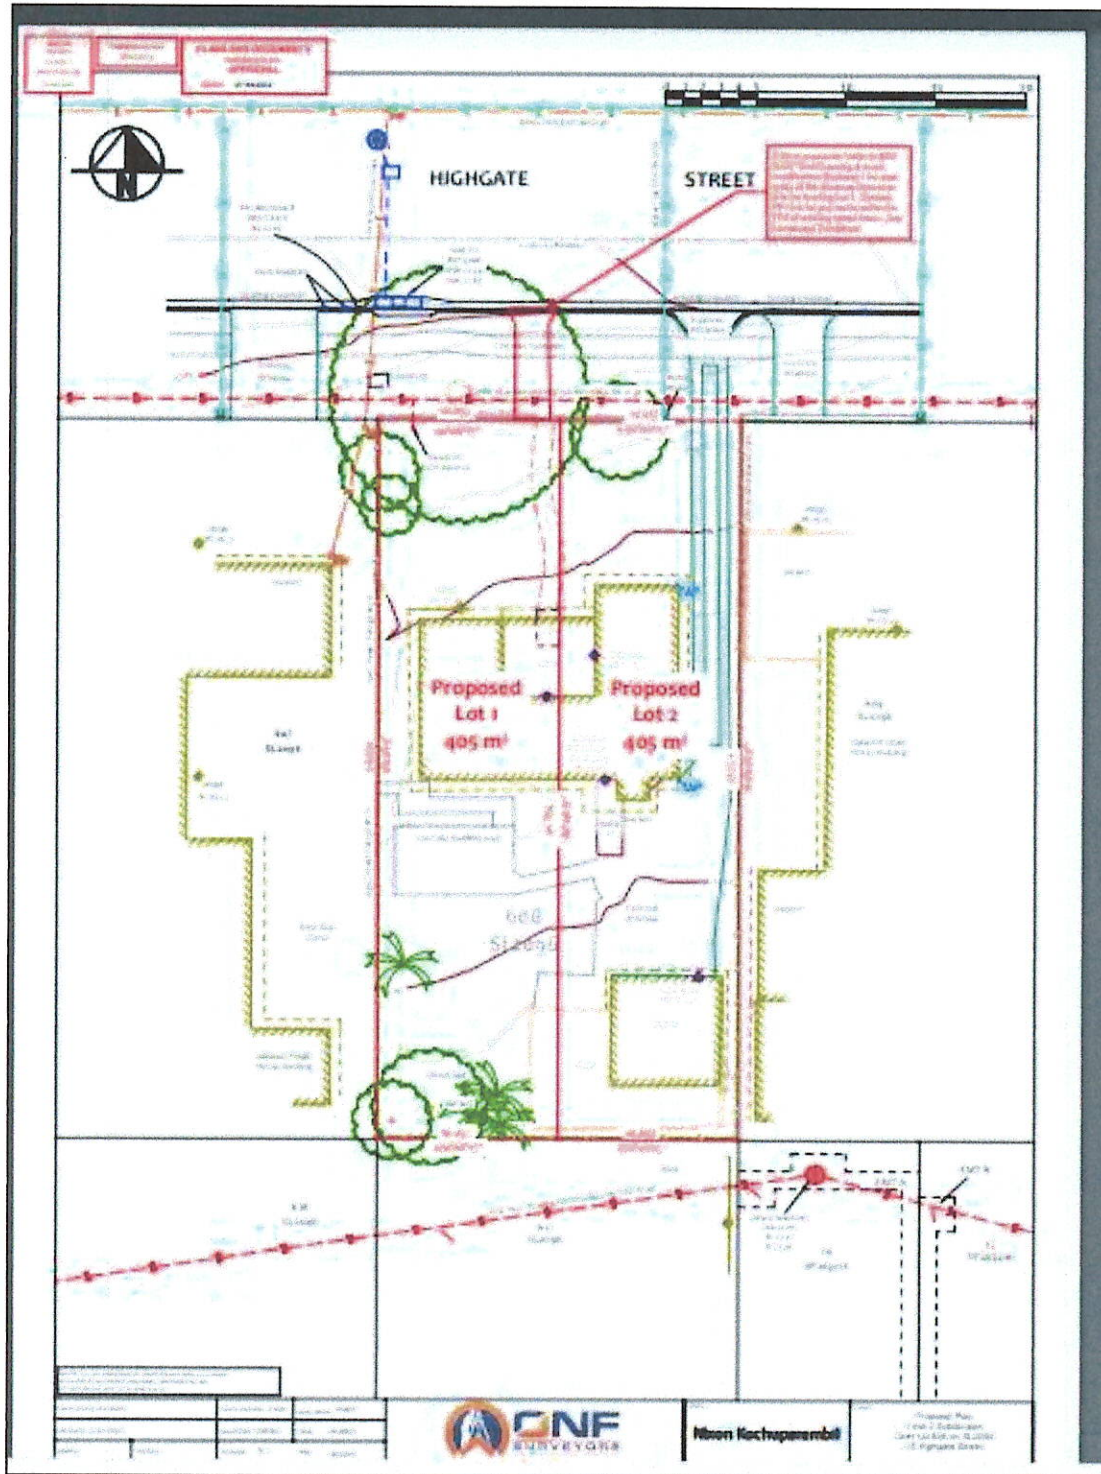


Approved plan of Upslope condition property – No Council red line or “fill the site” condition  
25 Hightgate St Coopers Plains.

Deponent 

Justice of the Peace 

Deponent


Justice of the Peace

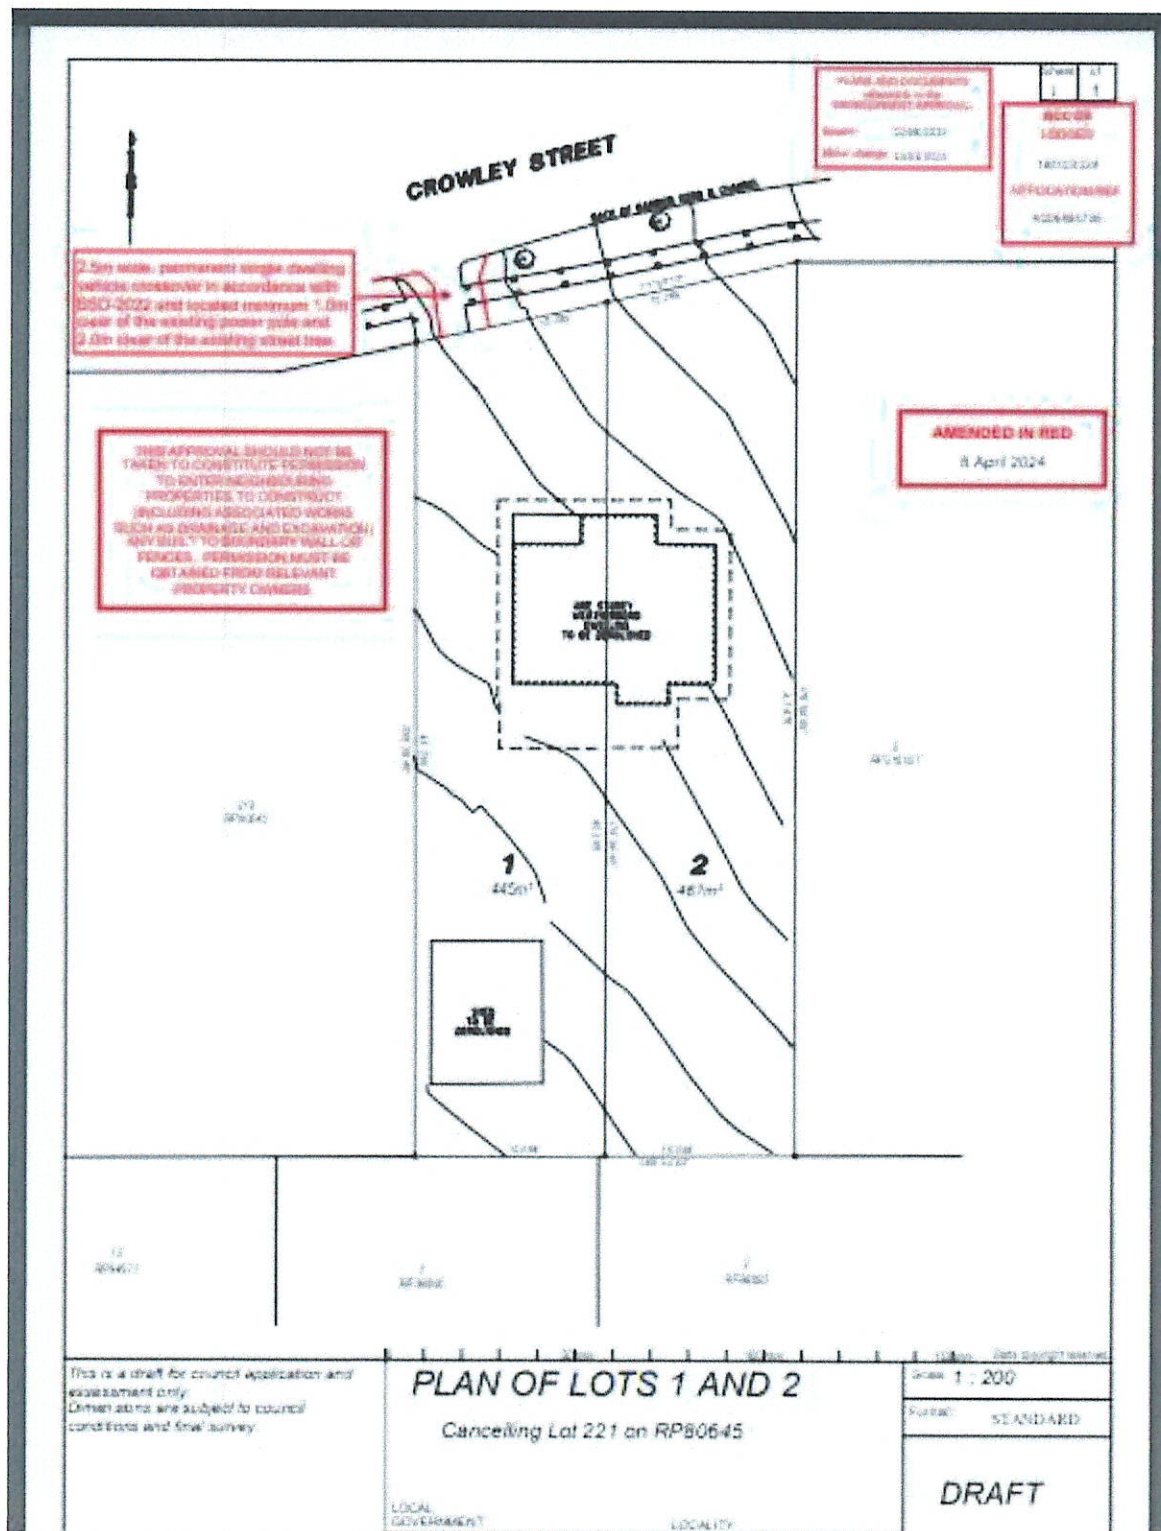

Approved plan of Upslope condition property – No Council red line or “fill the site” condition  
84 Crowley St Zillmere

Deponent


Justice of the Peace

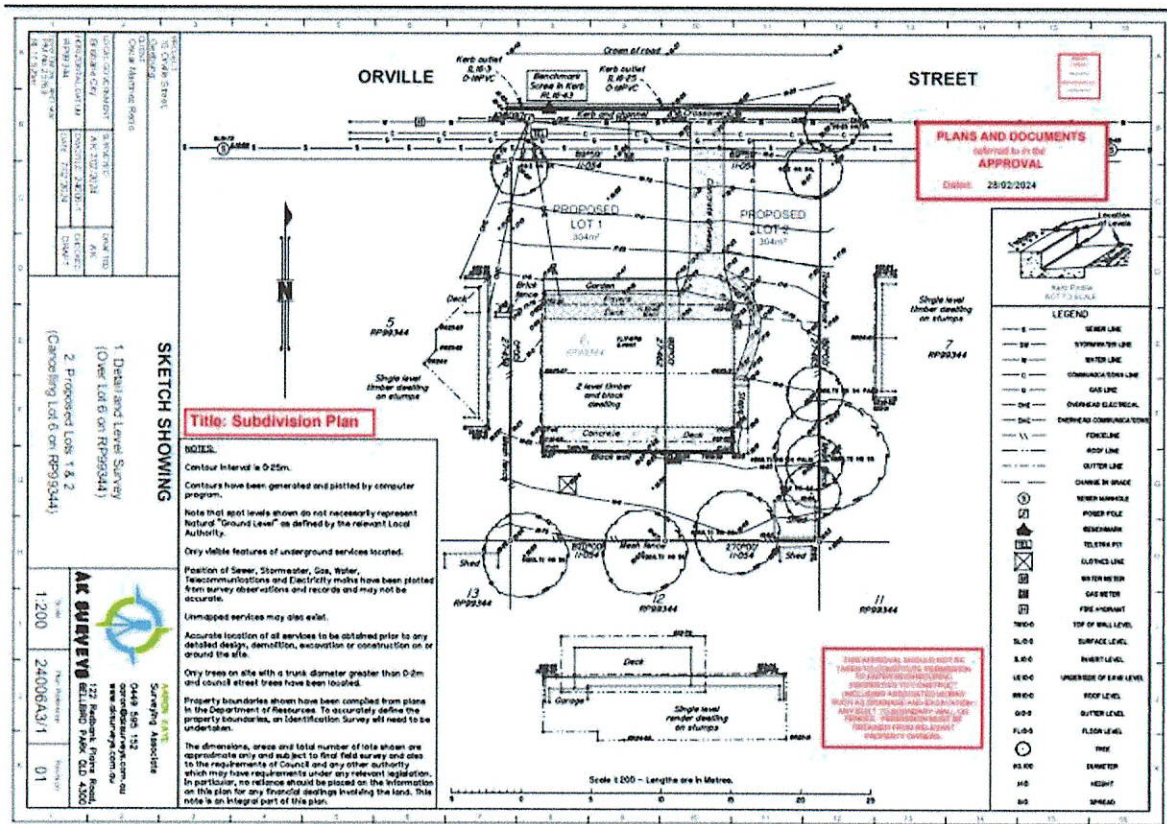

Approved plan of Upslope condition property – No Council red line or “fill the site” condition  
 15 Orville St Geebung


Deponent

Justice of the Peace

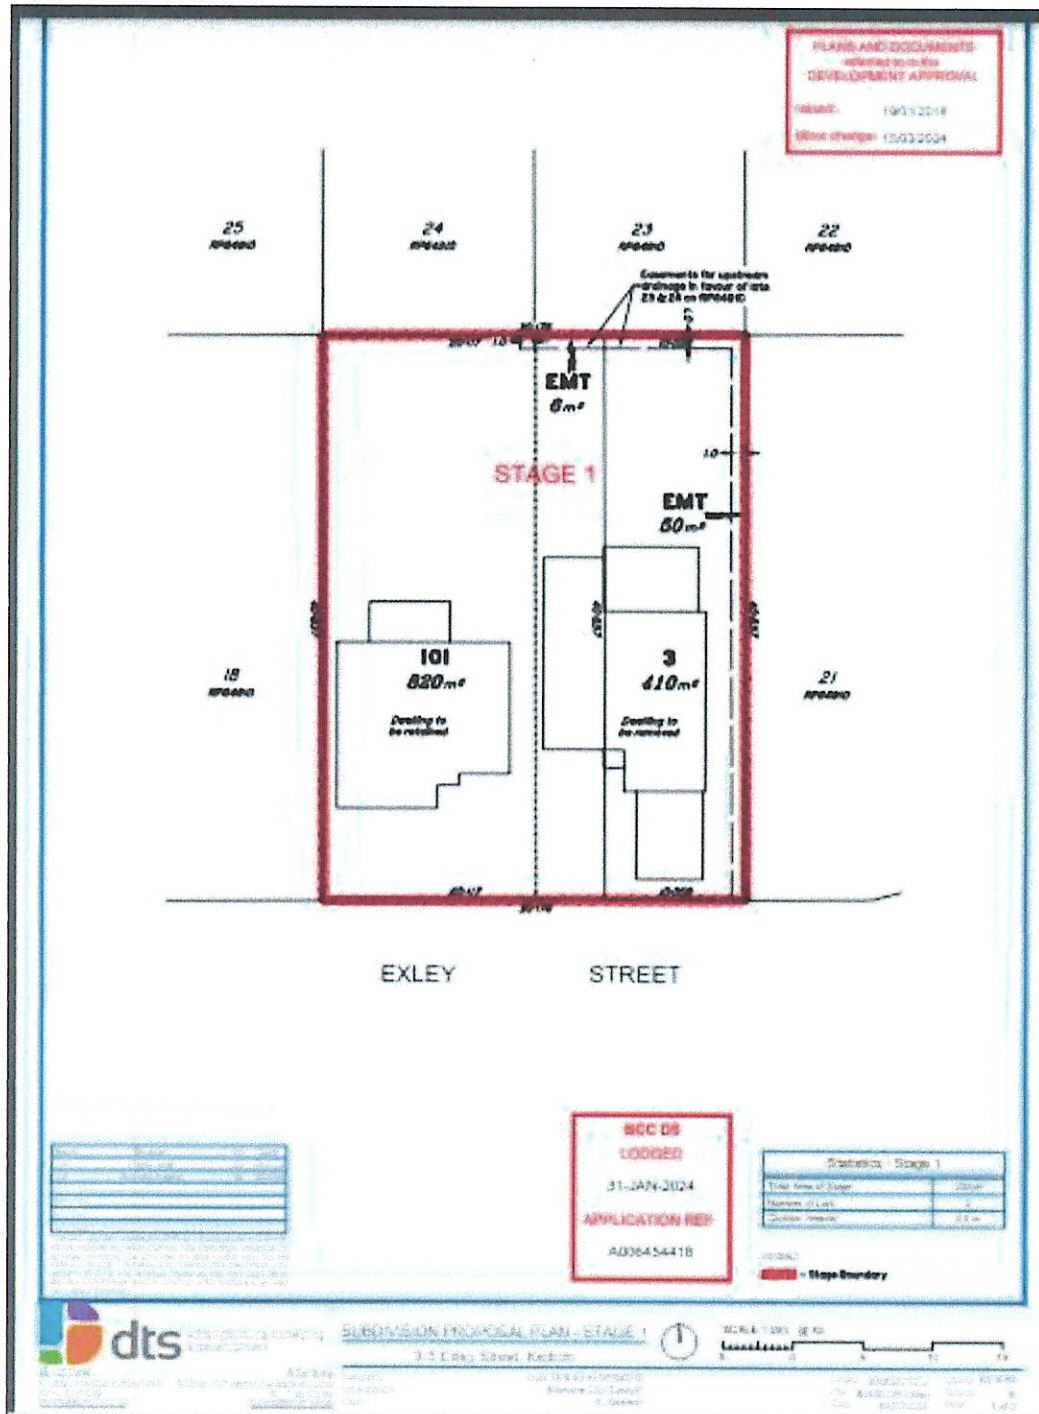

Justice of the Peace

Deponent  Justice of the Peace 

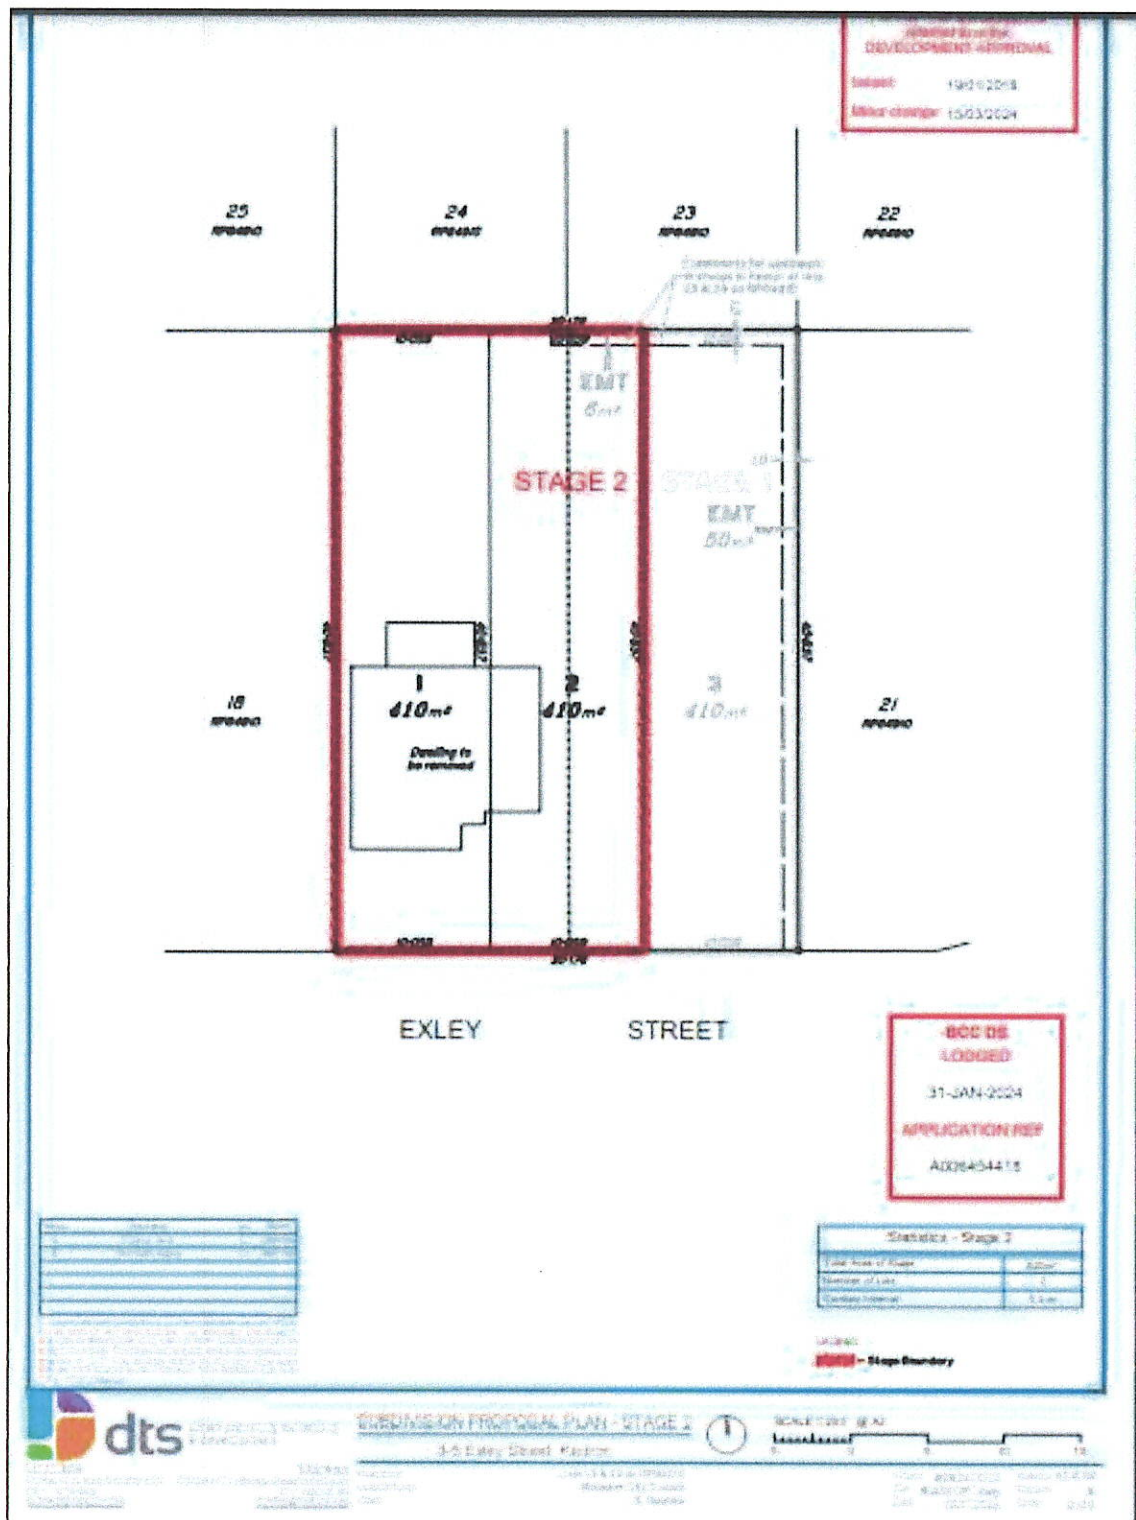


**Approved plan of Upslope condition property – No Council red line or “fill the site” condition**  
**3 Exley St Kedron Stage 2**

Deponent

Justice of the Peace




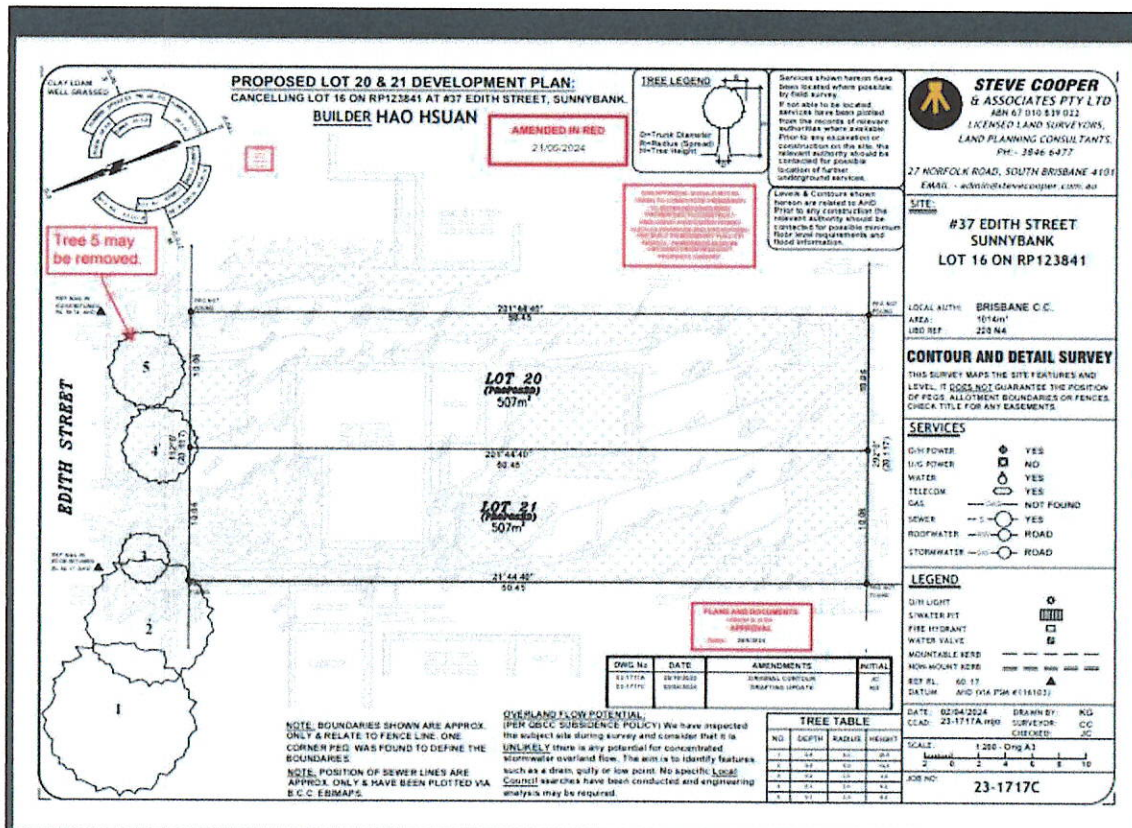

Approved plan of Upslope condition property – No Council red line or “fill the site” condition  
 37 Edith St Sunnybank

Deponent 

Justice of the Peace 

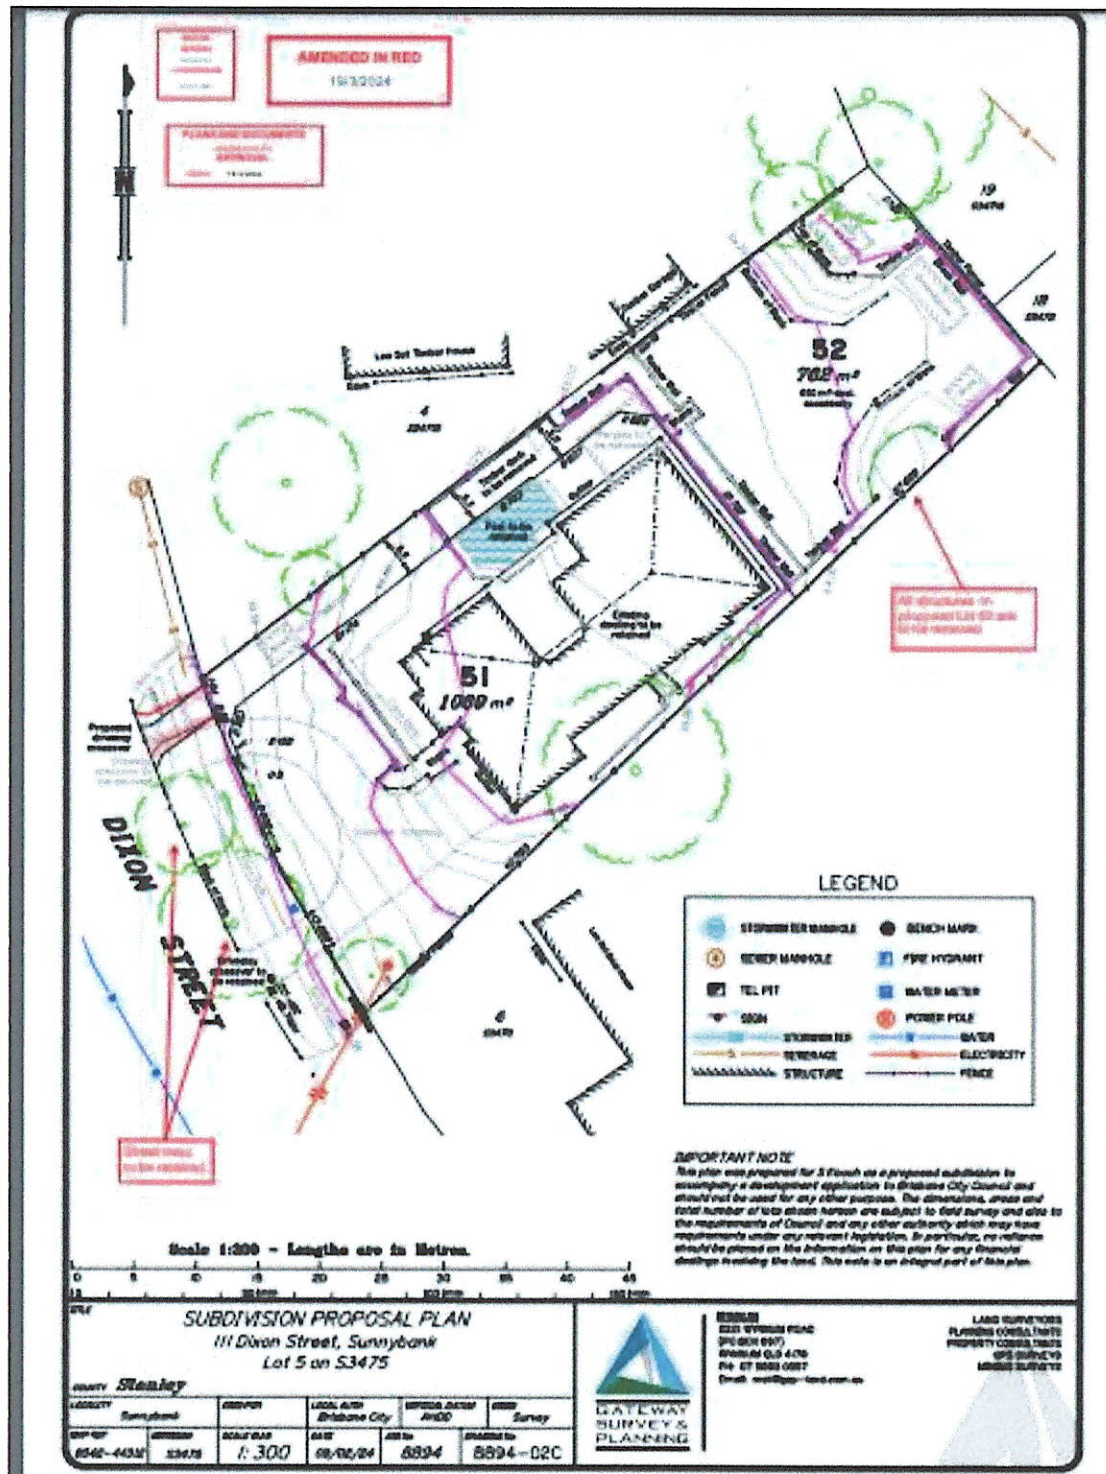


Approved plan of Upslope condition property – No Council red line or “fill the site” condition  
111 Dixon St Sunnybank

Deponent 

Justice of the Peace 

## Justice of the Peace




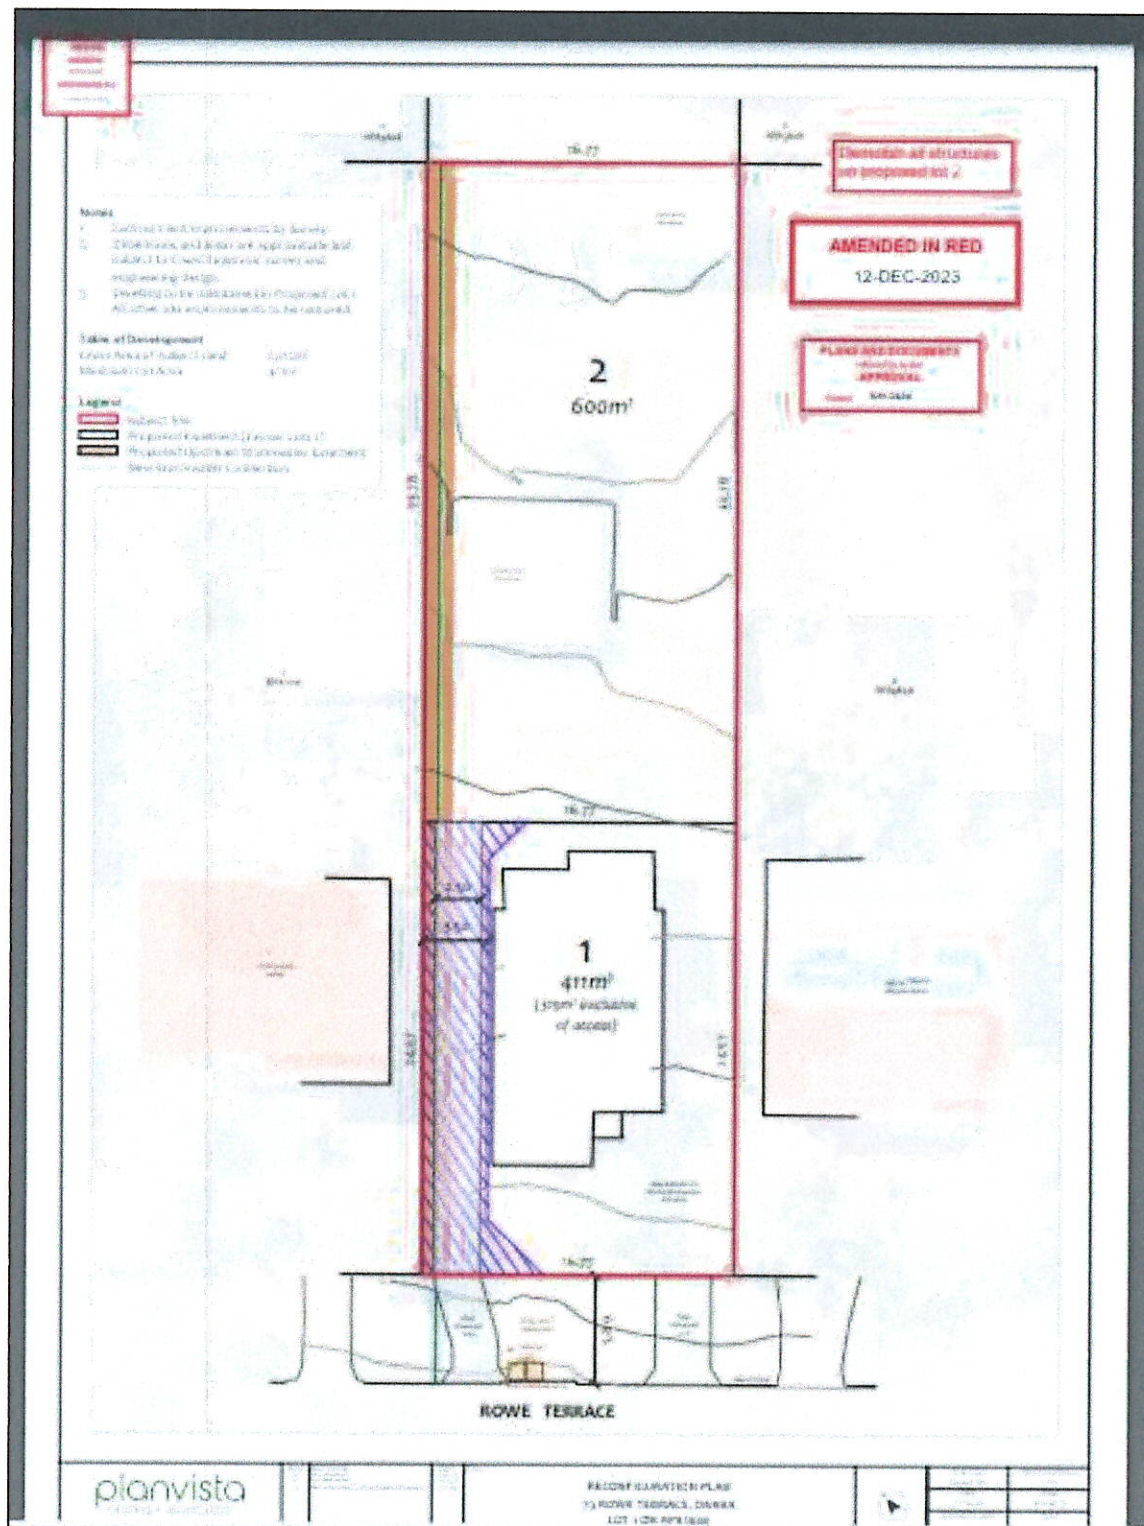

Approved plan of Upslope condition property – No Council red line or “fill the site” condition  
79 Rowe Tce Darra

Deponent \_\_\_\_\_

Justice of the Peace \_\_\_\_\_

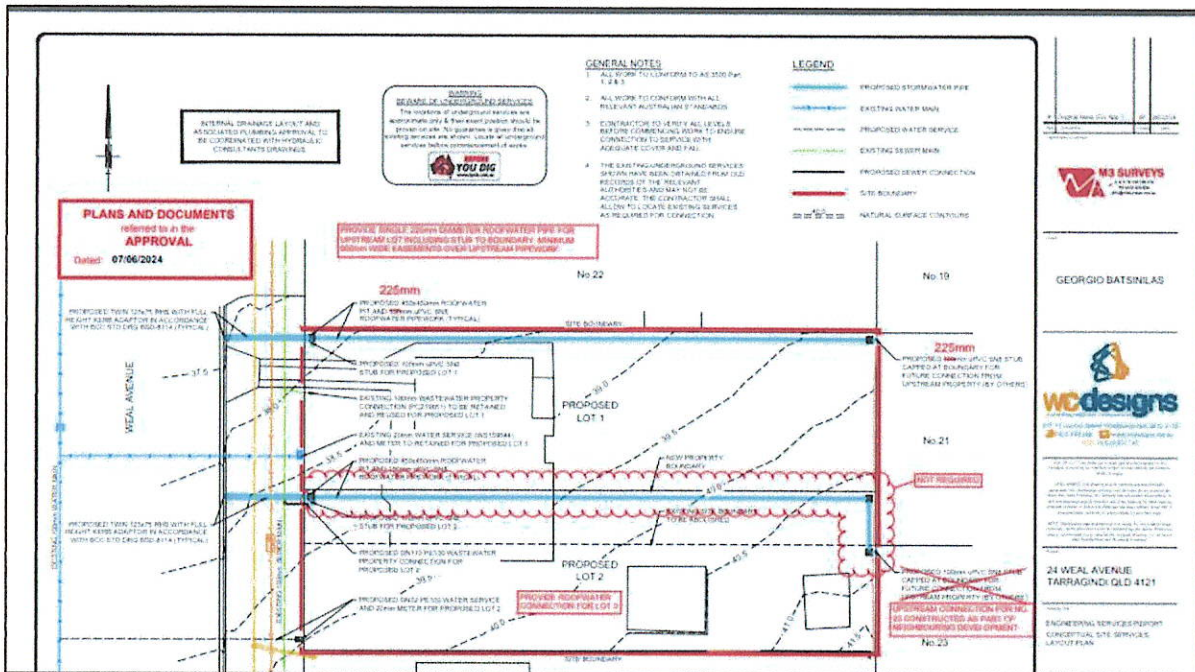

**Approved plan of Upslope condition property – No Council red line or “fill the site” condition  
19 Idriess St Oxley. Note Council correction of 100mm pipe to non-upslope property. Mistake by  
WC Designs.**

**I mention that in the interests of transparency that this is not Council design as such. This is merely making corrections to WC Design mistakes.**

Deponent

Justice of the Peace