



ABBREVIATIONS:

- A/C AIR CONDITIONER COMPRESSOR
 - ALUM. ALUMINUM
 - APPROX. APPROXIMATE
 - C.B.S. CONCRETE BLOCK STRUCTURE
 - C.L. CHAIN LINK
 - CONC. CONCRETE
 - ECB ELECTRIC CONTROL BOX
 - EM ELECTRIC METER
 - F.F. FINISHED FLOOR
 - F.G.P. FENCE GATE POST
 - HP HOSE BIB
 - MP METAL POST
 - RET. RETENTION
 - WD. WOOD
 - WPP WOOD POWER POLE
 - WV WATER VALVE
 - WSP WOOD SERVICE POLE
 - EO ELECTRIC OUTLET
 - TRB TELEPHONE RISER BOX
 - WLP WOOD LIGHT POLE
 - OHV OVERHEAD WIRE
 - MOP METAL GUY POLE
 - PB PHONE BOOT
 - WM WATER METER
 - FH FIRE HYDRANT
 - EL ELEVATION
 - RET. RETAINING
 - GA GUY ANCHOR
 - ESM ELECTRIC SERVICE METER
 - TVRB TELEVISION RISER BOX
 - INV. INVERT
 - RCP REINFORCED CONCRETE PIPE
 - MH MANHOLE
 - E.H. ELECTRIC HANDHOLE
 - SS SANITARY SEWER LINE
 - DIA. DIAMETER
 - VCP VITRIFIED CONCRETE PIPE
 - O.C. OFF CENTER
 - W.P. WOOD POST
 - WS WATER SERVICE
 - COV. COVERED
 - UGE UNDERGROUND ELECTRIC
 - HOSE HOSE BIB
 - EXWA EXISTING WATERLINE
 - WA WATERLINE
 - WL TAPPING SLEEVE
 - FM FORCE MAIN
 - MH MANHOLE
 - HD HIGH DENSITY POLYETHYLENE
 - TEMP. TEMPORARY
 - LF LINEAR FEET
 - BLP BACKFLOW PREVENTOR
 - ST. STORAGE
 - ELEV. ELEVATOR
 - ELEC. ELECTRIC
- 7 REGULAR PARKING SPACE COUNT
- Handicap Parking Space

Marina Village, A Condominium, Phase 1 contains a 4-story building with a total of 18 living units, 36 garage parking spaces, 7 regular parking spaces and 1 handicap parking space

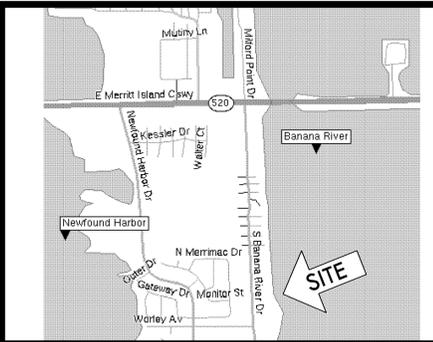

LOCATION MAP
NOT TO SCALE

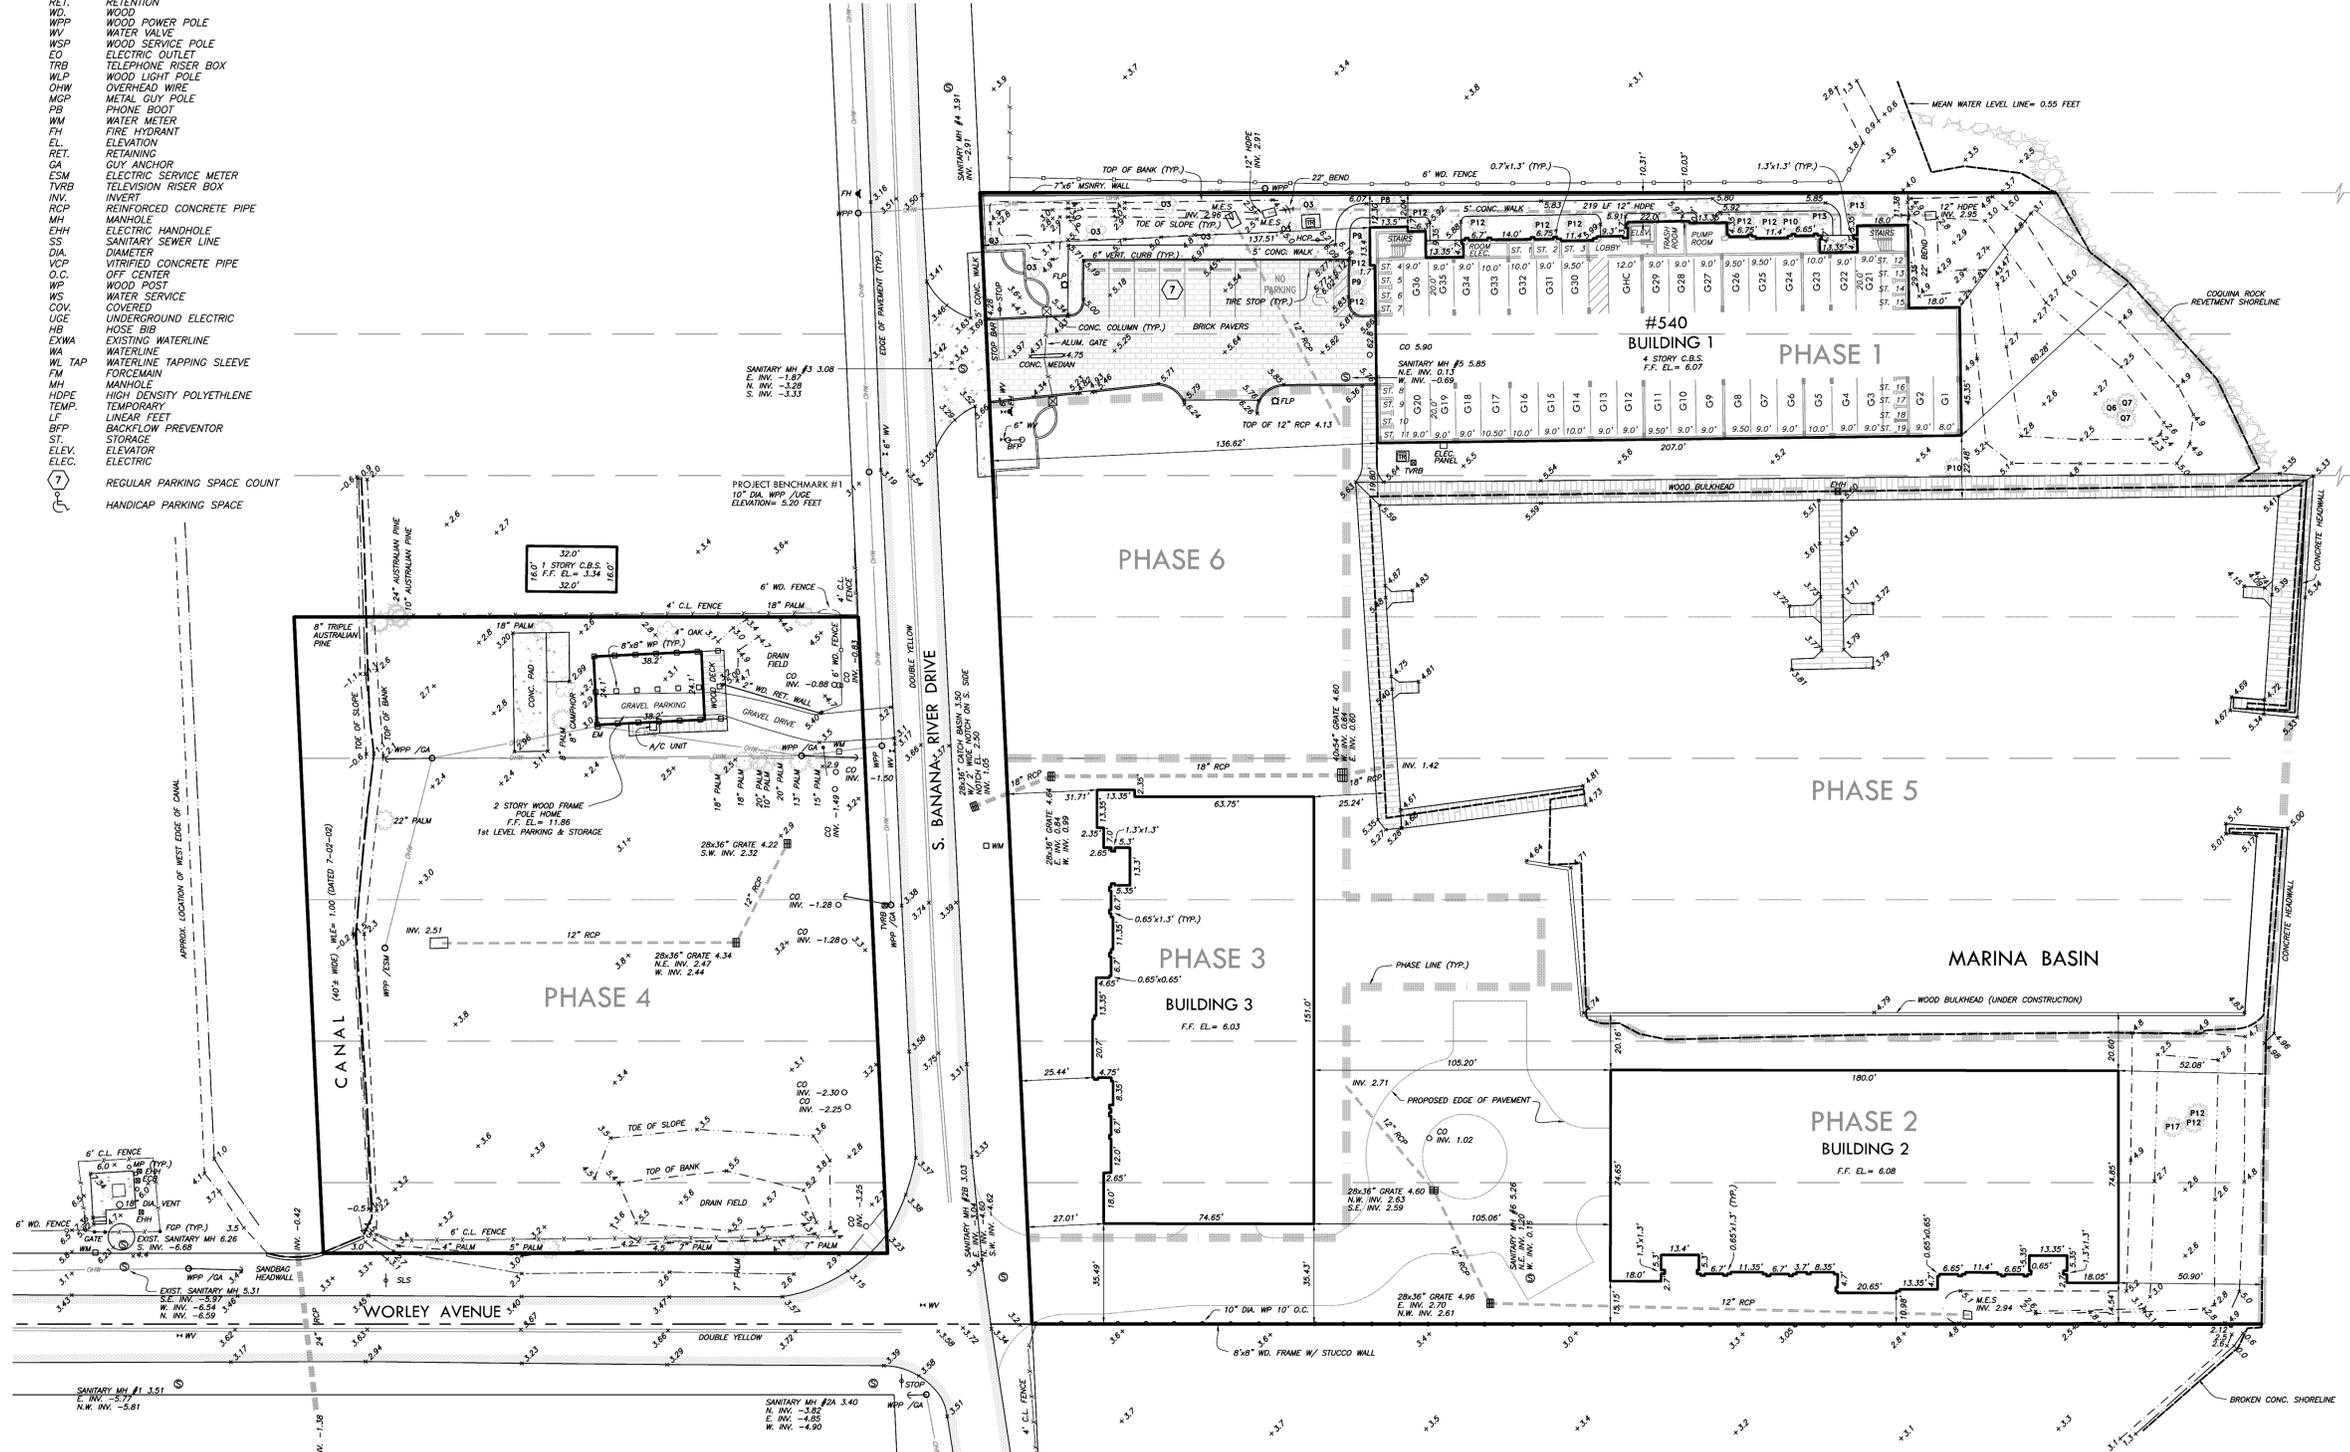

BANANA RIVER
M.E. = 0.73 FEET (DATED 7-12-02)

SURVEYOR'S NOTES:

1. THIS IS NOT A BOUNDARY SURVEY. Refer to Boundary, Topographic, Tree & Mean High Water Survey prepared by Allen Engineering, Inc., Job Number 020090, last date of field survey, March 29, 2004.
2. The elevations shown herein are based on National Coast and Geodetic Survey Benchmark Q-205, elevation 6.201 National Geodetic Vertical Datum of 1929.
3. Unless otherwise shown or noted underground utilities were not located by this survey.

SURVEYOR'S CERTIFICATION:

I hereby certify that the attached sketch is an accurate representation of a Paving & Drainage As-Built Survey performed under my direction, in accordance with all applicable requirements of the "Minimum Technical Standards," for surveys, described in Chapter 61G17-6, Florida Administrative Code, pursuant to Chapter 472.027, Florida Statutes.

ALLEN ENGINEERING, INC.

BY: JOSEPH C. BAKER
Professional Surveyor & Mapper
Florida Registration No. 4222

Not valid without the signature and the original raised seal of a Florida licensed surveyor and mapper.

SITE PLAN NO.: SP #02-10-012
BUILDING 1 PERMIT NO.: M0152537

COPYRIGHT © 2005 ALLEN ENGINEERING, INC.

FOR:	HARBOR HOMES, LLC	SURVEY DATE:	8-11-05
	SKETCH OF PAVING & DRAINAGE AS-BUILT SURVEY MARINA VILLAGE CONDOMINIUM, PHASE 1 OF A PORTION OF SECTION 31, TOWNSHIP 24 S., RANGE 37 E. BREVARD COUNTY, FLORIDA	SCALE:	1" = 30'
	ALLEN ENGINEERING, INC. FLORIDA CERTIFICATE OF AUTHORIZATION No. LB 286 106 DIXIE LANE COCOA BEACH, FLORIDA 32931 TELEPHONE: (321)783-7443 - FAX: (321)783-5902 WEBSITE: www.alleneng.net - EMAIL: info@alleneng.net	JOB NO.:	020090
		DRAWN:	DJG
		SHEET NO.:	1 OF 1

NO.	DATE	REVISIONS	CHK'D
1	8-16-05	COUNTY COMMENTS	DJG