



860-243-9000

LANDSCAPE AND IRRIGATION
P.O. BOX 336, BLOOMFIELD, CT. 06002
BUSINESS REG.# B-0146
Home Improvement #534695; Irrigation Contractor #280012

November 15, 2004

The Common at Sinnott Farm
Attn: Edie Thompson
PO Box 681
Bloomfield CT 06002

Dear Edie,

The following is the information requested about the irrigation systems at The Common at Sinnott Farms:

✓ **Terry Plains Road Left side of entrance:**

Installed one (1) zone irrigation system – September 5, 2002

Terry Plains Road Right side of entrance:

Installed one (1) zone irrigation system – September 5, 2002 (no water yet)

Installed backflow and connected to water meter service * – September 7, 2004

Spice Bush Lane island:

Installed four (4) zone irrigation system – August 21, 2002

✓ **Spring Hill Lane island:**

Installed six (6) zone irrigation system – September 4, 2002 (no water yet)

Installed backflow and connected to water meter service* – September 3, 2004

Quail Run Lane island:

Installed three (3) zone irrigation system – September 19, 2002

Timothy Lane island:

Installed one (1) zone irrigation system – September 2, 2004

Arrowwood Lane larger island:

Installed three (3) zone irrigation system – September 7, 2004

Arrowwood Lane smaller island:

Installed one (1) zone irrigation system – September 2, 2004

**Water meter service was installed by another company*

If you have any other questions feel free to call anytime. I have also enclosed as-builts (3 copies each) for each location.

Regards,


Angelia Jarvis – Office assistant


 Hunter SVC Battery Operated Controller

Febco 825 3/4" Backflow

The Common at Sinnott Farm
Terry Plains Road Entrance
Right & Left Sides
Bloomfield CT 06002


 Hunter SVC Battery Operated Controller

The Green Machine, Inc.
1345 Blue Hills Ave
PO Box 336
Bloomfield CT 06002
(860) 243-9000

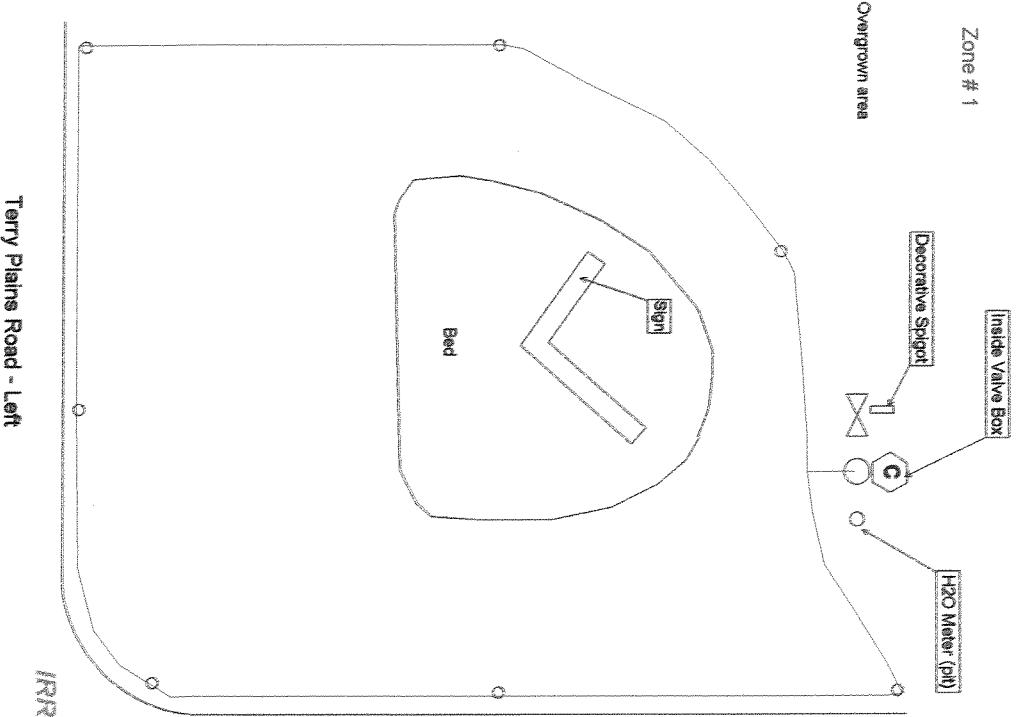

Installed By:
John, Ivan
Joergin
09/05/02


IRRIGATION ASBUILT
NOT TO SCALE

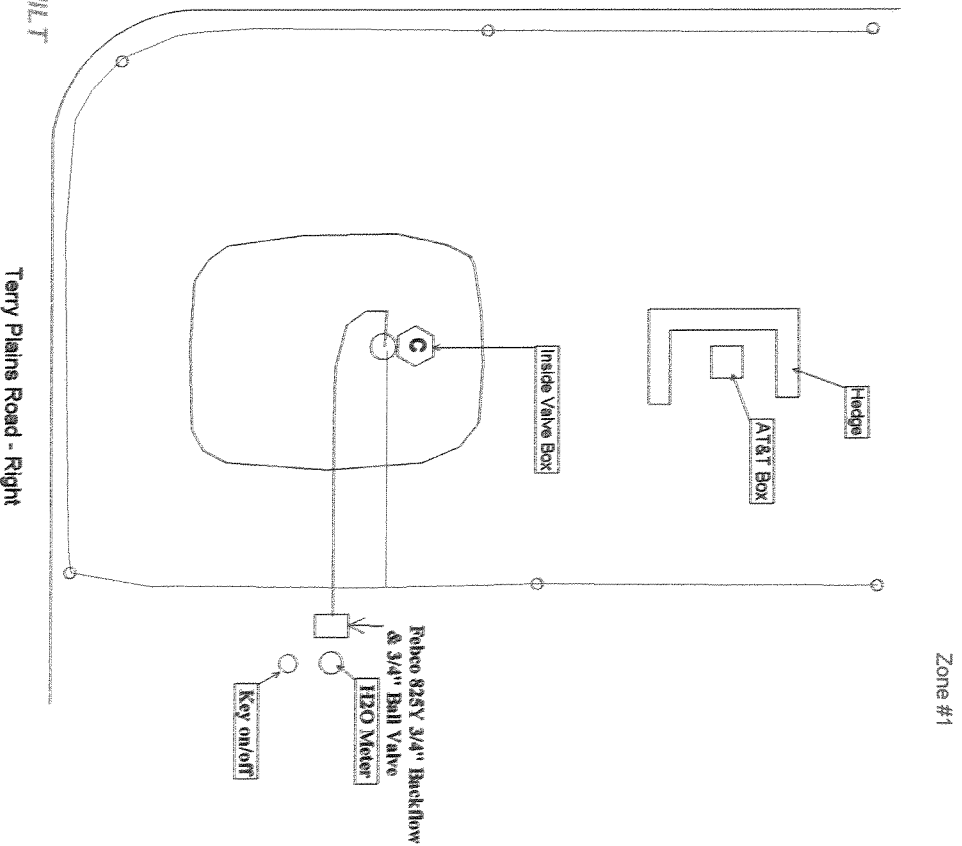

The Green Machine, Inc.
1345 Blue Hills Ave
Bloomfield CT 06002
(860) 243-9000

IRRIGATION AS-BUILT
NOT TO SCALE

The Common at Sinnott Farm
Arrowwood Lane (Small island)
Bloomfield CT 06002

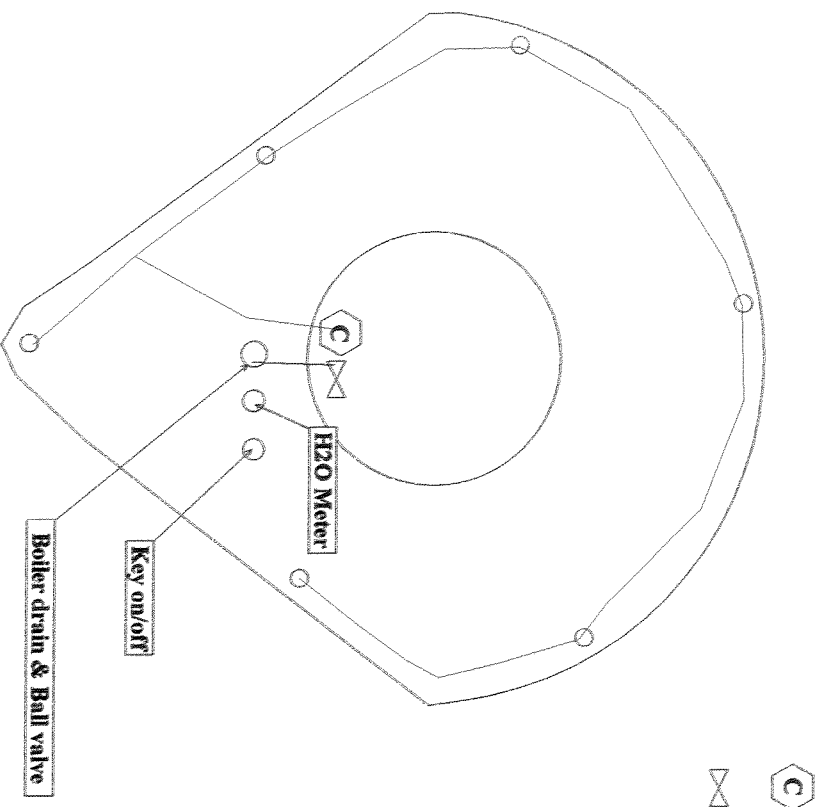

⬡ Hunter SVC Battery Op. Controller
↔ Febco 825Y 3/4" Backflow

Zone # 1


Installed:
September 2, 2004

The Green Machine, Inc.
1345 Blue Hills Ave
Bloomfield CT 06002
(860) 243-9000

IRRIGATION AS-BUILT
NOT TO SCALE

The Common at Simnott Farm
Timothy Lane (island)
Bloomfield CT 06002

Hunter SVC Battery Op. Controller
Febco 825Y 3/4" Backflow

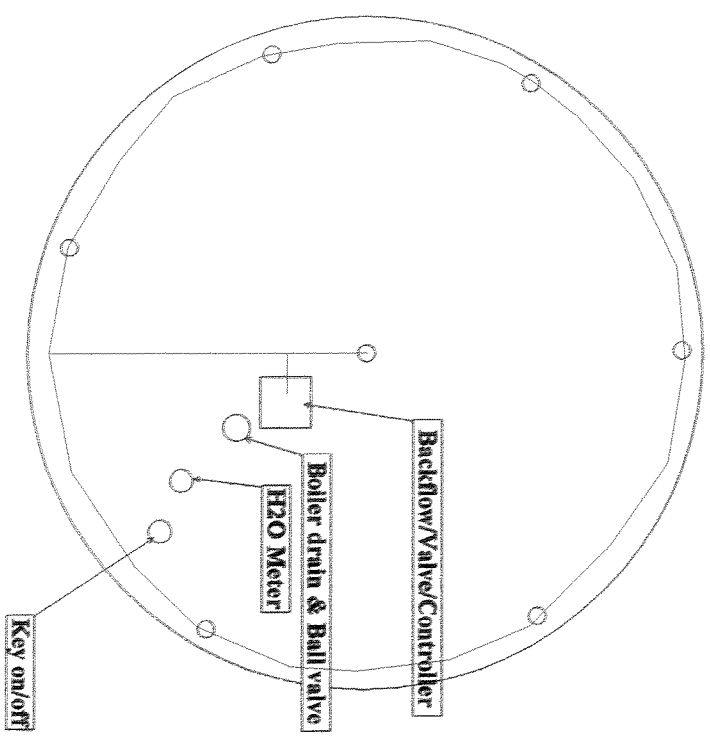


Installed:
September 2, 2004

The Green Machine, Inc.
1345 Blue Hills Ave
Bloomfield CT 06002
(860) 243-9000

 **Hunter SVC Battery Op. Controller**
In the valve box

 **Febco 825Y 3/4" Backflow**

Zone # 1
Zone # 2
Zone # 3

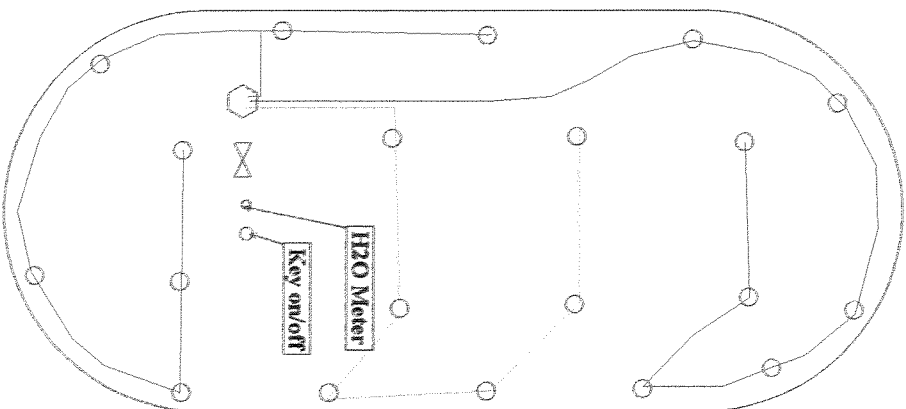

IRRIGATION AS-BUILT
NOT TO SCALE


The Common at Sinnott Farm
Arrowwood Lane (Large Island)
Bloomfield CT 06002

Installed:
September 7, 2004

The Green Machine Inc.
1345 Blue Hills Ave
PO Box 336
Bloomfield CT 06002
(860) 243-9000

IRRIGATION ASBULT
NOT TO SCALE

The Common at Sinnott Farm
Quail Run Lane (turn around)
Bloomfield CT 06002

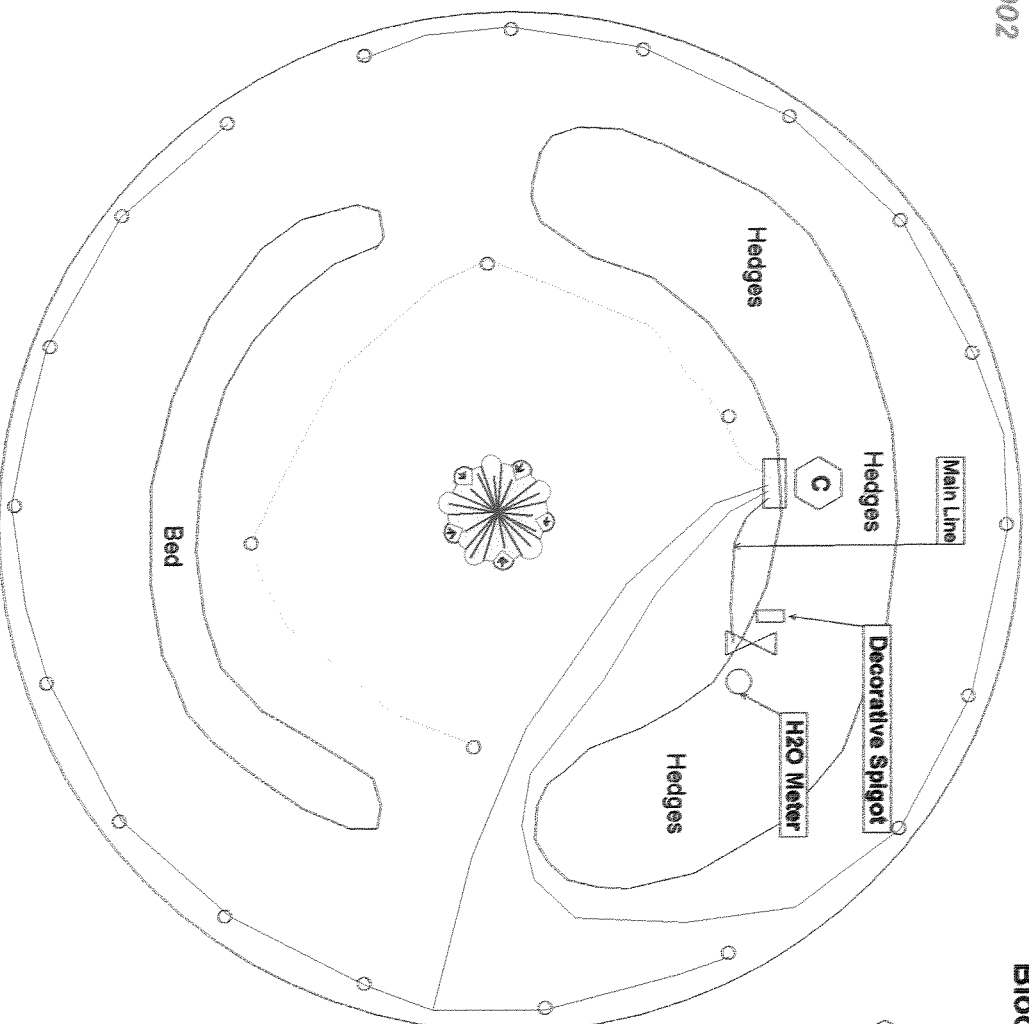

 Miracle Battery Operated Controller

 Febco 825 1" Backflow

Zone # 1

Zone # 2


Zone # 3

Installed By:
John, Ivan
Junior, Daniel
Sammy & Joaquin
09/05/02

IRRIGATION ASBUILT
NOT TO SCALE

The Green Machine, Inc.
1345 Blue Hills Ave
PO Box 336
Bloomfield CT 06002
(860) 243-9000

Installed By:
John, Ivan
Joachim
09/05/02

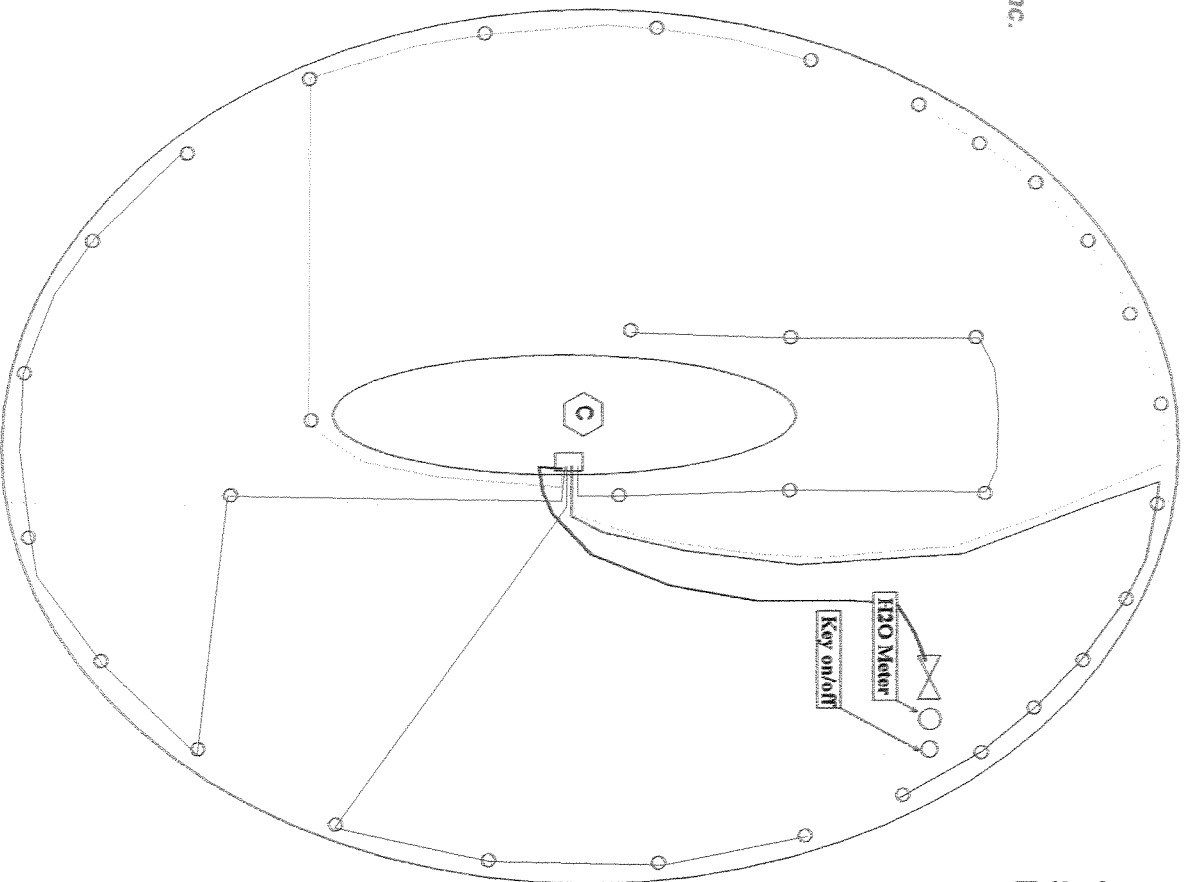

The Common at Sinnott Farm
Spring Hill Lane (turn around)
Bloomfield CT 06002

 Miracle Battery Operated Controller
 Febco 825 3/4" Backflow


Zone # 1
Zone # 2
Zone # 3
Zone # 4
Zone # 5
Zone # 6



The Green Machine, Inc.
1345 Blue Hills Ave
PO Box 336
Bloomfield CT 06002
(860) 243-9000

Installed By:
John, Ivan
Daniel, Sammy
Junior & Joaquin
09/05/02

IRRIGATION ASBUILT
NOT TO SCALE

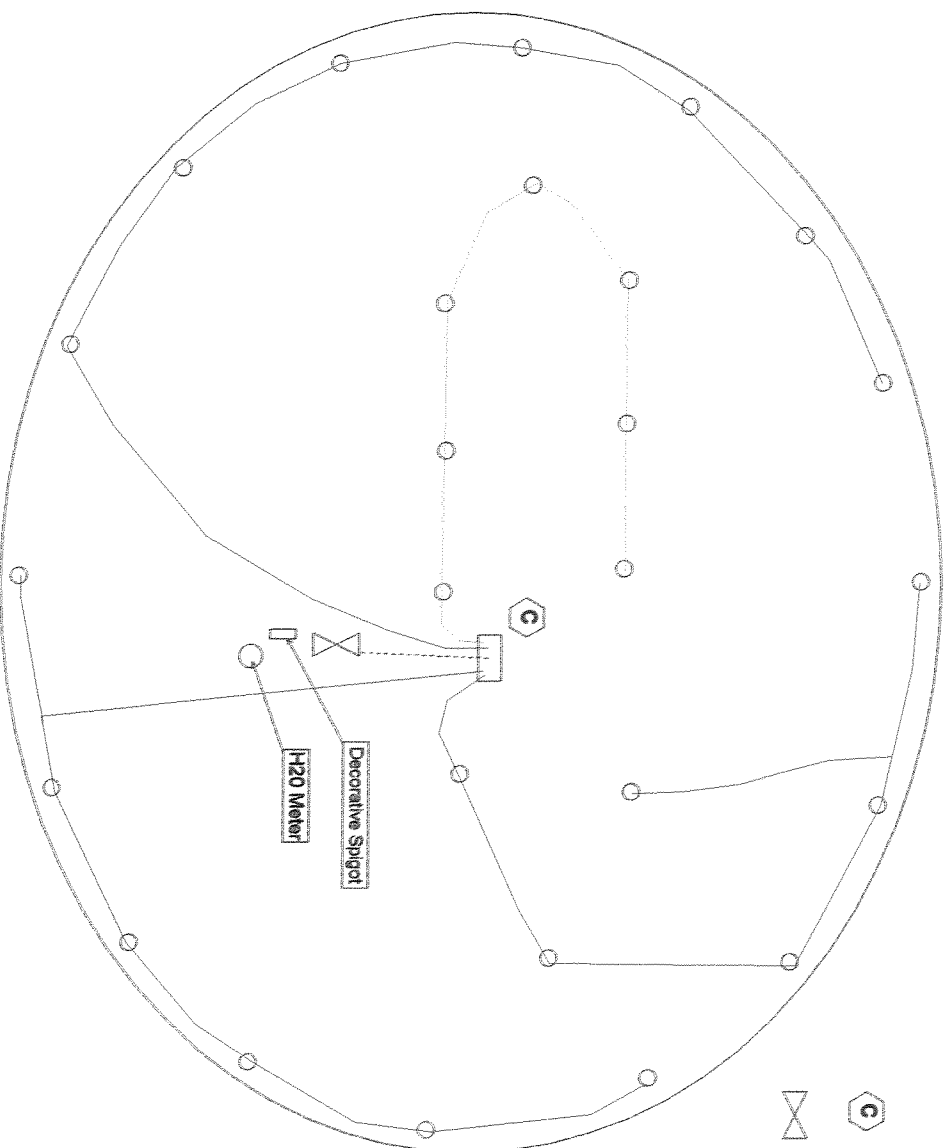The Common at Sinnott Farm
Spice Bush Lane (turn around)
Bloomfield CT 06002



 Miracle Battery Operated Controller
 Febco 825 1" Backflow

Zone # 1
Zone # 2
Zone # 3
Zone # 4