



B. 9 Paae 38 (2016)

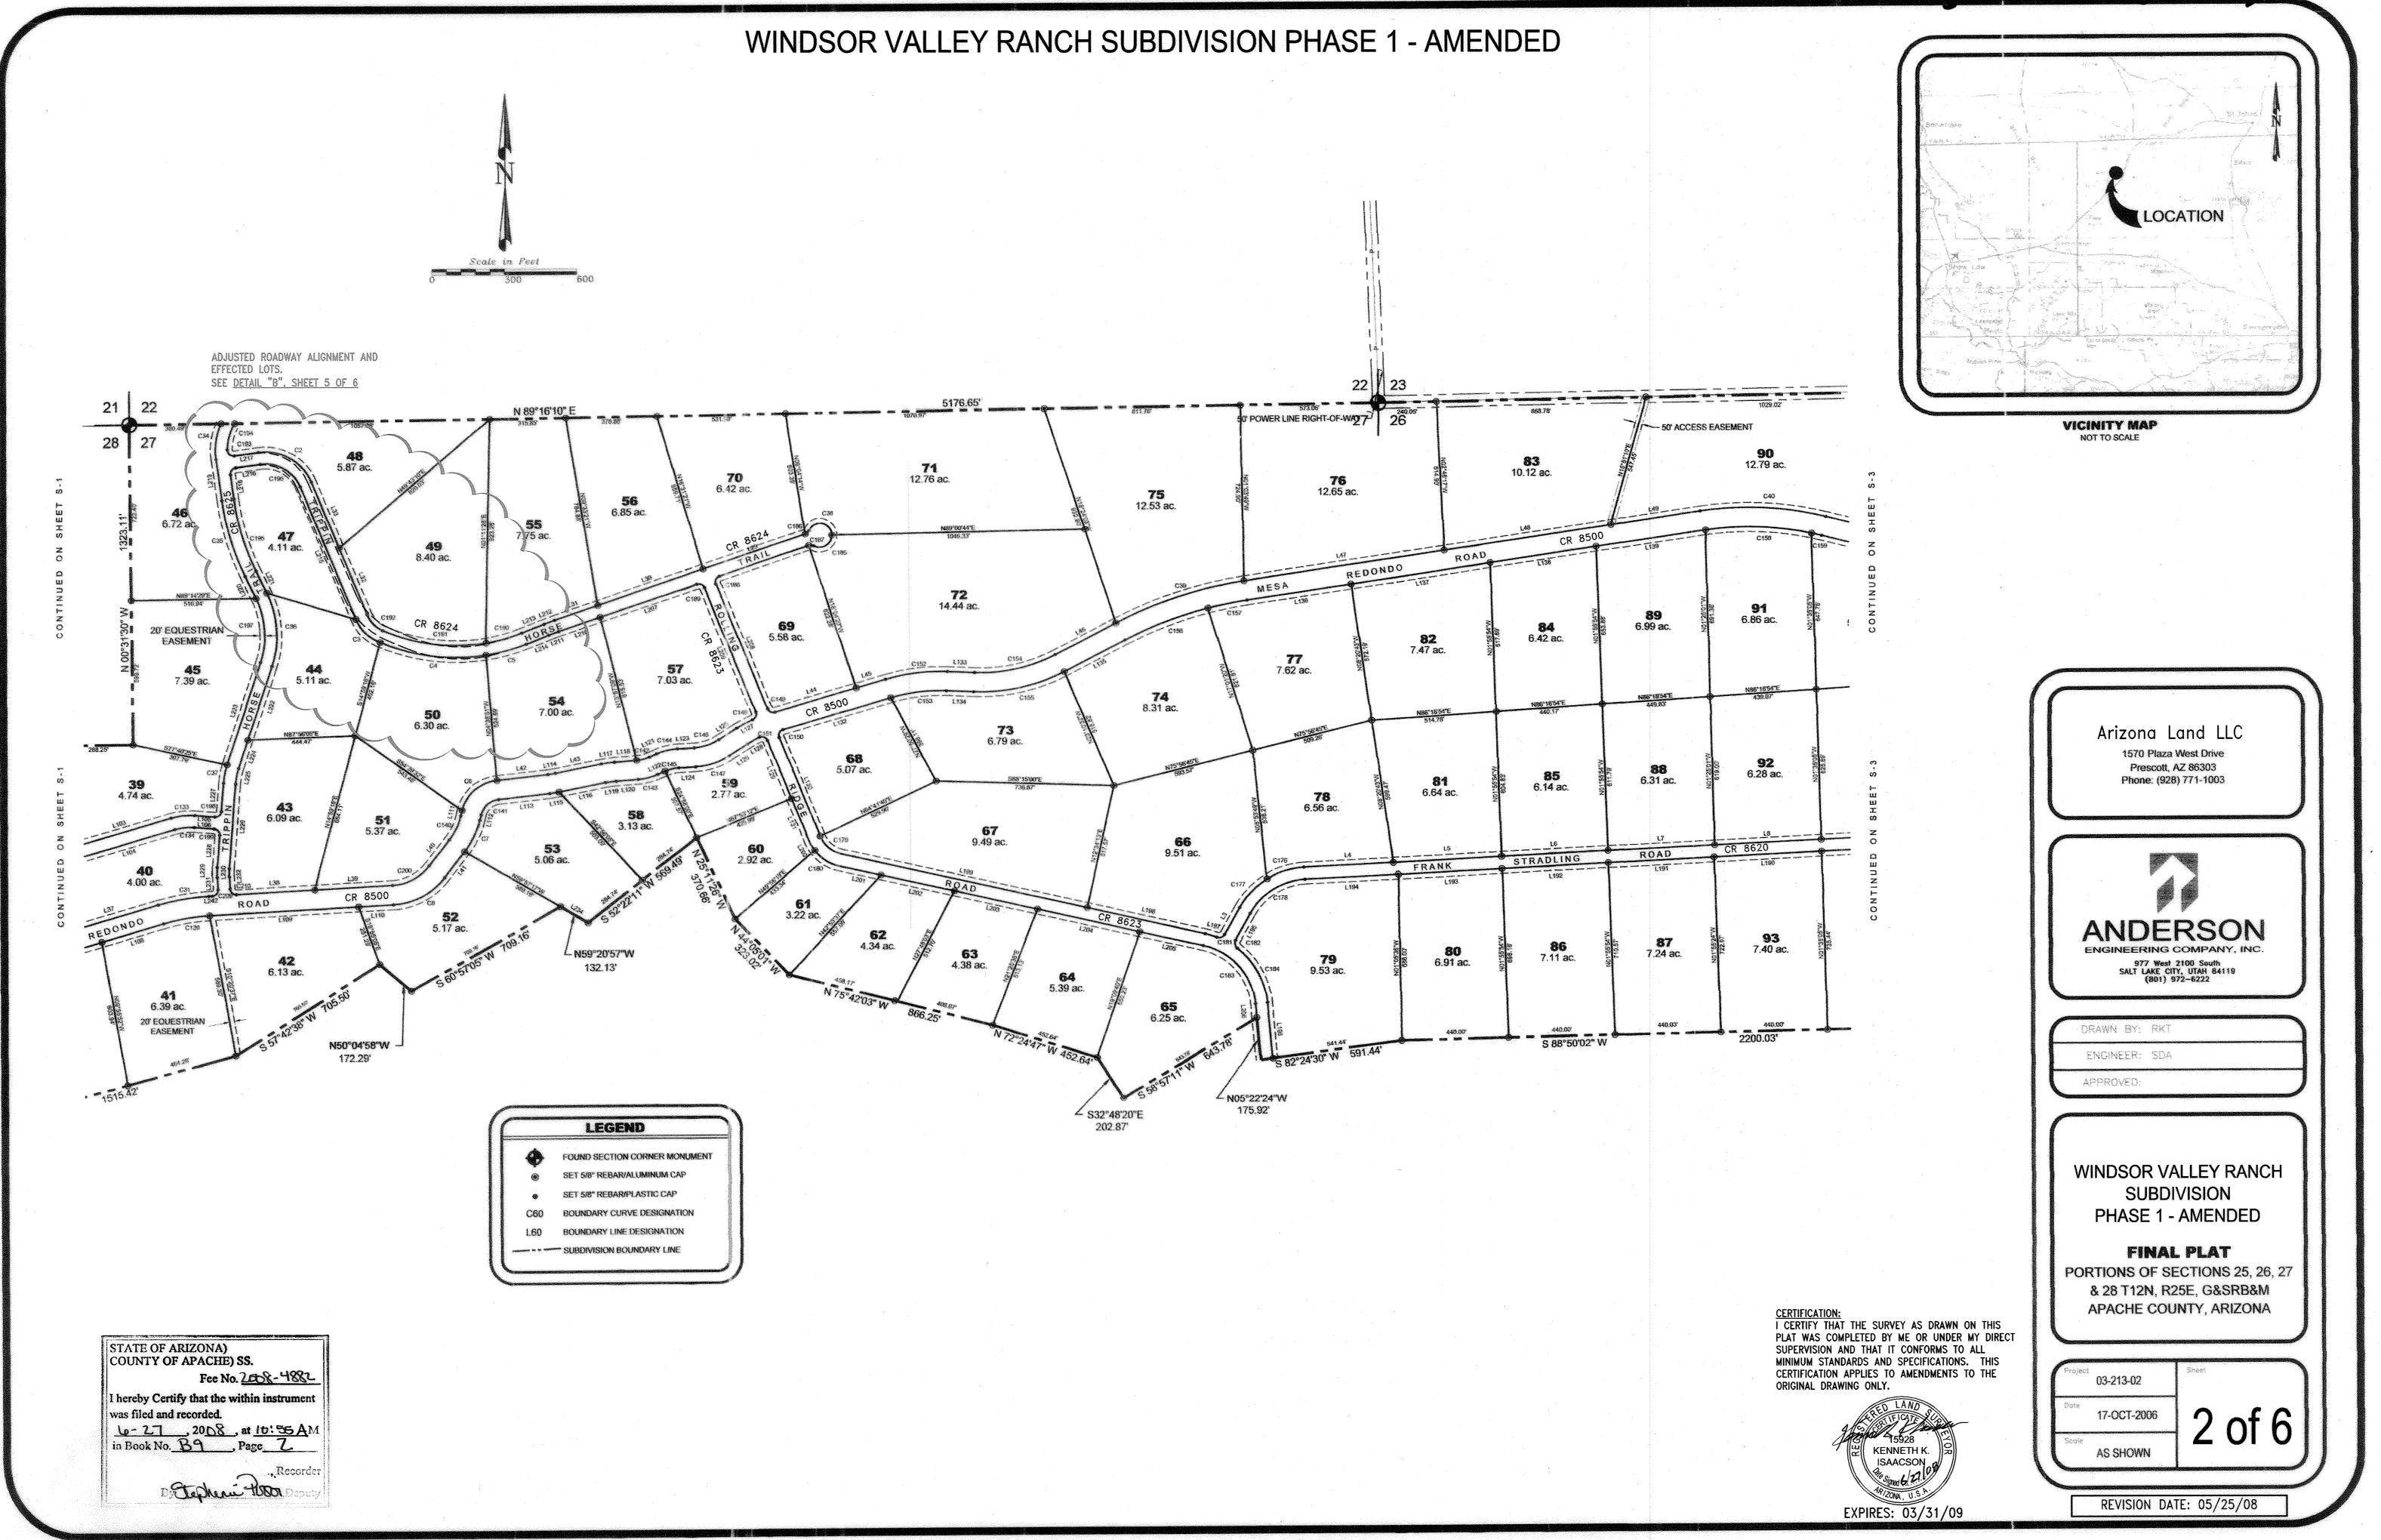

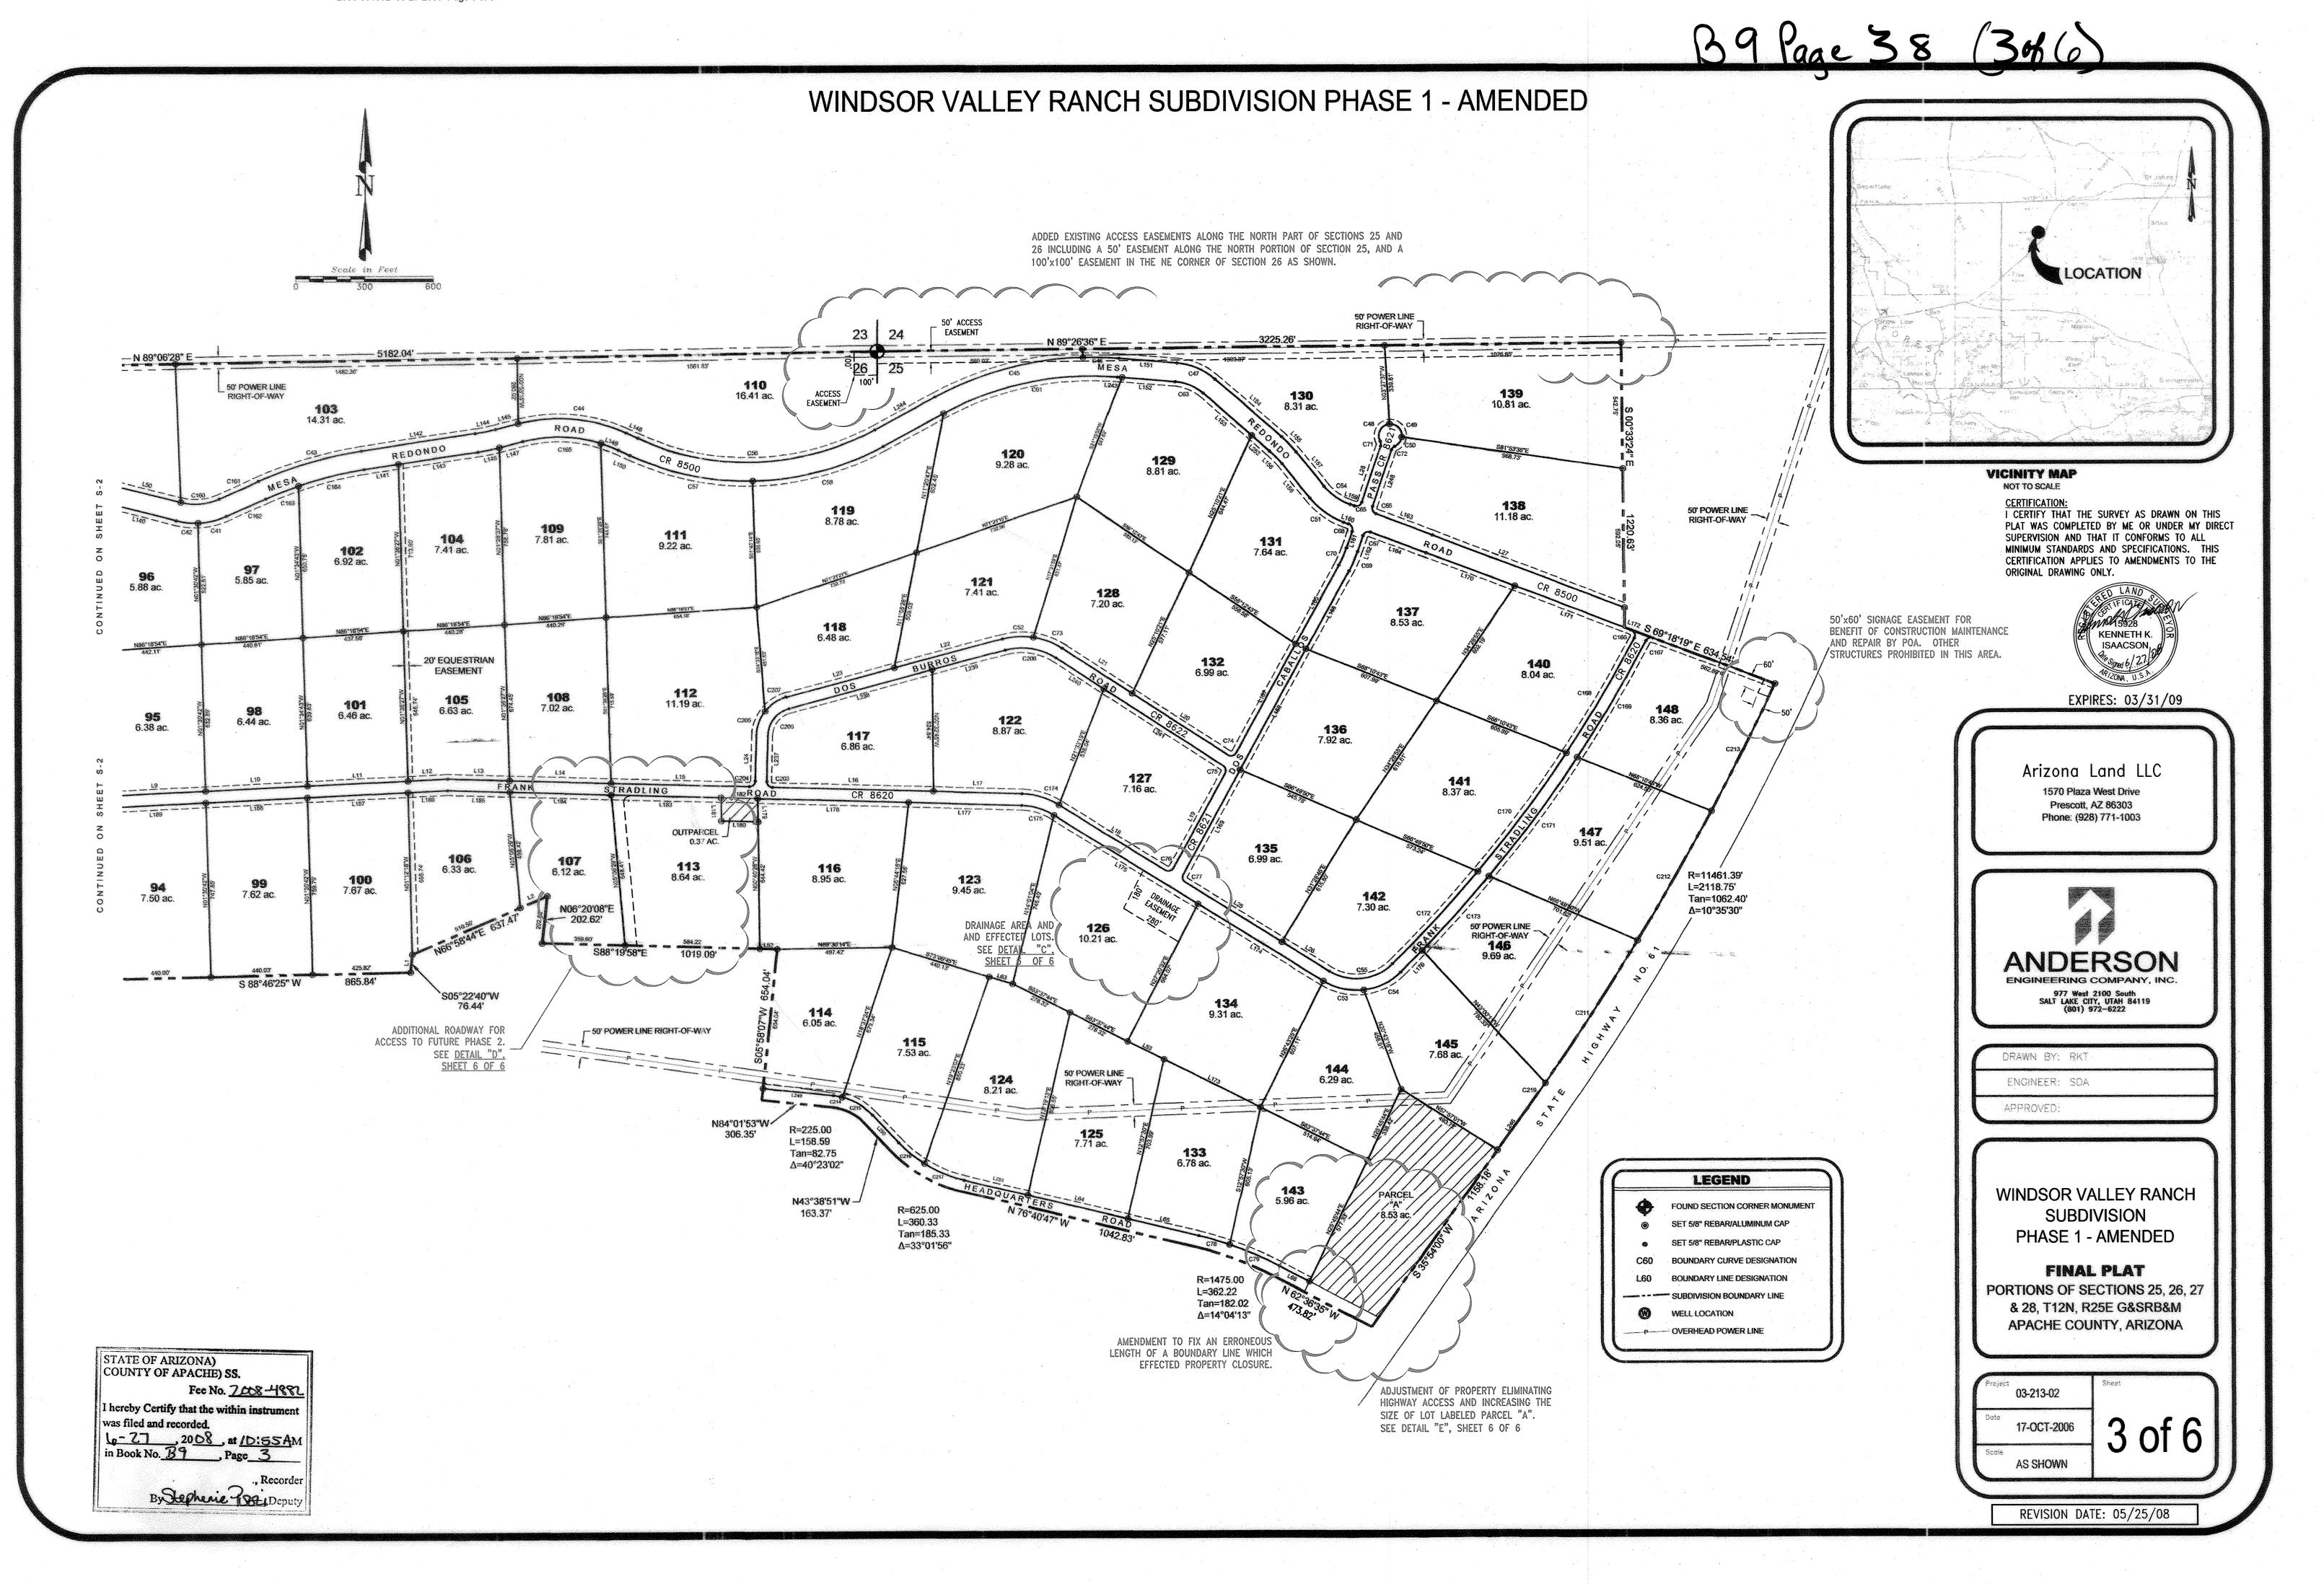

	LINE TABL	
INE	LENGTH	BEARING
L1	76.44	N05°22'40"E
L2	126.92	N66°58'44"E
L3	126.71	N29"31'31"E
L4	371.50	N87°13'11"E
L5	447.63	N87°13'11"E
L6	440.01	N87°13'11"E
L7	444.11	N87°13'11"E
L8	440.69	N87°13'11"E
L9	441.10	N87°13'11"E
L10	441.15	N87°13'11"E
L11	437.70	N87°13'11"E
L12	172.73	N87°13'11"E
L13	267.74	S88°19'58"E
L14	440.72	S88°19'58"E
L15	599.68	S88"19'58"E
L16	698.70	S88°19'58"E
L17	382.93	S88°19'58"E
L18	539,92	S58°30'21"E
L19	463.81	N28°53'14"E
L20	491.60	N57°07'54"W
L21	361.70	N57°07'54"W
L22	484.19	S75°05'34"W
L23	484.19	S75°05'34"W
L24	196.86	S01°40'02"W
L25	491.86	S58°30'21"E
L26	239.79	S58°30'21"E
L27	1149.49	S69°28'17"E
L28	252.14	N19°01'12"E
L29	446.90	S71°27'04"W
L30	460.07	S71°27'04"W
L31	188.23	S71°27'04"W
L32	\^\\\\\\\\\\\\\\\\\\\\\\\\\\\\\\\\\\\\	/XXXXXXXXX
L33	\\\\\\\\\\\\\\\\\\\\\\\\\\\\\\\\\\\\\\	/NEC-VECTAIN
L34	461.22	S89°00'53"E
L35	96.05	S59°11'41"E
L36	319.17	N73°57'00"E
L37	390.29	N73°57'00"E
L38	324.02	N86°53'53"E
L39	324.02	N86°53'53"E
L40	135.83	N38°08'32"E
L41	135.83	N38°08'32"E
L42	213.57	N83°47'32"E
L43	194.70	N78°44'14"E
L44	352.07	N73°46'18"E
L45	125.81	N73°46'18"E
L46	285.13	N62°40'05"E
L47	838.19	N81°39'17"E
L48	696.77	N81°39'17"E
L49	377.31	N81°39'17"E

	LINE TABLE	
INE	LENGTH	BEARING
52	75.27	S83°19'58"E
53	175.93	S63°37'44"E
54	106.79	N14°31'41"E
55	76.98	N14°22'25"W
56	317.17	N13°45'31"E
57	277.21	N13°45'31"E
58	185.73	N71°57'13"E
59	56.71	N71°57'13"E
60	67.72	N11°09'57"E
.61	178.09	N67°37'44"E
62	\\\\\\\\\\\\\\\\\\\\\\\\\\\\\\\\\\\\\\	\80008U9E
33	105.07	S73°09'45"E
34	446.97	S76°40'47"E
35	314.15	S76°40'47"E
36	146.19	S62°36'34"E
37	76.53	S86°25'26"E
S8	115.98	S85°25'26"E
69	38.07	S86°25'26"E
70	261.63	N85°29'24"E
71	355.54	N85"29'24"E
72	120.52	N75°37'35"E
73	V31022V	\XX5%\Z\X\E/
74	V2748/	VINCOUTOW.
75	\\\\\\\\\\\\\\\\\\\\\\\\\\\\\\\\\\\\\\	AND SOUTHING
6	338.57	N75°37'35"E
77	361.32	N32°00'08"W
78	292.30	N32°00'08"W
79	265.25	S32°00'08"E
30	267.40	S32°00'08"E
81	178.79	N67°37'44"E
82	595.06	N13°45'31"E
33	396.84	S07°39'13"E
.~ }4	398.31	S07°39'13"E
 35	279.51	S04°45'17"E
 16	187.79	S04°45'17"E
<del>70</del> 37	271.52	S04°45'17"E
,, 38	195.69	S04°45'17"E
30 39	375.06	S04°45'17"E
90	32.19	N71°57'13"E
enterenterenterenterenterenterenterente		anisaterina - commence per propries e consequence (1777) e transcribe e consequence (1777) e transcribe e conse
31 ~	210.26	N71°57'13"E
32 	34.31	N66°17'33"E
)3	34.31	N66°17'33"E
<del>34</del>	96.05	S59°11'41"E
95	222.41	S01°01'15"E
<del>3</del> 6	46.14	N23°00'42"E
)7	90.02	N23°00'42"E
)8	173.15	N79°39'41"E
)9	173.15	N79°39'41"E
00	461.22	S89°00'53"E
		OTA OF OLD AND

S72°56'39"E

L101

LINE	LENGTH	BEARING
L102	100.05	S72°56'39"E
L103	423.01	N73°37'49"E
L104	423.01	N73°37'49"E
L105	83.06	S85°40'14"E
L106	83.02	S85°40'14"E
L107	443.72	N73°57'00"E
L108	265.73	N73°57'00"E
L109	617.50	N86"53'53"E
L110	145.30	N86°53'53"E
L111	23.59	N13°30'10"E
L112	23.59	N13°30'10"E
L113	213.57	N83°47'32"E
L114	31.75	N81°15'53"E
L115	38.81	N81°15'53"E
L116	194.70	N78°44'14"E
L117	55.00	N82°19'14"E
L118	92.30	N85°54'15"E
L119	45.00	N82°19'14"E
L120	92.30	N85°54'15"E
L121	32.48	N65°49'45"E
L122	32.48	N65°49'45"E
L123	71.32	N86°35'13"E
L124	71.32	N86°35'13"E
L125	88.99	N57°22'19"E
L126	88.99	N57°22'19"E
L127	73.85	N61°59'21"E
L128	57.87	N61°45'13"E
L129	262.97	S22°06'48"E
L130	446.40	S22"06'48"E
L131	190.58	S22°06'48"E
L132	464.49	N73°46'18"E
L133	112.61	S87°21'54"E
L134	112.61	S87°21'54"E
L135	285.13	N62°40'05"E
L136	436.73	N81°39'17"E
L137	582.10	N81°39'17"E
L138	442.73	N81°39'17"E
L139	458.70	N81°39'28"E
L140	318.10	S75°59'54"E
L141	151.13	N81°23'25"E
L142	499.58	N81°23'25'E
L143	348.45	N81°23'25"E
L144	89.76	N78°42'38"E
L145	101.74	N76°01'51'E
L146	95.49	N78°45'33"E
L147	103.50	N76°01'54"E
L148	55.45	S65°33'45"E
2 A 2 A	The second second	PARTY AND A SECOND CONTRACTOR

L150

L151

55.45

CURVE TABLE

250.75

S69°15'55"E

S65°33'45"E


S85°16'29"E

LINE TABLE

	LINE TABLE	
LINE	LENGTH	BEARING
L152	230.40	S85°16'29"E
L153	279.38	S49°14'17"E
L154	381.82	S49°14'17"E
L155	89.88	S44°27'51"E
L156	76.56	S44°27'51"E
L157	189.12	S39°41'26"E
L158	189.12	S39°41'26"E
L159	19.77	S70°02'24"E
L160	21.90	S70°02'24"E
L161	73.09	S19°01'12"W
L162	71.45	S19°01'12"W
L163	259.89	S70°02'24"E
L164	257.24	S70°02'24"E
L165	388.78	S28°53'14"W
L166	386.22	S28°53'14"W
L167	537.54	S28°53'14"W
L168	595.25	S28°53'14"W
L169	513.45	S28°53'14"W
L170	411.41	S69°18'19"E
L171	508.80	S69°18'19"E
L172	30.28	S69°18'19"E
L173	465.92	N63°37'44"W
L174	636.88	N58°30'21"W
L175	V72052V	/XX8%90;21/W
L176	131.39	S45°16'04"W
L177	489.92	N88°19'58"W
L178	327.06	N88°19'58"W
L179	100.00	S00°40'28"E
L180	160.00	N88°19'58"W
L181	100.00	N00°40'28"W
L182	160.00	S88°19'58"E
L183	V4438V	\M887956\W
L184	V85008V	V188219:56\W
L185	268.66	N88°19'58"W
L186	171.81	S87°13'11"W
L187	438.81	S87°13'11"W
L188	440.13	S87°13'11"W
L189	441.04	S87°13'11"W
L190	444.36	S87°13'11"W
L191	440.14	S87°13'11"W
L192	440.01	S87°13'11"W
L193	429.97	S87°13'11"W
L194	388.41	S87°13'11"W
L195	126.71	S29°31'31"W
L196	232.42	S05°22'24"E
L197	49.54	N73°03'32"W
L198	502.75	N77°25'47"W
L199	1039.30	N77°25'47"W
L200	46.42	S29°44'06"E
L201	175.44	S77°25'47"E

LINE	LENGTH	BEARING
L202	311.39	S77°25'47"E
L203	352.20	S77°25'47"E
L204	435.05	S77°25'47"E
L205	267.97	S77°25'47"E
L206	57.51	S05°22'24"E
L207	421.86	S71°27'04"W
L208	559.10	S22°06'48"E
L209	558.82	S22°06'48"E
L210	182.43	S71°27'04"W
L211	V/4569//	\ 870°06'52\\V
L212	V 36.05/	\8X0°06'52\V
 L213	100221	VV/VE/PASSOR/
L214	1/180,221/	86824V41VV
L215	\_\583\98\_	\N22246'07\VV
L216	1/183821/	/885340.754A
L217	\\101\80\\	\882°10'12\VV
L218	101.61	S07°49'48"E
L219	171.51	S07°49'48"E
L220	100.00	S26°10'22"E
L221	100.00	S26°10'22"E
L222	323.06	S18°19'23"W
L223	448.53	S18°19'23"W
L224	125.47	S18°19'23"W
L225	66.90	S11°20'13"W
L226	352.22	S04°21'02"W
L227	118.06	S04°21'02"W
L228	134.16	S04°21'02"W
L229	40.17	S00°48'28"W
L230	33.99	S00°48'28"W
L231	50.07	S02°44'06"E
L232	49.43	S02°44'06"E
L233	66.51	N32°00'08"W
L234	132.13	N59°20'57"W
L235	30.82	N67°37'44"E
L236	50.38	S67°37'44"W
L237	196.86	N01°40'02"E
L238	640.72	N75°05'34"E
L239	327,66	N75°05'34"E
L240	248.13	S57°07'54"E
L241	612.13	S57°07'54"E
L241	14.76	N86°53'53"E
L243	20.35	S85°16'29"E
L244	296.91	N61°52'42"E
L246	222.61	N35°54'00"E
L247	6.27	S69°16'54"E
L248	253.78	N19°01'12"E
L240 L249	306.35	S84°01'53"E
L249	163.29	S43°39'03"E
L250	281.72	S76°40'47"E
L251 L252	102.44	S49°14'17"E
-LVL	102.44	343 14 17 E

**CURVE TABLE** 

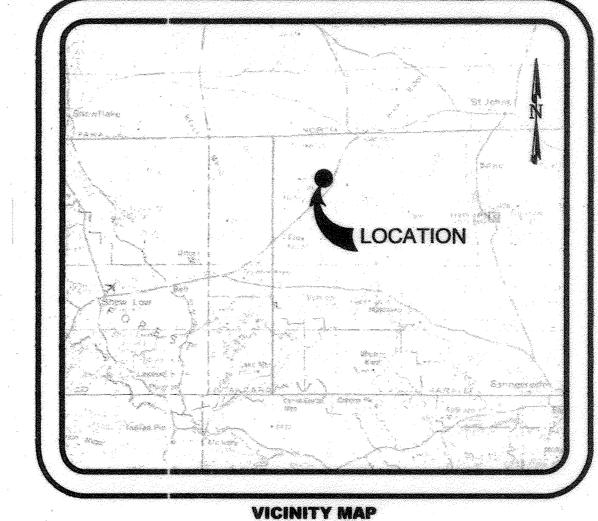

## VICINITY MAP NOT TO SCALE


CERTIFICATION:
I CERTIFY THAT THE SURVEY AS DRAWN ON THIS PLAT WAS COMPLETED BY ME OR UNDER MY DIRECT SUPERVISION AND THAT IT CONFORMS TO ALL MINIMUM STANDARDS AND SPECIFICATIONS. THIS



EXPIRES: 03/31/09

#### Arizona Land LLC

1570 Plaza West Drive Prescott, AZ 86303 Phone: (928) 771-1003

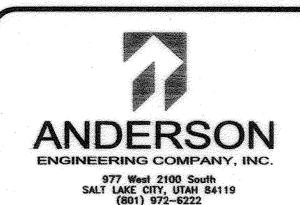

DRAWN BY: RKT ENGINEER: SDA APPROVED:

WINDSOR VALLEY RANCH SUBDIVISION PHASE 1 - AMENDED

#### FINAL PLAT

PORTIONS OF SECTIONS 25, 26, 27 & 28, T12N, R25E G&SRB&M APACHE COUNTY, ARIZONA

Project	03-213-02	Sheet
Octe	17-OCT-2006	
Scale	AS SHOWN	

REVISION DATE: 05/25/08

of 6

Carried Street	1 print 1 processor 1	
URVE	LENGTH	RADIUS
C2	\\\\\\\\\\\\\\\\\\\\\\\\\\\\\\\\\\\\\\	V 28508V
СЗ	\\\\\\\\\\\\\\\\\\\\\\\\\\\\\\\\\\\\\\	\\\\\\\\\\\\\\\\\\\\\\\\\\\\\\\\\\\\\\
C4	\\\\\\\\\\\\\\\\\\\\\\\\\\\\\\\\\\\\\\	\\808.01\/
C5	\\\\\\\\\\\\\\\\\\\\\\\\\\\\\\\\\\\\\\	\\805\V\/
C6	202.42	165.00
C7	146.21	340.00
C8	246.78	290.00
C9	339.03	581.15
C10	119.21	425.00
C11	177.97	180.00
C12	248.11	418.89
C13	184.65	290.00
C14	191.33	140.00
C15	156.00	290.00
C16	194.11	290.00
C17	311.08	890.00
C18	244.35	890.00
C19	1.57	0.50
C20	87.15	50.00
C21	81.08	50.00
C22	72.95	50.00
C23	\\\\\\\\\\\\\\\\\\\\\\\\\\\\\\\\\\\\\\	Wassen/
C24	222.66	299.37
C25	208.31	389.99
C26	114.94	175.00
C27	110.32	175.00
C28	432.85	3039.95
C29	167.73	298.35
C30	470.28	1840.00
C31	212.43	940.00
C32	92.43	325.00
C33	72.06	325.00
C34	151.23	265.77
C35	329.67	1029.76
		401.66
C36	311.93	
C37	79.26	325.00
C38	135.92	50.00
C39	560.03	1689.98
C40	522.64	1340.01
C41	127.56	340.00
C42	95.02 - Energy and the company of the compa	339.98
C43	465,43	1790.03
C44	479.28	715.00

C45 C46 C47 C48

C49 C50 C51

669.21

156.32

182.40

88.63

51.58

180.10

1439.99

1439.92

290.00

50.00 50.00

340.00

C104

	CURVE TAB	
CURVE	LENGTH	RADIUS
C52	135.50	324.99
C53	181.32	275.00
C54	181.32	275.00
C55	296.71	225.00
C56	1064.10	1160.00
C57	546.69	1240.01
C58	590.80	1240.00
C61	779.67	1360.00
C63	132.08	210.00
C64	137.72	260.00
C65	39.68	25.00
C66	38.86	25.00
C67	39.68	25.00
C68	38.86	25.00
C69	90.41	524.95
C70	81.80	475,02
C71	21.03	25.00
C72	21.03	25.01
C73	135.50	325.00
C74	41.01	25.00
C75	37.53	25.00
C76	40.41	25.00
C77	38.13	25.00
C78	139.31	1525.00
C79	235.18	1525.03
C80	187.72	2 <b>19</b> .37
C81	165.58	310.00
C82	139.23	516.22
C83	37.62	25.00
C84	36.89	25.00
C85	57.78	596.22
C86	263.35	1641.80
C87	39.38	25.00
C88	39.16	25.00
C89	264.72	1571.15
C90	234.13	1360.00
C91	\\\\\\\\\\\\\\\\\\\\\\\\\\\\\\\\\\\\\\	\\uancon\
C92	V 4683V	V/2001/
C93	V46.83V/	V/2802//
C94	217.95	810.00
C95	40.24	25.00
C96	41.49	25.00
C97	21.03	25.00
C98	64.23	50.00
C99	95.00	50.00
C100	81.96	50.00
C101	21.03	25.00
C102	219.64	275.00
C103	40.61	25.00
C104	20.62	28.00

25.00

	OOKVE IND	L-L
CURVE	LENGTH	RADIUS
C105	21.03	25.00
C106	21.03	25.00
C107	21.03	25.00
C108	21.03	25.00
C109	54.87	50.00
C110	53.52	50.00
C111	459.45	3107.28
C112	465.92	3057.28
C113	345.26	2072.49
C114	296.51	3057.28
C115	192.95	125.00
C116	272.86	810.00
C117	112.97	210.00
C118	140.56	210.00
C119	41.00	60.00
C120	41.00	60.00
C121	207.00	339.56
C122	244.34	2960.00
C123	279.82	2960.00
C124	122.75	218.35
C125	\\\\\\\\\\\\\\\\\\\\\\\\\\\\\\\\\\\\\\	V\12508\/
C126	38.29	25.00
C127	39.43	25.00
C128	128.53	130.00
C129	202.58	1025.00
C130	192.69	975.00
C131	105.18	375.00
C132	309.86	531.15
C133	99.35	275.00
C134	81.29	225.00
C135	1.57	0.50
C136	1.57	0.50
C137	224.92	1760.00
C138	224.92	1760.00
C139	194.35	860.00
C139	111.81	260.00
C141	104.28 56.06	85.00 460.00
C142		160.00
C143	84.09	240.00
C144	85.94	240.00
C145	57.97	160.00
C146	107.08	210.00
C147	147.87	290.00
C148	38.71	25.00
C149	36.70	25.00
C150	41.84	25.00
C151	40.03	25.00
C152	260.09	790.00
and the state of t		
C153 C154	233.75	710.00 660.00


		OUI (1/ II)	Brain Stein.
1	CURVE	LENGTH	RADIUS
-	C155	387.04	740.00
- salesions	C156	369,45	1610.00
	C157	164.07	1610.00
	C158	439.85	1260.00
reypoless <del>a</del>	C159	43.60	1260.00
- in annies in	C160	170.21	260.00
	C161	1.57	0.50
Para de la compansión d	C162	1.57	0.50
-	C163	150.98	1710.00
	C164	293.65	1710.00
-	C165	343.58	635.00
,	C166	42.40	25.00
- Security of the Security of	C167	36.20	25.00
	C168	577.91	5575.00
-constant	C169	585.00	5625.00
anni ein jan <del>ear</del>	C170	639.97	5575.00
	C171	640.84	5625.00
	C172	541.30	5575.00
	C173	430.24	5625.00
····	C174	169.19	325.00
	C175	147.44	275.45
and the safety	C176	163.63	325.00
-	C177	163.63	325.00
	C178	276.91	275.00
	C179	120.68	125.00
	C180	122.40	175.00
<del></del>	C181	35.69	25.00
	C182	35.69	25.00
	C183	345.85	275.00
-	C184	265.97	325.00
	C185	105.27	50.00
,	C186	21.03	25.00
	C187	21.03	25.00
-	C188	42.01	25.04
	C189	37.71	25.00
	C190	\\\\\\\\\\\\\\\\\\\\\\\\\\\\\\\\\\\\\\	\\Z88.01\/
i-provocase	C191	\\42941\/	V\Z88.01\
بمعدد أحدث	C192	V9686V	125,081
-	C193	42.85	25.00
	C194	113.39	215.77
<del></del>	C195	313.67	979.76
	C196	1/203001/	V 185,08V
	C197	273.10	351.66
*******	C198	39.26	25.00
-	C199	39.28	25.00
Section 2	C200	178.70	210.00
*	C201	38.44	25.00
	C202	37.36	25.00
	C202	39.27	25.00
	C203	39.27	25.00
نبيب	VZU4	1 39.21	20.00

**CURVE TABLE** 

	OOMAT IVE	
CURVE	LENGTH	RADIUS
C205	112.13	175.00
C206	160.19	125.00
C207	112.13	175.00
C208	229.31	275.00
C209	39.11	25.00
C210	39.43	25.00
C211	733.02	11461.39
C212	641.26	11461.39
C213	613.57	11461.39
C214	39.22	275.00
C215	154.61	275.00
C216	144.07	575.00
C217	187,43	575.00
C218	133.72	210.34
C219	130.91	11461.39
	The state of the s	
- Annual Control of the Control of t		egger-paragoner gale mengenjak melakat pengelah kanapat terbangan pengenjang melakin mengenjang melakin penang
		ed transferred to the second control of the second
		and and a second se
and the second	D <sub>1</sub>	
· · · · · · · · · · · · · · · · · · ·	-	
	A design of the second of the	>
and the same of th		
· · · · · · · · · · · · · · · · · · ·		
and the second		t.
Constant of the Constant of th		<ul> <li>A comment of the second of the</li></ul>
- Company	T and the same of	
district the second sec		
and the state of t	\$ 100 miles	
-		
4		
***************************************		
		og for 1696 til med en sternise fra søg er og som en frams <del>el</del> en en mennem kregder mende omstydelder og ferte bedre fret fra til ferte bedre fret fra til framse fra til framse f
		o positivito e proprieta de la compressión de la companya de la compressión de la co
	<del>a de la composição de la como como de la como como como como como como como com</del>	

## WINDSOR VALLEY RANCH SUBDIVISION PHASE 1 - AMENDED

PORTIONS OF SECTIONS 26, 26, 27 & 28, T. 12 N., R. 25 E. G.&S.R.B.&M., APACHE COUNTY, ARIZONA

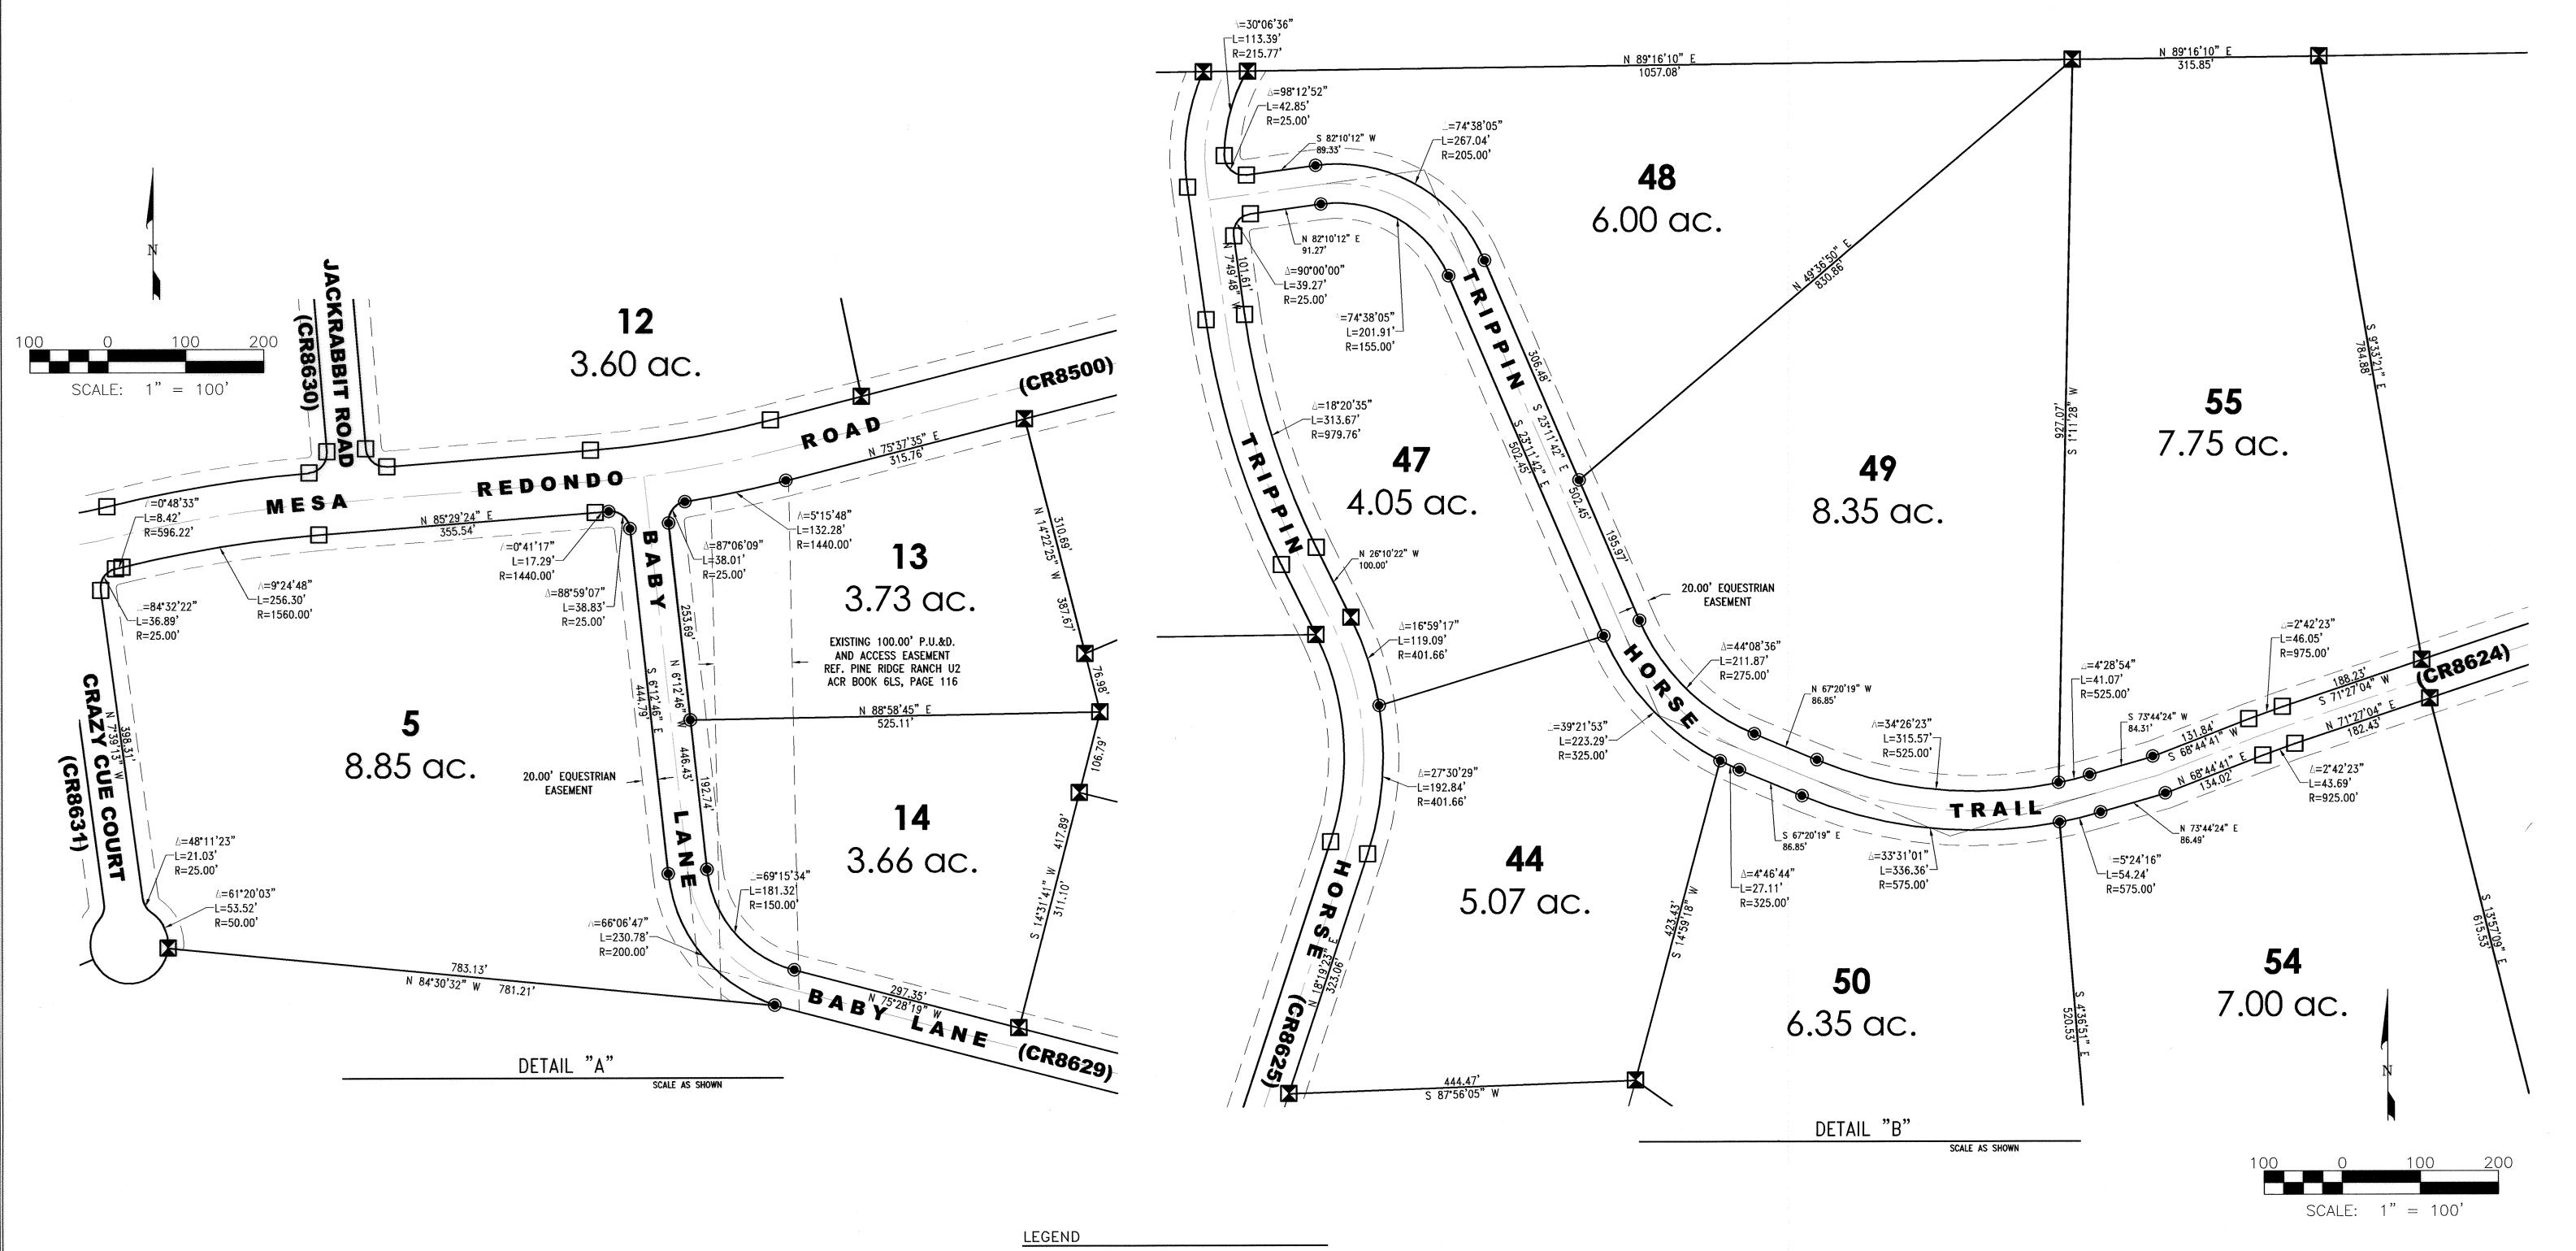

STATE OF ARIZONA)
COUNTY OF APACHE) SS.

Fee No. 2008-4882.

I hereby Certify that the within instrument was filed and recorded.

10:55 AM in Book No. B9 Page 5

Recorder

By Lephane 10:50, Deputy

Fd. REBAR W/ALUM CAP
MARKED LS #42811

Fd. REBAR W/PLASTIC CAP
MARKED LS #42811

SET #5 REBAR WITH
PLASTIC CAP MARKED
LS #15928

CALCULATED CORNER
NOTHING SET OR FOUND
EXCEPT AS NOTED

CERTIFICATION:
I CERTIFY THAT THE SURVEY AS DRAWN ON THIS
PLAT WAS COMPLETED BY ME OR UNDER MY DIRECT
SUPERVISION AND THAT IT CONFORMS TO ALL
MINIMUM STANDARDS AND SPECIFICATIONS. THIS
CERTIFICATION APPLIES TO AMENDMENTS TO THE
ORIGINAL DRAWING ONLY.



### ISAACSON ENGINEERING

P.O. Box 2924 ST. JOHNS, ARIZONA 85936 PHONE: (928) 337-9910 FAX: (928) 337-9905


WINDSOR VALLEY RANCH SUBDIVISION PHASE 1 - AMENDED


RECORD CREATED AT THE REQUEST OF:
Arizona Land LLC

DATE:05/25/08 FILE:08Amended Plat 05-28-08.dwg
REV. DATE:
REV. DATE:
Drawn By: D.S.JR Reviewed By: K.I. NO. 5 of

# WINDSOR VALLEY RANCH SUBDIVISION PHASE 1 - AMENDED

PORTIONS OF SECTIONS 26, 26, 27 & 28, T. 12 N., R. 25 E. G.&S.R.B.&M., APACHE COUNTY, ARIZONA

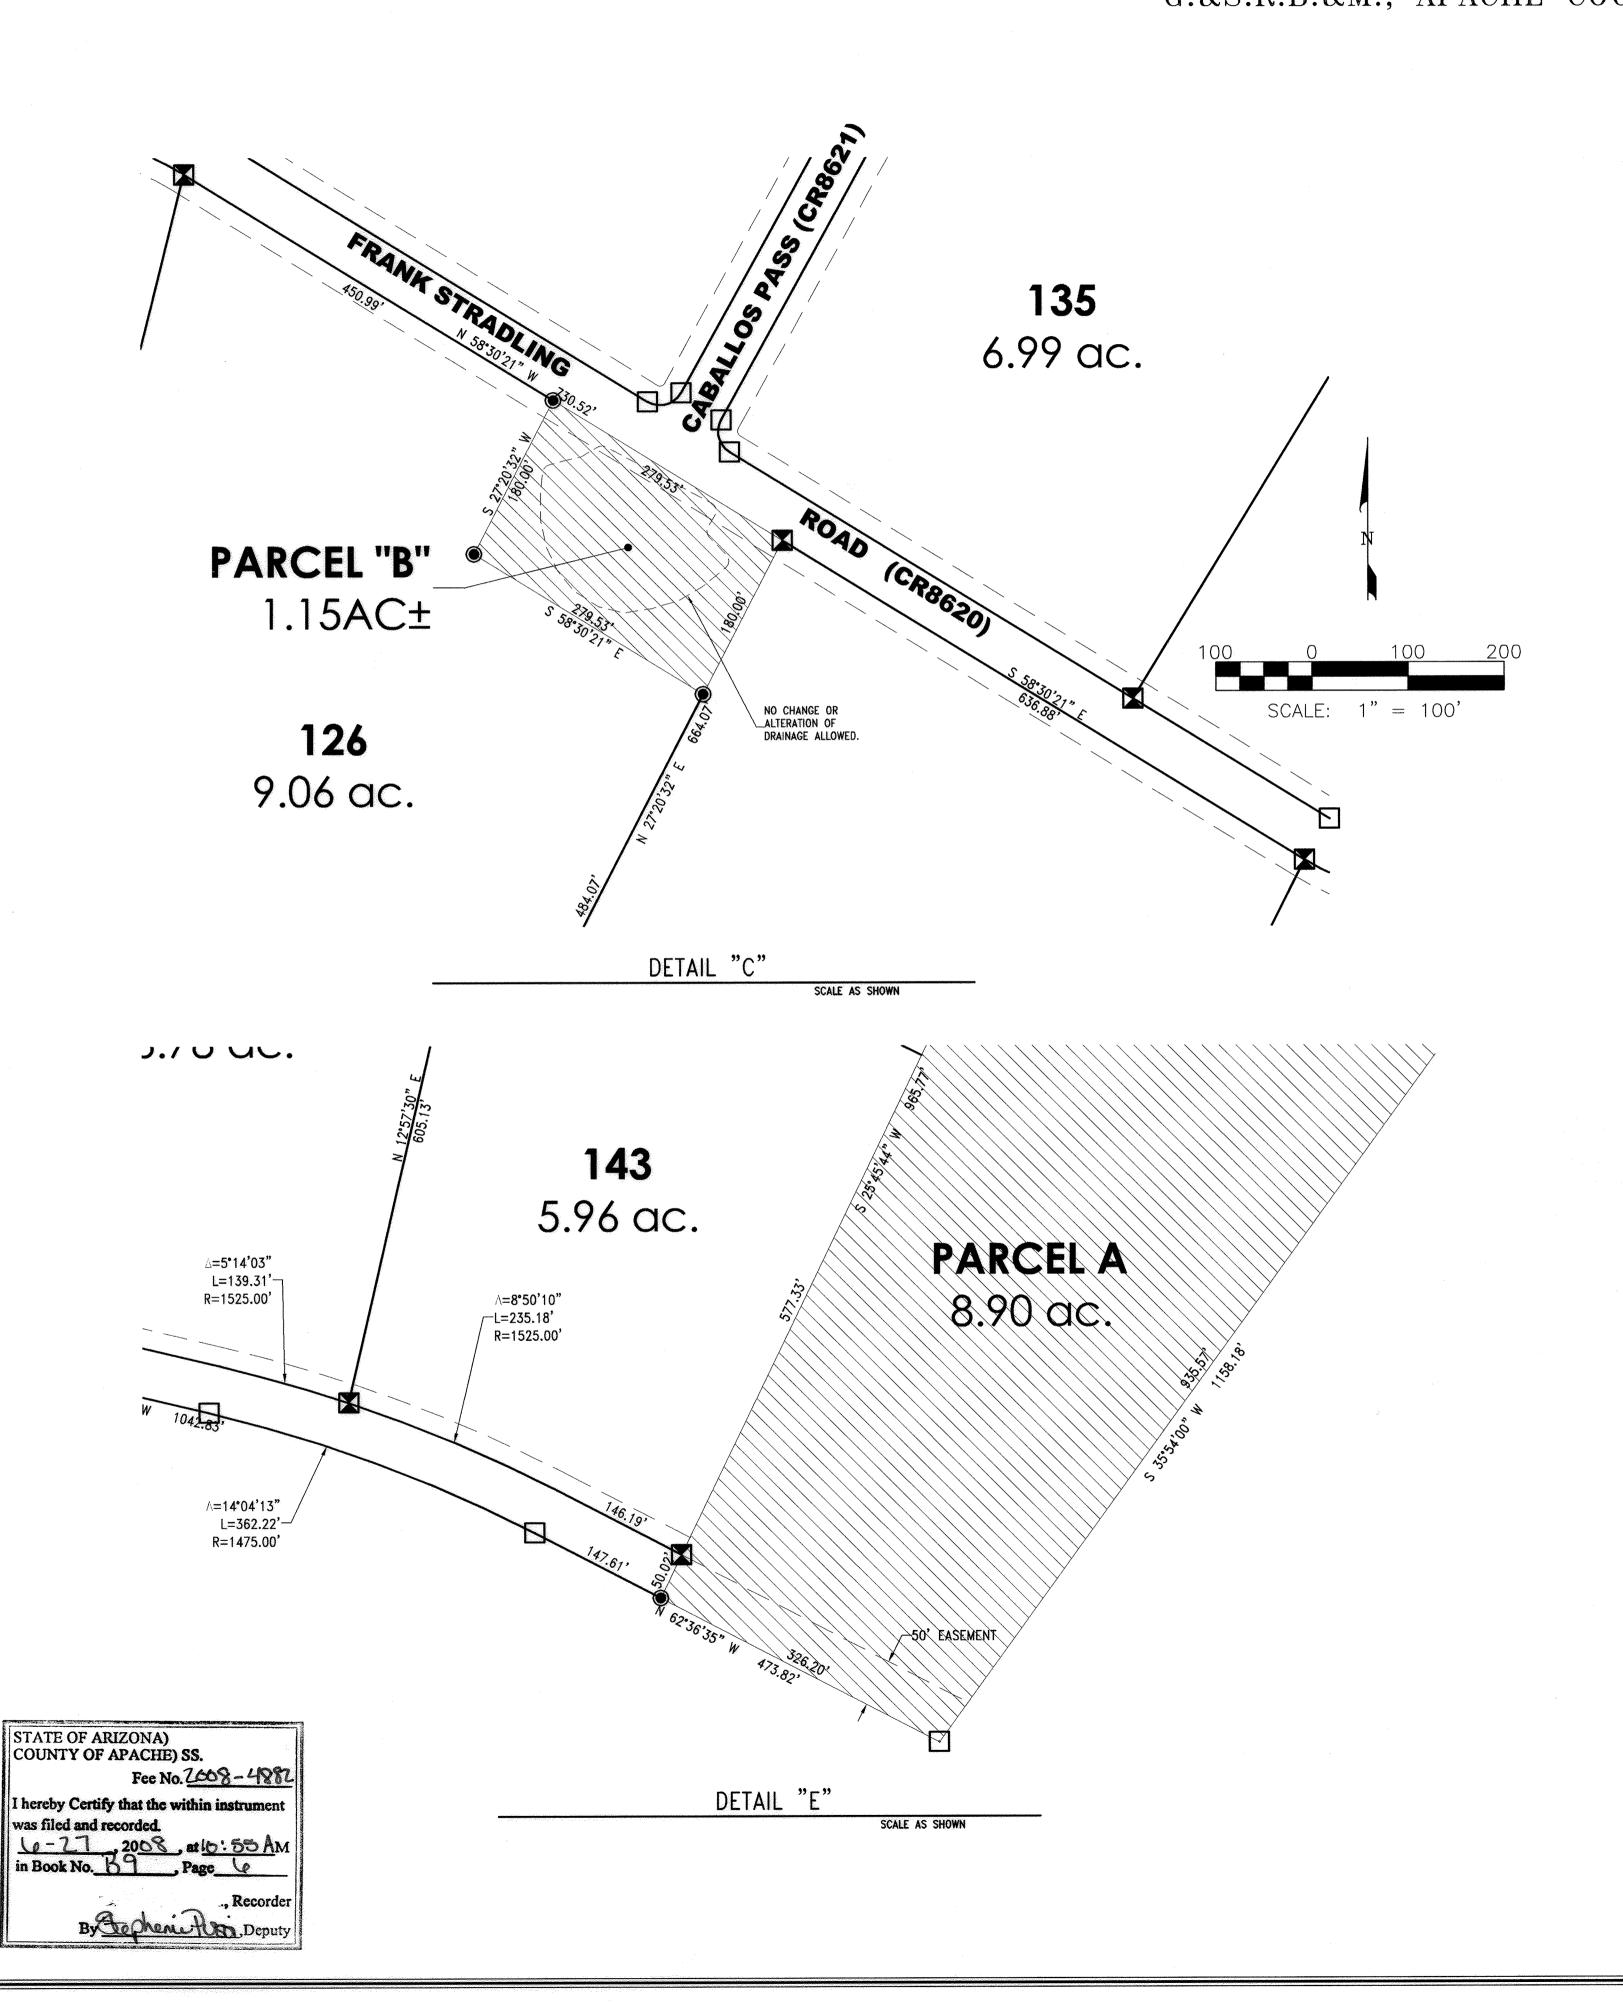

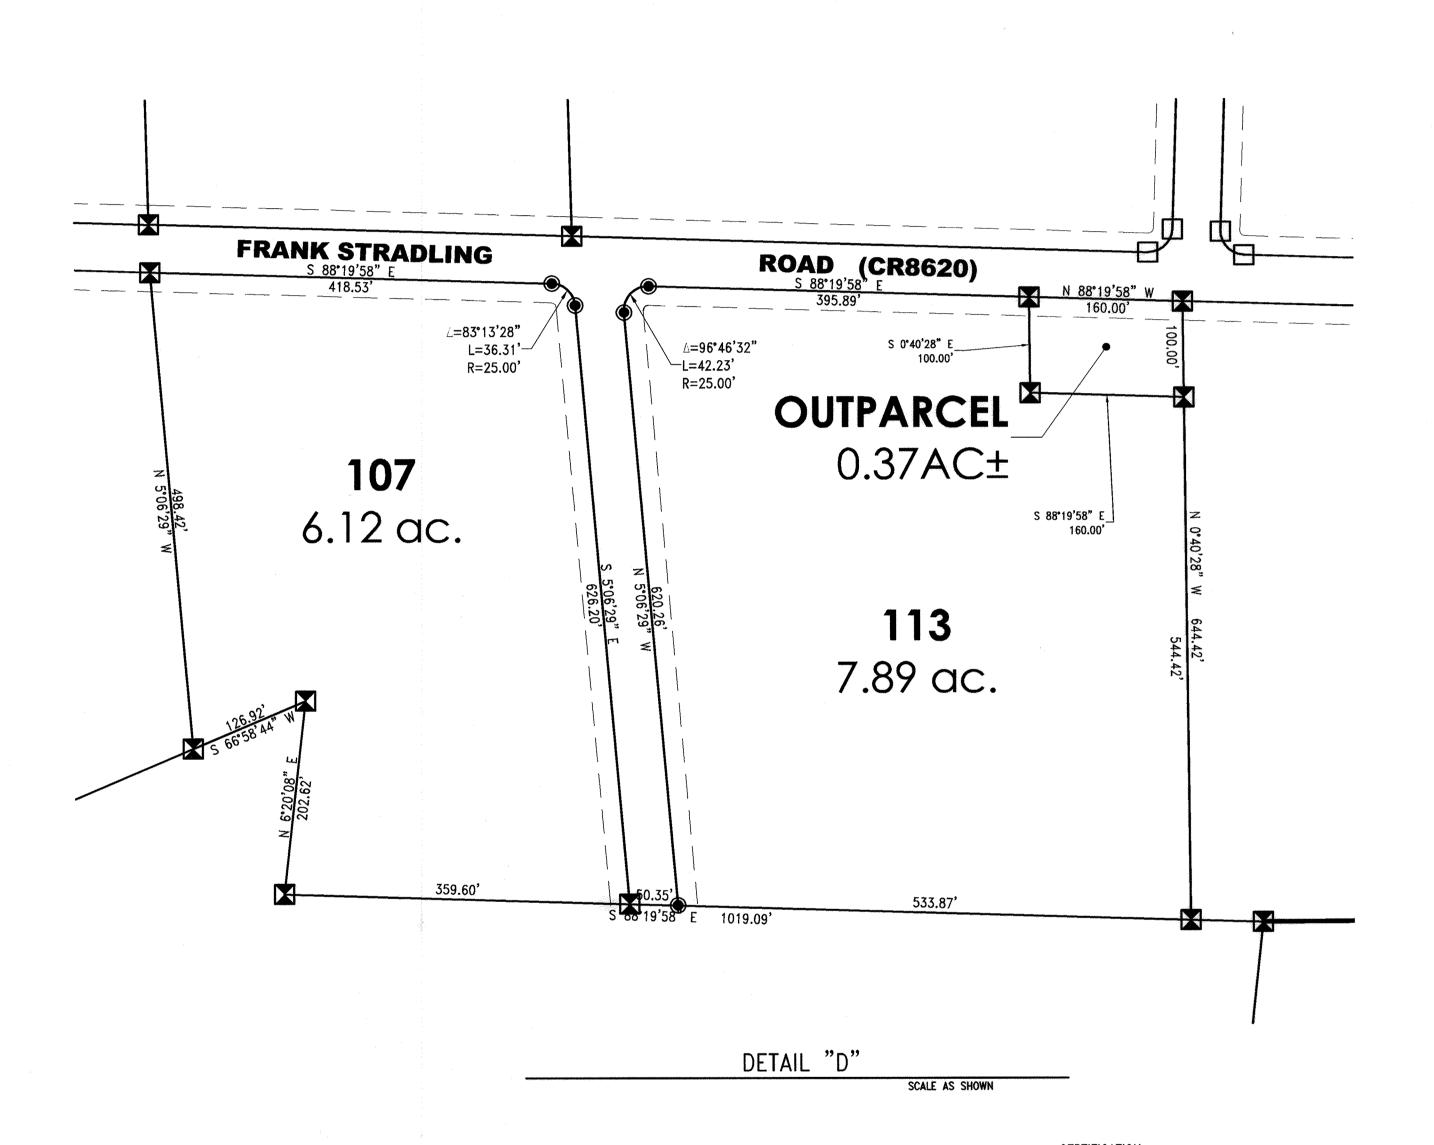

LEGEND

Fd. REBAR W/ALUM CAP
MARKED LS #42811

Fd. REBAR W/PLASTIC CAP
MARKED LS #42811

SET #5 REBAR WITH
PLASTIC CAP MARKED
LS #15928

CALCULATED CORNER
NOTHING SET OR FOUND
EXCEPT AS NOTED

CERTIFICATION:
I CERTIFY THAT THE SURVEY AS DRAWN ON THIS
PLAT WAS COMPLETED BY ME OR UNDER MY DIRECT
SUPERVISION AND THAT IT CONFORMS TO ALL
MINIMUM STANDARDS AND SPECIFICATIONS. THIS
CERTIFICATION APPLIES TO AMENDMENTS TO THE
ORIGINAL DRAWING ONLY.



### ISAACSON ENGINEERING

P.O. Box 2924

ST. JOHNS, ARIZONA 85936

PHONE: (928) 337-9910 FAX: (928) 337-9905

WINDSOR VALLEY RANCH SUBDIVISION PHASE 1 - AMENDED

RECORD CREATED AT THE REQUEST OF:
Arizona Land LLC

DATE:05/25/08 FILE:08Amended Plat 05-28-08.dwg
REV. DATE:
REV. DATE:
Drawn By: D.S.JR Reviewed By: K.I.

NO. 6 of 6