


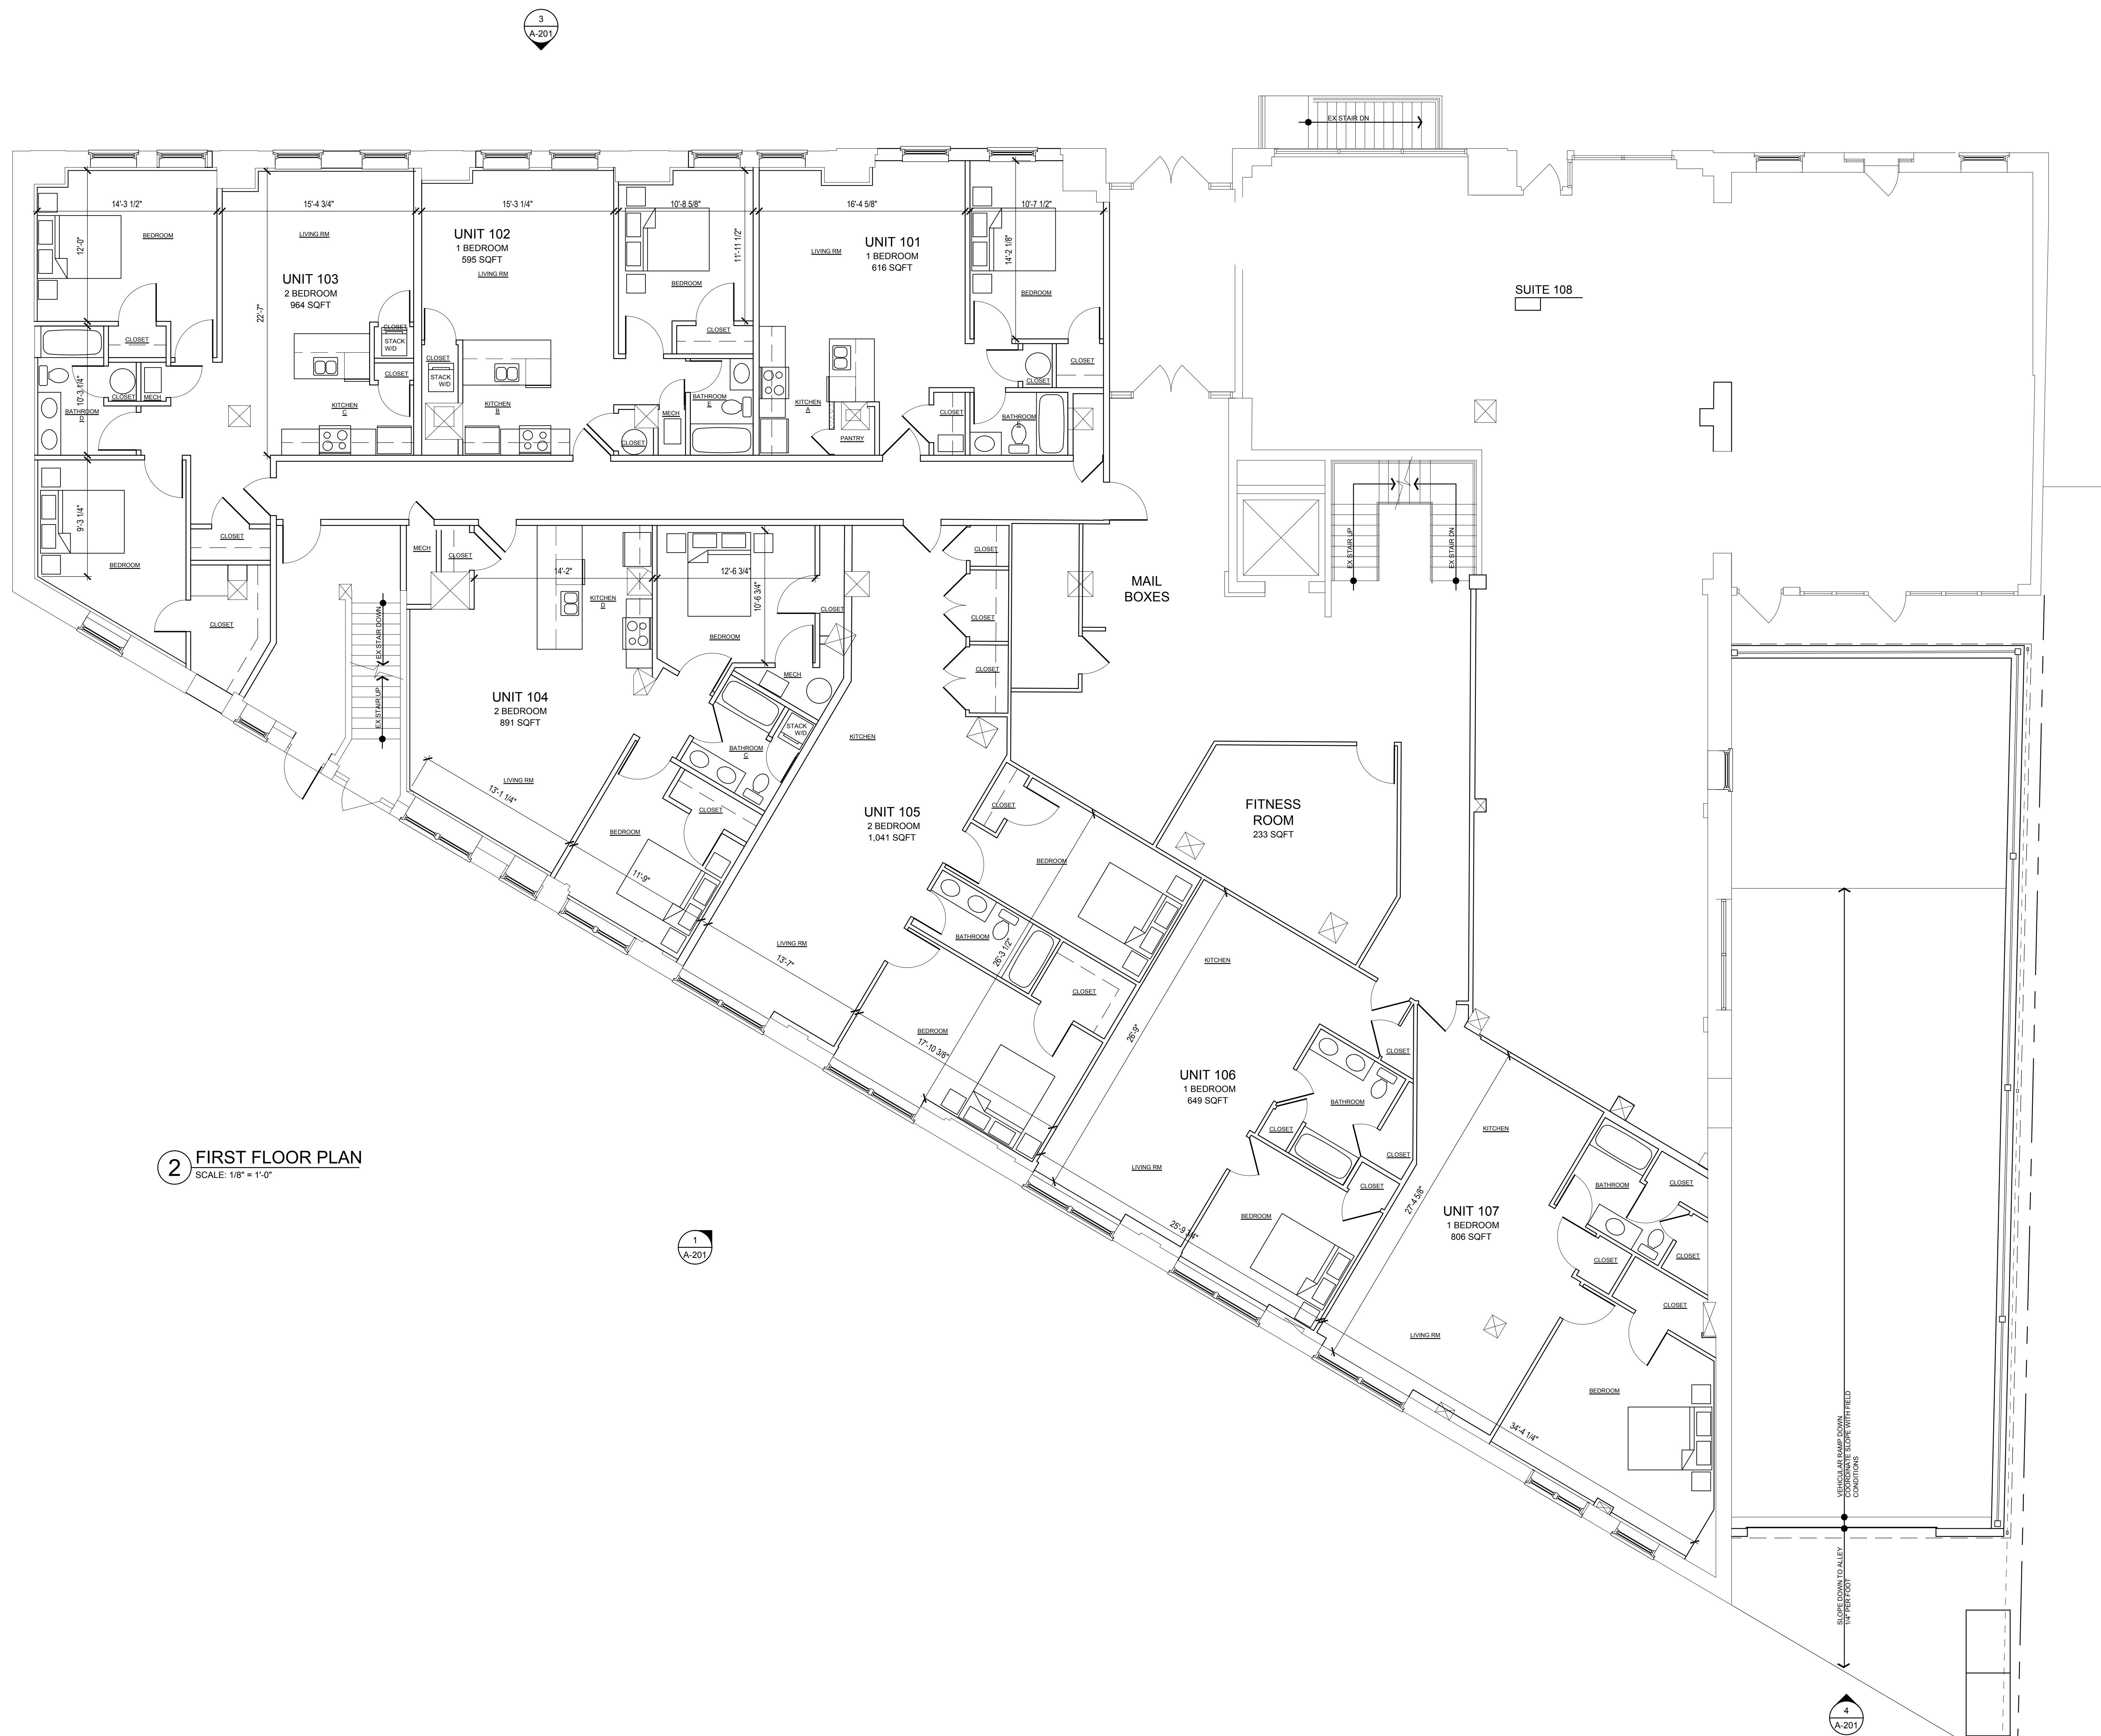

2 FIRST FLOOR PLAN
SCALE: 1/8" = 1'-0"

DRAWING TITLE		PROPOSED FIRST FLOOR PLAN	
© 2018 SAA Architects, Inc.		AS BUILT DRAWINGS FOR: McALLISTER LOFTS 11 YORK STREET HANOVER, PA 17331	
FILE NO:	18-027	DATE:	01.07.2020
SCALE:	AS NOTED	DRAWN BY:	KMS
DRAWING NO:	A-101		

NOTE: DIMENSIONS INDICATED WERE TAKEN AT TYPICAL LOCATIONS THROUGHOUT THE PROJECT. DIMENSIONS MAY VARY SLIGHTLY FROM THE INDICATED DIMENSIONS DUE TO THE CONSTRUCTION OF THE PROJECT.

THESE TECHNICAL DRAWINGS AND SPECIFICATIONS ("THE DOCUMENTS") HAVE BEEN PREPARED BY SAA ARCHITECTS, INC. ("SAA") FOR THE ARCHITECT. SAA HAS CONDUCTED VISUAL VERIFICATION OF THE DOCUMENTS AND HAS FOUND NO MATERIAL ERRORS OR OMISSIONS. SAA HAS NOT CONDUCTED A FIELD SURVEY OF THE PROJECT. 

SAA architects
600 North Liberty Street, Suite 150
York, PA 17404
1-717-843-3225 1-717-859-8265
www.saaarchitects.com