








# Utilities Report

## Utility Type

	Electricity	STATUS: AFFECTED NUMBER AFFECTED: 3
	Gas	STATUS: AFFECTED NUMBER AFFECTED: 1
	Water and Sewerage	STATUS: AFFECTED NUMBER AFFECTED: 2
	Telecoms	STATUS: AFFECTED NUMBER AFFECTED: 3
	Other	STATUS: AFFECTED NUMBER AFFECTED: 2

Total Number of Utility Companies Contacted: 18

## Report Information

	Works Description: Development Appraisal
	Batch: A

Status: Complete - Please see 'Understanding This Report'

This report is issued  
for the site described  
as:

**Site off Penallta Road, Ystrad  
Mynach, Hengoed**

Report Number  
**LM / 94066**

National Grid Reference  
**313946 195663,314066  
195570,313906 195656,314054  
195776,314047 195549**

Customer Reference  
**274907605\_1**

Report Date  
**09 April 2021**

## CONTACT DETAILS

If you require any assistance, please contact our  
customer services team on:

**0844 844 9966**

or by email at:  
**helpdesk@landmark.co.uk**

# Utilities Report



## Understanding this report

We have asked a comprehensive list of Utility companies whether they have any apparatus or underground services in the vicinity of the site.

---

### Report Summary

The table provides a breakdown of the number of responses received by utility category; however, it must be noted that some utility companies provide services across multiple categories. As a result, the total number of responses gathered will often be greater than the total number of utility companies contacted.

### Location Map

This shows the plan that was dispatched to the Utility companies. The companies have been asked to return information on the area outlined, which will encompass your chosen site.

### Request Status Report

This will confirm the current status of the information requests. We list which responses we have received and whether the company is affected. The Status Report will be divided into the following sections.

**Affected Utilities** – We have received plans/information

**No Response Received** – We are still awaiting a full response

**Not affected Utilities** – We have received a not affected/no plant present response

### Responses

Affected responses are listed by company. Any responses from companies confirming they are not affected are provided at the back of the report for your records.

### ‘Awaiting Further Responses’ or ‘Pack Complete’?

We do not include Local Authority requests when indicating if the pack is ‘Complete’ or ‘Awaiting Further Responses’ as Local Authorities are not obliged to reply to these enquiries.

The local authority for the area is contacted to see if they have any council owned property that may be affected by works. In general, these plant enquiries go to the highways department for responses regarding street lighting and drainage. However, the responses we receive can vary each time depending on resources available at the council and we often don’t receive replies from local authorities at all

# Utilities Report

## Landmark Utilities Report Service PAS 128 Statement

---

Prepared for: **Landmark Information Group Ltd**  
Practitioner: **Atkins**  
Report Number: LM / 94066  
Client Reference: 274907605\_1  
Site Name: Site off Penallta Road, Ystrad Mynach, Hengoed  
Date of Order: 15 March 2021  
Date of Issue: 09 April 2021

Thank you for using our Utility Report Service.

This report has been completed in accordance with the standards defined under Survey Category D of PAS128, a Publicly Available Specification for underground utility detection, verification and location published by the British Standards Institution.

Positional accuracy of plant is not guaranteed from information presented in a desktop search alone and the location of underground utilities should be verified through other means prior to breaking ground.

Information relating to the presence of Radio Frequency Identification Devices (RFIDs) has been requested from relevant utility companies or taken from mapping systems where available.

Utility companies who have not responded to enquiries are referenced on the enclosed Status Report accordingly. Their response will be chased and forwarded on for a period of up to four working weeks. Whilst we cannot guarantee that a utility company will respond to our enquiries, we endeavour to obtain responses from those that have not responded.

Any responses contained within this report have been obtained between the start date of the order and the date of issue.


If you want to discuss your report further with us, please contact Landmark Customer Services.

# Utilities Report



Search data map



**Please ensure that search data covers the COMPLETE AREA within the boundary lines on this map. This is marked by **

Landmark will not be held responsible for any incident or accident arising from the use of the information associated with this particular Statutory Search. The details provided are given in good faith, but no liability whatsoever can be accepted in respect thereof.

Client Reference:  
274907605\_1

Route:  
Site off Penallta Road, Ystrad Mynach, Hengoed

Postcode:  
CF82 6AA, CF82 6AJ, CF82 6AU

OSGR:  
314000 195650

Check by:  
NJ



# Utilities Report



## Request Status Report

Route:  
Site off Penallta Road, Ystrad  
Mynach, Hengoed  
Postcode:  
CF82 6AA, CF82 6AJ, CF82 6AU  
OSGR:  
314000 195650

Date Requested:  
15 March 2021  
Client Reference:  
274907605\_1  
Report Number:  
LM / 94066

Checked and Validated By:  
ShP  
Validation Date:  
09 April 2021

### Affected Utilities

We have received plans/information from the following companies. Please see the enclosed response.

Utility	Category	Date Issued	Notes
Dŵr Cymru Welsh Water	Water, Sewerage	09 April 2021	
GTC	Telecom, Gas, Electric, Water	09 April 2021	
LinesearchbeforeUdig	Other	09 April 2021	Wales and West Utilities, Western Power Distribution - Identified as affected. See separate responses.
Natural Resources Wales	Environmental Agency	09 April 2021	See response.
Openreach - [British Telecommunications]	Telecom	09 April 2021	
Utility Assets	Electric	09 April 2021	See response.
Western Power Distribution	Electric, Telecom	09 April 2021	

# Utilities Report

## No Response Received


We are still awaiting a full response from the following companies.

Utility	Category	Date Issued	Notes
Caerphilly County Borough Council	Council		

## Not Affected Utilities

We have received a not affected/no plant present response from the following companies.

Utility	Category	Date Issued	Notes
C.A. Telecom UK - [Colt Technology Services]	Telecom	09 April 2021	
CityFibre	Telecom	09 April 2021	
Instalcom - [CenturyLink, Global Crossing, Fibernet & Fibrespan]	Telecom	09 April 2021	
Last Mile	Gas, Electric	09 April 2021	
Network Rail	Rail	09 April 2021	
SKY Telecommunications Services	Telecom	09 April 2021	
Verizon	Telecom	09 April 2021	
Virgin Media	Telecom	09 April 2021	
Vodafone	Telecom	09 April 2021	
Wales and West Utilities	Gas	09 April 2021	

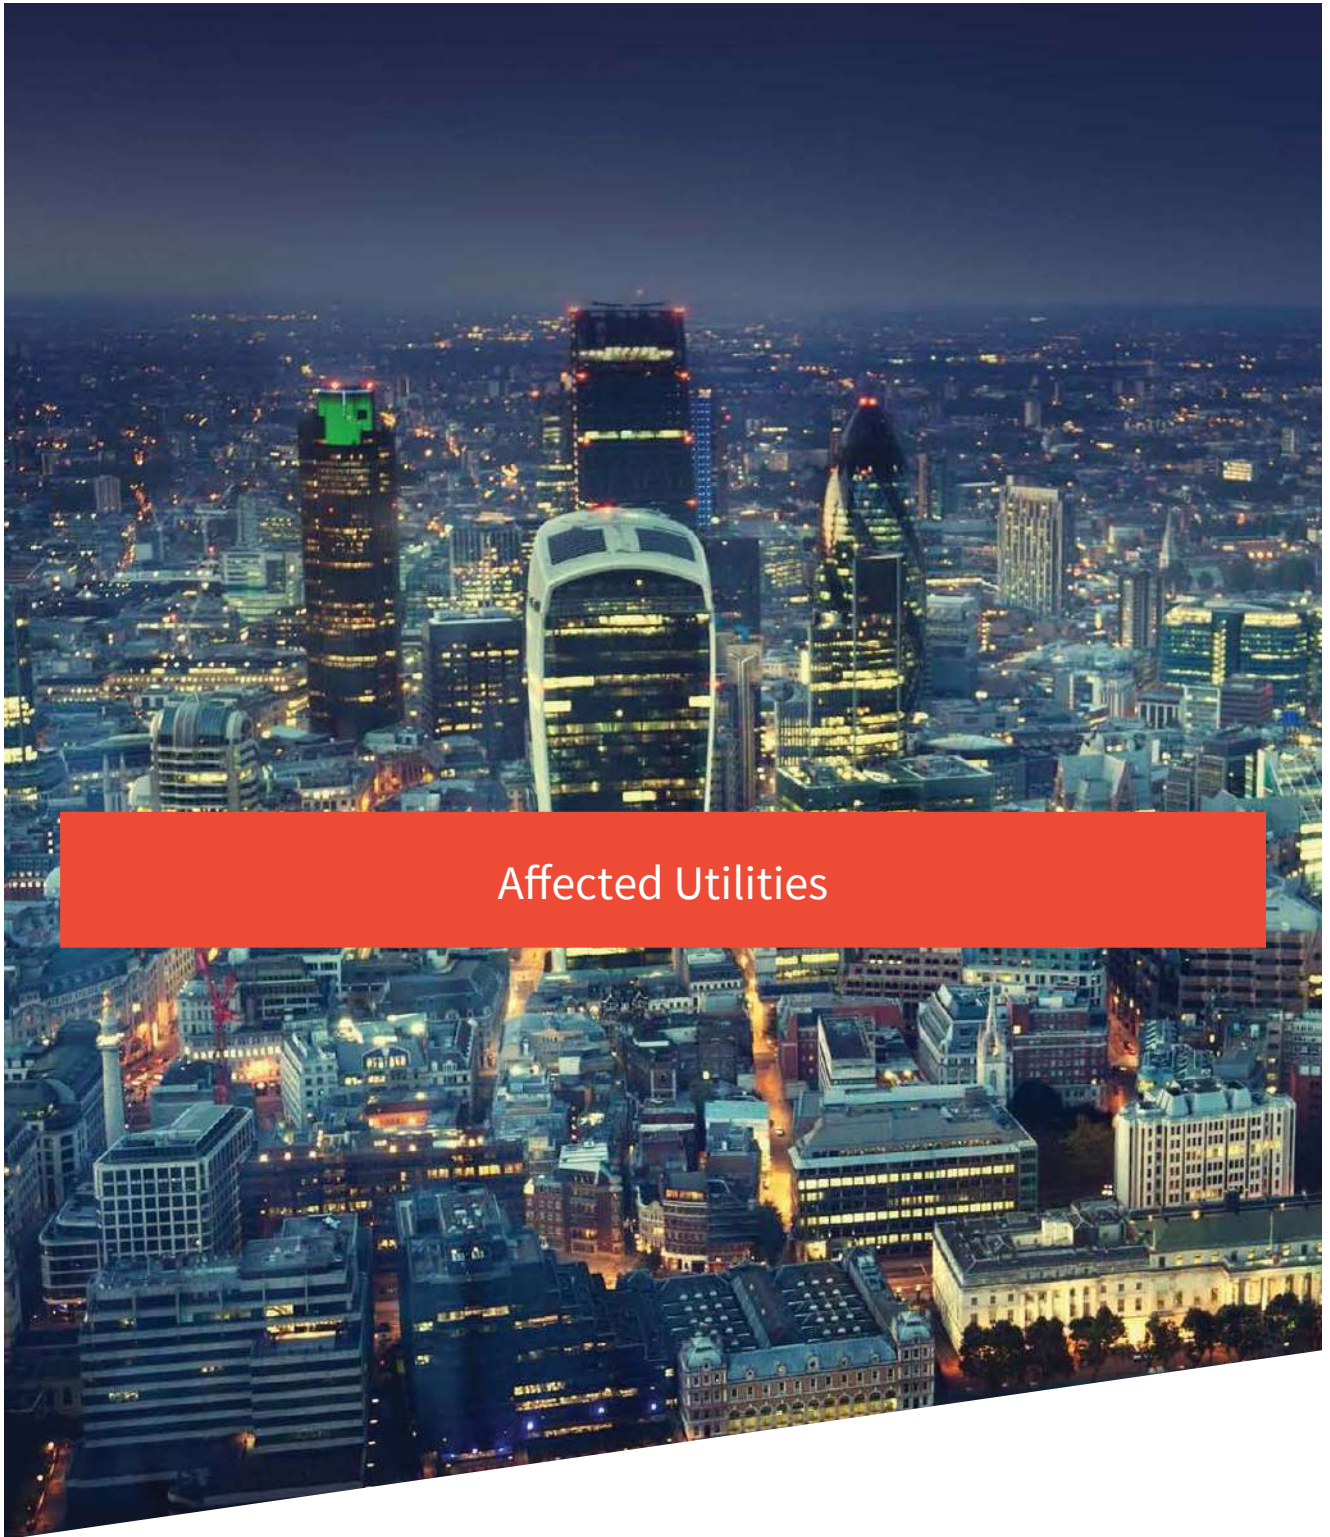

Affected Utilities





Affected Utilities

Dŵr Cymru Welsh Water



**LEGEND**

**Clean Water**

- Sluice Val
- Air Val, SINGLE
- Tap
- Pressure Reducing Valve
- Meter
- BULK Meter
- FH
- Cap
- Existing Main
- NON COMPANY

**Sewerage External**

- Foul
- Surface Water
- Combined
- Rising Main
- Private
- Treatment Works
- Pumping Station
- Special Purpose
- Unknown End
- Change, Combined Overflow
- Outfall, FOUL
- Lamp Hole, Foul
- Private Sewer Transfer
- Lateral Drain
- Inspection Chamber

**313938,195793**

Dŵr Cymru Cyfyngedig ('the Company') gives this information as to the position of its underground apparatus by way of general guidance only and on the strict understanding that it is based on the best information available and no warranty as to its correctness is relied upon in the event of excavations or other works made in the vicinity of the company's apparatus and any onus of locating the apparatus before carrying out any excavations rests entirely on you. The information which is supplied hereby the company, is done so in accordance with statutory requirements of sections 198 and 199 of the water industry Act 1991 based upon the best information available and in particular, but without prejudice to the generality of the foregoing, it should be noted that the records that are available to the Company may not disclose the existence of a drain sewer or disposal main laid before 1 September 1989, or if they do, the particulars thereof including their position underground may not be accurate. It must be understood that the furnishing of this information is entirely without prejudice to the provision of the New Roads and Street Works Act 1991 and the company's right to be compensated for any damage to its apparatus.

**EXACT LOCATION OF  
ALL APPARATUS TO  
BE DETERMINED ON  
SITE**

Reproduced from the Ordnance Survey's maps with the permission of the Controller of Her Majesty's Stationary Office. Crown Copyright. Licence No: WU298565.

Whilst every reasonable effort has been taken to correctly record the pipe material of DCWW assets, there is a possibility that in some cases pipe material (other than Asbestos Cement or Pitch Fibre) may be found to be Asbestos Cement (AC) or Pitch Fibre (PF). It is therefore advisable that the possible presence of AC or PF pipes be anticipated and considered as part of any risk assessment prior to excavation.






Dŵr Cymru  
Welsh Water

Water	
-------	--







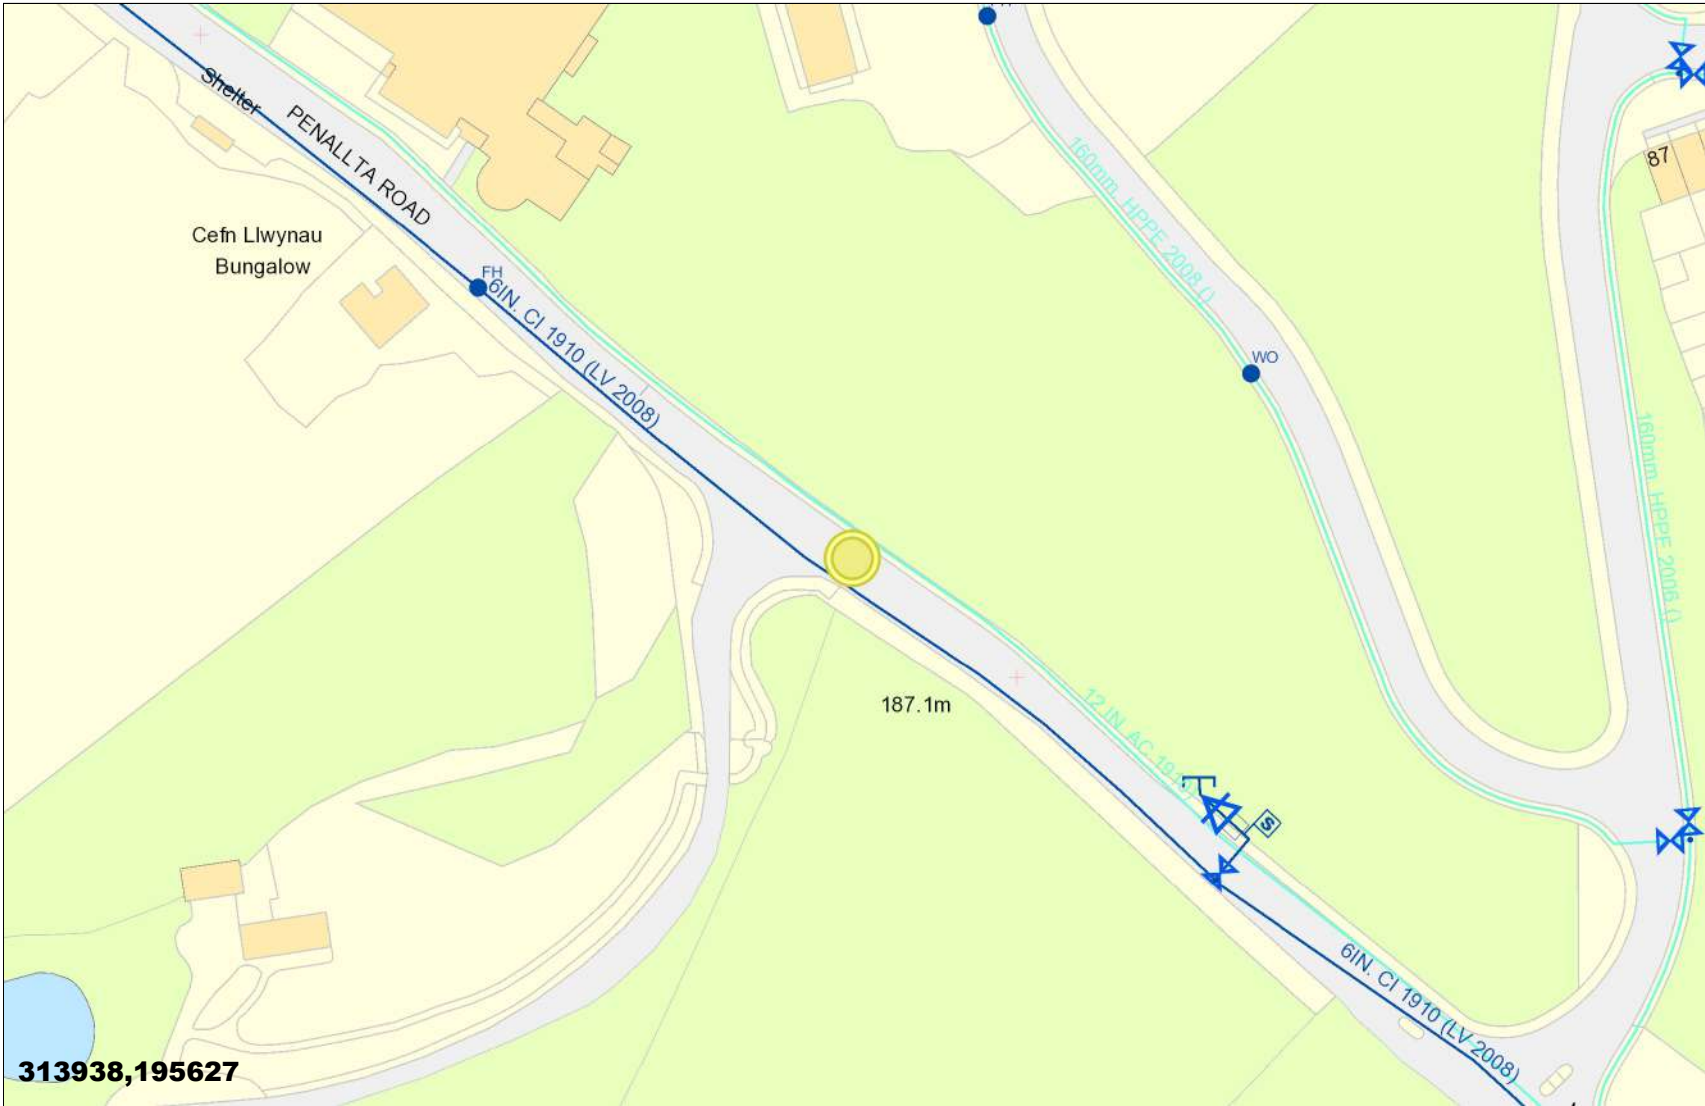

18/03/2021

Scale: 1: 1250



- ## Clean Water

## Clean Water

-  Sluice Val
-  Air Val, SINGLE
-  Tap
-  Pressure Reducing Valve
-  Meter
-  BULK Meter
-  FH FH

## Sewerage External


-  Foul
-  Surface Water
-  Combined
-  Rising Main
-  Private
-  Treatment Works
-  Pumping Station
-  Special Purpose
-  Unknown End
-  Change, Combined Overflow
-  Outfall, FOUL
-  Lamp Hole, Foul
-  Private Sewer Transfer
-  Lateral Drain
-  Inspection Chamber

Dwr Cymru Cfyngedig ('the Company') gives this information as to the position of its underground apparatus by way of general guidance only and on the strict understanding that it is based on the best information available and no warranty as to its correctness is relied upon in the event of excavations or other works made in the vicinity of the company's apparatus and any onus of locating the apparatus before carrying out any excavations rests entirely on you. The information which is supplied hereby the company, is done so in accordance with statutory requirements of sections 198 and 199 f the water industry Act 1991 based upon the best Information available and in particular, but without prejudice to the generality of the foregoing, it should be noted that the records that are available to the Company may not disclose the existence of a drain sewer or disposal main laid before 1 September 1989, or if they do, the particulars thereof including their position underground may not be accurate. It must be understood that the furnishing of this information is entirely without prejudice to the provision of the New Roads and Street Works Act 1991 and the company's right to be compensated for any damage to its apparatus.

EXACT LOCATION OF  
ALL APPARATUS TO  
BE DETERMINED ON  
SITE

Reproduced from the Ordnance Survey's  
maps with the permission of the  
Controller of Her Majesty's Stationary  
Office. Crown Copyright. Licence No:  
WU298565.

Whilst every reasonable effort has been taken to correctly record the pipe material of DCWW assets, there is a possibility that in some cases pipe material (other than Asbestos Cement or Pitch Fibre) may be found to be Asbestos Cement (AC) or Pitch Fibre (PF). It is therefore advisable that the possible presence of AC or PF pipes be anticipated and considered as part of any risk assessment prior to excavation

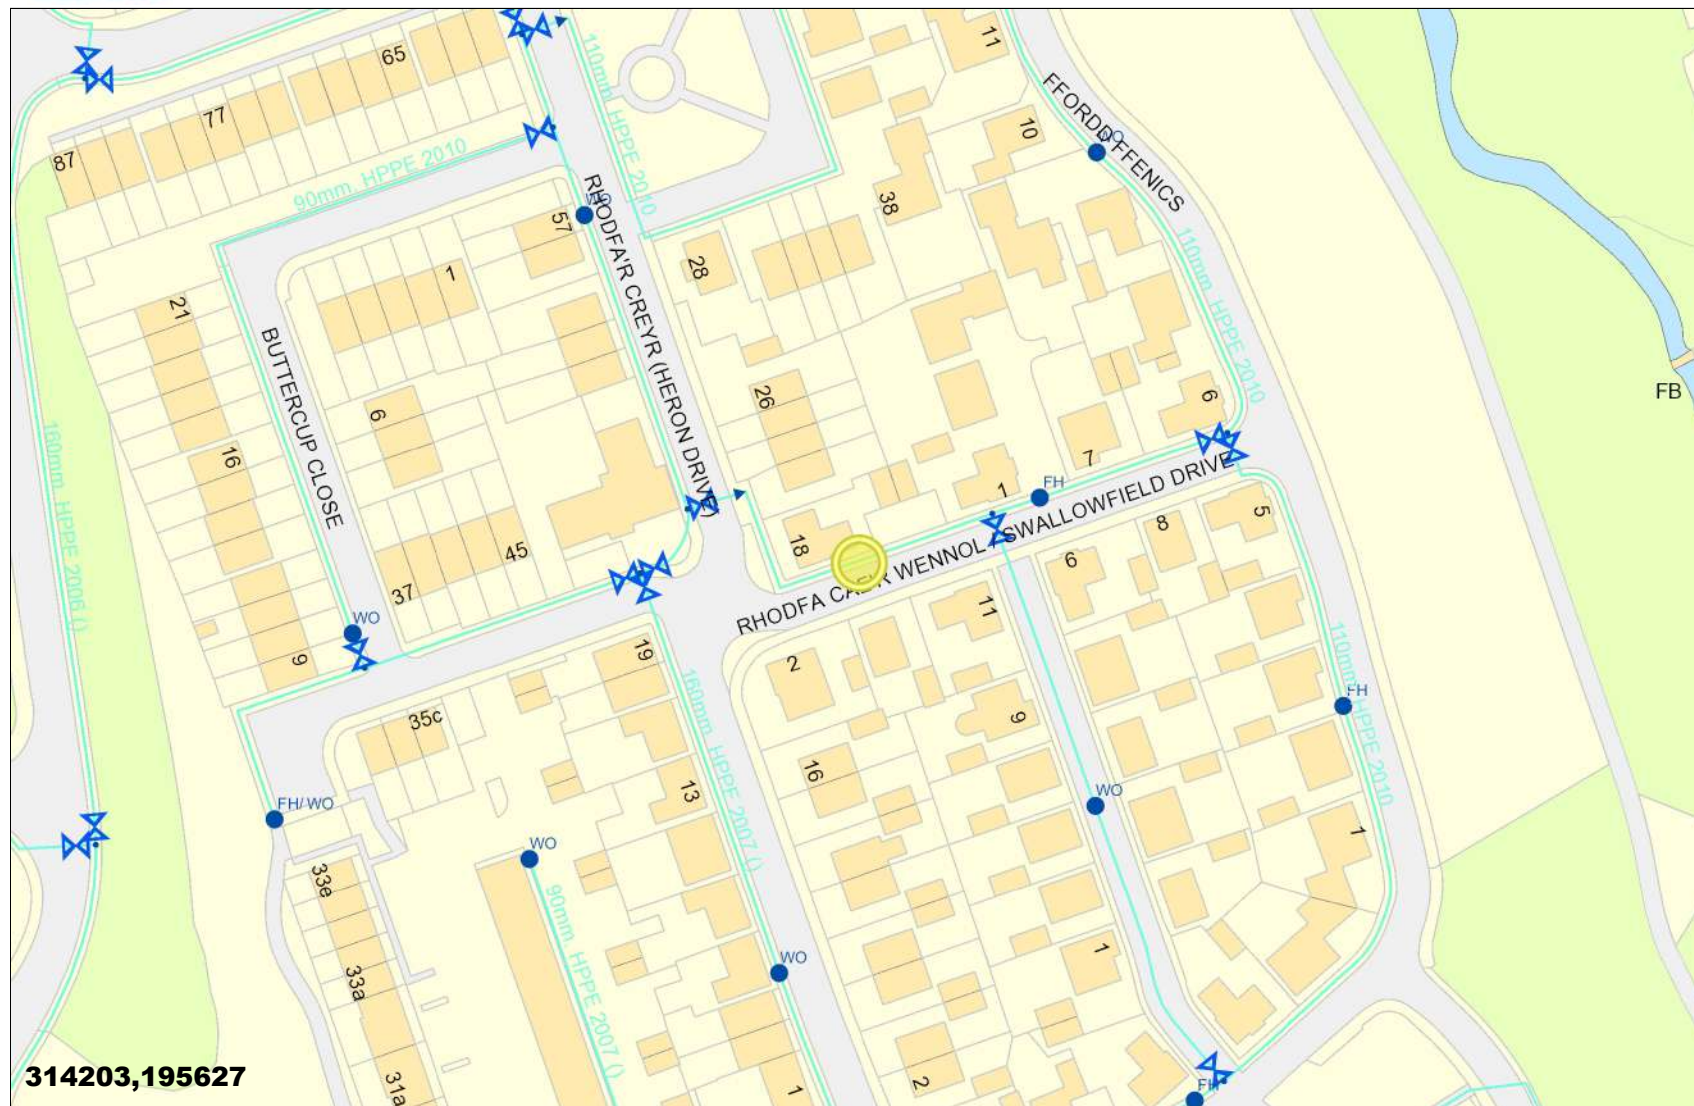

**314203,195627**

Dŵr Cymru Cyfyngedig ('the Company') gives this information as to the position of its underground apparatus by way of general guidance only and on the strict understanding that it is based on the best information available and no warranty as to its correctness is relied upon in the event of excavations or other works made in the vicinity of the company's apparatus and any onus of locating the apparatus before carrying out any excavations rests entirely on you. The information which is supplied hereby by the company, is done so in accordance with statutory requirements of sections 198 and 199 of the water industry Act 1991 based upon the best information available and in particular, but without prejudice to the generality of the foregoing, it should be noted that the records that are available to the Company may not disclose the existence of a drain sewer or disposal main laid before 1 September 1989, or if they do, the particulars thereof including their position underground may not be accurate. It must be understood that the furnishing of this information is entirely without prejudice to the provision of the New Roads and Street Works Act 1991 and the company's right to be compensated for any damage to its apparatus.

**EXACT LOCATION OF  
ALL APPARATUS TO  
BE DETERMINED ON  
SITE**

Reproduced from the Ordnance Survey's maps with the permission of the Controller of Her Majesty's Stationary Office. Crown Copyright. Licence No: WU298565.

Whilst every reasonable effort has been taken to correctly record the pipe material of DCWW assets, there is a possibility that in some cases pipe material (other than Asbestos Cement or Pitch Fibre) may be found to be Asbestos Cement (AC) or Pitch Fibre (PF). It is therefore advisable that the possible presence of AC or PF pipes be anticipated and considered as part of any risk assessment prior to excavation



Scale: 1: 1250



Whilst every reasonable effort has been taken to correctly record the pipe material of DCWW assets, there is a possibility that in some cases pipe material (other than Asbestos Cement or Pitch Fibre) may be found to be Asbestos Cement (AC) or Pitch Fibre (PF). It is therefore advisable that the possible presence of AC or PF pipes be anticipated and considered as part of any risk assessment prior to excavation






18/03/2021





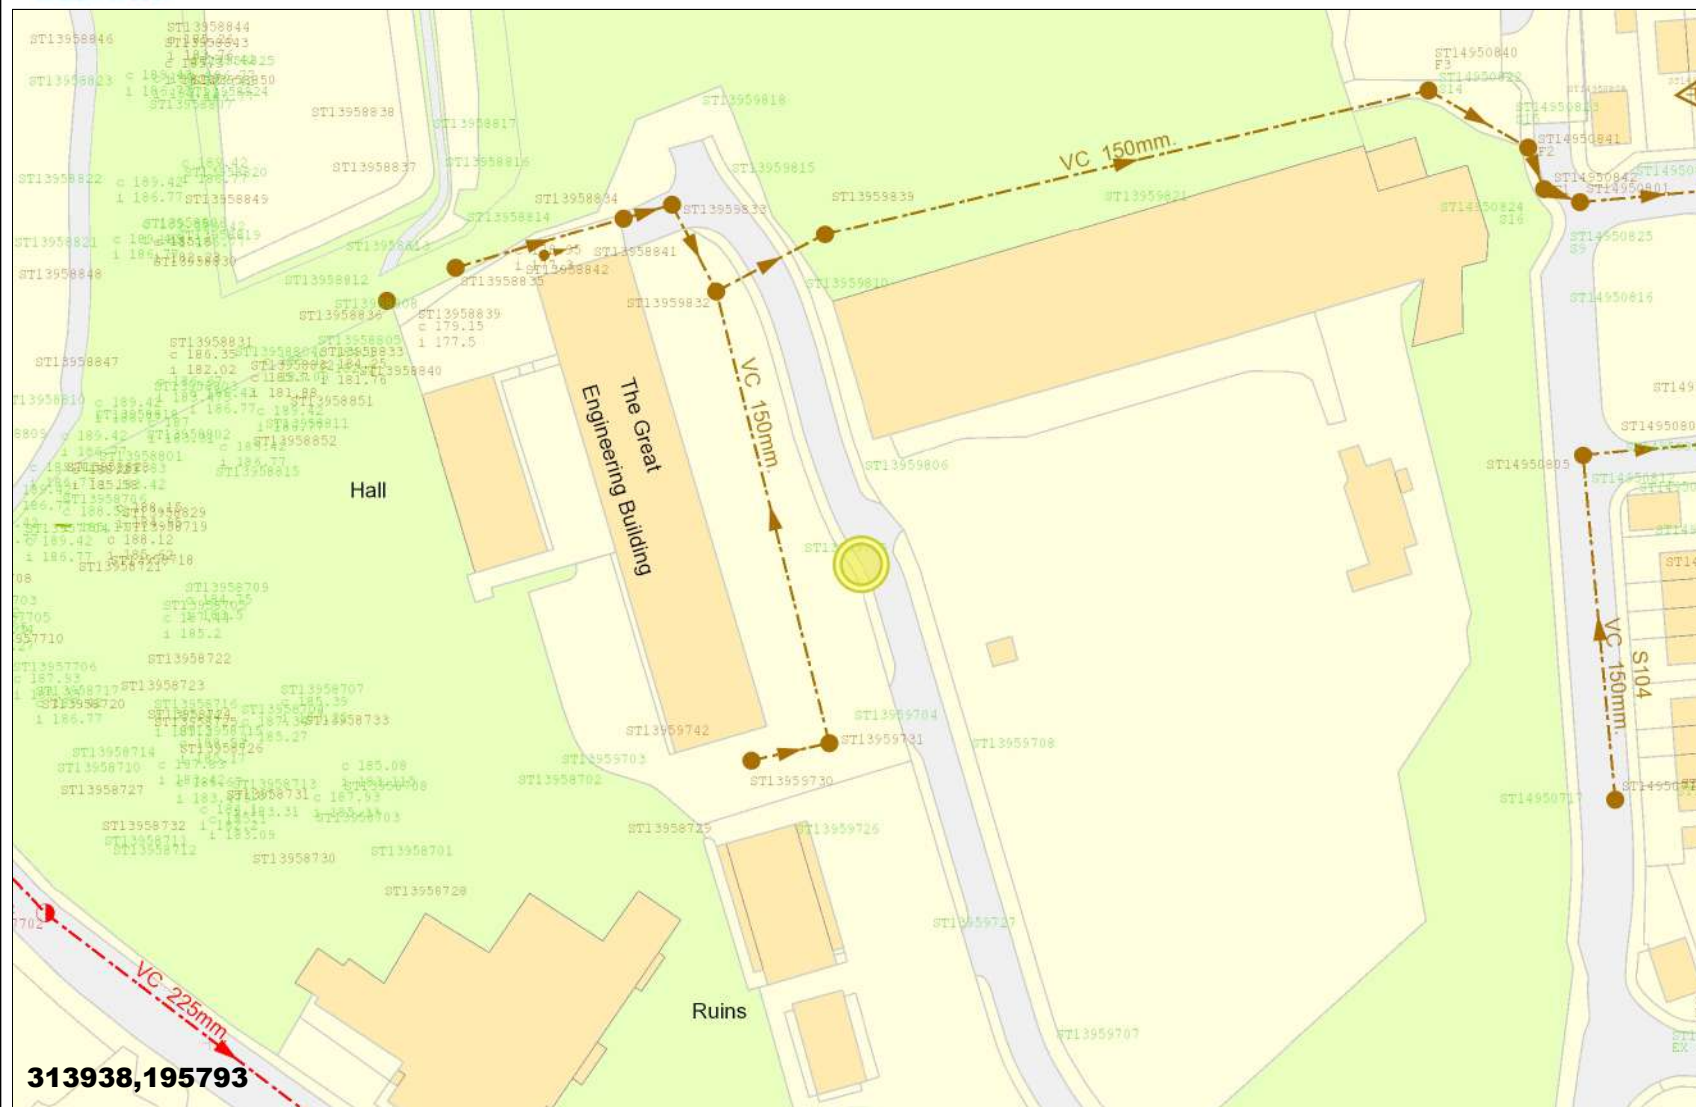



Scale: 1: 1250



### LEGEND

## Clean Water

-  Sluice Val
-  Air Val, SINGLE
-  Tap
-  Pressure Reducing Valve
-  Meter
-  BULK Meter
-  FH
-  Cap

### Sewerage External


-  Foul
-  Surface Water
-  Combined
-  Rising Main
-  Private
-  Treatment Works
-  Pumping Station
-  Special Purpose
-  Unknown End
-  Change, Combined Overflow
-  Outfall, FOUL
-  Lamp Hole, Foul
-  Private Sewer Transfer
-  Lateral Drain
-  Inspection Chamber

Dwr Cymru Cyfyngedig ('the Company') gives this information as to the position of its underground apparatus by way of general guidance only and on the strict understanding that it is based on the best information available and no warranty as to its correctness is relied upon. In the event of excavations or other works made in the vicinity of the company's apparatus and any onus of locating the apparatus before carrying out any excavations rests entirely on you. The information which is supplied hereby the company, is done so in accordance with statutory requirements of sections 198 and 199 f the water industry Act 1991 based upon the best Information available and in particular, but without prejudice to the generality of the foregoing, it should be noted that the records that are available to the Company may not disclose the existence of a drain sewer or disposal main laid before 1 September 1989, or if they do, the particulars thereof including their position underground may not be accurate. It must be understood that the furnishing of this information us entirely without prejudice to the provision of the New Roads and Street Works Act 1991 and the company's right to be compensated for any damage to its apparatus.

EXACT LOCATION OF  
ALL APPARATUS TO  
BE DETERMINED ON  
SITE

Reproduced from the Ordnance Survey's  
maps with the permission of the  
Controller of Her Majesty's Stationary  
Office. Crown Copyright. Licence No:  
WU298565.

Whilst every reasonable effort has been taken to correctly record the pipe material of DCWW assets, there is a possibility that in some cases pipe material (other than Asbestos Cement or Pitch Fibre) may be found to be Asbestos Cement (AC) or Pitch Fibre (PF). It is therefore advisable that the possible presence of AC or PF pipes be anticipated and considered as part of any risk assessment prior to excavation

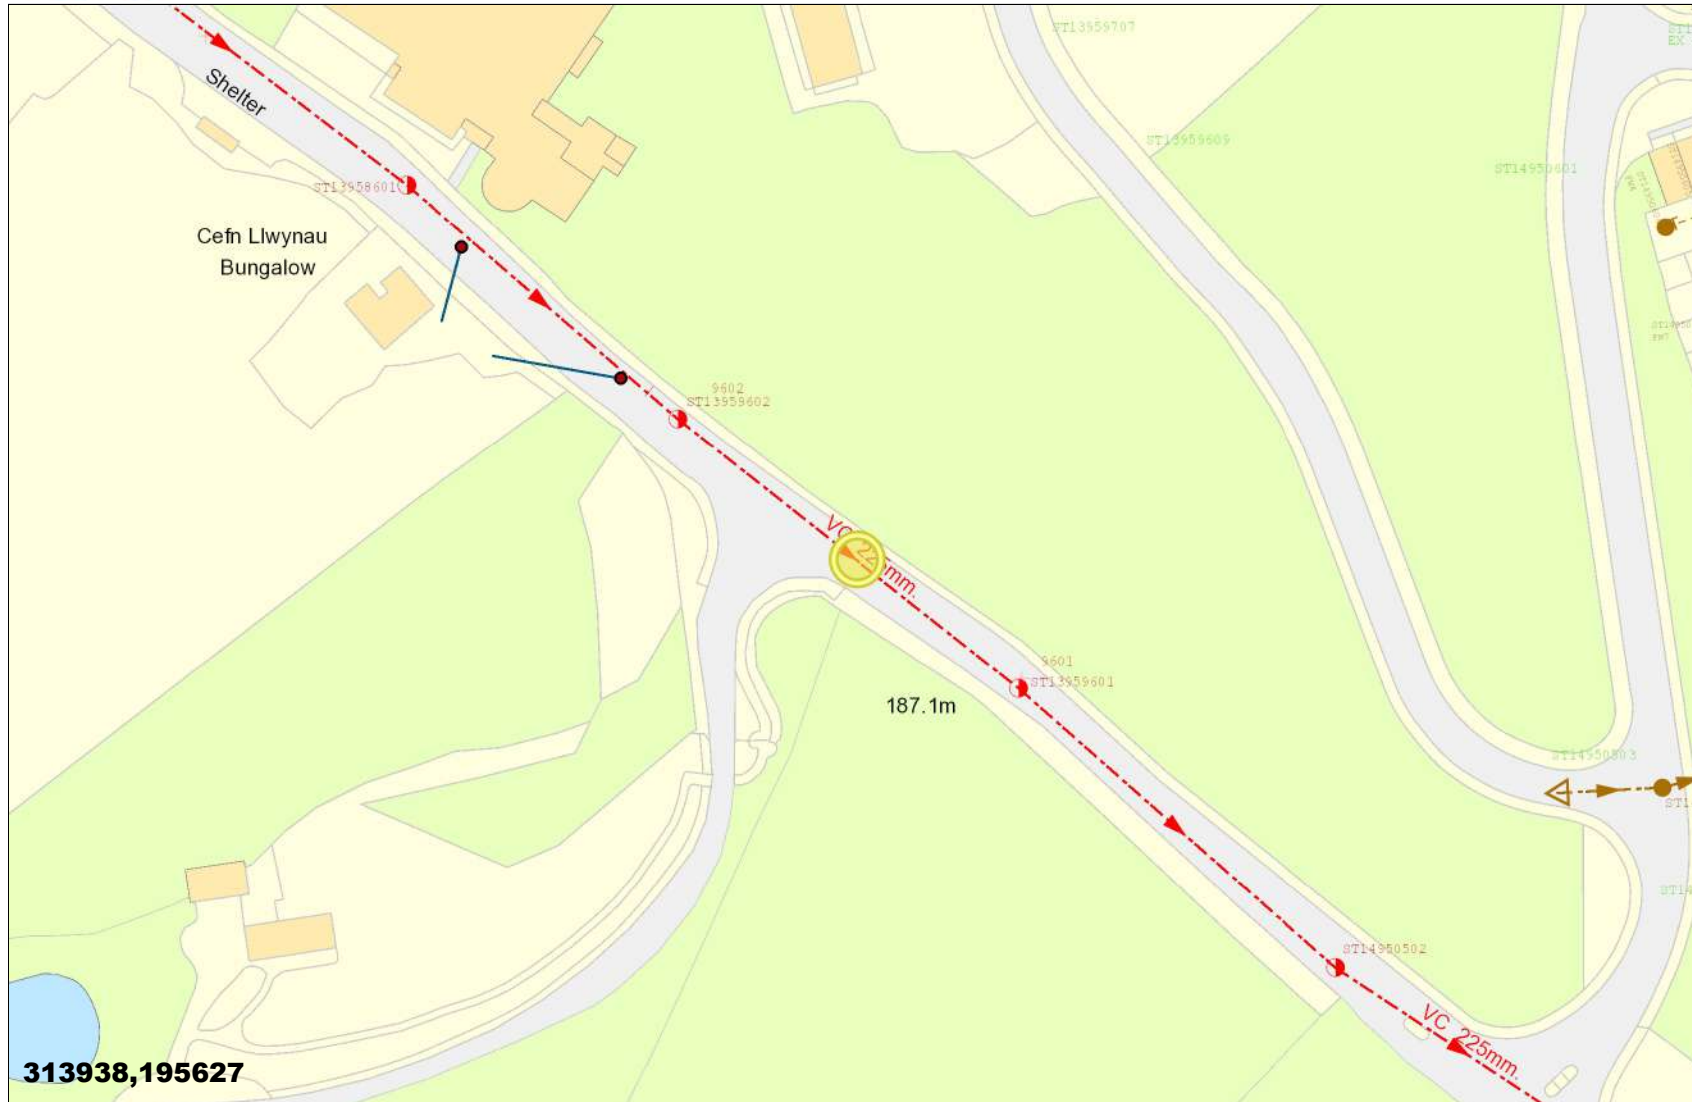

**LEGEND**

**Clean Water**

- Sluice Val
- Air Val, SINGLE
- Tap
- Pressure Reducing Valve
- Meter
- BULK Meter
- FH
- Cap
- Existing Main
- NON COMPANY

**Sewerage External**

- Foul
- Surface Water
- Combined
- Rising Main
- Private
- Treatment Works
- Pumping Station
- Special Purpose
- Unknown End
- Change, Combined Overflow
- Outfall, FOUL
- Lamp Hole, Foul
- Private Sewer Transfer
- Lateral Drain
- Inspection Chamber

**313938,195627**

Dŵr Cymru Cyfyngedig ('the Company') gives this information as to the position of its underground apparatus by way of general guidance only and on the strict understanding that it is based on the best information available and no warranty as to its correctness is relied upon in the event of excavations or other works made in the vicinity of the company's apparatus and any onus of locating the apparatus before carrying out any excavations rests entirely on you. The information which is supplied hereby by the company, is done so in accordance with statutory requirements of sections 198 and 199 of the water industry Act 1991 based upon the best information available and in particular, but without prejudice to the generality of the foregoing, it should be noted that the records that are available to the Company may not disclose the existence of a drain sewer or disposal main laid before 1 September 1989, or if they do, the particulars thereof including their position underground may not be accurate. It must be understood that the furnishing of this information is entirely without prejudice to the provision of the New Roads and Street Works Act 1991 and the company's right to be compensated for any damage to its apparatus.

**EXACT LOCATION OF  
ALL APPARATUS TO  
BE DETERMINED ON  
SITE**

Reproduced from the Ordnance Survey's maps with the permission of the Controller of Her Majesty's Stationary Office. Crown Copyright. Licence No: WU298565.











Whilst every reasonable effort has been taken to correctly record the pipe material of DCWW assets, there is a possibility that in some cases pipe material (other than Asbestos Cement or Pitch Fibre) may be found to be Asbestos Cement (AC) or Pitch Fibre (PF). It is therefore advisable that the possible presence of AC or PF pipes be anticipated and considered as part of any risk assessment prior to excavation.
















 
 


#### LEGEND

##### Clean Water

-  Sluice Val
-  Air Val, SINGLE
-  Tap
-  Pressure Reducing Valve
-  Meter
-  BULK Meter
-  FH
-  Cap
-  Existing Main
-  NON COMPANY

##### Sewerage External

-  Foul
-  Surface Water
-  Combined
-  Rising Main
-  Private
-  Treatment Works
-  Pumping Station
-  Special Purpose
-  Unknown End
-  Change, Combined Overflow
-  Outfall, FOUL
-  Lamp Hole, Foul
-  Private Sewer Transfer
-  Lateral Drain
-  Inspection Chamber


314203,195627

Dwr Cymru Cyfyngedig ('the Company') gives this information as to the position of its underground apparatus by way of general guidance only and on the strict understanding that it is based on the best information available and no warranty as to its correctness is relied upon in the event of excavations or other works made in the vicinity of the company's apparatus and any onus of locating the apparatus before carrying out any excavations rests entirely on you. The information which is supplied hereby the Company, is done so in accordance with statutory requirements of sections 198 and 199 of the water industry Act 1991 based upon the best information available and in particular, but without prejudice to the generality of the foregoing, it should be noted that the records that are available to the Company may not disclose the existence of a drain sewer or disposal main laid before 1 September 1989, or if they do, the particulars thereof including their position underground may not be accurate. It must be understood that the furnishing of this information is entirely without prejudice to the provision of the New Roads and Street Works Act 1991 and the company's right to be compensated for any damage to its apparatus.

EXACT LOCATION OF  
ALL APPARATUS TO  
BE DETERMINED ON  
SITE





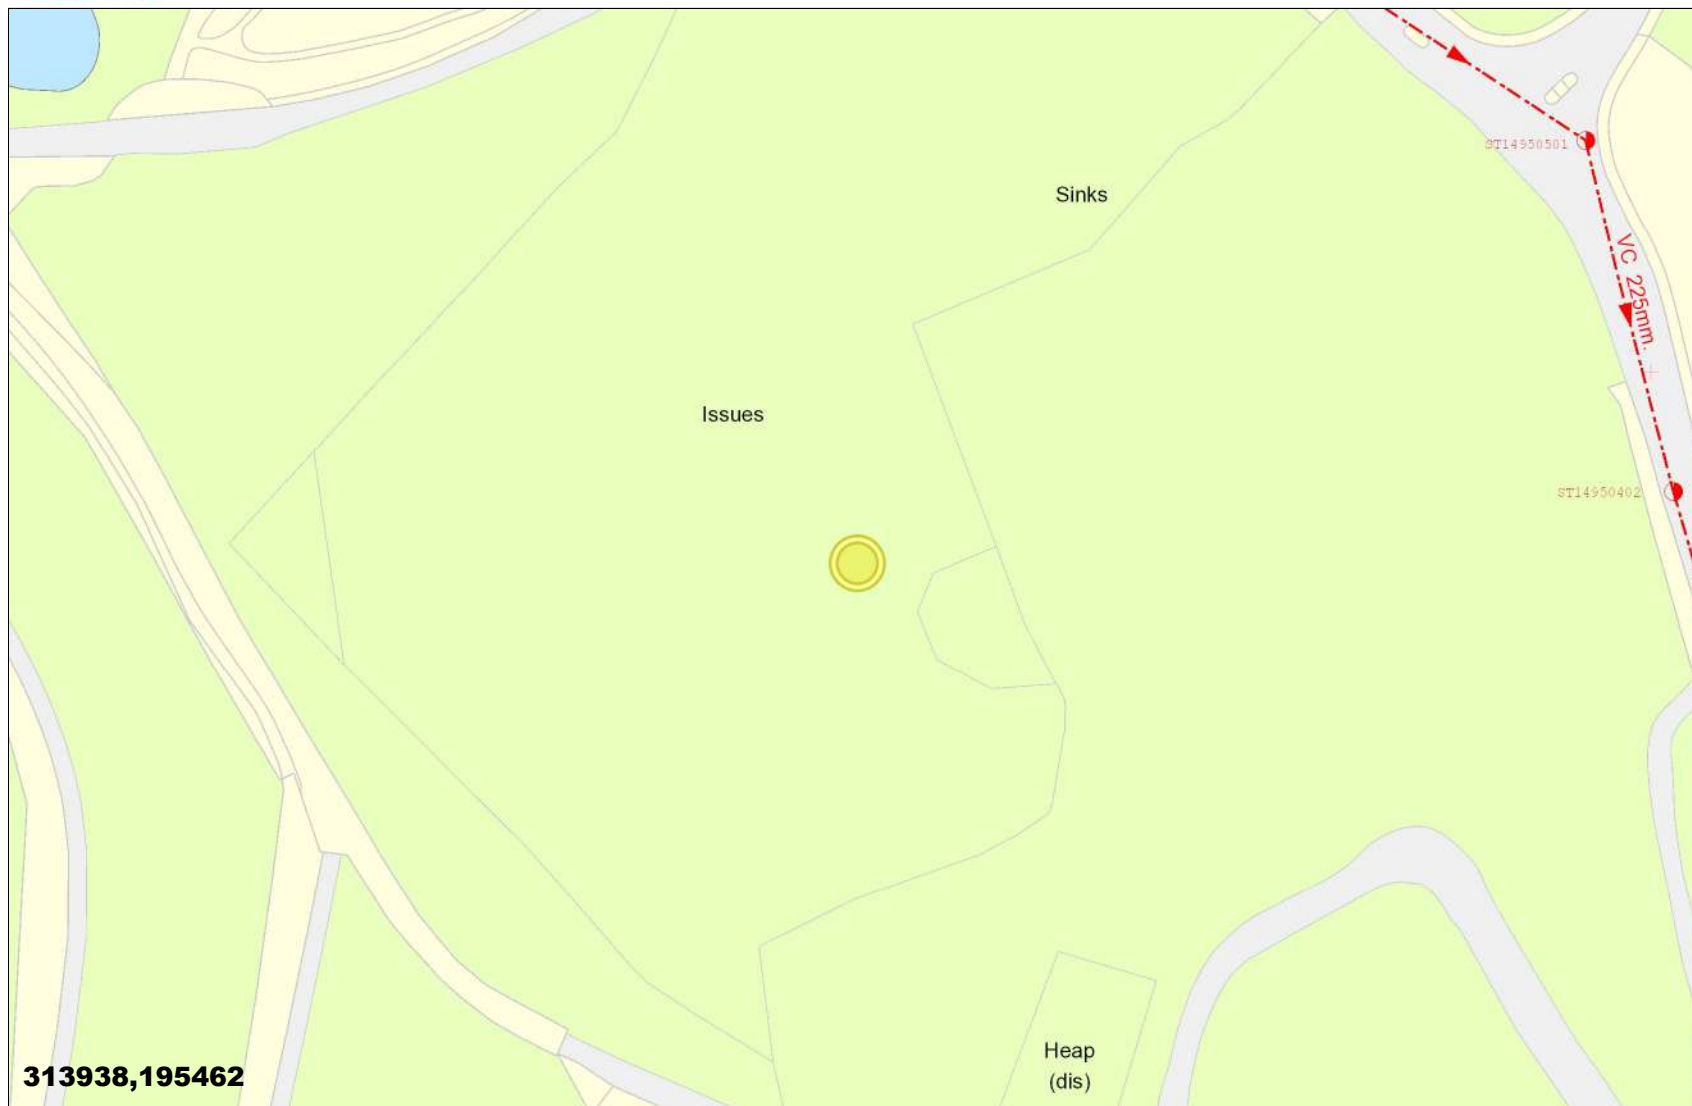


Reproduced from the Ordnance Survey's maps with the permission of the Controller of Her Majesty's Stationary Office. Crown Copyright. Licence No: WU298555.

Whilst every reasonable effort has been taken to correctly record the pipe material of DCWW assets, there is a possibility that in some cases pipe material (other than Asbestos Cement or Pitch Fibre) may be found to be Asbestos Cement (AC) or Pitch Fibre (PF). It is therefore advisable that the possible presence of AC or PF pipes be anticipated and considered as part of any risk assessment prior to excavation



#### LEGEND

##### Clean Water

-  Sluice Val
-  Air Val, SINGLE
-  Tap
-  Pressure Reducing Valve
-  Meter
-  BULK Meter
-  FH
-  Cap
-  Existing Main
-  NON COMPANY

##### Sewerage External

-  Foul
-  Surface Water
-  Combined
-  Rising Main
-  Private
-  Treatment Works
-  Pumping Station
-  Special Purpose
-  Unknown End
-  Change, Combined Overflow
-  Outfall, FOUL
-  Lamp Hole, Foul
-  Private Sewer Transfer
-  Lateral Drain
-  Inspection Chamber


Dwr Cymru Cyfyngedig ('the Company') gives this information as to the position of its underground apparatus by way of general guidance only and on the strict understanding that it is based on the best information available and no warranty as to its correctness is relied upon in the event of excavations or other works made in the vicinity of the company's apparatus and any onus of locating the apparatus before carrying out any excavations rests entirely on you. The information which is supplied hereby the company, is done so in accordance with statutory requirements of sections 198 and 199 of the Water Industry Act 1991 based upon the best information available and in particular, but without prejudice to the generality of the foregoing, it should be noted that the records that are available to the Company may not disclose the existence of a drain sewer or disposal main laid before 1 September 1989, or if they do, the particulars thereof including their position underground may not be accurate. It must be understood that the furnishing of this information is entirely without prejudice to the provision of the New Roads and Street Works Act 1991 and the company's right to be compensated for any damage to its apparatus.

**EXACT LOCATION OF  
ALL APPARATUS TO  
BE DETERMINED ON  
SITE**

Reproduced from the Ordnance Survey's maps with the permission of the Controller of Her Majesty's Stationary Office. Crown Copyright. Licence No: WU298565.

Whilst every reasonable effort has been taken to correctly record the pipe material of DCWW assets, there is a possibility that in some cases pipe material (other than Asbestos Cement or Pitch Fibre) may be found to be Asbestos Cement (AC) or Pitch Fibre (PF). It is therefore advisable that the possible presence of AC or PF pipes be anticipated and considered as part of any risk assessment prior to excavation.



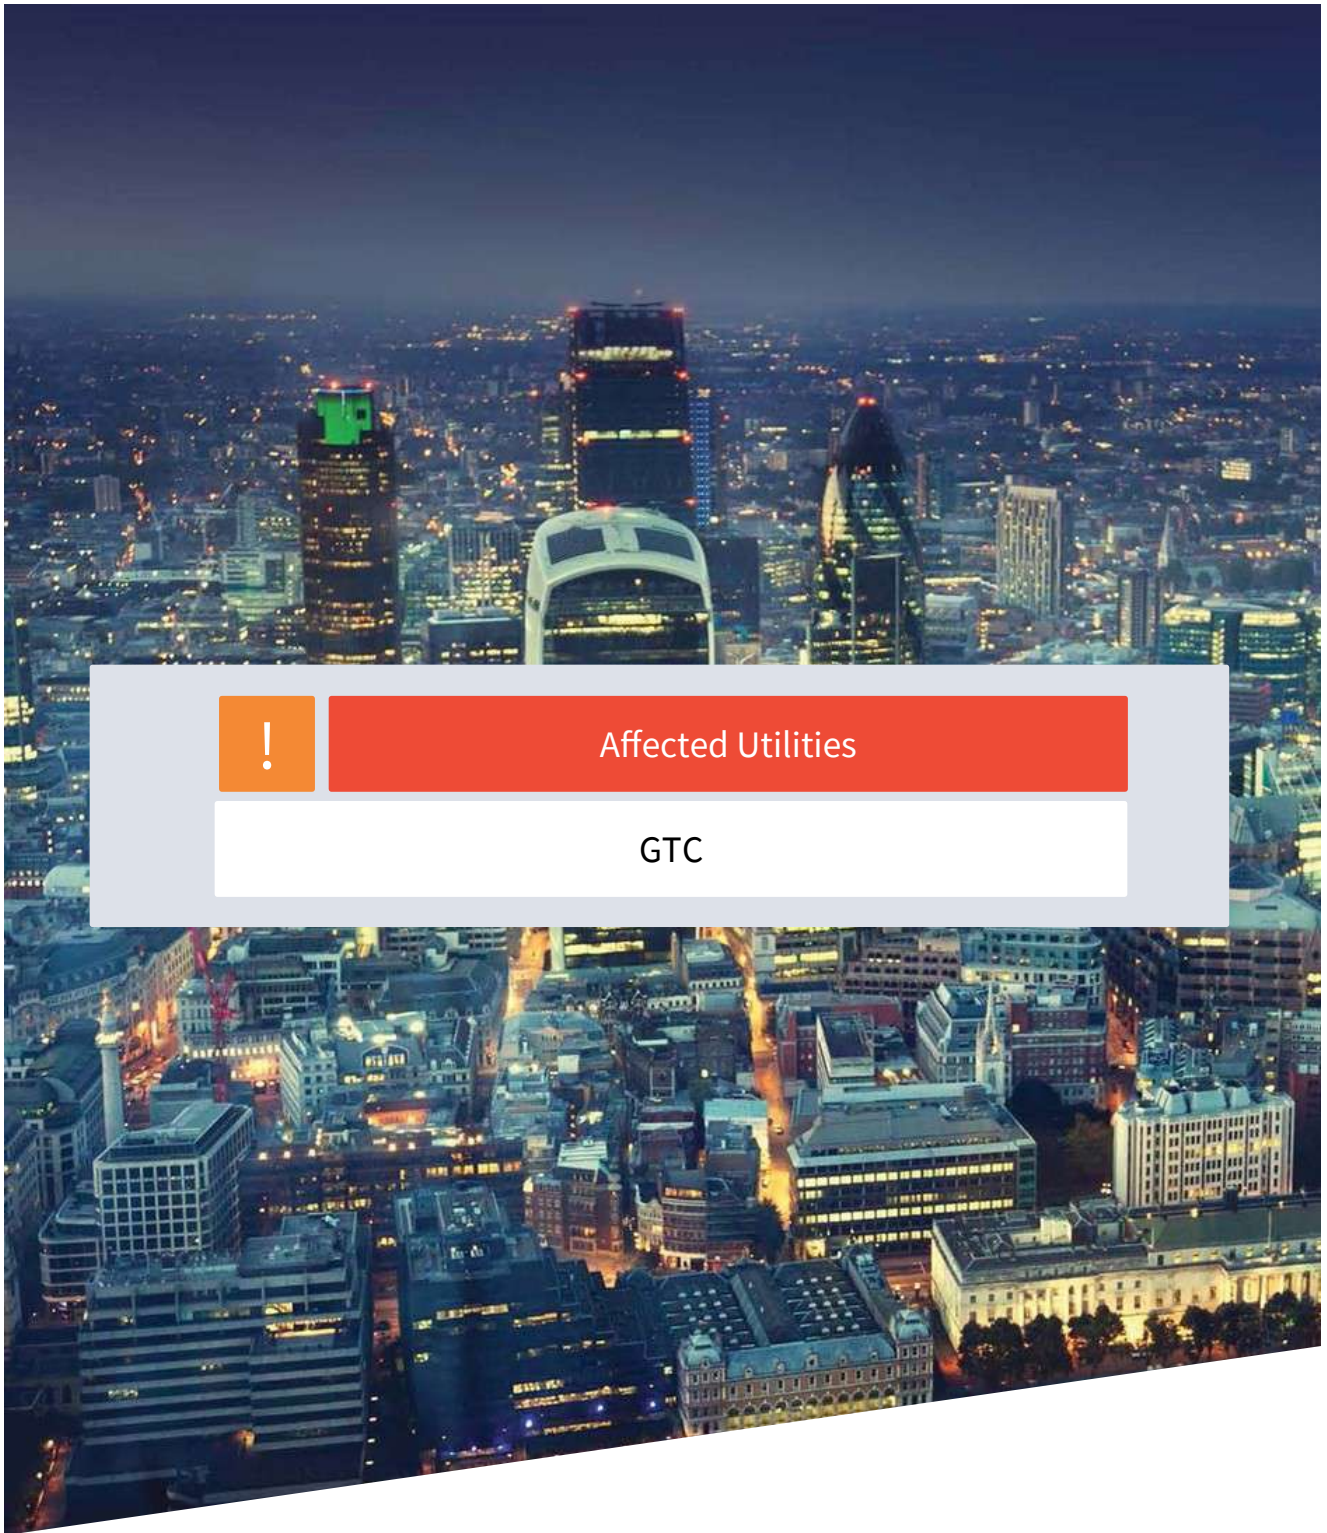

**CHECKED**

**From:** plantenquiryservice@gtc-uk.co.uk  
**Sent:** 22 March 2021 14:35  
**To:** Utility Solutions GDC Requests  
**Subject:** GTC Plant Enquiry - Ref- 1763250  
**Attachments:** 1763250.png; GU-DPR-IG-0022 Safe working in the vicinity of utility networks.pdf

**Follow Up Flag:** Follow up  
**Flag Status:** Completed

### **Warning: GTC Apparatus Exists in This Area**

**Our Plant Enquiry Service Ref: 1763250**  
**Your Enquiry Ref: LM 94066/BRK**

Dear Chrissy,

Thank you for your enquiry concerning apparatus in the vicinity of your proposed work. For your records, the search area is shown in the attached map.

Please click on the links below to download copies of the relevant utility asset drawings locating our assets in the area which you identified. These drawings are grouped by our relevant network reference, should you need to contact us regarding any of our networks please quote this reference. Links to files will remain live for 10 days. If you do not download these files within this period you will need to submit a new enquiry – this will ensure you have an up-to-date copy of our asset records.

**PLEASE NOTE:** Where drawings are large, these have been provided in smaller segments. A drawing index is provided as the first file listed for each network reference (example of a network reference: N1234567) shown below. This is intended to help you find the drawing relevant to you more quickly. Please take care to ensure that you use the relevant drawings for every network listed below as we may have multiple networks and multiple utilities in this area.

### **N0003142**

#### **Gas**

- [N0003142-1 1 of 7 Entire site.png](#)
- [N0003142-1 2 of 7.png](#)
- [N0003142-1 3 of 7.png](#)
- [N0003142-1 4 of 7.png](#)
- [N0003142-1 5 of 7.png](#)
- [N0003142-1 6 of 7.png](#)
- [N0003142-1 7 of 7.png](#)

This information is for guidance only and the precise position of the plant must be established, prior to your works, using hand-digging methods only. The contractor will be held responsible for any damage caused to our asset. Please note our assets now include those owned and operated by:

- GTC Pipelines Limited
- Independent Pipelines Limited
- Quadrant Pipelines Limited
- Electricity Network Company Limited
- Independent Power Networks Limited
- Independent Water Networks Limited
- Open Fibre Networks Limited
- Independent Community Heating Limited

If you have any queries or require any further information please do not hesitate to contact us.

All works in the vicinity of our networks should be undertaken in accordance with the attached document "GU-DPR-IG-0022: Safe working in the vicinity of utility networks". Reference should also be made to HSG47 Avoiding Danger from Underground Services.

**Important: The area of your proposed works may contain gas mains operating at Medium and Intermediate Pressure tiers or electric cables operating at High Voltage – please refer to the network drawings included with this email. If your proposed works are likely to involve excavation within 10 metres of any of these assets, including but not limited to gas governors and electric substations you MUST inform GTC Plant Enquiries by calling 01359 240363 and quoting your Plant Enquiries Service Reference number.**

**Important: Drawings provided by this service may include utility assets not owned or managed by GTC. Conversely our drawings will NOT display assets from all third parties. It is your responsibility to ensure you have requested information from all utility asset owners.**

**Gas Escape or Damage MUST be reported on 0800 111 999. National Grid / DNGT will attend to make safe and repair.**

**Electricity Network Damage MUST be reported to ENC on 0800 032 6990.**

**Water Network Damage MUST be reported to IWNL on 02920 028 711**

**Fibre Network Damage MUST be reported to IFNL on 0845 051 1669**

**Thank you for using the GTC Plant Enquiries Service.**

Your sincerely,

**GTC Plant Enquiry Service**


**GTC  
Synergy House  
Woolpit Business Park  
Woolpit  
Bury St Edmunds  
Suffolk, IP30 9UP  
Tel: 01359 240363  
plant.enquiries@gtc-uk.co.uk**

NOTE:


This E-Mail originates from GTC, Synergy House, Woolpit Business Park, Woolpit, Bury St Edmunds, Suffolk, IP30 9UP

VAT Number: GB688 8971 40. Registered No: 029431.



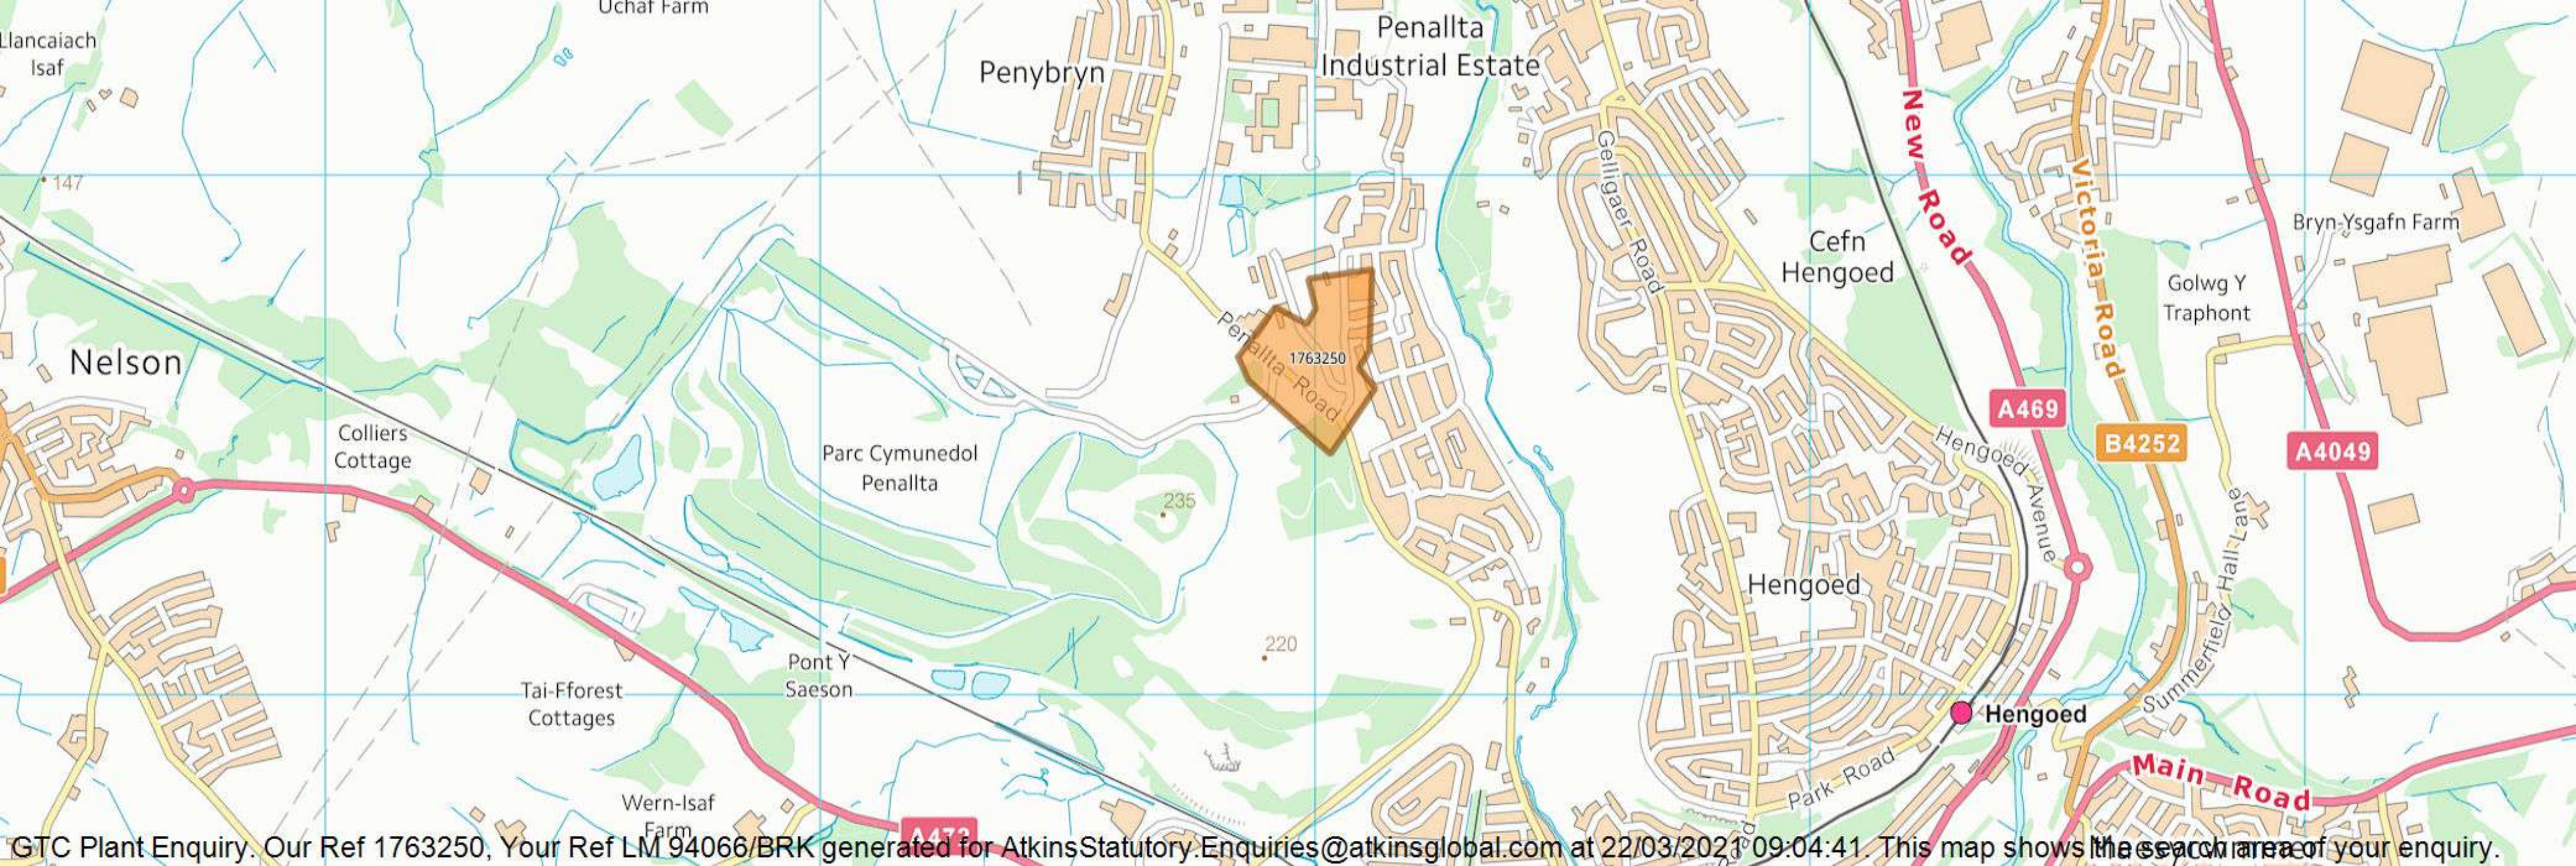




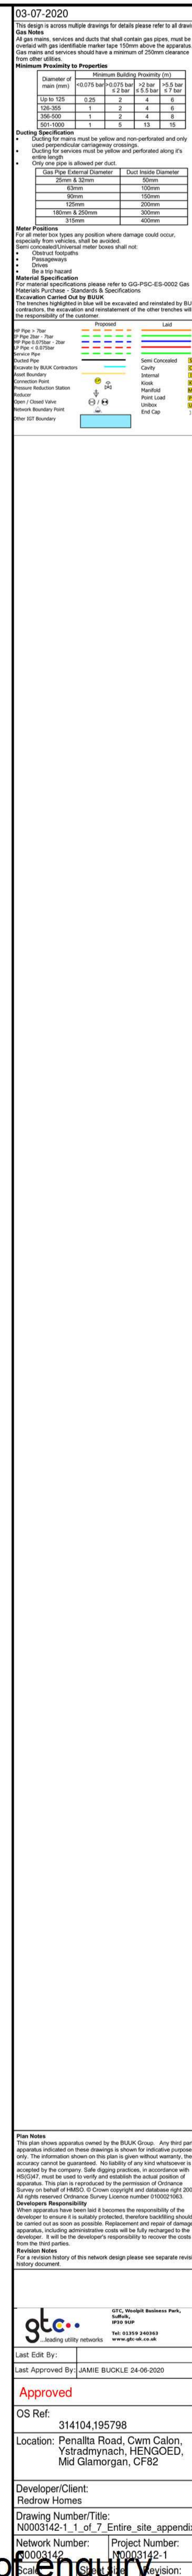








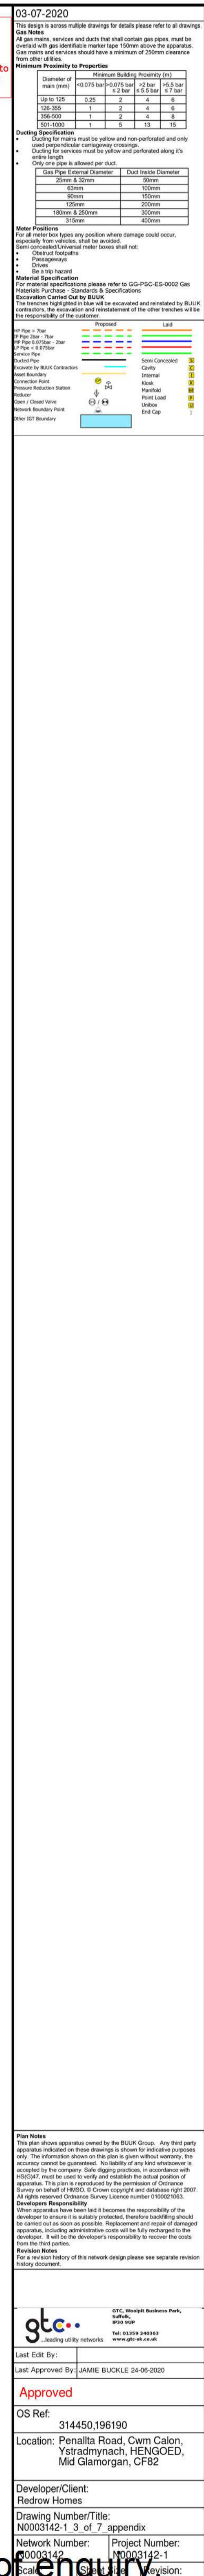



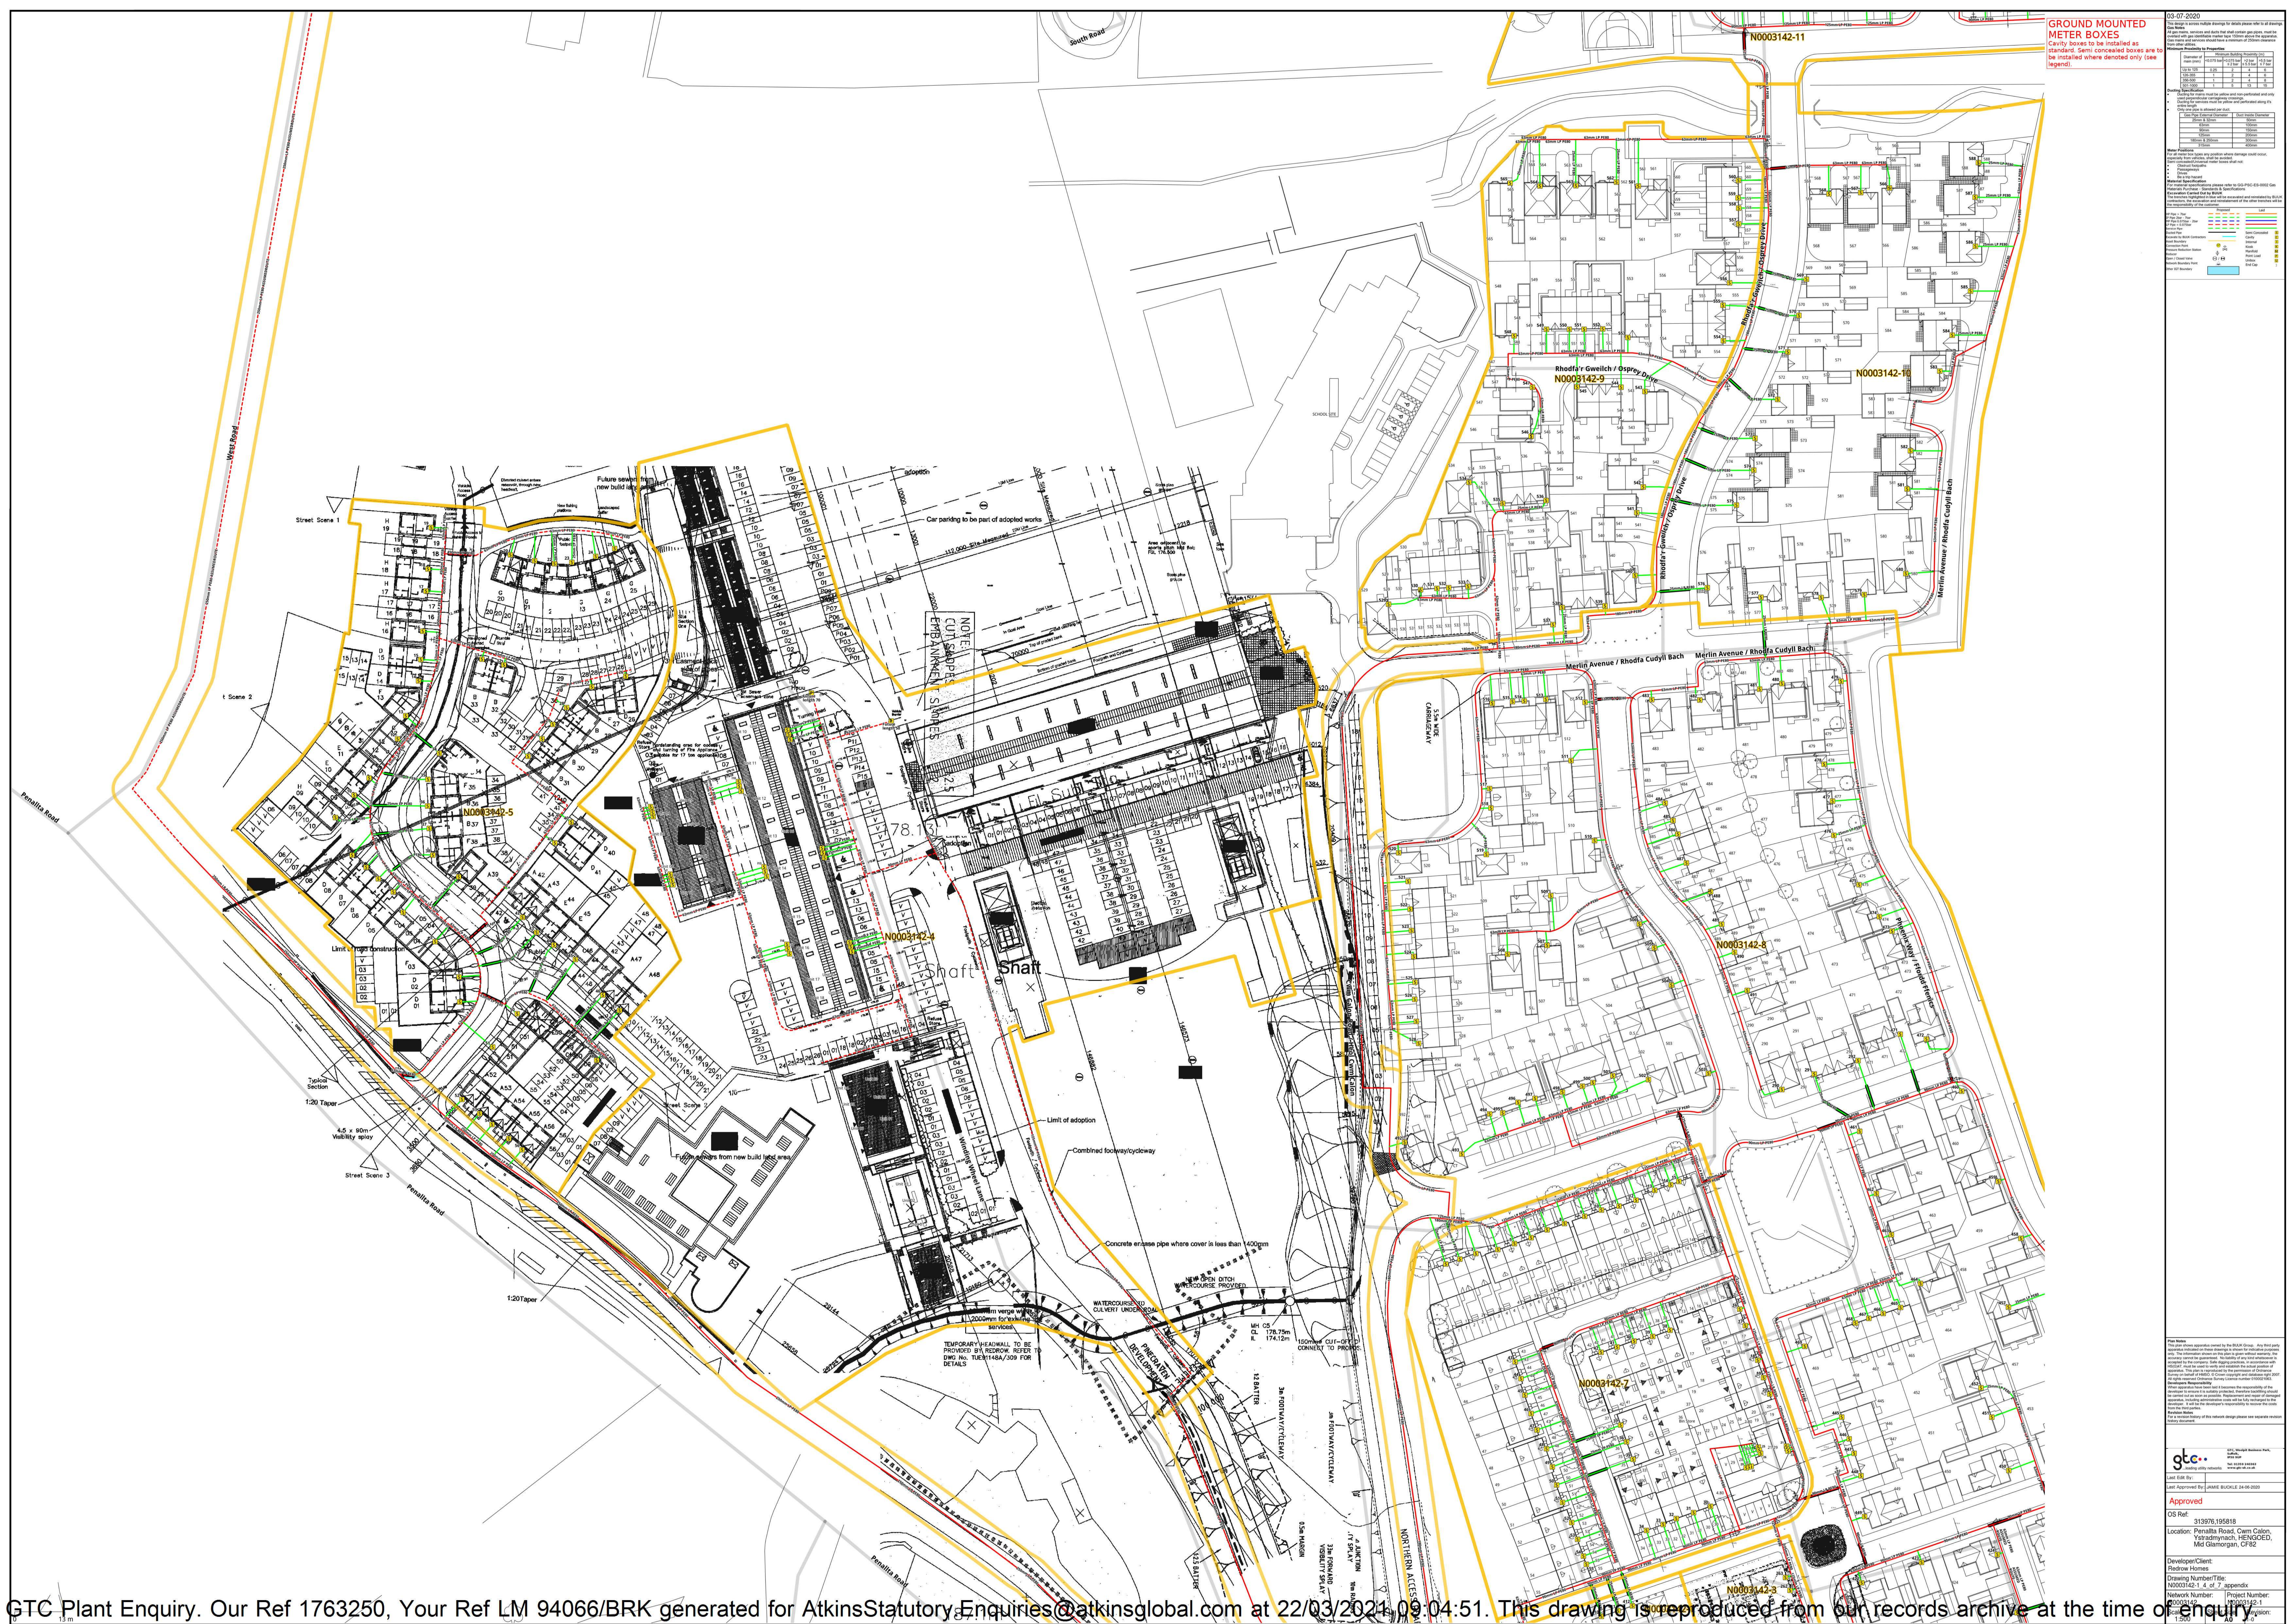

**GROUND MOUNTED METER BOXES**  
Cavity boxes to be installed as standard. Semi-concealed boxes to be installed where denoted only (see legend).














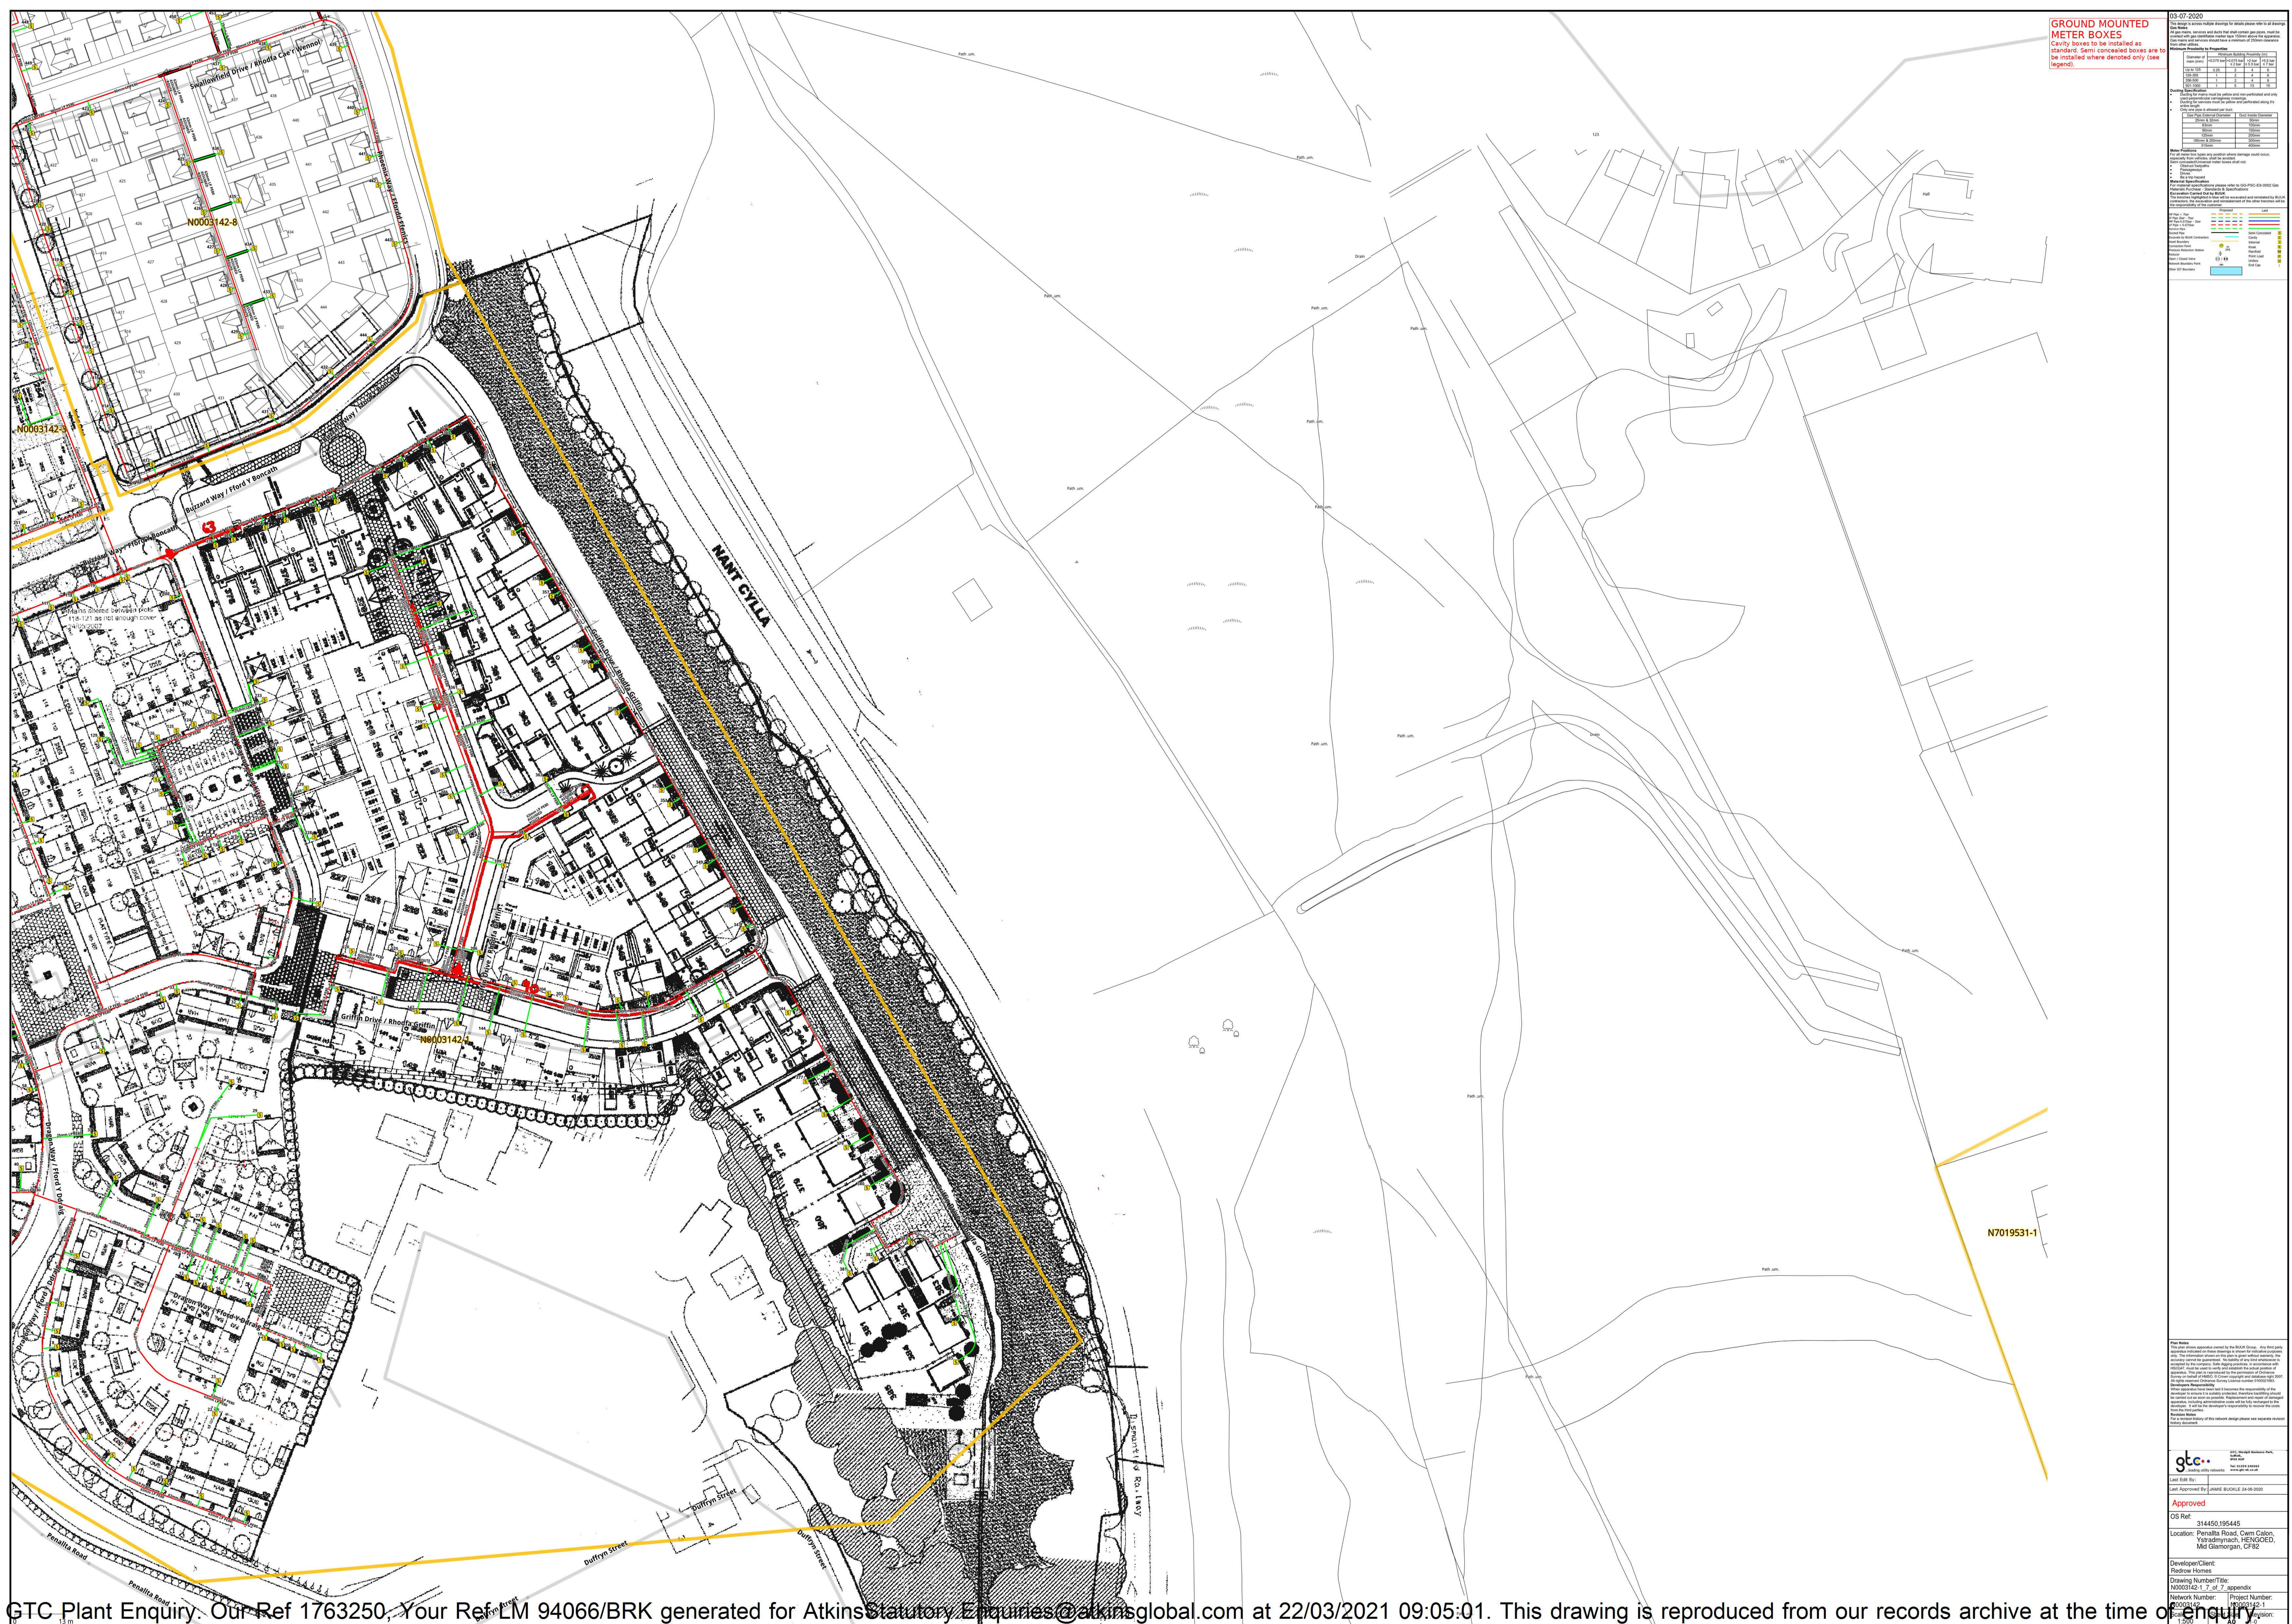



## SAFE WORKING IN THE VICINITY OF UTILITY NETWORKS

(Refer to the HSE Guidance Document HSG47)

### General

1. It is imperative that all works are carried out in accordance with the guidance provided by the HSE in their document HSG47 "Avoiding Danger from Underground Services", ISBN 0-7176-1744-0. No party should carry out any excavation works or other intrusive works such as piling, blasting or demolition without following the guidance in HSG47.
2. We own gas, electricity, water and fibre apparatus located in the highway, private property and through the countryside. Some plant may be located in land for which a wayleave or easement has been granted & there may be no surface evidence of the presence of apparatus.
3. Ensure that you have obtained detailed plans of existing and proposed gas, electricity water and fibre networks.
4. The position of the networks should be pinpointed as accurately as possible by reference to the plans and by means of a locating device, which has been tested and calibrated within the last twelve months.

Excavation work should be carried out where applicable, and carefully follow recognised safe digging practices. Once a locating device has been used to determine position and route, excavation may proceed; trial holes should be dug using suitable hand tools to confirm the position of buried networks. During excavation the locating device should be reused to check position and route of buried apparatus.

5. Hand-held power tools can damage buried apparatus and should be used with care until the exact position has been determined. They may only be used to break a paved or concrete surface above the network, unless there are any indications that the network is particularly shallow, in such circumstances, accuracy of plant location is determined and excavation initiated adjacent to the apparatus.
6. No manhole, chamber or other structure should be built over, around or under the network. Such structures, other pipes, ducts and cables should be laid to provide a minimum clearance from the network of 300mm or 1.5 times the diameter of the network, whichever is the greater. No work should be carried out if this minimum clearance cannot be met or which results in a reduction of cover or protection over the network, without first consulting GTC.
7. Where an excavation uncovers a network apparatus the backfill should be adequately compacted, particularly beneath the network, to prevent any settlement, which would subsequently damage the network. Backfill material adjacent to the network should be selected fine material or sand, containing no stones, bricks or lumps of concrete etc. and should be suitably compacted to give comparable support and protection to that provided before excavation. No power compaction should take place until 200mm cover of selected fine fill has been suitably compacted by hand tools.



8. If the road construction is close to the top of the network, GTC should be asked about necessary precautions. The road construction depth should not be reduced without permission from the local Highway Authority.
9. Costs incurred by GTC through direct or consequential damage will be recharged.

### **Precautions for Gas Networks**

10. Plans do not always show the presence of gas service pipes (from the gas main to premises) but their existence should be assumed.
11. The depth of cover for gas mains is normally 750mm in carriageways and grass verges and 600mm in footways. The depth of cover for gas services is normally 450mm. Remember these covers are to finished level, you may be working in an area, which will be made up or lowered at a later date.
12. Plastic gas pipes should be located by hand digging before mechanical excavation begins. When the positions and depth of the pipes have been determined, work can proceed.
13. The danger created by damaging a gas pipe with an excavator is much greater than if the damage is done with a hand-held power tool (the opposite is true for work near electricity cables and this is reflected in the different safe digging practices). Gas pipes may have projections such as valve housings, which are not shown on the plans and to allow for this mechanical excavators should not be used within 500mm of a gas pipe.
14. If a gas leak is suspected, the following action should be taken immediately:
  - Remove all people from the immediate vicinity of the escape. If the service connection to a building or the adjacent main has been damaged, warn the occupants to leave the building, and any adjoining building, until it is safe for them to return. It is important to note that a mechanical excavator may not only cause damage/leakage at the point of impact. For example, damage to a service connection outside the building may result in further, unseen damage to the connection inside the building. Gas leaking from the damage inside or gas travelling along the line of the service connection pipe from outside the building may cause a build-up of gas within the building.
  - Prohibit smoking, and extinguish all naked flames and other sources of ignition i.e. stop excavator and compressor engines within at least 5.0m of the leak.
  - Inform National Grid by dialling **0800 111 999**
  - Remain on site.
  - Assist National Grid staff, Police or Fire Services as requested.
15. Where gas pipes cross or are parallel and close to excavations, changes in backfill etc. may cause differential ground settlement and increased stress in the pipe. For pipes parallel and close to excavations, the degree of risk depends upon the depth of the excavation, the distance of the pipe from the excavation, the type of soil and any excessive loading from heavy construction plant and materials. Wherever excavation works may affect the support of the gas pipe or cause excessive loading over the gas pipe then GTC must be consulted.

16. No concrete or other hard material should be placed or left under or adjacent to any gas pipe as this can cause pipe fracture at a later date. Concrete backfill should not be used within 300mm of a gas pipe.
17. Where an excavation uncovers a gas pipe with a damaged wrapping, GTC should be told, so that repairs can be made to prevent future corrosions and leakage.
18. Pipe restraints or thrust blocks close to gas mains should never be removed.
19. Anyone who carries out work near underground gas plant should observe any specific requirements made by the site manager, and ensure that access to the plant by National Grid Gas and GTC staff is available at all times. No unauthorised repairs to gas pipes should be made.
20. Where excavation is within 5 metres proximity to above or below ground pressure control equipment, ground workers must be aware of the possibility of encountering small impulse pipe work that is more susceptible to damage.
21. Where PE pipes and cables have been exposed and it is intended hot work (e.g. welding, grinding, etc) be carried out, contact must be made with GTC to confirm additional precautions and actions that may require to be undertaken.
22. GTC should be consulted if it is intended to carry out any of the following activities:
  - using explosives within 30m of gas pipes or 400m of gas pressure reduction equipment
  - piling or boring within 15m of gas plant
  - excavating within 10m of pressure reduction equipment
  - reducing the cover or protection of a gas pipe
  - carrying out nearby deep excavations
  - working near our intermediate pressure (IP) mains.

### **Precautions for Electricity Networks**

23. Plans do not always show the presence of electric service cables (from the electricity main to premises) but their existence should be assumed.
24. In most cases there will be no permanent surface marker posts or other visible indication of the presence of a buried cable. Even if no cables are shown on plans or detected by a locator, there may still be cables present, which could be live and a close watch should be kept for any signs which could indicate their presence such as marker tape, tape tile, concrete tiles and wooden battens. Any marker which is disturbed by our excavations must be replaced once work is completed.
25. Typically underground cables are laid in trenches between 450mm and 1.0m deep, although some high voltage cables will be deeper, however, depths should never be assumed.
26. A cable is positively located only when it has been safely exposed. Even then, digging should still proceed with care as there may be other cables adjacent or lower down.

27. Occasionally, cables are terminated in the ground by means of a seal, sometimes with external mechanical protection. These “pot ended” or “bottle ended” cables should be treated as live and should not be assumed to be abandoned or disused. They can be difficult to detect with locators even when “live”.
28. Using hand held power tools to break up hard surfaces often leads to accidents. Where practicable, such power tools should only be used 500mm or more away from the indicated line of a cable buried in or below a hard surface. Having done so, the cable should then be positively located by careful hand digging under the hard surface. The hard surface should be gradually removed until the cable is exposed. If the cable is not exposed then it must be assumed to be embedded within the surface. Where possible a cable locator should be used as a depth guide down the side of the excavation.
29. Because of the difficulty in confirming depth, hand held power tools should never be used over the cable unless either:
  - the cable has already been exposed by digging under the surface to be broken out and it is at a safe depth (at least 300mm) below the bottom of the hard surface material; or
  - physical precautions have been taken to prevent the tool striking the cable.
30. Excavating close to electricity cables buried in concrete is dangerous and should not be undertaken unless the cable(s) have been isolated. For this reason alone electricity cables should not be buried in concrete.
31. Using mechanical means to break up concrete can cause damage to cables and if the cable is live, anyone present is likely to be injured.
32. Where mechanical excavators are used in the possible vicinity of underground cables, the work should be arranged so that damage to cables is avoided so far as is reasonably practicable and so that everyone is kept well clear of the excavator bucket while it is digging. Drivers should have been instructed to stay in the cab if a cable is struck. If they have to leave the cab, they should jump clear. If drivers climb down, they may be electrocuted. When a cable is struck, a watch should be kept on the machine and no one should go down into the excavation or approach the mechanical excavator or the cable until GTC are contacted and arranged for the damaged cable to be made safe.
33. Where cables have been exposed:
  - any damage should be reported to GTC immediately on **0800 032 6990** and work should not be undertaken in the vicinity of a damaged cable until GTC has investigated its condition;
  - for more than 1.0m and they cross a trench, support should be provided. If the exposed cable length is shorter than 1.0m support should still be considered if joints have been exposed or the cable appears otherwise vulnerable to damage. Where advice and help is needed contact GTC;

- Suitable precautions should be taken to prevent damage from on-going work in the excavation. This may involve for example the use of physical means (e.g. timber boards, sandbags etc) to prevent mechanical damage. Materials or equipment which could damage or penetrate the outer sheath of the cable should not be used. Cables lying in the bottom of an excavation are particularly vulnerable and should be protected by nail free wooden planks, troughing or other suitable means;
  - cables should not be moved aside unless the operation is supervised by GTC;
  - Precautions should be taken to prevent access by members of the public.
34. GTC should be consulted if it is intended to carry out any of the following activities:
- using explosives within 30m of plant or substations piling or boring within 15m of electric plant
  - excavating within 10m of a substation
  - carrying out nearby deep excavations
  - working near our HV plant.

### **Precautions for Water Networks**

35. Plans do not always show the presence of water service pipes (from the water main to premises) but their existence should be assumed.
36. The depth of cover for water mains is normally 750mm in carriageways and grass verges and 750mm footways. The depth of cover for water services is normally 450mm. Remember these covers are to finished level, you may be working in an area, which will be made up or lowered at a later date.
37. Water mains should be located by hand digging before mechanical excavation begins. When the positions and depth of the pipes have been determined, work can proceed.
38. The danger created by damaging a water pipe with an excavator is much greater than if the damage is done with a hand-held power tool (the opposite is true for work near electricity cables and this is reflected in the different safe digging practices). Water pipes may have projections such as valve housings, which are not shown on the plans and to allow for this mechanical excavators should not be used within 500mm of a water pipe.
39. If a water leak is suspected, the following action should be taken immediately:
- Remove all people from the immediate vicinity of the damage. It is important to note that a mechanical excavator may not only cause damage/leakage at the point of impact. For example, damage to a service connection outside the building may result in further, unseen damage to the connection inside the building.
  - Shut down all working plant and machinery in the vicinity of the damage

- Inform IWNL by dialling **02920 028 711**.
  - Remain on site.
  - Do not attempt to make a repair.
  - Assist GTC, approved contractors and Police or Fire Services as requested.
40. Where water pipes cross or are parallel and close to excavations, changes in backfill etc. may cause differential ground settlement and increased stress in the pipe. For pipes parallel and close to excavations, the degree of risk depends upon the depth of the excavation, the distance of the pipe from the excavation, the type of soil and any excessive loading from heavy construction plant and materials. Wherever excavation works may affect the support of the water pipe or cause excessive loading over the water pipe then GTC must be consulted.
41. No concrete or other hard material should be placed or left under or adjacent to any water pipe as this can cause pipe fracture at a later date. Concrete backfill should not be used within 300mm of a water pipe.
42. Where an excavation uncovers a water pipe with a damaged wrapping, GTC should be told, so that repairs can be made to prevent future corrosions and leakage.
43. Pipe restraints or thrust blocks close to water mains should never be removed.
44. Anyone who carries out work near underground water plant should observe any specific requirements made by the site manager, and ensure that access to the plant by GTC staff is available at all times. No unauthorised repairs to water pipes should be made.
45. Where PE pipes and cables have been exposed and it is intended hot work (e.g. welding, grinding, etc) be carried out, contact must be made with GTC to confirm additional precautions and actions that may require to be undertaken.
46. GTC should be consulted if it is intended to carry out any of the following activities:
- using explosives within 30m of plant
  - piling or boring within 15m of water plant
  - excavating within 10m of water asset structures
  - reducing the cover or protection of a water main or service
  - carrying out nearby deep excavations

### **Precautions for Fibre Networks**


47. Plans may not always show the presence of fibre ducts but their existence should be assumed if GTC advise they have fibre services deployed in the given area. Any planned excavation work should only proceed with due care and attention.
48. Chambers with IFNL marked lids can be used as an onsite indicator that GTC have fibre plant deployed in a given area however an exclusion of their presence does not necessarily mean there is no plant present.

49. In most cases there will be no permanent surface marker posts or other visible indication of the presence of a buried fibre duct. Even if no ducts are shown on plans there may still be ducts present which could have live fibre service installed. A close watch should be kept for any signs which could indicate duct presence such as marker tape. Any marker which is disturbed by our excavations must be replaced once work is completed.
50. The depth of cover for fibre duct is normally 350mm in footways and grass verges, 600mm in carriageways and 1000mm in agricultural deployments. Remember these covers are to finished level, you may be working in an area, which will be made up or lowered at a later date.
51. Fibre ducts should be located by hand digging before mechanical excavation begins. When the positions and depth of the ducts have been determined, work can proceed. Even then, digging should still proceed with care as there may be other ducts adjacent or lower down.
52. If fibre duct damage is suspected, the following action should be taken immediately:
  - Remove all people from the immediate vicinity of the damage. It is important to note that a mechanical excavator may not only cause damage at the point of impact. For example, damage to a fibre connection outside the building may result in further, unseen damage to the connection inside the building.
  - Shut down all working plant and machinery in the vicinity of the damage
  - Inform IFNL NOC immediately on **0845 051 1669**.
  - Remain on site.
  - Do not attempt to make a repair.
53. Where fibre ducts cross or are parallel and close to excavations, changes in backfill etc. may cause differential ground settlement and increased stress on the duct. For ducts parallel and close to excavations, the degree of risk depends upon the depth of the excavation, the distance of the duct from the excavation, the type of soil and any excessive loading from heavy construction plant and materials. Wherever excavation works may affect the support of the fibre duct or cause excessive loading over the fibre duct then GTC must be consulted.
54. No concrete or other hard material should be placed or left under or adjacent to any fibre duct as this can cause damage to the duct at a later date. Any backfill should comply with the requirements of NRSWA. Concrete backfill should not be used within 300mm of a fibre duct.
55. Anyone who carries out work near underground fibre plant should observe any specific requirements made by the site manager, and ensure that access to the plant by GTC staff is available at all times. No unauthorised repairs to fibre ducts should be made.
56. Where fibre ducts have been exposed and it is intended hot work (e.g. welding, grinding, etc) be carried out, contact must be made with GTC to confirm additional precautions and actions that may require to be undertaken.

57. GTC should be consulted if it is intended to carry out any of the following activities:

- using explosives within 30m of plant or fibre asset structures
- piling or boring within 15m of fibre plant
- excavating within 10m of fibre asset structures (including the OSCP)
- reducing the cover or protection of a fibre duct
- carrying out nearby deep excavations



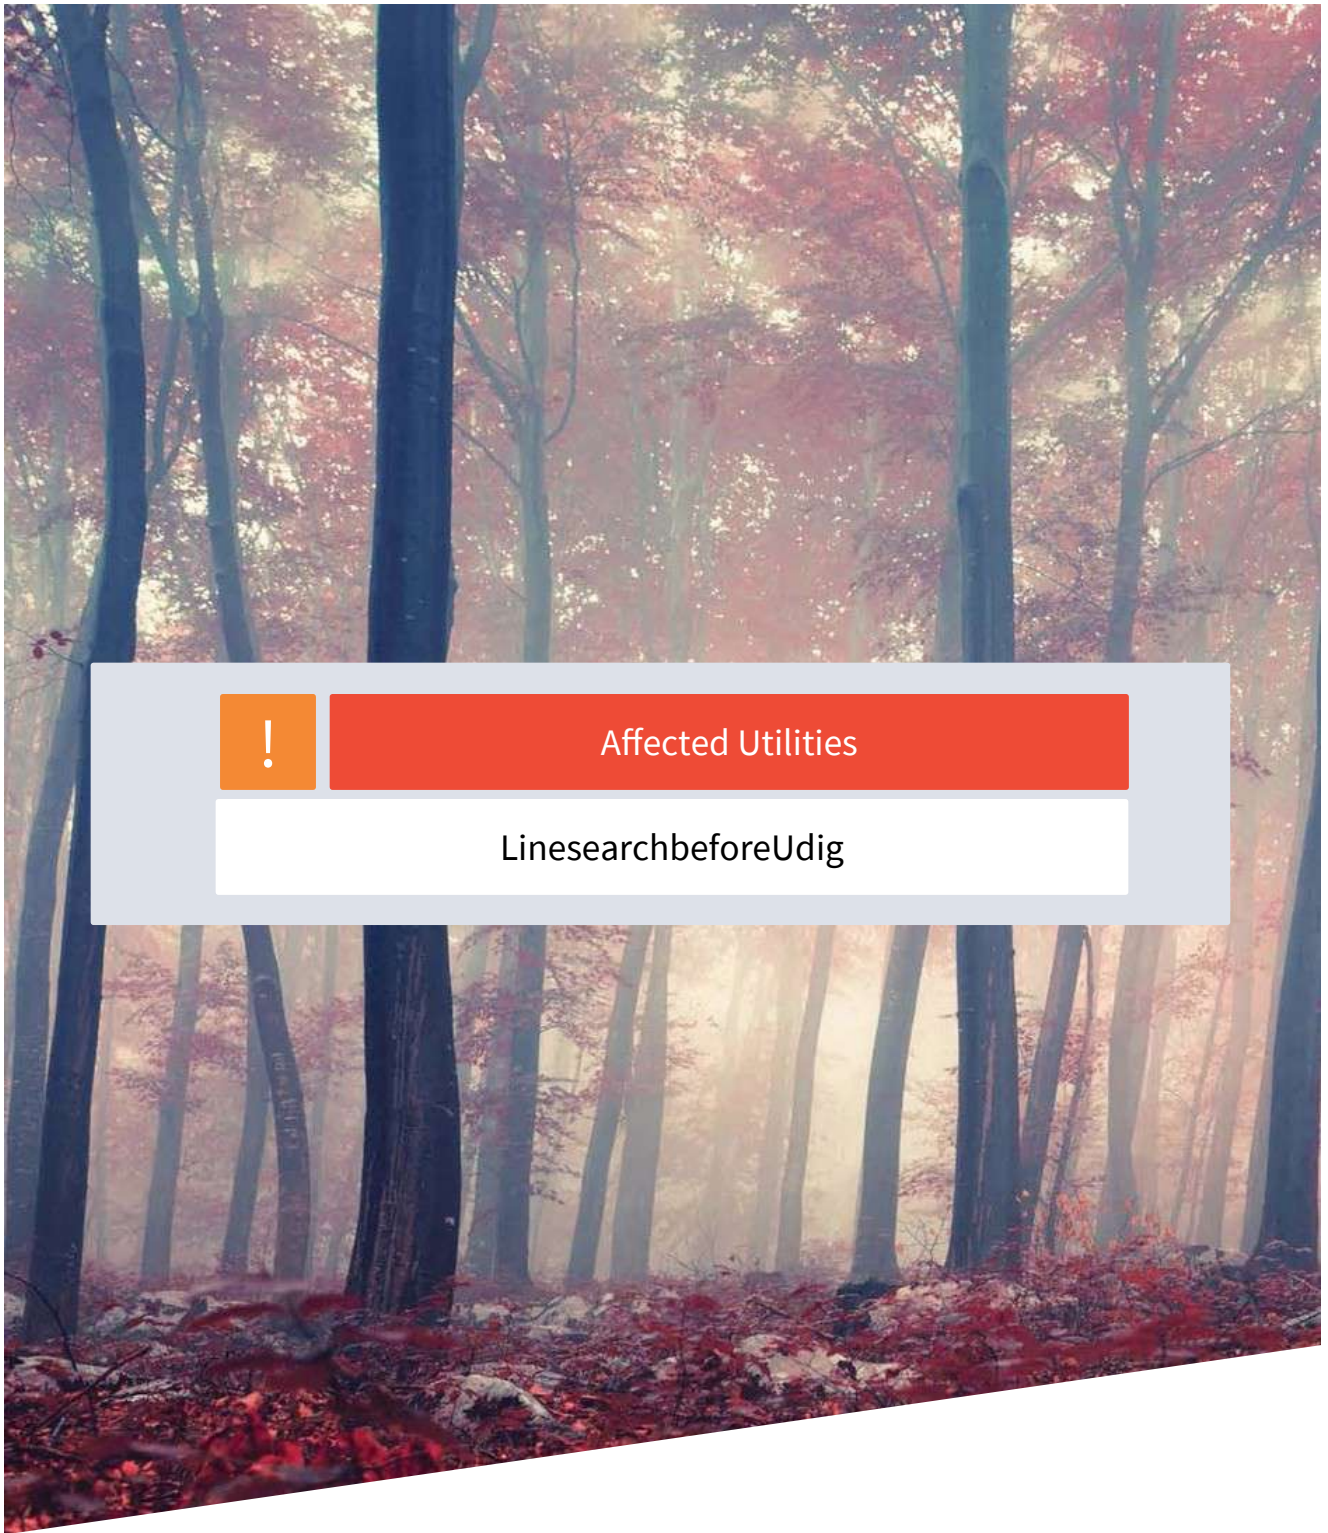

Affected Utilities

LineSearchbeforeUdig




**Enquirer**

Name	Ms Christina Elliott	Phone	01454 662397
Company	Atkins	Mobile	Not Supplied
Address	500 Park Avenue Aztec West Almondsbury Bristol BS32 4RZ		
Email	stat.enquiries@atkinsglobal.com		

**Enquiry Details**

Scheme/Reference	LM 94066/BRK		
Enquiry type	Initial Enquiry	Work category	Utility Works
Start date	06/04/2021	Work type	Single excavation site
End date	06/07/2021	Site size	42620 metres square
Searched location	XY= 314000, 195650	Work type buffer*	25 metres
Confirmed location	313973 195662		
Site Contact Name	Not Supplied	Site Phone No	Not Supplied
Description of Works			

\* The WORK TYPE BUFFER is a distance added to your search area based on the Work type you have chosen.

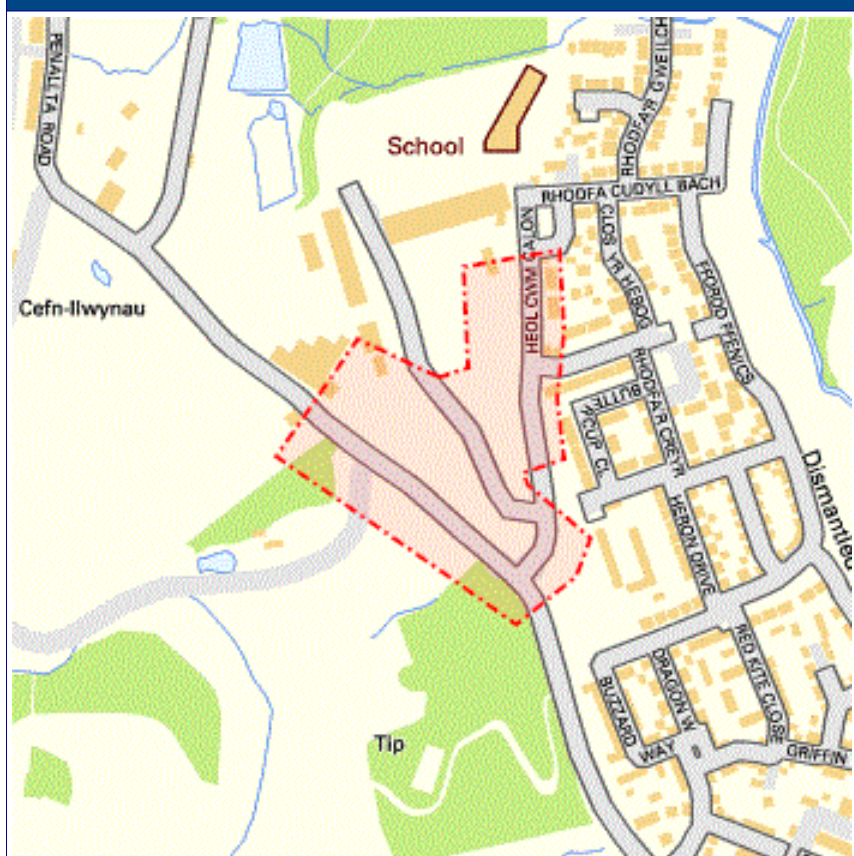**Site Map**


**LSBUD Members who have assets registered on the LSBUD service within the vicinity of your search area.**

### List of affected LSBUD members


Asset Owner	Phone/Email	Emergency Only	Status
Wales and West Utilities	02920278912	0800111999	Await response
Western Power Distribution	08000963080	08006783105	Await response

**LSBUD Members who do not have assets registered on the LSBUD service within the vicinity of your search area. Please be aware that LSBUD Members make regular changes to their assets and this list may vary for new enquiries in the same area.**

### List of not affected LSBUD members

AWE Pipeline	Balfour Beatty Investments Limited	BOC Limited (A Member of the Linde Group)
Box Broadband	BP Exploration Operating Company Limited	BPA
Carrington Gas Pipeline	CATS Pipeline c/o Wood Group PSN	Cemex
Centrica Storage Ltd	Chrysaor Production (UK) Limited	CLH Pipeline System Ltd
CNG Services Ltd	Concept Solutions People Ltd	ConocoPhillips (UK) Teesside Operator Ltd
Diamond Transmission Corporation	DIO (MOD Abandoned Pipelines)	DIO (MOD Live Pipelines)
E.ON UK CHP Limited	EirGrid	Electricity North West Limited
ENI & Himor c/o Penspen Ltd	EnQuest NNS Limited	EP Langage Limited
ESP Utilities Group	ESSAR	Esso Petroleum Company Limited
Fulcrum Pipelines Limited	Gamma	Gas Networks Ireland (UK)
Gateshead Energy Company	Gigaclear Ltd	Gtt
Heathrow Airport LTD	Humbly Grove Energy	IGas Energy
INEOS FPS Pipelines	INEOS Manufacturing (Scotland and TSEP)	INOVYN ChlorVinyls Limited
INOVYN Enterprises Limited	Intergen (Coryton Energy or Spalding Energy)	Jurassic Fibre Ltd
Mainline Pipelines Limited	Manchester Jetline Limited	Manx Cable Company
Marchwood Power Ltd (Gas Pipeline)	Melbourn Solar Limited	Murphy Utility Assets
National Grid Gas (Above 7 bar), National Grid Gas Distribution Limited (Above 2 bar) and National Grid Electricity Transmission	Northumbrian Water Group	NPower CHP Pipelines
NYNet Ltd	Oikos Storage Limited	Ørsted
Perenco UK Limited (Purbeck Southampton Pipeline)	Petroineos	Phillips 66
Portsmouth Water	Premier Transmission Ltd (SNIP)	Redundant Pipelines - LPDA
RWE - Great Yarmouth Pipeline (Bacton to Great Yarmouth Power Station)	RWEpower (Little Barford and South Haven)	SABIC UK Petrochemicals
Scottish and Southern Electricity Networks	Scottish Power Generation	Seabank Power Ltd
SES Water	SGN	Shell
Shell NOP	SSE Enterprise Telecoms	SSE Generation Ltd
SSE Utility Solutions Limited	Tata Communications (c/o JSM Construction Ltd)	Total (Colnbrook & Colwick Pipelines)
Total Finaline Pipelines	Transmission Capital	UK Power Networks

Uniper UK Ltd	University of Cambridge Granta Backbone Network	Vattenfall
Veolia ES SELCHP Limited	Veolia ES Sheffield Ltd	VPI Power Limited
West of Duddon Sands Transmission Ltd	Westminster City Council	Zayo Group UK Ltd c/o JSM Group Ltd

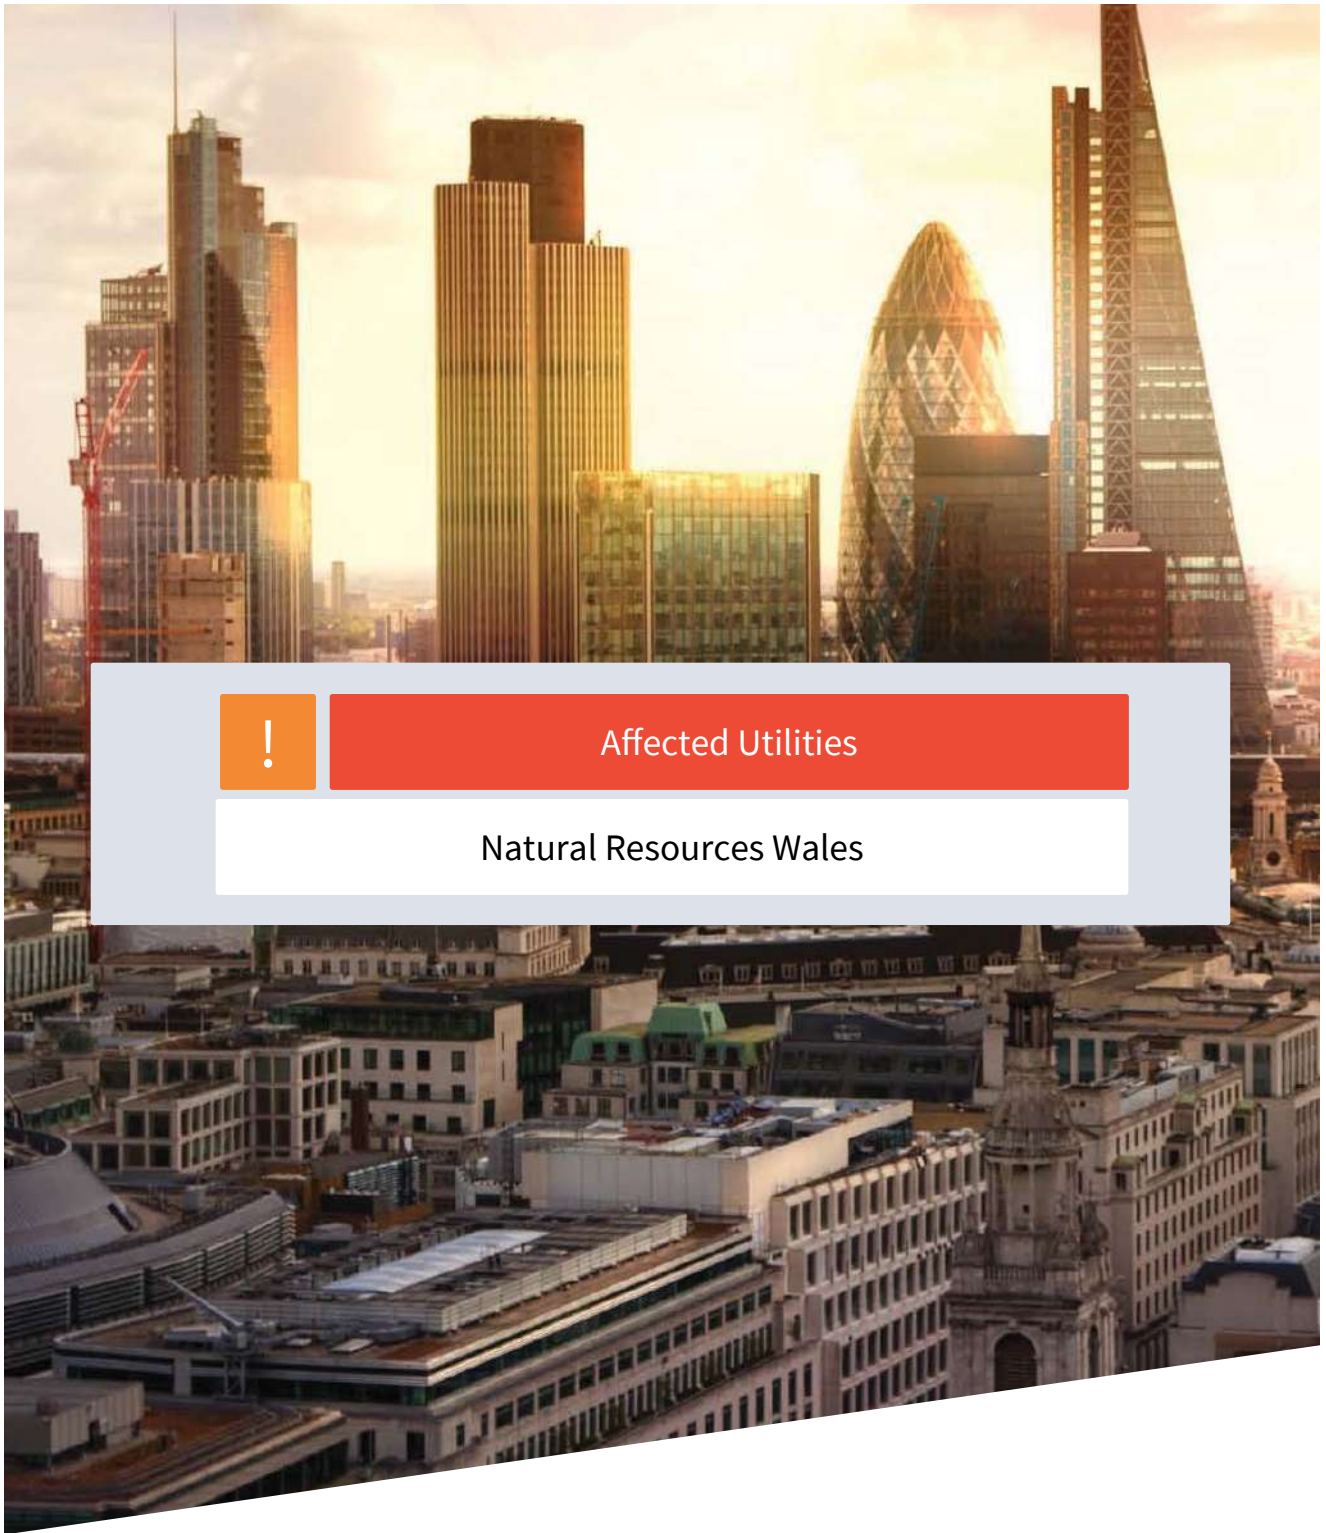

Affected Utilities

Natural Resources Wales



To: [atkinsstatutory.enquiries@atkinsglobal.com](mailto:atkinsstatutory.enquiries@atkinsglobal.com)

Dear Sir / Madam,

The process by which Natural Resources Wales responds to plant / asset enquiries has changed since August 2016.

We no longer carry out any checks on the sites in question, either on our mapping system or with internal teams. We ask that in the first instance organisations make their own checks via various links. These are as follows:

If you want to carry out works in, over, under or near a main river or flood defence (including a sea defence), or within a flood plain you will need to apply for Flood Risk Activity Permit. (This was previously called a Flood Defence Consent.) For further advice please visit our website <http://naturalresources.wales/apply-for-a-permit/flood-risk-activities/?lang=en>  
Contact details for the relevant office are also included within the application forms.

For locations of main rivers, flood defences and flood plains, you can view our Risk of Flooding maps online at this link <https://naturalresources.wales/our-evidence-and-reports/maps/flood-risk-map/?lang=en>

You can download GIS data on the locations of designated sites from the Lle web portal <http://lle.wales.gov.uk/catalogue?lang=en>

Further information about these sites can also be found on our website <http://naturalresources.wales/conservation-biodiversity-and-wildlife/find-protected-areas-of-land-and-seas/designated-sites-search/?lang=en>

Please note - although Natural Resources Wales is classed as a statutory undertaker, we do not generally have plant equipment or pipelines situated in the public highway.

To confirm: **Natural Resources Wales has not conducted a specific search of our records.** After checking the above links, if you have reason to think that your proposal will affect land or equipment which we own, please submit your enquiry to [datadistribution@naturalresourceswales.gov.uk](mailto:datadistribution@naturalresourceswales.gov.uk) with details of the specific areas affected.

Yours sincerely

Tîm Cysylltiadau Allanol / **External Relations Team**  
Cyfoeth Naturiol Cymru / **Natural Resources Wales**

## Standard Notice

(not for use with Special Data, Personal Data or unlicensed 3<sup>rd</sup> party rights)

### **Information warning**

We (Natural Resources Wales) do not promise that the Information supplied to You will always be accurate, free from viruses and other malicious or damaging code (if electronic), complete or up to date or that the Information will provide any particular facilities or functions or be suitable for any particular purpose. You must ensure that the Information meets your needs and are entirely responsible for the consequences of using the Information. Please also note any specific information warning or guidance supplied to you.

### **Permitted use**

- The Information is protected by intellectual property rights and whilst you have certain statutory rights which include the right to read the Information, you are granted no additional use rights whatsoever unless you agree to the licence set out below.
- Commercial use of anything except EA OpenData is subject to payment of a £50 licence fee (+VAT) for each person seeking the benefit of the licence, except for use as an Natural Resources Wales contractor or for approved media use.
- To activate this licence you do not need to contact us (unless you need to pay us a Commercial licence fee) but if you make any use in excess of your statutory rights you are deemed to accept the terms below.

### **Licence**

We grant you a worldwide, royalty-free (apart from the £50 licence fee for commercial use), perpetual, non-exclusive licence to use the Information subject to the conditions below.

### **You are free to:**



copy, publish, distribute and transmit the Information



adapt the Information



exploit the Information commercially, for example, by combining it with other Information, or by including it in your own product or application

### **You must (where you do any of the above):**



acknowledge the source of the Information by including the following attribution statement:

*"Contains Natural Resources Wales information © Natural Resources Wales and database right"* ensure that you do not use the Information in a way that suggests any official status or



that We endorse you or your use of the Information



ensure that you do not mislead others or misrepresent the Information or its source or use the Information in a way that is detrimental to the environment, including the risk of reduced future enhancement



ensure that your use of the Information does not breach the Data Protection Act 1998 or the Privacy and Electronic Communications (EC Directive) Regulations 2003

These are important conditions and if you fail to comply with them the rights granted to you under this licence, or any similar licence granted by us will end automatically.

### **No warranty**

The Information is licensed 'as is' and We exclude all representations, warranties, obligations and liabilities in relation to the Information to the maximum extent permitted by law. We are not liable for any errors or omissions in the Information and shall not be liable for any loss, injury or damage of any kind caused by its use. We do not guarantee the continued supply of the Information.

### **Governing Law**


This licence is governed by the laws of England and Wales.

### **Definitions**

"Information" means the information that is protected by copyright or by database right (for example, literary and artistic works, content, data and source code) offered for use under the terms of this licence.

"Commercial" means:

- f* offering a product or service containing the Information, or any adaptation of it, for a charge, or
- f* internal use for any purpose, or offering a product or service based on the Information for indirect commercial advantage, by an organisation that is primarily engaged in trade, commerce or a profession.

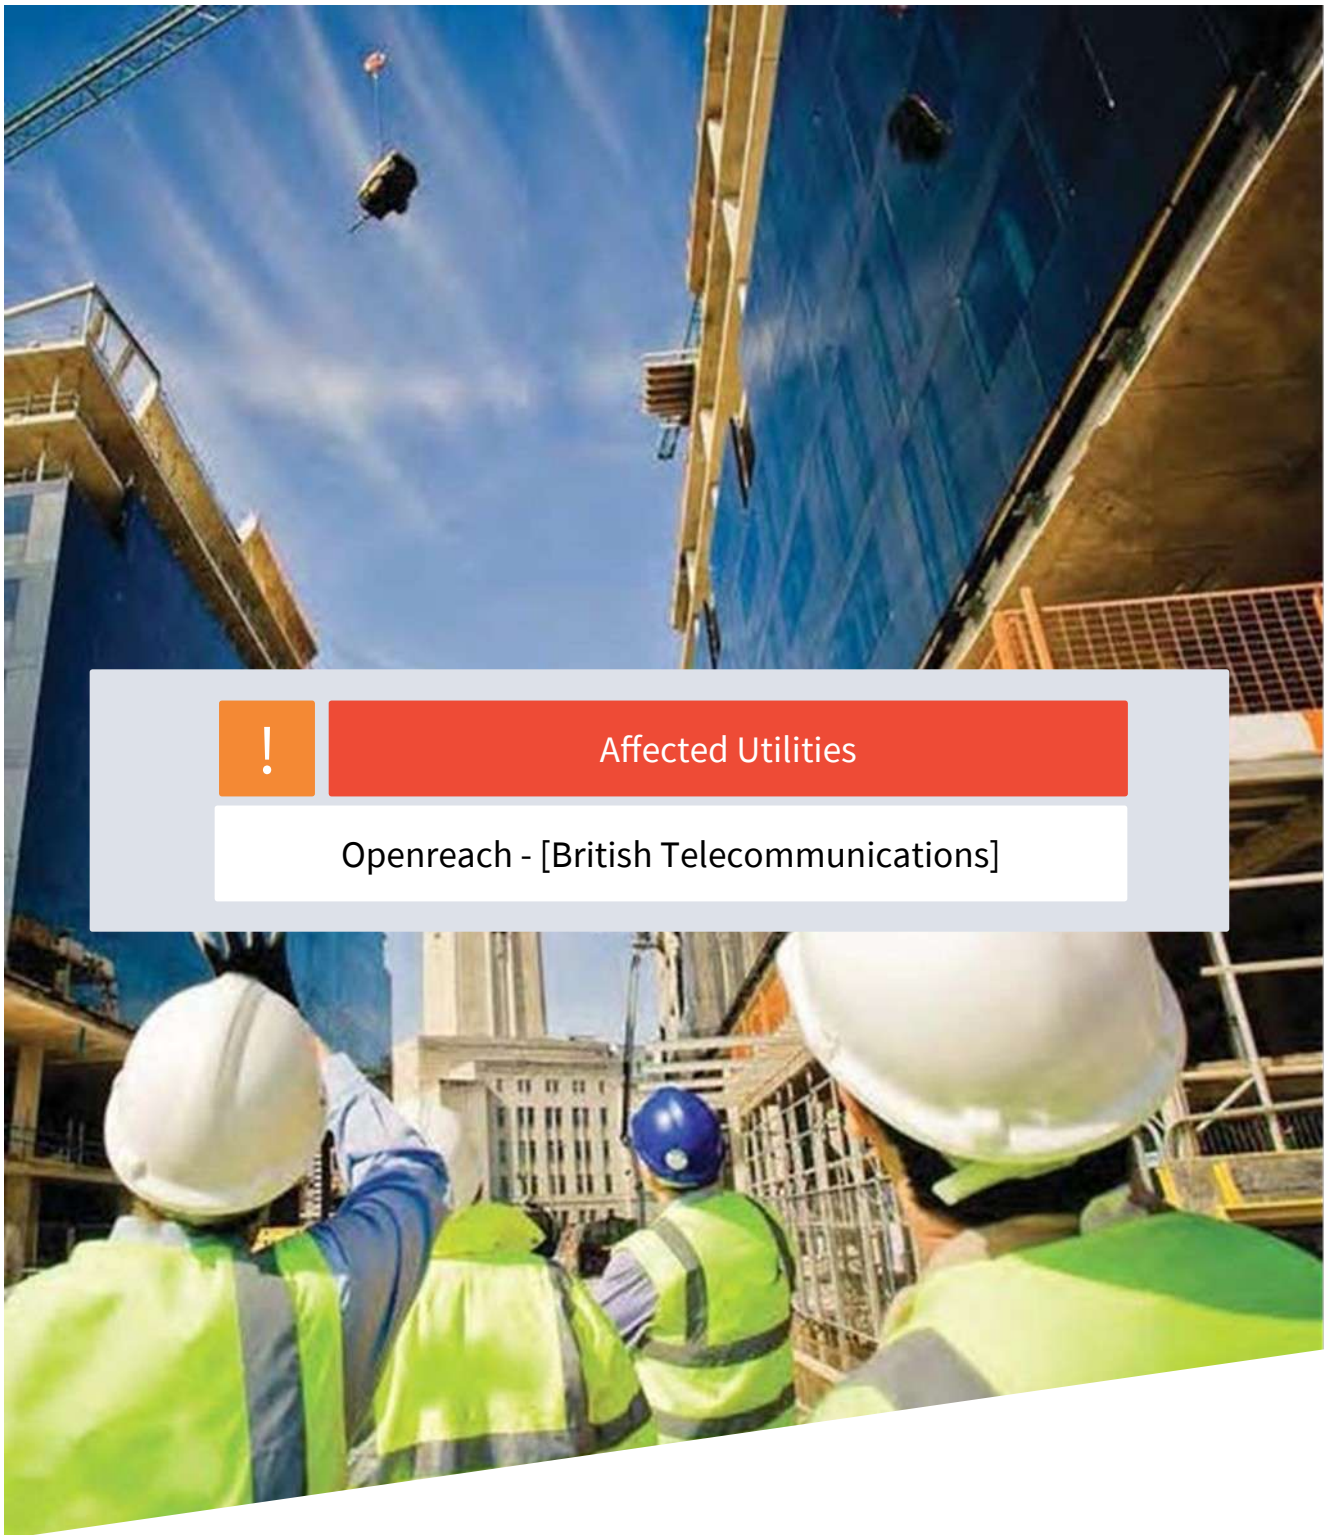

Affected Utilities

Openreach - [British Telecommunications]



openreach

Our Ref: Ref shown on map

Date of issue: shown on map

email: [nnhc@openreach.co.uk](mailto:nnhc@openreach.co.uk)

Dear Customer,

**NR & SW ACT 1991 – PROPOSED WORKS AT: \*\*SITE LOCATION\*\***

Prior to commencement of work: For free onsite guidance and accurate up to date location of BT Apparatus please contact our Plant Protection Service by the following methods:-

Email the Click Before You Dig Team [CBYD@openreach.co.uk](mailto:CBYD@openreach.co.uk)

Visit the Click Before You Dig Website [www.openreach.co.uk/cbyd](http://www.openreach.co.uk/cbyd)

Thank you for your request of \*\*/\*\*/\*\* describing the above proposals.

Enclosed are copies of our drawings marked up to show the approximate locations of BT apparatus in the immediate vicinity of your works. It is intended for general guidance only. No guarantee is given of its accuracy.

The drawings are valid for 90 days from the date of issue and should not be relied upon after this time period has expired.

When planning excavation work or other works near to BT apparatus, please be mindful our apparatus may exist at various depths and may deviate from the marked route.

To avoid damage it is recommended that mechanical excavators or borers are not used within 600mm of BT apparatus. If scaffolding is erected, please ensure that our equipment is not enclosed, blocked, covered or otherwise obstructed by the scaffolding.


In the event of BT apparatus being in the area of your works we recommend that your plant/vehicle crossing is either resited, or apply for a budget estimate by submitting detailed plans to our Network Relocation Team at <https://www.ournetwork.openreach.co.uk/altering-our-network.aspx>

Yours faithfully,

**Julie Cullum**  
**NNHC & MBE Manager**



# Maps by email Plant Information Reply

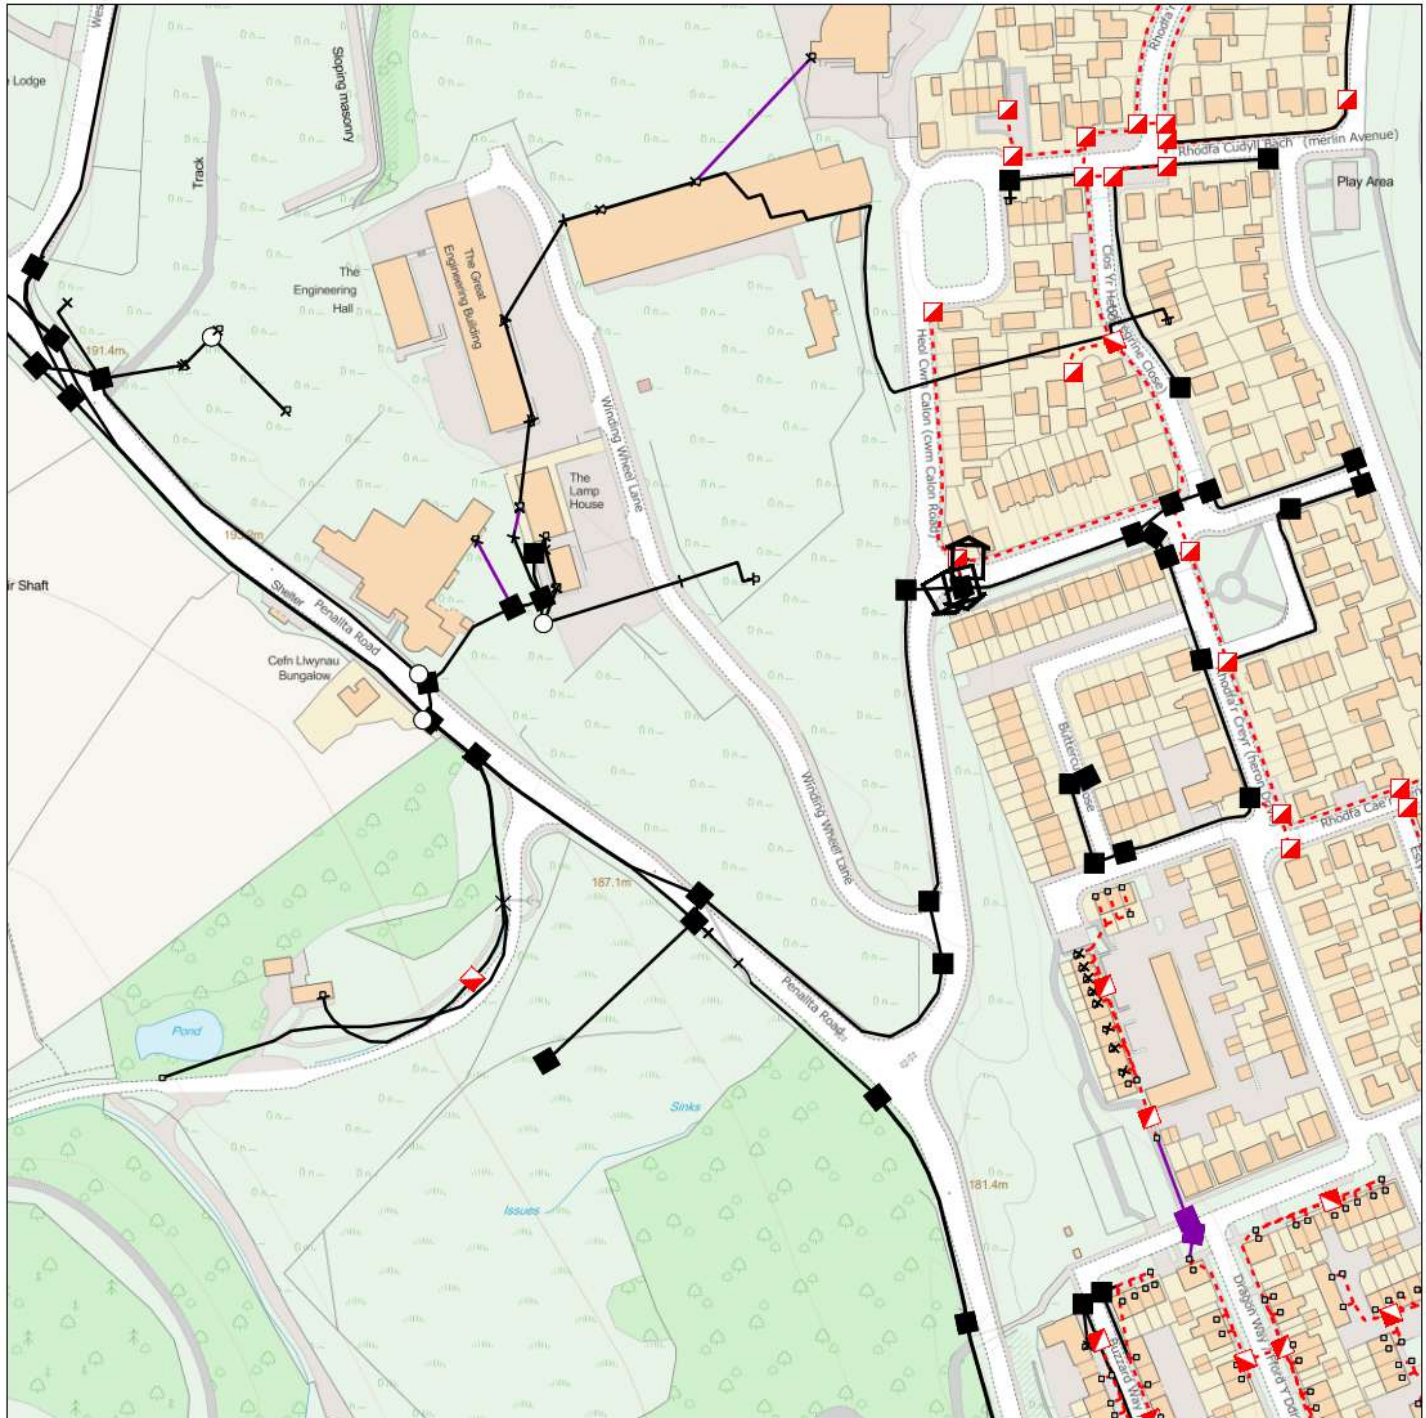

## IMPORTANT WARNING

Information regarding the location of BT apparatus is given for your assistance and is intended for general guidance only. No guarantee is given of its accuracy. It should not be relied upon in the event of excavations or other works being made near to BT apparatus which may exist at various depths and may deviate from the marked route.



**openreach**

### CLICK BEFORE YOU DIG

FOR PROFESSIONAL FREE ON SITE ASSISTANCE PRIOR TO COMMENCEMENT OF EXCAVATION WORKS INCLUDING LOCATE AND MARKING SERVICE

email [cbyd@openreach.co.uk](mailto:cbyd@openreach.co.uk)

ADVANCE NOTICE REQUIRED  
(Office hours: Monday - Friday 08.00 to 17.00)  
[www.openreach.co.uk/cbyd](http://www.openreach.co.uk/cbyd)

### Accidents happen

If you do damage any Openreach equipment please let us know by calling 0800 023 2023 (opt 1 + opt 1) and we can get it fixed ASAP

## KEY TO BT SYMBOLS

	Planned	Live	Change Of State	+	Hatchings	
PCP			Split Coupling		Built	
Pole			Duct Tee		Planned	
Box			Building		Inferred	
Manhole			Kiosk		Duct	
Cabinet			Other proposed plant is shown using dashed lines. BT Symbols not listed above may be disregarded. Existing BT Plant may not be recorded. Information valid at time of preparation. Maps are only valid for 90 days after the date of publication.			
	Pending Add	In Place	Pending Remove	Not In Use		
Power Cable						
Power Duct				N/A		

BT Ref : ECC083590

Map Reference : (centre) ST1398695663


Easting/Northing : (centre) 313986,195663

Issued : 18/03/2021 20:35:19

**WARNING: IF PLANNED WORKS FALL INSIDE HATCHED AREA IT IS ESSENTIAL BEFORE PROCEEDING THAT YOU CONTACT THE NATIONAL NOTICE HANDLING CENTRE. PLEASE SEND E-MAIL TO: [nnhc@openreach.co.uk](mailto:nnhc@openreach.co.uk)**

Reproduced from the Ordnance Survey map by BT by permission of Ordnance Survey on behalf of the Controller of Her Majesty's Stationary Office  
(C) Crown Copyright British Telecommunications plc 100028040



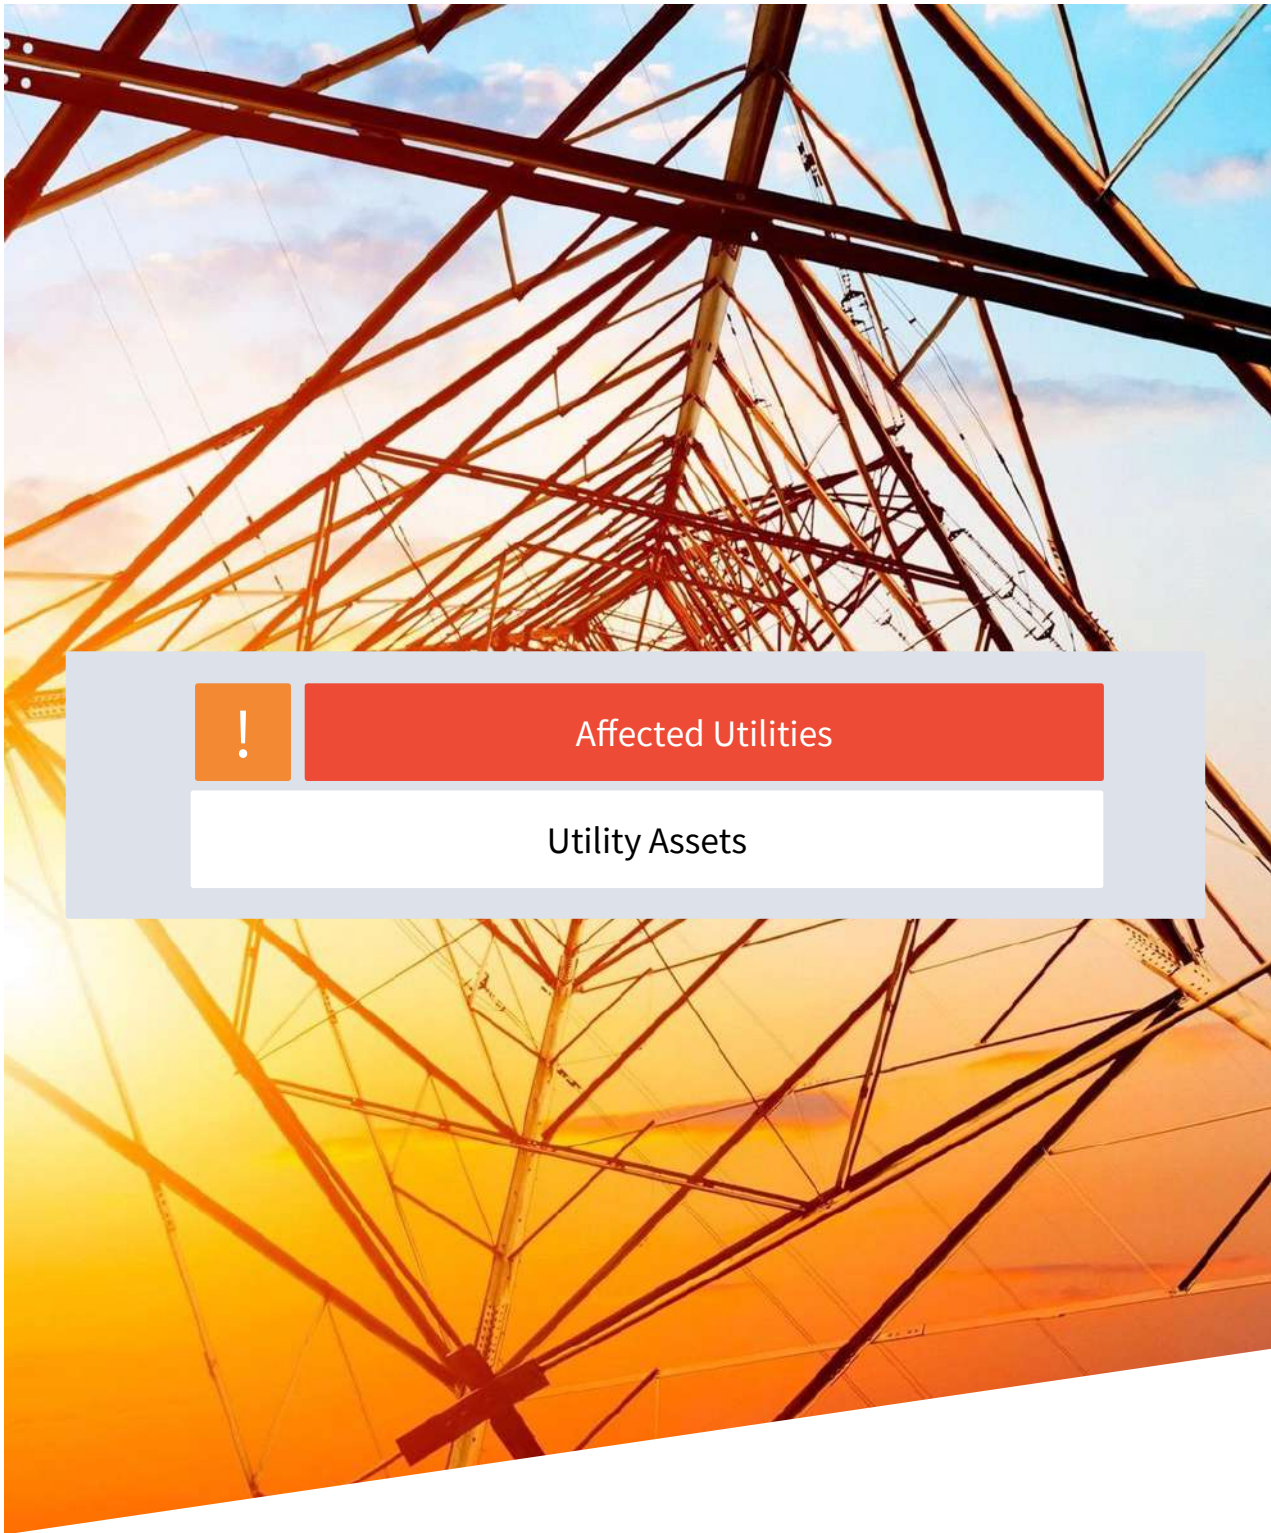

Affected Utilities

Utility Assets

## ADVISORY NOTICE

### SUPPLIER UPDATE: Utility Assets

On 17/03/2021, an enquiry was sent to Utility Assets' plant record department. As of the date of issue of this Utilities Report, we have not received a formal response from Utility Assets in regards to owning any equipment on this site. Utility Assets have however advised the following:

*"Thank you for recently contacting Utility Assets plant record department. We will check whether we have any plant present at your site and contact you within 5 - 7 working days ONLY if we own any plant in the vicinity.*

*If we do not reply, we do not have any apparatus in the area of your works. However, PLEASE TAKE CARE when excavating around electricity cables in the event that not all cables present may be accurately shown. We recommend you use detecting equipment to map the site before excavating and fully comply with HSG47. DO NOT assume that a cable is dead if you don't have a record of its presence. The cable must be treated as live unless PROVEN DEAD by the cable owner. In case of emergency please contact your local electricity distribution company.*

*This is an automated reply from our dedicated asset records email address. If you receive further correspondence from us it will be from [asset.manager@utilityassets.co.uk](mailto:asset.manager@utilityassets.co.uk) quoting a site reference number.*

*Asset Manager - Utility Assets Ltd"*

If a formal response is received within 3 months of the date of this search it will be forwarded onto you as per our usual service. However, without formal communication from Utility Assets it remains unconfirmed that your site will not be affected by their network. Utility Assets will not acknowledge receipt of this enquiry, or any subsequent queries, unless their network will be affected.


## Terms and Conditions

Full Terms and Conditions can be found on the following URL:  
<http://www.landmarkinfo.co.uk/Terms/Show/515>

Please note that Utilities Reports have a validity of 3 months from the date of purchase.

If you experience difficulties accessing our Terms and Conditions, please telephone our Customer Service Team on 0844 844 9966.



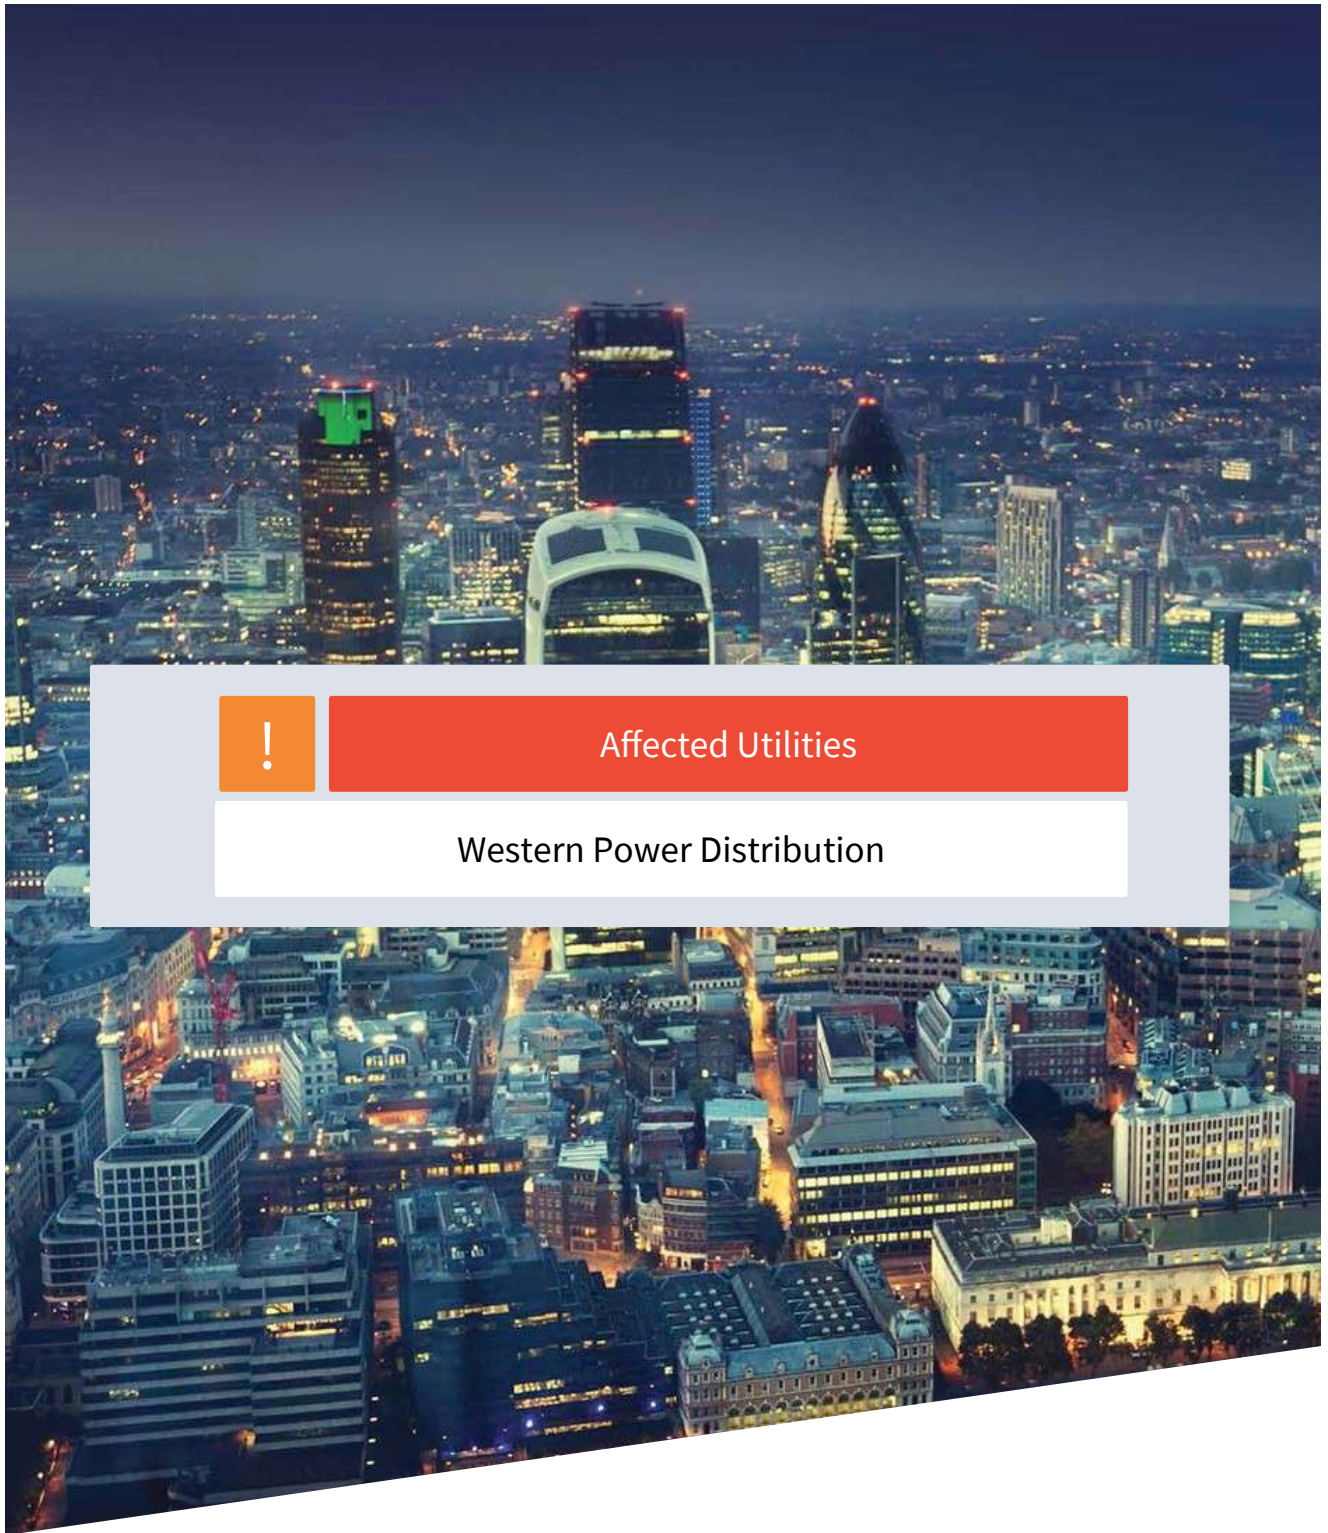

Our Ref: 21632395      Your Ref: LM 94066/BRK

Monday, 22 March 2021

Christina Elliott  
500 Park Avenue Aztec West  
Almondsbury  
Bristol  
BS32 4RZ

**CHECKED**

**Western Power Distribution,**  
Mapping Centre  
Toll End Road  
Tipton  
West Midlands  
United Kingdom  
DY4 0HH  
www.westernpower.co.uk

Dear Christina Elliott

Thank you for your enquiry dated Monday, 22 March 2021

I now enclose a copy of our plan showing existing Western Power Distribution (WPD) Electricity / WPD Surf Telecom apparatus in the vicinity of your proposed works. This information is given as a general guide only and its accuracy cannot be guaranteed. Please note that all WPD equipment on site should be assumed to be LIVE until WPD prove otherwise and provide you with confirmation to this effect in writing. Recent additions to our network, or service connections between the main cable and a building or street lamp may not be shown.

Map Response  
T 0121 623 9780  
WPDMapResponse  
@westernpower.co.uk

**LinesearchbeforeUdig**  
Help Desk 0845 437 7365

Damage to underground cables and contact with overhead lines can cause severe injury or may prove fatal. If you are excavating on site in the vicinity of either WPD Electrical apparatus or WPD Surf Telecom apparatus you must comply with the requirements of the following:-

Health & Safety Executive guidance HS(G)47, Avoiding Danger from underground services.

Work taking place in the vicinity of our plant is also regulated under the:-

Electricity at Work Regulations 1989, Health and Safety Act 1974, CDM Regulations 2015.  
Safe working procedures should be defined and practiced

Please ensure that the use of mechanical excavators in the vicinity of our plant is kept to a minimum. WPD Surf Telecom ducts contain fibre cables, which are expensive to repair. Therefore, extreme care must be taken whilst working in the vicinity of these ducts, hand digging methods being used to determine their precise position.

If there are overhead lines crossing your site and your proposal involves building works which may infringe the clearance to our overhead system then you should call the relevant general enquiries number (see page 2 of this letter) for advice. Where overhead lines cross your site you must comply with the requirements of Health & Safety Executive guidance as laid down in GS6, Avoidance of Danger from Overhead Electric Lines.

Western Power Distribution PLC  
South West - 02366894  
South Wales - 02366985  
East Midlands - 02366923  
West Midlands - 03600574

Where diversions to WPD apparatus are needed to allow change to occur on site, the cost of these alterations may be charged to the persons responsible for the works.

If you require advice in connection with your proposals please contact the relevant general enquiries number (see page 2 of this letter)

Registered in  
England and Wales

Following consultation the local Western Power Distribution team will where necessary prepare detailed proposals and provide a quotation for any necessary alterations and/or development of our equipment on the site.

Registered Office:  
Avonbank  
Feeder Road  
Bristol  
BS2 0TB

Yours sincerely  
WPD Map Response Team

## **Contact Us**

### **Emergency or Power Supply issues**

In an emergency call 105, 24 hours a day.

### **Mapping Enquiries**

If you have an enquiry relating to this letter or the attached map plan, please contact us using the following information:

Telephone        0121 623 9780  
Email             WPDMapResponse@westernpower.co.uk

### **General Enquiries**

If you have a general enquiry, please call us on the following telephone number:

All areas        0800 096 3080

### **LinesearchbeforeUdig**

If you have an enquiry relating to the use of the LinesearchbeforeUdig website please contact LinesearchbeforeUdig using the following information:

Telephone        0845 437 7365  
Email             enquiries@linesearchbeforeudig.co.uk  
Website          www.linesearchbeforeudig.co.uk



## Steps to help keep you safe


- **If you are working within 10 metres of our 33kV, 66kV, 132kV underground electricity cables or within 10 metres of an overhead electricity line you should call the relevant General Enquiries for free safety advice.**

**Safety Documents** – please download our informative safety documents to help ensure that you, your staff and the public are kept safe whilst working in the vicinity of electricity.

<https://www.westernpower.co.uk/customers-and-community/health-safety/public-safety-advice>

- **Make sure you have up to date plans** - remember that recent additions to our network or service connections between the main cable and a building or street lamp may not be shown.
- **Look for signs of service cables** - an electricity meter box or nearby streetlamp may give you an indication that service cables are present in your area of work.
- **Non WPD Network** - electricity cables, lines and equipment owned by others may also be present in addition to WPD network. They are unlikely to be shown on our plans.
- **Use a cable locator** - trace electricity cables and mark the position of them using paint or other waterproof marking on the ground.
- **Hand dig trial holes** - to confirm the position of cables in close proximity to your area of your work and use spades and shovels rather than picks, pins or forks.
- **Have an emergency plan** - so that everyone working on site understands what to do in the event of an underground electricity cable being damaged or contact being made with an overhead electricity line.
- **If you are working within 10 metres** of an overhead electricity line then it may be necessary for you to erect warning signs and markers, or height restriction goal posts. Ensure that you comply with the requirements of Health & Safety Executive guidance laid down in GS6, Avoidance of Danger from Overhead Electric Lines.
- **If you are erecting a structure** that could allow anyone standing on it, or its access device (ladder, scaffold, MEWP), to come within 3m of any overhead electric line then **you must inform us**. This is your duty and a legal requirement under the Electricity Safety, Quality & Continuity Regulations 2002.
- **If you cannot work safely** around the underground electricity cable or overhead electricity line, then you may need to get it moved to allow your works to go ahead. Call the general enquiry numbers above for guidance.
- **It is possible that cables or pipes may be embedded in concrete** - electricity cables embedded in concrete MUST be made 'dead' by Western Power Distribution or the cable owner before the concrete is broken out. Alternatively, another safe way of working should be agreed.

**Cables are sometimes covered by tiles or a marker tape** - these can be concrete, polythene or earthenware and are a useful early warning of the presence of cables; you should avoid disturbing any tiles or tape to expose the cable. Not all cables have these warning indicators.

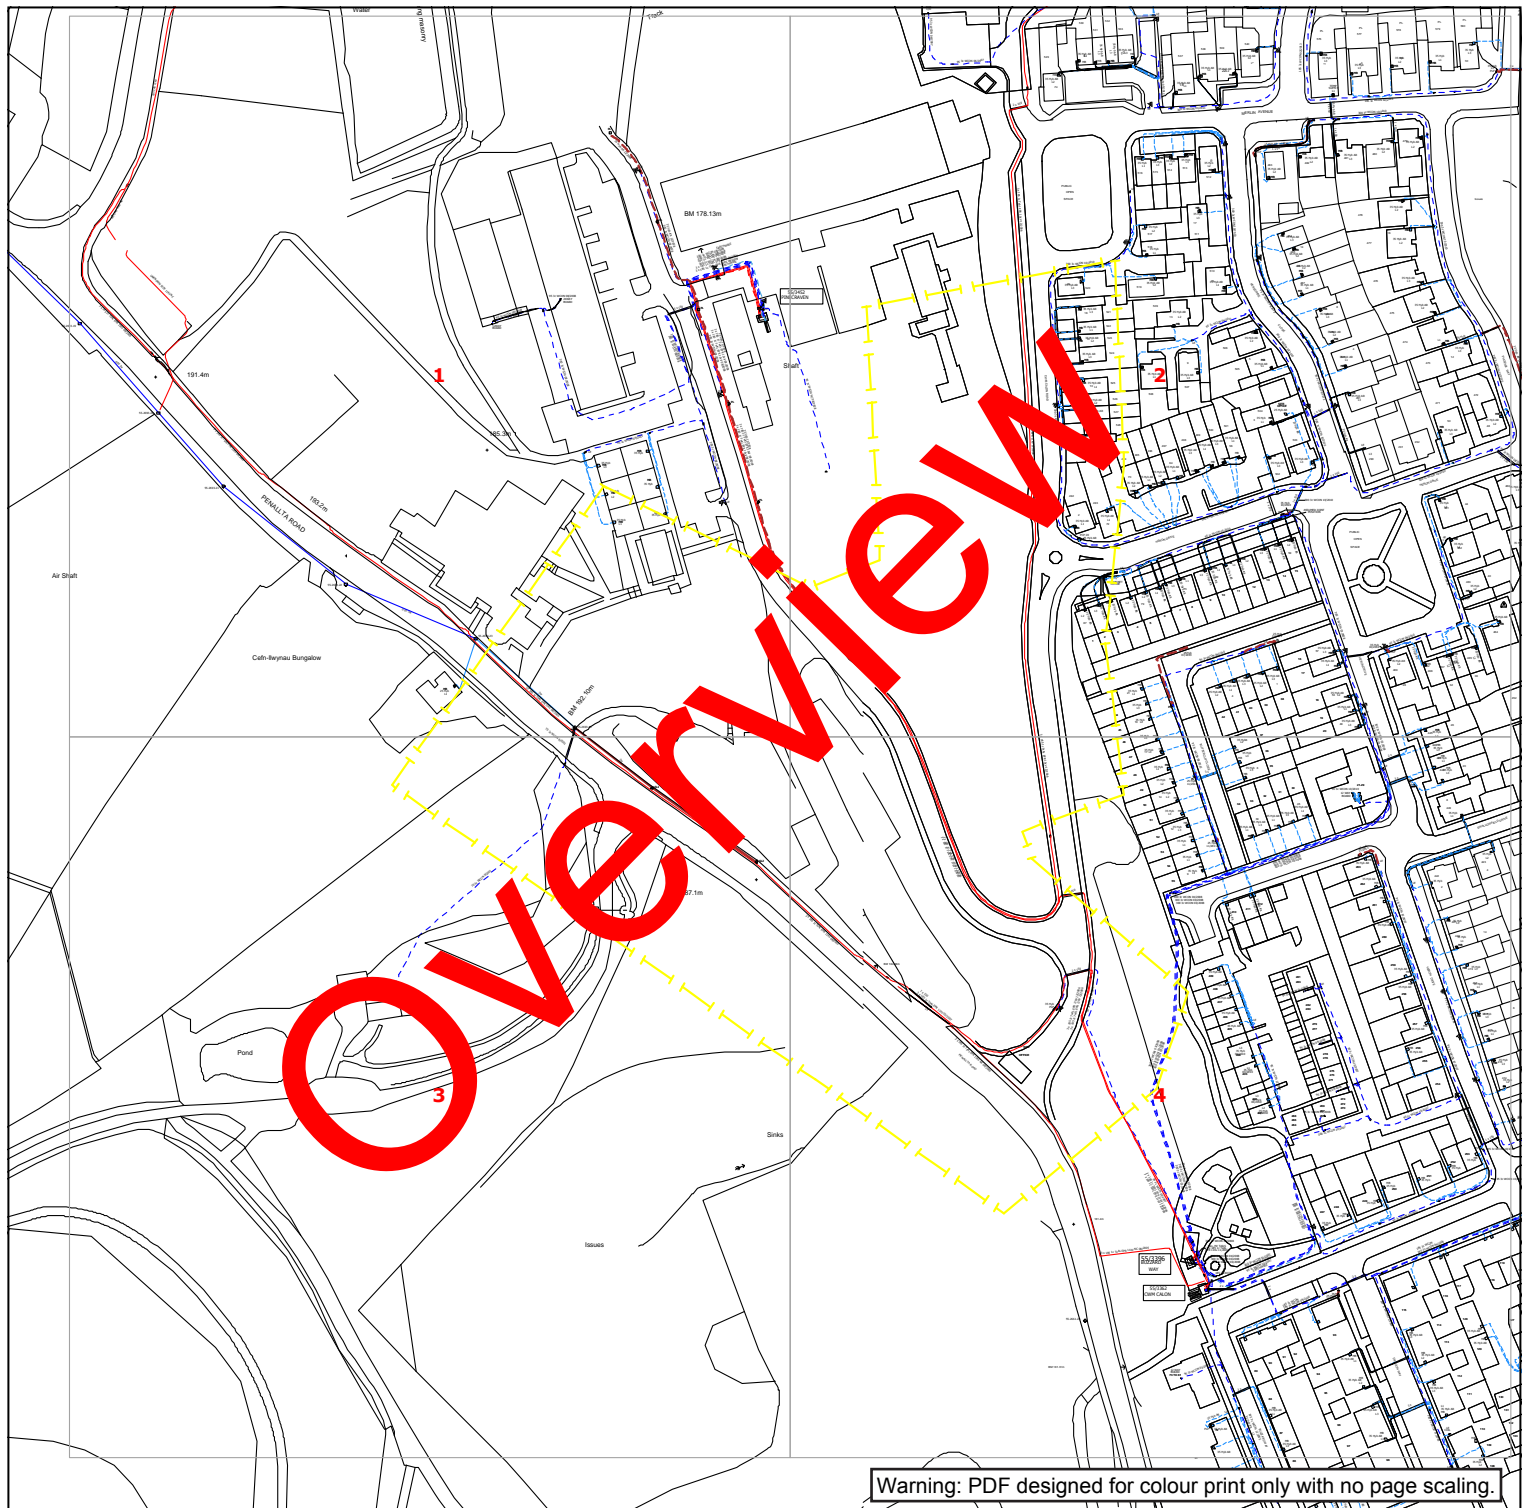

**WESTERN POWER DISTRIBUTION**  
Serving the Midlands, South West and Wales

**Contact Us**  
**Mapping Enquiries:**  
All areas 0121 623 9780  
**General Enquiries:**  
All areas 0800 096 3080

Date Requested: 22/03/2021  
Job Reference: 21632395  
Site Location: 313976 195654  
Requested by:  
Ms Christina Elliott  
Your Scheme/Reference:  
LM 94066/BRK

**Link Box**  
●  
**Site Location**  
**Line/Area**  
| |

**Overhead Line**  
○ PL  
○ Service  
○ LV (11kV)  
○ HV (11kV)  
○ HV (33kV)  
○ HV (66kV)  
⊠ HV (132kV)

**Underground Cable**  
— PL  
— Service  
— LV (11kV)  
— HV (11kV)  
— HV (33kV)  
— HV (66kV)  
— HV (132kV)

**SURF Telecoms**  
— S — S —  
PME Earth  
Underground Earth


**Pilot Cables**  
— P — P —  
Pole Mounted Transformer  
Ground Mounted Transformer

#### IMPORTANT NOTICES

- This information is given as a guide only and its accuracy cannot be guaranteed. Services or recent additions to the network may not be shown.
- Cables, overhead lines & substations owned by other electricity network owners or private companies may be present and may not be shown.
- You should always verify exact locations of cables using a cable locator and by careful use of hand tools in accordance with HSE guidance note HSG47.
- When working within 10m of any overhead electric line you should follow the requirements of HSE Guidance Note GS6.
- For further advice on working near our electricity cables or lines, call our General Enquiries number.
- Advice should be sought from the Western Power Distribution General Enquiries team for any work that is to take place in proximity to 132kV underground cables and 132kV overhead lines.

**Report damage immediately – KEEP EVERYONE AWAY FROM THE AREA**  
**0800 6783 105**

Crown Copyright © All Rights Reserved. Ordnance Survey Licence numbers: 100022488, 100024877 & 100021807.  
WPD Copyright: This copy has been made by or with the authority of Western Power Distribution (WPD) pursuant to Section 47 of the Copyright Designs and Patents Act 1988 unless that Act provides a relevant exception to copyright the copy must not be copied without the prior permission of the copyright owner

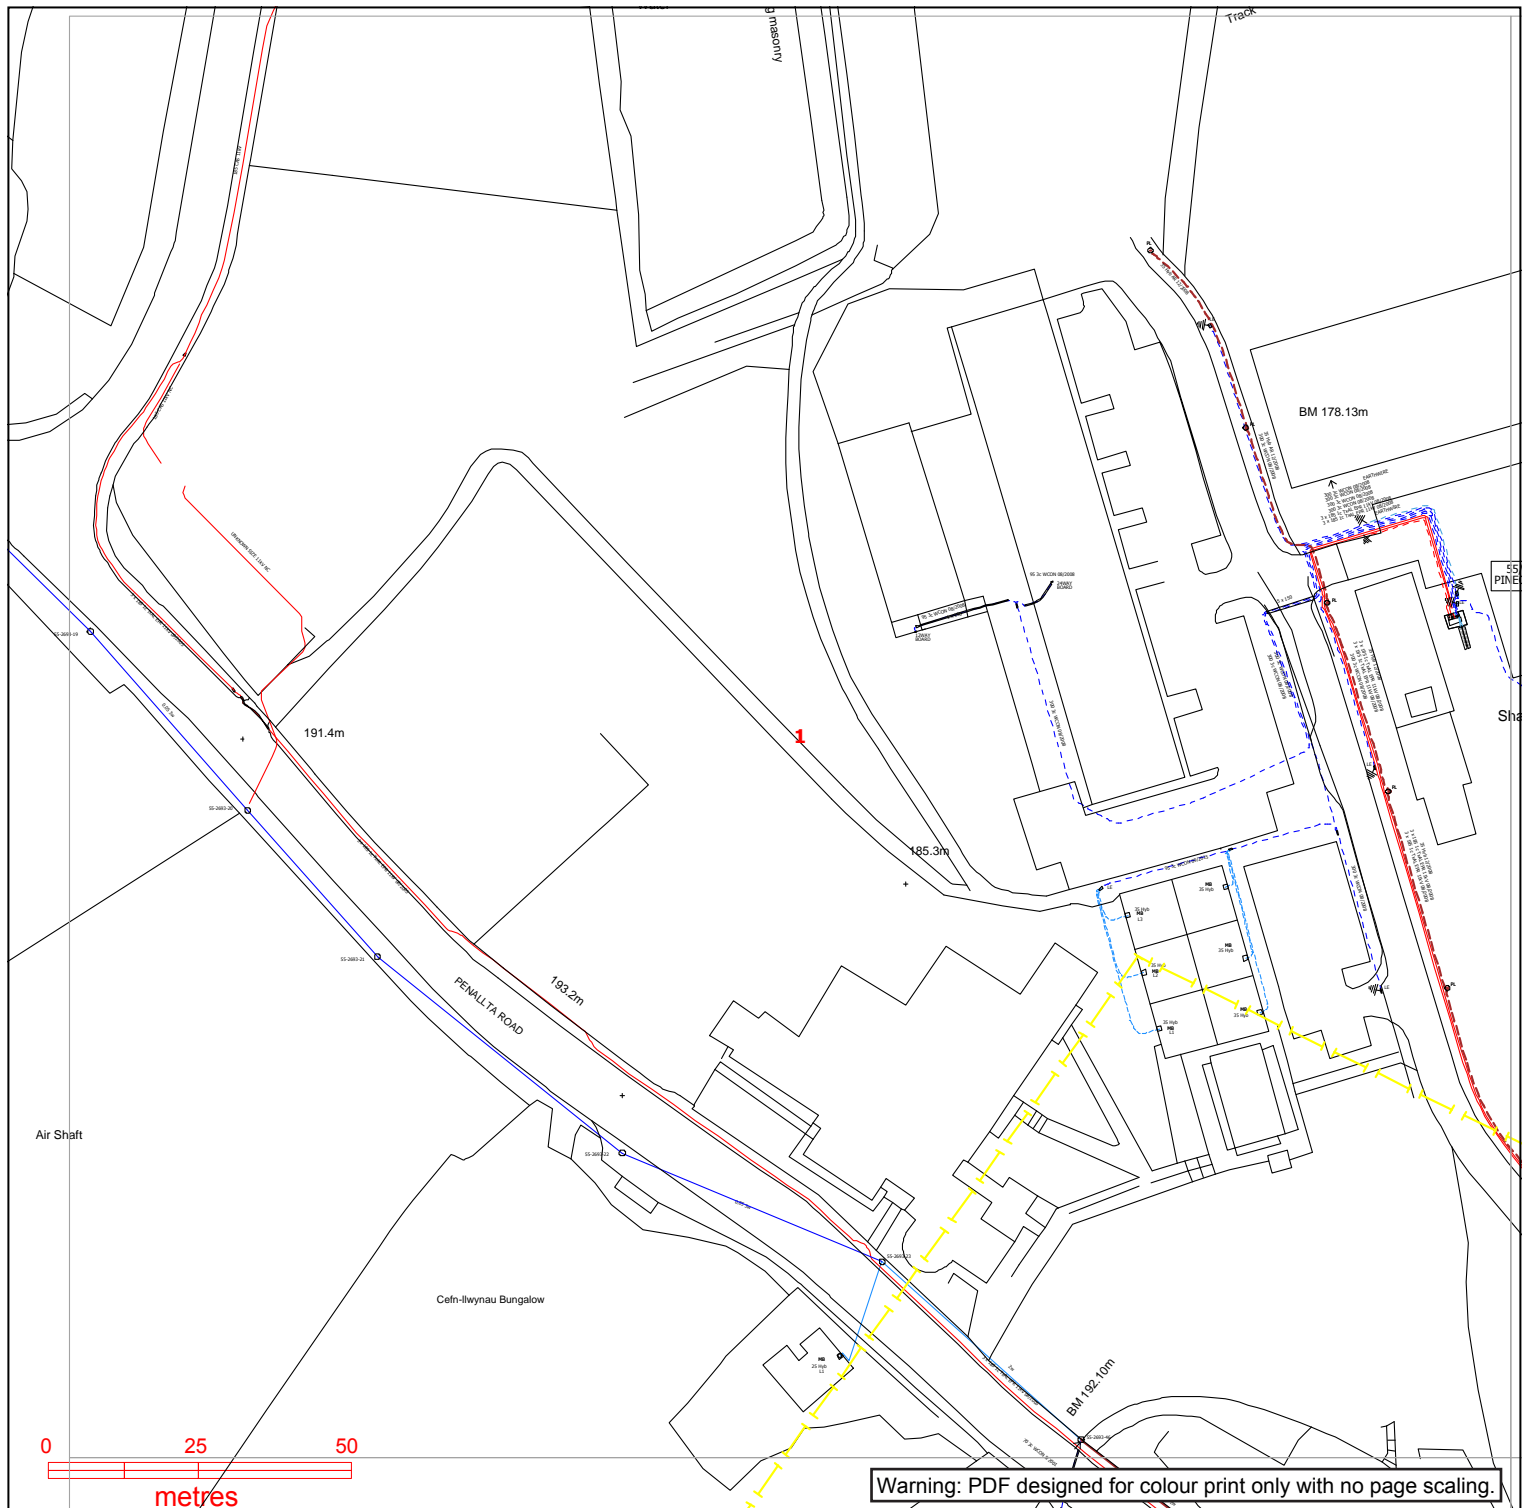

**WESTERN POWER DISTRIBUTION**  
Serving the Midlands, South West and Wales

**Contact Us**  
**Mapping Enquiries:**  
All areas 0121 623 9780  
**General Enquiries:**  
All areas 0800 096 3080

Date Requested: 22/03/2021  
Job Reference: 21632395  
Site Location: 313976 195654  
Requested by:  
Ms Christina Elliott  
Your Scheme/Reference:  
LM 94066/BRK

Exact Scales:  
1:1250 Area or Circle dig site  
1:500 Line dig site

**Link Box**  
●  
**Site Location**  
**Line/Area**  
| |

**Overhead Line**  
○ PL  
○ Service  
○ LV  
○ HV (11kV)  
○ HV (33kV)  
○ HV (66kV)  
⊠ HV (132kV)

**Underground Cable**  
--- PL  
--- Service  
--- LV  
--- HV (11kV)  
--- HV (33kV)  
--- HV (66kV)  
--- HV (132kV)

**SURF Telecoms**  
S S  
PME Earth  
Underground Earth

**Pilot Cables**  
P P  
Pole Mounted Transformer  
Ground Mounted Transformer

#### IMPORTANT NOTICES


- This information is given as a guide only and its accuracy cannot be guaranteed. Services or recent additions to the network may not be shown.
- Cables, overhead lines & substations owned by other electricity network owners or private companies may be present and may not be shown.
- You should always verify exact locations of cables using a cable locator and by careful use of hand tools in accordance with HSE guidance note HSG47.
- When working within 10m of any overhead electric line you should follow the requirements of HSE Guidance Note GS6.
- For further advice on working near our electricity cables or lines, call our General Enquiries number.
- Advice should be sought from the Western Power Distribution General Enquiries team for any work that is to take place in proximity to 132kV underground cables and 132kV overhead lines.

**Report damage immediately – KEEP EVERYONE AWAY FROM THE AREA**  
**0800 6783 105**

Crown Copyright © All Rights Reserved. Ordnance Survey Licence numbers: 100022488, 100024877 & 100021807.  
WPD Copyright: This copy has been made by or with the authority of Western Power Distribution (WPD) pursuant to Section 47 of the Copyright Designs and Patents Act 1988 unless that Act provides a relevant exception to copyright the copy must not be copied without the prior permission of the copyright owner





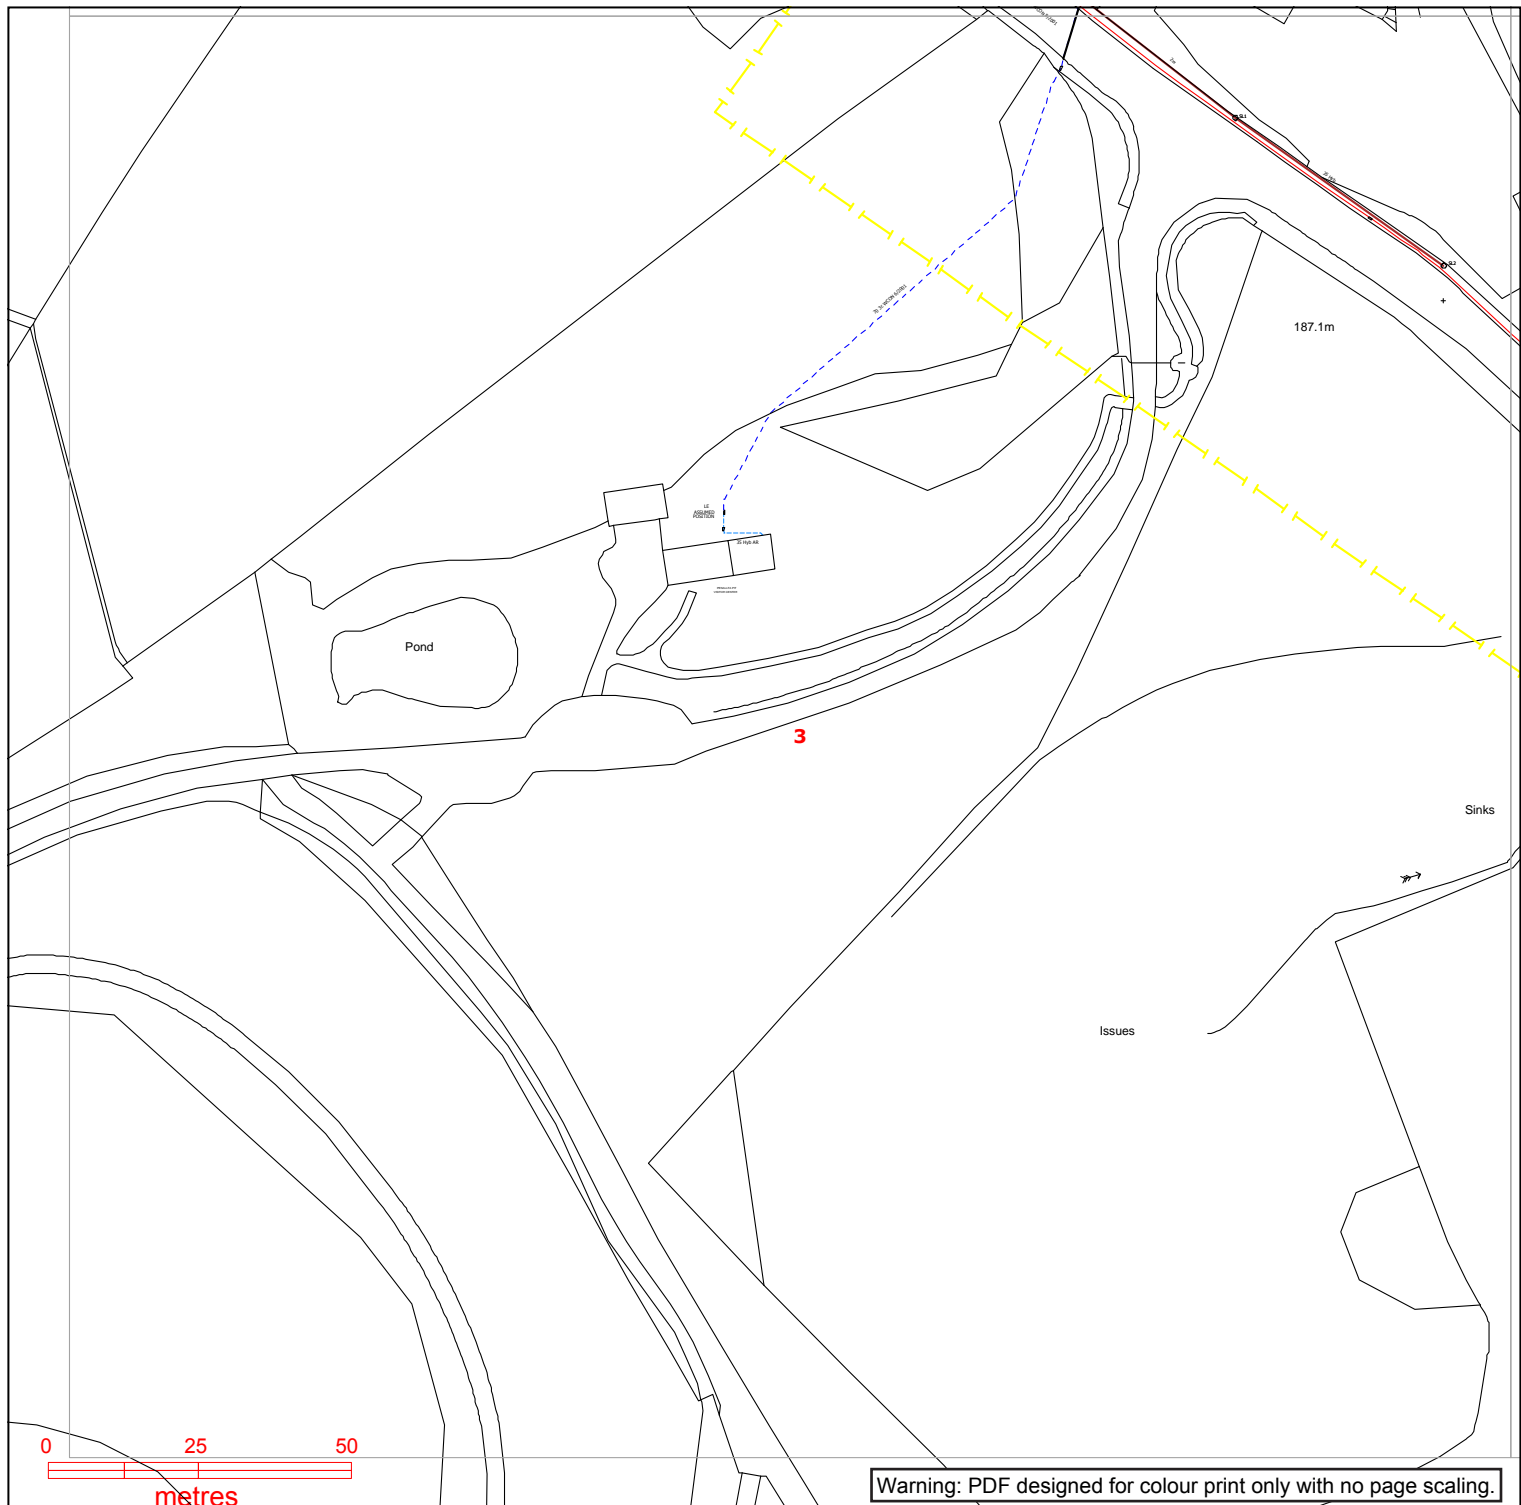

**WESTERN POWER DISTRIBUTION**  
Serving the Midlands, South West and Wales

**Contact Us**  
**Mapping Enquiries:**  
All areas 0121 623 9780  
**General Enquiries:**  
All areas 0800 096 3080

Date Requested: 22/03/2021  
Job Reference: 21632395  
Site Location: 313976 195654  
Requested by:  
Ms Christina Elliott  
Your Scheme/Reference:  
LM 94066/BRK

Exact Scales:  
1:1250 Area or Circle dig site  
1:500 Line dig site

**Link Box**  
●  
**Site Location**  
**Line/Area**  
┌───┴───┐

**Overhead Line**  
○ PL  
○ Service  
○ LV  
○ HV (11kV)  
○ HV (33kV)  
○ HV (66kV)  
⊠ HV (132kV)

**Underground Cable**  
— PL  
— Service  
— LV  
— HV (11kV)  
— HV (33kV)  
— HV (66kV)  
- - HV (132kV)

**SURF Telecoms**  
— S — S —  
PME Earth  
— E —

**Pilot Cables**  
— P — P —  
Pole Mounted Transformer  
Ground Mounted Transformer

#### IMPORTANT NOTICES

- This information is given as a guide only and its accuracy cannot be guaranteed. Services or recent additions to the network may not be shown.
- Cables, overhead lines & substations owned by other electricity network owners or private companies may be present and may not be shown.
- You should always verify exact locations of cables using a cable locator and by careful use of hand tools in accordance with HSE guidance note HSG47.
- When working within 10m of any overhead electric line you should follow the requirements of HSE Guidance Note GS6.
- For further advice on working near our electricity cables or lines, call our General Enquiries number.
- Advice should be sought from the Western Power Distribution General Enquiries team for any work that is to take place in proximity to 132kV underground cables and 132kV overhead lines.

**Report damage immediately – KEEP EVERYONE AWAY FROM THE AREA**  
**0800 6783 105**

Crown Copyright © All Rights Reserved. Ordnance Survey Licence numbers: 100022488, 100024877 & 100021807.  
WPD Copyright: This copy has been made by or with the authority of Western Power Distribution (WPD) pursuant to Section 47 of the Copyright Designs and Patents Act 1988 unless that Act provides a relevant exception to copyright the copy must not be copied without the prior permission of the copyright owner







# Avoidance of Danger from Electricity Overhead Lines and Underground Cables

# Avoidance of Danger from Electricity Overhead Lines and Underground Cables

## Introduction

In the UK on average, 20 people are killed and 400 people are injured as a result of coming into contact (or close proximity) with electricity overhead lines and underground cables.

Although electric shock is the first thing that people associate with coming into contact with our network, those who have witnessed the effects of damage to our system are shocked by the amounts of heat, light and noise that are the result of an electrical flashover.

In the Midlands, South West and South Wales, Western Power Distribution (WPD) have had to attend to incidents where people have accidentally made contact with one of our live electricity overhead lines or damaged an underground cable and become seriously injured.

A significant number of these accidents occurred whilst people were working in the vicinity of overhead and underground electrical apparatus and this booklet has been produced to provide general guidance on how you and your employees can avoid becoming one of these statistics.

## Our Operational Area



## PLANNING YOUR WORK.

It makes sense to consider your safety while in the vicinity of our equipment as early in your planning process as possible.

One of the first things you should do whenever you are planning your work is to check whether there is any of our equipment in the immediate vicinity. You should do this whether your work is taking place on public (e.g. highways and footpaths) or on private land.

For instance, take a good look around your site to see if there are any visible overhead lines. You should also bear in mind that we have a very extensive network of underground cables, and we are always happy to supply a plan from our Map Response Team who can be contacted via the following;

Tel: 0121 623 9780

Fax: 0121 623 9223

[WPDMapResponse@westernpower.co.uk](mailto:WPDMapResponse@westernpower.co.uk)

An online mapping service is available at  
[www.westernpower.co.uk/locationplans](http://www.westernpower.co.uk/locationplans)


**It is always safer to assume that there are underground cables present in the ground until you have proven otherwise.**



# WORKING IN THE VICINITY OF UNDERGROUND CABLES

Having obtained copies of our network maps, it is important to recognise that in most cases there will be no surface indication of the presence of our underground cables. We therefore advise that you take the following actions:

- Make sure that you have up-to-date copies of our cable record plans ON SITE - not back in the office.
- Don't assume that these plans are to scale if they have been faxed or copied.
- Make sure that a competent person using a Cable Avoidance Tool (CAT) locates all of the cables shown on these plans.
- Mark the locations of cables on the ground surface with waterproof road paint or other permanent marker.
- Always assume that our cables are live unless we have informed you, in writing, otherwise.

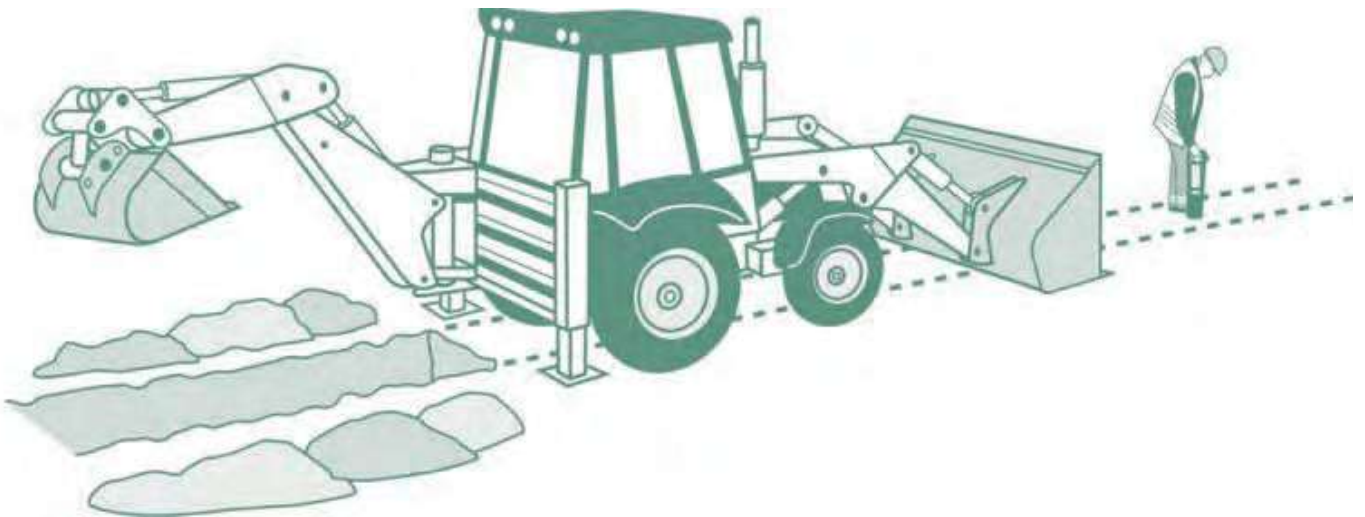

- By hand, dig trial holes to locate the exact position of all cables. Always use a spade or shovel – never use a pick, fork or power tool – push the spade or shovel into the ground applying foot pressure.

- Look out for ducts, marker tape or tiles but do not rely on these. Even if a cable route was originally laid in a duct or with a marker tape, these may have been removed during other excavations at a later date along all or part of the cable route.
- Brief all people working in the vicinity of the presence and location of all underground cables.

**UNDER NO CIRCUMSTANCES SHOULD YOU ATTEMPT TO WORK ON, OR INTERFERE WITH, ANY OF OUR UNDERGROUND CABLES.**

The only people qualified to work on this equipment are our operatives; who have been specifically trained and are authorised in writing to do so.

**Please also be aware that:**

- Cable record plans are not guaranteed to be completely accurate. Kerb lines, roads and buildings may have been moved or altered since the cables were laid.
- Cables should ordinarily be at least 450mm deep but don't assume this to be the case where you are working – ground levels could have changed.
- Not all service cables are shown on record plans, so look for cables running down poles and bear in mind that all buildings, street lights and street furniture are likely to have cables running to them. Cables feeding street furniture may be relatively shallow near to the furniture.
- Cables do not run in straight lines. They often “snake” through the ground avoiding surface and buried obstacles that may not be visible to you.
- Cables are flexible and can change direction and depth abruptly – for this reason never use mechanical excavators within 0.5m of any underground electricity cable even if you have located it with trial holes.

- **No attempt should be made to break out concrete surrounding a cable. Please contact us immediately on our general enquiries number and we will discuss the options for safe working which may include making the cable dead or you moving your work site if possible. If we need to make the cable dead we may need to provide our customers with two weeks notice of the power interruption.**
- Our cables and joints are not designed to act as steps or to be left unsupported. If you remove support from any cable, you will need to support it using temporary hangers at not more than 0.5m intervals.
- When backfilling, please consolidate the ground under the cables, cover the cable with soil free of stones or with stone dust and replace any cable marker tiles, ducts and tape.

#### **IF YOU DAMAGE AN UNDERGROUND CABLE**

you must immediately clear the area of personnel, because the cable could still be live, or become live again.

If a machine is still in contact with the cable, instruct the driver to JUMP clear. Do not touch any part of the machine.

Please contact us on our emergency number immediately and tell us what has happened. Please be ready to provide us with a contact telephone number and an accurate location or set of directions – this will help us in getting our staff to site quickly to minimise any danger and lessen the disruption to your work.

**Please report any damage to a cable, however superficial it might seem. The cable may not fail at the time of damage, but it could fail later, causing danger to our staff and other contractors, disruption to our customers' supplies, and also – if we trace the damage back to you – a very much larger repair bill.**



# WORKING IN THE VICINITY OF OVERHEAD LINES


UNDER NO CIRCUMSTANCES SHOULD YOU ATTEMPT TO WORK ON, OR INTERFERE WITH ANY OF OUR OVERHEAD LINE EQUIPMENT OR SERVICE WIRES.

The only people qualified to work on this equipment are our operatives; who have been specifically trained and are authorised in writing to do so.

Overhead lines have the advantage that, unlike underground cables, they can easily be seen.


- Always assume that our overhead lines are live unless we have informed you otherwise in writing.
- We will be able to advise you about the type and voltage of the overhead lines in question and provide you with information about the clearances that you must adhere to during your work. Please ring our regional general enquiries number for further advice.
- If you are in any doubt about whether the overhead lines in question are power or telephone (this is a very common mistake) – please ask us.
- In some circumstances, we may be able to temporarily shroud low voltage overhead lines and services running to buildings if you need to work in the vicinity e.g. for scaffolding erection, fascia repairs and painting work on domestic properties. We don't normally charge for the shrouding of overhead lines, but please give us as much notice as possible.
- If you think that you will be working close to our overhead lines and they need shrouding – please don't start work until we have agreed what needs to be done and all safety precautions are in place.
- Please note that it is not technically possible to shroud high voltage lines, so if you cannot avoid working near to our high voltage lines, contact us and we will be happy to meet with you to discuss safe alternatives.

- If it is decided that work can go ahead in the vicinity of our overhead lines but there is a risk of you infringing the safety clearances from the overhead lines, you have a responsibility to erect safety barriers to segregate your works from the area around the overhead lines. The detailed requirements for these barriers are provided in the HSE document GS6 'Avoidance of Danger from Overhead Lines'. As a summary they should consist of:
  - Red and white coloured posts erected at 6m intervals, with coloured bunting stretched between their tops, supplemented by low level bunting erected at 1m above ground level, supported at 3m intervals on red and white coloured posts. This is shown below.

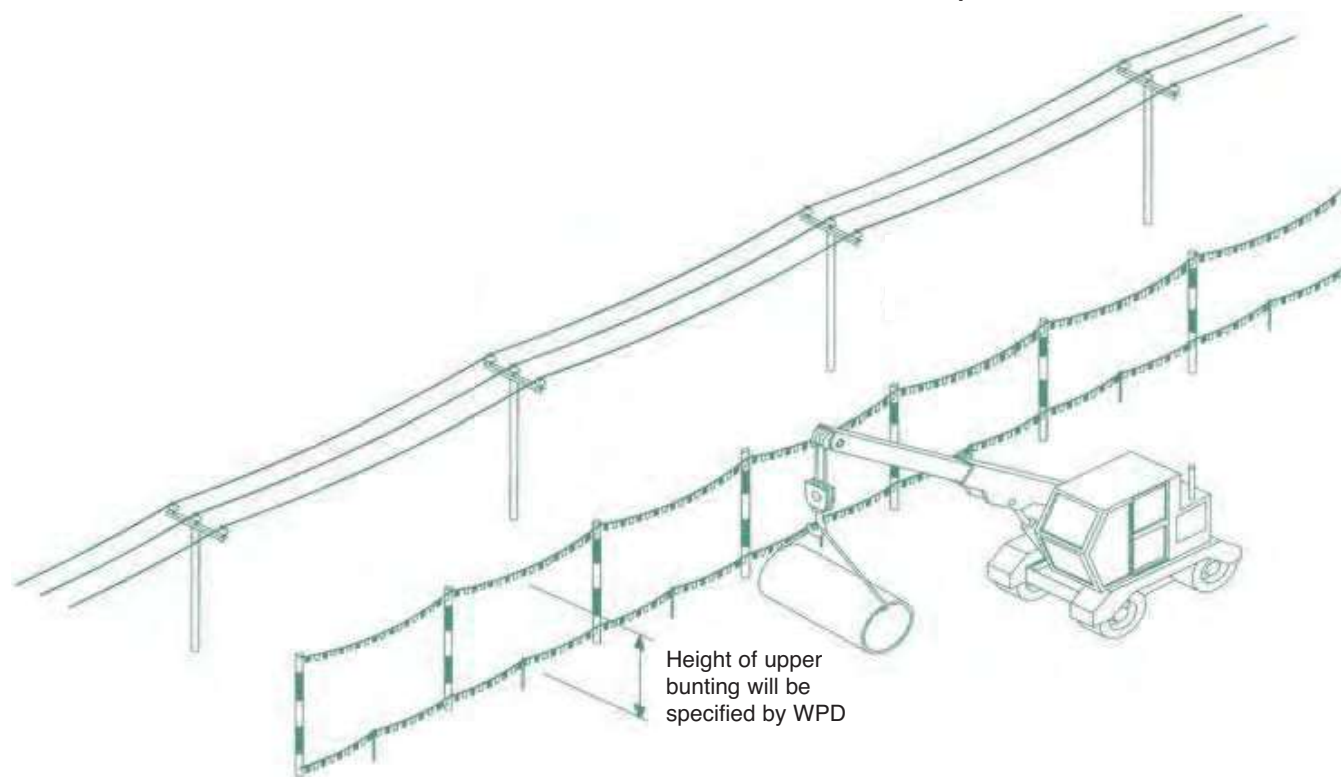

- We are able to advise you on the height of the barriers and any additional clearances necessary if you are using large plant on your site.
- Any bunting, ropes and lanyards used should be made from an insulating material.
- These barriers should be erected parallel to the overhead line at a minimum distance of 6m horizontally from the outermost conductor of the overhead line.


- The supports may be supported by rubble or concrete filled barrels or buried directly in the ground.
- Danger Notices should be fixed to all of your high level supports.
- The ground enclosed within these barriers is best regarded as “dead ground” in which all foot and vehicular traffic is forbidden, in all circumstances, for the duration of your work.
- Where it is necessary for foot and vehicular traffic to pass under the line, you will need to form a marked access way between the barriers as shown below.

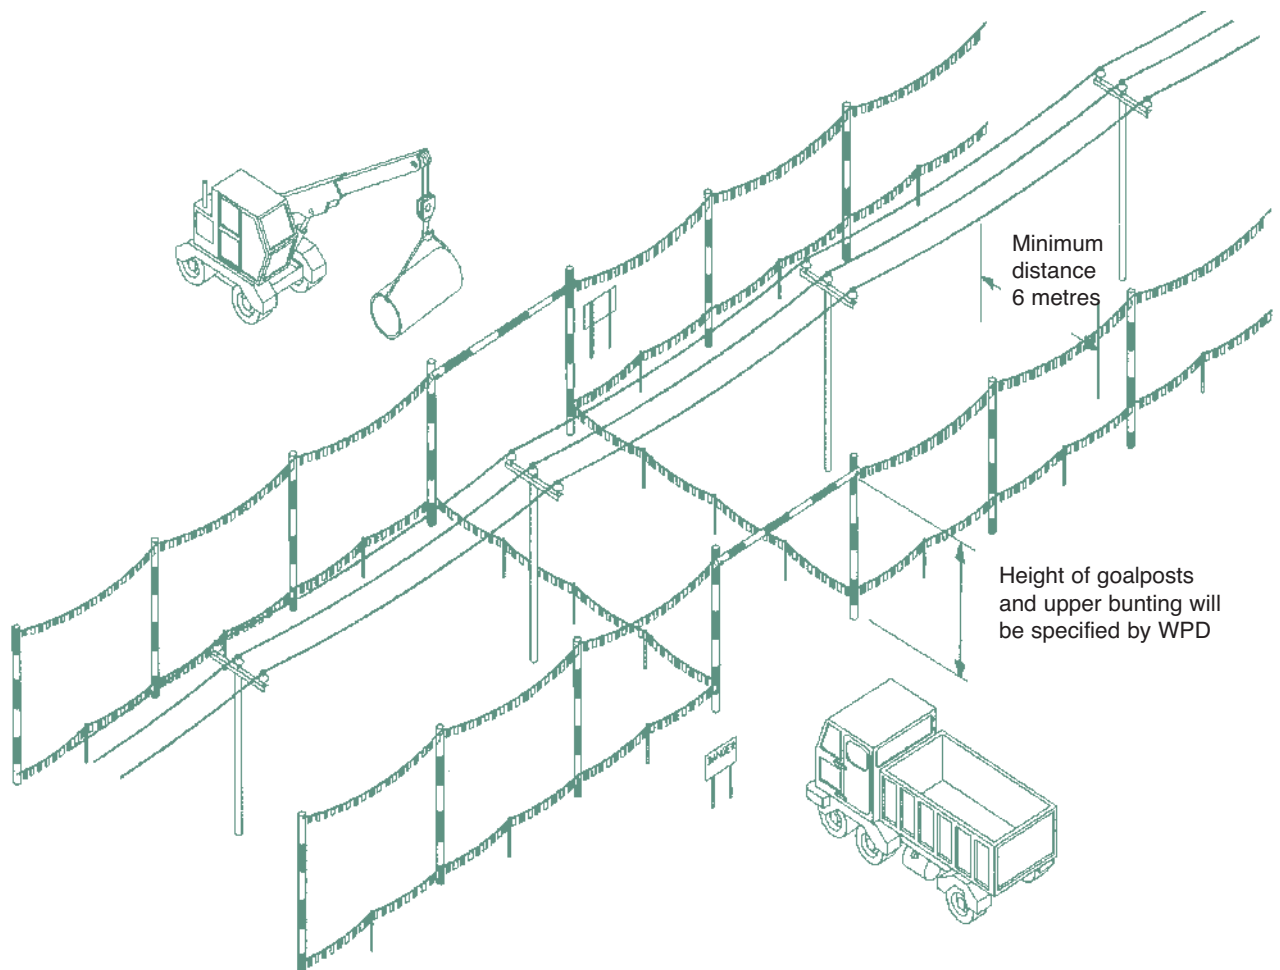

- This access way should comprise of bunting erected 1m above ground, supplemented by high level “goal-posts” erected at either end.
- The goal post cross bars should be rigid, made of insulating material and positioned in a location and at a height specified by us.



- The access route should be as narrow as possible and should not normally exceed 10m in width.
- If it is necessary to make the access route wider than this, you may find it impractical to use rigid cross bars, so you may use a tensioned rope and bunting instead. If you use rope and bunting as a cross bar, you should move the entrance to the access route out to a minimum distance of 12m from the outermost conductor of the line. This is to allow for any stretching of the rope if pulled by your plant.

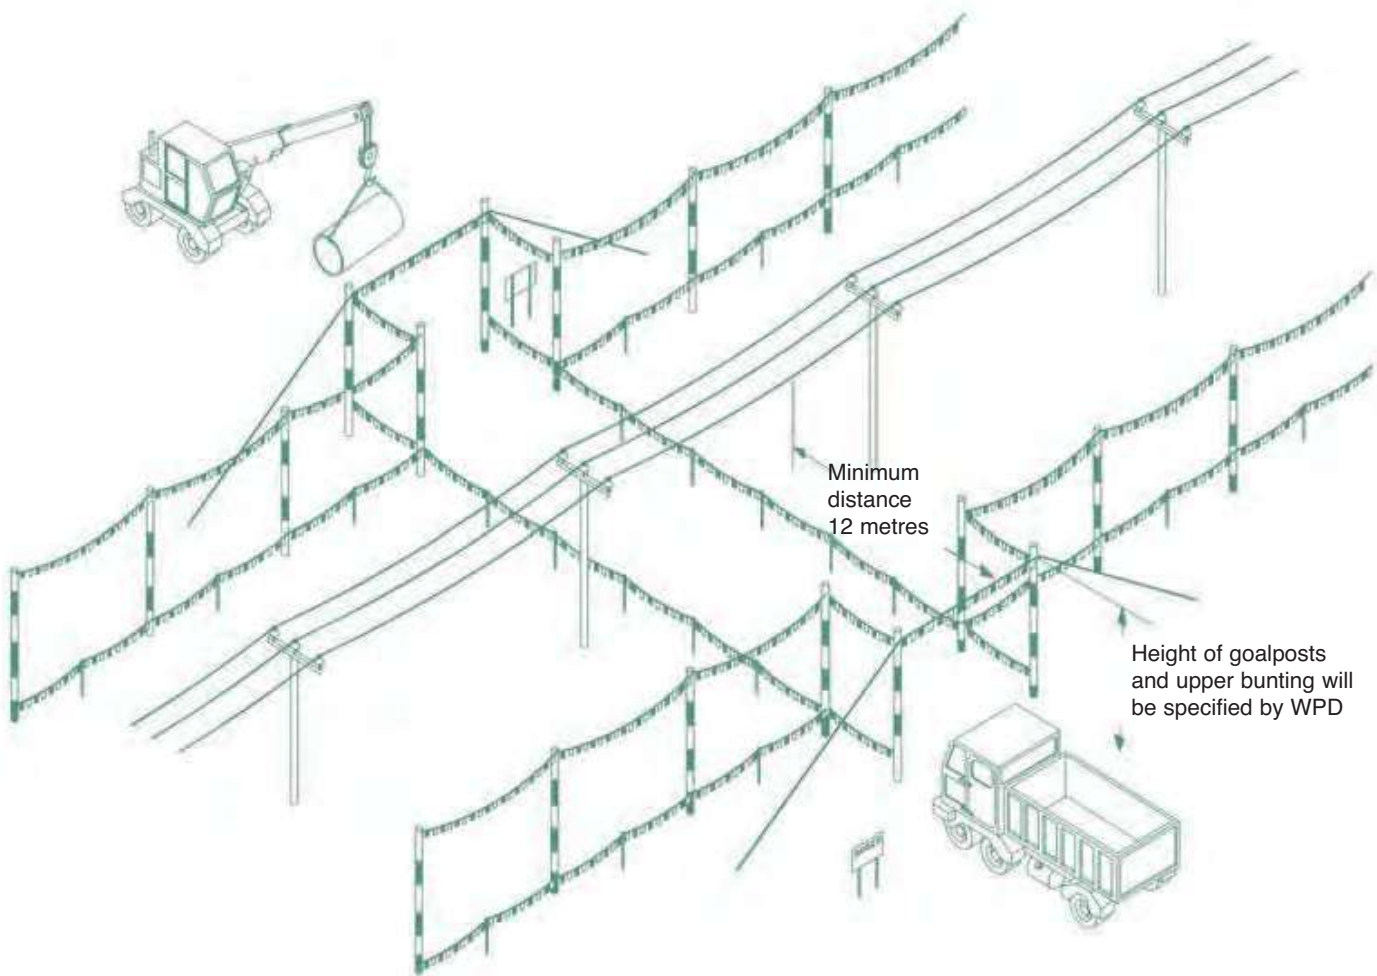

- If you decide to use steel wire rope to support the barrier, this must be effectively connected to earth at both ends.
- You should also install Danger Notices at all probable directions of approach and clearly display the cross bar height.
- If you are working at night, or in conditions of poor visibility, you should ensure the area is well lit and that the overhead lines are clearly visible.
- Whatever measures you take, you should ensure that everyone working in the vicinity of overhead lines is briefed about the risks and what safety measures are in place. Do not permit anyone to carry long objects, especially scaffold poles, ladders and irrigation pipes in the vicinity of overhead lines.
- You should ensure that all shrouding, barriers and signs are regularly inspected and maintained so that they remain effective.
- Overhead lines are not normally insulated and electricity at high voltages may jump, so a dangerous situation can arise just from a close approach.
- Cranes and excavators working near overhead lines are at increased risk because of the possibility of the jib/arm slewing or being raised into the overhead line, or the load swinging into the overhead line. You may therefore also need to fit plant and vehicles with restricting chains etc. to physically restrain their operation – we can advise on this if you wish.
- If you are planning to carry out tree cutting or arboriculture work in the vicinity of our overhead lines, you need to be aware that this is a complex, high risk activity and we recommend that you employ a competent tree surgeon, who complies with all of the requirements of Forestry industry Safety Accord (FISA) publication FISA 804 - Electricity at work: Forestry.

## If contact is made with an overhead line

you must immediately clear the area and suspend all work within 50m of the damage because the line could still be live, or become live again.

The operator of a machine that is in contact with an overhead line should:

- **if the machine is still operable and the operator is still in the cab:**

provided that you do not risk breaking the overhead line or dragging it to the ground, immediately lower the raised parts of the machine USING ONLY THE CONTROLS IN THE CAB and/or drive the vehicle clear of the overhead line.

contact us immediately on our emergency number so that we can check the overhead lines.

instruct other people in the vicinity not to approach the vehicle.

- **if the machine is not operable, cannot be driven clear of the overhead line or there is a risk that doing so will break the line or drag it to the ground:**

stay in the cab.

contact your site manager or us immediately on our emergency number by radio or mobile phone or as soon as possible by any other method.

instruct everyone outside the vehicle not to approach it.

do not exit the cab until given confirmation BY WPD PERSONNEL that it is safe to do so.

- **if the machine is inoperable or cannot be driven free and there is risk of fire or other immediate hazard:**

JUMP clear of the vehicle, avoiding simultaneous contact with any part of the machine and the ground.

try to land with your feet as close together as possible.

where possible, continue to move away from the vehicle using “bunny hops” with your feet together until at least 15m from the vehicle.

instruct other people in the vicinity not to approach the vehicle.

contact us immediately on our emergency number.

do not return to the vehicle until given confirmation by WPD PERSONNEL that it is safe to do so.



Whatever the circumstances please contact us on our emergency number immediately and tell us what has happened. Please be ready to provide us with a contact telephone number and an accurate location or set of directions – this will help us in getting our staff to site quickly to minimise any danger and lessen any disruption to your work.

**Please report any damage or contact no matter how minor they may seem to you at the time. The damage may not cause a serious problem at the time of damage, but it could fail later, causing danger to our staff and members of the public, disruption to our customers' supplies, and – if we trace the damage back to you – a large repair bill.**

## MORE INFORMATION

For your information, we are legally obliged to report all contact with our system to the Health & Safety Executive (HSE), and, if you are an employer, you may be obliged to report incidents involving your staff or contractors to the HSE. Even if no one is hurt, you could be prosecuted for failing to report such an incident.

More detailed general information on this subject is available in the following publications from the HSE:

HSG(47) – Avoiding Danger from Underground Services

GS6 – Avoidance of Danger from Overhead Lines

Along with Forestry Industry Safety Accord (FISA) publication FISA 804 – Electricity at Work: Forestry

If you require more site-specific information relating to our equipment at your location please contact us on our regional general enquiries numbers.

Our general enquiries numbers are;

Midlands	0845 724 0240
----------	---------------

General Enquiries

South Wales	0845 601 3341
-------------	---------------

General Enquiries

South West	0845 601 2989
------------	---------------

General Enquiries

### FINALLY...

Please, always remember that electricity cables and overhead lines can be very dangerous – the general rule is **STAY AWAY** and stay safe.

# NOTES



This booklet is issued by the Safety Team

Western Power Distribution (East Midlands) plc. Registered in England and Wales No. 2366923

Western Power Distribution (West Midlands) plc. Registered in England and Wales No. 3600574

Western Power Distribution (South Wales) plc. Registered in England and Wales No. 2366985

Western Power Distribution (South West) plc. Registered in England and Wales No. 2366894

Registered Office: Avonbank, Feeder Road, Bristol BS2 0TB

Printed on material sourced from sustainable forests and TCF. Printed using vegetable/mineral oil based environmentally friendly inks.

2014, 4th issue



Our emergency number is:  
0800 6783 105

Calling from a mobile?

East Midlands

0330 123 5009

West Midlands

0330 123 5008

South Wales

0330 123 5002


South West

0330 123 5001



# LOOK OUT-

# LOOK UP!

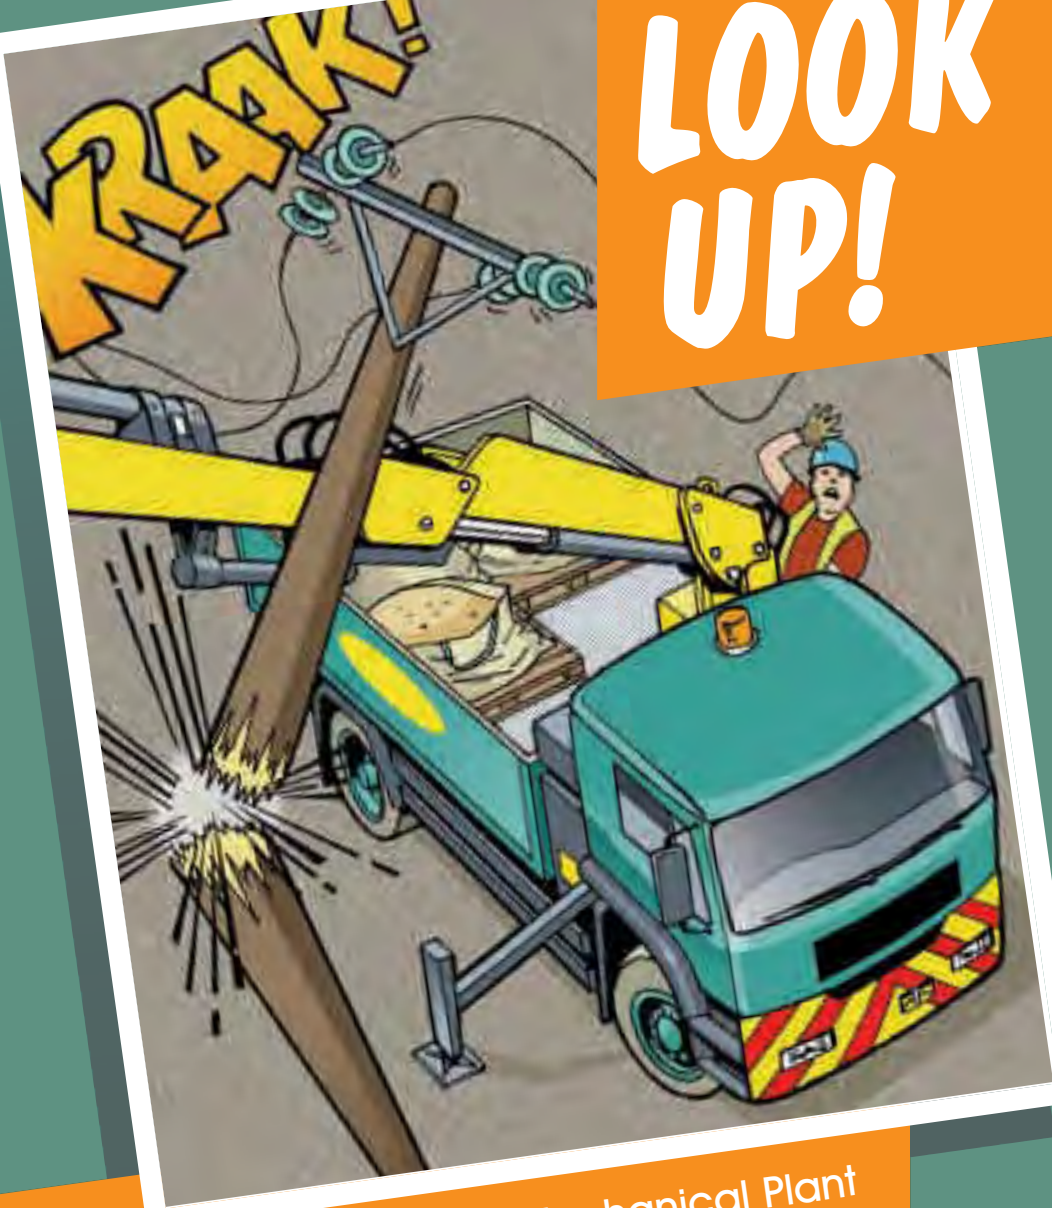

A Guide to the Safe Use of Mechanical Plant  
in the Vicinity of Electricity Overhead Lines

**WESTERN POWER**  
**DISTRIBUTION**

*Serving the Midlands, South West and Wales*



# The Safe Use of Mechanical Plant in the Vicinity of Electricity Overhead Lines

## Introduction

Every year in the UK on average, two people are killed and many more are injured when mechanical plant and machinery comes into contact or close proximity to overhead electricity lines.

This booklet has been produced for anyone who uses mobile plant, (such as Hiabs, MEWPs, Tipper Lorries and Trailers, Grab Lorries, Concrete Conveyors and Excavators) for short duration work and provides general guidance on how to avoid becoming part of these statistics.



## 1 BEFORE STARTING WORK


- Overhead lines have the advantage that they can easily be seen, so before you set up your vehicle or plant always:

### STOP AND LOOK UP!


- If you are working at night, or in conditions of poor visibility, you should use spotlights or a torch to carefully check that there are no overhead lines within your vehicle's reach.
- Always assume that our lines are live unless we have informed you otherwise in writing.
- If you are in any doubt about whether the lines in question are power or telephone (this is a very common mistake) – always assume that they are power lines and are live.
- It is not normally practical for electricity companies to shroud high voltage conductors and even when low voltage conductors are shrouded, the shrouding is not designed to protect against contact by mechanical plant – again, always assume the lines are live.

## 2 EXCLUSION ZONES

- Overhead power lines are not normally insulated and so any contact can result in serious or fatal injuries.
- Electricity at high voltages can also jump gaps with no warning whatsoever, so it is also dangerous to let your plant approach too close to a line.
- The distance that electricity can jump depends on the voltage of the line. The higher the voltage, the further you must stay away from the line and any other equipment that may be fitted to the pole or pylon. This distance is called the **EXCLUSION ZONE**. Examples of this are shown highlighted in the diagram below.

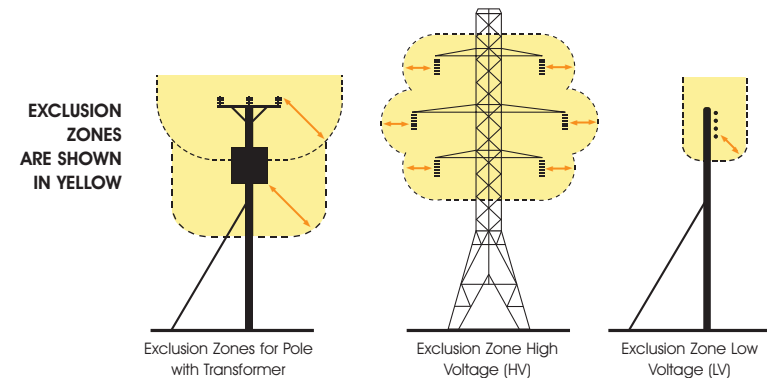

- You must not allow any part of your plant to enter the **EXCLUSION ZONE**.
- The diagram below shows typical types of overhead lines and provides a guide to help you assess the line voltage of lines on wooden poles or steel pylons. The minimum **EXCLUSION ZONE DISTANCE** is shown for each example.

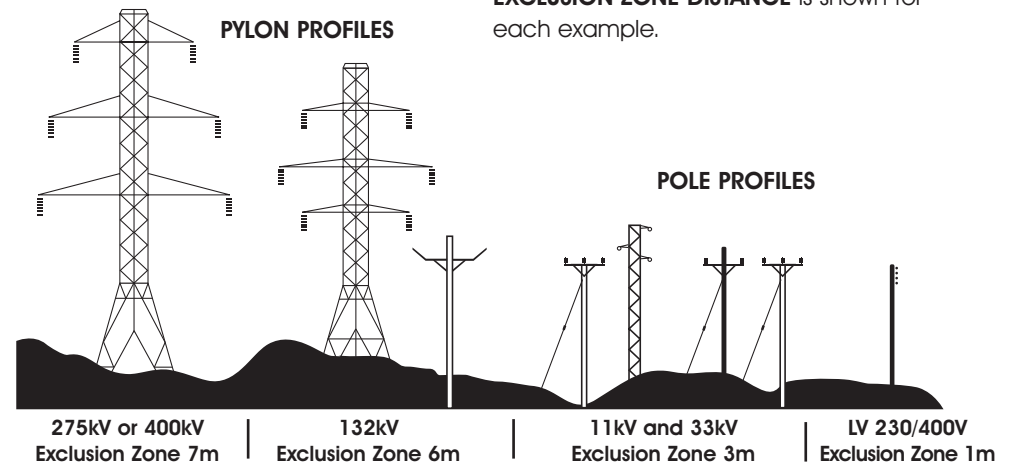


- Please note that these are absolute minimum distances that should under no circumstances be infringed. **If you do – it could prove fatal.**




- As well as staying away from the lines or equipment, you should also stay at least 600mm away from any part of poles, pylons and stay wires.
- Please remember that is for guidance only, and if you are in any doubt, please call us for advice before setting up your plant or starting work.

### 3 STAND OFF DISTANCES

- If there are power lines in the vicinity of your work the best way to make sure you stay out of the **EXCLUSION ZONE** is to position your vehicle at a **SAFE STAND OFF DISTANCE** so that, even when fully extended, no part of it can accidentally reach inside the **EXCLUSION ZONE**.
- This **SAFE STAND OFF DISTANCE** can be calculated by adding the **EXCLUSION ZONE** distance for the appropriate voltage of the line to the Maximum Operating Reach of your vehicle. This is shown in the diagram below.

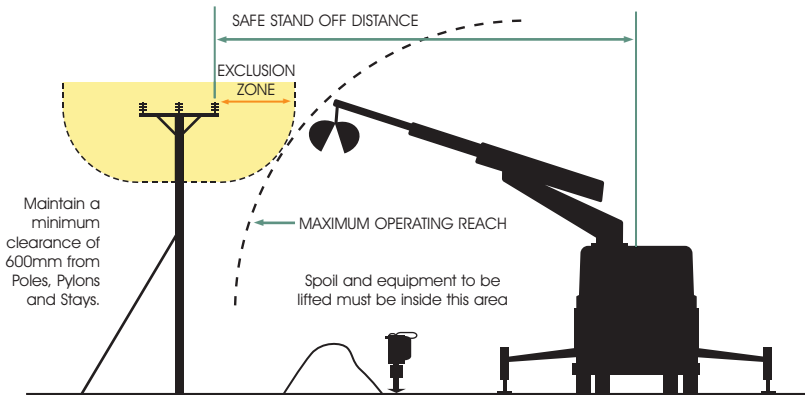


- If you position your vehicle outside of the **SAFE STAND OFF DISTANCE**, there is no risk of accidental contact with the lines and no danger of electricity jumping from the line to your vehicle.
- If you cannot achieve a **SAFE STAND OFF DISTANCE**, consider moving your vehicle to a safer location. It may make your job a bit more difficult, but if it means you stay away from the **EXCLUSION ZONE** - it will be safer. The next best option would be to consider using smaller plant with a Maximum Operating Reach that cannot enter the **EXCLUSION ZONE**.

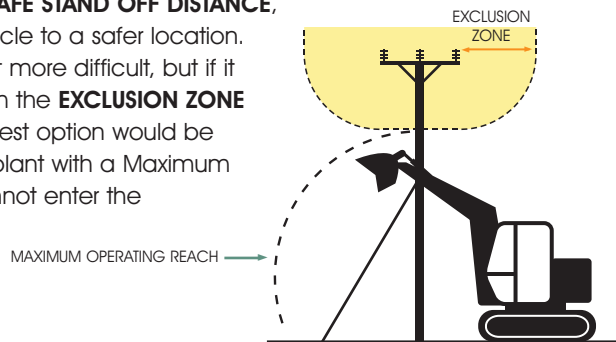

- You may not be able to achieve either of these options, so, as a last resort, if you cannot avoid operating large items of plant in the vicinity of lines, you **MUST** make sure that the plant is fitted with restraints to ensure that the **EXCLUSION ZONE** cannot be entered. These restraints may be electrical or hydraulic systems fitted to the plant, or mechanical devices such as chains.

Please seek advice from the plant manufacturer for more information on choices available for your particular item of plant.

- If you are using a mechanical excavator to dig parallel to the line, it is good practice to position the excavator with the tracks or wheels parallel to the line, so as you move along the excavation the **SAFE STAND OFF DISTANCE** is easily maintained.

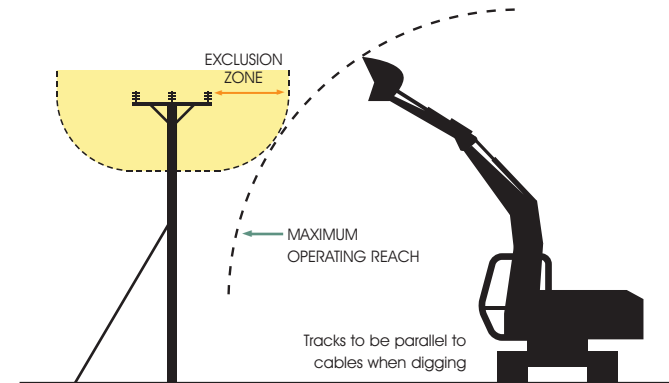

- Care must also be taken to avoid non-mechanical equipment, (e.g. scaffold poles, ladders and long loads such as lengths of steel or timber) from entering the **EXCLUSION ZONE**.
- Always maintain at least 600mm clearance from your plant to any of our poles, stay wires or pylons. Any contact with these by your plant could cause the line to break and fall to the ground.

### 4 EMERGENCY PROCEDURES

**If contact is made with an overhead line**, you must immediately clear the area and suspend all work within 50m of the damage because the line could still be live, or become live again.

The operator of a machine that is in contact with an overhead line should take the following steps:

- **If the machine is still operable:**
  - lower any raised parts that are controlled from the driving position and/or drive the vehicle clear of the line, as long as neither of these actions risk breaking the line or dragging it to the ground.



● **If the machine is not operable or cannot be driven clear of the line:**

- stay in the cab.
- contact your site manager or us immediately by radio or mobile phone or as soon as possible by any other method.
- instruct everyone outside the vehicle not to approach it.
- do not exit the cab until given confirmation BY WPD PERSONNEL that it is safe to do so.

● **If the machine is inoperable or cannot be driven free and there is risk of fire or other immediate hazard:**

- jump clear of the vehicle, avoiding simultaneous contact with any part of the machine and the ground.
- try to land with your feet as close together as possible.
- where possible, continue to move away from the vehicle using "bunny hops" with your feet together until at least 15m from the vehicle.
- instruct other people in the vicinity not to approach the vehicle.
- do not return to the vehicle until given confirmation BY WPD PERSONNEL that it is safe to do so.

***Whatever the circumstances please contact us on our emergency number immediately and tell us what has happened.***

Please be ready to provide us with a contact telephone number and an accurate location or set of directions – this will help us in getting our staff to site quickly to minimise any danger and to reduce any disruption to your work.

Our emergency number is:

**105 or 0800 6783 105**

Please report any damage or contact no matter how minor they may seem to you at the time. Whilst the damage may not cause a serious problem at the time of contact it could fail later, causing danger to our staff and members of the public, disruption to our customer's supplies, and – if we trace the damage back to you – a larger repair bill!

## 5 MORE INFORMATION

- Proximity Warning Systems (such as Wire Watcher – see [wirewatcher.co.uk](http://wirewatcher.co.uk) for information) may be fitted to your vehicle. Never turn these devices off or disable them in any way.
- Take note of any warnings these proximity warning systems may provide but do not use the presence of such devices as a reason not to follow the advice provided in this leaflet.
- For your information, we are legally obliged to report all contact with our system to the Department of Trade and Industry (DTI), and, if you are an employer, you may be obliged to report incidents involving your staff or contractors to the Health & Safety Executive (HSE). Even if no one is hurt, you could still find yourself being prosecuted for causing a dangerous occurrence.

## 6 FURTHER READING

For advice related to signing and guarding at longer term work sites please also refer to WPD booklet "Avoidance of Danger from Electricity Overhead Lines and Underground Cables"

More detailed information is also published in the following documents available from the HSE.

**GS6 – Avoidance of Danger from Overhead Lines.**

**HS(G) 47 – Avoiding Danger from Underground Services.**

Along with Forestry Industry Safety Accord (FISA) publication **FISA 804 - Electricity at Work: Forestry.**

If you require more site-specific information relating to our equipment at your location please contact us on the relevant **GENERAL ENQUIRIES NUMBER:**

**0800 096 3080**

**FINALLY....** Please, always remember that electricity overhead lines can be very dangerous – **the general rule is STAY AWAY and STAY SAFE!**



# ***For the Safe Use of Mechanical Plant in the Vicinity of Electricity Overhead Lines ALWAYS FOLLOW THESE SIMPLE RULES – THEY COULD SAVE YOUR LIFE!***

- **Treat all overhead lines as live and dangerous**
- **Any contact may be fatal or cause very serious injuries**
- **Electricity can jump gaps**
- **Before you set up or use plant near to lines – STOP and LOOK UP**
- **Take special care and use lights in the dark or poor light conditions**
- **If there are lines in the vicinity of your work – stay well away**
- **Set up your plant with care to reduce the chance of contact**
- **If you are unsure or need advice**
  - please ask us before starting work

**Our emergency number is: 105 or 0800 6783 105**

**You can also call 105 if you spot damage to electricity power lines, poles and substations which could put you or someone else in danger.**


**If there's a serious immediate risk, you should also call the emergency services.**

**This booklet is issued by the Safety Team: [wpdsafetyhelpline@westernpower.co.uk](mailto:wpdsafetyhelpline@westernpower.co.uk)**



Western Power Distribution (East Midlands) plc. Registered in England and Wales No. 2366923  
Western Power Distribution (West Midlands) plc. Registered in England and Wales No. 3600574  
Western Power Distribution (South Wales) plc. Registered in England and Wales No. 2366985  
Western Power Distribution (South West) plc. Registered in England and Wales No. 2366894  
Registered Office: Avonbank, Feeder Road, Bristol BS2 0TB



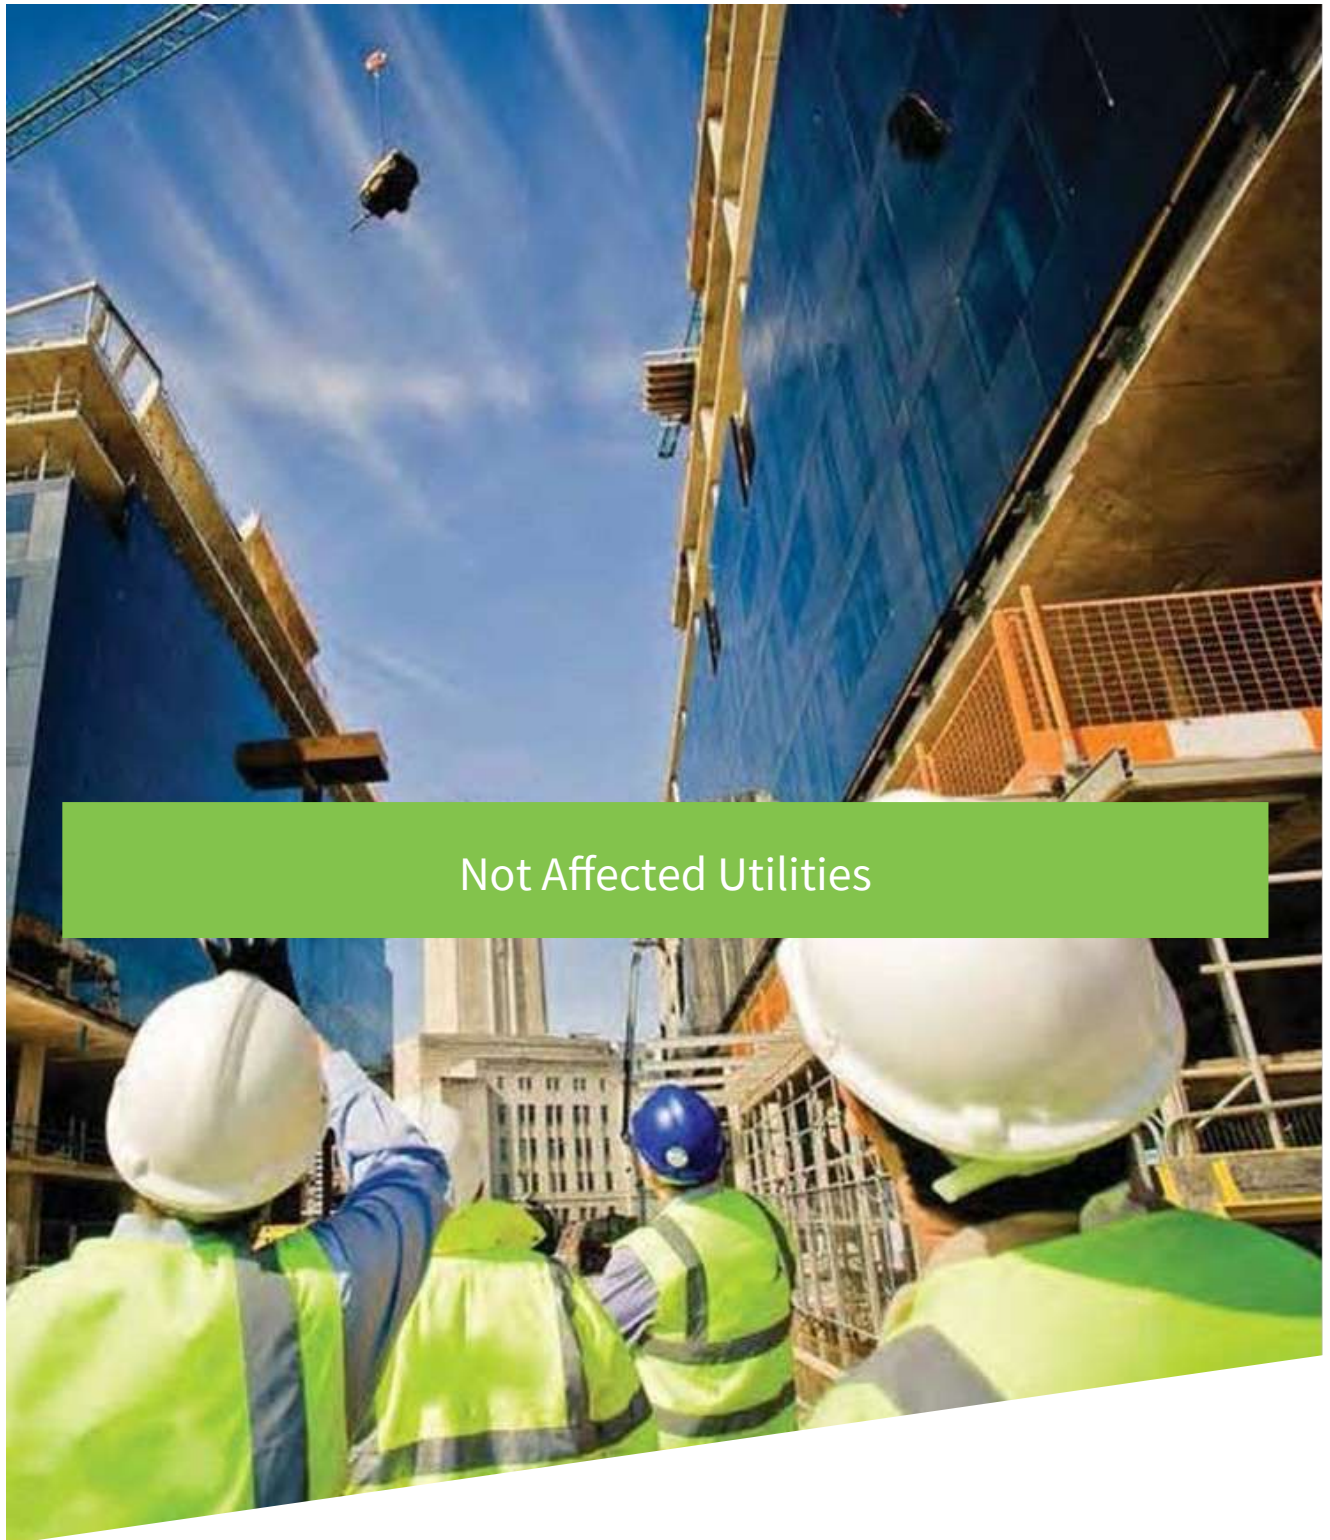

Not Affected Utilities



**From:** Plantenquiries <plantenquiries@catelecomuk.com>  
**Sent:** 23 March 2021 23:32  
**To:** Utility Solutions GDC Requests  
**Subject:** RE: Plant Enquiry - 94066 - Site off Penallta Road, Ystrad Mynach, Hengoed - Please respond by 06/04/2021

**Please Note: Our search criteria has changed. We previously searched for Colt Network which was within 200 metres, this has now changed to 50 metres. The negative response will be for all enquiries that the network is 50 metres or more away from the place of enquiry.**

Dear Sir/Madam,

Thank you for your enquiry for the above reference.

We can confirm that Colt Technology Services do not have apparatus near the above location as presented on your submitted plan, if any development or scheme amendments fall outside the 50 metre perimeter new plans must be submitted for review.

Search is based on Overseeing Organisation Agent data supplied; we do not accept responsibility for O.O. Agent inaccurate data.

If we can be of any further assistance please do not hesitate to contact us.

Kind regards,

**Plant Enquiry Team**



**Please consider the environment before printing this email.**

*This e-mail and any files transmitted with it are confidential and are intended solely for the use of the intended recipient(s). If you are not the intended recipient, you must not copy, distribute or take any action based on this communication. If you have received this communication in error please contact [plantenquiries@catelecomuk.com](mailto:plantenquiries@catelecomuk.com) and delete this communication and any copies of it. Any views or opinions presented are solely those of the author and do not necessarily represent those of C A Telecom LTD. C A Telecom LTD monitors e-mails to ensure that its systems operate effectively and to minimise the risk of viruses.*

---

**From:** requests.utilitysolutions@atkinsglobal.com <requests.utilitysolutions@atkinsglobal.com>  
**Sent:** 17 March 2021 11:32  
**Cc:** requests.utilitysolutions@atkinsglobal.com





We have checked CityFibre's website and in this instance your area is not affected.



**From:** Plantenquiries <Plantenquiries@instalcom.co.uk>  
**Sent:** 22 March 2021 17:35  
**To:** Utility Solutions GDC Requests  
**Subject:** E03-21-6611 RE: Plant Enquiry - 94066 - Site off Penallta Road, Ystrad Mynach, Hengoed - Please respond by 06/04/2021

Dear Sir or Madam,

Thank you for your plant enquiry below.

We can confirm that Lumen Technologies (formerly CenturyLink Communications UK Limited, Level 3, Global Crossing (UK) Ltd, Global Crossing PEC, Fibernet UK Ltd and Fibrespan Ltd) do not have any apparatus within the indicated works area.

Instalcom responds to plant enquiries for all of the above and therefore you only need send one plant enquiry to cover all of these companies.

**Please note that this response is only valid for 3 months. If your works do not commence within this time period, please resubmit your plant enquiry for assessment before any works commence.**

Regards

Plant Enquiries Dept  
Instalcom Limited  
Borehamwood Ind. Park  
Rowley Lane  
Borehamwood  
WD6 5PZ

Office: +44 (0)208 731 4613  
Fax: +44 (0)208 731 4601  
Email: [plantenquiries@instalcom.co.uk](mailto:plantenquiries@instalcom.co.uk)  
Web: <http://www.instalcom.co.uk>



---

**From:** requests.utilitysolutions@atkinsglobal.com <requests.utilitysolutions@atkinsglobal.com>  
**Sent:** 17 March 2021 11:32  
**Cc:** requests.utilitysolutions@atkinsglobal.com  
**Subject:** Plant Enquiry - 94066 - Site off Penallta Road, Ystrad Mynach, Hengoed - Please respond by 06/04/2021



**From:** Plant Enquiries <plantenquiries@lastmile-uk.com>  
**Sent:** 17 March 2021 18:13  
**To:** Utility Solutions GDC Requests  
**Subject:** RE: Plant Enquiry - 94066 - Site off Penallta Road, Ystrad Mynach, Hengoed - Please respond by 06/04/2021

Dear Sir/Madam,

Thank you for submitting your recent plant enquiry.

Based on the information provided, I can confirm that Last Mile **does not** have any plant within the area(s) specified in your request.

If you require further assistance with outstanding enquiries, please call 03300 587 443.

Please ensure all plant enquiries are sent to [plantenquiries@lastmile-uk.com](mailto:plantenquiries@lastmile-uk.com)

Regards



#### Plant Enquiries

e: [plantenquiries@lastmile-uk.com](mailto:plantenquiries@lastmile-uk.com) | w: [www.energetics-uk.com](http://www.energetics-uk.com)  
a: Fenick House, Lister Way, Hamilton International Techn



---

**From:** requests.utilitysolutions@atkinglobal.com <requests.utilitysolutions@atkinglobal.com>  
**Sent:** 17 March 2021 11:32  
**Cc:** requests.utilitysolutions@atkinglobal.com  
**Subject:** Plant Enquiry - 94066 - Site off Penallta Road, Ystrad Mynach, Hengoed - Please respond by 06/04/2021

Our Reference: 94066  
Site Name: Site off Penallta Road, Ystrad Mynach, Hengoed  
Works Description: Development Appraisal  
Site Grid References: 313946 195663,314066 195570,313906 195656,314054 195776,314047 195549

To whom it may concern,

Please find enclosed a plant enquiry for your attention.

**We request plans showing the location of your company's affected plant in relation to the entire site area shown within the boundary on the attached map. Grid references and postcodes relative to the site boundary are provided on the attached map to help you locate the site.**

Within your response please quote our reference number and the name of the site shown above. If you do not have any apparatus in this area, please could you send written confirmation to declare that no apparatus is affected. Please also include information relating to the use and location of Radio Frequency Identification Devices (RFIDs) where available.



**From:** Dain Fuller <Dain.Fuller@networkrail.co.uk> on behalf of OP Buried Services Enquiries <OPBuriedServicesEnquiries@networkrail.co.uk>  
**Sent:** 17 March 2021 17:18  
**To:** Utility Solutions GDC Requests  
**Subject:** RE: Plant Enquiry - 94066 - Site off Penallta Road, Ystrad Mynach, Hengoed - Please respond by 06/04/2021

OFFICIAL

Dear Sir/Madam,

With regards to your enquiry, Network Rail does not believe there is any Network Rail owned apparatus or underground services within the area you have defined. As there is always the possibility that new works could be planned and undertaken in this area by Network Rail this information is valid as at today's date and is supplied for general guidance only.

Please be aware that this response is based on Network Rail's records and knowledge and no guarantee can be given regarding accuracy or completeness. CAT scans, safe digging practices (as contained in HSE publications) and other appropriate investigative techniques should always be carried out.

There may be other apparatus or underground services owned or operated by Utility Companies and accordingly you should contact individual utilities for information.

If, in connection with your investigations and/or work, you become aware of Network Rail apparatus or underground services within your area of work, please ensure these are notified to our Asset Protection team via the following link as a matter of urgency so that appropriate measures for avoidance of risk and damage can be put in place.

Contact details can be found in the following link: [Network Rail Asset Protection Teams](#)

If you require any further clarification on any of the information provided by the team, please contact [opburiedservicesenquiries@networkrail.co.uk](mailto:opburiedservicesenquiries@networkrail.co.uk).

Regards,

**Dain Fuller**

Worksite Survey Manager



**Worksite Survey | Asset Information Services**

National Records Centre | Audax Road | York YO30 4US

**W:** [www.networkrail.co.uk](http://www.networkrail.co.uk)

*At Network Rail we work flexibly – so whilst it suits me to email now, I do not expect a response or action outside of your own working hours*



**From:** NRSWA <nrswa.nrswa@sky.uk>  
**Sent:** 18 March 2021 22:01  
**To:** Utility Solutions GDC Requests  
**Subject:** Plant Enquiry - 94066 - Site off Penallta Road, Ystrad Mynach, Hengoed - 06/04/2021



Thank you for your enquiry.

Please be advised that Sky Telecommunications Services Ltd will not be affected by your proposal.

Best endeavours have been made to ensure accuracy, however if you require further information, please contact us by email at [nrswa@sky.uk](mailto:nrswa@sky.uk).

Regards



NRSWA Department  
Sky UK - Technology - Operations

 [nrswa@sky.uk](mailto:nrswa@sky.uk)  +44 2070323234

---

**From:** requests.utilitysolutions@atkinsglobal.com <requests.utilitysolutions@atkinsglobal.com>  
**Sent:** 17 March 2021 11:32  
**Cc:** requests.utilitysolutions@atkinsglobal.com  
**Subject:** [EXTERNAL] Plant Enquiry - 94066 - Site off Penallta Road, Ystrad Mynach, Hengoed - Please respond by 06/04/2021

Our Reference: 94066  
Site Name: Site off Penallta Road, Ystrad Mynach, Hengoed  
Works Description: Development Appraisal  
Site Grid References: 313946 195663,314066 195570,313906 195656,314054 195776,314047 195549

To whom it may concern,

Please find enclosed a plant enquiry for your attention.



**From:** UK OSP-Team <osp-team@uk.verizon.com>  
**Sent:** 18 March 2021 00:08  
**To:** Utility Solutions GDC Requests  
**Cc:** UK OSP-Team  
**Subject:** RE: [E] Plant Enquiry - 94066 - Site off Penallta Road, Ystrad Mynach, Hengoed - Please respond by 06/04/2021

Dear Sir/Madam

Verizon is a licensed Statutory Undertaker.

We have reviewed your plans and have determined that Verizon (Formally known as MCI WorldCom, MFS) has no apparatus in the areas concerned.

If you have any further queries please do not hesitate to get in touch.

Yours faithfully

Plant Protection Officer E.mail osp-team@uk.verizon.com

**From:** requests.utilitysolutions@atkingglobal.com  
[mailto:requests.utilitysolutions@atkingglobal.com]  
**Sent:** 17 March, 2021 11:32 AM  
**Cc:** requests.utilitysolutions@atkingglobal.com  
**Subject:** [E] Plant Enquiry - 94066 - Site off Penallta Road, Ystrad Mynach, Hengoed - Please respond by 06/04/2021

Our Reference: 94066  
Site Name: Site off Penallta Road, Ystrad Mynach, Hengoed  
Works Description: Development Appraisal  
Site Grid References: 313946 195663,314066 195570,313906 195656,314054 195776,314047 195549

To whom it may concern,

Please find enclosed a plant enquiry for your attention.

**We request plans showing the location of your company's affected plant in relation to the entire site area shown within the boundary on the attached map. Grid references and postcodes relative to the site boundary are provided on the attached map to help you locate the site.**

Within your response please quote our reference number and the name of the site shown above. If you do not have any apparatus in this area, please could you send written confirmation to declare that no apparatus is affected. Please also include information relating to the use and location of Radio Frequency Identification Devices (RFIDs) where available.

**It would be greatly appreciated if you could respond to this enquiry by 06/04/2021.** Your prompt response will assist with our clients proposals in your interests of plant protection.





As of 17/03/2021, Virgin Media are deemed to be not affected by your site.

An additional response from Virgin Media in relation to your area of interest is available on request from Landmark Customer Services with prices starting from £43 + VAT.

No liability of any kind whatsoever is accepted by Landmark Information Group, its servants or agents, for any error or omission in respect of information contained in this report. The underground services must be verified and established on site before any excavation is carried out.



**From:** Joi, Ravina  
**Sent:** 27 March 2021 15:01  
**To:** Utility Solutions GDC Requests  
**Subject:** RE: Plant Enquiry - 94066 - Site off Penallta Road, Ystrad Mynach, Hengoed - Please respond by 06/04/2021

Please accept this email as confirmation that Vodafone: Fixed **does not** have apparatus within the vicinity of your proposed works detailed below.

Many thanks.

Plant Enquiries Team  
T: +44 (0)1454 662881  
E: [osm.enquiries@atkinsglobal.com](mailto:osm.enquiries@atkinsglobal.com)

This response is made only in respect to electronic communications apparatus forming part of the Vodafone Limited electronic communications network formerly being part of the electronic communications networks of Cable & Wireless UK (now re-named Vodafone Enterprise UK), Energis Communications Limited, Thus Group Holdings Limited and Your Communications Limited.

ATKINS working on behalf of Vodafone: Fixed



#### **PLEASE NOTE:**

The information given is indicative only. No warranty is made as to its accuracy. This information must not be solely relied upon in the event of excavation or other works carried out in the vicinity of Vodafone plant. No liability of any kind whatsoever is accepted by Vodafone, its servants, or agents, for any error or omission in respect of information contained on this information. The actual position of underground services must be verified and established on site before any mechanical plant is used. Authorities and contractors will be held liable for the full cost of repairs to Vodafone's apparatus and all claims made against them by Third parties as a result of any interference or damage.

#### **IMPORTANT - PLEASE READ:**

Diversification works may be necessary if the existing line of the highway/railway or its levels are altered, where apparatus is affected. Where apparatus is affected and requires diversion, you must submit draft details of the proposed scheme with a request for a 'C3 Budget Estimate' to [c3requests@vodafone.com](mailto:c3requests@vodafone.com). These estimates should be provided by Vodafone normally within 20 working days from receipt of your request. Please include proof of this C2 response when requesting a C3 (using the 'forward' option).



Please consider the environment before printing this e-mail

---

**From:** [requests.utilitysolutions@atkinsglobal.com](mailto:requests.utilitysolutions@atkinsglobal.com) <[requests.utilitysolutions@atkinsglobal.com](mailto:requests.utilitysolutions@atkinsglobal.com)>  
**Sent:** 17 March 2021 17:02  
**Cc:** Utility Solutions GDC Requests <[requests.utilitysolutions@atkinsglobal.com](mailto:requests.utilitysolutions@atkinsglobal.com)>  
**Subject:** Plant Enquiry - 94066 - Site off Penallta Road, Ystrad Mynach, Hengoed - Please respond by 06/04/2021

Our Reference: 94066  
Site Name: Site off Penallta Road, Ystrad Mynach, Hengoed  
Works Description: Development Appraisal  
Site Grid References: 313946 195663,314066 195570,313906 195656,314054 195776,314047 195549

To whom it may concern,

Please find enclosed a plant enquiry for your attention.



**Company Address**

Wales and West Utilities Ltd,  
Wales and West House,  
Spooner Close, Celtic,  
Springs, Coedkernew,  
Newport, NP10 8FZ

Our Ref: 21632395      LM 94066/BRK

Monday, 22 March 2021

Christina Elliott  
500 Park Avenue Aztec West  
Almondsbury  
Bristol  
BS32 4RZ

Dear Christina Elliott

Thank you for contacting us regarding Wales & West Utilities equipment at the above site.

According to our mains records Wales & West Utilities has no apparatus in the area of your enquiry. However Gas pipes owned by other GT's and also privately owned may be present in this area. Information with regard to such pipes should be obtained from the owners.

Safe digging practices, in accordance with HS(G)47, Avoiding Danger from underground services must be used to verify and establish the actual position of mains, pipes, services and other apparatus on site before any mechanical plant is used. It is your responsibility to ensure that this information is provided to all persons (either direct labour or contractors) working for you on or near gas apparatus. Safe working procedures should be defined and practiced.

If you require advice in connection with your proposals please contact the relevant number below.

Yours sincerely,  
WWU Dig Team

**Gas Emergency Number:**

In an emergency call 0800 111 999, 24 hours a day.

**Mapping Enquiries:**

If you have an enquiry relating to this letter or the attached map plan, please contact us using the following information:

Telephone      02920 278912  
Email            dig@wwutilities.co.uk

**General Enquiries:**

If you have a general enquiry, please call us on the following number


All areas      0800 912 29 99

**LinesearchbeforeUdig:**

If you have an enquiry relating to the use of the LinesearchbeforeUdig website please contact LinesearchbeforeUdig using the following information:

Telephone      0845 437 7365  
Email            enquiries@linesearchbeforeudig.co.uk  
Website        www.linesearchbeforeudig.co.uk



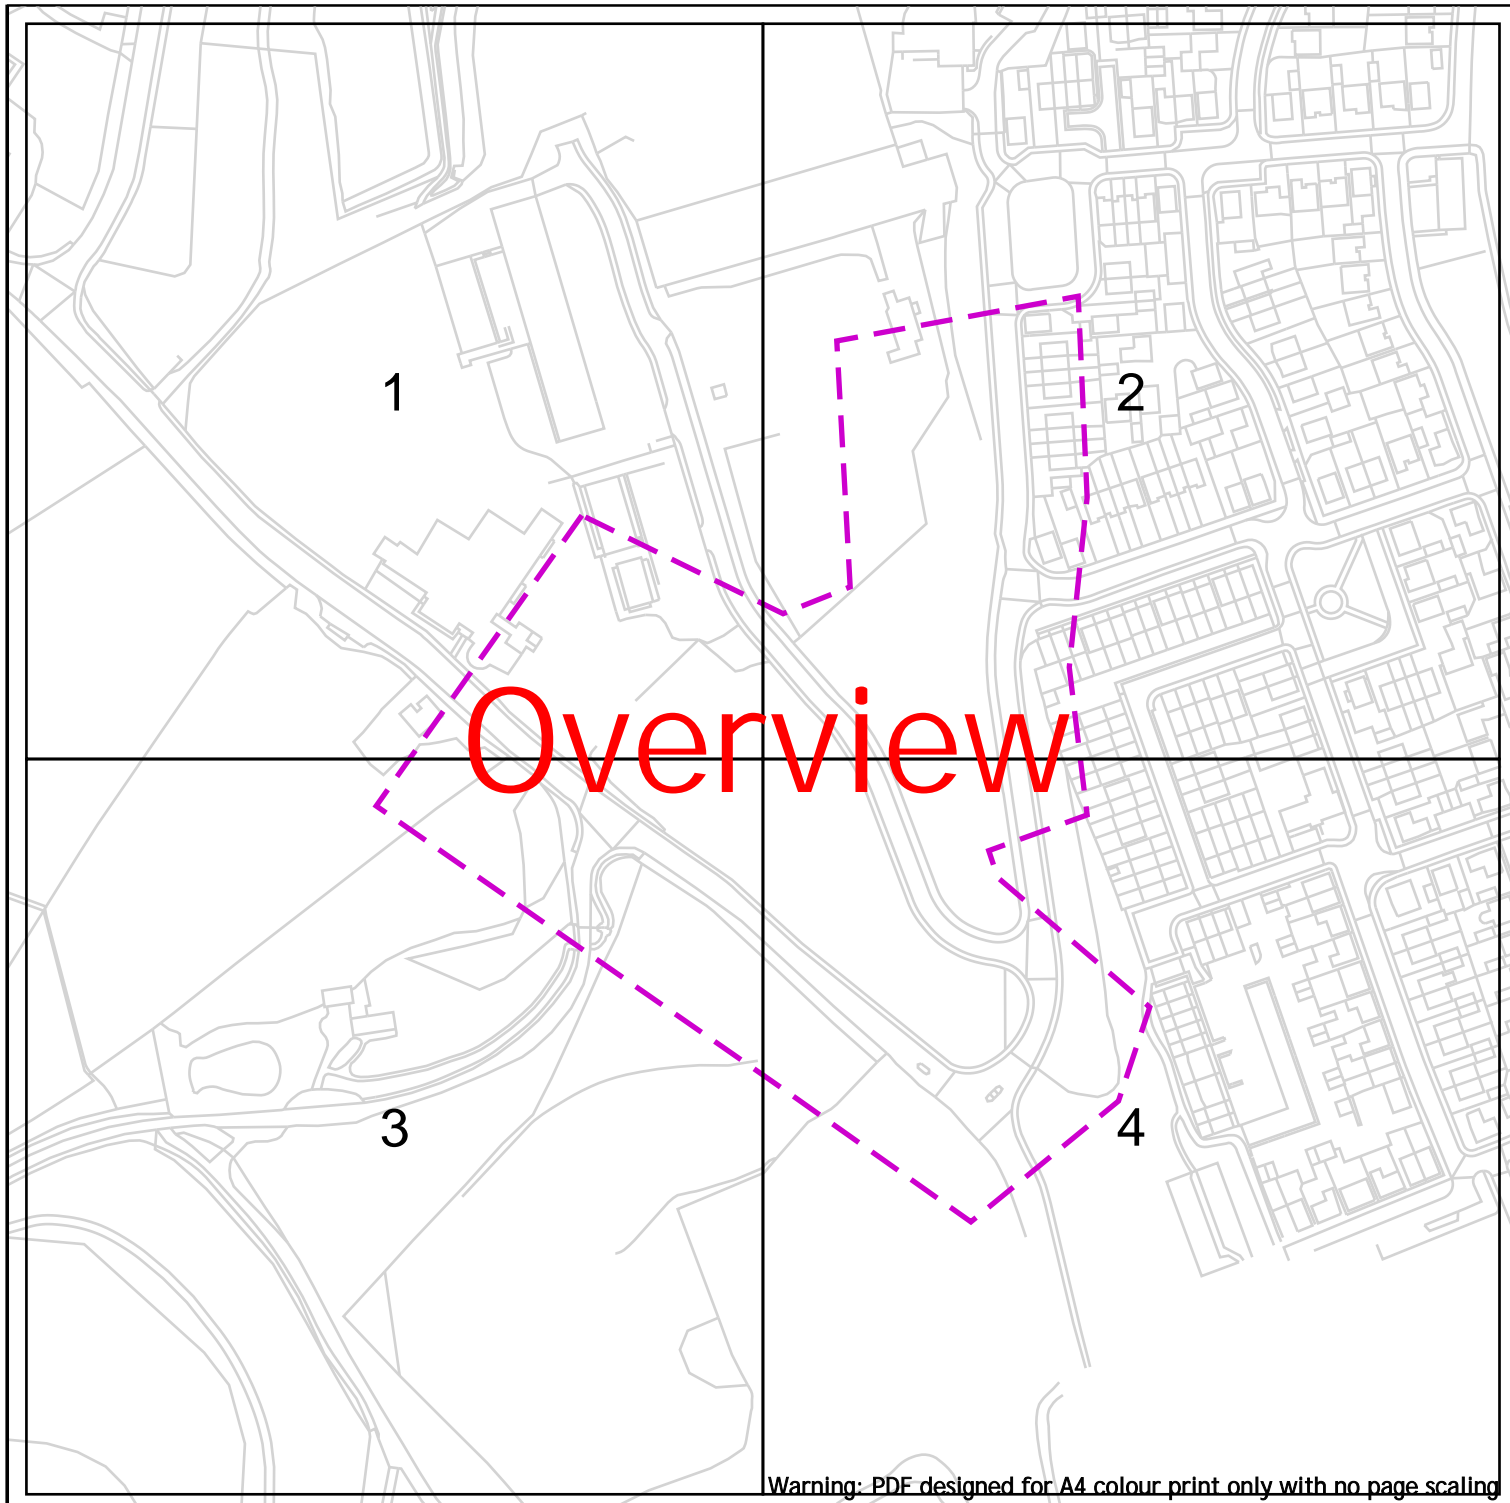

Warning: PDF designed for A4 colour print only with no page scaling



#### Contact Us

##### Mapping Enquiries:

All areas 02920 278 912

##### General Enquiries:

All areas 0800 912 2999

#### Dig Sites

Area:



Line:



Low Pressure (LP) 21mbar – 75mbar

Medium Pressure (MP) 350mbar – 2bar

Intermediate Pressure (IP) 2bar – 7bar

High Pressure (HP) >7bar

Low Pressure (LP) 21mbar – 75mbar

Medium Pressure (MP) 350mbar – 2bar

Intermediate Pressure (IP) 2bar – 7bar

High Pressure (HP) >7bar



Change of Diameter



End Cap



Depth of cover



Line/Fire Valve



Governor Station

Date Requested: 22/03/2021  
Job Reference: 21632395  
Site Location: 313973 195662  
Requested by: Ms Christina Elliott

Your Scheme/Reference: LM  
94066/BRK

#### IMPORTANT NOTICES

- This information is given as a guide only and its accuracy cannot be guaranteed
- The plan only shows those pipes owned by Wales & West Utilities (WWU) as its role as a licensed Gas Transporter
- Service pipes, valves, syphons, stub connections etc. may not be shown but their presence should be anticipated
- You must use safe digging practices in accordance with H5(G)47 to establish the actual position of mains, services and other apparatus before any mechanical excavation is used
- It is your responsibility to ensure this information is provided to all persons working near our plant
- If in doubt call the WWU dig team on 02920 27891

**Report damage immediately – KEEP EVERYONE AWAY FROM THE AREA**  
**0800 111 999**

Scale: 1:2563 (When plotted at A4)

Crown Copyright © - Reproduced by permission of Ordnance Survey on behalf of HMSO. And database right 2020. All rights reserved. Ordnance Survey Licence number 0100044308.

Smell gas?  
Call the Gas Emergency Service on  
**0800 111 999**

**Dial**  
before  
you dig


We need  
10 days'  
notice

**Dial**  
Call **029 2027 8912**  
before you start work

**Investigate**  
Before you dig, make sure  
you know what's below.

**Go ahead**  
Do your research?  
Now you can dig safely.



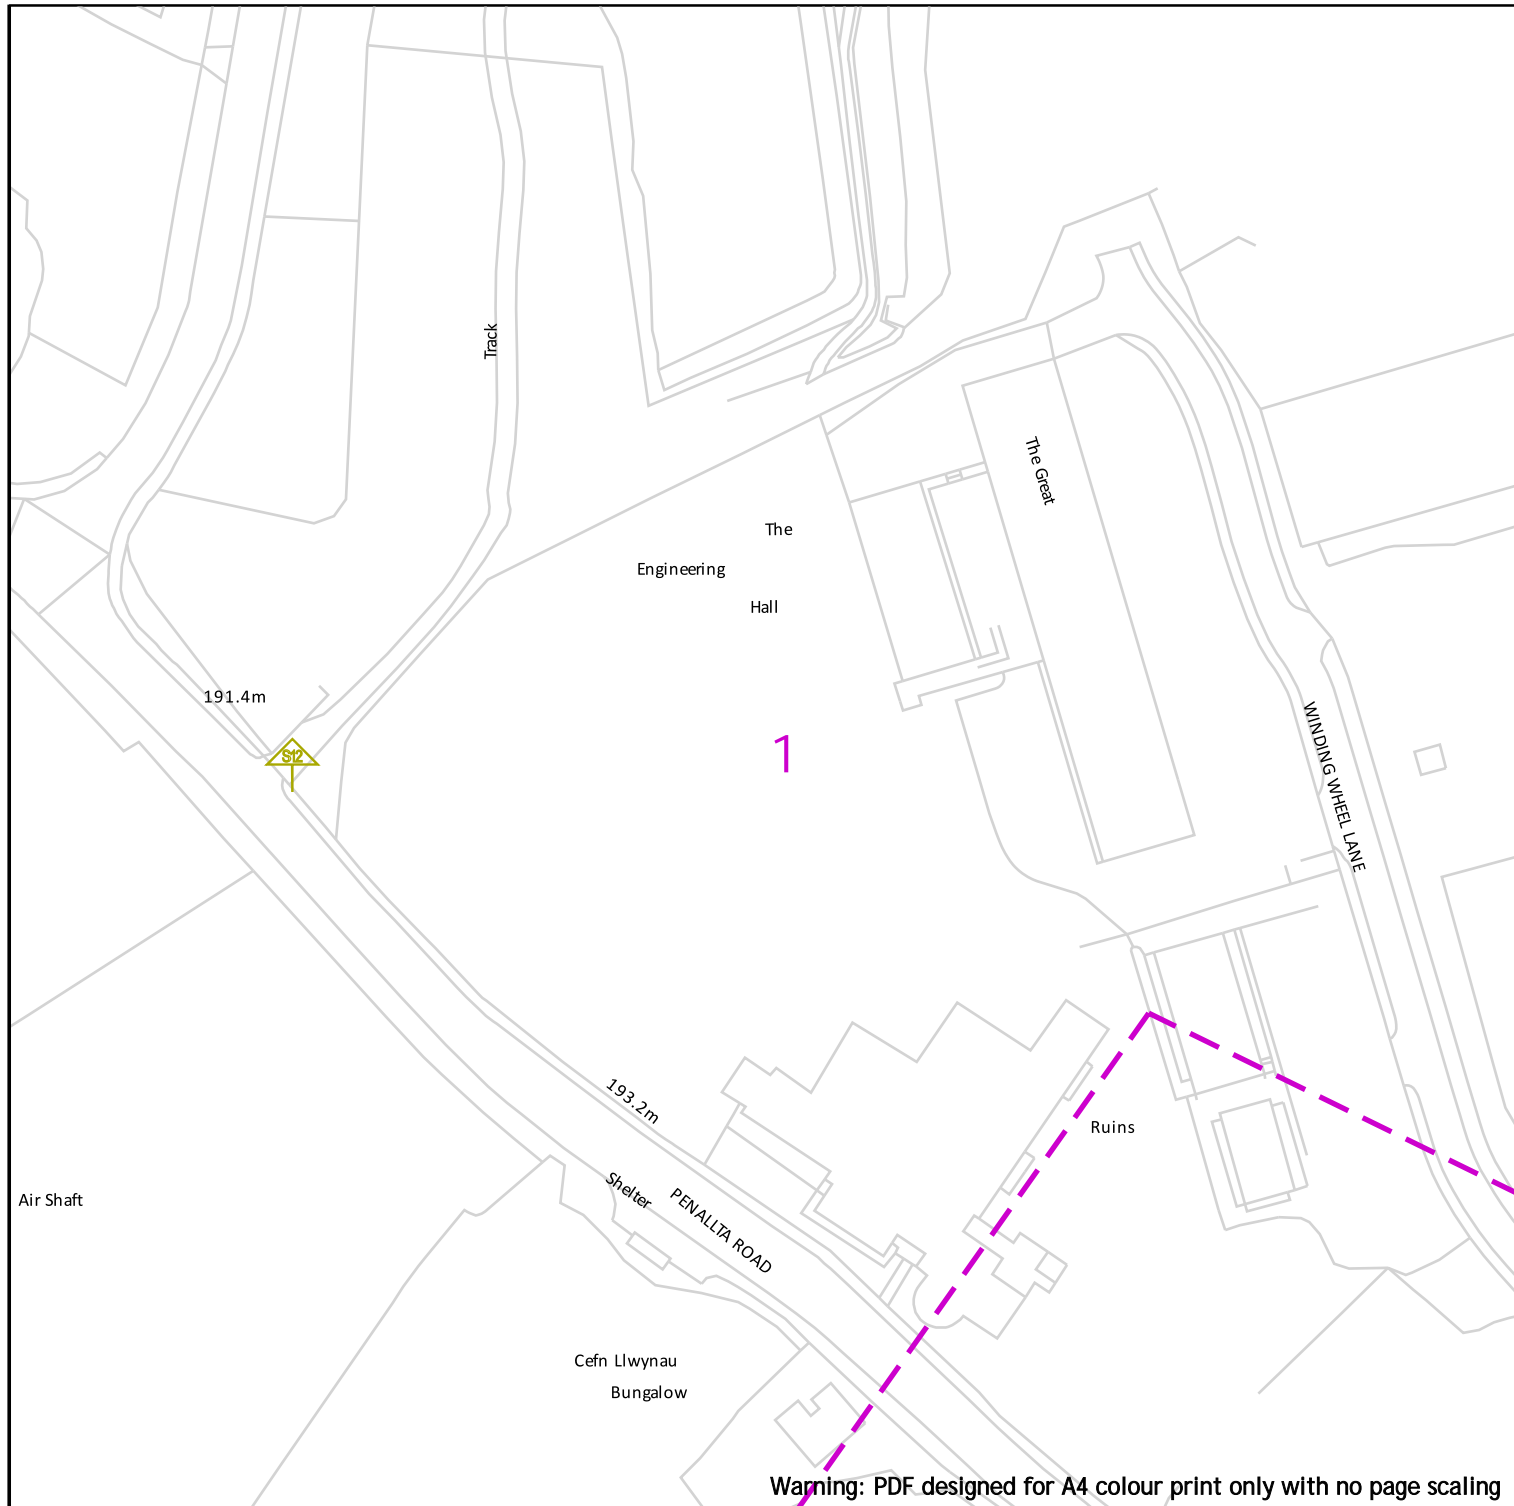

Warning: PDF designed for A4 colour print only with no page scaling



#### Contact Us

##### Mapping Enquiries:

All areas 02920 278 912

##### General Enquiries:

All areas 0800 912 2999

100m

#### Dig Sites

Area:



Line:



Low Pressure (LP) 21mbar – 75mbar

Medium Pressure (MP) 350mbar – 2bar

Intermediate Pressure (IP) 2bar – 7bar

High Pressure (HP) >7bar

Change of Diameter

End Cap

Depth of cover

Line/Fire Valve

Governor Station

#### IMPORTANT NOTICES

- This information is given as a guide only and its accuracy cannot be guaranteed
- The plan only shows those pipes owned by Wales & West Utilities (WWU) as its role as a licensed Gas Transporter
- Service pipes, valves, syphons, stub connections etc. may not be shown but their presence should be anticipated
- You must use safe digging practices in accordance with H5(G)47 to establish the actual position of mains, services and other apparatus before any mechanical excavation is used
- It is your responsibility to ensure this information is provided to all persons working near our plant
- If in doubt call the WWU dig team on 02920 27891

**Report damage immediately – KEEP EVERYONE AWAY FROM THE AREA**  
**0800 111 999**

Date Requested: 22/03/2021  
Job Reference: 21632395  
Site Location: 313973 195662  
Requested by: Ms Christina Elliott  
Your Scheme/Reference: LM 94066/BRK

Scale: 1:1250 (When plotted at A4)

Crown Copyright © - Reproduced by permission of Ordnance Survey on behalf of HMSO. And database right 2020. All rights reserved. Ordnance Survey Licence number 0100044308.

**Dial before you dig**


Call 029 2027 8912 before you start work

**Investigate**  
Before you dig, make sure you know what's below.

**Go ahead**  
Done your research? Now you can dig safely.

We need 10 days' notice



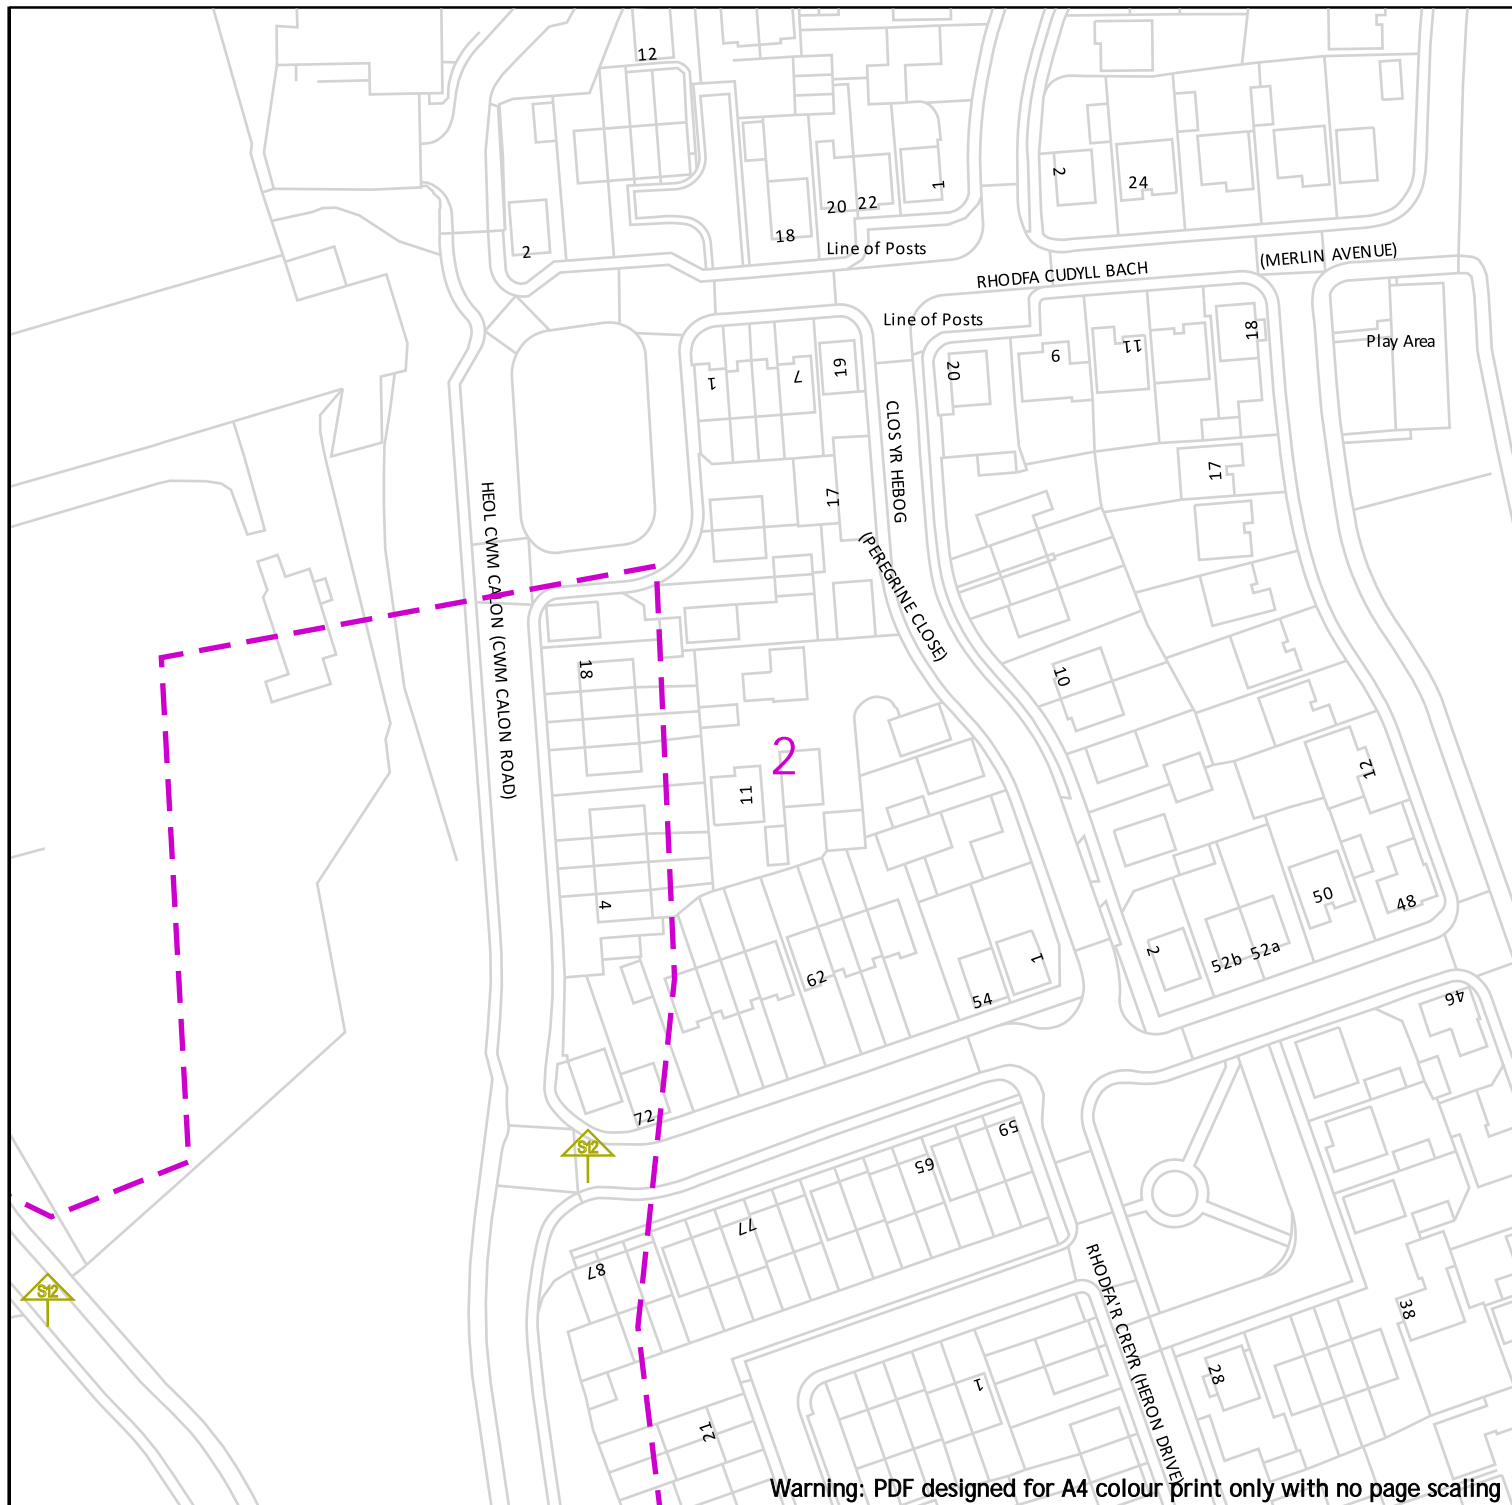

#### Contact Us

##### Mapping Enquiries:

All areas 02920 278 912

##### General Enquiries:

All areas 0800 912 2999

#### Dig Sites

Area:

Line:

	Low Pressure (LP) 21mbar – 75mbar
	Medium Pressure (MP) 350mbar – 2bar
	Intermediate Pressure (IP) 2bar – 7bar
	High Pressure (HP) >7bar



Change of Diameter



End Cap



Depth of cover



Line/Fire Valve



Governor Station

Date Requested: 22/03/2021  
Job Reference: 21632395  
Site Location: 313973 195662  
Requested by: Ms Christina Elliott  
  
Your Scheme/Reference: LM  
94066/BRK

#### IMPORTANT NOTICES

- This information is given as a guide only and its accuracy cannot be guaranteed
- The plan only shows those pipes owned by Wales & West Utilities (WWU) as its role as a licensed Gas Transporter
- Service pipes, valves, syphons, stub connections etc. may not be shown but their presence should be anticipated
- You must use safe digging practices in accordance with H5(G)47 to establish the actual position of mains, services and other apparatus before any mechanical excavation is used
- It is your responsibility to ensure this information is provided to all persons working near our plant
- If in doubt call the WWU dig team on 02920 27891

**Report damage immediately – KEEP EVERYONE AWAY FROM THE AREA**  
**0800 111 999**

Scale: 1:1250 (When plotted at A4)

Crown Copyright © - Reproduced by permission of Ordnance Survey on behalf of HMSO. And database right 2020. All rights reserved. Ordnance Survey Licence number 0100044308.

**Smell gas?**  
Call the Gas Emergency Service on  
**0800 111 999**

**Dial**  
before  
you dig


We need  
10 days'  
notice










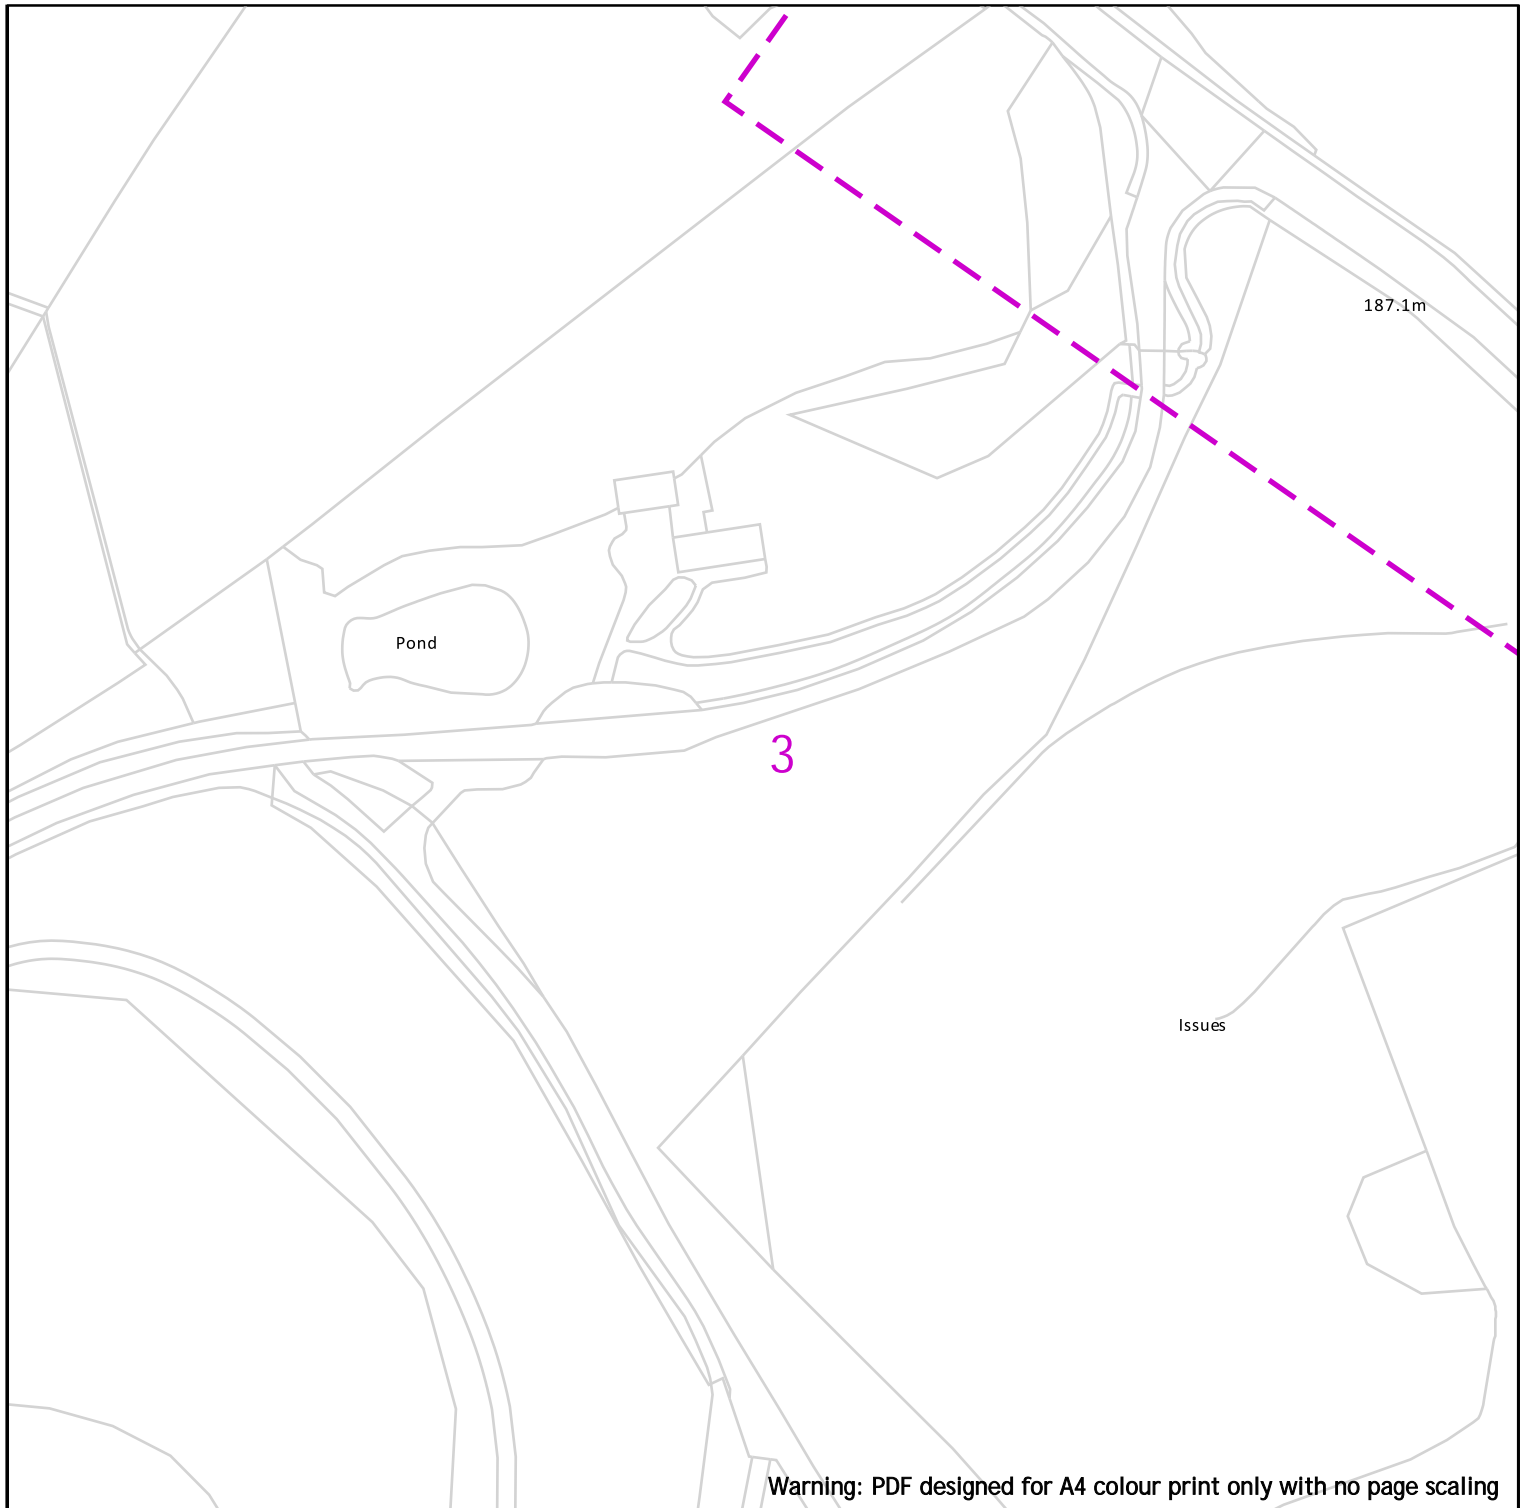






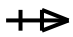








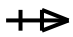





**Dial**  
Call **029 2027 8912**  
before you start work

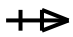**Investigate**  
Before you dig, make sure  
you know what's below.


**Go ahead**  
Done your research?  
Now you can dig safely.





 <p><b>Contact Us</b>  <b>Mapping Enquiries:</b>  All areas 02920 278 912  <b>General Enquiries:</b>  All areas 0800 912 2999</p>	<p>Warning: PDF designed for A4 colour print only with no page scaling</p> <p>100m</p> <p><b>Dig Sites</b>      Area:       Line: </p> <table border="0"> <tr> <td></td> <td>Low Pressure (LP) 21mbar – 75mbar</td> <td></td> <td>Change of Diameter</td> <td></td> <td>Line/Fire Valve</td> </tr> <tr> <td></td> <td>Medium Pressure (MP) 350mbar – 2bar</td> <td></td> <td>End Cap</td> <td></td> <td>Governor Station</td> </tr> <tr> <td></td> <td>Intermediate Pressure (IP) 2bar – 7bar</td> <td></td> <td>Depth of cover</td> <td></td> <td></td> </tr> <tr> <td></td> <td>High Pressure (HP) &gt;7bar</td> <td></td> <td></td> <td></td> <td></td> </tr> </table>		Low Pressure (LP) 21mbar – 75mbar		Change of Diameter		Line/Fire Valve		Medium Pressure (MP) 350mbar – 2bar		End Cap		Governor Station		Intermediate Pressure (IP) 2bar – 7bar		Depth of cover				High Pressure (HP) >7bar					
	Low Pressure (LP) 21mbar – 75mbar		Change of Diameter		Line/Fire Valve																					
	Medium Pressure (MP) 350mbar – 2bar		End Cap		Governor Station																					
	Intermediate Pressure (IP) 2bar – 7bar		Depth of cover																							
	High Pressure (HP) >7bar																									
<p>Date Requested: 22/03/2021  Job Reference: 21632395  Site Location: 313973 195662  Requested by: Ms Christina Elliott    Your Scheme/Reference: LM 94066/BRK</p>	<p><b>IMPORTANT NOTICES</b></p> <ul style="list-style-type: none"> <li>This information is given as a guide only and its accuracy cannot be guaranteed</li> <li>The plan only shows those pipes owned by Wales &amp; West Utilities (WWU) as its role as a licensed Gas Transporter</li> <li>Service pipes, valves, syphons, stub connections etc. may not be shown but their presence should be anticipated</li> <li>You must use safe digging practices in accordance with HS(G)47 to establish the actual position of mains, services and other apparatus before any mechanical excavation is used</li> <li>It is your responsibility to ensure this information is provided to all persons working near our plant</li> <li>If in doubt call the WWU dig team on 02920 27891</li> </ul> <p><b>Report damage immediately – KEEP EVERYONE AWAY FROM THE AREA</b>  <b>0800 111 999</b></p>	 <p><b>Smell gas?</b>  Call the Gas Emergency Service on  <b>0800 111 999</b></p> <p><b>Dial</b>  before  you dig</p> <p><b>Go ahead</b>  Before you dig, make sure  you know what's below.  Do your research!  Now you can dig safely.</p>																								
<p>Scale: 1:1250 (When plotted at A4)</p>	<p>Crown Copyright © - Reproduced by permission of Ordnance Survey on behalf of HMSO. And database right 2020. All rights reserved. Ordnance Survey Licence number 0100044308.</p>																									



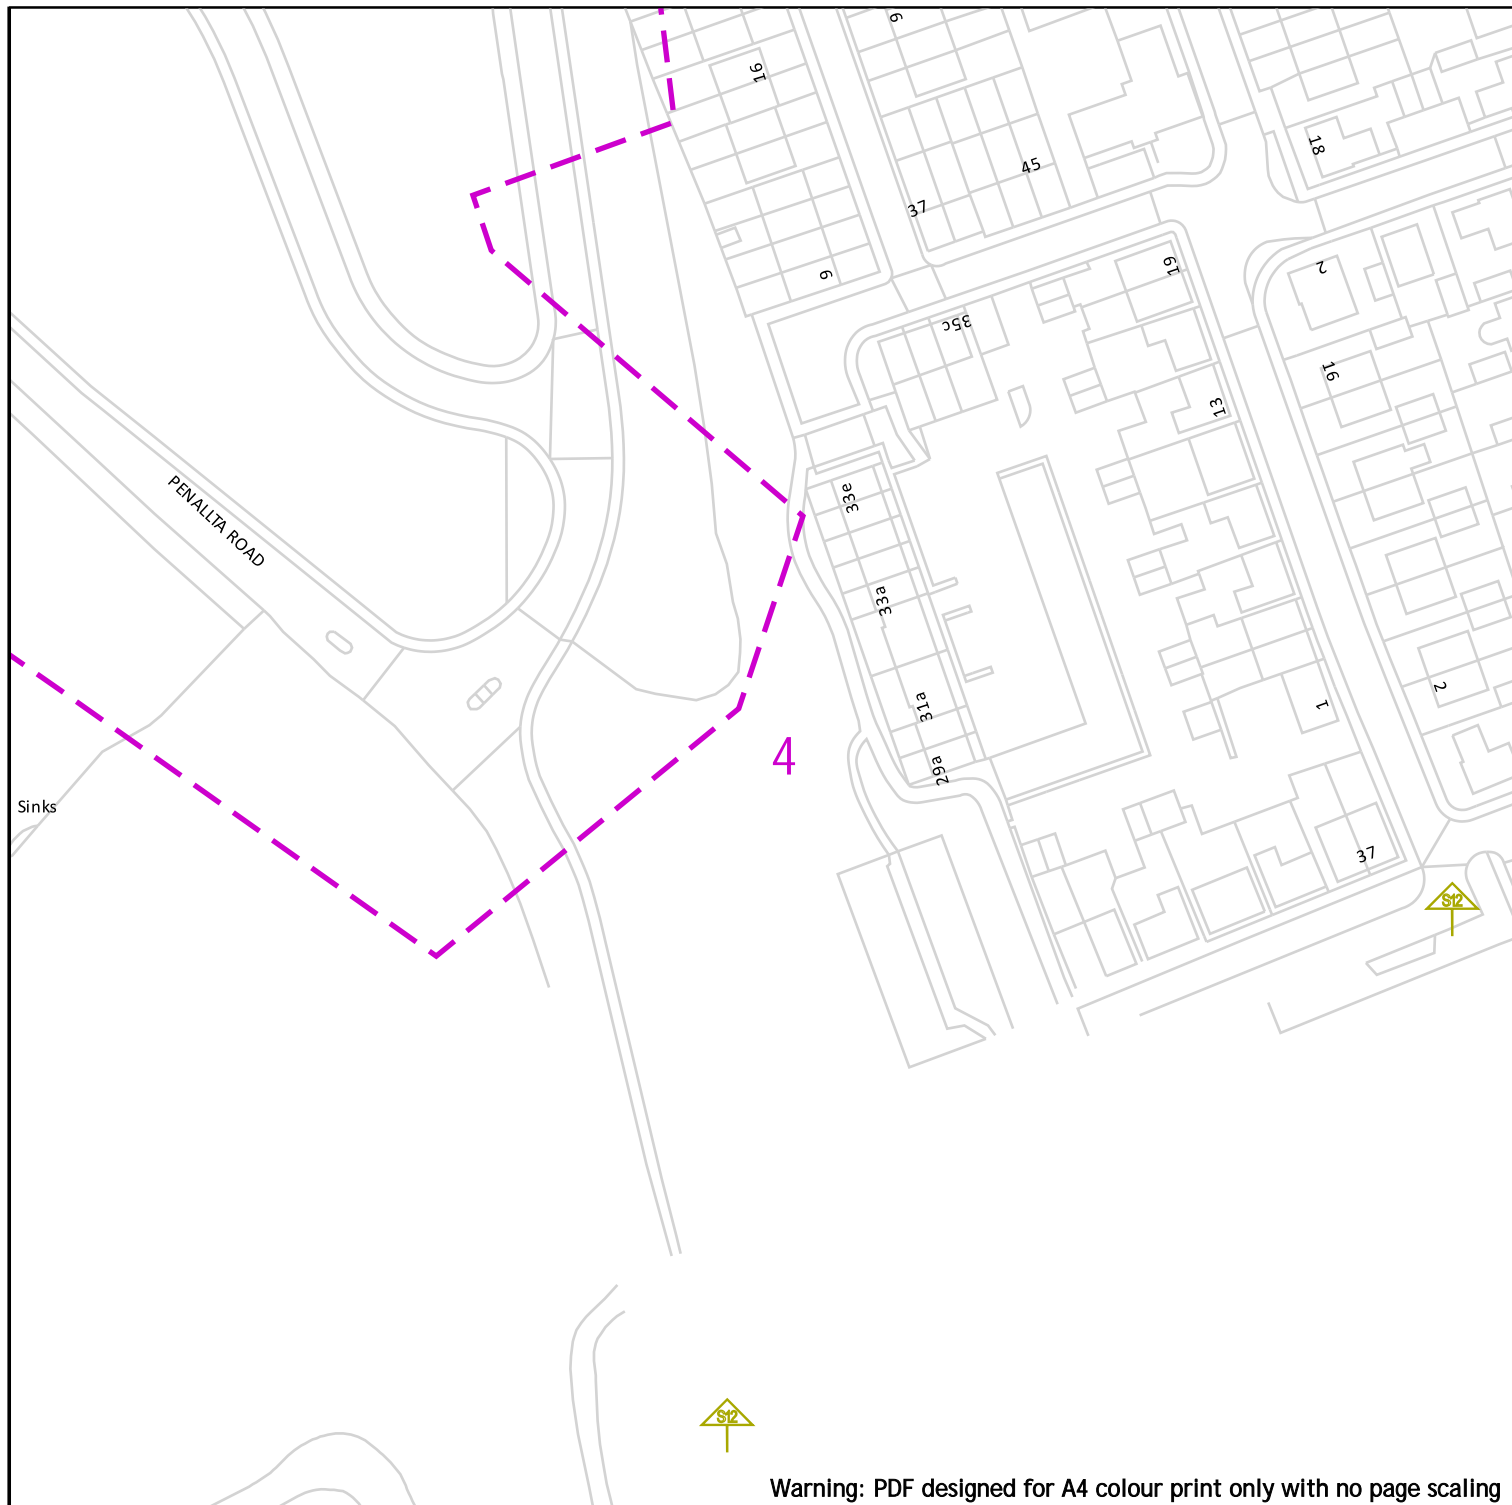

Warning: PDF designed for A4 colour print only with no page scaling



#### Contact Us

##### Mapping Enquiries:

All areas 02920 278 912

##### General Enquiries:

All areas 0800 912 2999

100m

#### Dig Sites

Area:

Line:

- Low Pressure (LP) 21mbar – 75mbar
- Medium Pressure (MP) 350mbar – 2bar
- Intermediate Pressure (IP) 2bar – 7bar
- High Pressure (HP) >7bar



Change of Diameter



End Cap



Depth of cover



Line/Fire Valve



Governor Station

#### IMPORTANT NOTICES

- This information is given as a guide only and its accuracy cannot be guaranteed
- The plan only shows those pipes owned by Wales & West Utilities (WUU) as its role as a licensed Gas Transporter
- Service pipes, valves, syphons, stub connections etc. may not be shown but their presence should be anticipated
- You must use safe digging practices in accordance with H5(G)47 to establish the actual position of mains, services and other apparatus before any mechanical excavation is used
- It is your responsibility to ensure this information is provided to all persons working near our plant
- If in doubt call the WUU dig team on 02920 27891

**Report damage immediately – KEEP EVERYONE AWAY FROM THE AREA**  
**0800 111 999**

Date Requested: 22/03/2021  
Job Reference: 21632395  
Site Location: 313973 195662  
Requested by: Ms Christina Elliott  
Your Scheme/Reference: LM  
94066/BRK

Scale: 1:1250 (When plotted at A4)

Crown Copyright © - Reproduced by permission of Ordnance Survey on behalf of HMSO. And database right 2020. All rights reserved. Ordnance Survey Licence number 0100044308.

**Smell gas?**  
Call the Gas Emergency Service on  
**0800 111 999**

**Dial before you dig**

**Dial**  
Call **020 2027 8912**  
before you start work

**Investigate**  
Before you dig, make sure  
you know what's below.

**Go ahead**  
Do your research?  
Now you can dig safely.

We need 10 days' notice



## Important Consumer Protection Information

This search has been produced by Landmark Information Group Ltd, Imperium, Imperial Way, Reading, Berkshire, RG2 0TD, Tel: 0844 844 9966 Fax: 0844 844 9980 Email: [helpdesk@landmark.co.uk](mailto:helpdesk@landmark.co.uk)

Landmark adheres to the Conveyancing Information Executive (CIE) standards.

### The Standards:

- Conveyancing Information Executive Members shall act in a professional and honest manner at all times in line with the Conveyancing Information Executive Standards and carry out the delivery of the Search with integrity and due care and skill.
- Compliance with the Conveyancing Information Executive Standards will be a condition within the Conveyancing Information Executive Member's Terms and Conditions.
- Conveyancing Information Executive Members will promote the benefits of and deliver the Search to the agreed standards and in the best interests of the customer and associated parties.
- The standards can be seen here: <http://www.conveyinfoexec.com>

### Complaints

If you have a query or complaint about your search, you should raise it directly with the search firm, and if appropriate ask for any complaint to be considered under their formal internal complaints procedure. If you remain dissatisfied with the firm's final response, after your complaint has been formally considered, or if the firm has exceeded the response timescales, you may refer your complaint for consideration under The Property Ombudsman scheme (TPOs). The Ombudsman can award up to £5,000 to you if the Ombudsman finds that you have suffered actual financial loss and/or aggravation, distress or inconvenience as a result of your search provider failing to keep to the Standards.

Please note that all queries or complaints regarding your search should be directed to your search provider in the first instance, not to TPO.

### TPOs Contact Details:

The Property Ombudsman scheme  
Milford House  
43-55 Milford Street  
Salisbury  
Wiltshire SP1 2BP

Tel: 01722 333306

Fax: 01722 332296

Website: [www.tpos.co.uk](http://www.tpos.co.uk)

Email: [admin@tpos.co.uk](mailto:admin@tpos.co.uk)



## Landmark Complaints Procedure

If you want to make a complaint to Landmark, we will:

- Acknowledge it within 5 working days of receipt
- Normally deal with it fully and provide a final response, in writing, within 20 working days of receipt
- Keep you informed by letter, telephone or e-mail, as you prefer, if we need more time
- Provide a final response, in writing, at the latest within 40 working days of receipt
- Liaise, at your request, with anyone acting formally on your behalf

Complaints should be sent to:

Customer Relationships Manager  
Landmark Information  
Imperium  
Imperial Way  
Reading  
RG2 0TD  
Tel: 0844 844 9966  
Email: [helpdesk@landmark.co.uk](mailto:helpdesk@landmark.co.uk)  
Fax: 0844 844 9980

If you are not satisfied with our final response, or if we exceed the response timescales, you may refer the complaint to The Property Ombudsman scheme (TPOs):

Tel: 01722 333306,

Email: [admin@tpos.co.uk](mailto:admin@tpos.co.uk)

We will co-operate fully with the Ombudsman during an investigation and comply with his final decision.