SYSTEM INTEGRATION:

* PB FURNISHED EQUIPMENT & SERVICES *

1 - SILENCER EXHAUST ELBOW
1 - SILENCER EXHAUST RAINCAP

SHIPPED LOOSE ITEMS:

1 - RAIN SHIELD, 12"ø F
1 - SET OF SILENCER BRACKETS, 30"ø
1 - BAG OF SILENCER HARDWARE
A 1 - SET OF SILENCER SUPPORTS, 107 1/2"L
A 1 - ROOF EXHAUST FAN
A 1 - SILENCER EXHAUST ASSEMBLY (ELBOW & CAP)
A 1 - ACOUSTIGRID ASSEMBLY

REVISIONS				
ZONE	LTR	DESCRIPTION	DATE	APP'D
	A	REVISED FOR PRODUCTION RELEASE (ARR)	06/18/98	BJS
	B	REVISED "AS BUILT" (ARR)	07/01/98	BJS
	C	REVISED AS BUILT (ADS)	07/27/98	BJS

NOTES:

1. SEE PB SPEC NO. 9930 FOR DETAILED DESIGN CONSTRUCTION CRITERIA
2. GENSET: G3516LE, 770KW
3. AIR FLOW BASED ON: 20,000 CFM
4. INSULATION: 3" ACOUSTIC
5. LINING: M/F PERFORATED ALUM
6. ESTIMATED SHELTER WEIGHT: TBD.
7. ESTIMATED AVERAGE 25 db(A) REDUCTION OF SOURCE NOISE MEASURED 1 METER FROM ENCLOSURE
8. SILENCER - MAKE: HARCO
   MODEL: 30110VCS12SI
   SIZE: 12"
   DIAM: 30"
   WEIGHT: 914 lbs
9. ISOLATORS - MAKE: ACE
   MODEL: 822-K
   OPER. HGT: 5 1/2"
   MTG DISTANCE: 12 1/2"
A 10. EXTERIOR COLOR: DESERT TAN

ELECTRICAL PACKAGE:

* PB FURNISHED & WIRED *
1 - PANELBOARD, 100A, 3ø, 120/208V, 24 SPACE w/ MAIN
6 - INCANDESCENT LIGHTS, 100A w/ GLOBE & GUARD
2 - 3-WAY SWITCHES (LIGHTS)
2 - DUPLEX RECEPTACLES
1 - ROOF EXHAUST FAN (7C484) w/ MOTOR STARTER
1 - HEATER, 5KW, 3ø, 208V w/ THERMOSTAT
1 - DAMPER WIRED TO PANEL
A 1 - JUNCTION BOX w/ DROP FOR JWH & GENERATOR STRIP HEATER
* FOLEY FURNISHED PB WIRED *
A 1 - BATTERY CHARGER, AC ONLY

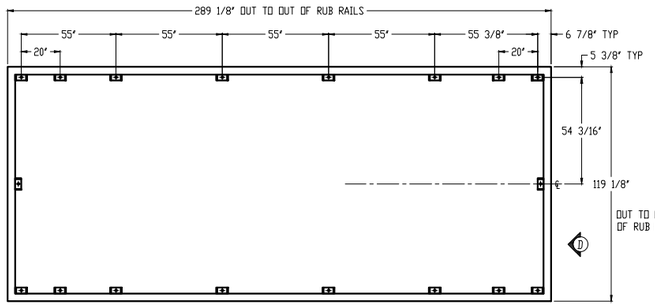

A TIEDOWN LOCATIONS

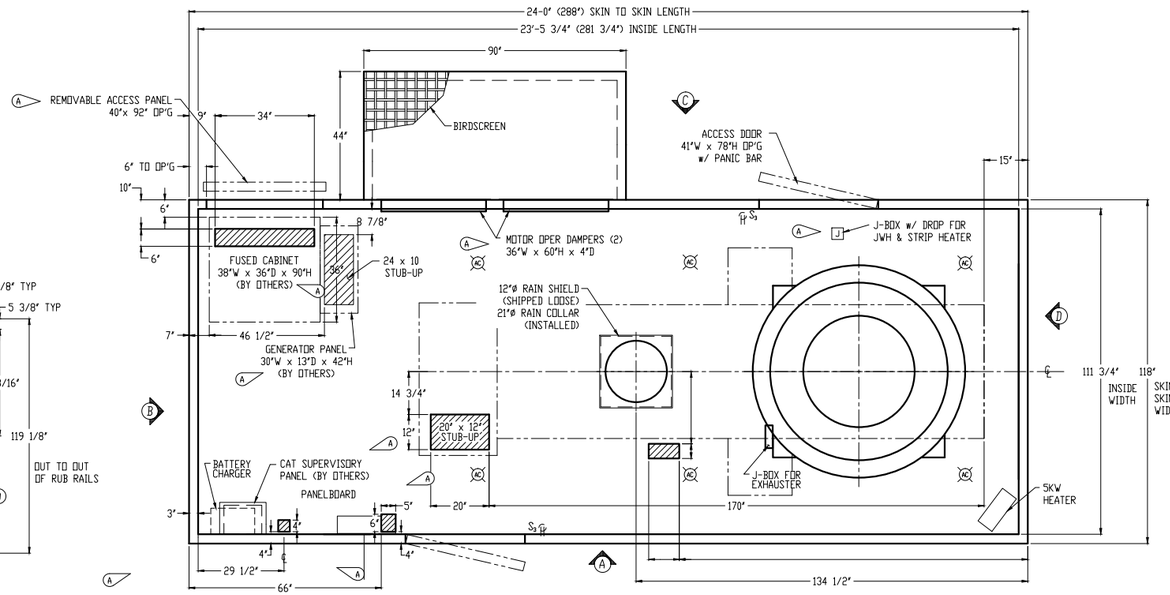

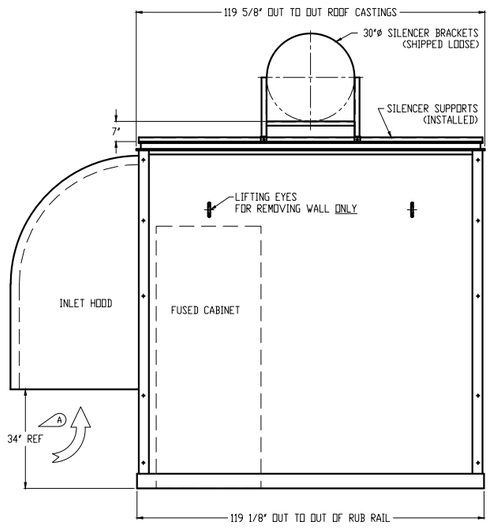

"B" END WALL
(REMOVABLE)

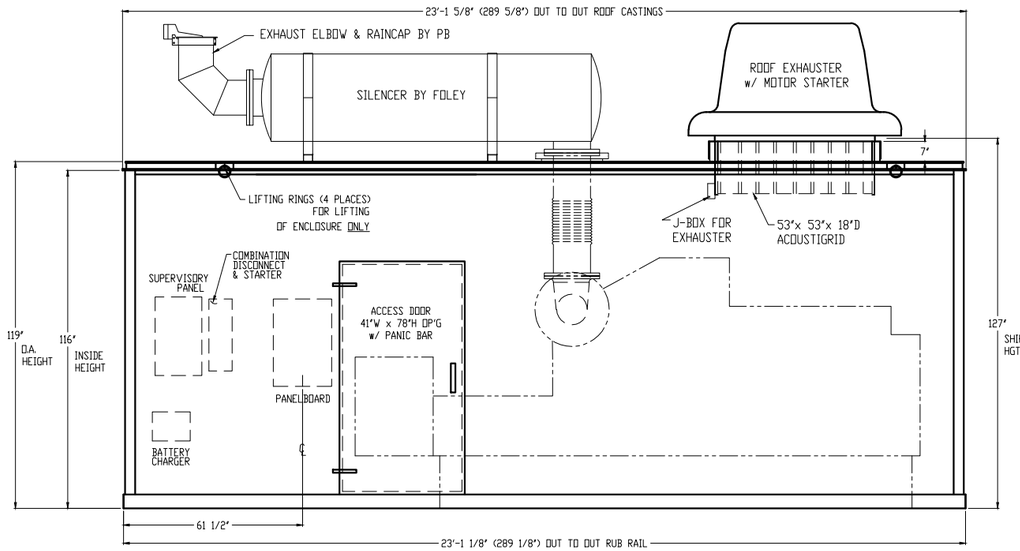

"A" SIDE WALL

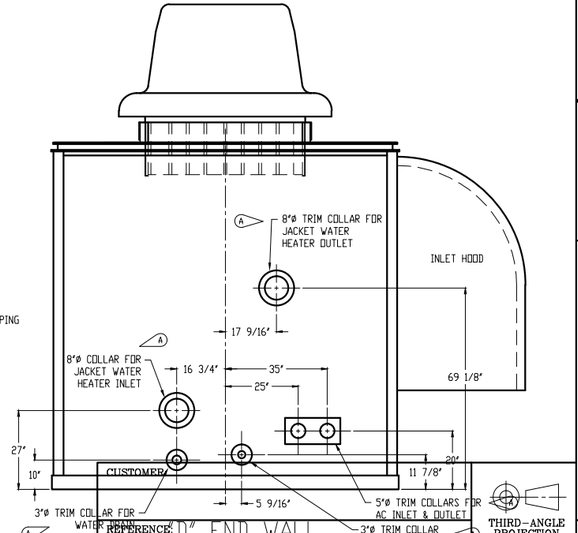

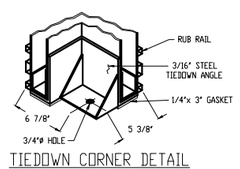

TIEDOWN CORNER DETAIL

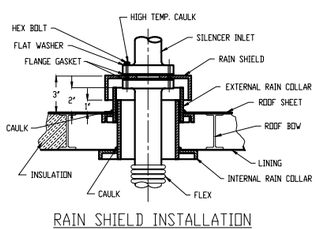

RAIN SHIELD INSTALLATION

FOLEY MACHINERY

REF: NEW JERSEY MANUFACTURES

SCALE IN FEET

PATENT NO. 3,882,592

PRITCHARD-BROWN, LLC CLAIMS PROPRIETARY RIGHT IN THE MATERIAL DISCLOSED HEREON. THIS DRAWING IS ISSUED FOR SALES INFORMATION ONLY AND MAY NOT BE REPRODUCED OR USED TO MANUFACTURE ANYTHING SHOWN HEREON WITHOUT PERMISSION FROM PRITCHARD-BROWN, LLC TO THE USER.

CUSTOMER REFERENCE: "D" END WALL
UNITS REQ'D:

THIRD-ANGLE PROJECTION

REVISION C 07 / 27 / 98

PRITCHARD-BROWN, LLC
6501 ERDMAN AVE.
BALTIMORE, MD 21205

DATE 11 06 97

24'-0"L x 118"W x 116"ins H GENERATOR ENCLOSURE

DRW.	CT	JOB SERIAL NO.	971278
CHK.	SBS		
APP.	MDS		
APP.	CCG	SCALE: 1/2"= 1'-0"	SHEET 1 OF 2

created using AutoCAD