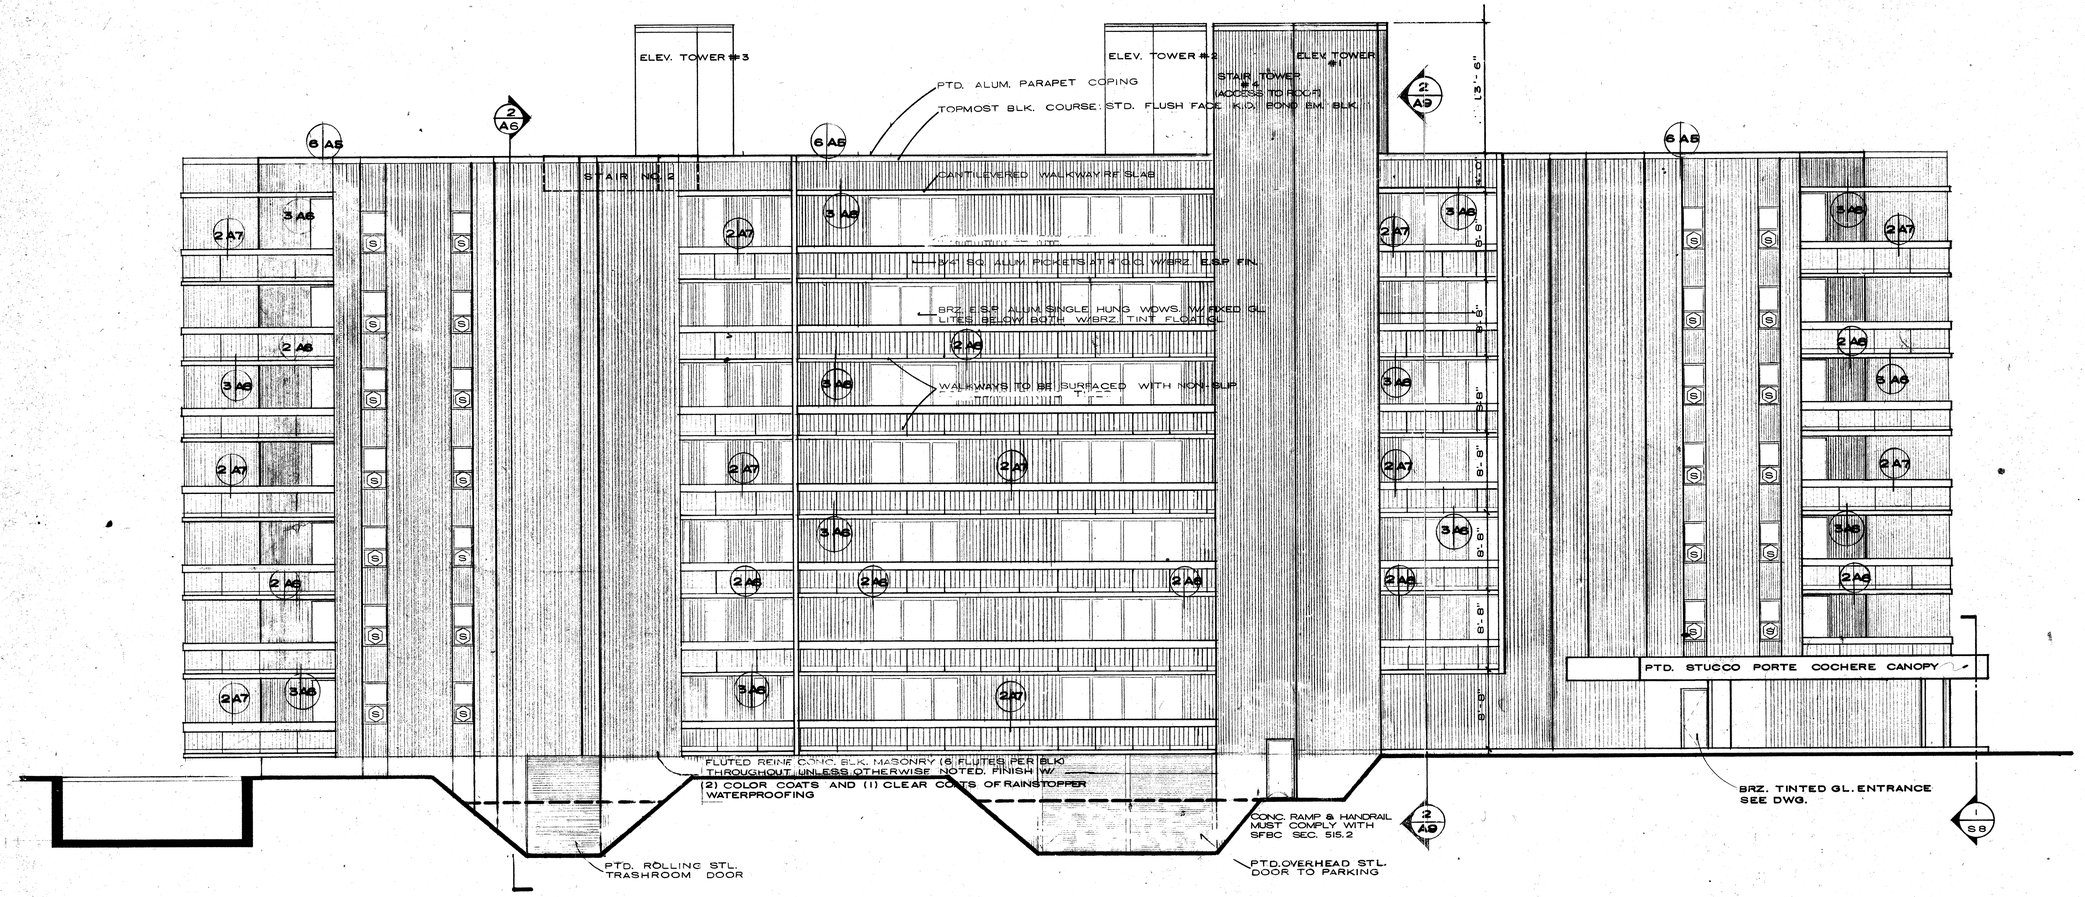

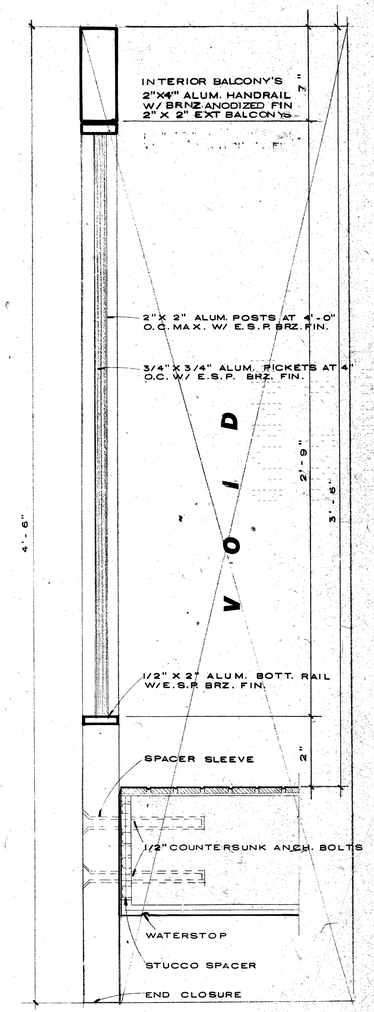

WEST BUILDING ELEVATION 1/A7

SCALE: 1/8" = 1'-0"

EXTERIOR HANDRAIL DET. 2/A7

SCALE: 3" = 1'-0"

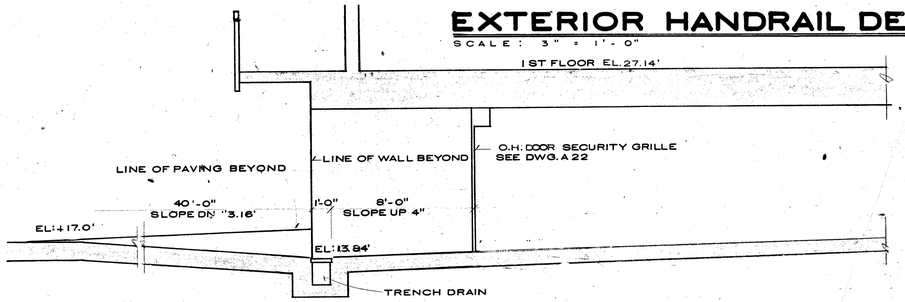

UPPER LEVEL PARKING ENTRANCE PROFILE /A7

SCALE: 1/4" = 1'-0"

R. Wm. Clayton Jr.

R. WM. CLAYTON JR. ARCHITECT
1995 EAST OAKLAND PARK BLVD. FT. LAUDERDALE, FLA.

OVERLOOK CONDOMINIUM

WEST BUILDING ELEVATION

DRAWN BY: RNS
JOB NO:
DATE: 8-12-81
REVISIONS: 6-11-84
10-30-81 STAIR DET.
ELEV. & STAIR TOWER
9-30-84
AS BUILT 2-8-88
SHEET: A7