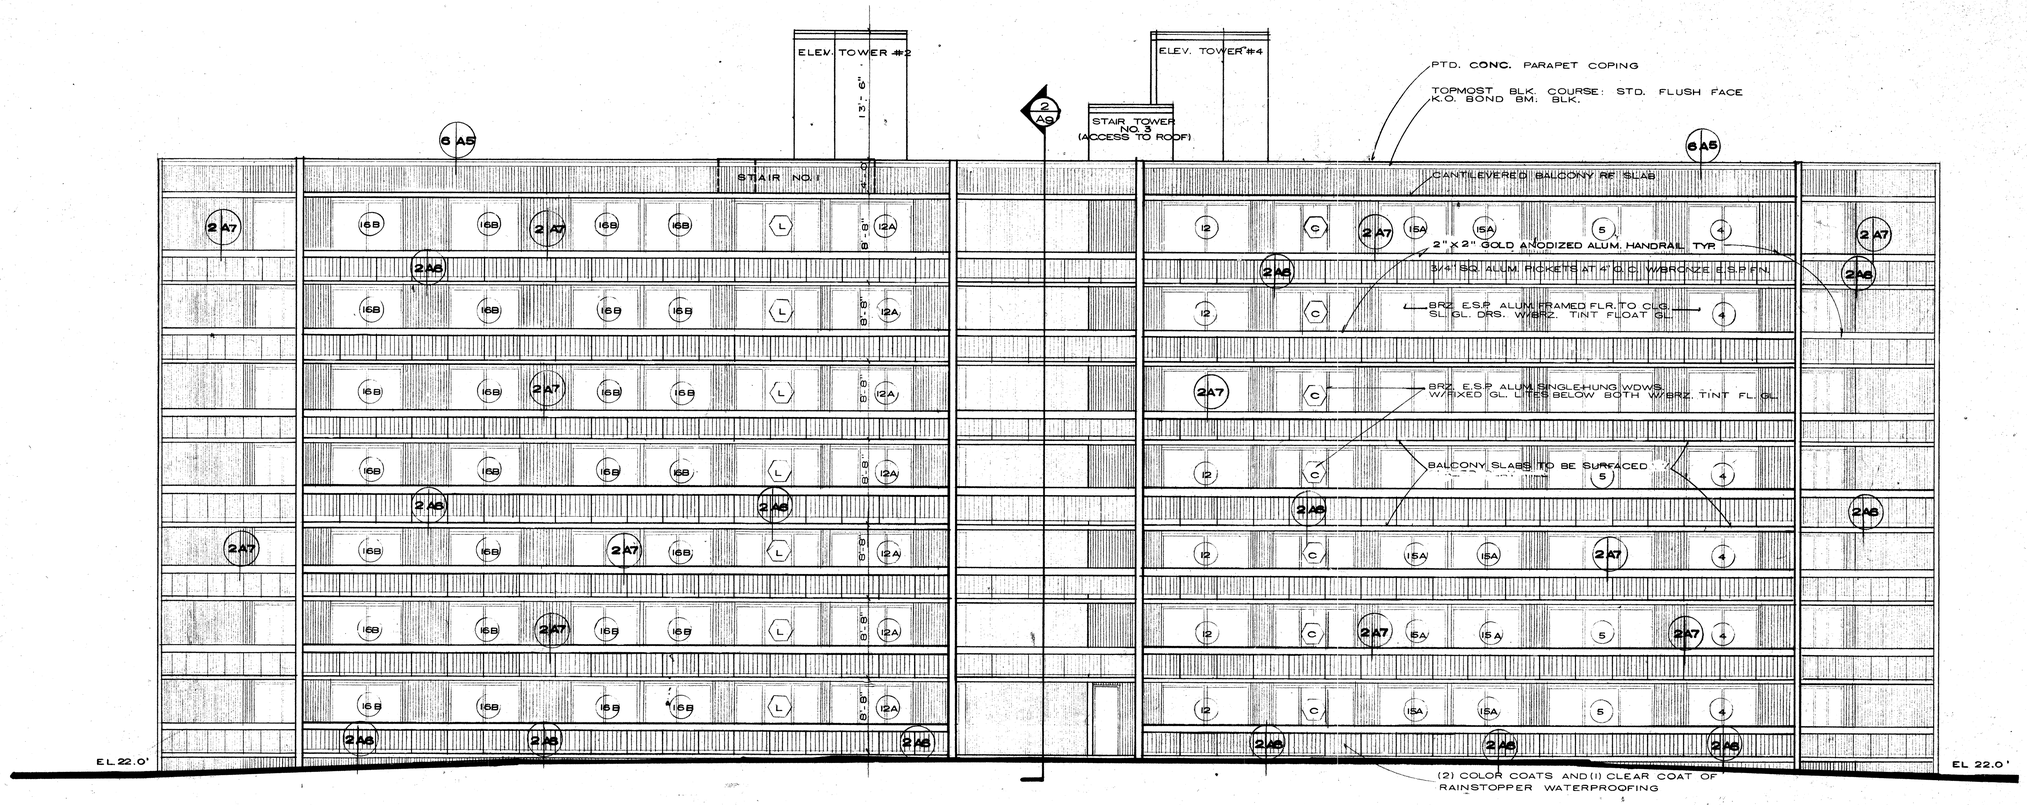

EAST BUILDING ELEVATION

SCALE: 1/8" = 1'-0"

A9

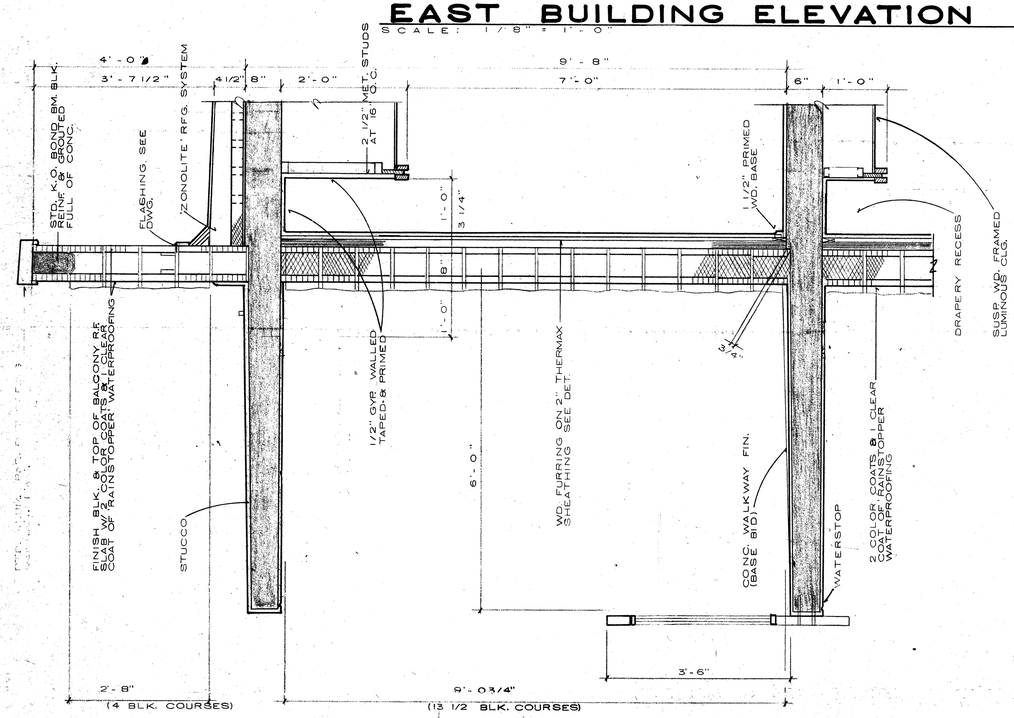

WALL SECTION

SCALE: 3/4" = 1'-0"

A9

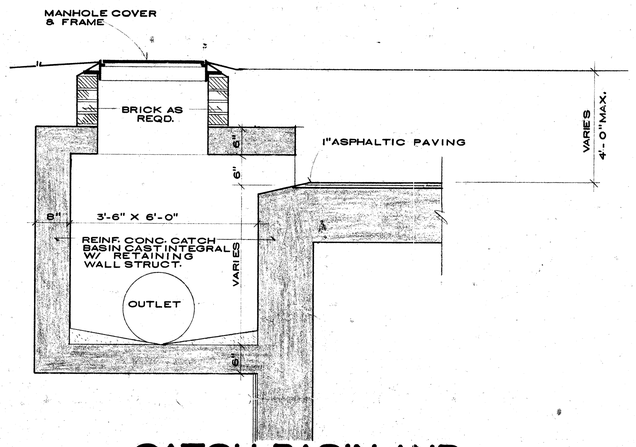

CATCH BASIN AND RETAINING WALL DET.

SCALE: 3/4" = 1'-0"

/A9

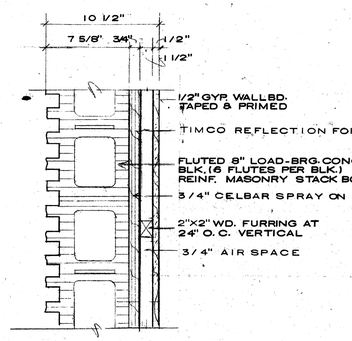

R-VALUES

0.25	OUTSIDE AIR FILM
1.04	8" CONC. BLK.
3.12	3/4" CELABAR
7.00	TIMCO REF. FOIL
1.01	3/4" AIR SPACE
0.45	1/2" GYPSUM BOARD
0.68	INSIDE AIR FILM
13.55	R_T

U-VALUE: 0.038

WALL DETAIL

SCALE: 1 1/2" = 1'-0"

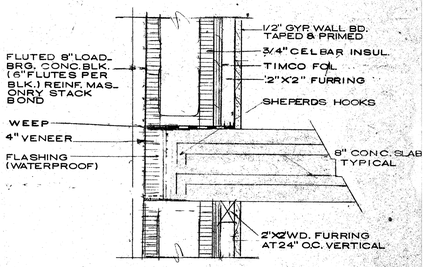

WALL SECTION

SCALE: 1 1/2" = 1'-0"

R. WM. CLAYTON JR. ARCHITECT
1995 EAST OAKLAND PARK BLVD. FT. LAUDERDALE, FLA.

OVERLOOK CONDOMINIUM

EAST BUILDING ELEVATION

DRAWN BY: RNS
JOB NO. 8101
DATE: 8-12-81
REVISIONS: 6-11-84
10-30-81 ELEV. & STAIR TOWER
11-2-81 WALL SEC-SLAB

AS BUILT 2-6-88

SHEET: A9