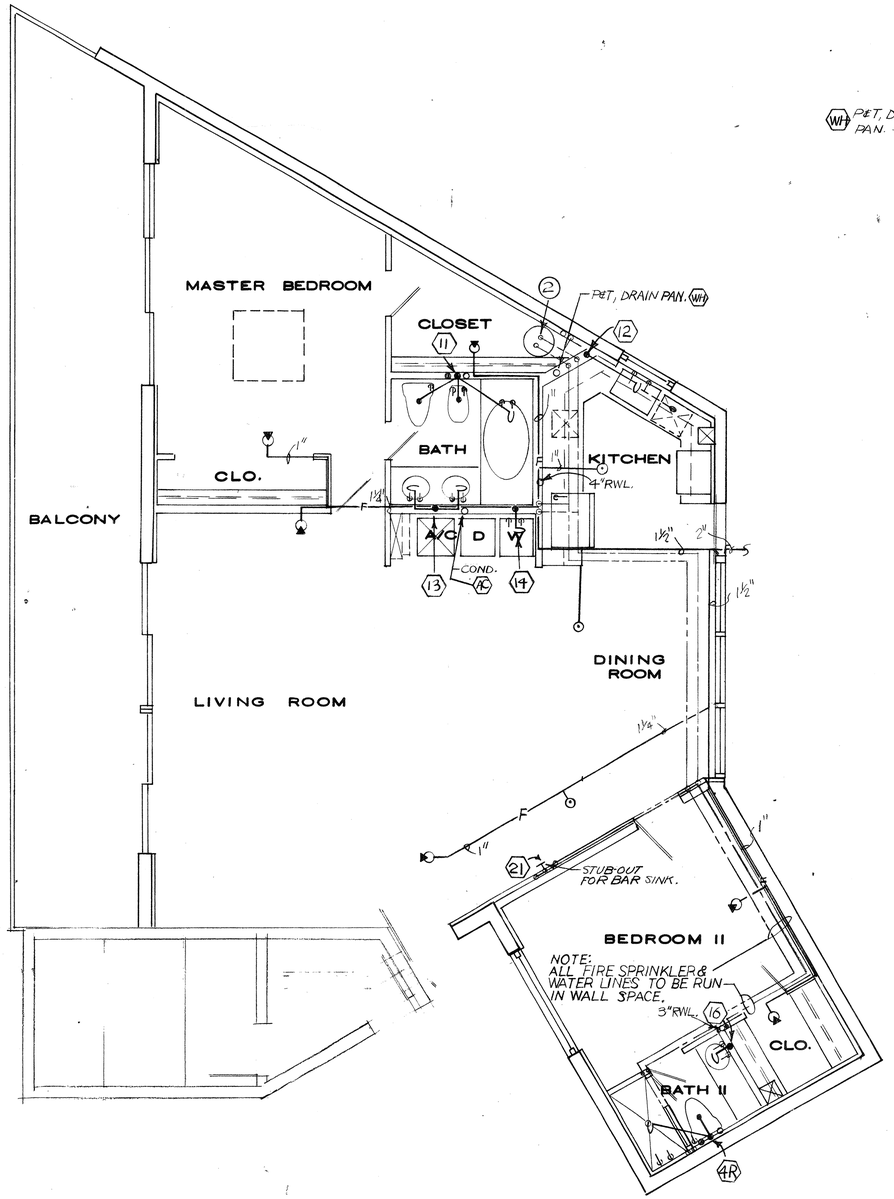

FLOOR PLAN APT. D

SCALE : 1/4" = 1'-0"

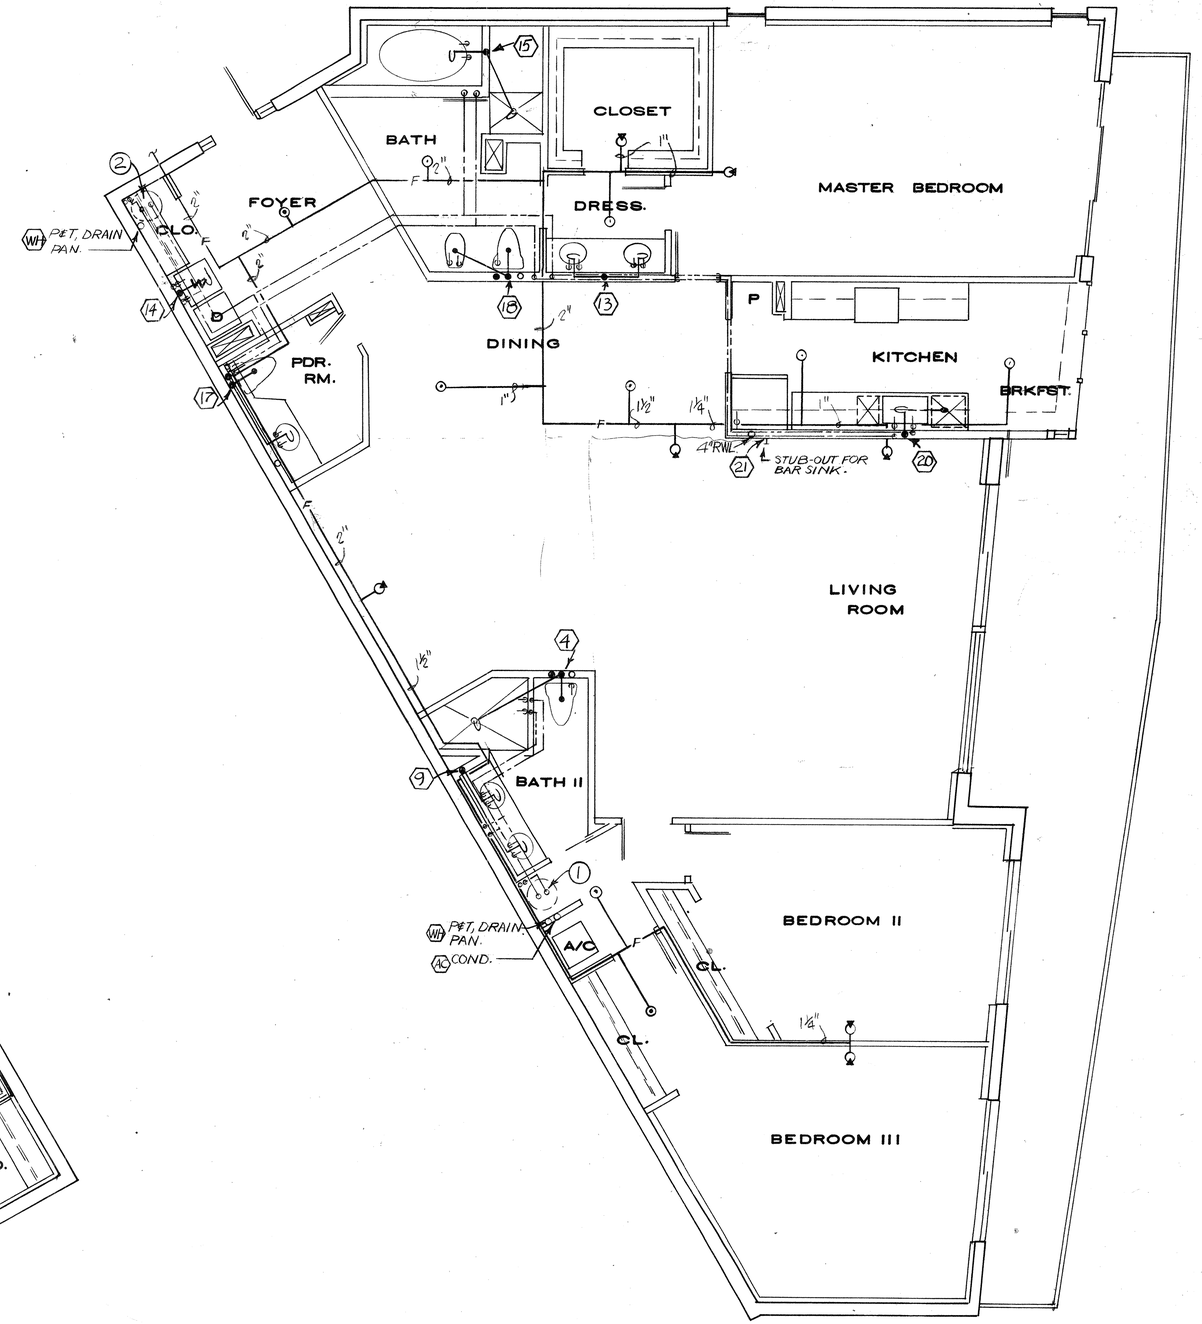

FLOOR PLAN APT. F

SCALE : 1/4" = 1'-0"

FIRE SPRINKLER NOTE
SUBMIT A COMPLETE SET OF SHOP DRAWINGS & HYDRAULIC CALCULATIONS TO ALL GOVERNING AUTHORITIES PRIOR TO CONSTRUCTION.

Eugenio Espinaga 7/3/86

R. WM. CLAYTON JR. ARCHITECT
1995 EAST OAKLAND PARK BLVD. FT. LAUDERDALE, FLA.
E & E CONSULTING ENGINEERS
2701 EAST SUNRISE BLVD. FT. LAUDERDALE, FLA.

OVERLOOK CONDOMINIUM

APT. 'D', 'F' PLUMBING

DRAWN BY: M.B.
JOB NO: 8101
DATE: 8-12-81
REVISIONS: 6-11-84
AS BUILT 2-8-88
SHEET: P4