


GARAGE RENOVATIONS FOR STEPHEN LAMSENS

PERMIT PLAN 8/30/2016

**NOTE: DUE TO THE LIMITATIONS OF A
3-D TYPE CAD PROGRAM THE EXISTING
SWOOPED WALLS CANNOT BE DRAWN AS
THEY EXIST. HOWEVER, THE SWOOPED
WALLS WILL REMAIN AS THEY
CURRENTLY ARE.**

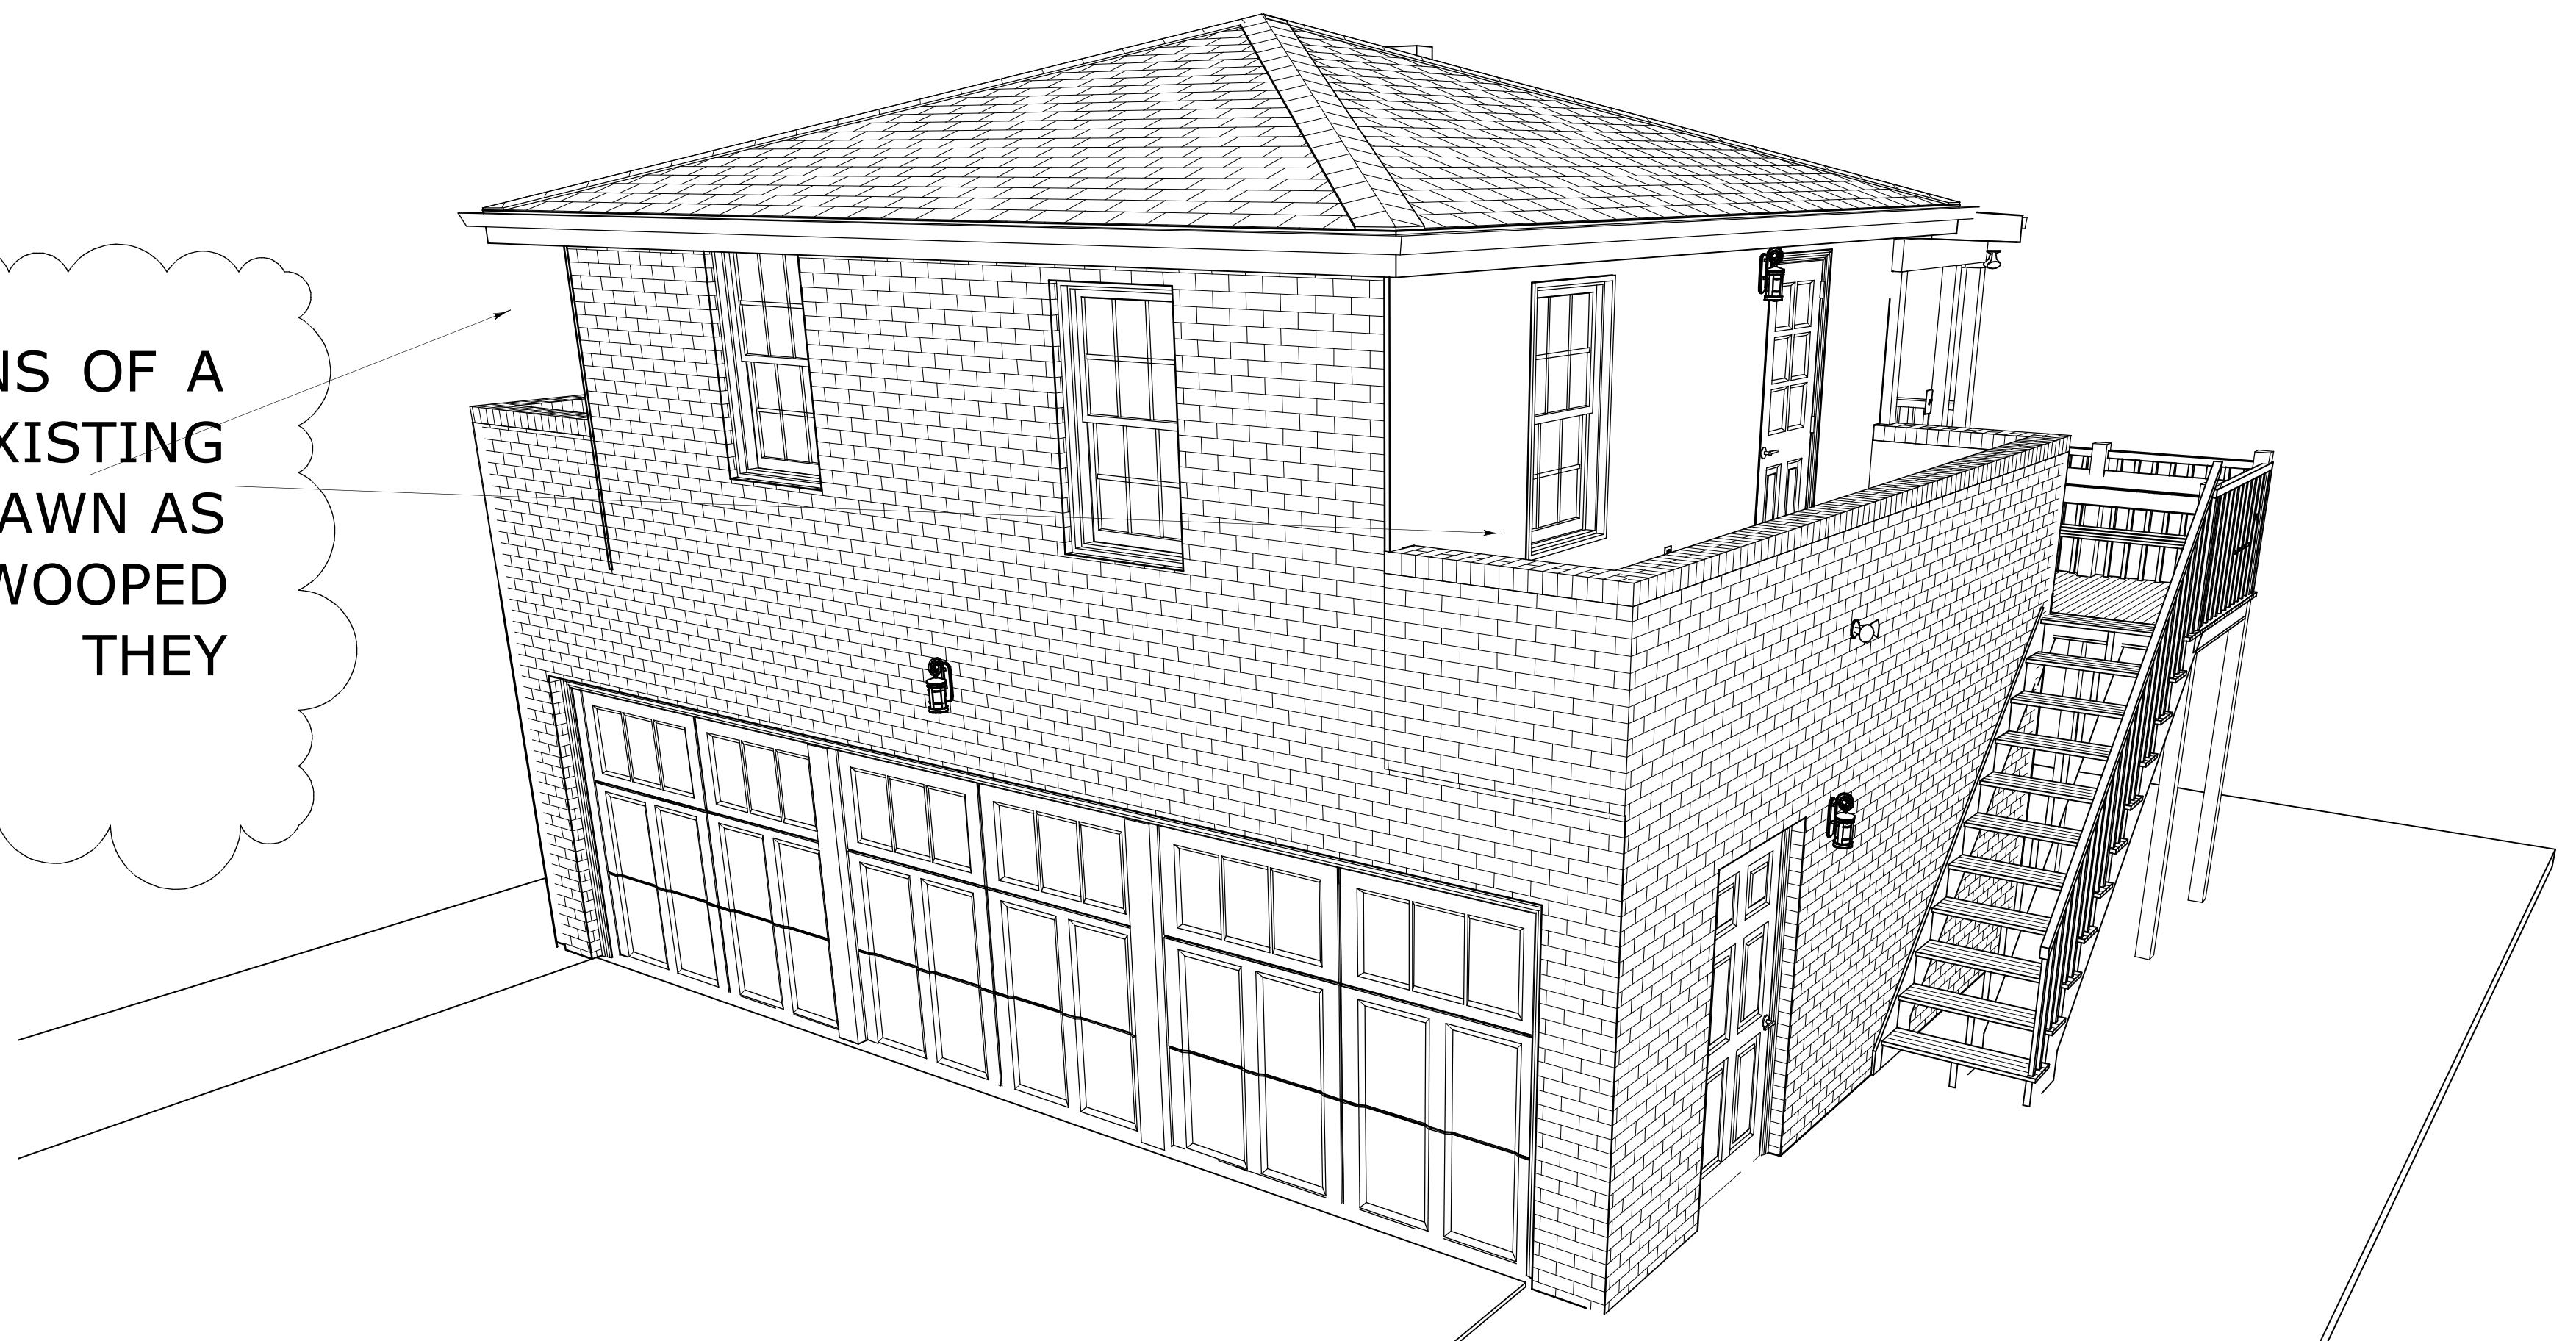

873 GOODWIN STREET, A.K.A. 2061-1 COLLEGE STREET
JACKSONVILLE, FLORIDA 32204

LOT 7, BLOCK 86, RIVERSIDE

R/E #: 091265-0000

BUILT BY:

**DOXA PROPERTIES, LLC
8862 CANOPY OAKS DRIVE
JACKSONVILLE, FLORIDA 32256**

904-219-9279

CGC1504731

AN #
061-R

10 of 10

DUXA PROPERTIES, LLC
8862 CANOPY OAKS DRIVE
JACKSONVILLE, FL 32256
904-219-9279 CGC150472-

LAMSENS
73 Goodwin Street/2061-1 College St
Jacksonville, FL 32204

The logo for GNS for LIVING LLC. It features a stylized crown or dome icon on the left, composed of vertical lines and decorative patterns. To the right of the icon, the word "LIVING" is written in a large, flowing, cursive font. Above "LIVING", the letters "GNS" are written in a smaller, bold, sans-serif font. Below "LIVING", the word "for" is written in a smaller, italicized serif font. To the right of the main text, "LLC" is written in a small, uppercase sans-serif font. Below the "LLC", the words "RESIDENTIAL DESIGN SINCE 1969" are written in a small, uppercase sans-serif font. To the right of the company name, the phone number "904-730-7135" is written in a large, bold, black font.

DESIGN

DATE:
/30/2016



CALENDAR

N.T.S

A-1

**CONTRACT NOTE: CONTRACT
AND SPECIFICATIONS TAKE
PRECEDENCE OVER THESE
DRAWINGS. ANY CONFLICT WILL
DEFAULT TO SAID DOCUMENTS.**


NOTE: ENGINEERS DETAILS TAKE PRECEDENCE!

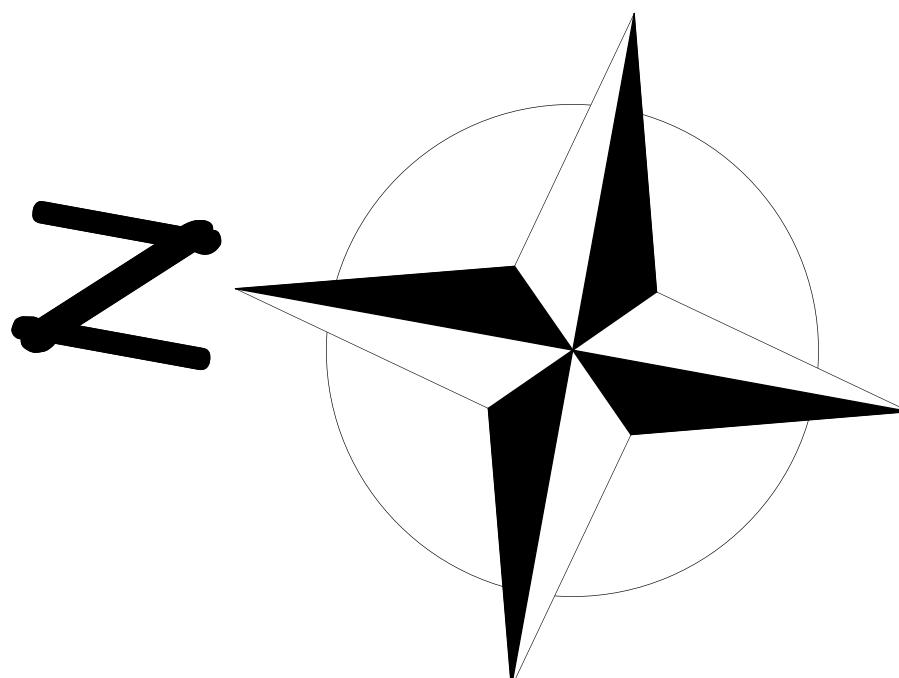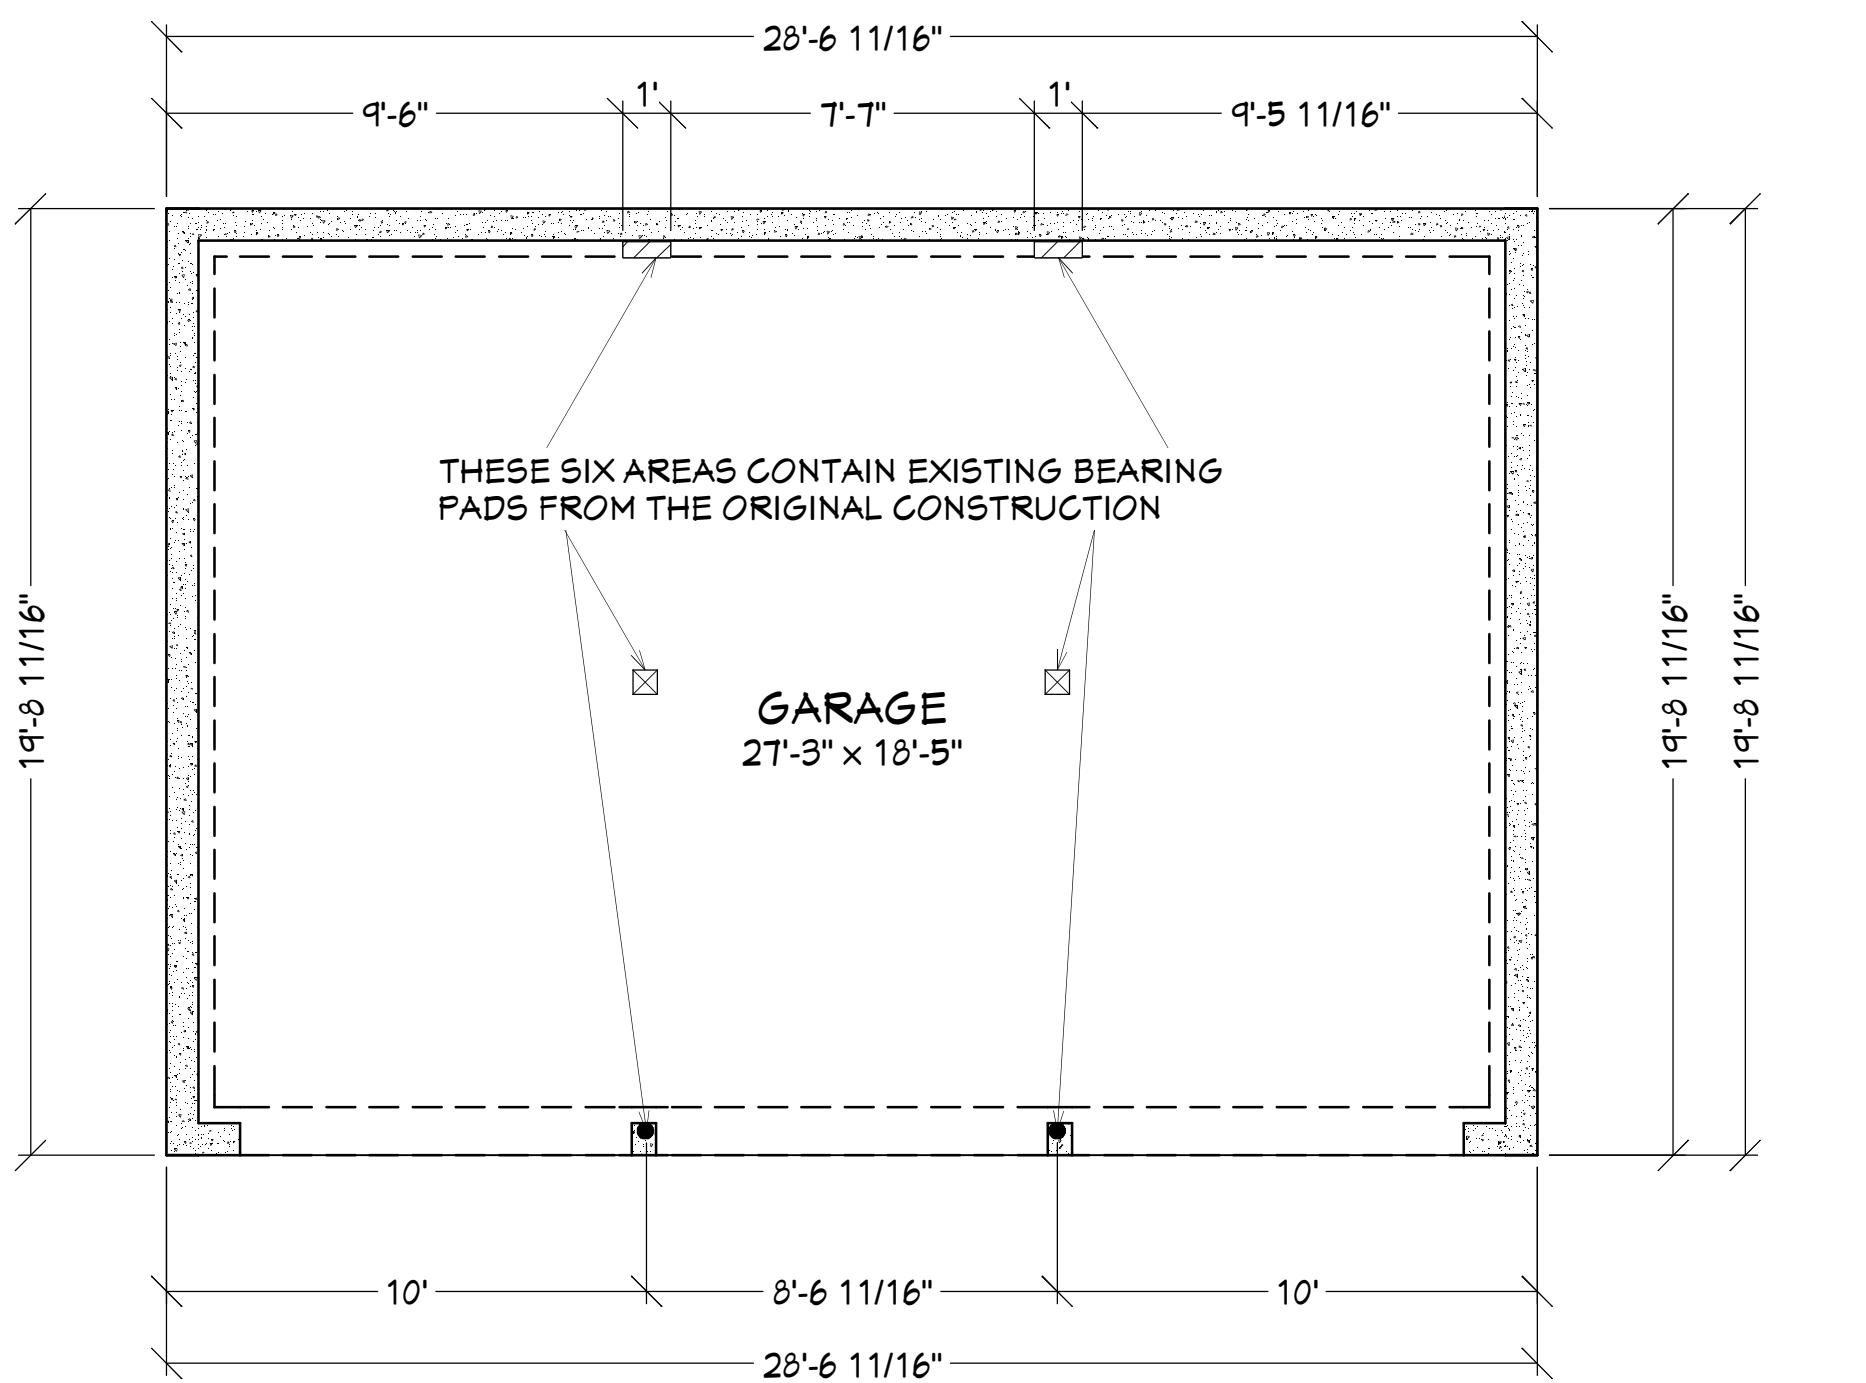

FOUNDATION PLAN

PLAN #		
2061-R		
CLIENT APPROVAL SIGNATURE	DATE	
DOXA PROPERTIES, LLC 8862 CANOPY OAKS DRIVE JACKSONVILLE, FL 32256 904-219-9279 CGC1504721	STEPHAN D. LAMSENS	
BUILT BY: DOXA PROPERTIES, LLC 8862 CANOPY OAKS DRIVE JACKSONVILLE, FL 32256 904-219-9279 CGC1504721		
PROJECT DESCRIPTION: GARAGE RENOVATIONS FOR STEPHEN LAMSENS 873 Goodwin Street/2061-1 College St , Jacksonville, FL 32204		
Design Drawings provided by:  DESIGNS <i>by</i> LIVING RESIDENTIAL DESIGN SINCE 1969 904-730-7135		
DATE:	8/30/2016	
SCALE:	1/4" = 1'-0"	
SHEET:	A-2	

INSULATION:
WALLS: 3.5" R-13 FIBERGLASS BATT
CEILINGS: R-30 FIBERGLASS BATT

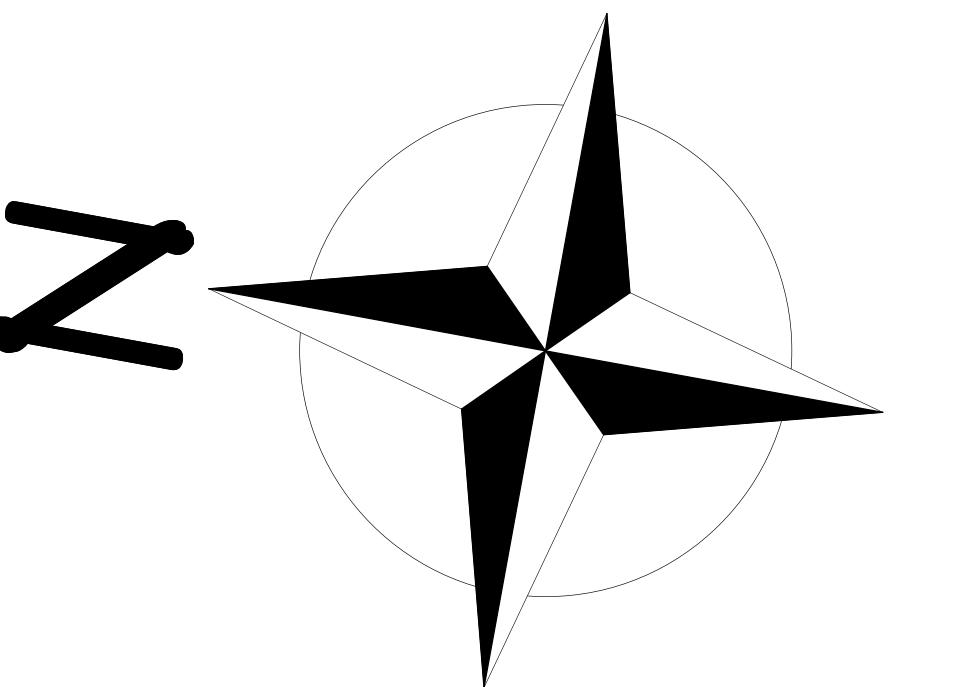

R302.11 Fireblocking.
In combustible construction, fireblocking shall be provided to cut off all concealed draft openings (both vertical and horizontal) and to form an effective fire barrier between stories, and between a top story and the roof space.

Fireblocking shall be provided in wood-frame construction in the following locations:

1. In concealed spaces of stud walls and partitions, including furred spaces and parallel rows of

1. In concealed spaces of stud walls and partitions, including furred spaces and parallel rows of studs or staggered studs, as follows:
 - 1.1. Vertically at the ceiling and floor levels.
 - 1.2. Horizontally at intervals not exceeding 10 feet (3048 mm).
 2. At all interconnections between concealed vertical and horizontal spaces such as occur at soffits, drop ceilings and cove ceilings.
 3. In concealed spaces between stair stringers at the top and bottom of the run. Enclosed spaces under stairs shall comply with Section R302.7.
 4. At openings around vents, pipes, ducts, cables and wires at ceiling and floor level, with an approved material to resist the free passage of flame and products of combustion. The material filling this annular space shall not be required to meet the ASTM E 136 requirements.
 5. For the fireblocking of chimneys and fireplaces, see Section R1003.19.
 6. Fireblocking of cornices of a two-family dwelling is required at the line of dwelling unit separation.

SECTION R310

EMERGENCY ESCAPE AND RESCUE OPENINGS

R310.1 Emergency escape and rescue required. Basements, habitable attics and every sleeping room shall have at least one operable emergency escape and rescue opening. Where basements contain one or more sleeping rooms, emergency egress and rescue openings shall be required in each sleeping room. Where emergency escape and rescue openings are provided they shall have a sill height of not more than 44 inches (1118 mm) above the floor. Where a door opening having a threshold below the adjacent ground elevation serves as an emergency escape and rescue opening and is provided with a bulkhead enclosure, the bulkhead enclosure shall comply with Section R310.3. The net clear opening dimensions required by this section shall be obtained by the normal operation of the emergency escape and rescue opening from the inside. Emergency escape and rescue openings with a finished sill height below the adjacent ground elevation shall be provided with a window well in accordance with Section R310.2. Emergency escape and rescue openings shall open directly into a public way, or to a yard or court that opens to a public way.

Exceptions:

- Exceptions:

 1. Basements used only to house mechanical equipment and not exceeding total floor area of 200 square feet (18.58 m²).
 2. The emergency escape and rescue opening shall be permitted to open into a screen enclosure, open to the atmosphere, where a screen door is provided leading away from the residence.

B310.1.1 Minimum opening area

All emergency escape and rescue openings shall have a minimum net clear opening of 5.7 square feet (0.530 m^2)


Grade floor openings shall have a minimum net clear opening of 5 square feet (0.465 m^2)

Grade floor openings shall have a B310.1-2 Minimum opening height

R310.1.2 Minimum opening height. The minimum net clear opening height shall be 24 inches (610 mm).

B310.1.3 Minimum opening width

R310.1.5 Minimum opening width. The minimum net clear opening width shall be 20 inches (508 mm).



B310.1.4 Operational constraints

R510.1.4 Operational constraints. Emergency escape and rescue openings shall be operational from the interior.


Emergency escape and rescue operation special knowledge

special knowledge.


**NOTE: ALL WINDOWS AND
DOORS SHOWN ARE
EXISTING EITHER ACTUALLY
THERE OR THE REMNANTS
OF THEM ARE IN PLACE AND
WILL BE REMEDIED DURING
CONSTRUCTION**

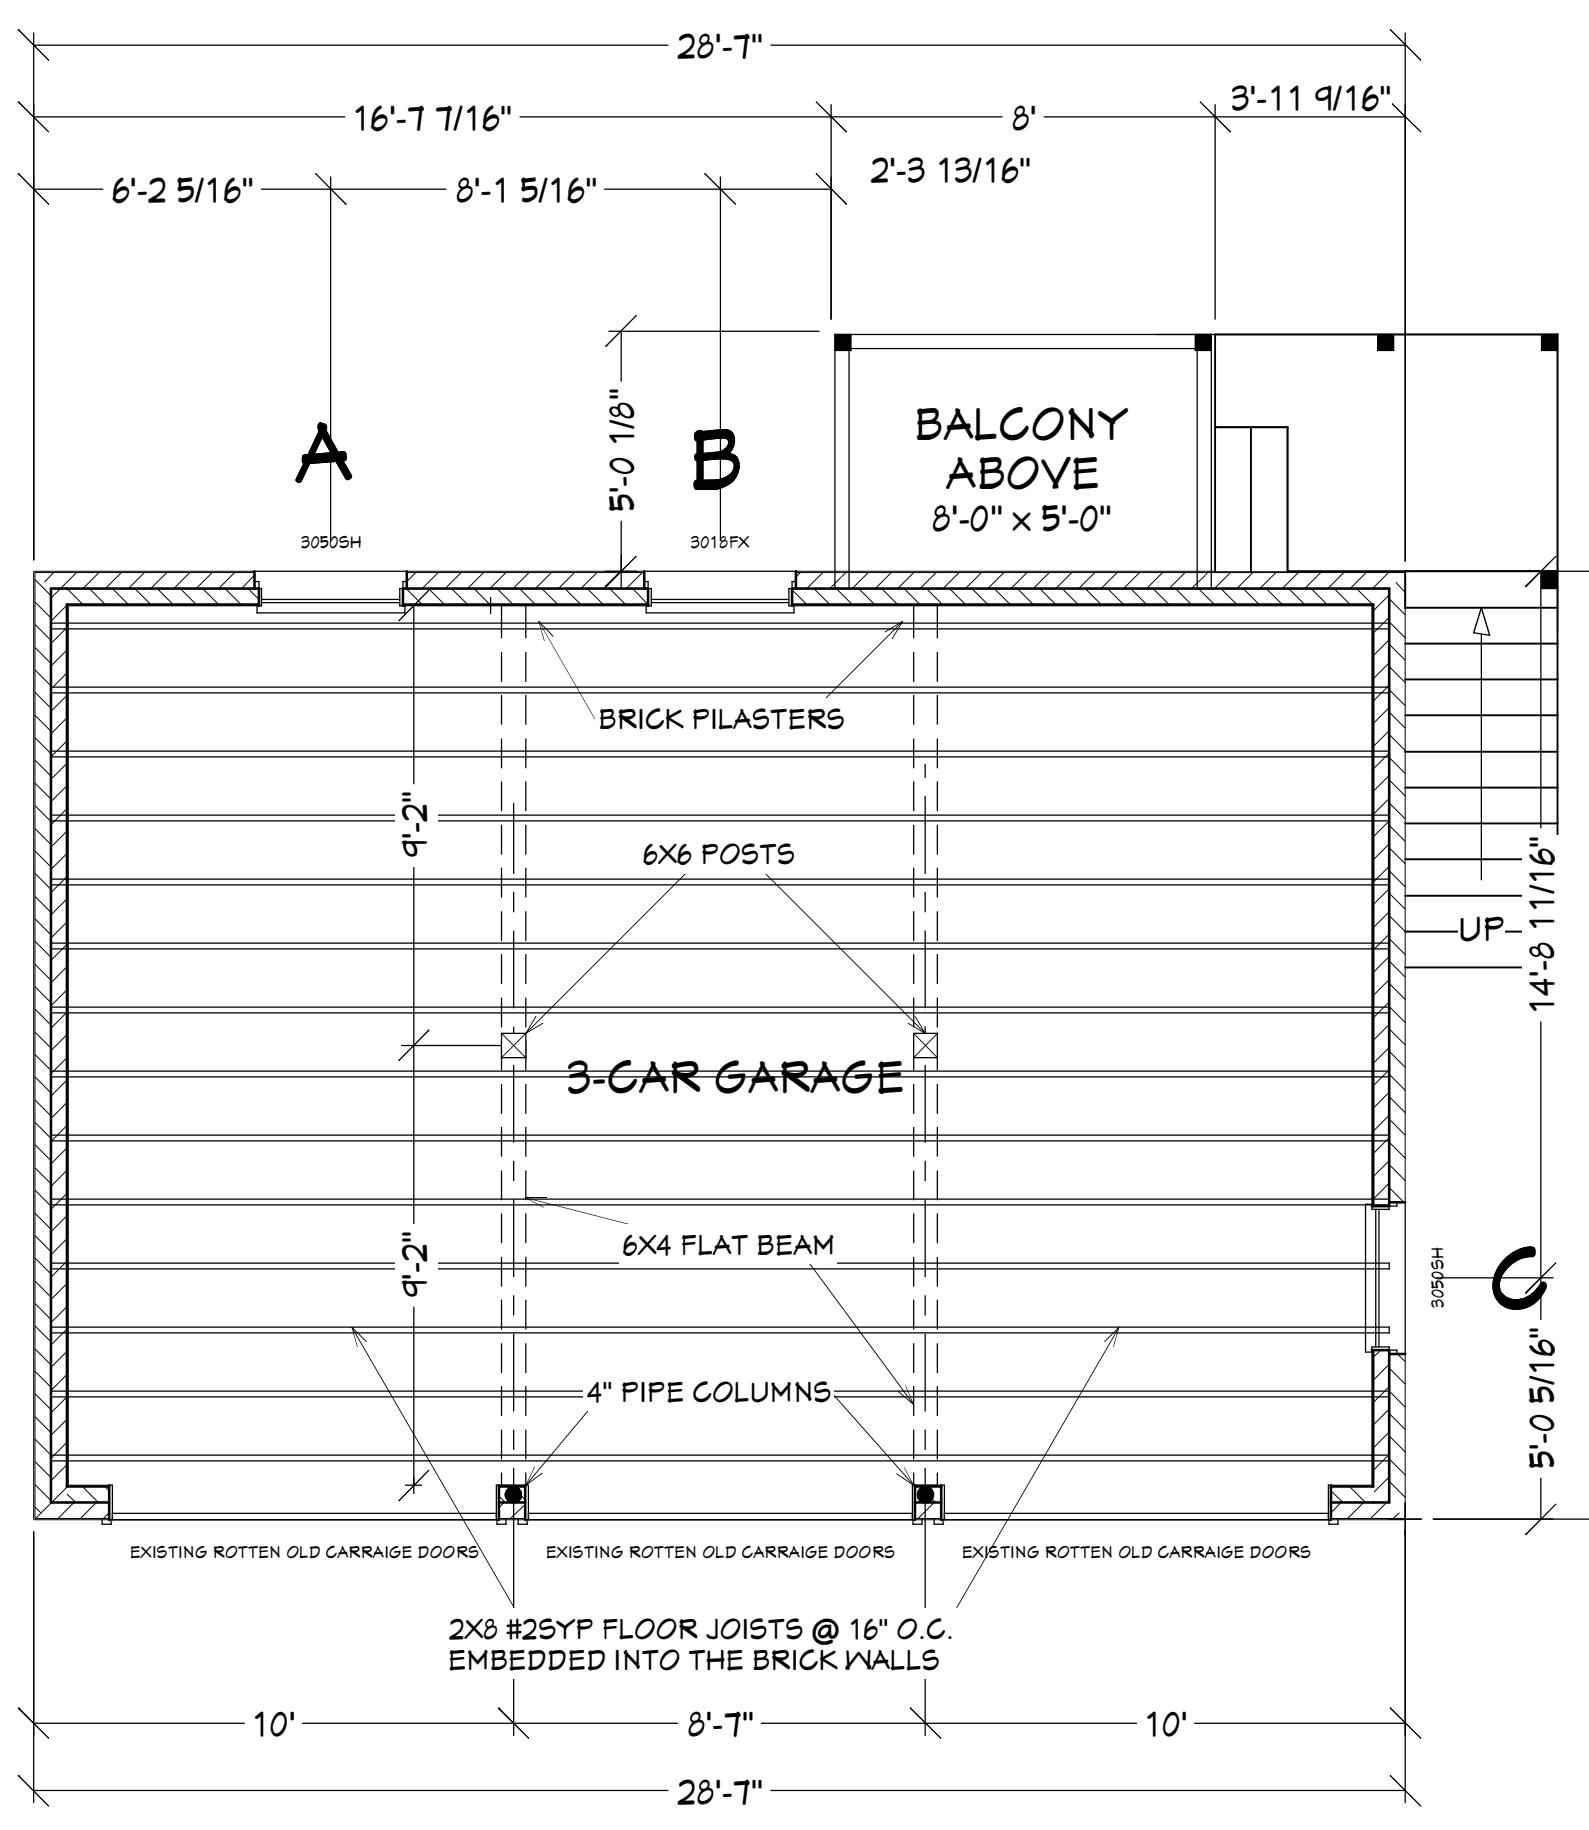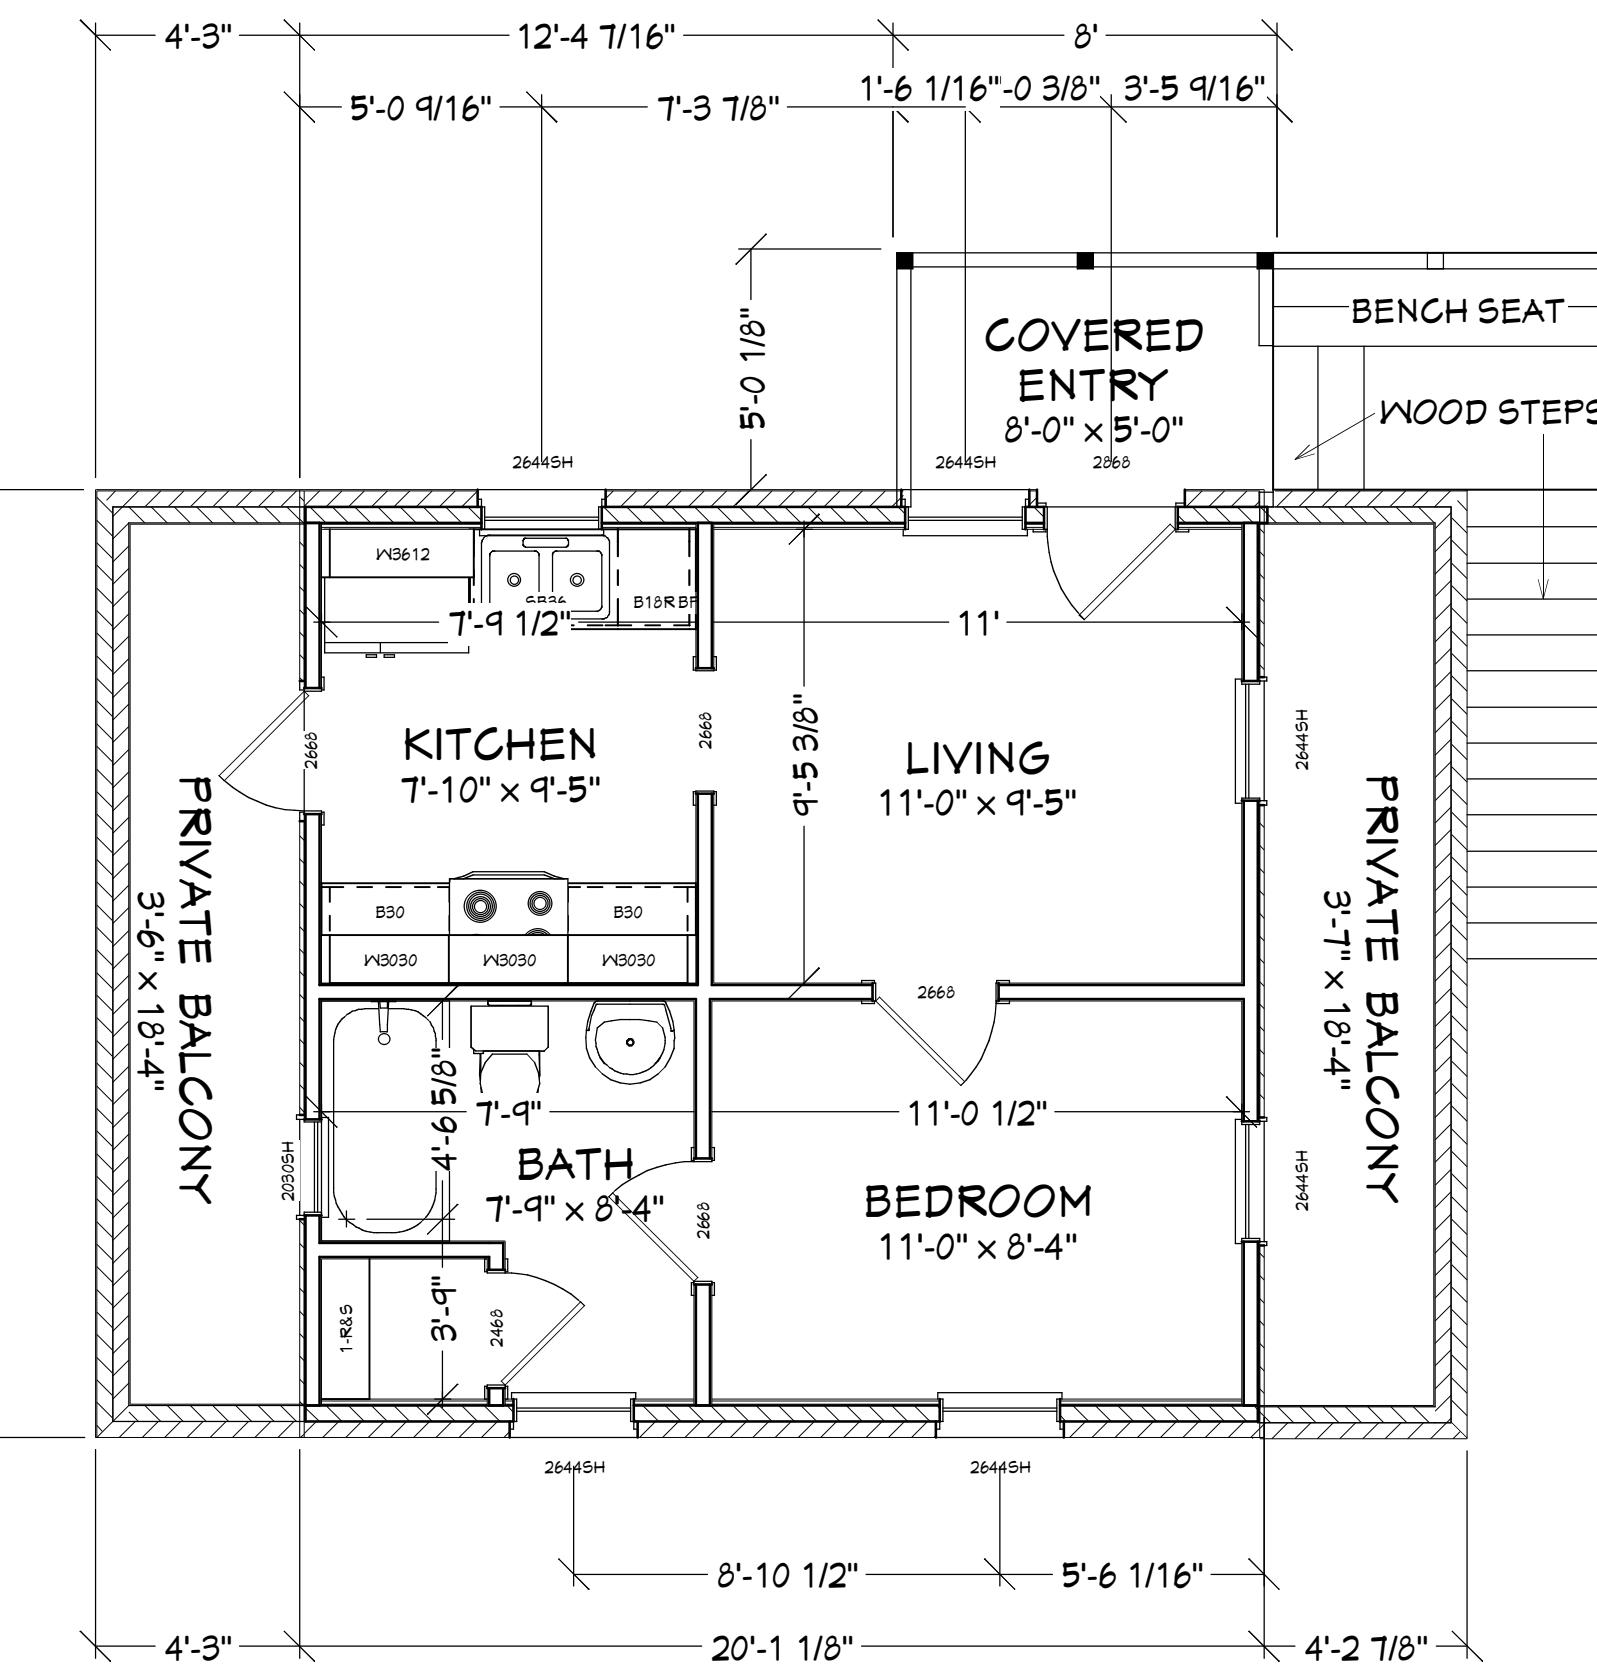

AS-BUILT FLOOR PLANS

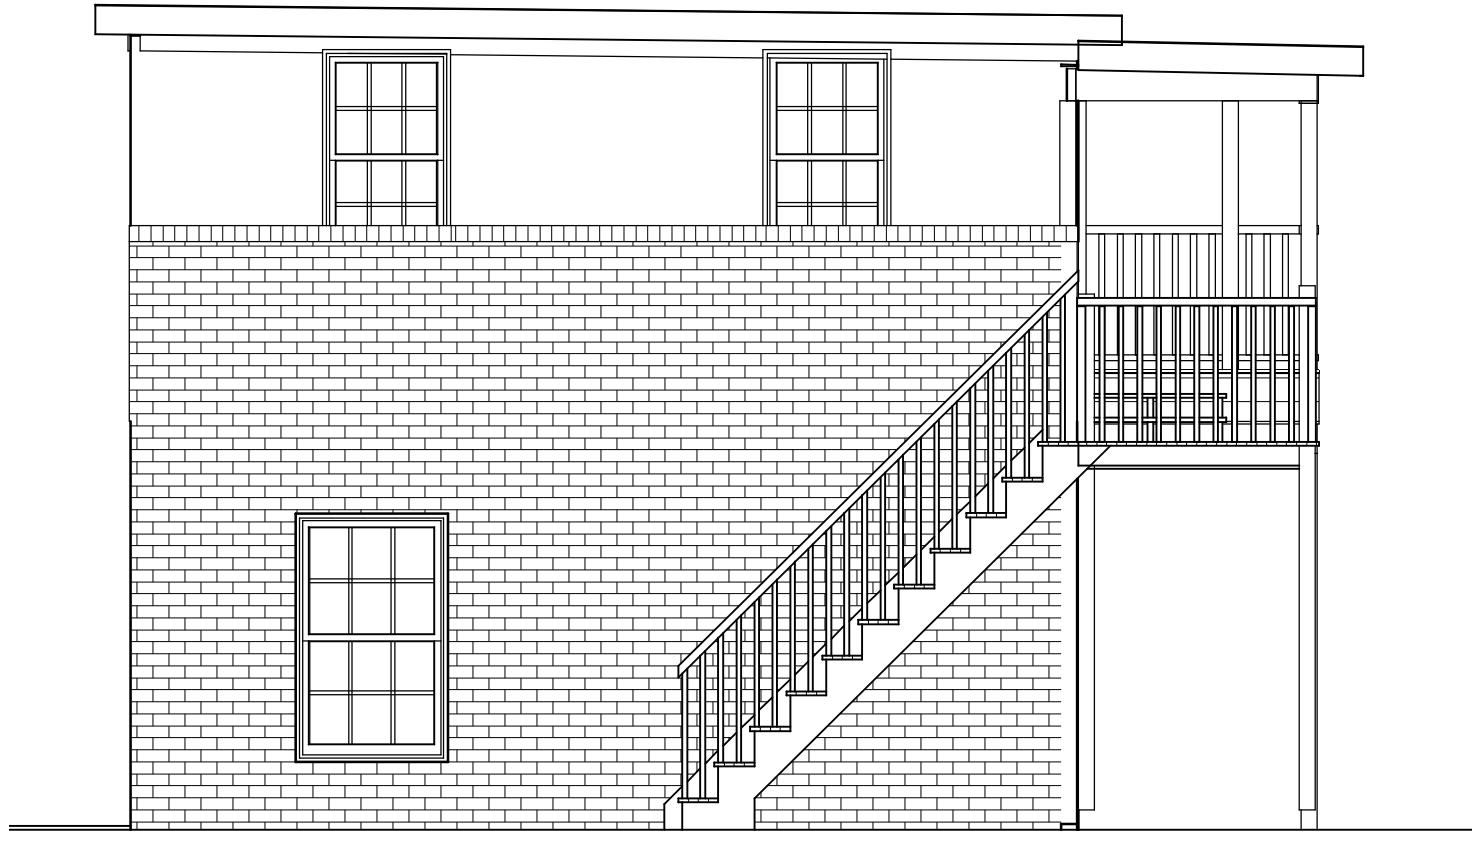

RIGHT ELEVATION

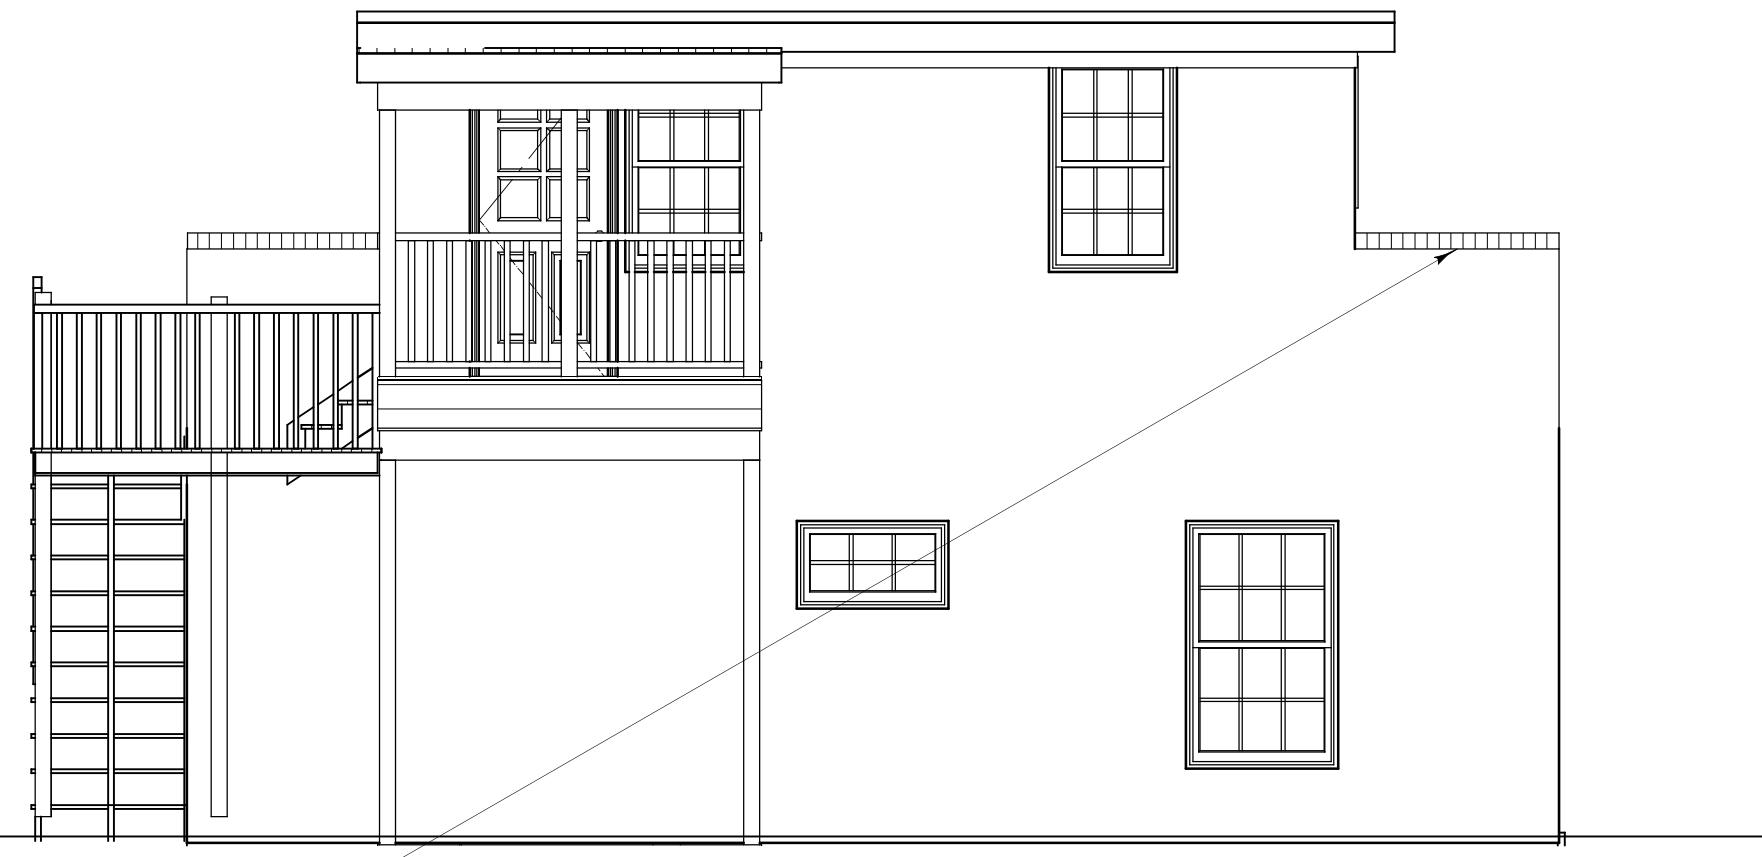


REAR ELEVATION

NOTE: DUE TO THE LIMITATIONS OF A 3-D TYPE CAD PROGRAM THE EXISTING SWOOPED WALLS CANNOT BE DRAWN AS THEY EXIST. HOWEVER, THE SWOOPED WALLS WILL REMAIN AS THEY CURRENTLY ARE.




FRONT ELEVATION

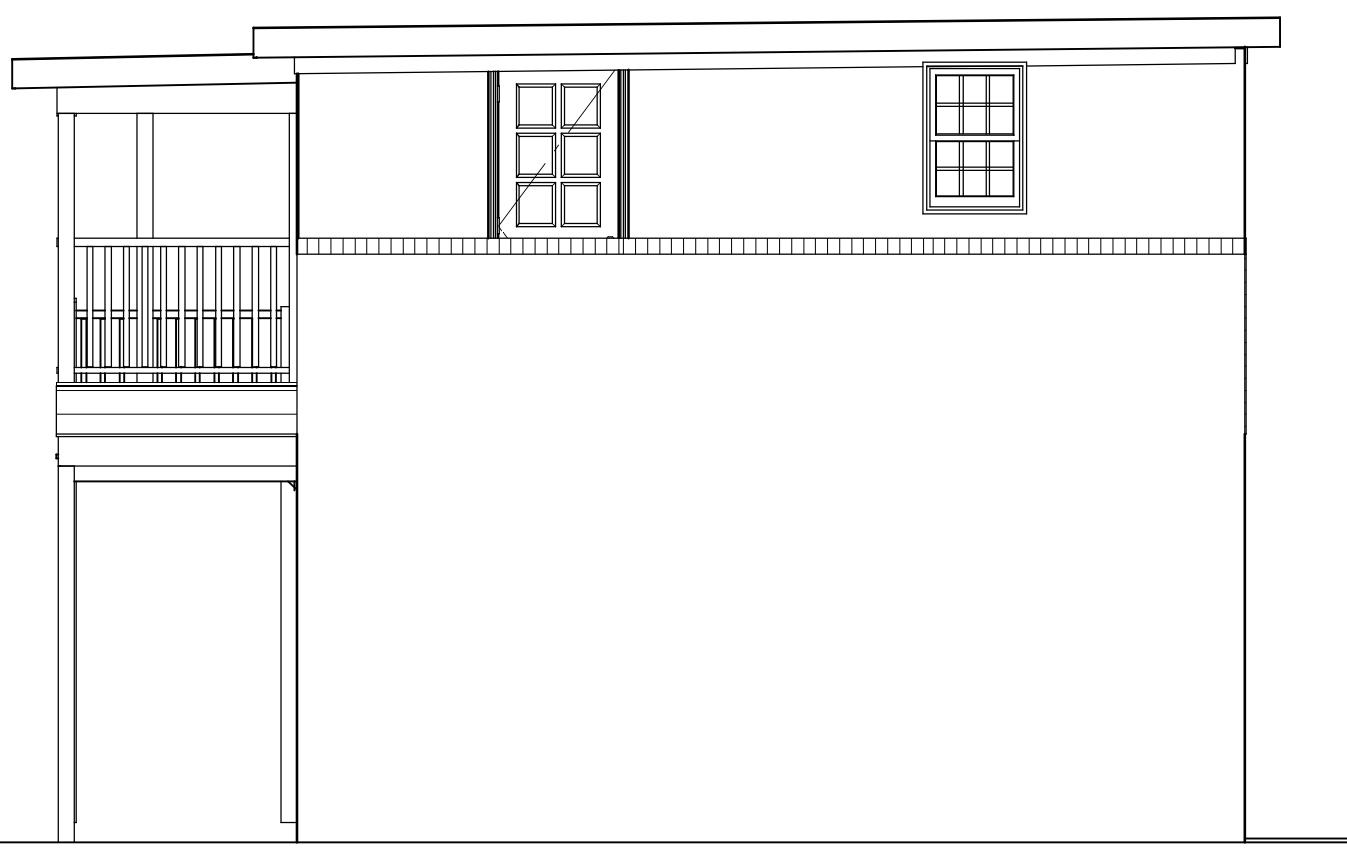


LEFT ELEVATION

**CONTRACT NOTE: CONTRACT AND
SPECIFICATIONS TAKE PRECEDENCE
OVER THESE DRAWINGS. ANY CONFLICT
WILL DEFAULT TO SAID DOCUMENTS.**

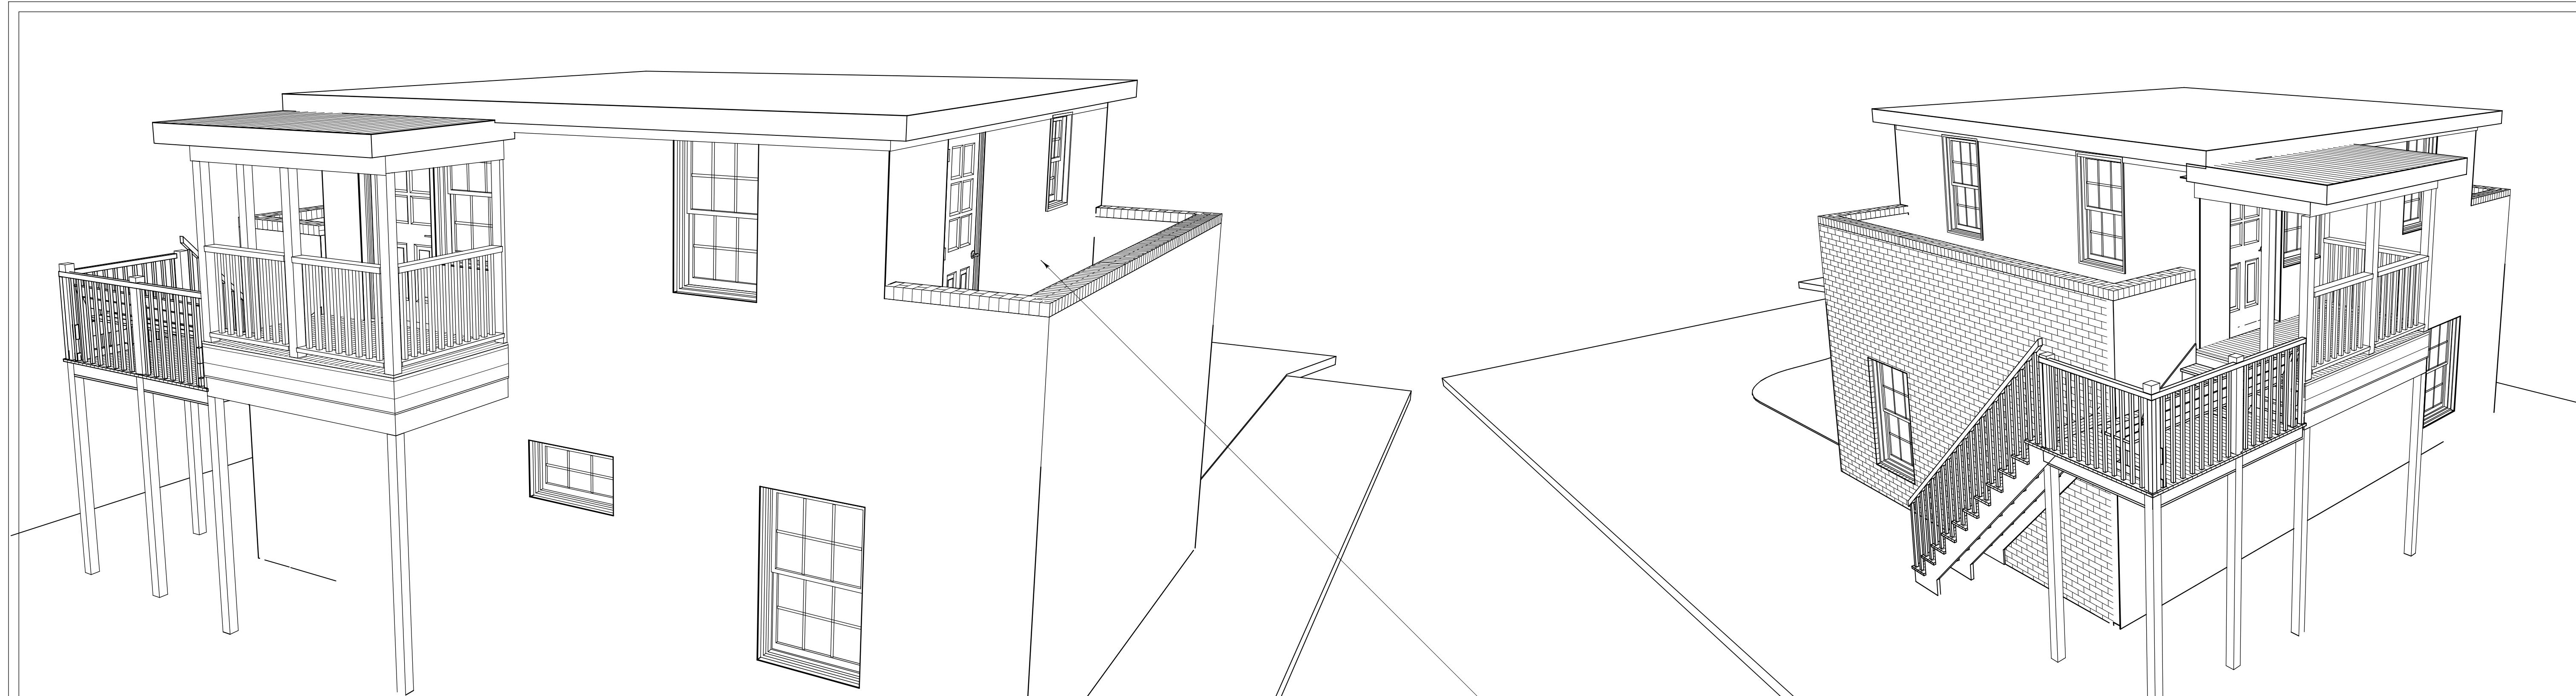

NOTE: DUE TO THE LIMITATIONS OF A 3-D TYPE CAD PROGRAM THE EXISTING SWOOPED WALLS CANNOT BE DRAWN AS THEY EXIST. HOWEVER, THE SWOOPED WALLS WILL REMAIN AS THEY CURRENTLY ARE.

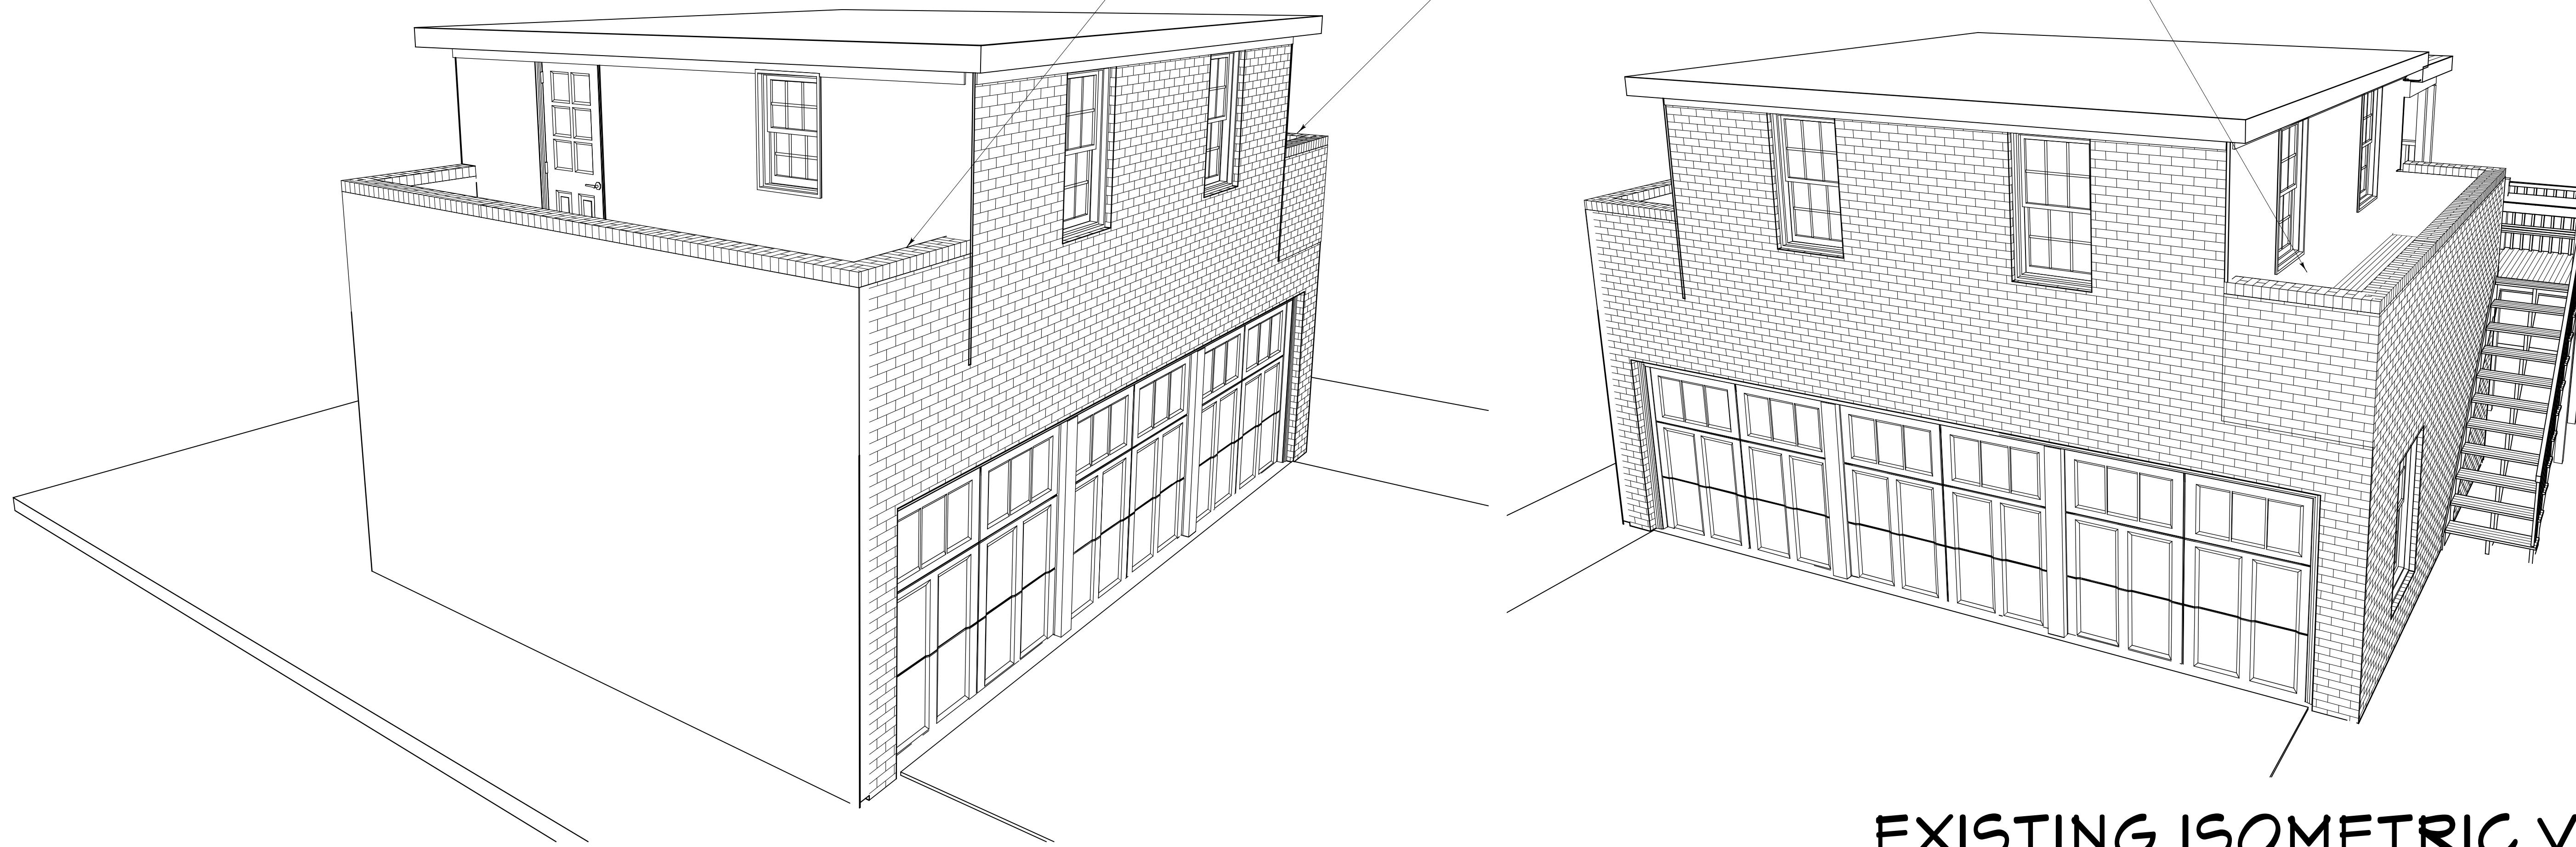

EXISTING ISOMETRIC VIEWS

COPYRIGHT 2016: DESIGNS FOR LIVING, LLC. -Under section 102 of the Architectural Works Copyright Protection Act (title 17 of the United States Code) specific tacit copyright laws apply to original design of a building created in any tangible medium of expression, including a constructed building or architectural plans, models, or drawings and is subject to copyright protection as an "architectural work" by Designs for Living, LLC. herein referred to as Designer. It is unlawful for anyone to copy these drawings, either in whole or in part, without the express written permission of the Designer. The use of any plans, specifications, electronic or hard copy prints shall be restricted to the original site for which they were prepared and publication thereof is expressly limited to such use. Title to all works, specifically all drawings, specifications, and modified derivatives of any blueprints, e-files, drawings, or specifications remain the Designers without prejudice. VISUAL CONTACT with any of these drawings, or their purchase constitutes prima facie evidence of the acceptance of these restrictions! This has held precedent in the North Florida Court system! Any and all violations WILL result in legal action being taken and litigated damages to the full extent allowed by law! No exceptions and no excuses! Contractor &/or owner shall verify all dimensions, details, & specifications prior to construction. Every attempt has been made to avoid mistakes. The contractor and the owners also fully acknowledge that they have full copyright release approval and Designs for Living LLC nor R.E. Chip Mitchell shall not be liable for error for copyright infringement or other errors after delivery via email of drawings including after construction has begun! This copyright law is only valid on building designs created on or after December 1, 1990.

PLAN # 2061-R		
CLIENT APPROVAL SIGNATURE	DATE	
DOXA PROPERTIES, LLC 8862 CANOPY OAKS DRIVE JACKSONVILLE, FL 32256 904-219-9279 CGC1504721	STEPHAN D. LAMSENS	
BUILT BY: DOXA PROPERTIES, LLC 8862 CANOPY OAKS DRIVE JACKSONVILLE, FL 32256 904-219-9279 CGC1504721		
PROJECT DESCRIPTION: GARAGE RENOVATIONS FOR STEPHEN LAMSENS 873 Goodwin Street/2061-1 College St , Jacksonville, FL 32204		
Design Drawings provided by:  DESIGNS <i>for</i> LIVING RESIDENTIAL DESIGN SINCE 1969 904-730-7135		
DATE:	8/30/2016	
SCALE:	N.T.S.	
SHEET:	A-5	

INSULATION:
WALLS: 3.5" R-13 FIBERGLASS BATT
CEILINGS: R-30 FIBERGLASS BATT

WINDOW & DOOR SURVEY WITH SCOPE OF WORK:

- 1: Existing 3050SH original window. Wish to replace with new SDL mutton vinyl window
- 2: Existing 3018FX original window damaged. Wish to replace with new SDL mutton vinyl window
- 3: Boarded up 3050SH window opening. Window missing and to be converted using a door to access the garage
- 4: Existing 2644SH original window. Wish to replace with new SDL mutton vinyl window.
- 5: Existing 2644SH original window. Wish to replace with new SDL mutton vinyl window.
- 6: Existing 2644SH original window. Wish to replace with new SDL mutton vinyl window.
- 7: Existing 2644SH original window. Wish to convert to new door to access the side porch.
- 8: Existing 1/2 glass door in steel. Wishing to replace with composite similar type door.
- 9: Existing 2644SH window is missing and boarded up. Wish to replace with new SDL mutton vinyl window.
- 10: Existing 2644SH original window. Wish to replace with new SDL mutton vinyl window.
- 11: Existing 2668 6-panel damaged jambs & door. Wishing to replace with composite similar type door assembly.
- 12: Existing 2030SH window missing & boarded up. Wish to replace with new SDL mutton vinyl window.

R302.11 Fireblocking.

In combustible construction, fireblocking shall be provided to cut off all concealed draft openings (both vertical and horizontal) and to form an effective

fire barrier between stories, and between a top story and the roof space.

Fireblocking shall be provided in wood-frame construction in the following locations:

1. In concealed spaces of stud walls and partitions, including furred spaces and parallel rows of studs or staggered studs, as follows:
 - 1.1. Vertically at the ceiling and floor levels.
 - 1.2. Horizontally at intervals not exceeding 10 feet (3048 mm).
2. At all interconnections between concealed vertical and horizontal spaces such as occur at soffits, drop ceilings and cove ceilings.
3. In concealed spaces between stair stringers at the top and bottom of the run. Enclosed spaces under stairs shall comply with Section R302.7.
4. At openings around vents, pipes, ducts, cables and wires at ceiling and floor level, with an approved material to resist the free passage of flame and products of combustion. The material filling this annular space shall not be required to meet the ASTM E 136 requirements.
5. For the fireblocking of chimneys and fireplaces, see Section R1003.19.
6. Fireblocking of cornices of a two-family dwelling is required at the line of dwelling unit separation.

**SECTION R310
EMERGENCY ESCAPE AND RESCUE OPENINGS**

R310.1 Emergency escape and rescue required. Basements, habitable attics and every sleeping room shall have at least one operable emergency escape and rescue opening. Where basements contain one or more sleeping rooms, emergency egress and rescue openings shall be required in each sleeping room. Where emergency escape and rescue openings are provided they shall have a sill height of not more than 44 inches (1118 mm) above the floor. Where a door opening having a threshold below the adjacent ground elevation serves as an emergency escape and rescue opening and is provided with a bulkhead enclosure, the bulkhead enclosure shall comply with Section R310.3. The net clear opening dimensions required by this section shall be obtained by the normal operation of the emergency escape and rescue opening from the inside. Emergency escape and rescue openings with a finished sill height below the adjacent ground elevation shall be provided with a window well in accordance with Section R310.2. Emergency escape and rescue openings shall open directly into a public way, or to a yard or court that opens to a public way.

Exceptions:

1. Basements used only to house mechanical equipment and not exceeding total floor area of 200 square feet (18.58 m²).
2. The emergency escape and rescue opening shall be permitted to open into a screen enclosure, open to the atmosphere, where a screen door is provided leading away from the residence.

R310.1.1 Minimum opening area.

All emergency escape and rescue openings shall have a minimum net clear opening of 5.7 square feet (0.530 m²).

Exception:

Grade floor openings shall have a minimum net clear opening of 5 square feet (0.465 m²).

R310.1.2 Minimum opening height.

The minimum net clear opening height shall be 24 inches (610 mm).



R310.1.3 Minimum opening width.

The minimum net clear opening width shall be 20 inches (508 mm).

R310.1.4 Operational constraints.

Emergency escape and rescue openings shall be operational from the inside of the room without the use of keys, tools or special knowledge.

FOOTAGES (A.N.S.I.):	
GARAGE:	559.60
SLAB AREA:	559.60
HEATED:	393.17
ENTRY:	40.00
BALCONIES:	166.43
UNDER ROOF:	1,159.20

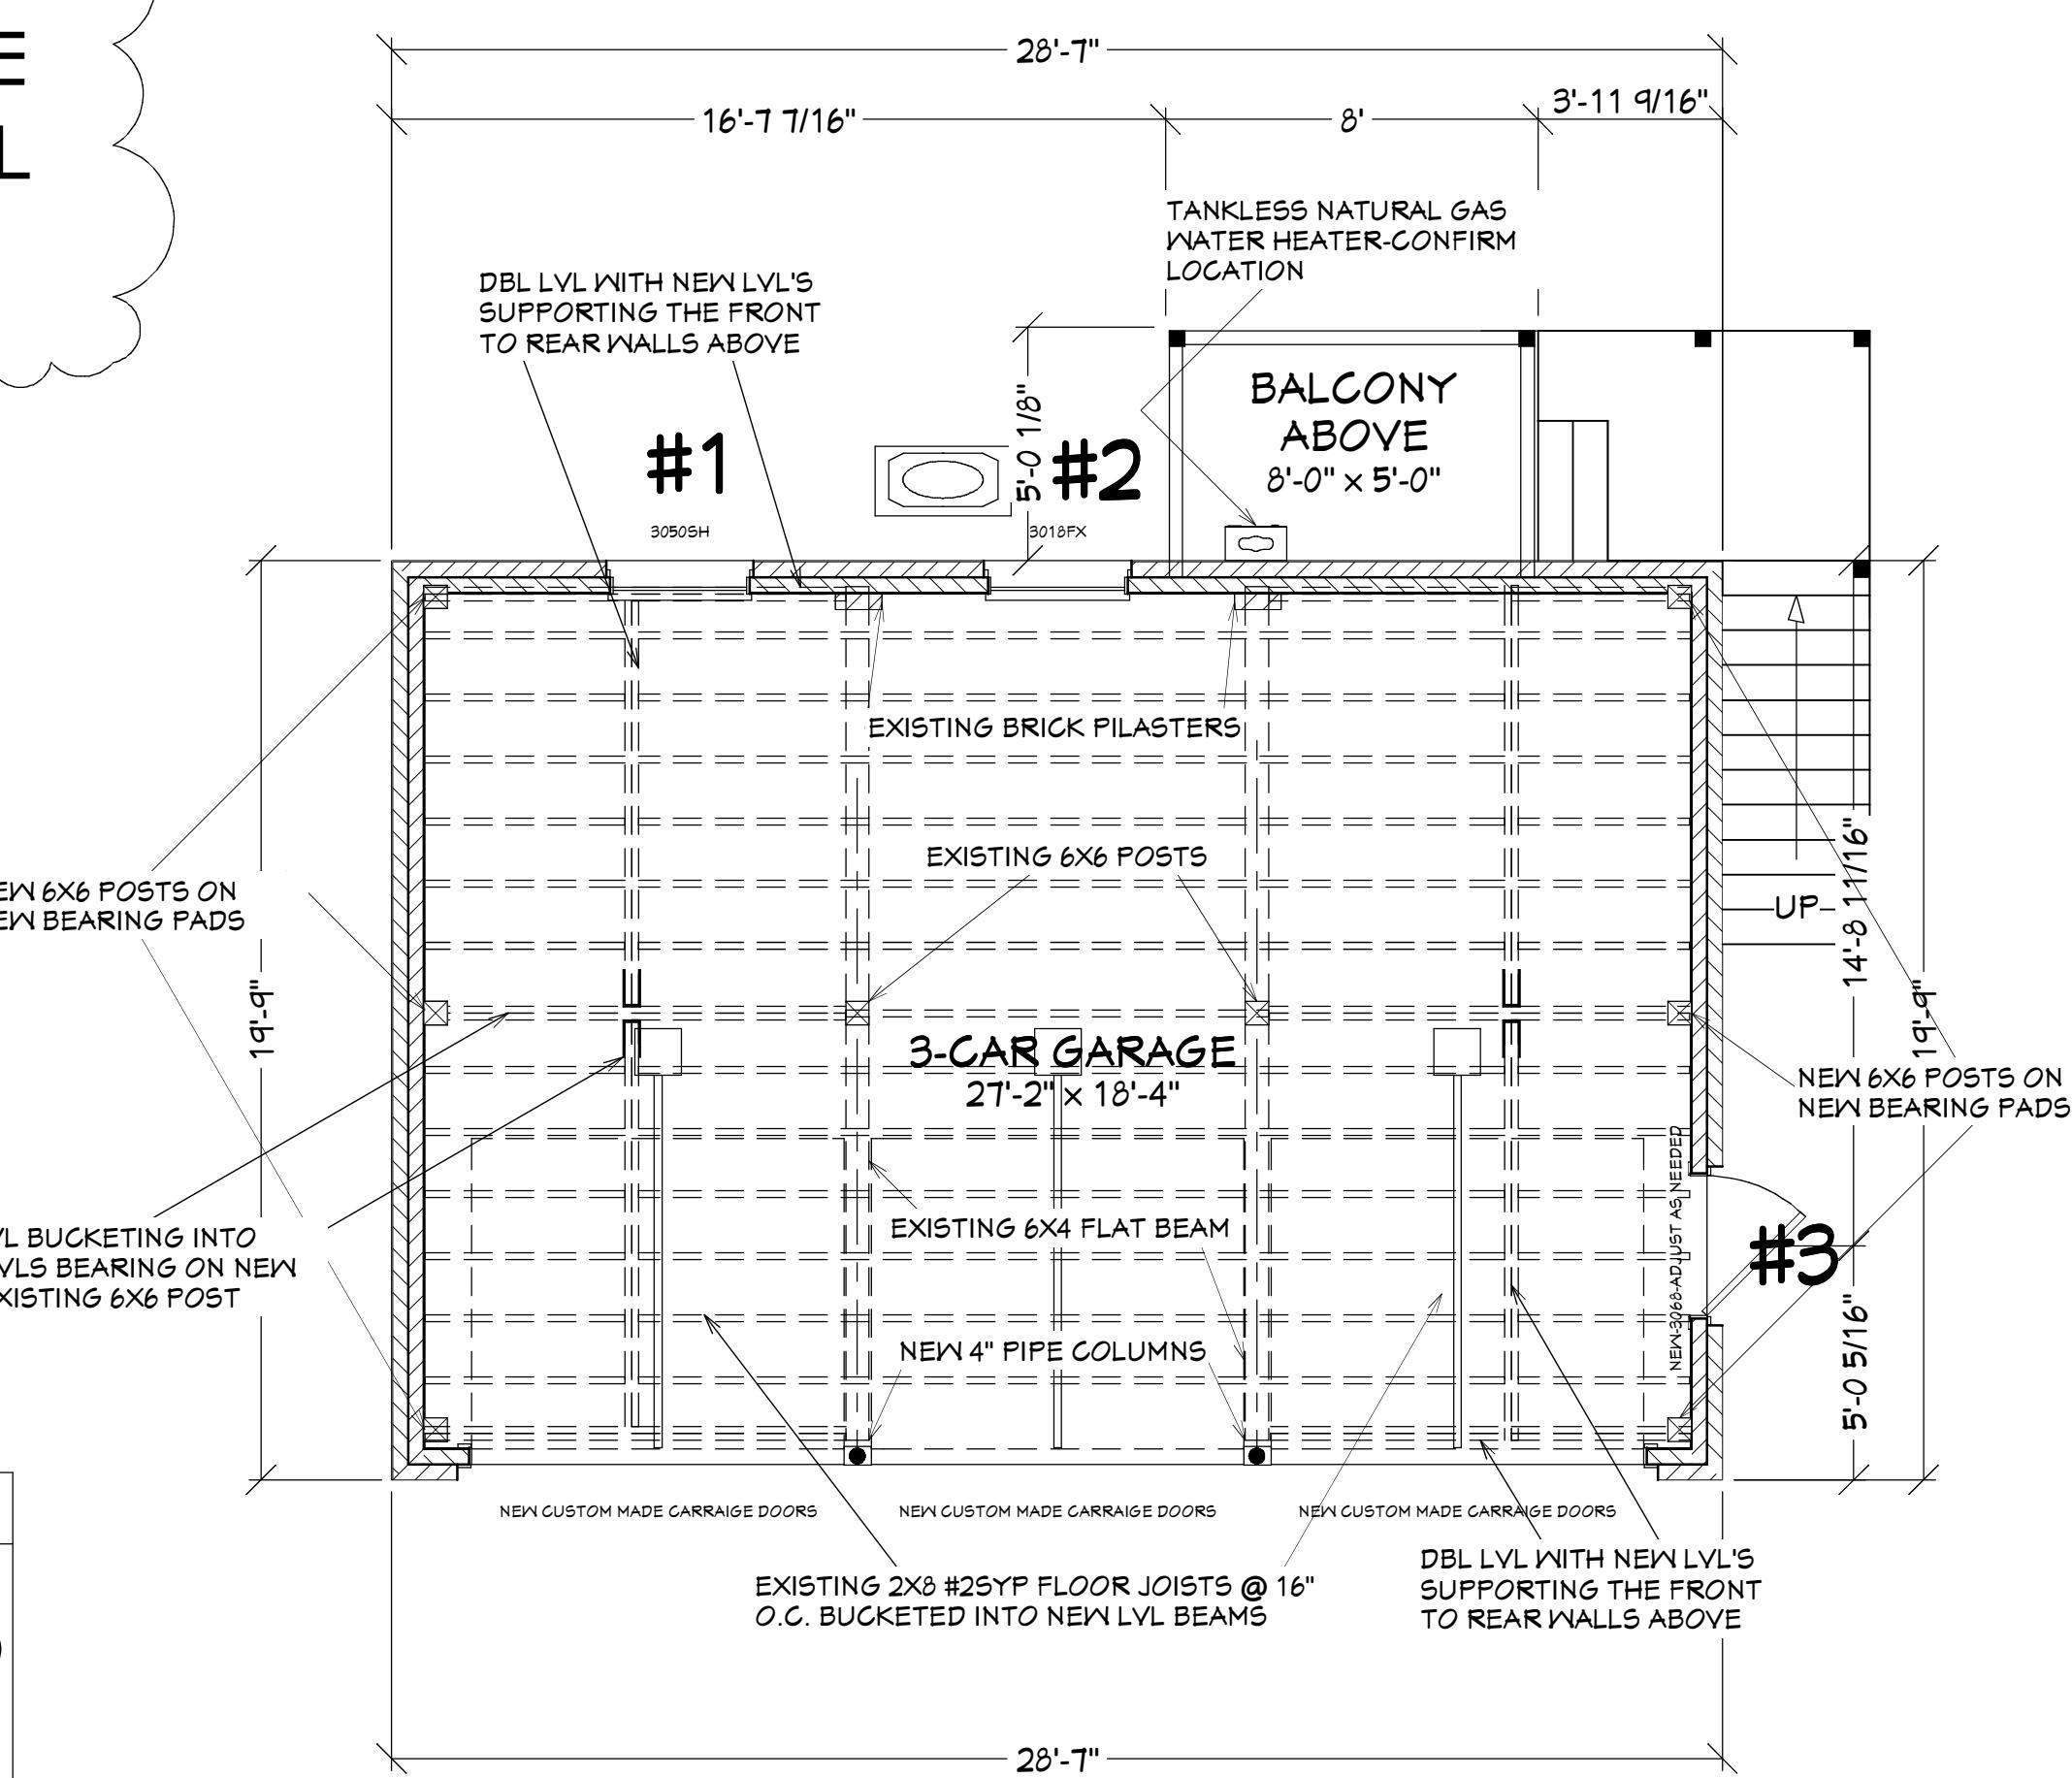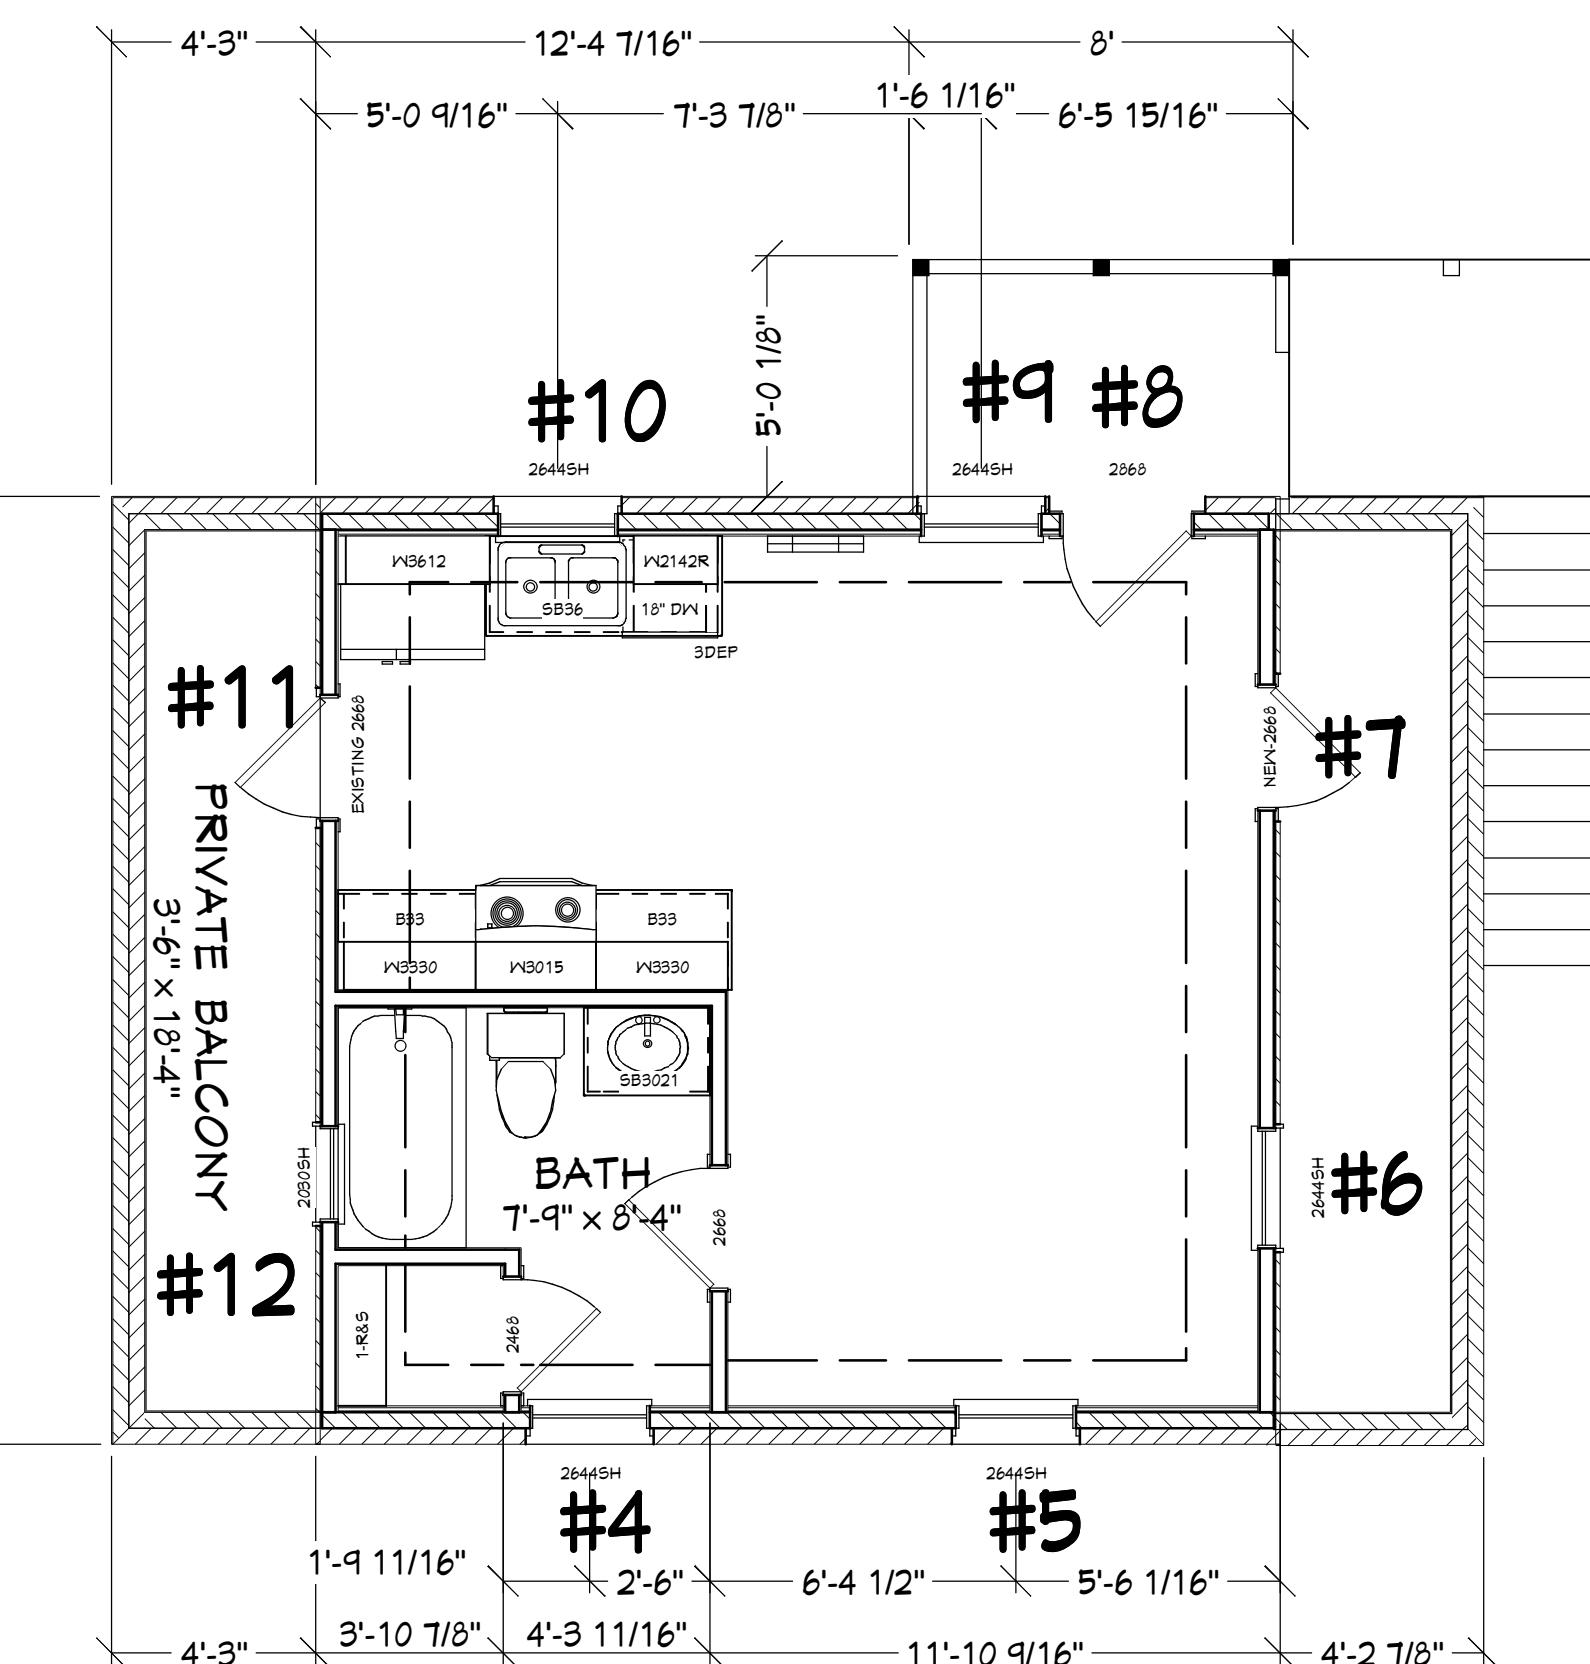

PROPOSED FLOOR PLANS

COPYRIGHT 2016. DESIGNS FOR LIVING, LLC. Under section 102 of the Architectural Works Copyright Protection Act (title 17 of the United States Code) specific fair use rights apply to original design of a building created in any tangible medium of expression, including a constructed building or architectural plans, models, or drawings, and is subject to copyright protection. It is unlawful for anyone to copy these drawings either in whole or in part, without the express written permission of the designer. The use of any plans, specifications, electronic or hard copy prints, drawings, or other materials of any kind, for the design, construction, or modification of any buildings, structures, or facilities, or for any other purpose, without the express written permission of the designer, is a violation of federal law. No portion of these drawings, or their purposed use, constitutes a prime factor in the defense of these restrictions! This is held true in the North Florida Court system. The contractor and the owners also duly acknowledge that they have full copyright, release approval and Designs for Living, LLC to R.E. Chip Mitchell. Chip Mitchell shall not be liable for copyright infringement or other errors after delivery via email of drawings including after construction has begun! This copyright law is only valid on buildings designs created on or after December 1, 1990.

PLAN #
2061-R

CLIENT APPROVAL SIGNATURE	DATE
STEPHAN D. LAMSENS	

BUILT BY:	DOXA PROPERTIES, LLC
	8862 CANOPY OAKS DRIVE
	JACKSONVILLE, FL 32256
	904-219-9279 CGC1504721

PROJECT DESCRIPTION:	GARAGE RENOVATIONS FOR STEPHEN LAMSENS
	873 Goodwin Street/2061-1 College St
	Jacksonville, FL 32204

Design Drawings provided by:	DESIGNS FOR LIVING, LLC
	RECREATIONAL DESIGNERS SINCE 1989
	904-730-2135

DATE:	8/30/2016
SCALE:	1/4" = 1'-0"
SHEET:	A-6

CLIENT APPROVAL SIGNATURE DATE

STEPHAN D. LAMSENS

DOXA PROPERTIES, LLC
8862 CANOPY OAKS DRIVE
JACKSONVILLE, FL 32256
904-219-9279 CGC1504721

BUILT BY:

STEPHEN LAMSENS

PROJECT DESCRIPTION:
GARAGE RENOVATIONS FOR STEPHEN
LAMSENS
873 Goodwin Street/2061-1 College St
Jacksonville, FL 32204DESIGNS FOR LIVING, LLC
RECREATIONAL, DESIGN & BUILD SINCE 1989

904-730-2135

Design Drawings

provided by:

DATE:
8/30/2016

SCALE:

1/2" = 1'-0"


SHEET:

A-7


Copyright 2016. DESIGNS FOR LIVING, LLC. Under section 102 of the Architectural Works Copyright Protection Act (title 17 of the United States Code) specific fair use rights apply to original designs of a building created in any tangible medium of expression, including a constructed building or architectural plans, models, or drawings, and is subject to copyright protection. It is unlawful for anyone to copy these drawings either in whole or in part, without the express written permission of the designer. The use of any plans, specifications, electronic or hard copy prints, drawings, or other materials of any kind, for which the original plan, drawing, or specification was developed, or modified, from the designs or specifications of any architect, engineer, or designer, or any other person, shall be considered to be the original plan, drawing, or specification of the designer. All drawings, specifications, and modified drawings, or other materials of any kind, for which the original plan, drawing, or specification was developed, or modified, from the designs or specifications of any architect, engineer, or designer, or any other person, shall be considered to be the original plan, drawing, or specification of the designer. No exception is made for the reuse of any drawings, or other materials, or their purchase constitutes prima facie evidence of the acceptance of these restrictions! This is a valid contract in the State of Florida. A Court system and all locations will result in legal action being taken, and the parties also fully acknowledge that they have full copyright release approval and Designs for Living, LLC to R.E. Chip Mitchell shall not be liable for error for copyright infringement or other errors after delivery via email or otherwise. This copyright law is only valid on buildings designs created on or after December 1, 1990.

CONTRACT NOTE: CONTRACT AND SPECIFICATIONS TAKE PRECEDENCE OVER THESE DRAWINGS. ANY CONFLICT WILL DEFAULT TO SAID DOCUMENTS.

NOTE: ENGINEERS DETAILS TAKE PRECEDENCE!

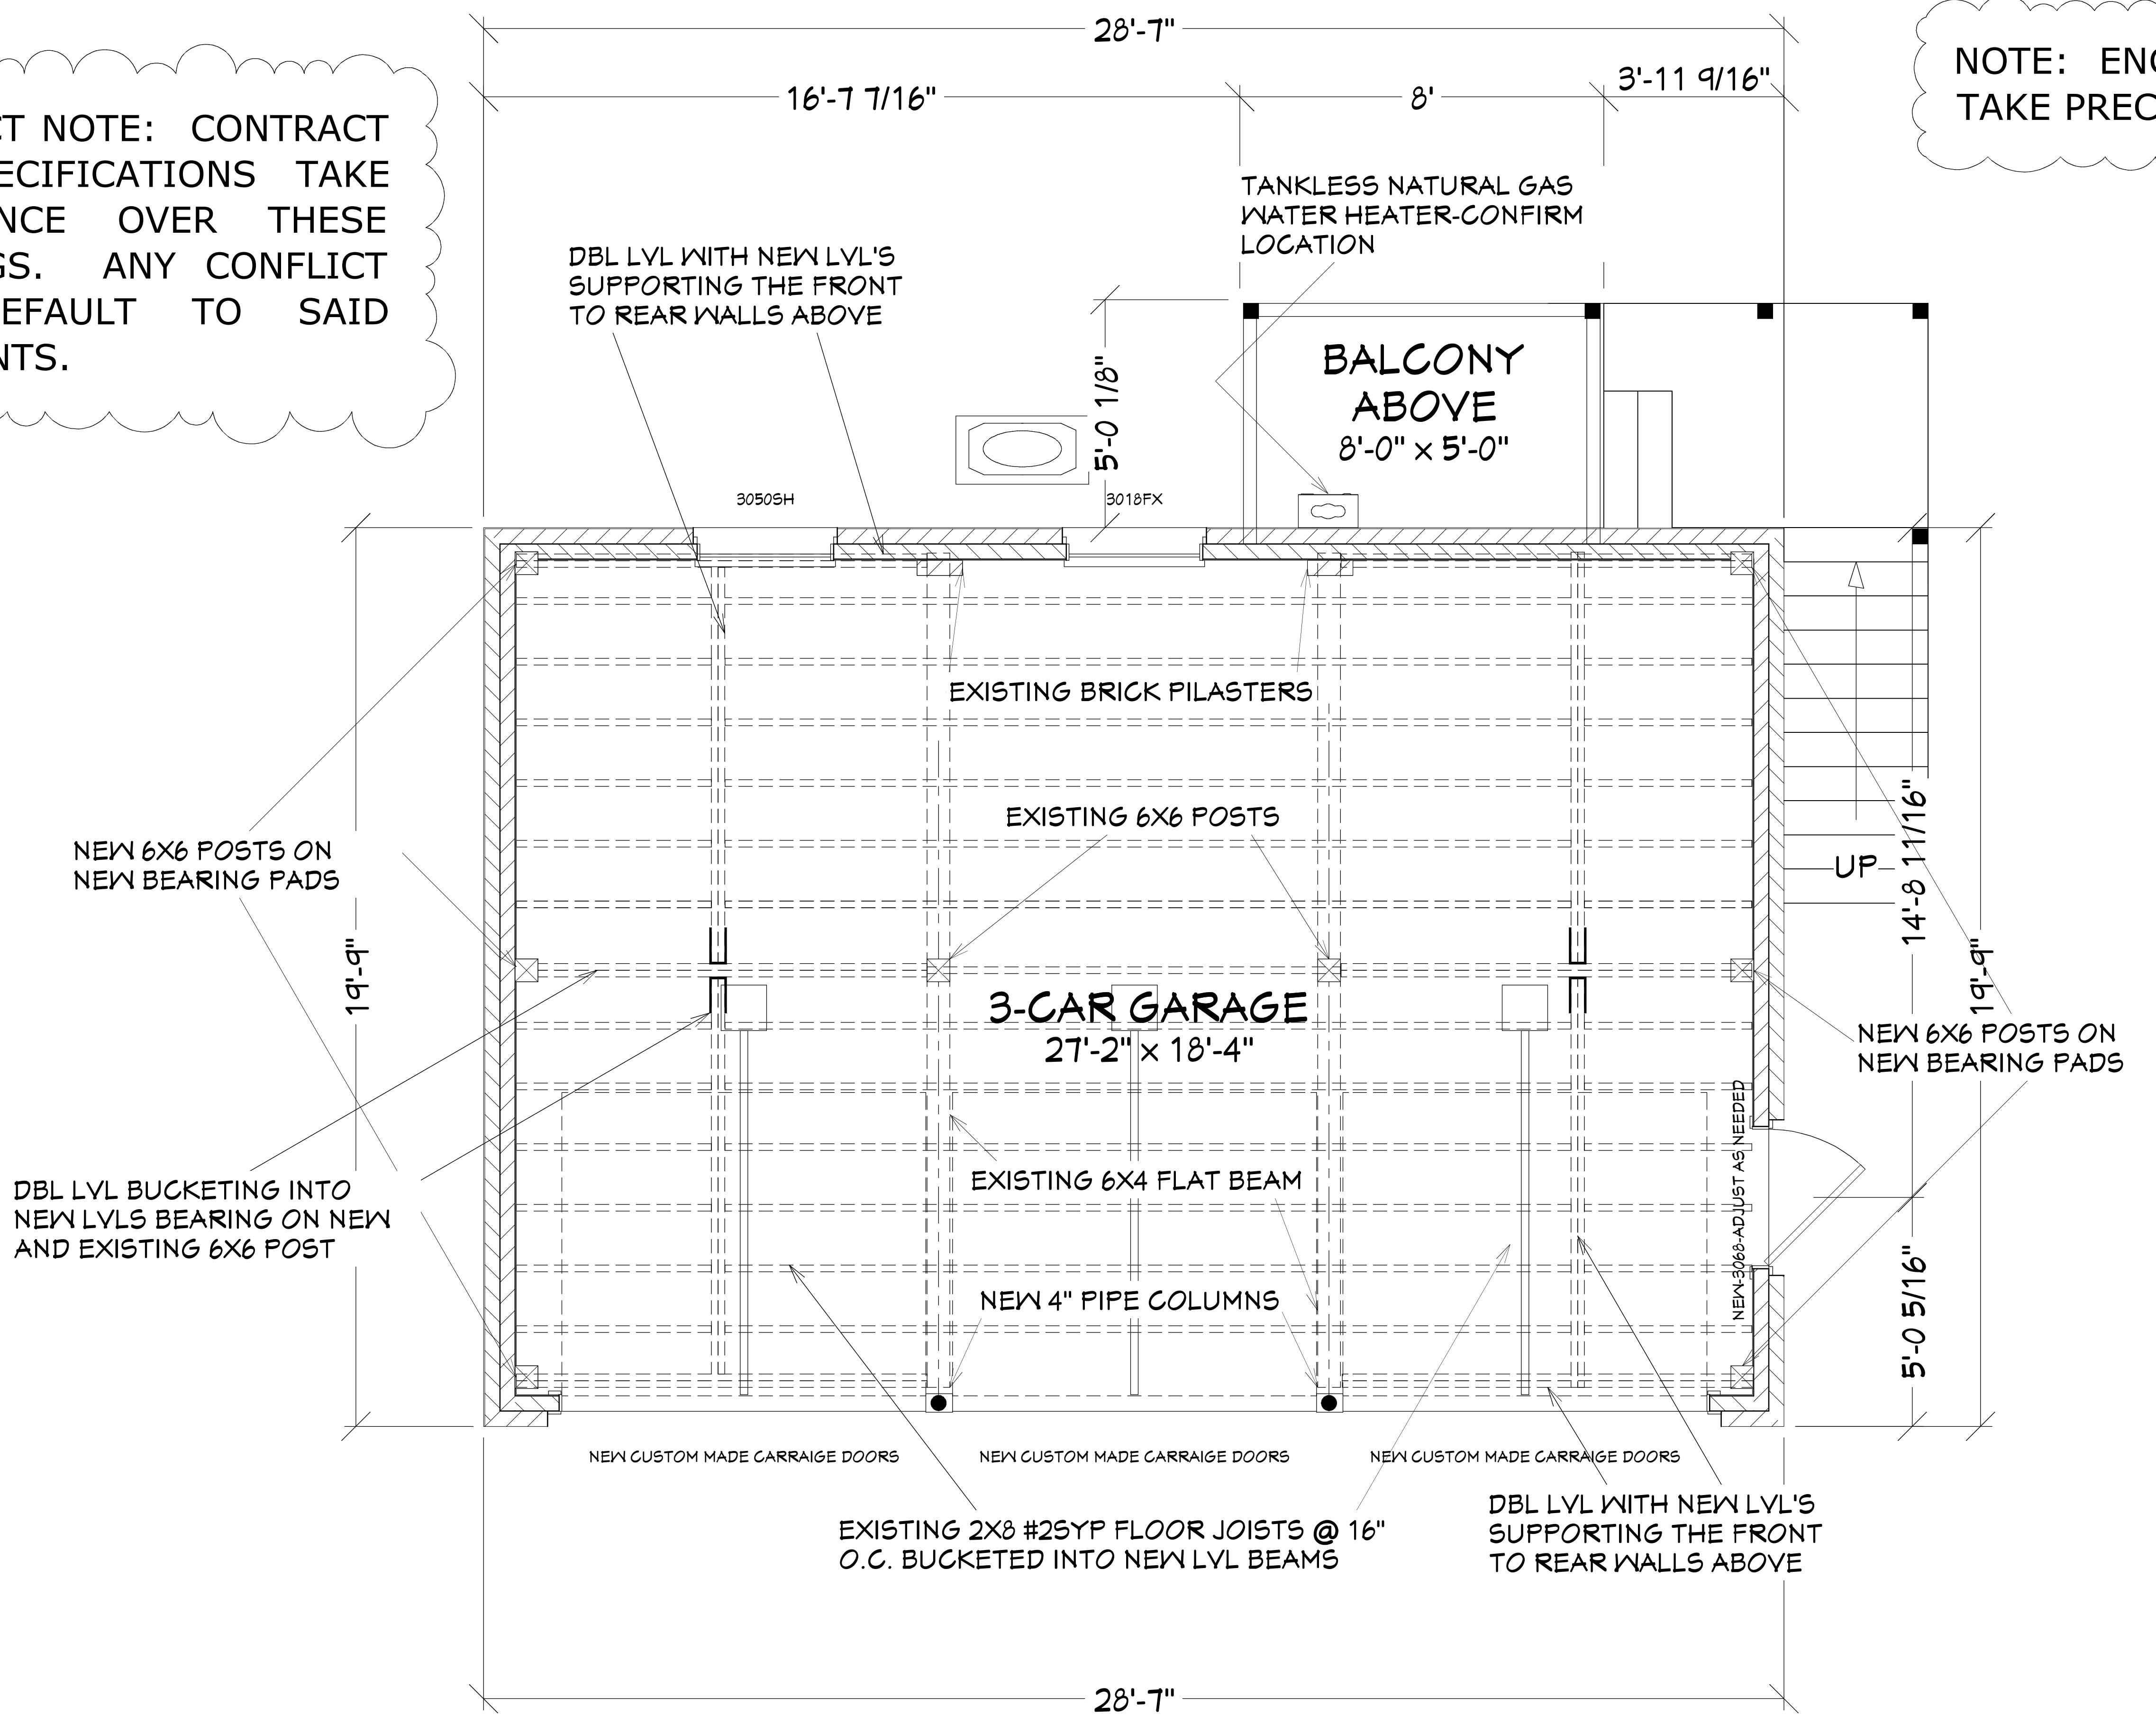

1ST FLOOR FRAMING PLAN

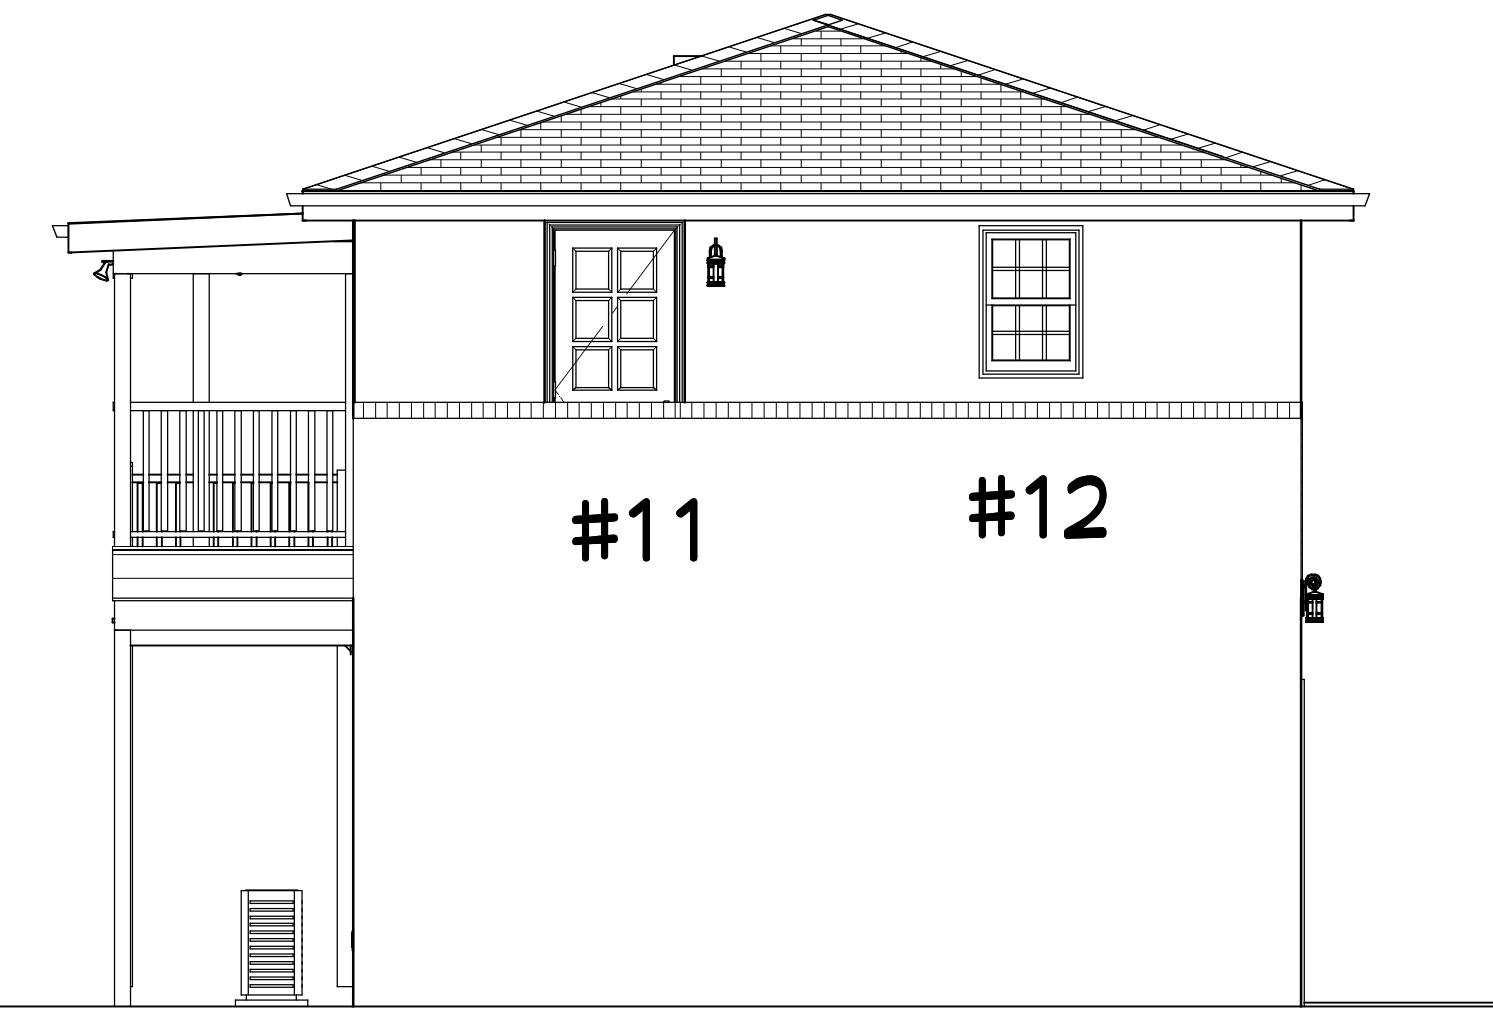


LEFT ELEVATION




RIGHT ELEVATION

CONTRACT NOTE: CONTRACT AND SPECIFICATIONS TAKE PRECEDENCE OVER THESE DRAWINGS. ANY CONFLICT WILL DEFAULT TO SAID DOCUMENTS.

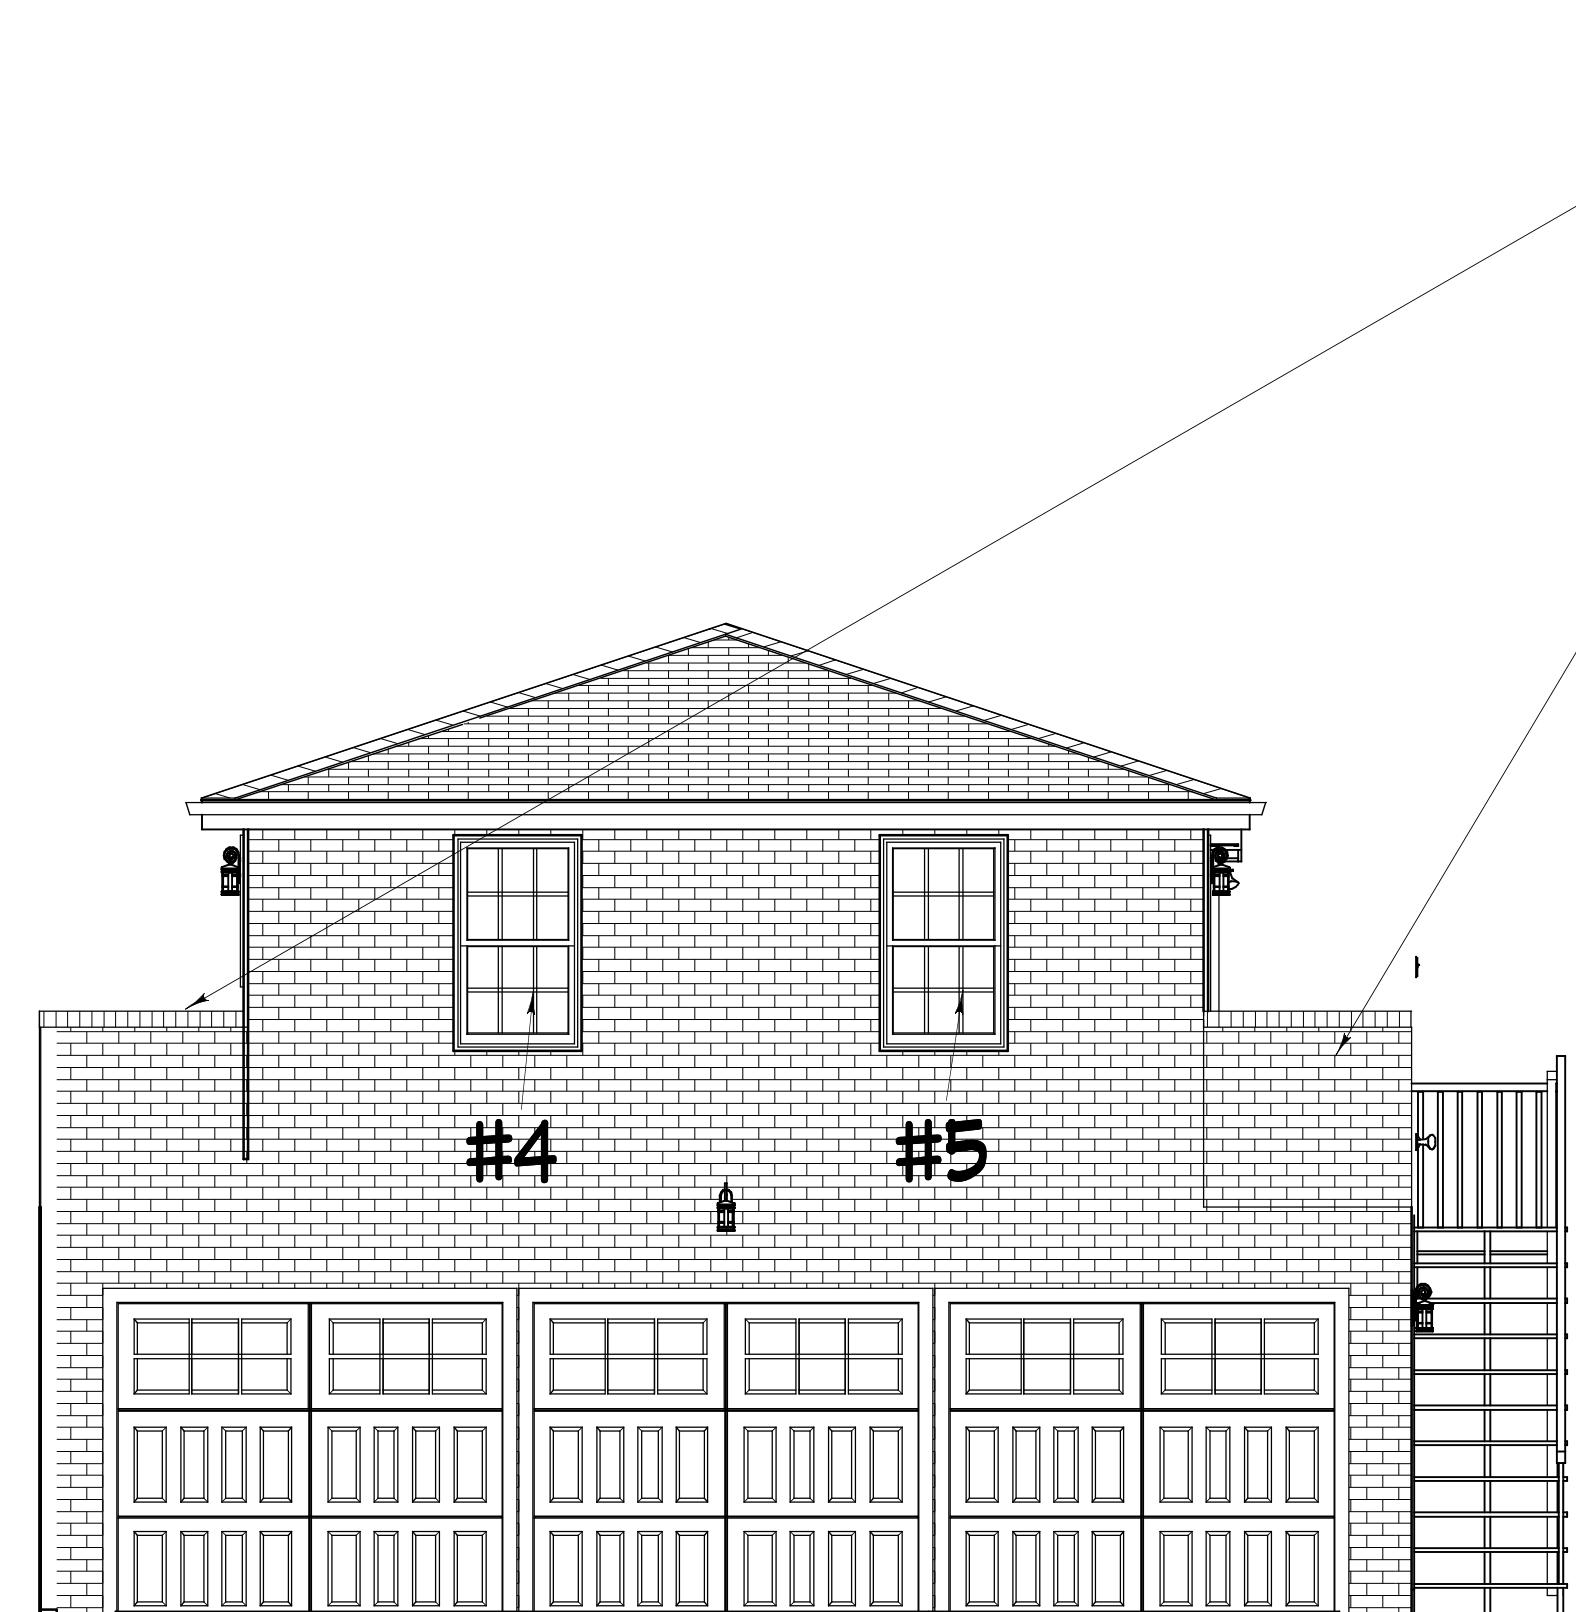

FRONT ELEVATION

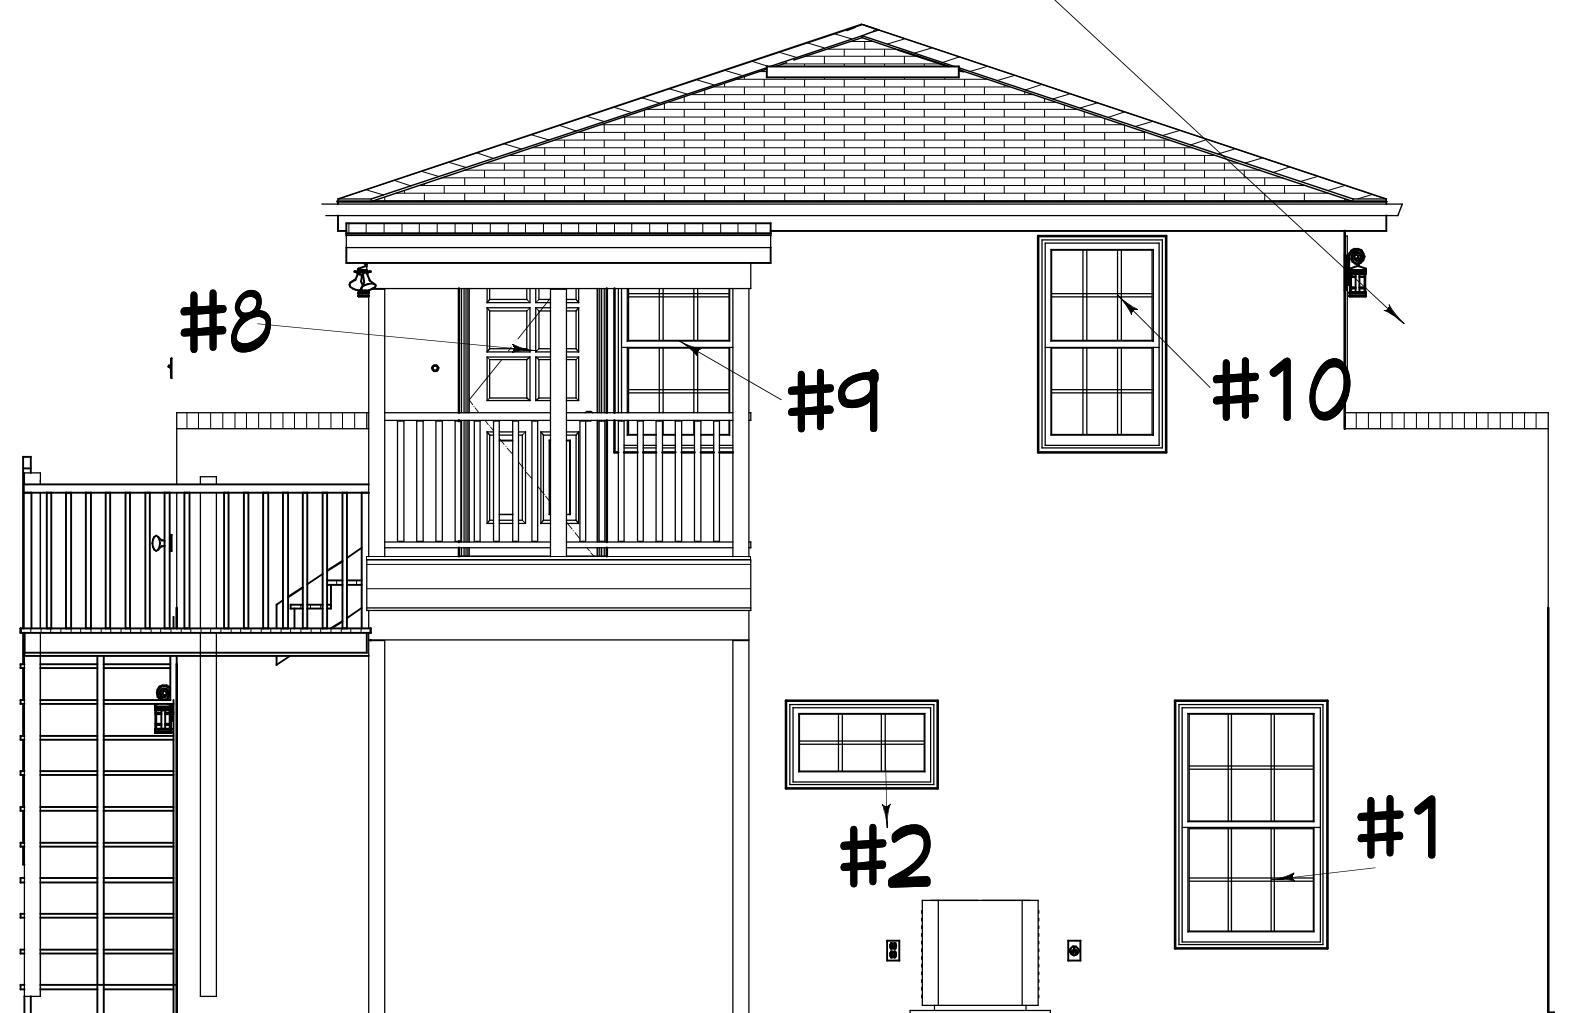

REAR ELEVATION

WINDOW & DOOR SURVEY WITH SCOPE OF WORK:

- 1: Existing 3050SH original window. Wish to replace with new SDL mutton vinyl window

2: Existing 3018FX original window damaged. Wish to replace with new SDL mutton vinyl window

3: Boarded up 3050SH window opening. Window missing and to be converted using a door to access the garage

4: Existing 2644SH original window. Wish to replace with new SDL mutton vinyl window.

5: Existing 2644SH original window. Wish to replace with new SDL mutton vinyl window.

6: Existing 2644SH original window. Wish to replace with new SDL mutton vinyl window.

7: Existing 2644SH original window. Wish to convert to new door to access the side porch.

8: Existing 1/2 glass door in steel. Wishing to replace with composite similar type door.

9: Existing 2644SH window is missing and boarded up. Wish to replace with new SDL mutton vinyl window.

10: Existing 2644SH original window. Wish to replace with new SDL mutton vinyl window.

11: Existing 2668 6-panel damaged jambs & door. Wishing to replace with composite similar type door assembly.

12: Existing 2030SH window missing & boarded up. Wish to replace with new SDL mutton vinyl window.

**PLAN #
2061-R**

CLIENT APPROVAL SIGNATURE _____ **DATE** _____

BUILT BY:
DOXA PROPERTIES, LLC
8862 CANOPY OAKS DRIVE
JACKSONVILLE, FL 32256
904-219-9279 CGC1504721

PROJECT DESCRIPTION:
GARAGE RENOVATIONS FOR STEPHEN
LAMSENS
73 Goodwin Street/2061-1 College St
Jacksonville, FL 32204



DESIGN DRAWINGS
PROVIDED BY:

DATE:

SCALE:

SECRET

SHEET

A-8

PROPOSED ELEVATIONS

ELECTRICAL - DATA - AUDIO LEGEND	
SYMBOL	DESCRIPTION
	Ceiling Fan
	Ventilation Fans: Ceiling Mounted, Wall Mounted
	Ceiling Mounted Light Fixtures: Surface/Pendant, Recessed, Heat Lamp, Low Voltage
	Wall Mounted Light Fixtures: Flush Mounted, Wall Sconce
	Chandelier Light Fixture
	Fluorescent Light Fixture
	240V Receptacle
	110V Receptacles: Duplex, Weather Proof, GFCI
	Switches: Single Pole, Weather Proof, 3-Way, 4-Way
	Switches: Dimmer, Timer
	Audio Video: Control Panel, Switch
	Speakers: Ceiling Mounted, Wall Mounted
	Wall Jacks: CAT5, CAT5 + TV, TV/Cable
	Telephone Jack
	Intercom
	Thermostat
	Door Chime, Door Bell Button
	Smoke Detectors: Ceiling Mounted, Wall Mounted
	Electrical Breaker Panel


CONTRACT NOTE: CONTRACT AND SPECIFICATIONS TAKE PRECEDENCE OVER THESE DRAWINGS. ANY CONFLICT WILL DEFAULT TO SAID DOCUMENTS.

ELECTRICAL NOTES:

1. METER IS EXISTING
2. PROPERTY IS PUBLIC WATER & SEWER
3. WATER HEATER TO BE 50 GALLON ELECTRIC
4. SECURITY PRE-WIRE & TRIM -CONFIRM
5. PRE-WIRE & TRIM FOR CAT5/TV PER PLANS-CONFIRM
6. CONFIRM WITH OWNER ON STRUCTURED WIRING
7. ONE-150 AMP ELECTRICAL PANEL
8. CONFIRM ALL ELECTRICAL W/OWNER PRIOR TO WIRING ANYTHING

PER FBC-R-E3902.12 AFCI PROTECTION REQUIRED Arc-fault circuit-interrupter protection. All branch circuits that supply 120-volt, single-phase, 15- and 20-ampere outlets installed in family rooms, dining rooms, living rooms, parlors, libraries, dens, bedrooms, sunrooms, recreation rooms, closets, hallways, or similar rooms or areas shall be protected by a listed AFCI, combination type.

PER FBC-R-E3901.7, NEC 210, E3901.7 & E3902.3 GFCI PROTECTION REQUIRED Bathrooms, garages, boathouses & accessory structures not intended as habitable rooms and limited to storage, work & similar uses. Outdoors, crawl spaces, unfinished basements, kitchen countertops. Outlets within 6 feet of laundry, utility or wet sinks. Balcony, deck or porch greater than 20 s.f. One at the front and back of the dwelling and at the condenser units.

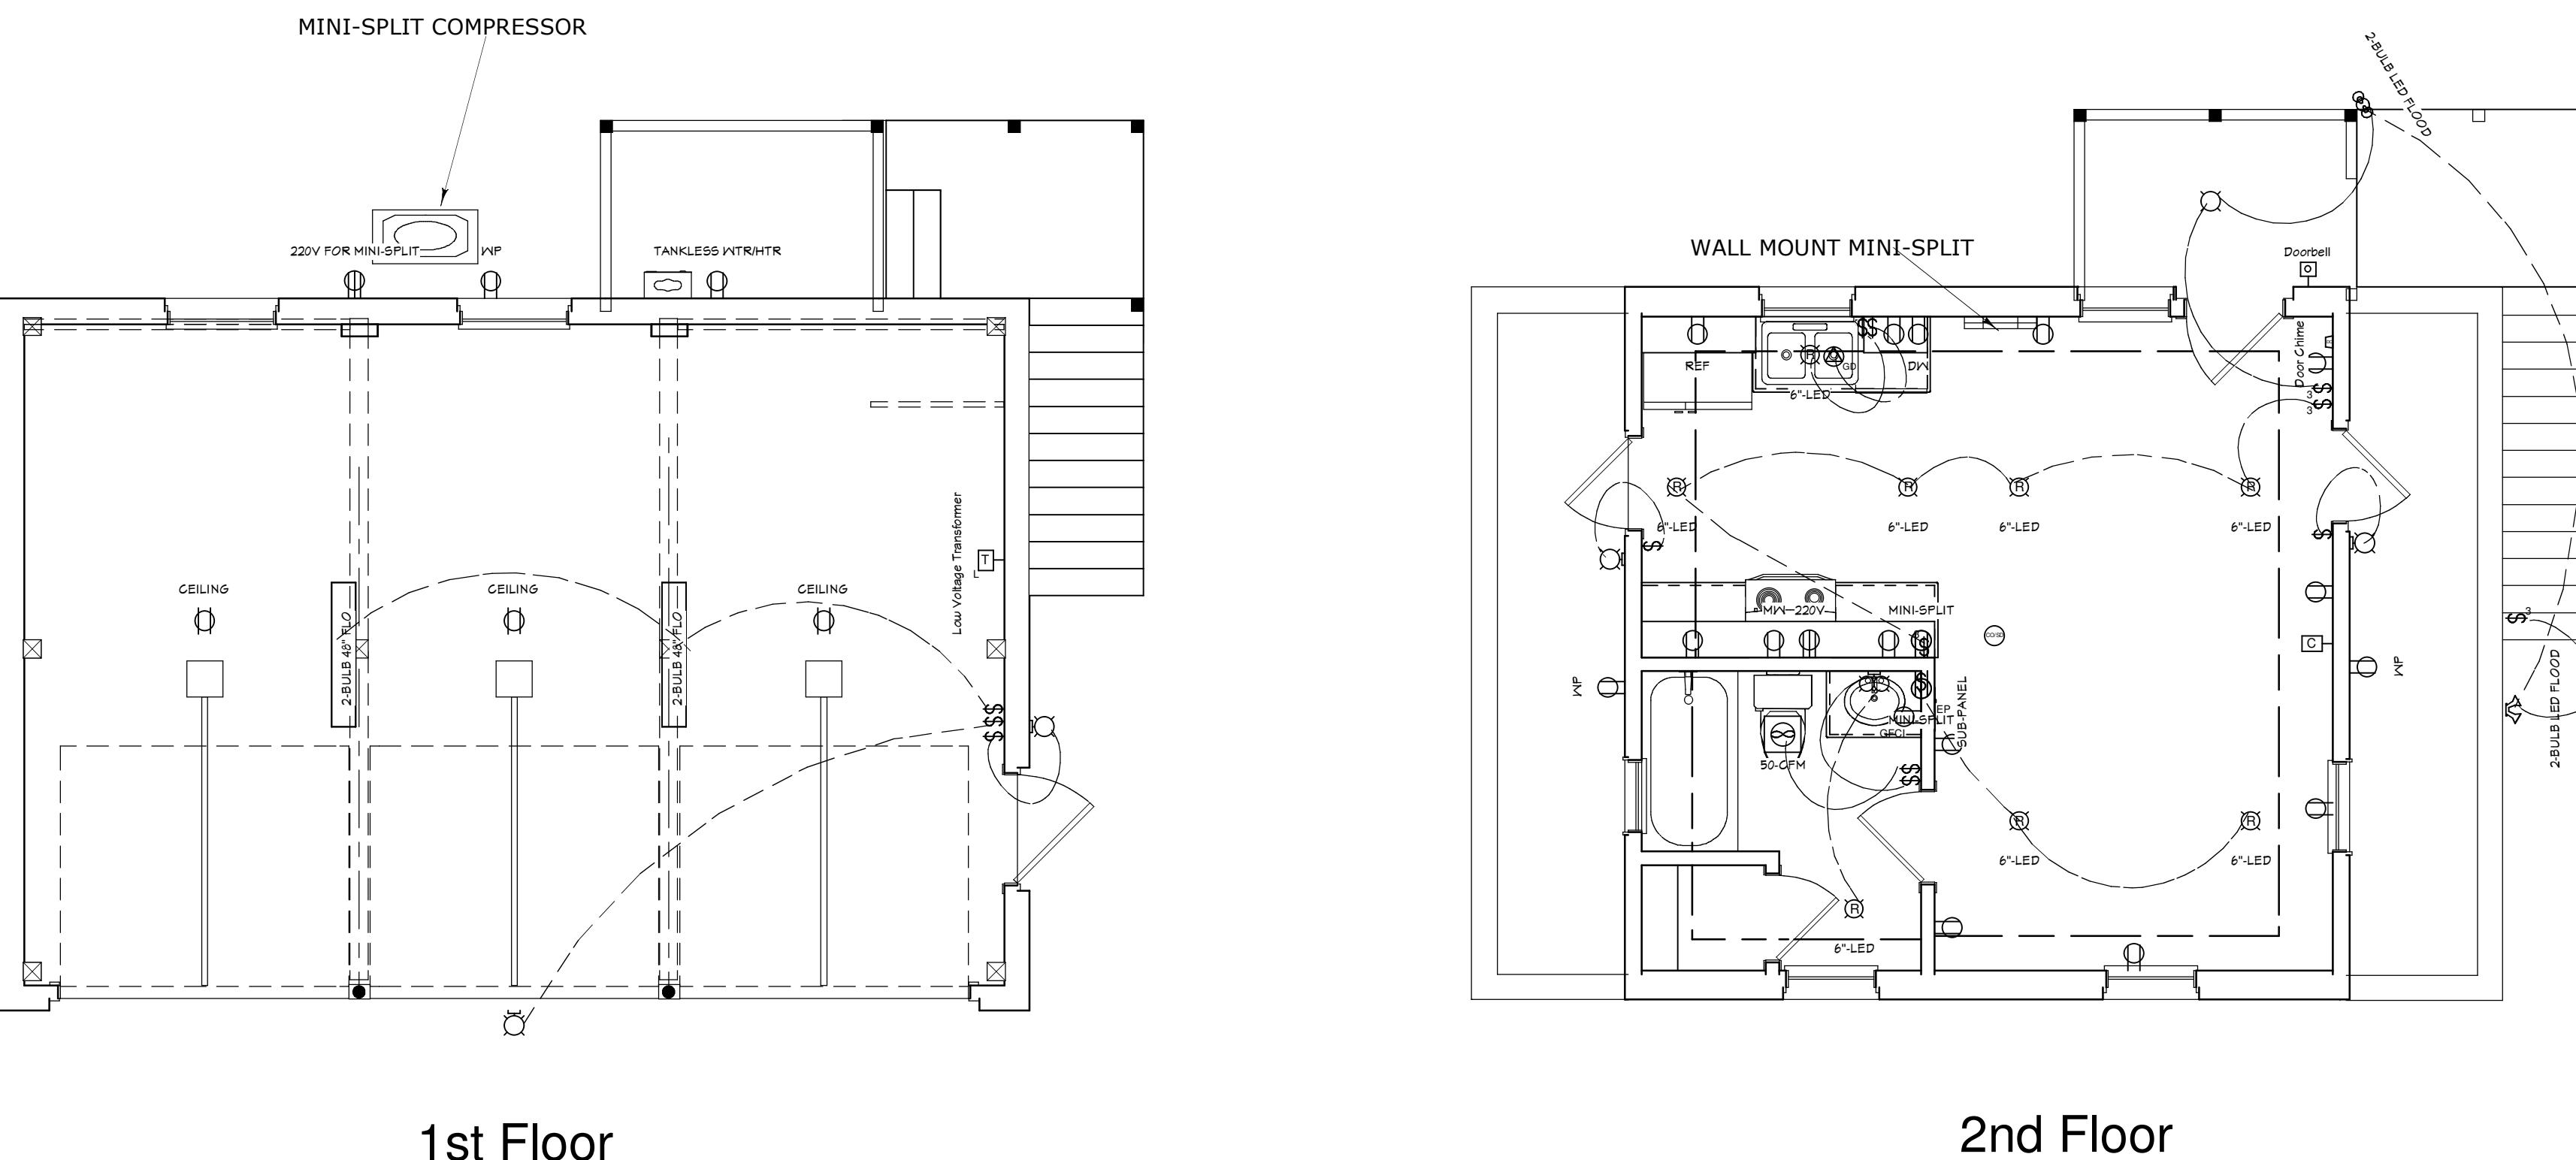

1st Floor

2nd Floor

EFFICACY NOTE: THE NEW FBC-R FBC EC R404.1 & R202 BUILDING CODE REQUIRES ALL INSIDE & OUTSIDE LIGHT FIXTURES WILL USE CFL OR LED LIGHT BULBS.

CONTRACT NOTE: CONTRACT AND SPECIFICATIONS TAKE PRECEDENCE OVER THESE DRAWINGS. ANY CONFLICT WILL DEFAULT TO SAID DOCUMENTS.

ELECTRICAL PLAN

COPYRIGHT 2016. DESIGNS FOR LIVING, LLC. Under section 102 of the Architectural Works Copyright Protection Act (title 17 of the United States Code) specific fair use rights apply to original design of a building created in any tangible medium of expression, including a constructed building or architectural plans, models, or drawings, and is subject to copyright protection. It is unlawful for anyone to copy these drawings either in whole or in part, without the express written permission of the designer. The use of any plans, specifications, electronic or hard copy prints, drawings or other materials of any kind, for which these plans were prepared and published, or for which these plans were designed, is expressly prohibited. This copyright law is only valid on buildings designs created on or after December 1, 1990.

BUILT BY:
DOXA PROPERTIES, LLC
8862 CANOPY OAKS DRIVE
JACKSONVILLE, FL 32256
904-219-9279 CGC1504721

PROJECT DESCRIPTION:
GARAGE RENOVATIONS FOR STEPHEN
LAMSENS
873 Goodwin Street/2061-1 College St
Jacksonville, FL 32204

Design Drawings provided by:
DESIGNS FOR LIVING, LLC
RE-DESIGNERS SINCE 1989
904-730-2135


DATE: 8/30/2016
SCALE: 1/4" = 1'-0"
SHEET: A-9

CONTRACT NOTE: CONTRACT AND SPECIFICATIONS TAKE PRECEDENCE OVER THESE DRAWINGS. ANY CONFLICT WILL DEFAULT TO SAID DOCUMENTS.

ROOF NOTES (VERY CRITICAL):
PITCH: 4/12 & FLAT ROOF AT ENTRY
UNDERLayment: 30 # FELT MINIMUM
ROOFING: ENGINEERED METAL SHINGLES
LIKE THE ONES ON THE MAIN HOME
EAVE OVERHANG: MATCH EXISTING
PRE-ENGINEERED TRUSSES WITH 12" LEGS
SITTING ON THE EXISTING TOP PLATE. THE
TRUSSES WILL BE 2X6 TOP CHORD BEARING
TYPE WITH 2X6 LEGS THAT RAISE THE
CEILING FROM 7 FOOT INSIDE TO 8'-1&1/8"
WITH COLLAR TIES AT THE 8'-1&1/8" HEIGHT
SUBJECT TO TRUSS ENGINEERING.

NOTE: ENGINEERS DETAILS TAKE PRECEDENCE!

4 FOOT OFF RIDGE VENT PER PLAN

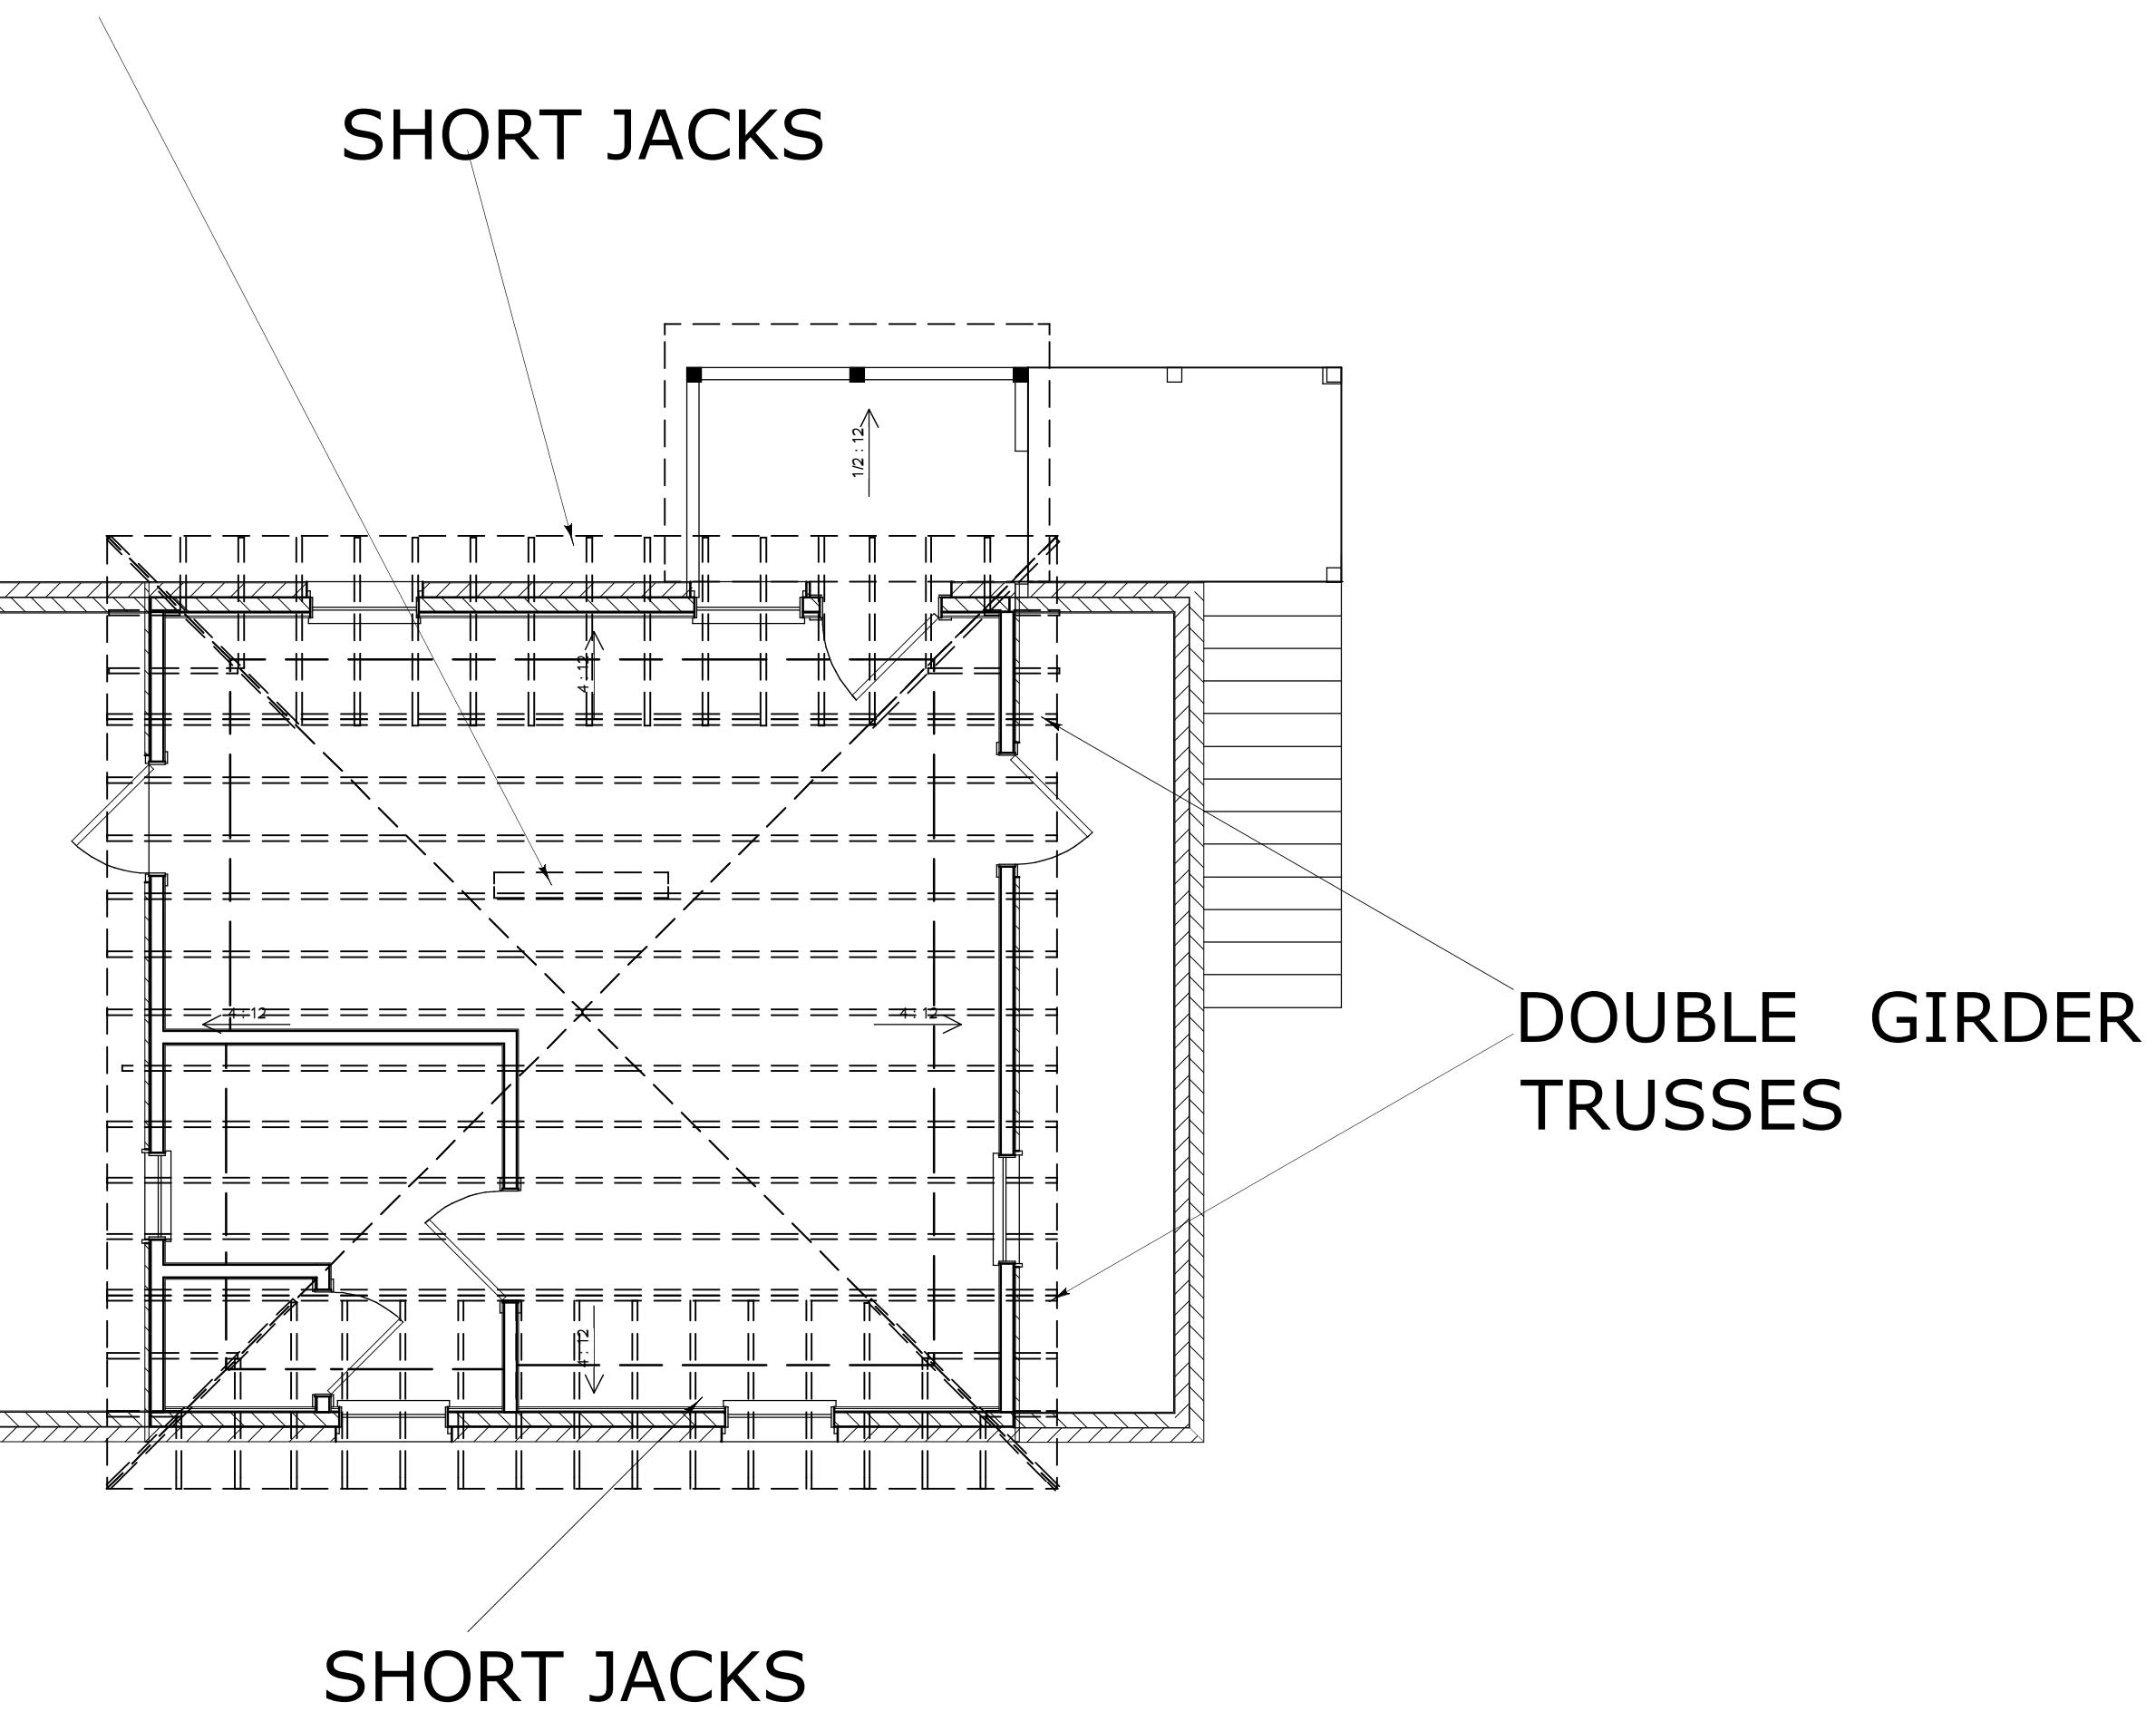

XISTING FLAT ROOF TO BE MOVED DOWN TO THE TOP PLATE

PROPOSED ROOF PLAN

**PLAN #
2061-R**

CLIENT APPROVAL SIGNATURE	DATE
STEPHAN D. LAMSENS	

BUILT BY:
DOXA PROPERTIES, LLC
8862 CANOPY OAKS DRIVE
JACKSONVILLE, FL 32256
904-219-9279 CGC150472

**'PROJECT DESCRIPTION:
GARAGE RENOVATIONS FOR STEPHEN
LAMSENS
8873 Goodwin Street/2061-1 College St
Jacksonville, FL 32204**

Design Drawings
provided by:

DESIGNS *for* LIVING LLC
RESIDENTIAL DESIGN SINCE 1969

904-730-7135

DATE:
8/30/2016
SCALE:
1/4" = 1'-0"
SHEET:
A-10

PLAN #
2061-R

CLIENT APPROVAL SIGNATURE DATE

STEPHAN D. LAMSENS

BUILT BY:
DOXA PROPERTIES, LLC
8862 CANOPY OAKS DRIVE
JACKSONVILLE, FL 32256
904-219-9279 CGC1504721

PROJECT DESCRIPTION:
GARAGE RENOVATIONS FOR STEPHEN
LAMSENS
873 Goodwin Street/2061-1 College St
Jacksonville, FL 32204

Design Drawings
provided by:
DESIGNS  LIVING, LLC
904-730-2135

DATE:
8/30/2016
SCALE:
N.T.S
SHEET:
A-11

COPYRIGHT 2016. DESIGNS FOR LIVING, LLC. Under section 102 of the Architectural Works Copyright Protection Act (title 17 of the United States Code) specific fair-use rights apply to original design of a building created in any tangible medium of expression, including a constructed building or architectural plans, models, or drawings, and is subject to copyright protection. It is unlawful for anyone to copy these drawings either in whole or in part, without the express written permission of the designer. The use of any plans, specifications, electronic or hard copy prints, drawings or other materials of any kind, for which the original plan or drawing was prepared and submitted, shall be restricted to the original client for whom they were prepared and submitted. Any unauthorized copying, reproduction, distribution, or publication of these drawings, or any portion thereof, is illegal and constitutes a criminal offense under the laws of the state of Florida. A Court system may award damages for the infringement of these restrictions! This shall supersede all other terms of the agreement of these restrictions. Every attempt has been made to avoid mistakes. The contractor and the owners also fully acknowledge that they shall verify all dimensions, details, & specifications prior to construction. Any conflict will default to said documents. Other errors after delivery via email of drawings including after construction has begun! This copyright law is only valid on building designs created on or after December 1, 1990.

