


RENOVATIONS FOR THE WILLIAMS FAMILY

PERMIT SET 5/6/2016

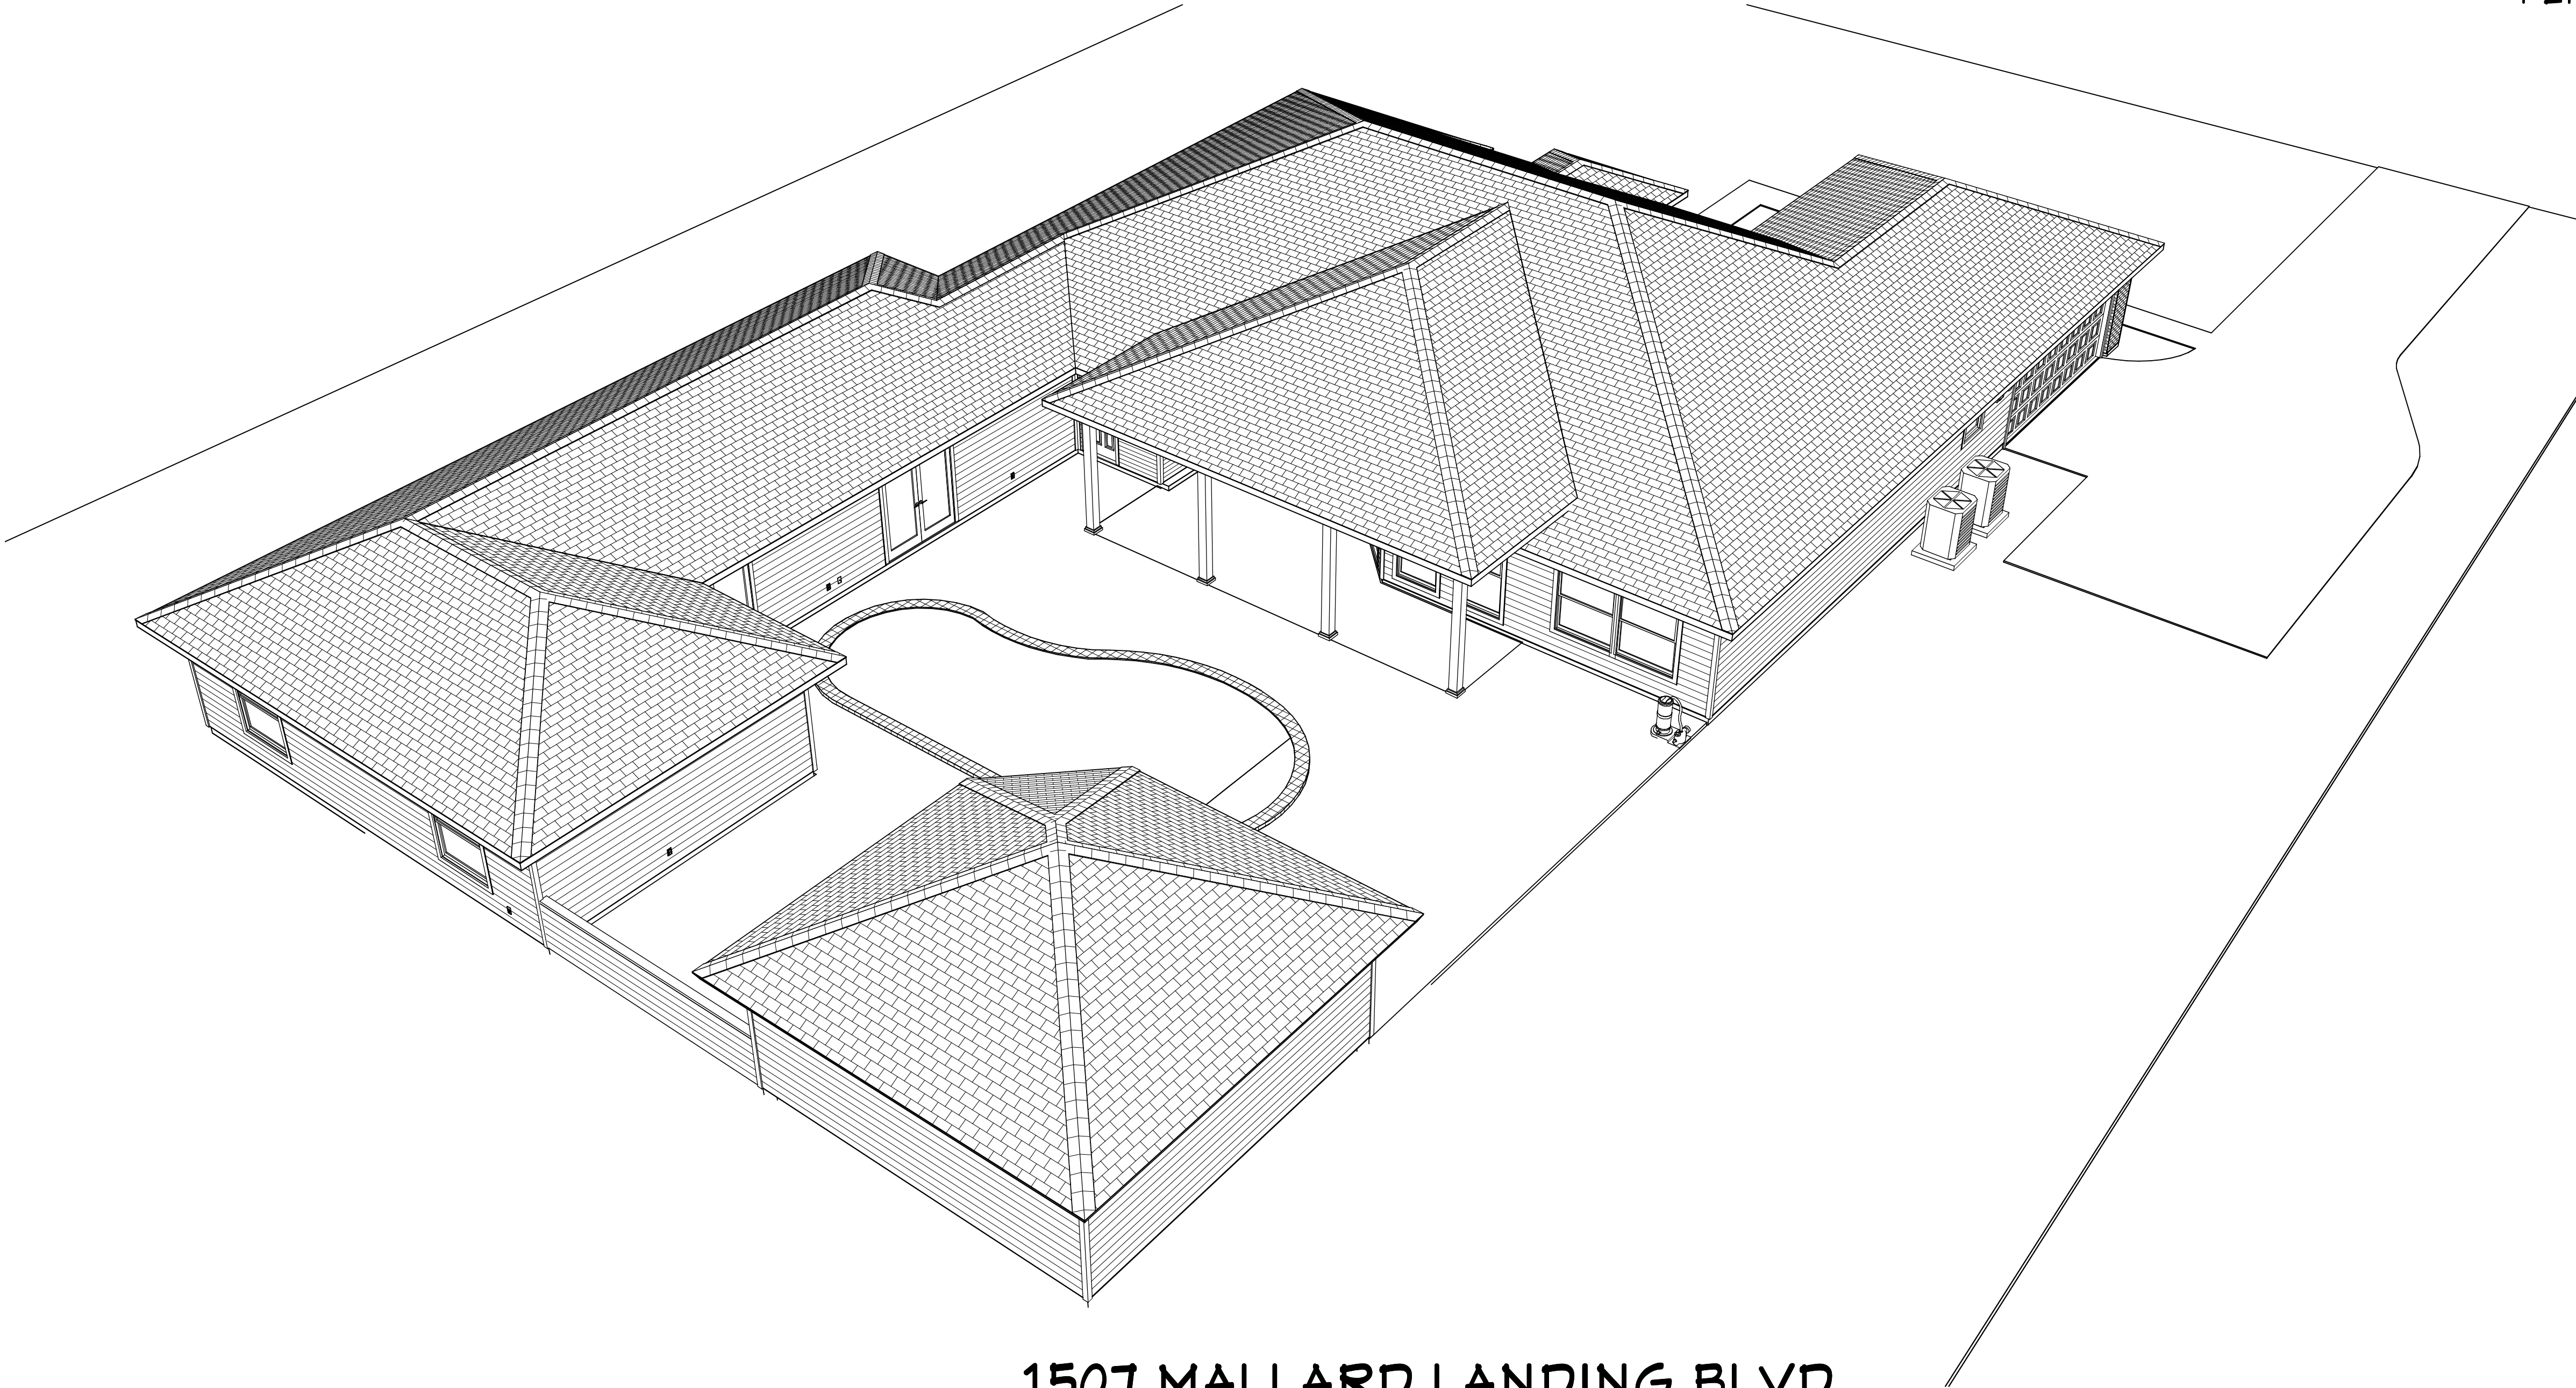

1507 MALLARD LANDING BLVD.
SAINT JOHNS, FL 32259

MALLARD LANDING, UNIT 2, LOT 44
R/E #: 010552-0440

BUILT BY CHAMPION HOMES, INC.
1213 CUNNINGHAM CREEK DRIVE
SAINT JOHNS, FL 32259
904-545-4769
CBC016614

COVER PAGE

COPYRIGHT 2016. DESIGNS FOR LIVING, LLC. Under Federal Statute HR 5490 of the Architectural Drawing Act & Title 17 specific tacit copyright laws apply to all published works of Designs for Living, LLC. herein referred to as Designer. It is unlawful for anyone to copy these drawings, either in whole or in part, without the express written permission of the Designer. The use of any plans, specifications, electronic or hard copy prints shall be restricted to the original site for which they were prepared and publication thereof is expressly limited to such use. Title to all works, specifically all drawings, specifications, and modified derivatives of any blueprints, e-files, or other digital or physical documents, shall remain the property of Designs for Living, LLC. No portion of these drawings, specifications, or other documents may be reproduced, stored in a retrieval system, or transmitted in any form or by any means, electronic, mechanical, photocopying, recording, or by any information storage and retrieval system, without the prior written permission of Designs for Living, LLC. Designs for Living, LLC shall not be liable for error after construction has begun.

DRAWINGS PROVIDED BY:

**Designs for Living,
LLC**
Residential Design & Consulting Since
1969, Serving NE FL Since 1978
904-993-2231

PROJECT DESCRIPTION:

**RENOVATIONS FOR THE
WILLIAMS FAMILY**
1507 MALLARD LANDING BLVD
SAINT JOHNS, FL 32259

BUILT BY:

CHAMPION HOMES, INC.
1213 CUNNINGHAM CREEK DRIVE
SAINT JOHNS, FL 32259
CBC016614
904-545-4769

DATE:

5/6/2016

SCALE:

N.T.S.

SHEET:

A-1

PLAN #:
1507-R


NO.	DESCRIPTION	BY	DATE

DEREK S. & PAMELA WILLIAMS; OWNERS
LOT 44, UNIT 2, MALLARD LANDING AS
RECORDED IN PLAT BOOK 3671, PAGES 524 OF
THE CURRENT PUBLIC RECORDS OF SAINT
JOHNS COUNTY, FLORIDA


R/E #: 010552-0440

IMPERVIOUS CALCULATIONS:
1.49 ACRES = 64,904 S.F.
BUILDING AREA: 4,773 S.F.=7.35%
WALKS, DRIVES & PADS: 1,863 S.F.=2.87%
POOL AREA: 993 S.F. = 1.53%
TOTAL IMPERVIOUS = 7,629 S.F.
64,904/7,629 = 11.75%

WIND DESIGN CRITERIA:
WIND SPEED: 130 MPH
EXPOSURE CATEGORY: "B"
BUILDING TYPE: ENCLOSED
BUILDING CATEGORY: II
IMPORTANCE FACTOR: 1.0
TOPOGRAPHY: SLIGHT SLOPE
MEAN ROOF HEIGHT: 14 FT
BUILDING CODE: FBC 2014-R

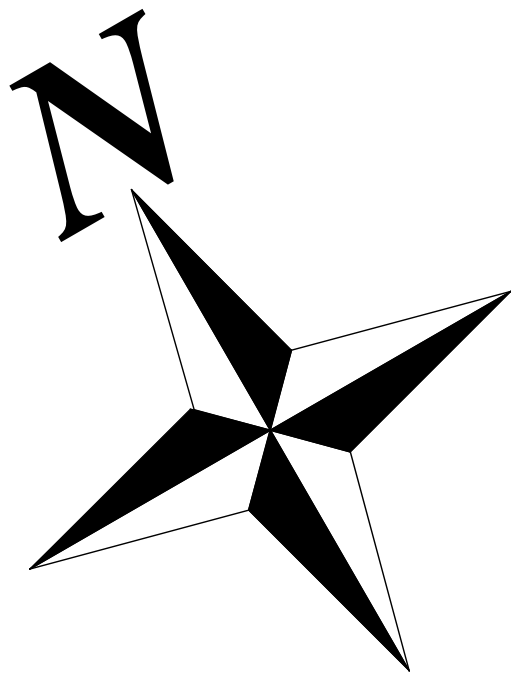

1507 MALLARD LANDING BLVD.

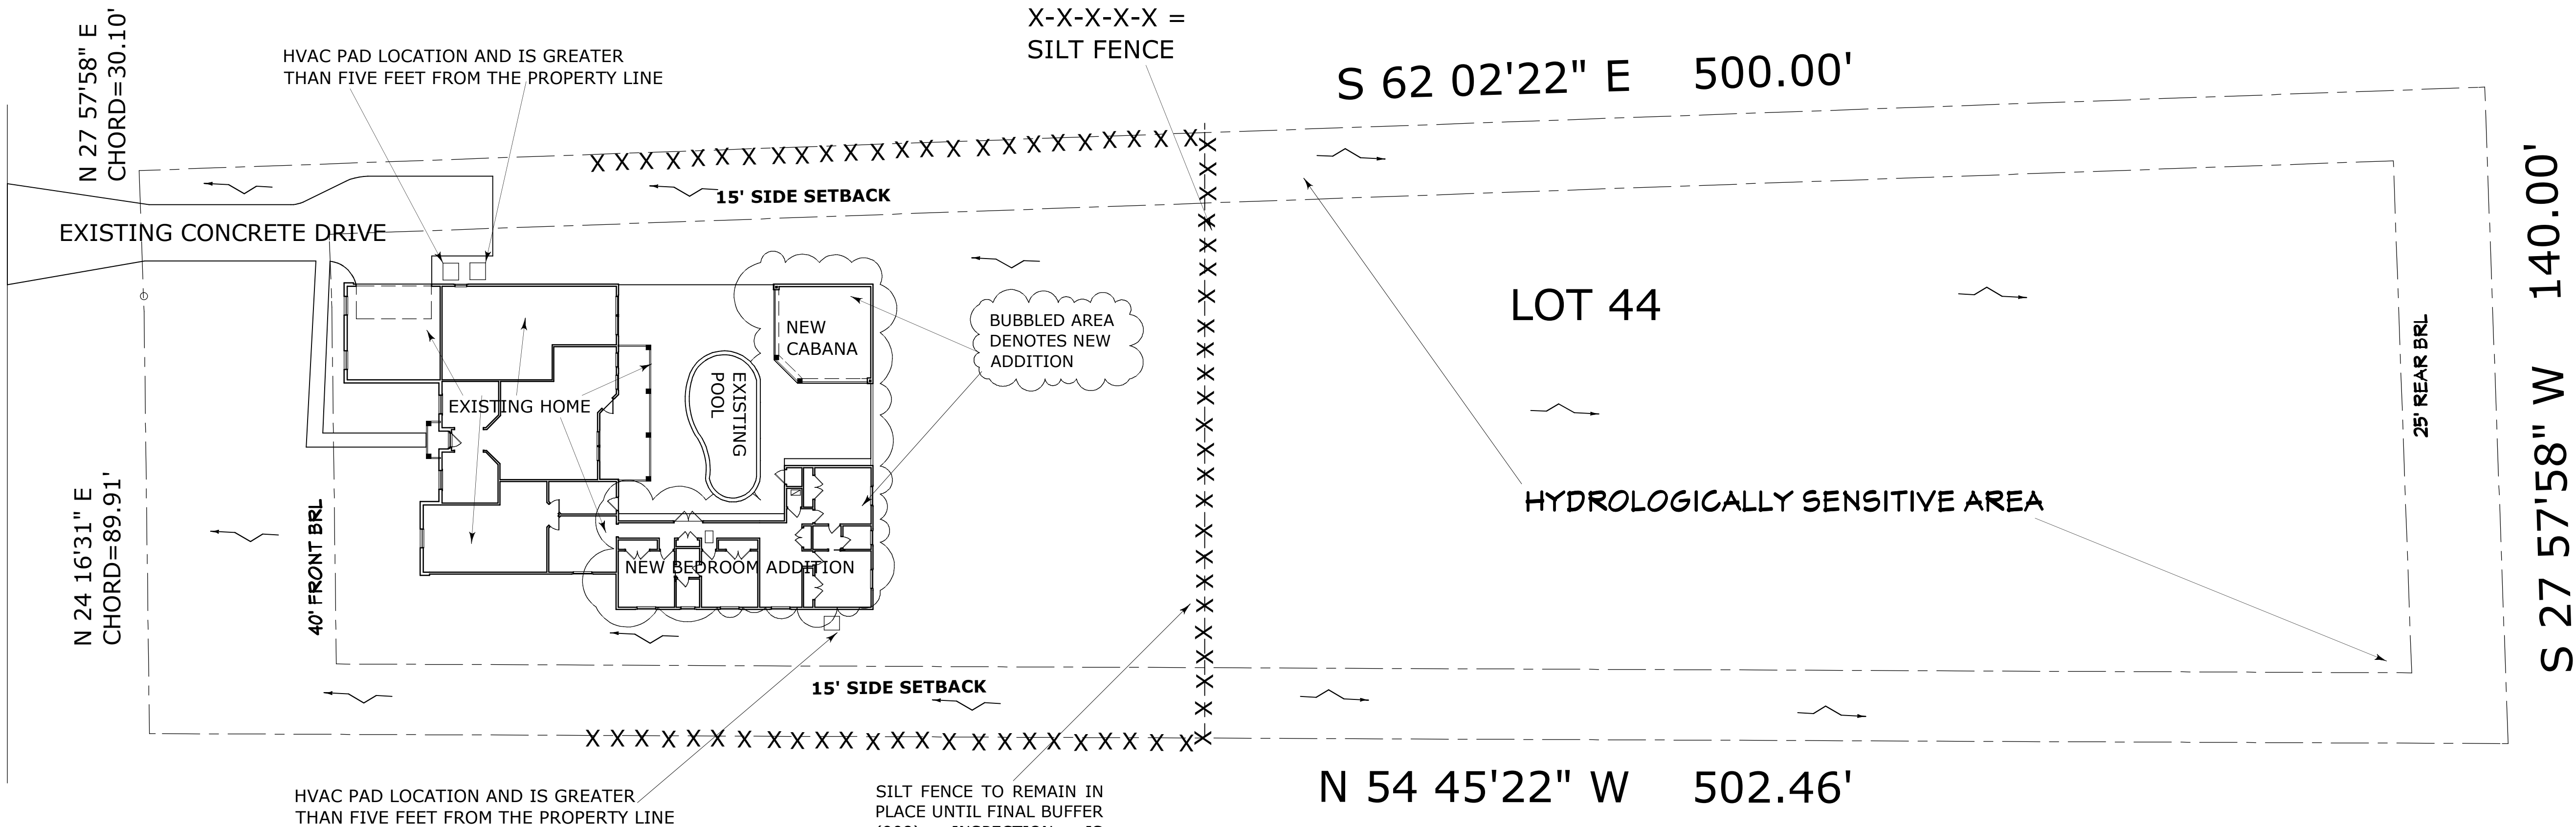

**1.49 ACRES X 40 INCHES PER ACRE EQUALS
59.6 INCHES OF APPROVED TREES. 70% OF
THE REQUIRED TREES SHALL BE CANOPY TYPE
WITH NO MORE THAN 1/2 OF THE SAME
SPECIES. ADDITIONAL TREES ALONG WITH
EXISTING TREES ON THE PROPERTY MEET THIS
REQUIREMENT. EVERYTHING IS EXISTING
AND MANY MORE INCHES THAN REQUIRED**

LOT FILL INFORMATION: THERE IS
NO FILL REQUIRED TO DO THE
CONSTRUCTION SINCE
EVERYTHING IS EXISTING

NOTE: SETBACKS ARE MEASURED
TO THE FURTHEST PROJECTION!

NOTE: SILT FENCE (EROSION
CONTROL) WILL BE USED ON
SITE TO PREVENT IMPACTS TO
SURROUNDING PROPERTIES.

CONSTRUCTION STANDARDS FOR AE-6 REQUIRES ANYTHING
CONSTRUCTION BELOW A FINAL FINISH FLOOR OF 7.00
REQUIRES FLOOD VENTS AND FLOOD RESISTANT MATERIALS-
NO EXCEPTIONS! A EMA ELEVATION CERTIFICATE WILL DO GO
PAST FRAMING STAGE AND ALSO A FINAL FEMA CERTIFICATE
WILL BE REQUIRED TO OBTAIN A CERTIFICATE OF OCCUPANCY.

*The applicant/owner/contractor shall
immediately contact St. Johns County lot
grading staff should modifications to the
drainage plan be required during site
development, based on actual field conditions.*

FLOOD INFORMATION:
TYPE "B" DRAINAGE
FLOOD ZONE: X

ZONING: PUD
FRONT: 40 FEET
SIDES: 15 FEET
REAR: 20 FEET

UTILITIES:
PUBLIC WATER
PUBLIC SEWER

CLEARANCE SHEET #: R1998-002859*001

COPYRIGHT 2016: DESIGNS FOR LIVING, LLC. Under Federal Statute 17 USC 5490 of the Architectural Drawing Act & Title 17 specific tacit copyright laws apply to all published works of Designs for Living, LLC. herein referred to as Designer. It is unlawful for anyone to copy these drawings, either in whole or in part, without the express written permission of the Designer. The use of any plans, specifications, electronic or hard copy prints shall be restricted to the original site for which they were prepared and publication thereof is expressly limited to such use. Title to all works, specifically all drawings, specifications, and modified derivatives of any blueprints, e-files, or other digital or physical files, shall remain the property of Designs for Living, LLC. No part of these drawings, specifications, or other digital or physical files, shall be reproduced, stored in a retrieval system, or transmitted in any form or by any means, electronic, mechanical, photocopying, recording, or by any information storage and retrieval system, without the prior written permission of Designs for Living, LLC. Designs for Living, LLC nor R.E. Chip Mitchell shall not be liable for error after construction has begun.

PLAN #:
1507-R

NO.	DESCRIPTION	BY	DATE

DRAWINGS PROVIDED BY:

Designs for Living,
LLC
Residential Design & Consulting Since
1969, Serving NE FL Since 1978
904-993-2231

PROJECT DESCRIPTION:

RENOVATIONS FOR THE
WILLIAMS FAMILY
1507 MALLARD LANDING BLVD
SAINT JOHNS, FL 32259

BUILT BY:

CHAMPION HOMES, INC.
1213 CUNNINGHAM CREEK DRIVE
SAINT JOHNS, FL 32259
CBC016614
904-545-4769

DATE:


5/6/2016

SCALE:

1" = 10 - 0"

SHEET:

A-2

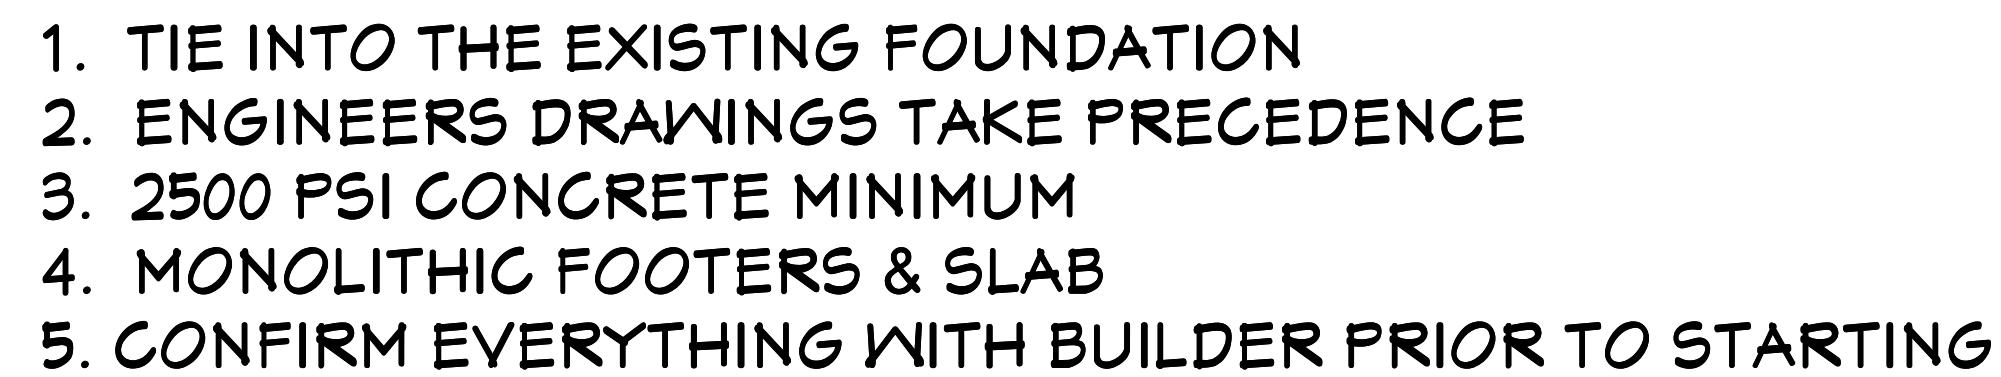

FOUNDATION PLAN

A-3



A-4

T DESCRIPTION:


**RENOVATIONS FOR THE
WILLIAMS FAMILY**

1507 MALLARD LANDING BLVD
SAINT JOHNS, FL 32259

DATE:
5/6/2016

SCALE:
1/4" = 1' - 0"

SHEET:

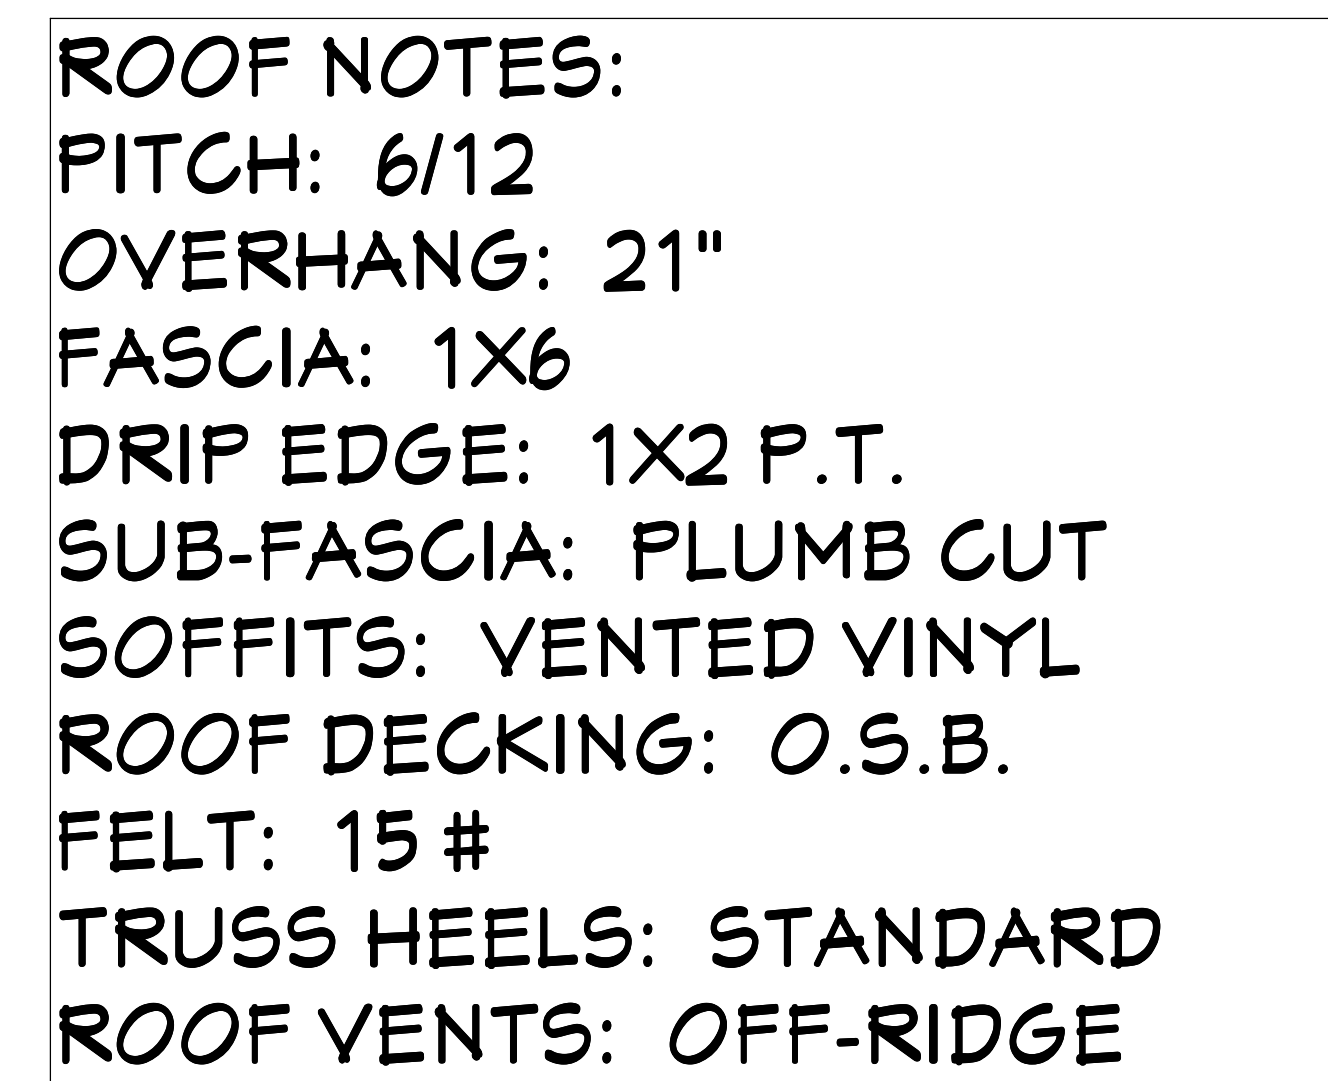

AS-BUILT ROOF PLAN

COPYRIGHT 2016: DESIGNS FOR LIVING, LLC. Under Federal Statute HR 5490 of the Architectural Drawing Act & Title 17 specific tacit copyright laws apply to all published works of Designs for Living, LLC. herein referred to as Designer. It is unlawful for anyone to copy these drawings, either in whole or in part, without the express written consent of the Designer. Any unauthorized copying, reproduction, distribution, sale, rental, loan, or other use of these drawings, in whole or in part, without the express written consent of the Designer, shall constitute prima facie evidence of infringement. All violations WILL result in legal action being taken and damages to the full extent allowed by law. No exceptions and no excuses! Contractor &/or owner shall verify all dimensions, details, specifications, materials, and finishes prior to construction. Every attempt has been made to avoid mistakes. Design for Living LLC nor R.E. Chip Mitchell shall not be liable for error after construction has begun!

PLAN #:
1507-R

NO.	DESCRIPTION	BY	DATE		

DRAWINGS PROVIDED BY:

Designs for Living,
LLC
Residential Design & Consulting Since
1969, Serving NE FL since 1978
904-593-2731

PROJECT DESCRIPTION:

RENOVATIONS FOR THE
WILLIAMS FAMILY
1507 MALLARD LANDING BLVD
SAINT JOHNS, FL 32259

BUILT BY:
CHAMPION HOMES, INC.
1213 CUNNINGHAM CREEK DRIVE
SAINT JOHNS, FL 32259
CBC016614
904-545-4769

DATE:

5/6/2016

SCALE:

1/4" = 1' - 0"

SHEET:

A-5



LEFT ELEVATION



RIGHT ELEVATION

AS-BUILT SIDE ELEVATIONS

COPYRIGHT 2016: DESIGNS FOR LIVING, LLC. -Under Federal Statute HR 5490 of the Architectural Drawing Act & Title 17 specific tacit copyright laws apply to all published works of Designs for Living, LLC. herein referred to as Designer. It is unlawful for anyone to copy these drawings, either in whole or in part, without the express written permission of the Designer! The use of any plans, specifications, electronic or hard copy prints shall be restricted to the original site for which they were prepared and publication thereof is expressly limited to such use. Title to all works, specifically all drawings, specifications, and modified derivatives of any blueprints, e-files, drawings, or specifications remain the Designer's without prejudice. VISUAL CONTACT with any of these drawings, or their purchase constitutes prima facie evidence of acceptance of these restrictions! This has held precedent in the North Florida Court system! Any and all violations WILL result in legal action being taken and litigated damages to the full extent allowed by law! No exceptions and no excuses! Contractor &/or owner shall verify all dimensions, details, & specifications prior to construction. Every attempt has been made to avoid mistakes. Design for Livings LLC nor R.E. Chip Mitchell shall not be liable for error after construction has begun!

A-6

SHEET:

$$1/4'' = 1' - 0''$$

SCALE:

5/6/2016

DATE:

BUILT BY:
CHAIN
121

BUILT BY: **CHAMPION HOMES, INC.**
1213 CUNNINGHAM CREEK DRIVE
SAINT JOHNS, FL 32259
CBC016614
904-545-4769

PROJECT DESCRIPTION:

**RENOVATIONS FOR THE
WILLIAMS FAMILY**

1507 MALLARD LANDING BLVD
SAINT JOHNS, FL 32259

DRAWINGS PROVIDED BY:
**Designs for Living,
LLC**
Residential Design & Consulting Since
1969, Serving NE FL since 1978
904-993-2231

[illegible]



FRONT ELEVATION



REAR ELEVATION

AS-BUILT FRONT/REAR ELEVATIONS

COPYRIGHT 2016: DESIGNS FOR LIVING, LLC. Under Federal Statute HR 5490 of the Architectural Drawing Act & Title 17 specific tacit copyright laws apply to all published works of Designs for Living, LLC. herein referred to as Designer. It is unlawful for anyone to copy these drawings, either in whole or in part, without the express written permission of the Designer. The use of any plans, specifications, electronic or hard copy prints shall be restricted to the original site for which they were prepared and publication thereof is expressly limited to such use. Title to all works, specifically all drawings, specifications, and modified derivatives of any blueprints, e-files, or any other digital or physical format, shall remain the property of Designs for Living, LLC. No exceptions and no excesses/Contractor &/or owner shall verify all dimensions, details, & specifications prior to construction. Every attempt has been made to avoid mistakes. Design for Living, LLC nor R.E. Chip Mitchell shall not be liable for error after construction has begun.

SHEET:

A-7

SCALE:

1/4" = 1' - 0"

DATE:

5/6/2016

BUILT BY:

CHAMPION HOMES, INC.
1213 CUNNINGHAM CREEK DRIVE
SAINT JOHNS, FL 32259
CBC016614
904-545-4769

PROJECT DESCRIPTION:

RENOVATIONS FOR THE
WILLIAMS FAMILY
1507 MALLARD LANDING BLVD
SAINT JOHNS, FL 32259


DRAWINGS PROVIDED BY:

Designs for Living,
LLC
Residential Design & Consulting Since
1969, Serving NE FL since 1978
904-993-2231

NO.	DESCRIPTION	BY	DATE

PLAN #:

1507-R

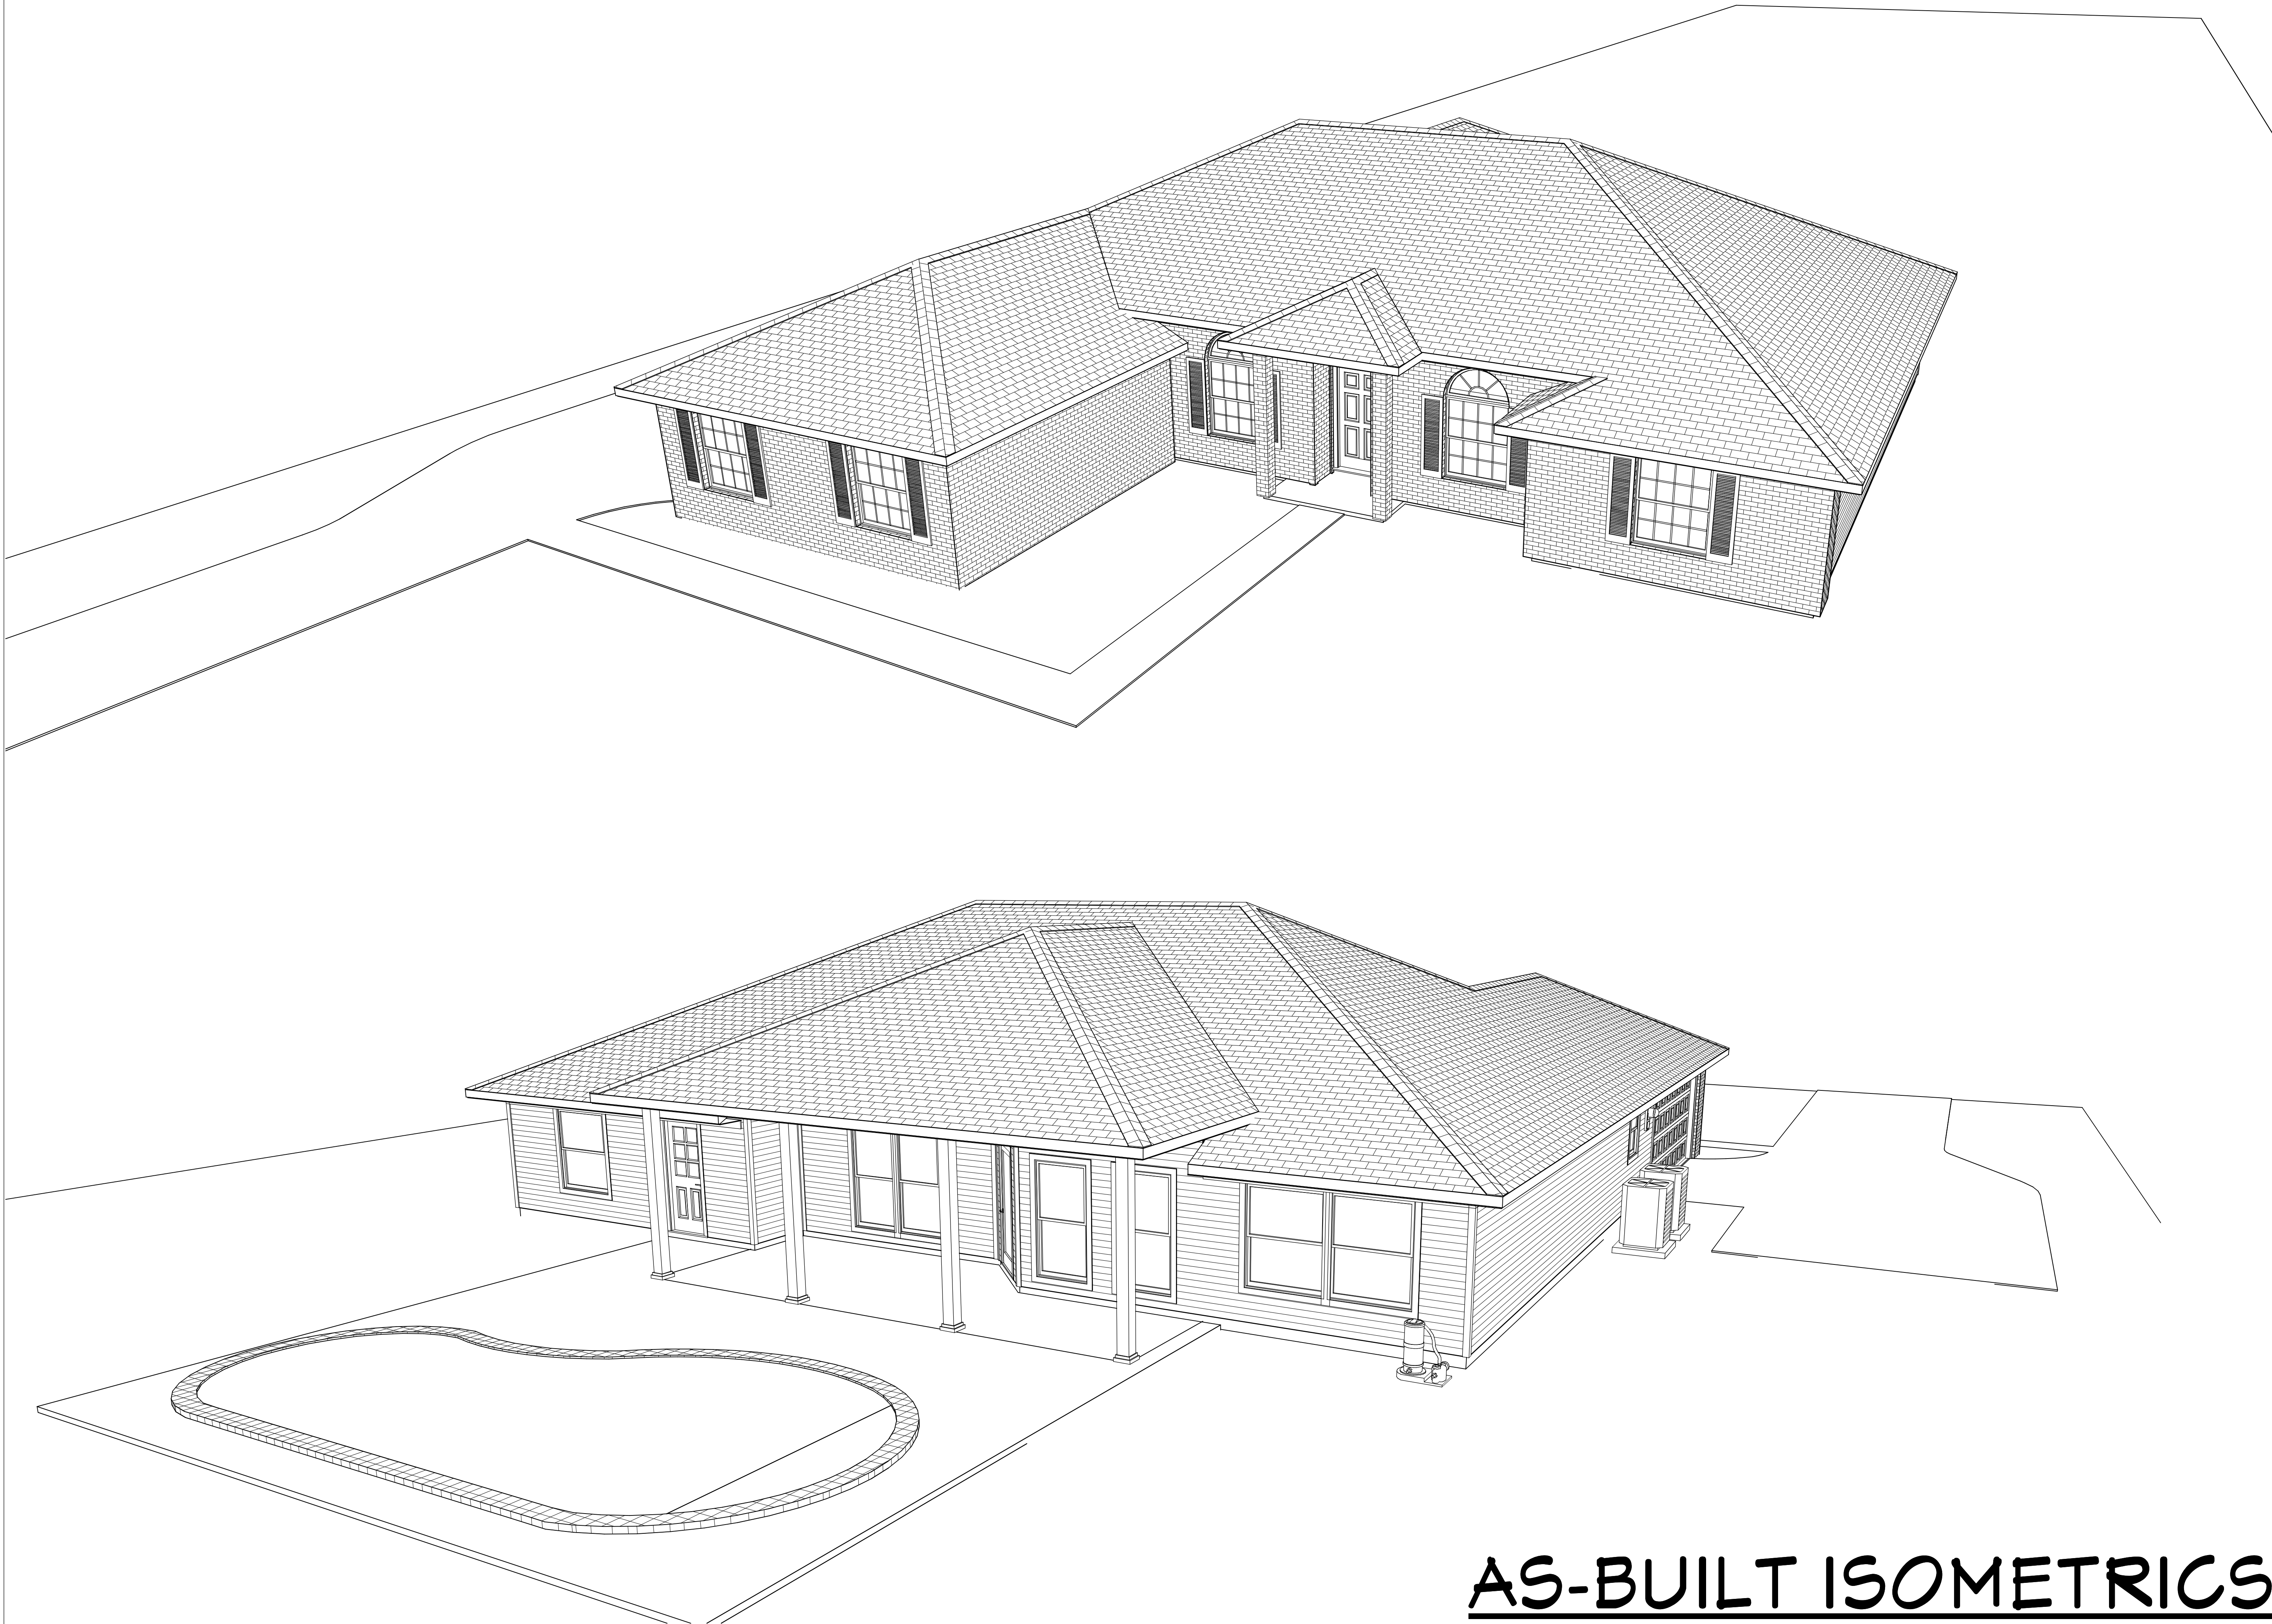

AS-BUILT ISOMETRICS

COPYRIGHT 2016: DESIGNS FOR LIVING, LLC. Under Federal Statute HR 5490 of the Architectural Drawing Act & Title 17 specific tacit copyright laws apply to all published works of Designs for Living, LLC. herein referred to as Designer. It is unlawful for anyone to copy these drawings, either in whole or in part, without the express written permission of the Designer. The use of any plans, specifications, electronic or hard copy prints shall be restricted to the original site for which they were prepared and publication thereof is expressly limited to such use. 

SHEET:
A-8

SCALE:
1/4" = 1' - 0"

DATE:
5/6/2016


BUILT BY:
CHAMPION HOMES, INC.
1213 CUNNINGHAM CREEK DRIVE
SAINT JOHNS, FL 32259
CBC016614
904-545-4769

PROJECT DESCRIPTION:
**RENOVATIONS FOR THE
WILLIAMS FAMILY**
1507 MALLARD LANDING BLVD
SAINT JOHNS, FL 32259

DRAWINGS PROVIDED BY:
**Designs for Living,
LLC**
Residential Design & Consulting Since
1969, Serving NE FL since 1978
904-993-2231

NO.	DESCRIPTION	BY	DATE

PLAN #:
1507-R

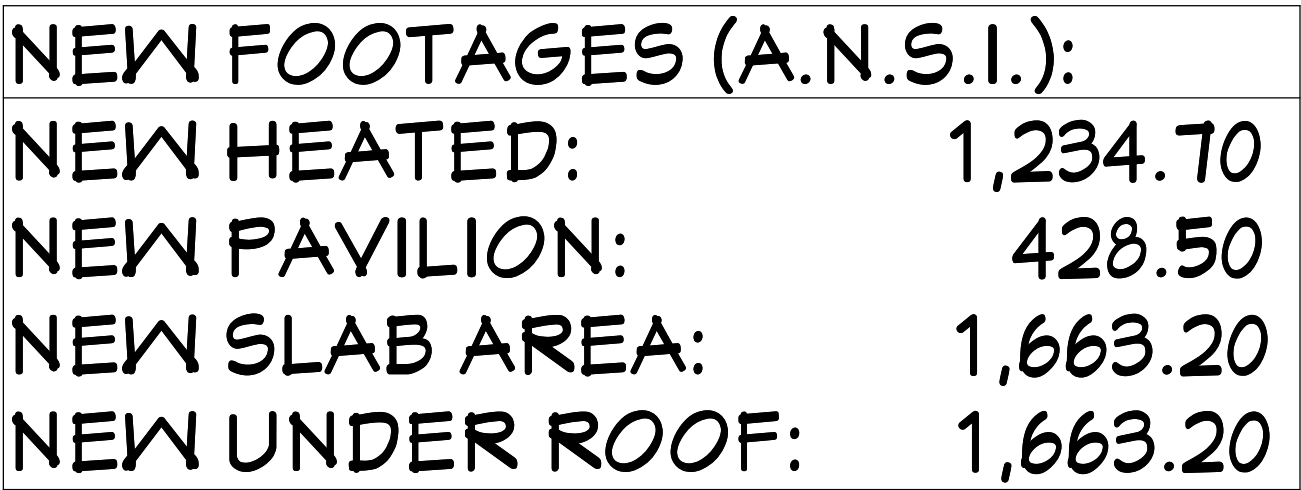

INSULATION NOTES:
WALLS: R-13 FIBERGLASS BATTS
ATTICS: R-30 BLOWN FIBERGLASS
KNEEWALLS: R-19 FIBERGLASS BATTS

ALL PLATE HEIGHTS ARE 8'-1&1/8"

PROPOSED FLOOR PLAN

COPYRIGHT © DESIGNS FOR LIVING, LLC. Under Federal Statute HR 9480 of the Architectural Drawing Act & Title 17 specific copyright laws apply to all published works of Designs for Living, LLC herein referred to as Designer. It is unlawful for one to copy these drawings, either in whole or in part, without the express written permission of the Designer. The use of any plans, specifications, electronic or hard copy prints shall be restricted to the original site for which they were prepared and publication thereof is expressly limited to such use. Title to all works, specifically all drawings, specifications, and modified derivatives of any blueprints, e-files, drawings, or specifications remain the Designers without prejudice. VISUAL CONTACT with any of these drawings, or their purchase constitutes prima facie evidence of the acceptance of these restrictions! This has held precedent in the North Florida Court WILL result in legal action being taken and litigated damages to the full extent allowed by law! No exceptions/Contractor &/or owner shall verify all dimensions, details, & specifications been made to avoid misreading. Every attempt has been made to hold misreading. Design for Living LLC nor R.E. Chip Mitchell are not liable for error construction has begun

NO.	DESCRIPTION	BY	DATE

DRAWINGS PROVIDED BY:
**Designs for Living,
LLC**
Residential Design & Consulting Since
1969, Serving NE FL since 1978
904-993-2231

PROJECT DESCRIPTION:

**RENOVATIONS FOR THE
WILLIAMS FAMILY**

1507 MALLARD LANDING BLVD

BUILT BY:
CHAMPION HOMES, INC.
1213 CUNNINGHAM CREEK DRIVE
SAINT JOHNS, FL 32259
CBC016614
904-545-1760

DATE:
5/6/2016

SCALE:
1/4" = 1' - 0"

SHEET:
A-9



ROOF NOTES:
PITCH: 6/12
OVERHANG: 21" CONFIRM
FASCIA: 1X6 CONFIRM
DRIP EDGE: 1X2 P.T.
SUB-FASCIA: PLUMB CUT
SOFFITS: VENTED VINYL
ROOF DECKING: O.S.B.
FELT: 15 #
TRUSS HEELS: STANDARD
ROOF VENTS: OFF-RIDGE

PROPOSED ROOF PLAN

COPYRIGHT 2016: DESIGNS FOR LIVING, LLC. -Under Federal Statute HR 5490 of the Architectural Drawing Act & Title 17 specific tacit copyright laws apply to all published works of Designs for Living, LLC. herein referred to as Designer. It is unlawful for anyone to copy these drawings, either in whole or in part, without the express written permission of the Designer! The use of any plans, specifications, electronic or hard copy prints shall be restricted to the original site for which they were prepared and publication thereof is expressly limited to such use. Title to all works, specifically all drawings, specifications, and modified derivatives of any blueprints, e-files, drawings, or specifications remain the Designer's without prejudice. VISUAL CONTACT with any of these drawings, or their purchase constitutes prima facie evidence of the acceptance of these restrictions! This has held precedent in the North Florida Court system! Any and all violations WILL result in legal action being taken and litigated damages to the full extent allowed by law! No exceptions and no excuses! Contractor &/or owner shall verify all dimensions, details, & specifications prior to construction. Every attempt has been made to avoid mistakes. Design for Livings LLC nor R.E. Chip Mitchell shall not be liable for error after construction has begun!

[illegible]

DRAWINGS PROVIDED BY:
**Designs for Living,
LLC**
Residential Design & Consulting Since
1969, Serving NE FL since 1978
904-993-2231

PROJECT DESCRIPTION:

**RENOVATIONS FOR THE
WILLIAMS FAMILY**

1507 MALLARD LANDING BLVD
SAINT JOHNS, FL 32259


BUILT BY: **CHAMPION HOMES, INC.**
1213 CUNNINGHAM CREEK DRIVE
SAINT JOHNS, FL 32259
CBC016614
904-545-4769

DATE:
5/6/2016

SCALE:
$1/4" = 1' - 0"$

SHEET:

A-10

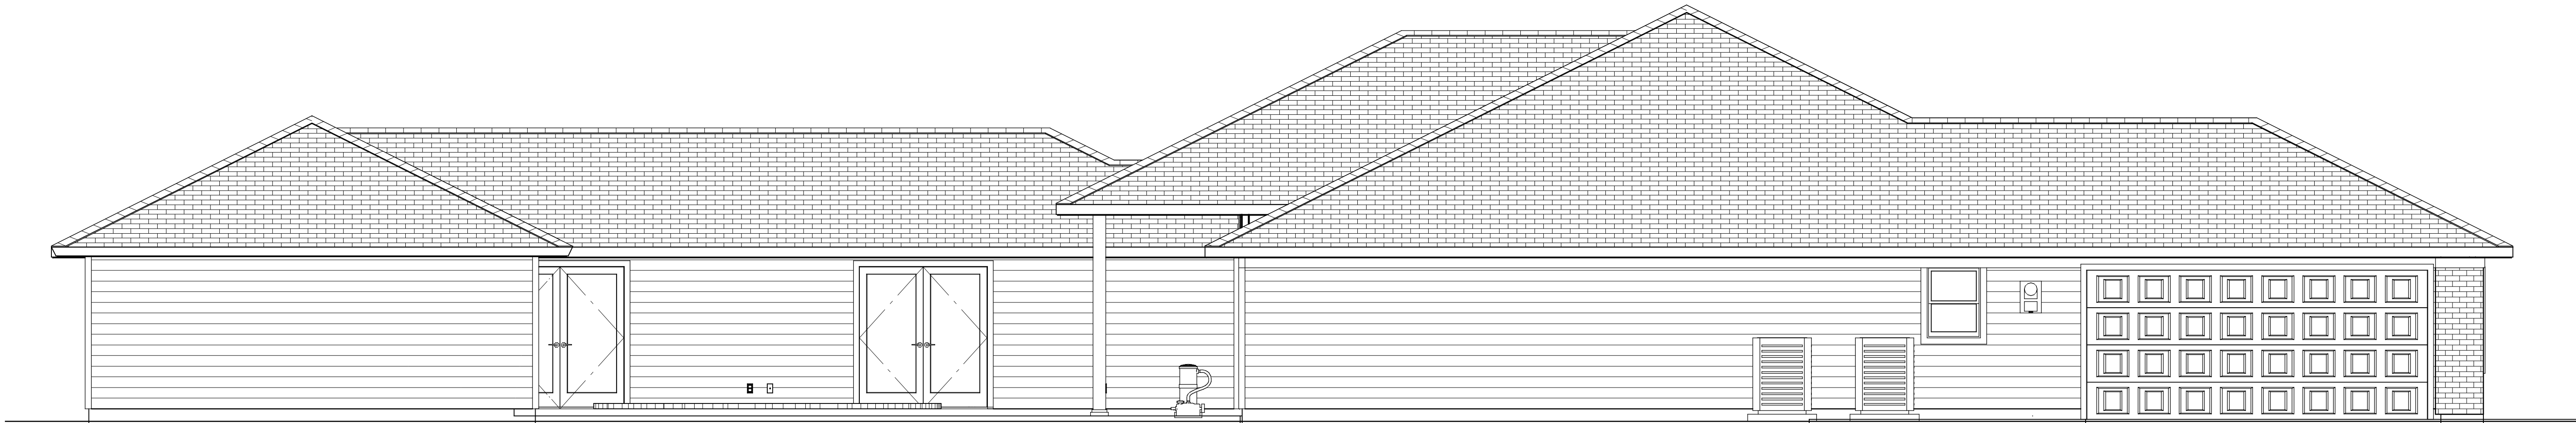

LEFT ELEVATION

EXTERIOR NOTES:
SIDING: CEMENTIOUS LAP, PAINTED
SOFFITS: MATCH EXISTING
FASCIA: MATCH EXISTING
ROOFING: ARCHITECTURAL FIBERGLASS TO MATCH EXISTING
FOUNDATION: MONOLITHIC SLAB & FOOTERS
CORNER BOARDS: MATCH EXISTING
FRIEZE: MATCH EXISTING
CONFIRM ALL WITH THE OWNERS

CONTRACT NOTE: BUILDERS
CONTRACT DOCUMENTS TAKE
PRECEDENCE OVER THESE DRAWINGS.
ANY CONFLICT DEFAULTS BACK TO THE
CONTRACT DOCUMENTS.



RIGHT ELEVATION

PROPOSED SIDE ELEVATIONS

COPYRIGHT 2016: DESIGNS FOR LIVING, LLC. Under Federal Statute HR 5490 of the Architectural Drawing Act & Title 17 specific fact copyright laws apply to all published works of Designs for Living, LLC. herein referred to as Designer. It is unlawful for anyone to copy these drawings, either in whole or in part, without the express written permission of the Designer. The use of any plans, specifications, electronic or hard copy prints shall be restricted to the original site for which they were prepared and publication thereof is expressly limited to such use. Title to all works, specifically all drawings, specifications, and modified derivatives of any blueprints, e-files, or other digital or physical files, shall remain the property of Designs for Living, LLC. No exceptions and no excesses/Contractor &/or owner shall verify all dimensions, details, & specifications prior to construction. Every attempt has been made to avoid mistakes. Design for Living, LLC nor R.E. Chip Mitchell shall not be liable for error after construction has begun!

PLAN #:
1507-R

NO.	DESCRIPTION	BY	DATE

DRAWINGS PROVIDED BY:
Designs for Living, LLC
Residential Design & Consulting Since 1969, Serving NE FL Since 1978
904-993-2231

PROJECT DESCRIPTION:
RENOVATIONS FOR THE WILLIAMS FAMILY
1507 MALLARD LANDING BLVD
SAINT JOHNS, FL 32259

BUILT BY:
CHAMPION HOMES, INC.
1213 CUNNINGHAM CREEK DRIVE
SAINT JOHNS, FL 32259
CBC016614
904-545-4769

DATE:
5/6/2016

SCALE:
1/4" = 1' - 0"

SHEET:
A-11



FRONT ELEVATION

EXTERIOR NOTES:
SIDING: CEMENTIOUS LAP, PAINTED
SOFFITS: MATCH EXISTING
FASCIA: MATCH EXISTING
ROOFING: ARCHITECTURAL FIBERGLASS TO MATCH EXISTING
FOUNDATION: MONOLITHIC SLAB & FOOTERS
CORNER BOARDS: MATCH EXISTING
FRIEZE: MATCH EXISTING
CONFIRM ALL WITH THE OWNERS

CONTRACT NOTE: BUILDERS
CONTRACT DOCUMENTS TAKE
PRECEDENCE OVER THESE DRAWINGS.
ANY CONFLICT DEFAULTS BACK TO THE
CONTRACT DOCUMENTS.



REAR ELEVATION

PROPOSED FRONT/REAR ELEVATIONS

COPYRIGHT 2016: DESIGNS FOR LIVING, LLC. Under Federal Statute HR 5490 of the Architectural Drawing Act & Title 17 specific tacit copyright laws apply to all published works of Designs for Living, LLC. herein referred to as Designer. It is unlawful for anyone to copy these drawings, either in whole or in part, without the express written permission of the Designer. The use of any plans, specifications, electronic or hard copy prints shall be restricted to the original site for which they were prepared and publication thereof is expressly limited to such use. 

PLAN #:
1507-R

NO.	DESCRIPTION	BY	DATE

DRAWINGS PROVIDED BY:

Designs for Living,
LLC
Residential Design & Consulting Since
1969, Serving NE FL Since 1978
904-993-2231

PROJECT DESCRIPTION:

RENOVATIONS FOR THE
WILLIAMS FAMILY
1507 MALLARD LANDING BLVD
SAINT JOHNS, FL 32259

BUILT BY:

CHAMPION HOMES, INC.
1213 CUNNINGHAM CREEK DRIVE
SAINT JOHNS, FL 32259
CBC016614
904-545-4769

DATE:

5/6/2016


SCALE:

1/4" = 1' - 0"

SHEET:

A-12

EXTERIOR NOTES:
SIDING: CEMENTIOUS LAP, PAINTED
SOFFITS: MATCH EXISTING
FASCIA: MATCH EXISTING
ROOFING: ARCHITECTURAL FIBERGLASS TO MATCH EXISTING
FOUNDATION: MONOLITHIC SLAB & FOOTERS
CORNER BOARDS: MATCH EXISTING
FRIEZE: MATCH EXISTING
CONFIRM ALL WITH THE OWNERS

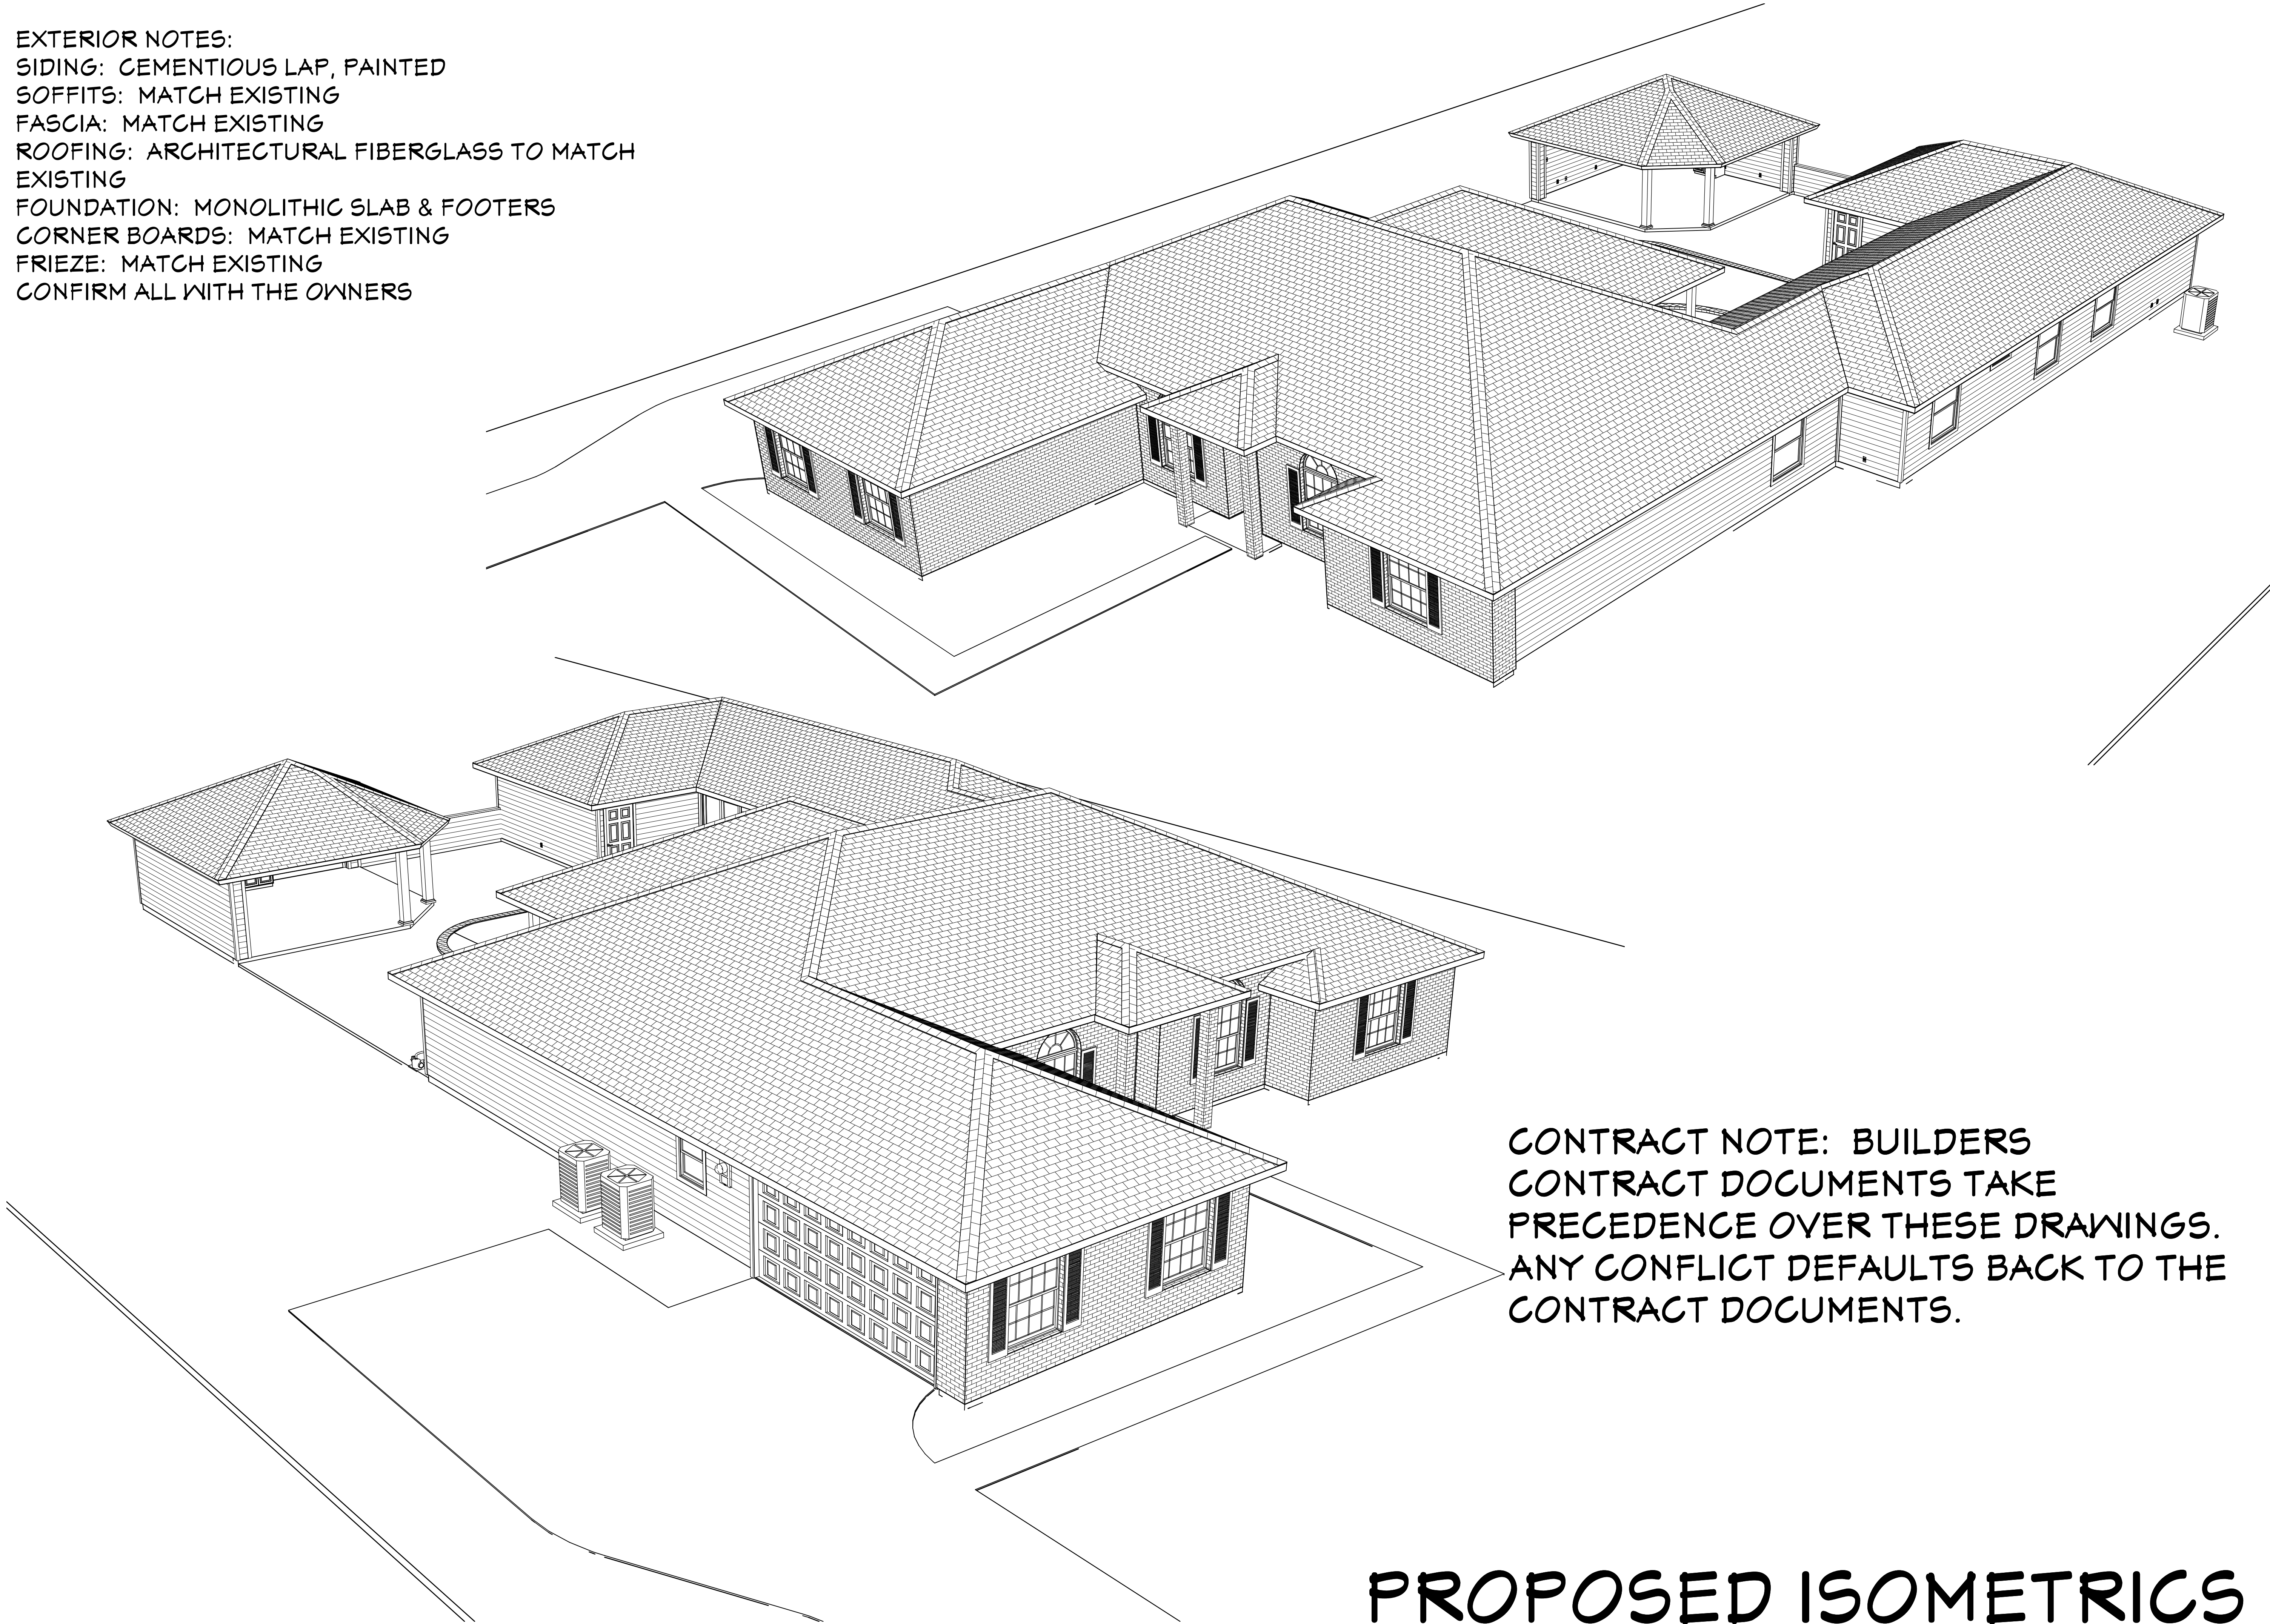

CONTRACT NOTE: BUILDERS
CONTRACT DOCUMENTS TAKE
PRECEDENCE OVER THESE DRAWINGS.
ANY CONFLICT DEFAULTS BACK TO THE
CONTRACT DOCUMENTS.

PROPOSED ISOMETRICS

COPYRIGHT 2016: DESIGNS FOR LIVING, LLC. Under Federal Statute HR 5490 of the Architectural Drawing Act & Title 17 specific tacit copyright laws apply to all published works of Designs for Living, LLC. herein referred to as Designer. It is unlawful for anyone to copy these drawings, either in whole or in part, without the express written permission of the Designer. The use of any plans, specifications, electronic or hard copy prints shall be restricted to the original site for which they were prepared and publication thereof is expressly limited to such use. Title to all works, specifically all drawings, specifications, and modified derivatives of any blueprints, e-files, or other digital or physical files, shall remain the property of Designs for Living, LLC. Designs for Living, LLC shall not be liable for error after construction has begun.

PLAN #:
1507-R

NO.	DESCRIPTION	BY	DATE

DRAWINGS PROVIDED BY:
Designs for Living,
LLC
Residential Design & Consulting Since
1969, Serving NE FL Since 1978
904-993-2231


PROJECT DESCRIPTION:
RENOVATIONS FOR THE
WILLIAMS FAMILY
1507 MALLARD LANDING BLVD
SAINT JOHNS, FL 32259

BUILT BY:
CHAMPION HOMES, INC.
1213 CUNNINGHAM CREEK DRIVE
SAINT JOHNS, FL 32259
CBC016614
904-545-4769

DATE:
5/6/2016

SCALE:
N.T.S.

SHEET:
A-13

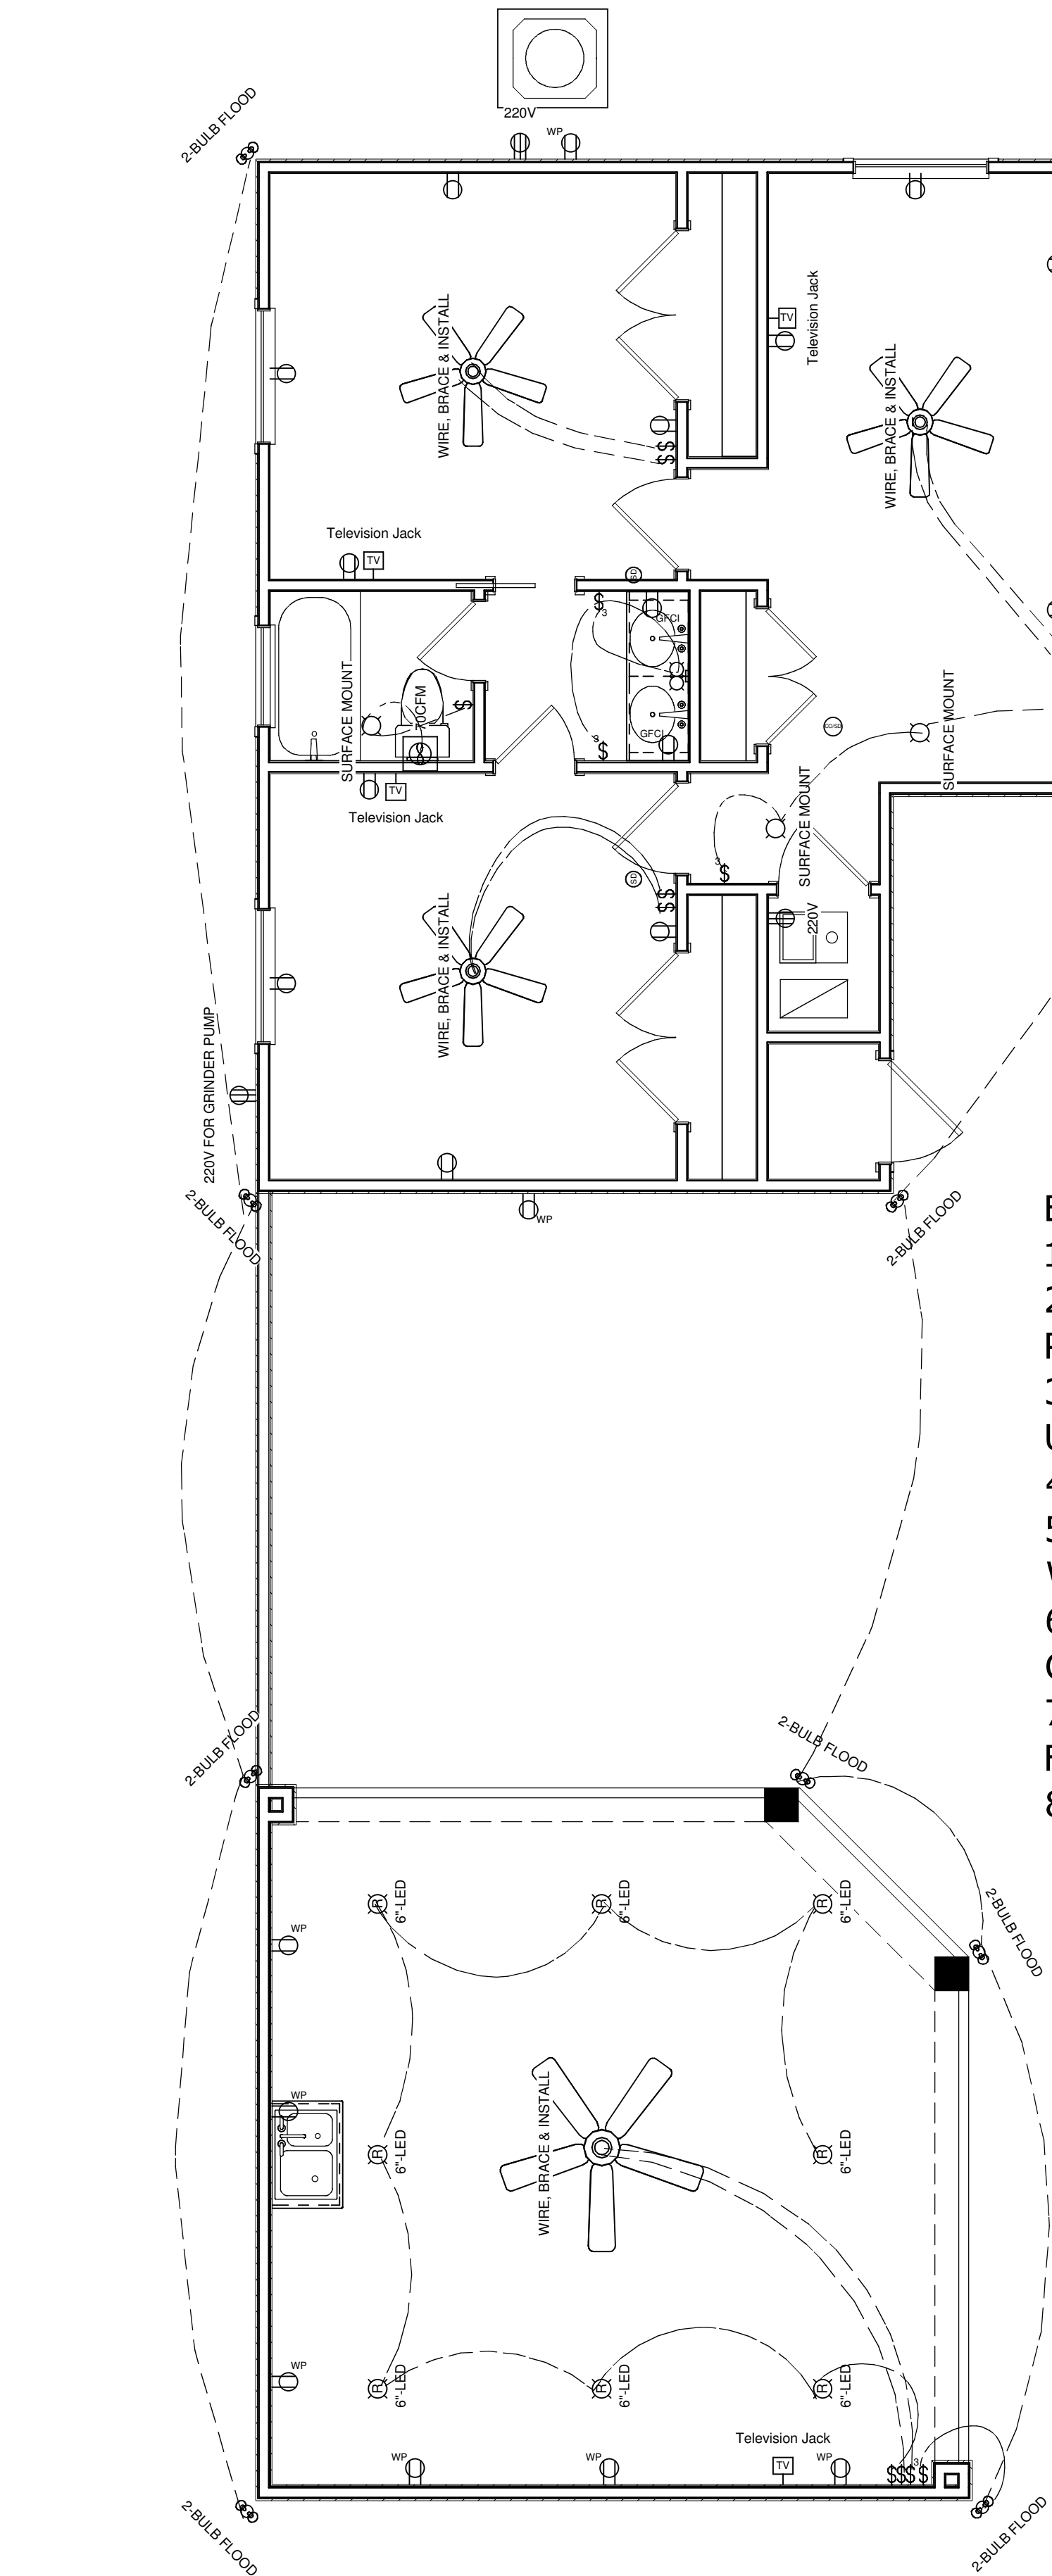


PER FBC-R-E3901.7, NEC 210, E3901.7 & E3902.3 GFCI PROTECTION REQUIRED Bathrooms, garages, boathouses & accessory structures not intended as habitable rooms and limited to storage, work & similar uses. Outlets within 6 feet of laundry, utility or wet sinks. Balcony, deck or porch greater than 20 s.f. One at the front and back of the dwelling and at the condenser units.

- ELECTRICAL NOTES:
1. EXISTING SERVICE WILL REMAIN
 2. GET WITH OWNERS ON OUTDOOR PAVILION
 3. POWER TO HOME TO BE UNDERGROUND.
 4. 200 AMP SERVICE EXISTING
 5. WALK HOME WITH OWNER PRIOR TO WIRING.
 6. ALL FIXTURES, EXCEPT, RECESSED CAN ROUGHS BY OWNER.
 7. CONFIRM LOCATION OF ALL FIXTURES PRIOR TO WIRING
 8. LOW VOLTAGE BY OTHERS.

ELECTRICAL - DATA - AUDIO LEGEND	
SYMBOL	DESCRIPTION
	Ceiling Fan
	Ventilation Fans: Ceiling Mounted, Wall Mounted
	Ceiling Mounted Light Fixtures: Surface/Pendant, Recessed, Heat Lamp, Low Voltage
	Wall Mounted Light Fixtures: Flush Mounted, Wall Sconce
	Chandelier Light Fixture
	Fluorescent Light Fixture
	240V Receptacle
	110V Receptacles: Duplex, Weather Proof, GFCI
	Switches: Single Pole, Weather Proof, 3-Way, 4-Way
	Switches: Dimmer, Timer
	Audio Video: Control Panel, Switch
	Speakers: Ceiling Mounted, Wall Mounted
	Wall Jacks: CAT5, CAT5 + TV, TV/Cable
	Telephone Jack
	Intercom
	Thermostat
	Door Chime, Door Bell Button
	Smoke Detectors: Ceiling Mounted, Wall Mounted
	Electrical Breaker Panel

PER FBC-R-E3902.12 AFCI PROTECTION REQUIRED Arc-fault circuit-interrupter protection. All branch circuits that supply 120-volt, single-phase, 15- and 20-ampere outlets installed in family rooms, dining rooms, living rooms, parlors, libraries, dens, bedrooms, sunrooms, recreation rooms, closets, hallways, or similar rooms or areas shall be protected by a listed AFCI, combination type.

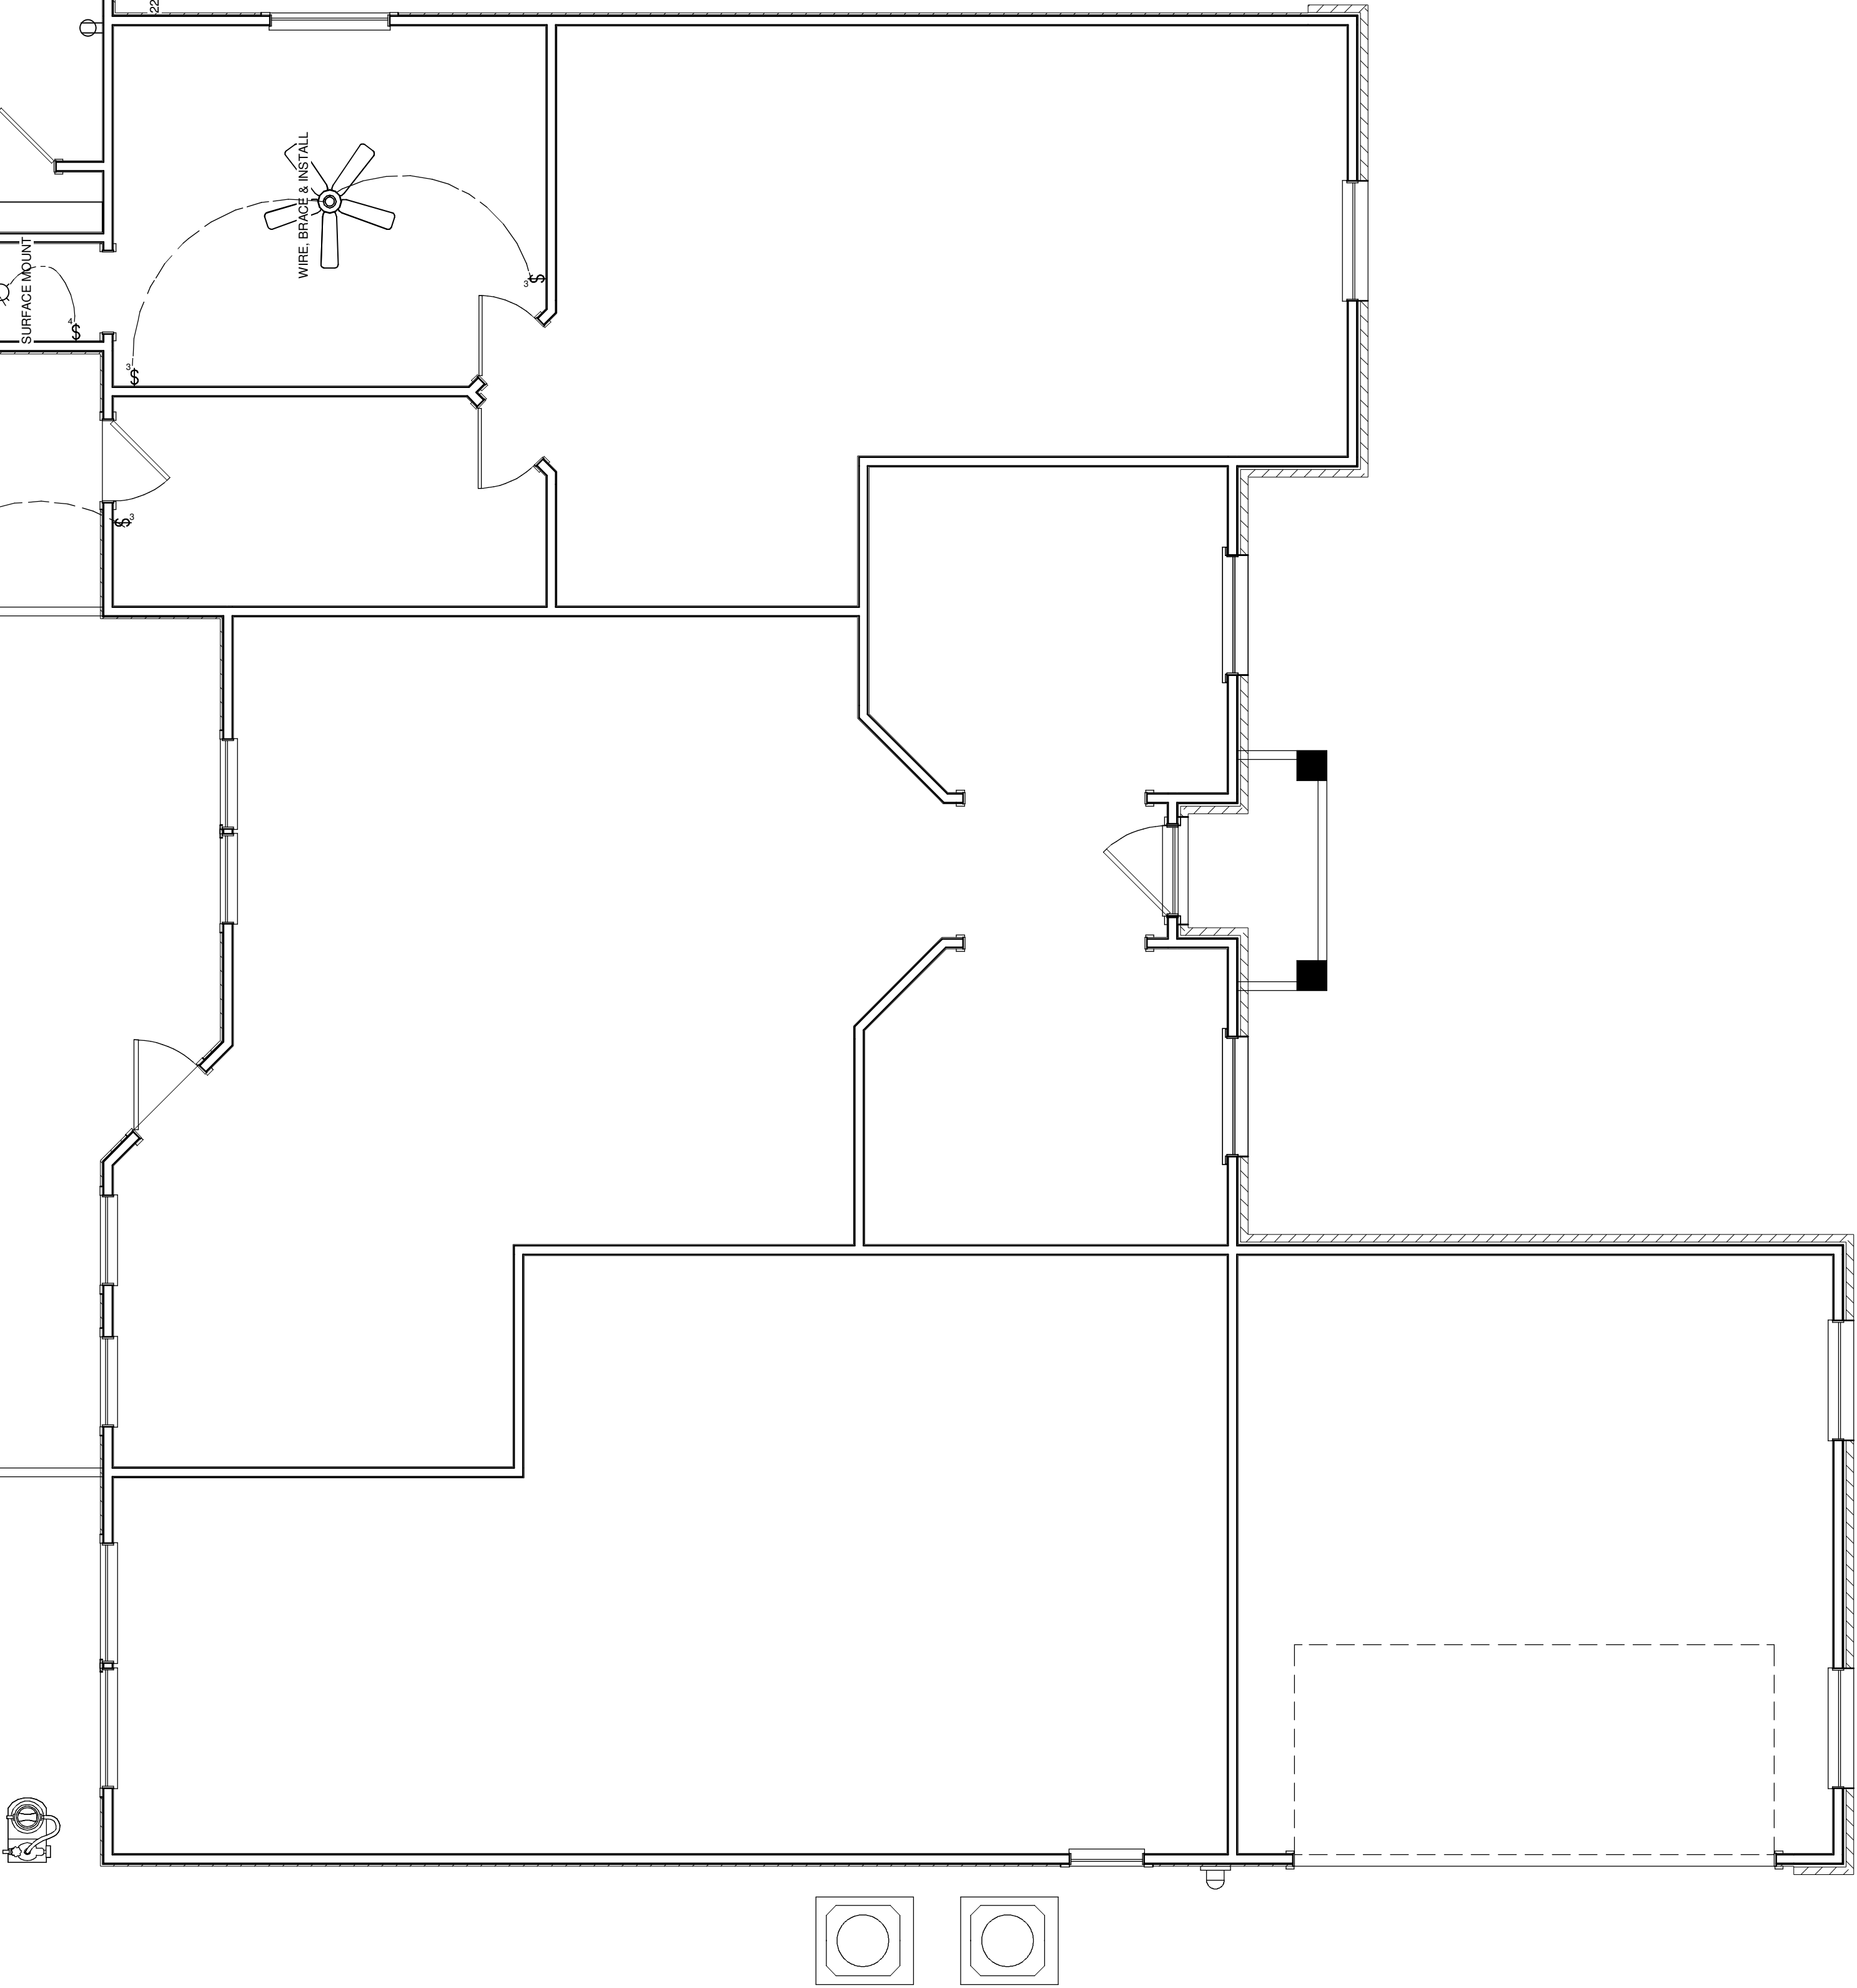

EFFICACY NOTE: THE NEW FBC-R FBC EC R404.1 & R202 BUILDING CODE REQUIRES ALL INSIDE & OUTSIDE LIGHT FIXTURES WILL USE CFL OR LED LIGHT BULBS.

ELECTRICAL PLAN

COPYRIGHT 2016: DESIGNS FOR LIVING, LLC. Under Federal Statute HR 5490 of the Architectural Drawing Act & Title 17 specific tacit copyright laws apply to all published works of Designs for Living, LLC. herein referred to as Designer. It is unlawful for anyone to copy these drawings, either in whole or in part, without the express written permission of the Designer. The use of any plans, specifications, electronic or hard copy prints shall be restricted to the original site for which they were prepared and publication thereof is expressly limited to such use. Title to all works, specifically all drawings, specifications, and modified derivatives of any blueprints, e-files, or other electronic or hard copy prints shall remain the property of Designs for Living, LLC. No exceptions and no excuses/Contractor &/or Owner shall verify all dimensions, details, & specifications prior to construction. Every attempt has been made to avoid mistakes. Design for Living, LLC nor R.E. Chip Mitchell shall not be liable for error after construction has begun!

PLAN #:
1507-R

NO.	DESCRIPTION	BY	DATE

DRAWINGS PROVIDED BY:
Designs for Living, LLC
Residential Design & Consulting Since 1969, Serving NE FL since 1978
904-993-2231

PROJECT DESCRIPTION:
RENOVATIONS FOR THE WILLIAMS FAMILY
1507 MALLARD LANDING BLVD
SAINT JOHNS, FL 32259

BUILT BY:
CHAMPION HOMES, INC.
1213 CUNNINGHAM CREEK DRIVE
SAINT JOHNS, FL 32259
CBC016614
904-545-4769

DATE:
5/6/2016

SCALE:
1/4" = 1' - 0"

SHEET:
A-14