


# RENOVATIONS FOR THE DAVIS FAMILY

PERMIT SET 6/21/2017

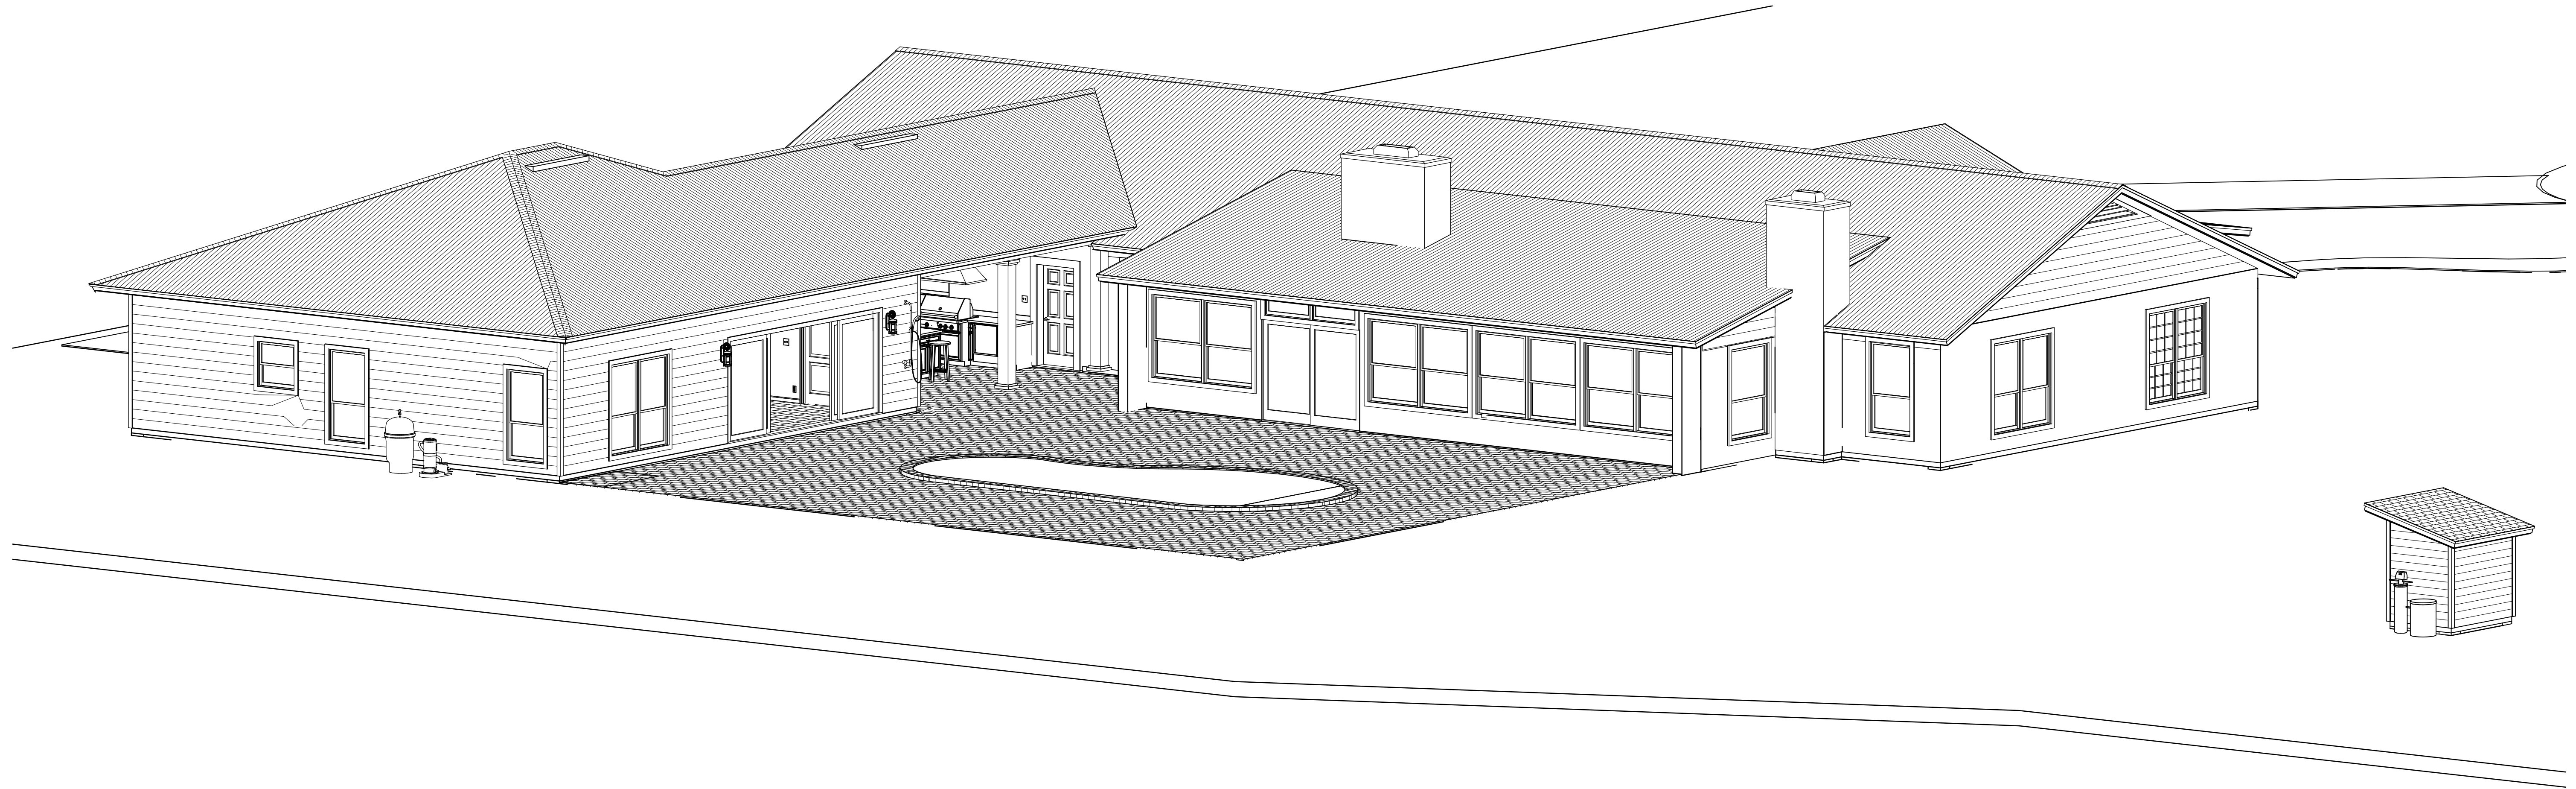

5438 TIERRA VERDE LANE  
JACKSONVILLE, FL 32258-2281  
PT SW 1/4 OF NW1/4 O/R 17782-676  
R/E #: 157149-0100

BUILT BY:  
BRACEY BUILDING CONTRACTORS, INC.  
10513 ATLANTIC BOULEVARD  
JACKSONVILLE, FL 32225  
904-237-3433  
CBC1251050

COPYRIGHT 2017: DESIGNS FOR LIVING, LLC. -Under section 102 of the Architectural Works Copyright Protection Act (title 17 of the United States Code) specific tacit copyright laws apply to original design of a building created in any tangible medium of expression, including a constructed building or architectural plans, models, or drawings and is subject to copyright protection as an "architectural work" by Designs for Living, LLC. herein referred to as Designer. It is unlawful for anyone to copy these drawings, either in whole or in part, without the express written permission of the Designer. The use of any plans, specifications, electronic or hard copy prints shall be restricted to the original site for which they were prepared and publication thereof is expressly limited to such use. Title to all works, specifically all drawings, specifications, and modified derivatives of any blueprints, e-files, drawings, or specifications remain the Designers without prejudice. VISUAL CONTACT with any of these drawings, or their purchase constitutes prima facie evidence of the acceptance of these restrictions! This has held precedent in the North Florida Court system! Any and all violations WILL result in legal action being taken and litigated damages to the full extent allowed by law! No exceptions and no excuses! Contractor &/or owner shall verify all dimensions, details, & specifications prior to construction. Every attempt shall be made to avoid errors and omissions and as such, the Designer shall not be liable for errors or omissions. Copyright release approval and Design for Living Building Contractors logo shall be required for all reproductions or alterations. This copyright law is only valid on building designs created on or after December 1, 1990. Other errors after delivery via email or drawings including after construction has begun. This copyright law is only valid on building designs created on or after December 1, 1990.

PLAN #  
4119

CLIENT APPROVAL SIGNATURE DATE

JAMES W. DAVIS

LINDA M. DAVIS

BUILT BY: CBC1251050 CELL: 904-237-3433  
**Bracey**  
BUILDING CONTRACTORS

PROJECT DESCRIPTION:  
RENOVATIONS FOR THE DAVIS FAMILY  
5438 TIERRA VERDE LANE  
JACKSONVILLE, FLORIDA 32228-2281  
R/E #: 157149-0100

Design Drawings  
provided by:  
**DESIGNS FOR LIVING, LLC**  
RESIDENTIAL DESIGN SINCE 1998  
904-730-7135

DATE:

6/21/2017


SCALE:

N.T.S

SHEET:

**A-1**

SITE LOCATION

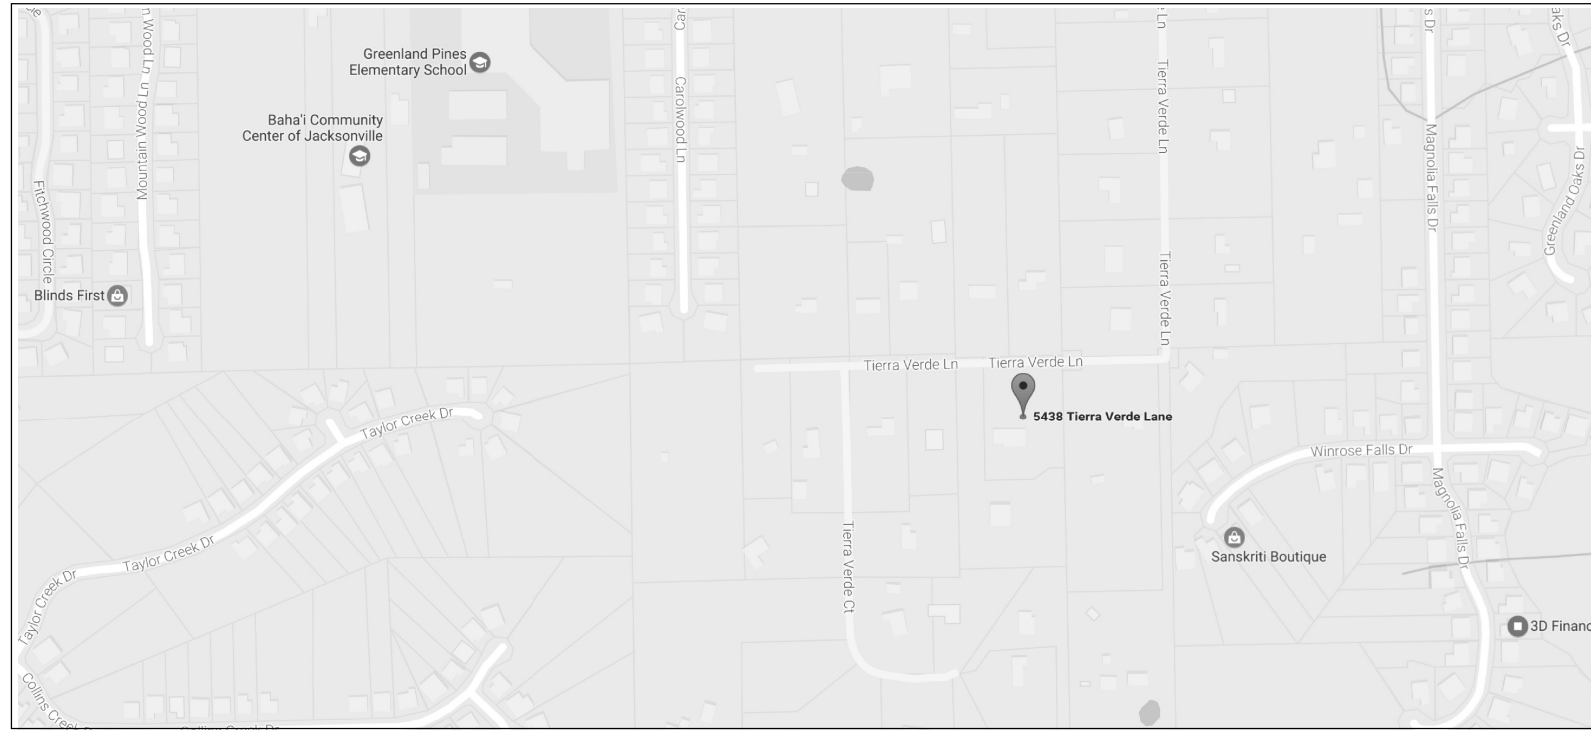


CONTRACT NOTE: CONTRACT AND SPECIFICATIONS TAKE PRECEDENCE OVER THESE DRAWINGS. ANY CONFLICT WILL DEFAULT TO SAID DOCUMENTS.

SITE CALCULATIONS:  
TOTAL LAND AREA: 87,555.60 S.F.= 2.01 ACRES  
HOME COVERAGE: 6036.33 S.F.  
% OF HOME COVERAGE: 6.894%  
DRIVES, STOOPS & HYAC COVERAGE: 2,460 S.F.  
% OF STOOPS & HYAC COVERAGE: 2.81%  
TOTAL IMPERVIOUS: 9.704%

SETBACKS:  
ZONING: RR  
FRONT = 25'  
SIDES = 10'  
REAR = 10'  
MAX.HT=35'  
MAX. LOT COVERAGE = 25%


PRIVATE EXISTING WELL & SEPTIC  
FLOOD ZONE: TYPE "X"-SHADED  
TYPE "C" DRAINAGE

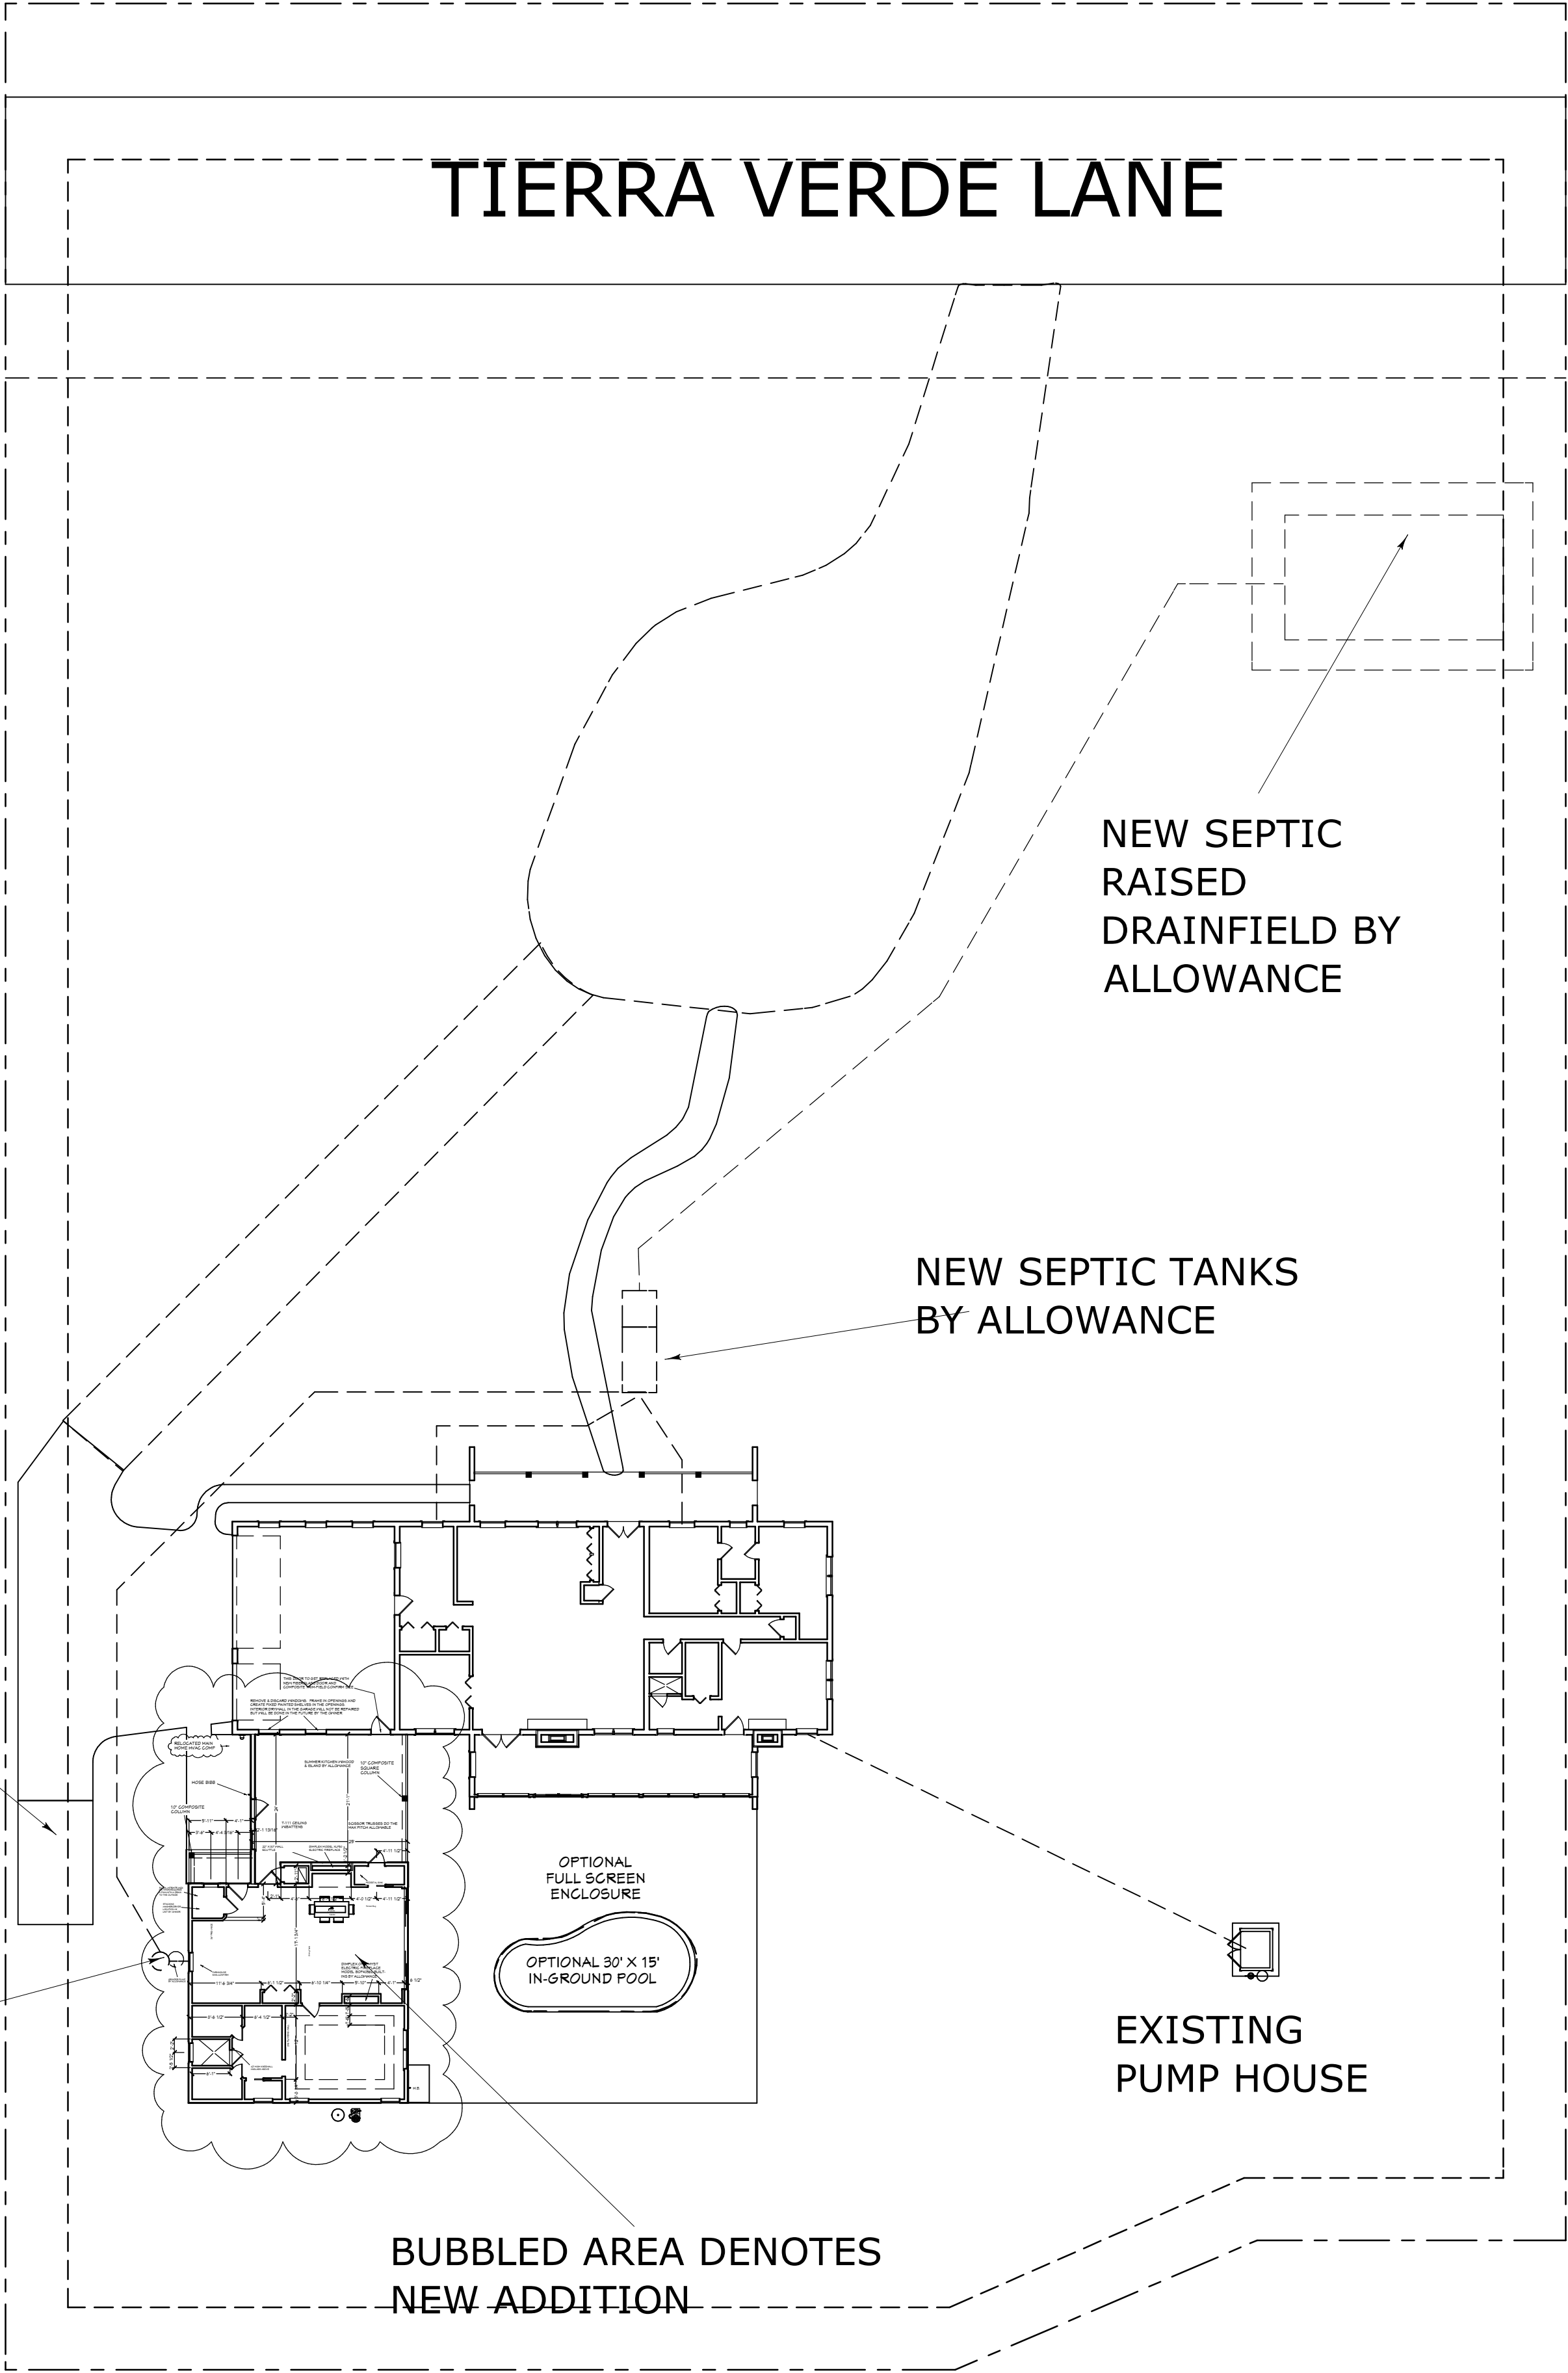

WIND DESIGN CRITERIA:  
WIND SPEED: 130 MPH  
EXPOSURE CATEGORY: "B"  
BUILDING TYPE: ENCLOSED  
BUILDING CATEGORY: II  
IMPORTANCE FACTOR: 1.0  
TOPOGRAPHY: SLOPED  
MEAN ROOF HEIGHT: 25 FT  
BUILDING CODE: 2014 FBC-R

NEW SEPTIC SYSTEM NOTE:  
ALTHOUGH THE SYSTEM SPECIFICATIONS HAVE BEEN LISTED HERE THEY ARE SUBJECT TO THE ACTUAL ENVIRONMENTAL HEALTH PERMIT.

REMOVAL AND STUMP GRINDING OF UP TO THREE 12" CALIPER TREES IS INCLUDED

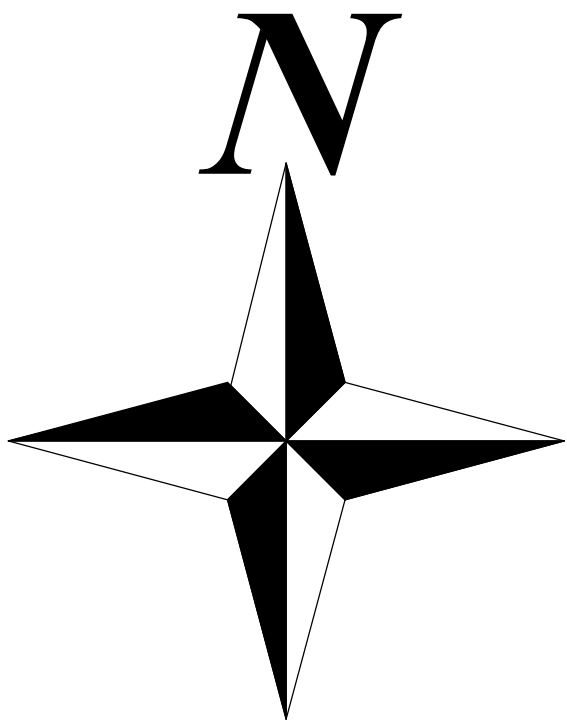

LEGAL DESCRIPTION:  
14 - 4S - 27E 2.01 ACRES  
R/E #: 1157149-0100  
PT SW 1/4 OF NW1/4  
RECD O/R 17782-676

SITE PLAN

COPYRIGHT 2017: DESIGNS FOR LIVING, LLC. -Under section 102 of the Architectural Works Copyright Protection Act (title 17 of the United States Code) specific tact copyright laws apply to original design of a building created in any tangible medium of expression, including a constructed building or architectural plans, models, or drawings and is subject to copyright protection as an "architectural work" by Designs for Living, LLC. herein referred to as Designer. It is unlawful for anyone to copy these drawings, either in whole or in part, without the express written permission of the Designer. The use of any plans, specifications, electronic or hard copy prints shall be restricted to the original site for which they were prepared and publication thereof is expressly limited to such use. Title to all works, specifically all drawings, specifications, and modified derivatives of any blueprints, e-files, drawings, or specifications remain the Designer's without prejudice. VISUAL CONTACT with any of these drawings, or their purchase constitutes prima facie evidence of the acceptance of these restrictions. This has held precedent in the North Florida Court system! Any and all violations WILL result in legal action being taken and litigated damages to the full extent allowed by law! No exceptions and no excuses! Contractor &/or owner shall verify all dimensions, details, & specifications prior to construction. Every attempt is made to avoid errors and omissions, but errors and omissions do occur and are assumed by the client. Copyright release approval and design for the drawings is provided for K.E. Chip Mitchell shall not be liable for error for copyright infringement or other errors after delivery via email of drawings including after construction has begun. This copyright law is only valid on building designs created on or after December 1, 1990.


PLAN #  
4119

CLIENT APPROVAL SIGNATURE DATE


JAMES W. DAVIS

LINDA M. DAVIS

BUILT BY: CBC1251050 CELL: 904-237-3433

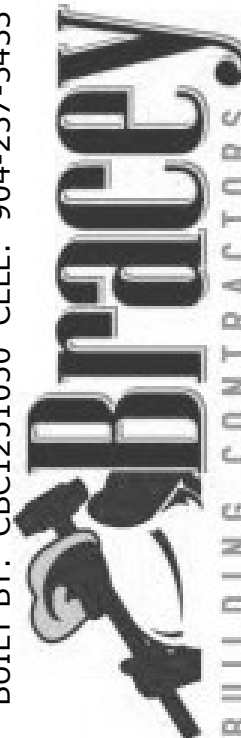  
BUILDING CONTRACTORS

PROJECT DESCRIPTION:  
RENOVATIONS FOR THE DAVIS FAMILY  
5438 TIERRA VERDE LANE  
JACKSONVILLE, FLORIDA 32228-2281  
R/E #: 157149-0100

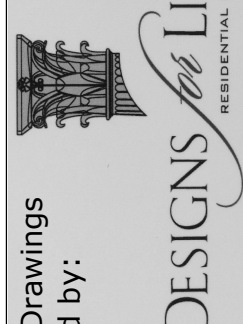
  
DESIGNS FOR LIVING, LLC  
RESIDENTIAL DESIGN SINCE 1999  
904-730-7135



Design Drawings provided by:

DATE:  
6/21/2017


SCALE:  
1" = 20'-0"

SHEET:  
A-2

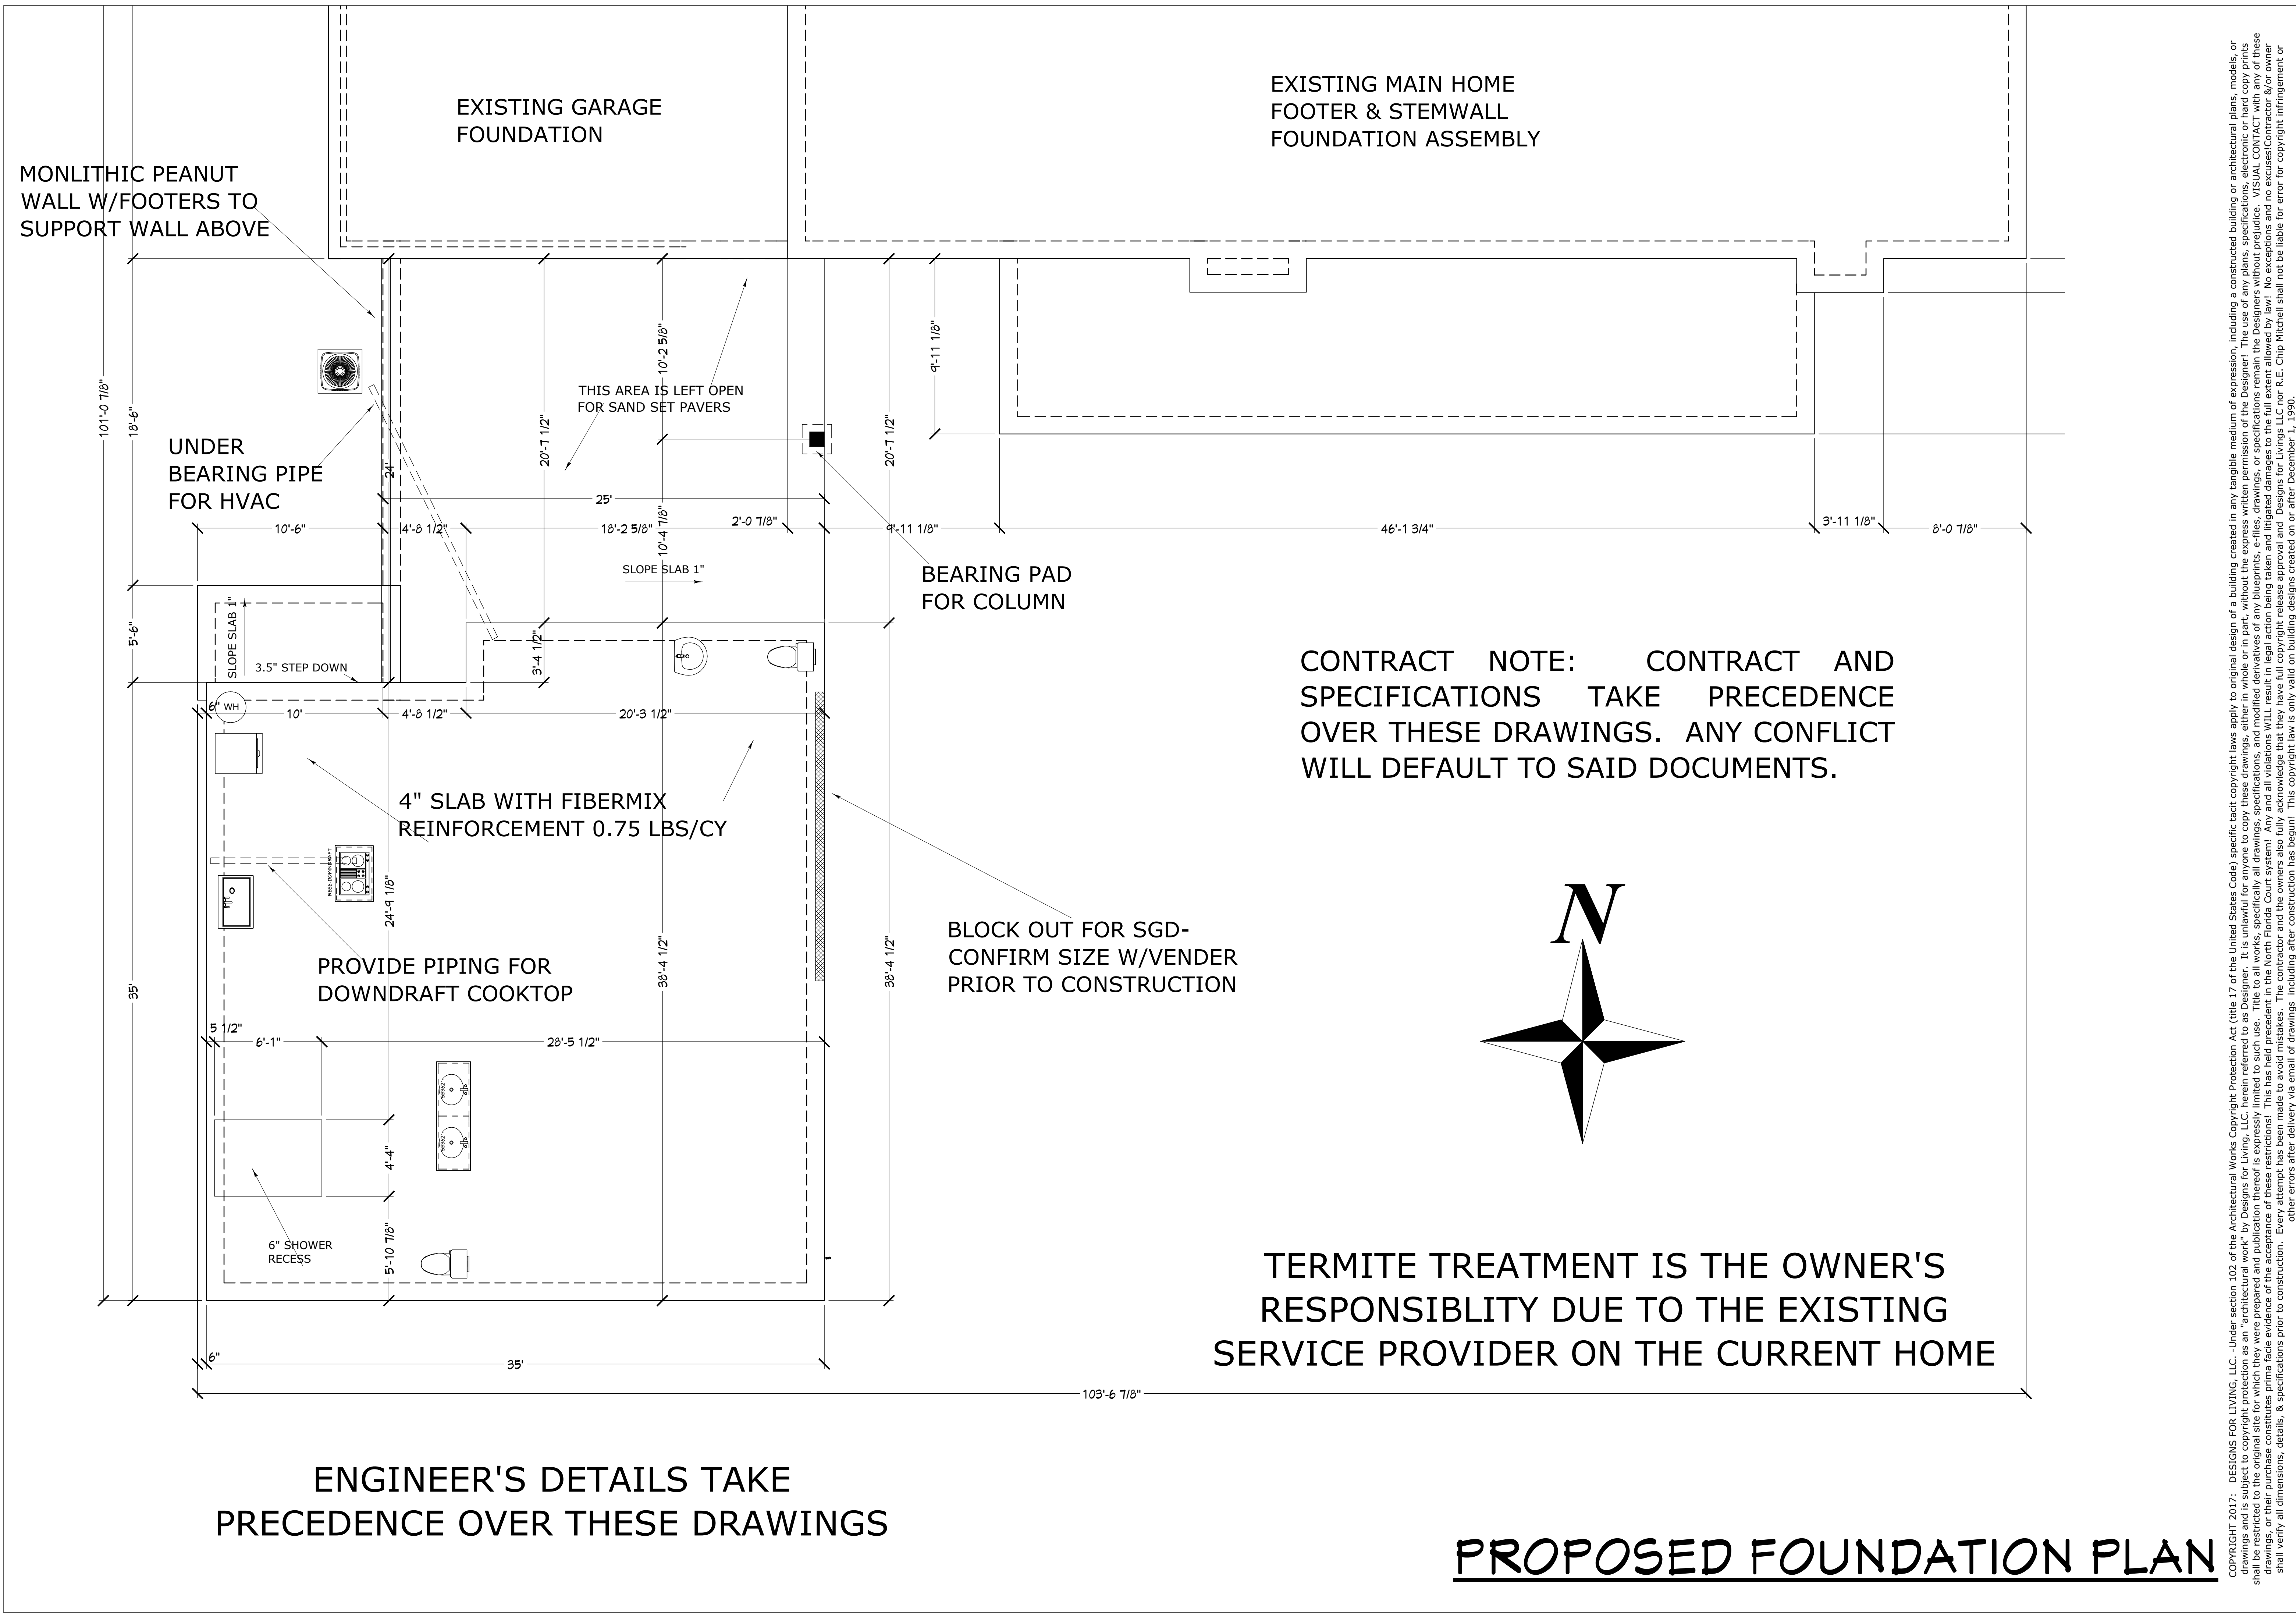

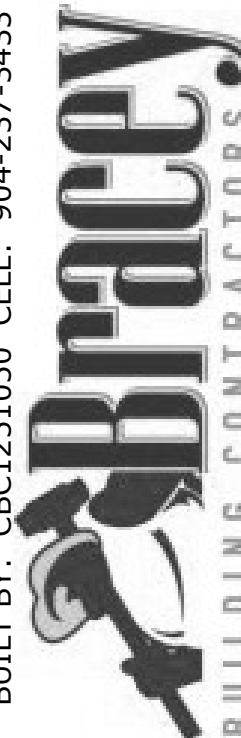
|  |                    |
|--|--------------------|
| PLAN #<br>4119   |                    |
| CLIENT APPROVAL SIGNATURE  | DATE               |
| JAMES W. DAVIS   |                    |
| LINDA M. DAVIS   |                    |
| BUILT BY: CBC1251050 CELL: 904-237-3433  |                    |
|   |                    |
| PROJECT DESCRIPTION:<br>RENOVATIONS FOR THE DAVIS FAMILY<br>5438 TIERRA VERDE LANE<br>JACKSONVILLE, FLORIDA 32228-2281<br>R/E #: 157149-0100 |                    |
|   |                    |
| Design Drawings provided by:   | DATE:<br>6/21/2017 |
| SCALE:<br>1/4" = 1'-0"   | SHEET:<br>A-3      |

COPYRIGHT 2017: DESIGNS FOR LIVING, LLC. -Under section 102 of the Architectural Works Copyright Protection Act (title 17 of the United States Code) specific tact copyright laws apply to original design of a building created in any tangible medium of expression, including a constructed building or architectural plans, models, or drawings and is subject to copyright protection as an "architectural work" by Designs for Living, LLC. herein referred to as Designer. It is unlawful for anyone to copy these drawings, either in whole or in part, without the express written permission of the Designer. The use of any plans, specifications, electronic or hard copy prints shall be restricted to the original site for which they were prepared and publication thereof is expressly limited to such use. Title to all works, specifically all drawings, specifications, and modified derivatives of any blueprints, e-files, drawings, or specifications remain the Designer's without prejudice. VISUAL CONTACT with any of these drawings, or their purchase constitutes prima facie evidence of the acceptance of these restrictions. This has held precedent in the North Florida Court system! Any and all violations WILL result in legal action being taken and litigated damages to the full extent allowed by law! No exceptions and no excuses! Contractor &/or owner shall verify all dimensions, details, & specifications prior to construction. Every attempt shall be made to avoid errors and omissions and as such, the Designer does not assume any liability for errors or omissions. Copyright release approval and design for errors or omissions shall be provided to the Designer for R.E. Chip Mitchell shall not be liable for copyright infringement or other errors after delivery via email of drawings including after construction has begun. This copyright law is only valid on building designs created on or after December 1, 1990.

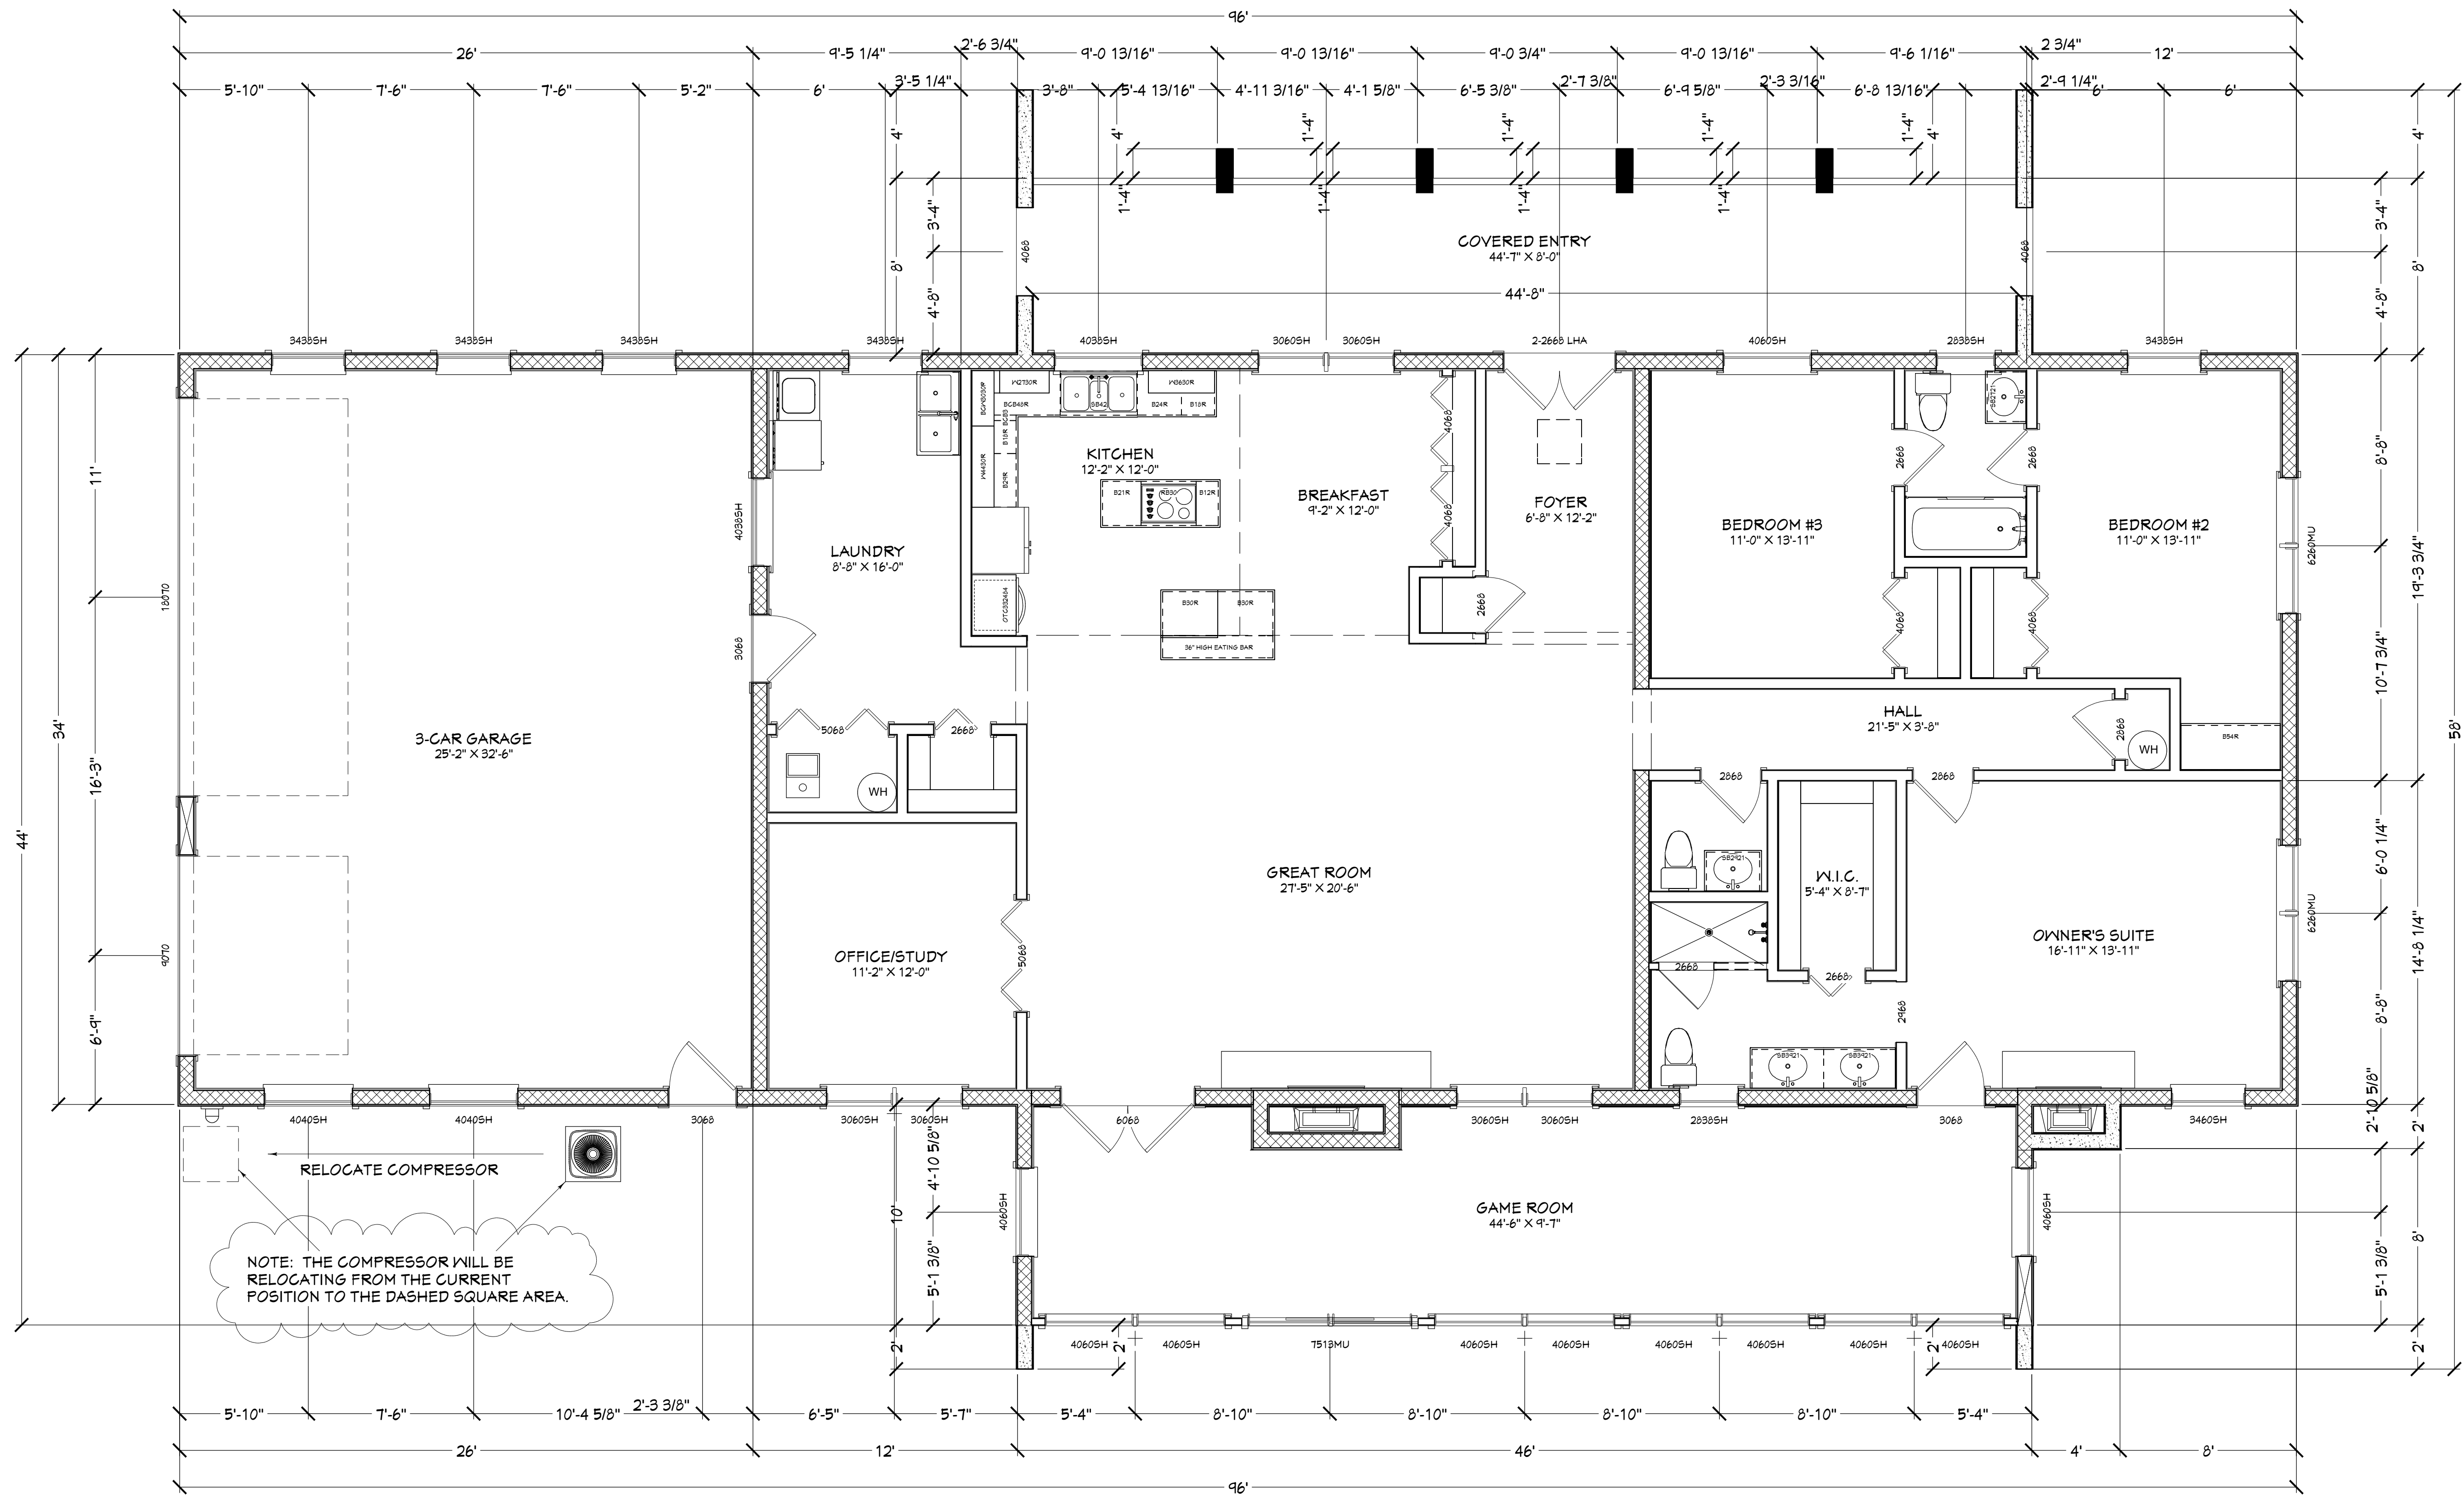

CONTRACT NOTE: CONTRACT AND SPECIFICATIONS TAKE PRECEDENCE OVER THESE DRAWINGS. ANY CONFLICT WILL DEFAULT TO SAID DOCUMENTS.

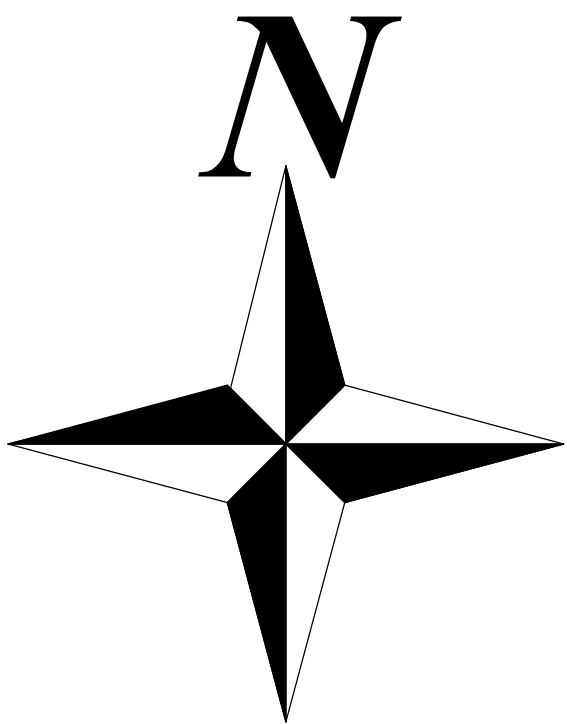

| EXISTING FOOTAGES<br>(A.N.S.I.): |          |
|----------------------------------|----------|
| ENTRY:                           | 429.33   |
| 3-CAR GARAGE:                    | 884.00   |
| FIREPLACE:                       | 8.00     |
| TOTAL HEATED:                    | 2,848.00 |
| SLAB AREA:                       | 4,169.33 |
| UNDER ROOF:                      | 4,109.92 |

AS-BUILT FLOOR PLAN

COPYRIGHT 2017: DESIGNS FOR LIVING, LLC. -Under section 102 of the Architectural Works Copyright Protection Act (title 17 of the United States Code) specific tact copyright laws apply to original design of a building created in any tangible medium of expression, including a constructed building or architectural plans, models, or drawings and is subject to copyright protection as an "architectural work" by Designs for Living, LLC. herein referred to as Designer. It is unlawful for anyone to copy these drawings, either in whole or in part, without the express written permission of the Designer. The use of any plans, specifications, electronic or hard copy prints shall be restricted to the original site for which they were prepared and publication thereof is expressly limited to such use. Title to all works, specifically all drawings, specifications, and modified derivatives of any blueprints, e-files, drawings, or specifications remain the Designer's without prejudice. VISUAL CONTACT with any of these drawings, or their purchase constitutes prima facie evidence of the acceptance of these restrictions. This has held precedent in the North Florida Court system! Any and all violations WILL result in legal action being taken and litigated damages to the full extent allowed by law! No exceptions and no excuses! Contractor &/or owner shall verify all dimensions, details, & specifications prior to construction. Every attempt shall be made to avoid errors and omissions and the Designer shall not be liable for copyright infringement or other errors after delivery via email of drawings including after construction has begun. This copyright law is only valid on building designs created on or after December 1, 1990.

Design Drawings  
provided by:



904-730-7135

DATE:

6/21/2017

SCALE:

1/4" = 1'-0"

SHEET:

A-4

PROJECT DESCRIPTION:  
RENOVATIONS FOR THE DAVIS FAMILY  
5438 TIERRA VERDE LANE  
JACKSONVILLE, FLORIDA 32228-2281  
R/E #: 157149-0100

BUILT BY: CBC1251050 CELL: 904-237-3433




CLIENT APPROVAL SIGNATURE DATE

JAMES W. DAVIS


LINDA M. DAVIS

PLAN #  
4119

CONTRACT NOTE: CONTRACT AND SPECIFICATIONS TAKE PRECEDENCE OVER THESE DRAWINGS. ANY CONFLICT WILL DEFAULT TO SAID DOCUMENTS.

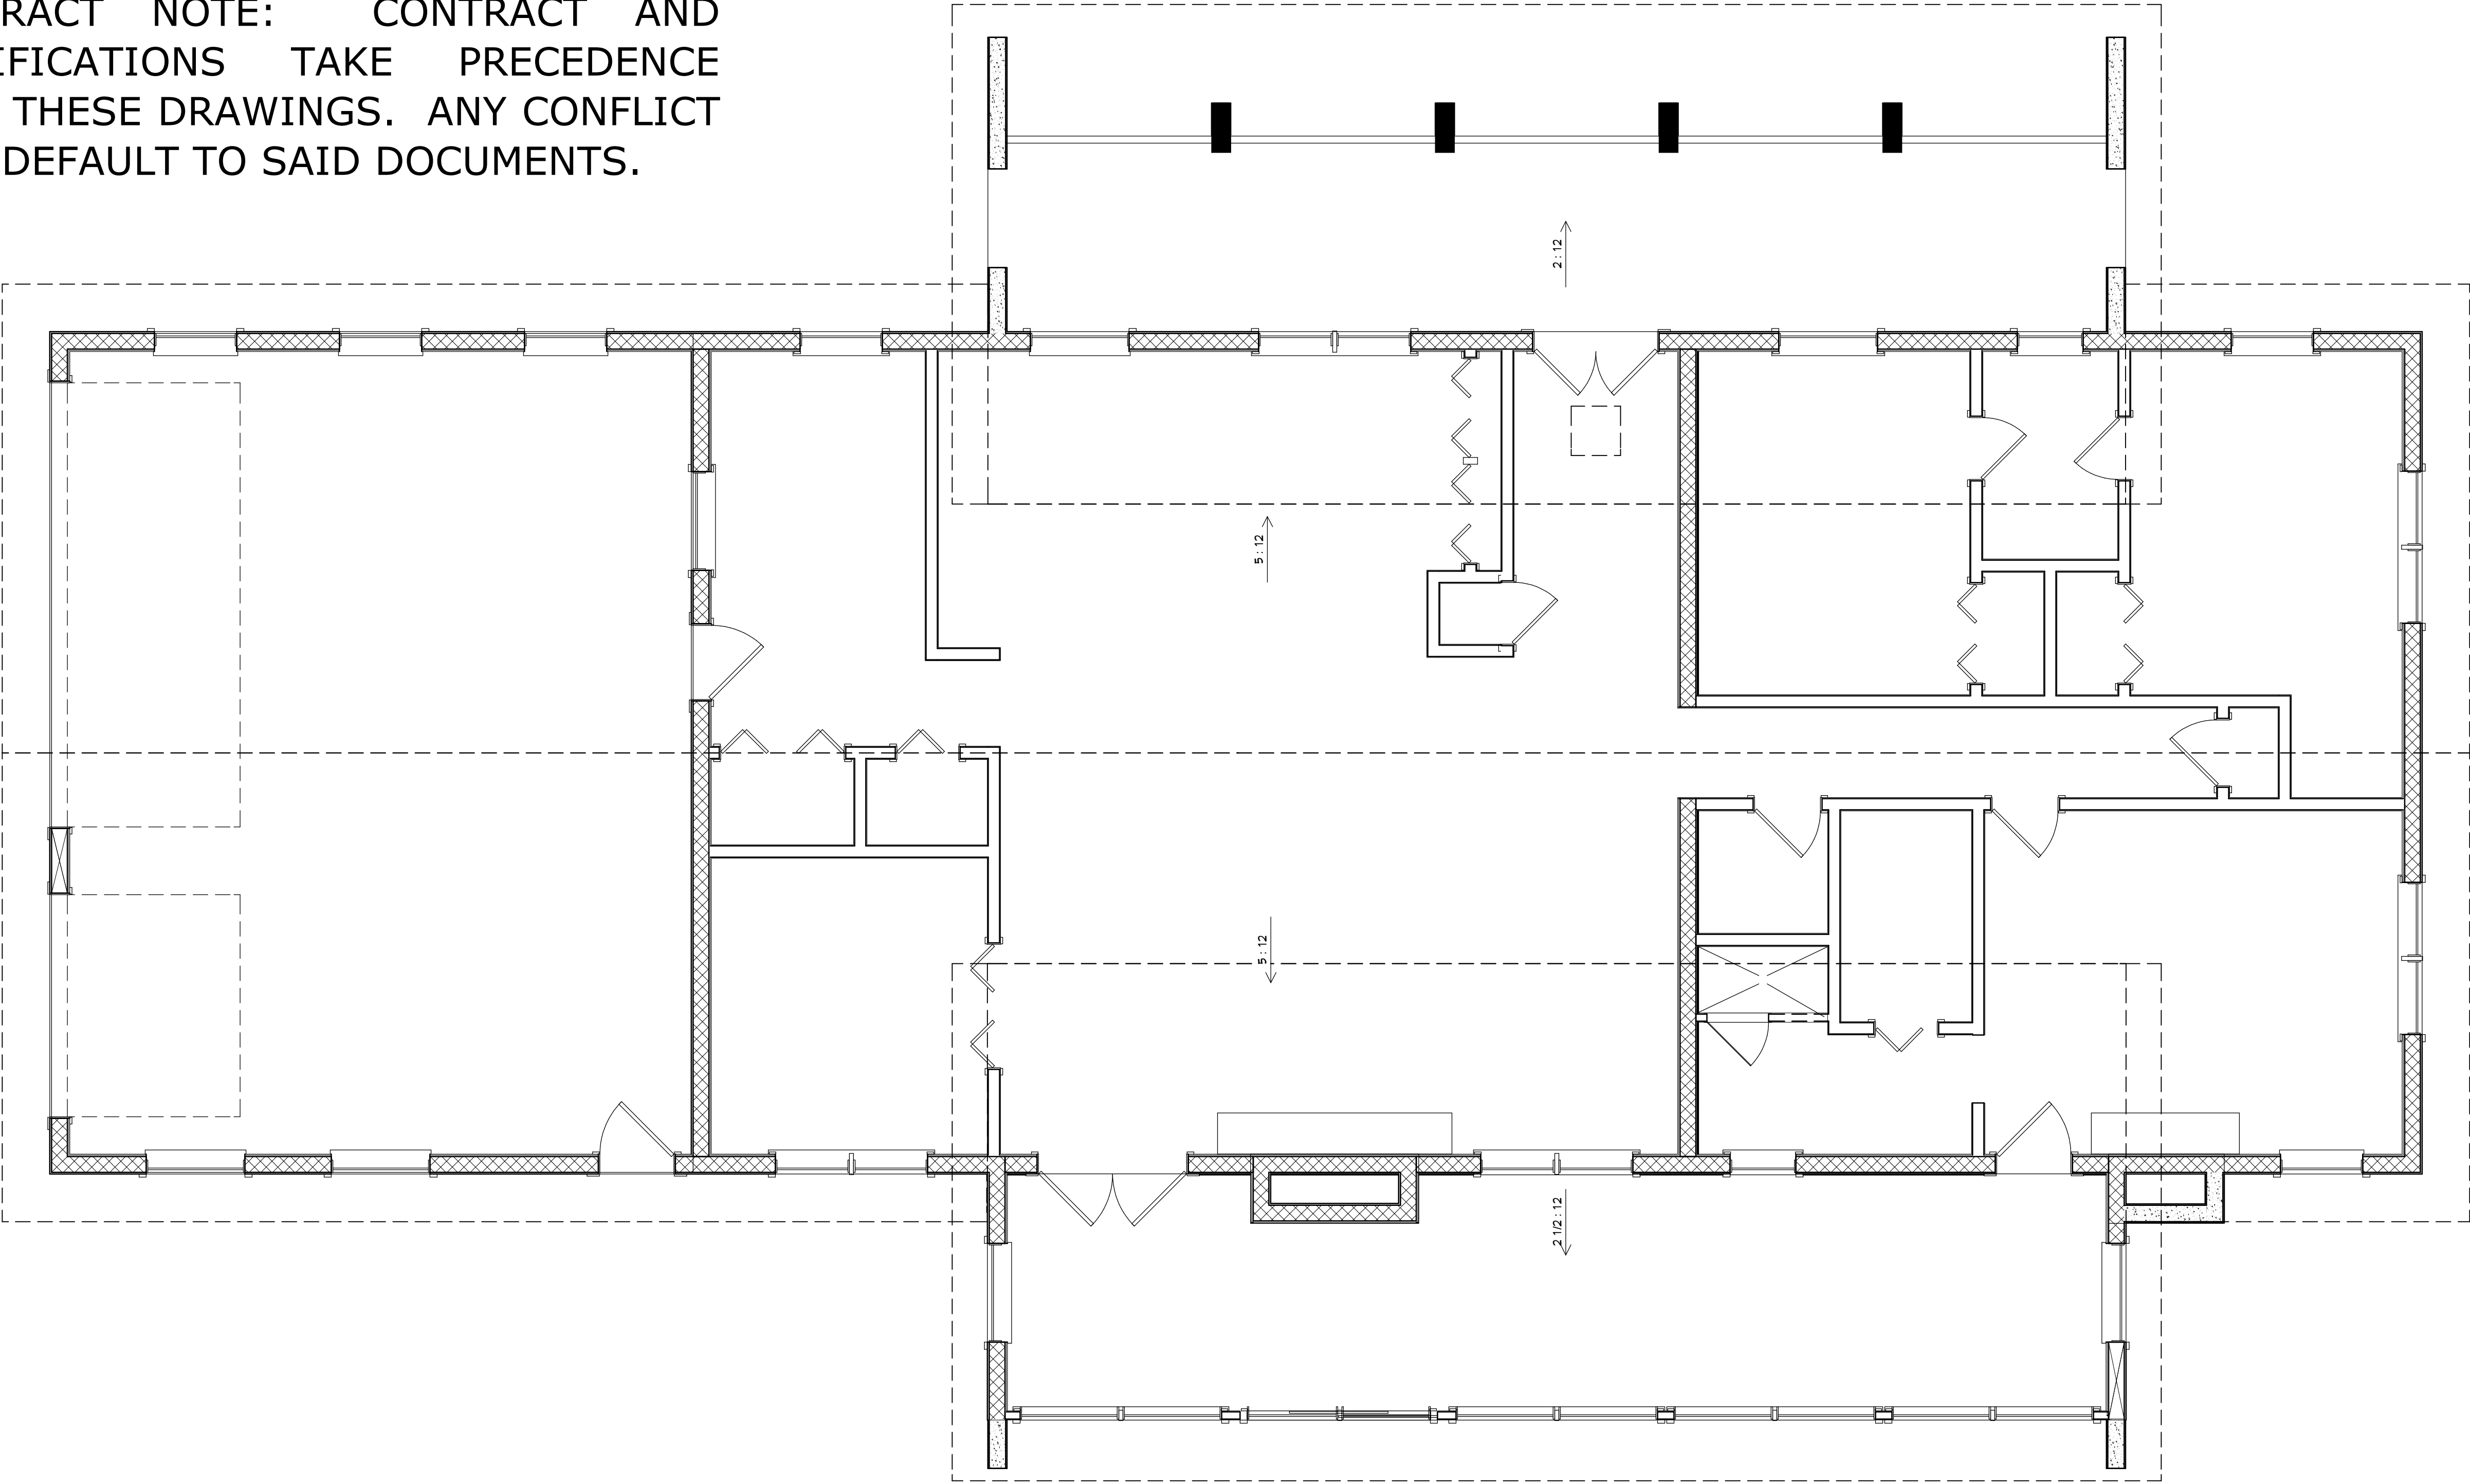

EXISTING ROOF NOTES:  
FASCIA: 2X6 W/1X2 P.T. DRIP  
EAVE OVERHANG: 24"  
SOFFITS: SMOOTH PLYWOOD W/LINEAR PERFORATED ALUMINUM VENTS  
ROOFING: SCREW DOWN METAL 5V CRIMP ROOF  
ROOF PITCH: 5/12 & 2.5/12-FIELD CONFIRM  
TRUSS HEELS: STANDARD  
VENTS: GABLE END VENTS

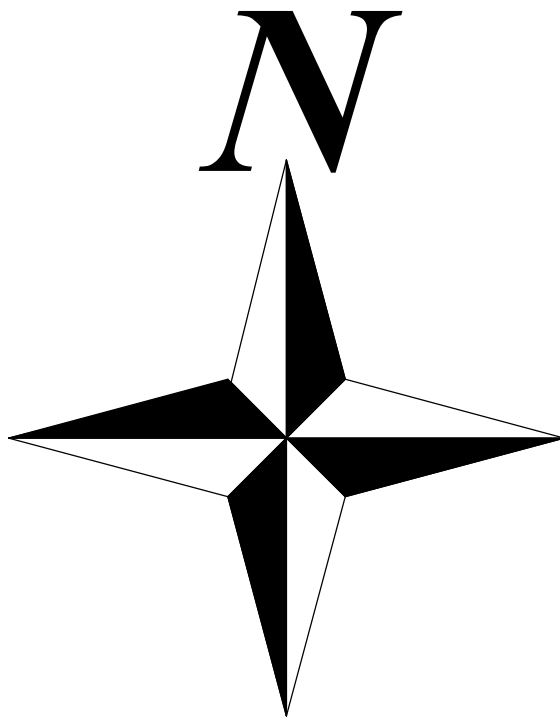

AS-BUILT ROOF PLAN

COPYRIGHT 2017: DESIGNS FOR LIVING, LLC. -Under section 102 of the Architectural Works Copyright Protection Act (title 17 of the United States Code) specific tact copyright laws apply to original design of a building created in any tangible medium of expression, including a constructed building or architectural plans, models, or drawings and is subject to copyright protection as an "architectural work" by Designs for Living, LLC. herein referred to as Designer. It is unlawful for anyone to copy these drawings, either in whole or in part, without the express written permission of the Designer. The use of any plans, specifications, electronic or hard copy prints shall be restricted to the original site for which they were prepared and publication thereof is expressly limited to such use. Title to all works, specifically all drawings, specifications, and modified derivatives of any blueprints, e-files, drawings, or specifications remain the Designer's without prejudice. VISUAL CONTACT with any of these drawings, or their purchase constitutes prima facie evidence of the acceptance of these restrictions! This has held precedent in the North Florida Court system! Any and all violations WILL result in legal action being taken and litigated damages to the full extent allowed by law! No exceptions and no excuses! Contractor &/or owner shall verify all dimensions, details, & specifications prior to construction. Every attempt shall be made to avoid errors and omissions as fully as possible. The Designer does not warrant the accuracy of the drawings and is not responsible for any errors or omissions. The Designer shall not be liable for copyright infringement or other errors after delivery via email or drawings including after construction has begun. This copyright law is only valid on building designs created on or after December 1, 1990.


|  |              |
|--|--------------|
| PLAN #<br>4119   |              |
| CLIENT APPROVAL SIGNATURE  | DATE         |
| JAMES W. DAVIS   |              |
| LINDA M. DAVIS   |              |
| BUILT BY: CBC1251050 CELL: 904-237-3433  |              |
|   |              |
| PROJECT DESCRIPTION:<br>RENOVATIONS FOR THE DAVIS FAMILY<br>5438 TIERRA VERDE LANE<br>JACKSONVILLE, FLORIDA 32228-2281<br>R/E #: 157149-0100 |              |
|   |              |
| DATE:  | 6/21/2017    |
| SCALE:   | 1/4" = 1'-0" |
| SHEET:   | A-5          |




REAR ELEVATION

NOTE: THIS COMPRESSOR  
WILL GET SHIFTED TO THE  
LEFT AS NOTED ON SHEET A-4

CONTRACT NOTE: CONTRACT AND  
SPECIFICATIONS TAKE PRECEDENCE  
OVER THESE DRAWINGS. ANY CONFLICT  
WILL DEFAULT TO SAID DOCUMENTS.

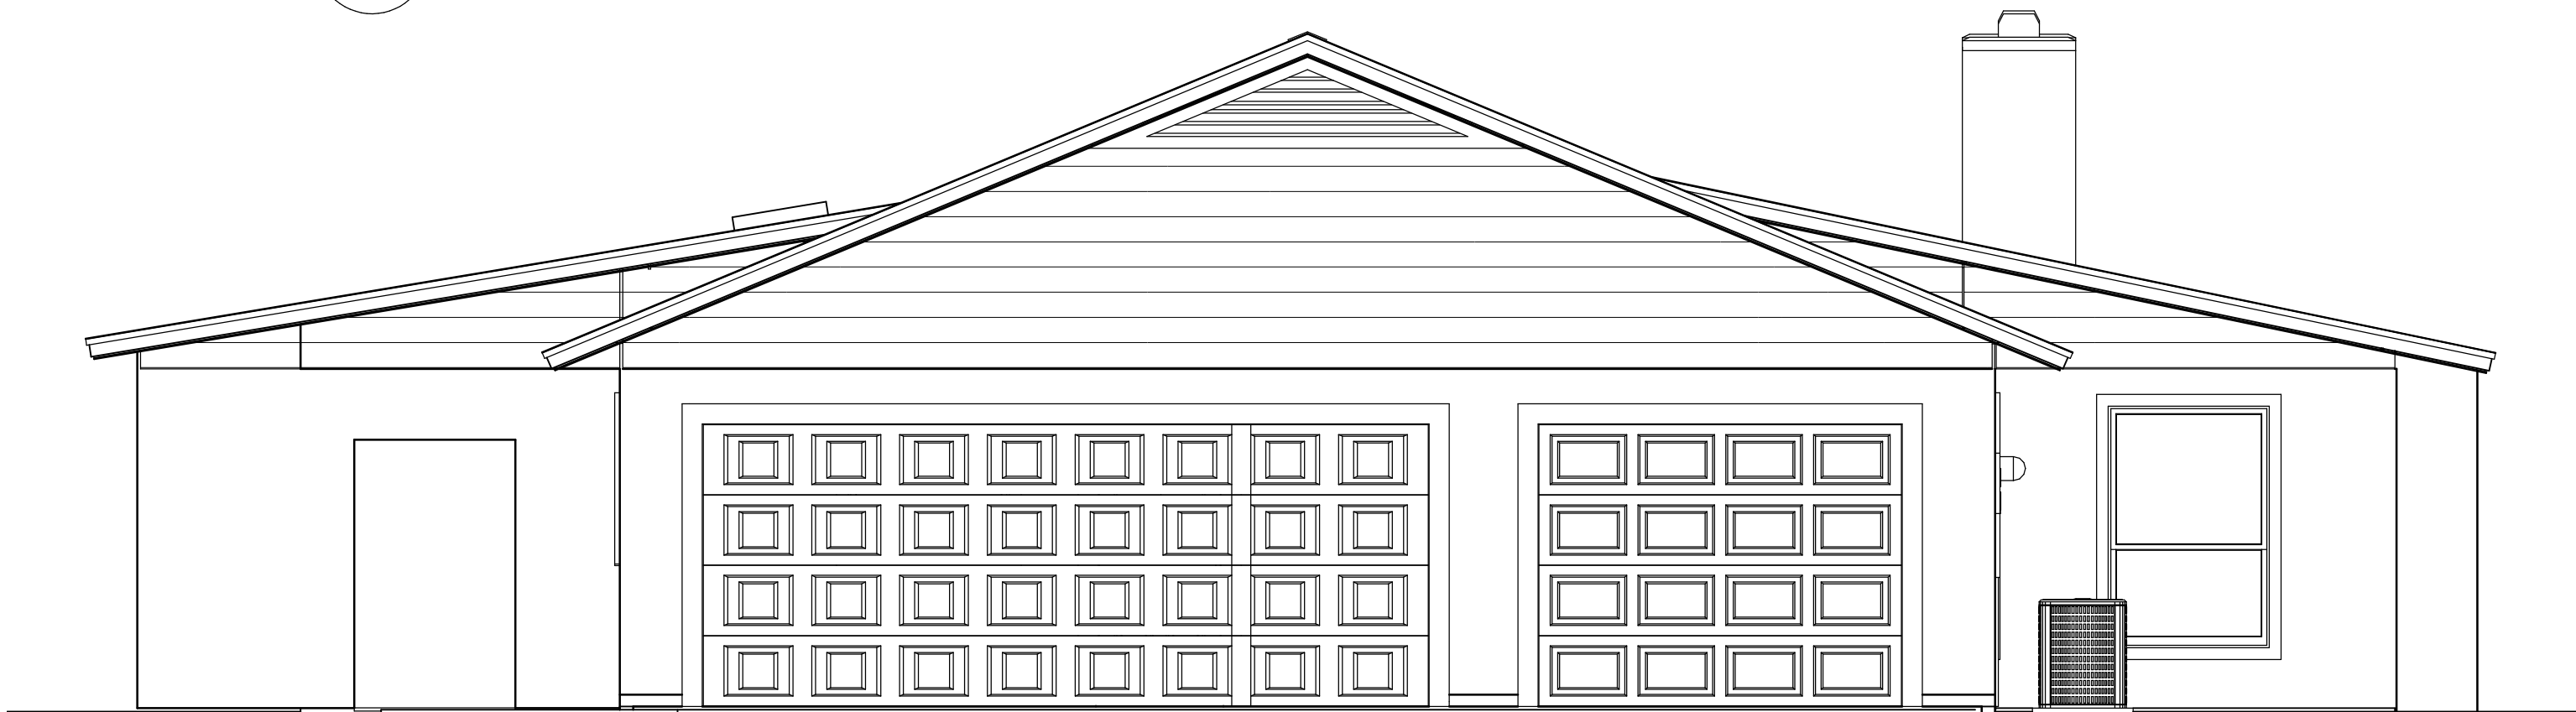

RIGHT ELEVATION

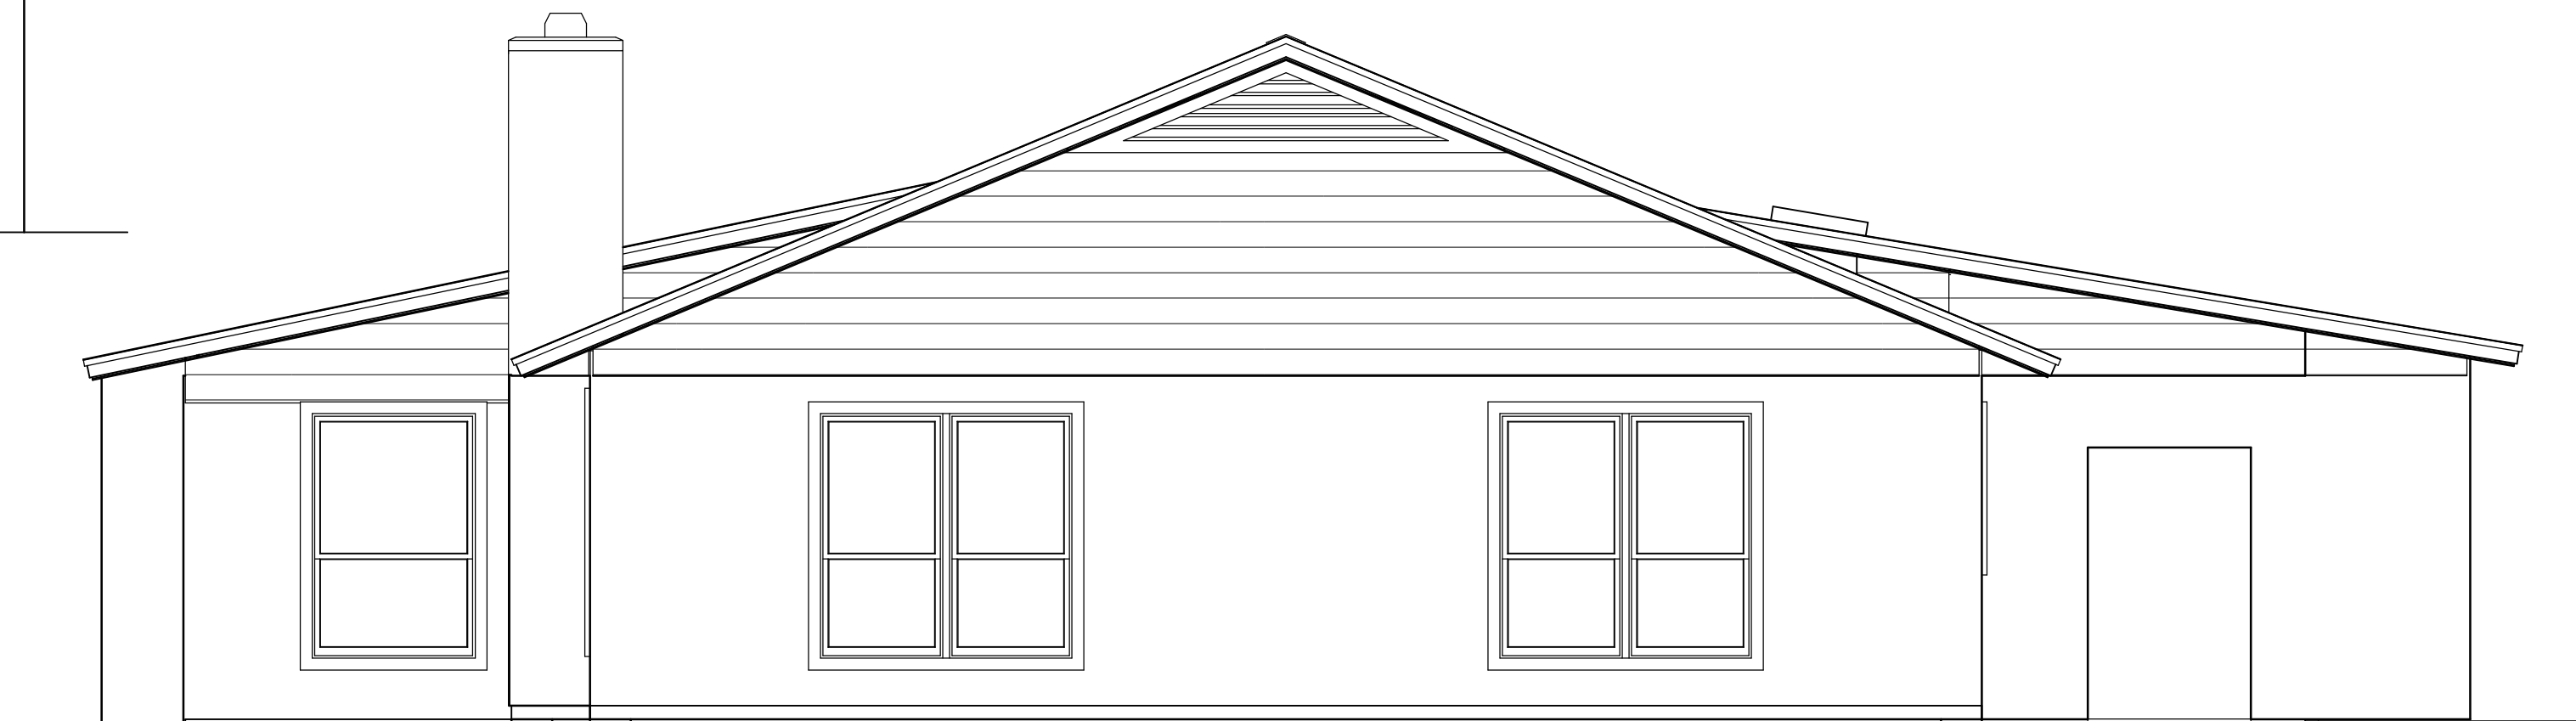

LEFT ELEVATION



FRONT ELEVATION

AS-BUILT ELEVATIONS

COPYRIGHT 2017: DESIGNS FOR LIVING, LLC. -Under section 102 of the Architectural Works Copyright Protection Act (title 17 of the United States Code) specific tact copyright laws apply to original design of a building created in any tangible medium of expression, including a constructed building or architectural plans, models, or drawings and is subject to copyright protection as an "architectural work" by Designs for Living, LLC. herein referred to as Designer. It is unlawful for anyone to copy these drawings, either in whole or in part, without the express written permission of the Designer. The use of any plans, specifications, electronic or hard copy prints shall be restricted to the original site for which they were prepared and publication thereof is expressly limited to such use. 

PROJECT DESCRIPTION:  
RENOVATIONS FOR THE DAVIS FAMILY  
5438 TIERRA VERDE LANE  
JACKSONVILLE, FLORIDA 32228-2281  
R/E #: 157149-0100

Design Drawings  
provided by:  
DESIGNS FOR LIVING, LLC  
RESIDENTIAL DESIGN SINCE 1999  
904-730-7135


DATE:  
6/21/2017  
SCALE:  
1/4" = 1'-0"  
SHEET:  
A-6

PLAN #  
4119  
CLIENT APPROVAL SIGNATURE DATE  
JAMES W. DAVIS  
LINDA M. DAVIS  
BUILT BY: CBC1251050 CELL: 904-237-3433  
Bracey  
BUILDING CONTRACTORS



NOTE: THIS COMPRESSOR  
WILL GET SHIFTED TO THE  
LEFT AS NOTED ON SHEET A-4

CONTRACT NOTE: CONTRACT AND  
SPECIFICATIONS TAKE PRECEDENCE  
OVER THESE DRAWINGS. ANY CONFLICT  
WILL DEFAULT TO SAID DOCUMENTS.

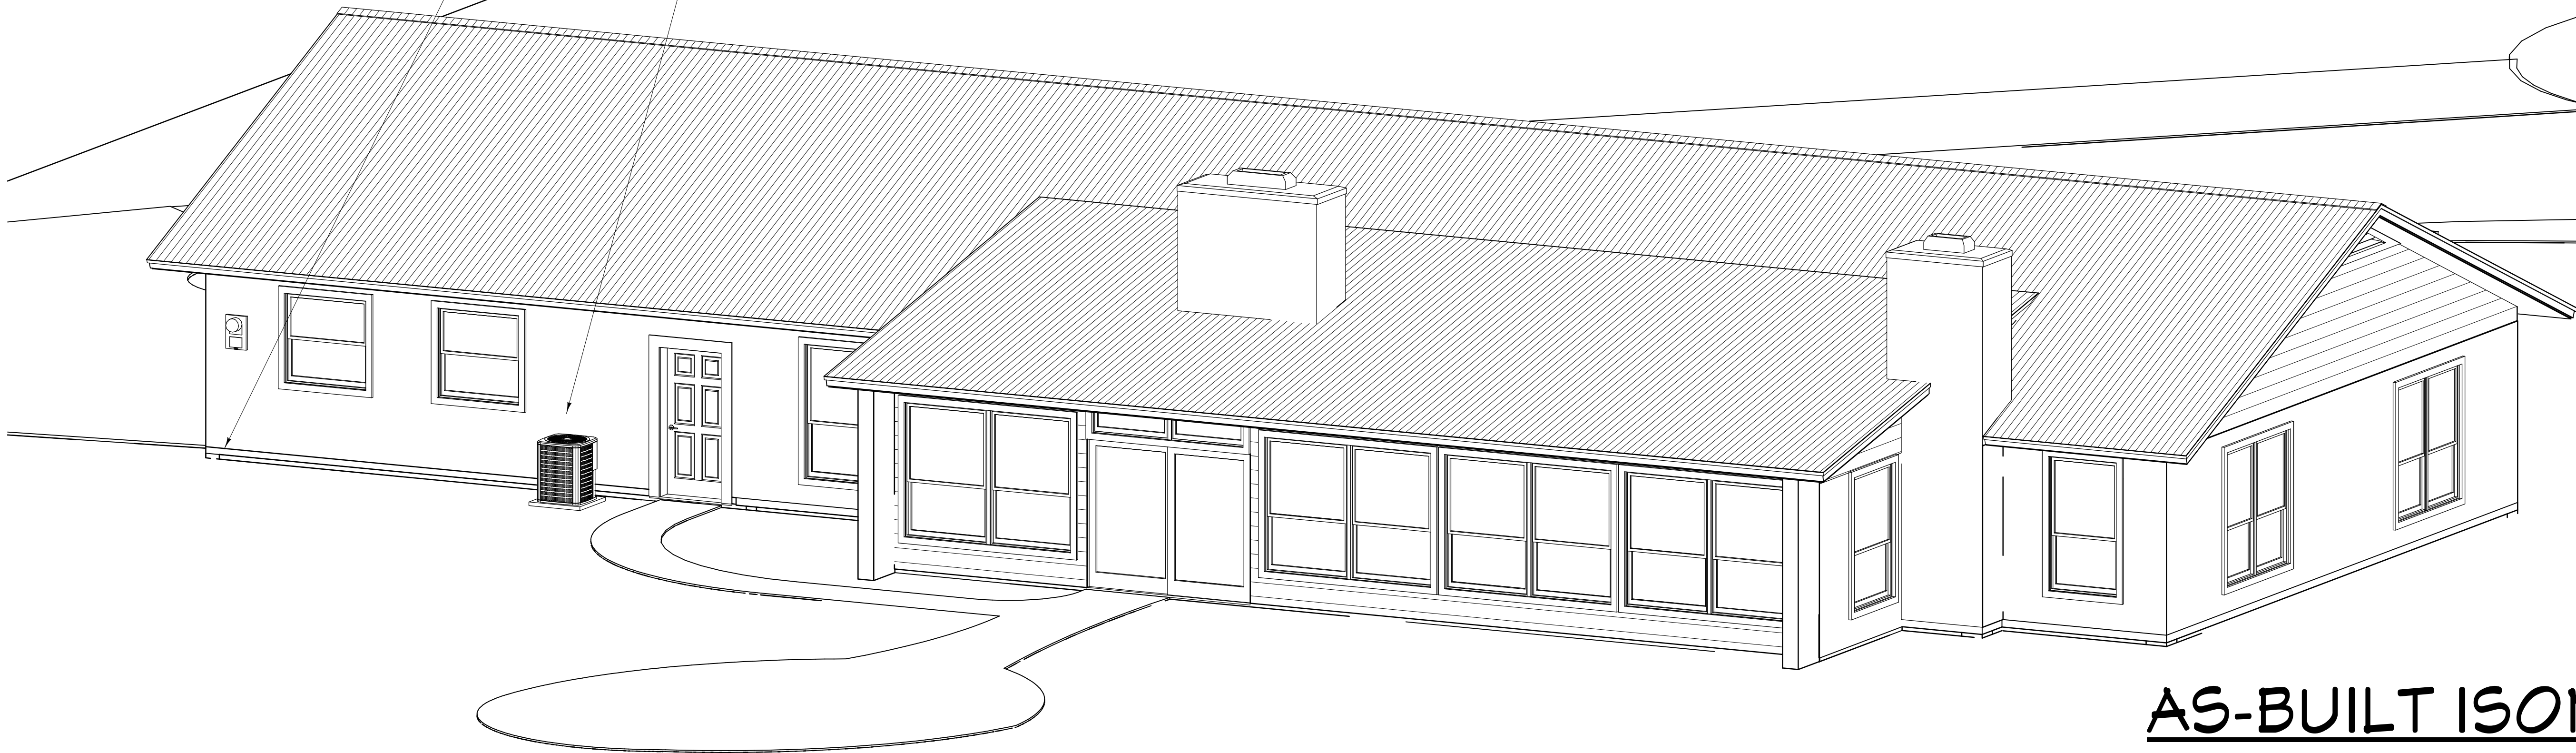

**AS-BUILT ISOMETRICS**

COPYRIGHT 2017: DESIGNS FOR LIVING, LLC. -Under section 102 of the Architectural Works Copyright Protection Act (title 17 of the United States Code) specific tacit copyright laws apply to original design of a building created in any tangible medium of expression, including a constructed building or architectural plans, models, or drawings and is subject to copyright protection as an "architectural work" by Designs for Living, LLC, herein referred to as Designer. It is unlawful for anyone to copy these drawings, either in whole or in part, without the express written permission of the Designer. The use of any plans, specifications, electronic or hard copy prints shall be restricted to the original site for which they were prepared and publication thereof is expressly limited to such use. Title to all works, specifically all drawings, specifications, and modified derivations of any blueprints, e-files, drawings, or specifications remain the Designer's without prejudice. VISUAL CONTACT with any of these drawings, or their purchase constitutes prima facie evidence of the acceptance of these restrictions! This has held precedent in the North Florida Court system! Any and all violations WILL result in legal action being taken and litigated damages to the full extent allowed by law! No exceptions and no excuses! Contractor &/or owner shall verify all dimensions, details, & specifications prior to construction. Every attempt shall be made to avoid mistakes. The Designer and/or owner is not responsible for any errors or omissions in these drawings or specifications. The Designer shall not be liable for copyright infringement or other errors after delivery via email of drawings including after construction has begun. This copyright law is only valid on building designs created on or after December 1, 1990.

|   |           |
|---|-----------|
| PLAN #<br>4119  |           |
| CLIENT APPROVAL SIGNATURE   | DATE      |
| JAMES W. DAVIS  |           |
| LINDA M. DAVIS  |           |
| BUILT BY: CBC1251050 CELL: 904-237-3433   |           |
|    |           |
| PROJECT DESCRIPTION:<br>RENOVATIONS FOR THE DAVIS FAMILY<br>5438 TIERRA VERDE LANE<br>JACKSONVILLE, FLORIDA 32228-2281<br>R/E #: 157149-0100  |           |
| Design Drawings provided by:<br><br>DESIGNS FOR LIVING, LLC<br>RESIDENTIAL DESIGN SINCE 1999<br>904-730-7135 |           |
| DATE:   | 6/21/2017 |
| SCALE:  | N.T.S     |
| SHEET:  | A-7       |

**COPYRIGHT 2017: DESIGNS FOR LIVING, LLC.** -Under section 102 of the Architectural Works Copyright Protection Act (title 17 of the United States Code) specific tacit copyright laws apply to original design of a building created in any tangible medium of expression, including a constructed building or architectural plans, models, or drawings and is subject to copyright protection as an "architectural work" by Designs for Living, LLC. herein referred to as Designer. It is unlawful for anyone to copy these drawings, either in whole or in part, without the express written permission of the Designer. The use of any plans, specifications, electronic or hard copy prints shall be restricted to the original site for which they were prepared and publication thereof is expressly limited to such use. Title to all works, specifically all drawings, specifications, and modified derivatives of any blueprints, e-files, drawings, or specifications remain the designers without prejudice. VISUAL CONTACT with any of these drawings, or their purchase constitutes prima facie evidence of the acceptance of these restrictions! This has held precedent in The North Florida Court system! Any and all violations WILL result in legal action being taken and litigated damages to the full extent allowed by law! No exceptions and no excuses Contractor &/or owner shall verify all dimensions, details, & specifications prior to construction. Every attempt has been made to avoid mistakes. The contractor and the owners also fully acknowledge that they have full copyright release approval and Designs for Livings LLC nor R.E. Chip Mitchell shall not be liable for copyright infringement or other errors after delivery via email of drawings including after construction has begun! This copyright law is only valid on building designs created on or after December 1, 1990.

NEW REAR ROOF AREA IS 27  
SQUARES WITH 176 L.F. OF  
CONTINUOUS VENT SOFFITS


THIS AREA ABOVE THE ENTRY  
PORCH IS CONVENTIONALLY FRAMED  
AND OPTIONAL ALONG WITH THE  
NEW PORCH COLUMNS AND RAILING

INSULATION NOTES:  
WALLS: R-19 FIBERGLASS BATTS  
KNEEWALLS: R-19 FIBERGLASS BATTS  
CEILINGS: R-38 BLOWN FIBERGLASS  
ROOF SHEATHING: 1/2" RADIANT  
BARRIER OSB

CONTRACT NOTE: CONTRACT AND  
SPECIFICATIONS TAKE PRECEDENCE  
OVER THESE DRAWINGS. ANY CONFLICT  
WILL DEFAULT TO SAID DOCUMENTS.

ROOF NOTES:  
FASCIA: 2X6 WITH 1X2 P.T. DRIP  
EAVE OVERHANG: 24"  
SOFFITS: SMOOTH PLYWOOD TO MATCH EXISTING  
ROOFING: SCREW DOWN METAL ROOF TO MATCH EXISTING  
ROOF PITCH: 5/12-FIELD CONFIRM  
TRUSS HEELS: STANDARD-BUILDER TO CONFIRM  
ROOF VENTS: TWO-SIX FOOT OFF-RIDGE VENTS  
SOFFIT VENTS: CONTINUOUS 2" + ALUMINUM VENTS  
CONNECTOR BETWEEN NEW AND OLD TO BE CONVENTIONALLY FRAMED  
ROOF SHEATHING: 1/2" RADIANT BARRIER OSB  
TOTAL SQUARES: 27  
L.L. SOFFIT & FASCIA: 176

**IMPORTANT TRUSS NOTE: IT IS THE BUILDERS RESPONSIBILITY TO  
CONFIRM THE HEEL HEIGHT REQUIRED ON THE TRUSSES PRIOR TO  
ENGINEERING AND CONSTRUCTION**

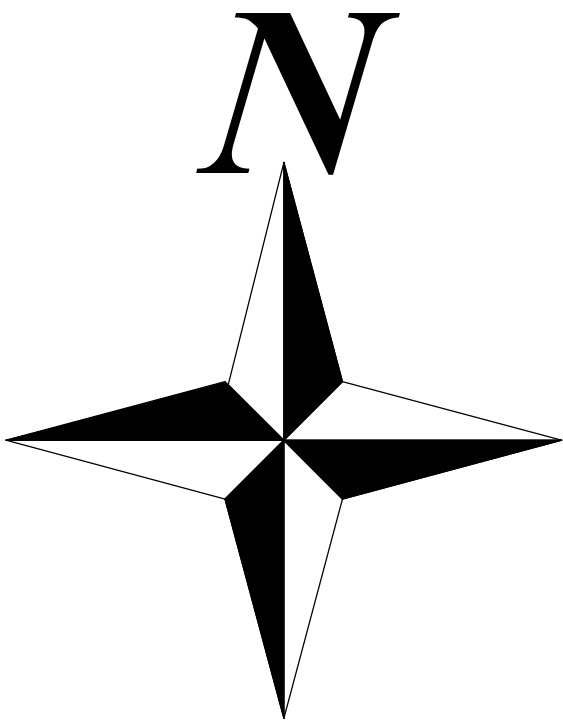

**PROPOSED ROOF PLAN**  
**CAUTION: 3/16" SCALE**

COPYRIGHT 2017: DESIGNS FOR LIVING, LLC. -Under section 102 of the Architectural Works Copyright Protection Act (title 17 of the United States Code) specific tacit copyright laws apply to original design of a building created in any tangible medium of expression, including a constructed building or architectural plans, models, or drawings and is subject to copyright protection as an "architectural work" by Designs for Living, LLC. herein referred to as Designer. It is unlawful for anyone to copy these drawings, either in whole or in part, without the express written permission of the Designer. The use of any plans, specifications, electronic or hard copy prints shall be restricted to the original site for which they were prepared and publication thereof is expressly limited to such use. Title to all works, specifically all drawings, specifications, and modified derivatives of any blueprints, e-files, drawings, or specifications remain the Designers without prejudice. VISUAL CONTACT with any of these drawings, or their purchase constitutes prima facie evidence of the acceptance of these restrictions! This has held precedent in the North Florida Court system! Any and all violations WILL result in legal action being taken and litigated damages to the full extent allowed by law! No exceptions and no excuses! Contractor &/or owner shall verify all dimensions, details, & specifications prior to construction. Every attempt shall be made to avoid errors and omissions and the Designer shall not be liable for copyright infringement or other errors after delivery via email of drawings including after construction has begun. This copyright law is only valid on building designs created on or after December 1, 1990.

DATE:  
6/21/2017  
SCALE:  
3/16" = 1'-0"  
SHEET:  
**A-9**

Design Drawings  
provided by:  
**DESIGNS FOR LIVING, LLC**  
RESIDENTIAL DESIGN SINCE 1998  
904-730-7135

PROJECT DESCRIPTION:  
**RENOVATIONS FOR THE DAVIS FAMILY**  
5438 TIERRA VERDE LANE  
JACKSONVILLE, FLORIDA 32228-2281  
R/E #: 157149-0100

BUILT BY: CBC1251050 CELL: 904-237-3433  
**Bracey**  
BUILDING CONTRACTORS

CLIENT APPROVAL SIGNATURE DATE  
JAMES W. DAVIS  
LINDA M. DAVIS

PLAN #  
4119




REAR (SOUTH) ELEVATION

EXTERIOR NOTES:  
EXTERIOR: HARDY-LAP SIDING AND HARDY TRIMS PAINTED  
SOFFITS: SMOOTH PLYWOOD TO MATCH EXISTING  
FASCIA: 2X6 WITH 1X2 P.T. DRIP - MATCH EXISTING  
ROOFING: SCREW DOWN METAL 5V CRIMP ROOF TO MATCH EXISTING  
PORCH CEILING: T-111 W/BATTENS  
FOUNDATION: MONOLITHIC SLAB & FOOTERS  
COLUMNS: 10" COMPOSITE IN CASITA AND ENTRY  
WALKS, DRIVES & PATIO: 2,500 PSI CONCRETE

CONTRACT NOTE: CONTRACT AND SPECIFICATIONS TAKE PRECEDENCE OVER THESE DRAWINGS. ANY CONFLICT WILL DEFAULT TO SAID DOCUMENTS.

THE COLUMNS, RAILING, SHUTTERS, EXISTING WINDOW REPLACEMENT AND DORMER WORK ARE NOT PART OF THIS CONTRACT WORK & IS OPTIONAL

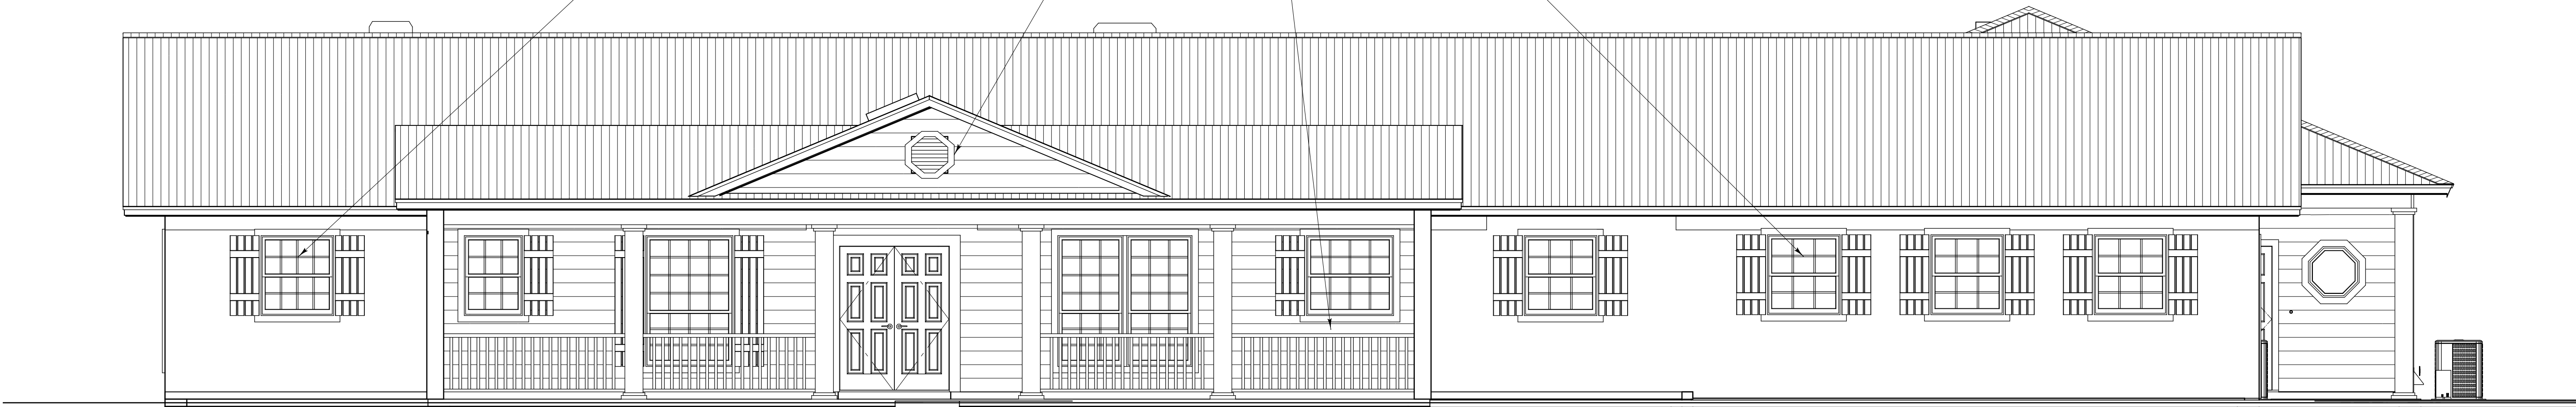

FRONT (NORTH) ELEVATION

PROPOSED FRONT/REAR ELEVATIONS

COPYRIGHT 2017: DESIGNS FOR LIVING, LLC. -Under section 102 of the Architectural Works Copyright Protection Act (title 17 of the United States Code) specific tact copyright laws apply to original design of a building created in any tangible medium of expression, including a constructed building or architectural plans, models, or drawings and is subject to copyright protection as an "architectural work" by Designs for Living, LLC. herein referred to as Designer. It is unlawful for anyone to copy these drawings, either in whole or in part, without the express written permission of the Designer. The use of any plans, specifications, electronic or hard copy prints shall be restricted to the original site for which they were prepared and publication thereof is expressly limited to such use. Title to all works, specifically all drawings, specifications, and modified derivatives of any blueprints, e-files, drawings, or specifications remain the Designer's without prejudice. VISUAL CONTACT with any of these drawings, or their purchase constitutes prima facie evidence of the acceptance of these restrictions! This has held precedent in the North Florida Court system! Any and all violations WILL result in legal action being taken to the full extent allowed by law! No exceptions and no excuses! Contractor &/or owner shall verify all dimensions, details, & specifications prior to construction. Every attempt has been made to avoid mistakes. In the event of any mistakes, the Designer shall not be held responsible for any errors or omissions. This copyright law is only valid on building designs created on or after December 1, 1990. Other errors after delivery via email or drawings including after construction has begun. This copyright law is only valid on building designs created on or after December 1, 1990.

PLAN #  
4119


CLIENT APPROVAL SIGNATURE

DATE

JAMES W. DAVIS

LINDA M. DAVIS


BUILT BY: CBC1251050 CELL: 904-237-3433

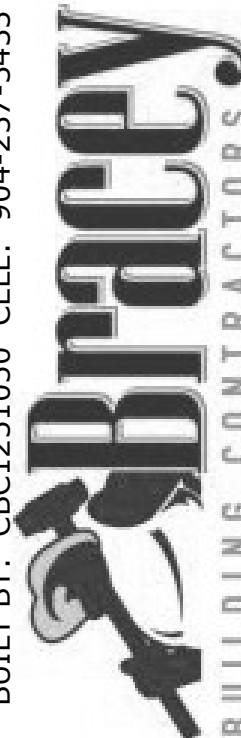  
BUILDING CONTRACTORS

PROJECT DESCRIPTION:

RENOVATIONS FOR THE DAVIS FAMILY  
5438 TIERRA VERDE LANE  
JACKSONVILLE, FLORIDA 32228-2281  
R/E #: 157149-0100

Design Drawings  
provided by:

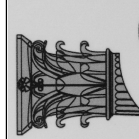  
DESIGNS FOR LIVING, LLC  
RESIDENTIAL DESIGN SINCE 1999  
904-730-7135

DATE:

6/21/2017

SCALE:

1/4" = 1'-0"

SHEET:


A-10



RIGHT (WEST) ELEVATION

CONTRACT NOTE: CONTRACT AND SPECIFICATIONS TAKE PRECEDENCE OVER THESE DRAWINGS. ANY CONFLICT WILL DEFAULT TO SAID DOCUMENTS.

EXTERIOR NOTES:  
EXTERIOR: HARDY-LAP SIDING AND HARDY TRIMS PAINTED  
SOFFITS: SMOOTH PLYWOOD TO MATCH EXISTING  
FASCIA: 2X6 WITH 1X2 P.T. DRIP - MATCH EXISTING  
ROOFING: SCREW DOWN METAL 5V CRIMP ROOF TO MATCH EXISTING  
PORCH CEILING: T-111 W/BATTENS  
FOUNDATION: MONOLITHIC SLAB & FOOTERS  
COLUMNS: 10" COMPOSITE IN CASITA AND ENTRY  
WALKS, DRIVES & PATIO: 2,500 PSI CONCRETE

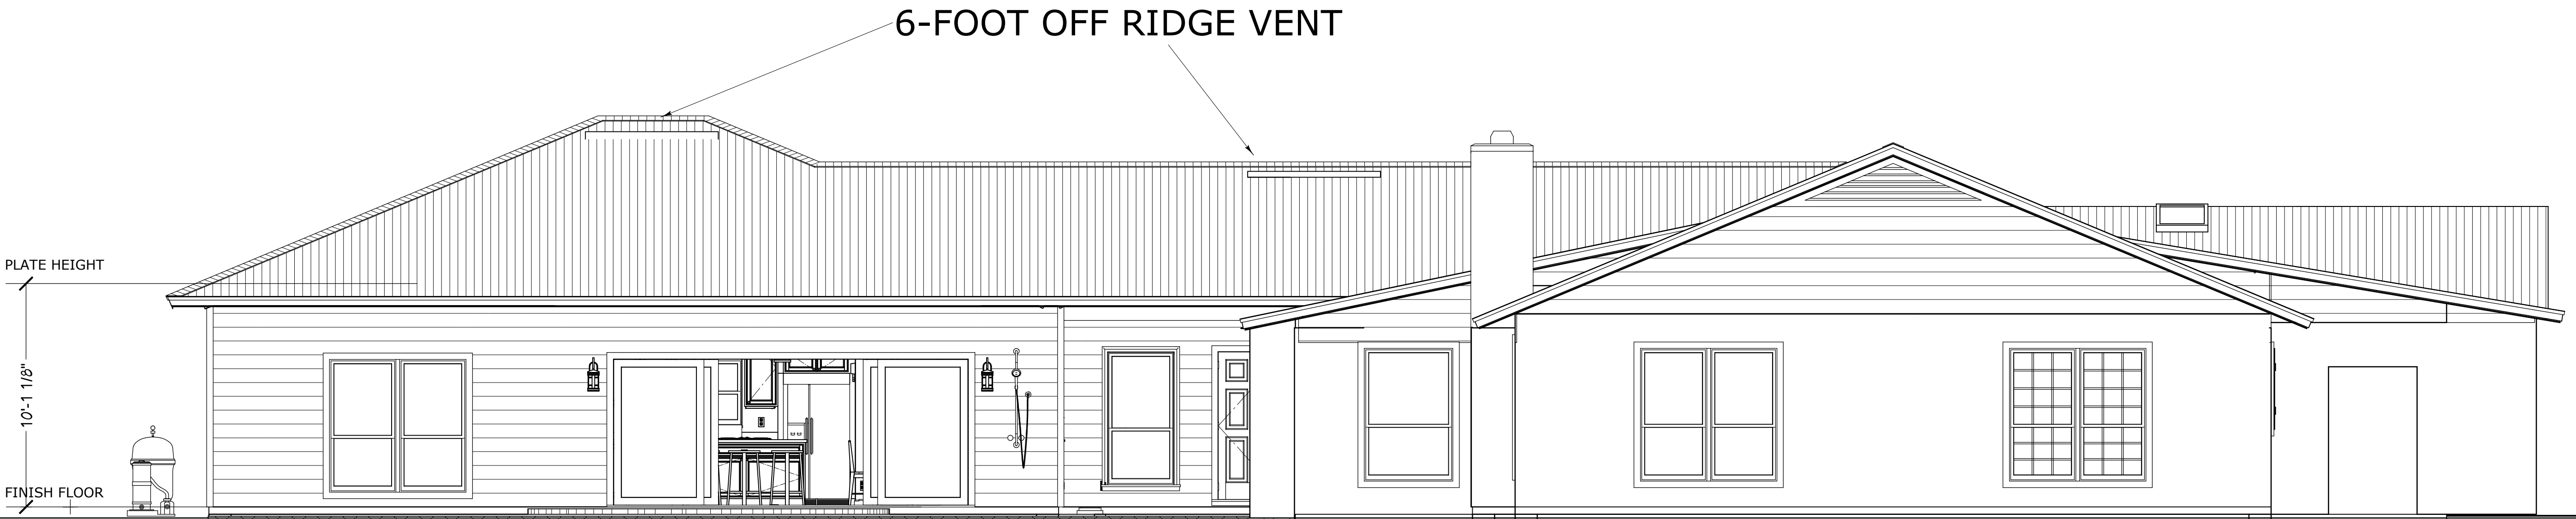

LEFT (EAST) ELEVATION

PROPOSED SIDE ELEVATIONS

COPYRIGHT 2017: DESIGNS FOR LIVING, LLC. -Under section 102 of the Architectural Works Copyright Protection Act (title 17 of the United States Code) specific tact copyright laws apply to original design of a building created in any tangible medium of expression, including a constructed building or architectural plans, models, or drawings and is subject to copyright protection as an "architectural work" by Designs for Living, LLC. herein referred to as Designer. It is unlawful for anyone to copy these drawings, either in whole or in part, without the express written permission of the Designer. The use of any plans, specifications, electronic or hard copy prints shall be restricted to the original site for which they were prepared and publication thereof is expressly limited to such use. Title to all works, specifically all drawings, specifications, and modified derivatives of any blueprints, e-files, drawings, or specifications remain the Designers without prejudice. VISUAL CONTACT with any of these drawings, or their purchase constitutes prima facie evidence of the acceptance of these restrictions! This has held precedent in the North Florida Court system! Any and all violations WILL result in legal action being taken and litigated damages to the full extent allowed by law! No exceptions and no excuses! Contractor &/or owner shall verify all dimensions, details, & specifications prior to construction. Every attempt has been made to avoid mistakes. The Designer does not warrant the accuracy of the drawings and is not responsible for any errors or omissions. The Designer shall not be liable for copyright infringement or other errors after delivery via email or drawings including after construction has begun. This copyright law is only valid on building designs created on or after December 1, 1990.

PLAN #  
4119

CLIENT APPROVAL SIGNATURE

DATE

JAMES W. DAVIS

LINDA M. DAVIS

BUILT BY: CBC1251050

CELL: 904-237-3433



PROJECT DESCRIPTION:

RENOVATIONS FOR THE DAVIS FAMILY

5438 TIERRA VERDE LANE

JACKSONVILLE, FLORIDA 32228-2281

R/E #: 157149-0100

Design Drawings  
provided by:



DESIGNS FOR LIVING, LLC

RESIDENTIAL DESIGN SINCE 1999

904-730-7135

DATE:


6/21/2017

SCALE:

1/4" = 1'-0"

SHEET:


A-11

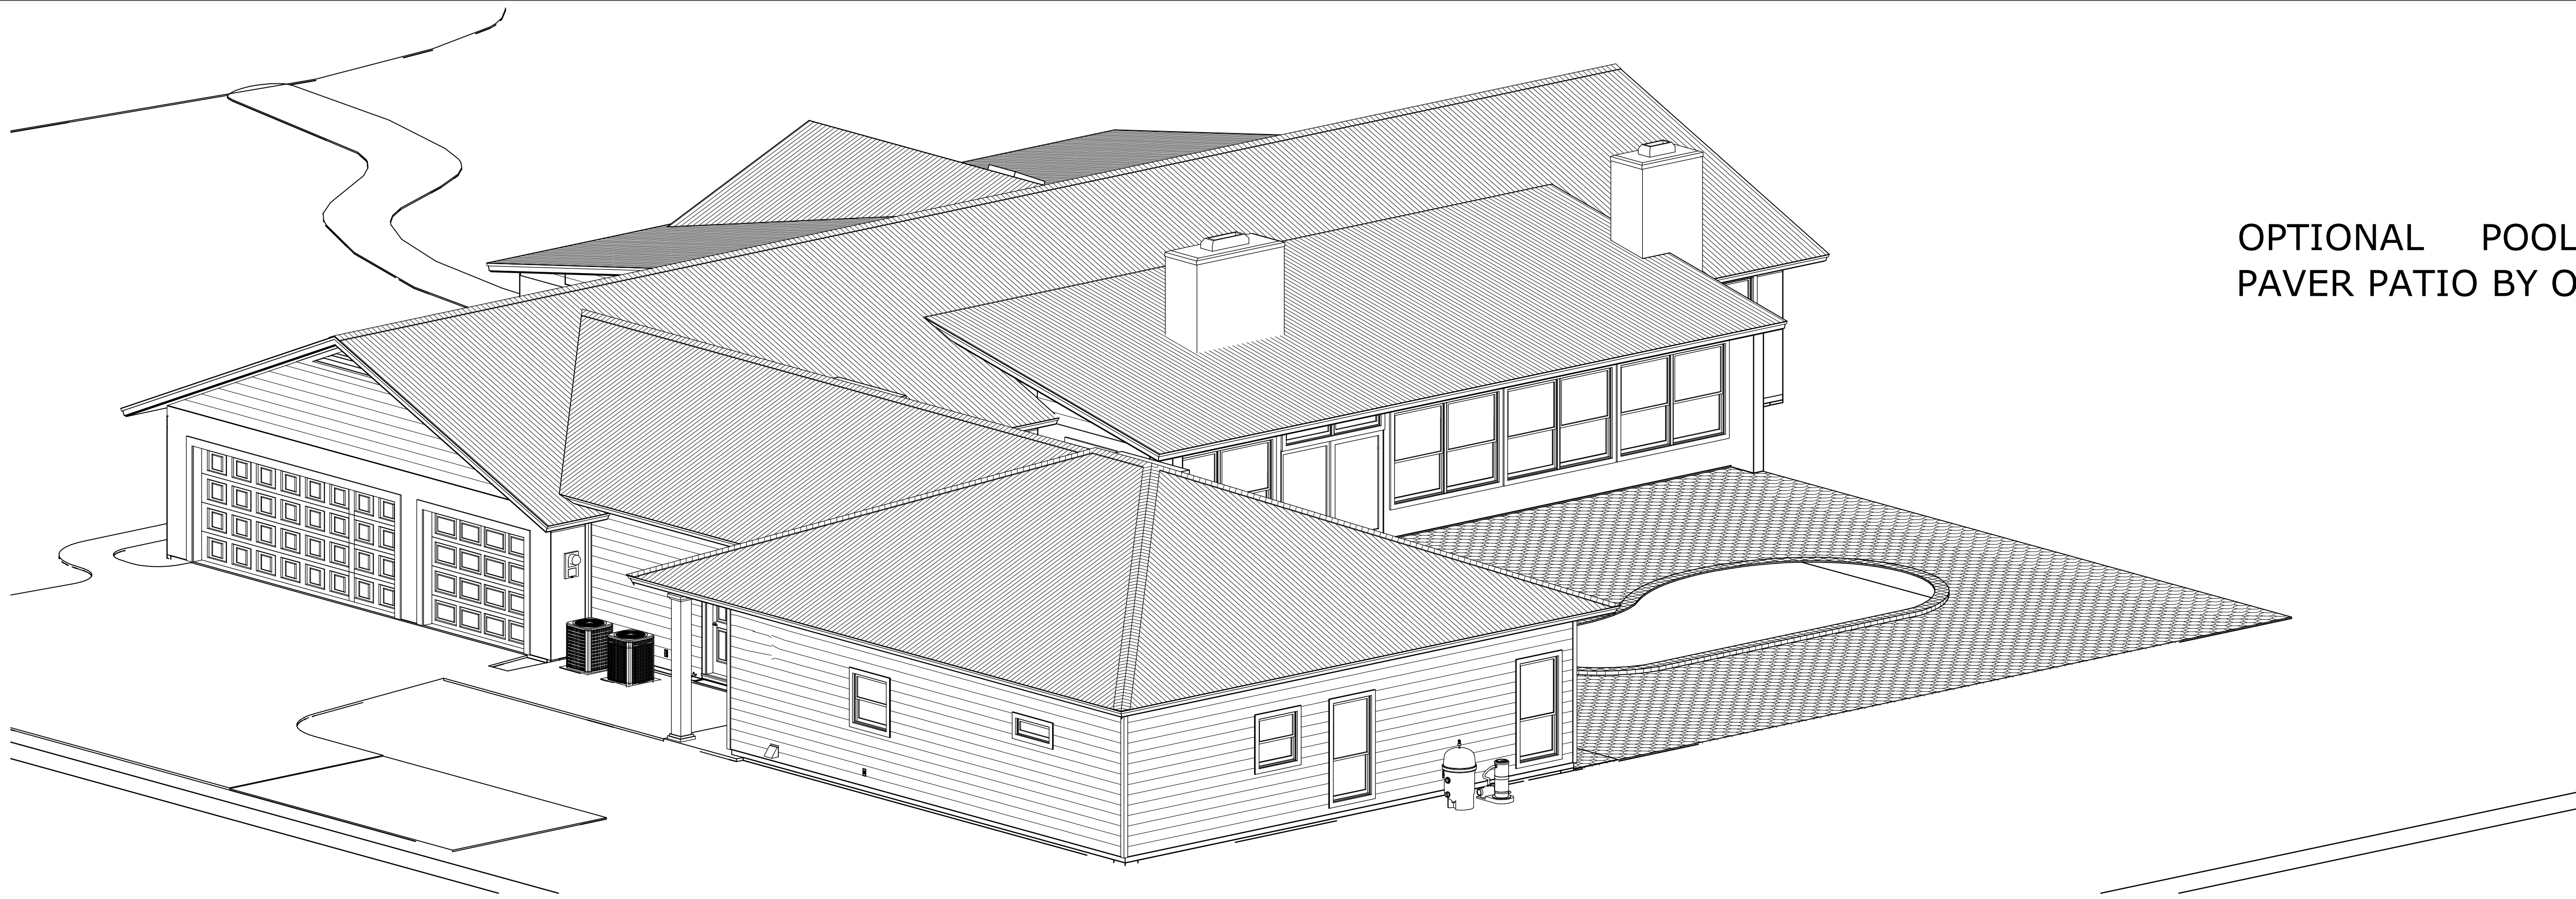

OPTIONAL POOL AND  
PAVER PATIO BY OTHERS

CONTRACT NOTE: CONTRACT AND  
SPECIFICATIONS TAKE PRECEDENCE  
OVER THESE DRAWINGS. ANY CONFLICT  
WILL DEFAULT TO SAID DOCUMENTS.

EXTERIOR NOTES:  
EXTERIOR: HARDY-LAP SIDING AND HARDY TRIMS PAINTED  
SOFFITS: SMOOTH PLYWOOD TO MATCH EXISTING  
FASCIA: 2X6 WITH 1X2 P.T. DRIP - MATCH EXISTING  
ROOFING: SCREW DOWN METAL 5V CRIMP ROOF TO MATCH EXISTING  
PORCH CEILING: T-111 W/BATTENS  
FOUNDATION: MONOLITHIC SLAB & FOOTERS  
COLUMNS: 10" COMPOSITE IN CASITA AND ENTRY  
WALKS, DRIVES & PATIO: 2,500 PSI CONCRETE

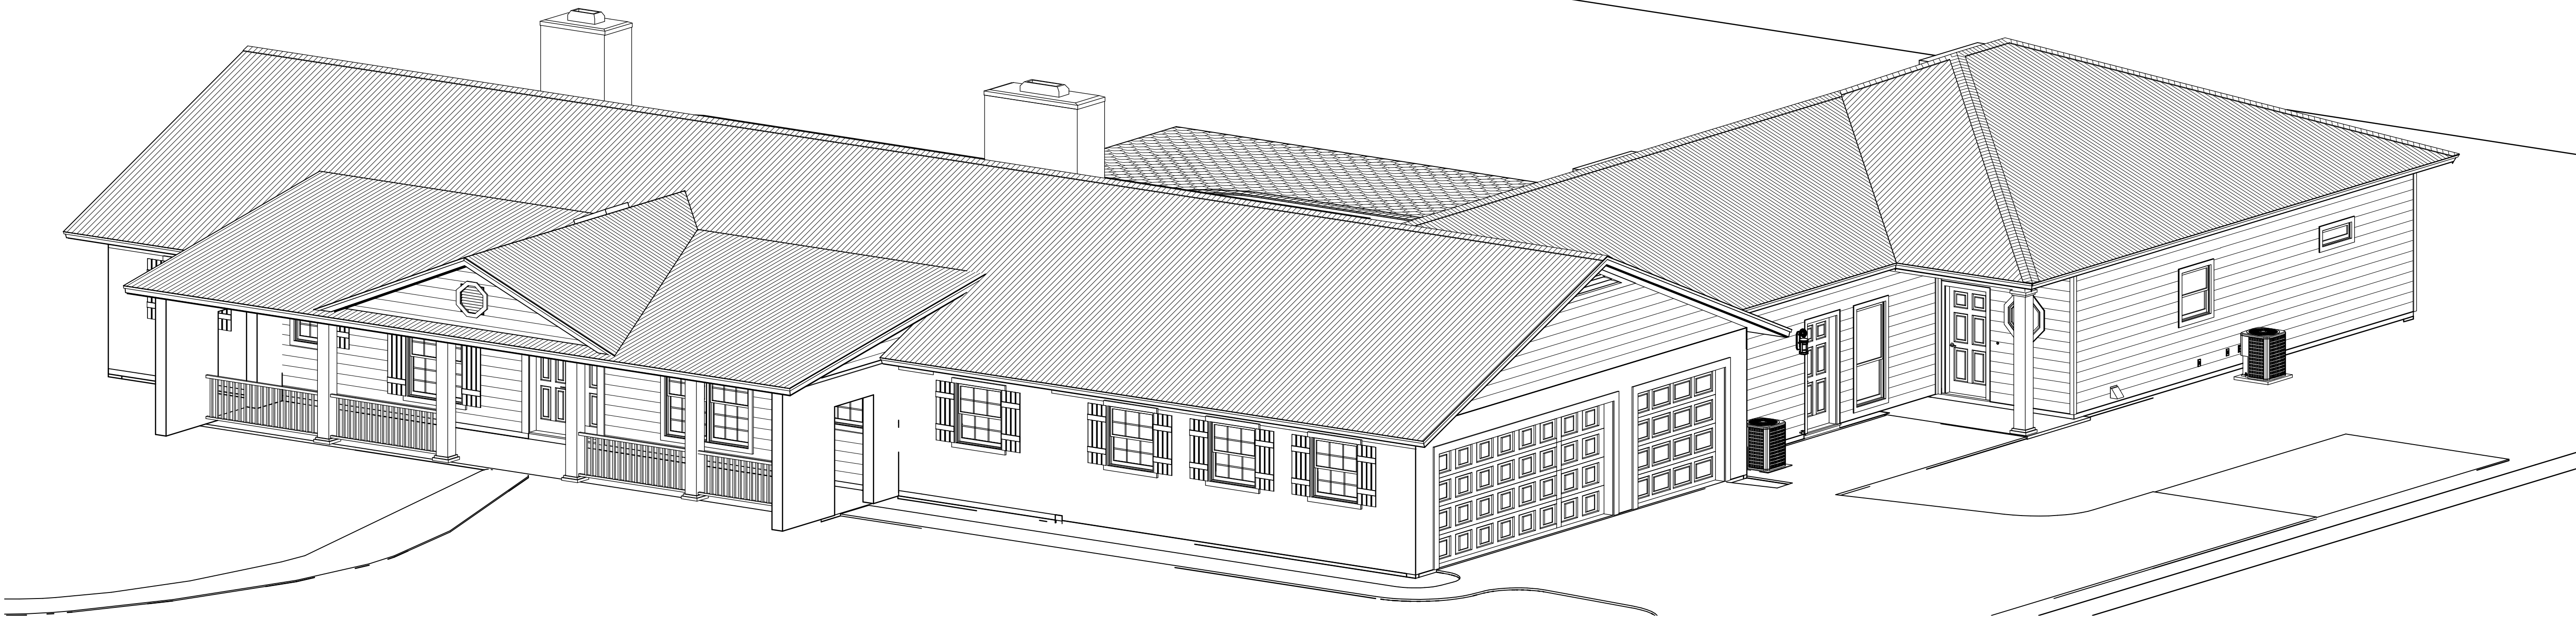

THE COLUMNS, RAILING, SHUTTERS, EXISTING WINDOW REPLACEMENT  
AND DORMER WORK ARE NOT PART OF THIS CONTRACT WORK

PROPOSED ISOMETRICS

COPYRIGHT 2017: DESIGNS FOR LIVING, LLC. -Under section 102 of the Architectural Works Copyright Protection Act (title 17 of the United States Code) specific tacit copyright laws apply to original design of a building created in any tangible medium of expression, including a constructed building or architectural plans, models, or drawings and is subject to copyright protection as an "architectural work" by Designs for Living, LLC. herein referred to as Designer. It is unlawful for anyone to copy these drawings, either in whole or in part, without the express written permission of the Designer. The use of any plans, specifications, electronic or hard copy prints shall be restricted to the original site for which they were prepared and publication thereof is expressly limited to such use. Title to all works, specifically all drawings, specifications, and modified derivatives of any blueprints, e-files, drawings, or specifications remain the Designers without prejudice. VISUAL CONTACT with any of these drawings, or their purchase constitutes prima facie evidence of the acceptance of these restrictions! This has held precedent in the North Florida Court system! Any and all violations WILL result in legal action being taken and litigated damages to the full extent allowed by law! No exceptions and no excuses! Contractor &/or owner shall verify all dimensions, details, & specifications prior to construction. Every attempt shall be made to avoid mistakes. The Designer and/or owner are not responsible for any errors or omissions in the drawings, including after delivery via email of drawings. This copyright law is only valid on building designs created on or after December 1, 1990.

PLAN #  
4119

CLIENT APPROVAL SIGNATURE

DATE

JAMES W. DAVIS

LINDA M. DAVIS

BUILT BY: CBC1251050 CELL: 904-237-3433

  
BUILDING CONTRACTORS

PROJECT DESCRIPTION:

RENOVATIONS FOR THE DAVIS FAMILY  
5438 TIERRA VERDE LANE  
JACKSONVILLE, FLORIDA 32228-2281  
R/E #: 157149-0100

Design Drawings  
provided by:

  
DESIGNS FOR LIVING, LLC  
RESIDENTIAL DESIGNER SINCE 1998  
904-730-7135

DATE:

6/21/2017

SCALE:

N.T.S.


SHEET:

A-12

PER FBC-R-E3902.12 AFCI PROTECTION REQUIRED Arc-fault circuit-interrupter protection. All branch circuits that supply 120-volt, single-phase, 15- and 20-ampere outlets installed in family rooms, dining rooms, living rooms, parlors, libraries, dens, bedrooms, sunrooms, recreation rooms, closets, hallways, or similar rooms or areas shall be protected by a listed AFCI, combination type.

PER FBC-R-E3901.7, NEC 210, E3901.7 & E3902.3 GFCI PROTECTION REQUIRED Bathrooms, garages, boathouses & accessory structures not intended as habitable rooms and limited to storage, work & similar uses. Outdoors, crawl spaces, unfinished basements, kitchen countertops. Outlets within 6 feet of laundry, utility or wet sinks. Balcony, deck or porch greater than 20 s.f. One at the front and back of the dwelling and at the condenser units.

PROVIDE POWER FOR GRINDER PUMP

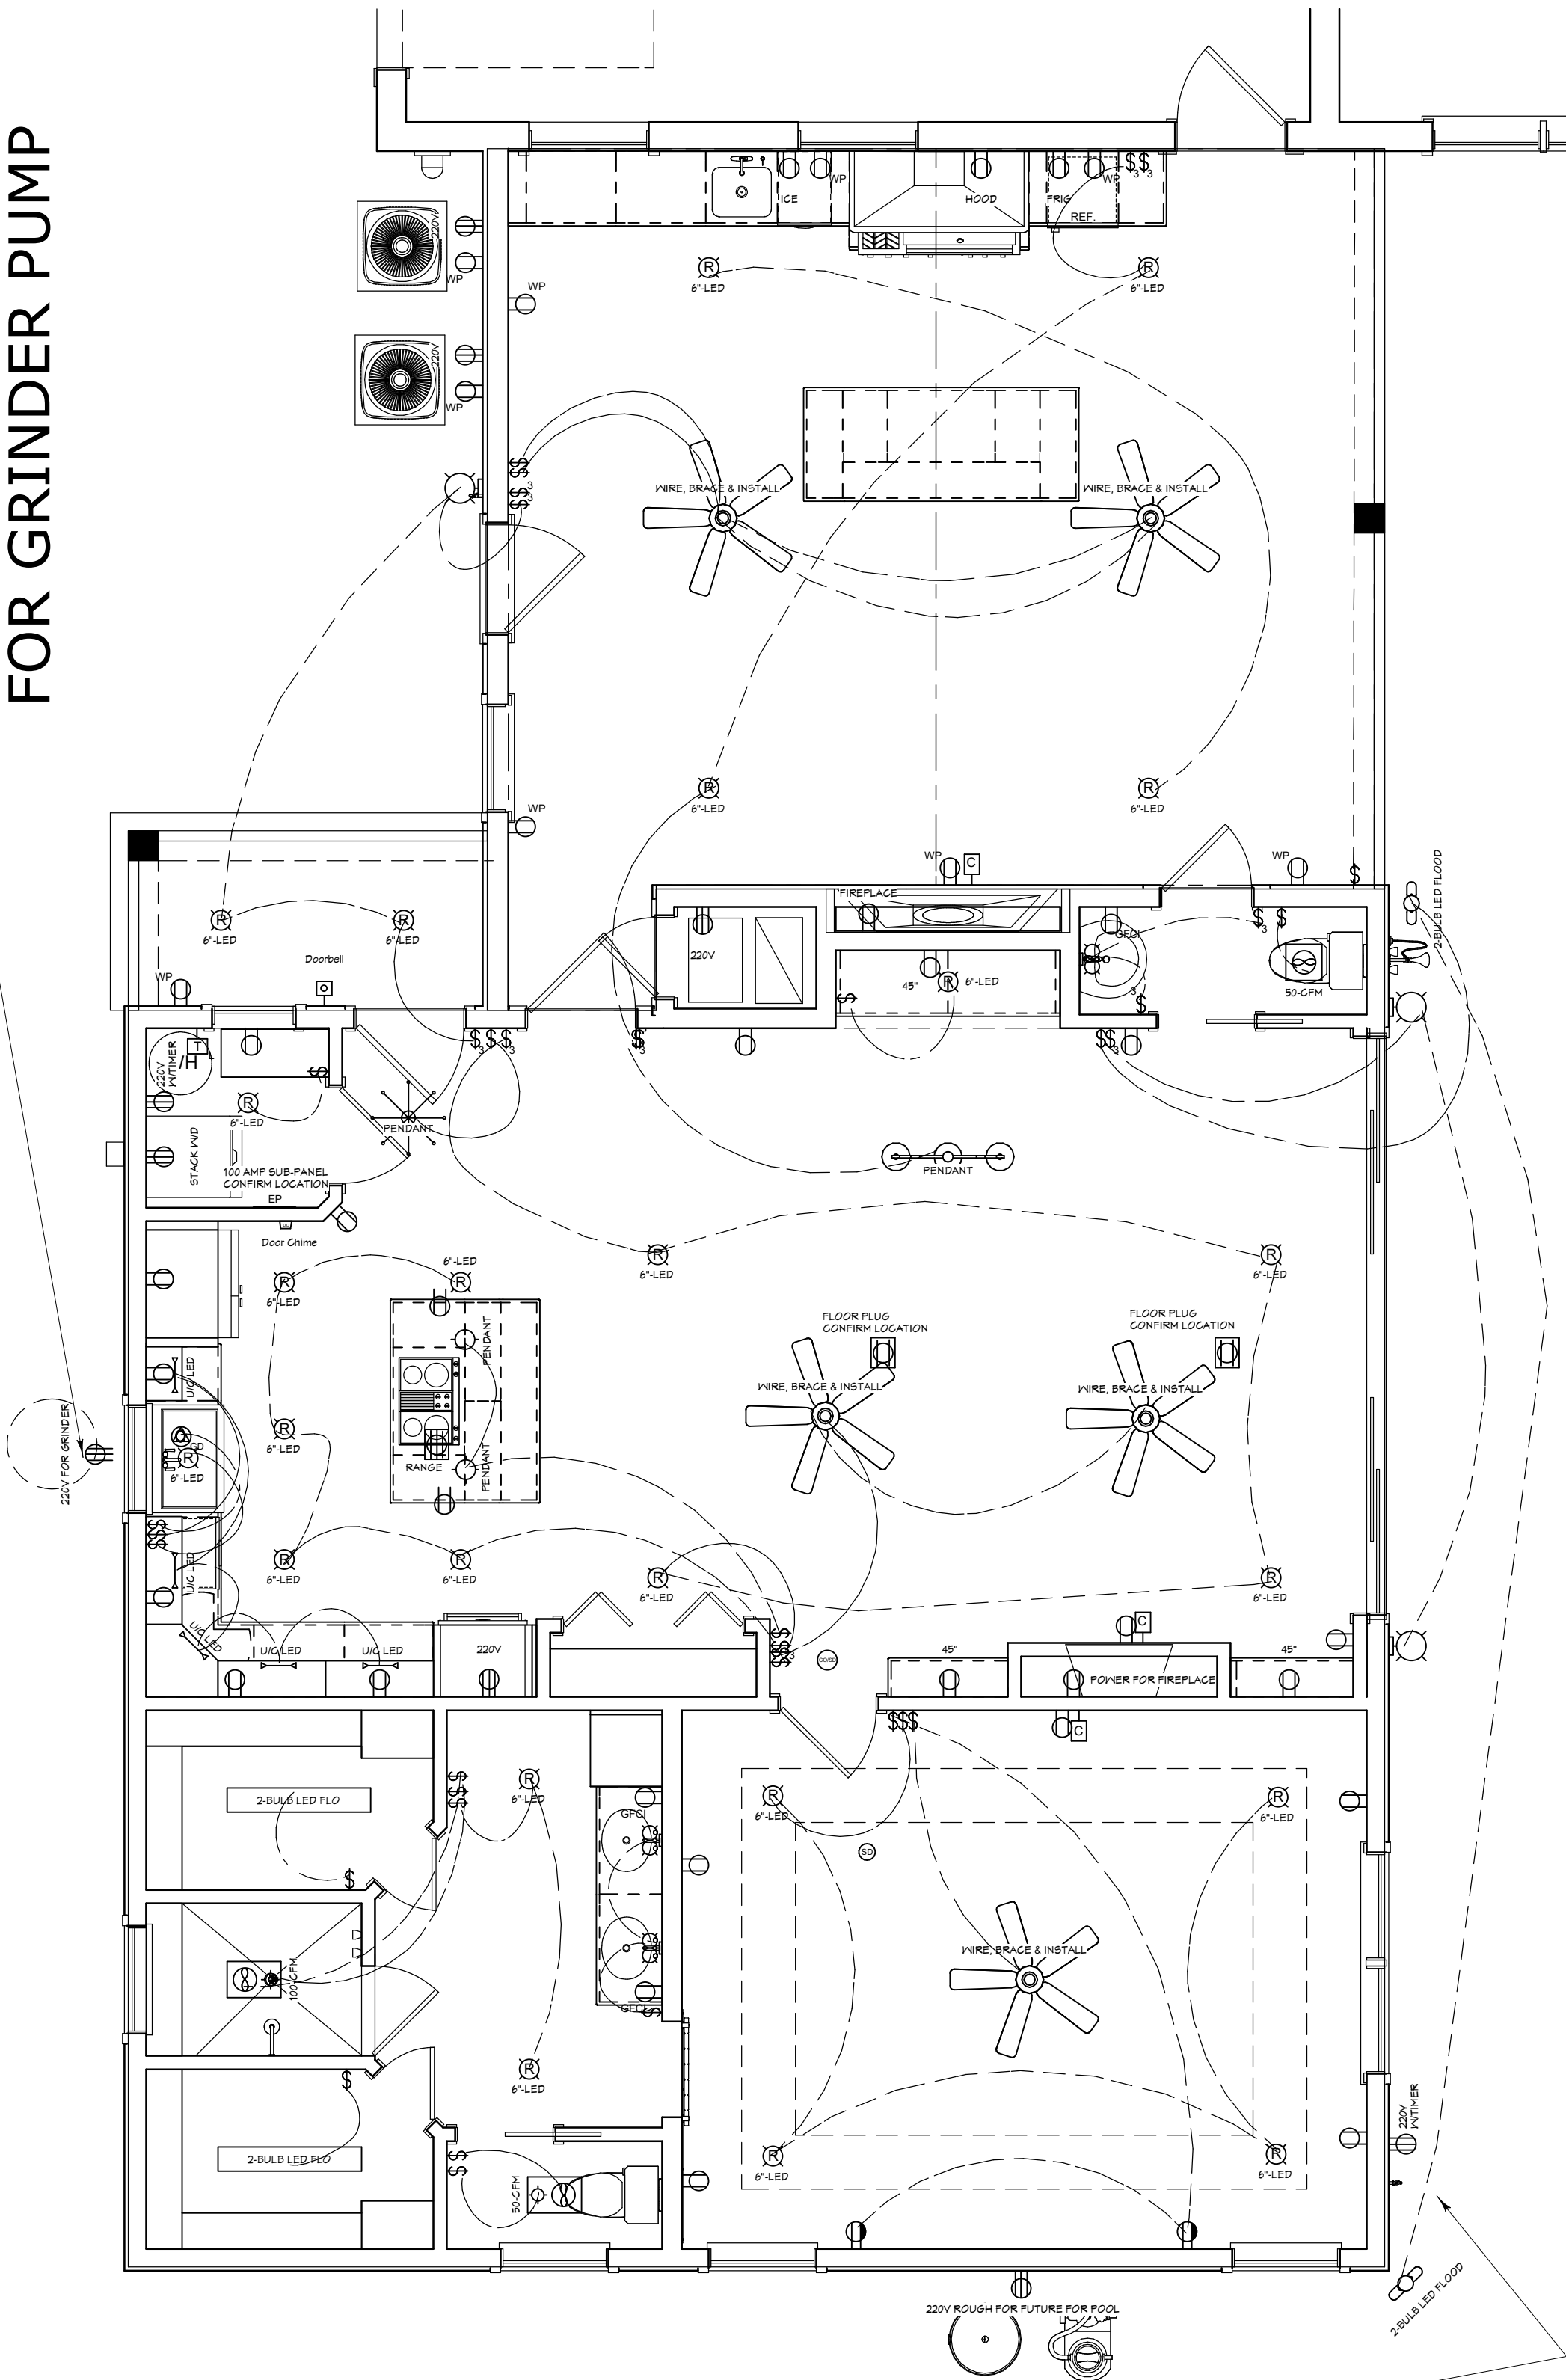


WIRE FOR FUTURE POOL EQUIPMENT

CONTRACT NOTE: CONTRACT AND SPECIFICATIONS TAKE PRECEDENCE OVER THESE DRAWINGS. ANY CONFLICT WILL DEFAULT TO SAID DOCUMENTS.

- GENERAL ELECTRICAL NOTES:
- 1. THE EXISTING SERVICE IS NOT BEING UPGRADED
  - 2. PROVIDE 220 VAC FOR NEW SPETIC SYTEM ON THE FRONT OF THE HOME-CONFIRM LOCATION
  - 3. INSTALL APPROPRIATE SIZE SUB-PANEL IN THE NEW OWNERS SUITE
  - 4. ELECTRICIAN TO PROVIDE ALL ROUGHS & TRIMS WITH FANS AND DECORATIVE LIGHTS TO BE PROVIDED BY OTHERS
  - 5. ALL LOW VOLTAGE BY OWNERS

EFFICACY NOTE: THE NEW FBC-R FBC EC R404.1 & R202 BUILDING CODE REQUIRES ALL INSIDE & OUTSIDE LIGHT FIXTURES WILL USE CFL OR LED LIGHT BULBS.

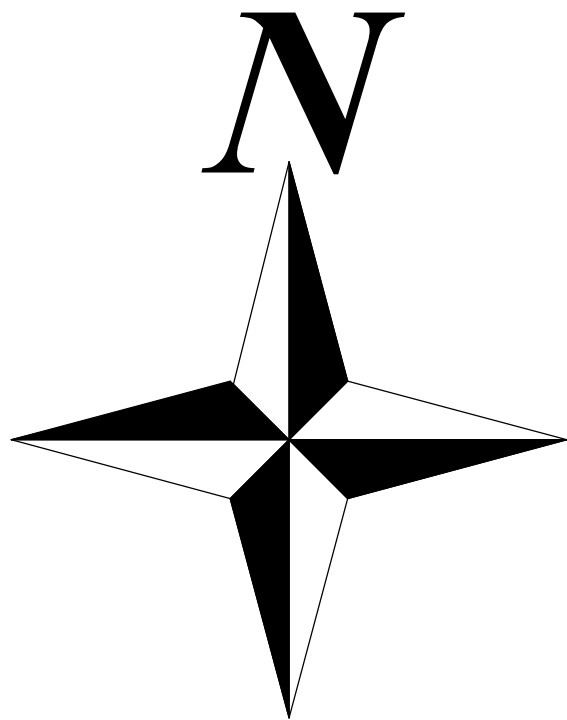

| ELECTRICAL - DATA - AUDIO LEGEND |   |
|----------------------------------|---|
| SYMBOL                           | DESCRIPTION   |
|                                  | Ceiling Fan   |
|                                  | Ventilation Fans: Ceiling Mounted, Wall Mounted                                   |
|                                  | Ceiling Mounted Light Fixtures: Surface/Pendant, Recessed, Heat Lamp, Low Voltage |
|                                  | Wall Mounted Light Fixtures: Flush Mounted, Wall Sconce                           |
|                                  | Chandelier Light Fixture  |
|                                  | Fluorescent Light Fixture   |
|                                  | 240V Receptacle   |
|                                  | 110V Receptacles: Duplex, Weather Proof, GFCI                                     |
|                                  | Switches: Single Pole, Weather Proof, 3-Way, 4-Way                                |
|                                  | Switches: Dimmer, Timer   |
|                                  | Audio Video: Control Panel, Switch  |
|                                  | Speakers: Ceiling Mounted, Wall Mounted   |
|                                  | Wall Jacks: CAT5, CAT5 + TV, TV/Cable   |
|                                  | Telephone Jack  |
|                                  | Intercom  |
|                                  | Thermostat  |
|                                  | Door Chime, Door Bell Button  |
|                                  | Smoke Detectors: Ceiling Mounted, Wall Mounted                                    |
|                                  | Electrical Breaker Panel  |

PROPOSED ELECTRICAL PLAN












COPYRIGHT 2017: DESIGNS FOR LIVING, LLC. -Under section 102 of the Architectural Works Copyright Protection Act (title 17 of the United States Code) specific tact copyright laws apply to original design of a building created in any tangible medium of expression, including a constructed building or architectural plans, models, or drawings and is subject to copyright protection as an "architectural work" by Designs for Living, LLC, herein referred to as Designer. It is unlawful for anyone to copy these drawings, either in whole or in part, without the express written permission of the Designer. The use of any plans, specifications, electronic or hard copy prints shall be restricted to the original site for which they were prepared and publication thereof is expressly limited to such use. Title to all works, specifically all drawings, specifications, and modified derivatives of any blueprints, e-files, drawings, or specifications remain the Designer's without prejudice. VISUAL CONTACT with any of these drawings, or their purchase constitutes prima facie evidence of the acceptance of these restrictions. This has held precedent in the North Florida Court system! Any and all violations WILL result in legal action being taken and litigated damages to the full extent allowed by law! No exceptions and no excuses! Contractor &/or owner shall verify all dimensions, details, & specifications prior to construction. Every attempt will be made to avoid errors and omissions, but the Designer does not assume any liability for errors or omissions. Copyright release approval and design for errors or omissions shall not be liable for copyright infringement or other errors after delivery via email or drawings including after construction has begun. This copyright law is only valid on building designs created on or after December 1, 1990.

PROJECT DESCRIPTION:  
RENOVATIONS FOR THE DAVIS FAMILY  
5438 TIERRA VERDE LANE  
JACKSONVILLE, FLORIDA 32228-2281  
R/E #: 157149-0100

Design Drawings provided by:  
DESIGNS FOR LIVING, LLC  
RESIDENTIAL DESIGNER SINCE 1999  
904-730-7135

DATE:  
6/21/2017  
SCALE:  
3/16" = 1'-0"  
SHEET:  
A-13

PLAN #  
4119  
CLIENT APPROVAL SIGNATURE DATE  
JAMES W. DAVIS  
LINDA M. DAVIS  
BUILT BY: CBC1251050 CELL: 904-237-3433  
Bracey BUILDING CONTRACTORS

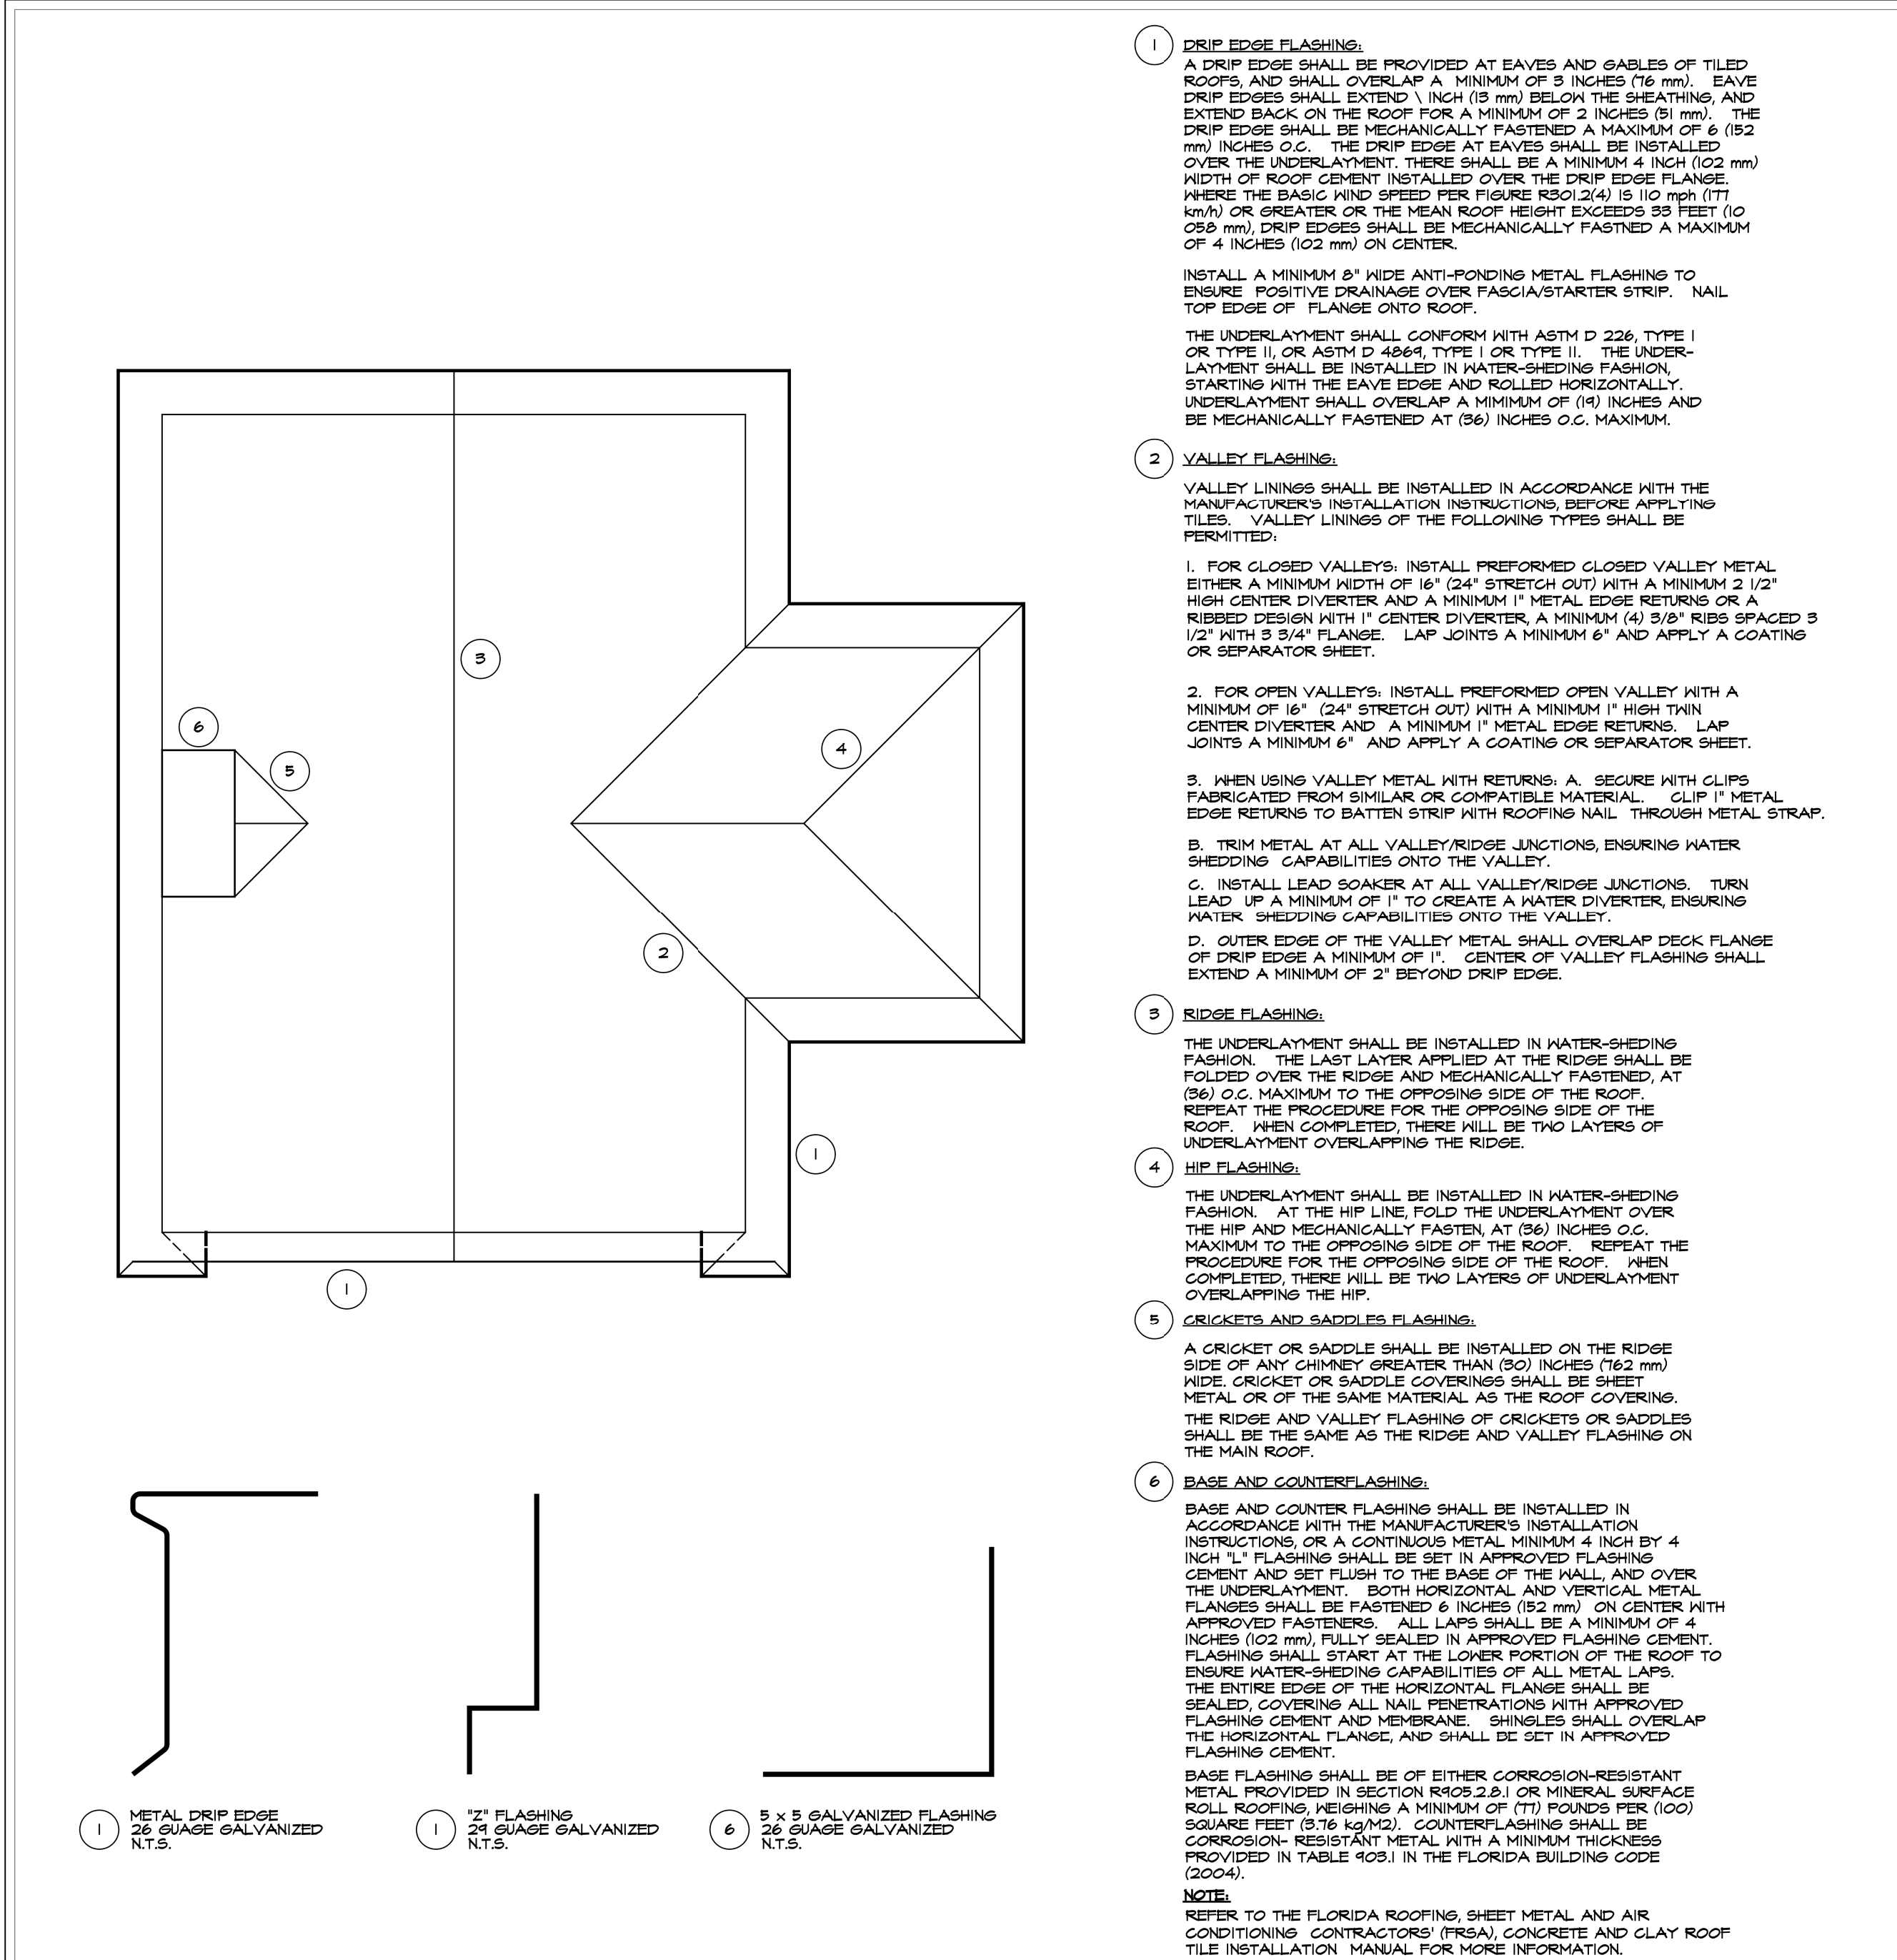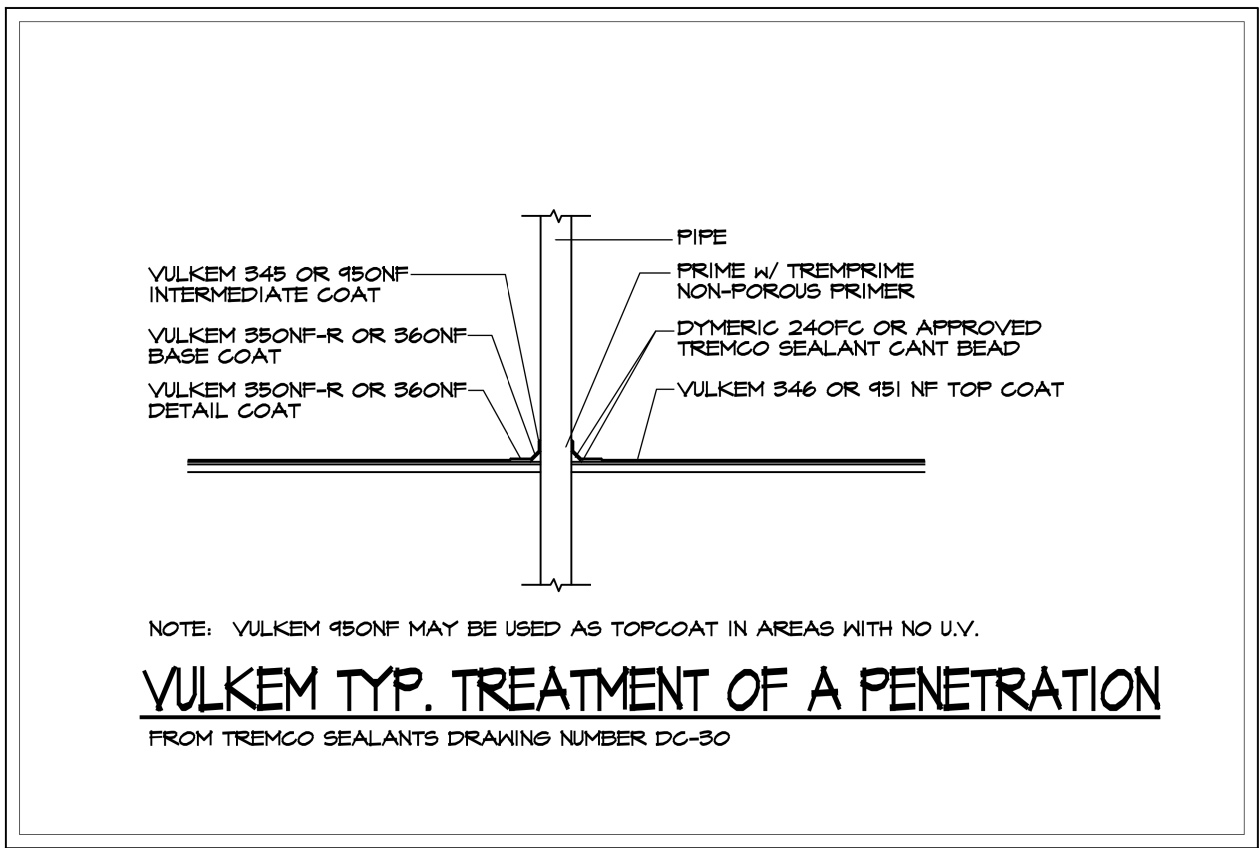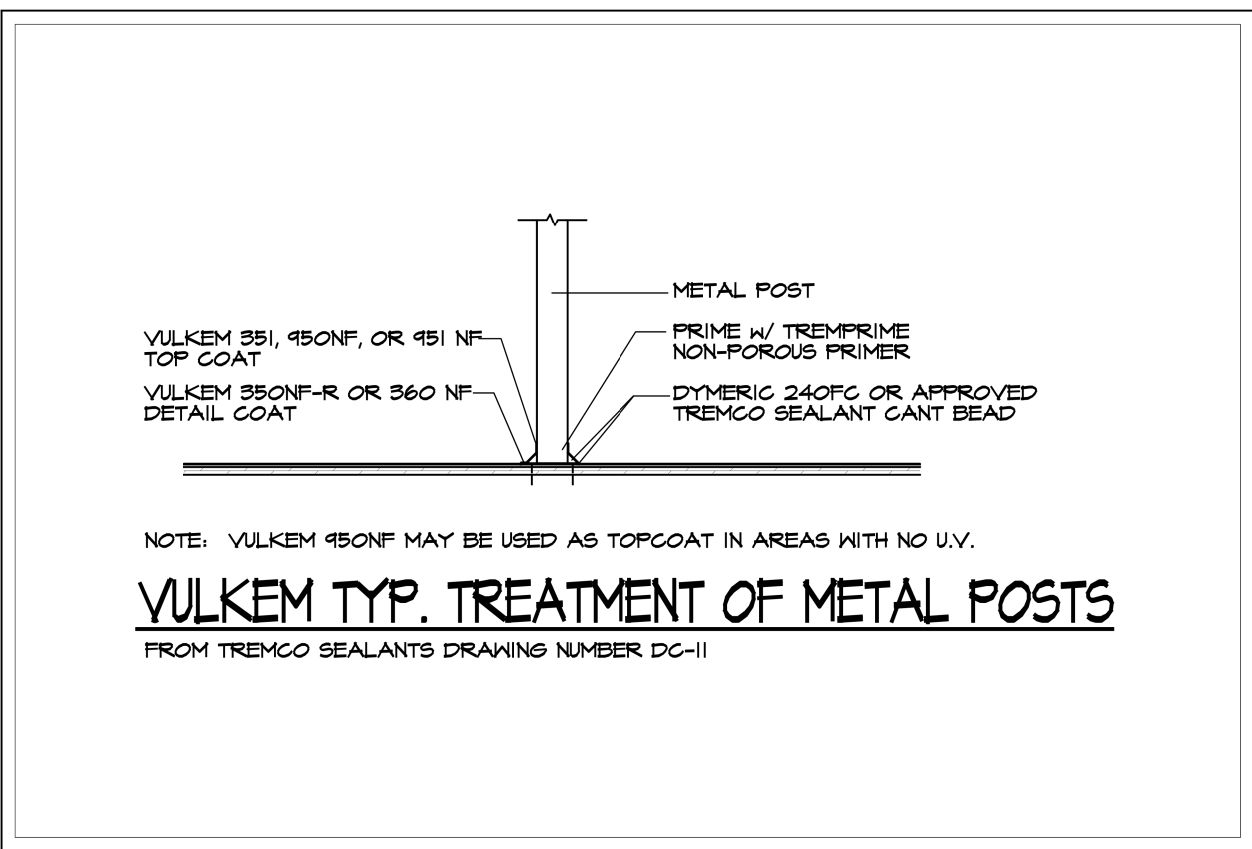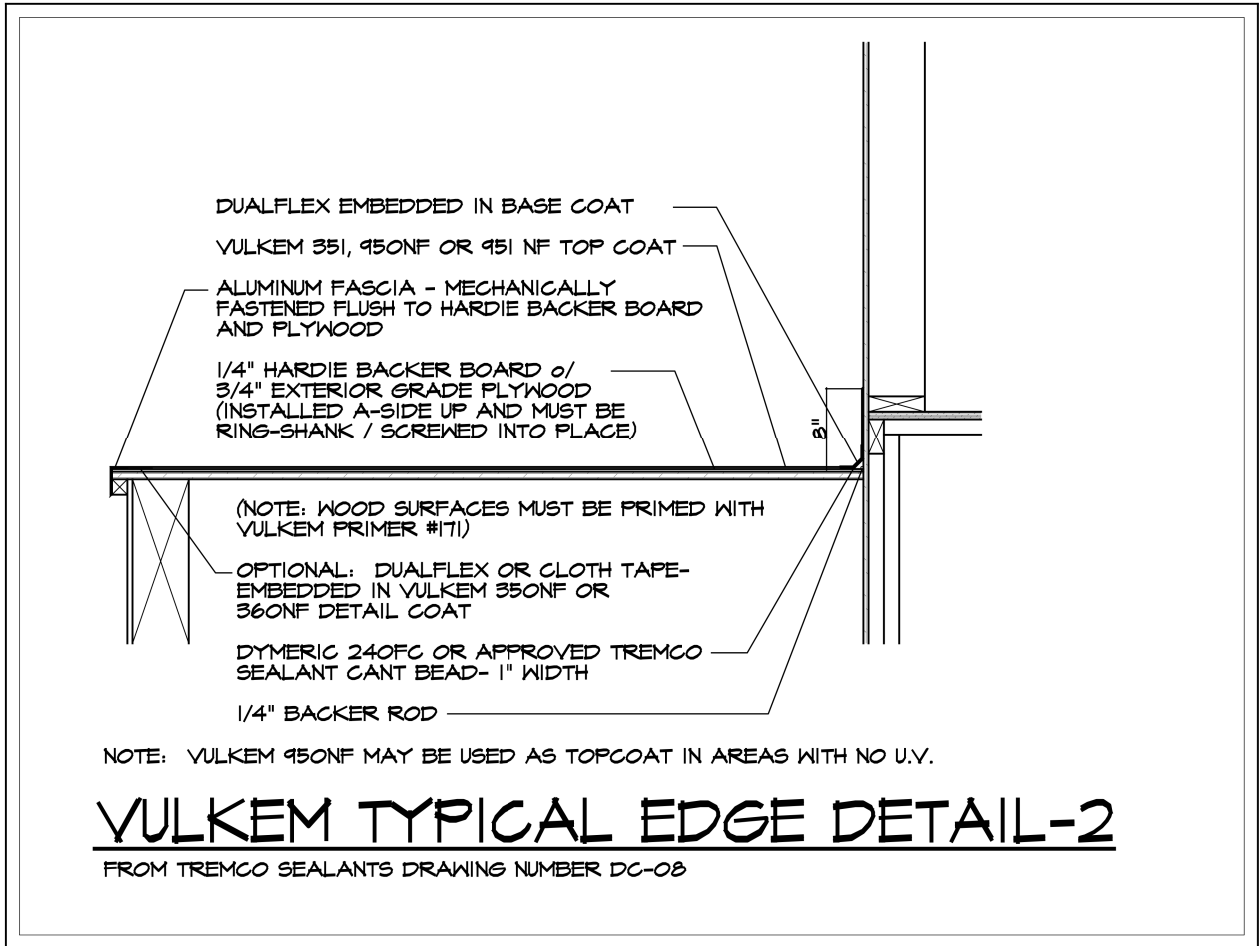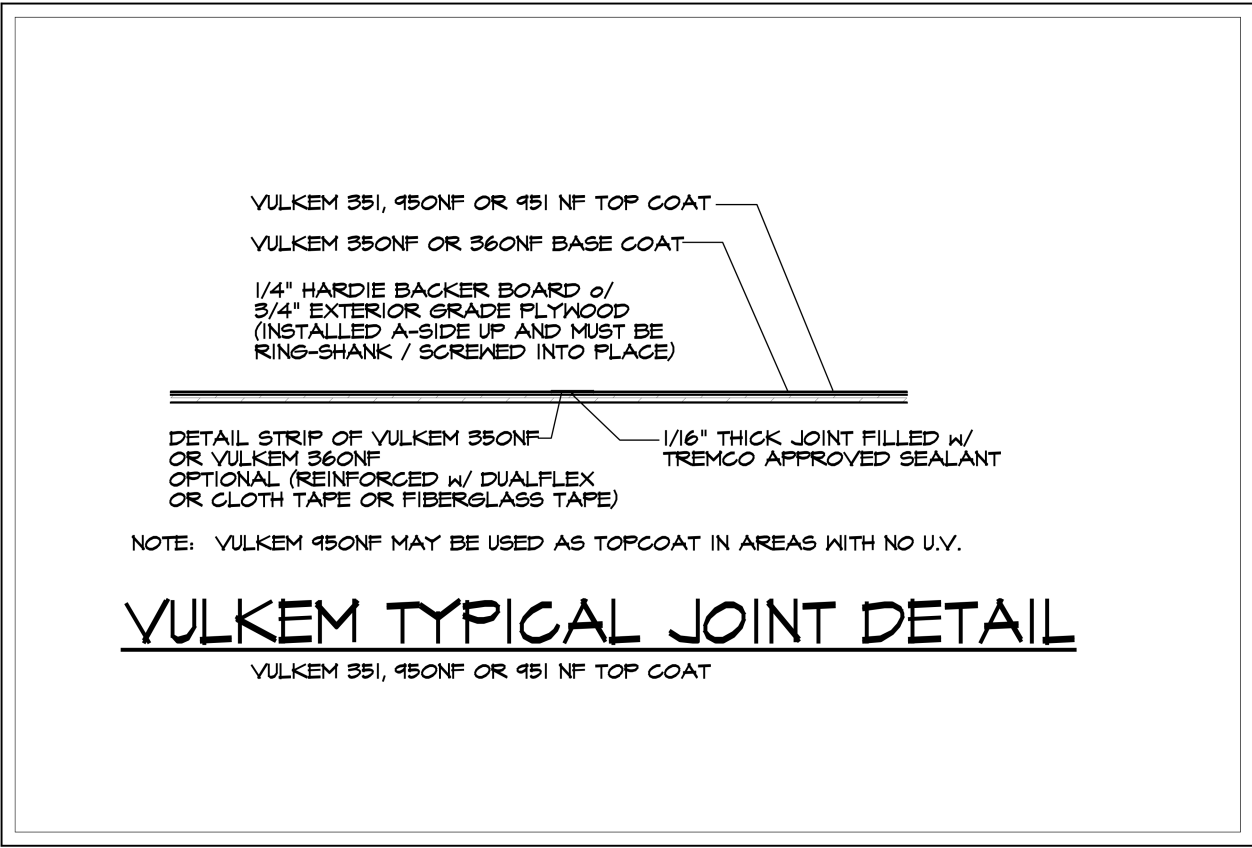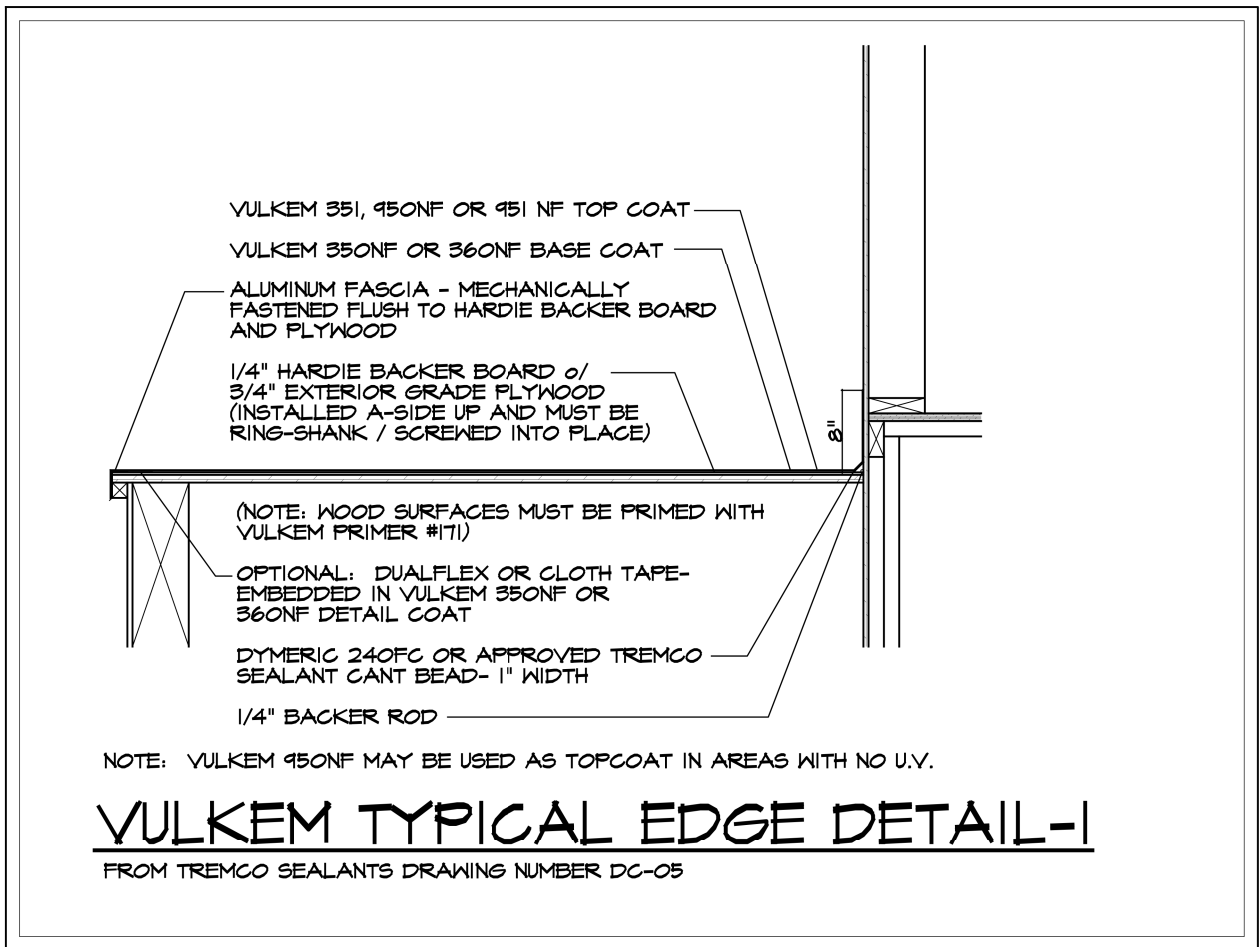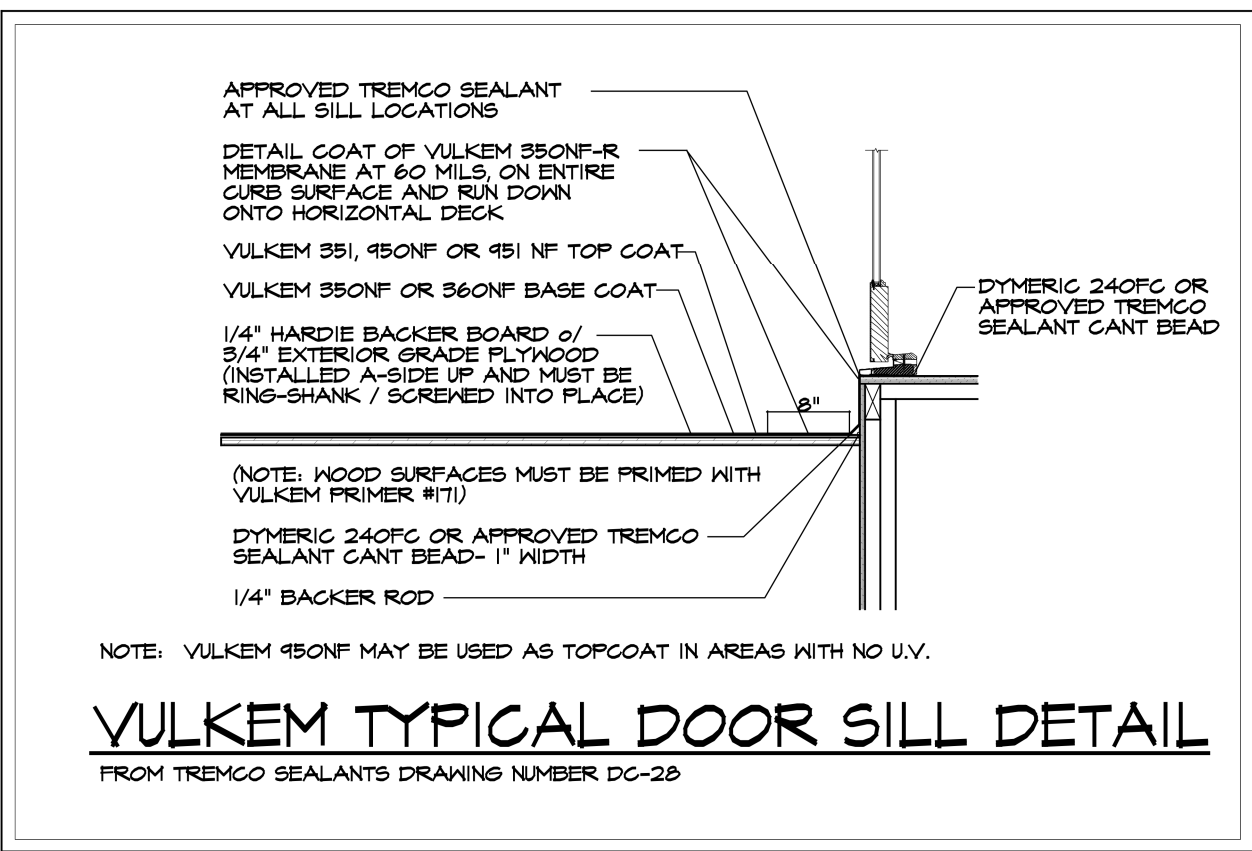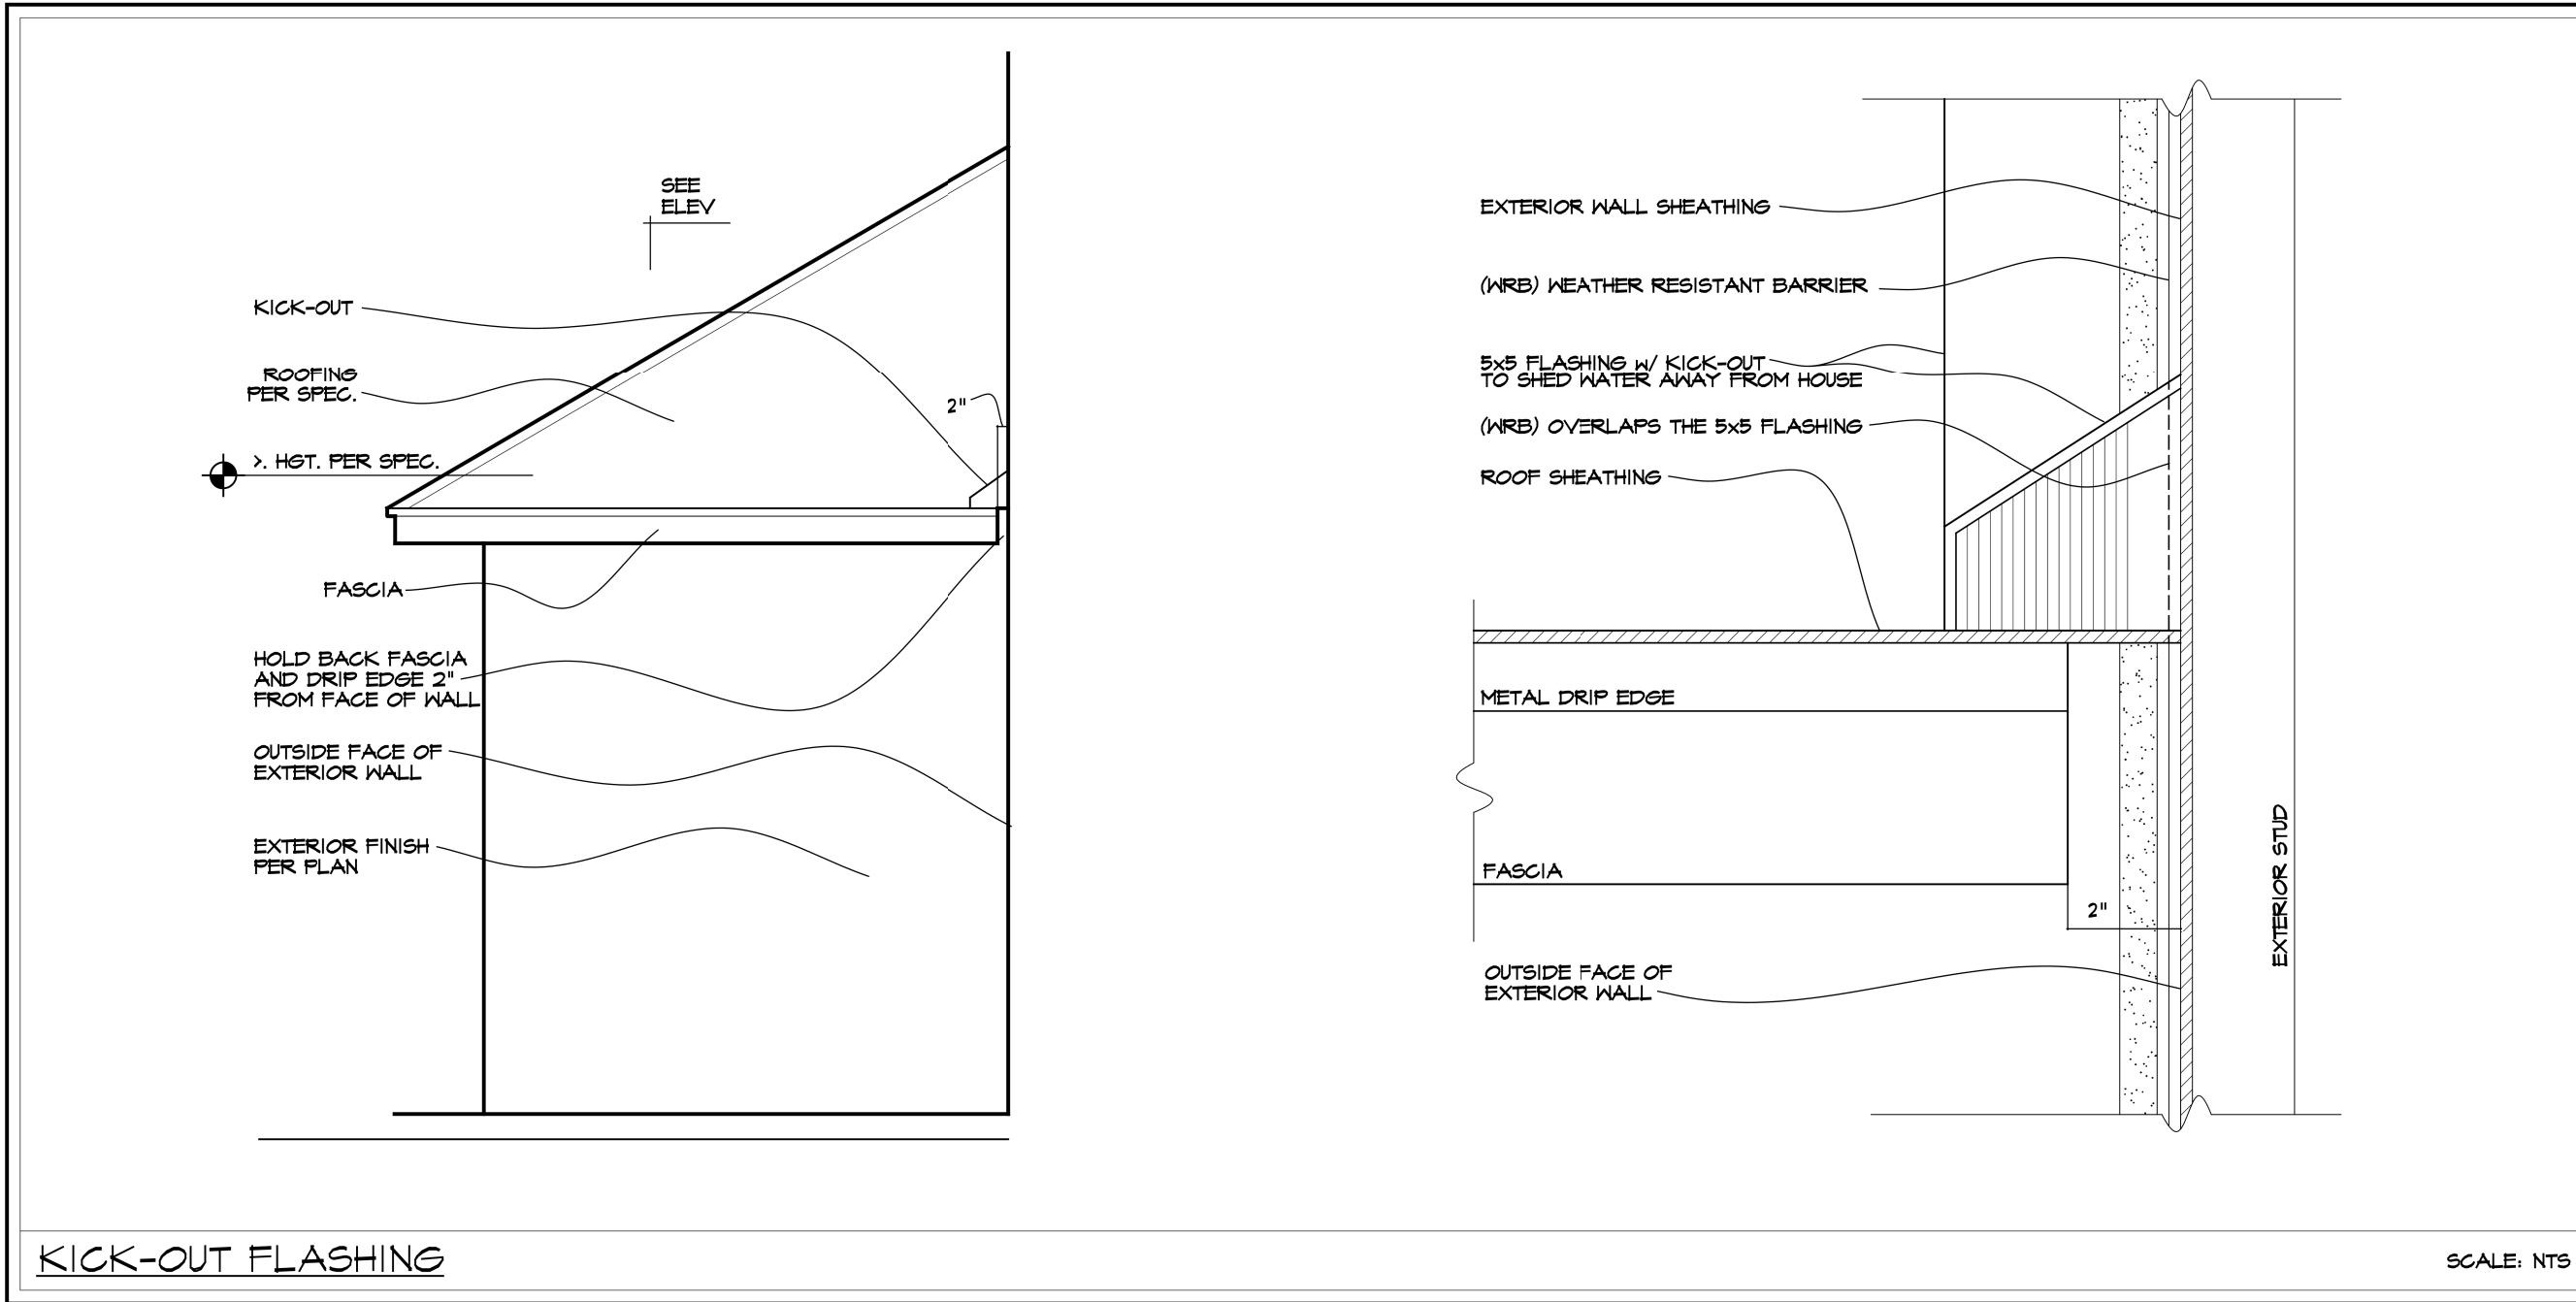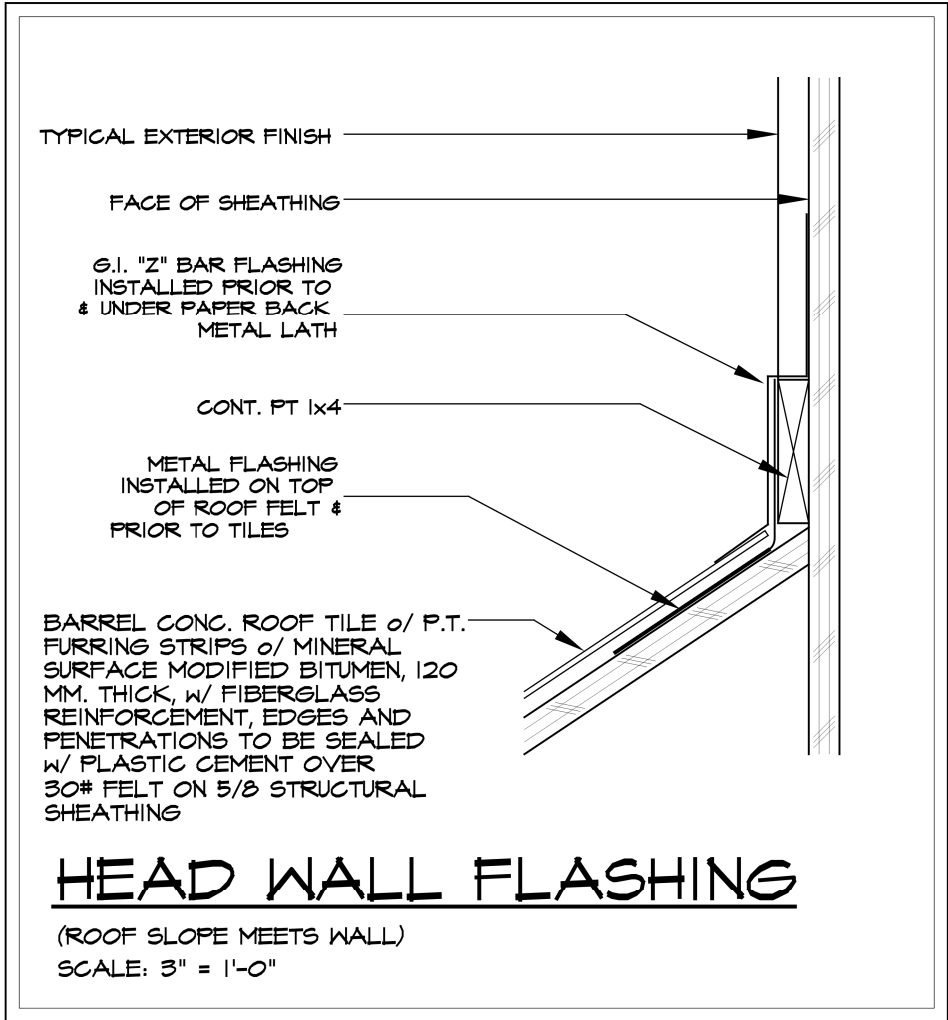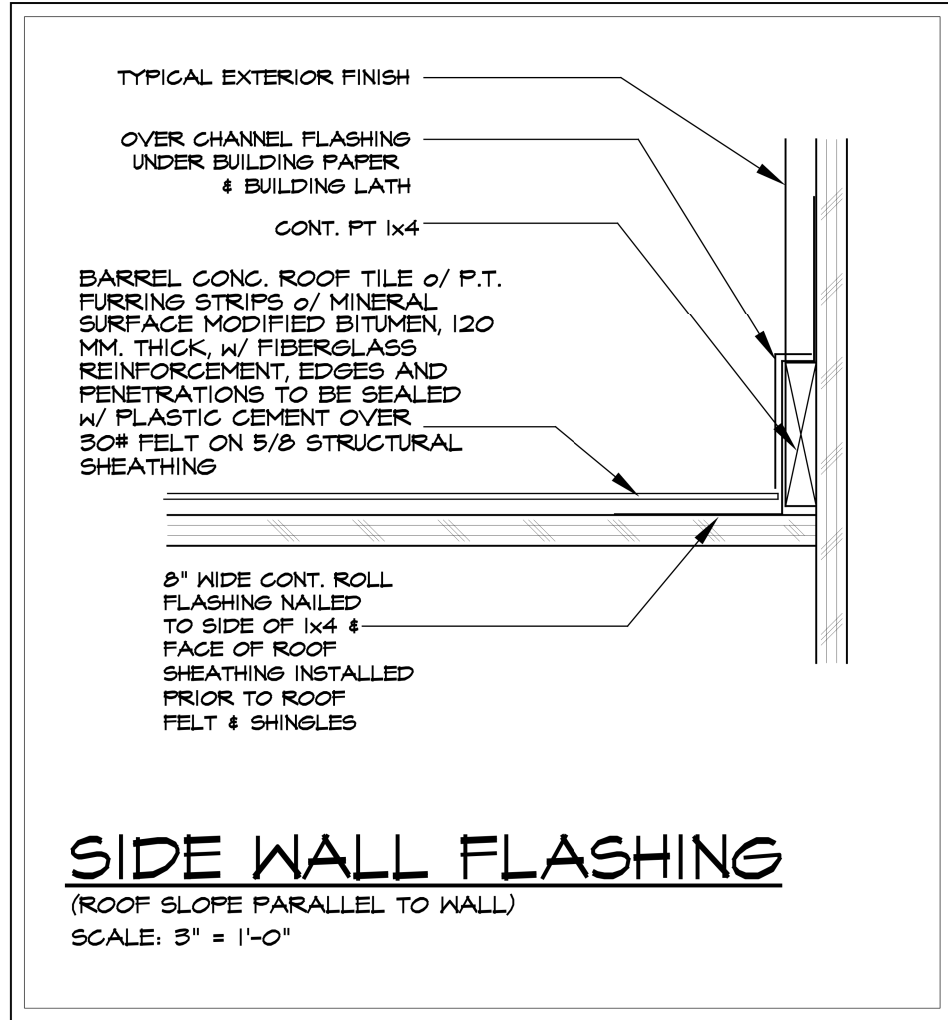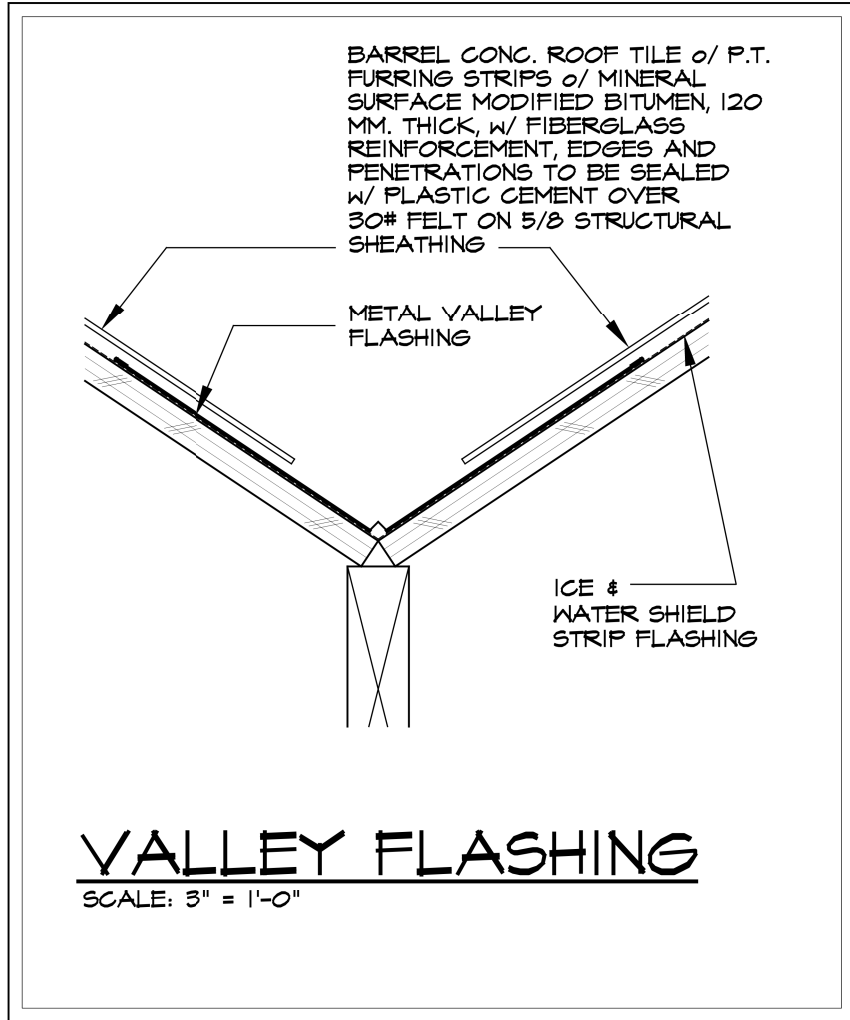

CONTRACT NOTE: CONTRACT AND SPECIFICATIONS TAKE PRECEDENCE OVER THESE DRAWINGS. ANY CONFLICT WILL DEFAULT TO SAID DOCUMENTS.


## FLASHING DETAILS

COPYRIGHT 2017: DESIGNS FOR LIVING, LLC. Under section 102 of the Architectural Works Copyright Protection Act (title 17 of the United States Code) specific tacit copyright laws apply to original design of a building created in any tangible medium of expression, including a constructed building or architectural plans, models, or drawings and is subject to copyright protection as an "architectural work" by Designs for Living, LLC, herein referred to as Designer. It is unlawful for anyone to copy these drawings, either in whole or in part, without the express written permission of the Designer. The use of any plans, specifications, electronic or hard copy prints shall be restricted to the original site for which they were prepared and publication thereof is expressly limited to such use. Title to all works, specifically all drawings, specifications, and modified derivatives of any blueprints, e-files, drawings, or specifications remain the Designers without prejudice. VISUAL CONTACT with any of these drawings, or their purchase constitutes prima facie evidence of the acceptance of these drawings, details, & specifications prior to construction. Every attempt has been made to avoid any mistakes, omissions, and the user is also fully responsible for any errors or omissions. Copyright release approval and Design for Living is not liable for error for copyright infringement or other errors after delivery via email or drawings including after construction has begun. This copyright law is only valid on building designs created on or after December 1, 1990.

|  |                  |
|--|------------------|
| PLAN #<br>4119   |                  |
| CLIENT APPROVAL SIGNATURE  | DATE             |
| JAMES W. DAVIS   |                  |
| LINDA M. DAVIS   |                  |
| BUILT BY: CBC1251050 CELL: 904-237-3433<br><br>BUILDING CONTRACTORS  |                  |
| PROJECT DESCRIPTION:<br>RENOVATIONS FOR THE DAVIS FAMILY<br>5438 TIERRA VERDE LANE<br>JACKSONVILLE, FLORIDA 32228-2281<br>R/E #: 157149-0100 |                  |
| Design Drawings provided by:   | <br>904-730-7135 |
| DATE:  | 6/21/2017        |
| SCALE:   | N.T.S.           |
| SHEET:   | A-14             |

CONTRACT NOTE: CONTRACT AND PRECEDENCE SPECIFICATIONS TAKE PRECEDENCE OVER THESE DRAWINGS. ANY CONFLICT WILL DEFAULT TO SAID DOCUMENTS.

INSTALLING TYVEK® STUCCO WRAP® ON VERTICAL WALLS, BEFORE INSTALLATION OF DOORS OR WINDOWS

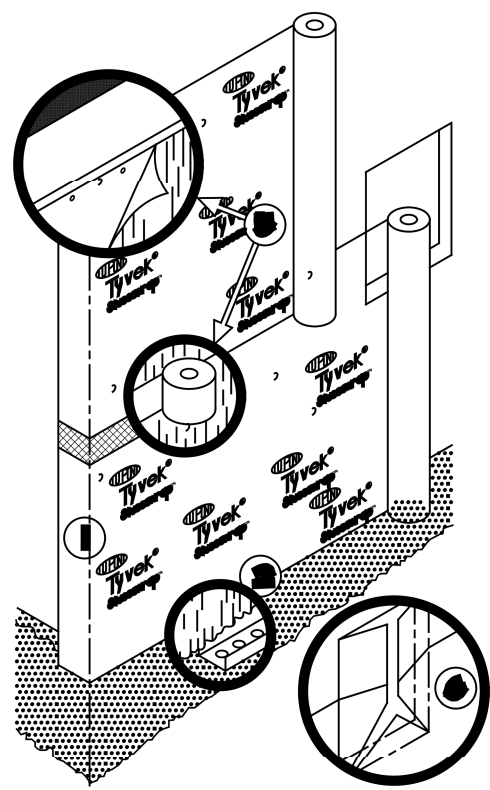

- Unwrap roll at corner, leaving 6" overlap.  
NOTE: Apply wrap with grooved surface pattern in VERTICAL position for proper drainage.
- Roll should be plumb. Bottom roll edge should extend over sill plate interface. SHINGLE Stucco Wrap® over back edge of weep screed for proper water drainage. For maximum air leakage reduction, seal wrap with caulk or tape to weep screed. Don't block weep holes.
- Secure Tyvek® every 12" on vertical stud line with wood insulated sheathing board or exterior gypsum board, use large head or plastic rubber head nails, as a best practice. Use staples with 1/2 inch minimum crown can also be used. When attaching to masonry, use adhesives with polyurethane, elastomeric, or latex base.
- Unroll directly over windows and doors. Upper roll overlaps bottom roll by 6" horizontally.
- COVER interface of upper and lower top plates with Tyvek®. As a best practice, TAPE all horizontal seams at joint, joints, headers and roll overlaps with 2" or 3" DuPont Contractor Tape. Tape any accidental tears or damage.
- Make a modified "I" CUT in Tyvek®.
- FOLD Flaps inside around window or door openings. Fasten every 6". Trim excess Tyvek®.  
NOTE: Apply wrap with grooved surface pattern in VERTICAL position for proper drainage.
- Tack up bottom sill flashing, overlapping rough sill by 4"-6". As a best practice, make two vertical corner cuts in the flashing. FOLD flashing over rough sill.
- Tack up side flashings, OVERLAPPING bottom sill flashing. Cut two 45° angles in Tyvek® from each top window corner. Then, install window or door according to manufacturer instructions.
- Install head flashing UNDER top flap of Tyvek®, OVER window flange. Extend Flashing out OVER side flashings by 2"-4". Fold top flap of Tyvek® OVER head flashing. TAPE both diagonal cuts.

RTOS.6 FLASHING. APPROVED CORROSION-RESISTANT FLASHING SHALL BE APPLIED SHINGLE-FASHION IN A MANNER TO PREVENT ENTRY OF WATER INTO THE WALL CAVITY OR PENETRATION OF WATER TO THE BUILDING STRUCTURAL FRAMING COMPONENTS. SELF-ADHERED MEMBRANES USED AS FLASHING SHALL COMPLY WITH AAMA T11. THE FLASHING SHALL EXTEND TO THE SURFACE OF THE EXTERIOR WALL FINISH. APPROVED CORROSION-RESISTANT FLASHINGS SHALL BE INSTALLED AT ALL OF THE FOLLOWING LOCATIONS:

- EXTERIOR WINDOW AND DOOR OPENINGS. FLASHING AT EXTERIOR WINDOW AND DOOR OPENINGS SHALL EXTEND TO THE SURFACE OF THE EXTERIOR WALL FINISH OR TO THE WATER-RESISTIVE BARRIER FOR SUBSEQUENT DRAINAGE. FLASHING AT EXTERIOR WINDOW AND DOOR OPENINGS SHALL BE INSTALLED IN ACCORDANCE WITH ONE OF MORE OF THE FOLLOWING OR OTHER APPROVED METHODS:
1. THE PENETRATION MANUFACTURER'S WRITTEN FLASHING INSTRUCTIONS.
2. THE FLASHING MANUFACTURER'S WRITTEN INSTALLATION INSTRUCTIONS.
3. IN ACCORDANCE WITH FMA/AAMA 100, FMA/AAMA 200, OR FMA/AAMA 250.
4. IN ACCORDANCE WITH THE FLASHING METHOD OR A REGISTERED DESIGN PROFESSIONAL.

- AT THE INTERSECTION OF CHIMNEYS OR OTHER MASONRY CONSTRUCTION WITH FRAME OF STUCCO WALLS, WITH PROJECTION LIPS ON BOTH SIDES UNDER STUCCO COPINGS.
- UNDER AND AT THE ENDS OF MASONRY, WOOD, OR METAL COPINGS AND SILLS.
- CONTINUOUSLY ABOVE ALL PROJECTING GROUND TRIM.
- WHERE EXTERIOR PORCHES, DECKS, OR STAIRS ATTACH TO A WALL OR FLOOR ASSEMBLY OF WOOD-FRAME CONSTRUCTION.
- AT WALL AND ROOF INTERSECTIONS.
- AT BUILT-IN GUTTERS.

ALL WINDOW AND DOOR FLASHING SHALL COMPLY WITH FMA AAMA T11, 100, 200, AND 250. EXCEPT OF FMA AAMA 100-01

6.0 PRE-WINDOW INSTALLATION PROCEDURES

6.1 Pre-installation requirements performed by others, per the manufactures instructions.

6.1.1 Rough Openings

6.1.1.1 The builder/contractor shall construct the rough openings in accordance with the window manufacturer's size and tolerance requirements.

6.1.1.2 The rough opening shall be plumb, level, square and true within 6 mm (1/4 in) prior to the installation of the window. Manufacturer's instructions may supersede these tolerance ranges.

6.1.2 Water-Resistive Barriers (WRB) This standard practice recommends that the WRB be installed prior to the window installation. The installation method described in this standard practice is based on this sequence.

6.1.2.1 The application of the WRB involves covering the vertical surfaces of the wall, lapped, fastened, taped and sealed per the WRB manufacturer's instructions.

6.1.2.2 Penetrations through the WRB for the installation of windows shall be made in accordance with the WRB manufacturer's recommendations or this standard practice.

6.1.2.3 The WRB shall be applied in water shedding fashion, starting at the base of the wall and working towards the top. The WRB shall be applied to the face of the building framing or sheathing.

6.2 TWO LAYER WRB SYSTEMS

6.2.1 A two layer WRB or building paper (BP) system may be required in accordance with state and local codes. The window shall be flashed/integrated with the WRB and into the wall per the WRB manufacturer's instruction.

6.2.2 After the installation of the second layer of WRB, the cladding shall be applied with a weep screed installed at the bottom of the first floor and at the bottom of any floor above or over a concrete masonry unit (CMU).

7.0 WINDOW INSTALLATION PROCEDURES

7.1 PRE-INSTALLATION INSPECTION

7.1.1 In the event that the WRB is installed after the window installation, refer to ASTM E 2112 for various sequencing considerations.

7.1.2 Before installation can occur, the installer shall inspect the WRB to ensure that it is installed in accordance with this standard practice and the WRB manufacturer's instructions. Any tears, penetration or defects within 508 mm (12 in) of the rough opening area shall be sealed per the WRB manufacturer's instructions before the installation starts. Refer to ASTM C 155.


7.1.3 The installer shall verify that the rough opening is plumb, level, square and true. The installer shall notify the contractor to remedy any discrepancies per this standard practice.

7.1.4 The installer shall inspect the fenestration product for damage and repair or replace if necessary.


7.2 INSTALLATION PROCEDURES

7.2.1 In the event that the WRB has not been previously modified, the installer shall complete the following steps:

- Carefully cut the WRB in a modified "I" pattern as shown in figure 1. The full-I cut of the WRB is also acceptable.

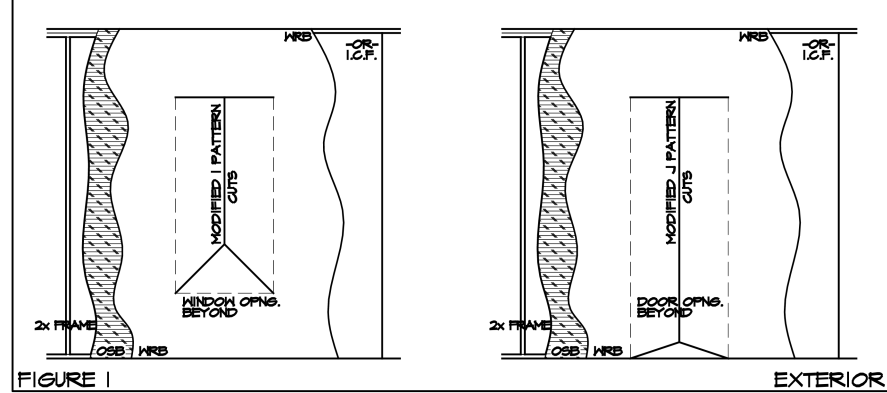


- Fold the bottom and side flaps over and behind the interior side of the framing (see Figure 2).

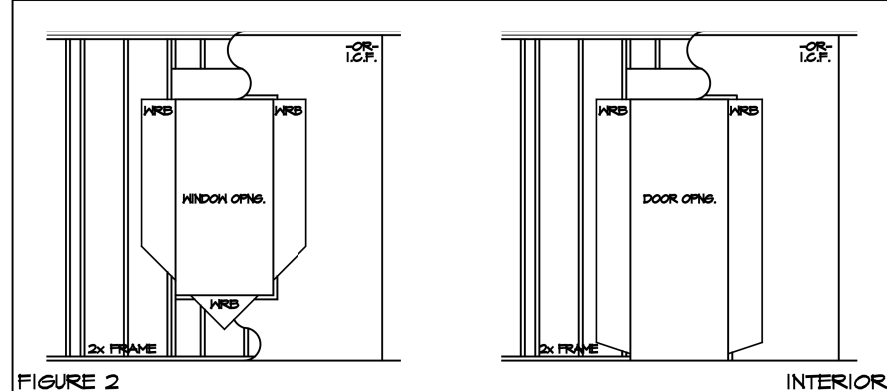


- Attach the WRB into position on the inside of the rough opening, and trim any excess as required.

7.2.2 At the head of the opening, starting at the top corner of the window (rough) opening, measure from the corner horizontally and then vertically a distance equal to the roll width of the flashing to be applied, and make a mark (see Figure 3).

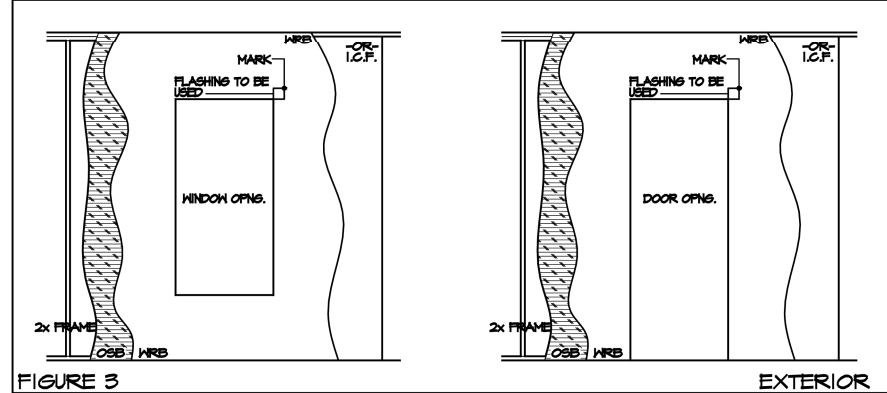

At a 45° angle, carefully cut the the WRB on a diagonal (see Figure 4). Repeat this step on the opposite corner.

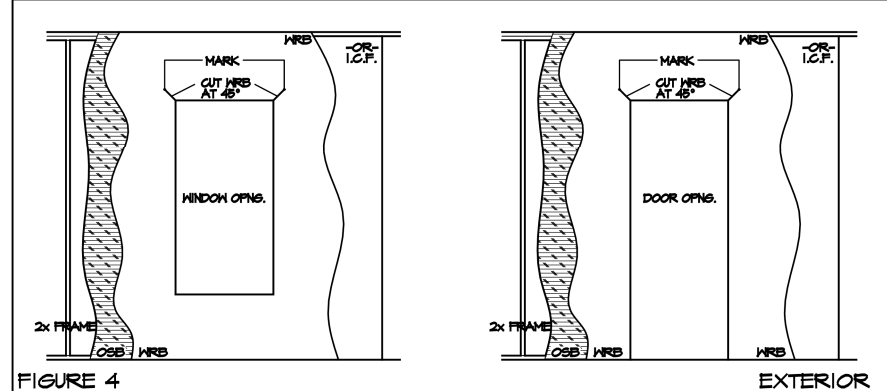

Gently raise the bottom edge of the flap created in the WRB and temporarily tape the top corners and center to the exterior face of the WRB above (see Figure 5). This is done in order to allow for installation of the window and head flashing later.


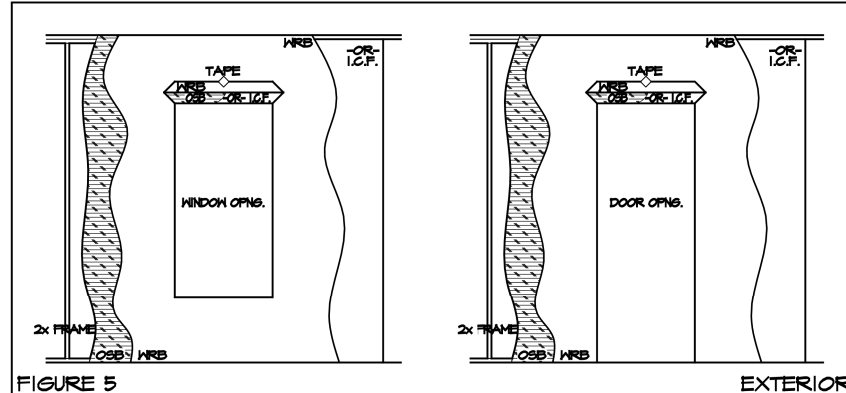



Figure 5 Applying a Sill Pan Flashing

7.2.3 There are a variety of sill pan systems available. (Reference ASTM E 2112 guidelines for the latest information). The pan shall direct water to the exterior of the building drainage plane for subsequent drainage to the exterior of the building.

7.2.3.1 When self-adhering flashing is used as a sill pan, cut to a length equal to the rough opening width plus at least 150 mm (6 in) up the jamb, to form an end dam (see Figure 6).

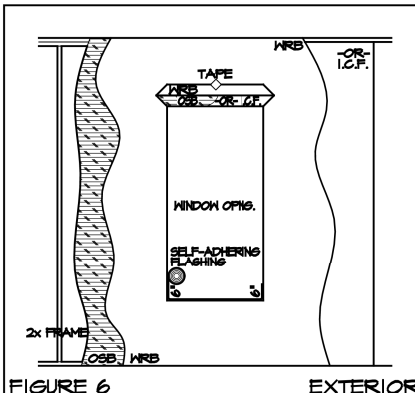


The self-adhering flashing sill pan system shall cover the sill to at least the depth of the window, plus 50 mm (2 in) onto the face of the WRB drainage plane (see Figure 7).

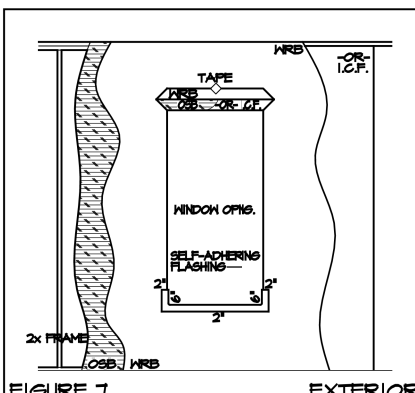

7.2.4 If a rigid or semi-rigid sill pan system is used, follow manufacturer's instructions for installation details and integration with the WRB and flashing.


7.2.5 Inspect and clean the back side (interior surface) of the exterior window mounting flange. Look for any sealant gaps or misaligned welding at the corner joints. If corner seals are missing in whole or part, contact the window manufacturer for the recommended remedy.

7.2.6 After cleaning the mounting flanges, carefully run a continuous 9 mm (3/8 in) nominal diameter bead of sealant on the back surface (interior face) of the mounting flange of the window at the head and both jambs (see Figure 8). Apply sealant in line with any pre-punched holes or slots in the mounting flange. Connect that bead of sealant across any jointery on the window frame at all four corners.

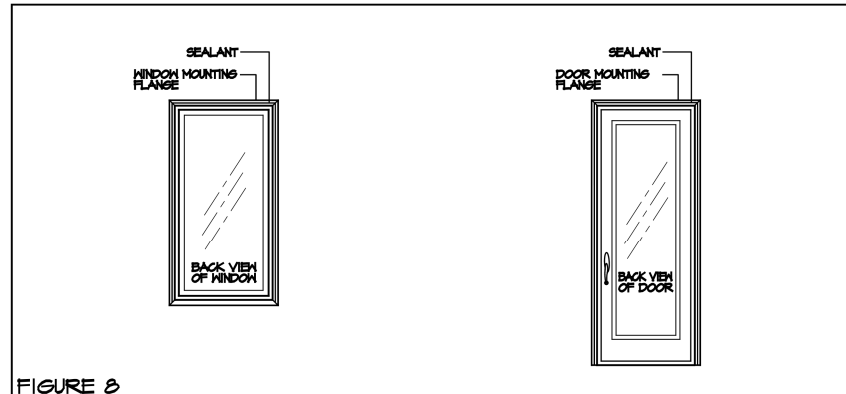

As an option, the sealant shall be permitted to be applied to the wall surface, as opposed to the back of the mounting flange, in line or inboard of any pre-punched holes or slots.


7.2.7 Apply a discontinuous bead of sealant on the interior surface of the mounting flange at the sill. The bead of sealant shall have a minimum of two 50 mm (2 in) voids near the ends (see Figure 9), allowing any liquid water that has entered the window opening to exit easily.

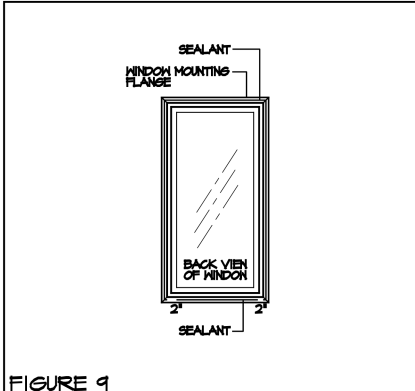


7.2.7.1 As an alternate to the discontinuous bead of sealant, a weep screed or wicking mechanism shall be permitted to be applied at the jamb ends of the sill to allow liquid water to escape.

7.2.7.2 Additionally, if a rigid or semi-rigid sill pan is used, apply a bead of sealant to the outboard side of the upturned leg of the pan where it will integrate with the interior side of the window and form an air/water seal.

7.2.8 Immediately set the window into the opening (see Figure 10).

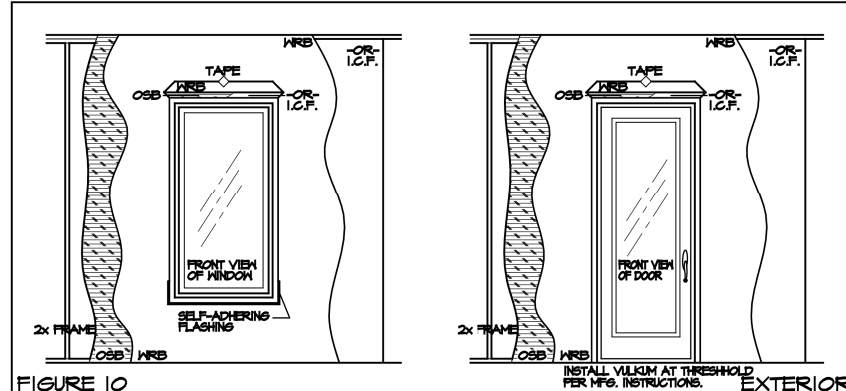

Hold the window temporarily into position and apply shims as required to ensure the window is set plumb, level, square and true. Fasten the window perimeter securely into position in accordance with the manufacturer's instructions. For proper sealant coverage, ensure squeeze out under the flange and in fastener holes (see Figure 11).

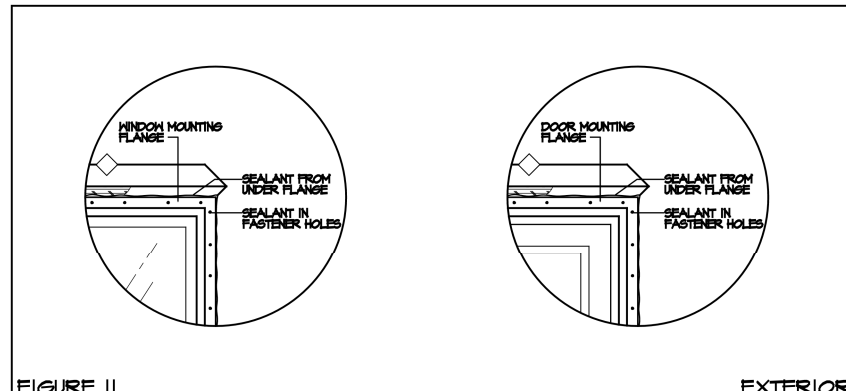


Install shims in such a manner that they are not permitted to interfere with the application of the air seal, which will be applied on the interior side in the steps that follow.

NOTE 2: Either self-adhesive flashing (see Section 7.2.4) or mechanically attached flashing (see Section 7.2.10) shall be permitted to be used for jamb and head flashing, per the following steps.


7.2.4 Jamb and Head Flashing Installation Using Self Adhering Flashing

7.2.4.1 Apply flashing over the mounting flange of the window at both jambs. The self adhering flashing shall be a minimum of 100 mm (4 in). With self-adhering flashing, the additional bead of sealant over the mounting flange (see Sections 7.2.10.2 and 7.2.10.6) shall be omitted.



7.2.4.2 Cut the jamb flashing to a measurement equal to twice the roll width of the flashing being used, plus the height of the rough opening, minus 25 mm (1 in) (see Figure 12).

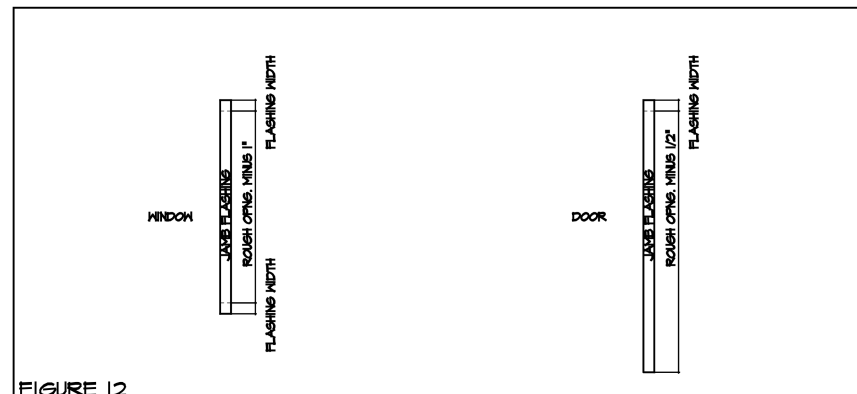

7.2.4.3 Position the top end of the flashing 15 mm (1/2 in) below the location where the top edge of the head flashing will cover the jamb flashing later (see Figure 13).

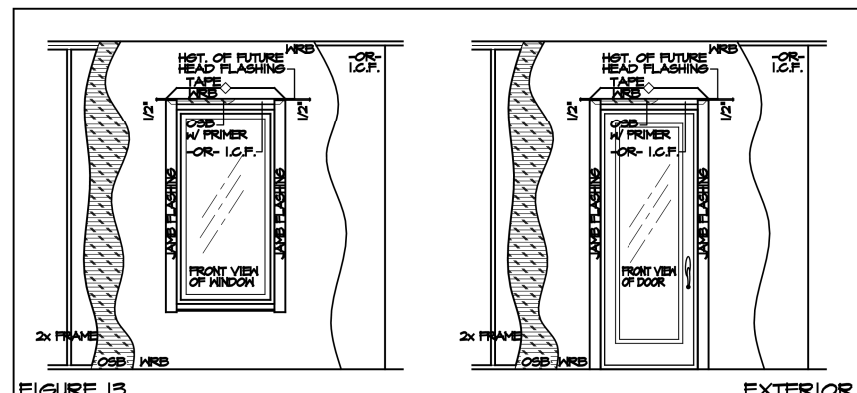

CONTRACT NOTE: CONTRACT AND SPECIFICATIONS TAKE PRECEDENCE OVER THESE DRAWINGS. ANY CONFLICT WILL DEFAULT TO SAID DOCUMENTS.

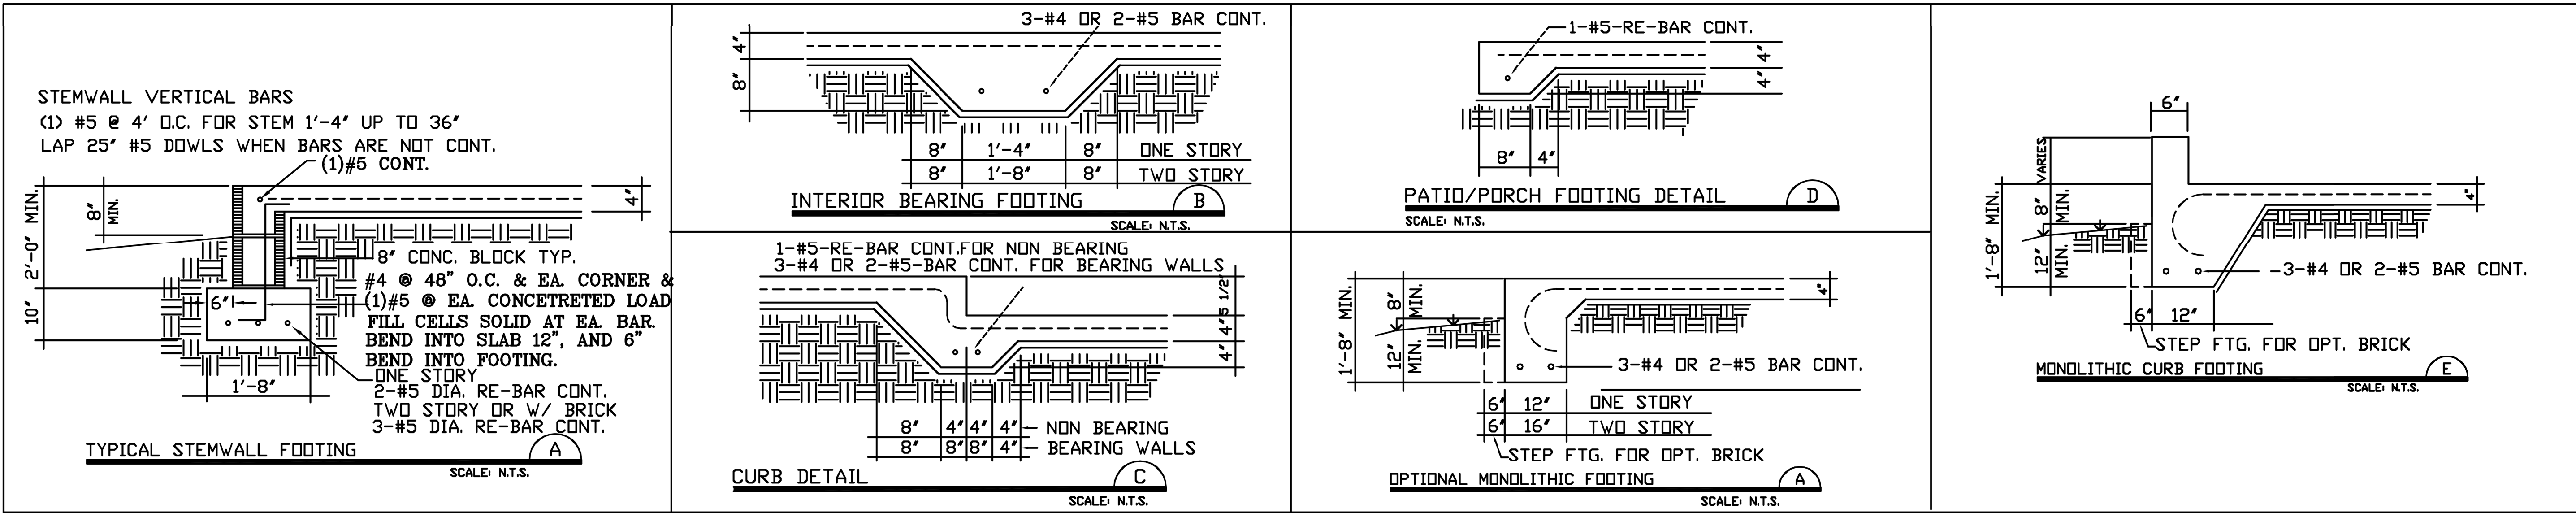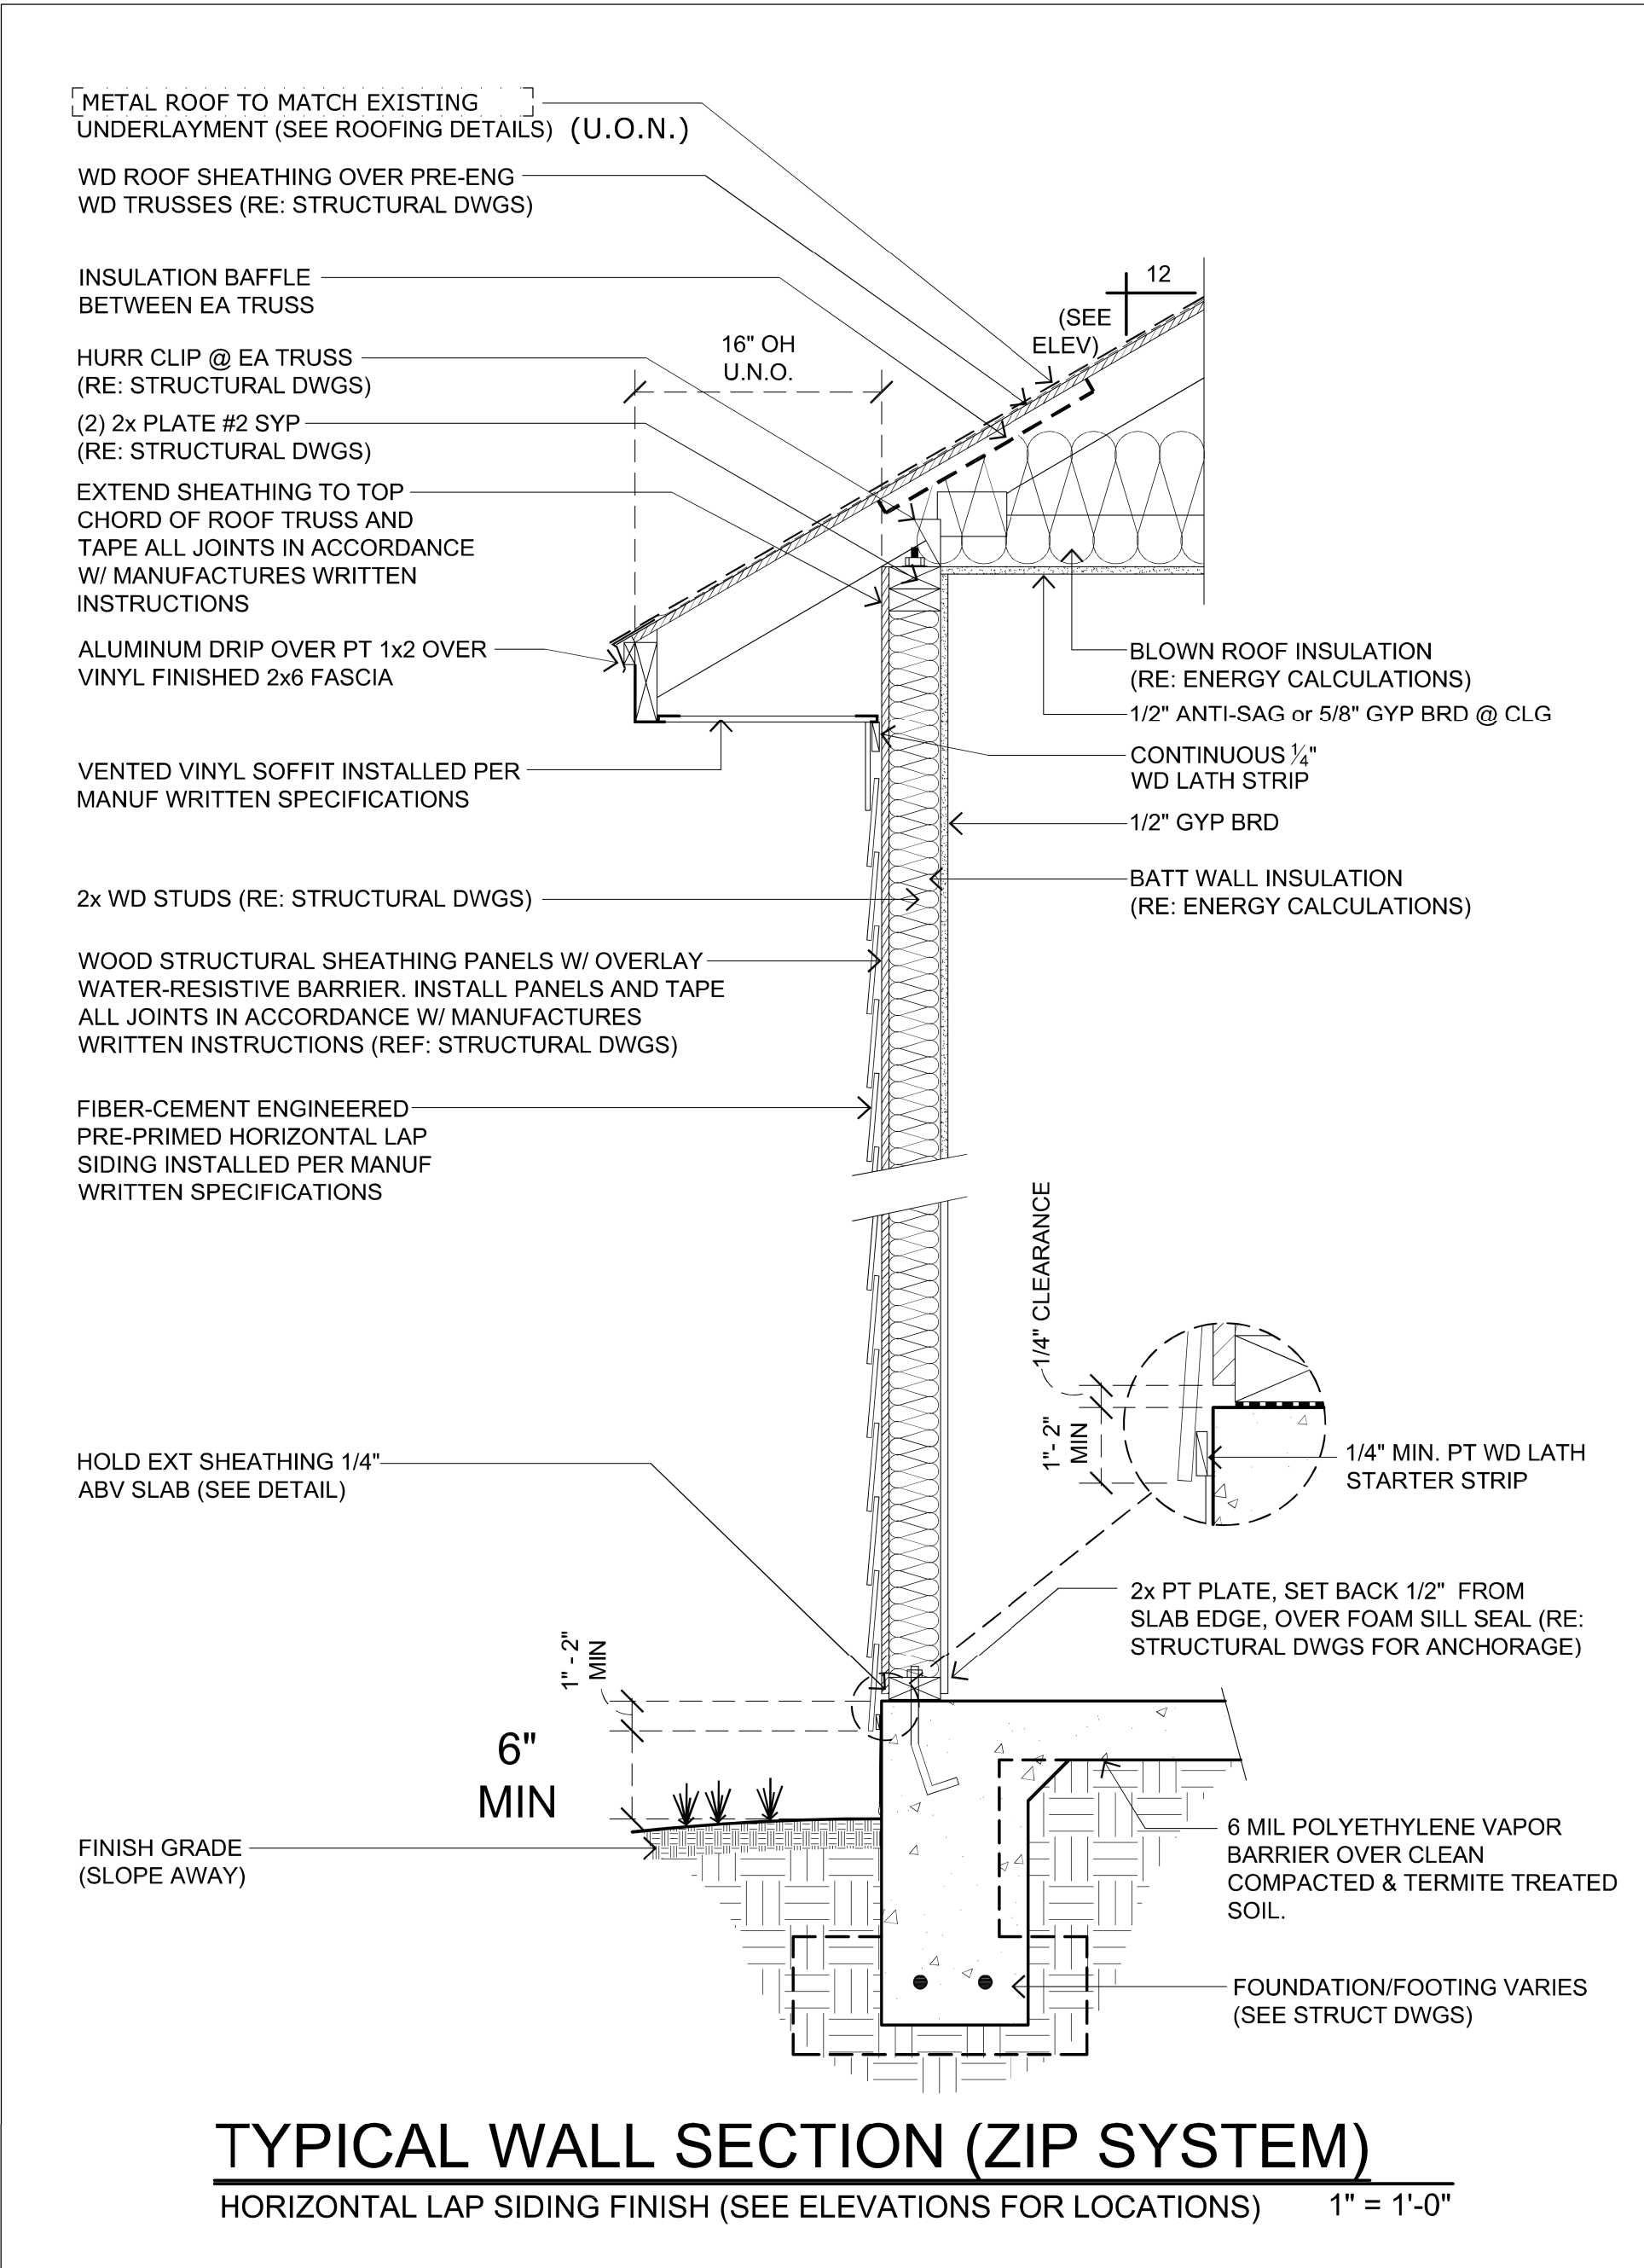

# FOUNDATIONBUILDING DETAILS

COPYRIGHT 2017: DESIGNS FOR LIVING, LLC. -Under section 102 of the Architectural Works Copyright Protection Act (title 17 of the United States Code) specific tact copyright laws apply to original design of a building created in any tangible medium of expression, including a constructed building or architectural plans, models, or drawings and is subject to copyright protection as an "architectural work" by Designs for Living, LLC. herein referred to as Designer. It is unlawful for anyone to copy these drawings, either in whole or in part, without the express written permission of the Designer. The use of any plans, specifications, electronic or hard copy prints shall be restricted to the original site for which they were prepared and publication thereof is expressly limited to such use. Title to all works, specifically all drawings, specifications, and modified derivatives of any blueprints, e-files, drawings, or specifications remain the Designers without prejudice. VISUAL CONTACT with any of these drawings, or their purchase constitutes prima facie evidence of the acceptance of these restrictions. This has held precedent in the North Florida Court system. Any and all violations WILL result in legal action being taken and litigated damages to the full extent allowed by law! No exceptions and no excuses! Contractor &/or owner shall verify all dimensions, details, & specifications prior to construction. Every attempt has been made to avoid mistakes. The contractor and the owners also fully acknowledge that they have full copyright release approval and Designer's for Livings LLC or R.E. Chip Mitchell shall not be liable for error for copyright infringement or other errors after delivery via email or drawings including after construction has begun. This copyright bar is only valid on building designs created on or after December 1, 1990.

PLAN #  
4119


CLIENT APPROVAL SIGNATURE

DATE

JAMES W. DAVIS

LINDA M. DAVIS


BUILT BY: CBC1251050 CELL: 904-237-3433

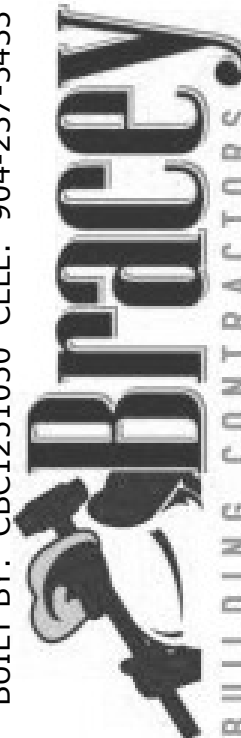Bracey  
BUILDING CONTRACTORS

PROJECT DESCRIPTION:

RENOVATIONS FOR THE DAVIS FAMILY  
5438 TIERRA VERDE LANE  
JACKSONVILLE, FLORIDA 32228-2281  
R/E #: 157149-0100

Design Drawings  
provided by:

DESIGNS FOR LIVING  
RESIDENTIAL DESIGN SINCE 1999  
904-730-7135

DATE:

6/21/2017

SCALE:

N.T.S.

SHEET:

A-16