

RENOVATIONS FOR THE GRECO FAMILY

REVIEW SET 3/16/16

PLAN #
2461



LOT 256, AMELIA VIEW, UNIT 1
2990 AMELIA BLUFF DRIVE
JACKSONVILLE, FL 32266 R/E #: 108422-6500
BUILT BY: PICKETT CONSTRUCTION, INC.
9526 ARGYLE FOREST BLVD.
SUITE B2 #302
JACKSONVILLE, FL 32222
OFFICE: 904-282-5505
CELL: 904-591-0190
CGC1506644

COPYRIGHT 2016 - DESIGNS FOR LIVING, LLC. Under Federal Statute HR 5490 of the Architectural Drawing Act & Title 17 specific copyright laws apply to all published works of Designs for Living, LLC, herein referred to as Designer. It is unlawful for anyone to copy these drawings, either in whole or in part, without the express written permission of the designer! The use of any plans, specifications, electronic or hard copy prints shall be restricted to the original site for which they were prepared and publication thereof is expressly limited to such use. Title to all works, specifically all drawings, specifications, and modified derivatives of any blueprints, e-prints, drawings, or specifications remain the designers without prejudice. VISUAL CONTACT with any of these drawings, or their purchase, constitutes prima facie evidence of the acceptance of these restrictions! This has held precedent in the North Florida Court system! Any and all violations WILL result in legal action being taken and litigated damages to the full extent allowed by law! No exceptions and no excuses! Contractor &/or owner shall verify all dimensions, details, & specificiations prior to construction. Every attempt has been made to avoid mistakes. The contractor and the owners also fully acknowledge that they have full copyright release approval and liability for any errors after delivery via email of drawings, including after construction has begun!

NO. DESCRIPTION BY DATE

PICKETT Construction, Inc.
9526 Argyle Forest Blvd.
Jacksonville, FL 32222
CGC1506644

PROJECT DESCRIPTION:
THE GRECO FAMILY
2990 AMELIA BLUFF DRIVE
JACKSONVILLE, FL 32266

Bid Drawings provided by:
Designs for Living, LLC
RESIDENTIAL DESIGN & CONSULTING
SERVING N/E FLORIDA SINCE 1978
904-730-7135

DATE:
3/16/2016
SCALE:
N.T.S
SHEET:
A-1

**PLAN #
2461**

COPYRIGHT 2016 - DESIGNS FOR LIVING, LLC. Under Federal Statute HR 5490 of the Architectural Drawing Act & Title 17 specific copyright laws apply to all published works of Designs for Living, LLC, herein referred to as Designer. It is unlawful for anyone to copy these drawings, either in whole or in part, without the express written permission of the Designer! The use of any plans, specifications, electronic or hard copy prints shall be restricted to the original site for which they were prepared and publication thereof is expressly limited to such use. violations WILL result in legal action being taken and litigated damages to the full extent allowed by law! No exceptions and no excuses! Contractor &/or owner shall verify all dimensions, details, & specifications prior to construction. 

BUILT BY:

Pickett Construction, Inc.
9526 Argyle Forest Blvd.
Jacksonville, FL 32222
CGC1506644

PROJECT DESCRIPTION:

THE GRECO FAMILY
2990 AMELIA BLUFF DRIVE
JACKSONVILLE, FL 32266

Bid Drawings provided by:

Designs for Living, LLC
RESIDENTIAL DESIGN & CONSULTING
SERVING N/E FLORIDA SINCE 1978
904-730-7135

DATE:


3/16/2016

SCALE:

1/4" = 1'-0"

SHEET:

A-2

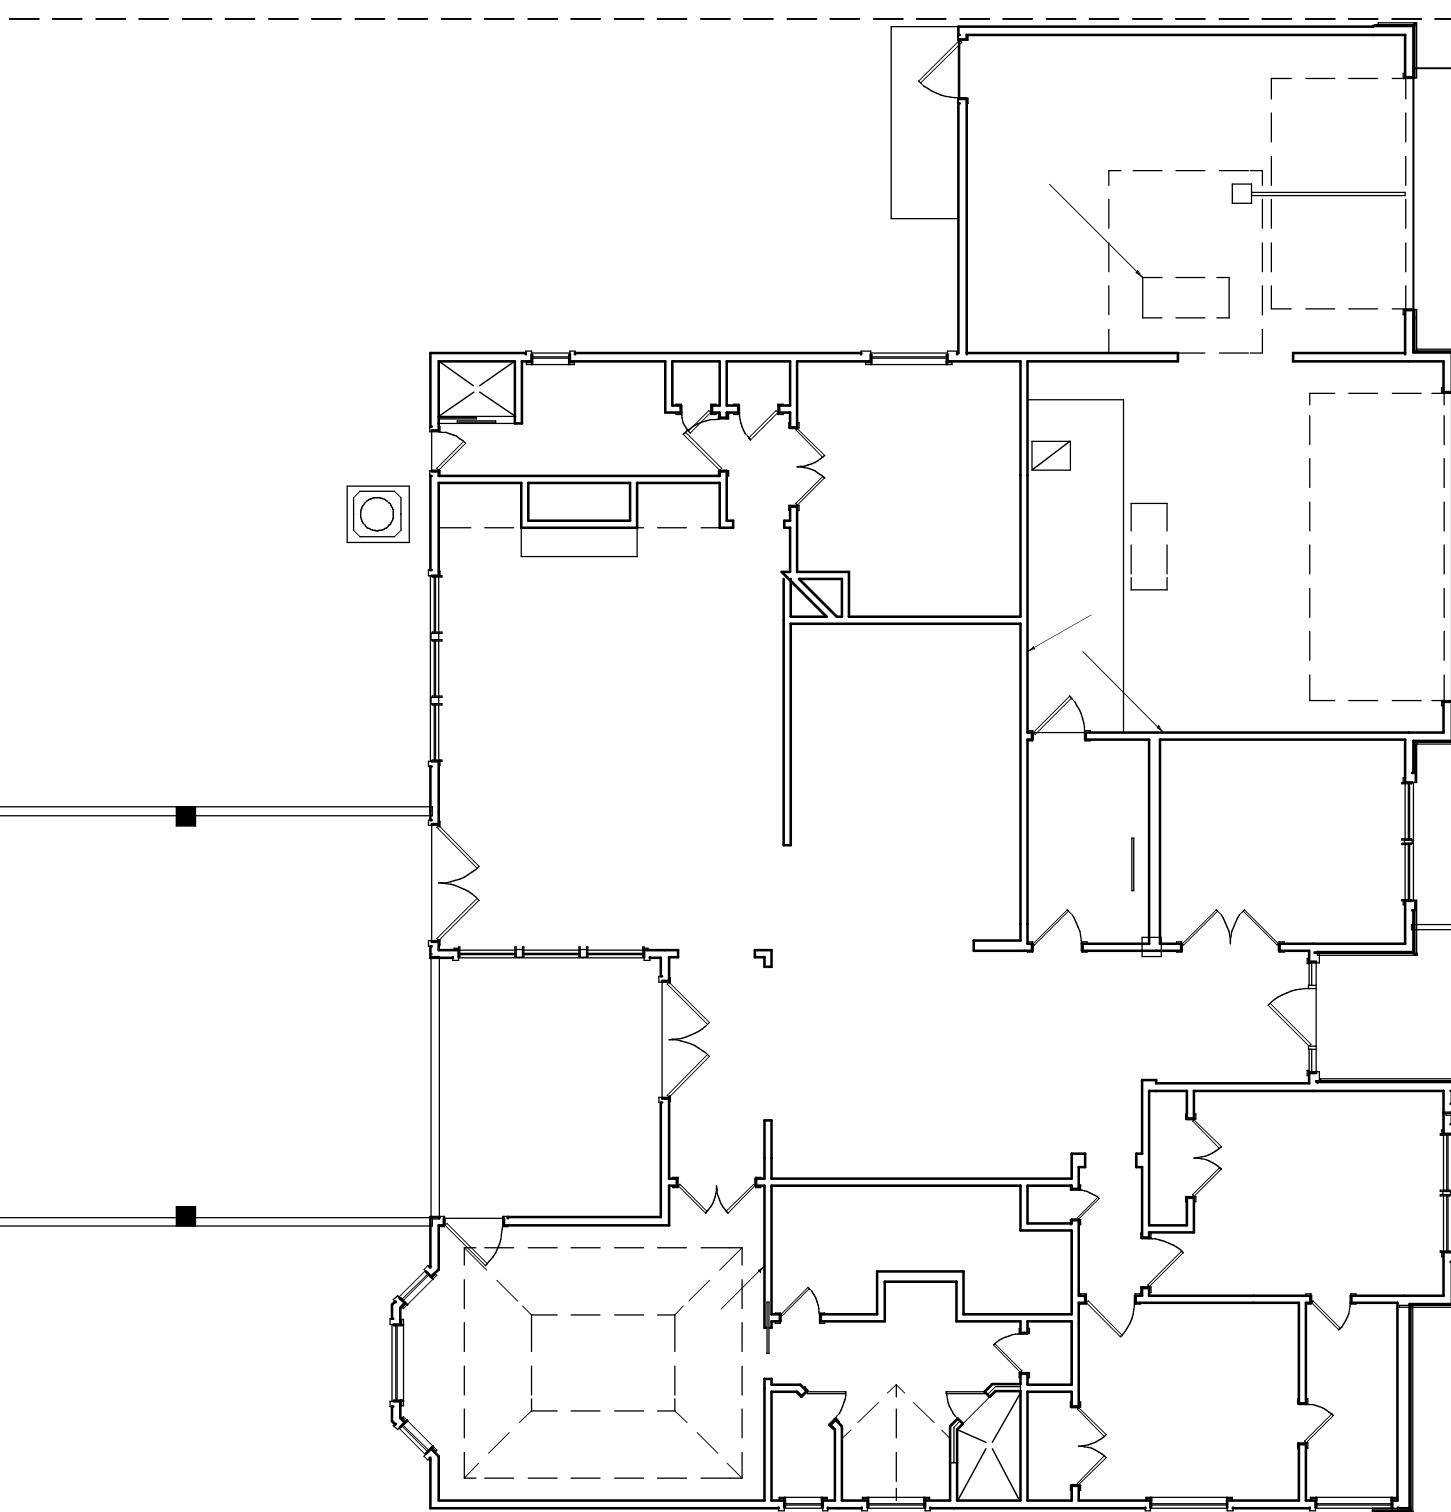

A-2

PLAN # 2461


BUILT BY:
Pickett Construction, Inc.
 9526 Argyle Forest Blvd.
 Jacksonville, FL 32222
 CGC1506644

PROJECT DESCRIPTION:
THE GRECO FAMILY
 2990 AMELIA BLUFF DRIVE
 JACKSONVILLE, FL 32266

Bid Drawings provided by:
Designs for Living, LLC
 RESIDENTIAL DESIGN & CONSULTING
 SERVING N/E FLORIDA SINCE 1978
 904-730-7135

DATE:	3/16/2016
SCALE:	1/4" = 1'-0"
SHEET:	A-3

COPYRIGHT 2016 - DESIGNS FOR LIVING, LLC. Under Federal Statute HR 5490 of the Architectural Drawing Act & Title 17 specific copyright laws apply to all published works of Designs for Living, LLC, herein referred to as Designer. It is unlawful for anyone to copy these drawings, either in whole or in part, without the express written permission of the designer! The use of any plans, specifications, electronic or hard copy prints shall be restricted to the original site for which they were prepared and publication thereof is expressly limited to such use. Title to all works, specifically all drawings, specifications and modified derivatives of any blueprints, series, drawings or specifications remain the designer's without prejudice. VISUAL CONTACT with any of these drawings, or their purchase, constitutes prima facie evidence of the acceptance of these restrictions! This has held precedent in the North Florida Court system! Any and all violations WILL result in legal action being taken and litigated damages to the full extent allowed by law! No exceptions and no excuses! Contractor &/or owner shall verify all dimensions, details & specifications prior to construction. 

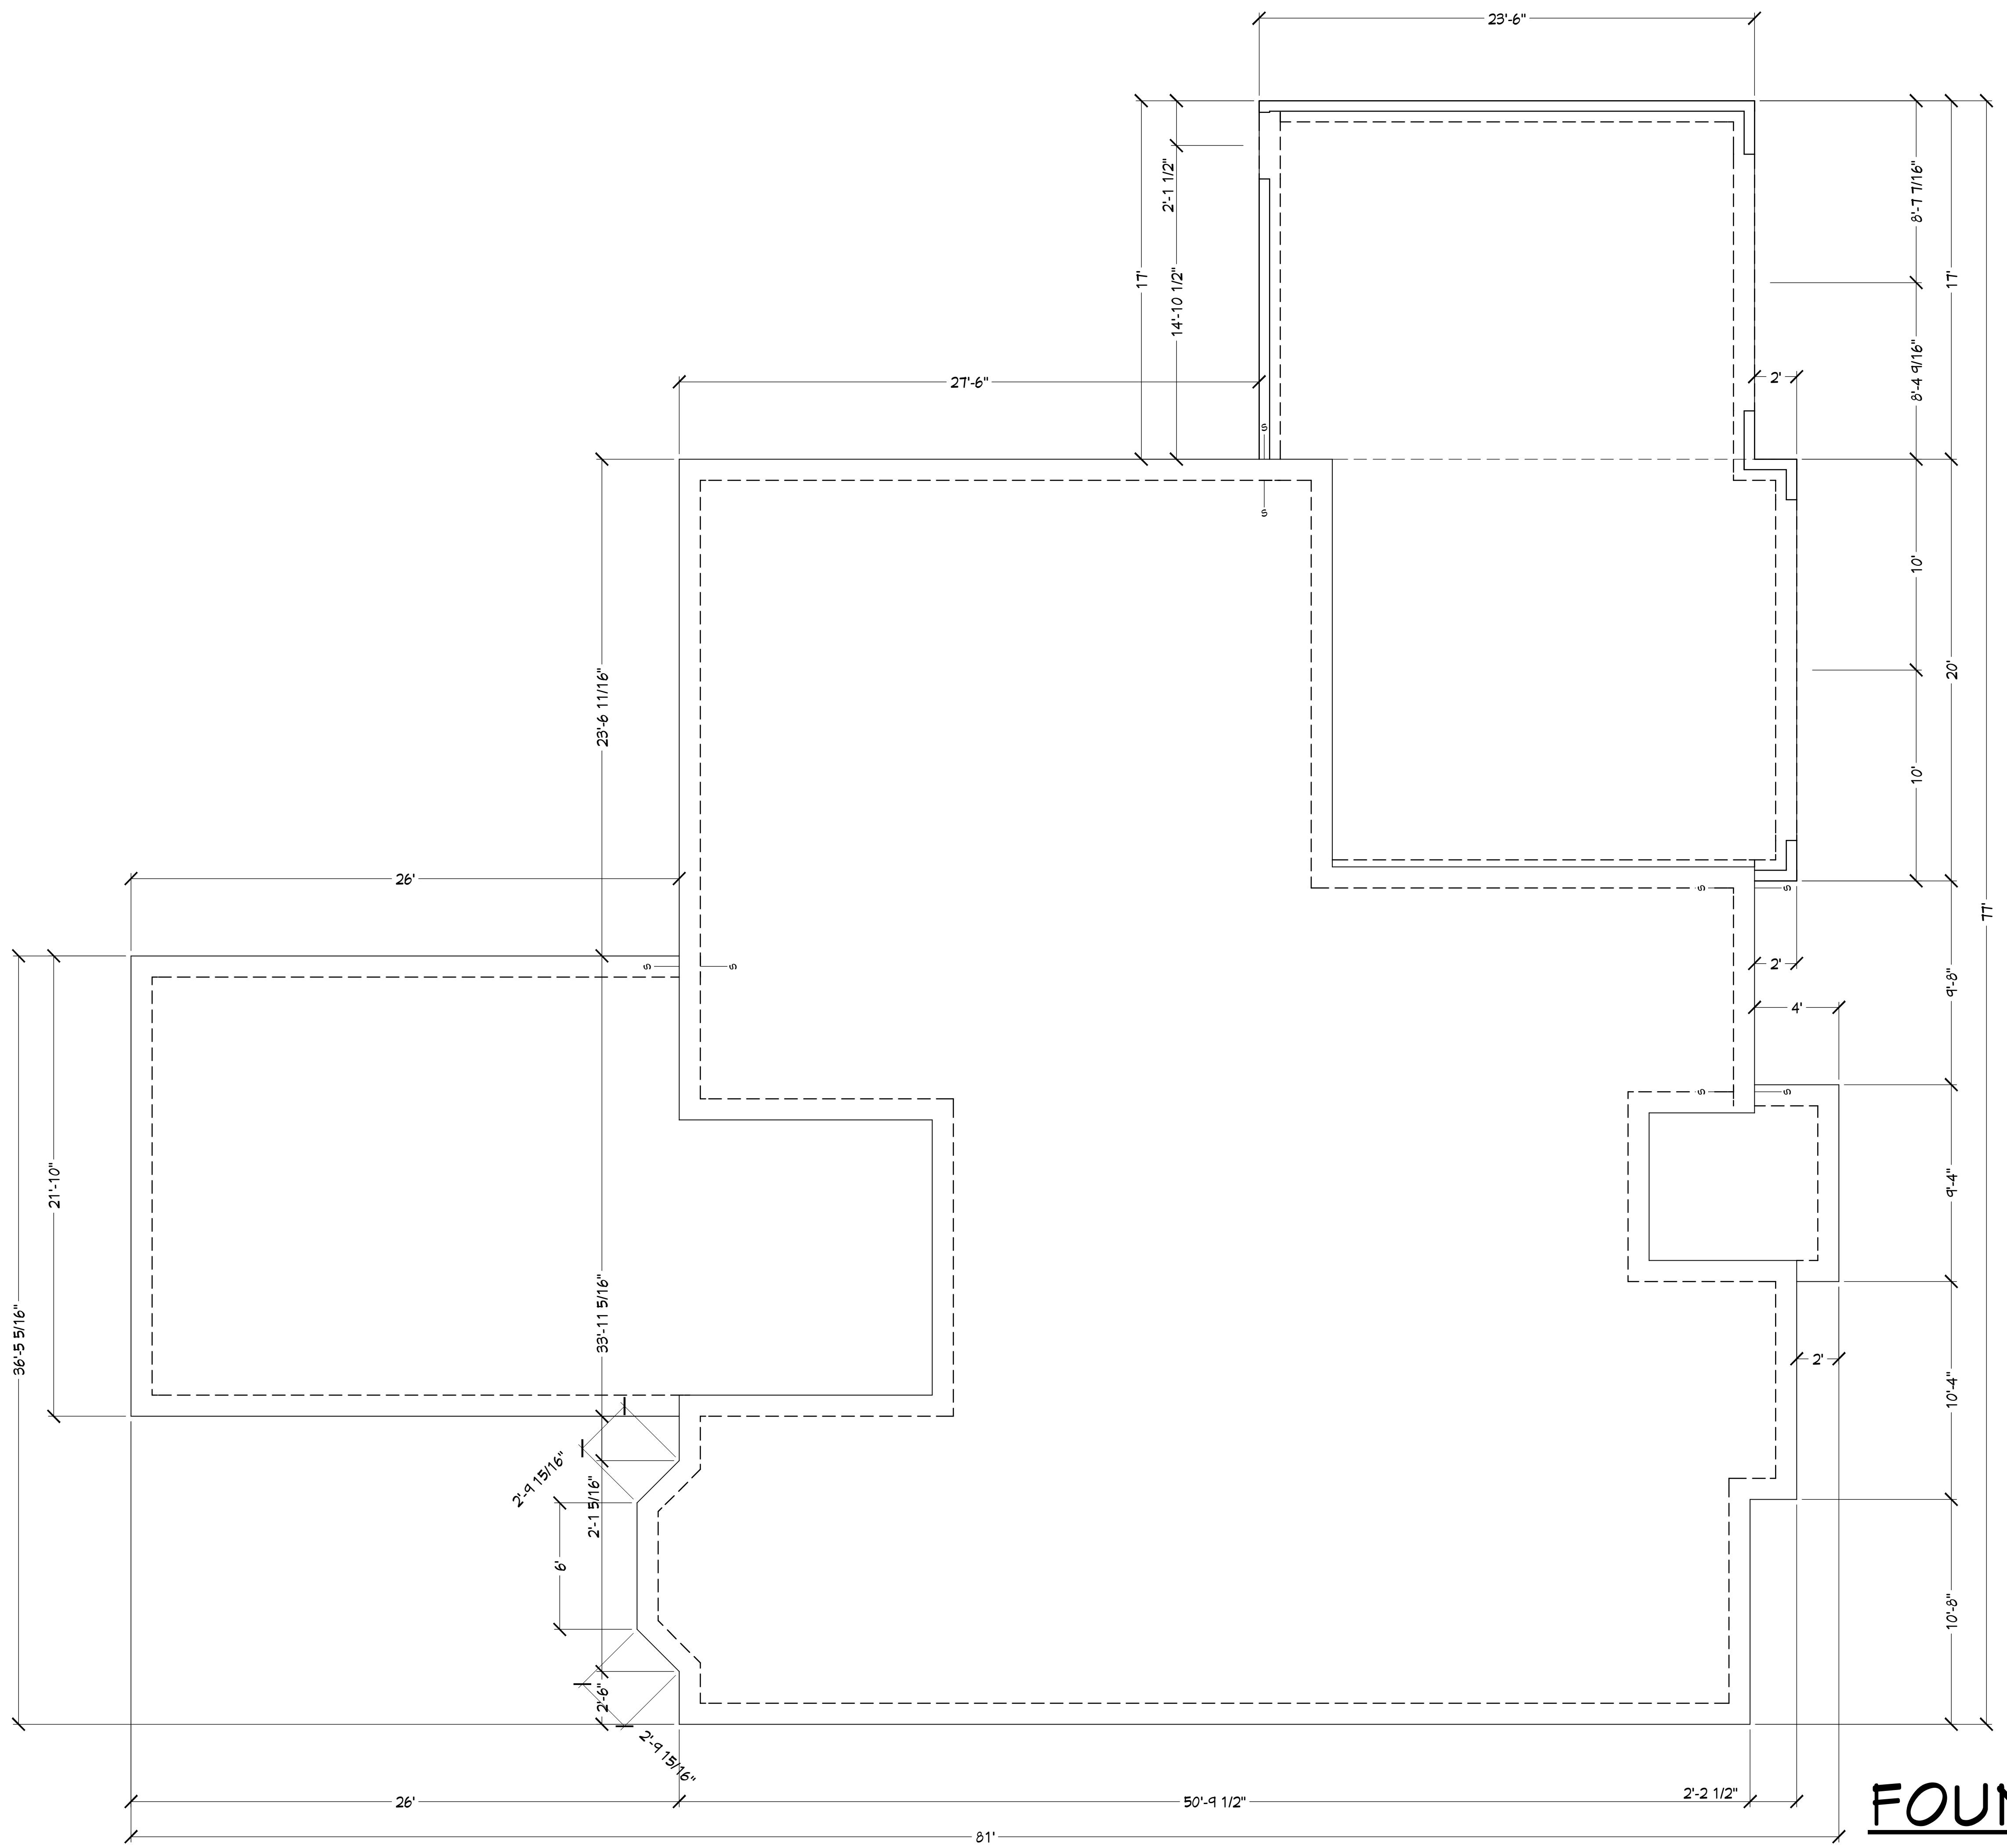

PLAN # 2461

PROJECT DESCRIPTION:	Divided by:		
BUILT BY:	NO	DESCRIPTION	BY
			DATE

P

Title to all works, specifically all drawings, specifications, and modified derivatives of any blueprints, e-files, electronic or hard copy prints shall be restricted to the original site for which they were prepared and publication thereof is expressly limited to such use. Every attempt has been made to avoid mistakes. The contractor and the owners also fully acknowledge that they have full copyright release approval and aligns for Livesigns for error for copyright infringement or other errors after delivery via email of drawings including after construction has begun!

ckett Construction, Inc.
526 Argyle Forest Blvd.
acksonville, FL 32222
CGC1506644


PROJECT DESCRIPTION:
THE GRECO FAMILY
2990 AMELIA BLUFF DRIVE
, JACKSONVILLE, FL 32266

Drawings provided by:
Designs for Living, LLC
RESIDENTIAL DESIGN & CONSULTING
SINCE 1969
SERVING N/E FLORIDA SINCE 1978
904-730-7135

DATE:
3/16/2016

SCALE:

SHEET:

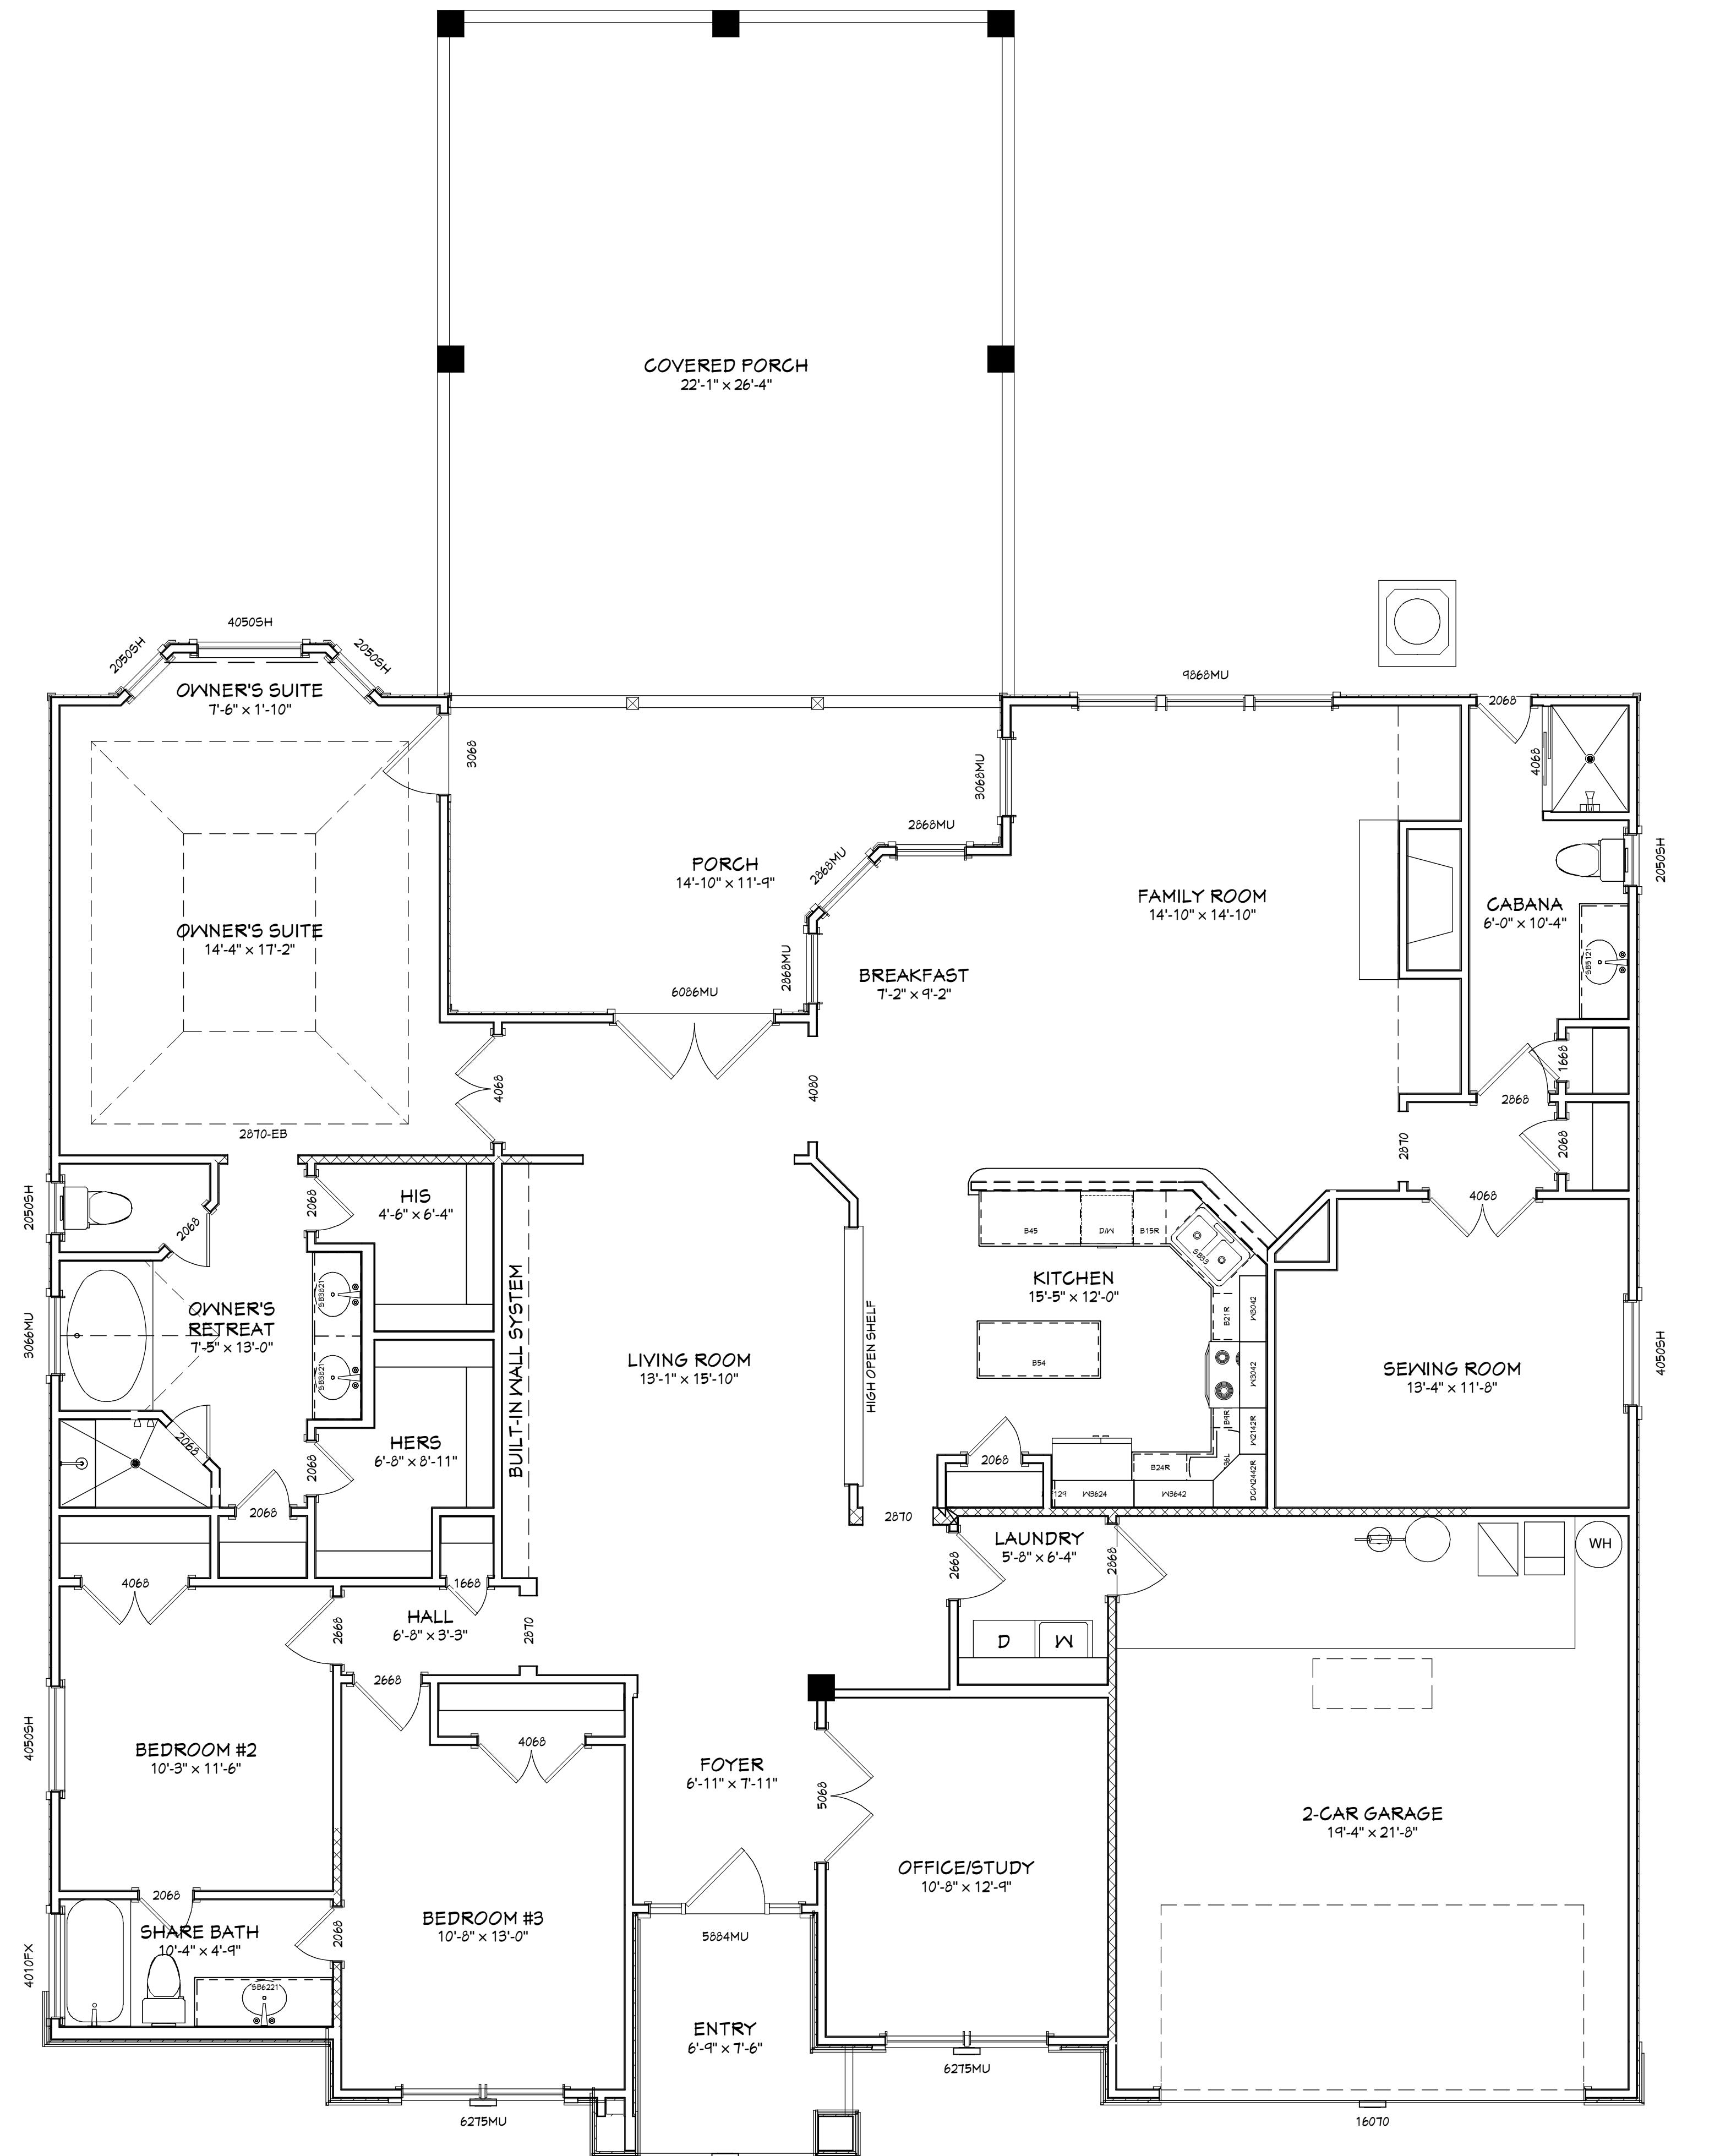

AS-BUILT FLOOR PLAN

**PLAN #
2461**

BUILT BY:
Pickett Construction, Inc.
9526 Argyle Forest Blvd.
Jacksonville, FL 32222
CGC1506644


PROJECT DESCRIPTION:
THE GRECO FAMILY
2990 AMELIA BLUFF DRIVE
JACKSONVILLE, FL 32266

Bid Drawings provided by:
Designs for Living, LLC
RESIDENTIAL DESIGN & CONSULTING
SERVING N/E FLORIDA SINCE 1978
904-730-7135

DATE:
3/16/2016

SCALE:
1/4" = 1'-0"

SHEET:
A-5

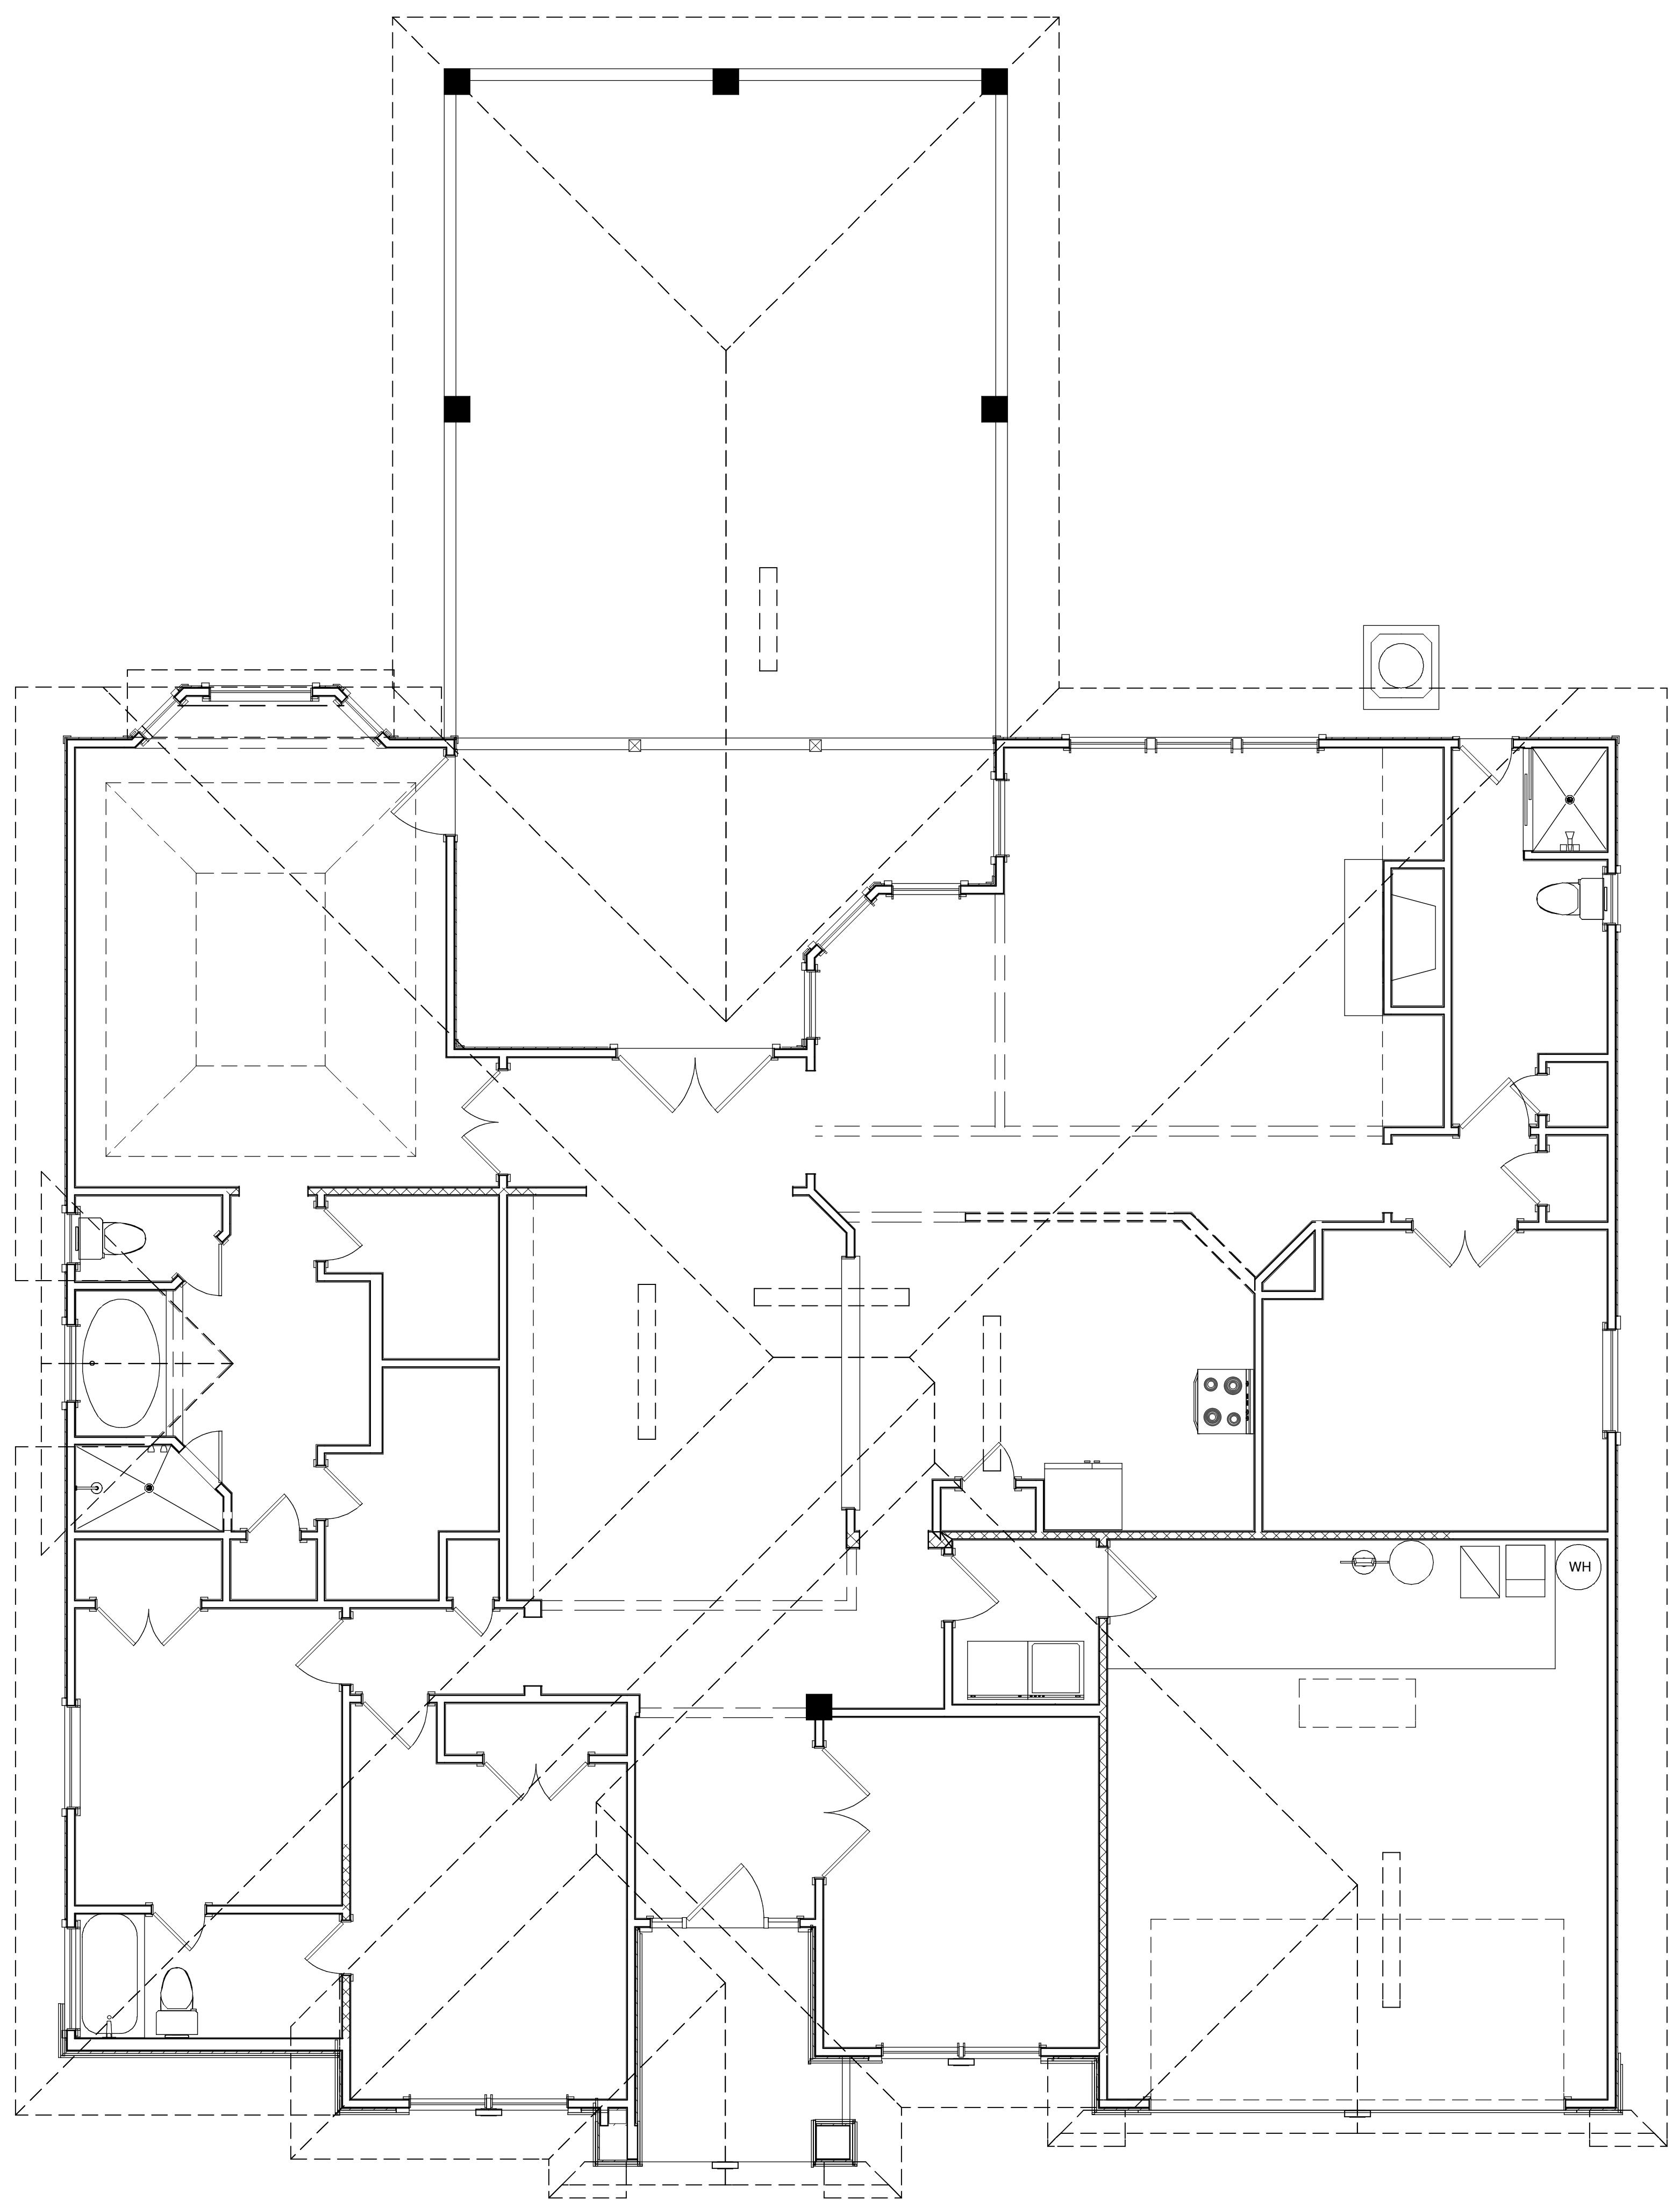

AS-BUILT ROOF PLAN

COPYRIGHT 2016 - DESIGNS FOR LIVING, LLC. Under Federal Statute HR 5490 of the Architectural Drawing Act & Title 17 specific copyright laws apply to all published works of Designs for Living, LLC, herein referred to as Designer. It is unlawful for anyone to copy these drawings, either in whole or in part, without the express written permission of the designer! The use of any plans, specifications, electronic or hard copy prints shall be restricted to the original site for which they were prepared and publication thereof is expressly limited to such use. Title to all works, specifically all drawings, specifications and modified derivatives of any blueprints, series, drawings or specifications remain the designer's without prejudice. VISUAL CONTACT with any of these drawings, or their purchase, constitutes prima facie evidence of the acceptance of these restrictions! This has held precedent in the North Florida Court system! Any and all violations WILL result in legal action being taken and litigated damages to the full extent allowed by law! No exceptions and no excuses! Contractor &/or owner shall verify all dimensions, details & specifications prior to construction. 

**PLAN #
2461**

Pickett Construction, Inc.
9526 Argyle Forest Blvd.
Jacksonville, FL 32222
CGC1506644

PROJECT DESCRIPTION:
THE GRECO FAMILY
2990 AMELIA BLUFF DRIVE
JACKSONVILLE, FL 32266

Bid Drawings provided by:
Designs for Living, LLC
RESIDENTIAL DESIGN & CONSULTING
SERVING N/E FLORIDA SINCE 1978
904-730-7135

DATE:
3/16/2016

SCALE:

1/4" = 1'-0"

SHEET:

A-6

COPYRIGHT 2016 - DESIGNS FOR LIVING, LLC. Under Federal Statute HR 5490 of the Architectural Drawing Act & Title 17 specific copyright laws apply to all published works of Designs for Living, LLC, herein referred to as Designer. It is unlawful for anyone to copy these drawings, either in whole or in part, without the express written permission of the designer! The use of any plans, specifications, electronic or hard copy prints shall be restricted to the original site for which they were prepared and publication thereof is expressly limited to such use. Title to all works, specifically all drawings, specifications and modified derivatives of any blueprints, series, drawings or specifications remain the designer's without prejudice. VISUAL CONTACT with any of these drawings, or their purchase, constitutes prima facie evidence of the acceptance of these restrictions! This has held precedent in the North Florida Court system! Any and all violations WILL result in legal action being taken and litigated damages to the full extent allowed by law! No exceptions and no excuses! Contractor &/or owner shall verify all dimensions, details & specifications prior to construction. 



Exterior Elevation Back



Exterior Elevation Front

AS-BUILT FRONT/REAR ELEVATIONS

**PLAN #
2461**

BUILT BY:
Pickett Construction, Inc.
9526 Argyle Forest Blvd.
Jacksonville, FL 32222
CGC1506644

PROJECT DESCRIPTION:
THE GRECO FAMILY
2990 AMELIA BLUFF DRIVE
JACKSONVILLE, FL 32266


Bid Drawings provided by:
Designs for Living, LLC
RESIDENTIAL DESIGN & CONSULTING
SERVING N/E FLORIDA SINCE 1978
904-730-7135

DATE:
3/16/2016

SCALE:
1/4" = 1'-0"

SHEET:
A-7

COPYRIGHT 2016 - DESIGNS FOR LIVING, LLC. Under Federal Statute HR 5490 of the Architectural Drawing Act & Title 17 specific copyright laws apply to all published works of Designs for Living, LLC, herein referred to as Designer. It is unlawful for anyone to copy these drawings, either in whole or in part, without the express written permission of the designer! The use of any plans, specifications, electronic or hard copy prints shall be restricted to the original site for which they were prepared and publication thereof is expressly limited to such use. Title to all works, specifically all drawings, specifications and modified derivatives of any blueprints, series, drawings or specifications remain the designer's without prejudice. VISUAL CONTACT with any of these drawings, or their purchase, constitutes prima facie evidence of the acceptance of these restrictions! This has held precedent in the North Florida Court system! Any and all violations will result in legal action being taken and litigated damages to the full extent allowed by law! No exceptions and no excuse! Contractor &/or owner shall verify all dimensions, details & specifications prior to construction. Every attempt has been made to avoid mistakes. The contractor and the owners also fully acknowledge that they have full copyright release approval and that they have fully acknowledged that they have fully acknowledged that they have begun!

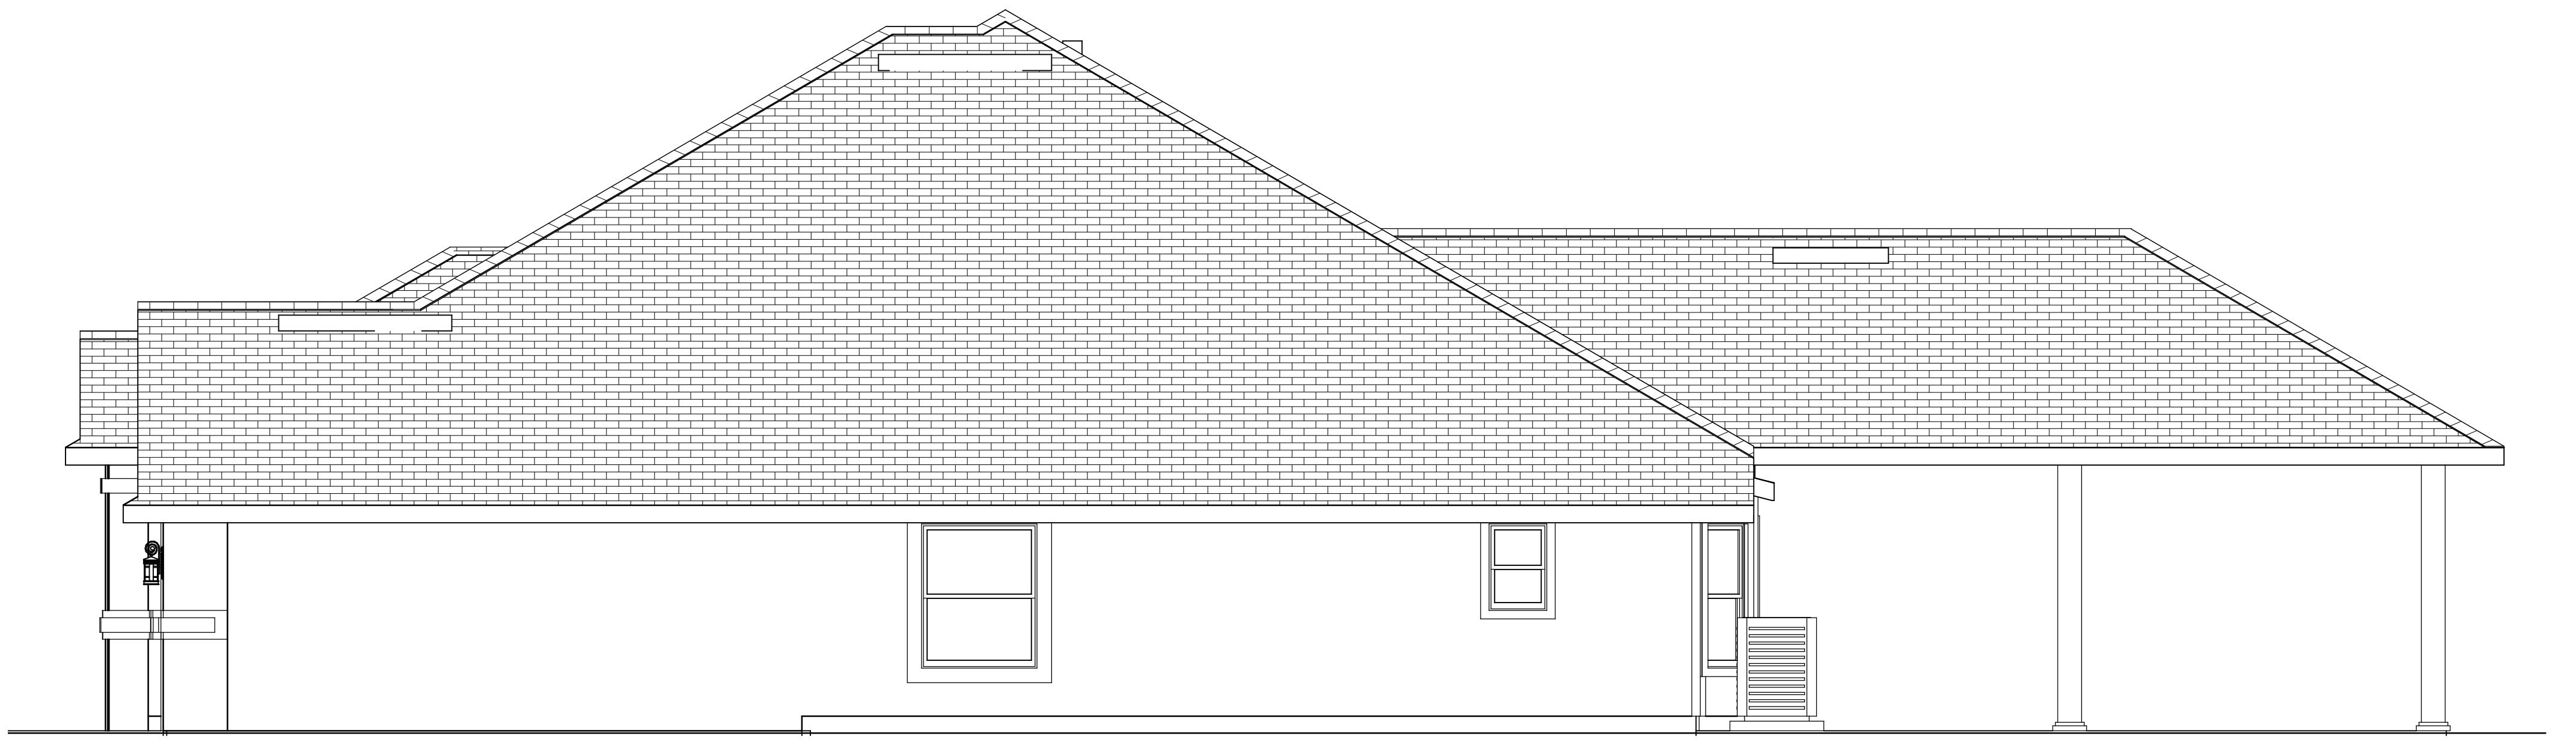

Exterior Elevation Right



Exterior Elevation Left

AS-BUILT SIDE ELEVATIONS

A-7

**PLAN #
2461**

BUILT BY:
Pickett Construction, Inc.
9526 Argyle Forest Blvd.
Jacksonville, FL 32222
CGC1506644

PROJECT DESCRIPTION:
THE GRECO FAMILY
2990 AMELIA BLUFF DRIVE
JACKSONVILLE, FL 32266



Bid Drawings provided by:
Designs for Living, LLC
RESIDENTIAL DESIGN & CONSULTING
SERVING N/E FLORIDA SINCE 1978
904-730-7135

DATE:
3/16/2016

SCALE:
N.T.S.

SHEET:
A-8

COPYRIGHT 2016 - DESIGNS FOR LIVING, LLC. Under Federal Statute HR 5490 of the Architectural Drawing Act & Title 17 specific copyright laws apply to all published works of Designs for Living, LLC, herein referred to as Designer. It is unlawful for anyone to copy these drawings, either in whole or in part, without the express written permission of the designer! The use of any plans, specifications, electronic or hard copy prints shall be restricted to the original site for which they were prepared and publication thereof is expressly limited to such use. Title to all works, specifically all drawings, specifications and modified derivatives of any blueprints, series, drawings or specifications remain the designers without prejudice. VISUAL CONTACT with any of these drawings, or their purchase, constitutes prima facie evidence of the acceptance of these restrictions! This has held precedent in the North Florida Court system! Any and all violations WILL result in legal action being taken and litigated damages to the full extent allowed by law! No exceptions and no excuse! Contractor &/or owner shall verify all dimensions, details & specifications prior to construction. 

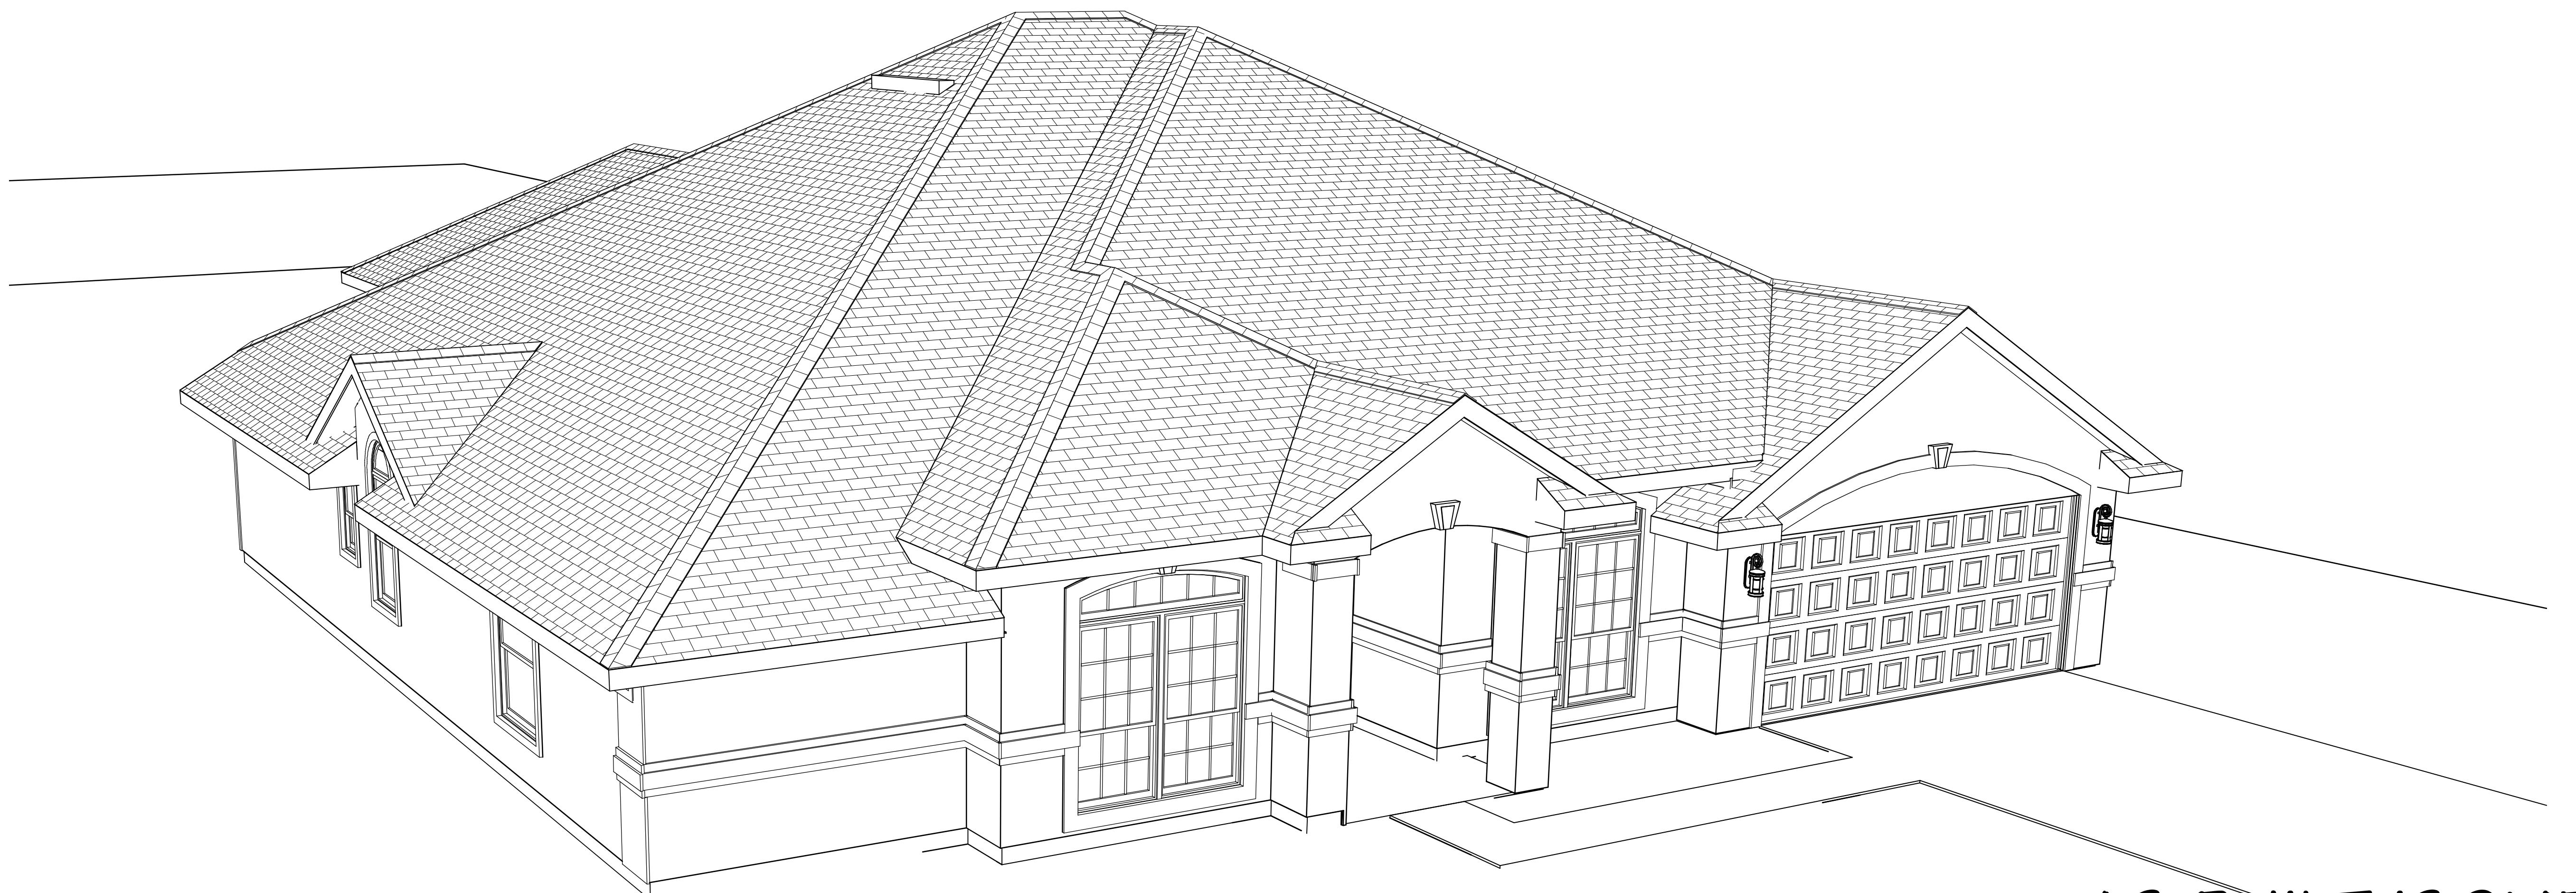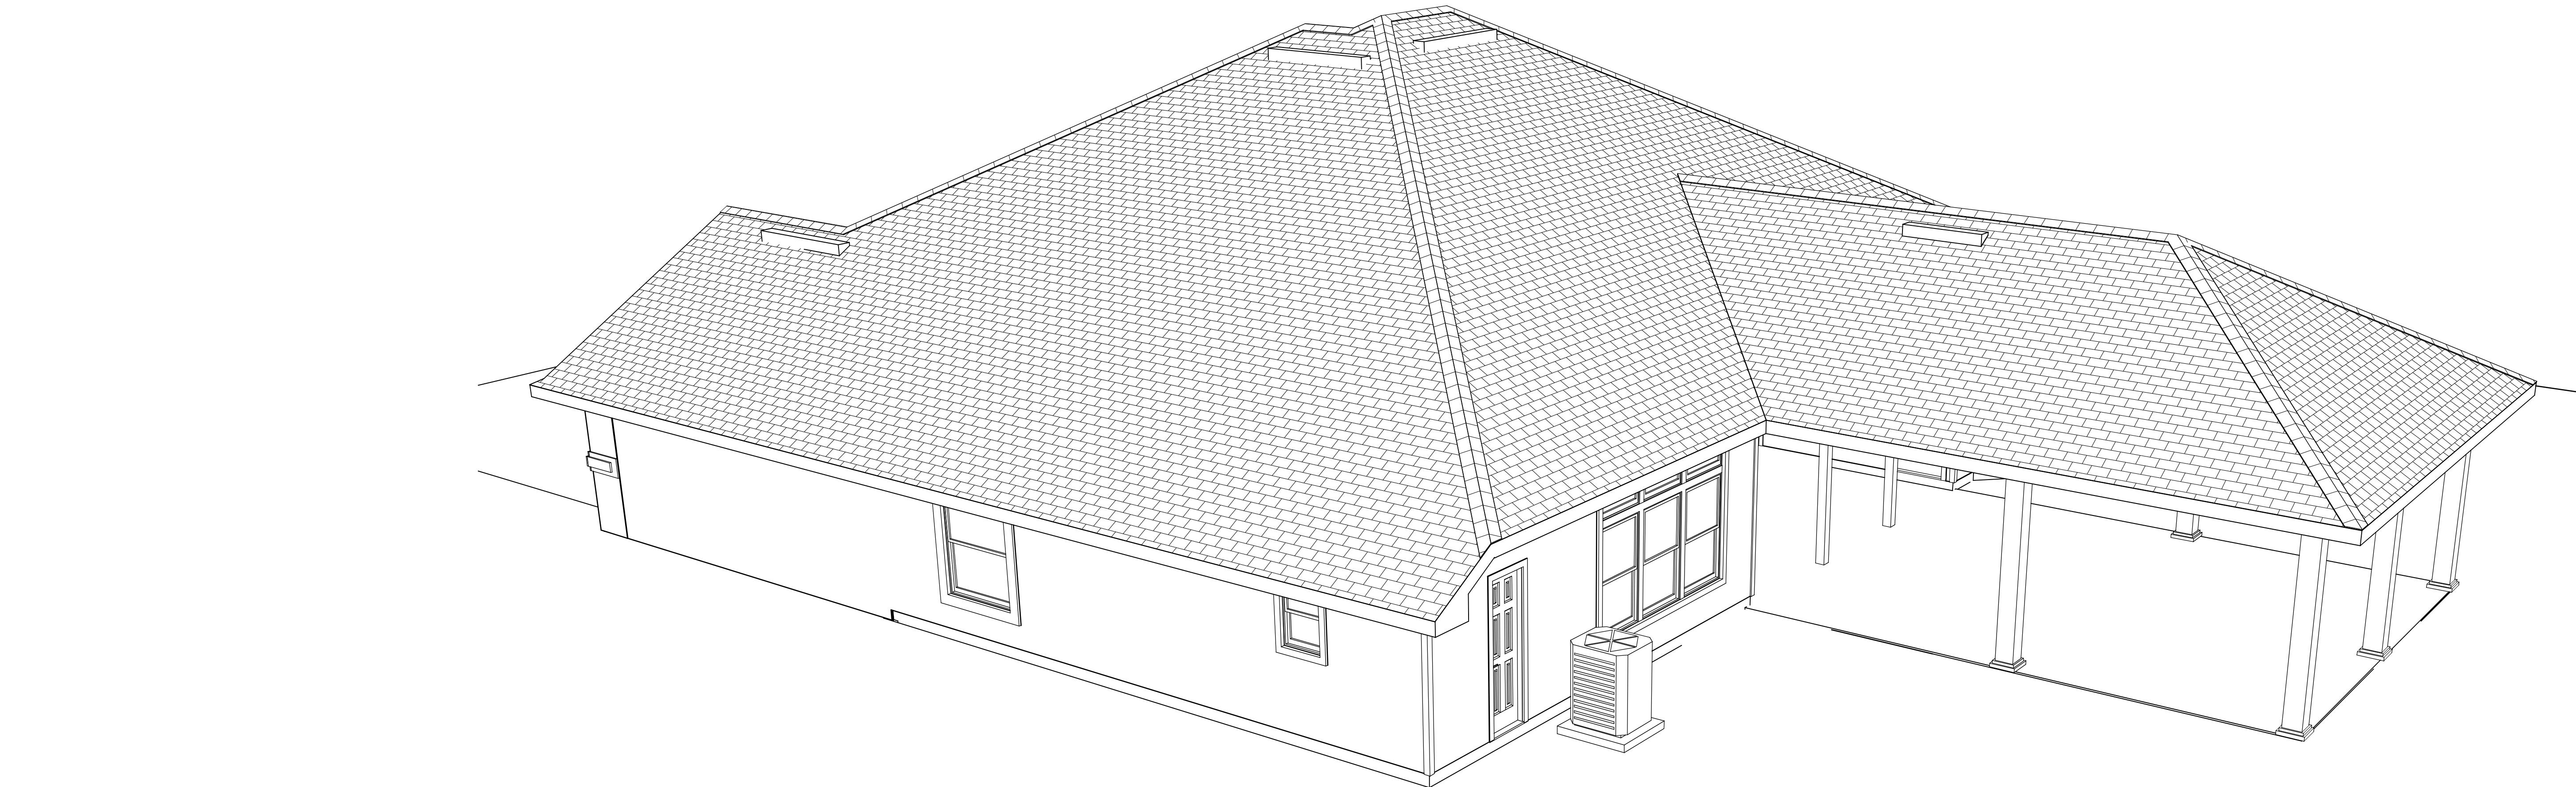

AS-BUILT ISOMETRICS

PLAN #

2461

35
ickett Construction, Inc.
0526 Argyle Forest Blvd.
Jacksonville, FL 32222
CGC1506644


PROJECT DESCRIPTION:
THE GRECO FAMILY
2990 AMELIA BLUFF DRIVE
, JACKSONVILLE, FL 32266

drawings provided by:
desiGns for Living, LL
RESIDENTIAL DESIGN & CONSULTING
SINCE 1969
SERVING N/E FLORIDA SINCE 1978
904-730-7135


DATE:
3/16/2016

SCALE:

SHEET:

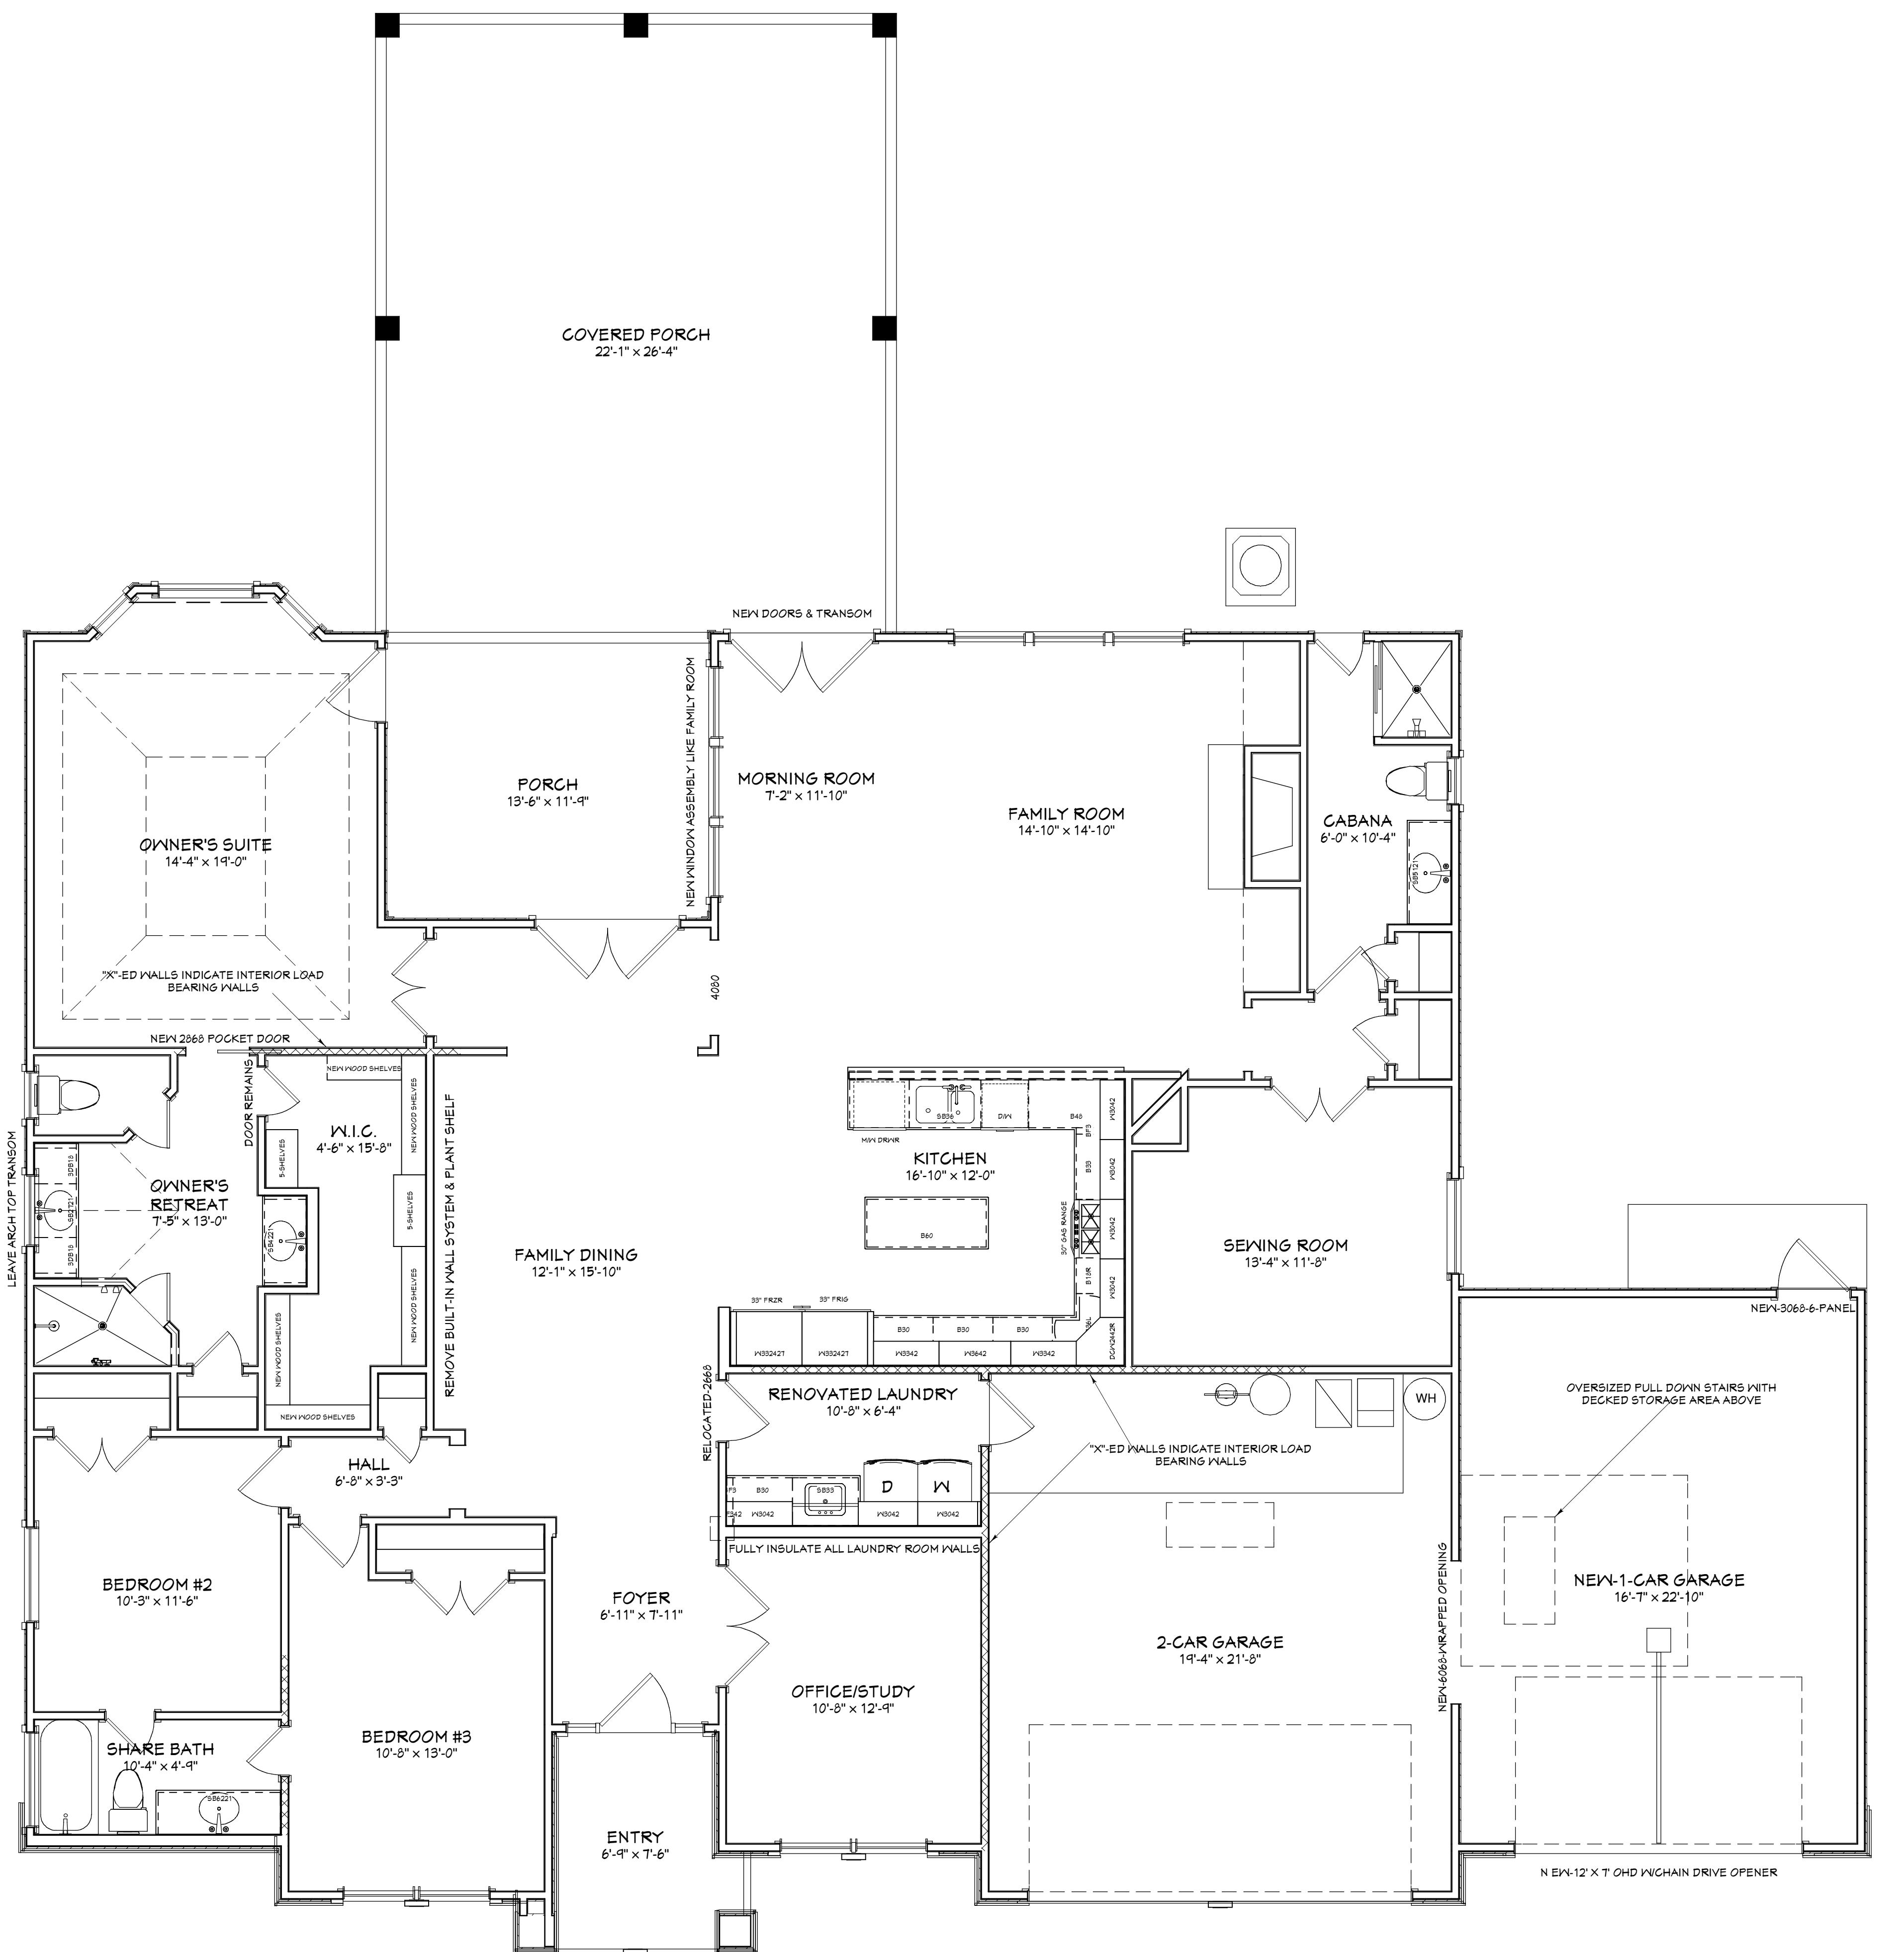

PROPOSED PLAN

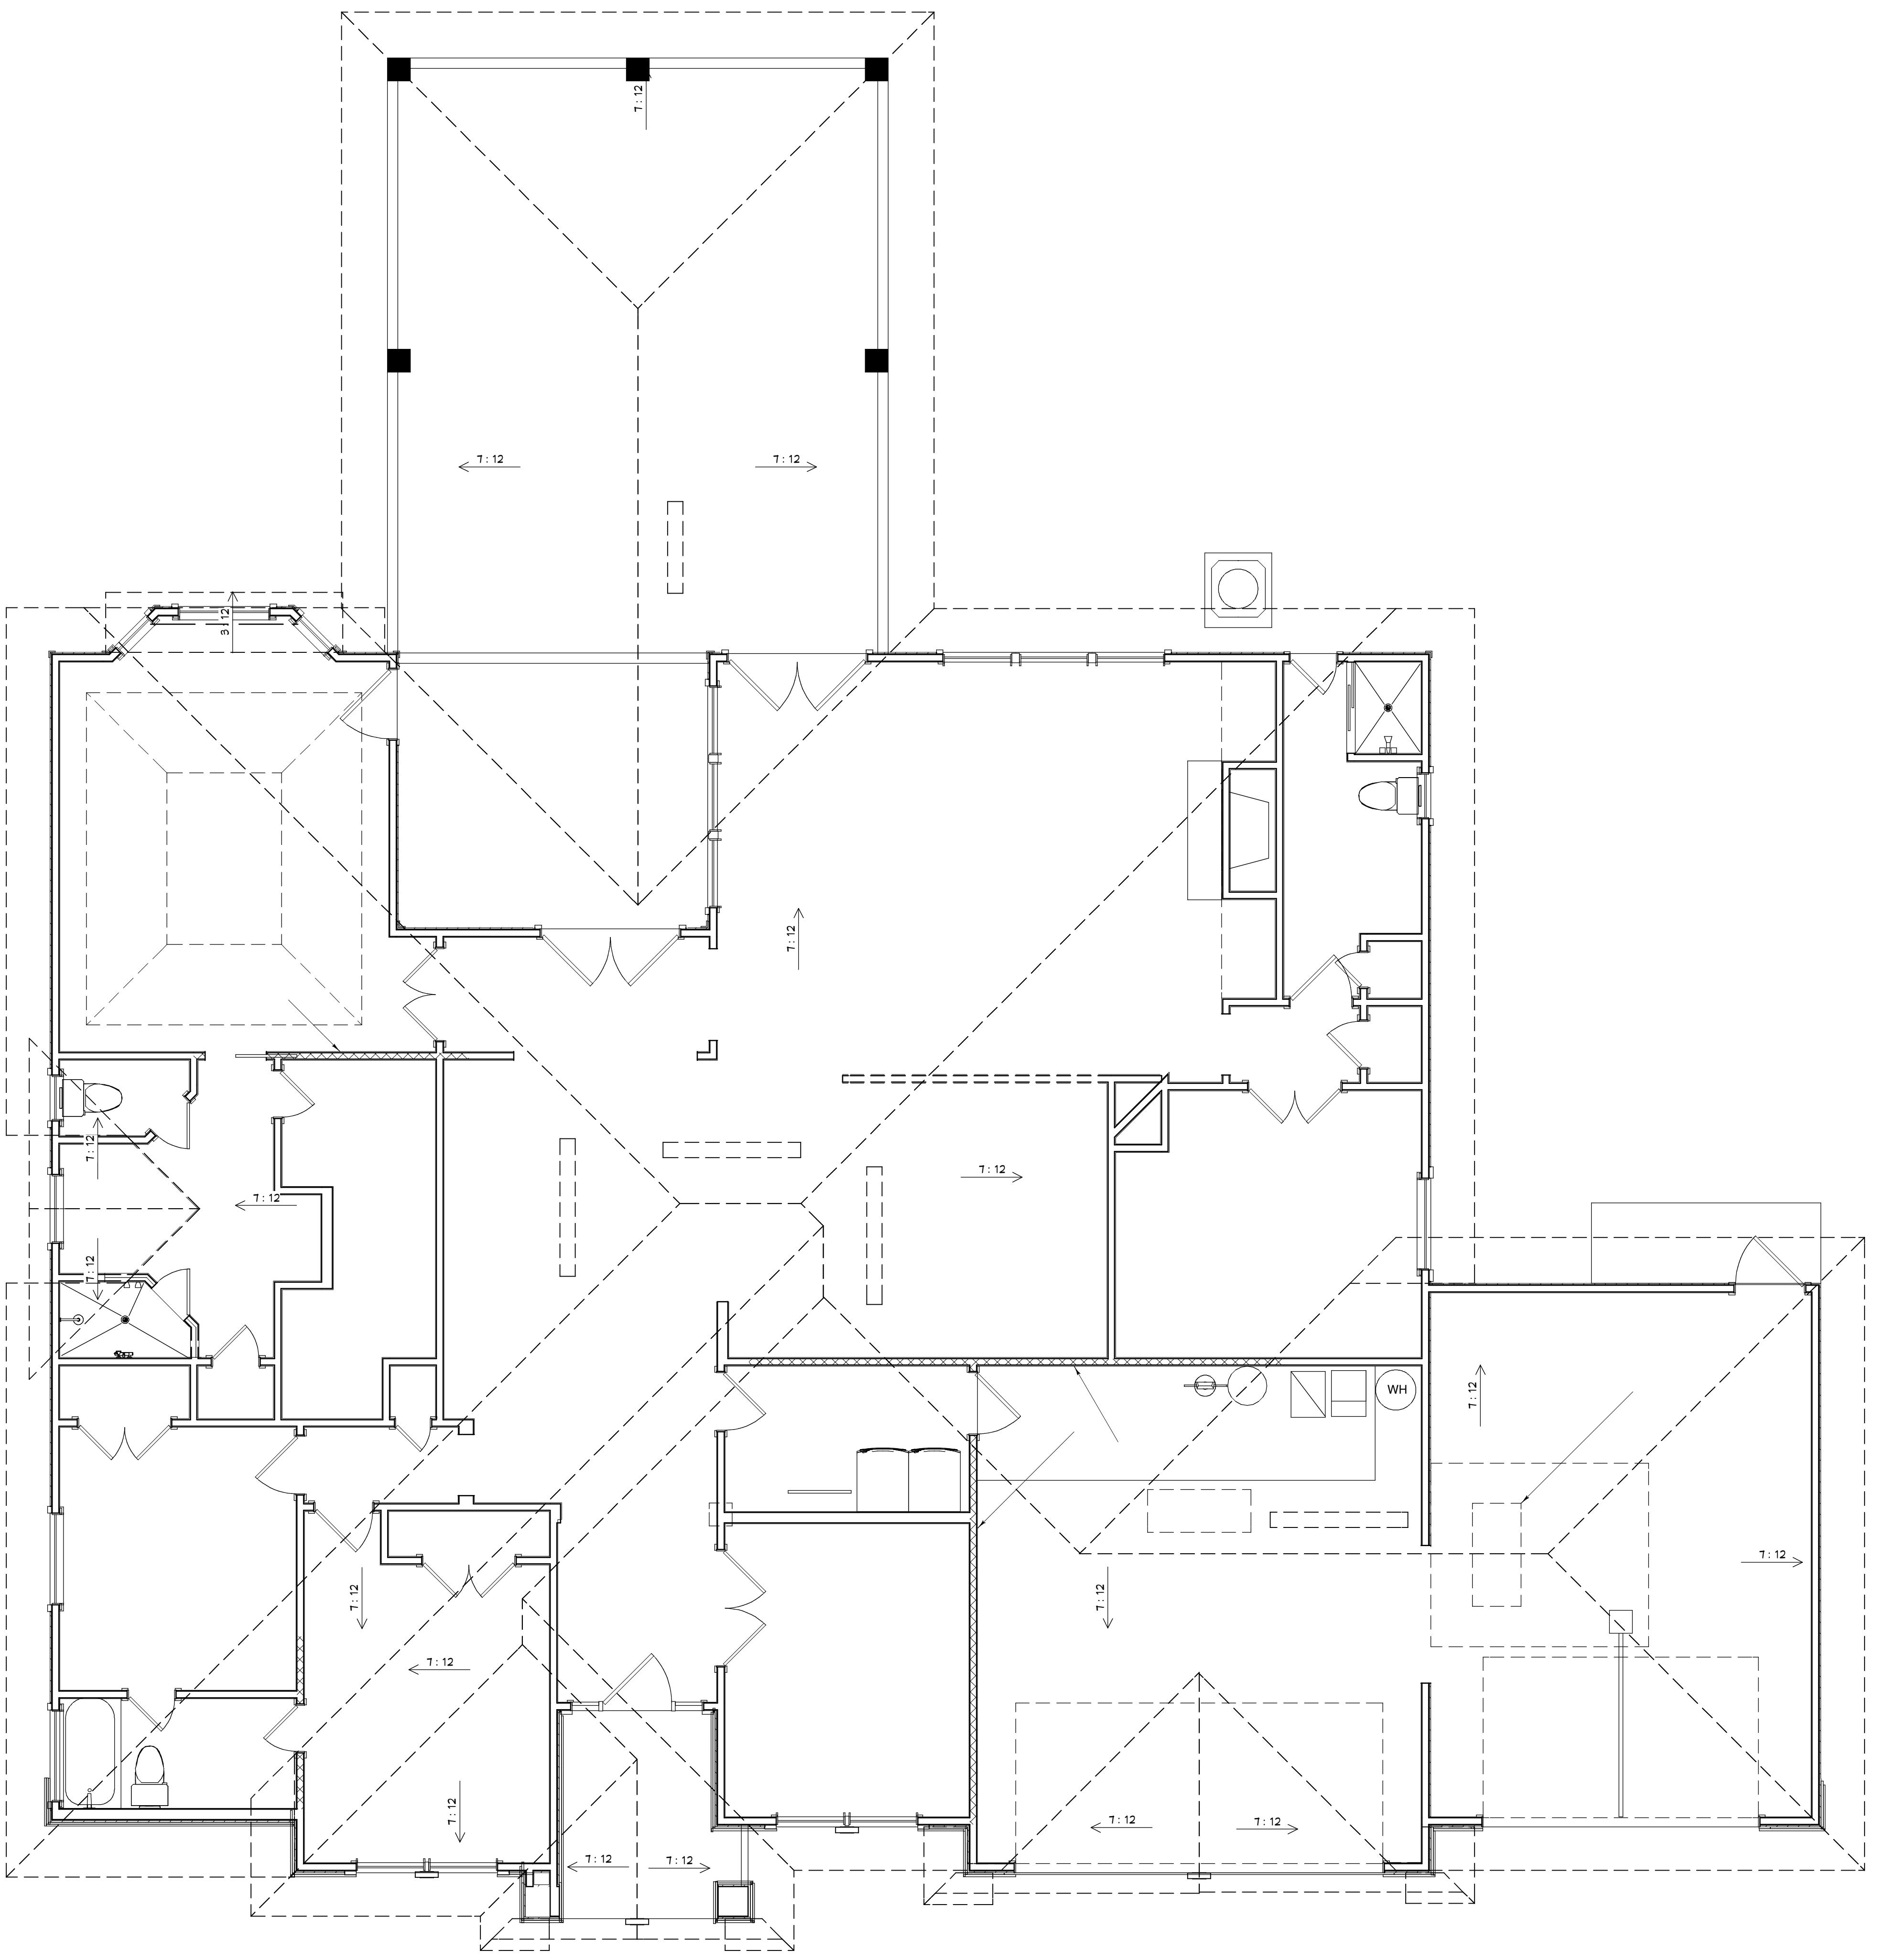

PROPOSED ROOF PLAN

COPYRIGHT 2016 - DESIGNS FOR LIVING, LLC. Under Federal Statute HR 5490 of the Architectural Drawing Act & Title 17 specific copyright laws apply to all published works of Designs for Living, LLC, herein referred to as Designer. It is unlawful for anyone to copy these drawings, either in whole or in part, without the express written permission of the designer! The use of any plans, specifications, electronic or hard copy prints shall be restricted to the original site for which they were prepared and publication thereof is expressly limited to such use. Title to all works, specifically all drawings, specifications, and modified derivatives of any blueprints, series, drawings, or specifications remain the designer's without prejudice. VISUAL CONTACT with any of these drawings, or their purchase, constitutes prima facie evidence of the acceptance of these restrictions! This has held precedent in the North Florida Court system! Any and all violations WILL result in legal action being taken and litigated damages to the full extent allowed by law! No exceptions and no excuse! Contractor &/or owner shall verify all dimensions, details, & specifications prior to construction. 

PLAN # 2461			
NO.	DESCRIPTION	BY	DATE

BUILT BY:	Pickett Construction, Inc.
PROJECT DESCRIPTION:	THE GRECO FAMILY 2990 AMELIA BLUFF DRIVE JACKSONVILLE, FL 32266
Designs for Living, LLC	RESIDENTIAL DESIGN & CONSULTING SERVING N/E FLORIDA SINCE 1978 904-730-7135
DATE:	3/16/2016
SCALE:	1/4" = 1'-0"
SHEET:	A-10

**PLAN #
2461**

NO.	DESCRIPTION	BY	DATE

BUILT BY:
Pickett Construction, Inc.
9526 Argyle Forest Blvd.
Jacksonville, FL 32222
CGC1506644

PROJECT DESCRIPTION:
THE GRECO FAMILY
2990 AMELIA BLUFF DRIVE
JACKSONVILLE, FL 32266

Bid Drawings provided by:
Designs for Living, LLC
RESIDENTIAL DESIGN & CONSULTING
SERVING N/E FLORIDA SINCE 1960
904-730-7135

DATE:
3/16/2016

SCALE:
1/4" = 1'-0"

SHEET:
A-11

COPYRIGHT 2016 - DESIGNS FOR LIVING, LLC. Under Federal Statute HR 5490 of the Architectural Drawing Act & Title 17 specific copyright laws apply to all published works of Designs for Living, LLC, herein referred to as Designer. It is unlawful for anyone to copy these drawings, either in whole or in part, without the express written permission of the designer! The use of any plans, specifications, electronic or hard copy prints shall be restricted to the original site for which they were prepared and publication thereof is expressly limited to such use. Title to all works, specifically all drawings, specifications, and modified derivatives of any blueprints, series, drawings, or specifications remain the designers without prejudice. VISUAL CONTACT with any of these drawings, or their purchase, constitutes prima facie evidence of the acceptance of these restrictions! This has held precedent in the North Florida Court system. Any and all violations WILL result in legal action being taken and litigated damages to the full extent allowed by law! No exceptions and no excuses! Contractor &/or owner shall verify all dimensions, details & specifications prior to construction. 



Exterior Elevation Back



Exterior Elevation Front

PROPOSED FRONT/REAR ELEVATIONS

A-11

**PLAN #
2461**

BUILT BY:
Pickett Construction, Inc.
9526 Argyle Forest Blvd.
Jacksonville, FL 32222
CGC1506644

PROJECT DESCRIPTION:
THE GRECO FAMILY
2990 AMELIA BLUFF DRIVE
JACKSONVILLE, FL 32266


Bid Drawings provided by:
Designs for Living, LLC
RESIDENTIAL DESIGN & CONSULTING
SERVING N/E FLORIDA SINCE 1960
904-730-7135

DATE:
3/16/2016


SCALE:
1/4" = 1'-0"

SHEET:
A-12

COPYRIGHT 2016 - DESIGNS FOR LIVING, LLC. Under Federal Statute HR 5490 of the Architectural Drawing Act & Title 17 specific copyright laws apply to all published works of Designs for Living, LLC, herein referred to as Designer. It is unlawful for anyone to copy these drawings, either in whole or in part, without the express written permission of the designer! The use of any plans, specifications, electronic or hard copy prints shall be restricted to the original site for which they were prepared and publication thereof is expressly limited to such use. Title to all works, specifically all drawings, specifications and modified derivatives of any blueprints, series, drawings or specifications remain the designer's without prejudice. VISUAL CONTACT with any of these drawings, or their purchase, constitutes prima facie evidence of the acceptance of these restrictions! This has held precedent in the North Florida Court system! Any and all violations WILL result in legal action being taken and litigated damages to the full extent allowed by law! No exceptions and no excuses! Contractor &/or owner shall verify all dimensions, details & specifications prior to construction. Every attempt has been made to avoid mistakes. The contractor and the owners also fully acknowledge that they have full copyright release approval and that they have fully acknowledged that they have begun!

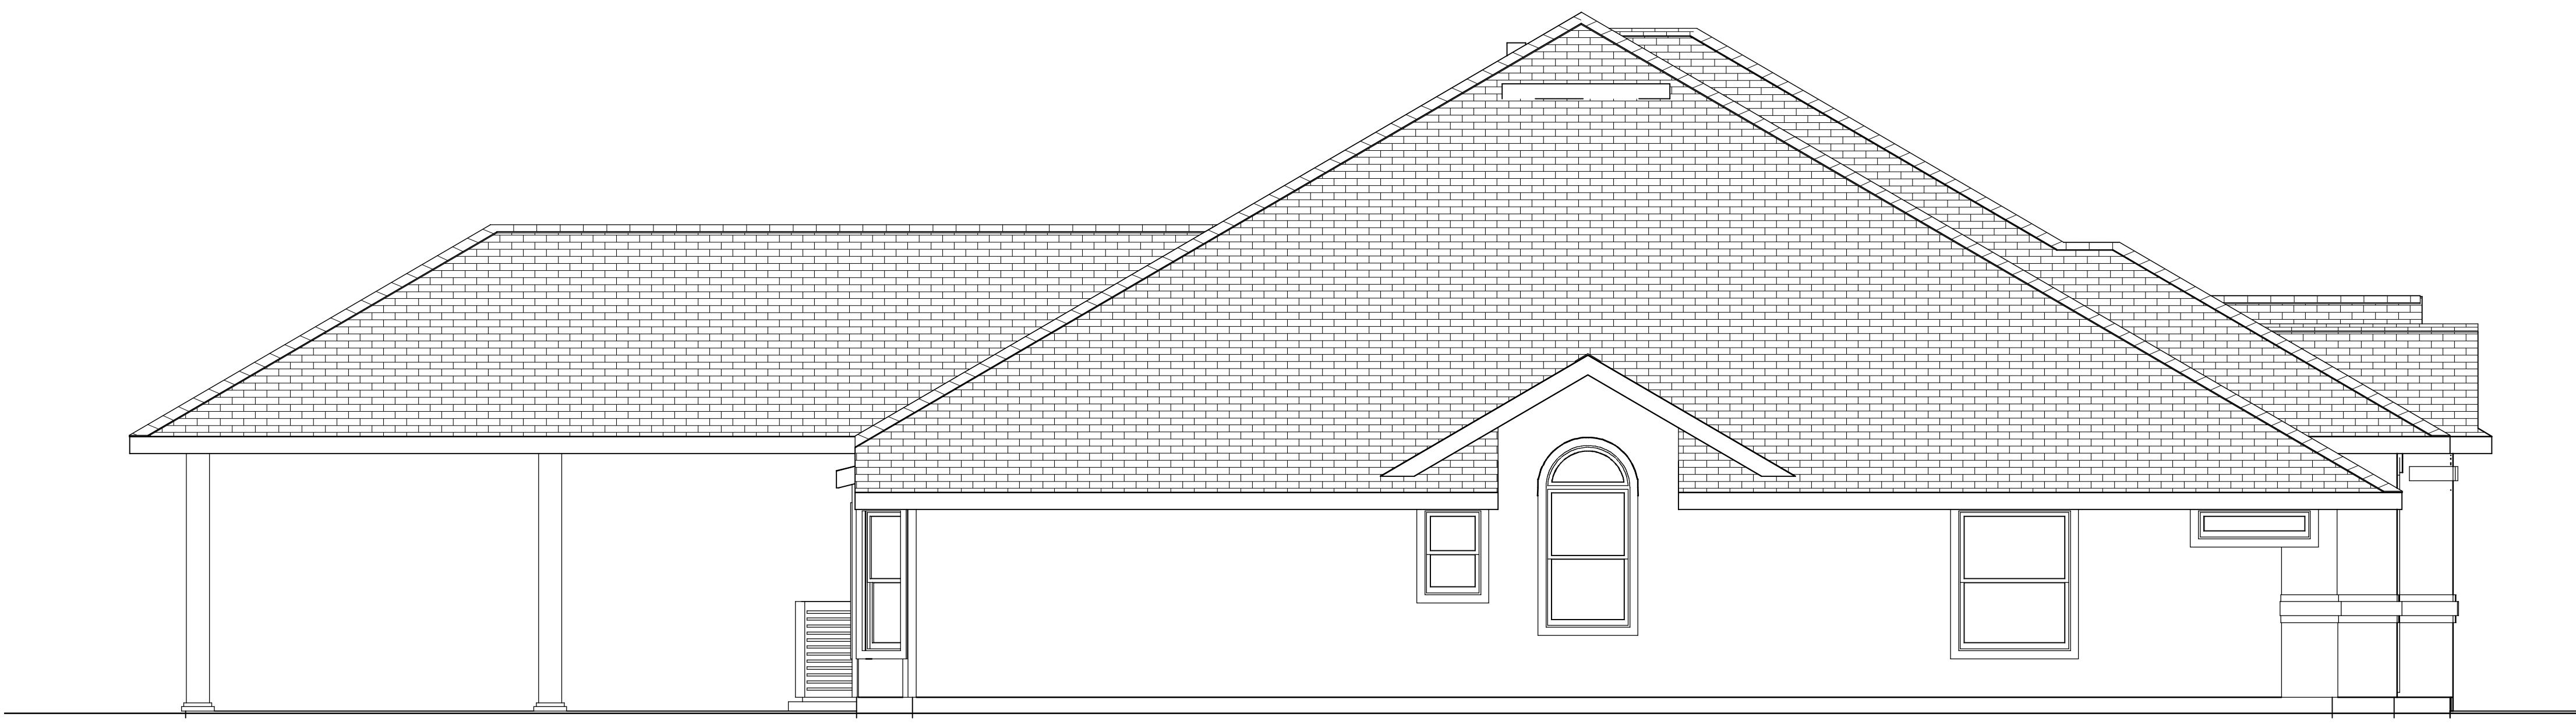

Exterior Elevation Left

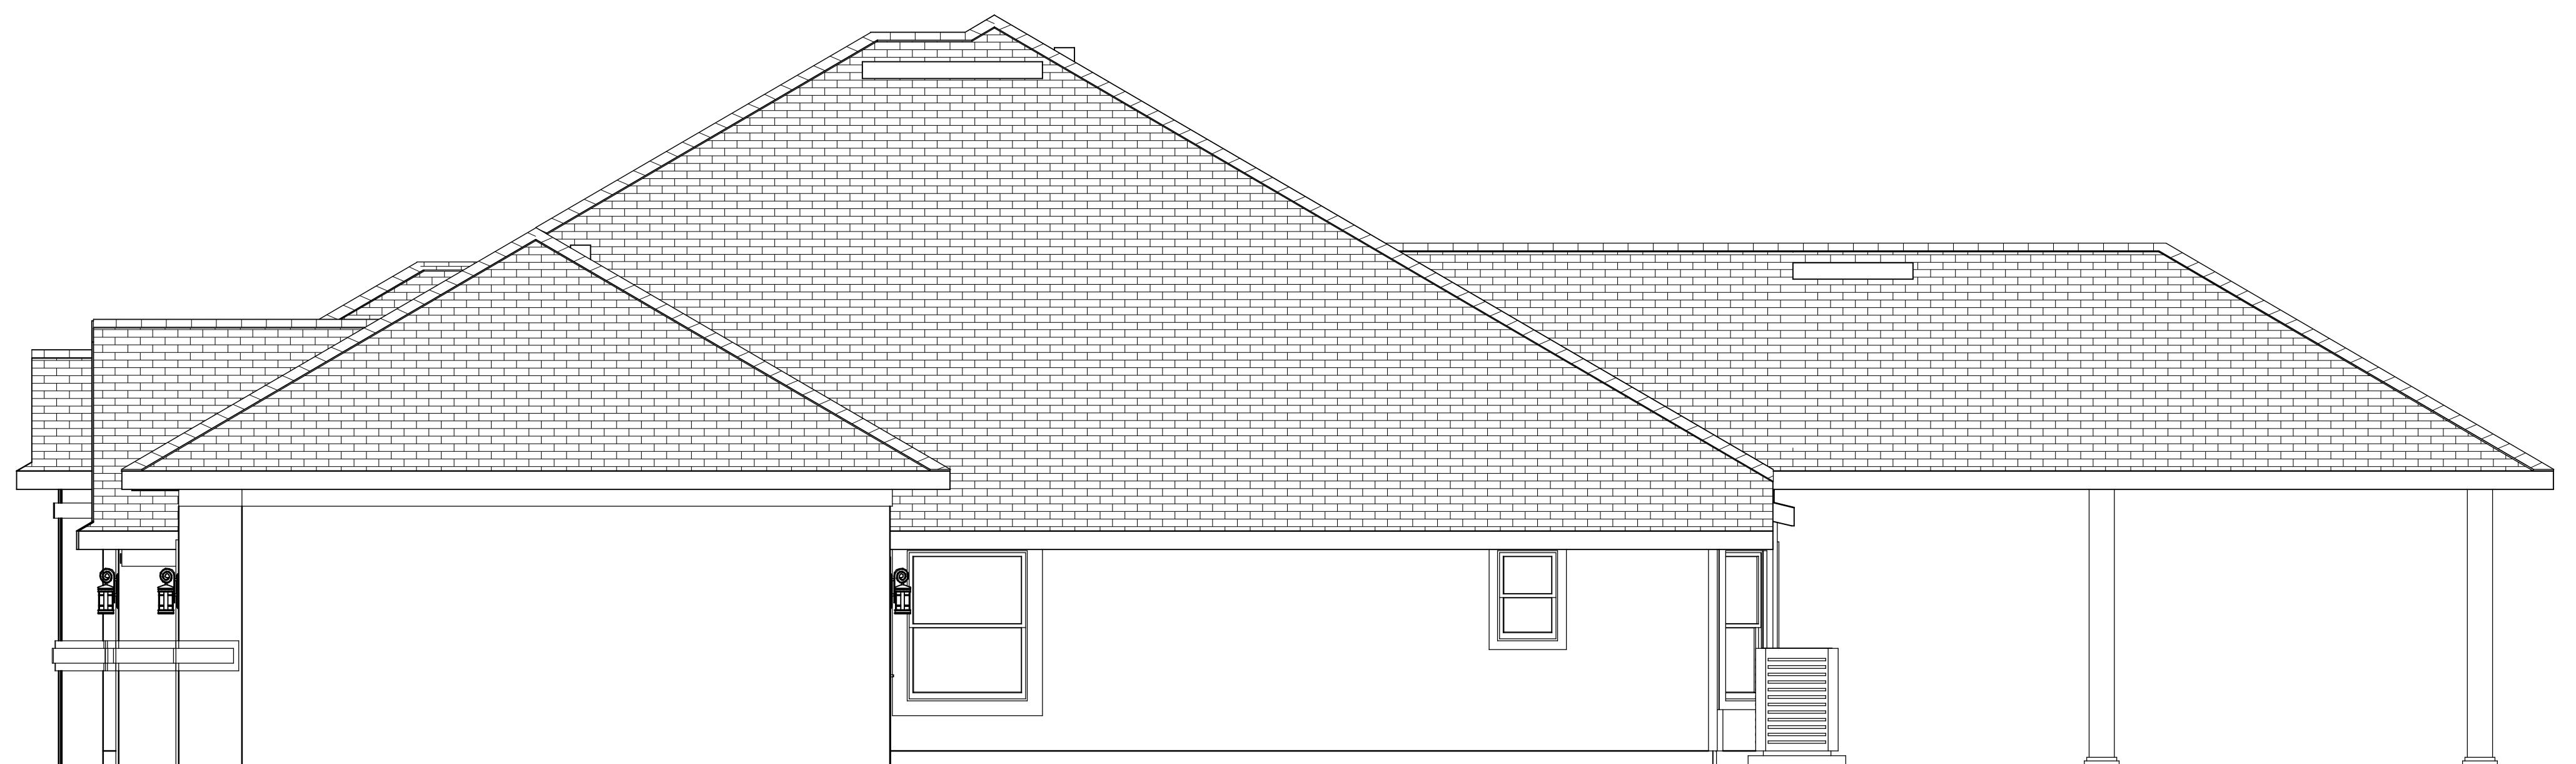

Exterior Elevation Right

PROPOSED SIDE ELEVATIONS

**PLAN #
2461**

NO. DESCRIPTION BY DATE

BUILT BY:
Pickett Construction, Inc.
9526 Argyle Forest Blvd.
Jacksonville, FL 32222
CGC1506644

PROJECT DESCRIPTION:
THE GRECO FAMILY
2990 AMELIA BLUFF DRIVE
JACKSONVILLE, FL 32266



Bid Drawings provided by:
Designs for Living, LLC
RESIDENTIAL DESIGN & CONSULTING
SERVING N/E FLORIDA SINCE 1978
904-730-7135

DATE:
3/16/2016

SCALE:
N.T.S.

SHEET:
A-13

COPYRIGHT 2016 - DESIGNS FOR LIVING, LLC. Under Federal Statute HR 5490 of the Architectural Drawing Act & Title 17 specific copyright laws apply to all published works of Designs for Living, LLC, herein referred to as Designer. It is unlawful for anyone to copy these drawings, either in whole or in part, without the express written permission of the designer! The use of any plans, specifications, electronic or hard copy prints shall be restricted to the original site for which they were prepared and publication thereof is expressly limited to such use. Title to all works, specifically all drawings, specifications, and modified derivatives of any blueprints, series, drawings, or specifications remain the designer's without prejudice. VISUAL CONTACT with any of these drawings, or their purchase, constitutes prima facie evidence of the acceptance of these restrictions! This has held precedent in the North Florida Court system. Any and all violations WILL result in legal action being taken and litigated damages to the full extent allowed by law! No exceptions and no excuse! Contractor &/or owner shall verify all dimensions, details & specifications prior to construction. Every attempt has been made to avoid mistakes. The contractor and the owners also fully acknowledge that they have full copyright release approval and liability released for any errors after delivery via email of drawings, including after construction has begun!

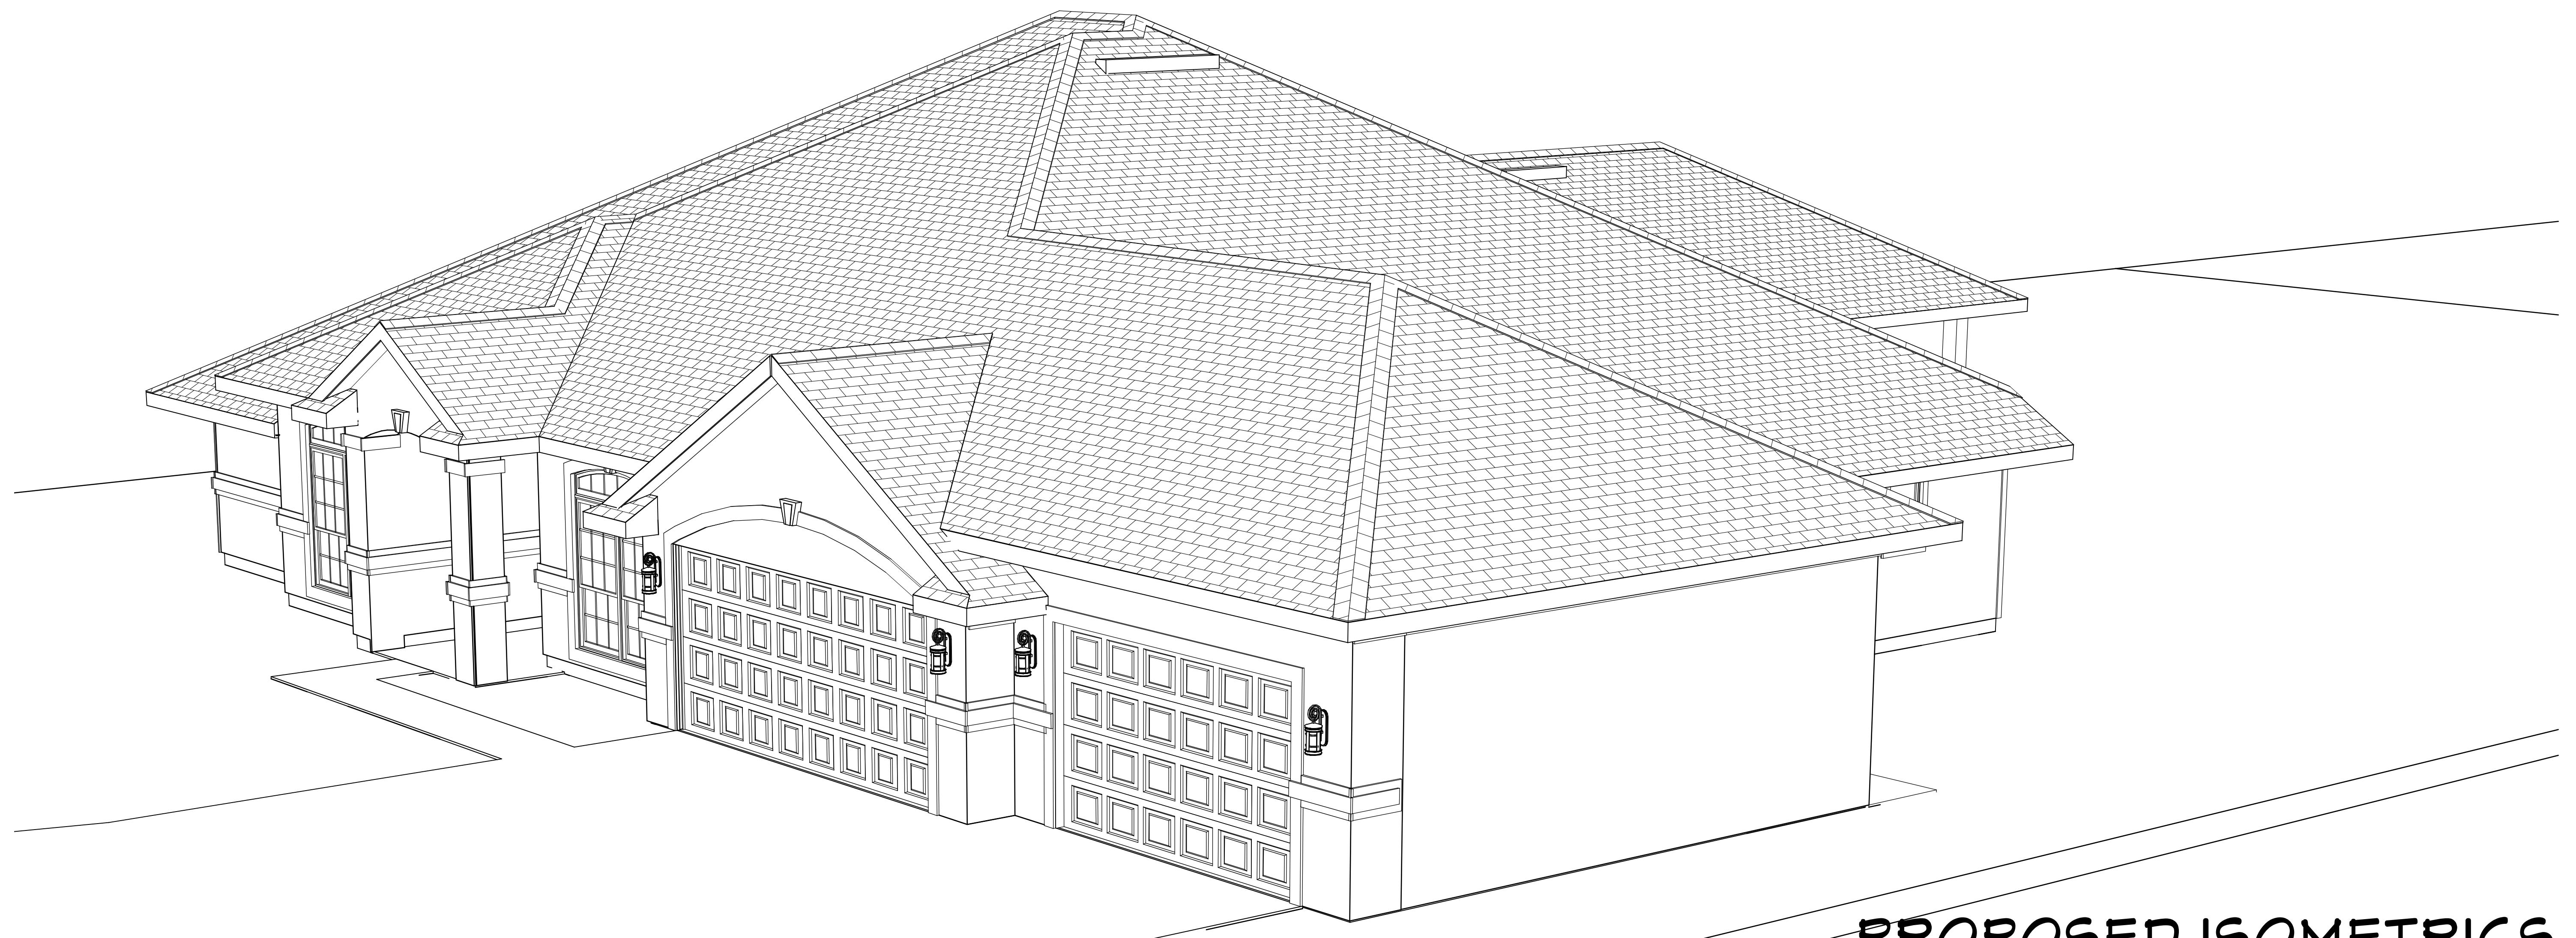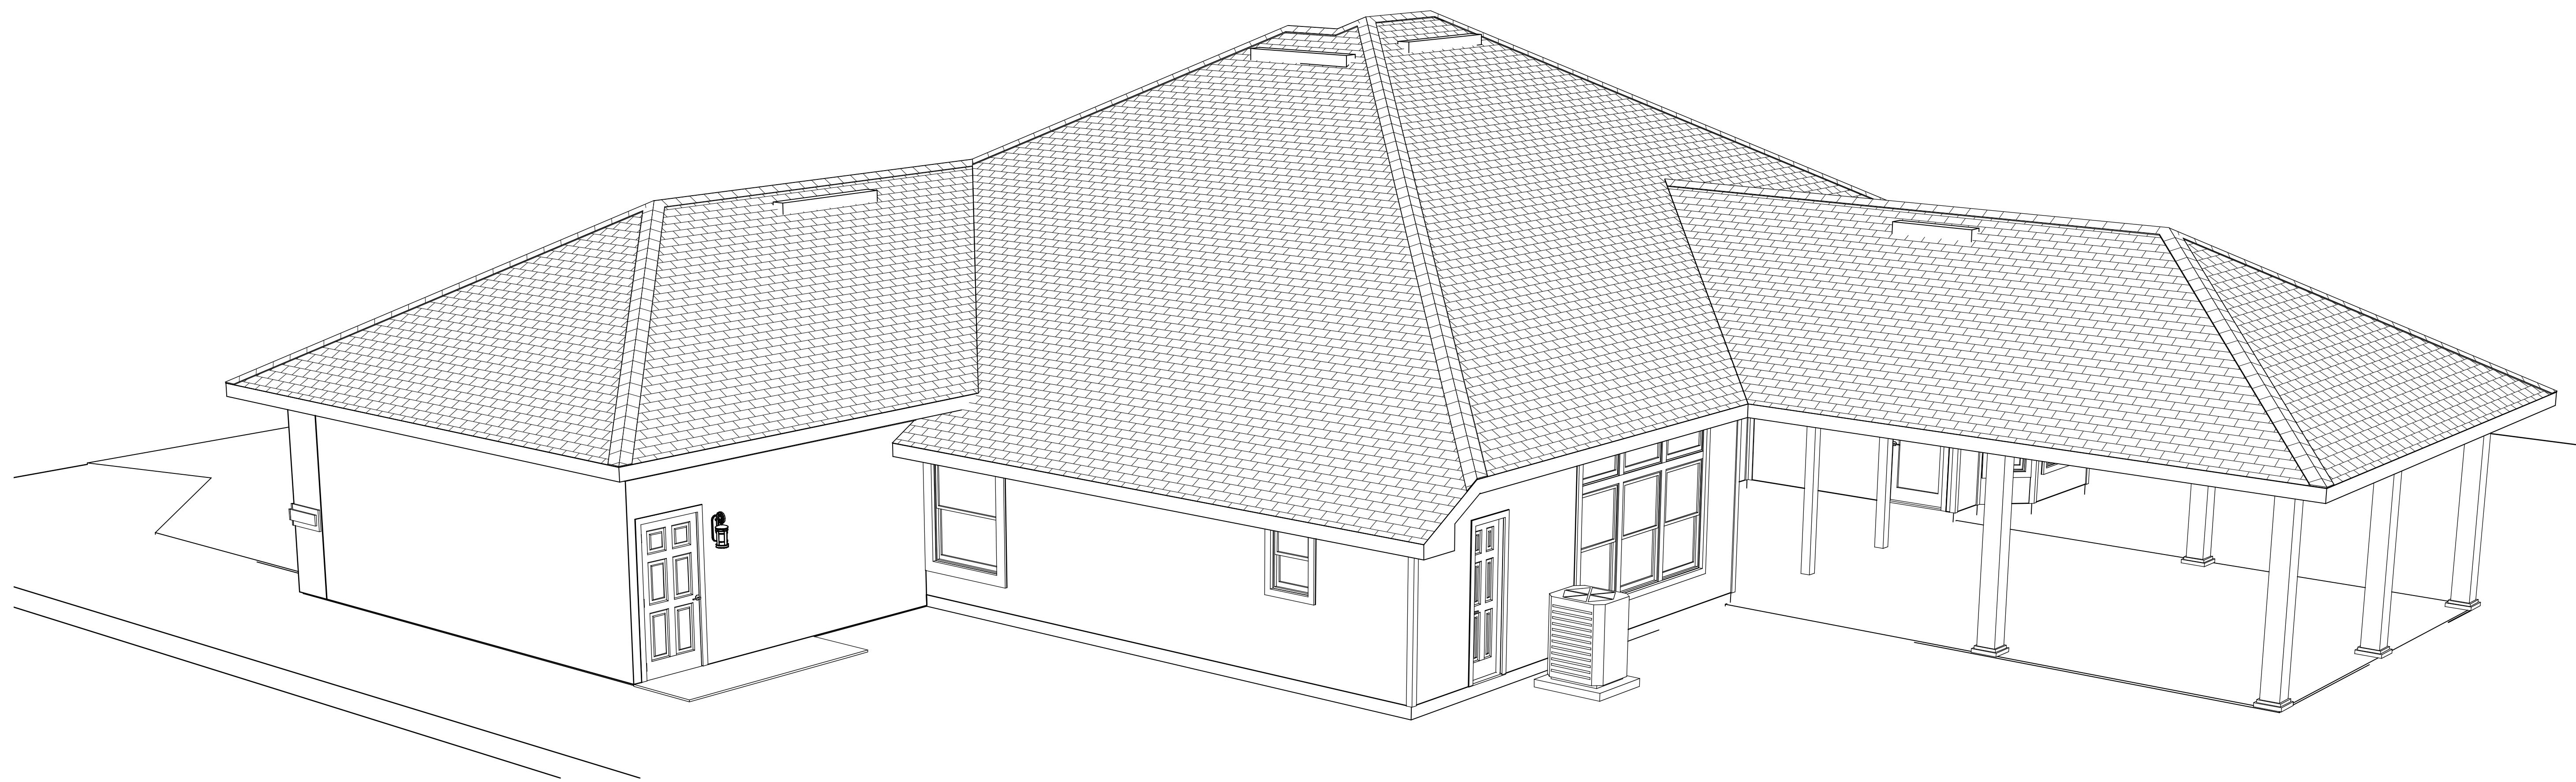

PROPOSED ISOMETRICS

NO.	DESCRIPTION	BY	DATE

BUILT BY:
Pickett Construction, Inc.
 9526 Argyle Forest Blvd.
 Jacksonville, FL 32222
 CGC1506644

PROJECT DESCRIPTION:
THE GRECO FAMILY
 2990 AMELIA BLUFF DRIVE
 JACKSONVILLE, FL 32266

Bid Drawings provided by:
Designs for Living, LLC
 RESIDENTIAL DESIGN & CONSULTING
 SERVING N/E FLORIDA SINCE 1978
 904-730-7135


DATE:
 3/16/2016

SCALE:
 1/4" = 1'-0"

SHEET:
A-14

PROPOSED ELECTRICAL PLAN

ELECTRICAL - DATA - AUDIO LEGEND	
SYMBOL	DESCRIPTION
	Ceiling Fan
	Ventilation Fans: Ceiling Mounted, Wall Mounted
	Ceiling Mounted Light Fixtures: Surface/Pendant, Recessed, Heat Lamp, Low Voltage
	Wall Mounted Light Fixtures: Flush Mounted, Wall Sconce
	Chandelier Light Fixture
	Fluorescent Light Fixture
	240V Receptacle
	110V Receptacles: Duplex, Weather Proof, GFCI
	Switches: Single Pole, Weather Proof, 3-Way, 4-Way
	Switches: Dimmer, Timer
	Audio Video: Control Panel, Switch
	Speakers: Ceiling Mounted, Wall Mounted
	Wall Jacks: CAT5, CAT5 + TV, TV/Cable
	Telephone Jack
	Intercom
	Thermostat
	Door Chime, Door Bell Button
	Smoke Detectors: Ceiling Mounted, Wall Mounted
	Electrical Breaker Panel

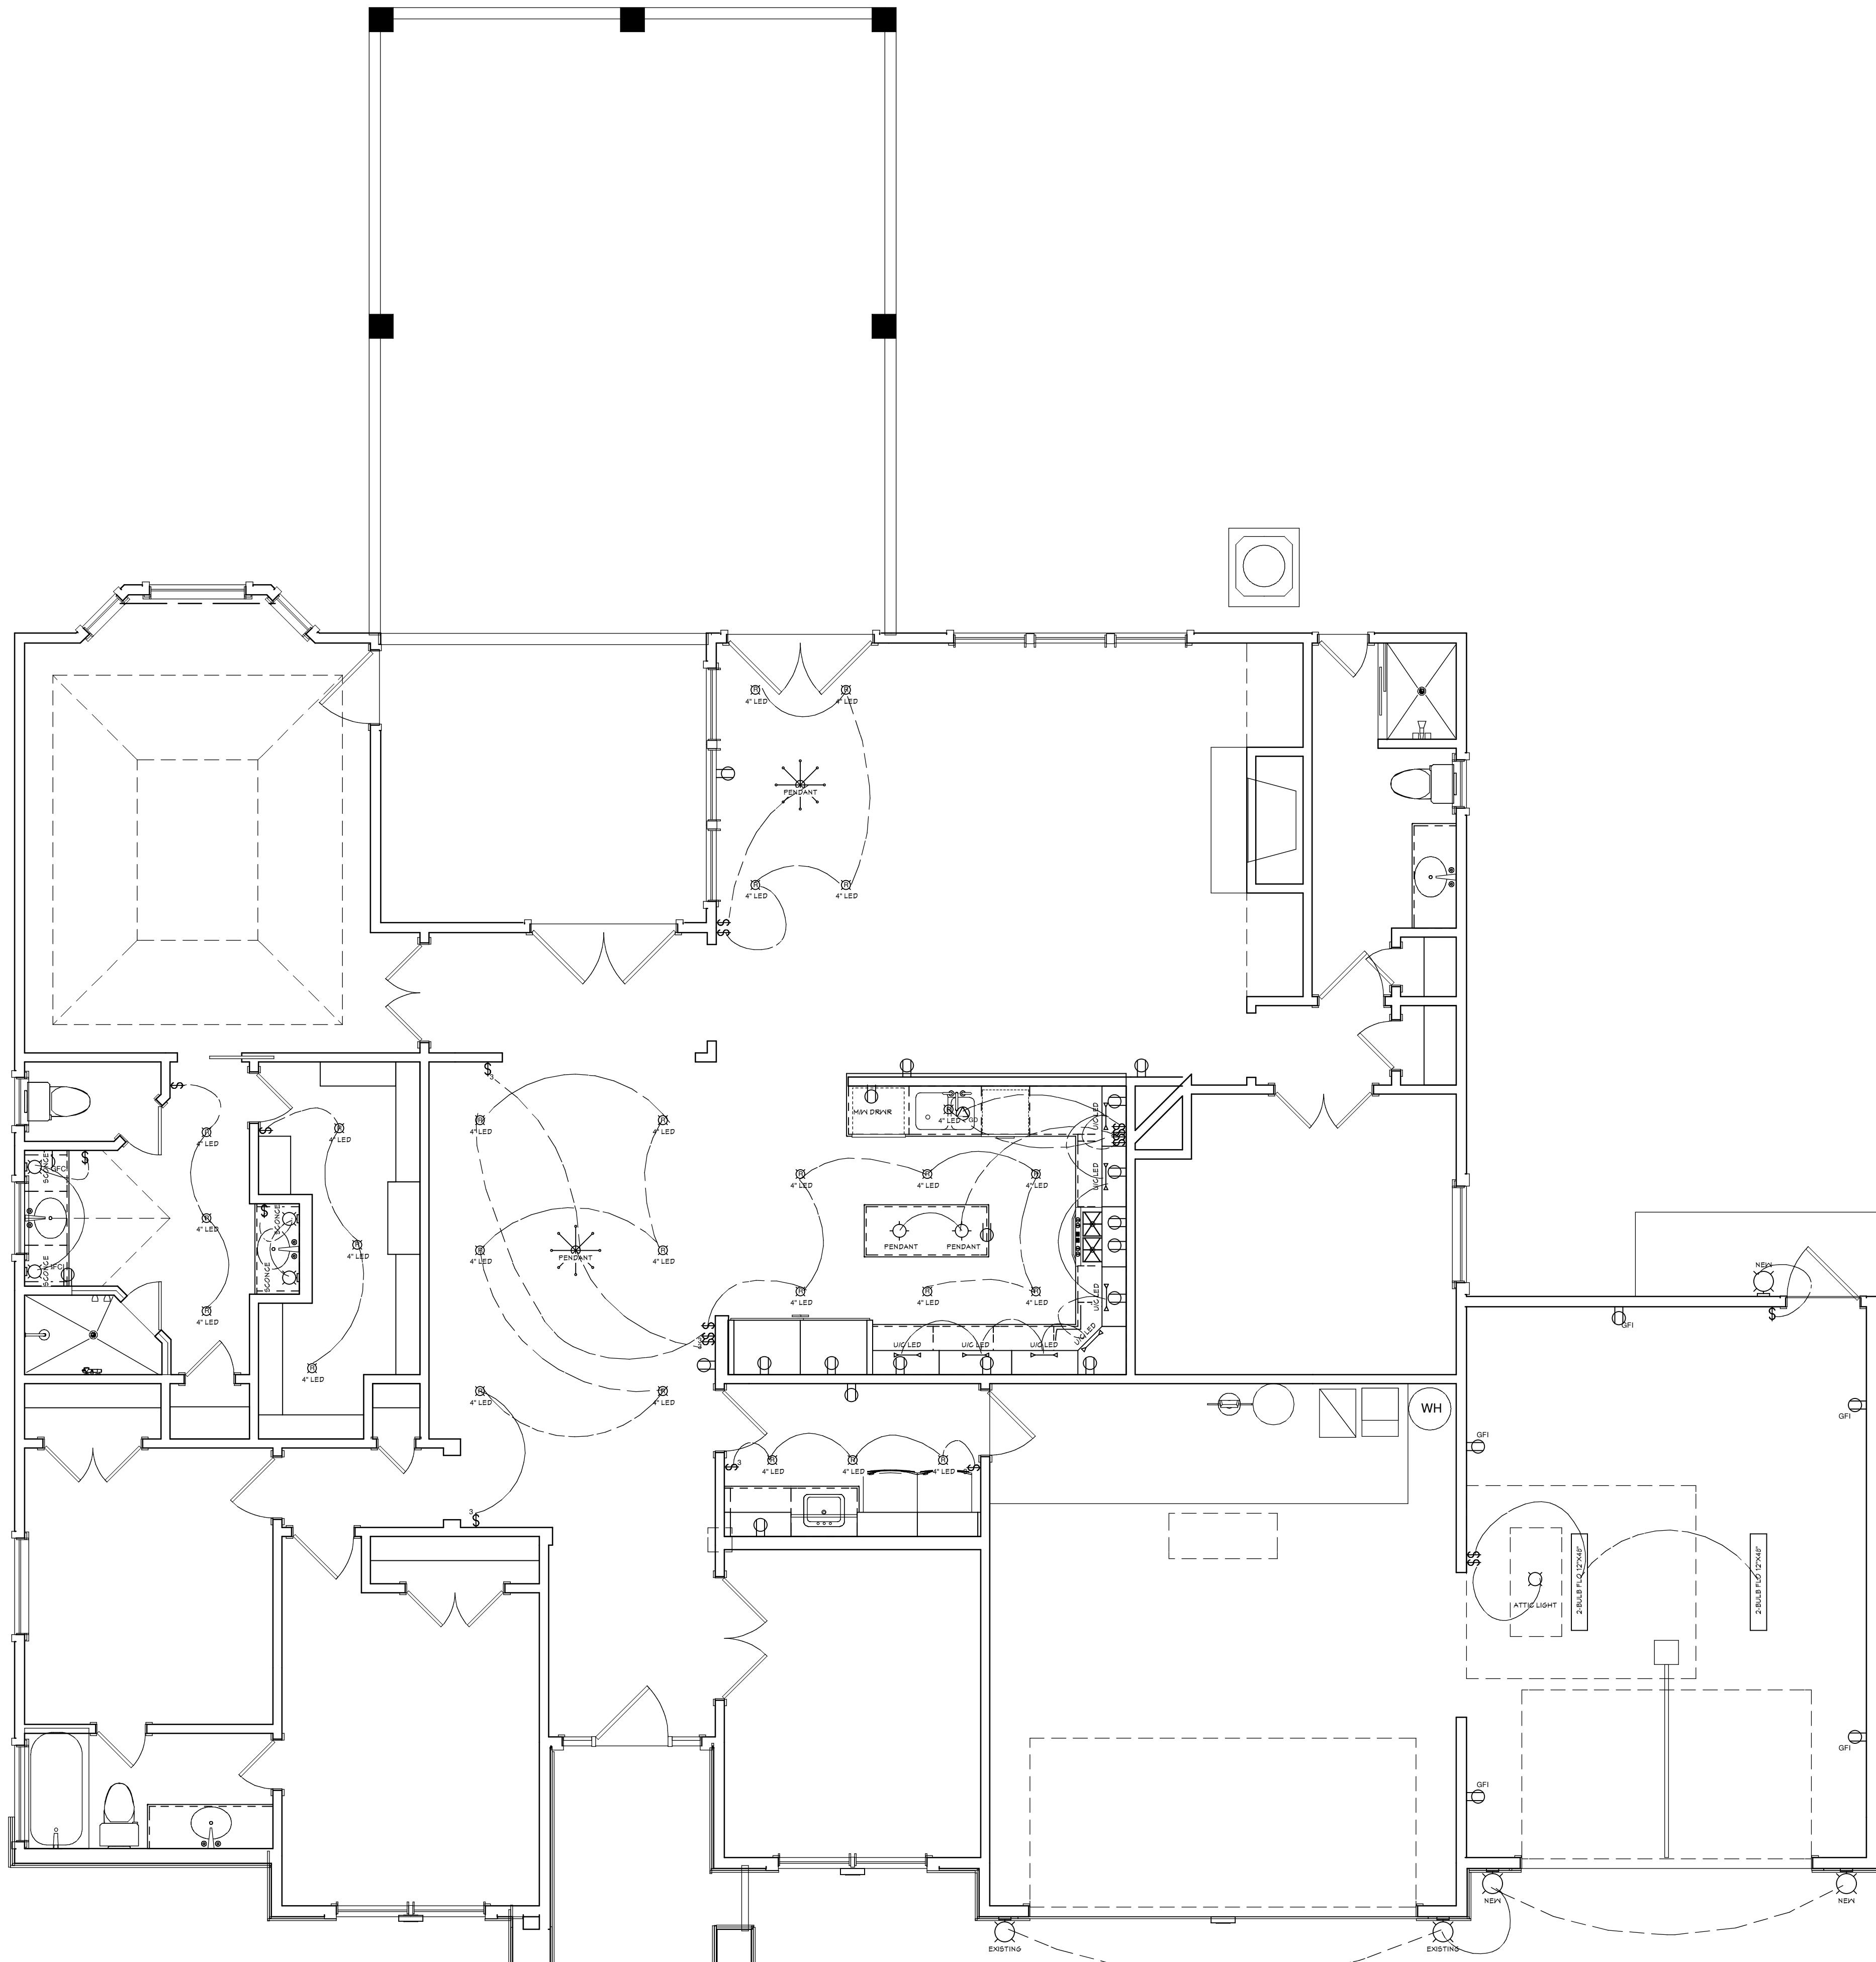

COPYRIGHT 2016 - DESIGNS FOR LIVING, LLC. Under Federal Statute HR 5490 of the Architectural Drawing Act & Title 17 specific trait copyright laws apply to all published works of Designs for Living, LLC, herein referred to as Designer. It is unlawful for anyone to copy these drawings, either in whole or in part, without the express written permission of the designer! The use of any plans, specifications, electronic or hard copy prints shall be restricted to the original site for which they were prepared and publication thereof is expressly limited to such use. Tie in to all works, specifically all drawings, specifications and modified derivatives of any blueprints, series, drawings or specifications remain the designers without prejudice. VISUAL CONTACT with any of these drawings, or their purchase, constitutes prima facie evidence of the acceptance of these restrictions! This has held precedent in the North Florida Court system! Any and all violations WILL result in legal action being taken and litigated damages to the full extent allowed by law! No exceptions and no excuse! Contractor &/or owner shall verify all dimensions, details & specifications prior to construction. Every attempt has been made to avoid mistakes. The contractor and the owners also fully acknowledge that they have full copyright release approval and liability released for any errors after delivery via email of drawings, including after construction has begun!