

2-STORY SINGLE FAMILY DWELLING

AS-BUILT 1ST FLOOR PLAN

COPYRIGHT 2016: DESIGNS FOR LIVING, LLC. Under Federal Statute HR 5490 of the Architectural Drawing Act & Title 17 specific tacit copyright laws apply to all published works of Designs for Living, LLC. herein referred to as Designer. It is unlawful for anyone to copy these drawings, either in whole or in part, without the express written permission of the Designer. The use of any plans, specifications, electronic or hard copy prints shall be restricted to the original site for which they were prepared and publication thereof is expressly limited to such use. Title to all works, specifically all drawings, specifications, and modified derivatives of any blueprints, e-files, or drawings, or specifications remain the Designer's without prejudice. No part of these drawings, specifications, or modified derivatives may be reproduced, stored in a retrieval system, or transmitted in any form or by any means, electronic, mechanical, photocopying, recording, or by any information storage and retrieval system, without the prior written permission of the Designer. Any and all violations of these terms shall be cause for legal action being taken and the Designer shall be entitled to recover all costs and expenses, including attorney's fees, incurred by the Designer. 

PLAN #
3651

NO.	DESCRIPTION	BY	DATE

BUILT BY:

Breakwater
 CONSTRUCTION
 904-226-7950

PROJECT DESCRIPTION:
RENOVATIONS FOR THE DENSMORE FAMILY
 828 BUGLER BRANCH WAY
 SAINT JOHNS, FLORIDA 32059

Design Drawings provided by:

DESIGNS FOR LIVING
 RESIDENTIAL DESIGN SINCE 1999
 904-730-7135


DATE:
4/4/2016

SCALE:
1/4" = 1'-0"


SHEET:
A-4



REAR ELEVATION

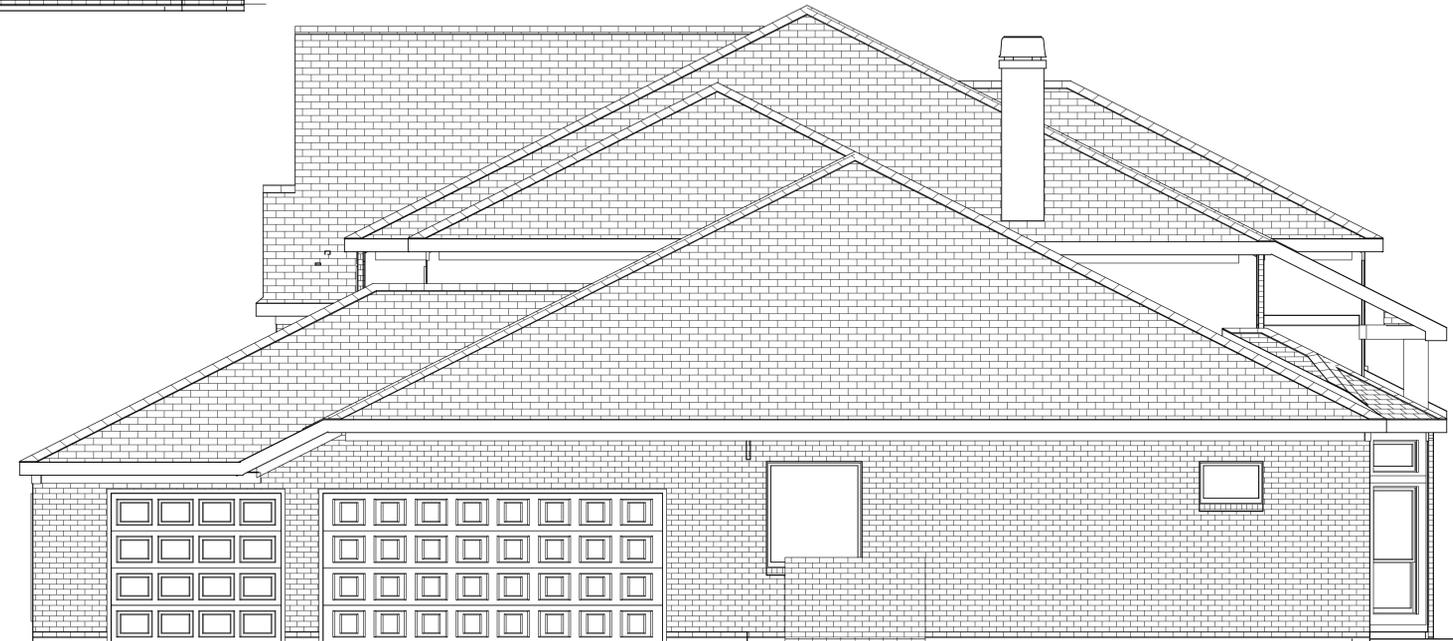

RIGHT ELEVATION

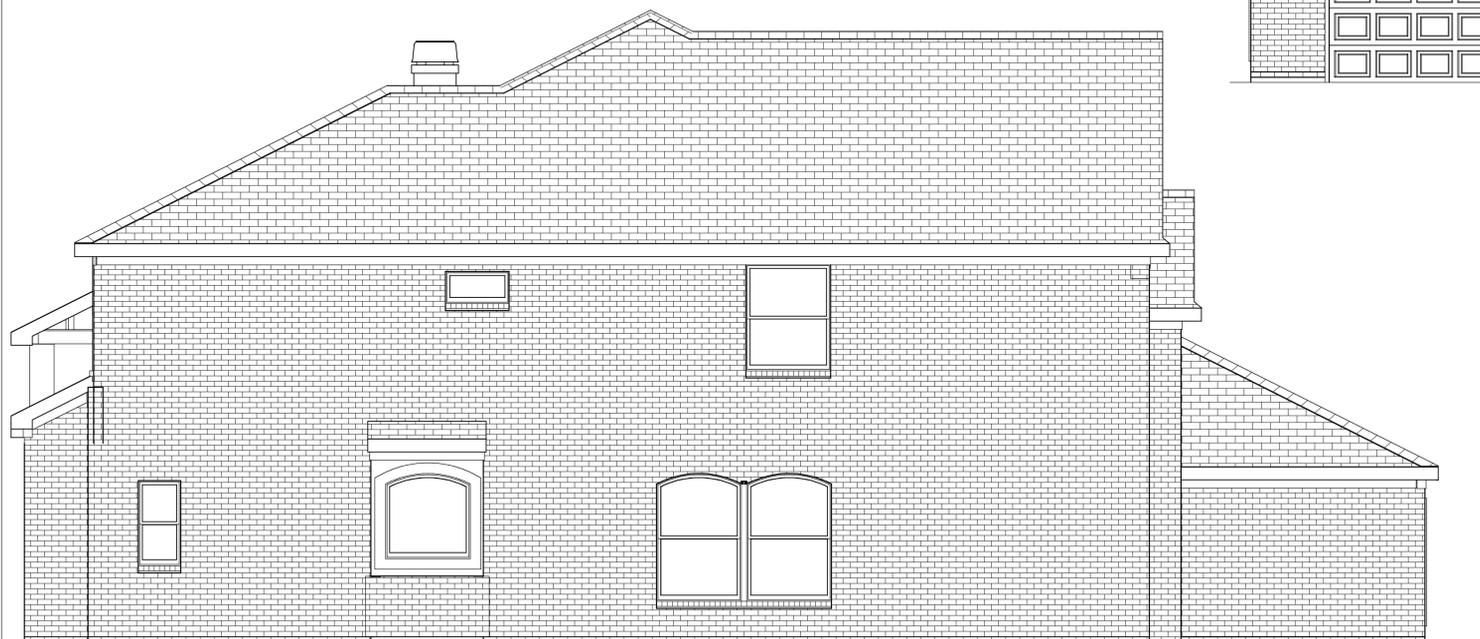

LEFT ELEVATION

AS-BUILT ELEVATIONS

COPYRIGHT 2016: DESIGNS FOR LIVING, LLC. Under Federal Statute HR 5490 of the Architectural Drawing Act & Title 17 specific tacit copyright laws apply to all published works of Designs for Living, LLC. herein referred to as Designer. It is unlawful for anyone to copy these drawings, either in whole or in part, without the express written permission of the Designer. The use of any plans, specifications, electronic or hard copy prints shall be restricted to the original site for which they were prepared and publication thereof is expressly limited to such use. Title to all works, specifically all drawings, specifications, and modified derivatives of any blueprints, e-files, or specifications remain the Designer's without prejudice. No part of these drawings, specifications, or modified derivatives may be reproduced, stored in a retrieval system, or transmitted in any form or by any means, electronic, mechanical, photocopying, recording, or otherwise, without the prior written permission of the Designer. Any and all violations shall result in legal action being taken and the Designer shall be held liable for all damages, including attorney's fees and costs. Errors and omissions are the responsibility of the Designer. The Designer shall not be liable for copyright infringement or other errors after delivery via email of drawings, including after construction has begun. Errors attempted to be corrected by email will also be fully acknowledged that they have full copyright release approval and no further action will be taken.

PLAN #
3651

NO.	DESCRIPTION	BY	DATE

BUILT BY:



Breakwater
CONSTRUCTION
904-226-7950

PROJECT DESCRIPTION:
RENOVATIONS FOR THE DENSMORE FAMILY
 828 BUGLER BRANCH WAY
 SAINT JOHNS, FLORIDA 32059

Design Drawings provided by:



DESIGNS FOR LIVING
RESIDENTIAL DESIGN STUDIO
904-730-7135

DATE:
4/4/2016

SCALE:
1/4" = 1'-0"

SHEET:
A-6

NO.	DESCRIPTION	BY	DATE

BUILT BY:

Breakwater
 CONSTRUCTION
 904-226-7950

PROJECT DESCRIPTION:
RENOVATIONS FOR THE DENSMORE FAMILY
 828 BUGLER BRANCH WAY
 SAINT JOHNS, FLORIDA 32059


Design Drawings provided by:

DESIGNS FOR LIVING
 ARCHITECTURAL DESIGN & PLANNING, INC. 1999
 904-730-7135

DATE:
4/4/2016

SCALE:
1/4" = 1'-0"

SHEET:
A-8

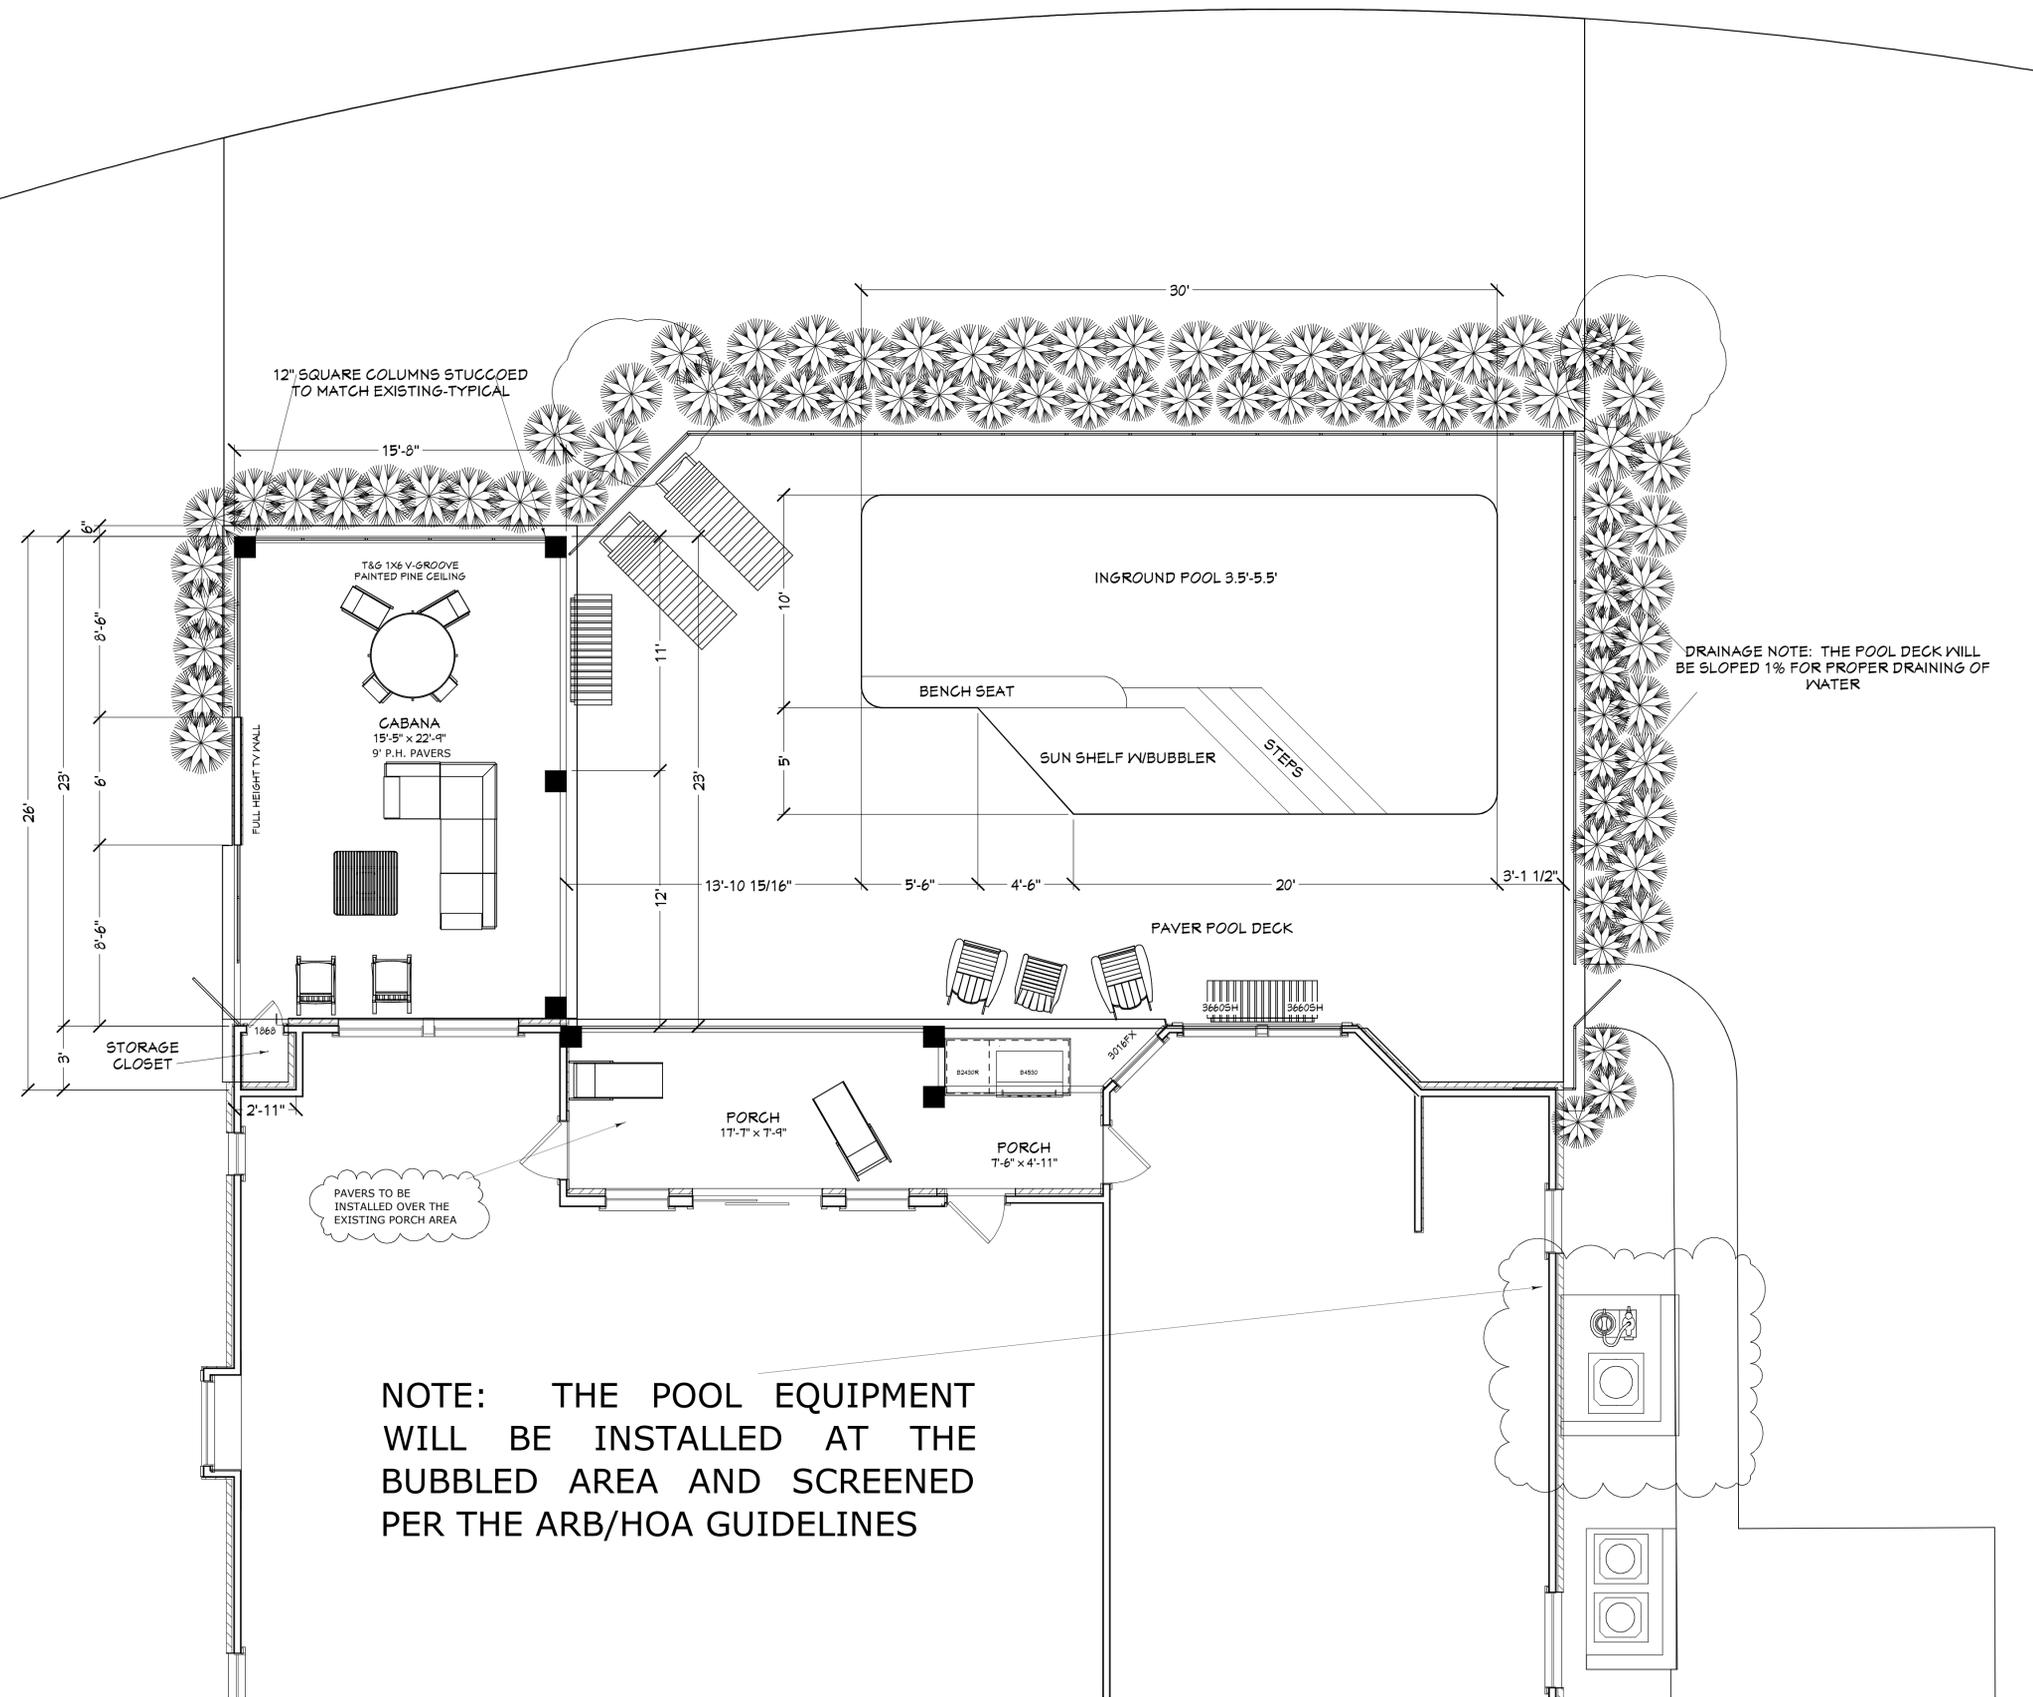

12" SQUARE COLUMNS STUCCOED TO MATCH EXISTING-TYPICAL

T&G 1X6 V-GROOVE PAINTED PINE CEILING


INGROUND POOL 3.5'-5.5'

BENCH SEAT

SUN SHELF W/BUBBLER

PAVER POOL DECK


PORCH 7'-6" x 4'-11"

STORAGE CLOSET

PAVERS TO BE INSTALLED OVER THE EXISTING PORCH AREA

DRAINAGE NOTE: THE POOL DECK WILL BE SLOPED 1% FOR PROPER DRAINING OF WATER

NOTE: THE POOL EQUIPMENT WILL BE INSTALLED AT THE BUBBLED AREA AND SCREENED PER THE ARB/HOA GUIDELINES


FOOTAGES (A.N.S.I.):

EXISTING PORCH:	198.42
NEW CABANA:	369.17
SLAB EXTENSIONS:	28.05
SLAB AREA:	397.22

PROPOSED CABANA AND POOL PLAN

COPYRIGHT 2016: DESIGNS FOR LIVING, LLC. Under Federal Statute HR 5490 of the Architectural Drawing Act & Title 17 specific tacit copyright laws apply to all published works of Designs for Living, LLC. herein referred to as Designer. It is unlawful for anyone to copy these drawings, either in whole or in part, without the express written permission of the Designer. The use of any plans, specifications, electronic or hard copy prints shall be restricted to the original site for which they were prepared and publication thereof is expressly limited to such use. Title to all works, specifically all drawings, specifications, and modified derivatives of any blueprints, e-files, or specifications remains with the Designer's without prejudice. If you are not the intended recipient of these drawings, please notify the Designer immediately. No part of these drawings may be reproduced, stored in a retrieval system, or transmitted in any form or by any means, electronic, mechanical, photocopying, recording, or by any information storage and retrieval system, without the prior written permission of the Designer. All dimensions are in feet and inches. Errors, omissions, and other errors shall not be liable for error for copyright infringement or other errors after delivery via email of drawings. Including after construction has begun. Designs for Living, LLC nor R.E. Chip Mitchell shall not be liable for error for copyright infringement or other errors after delivery via email of drawings. Including after construction has begun.

ROOF NOTES:
 FASCIA: PLUMB CUT
 EAVE OVERHANG: MATCH EXISTING
 FASCIA: CPVC COATED ALUM
 SOFFITS: VENTED VINYL TO MATCH EXISTING
 SHINGLES: LIFETIME ARCH FIBERGLASS
 ROOF PITCH: 3/12
 CONVENTIONALLY FRAMED ROOF AREA W/
 STANDARD HEELS TO ALLOW FIELD ADJUSTMENT
 TO PROPERLY CLEAR THE 2ND FLOOR WINDOWS.
 VENTS: OFFRIDGE TYPE ONE-4 FOOTER

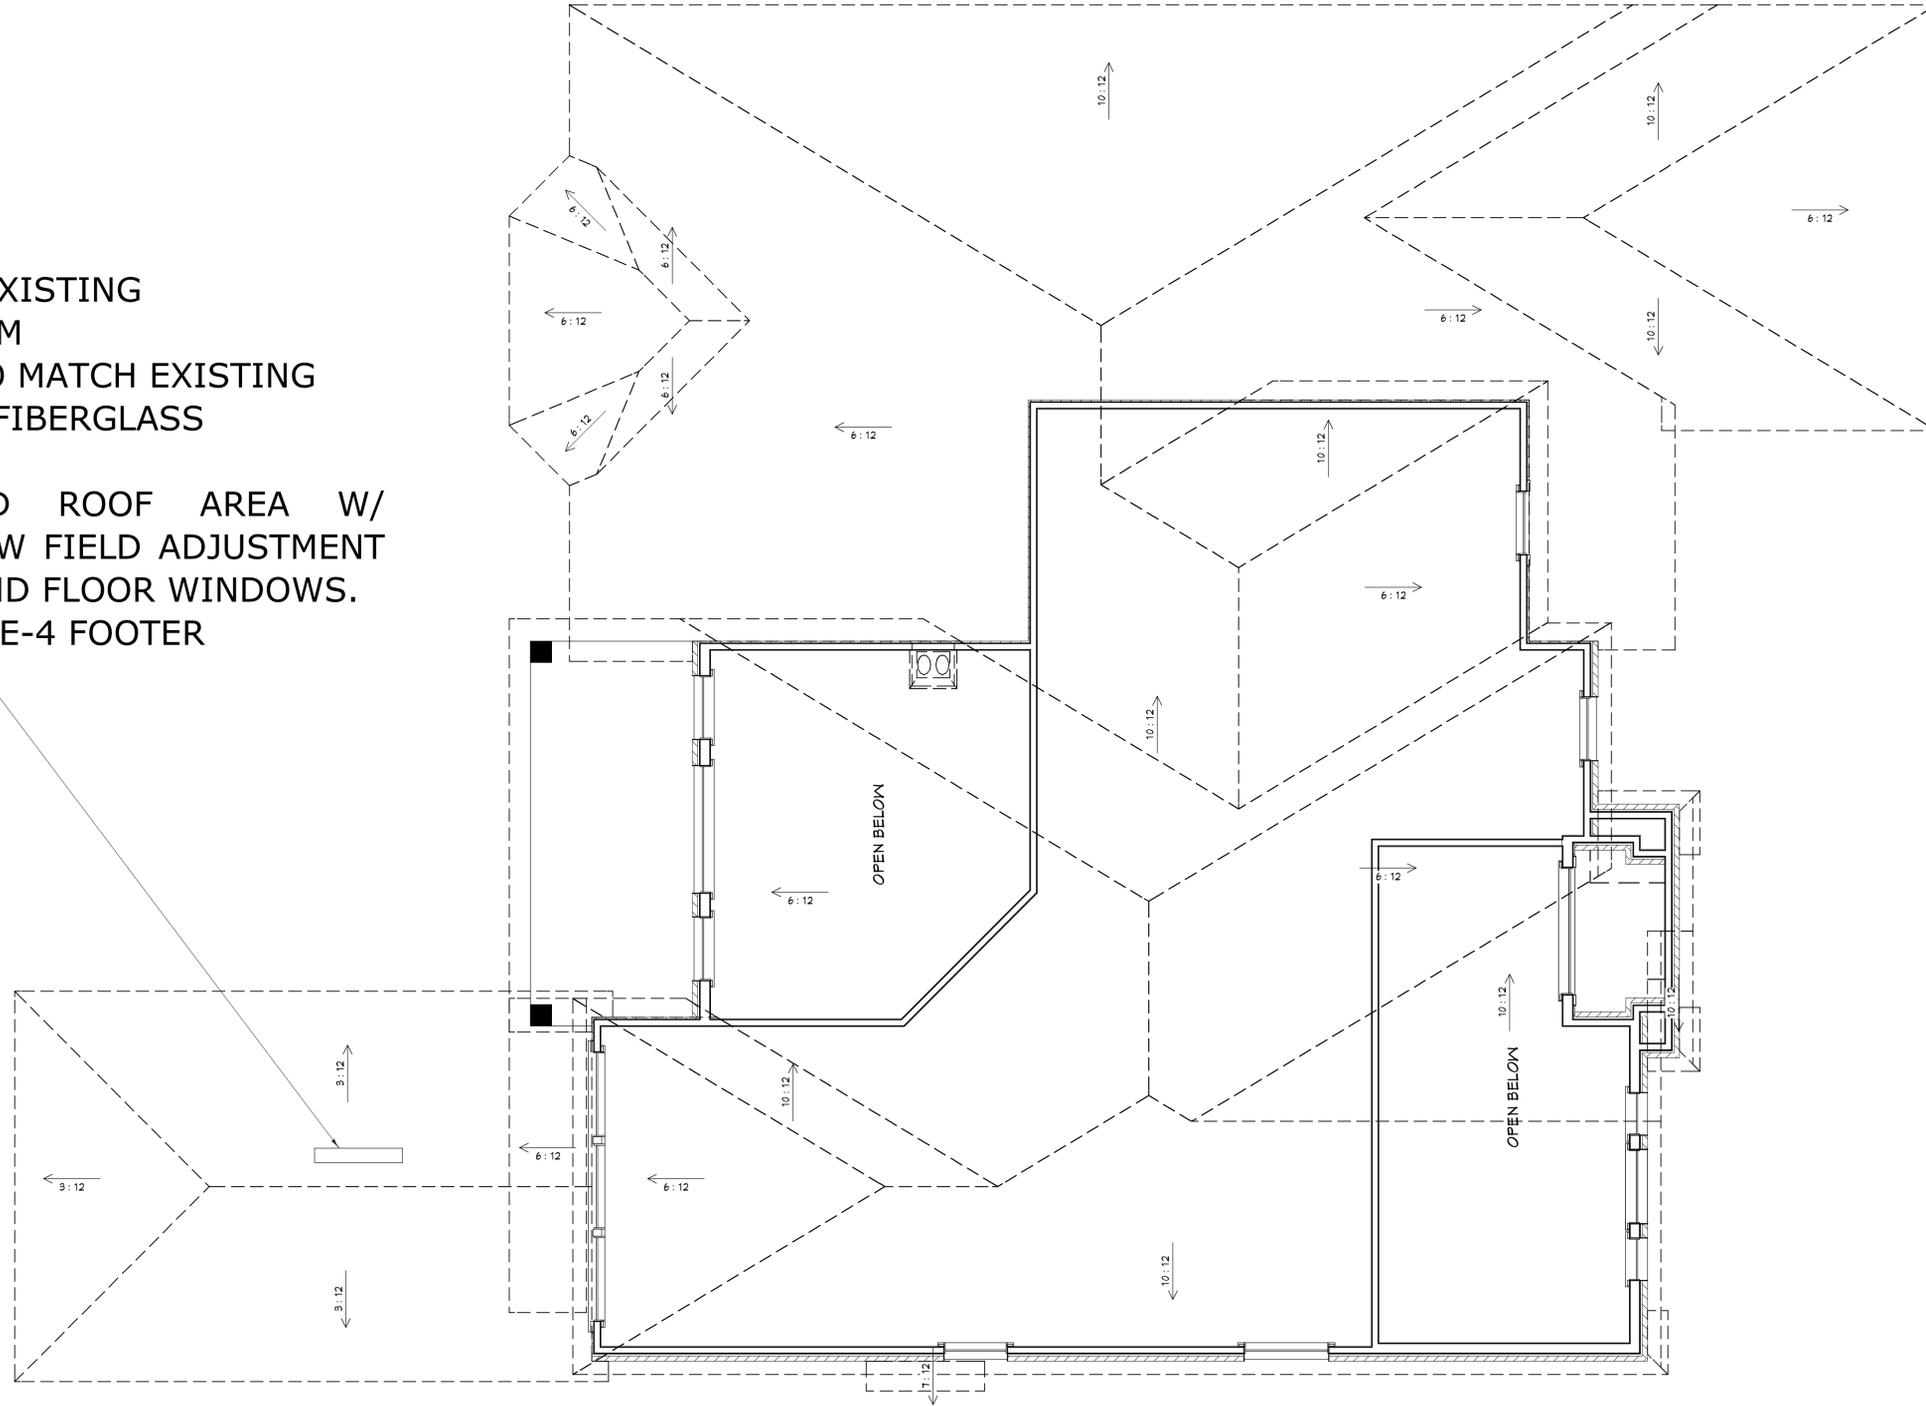

PROPOSED ROOF PLAN

COPYRIGHT 2016: DESIGNS FOR LIVING, LLC. Under Federal Statute HR 5490 of the Architectural Drawing Act & Title 17 specific tacit copyright laws apply to all published works of Designs for Living, LLC. herein referred to as Designer. It is unlawful for anyone to copy these drawings, either in whole or in part, without the express written permission of the Designer. The use of any plans, specifications, electronic or hard copy prints shall be restricted to the original site for which they were prepared and publication thereof is expressly limited to such use. Title to all works, specifically all drawings, specifications, and modified derivatives of any blueprints, e-files, or specifications remain the Designer's without prejudice. IS NOT BE USED FOR ANY OTHER PROJECTS WITHOUT THE WRITTEN PERMISSION OF THE DESIGNER. No part of this drawing may be reproduced, stored in a retrieval system, or transmitted in any form or by any means, electronic, mechanical, photocopying, recording, or by any information storage and retrieval system, without the prior written permission of the Designer. 



Design Drawings
 provided by:

DESIGNS FOR LIVING, LLC
 904-730-7135

PROJECT DESCRIPTION:
**RENOVATIONS FOR THE DENSMORE
 FAMILY**
 828 BUGLER BRANCH WAY
 SAINT JOHNS, FLORIDA 32059



BUILT BY:
**Breakwater
 CONSTRUCTION**
 904-226-7950

NO.	DESCRIPTION	BY	DATE

**PLAN #
 3651**

DATE:

4/4/2016

SCALE:

1/4" = 1'-0"

SHEET:

A-9

NOTE: THE POOL EQUIPMENT WILL BE INSTALLED AT THE BUBBLED AREA AND SCREENED PER THE ARB/HOA GUIDELINES



REAR ELEVATION



FRONT ELEVATION

EXTERIOR NOTES:

1. SYNTHETIC STUCCO EXTERIOR AT COLUMNS TO MATCH EXISTING
2. POOL DECK IS LEVEL WITH THE BACK PORCH
3. SOFFITS: BUILDER GRADE VINYL TO MATCH EXISTING
4. SHINGLES ARCHITECTURAL FIBERGLASS
5. VENTLESS OUTDOOR L.P. GAS FIREPLACE
6. CPVC COATED ALUMINUM PLUMB CUT FASCIA
7. 1X6 V-GROOVE T&G CEILING
8. SYNTHETIC STUCCO OVER ANY EXPOSED FOUNDATION
9. PAVER POOL DECK, CABANA & EXISTING PORCH FROM TREMRON PAVERS

PROPOSED FRONT/REAR ELEVATIONS

COPYRIGHT 2016: DESIGNS FOR LIVING, LLC. Under Federal Statute HR 5490 of the Architectural Drawing Act & Title 17 specific tacit copyright laws apply to all published works of Designs for Living, LLC. herein referred to as Designer. It is unlawful for anyone to copy these drawings, either in whole or in part, without the express written permission of the Designer. The use of any plans, specifications, electronic or hard copy prints shall be restricted to the original site for which they were prepared and publication thereof is expressly limited to such use. Including after construction has begun. Errors and omissions shall be the responsibility of the client and the Designer. No exceptions and no excuses. Designs for Living, LLC nor R.E. Chip Mitchell shall not be liable for copyright infringement or other errors after delivery via email of drawings. Including after construction has begun.

PLAN #
3651

NO.	DESCRIPTION	BY	DATE

BUILT BY:



Breakwater
CONSTRUCTION
904-226-7950

PROJECT DESCRIPTION:
RENOVATIONS FOR THE DENSMORE FAMILY
 828 BUGLER BRANCH WAY
 SAINT JOHNS, FLORIDA 32059

Design Drawings provided by:




DESIGNS FOR LIVING
RESIDENTIAL DESIGN, SINCE 1999
904-730-7135

DATE:
4/4/2016

SCALE:
1/4" = 1'-0"

SHEET:
A-11

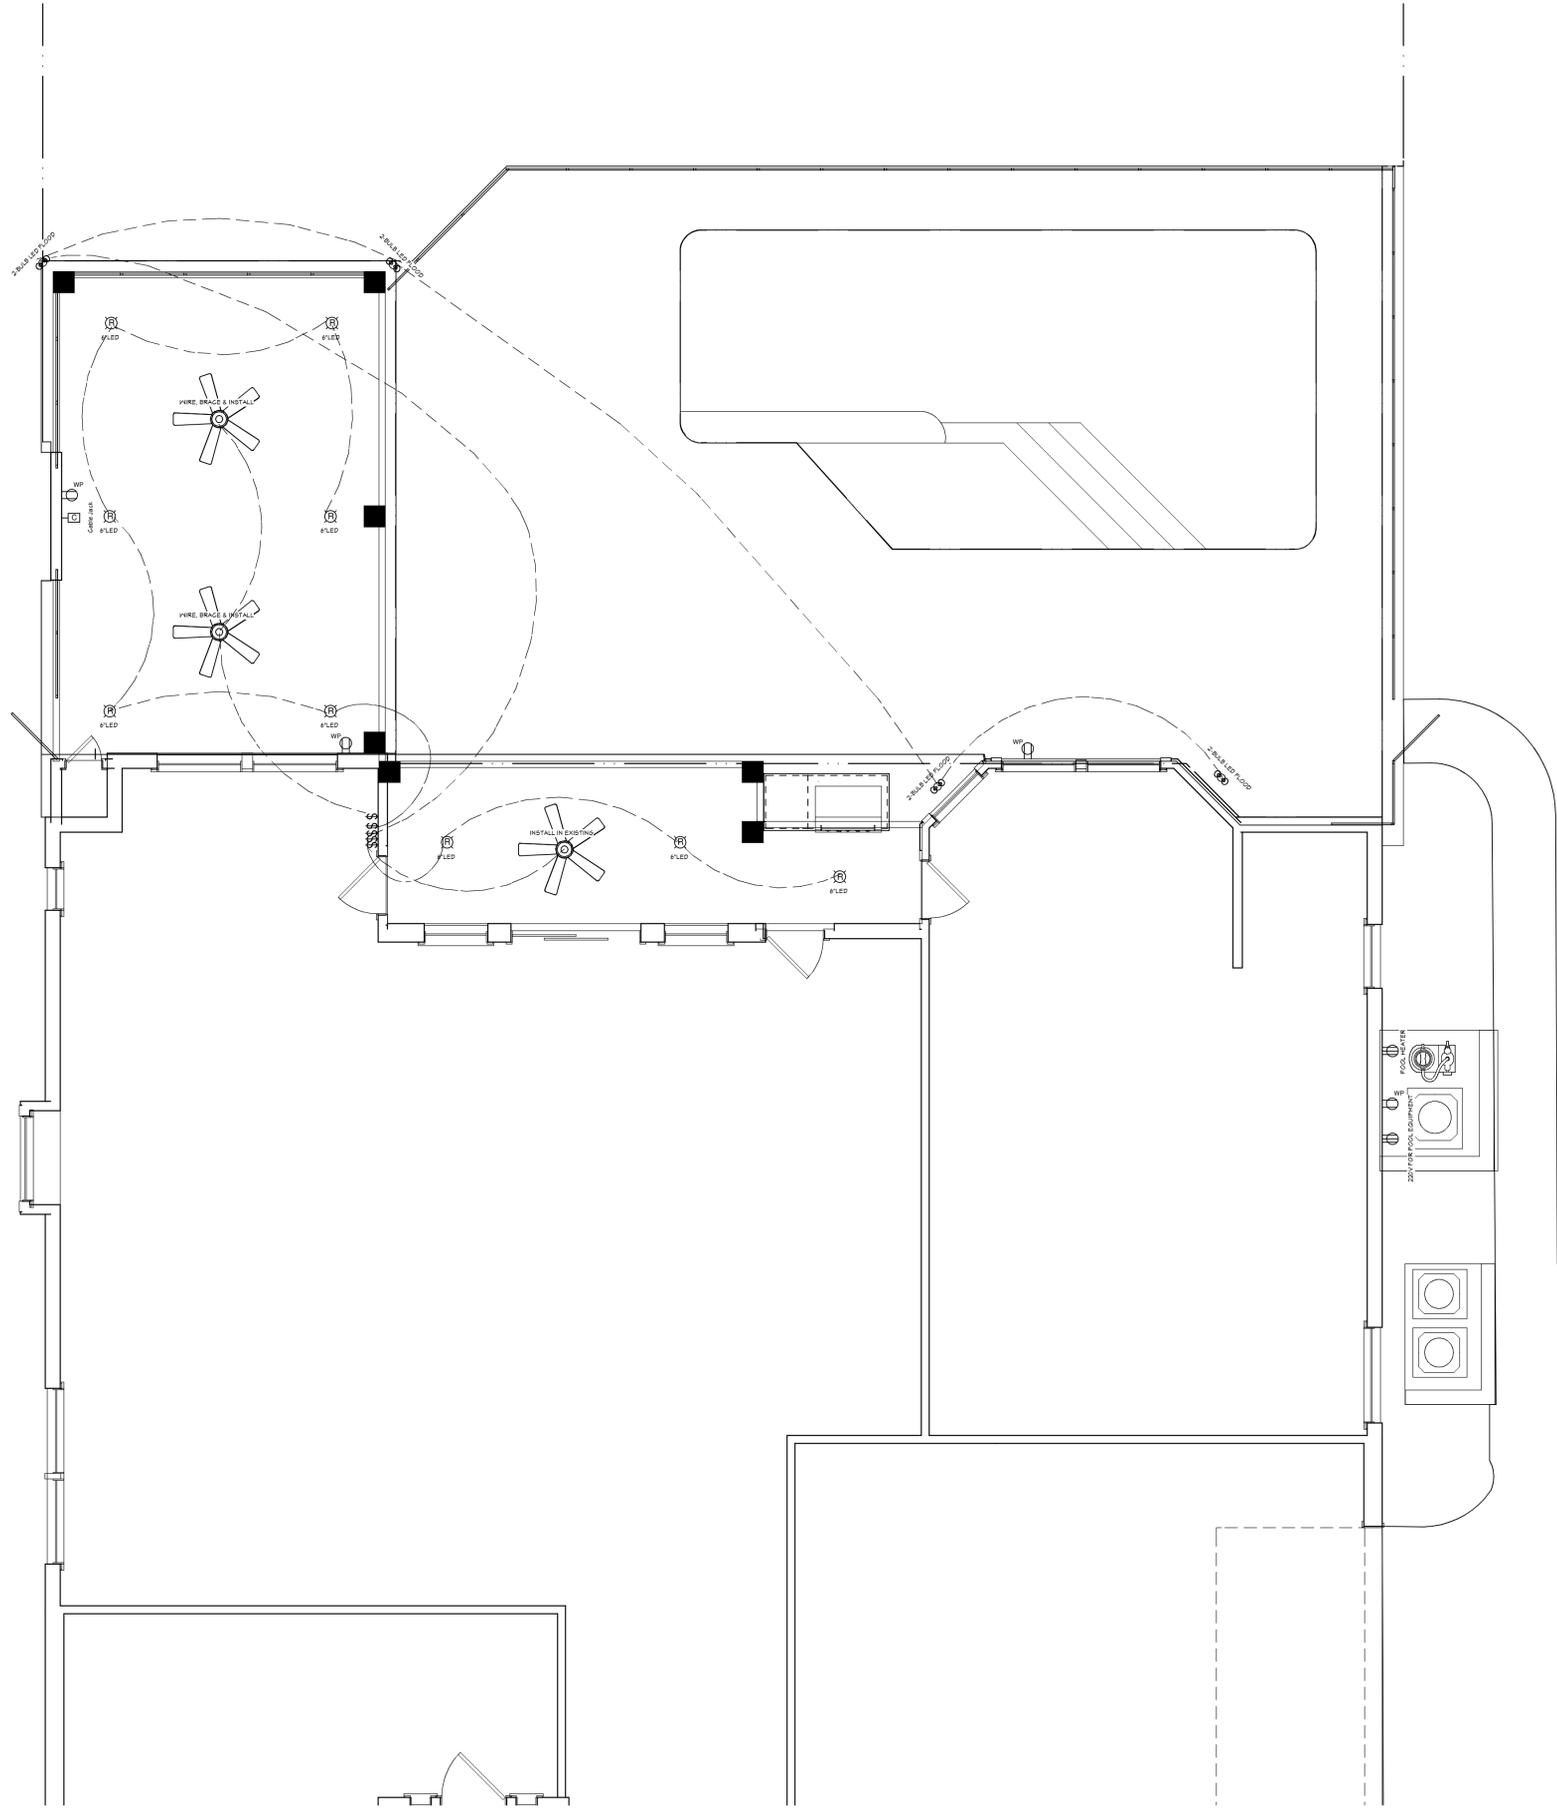

ELECTRICAL - DATA - AUDIO LEGEND	
SYMBOL	DESCRIPTION
	Ceiling Fan
	Ventilation Fans: Ceiling Mounted, Wall Mounted
	Ceiling Mounted Light Fixtures: Surface/Pendant, Recessed, Heat Lamp, Low Voltage
	Wall Mounted Light Fixtures: Flush Mounted, Wall Sconce
	Chandelier Light Fixture
	Fluorescent Light Fixture
	240V Receptacle
	110V Receptacles: Duplex, Weather Proof, GFCI
	Switches: Single Pole, Weather Proof, 3-Way, 4-Way
	Switches: Dimmer, Timer
	Audio Video: Control Panel, Switch
	Speakers: Ceiling Mounted, Wall Mounted
	Wall Jacks: CAT5, CAT5 + TV, TV/Cable
	Telephone Jack
	Intercom
	Thermostat
	Door Chime, Door Bell Button
	Smoke Detectors: Ceiling Mounted, Wall Mounted
	Electrical Breaker Panel

ELECTRICAL NOTES:

1. THE POOL EQUIPMENT IS LOCATED ON THE LEFT REAR
2. ALL EXTERIOR FLOODS TO BE DUAL BULB LED FLOODS
3. ALL RECESSED CANS TO BE 6" LED
4. ALL EXTERIOR FANS TO BE EXTERIOR RATED
5. WIRELESS PECO SWITCHES WOULD BE THE RECOMMEND WAY TO POWER THE EXTERIOR CIRCUITS OTHER THAN THE EXTERIOR PLUGS.

PROPOSED ELECTRICAL PLAN

COPYRIGHT 2016: DESIGNS FOR LIVING, LLC. Under Federal Statute HR 5490 of the Architectural Drawing Act & Title 17 specific tacit copyright laws apply to all published works of Designs for Living, LLC. herein referred to as Designer. It is unlawful for anyone to copy these drawings, either in whole or in part, without the express written permission of the Designer. The use of any plans, specifications, electronic or hard copy prints shall be restricted to the original site for which they were prepared and publication thereof is expressly limited to such use. Title to all works, specifically all drawings, specifications, and modified derivatives of any blueprints, e-files, drawings, or specifications remain the Designer's without prejudice. IS NOT TO BE REPRODUCED, COPIED, REPRODUCED, TRANSMITTED, OR IN ANY MANNER DISCLOSED TO ANY OTHER PARTY WITHOUT THE WRITTEN PERMISSION OF THE DESIGNER. ANY AND ALL VIOLATIONS OF THESE TERMS SHALL BE CONSIDERED A BREACH OF CONTRACT AND THE DESIGNER SHALL BE FULLY ENTITLED TO PURSUE ALL LEGAL ACTION BEING TAKEN AND TO SEEK DAMAGES TO THE FULL EXTENT ALLOWED BY LAW. No exceptions and no excuses. Contract & for all terms, conditions & definitions shall refer to the contract and the drawings. Errors, omissions, and discrepancies shall be the responsibility of the contractor and the designer shall not be held liable for any errors or omissions after delivery via email of drawings. including after construction has begun.

PLAN #
3651

NO.	DESCRIPTION	BY	DATE

BUILT BY:

Breakwater
CONSTRUCTION
904-226-7950

PROJECT DESCRIPTION:
RENOVATIONS FOR THE DENSMORE FAMILY
828 BUGLER BRANCH WAY
SAINT JOHNS, FLORIDA 32059

Design Drawings provided by:


DESIGNS FOR LIVING
RESIDENTIAL DESIGNER SINCE 1999
904-730-7135

DATE:
4/4/2016

SCALE:
1/4" = 1'-0"

SHEET:
A-12

NOTE: THE POOL & DECK WILL BE LEVEL WITH THE BACK PORCH AND THEN WILL BE HEAVILY LANDSCAPED FOR ADDITIONAL PRIVACY FOR THE HOMEOWNERS.

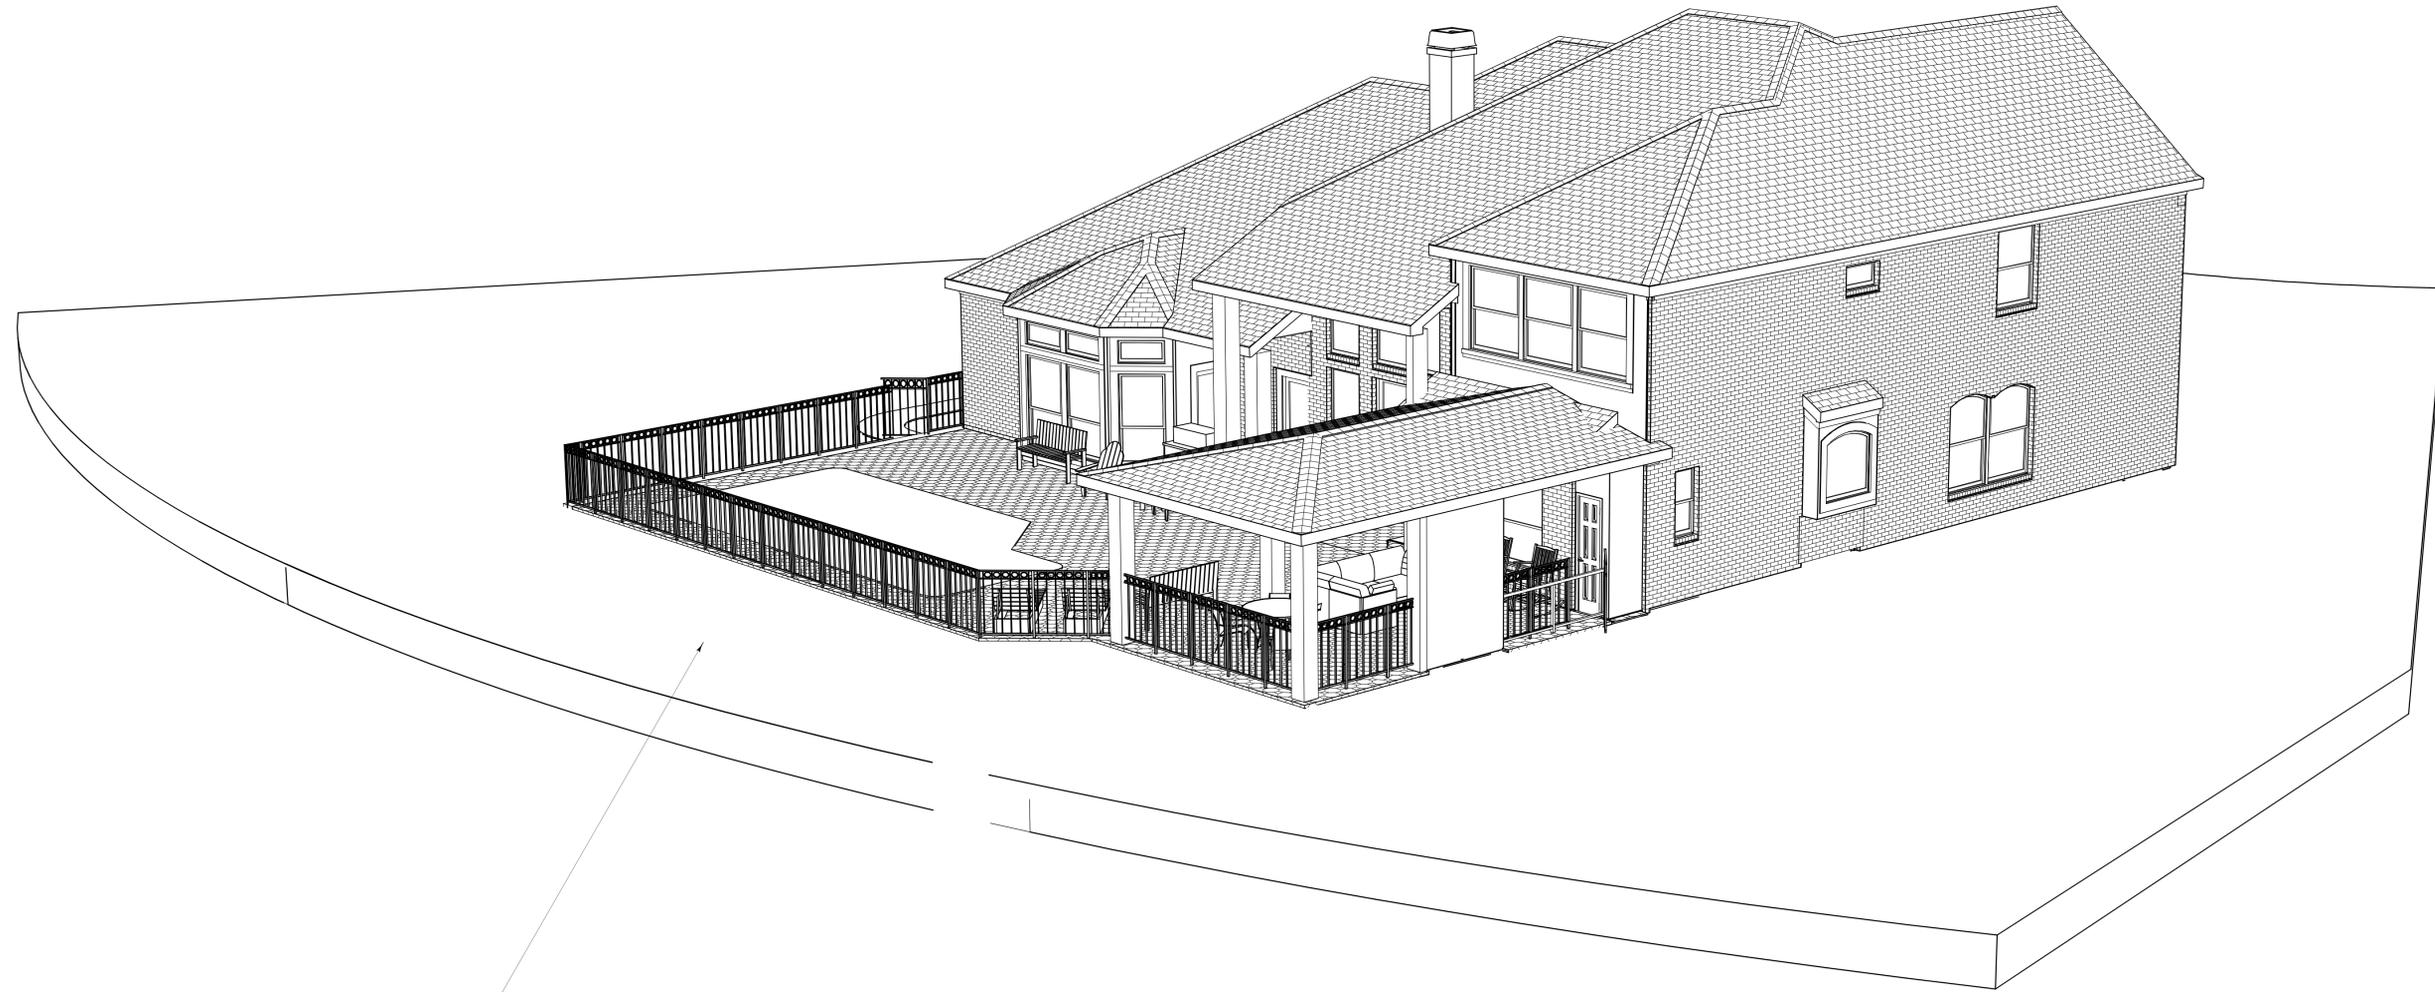

THE EXPOSED PORTION OF THE EDGE OF THE POOL STRUCTURE WILL BE LESS THAN 30" HIGH PER THE PREVIOUS APPROVED ACC# 7777.

PROPOSED ISOMETRICS

PLAN #
3651

NO.	DESCRIPTION	BY	DATE

BUILT BY:

Breakwater
 CONSTRUCTION
 904-226-7950

PROJECT DESCRIPTION:
RENOVATIONS FOR THE DENSMORE FAMILY
 828 BUGLER BRANCH WAY
 SAINT JOHNS, FLORIDA 32059

Design Drawings provided by:

DESIGNS FOR LIVING
 RESIDENTIAL DESIGN & BUILD SINCE 1999
 904-730-7135

DATE:
4/4/2016

SCALE:
1/4" = 1'-0"

SHEET:
A-13

COPYRIGHT 2016: DESIGNS FOR LIVING, LLC. Under Federal Statute HR 5490 of the Architectural Drawing Act & Title 17 specific tacit copyright laws apply to all published works of Designs for Living, LLC. herein referred to as Designer. It is unlawful for anyone to copy these drawings, either in whole or in part, without the express written permission of the Designer. The use of any plans, specifications, electronic or hard copy prints shall be restricted to the original site for which they were prepared and publication thereof is expressly limited to such use. Title to all works, specifically all drawings, specifications, and modified derivatives of any blueprints, e-files, or drawings, or specifications remain the Designer's without prejudice. No part of these drawings, or specifications, or any part thereof, may be reproduced, stored in a retrieval system, or transmitted in any form or by any means, electronic, mechanical, photocopying, recording, or otherwise, without the prior written consent of the Designer. Any and all violations of the above shall be cause for legal action being taken and the Designer shall be held harmless. No exceptions and no excuses. All dimensions, details, and specifications shall be as shown on the drawings and the Designer shall not be liable for error for copyright infringement or other errors after delivery via email of drawings. 

