

LUCAS-STRANAHAN RENOVATIONS

REVIEW PLAN 4/2/2017



1236 SALT CREEK ISLAND DRIVE
PONTE VEDRA BEACH, FL 32082
LOT 14, SALT CREEK ISLAND
R/E #: 061861-0140
BUILT BY:
DOXA PROPERTIES, LLC
8862 CANOPY OAKS DRIVE
JACKSONVILLE, FLORIDA 32256
904-219-9279
CGC1504731

COPYRIGHT 2016: DESIGNS FOR LIVING, LLC. -Under section 102 of the Architectural Works Copyright Protection Act (title 17 of the United States Code) specific tacit copyright laws apply to original design of a building created in any tangible medium of expression, including a constructed building or architectural plans, models, or drawings and is subject to copyright protection as an "architectural work" by Designs for Living, LLC. herein referred to as Designer. It is unlawful for anyone to copy these drawings, either in whole or in part, without the express written permission of the Designer. The use of any plans, specifications, electronic or hard copy prints shall be restricted to the original site for which they were prepared and publication thereof is expressly limited to such use. Title to all works, specifically all drawings, specifications, and modified derivatives of any blueprints, e-files, drawings, or specifications remain the Designers without prejudice. VISUAL CONTACT with any of these drawings, or their purchase constitutes prima facie evidence of the acceptance of these restrictions! This has held precedent in the North Florida Court system! Any and all violations WILL result in legal action being taken and litigated damages to the full extent allowed by law! No exceptions and no excuses! Contractor &/or owner shall verify all dimensions, details, & specifications prior to construction. Every attempt has been made to avoid errors and omissions, but errors and omissions do occur and are assumed by the client. The Designer shall not be liable for copyright infringement or other errors after delivery via email or drawings including after construction has begun. This copyright law is only valid on building designs created on or after December 1, 1990.

DATE:

4/2/2017

SCALE:

N.T.S.

SHEET:

A-1

Design Drawings
provided by:

DESIGNS FOR LIVING, LLC
RESIDENTIAL DESIGN SINCE 1998

904-730-7135

PROJECT DESCRIPTION:

LUCAS-STRANAHAN RENOVATIONS
1236 SALT CREEK ISLAND DRIVE
PONTE VEDRA BEACH, FL 32082

R/E#: 061861-0140

BUILT BY:

DOXA PROPERTIES, LLC
8862 CANOPY OAKS DRIVE
JACKSONVILLE, FL 32256
904-219-9279 CGC1504731

CLIENT APPROVAL SIGNATURE

DATE

LOREN L. LUCAS

HARRIET A. STRANAHAN

PLAN #
1236-R

CONTRACT NOTE: CONTRACT AND SPECIFICATIONS TAKE PRECEDENCE OVER THESE DRAWINGS. ANY CONFLICT WILL DEFAULT TO SAID DOCUMENTS.



CONTRACT NOTE: CONTRACT AND SPECIFICATIONS TAKE PRECEDENCE OVER THESE DRAWINGS. ANY CONFLICT WILL DEFAULT TO SAID DOCUMENTS.





CONTRACT NOTE: CONTRACT AND SPECIFICATIONS TAKE PRECEDENCE OVER THESE DRAWINGS. ANY CONFLICT WILL DEFAULT TO SAID DOCUMENTS.






CONTRACT NOTE: CONTRACT AND SPECIFICATIONS TAKE PRECEDENCE OVER THESE DRAWINGS. ANY CONFLICT WILL DEFAULT TO SAID DOCUMENTS.



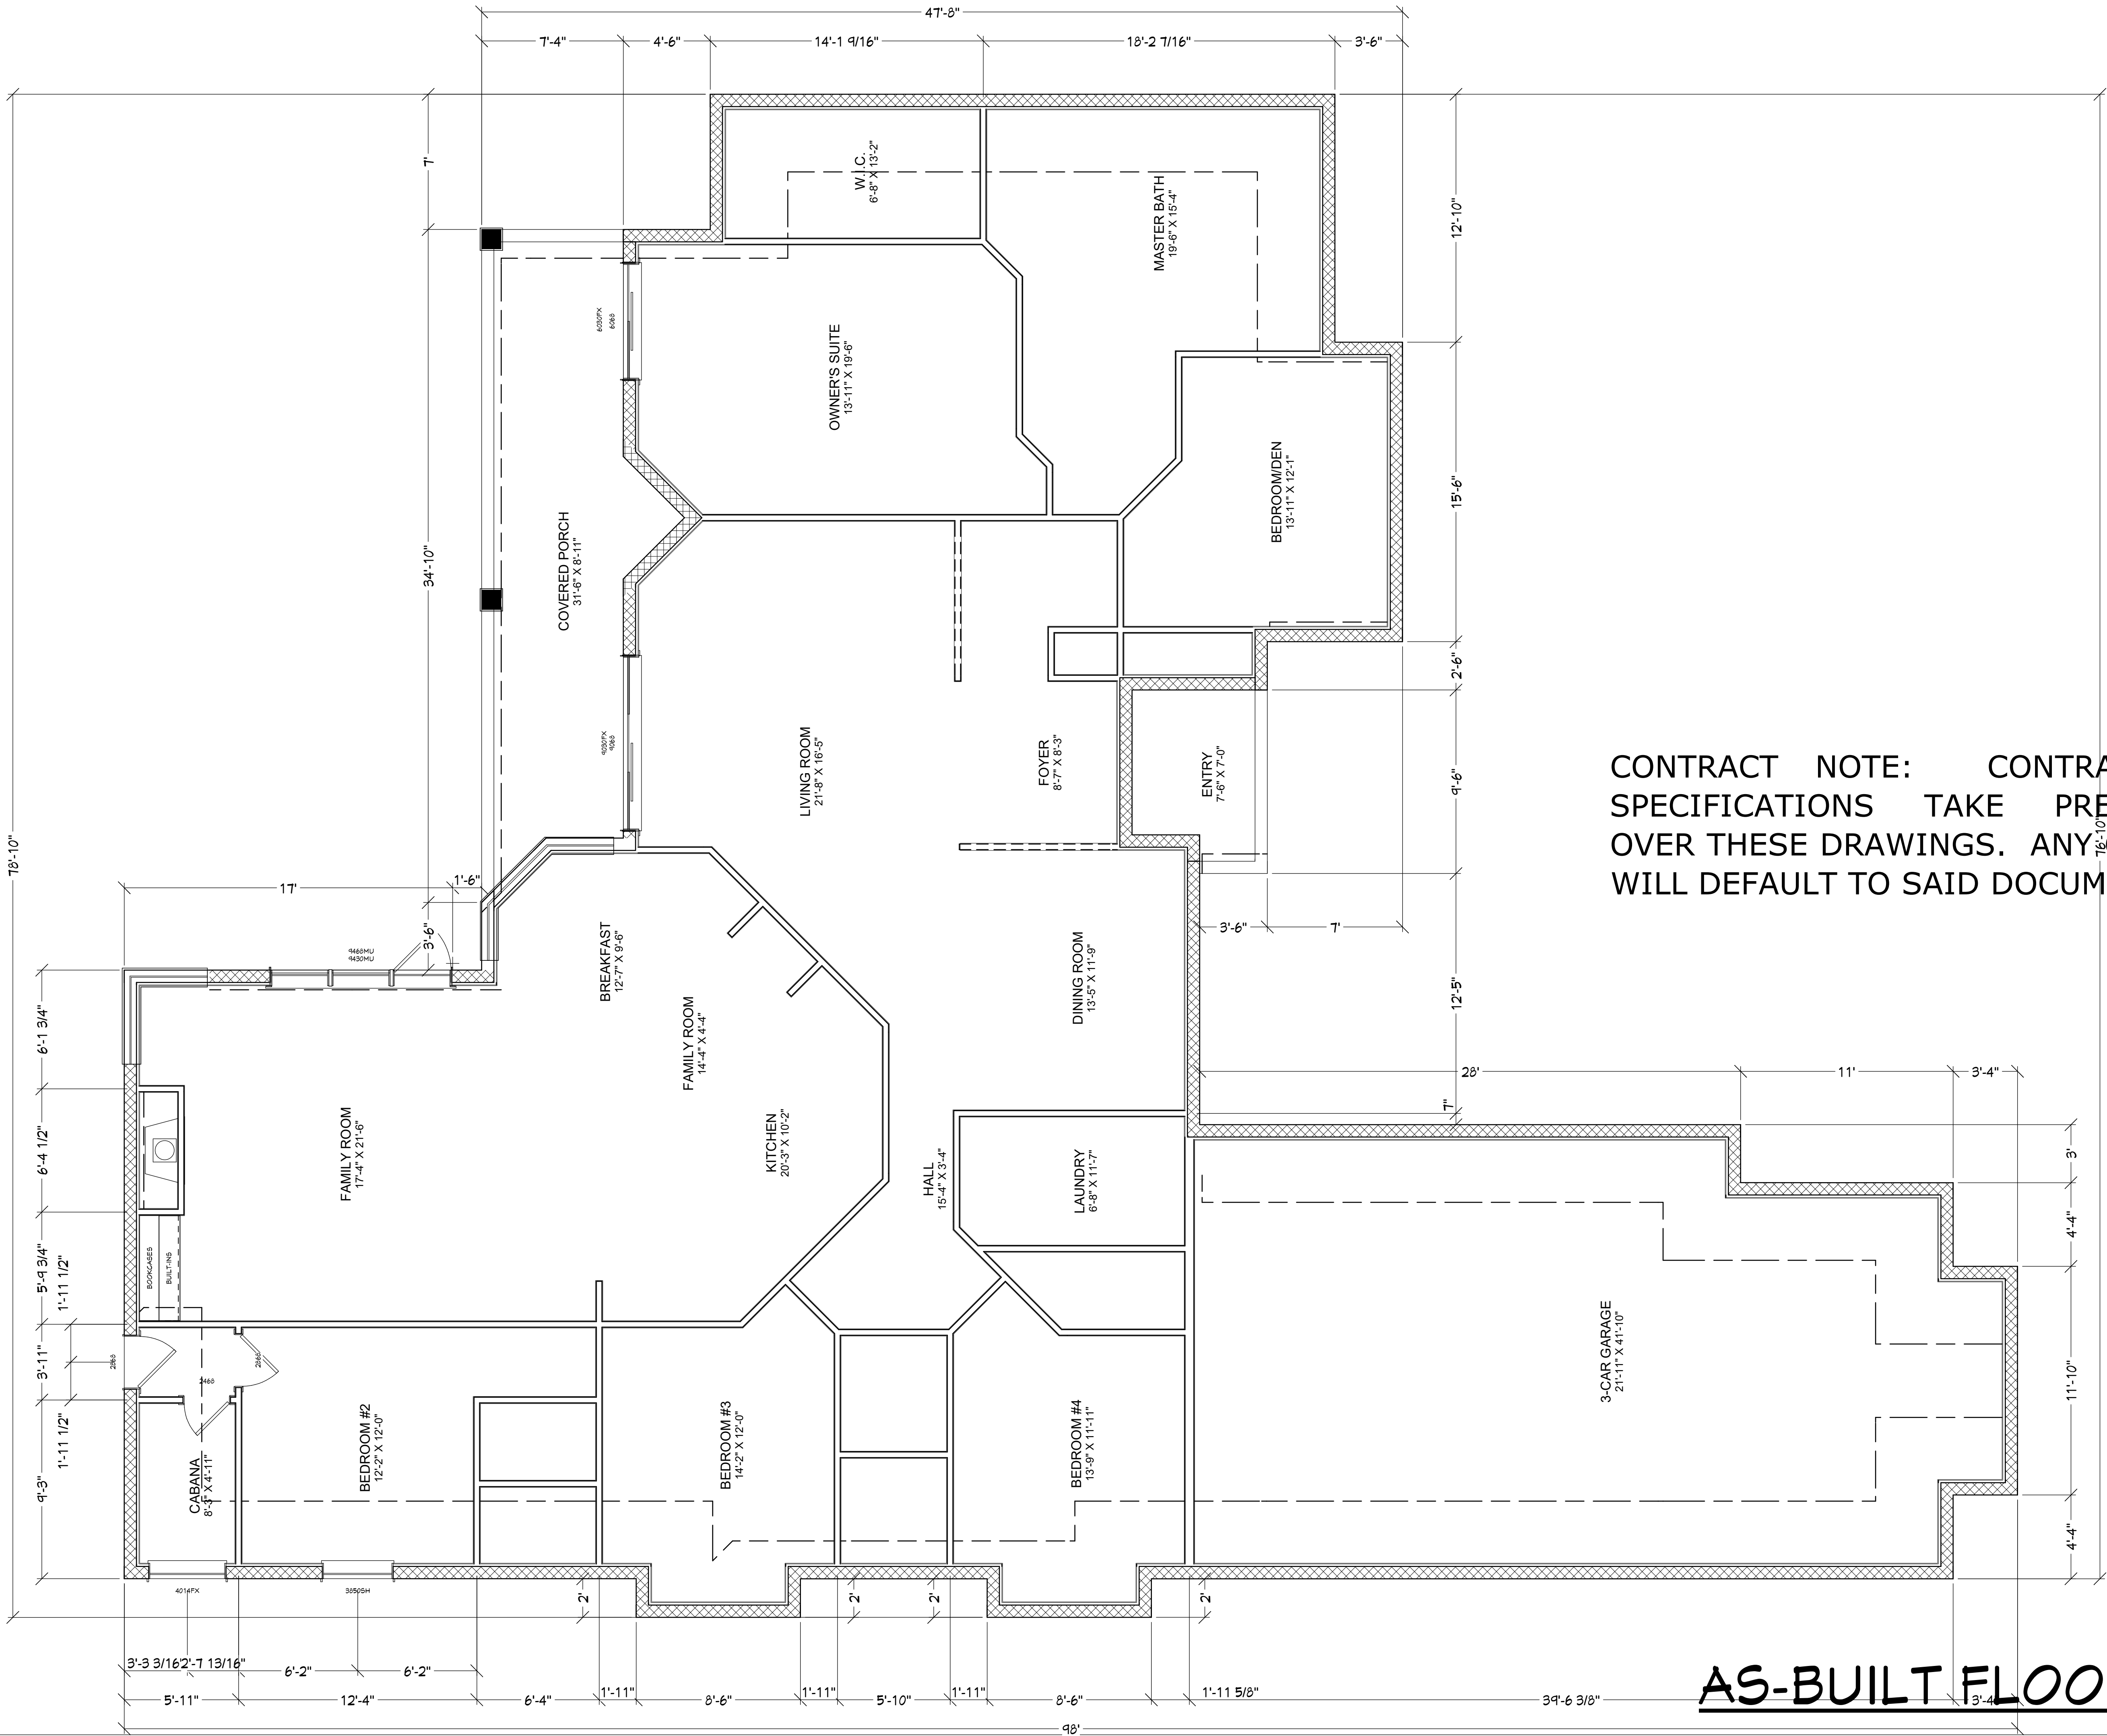

COPYRIGHT 2016: DESIGNS FOR LIVING, LLC. -Under section 102 of the Architectural Works Copyright Protection Act (title 17 of the United States Code) specific tact copyright laws apply to original design of a building created in any tangible medium of expression, including a constructed building or architectural plans, models, or drawings and is subject to copyright protection as an "architectural work" by Designs for Living, LLC. herein referred to as Designer. It is unlawful for anyone to copy these drawings, either in whole or in part, without the express written permission of the Designer. The use of any plans, specifications, electronic or hard copy prints shall be restricted to the original site for which they were prepared and publication thereof is expressly limited to such use. Title to all works, specifically all drawings, specifications, and modified derivatives of any blueprints, e-files, drawings, or specifications remain the Designers without prejudice. VISUAL CONTACT with any of these drawings, or their purchase constitutes prima facie evidence of the acceptance of these restrictions! This has held precedent in the North Florida Court system! Any and all violations WILL result in legal action being taken and litigated damages to the full extent allowed by law! No exceptions and no excuses! Contractor &/or owner shall verify all dimensions, details, & specifications prior to construction. 

PLAN #
1236-R

CLIENT APPROVAL SIGNATURE

DATE

BUILT BY:

DOXA PROPERTIES, LLC
8862 CANOPY OAKS DRIVE
JACKSONVILLE, FL 32256
904-219-9279 CGC1504721

PROJECT DESCRIPTION:

LUCAS-STRANAHAN RENOVATIONS
1236 SALT CREEK ISLAND DRIVE
PONTE VEDRA BEACH, FL 32082
R/E#: 061861-0140

Design Drawings
provided by:

DESIGNS FOR LIVING, LLC
RESIDENTIAL DESIGN SINCE 1999

904-730-7135

DATE:


4/2/2017

SCALE:

1/4" = 1'-0"

SHEET:

A-3

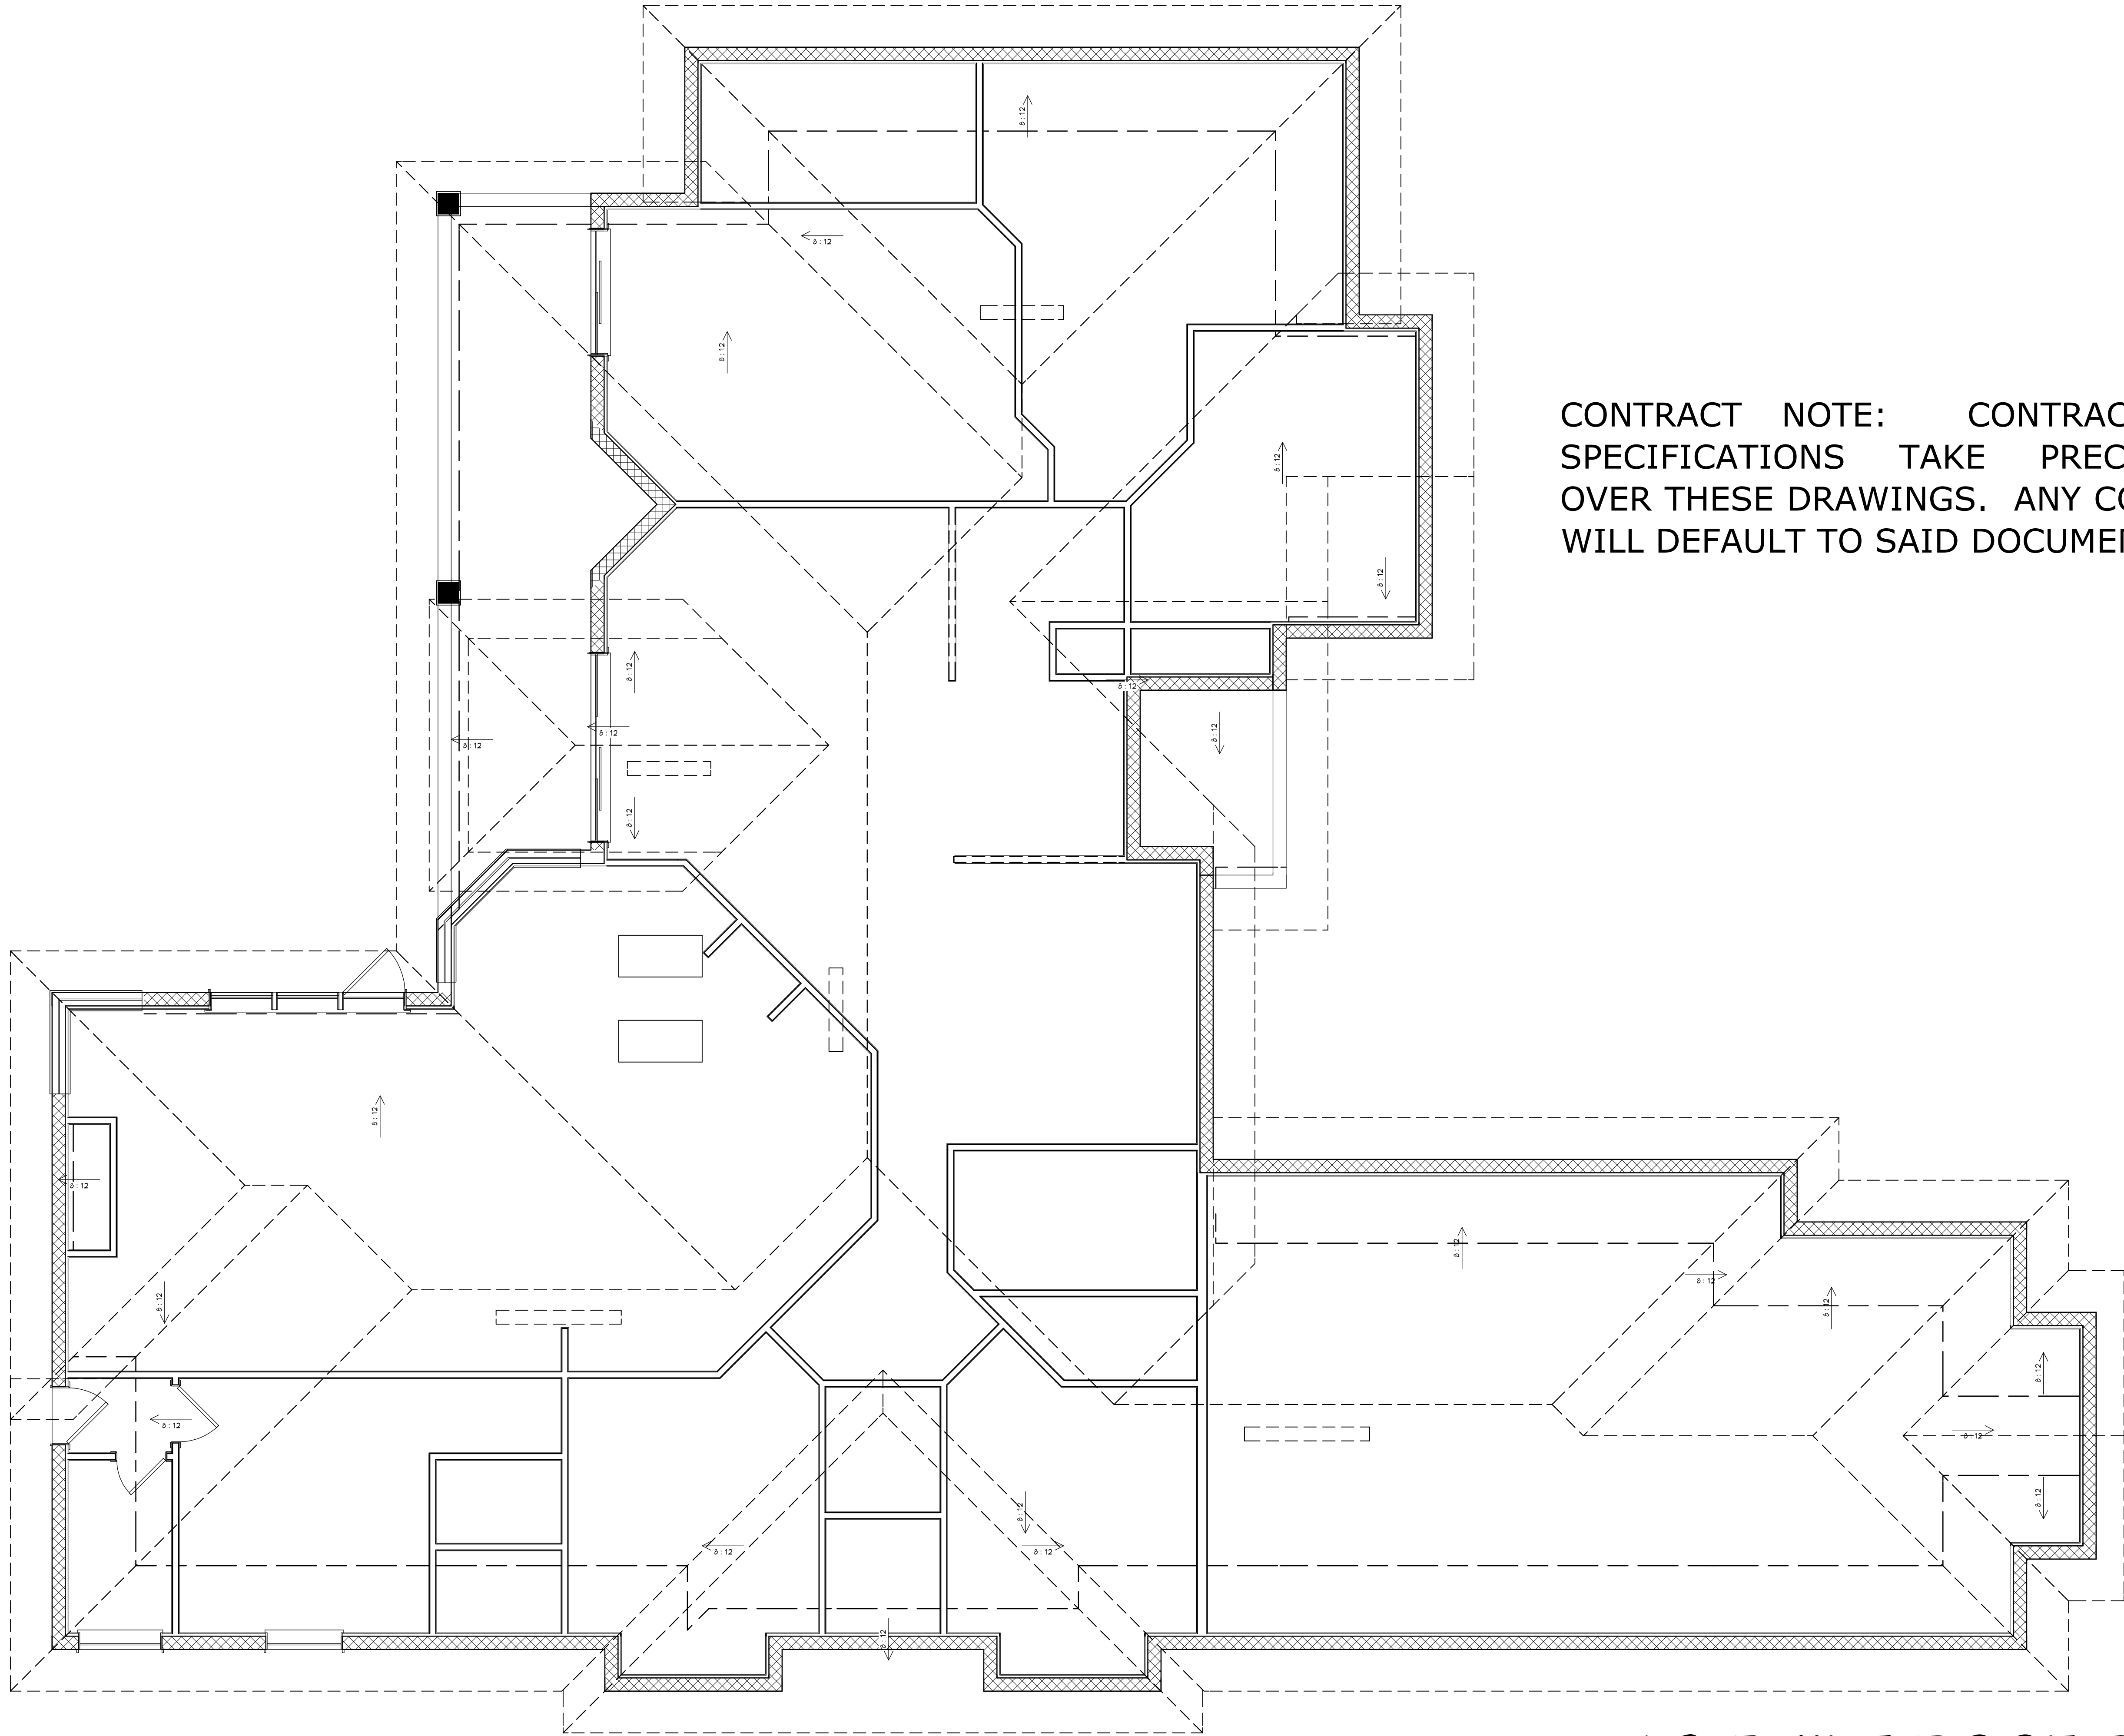

CONTRACT NOTE: CONTRACT AND SPECIFICATIONS TAKE PRECEDENCE OVER THESE DRAWINGS. ANY CONFLICT WILL DEFAULT TO SAID DOCUMENTS.

AS-BUILT ROOF PLAN

COPYRIGHT 2016: DESIGNS FOR LIVING, LLC. -Under section 102 of the Architectural Works Copyright Protection Act (title 17 of the United States Code) specific tact copyright laws apply to original design of a building created in any tangible medium of expression, including a constructed building or architectural plans, models, or drawings and is subject to copyright protection as an "architectural work" by Designs for Living, LLC. herein referred to as Designer. It is unlawful for anyone to copy these drawings, either in whole or in part, without the express written permission of the Designer. The use of any plans, specifications, electronic or hard copy prints shall be restricted to the original site for which they were prepared and publication thereof is expressly limited to such use. Title to all works, specifically all drawings, specifications, and modified derivatives of any blueprints, e-files, drawings, or specifications remain the Designers without prejudice. VISUAL CONTACT with any of these drawings, or their purchase constitutes prima facie evidence of the acceptance of these restrictions! This has held precedent in the North Florida Court system! Any and all violations WILL result in legal action being taken and litigated damages to the full extent allowed by law! No exceptions and no excuses! Contractor &/or owner shall verify all dimensions, details, & specifications prior to construction. 




DATE:
4/2/2017
SCALE:
1/4" = 1'-0"
SHEET:
A-4

PROJECT DESCRIPTION:
LUCAS-STRANAHAN RENOVATIONS
1236 SALT CREEK ISLAND DRIVE
PONTE VEDRA BEACH, FL 32082
R/E#: 061861-0140

BUILT BY:
DOXA PROPERTIES, LLC
8862 CANOPY OAKS DRIVE
JACKSONVILLE, FL 32256
904-219-9279 CGC1504721

CLIENT APPROVAL SIGNATURE	DATE
LOREN L. LUCAS	
HARRIET A. STRANAHAN	


PLAN #
1236-R

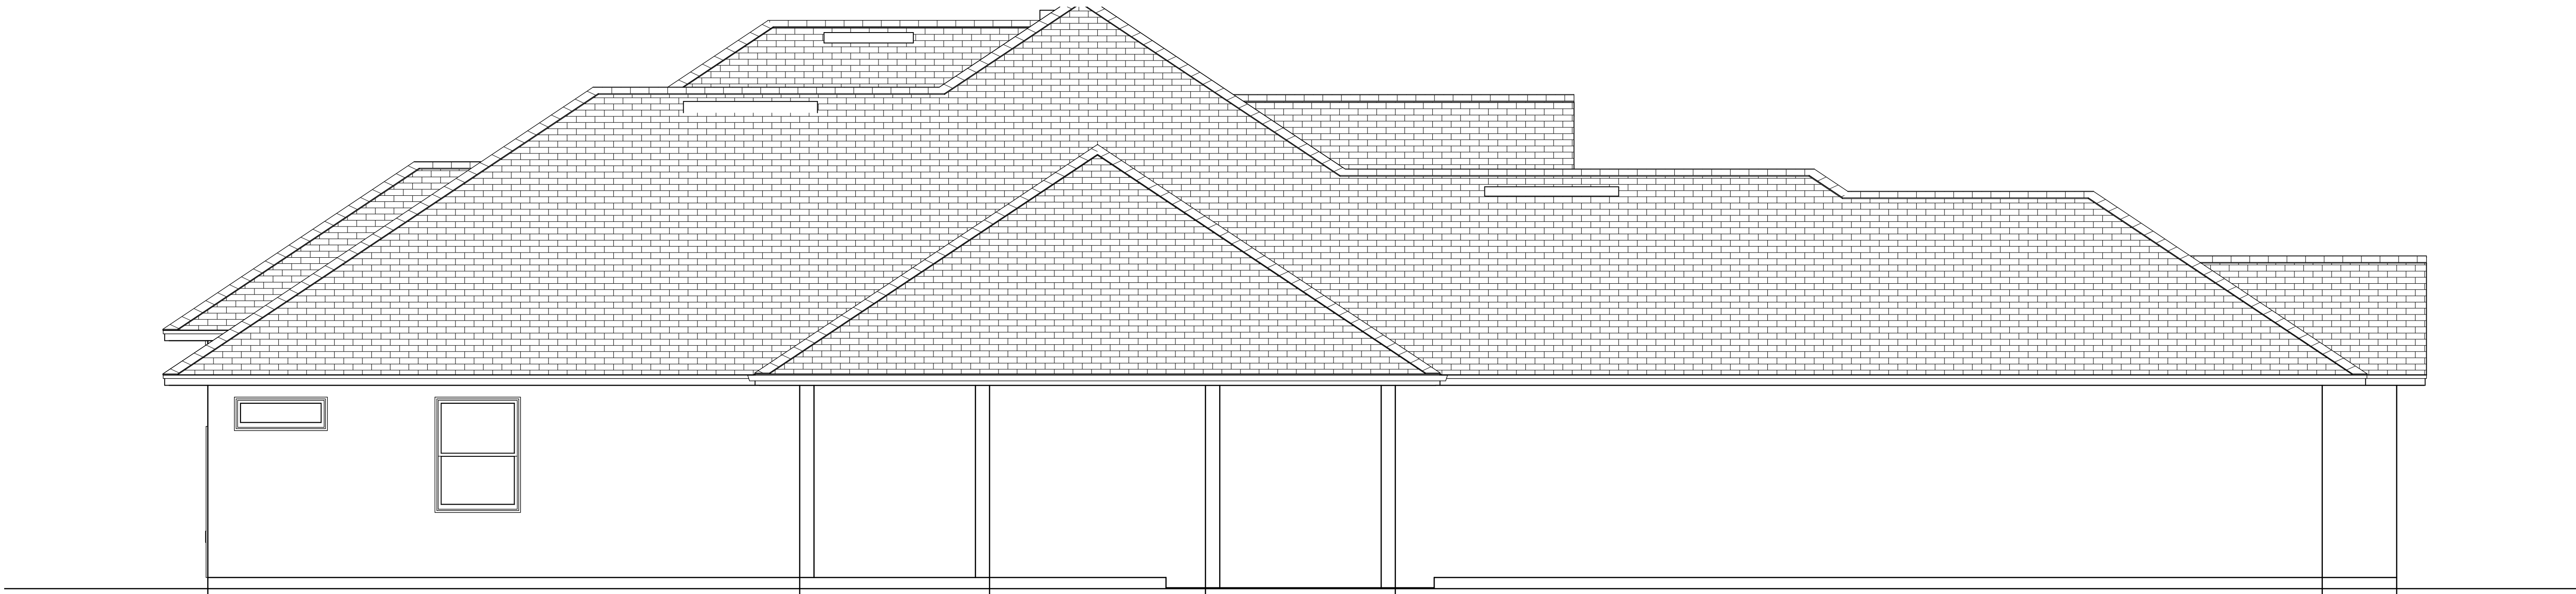

RIGHT ELEVATION



REAR ELEVATION

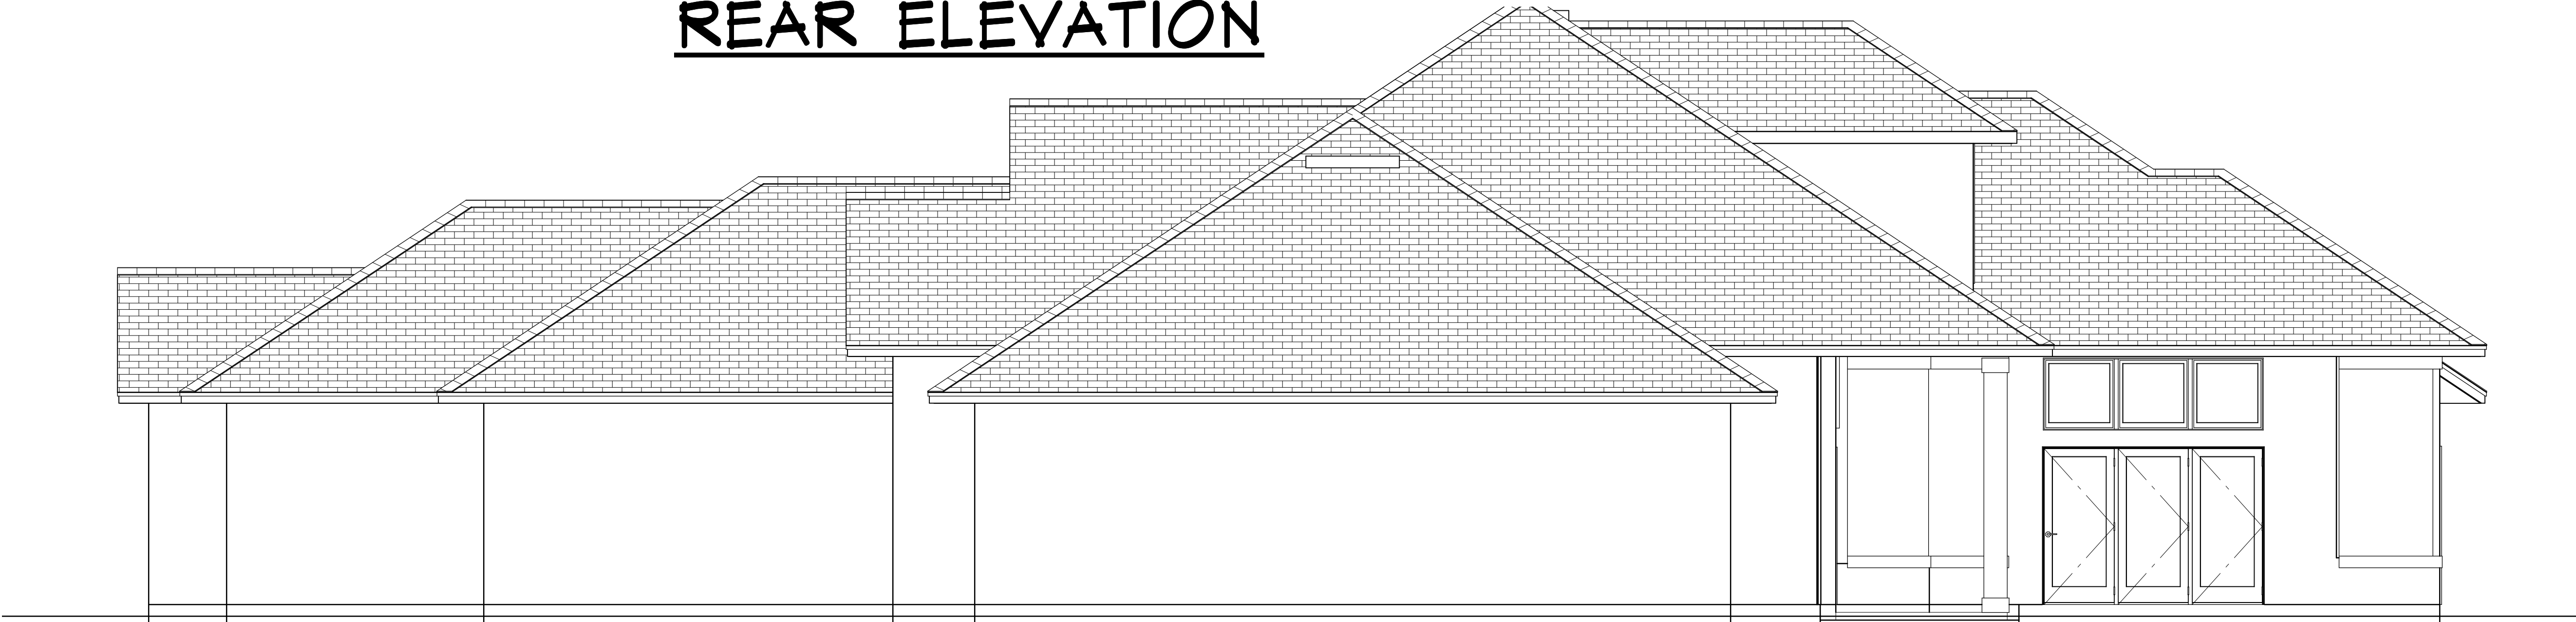

LEFT ELEVATION

AS-BUILT ELEVATIONS

CONTRACT NOTE: CONTRACT AND SPECIFICATIONS TAKE PRECEDENCE OVER THESE DRAWINGS. ANY CONFLICT WILL DEFAULT TO SAID DOCUMENTS.

COPYRIGHT 2016: DESIGNS FOR LIVING, LLC. -Under section 102 of the Architectural Works Copyright Protection Act (title 17 of the United States Code) specific tact copyright laws apply to original design of a building created in any tangible medium of expression, including a constructed building or architectural plans, models, or drawings and is subject to copyright protection as an "architectural work" by Designs for Living, LLC. herein referred to as Designer. It is unlawful for anyone to copy these drawings, either in whole or in part, without the express written permission of the Designer! The use of any plans, specifications, electronic or hard copy prints shall be restricted to the original site for which they were prepared and publication thereof is expressly limited to such use. Title to all works, specifically all drawings, specifications, and modified derivatives of any blueprints, e-files, drawings, or specifications remain the Designers without prejudice. VISUAL CONTACT with any of these drawings, or their purchase constitutes prima facie evidence of the acceptance of these restrictions! This has held precedent in the North Florida Court system! Any and all violations WILL result in legal action being taken and litigated damages to the full extent allowed by law! No exceptions and no excuses! Contractor &/or owner shall verify all dimensions, details, & specifications prior to construction. Every attempt has been made to avoid mistakes. The Designer and/or owner also assume no responsibility for any errors or omissions in the drawings or specifications. Copyright release approval and design for the drawings and specifications is given by the Designer and/or owner. Copyright infringement or other errors after delivery via email or drawings including after construction has begun. This copyright law is only valid on building designs created on or after December 1, 1990.

DATE:
4/2/2017

SCALE:
1/4" = 1'-0"

SHEET:
A-5



PROJECT DESCRIPTION:
LUCAS-STRANAHAN RENOVATIONS
1236 SALT CREEK ISLAND DRIVE
PONTE VEDRA BEACH, FL 32082
R/E#: 061861-0140

BUILT BY:
DOXA PROPERTIES, LLC
8862 CANOPY OAKS DRIVE
JACKSONVILLE, FL 32256
904-219-9279 CGC1504721

CLIENT APPROVAL SIGNATURE	DATE
LOREN L. LUCAS	
HARRIET A. STRANAHAN	

PLAN #
1236-R



CONTRACT NOTE: CONTRACT AND SPECIFICATIONS TAKE PRECEDENCE OVER THESE DRAWINGS. ANY CONFLICT WILL DEFAULT TO SAID DOCUMENTS.

AS-BUILT ISOMETRIC VIEWS

COPYRIGHT 2016: DESIGNS FOR LIVING, LLC - Under section 102 of the Architectural Works Copyright Protection Act (title 17 of the United States Code) specific tacit copyright laws apply to original design of any tangible medium of expression, including a constructed building or architectural plans, models, or drawings and is subject to copyright protection as an "architectural work" by Designs for Living, LLC. herein referred to as Designer. It is unlawful for anyone to copy these drawings, either in whole or in part, without the express written permission of the Designer! The use of any plans, specifications, electronic or hard copy prints shall be restricted to the original site for where they were prepared and publication thereof is expressly limited to such use. Title to all works, specifically all drawings, specifications, and modified derivatives of any blueprints, e-files, drawings, or specifications remain the Designer's without prejudice. VISUAL CONTACT with any of these drawings, or their purchase constitutes prima facie evidence of the acceptance of these restrictions! This has held precedent in the North Florida Court system! Any and all violations WILL result in legal action being taken and litigated damages to the full extent allowed by law! No exceptions and no excuses! Contractor &/or owner shall verify all dimensions, details, & specifications prior to construction. Every attempt has been made to avoid mistakes. The contractor and the owners also fully acknowledge that they have full copyright release approval and Designs for Living LLC nor R.E. Chip Mitchell shall not be liable for error for copyright infringement or other errors after delivery via email of drawings including after construction has begun! This copyright law is only valid on building designs created on or after December 1, 1990.

CLIENT APPROVAL SIGNATURE	DATE
LOREN L. LUCAS	
HARRIET A. STRANAHAN	

BUILT BY:
DOXA PROPERTIES, LLC
8862 CANOPY OAKS DRIVE
JACKSONVILLE, FL 32256
904-219-9279 CGC1504721

PROJECT DESCRIPTION:
LUCAS-STRANAHAN RENOVATIONS
1236 SALT CREEK ISLAND DRIVE
PONTE VEDRA BEACH, FL 32082
R/E#: 061861-0140



DATE:


4/2/2017

SCALE:

N.T.S.

SHEET:


A-6

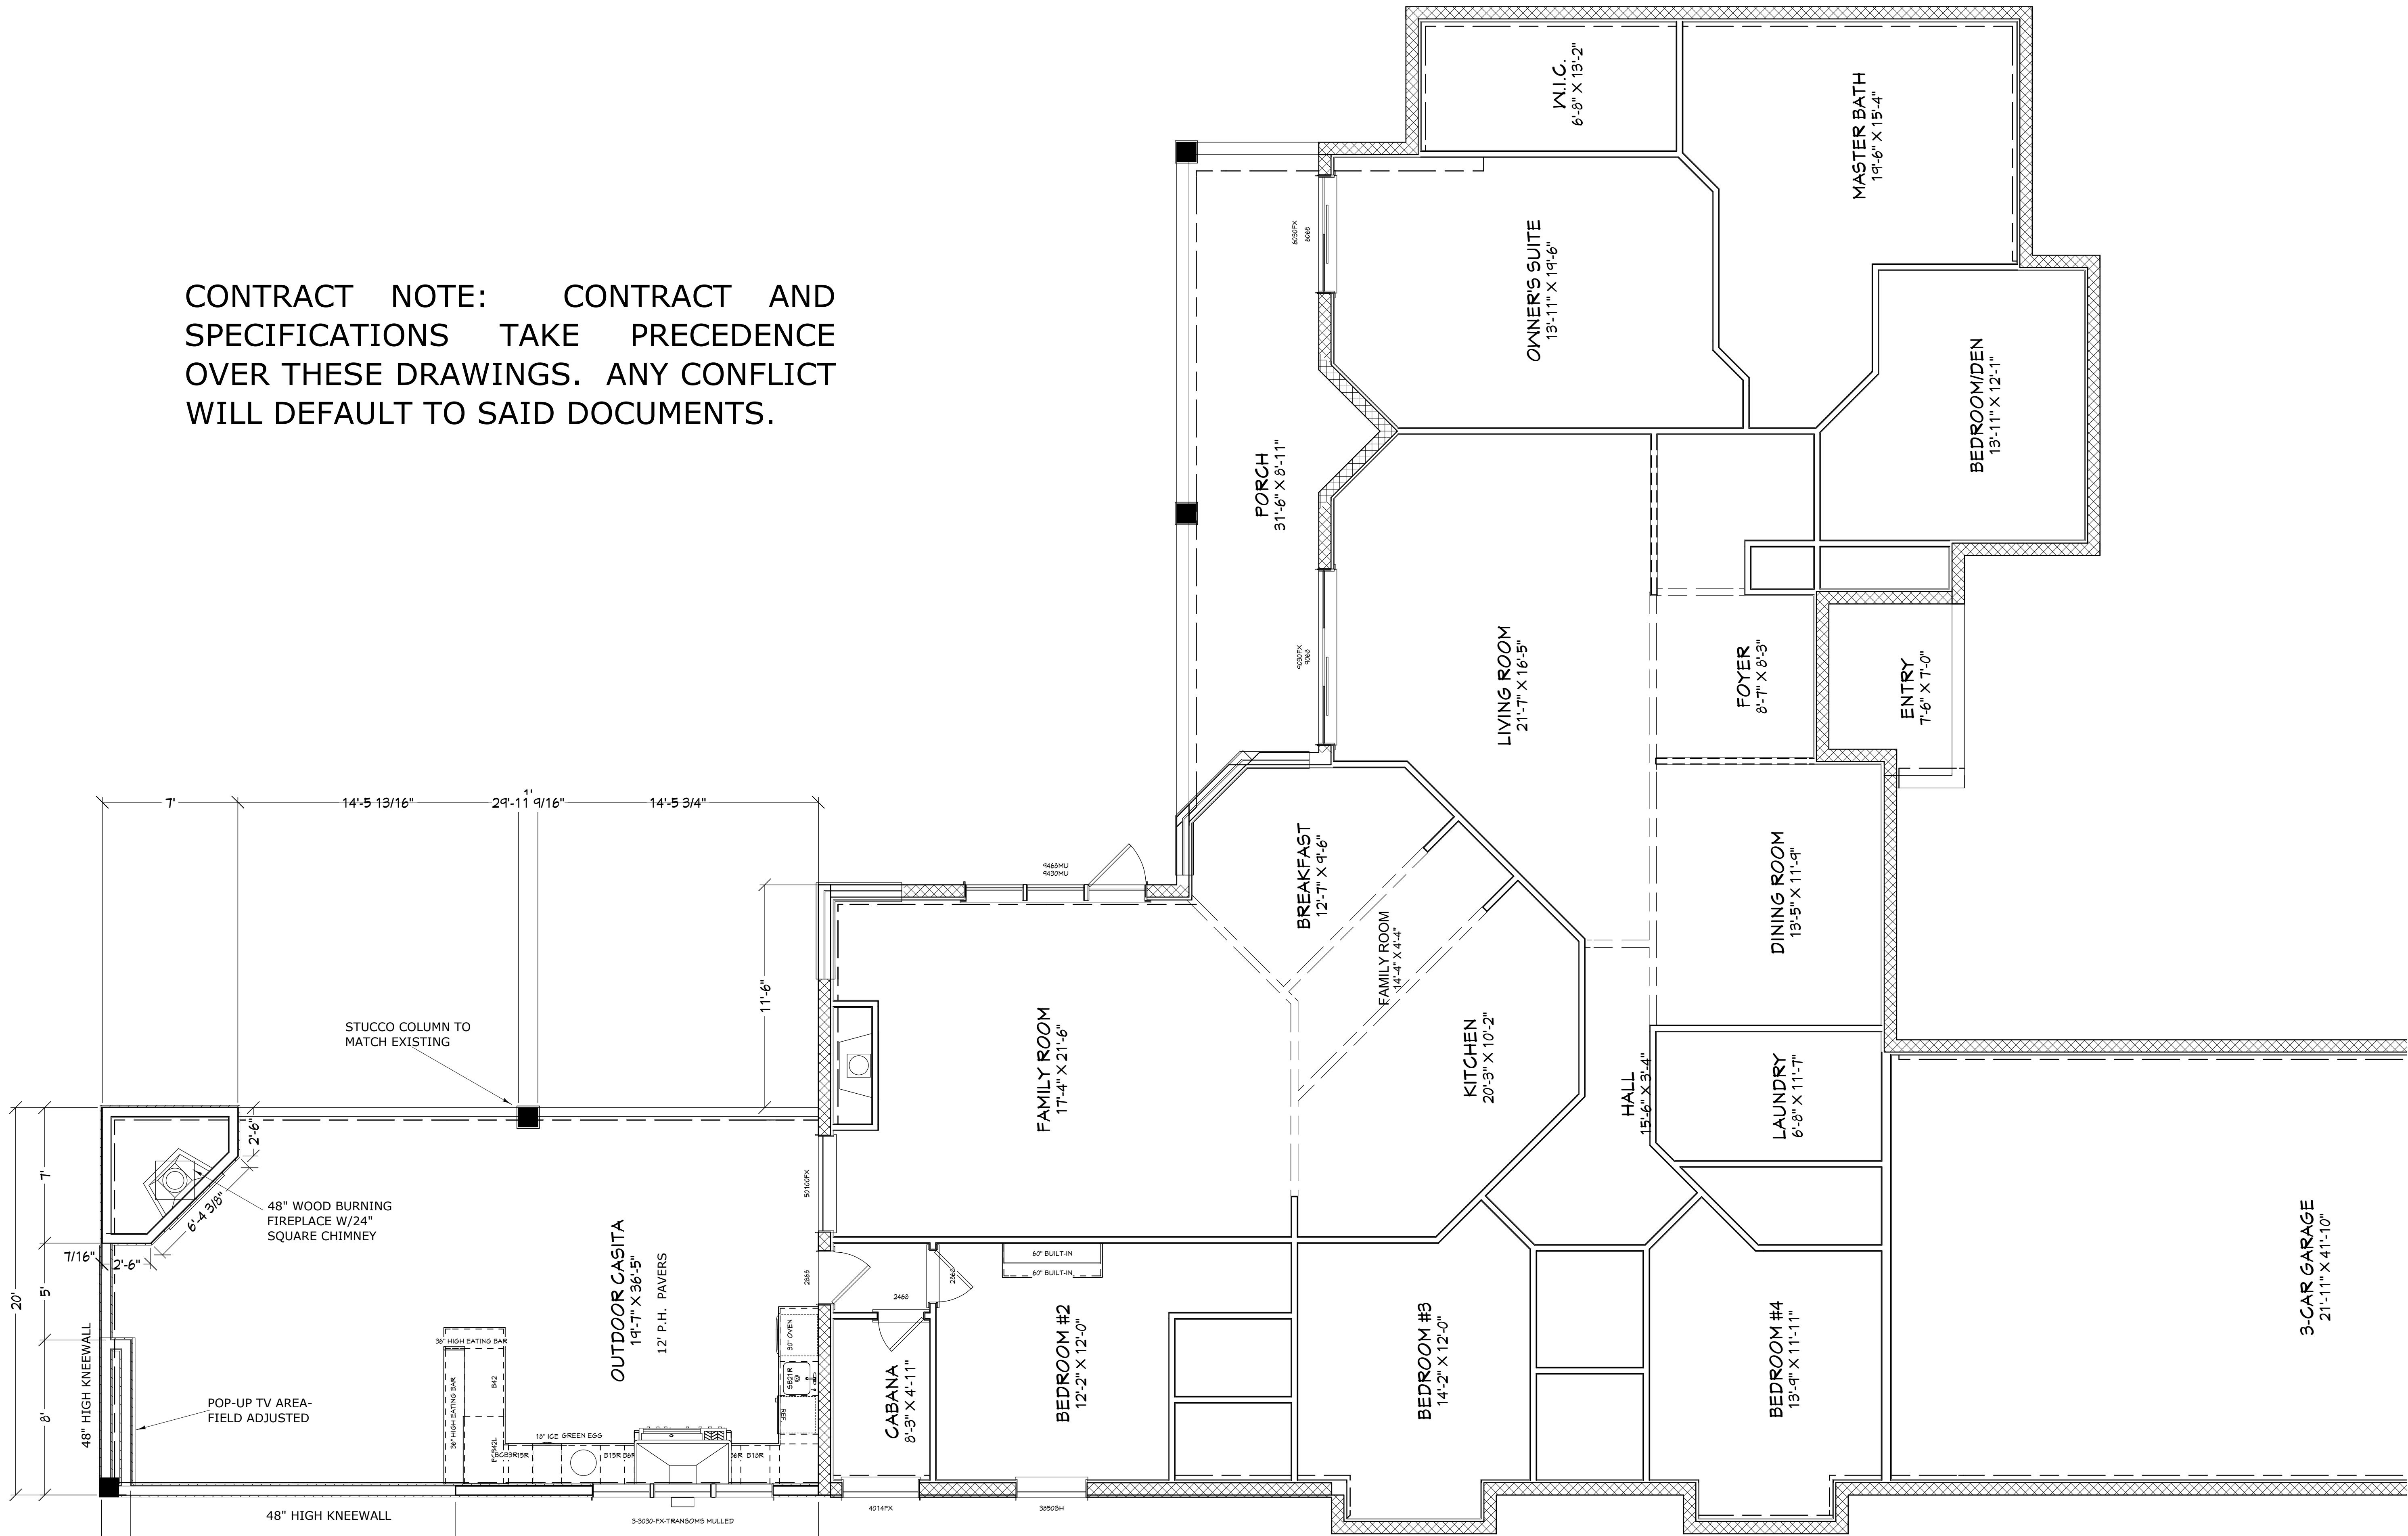
[illegible]

PROPOSED FLOOR PLAN

COPYRIGHT 2016: DESIGNS FOR LIVING, LLC. -Under section 102 of the Architectural Works Copyright Protection Act (title 17 of the United States Code) specific tacit copyright laws apply to original design of a building created in any tangible medium of expression, including a constructed building or architectural plans, models, or drawings and is subject to copyright protection as an "architectural work," by Designs for Living, LLC. herein referred to as Designer. It is unlawful for anyone to copy these drawings, either in whole or in part, without the express written permission of the Designer! The use of any plans, specifications, electronic or hard copy prints shall be restricted to the original site for which they were prepared and publication thereof is expressly limited to use. Title to all drawings, specifications, and modified derivatives of any blueprints, e-files, drawings, or specifications remain the Designer's without prejudice. VISUAL CONTACT with any of these drawings, or their purchase constitutes prima facie evidence of the acceptance of the acceptance of the full extent allowed by law! No exceptions and no excuses! Contractor &/or owner shall verify all dimensions, details, & specifications prior to construction. Every attempt has been made to avoid mistakes. The contractor and the owners also fully acknowledge that they have full legal action release and approval and Designs for Livings LLC for R.E. Chip Mitchell shall not be liable for error for copyright infringement or other errors after delivery via email of drawings including after construction has begun! This copyright law is only valid on building designs created on or after December 1, 1990.

PLAN #		DATE:
1236-R		4/2/2017
		SCALE:
		1/4" = 1'-0"
		SHEET:
A-7		

 PROJECT DESCRIPTION: LUCAS-STRANAHAN RENOVATIONS 1236 SALT CREEK ISLAND DRIVE PONTE VEDRA BEACH, FL 32082 R/E#: 061861-0140	BUILT BY:	DOXA PROPERTIES, LLC 8862 CANOPY OAKS DRIVE JACKSONVILLE, FL 32256 904-219-9279 CGC1504721
	DESIGN DRAWINGS PROVIDED BY:	 DESIGNS by LIVING, LLC RESIDENTIAL DESIGN SINCE 1999 904-730-7135
	CLIENT APPROVAL SIGNATURE	LOREN L. LUCAS
	DATE	HARRIET A. STRANAHAN

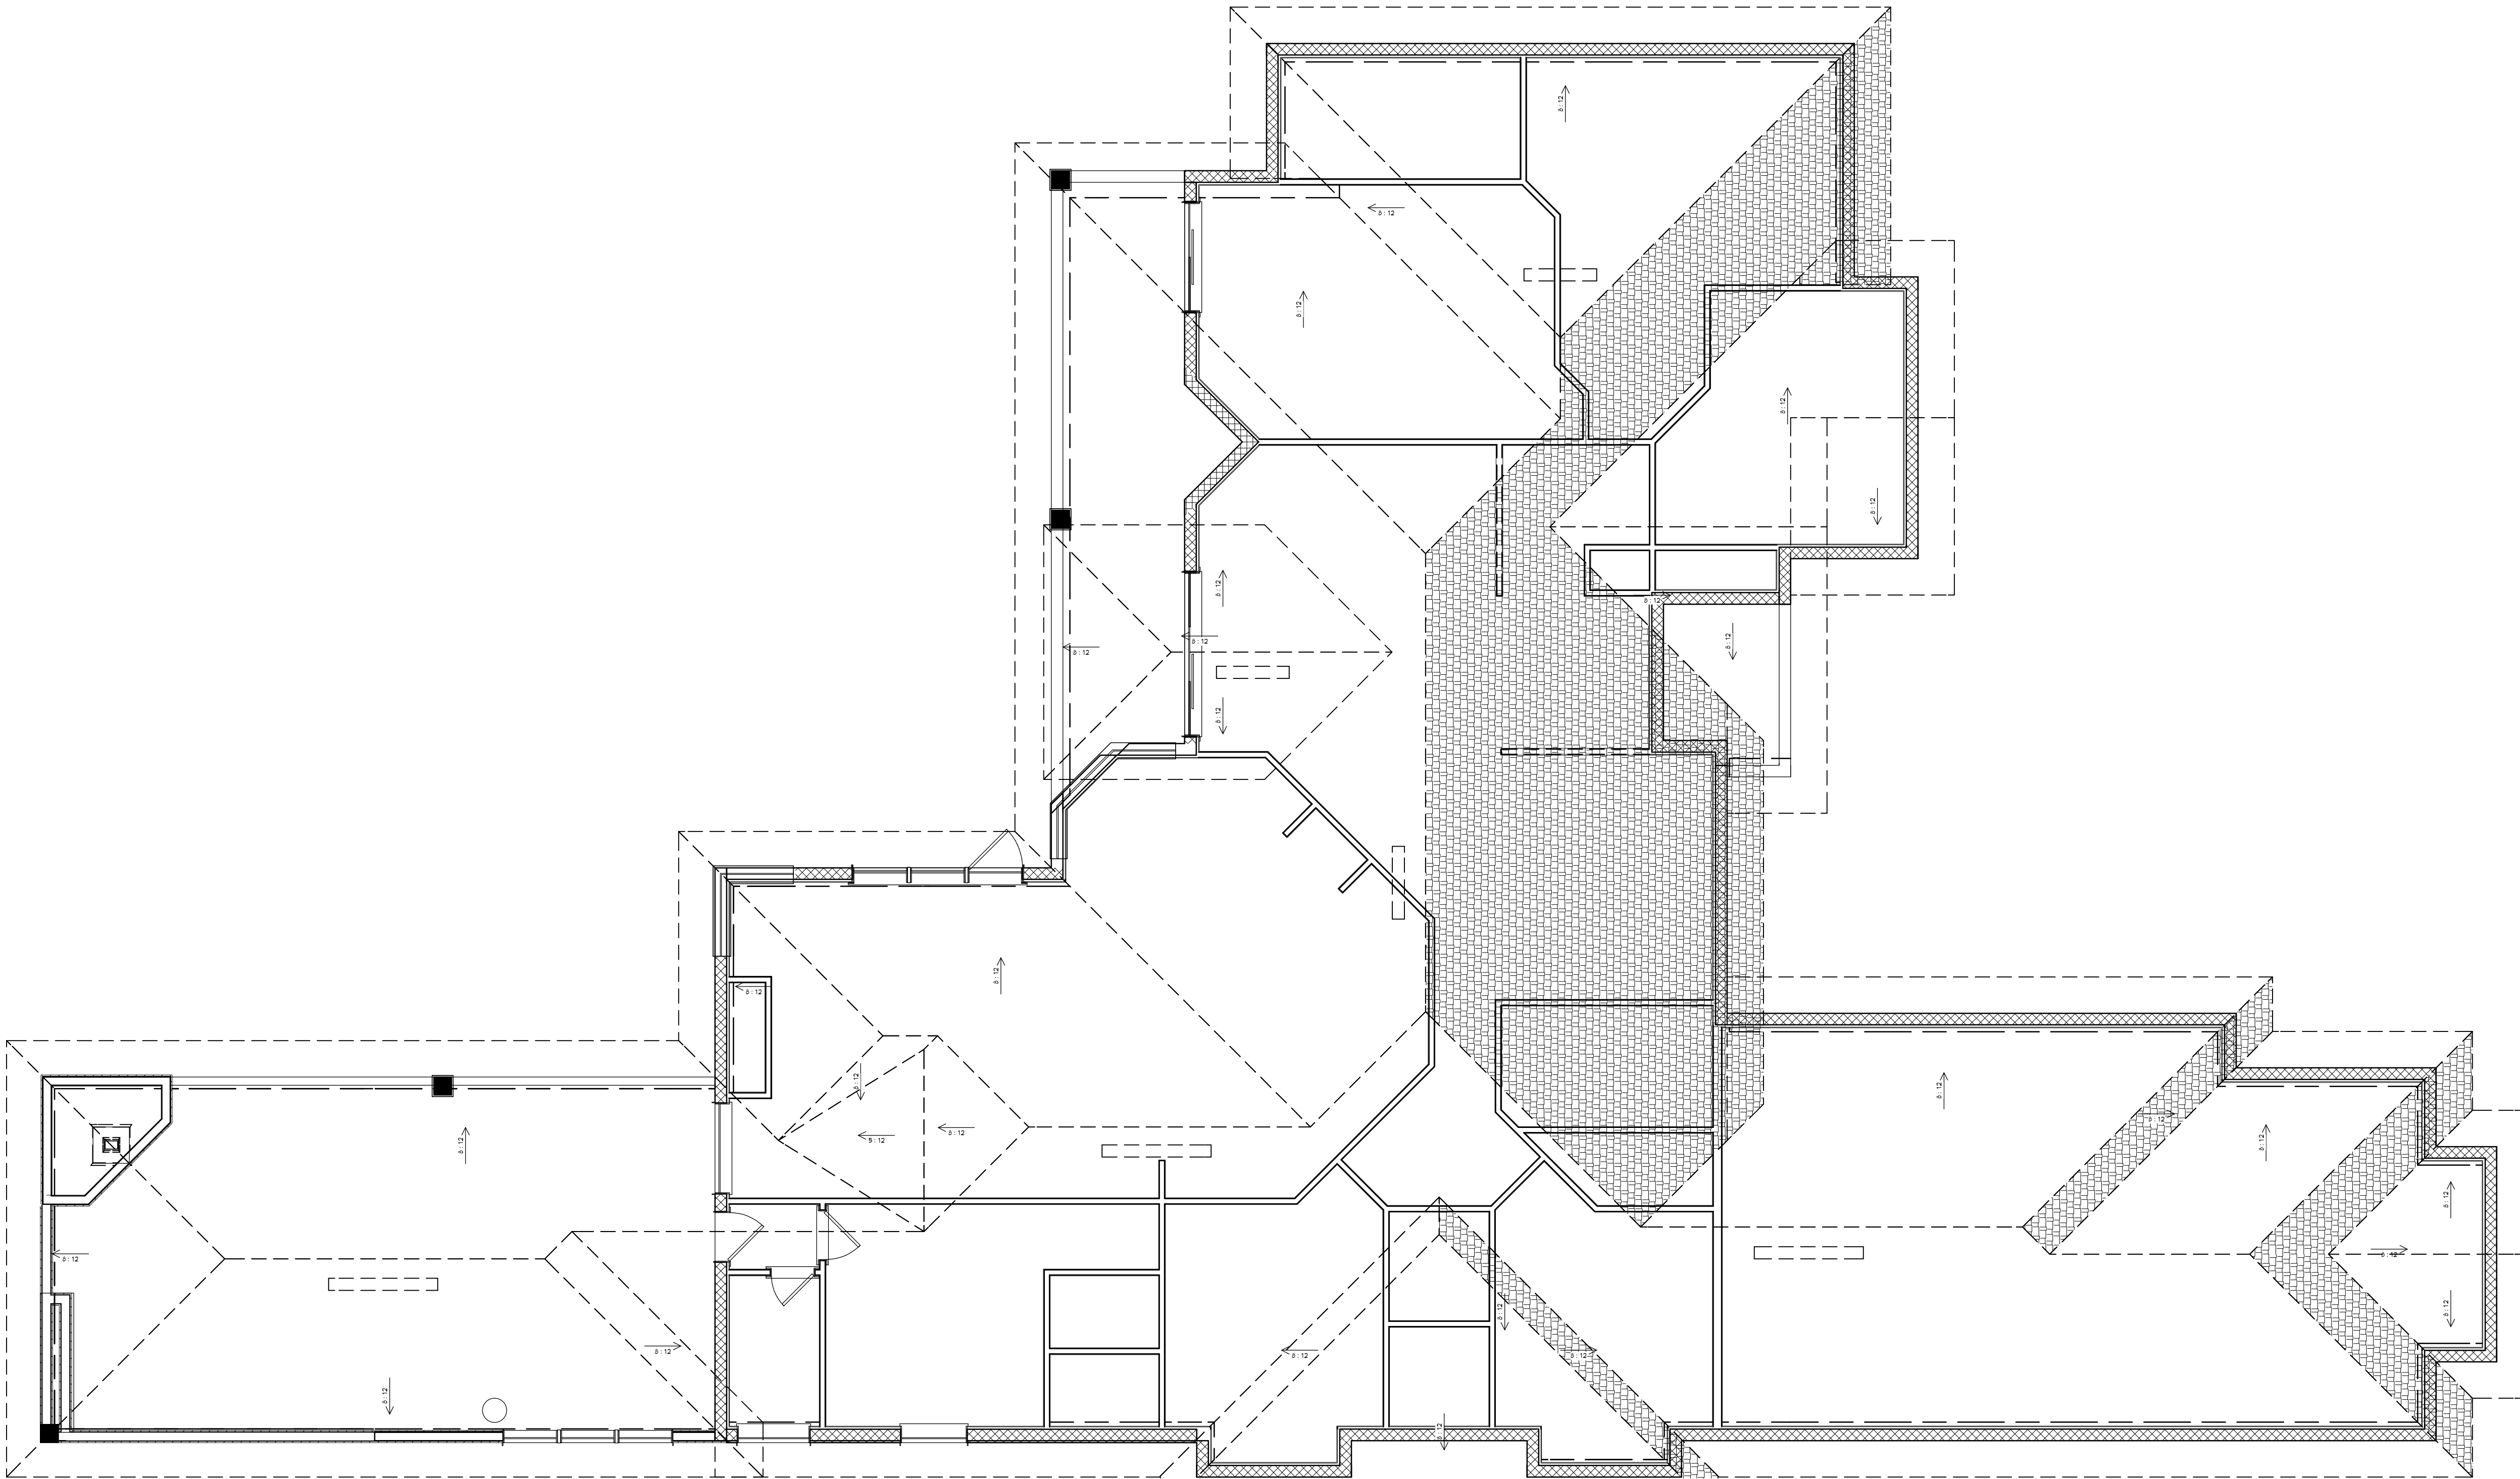

CONTRACT NOTE: CONTRACT AND SPECIFICATIONS TAKE PRECEDENCE OVER THESE DRAWINGS. ANY CONFLICT WILL DEFAULT TO SAID DOCUMENTS.

PROPOSED ROOF PLAN

COPYRIGHT 2016: DESIGNS FOR LIVING, LLC. -Under section 102 of the Architectural Works Copyright Protection Act (title 17 of the United States Code) specific tact copyright laws apply to original design of a building created in any tangible medium of expression, including a constructed building or architectural plans, models, or drawings and is subject to copyright protection as an "architectural work" by Designs for Living, LLC. herein referred to as Designer. It is unlawful for anyone to copy these drawings, either in whole or in part, without the express written permission of the Designer. The use of any plans, specifications, electronic or hard copy prints shall be restricted to the original site for which they were prepared and publication thereof is expressly limited to such use. Title to all works, specifically all drawings, specifications, and modified derivatives of any blueprints, e-files, drawings, or specifications remain the Designers without prejudice. VISUAL CONTACT with any of these drawings, or their purchase constitutes prima facie evidence of the acceptance of these restrictions! This has held precedent in the North Florida Court system! Any and all violations WILL result in legal action being taken and litigated damages to the full extent allowed by law! No exceptions and no excuses! Contractor &/or owner shall verify all dimensions, details, & specifications prior to construction. Every attempt has been made to avoid mistakes. The Designer and owner also assume responsibility for any errors or omissions in the drawings. Copyright release approval and design for drawings 10/1/2016 for K.E. Chip Mitchell shall not be liable for error for copyright infringement or other errors after delivery via email of drawings including after construction has begun. This copyright law is only valid on building designs created on or after December 1, 1990.

BUILT BY:
DOXA PROPERTIES, LLC
8862 CANOPY OAKS DRIVE
JACKSONVILLE, FL 32256
904-219-9279 CGC1504721


PROJECT DESCRIPTION:
LUCAS-STRANAHAN RENOVATIONS
1236 SALT CREEK ISLAND DRIVE
PONTE VEDRA BEACH, FL 32082
R/E#: 061861-0140



DATE:
4/2/2017
SCALE:
3/16" = 1'-0"
SHEET:
A-8

CLIENT APPROVAL SIGNATURE	DATE
LOREN L. LUCAS	
HARRIET A. STRANAHAN	


PLAN #
1236-R

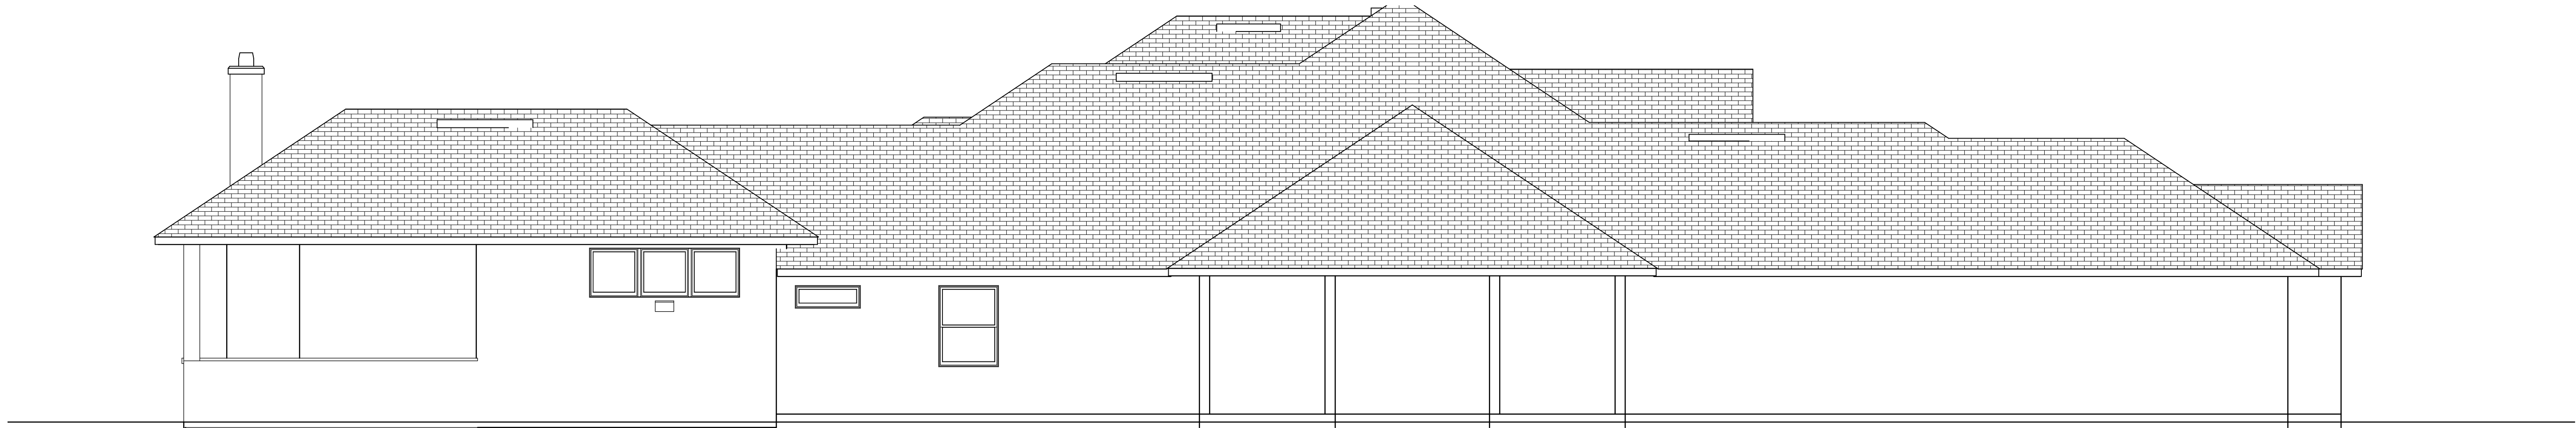

LEFT ELEVATION



REAR ELEVATION

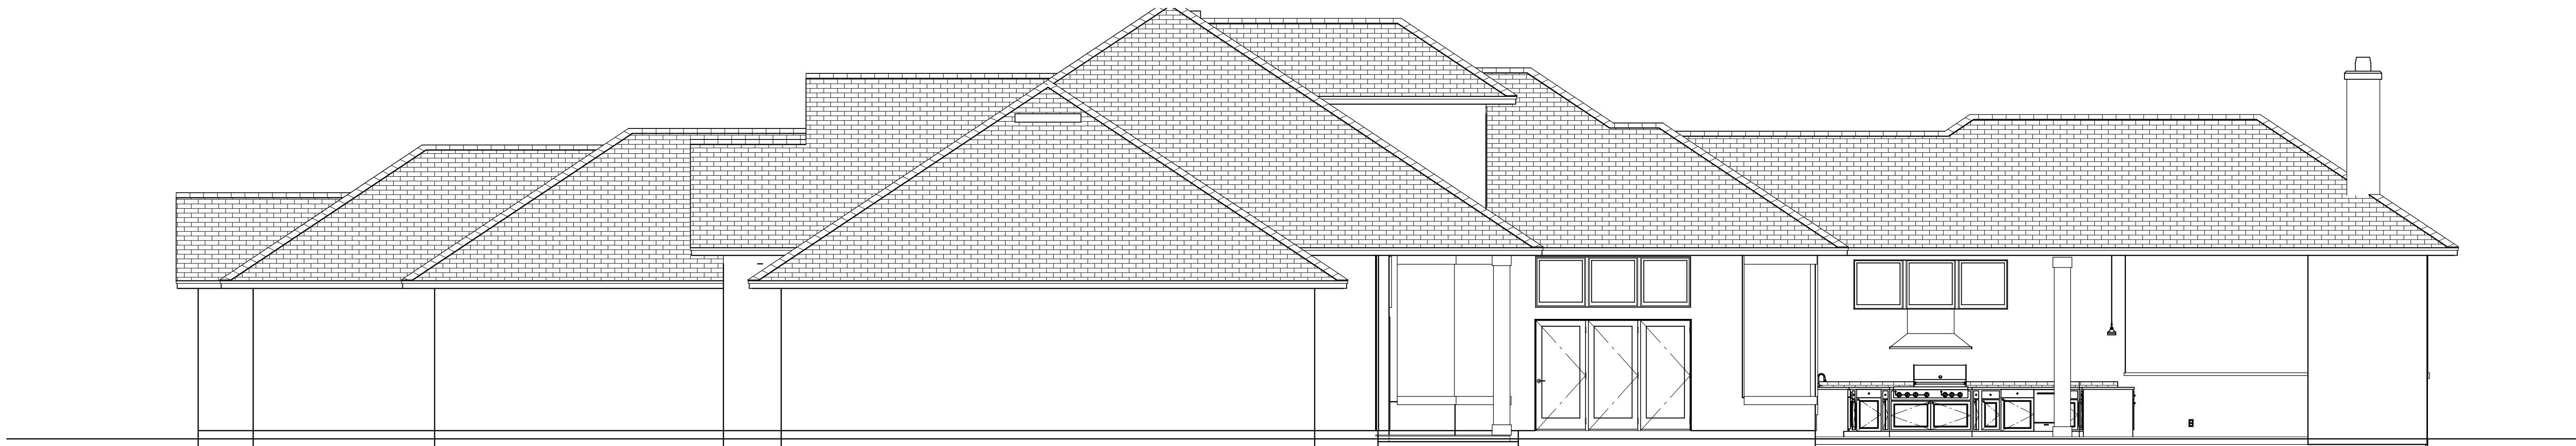


RIGHT ELEVATION

PROPOSED ELEVATIONS

CONTRACT NOTE: CONTRACT AND SPECIFICATIONS TAKE PRECEDENCE OVER THESE DRAWINGS. ANY CONFLICT WILL DEFAULT TO SAID DOCUMENTS.

COPYRIGHT 2016: DESIGNS FOR LIVING, LLC. -Under section 102 of the Architectural Works Copyright Protection Act (title 17 of the United States Code) specific tact copyright laws apply to original design of a building created in any tangible medium of expression, including a constructed building or architectural plans, models, or drawings and is subject to copyright protection as an "architectural work" by Designs for Living, LLC. herein referred to as Designer. It is unlawful for anyone to copy these drawings, either in whole or in part, without the express written permission of the Designer. The use of any plans, specifications, electronic or hard copy prints shall be restricted to the original site for which they were prepared and publication thereof is expressly limited to such use. Title to all works, specifically all drawings, specifications, and modified derivatives of any blueprints, e-files, drawings, or specifications remain the Designers without prejudice. VISUAL CONTACT with any of these drawings, or their purchase constitutes prima facie evidence of the acceptance of these restrictions! This has held precedent in the North Florida Court system! Any and all violations WILL result in legal action being taken and litigated damages to the full extent allowed by law! No exceptions and no excuses! Contractor &/or owner shall verify all dimensions, details, & specifications prior to construction. Every attempt has been made to avoid mistakes. The Designer and owner are equally responsible for any mistakes. Copyright release approval and design for drawings is only valid on building designs created on or after December 1, 1990. Copyright infringement or other errors after delivery via email or drawings including after construction has begun. This copyright law is only valid on building designs created on or after December 1, 1990.

Design Drawings
provided by:

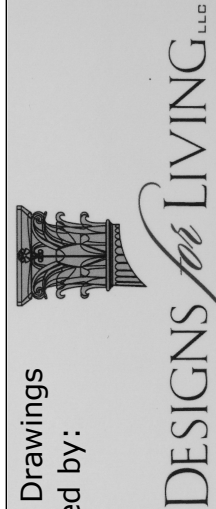

904-730-7135

PROJECT DESCRIPTION:

LUCAS-STRANAHAN RENOVATIONS
1236 SALT CREEK ISLAND DRIVE
PONTE VEDRA BEACH, FL 32082

R/E#: 061861-0140

BUILT BY:

DOXA PROPERTIES, LLC
8862 CANOPY OAKS DRIVE
JACKSONVILLE, FL 32256
904-219-9279 CGC1504721

CLIENT APPROVAL SIGNATURE

LOREN L. LUCAS
HARRIET A. STRANAHAN

DATE

DATE:

4/2/2017

SCALE:

3/16" = 1'-0"

SHEET:

A-9

PLAN #
1236-R



CONTRACT NOTE: CONTRACT AND SPECIFICATIONS TAKE PRECEDENCE OVER THESE DRAWINGS. ANY CONFLICT WILL DEFAULT TO SAID DOCUMENTS.

PROPOSED ISOMETRICS

COPYRIGHT 2016: DESIGNS FOR LIVING, LLC. -Under section 102 of the Architectural Works Copyright Protection Act (title 17 of the United States Code) specific tact copyright laws apply to original design of a building created in any tangible medium of expression, including a constructed building or architectural plans, models, or drawings and is subject to copyright protection as an "architectural work" by Designs for Living, LLC. herein referred to as Designer. It is unlawful for anyone to copy these drawings, either in whole or in part, without the express written permission of the Designer! The use of any plans, specifications, electronic or hard copy prints shall be restricted to the original site for which they were prepared and publication thereof is expressly limited to such use. Title to all works, specifically all drawings, specifications, and modified derivatives of any blueprints, e-files, drawings, or specifications remain the Designers without prejudice. VISUAL CONTACT with any of these drawings, or their purchase constitutes prima facie evidence of the acceptance of these restrictions! This has held precedent in the North Florida Court system! Any and all violations WILL result in legal action being taken and litigated damages to the full extent allowed by law! No exceptions and no excuses! Contractor &/or owner shall verify all dimensions, details, & specifications prior to construction. Every attempt will be made to avoid errors and omissions and as such, the Designer does not warrant the accuracy of the drawings. Copyright release approval and design for drawings is for K.E. Chip Mitchell shall not be liable for copyright infringement or other errors after delivery via email of drawings including after construction has begun. This copyright law is only valid on building designs created on or after December 1, 1990.

PLAN # 1236-R	
CLIENT APPROVAL SIGNATURE	DATE
LOREN L. LUCAS	
HARRIET A. STRANAHAN	
BUILT BY: DOXA PROPERTIES, LLC 8862 CANOPY OAKS DRIVE JACKSONVILLE, FL 32256 904-219-9279 CGC1504721	
PROJECT DESCRIPTION: LUCAS-STRANAHAN RENOVATIONS 1236 SALT CREEK ISLAND DRIVE PONTE VEDRA BEACH, FL 32082 R/E#: 061861-0140	
Design Drawings provided by: 904-730-7135	
DATE:	4/2/2017
SCALE:	N.T.S.
SHEET:	A-11