

ADDENDUM #01

PROJECT: UPPER POTTSGROVE TOWNSHIP NEW MUNICIPAL COMPLEX

PROJECT #: 22-0058
ISSUE DATE: April 14, 2024

BIDS DUE TO: UPLOAD TO PENBID

BIDS DUE: Thursday, May 22, 2025

The following clarifications, amendments, additions, deletions, revisions and modifications in this Addendum forms a part of the Contract Documents and modifies the original Bidding Documents as noted below. This addendum must be acknowledged in the form of proposal in the space provided for this purpose. Failure to acknowledge this addendum may subject the Bidder to disqualifications.

GENERAL

- 1. Project Manual Table of Contents has been updated to coordinate with **Addendum 01** changes.
- 2. Civil engineering ADD#01 responses included as attached document.

ADDED SPECIFICATIONS

- 1. The following specifications issued with this addendum shall be added from the Contract Documents
 - a. **SECTION 011100.01** MILESTONE CONSTRUCTION SCHEDULE
 - b. **SECTION 004300.01** A312 PAYMENT BOND 2010
 - c. **SECTION 004300.02** A312 PERFORMANCE BOND 2010
 - d. **SECTION 004300.03** A310 BID BOND 2010

REVISED SPECIFICATIONS

- 1. The following revised specifications issued with this addendum shall be made a part of the Contract Documents
 - a. **SECTION 00.0110** TABLE OF CONTENTS

REMOVED SPECIFICATIONS

- 1. The following removed specifications issued with this addendum shall be removed from the Contract Documents
 - a. NONE

ADDED DRAWINGS

1. The following added drawings issued with this addendum shall be made a part of the Contract Documents

ADMIN & POLICE BUILDING

a. **G3.00** ARCHITECTURAL SITE PLAN

PUBLIC WORKS

a. **NONE**

CIVIL DRAWINGS

a. **14.P-1** PROFILES

REVISED DRAWINGS

1. The following revised drawings issued with this addendum shall be made a part of the Contract Documents

ADMIN & POLICE BUILDING

- a. **C.0.00** COVER SHEET
- b. **G0.00** COVER SHEET
- c. A6.00 DOOR SCHEDULE & DETAILS
- d. A6.20 WINDOW TYPES AND DETAILS
- e. **A9.00** BID ALTERNATE SALLY PORT
- f. **E3.0** POWER PLAN
- g. **E4.0** FIRE ALARM PLAN

PUBLIC WORKS

a. **NONE**

CIVIL DRAWINGS

- a. 01.C-1 COVER SHEET
- b. **02.N-1** NOTES
- c. 03.EX-1 EXISTING FEATURES PLAN
- d. **04.D-1** DEMOLITION PLAN
- e. **05.S-1** SITE PLAN & DETAILS
- f. **06.ES-1** EROSION AND SEDIMENT CONTROL PLAN
- q. 07.ES-2 EROSION AND SEDIMENT CONTROL NOTES
- h. **08.ES-3** EROSION AND SEDIMENT CONTROL DETAILS
- i. **09.U-1** UTILITY PLAN
- j. **10.U-2** UTILITY DETAILS (SANITARY)
- k. 11.U-3 UTILITY DETAILS (WATER & ELECTRIC)
- I. **12.U-4** UTILITY DETAILS (ELECTRIC & GAS)
- m. 13.SWM-1 GRADING/STORMWATER MANAGEMENT PLAN
- n. 15.SWM-2 POST-CONSTRUCTION STORMWATER MANAGEMENT PLAN

- o. 16.SWM-3 POST-CONSTRUCTION STORMWATER MANAGEMENT NOTES/DETAILS
- p. 17.SWM-4 POST-CONSTRUCTION STORMWATER MANAGEMENT DETAILS
- q. **18.L-1** LANDSCAPE PLAN/DETAILS
- r. **19.LI-1** LIGHTING PLAN/NOTES
- s. 20.LI-2 LIGHTING DETAILS
- t. 21.CD-1 CONSTRUCTION DETAILS
- u. 22.CD-2 CONSTRUCTION DETAILS
- v. 23.CD-3 CONSTRUCTION DETAILS

Addendum No 1 Issued: April 14, 2025

PennBid Questions and Answers:

Q1: Is there an estimated value for each of the contracts?

A1:

Site - \$1.5M GC - \$3.6M

Plumbing - \$355,000 Mechanical - \$545,000 Electrical - \$925,000

Q2: Why are there (2) Fire Alarm panels show on E4.0 (Rms 019 & 001A)? Only (1) should be required. Also, there should be a Smoke Detector shown above the FACP

A2: Addressed on sheet E4.0 of this addendum (2) FACP panels will remain, Smoke detectors above each have been added.

Q3: Please confirm that there is no Fire Protection for this project. There are no documents or specifications, but Spec section 01.1000-1 says it is part of the Plumbing Contract.

A3: There is no Fire Protection

Q4: We are having difficulties locating the Liquidated damage amounts for this project. It is referenced multiple times in the first manual. Are we missing them?

A4: To be addressed in addendum 2

Q5: There is a copy of a Maintenance Bond in the documents, but, there does not seem to be a form for the Bid, Performance or Payment Bonds. Are AIA format documents acceptable or did we miss something.

A5: Yes attached AIA documents should be us

Q7: Does the estimated value of \$3.6 for the GC include the alternates?

A7: No

Q8: Is propane tanks and generators part of BASE Bid?

A8: Admin/PD generator will be purchased by the Owner through costars but EC will be responsible for transporting to the site, generator pad and complete install and hookup as part of base bid. Public works generator will be purchased by the Owner through costars but EC will be responsible for transporting to the site, generator pad and complete install and hookup as part of alternate bid.

Propane tanks are part of base bid.

Q9: Is well including electric part of BASE Bid?

A9: Yes

Q11: Who is responsible for the electric work associated with the grinder pump?

A11: Electrical Contractor

Addendum No 1 Issued: April 14, 2025

Q12: Is there a new holding tank on this project? Detail on page 11 of 33 Please let me know where we can find the location it will be installed.

A12: Shown on plans and in base bid



112 Moores Road, Suite 200 Malvern, PA 19355 610-644-4623 www.chesterv.com

April 14, 2025

Upper Pottsgrove Township New Municipal Complex 2290 Gilbertsville Road Pottstown, PA 19464

General Notes and Bid Document Revisions

Questions and Answers:

Below are the responses to the questions and answers from bidders. The responses are provided in bold and italics for clarity.

Q6: Please label all pipe runs, size and type of pipe, or tell me where it can be found. Please also add missing profiles of inlets and pipe. (ex OS # 102). Please add elevations for all FES end sections

Please see the attached document for all stormwater info.

Q10: Where can we find information on the type of 4 " sanitary sewer line? SDR?

All sanitary gravity piping shall be constructed of Schedule 40 Polyvinyl Chloride (PVC), as outlined in the construction specifications and shown on sanitary sewer profile.

Q13: Please label all sewer pipe runs with the size and type. Example page 9 of 11 sewer line coming out of two story stucco bldg.

All proposed sewer pipe runs are labeled excluding the connection to existing stucco building. The contractor shall be responsible for connection the proposed sewer to the existing sewer located within the basement of the building with a minimum slope of 2%.

Prepared by: Upper Pottsgrove Municipal Building Complex

Chester Valley Engineers, Inc.

CVE # 22096-2000

112 Moores Road, Suite 200 Malvern, PA 19355

Storm Drain Design

Date: 02/14/2025, Revised:

PIPE DATA

Pipe	Run	Inve	ert Elevat		Length	So	Diameter,
FROM	TO		Lievat	10110	Lengtin	30	D
US SW	DS SW	US	DS	DELTA			
(#)	(#)	(feet)	(feet)	(feet)	(feet)	(%)	(inches)
()	(,	(1001)	(.000)	(1001)	(.000)	(,,,,	(
RD1	CO2A	441.80	441.75	0.05	5	1.00	6
RD2	CO2A	441.80	441.75	0.05	5	1.00	6
CO2A	RD3	441.75	441.47	0.28	28	1.00	6
RD3	RD4	441.47	441.08	0.39	39	1.00	6
RD4	RD5	441.08	440.76	0.32	32	1.00	6
RD5	RD6	440.76	440.01	0.75	60	1.25	6
RD6	RD7	440.01	439.86	0.15	30	0.50	8
RD7	CO8A	439.86	439.74	0.12	23	0.50	8
RD8	CO8A	440.06	439.74	0.32	32	1.00	6
CO8A	FES100	439.74	439.50	0.24	48	0.50	8
OS102	FES200	436.72	436.50	0.21	43	0.50	15
RD9	RD10	437.91	437.38	0.53	53	1.00	6
RD10	CO12A	437.38	437.24	0.14	14	1.00	6
RD11	RD12	437.24	437.06	0.18	18	1.00	6
RD12	CO12A	437.06	436.89	0.17	17	1.00	6
CO12A	RD13	436.89	436.68	0.21	42	0.50	10
RD13	RD14	438.31	438.22	0.09	9	1.00	6
RD14	CO19A	437.00	436.68	0.32	32	1.00	6
RD15	CO16A	438.22	438.17	0.05	5	1.00	6
RD16	CO16A	438.22	438.17	0.05	5	1.00	6
CO16A	RD17	438.17	438.04	0.13	13	1.00	6
RD17	CO18A	438.04	437.78	0.26	26	1.00	6
RD18	CO18A	437.55	437.47	0.08	8	1.00	6
CO18A	RD19	437.78	436.97	0.81	81	1.00	6
RD19	CO19A	437.04	436.97	0.07	7	1.00	6
CO19A	FES201	436.68	436.50	0.18	36	0.50	10
014/202	614/202	427.47	426.07	0.50	00	0.50	4.5
SW204	SW203	437.47	436.97	0.50	99	0.50	15
SW203	FES202	436.97	436.50	0.47	94	0.50	15
RD20	RD21	438.33	438.04	0.29	29	1.00	6
RD21	RD21	438.04	438.04	0.29	23	1.00	6
עטצז	NUZZ	430.04	437.01	0.23	23	1.00	0

Prepared by: Upper Pottsgrove Municipal Building Complex

Chester Valley Engineers, Inc.

CVE # 22096-2000

112 Moores Road, Suite 200 Malvern, PA 19355

Storm Drain Design


Date: 02/14/2025, Revised:

PIPF DATA

PIPE DATA							
Pipe Run		Invert Elevations		Length	So	Diameter,	
FROM	TO						D
US SW	DS SW	US	DS	DELTA			
(#)	(#)	(feet)	(feet)	(feet)	(feet)	(%)	(inches)
RD22	RD23	437.81	437.61	0.20	20	1.00	6
RD23	RD24	437.61	437.37	0.24	24	1.00	6
SW207	RD24	437.49	437.37	0.12	23	0.50	10
RD24	RD25	437.37	437.16	0.21	43	0.50	10
RD25	RD26	437.16	437.06	0.10	19	0.50	10
RD26	RD27	437.06	436.95	0.11	22	0.50	10
RD27	CO32A	436.95	436.83	0.12	24	0.50	10
RD28	RD29	439.77	439.50	0.27	27	1.00	6
RD29	RD30	437.87	437.68	0.19	19	1.00	6
RD30	RD31	437.68	437.35	0.33	33	1.00	6
RD31	RD32	437.35	437.16	0.19	19	1.00	6
RD32	CO32A	437.16	436.83	0.33	33	1.00	6
CO32A	FES206	436.83	436.50	0.33	66	0.50	12
OS208	SW209	430.96	429.90	1.06	71	1.49	15
SW209	SW210	429.65	428.67	0.98	195	0.50	18





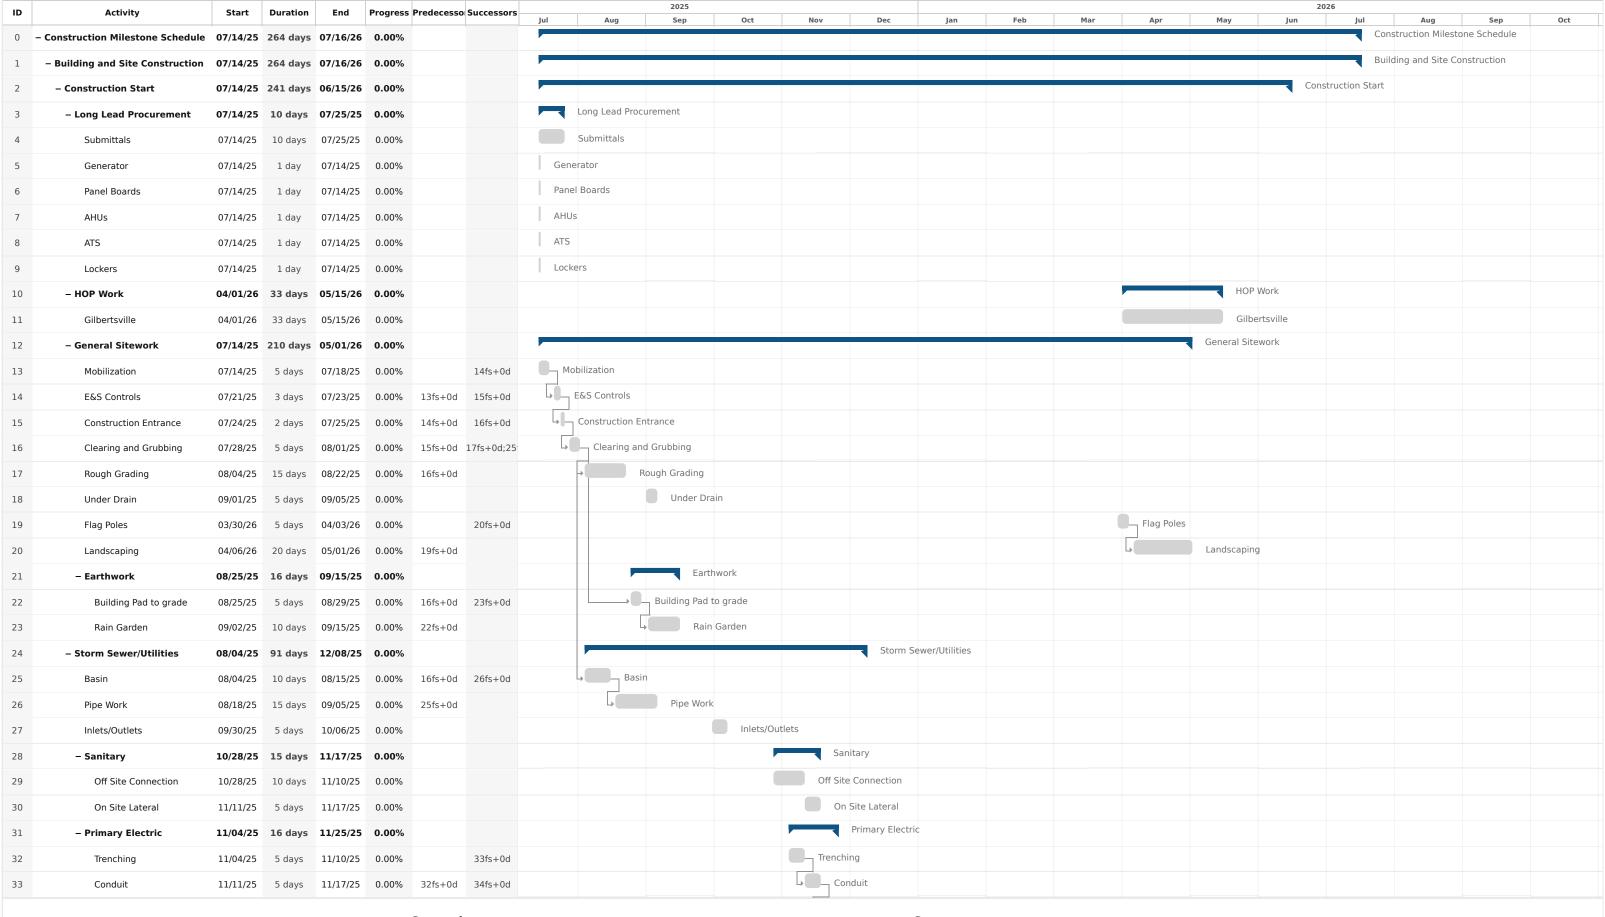

Outbuild

General


Parent Activity — Baseline → Milestone Links Completed Ahead
Child Activity (+# days) Delay Overdue Uninitiated

Printed on: 02/17/25

Page: 1/8





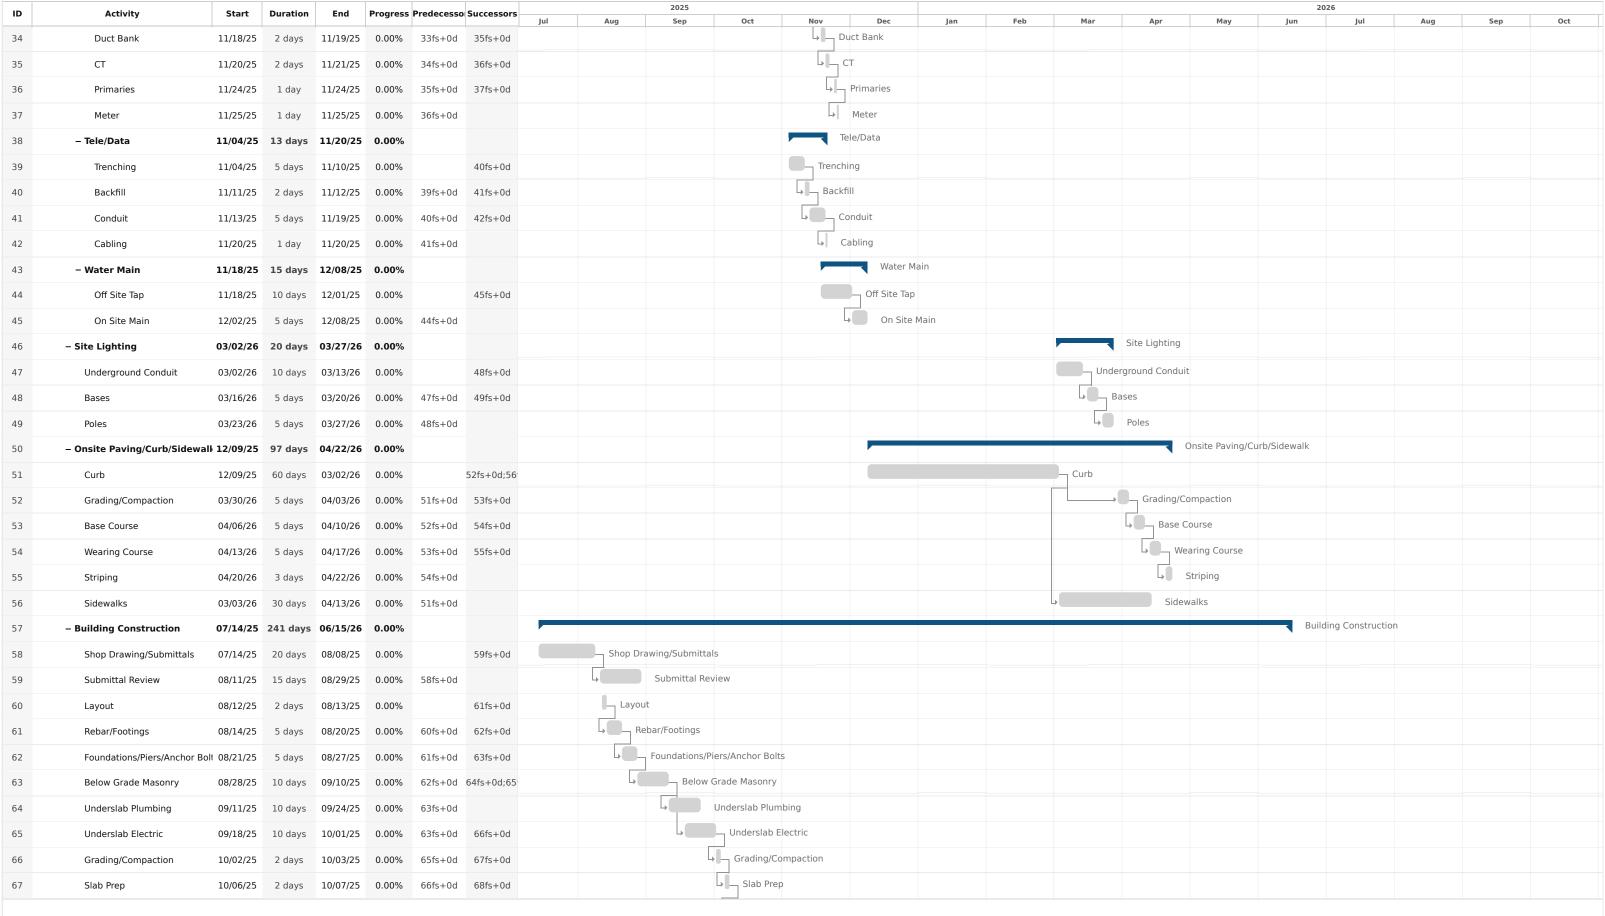




Printed on: 02/17/25

Page: 2/8





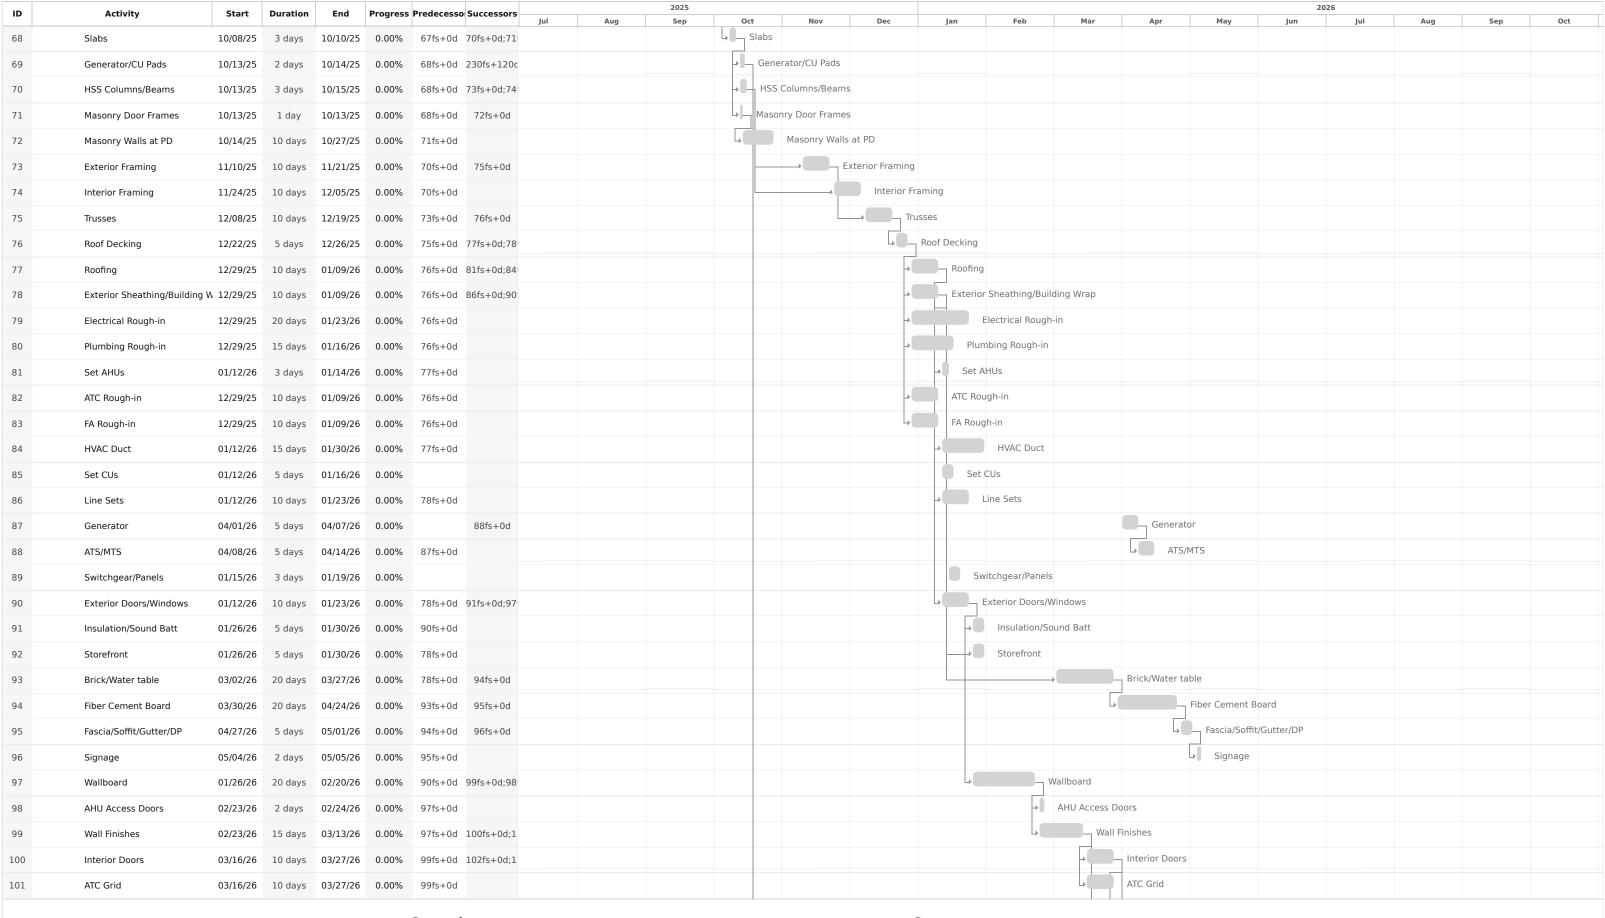



General

Parent Activity — Baseline ◆ Milestone Links Completed Ahead


Child Activity (+# days) Delay Overdue Uninitiated

Printed on: 02/17/25

Page: 3/8





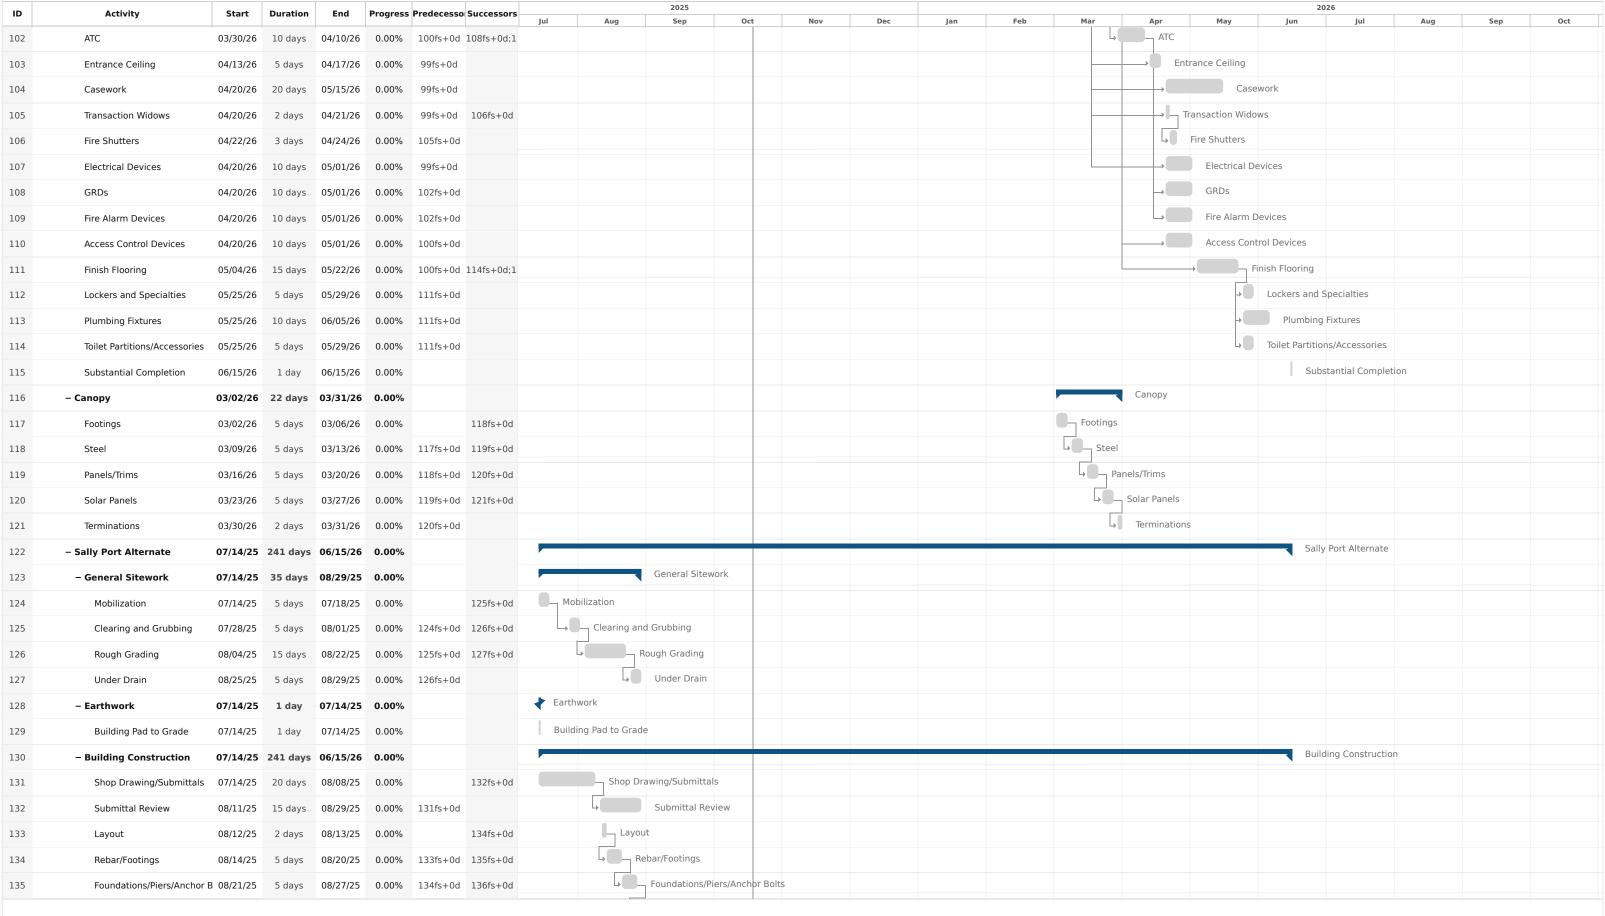



General

Parent Activity —— Baseline ◆ Milestone — Links —— Completed —— Ahead


Child Activity (+# days) Delay —— Overdue —— Uninitiated

Printed on: 02/17/25

Page: 4/8





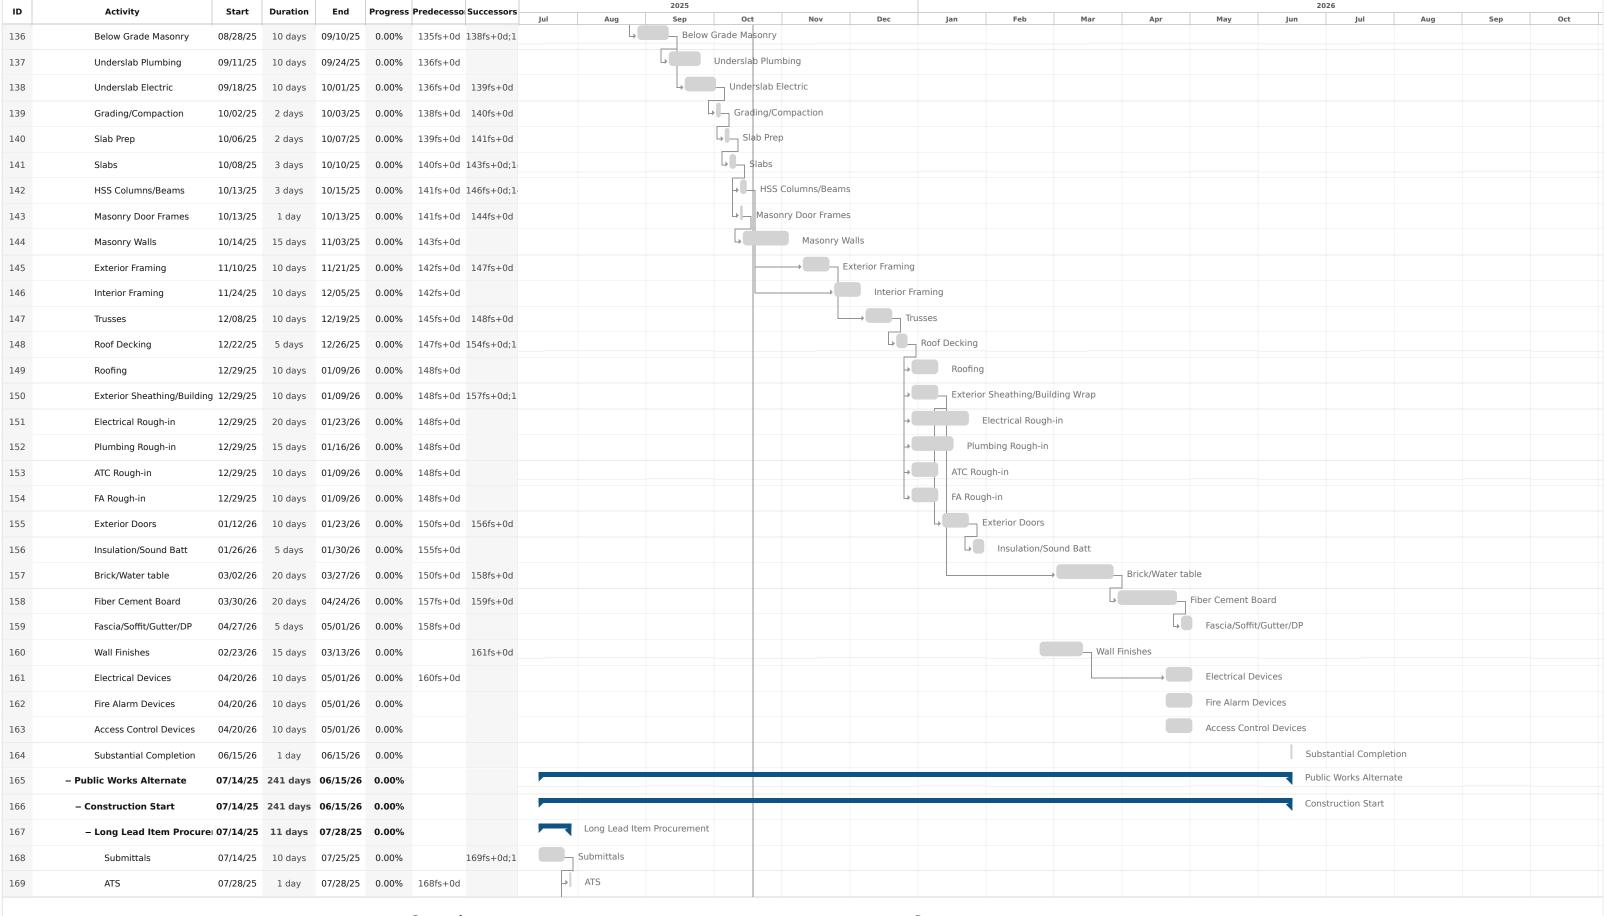






Printed on: 02/17/25

Page: 5/8





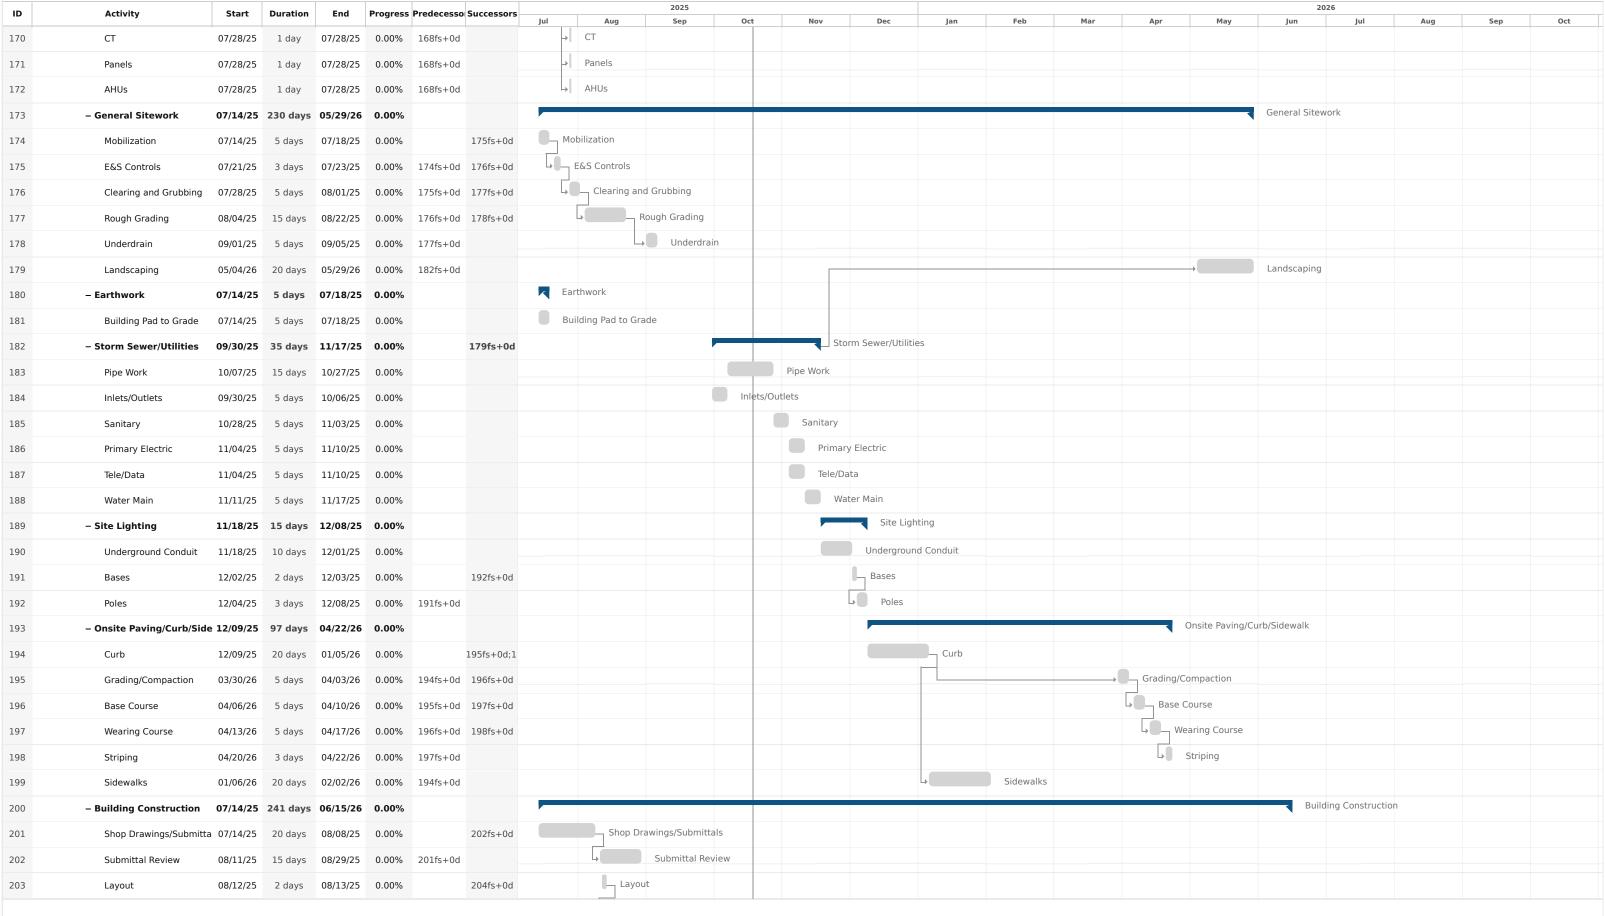




Printed on: 02/17/25

Page: 6/8





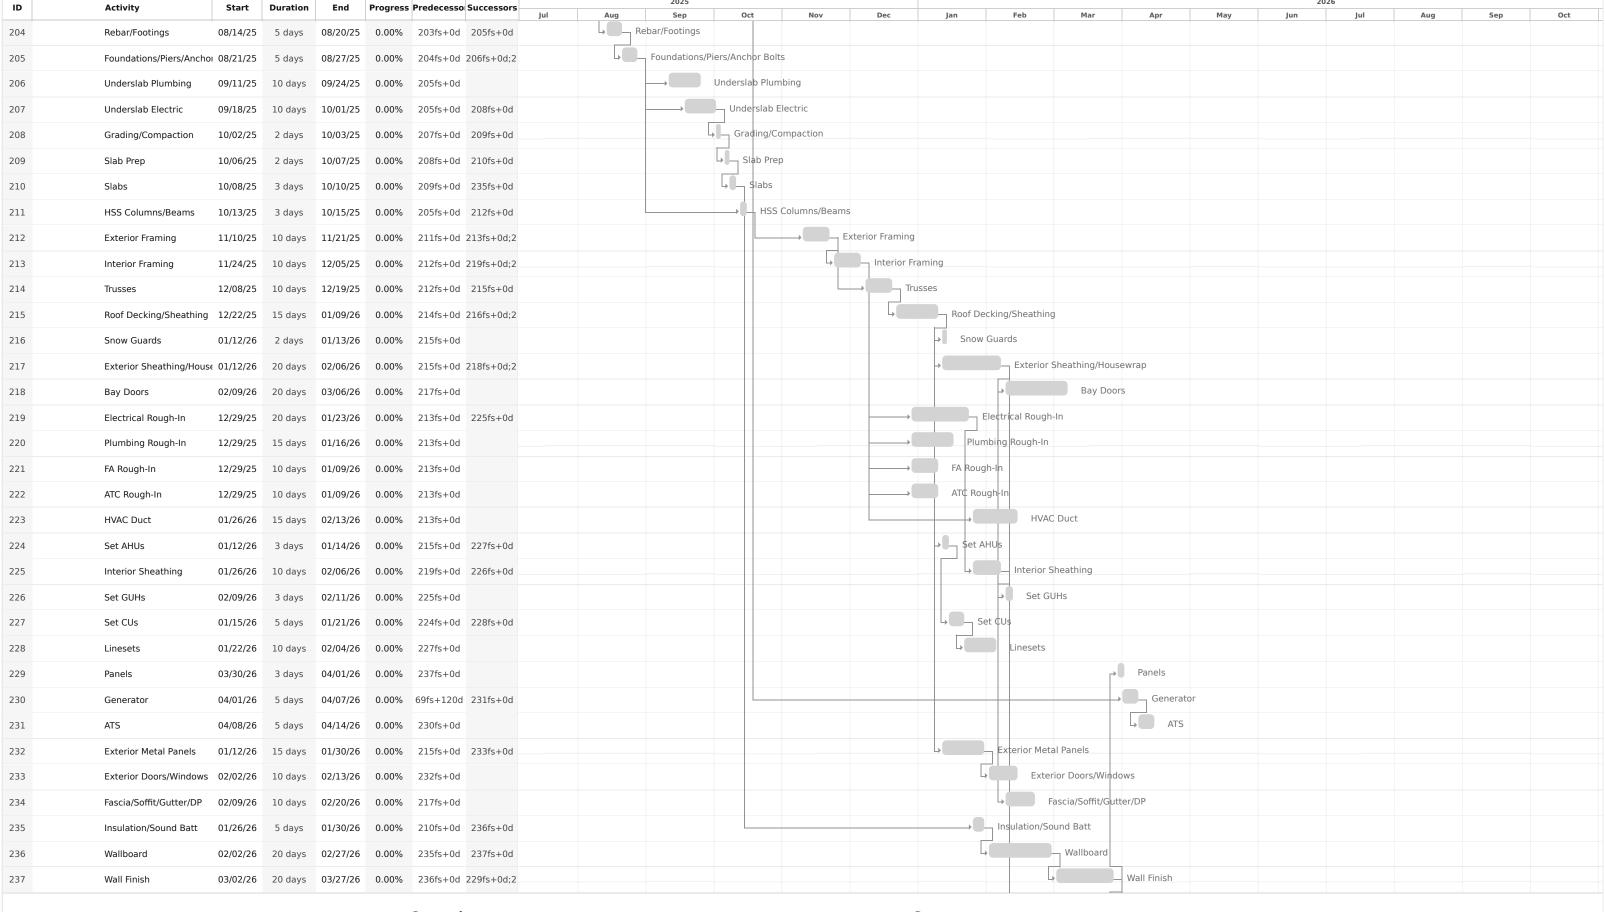



General Status

Parent Activity — Baseline ♦ Milestone Links Completed Ahead


Child Activity (+# days) Delay Overdue Uninitiated

Printed on: 02/17/25

Page: 7/8





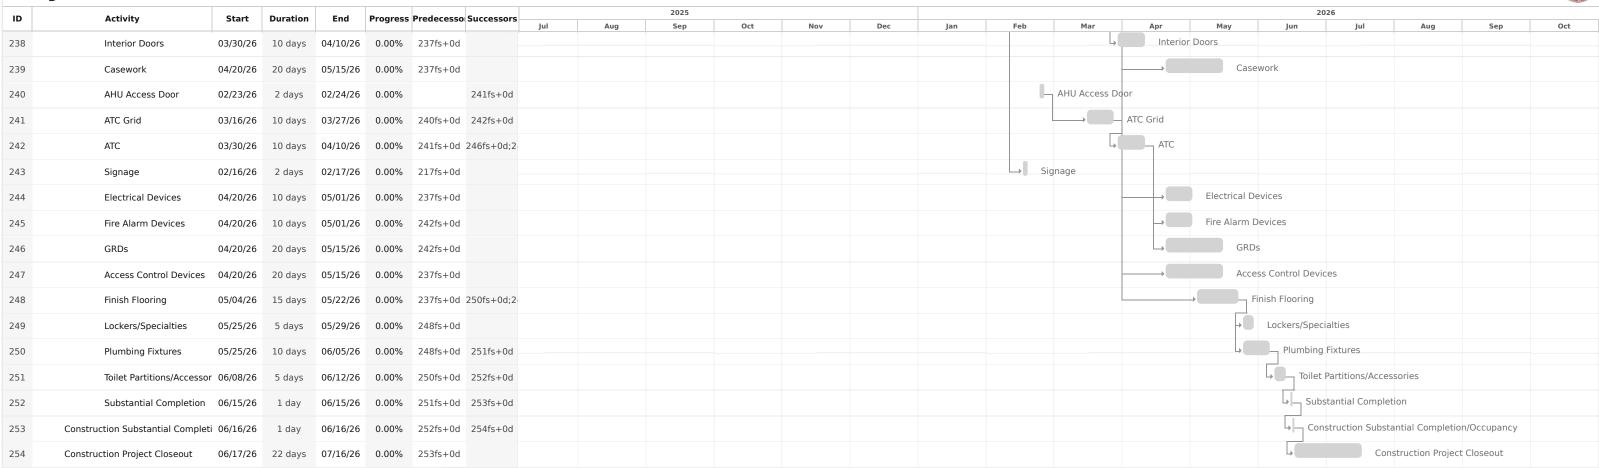

(+# days) Delay



Status Completed Ahead Uninitiated Overdue

Printed on: 02/17/25

CONTRACTOR: (Name, legal status and address) « »« » « »	SURETY: (Name, legal status and principal place of business) « »« » « »	
OWNER: (Name, legal status and address) « »« » « »		
CONSTRUCTION CONTRACT Date: Amount: \$ Description: (Name and location)		
BOND Date: (Not earlier than Construction Contra	None See Section 18	
CONTRACTOR AS PRINCIPAL Company: (Corporate Seal)	SURETY Company: (Corporate	
Company: (Corporate Seat)	Company: (Corporate Seal)	
Signature: Name and « »« » Title: (Any additional signatures appear on the state of the state		
(FOR INFORMATION ONLY — Name, AGENT or BROKER:	, address and telephone) OWNER'S REPRESENTATIVE:	
	(Architect, Engineer or other par-	
_	ty:)	
« »	« »	
« »	« » « »	
« »	« »	
	« »	
	« »	

- § 1 The Contractor and Surety, jointly and severally, bind themselves, their heirs, executors, administrators, successors and assigns to the Owner to pay for labor, materials and equipment furnished for use in the performance of the Construction Contract, which is incorporated herein by reference, subject to the following terms.
- § 2 If the Contractor promptly makes payment of all sums due to Claimants, and defends, indemnifies and holds harmless the Owner from claims, demands, liens or suits by any person or entity seeking payment for labor, materials or equipment furnished for use in the performance of the Construction Contract, then the Surety and the Contractor shall have no obligation under this Bond.
- § 3 If there is no Owner Default under the Construction Contract, the Surety's obligation to the Owner under this Bond shall arise after the Owner has promptly notified the Contractor and the Surety (at the address described in Section 13) of claims, demands, liens or suits against the Owner or the Owner's property by any person or entity seeking payment for labor, materials or equipment furnished for use in the performance of the Construction Contract and tendered defense of such claims, demands, liens or suits to the Contractor and the Surety.
- § 4 When the Owner has satisfied the conditions in Section 3, the Surety shall promptly and at the Surety's expense defend, indemnify and hold harmless the Owner against a duly tendered claim, demand, lien or suit.
- § 5 The Surety's obligations to a Claimant under this Bond shall arise after the following:
- § 5.1 Claimants, who do not have a direct contract with the Contractor,
 - have furnished a written notice of non-payment to the Contractor, stating with substantial accuracy the amount claimed and the name of the party to whom the materials were, or equipment was, furnished or supplied or for whom the labor was done or performed, within ninety (90) days after having last performed labor or last furnished materials or equipment included in the Claim; and
 - .2 have sent a Claim to the Surety (at the address described in Section 13).
- § 5.2 Claimants, who are employed by or have a direct contract with the Contractor, have sent a Claim to the Surety (at the address described in Section 13).
- § 6 If a notice of non-payment required by Section 5.1.1 is given by the Owner to the Contractor, that is sufficient to satisfy a Claimant's obligation to furnish a written notice of non-payment under Section 5.1.1.
- § 7 When a Claimant has satisfied the conditions of Sections 5.1 or 5.2, whichever is applicable, the Surety shall promptly and at the Surety's expense take the following actions:
- § 7.1 Send an answer to the Claimant, with a copy to the Owner, within sixty (60) days after receipt of the Claim, stating the amounts that are undisputed and the basis for challenging any amounts that are disputed; and
- § 7.2 Pay or arrange for payment of any undisputed amounts.
- § 7.3 The Surety's failure to discharge its obligations under Section 7.1 or Section 7.2 shall not be deemed to constitute a waiver of defenses the Surety or Contractor may have or acquire as to a Claim, except as to undisputed amounts for which the Surety and Claimant have reached agreement. If, however, the Surety fails to discharge its obligations under Section 7.1 or Section 7.2, the Surety shall indemnify the Claimant for the reasonable attorney's fees the Claimant incurs thereafter to recover any sums found to be due and owing to the Claimant.
- § 8 The Surety's total obligation shall not exceed the amount of this Bond, plus the amount of reasonable attorney's fees provided under Section 7.3, and the amount of this Bond shall be credited for any payments made in good faith by the Surety.
- § 9 Amounts owed by the Owner to the Contractor under the Construction Contract shall be used for the performance of the Construction Contract and to satisfy claims, if any, under any construction performance bond. By the Contractor furnishing and the Owner accepting this Bond, they agree that all funds earned by the Contractor in the

NEW MUNICIPAL COMPLEX

performance of the Construction Contract are dedicated to satisfy obligations of the Contractor and Surety under this Bond, subject to the Owner's priority to use the funds for the completion of the work.

- § 10 The Surety shall not be liable to the Owner, Claimants or others for obligations of the Contractor that are unrelated to the Construction Contract. The Owner shall not be liable for the payment of any costs or expenses of any Claimant under this Bond, and shall have under this Bond no obligation to make payments to, or give notice on behalf of, Claimants or otherwise have any obligations to Claimants under this Bond.
- § 11 The Surety hereby waives notice of any change, including changes of time, to the Construction Contract or to related subcontracts, purchase orders and other obligations.
- § 12 No suit or action shall be commenced by a Claimant under this Bond other than in a court of competent jurisdiction in the state in which the project that is the subject of the Construction Contract is located or after the expiration of one year from the date (1) on which the Claimant sent a Claim to the Surety pursuant to Section 5.1.2 or 5.2, or (2) on which the last labor or service was performed by anyone or the last materials or equipment were furnished by anyone under the Construction Contract, whichever of (1) or (2) first occurs. If the provisions of this Paragraph are void or prohibited by law, the minimum period of limitation available to sureties as a defense in the jurisdiction of the suit shall be applicable.
- § 13 Notice and Claims to the Surety, the Owner or the Contractor shall be mailed or delivered to the address shown on the page on which their signature appears. Actual receipt of notice or Claims, however accomplished, shall be sufficient compliance as of the date received.
- § 14 When this Bond has been furnished to comply with a statutory or other legal requirement in the location where the construction was to be performed, any provision in this Bond conflicting with said statutory or legal requirement shall be deemed deleted herefrom and provisions conforming to such statutory or other legal requirement shall be deemed incorporated herein. When so furnished, the intent is that this Bond shall be construed as a statutory bond and not as a common law bond.
- § 15 Upon request by any person or entity appearing to be a potential beneficiary of this Bond, the Contractor and Owner shall promptly furnish a copy of this Bond or shall permit a copy to be made.

§ 16 Definitions

§ 16.1 Claim. A written statement by the Claimant including at a minimum:

- .1 the name of the Claimant:
- 2 the name of the person for whom the labor was done, or materials or equipment furnished;
- .3 a copy of the agreement or purchase order pursuant to which labor, materials or equipment was furnished for use in the performance of the Construction Contract;
- 4 a brief description of the labor, materials or equipment furnished;
- .5 the date on which the Claimant last performed labor or last furnished materials or equipment for use in the performance of the Construction Contract;
- .6 the total amount earned by the Claimant for labor, materials or equipment furnished as of the date of the Claim:
- .7 the total amount of previous payments received by the Claimant; and
- .8 the total amount due and unpaid to the Claimant for labor, materials or equipment furnished as of the date of the Claim.

§ 16.2 Claimant. An individual or entity having a direct contract with the Contractor or with a subcontractor of the Contractor to furnish labor, materials or equipment for use in the performance of the Construction Contract. The term Claimant also includes any individual or entity that has rightfully asserted a claim under an applicable mechanic's lien or similar statute against the real property upon which the Project is located. The intent of this Bond shall be to include without limitation in the terms "labor, materials or equipment" that part of water, gas, power, light, heat, oil, gasoline, telephone service or rental equipment used in the Construction Contract, architectural and engineering services required for performance of the work of the Contractor and the Contractor's subcontractors, and all other

items for which a mechanic's lien may be asserted in the jurisdiction where the labor, materials or equipment were furnished.

- § 16.3 Construction Contract. The agreement between the Owner and Contractor identified on the cover page, including all Contract Documents and all changes made to the agreement and the Contract Documents.
- § 16.4 Owner Default. Failure of the Owner, which has not been remedied or waived, to pay the Contractor as required under the Construction Contract or to perform and complete or comply with the other material terms of the Construction Contract.
- § 16.5 Contract Documents. All the documents that comprise the agreement between the Owner and Contractor.
- § 17 If this Bond is issued for an agreement between a Contractor and subcontractor, the term Contractor in this Bond shall be deemed to be Subcontractor and the term Owner shall be deemed to be Contractor.
- § 18 Modifications to this bond are as follows:

~	>>

Company:	(Corporate Seal)	Company:		(Corporate Seal)
Signature: Name and Title:	« »« »	Signature: Name and Title:	« »« »	
Address:	« »	Address:	« »	

CONTRACTOR: (Name, legal status and address) « »« » « »	SURETY: (Name, legal status and principal place of business) « »« » « »
OWNER: (Name, legal status and address) « »« »	
CONSTRUCTION CONTRACT Date: « » Amount: \$ « » Description: (Name and location) « » « »	
BOND Date: (Not earlier than Construction Consum Note than Section 1) Amount: \$ \(\infty \) Modifications to this Bond:	None See Section 16
CONTRACTOR AS PRINCIPAL Company: (Corporate Seal)	SURETY Company: (Corporate Seal)
Signature: Name and « »« » Title: Any additional signatures appear on	Signature: Name and « »« » Title: I the last page of this Performance Bond.)
FOR INFORMATION ONLY — Nam AGENT or BROKER: « » « » « »	ne, address and telephone) OWNER'S REPRESENTATIVE: (Architect, Engineer or other party:) « » « » « » « » « » « »

- § 1 The Contractor and Surety, jointly and severally, bind themselves, their heirs, executors, administrators, successors and assigns to the Owner for the performance of the Construction Contract, which is incorporated herein by reference.
- § 2 If the Contractor performs the Construction Contract, the Surety and the Contractor shall have no obligation under this Bond, except when applicable to participate in a conference as provided in Section 3.
- § 3 If there is no Owner Default under the Construction Contract, the Surety's obligation under this Bond shall arise after
 - .1 the Owner first provides notice to the Contractor and the Surety that the Owner is considering declaring a Contractor Default. Such notice shall indicate whether the Owner is requesting a conference among the Owner, Contractor and Surety to discuss the Contractor's performance. If the Owner does not request a conference, the Surety may, within five (5) business days after receipt of the Owner's notice, request such a conference. If the Surety timely requests a conference, the Owner shall attend. Unless the Owner agrees otherwise, any conference requested under this Section 3.1 shall be held within ten (10) business days of the Surety's receipt of the Owner's notice. If the Owner, the Contractor and the Surety agree, the Contractor shall be allowed a reasonable time to perform the Construction Contract, but such an agreement shall not waive the Owner's right, if any, subsequently to declare a Contractor Default;
 - .2 the Owner declares a Contractor Default, terminates the Construction Contract and notifies the Surety; and
 - .3 the Owner has agreed to pay the Balance of the Contract Price in accordance with the terms of the Construction Contract to the Surety or to a contractor selected to perform the Construction Contract.
- § 4 Failure on the part of the Owner to comply with the notice requirement in Section 3.1 shall not constitute a failure to comply with a condition precedent to the Surety's obligations, or release the Surety from its obligations, except to the extent the Surety demonstrates actual prejudice.
- § 5 When the Owner has satisfied the conditions of Section 3, the Surety shall promptly and at the Surety's expense take one of the following actions:
- § 5.1 Arrange for the Contractor, with the consent of the Owner, to perform and complete the Construction Contract;
- § 5.2 Undertake to perform and complete the Construction Contract itself, through its agents or independent contractors;
- § 5.3 Obtain bids or negotiated proposals from qualified contractors acceptable to the Owner for a contract for performance and completion of the Construction Contract, arrange for a contract to be prepared for execution by the Owner and a contractor selected with the Owner's concurrence, to be secured with performance and payment bonds executed by a qualified surety equivalent to the bonds issued on the Construction Contract, and pay to the Owner the amount of damages as described in Section 7 in excess of the Balance of the Contract Price incurred by the Owner as a result of the Contractor Default; or
- § 5.4 Waive its right to perform and complete, arrange for completion, or obtain a new contractor and with reasonable promptness under the circumstances:
 - 1 After investigation, determine the amount for which it may be liable to the Owner and, as soon as practicable after the amount is determined, make payment to the Owner; or
 - .2 Deny liability in whole or in part and notify the Owner, citing the reasons for denial.
- § 6 If the Surety does not proceed as provided in Section 5 with reasonable promptness, the Surety shall be deemed to be in default on this Bond seven days after receipt of an additional written notice from the Owner to the Surety demanding that the Surety perform its obligations under this Bond, and the Owner shall be entitled to enforce any remedy available to the Owner. If the Surety proceeds as provided in Section 5.4, and the Owner refuses the pay-

ment or the Surety has denied liability, in whole or in part, without further notice the Owner shall be entitled to enforce any remedy available to the Owner.

- § 7 If the Surety elects to act under Section 5.1, 5.2 or 5.3, then the responsibilities of the Surety to the Owner shall not be greater than those of the Contractor under the Construction Contract, and the responsibilities of the Owner to the Surety shall not be greater than those of the Owner under the Construction Contract. Subject to the commitment by the Owner to pay the Balance of the Contract Price, the Surety is obligated, without duplication, for
 - .1 the responsibilities of the Contractor for correction of defective work and completion of the Construction Contract;
 - .2 additional legal, design professional and delay costs resulting from the Contractor's Default, and resulting from the actions or failure to act of the Surety under Section 5; and
 - .3 liquidated damages, or if no liquidated damages are specified in the Construction Contract, actual damages caused by delayed performance or non-performance of the Contractor.
- § 8 If the Surety elects to act under Section 5.1, 5.3 or 5.4, the Surety's liability is limited to the amount of this Bond.
- § 9 The Surety shall not be liable to the Owner or others for obligations of the Contractor that are unrelated to the Construction Contract, and the Balance of the Contract Price shall not be reduced or set off on account of any such unrelated obligations. No right of action shall accrue on this Bond to any person or entity other than the Owner or its heirs, executors, administrators, successors and assigns.
- § 10 The Surety hereby waives notice of any change, including changes of time, to the Construction Contract or to related subcontracts, purchase orders and other obligations.
- § 11 Any proceeding, legal or equitable, under this Bond may be instituted in any court of competent jurisdiction in the location in which the work or part of the work is located and shall be instituted within two years after a declaration of Contractor Default or within two years after the Contractor ceased working or within two years after the Surety refuses or fails to perform its obligations under this Bond, whichever occurs first. If the provisions of this Paragraph are void or prohibited by law, the minimum period of limitation available to sureties as a defense in the jurisdiction of the suit shall be applicable.
- § 12 Notice to the Surety, the Owner or the Contractor shall be mailed or delivered to the address shown on the page on which their signature appears.
- § 13 When this Bond has been furnished to comply with a statutory or other legal requirement in the location where the construction was to be performed, any provision in this Bond conflicting with said statutory or legal requirement shall be deemed deleted herefrom and provisions conforming to such statutory or other legal requirement shall be deemed incorporated herein. When so furnished, the intent is that this Bond shall be construed as a statutory bond and not as a common law bond.

§ 14 Definitions

- § 14.1 Balance of the Contract Price. The total amount payable by the Owner to the Contractor under the Construction Contract after all proper adjustments have been made, including allowance to the Contractor of any amounts received or to be received by the Owner in settlement of insurance or other claims for damages to which the Contractor is entitled, reduced by all valid and proper payments made to or on behalf of the Contractor under the Construction Contract.
- § 14.2 Construction Contract. The agreement between the Owner and Contractor identified on the cover page, including all Contract Documents and changes made to the agreement and the Contract Documents.
- § 14.3 Contractor Default. Failure of the Contractor, which has not been remedied or waived, to perform or otherwise to comply with a material term of the Construction Contract.

- § 14.4 Owner Default. Failure of the Owner, which has not been remedied or waived, to pay the Contractor as required under the Construction Contract or to perform and complete or comply with the other material terms of the Construction Contract.
- § 14.5 Contract Documents. All the documents that comprise the agreement between the Owner and Contractor.
- § 15 If this Bond is issued for an agreement between a Contractor and subcontractor, the term Contractor in this Bond shall be deemed to be Subcontractor and the term Owner shall be deemed to be Contractor.
- § 16 Modifications to this bond are as follows:

« »			
(Space is provided below for CONTRACTOR AS PRINCIPAL C		ed parties, other than SURETY	n those appearing on the cover page.)
Company:	(Corporate Seal)	Company:	(Corporate Seal)
Signature:		Signature:	
Name and Title: « »«	» >	Name and Title:	« »« »
Address: « »		Address:	« »

CONTRACTOR:

(Name, legal status and address)

« »« » « »

SURETY:

(Name, legal status and principal place of business)
« »« »

OWNER:

(Name, legal status and address)
« »« »
« »

BOND AMOUNT: \$ « »

PROJECT:

(Name, location or address, and Project number, if any)

« » « »

(()

The Contractor and Surety are bound to the Owner in the amount set forth above, for the payment of which the Contractor and Surety bind themselves, their heirs, executors, administrators, successors and assigns, jointly and severally, as provided herein. The conditions of this Bond are such that if the Owner accepts the bid of the Contractor within the time specified in the bid documents, or within such time period as may be agreed to by the Owner and Contractor, and the Contractor either (1) enters into a contract with the Owner in accordance with the terms of such bid, and gives such bond or bonds as may be specified in the bidding or Contract Documents, with a surety admitted in the jurisdiction of the Project and otherwise acceptable to the Owner, for the faithful performance of such Contract and for the prompt payment of labor and material furnished in the prosecution thereof; or (2) pays to the Owner the difference, not to exceed the amount of this Bond, between the amount specified in said bid and such larger amount for which the Owner may in good faith contract with another party to perform the work covered by said bid, then this obligation shall be null and void, otherwise to remain in full force and effect. The Surety hereby waives any notice of an agreement between the Owner and Contractor to extend the time in which the Owner may accept the bid. Waiver of notice by the Surety shall not apply to any extension exceeding sixty (60) days in the aggregate beyond the time for acceptance of bids specified in the bid documents, and the Owner and Contractor shall obtain the Surety's consent for an extension beyond sixty (60) days.

If this Bond is issued in connection with a subcontractor's bid to a Contractor, the term Contractor in this Bond shall be deemed to be Subcontractor and the term Owner shall be deemed to be Contractor.

When this Bond has been furnished to comply with a statutory or other legal requirement in the location of the Project, any provision in this Bond conflicting with said statutory or legal requirement shall be deemed deleted herefrom and provisions conforming to such statutory or other legal requirement shall be deemed incorporated herein. When so furnished, the intent is that this Bond shall be construed as a statutory bond and not as a common law bond.

	« » (Contractor as Principal)	(Seal)
		(Seui)
(Witness)	« » (Title)	
wunessy		
	« » (Surety)	(Seal)
		(seai)
Witness)	« » (Title)	

TABLE OF CONTENTS

VOLUME 1

<u>DIVISION 00 –</u>	- PROCUREMENT & CONTRACTING REQUIREMENTS
000110	TABLE OF CONTENTS
000115	LIST OF DRAWINGS
001113	ADVERTISEMENT FOR BIDS
001153	CONTRACTOR QUALIFICATION STATEMENT
001153.1	A305 – 2020 - WORKING DRAFT
001153.A	A305 EXHIBIT A – 2020 – FORM DRAFT
001153.B	A305 EXHIBIT B – 2020 – FORM DRAFT
001153.C	A305 EXHIBIT C – 2020 – FORM DRAFT
001153.D	A305 EXHIBIT D – 2020 – FORM DRAFT
001153.E	A305 EXHIBIT E – 2020 – FORM DRAFT
001154	AGREEMENT OF SURETY
001155	LETTER OF INSURER
002113	INSTRUCTION TO BIDDERS
002625	SUBSTITUTION REQUEST FORM
003132	GEOTECHNICAL DATA
003132.1	GEOTECHNICAL REPORT – GILBERTSVILLE
004116	GENERAL CONSTRUCTION BID FORM
004117	MECHANICAL CONTRACTOR BID FORM
004118	PLUMBING CONTRACTOR BID FORM
004119	ELECTRICAL CONTRACTOR BID FORM
004120	SITE CONTRACTOR BID FORM
004300	BID SECURITY, PAYMENT BOND, PERFORMANCE BOND
004300.01	A312 – 2010 PAYMENT BOND
004300.02	A312 – 2010 PERFORMANCE BOND
004300.03	A310 – 2010 BID BOND
005216	AGREEMENT FORM
005216.1	A132-2019 - AGREEMENT FORM – SAMPLE
005216.2	A132 EXHIBIT A – 2019 – SAMPLE
006119	MAINTENANCE BOND
006119.1	MAINTENANCE BOND – 18 MONTH
006216	CERTIFICATE OF INSURANCE
006216.1	CERTIFICATE OF INSURANCE - SAMPLE
007216	GENERAL CONDITIONS
007216.1	GENERAL CONDITIONS – AIA A232-2019 – SAMPLE
007300	SUPPLIMENTARY CONDTIONS
007343	PREVAILING WAGE RATE REQUIREMENTS
007343.1	PA PREVAILING WAGE RATES
008000	PUBLIC WORK EMPLOYMENT VERIFICAITON ACT – PA E VERIFY
008020.1	REDEVELOPEMENT ASSISTANCE CAPITAL PROGRAM – PROGRAM GUIDELINES
008020.2	REDEVELOPEMENT ASSISTANCE CAPITAL PROGRAM - KEY COMPLIANCE GUIDELINES
008020.3	REDEVELOPEMENT ASSISTANCE CAPITAL PROGRAM – FREQUENTLY ASKED QUESTIONS
008020.4	REDEVELOPEMENT ASSISTANCE CAPITAL PROGRAM – STEEL GUIDANCE
008020.5	REDEVELOPEMENT ASSISTANCE CAPITAL PROGRAM – ST-2

008020.6	REDEVELOPEMENT ASSISTANCE CAPITAL PROGRAM – ST-3
008020.7	LIST OF EXEMPT MACHINERY AND EQUIPMENT STEEL PRODUCTS
008200	SAFETY & HEALTH MANAGEMENT PLAN

009000 NON-COLLUSION AFFIDAVIT

<u>DIVISION 01 –</u>	GENERAL REQUIREMENTS
011100	SUMMARY
011100.01	MILESTONE CONSTRUCTION SCHEDULE
011250	SUMMARY OF MULTIPLE PRIMES
011400	WORK RESTRICTIONS
011500	FIELD ENGINEERING
012200	UNIT PRICES
012300	ALTERNATES
012600	CONTRACT MODIFICATION PROCEDURES
012900	PAYMENT PROCEDURES
013100	PROJECT MANAGEMENT AND COORDINATION
013117	COORDINATION DRAWINGS
013200	CONSTRUCTION PROGRESS DOCUMENTATION
013300	SUBMITTAL PROCEDURES
014000	QUALITY REQUIREMENTS
014200	REFERENCES
015000	TEMPORARY FACILITIES AND CONTROLS
015526	TRAFFIC CONTROL
016000	PRODUCT REQUIREMENTS
017300	EXECUTION
017329	CUTTING AND PATCHING
017419	CONSTRUCTION WASTE MANAGEMENT AND DISPOSAL
017700	CLOSEOUT PROCEDURES
017823	OPERATION AND MAINTNENCE DATA
017839	PROJECT RECORD DOCUMENTS
017900	DEMONSTRATION AND TRAINING

<u>DIVISION 02 – EXISTING CONDITIONS</u>

020500.0	DEMOLITION, REMOVAL, HAULING
004440	OF FOTIVE DEMOLITION

024119 SELECTIVE DEMOLITION

DIVISION 03 – CONCRETE 022000 CAST IN PLACE CONCRETE

033000	CAST IN PLACE CONCRETE
033000.0	POURED IN PLACE CONCRETE
033300.0	CONCRETE SIDEWALK/VEHICULAR APRON, FOUNDATION (GENERATOR), SLAB,
	PAD (TRASH ENCLOSURE AREA), CURBS, AND FOOTINGS
033002	CAST IN PLACE CONCRETE FOR UTILITIES
034000	PRECAST CONCRETE PAVING
034826	CONCRETE BUMPER BLOCK

DIVISION 04 – MASONRY

042000 UNIT MASONRY

DIVISION	05 - 1	METALS
----------	--------	--------

055000	METAL FABRICATIONS
055119	METAL GRATING STAIRS
055200	RAILINGS AND BARRIERS
055213	PIPE AND TUBE RAILINGS

DIVISION 06 – WOOD, PLASTICS, AND COMPOSITES

061000	ROUGH CARPENTRY
061600	SHEATHING
061753	SHOP FABRICATED WOOD TRUSSES
066400	REINFORCED PLASTIC PANELING

DIVISION 07 – THERMAL AND MOISTURE PROTECTION

<u> </u>	
071000	DAMPPROOFING AND WATERPROOFING
071326	SELF-ADHERING SHEET WATERPROOFING
072100	THERMAL INSULATION
072600	VAPOR RETARDERS
072715	WEATHER BARRIERS
073113	ASPHALT SHINGLES
074646	FIBER CEMENT SIDING
076200	SHEET METAL FLASHING AND TRIM
077253	SNOW GUARDS
078413	PENETRATION FIRESTOPPING
078443	FIRE-RESISTIVE JOINT SYSTEMS
079200	JOINT SEALANTS
079500	EXPANSION CONTROL

<u>DIVISION 08 – OPENINGS</u>

080671.AD	DOOR HARDWARE SCHEDULE – ADMINISTRATION/PD
080671.PW	DOOR HARDWARE SCHEDULE - PUBLIC WORKS ALTERNATE - GILBERTSVILLE
081113	HOLLOW METAL DOORS & FRAMES
081416	FLUSH WOOD DOORS
083113	ACCESS DOORS AND FRAMES
083323	COILING DOORS
083613	SECTIONAL DOORS
084113	ALUMINUM-FRAMED ENTRANCES AND STOREFRONT
084213	SECURITY ALUMINUM ENTRANCES AND STOREFRONT
085213	ALUMINUM-CLAD WOOD WINDOWS
085653	SECURITY WINDOWS
087100	DOOR HARDWARE
088800	GLAZING
089000	ARCHITECTURAL LOUVERS

<u>DIVISION 09 – FINISHES</u>

092216	NON-STRUCTURAL METAL FRAMING
092900	GYPSUM BOARD
093000	TILING
095100	CEILINGS

096500	RESILIENT WALL BASE
096519	RESILIENT TILE FLOORING
096710	FLUID APPLIED FLOORING
096813	TILE CARPETING
097200	VINYL WALLCOVERING
099100	PAINTING

DIVISION 10 – SPECIALTIES

101400	INTERIOR TACTILE SIGNAGE
101400.0	SIGNS
101410	PLAQUES
101419	DIMENSIONAL LETTER SIGNAGE
102113	TOILET COMPARTMENTS
102600	WALL PROTECTION
102641	BULLET RESISTANT PANELS
102800	TOILET ACCESSORIES
104400	FIRE PROTECTION SPECIALTIES
105100	METAL STORAGE LOCKERS
105626.13	MOBILE STORAGE SHELVING UNITS
105723	CLOSET AND UTILITY SHELVING
107316	CANOPIES
107516	GROUND SET FLAGPOLES

DIVISION 11 – EQUIPMENT

111100 SPECIALTY EQUIPMENT

DIVISION 12 – FURNISHINGS

122400	WINDOW SHADES
123200	MANUFACTURED PLASTIC LAMINATE CLAD CASEWORK
123600	SOLID SURFACE COUNTERTOPS
125500	DETENTION FURNITURE

DIVISION 13 – SPECIAL CONSTRUCTION

133418	ENGINEERED POST FRAME BUILDING SYSTEMS
133419	ENGINEERED CARPORT STRUCTURES

VOLUME 2

DIVISION 22 – PLUMBING

220518	ESCUTCHEONS FOR PLUMBING PIPING
220523	GENERAL DUTY VALVES FOR PLUMBING PIPING
220529	HANGERS AND SUPPORTS FOR PLUMBING PIPING AND EQUIPMENT
220553	IDENTIFICATION FOR PLUMBING PIPING AND EQUIPMENT
220700	PLUMBING INSULATION
221116	DOMESTIC WATER PIPING
221119	DOMESTIC WATER PIPING SPECIALTIES
221316	SANITARY WASTE AND VENT PIPING

224700 DRINKING FOUNTAINS AND WATER COOLERS

<u>DIVISION 23 – HEATING, VENTILATING, AND AIR-CONDITIONING(HVAC)</u>

DIVIDION ED	HEATING, VENTIEATING, AND AIR CONDITIONING(HVAC)
230529	HANGERS AND SUPPORTS FOR HVAC PIPING AND EQUIPMENT
230553	IDENTIFICATION FOR HVAC PIPING AND EQUIPMENT
230593	TESTING, ADJUSTING, AND BALANCING FOR HVAC
230700	HVAC INSULATION
230900	INSTRUMENTATION AND CONTROL FOR HVAC
230993	SEQUENCE OF OPERATIONS FOR HVAC CONTROLS
232300	RERIGERANT PIPING
233300	AIR DUCT ACCESSORIES
233423	HVAC POWER VENTILATOR
233713	DIFFUSERS, REGISTER, AND GRILLES
238126	SPLIT-SYSTEM HEAT PUMPS AND AIR CONDITIONERS

<u>DIVISION 26 – ELECTRICAL</u>

260500	GENERAL REQUIREMENTS
260500.0	GENERAL ELECTRIAL REQUIREMENTS
260529	HANGERS AND SUPPORTS FOR ELECTRICAL SYSTEMS
260533	RACEWAYS AND BOXES FOR ELECTRICAL SYSTEMS
262416	PANELBOARDS
262726	WIRING DEVICES
262816	ENCLOSED SWITCHES AND CIRCUIT BREAKERS
263213	ENGINE GENERATORS
263600	TRANSFER SWITCHES
265100	LIGHTING FIXTURES
265600	EXTERIOR LIGHTING
265600.0	EXTERIOR LIGHTING

DIVISION 31 – EARTHWORK

312000	ROUGH GRADING, EXCAVATION, AND TRENCHING
312500	FROSION AND SEDIMENT CONTROL

<u>DIVISION 32 – EXTERIOR IMPROVEMENTS</u>

321216	FURNISHING AND INSTALLATION OF ASPHALT PAVING
321723	PAVEMENT MARKINGS
321823	CONCRETE BUMPER BLOCK
323113	CHAINLINK FENCES AND GATES
323119	DECORATIVE AND CHAIN LINK METAL GATES
323119.0	ORNAMENTAL METAL FENCE
323223	SEGMENTED RETAINING WALL
323913	BOLLARDS
329000	LANDSCAPING
329200	FINE GRADING AND SEEDING

DIVISION 33 – UTILITIES

331100 WATER UTILITY DISTRIBUTION PIPING

333000	SANITARY SEWER
334000	STORMWATER UTILITIES
335100	PROPANE VESSELS

END OF SECTION

UPPER POTTSGROVE TOWNSHIP NEW MUNICIPAL COMPLEX

2290 GILBERTSVILLE ROAD, POTTSTOWN, PA 19464

UPPER POTTSGROVE TOWNSHIP

1409 FARMINGTON AVE, POTTSTOWN, PA 19464 MONTGOMERY COUNTY

BASE BID

NEW ADMINISTRATION & POLICE DEPARTMENT BUILDING

Sheet	Chasi Nama	Current
Number	Sheet Name	Revisior
GENERAL	100,450	Τ.
G0.00	COVER SHEET	1
G1.00	GENERAL INFORMATION	
G1.01	CODE DATA	
G1.11	LIFE SAFETY PLAN	
G2.00	PARTITION DETAILS	
G3.00	ARCHITECTURAL SITE PLAN	1
STRUCTURAL	TOURIS ATION BY AN	1
\$1.00	FOUNDATION PLAN	
\$1.01	ROOF FRAMING PLAN	
S2.00	GENERAL NOTES	
S2.01	SCHEDULES	
S3.00	TYPICAL FOUNDATION DETAILS	
S3.01	FOUNDATION SECTIONS	
\$4.00	TYPICAL FRAMING DETAILS	
S4.01	TYPICAL FRAMNG DETAILS	
S4.02	FRAMING SECTIONS	
ARCHITECTURE	FLOOD BLAN	1
A1.01	FLOOR PLAN	
A1.21	REFLECTED CEILING PLAN	
A1.22	CEILING DETAILS	
A1.40	ROOF PLAN & DETAILS	
A1.80	FINISH PLAN	
A1.81	FURNITURE & EQUIPMENT PLAN	
A2.00	EXTERIOR ELEVATIONS	
A3.00	BUILDING SECTIONS	
A3.01	BUILDING SECTIONS	
A4.00	WALL SECTIONS	
A4.01	WALL SECTIONS	
A4.02	WALL SECTIONS	
A4.03	WALL SECTIONS	
A4.40	DETAILS	
A4.41	DETAILS	
A5.00	ENLARGED PLANS & INTERIOR ELEVATIONS CANOPY DETAILS	
A5.01		
A5.40 A6.00	PLAN DETAILS DOOR SCHEDULE & DETAILS	1
A6.00 A6.01	DOOR SCHEDULE & DETAILS	
A6.20	WINDOW TYPES AND DETAILS	1
A7.00	INTERIOR ELEVATIONS	I
A7.00 A7.01	INTERIOR ELEVATIONS INTERIOR ELEVATIONS	
A7.40	MILLWORK SECTIONS & DETAILS	
A9.00	BID ALTERNATE - SALLY PORT	1
PLUMBING	BID ALTERNATE - SALLT FORT	I
P1.0	SCHEDULES, NOTES, DETAILS	
P2.0	SANITARY PLAN	
P2.1	DOMESTIC WATER PLAN	
MECHANICAL	DOMESTIC WATERT LAN	
M1.0	SCHEDULES, SPECIFICATIONS	
M1.1	MECHANICAL DETAILS	
M1.2	MECHANICAL DETAILS MECHANICAL DETAILS	
M2.0	MECHANICAL PLAN	
ELECTRICAL	INICOLIVINOVE I EWIN	
E1.0	ELECTRICAL DETAILS	
E2.0	LIGHTING PLAN	
E3.0	POWER PLAN	1
E4.0	EIDE ALADM DLAN	1

FIRE ALARM PLAN

ALTERNATE

NEW PUBLIC WORKS BUILDING & SALT SHED RELOCATION

Sheet Number	Sheet Name	Current Revision
GENERAL	Silect Name	HEVISION
G0.00PW	COVER SHEET	
G1.11PW	LIFE SAFETY PLAN	
G3.00PW	SITE PLAN	
ARCHITECTURE	OTTET LAW	
A1.01PW	FLOOR PLAN	
A1.21PW	REFLECTED CEILING PLAN	
A1.40PW	ROOF PLAN & DETAILS	
A1.61PW	FINISH PLAN & SCHEDULE - LEVEL 01	
A2.00PW	EXTERIOR ELEVATIONS	
A3.00PW	BUILDING SECTIONS	
A4.00PW	WALL SECTIONS	
A4.01PW	WALL SECTIONS	
A5.00PW	ENLARGED PLANS & DETAILS	
A6.00PW	DOOR SCHEDULE & DETAILS	
PLUMBING	-	1
P1.0PW	SCHEDULES, NOTES, DETAILS	
P2.0PW	PLUMBING PLAN	
MECHANICAL		I.
M1.0PW	SCHEDULES, SPECIFICATIONS	
M2.0PW	MECHANICAL PLAN	
ELECTRICAL		
E1.0PW	ELECTRICAL NOTES	
E2.0PW	PUBLIC WORKS BUILDING ELECTRICAL PLAN	

BASE BID & ALTERNATE

CIVIL DRAWINGS

Sheet Number Sheet Name		Current Revision			
CIVIL					
01.C-1	COVER SHEET	1			
02.N-1	NOTES	1			
03.EX-1	EXISTING FEATURES PLAN	1			
04.D-1	DEMOLITION PLAN	1			
05.S-1	SITE PLAN	1			
06.ES-1	EROSION & SEDIMENT CONTROL PLAN	1			
07.ES-2	EROSION AND SEDIMENT CONTROL NOTES	1			
08.ES-3	EROSION AND SEDIMENT CONTROL DETAILS	1			
09.U-1	UTILITY PLAN	1			
10.U-2	UTILITY DETAILS (SANITARY)	1			
11.U-3	UTILITY (WATER)	1			
12.U-4	UTILITY DETAILS	1			
13.SWM-1	GRADING/STORMWATER MANAGEMENT PLAN	1			
14.P-1	PROFILES	1			
15.SWM-2	POST-CONSTRUCTION STORMWATER MANAGEMENT PLAN	1			
16.SWM-3	POST-CONSTRUCTION STORMWATER MANAGEMENT NOTES	1			
17.SWM-4	POST-CONSTRUCTION STORMWATER MANAGEMENT DETAILS	1			
18.L-1	LANDSCAPE PLAN/NOTES/DETAILS	1			
19.LI-1	LIGHTING PLAN	1			
20.LI-2	LIGHTING DETAILS	1			
21.CD-1	CONSTRUCTION DETAILS	1			
22.CD-2	CONSTRUCTION DETAILS	1			
23.CD-3	CONSTRUCTION DETAILS	1			

NEW MUNICIPAL COMPLEX

> 2290 GILBERTSVILLE ROAL POTTSTOWN, PA 1946

UPPER POTTSGROVE

1409 FARMINGTON AVE POTTSGTOWN, PA 19464

CHESTER VALLEY ENGINEERS, INC.


TECT:

ARCHITECT:
ALLOY5
ARCHITECTURE


112 MOORES ROAD SUITE 200 MALVERN, PA 19355

STRUCTURAL:
SLATE STRUCTURAL ENGINEERS
40 SOUTH MAIN STREET NAZARETH, PA

MEPF: PROJECTX DESIGN GROUP 2433 BLUEJAY DRIVE NAZARETH, PA 18064

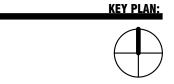



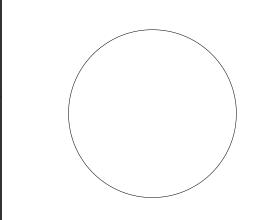

SHEET TITLE:

COVER SHEET

DATE: 03/31/2025

SCALE:

DRAWN BY: TB

CHECKED BY: RG

PROJ NO: 22-0058

HT ALLOYS ARCHITECTURE

NEW ADMINISTRATION AND POLICE DEPARTMENT BUILDING

2290 GILBERTSVILLE ROAD, POTTSTOWN, PA 19464

UPPER POTTSGROVE TOWNSHIP

1409 FARMINGTON AVE, POTTSTOWN, PA 19464 **MONTGOMERY COUNTY**

GENERAL CONDITIONS

- THE CONTRACTOR SHALL FILE ALL REQUIRED INSURANCE CERTIFICATES AND OBTAIN ALL REQUIRED BUILDING PERMITS PRIOR TO COMMENCEMENT OF THE WORK. COSTS OF PERMITS TO BE PAID BY OWNER, APPROVED
- PERMIT TO BE POSTED. 5. A COMPLETE SET OF PROJECT DOCUMENTS, INCLUDING AN ORIGINAL STAMPED SET OF DRAWINGS AND ALL SUBSEQUENT CHANGES AND CLARIFICATIONS SHALL BE KEPT ON SITE AT ALL TIMES. ALL PROPOSED CHANGES TO ORIGINAL PROJECT DOCUMENT BID SET ARE TO BE SUBMITTED BY CONTRACTOR IN THE FORM OF CHANGE ORDERS, INCLUDING ALL BACKUP INFORMATION, FOR APPROVAL BY OWNER/ARCHITECT/CONSTRUCTION
- 6. PRIOR TO COMMENCEMENT OF WORK, CONTRACTOR, OWNER, AND ARCHITECT SHALL HOLD A PRE-CONSTRUCTION CONFERENCE TO CONFIRM SITE ACCESS ROUTE, SCHEDULE, AND SEQUENCE OF WORK.
- THE CONTRACTOR SHALL BE RESPONSIBLE FOR THE SECURITY AND PROTECTION OF ALL CONDITIONS AND MATERIALS WITHIN THE PROPOSED CONSTRUCTION AREA. THE CONTRACTOR SHALL HAVE SOLE RESPONSIBILITY FOR ANY DAMAGE OR INJURY CAUSED BY OR DURING THE EXECUTION OF WORK.
- 8. SECTIONS AND DETAILS SHOWN, WHILE DRAWN FOR SPECIFIC LOCATIONS, ARE INTENDED TO ESTABLISH THE GENERAL TYPES OF DETAILS TO BE USED THROUGHOUT. WORK NOT INDICATED ON A PART OF THE DRAWINGS BUT REASONABLY IMPLIED TO BE SIMILAR TO THAT SHOWN AT CORRESPONDING PLACES, SHALL BE REPEATED. MINOR DETAILS NOT USUALLY SHOWN OR SPECIFIED, BUT REQUIRED FOR PROPER CONSTRUCTION OF ANY PART OF THE
- WORK SHALL BE INCLUDED AS IF THEY WERE INDICATED IN THE DRAWINGS. CONTRACTOR TO VERIFY AND/OR ESTABLISH ALL EXISTING CONDITIONS AND DIMENSIONS AT THE SITE AND TO NOTIFY THE OWNER/ARCHITECT OF ANY DISCREPANCIES AND/OR DEVIATIONS FROM DRAWINGS. PROPOSED REMEDIES, IF REQUIRING ADDITIONAL WORK, ARE TO BE SUBMITTED FOR APPROVAL IN THE FORM OF WRITTEN CHANGE ORDERS TO THE OWNER IN ACCORDANCE WITH THE TERMS OF THE CONTRACT BEFORE ORDERING
- MATERIAL OR COMMENCING WITH WORK. 10. CONTRACTOR TO VERIFY LOCATION OF ALL BELOW GRADE UTILITIES AND STORM WATER SYSTEMS PRIOR TO
- EXCAVATION. NOTIFY ARCHITECT OF ANY CONFLICTS WITH PROPOSED CONSTRUCTION. 11. ARCHITECT/ENGINEER IS NOT RESPONSIBLE FOR WORK THAT THE ARCHITECT/ENGINEER'S DOES NOT REVIEW AND/OR WORK NOT COMPLETED IN ACCORDANCE WITH ARCHITECT/ENGINEER'S PLAN AND/OR INSTRUCTIONS. NO
- DEVIATION FROM DESIGN DRAWINGS IS PERMITTED WITHOUT WRITTEN APPROVAL. 12. PROVIDE DAILY CLEAN-UP OF AREAS ADJACENT TO CONSTRUCTION AS WELL AS PERIODIC CLEAN-UP OF
- 13. AT JOB COMPLETION, BESIDES FINAL GENERAL CLEANING, REMOVE ALL STAINS AND PAINT FROM ALL NEW GLASS, TILE, AND OTHER FINISHES AND WASH AND POLISH STONE.

GENERAL DRAWING NOTES

- WRITTEN DIMENSIONS HAVE PRECEDENCE OVER SCALED DIMENSIONS. 2. ITEMS NOT NOTED AS EXISTING ARE NEW. DOORS AND WINDOWS NOT NUMBERED ON THE FLOOR PLAN OR
- ELEVATIONS ARE EXISTING TO REMAIN, UNLESS NOTED OTHERWISE.
- 3. ALL DIMENSIONS TO EXISTING SURFACES ARE TO FINISH, AND ALL DIMENSIONS TO NEW CONSTRUCTION ARE TO FACE OF STUD OR MASONRY, UNLESS NOTED OTHERWISE. 4. MECHANICAL, ELECTRICAL, PLUMBING & FIRE PROTECTION SYSTEMS INDICATED ON ARCHITECTURAL DRAWINGS
- ARE FOR REFERENCE ONLY. COORDINATE WITH MEPF DRAWINGS.
- 5. ENCLOSED ACCESSIBLE SPACE UNDER STAIRS SHALL HAVE WALLS AND SOFFITS PROTECTED BY 5/8" FIRE RATED GWB UNLESS NOTED OTHERWISE.

<u>MATERIA</u>	LS	<u>SYMBOLS</u>			
	GYPSUM WALLBOARD	- XX	KEYED NOTE IDENTIFIER	NO. MATL	CEILING HEIGHT & MATERIAL IDENTIFIER
·····	FOAM INSULATION	$ \langle xx \rangle$	KEYED NOTE (DEMOLITION)	WIATE	GLAZING PANEL
	BATT INSULATION		,	NO.	IDENTIFIER FURNITURE IDENTIFIER
	RIGID INSULATION	(XX)	CASEWORK/MILLWORK IDENTIFIEF	NO.	FUNIVITURE IDENTIFIER
· · · · · · · · · · · · · · · · · · ·	LOOSE FILL INSULATION		REVISION IDENTIFIER	WALL FINISH BASE MATL	FLOOR FINISH PLAN - FLOOR/WALL/BASE
	WOOD BLOCKING		COLLIMN LINE OD	FLOOR FINISH	FINISH IDENTIFIER
	ROUGH WOOD	(NO.)	COLUMN LINE OR GRID IDENTIFIER	EL NO.	SPOT ELEVATION INDICATOR
7////////	FINISH WOOD	NO.)—— ;		, T	INDIO/TIOIT
	PLYW00D/SHEATHING	SIM			NODTH INDICATOR
777474747474747 26728787878787	MDO/MDF	NO. DWG	DETAIL INDICATOR		NORTH INDICATOR
	ORIENTED STRAND BOARD (OSB)	SIM		LEVEL NAME	
	CORK	NO. DWG	SECTION INDICATOR —	LEVEL NAME ELEVATION	LEVEL INDICATOR
	GLASS	SIM			
	BRICK	NO.	EXTERIOR ELEVATION INDICATOR	NO. NO.	SLOPE INDICATOR
4 4 4 4 4 4 4 4 4 4 4 4 4 4 4 4 4 4 4 4	CONCRETE) XX			
	CONCRETE UNIT MASONRY	XX DWG XX	INTERIOR ELEVATION INDICATOR	0" - 0"	DIMENSION STRING
	STONE	w w		+	
	TILE	ROOM NAME No.	ROOM IDENTIFIER		
	TERRAZZO	150 SF			EXISTING DOOR TO REMA (SWING @ 45 DEGREES)
-	EARTH	(DOOR NO.)	DOOR & RATING IDENTIFIER		(SWING @ 43 DEGREES)
	GRAVEL	(DR NO.) 1HR			DOOR TO BE DEMOLISHED
	CLAY	⟨NO.⟩	WINDOW / GLAZING IDENTIFIER		DOOK TO BE DEMOCISHED
	STEEL	NO.	PARTITION TYPE IDENTIFIER	0000R NO.	
	ALUMINUM	NO.	ACCESSORIES IDENTIFIER		NEW DOOR AS SCHEDULE (SWING @ 90 DEGREES)
LINE TYP	EXISTING (CONSTRUCTION	/IEW NO. / SHEET NO.	BREAK LI	

DRAWING LIST

NO.	SHEET NAME	REVISION NO.
GENERAL	00/50 0/55	
G0.00	COVER SHEET	1
G1.00	GENERAL INFORMATION	
G1.01	CODE DATA	
G1.11	LIFE SAFETY PLAN	
G2.00	PARTITION DETAILS	
G3.00	ARCHITECTURAL SITE PLAN	1
STRUCTURAL		
S1.00	FOUNDATION PLAN	
S1.01	ROOF FRAMING PLAN	
S2.00	GENERAL NOTES	
S2.01	SCHEDULES	
S3.00	TYPICAL FOUNDATION DETAILS	
S3.01	FOUNDATION SECTIONS	
S4.00	TYPICAL FRAMING DETAILS	
S4.01	TYPICAL FRAMNG DETAILS	
S4.02	FRAMING SECTIONS	
ARCHITECTURE		
A1.01	FLOOR PLAN	
A1.21	REFLECTED CEILING PLAN	
A1.22	CEILING DETAILS	
A1.40	ROOF PLAN & DETAILS	
A1.80	FINISH PLAN	
A1.81	FURNITURE & EQUIPMENT PLAN	
A2.00	EXTERIOR ELEVATIONS	
A3.00	BUILDING SECTIONS	
A3.01	BUILDING SECTIONS	
A4.00	WALL SECTIONS	
A4.01	WALL SECTIONS	
A4.02	WALL SECTIONS	
44.03	WALL SECTIONS	
44.40	DETAILS	
44.41	DETAILS	
A5.00	ENLARGED PLANS & INTERIOR ELEVATIONS	
A5.00 A5.01	CANOPY DETAILS	
45.40	PLAN DETAILS	
46.00	DOOR SCHEDULE & DETAILS	1
		I
A6.01	DOOR SCHEDULE & DETAILS	4
A6.20	WINDOW TYPES AND DETAILS	1
A7.00	INTERIOR ELEVATIONS	
A7.01	INTERIOR ELEVATIONS	
A7.40	MILLWORK SECTIONS & DETAILS	4
A9.00	BID ALTERNATE - SALLY PORT	1
PLUMBING	ACCUEDING A MOTEO DETAILO	
P1.0	SCHEDULES, NOTES, DETAILS	
P2.0	SANITARY PLAN	
P2.1	DOMESTIC WATER PLAN	
MECHANICAL		
M1.0	SCHEDULES, SPECIFICATIONS	
M1.1	MECHANICAL DETAILS	
M1.2	MECHANICAL DETAILS	
M2.0	MECHANICAL PLAN	
ELECTRICAL		
E1.0	ELECTRICAL DETAILS	
E2.0	LIGHTING PLAN	
E3.0	POWER PLAN	1
E4.0	FIRE ALARM PLAN	1

POLICE DEPARTMENT

UPPER POTTSGROVE

1409 FARMINGTON AVENUE


ENGINEERS, INC.

SLATE STRUCTURAL ENGINEERS 40 SOUTH MAIN STREET

PROJECTX DESIGN GROUP 2433 BLUEJAY DRIVE NAZARETH, PA 18064 610-365-2436

- CODMINICOTO		
NO.	ISSUE DESCRIPTION	DATE
	BID DOCUMENTS	03/31/25
1	ADDENDUM #01	04/14/25



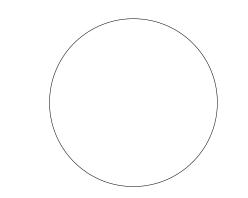

COVER SHEET

SCALE: **12" = 1'-0'** DRAWN BY: Author CHECKED BY: Checker


PROJ NO: **22-0058**


THEM / WALL TO BE DEMOLISHED NEW CONSTRUCTION

MATCH LINE VIEW NO. / SHEET NO. — - — - — - — - — - — MOISTURE / VAPOR BARRIER ---- DAMPROOFING / WATER PROOFING

— - — - — - — - — - — GRID LINE

---- ITEM ABOVE

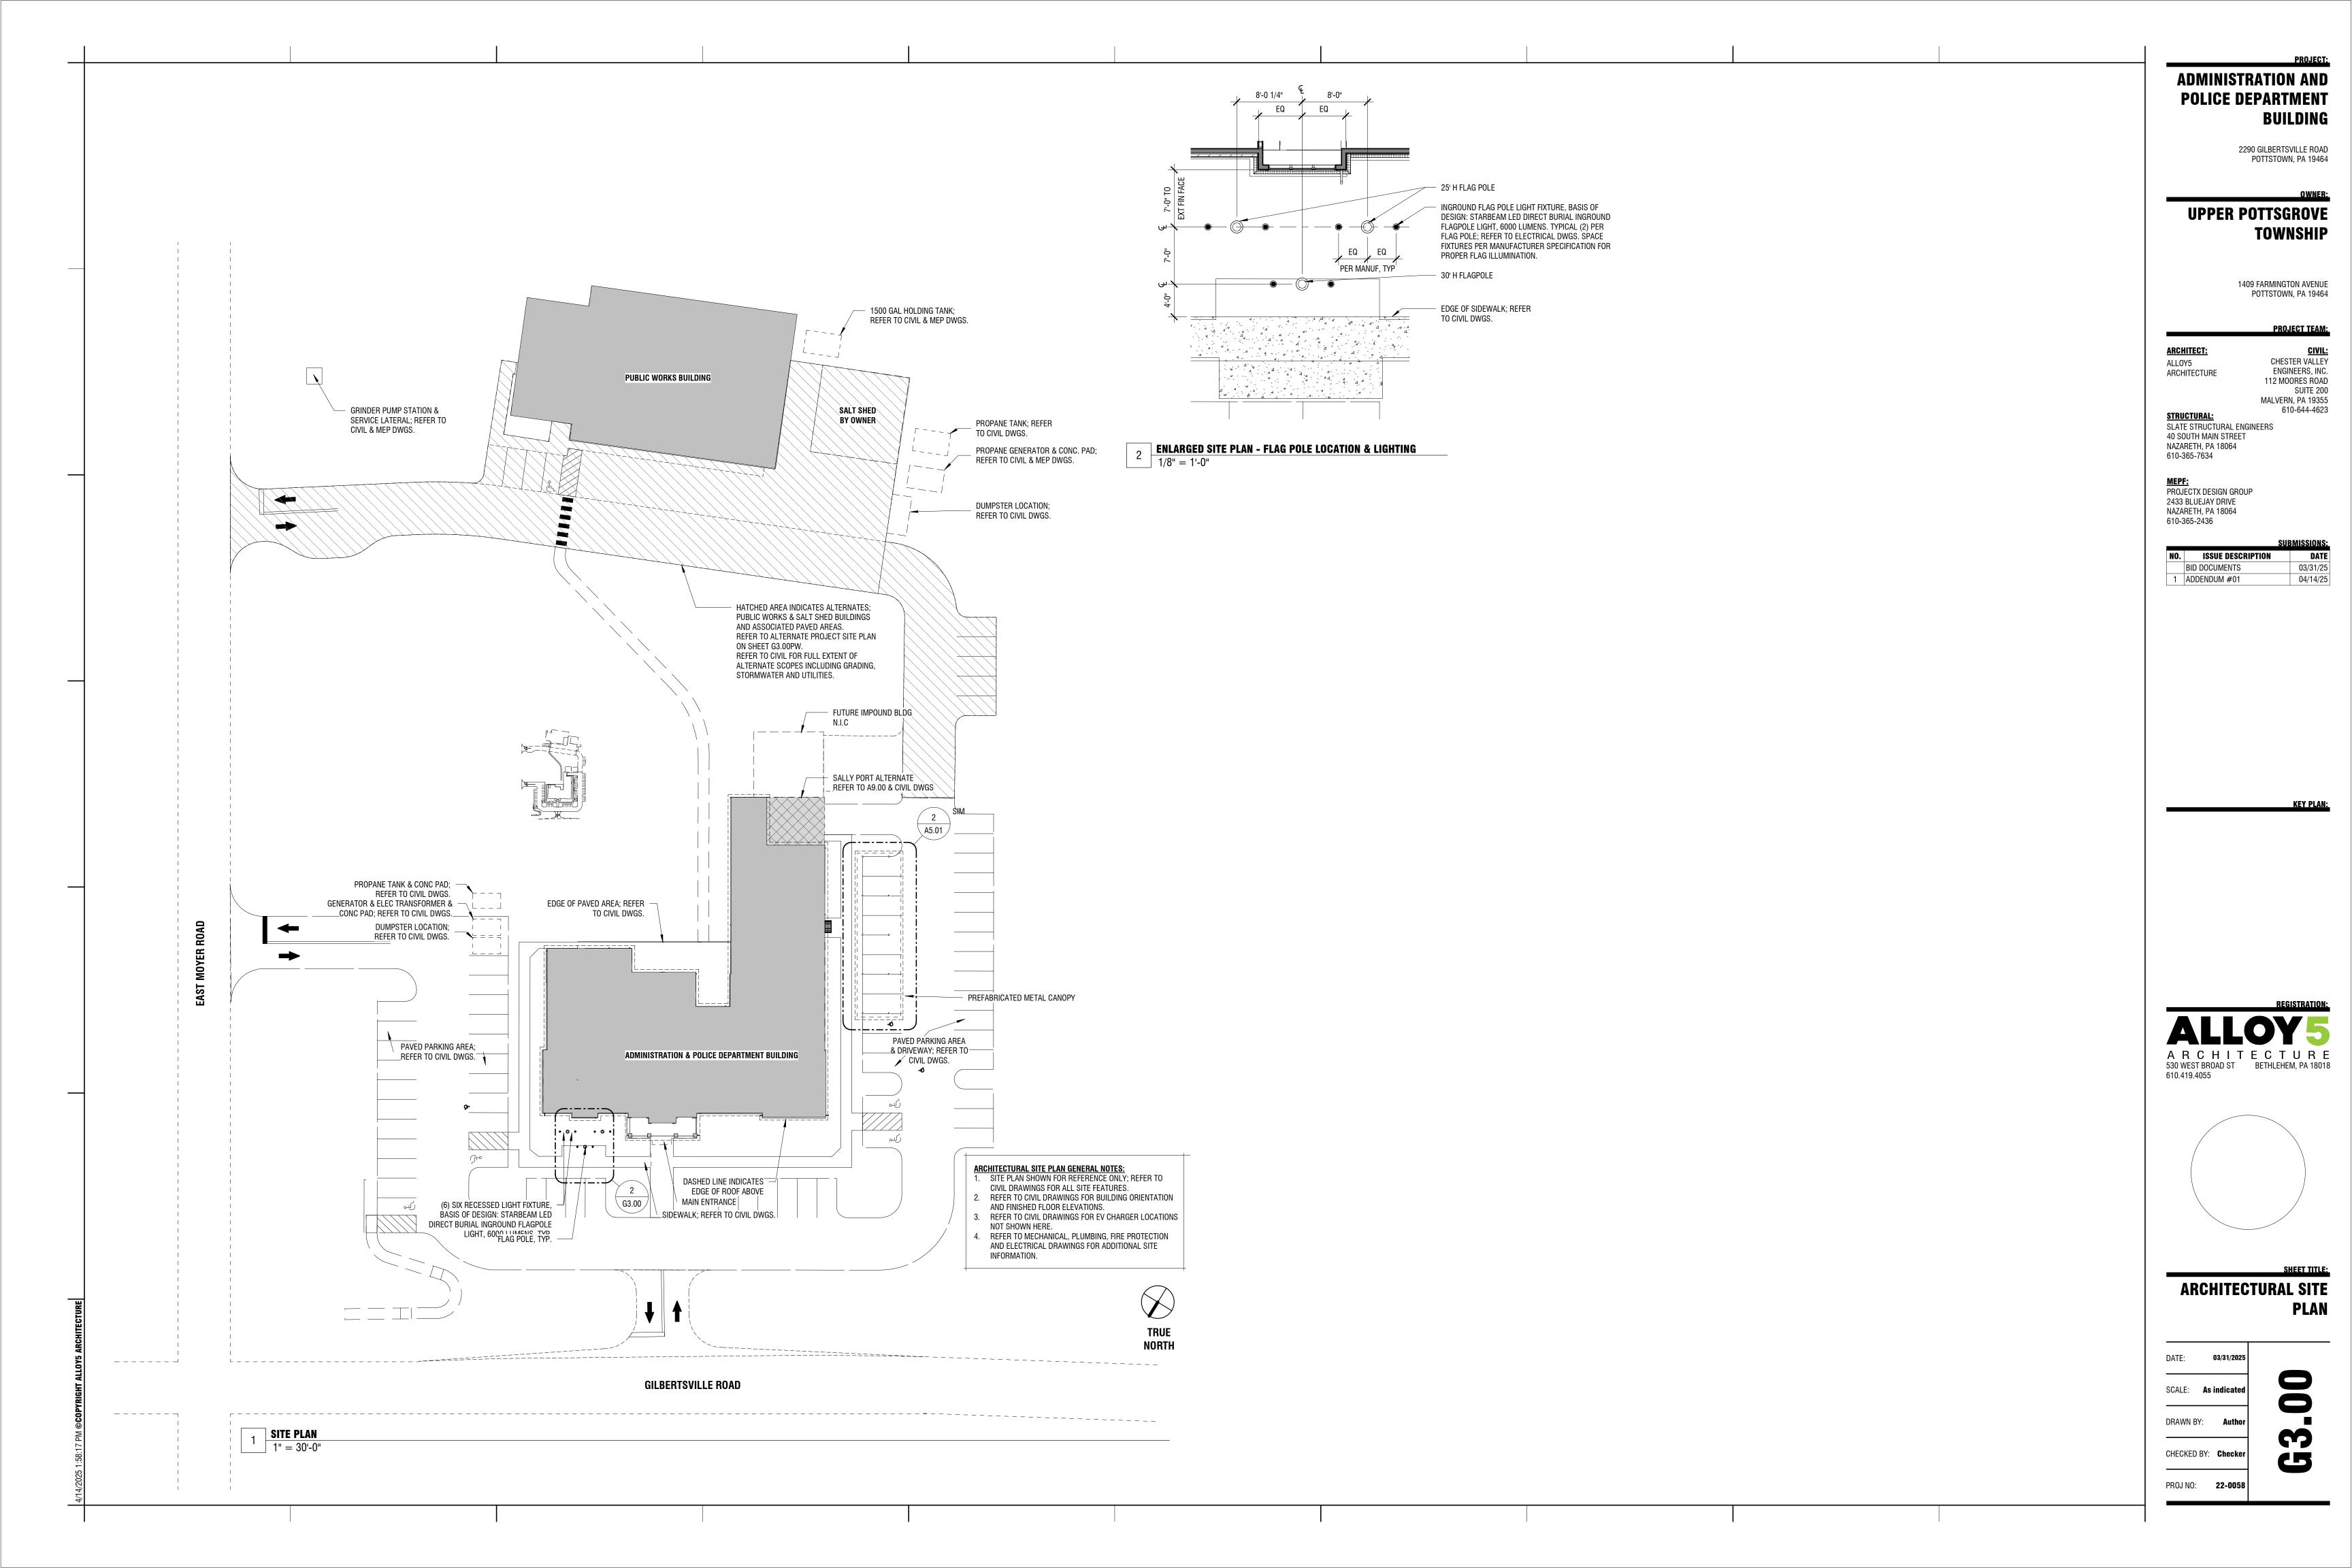

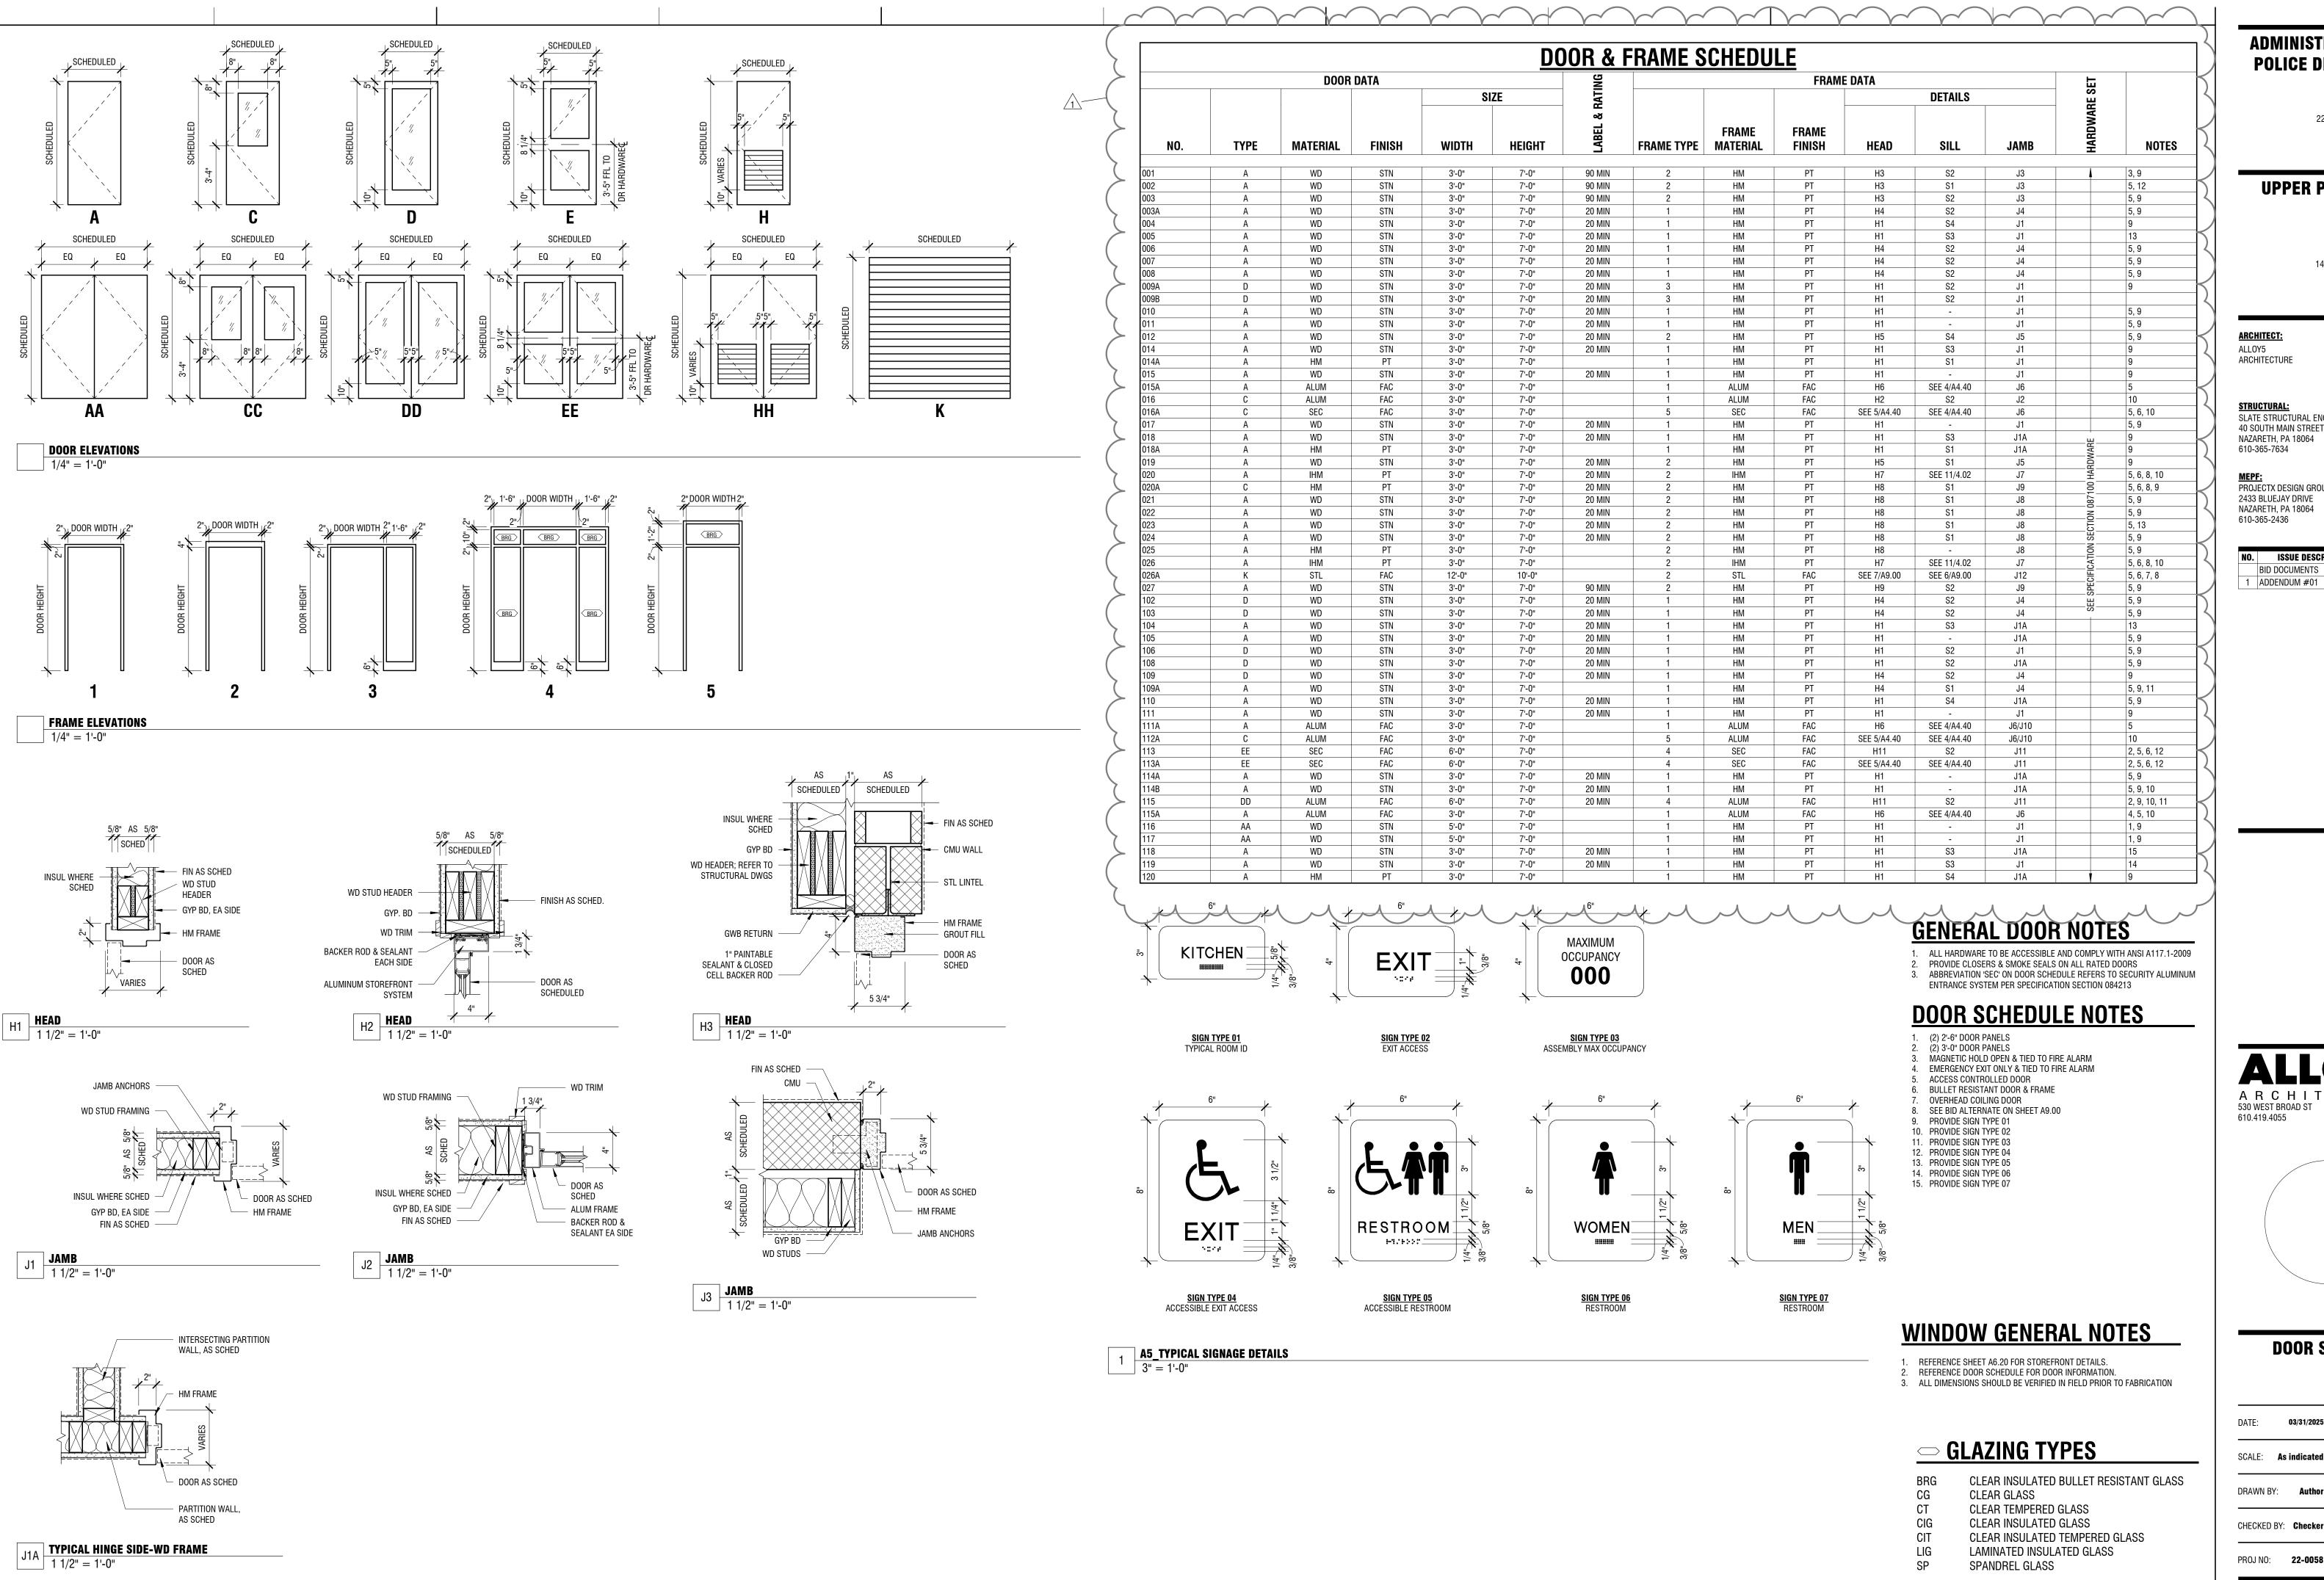

ADMINISTRATION AND POLICE DEPARTMENT BUILDING

2290 GILBERTSVILLE ROAD

POTTSTOWN, PA 19464

UPPER POTTSGROVE TOWNSHIP

> 1409 FARMINGTON AVENUE POTTSTOWN, PA 19464

PROJECT TEAM:


CHESTER VALLEY ENGINEERS, INC. 112 MOORES ROAD SUITE 200 MALVERN, PA 19355 610-644-4623

SLATE STRUCTURAL ENGINEERS 40 SOUTH MAIN STREET

PROJECTX DESIGN GROUP 2433 BLUEJAY DRIVE NAZARETH, PA 18064


> 03/31/25 BID DOCUMENTS 04/14/25


A R C H I T E C T U R E 530 WEST BROAD ST BETHLEHEM, PA 18018 610.419.4055

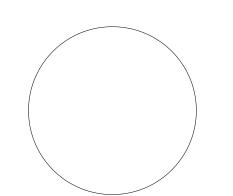


DOOR SCHEDULE & **DETAILS**

4

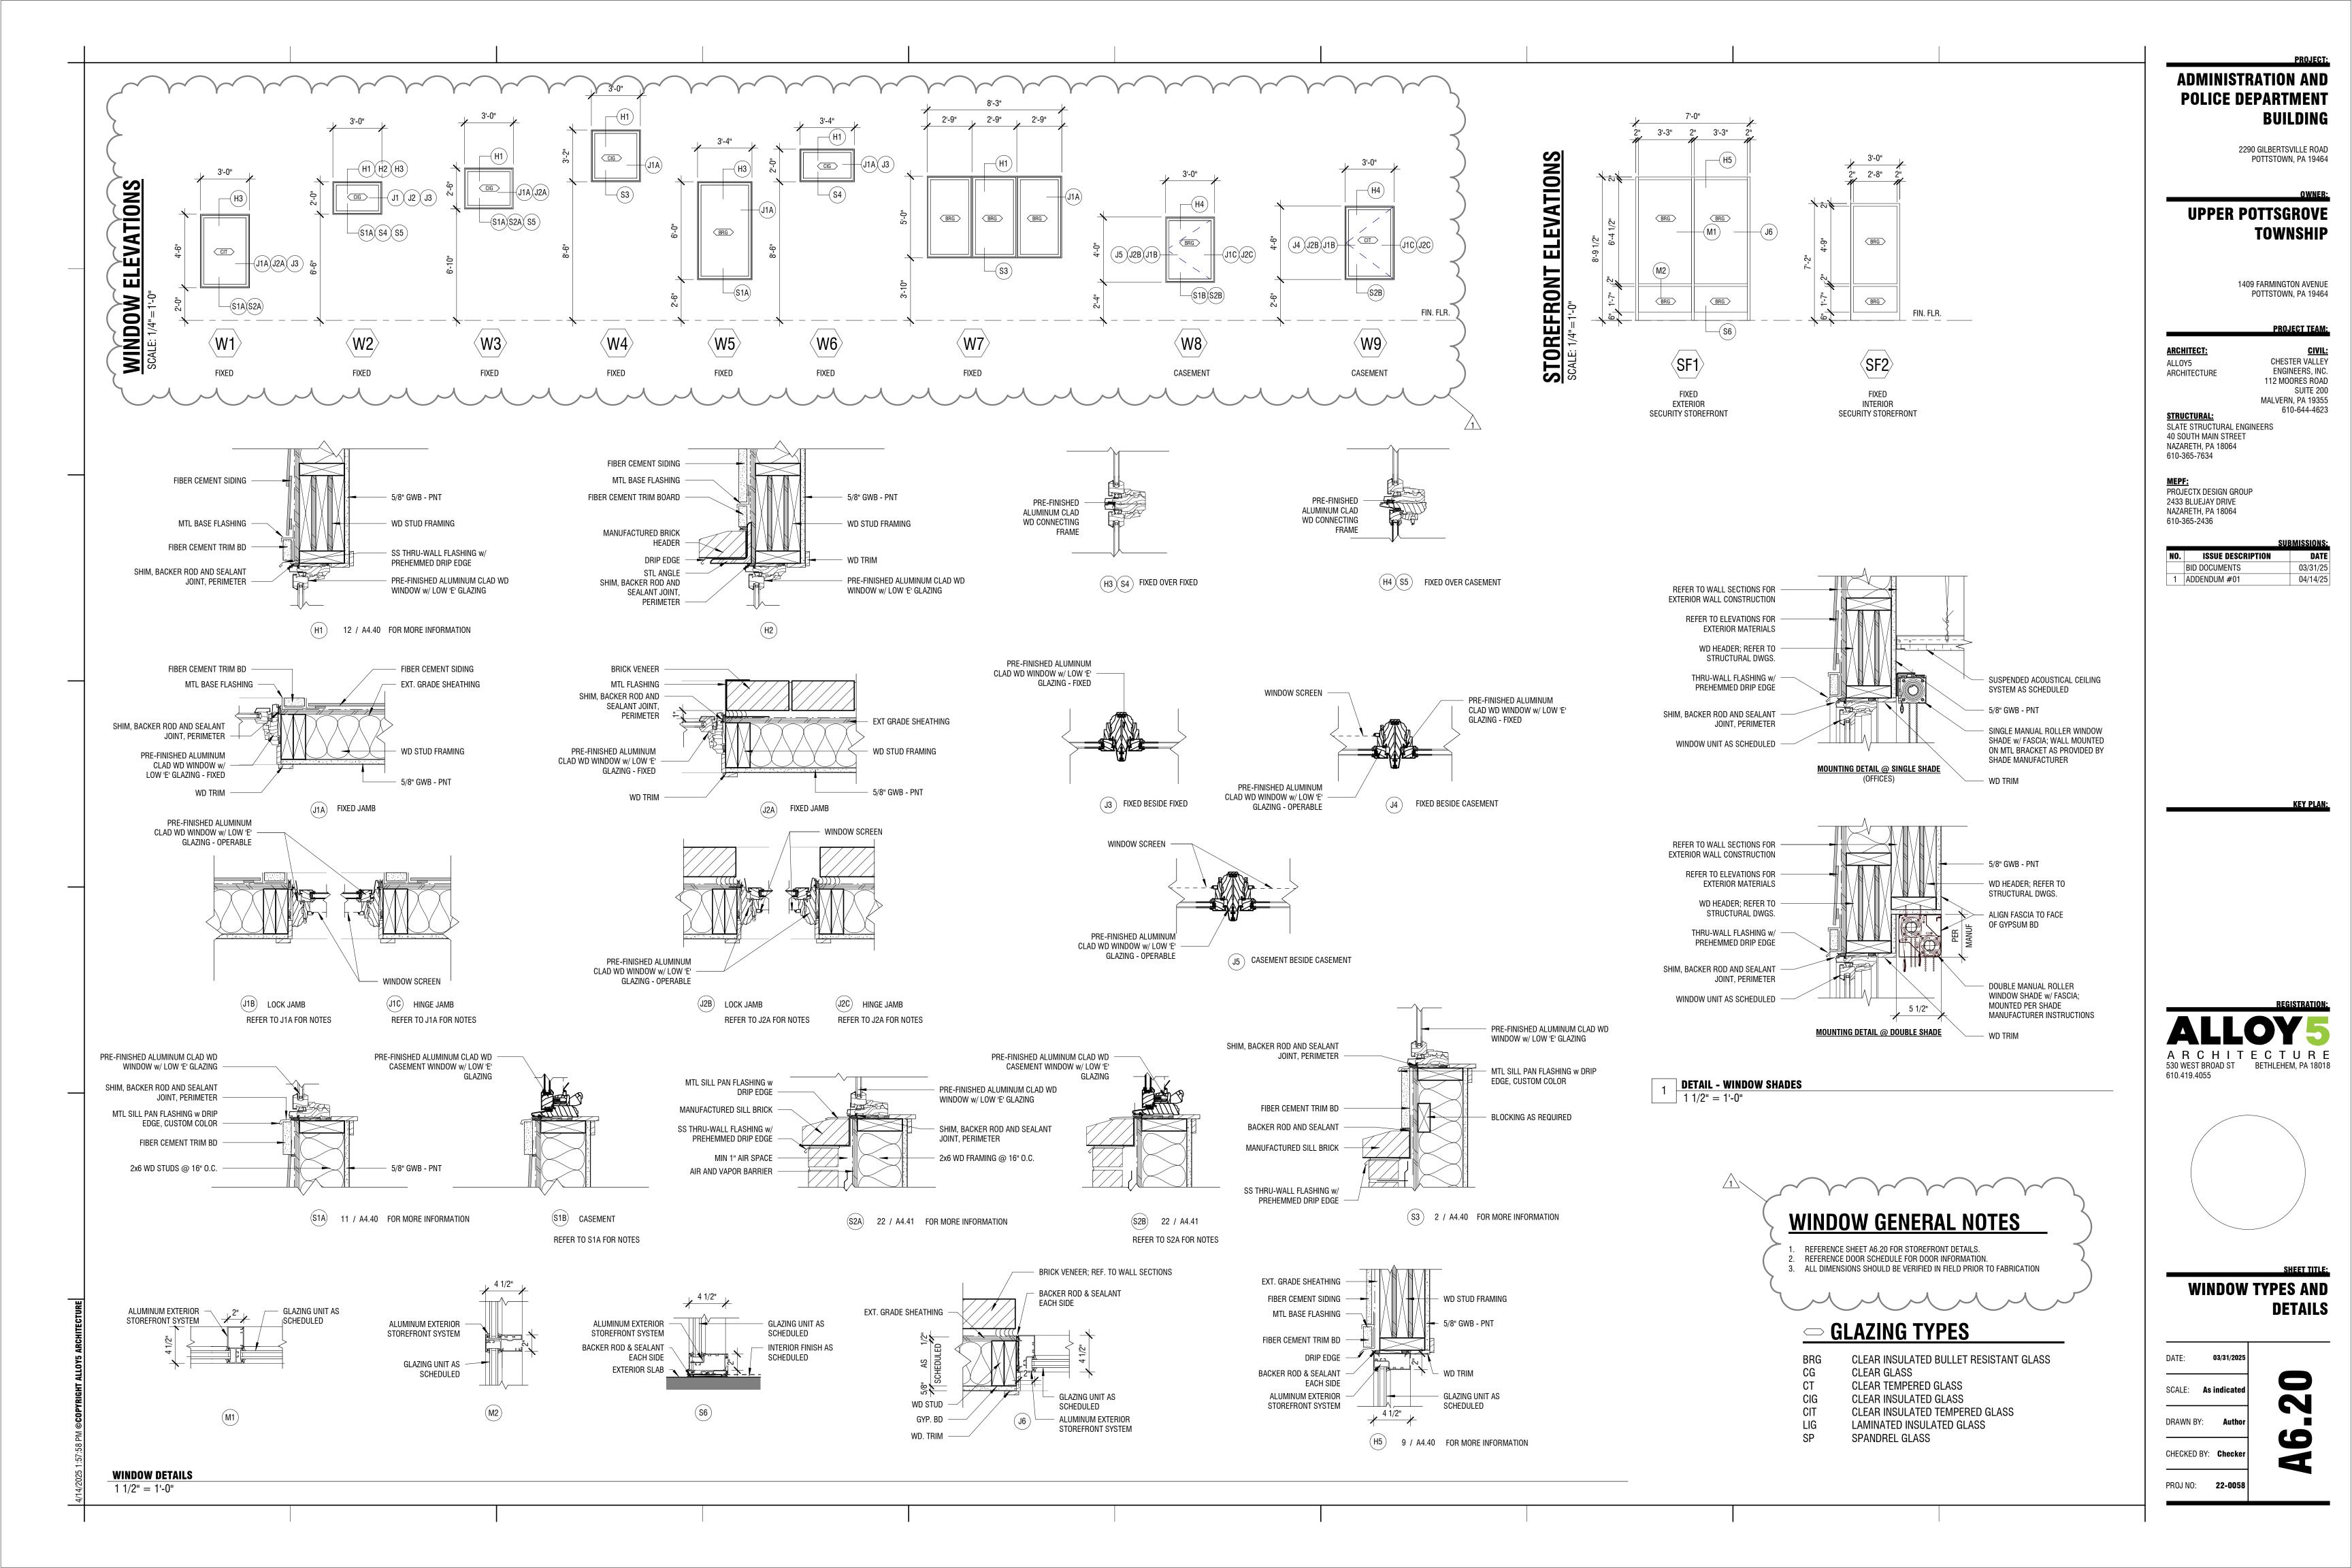

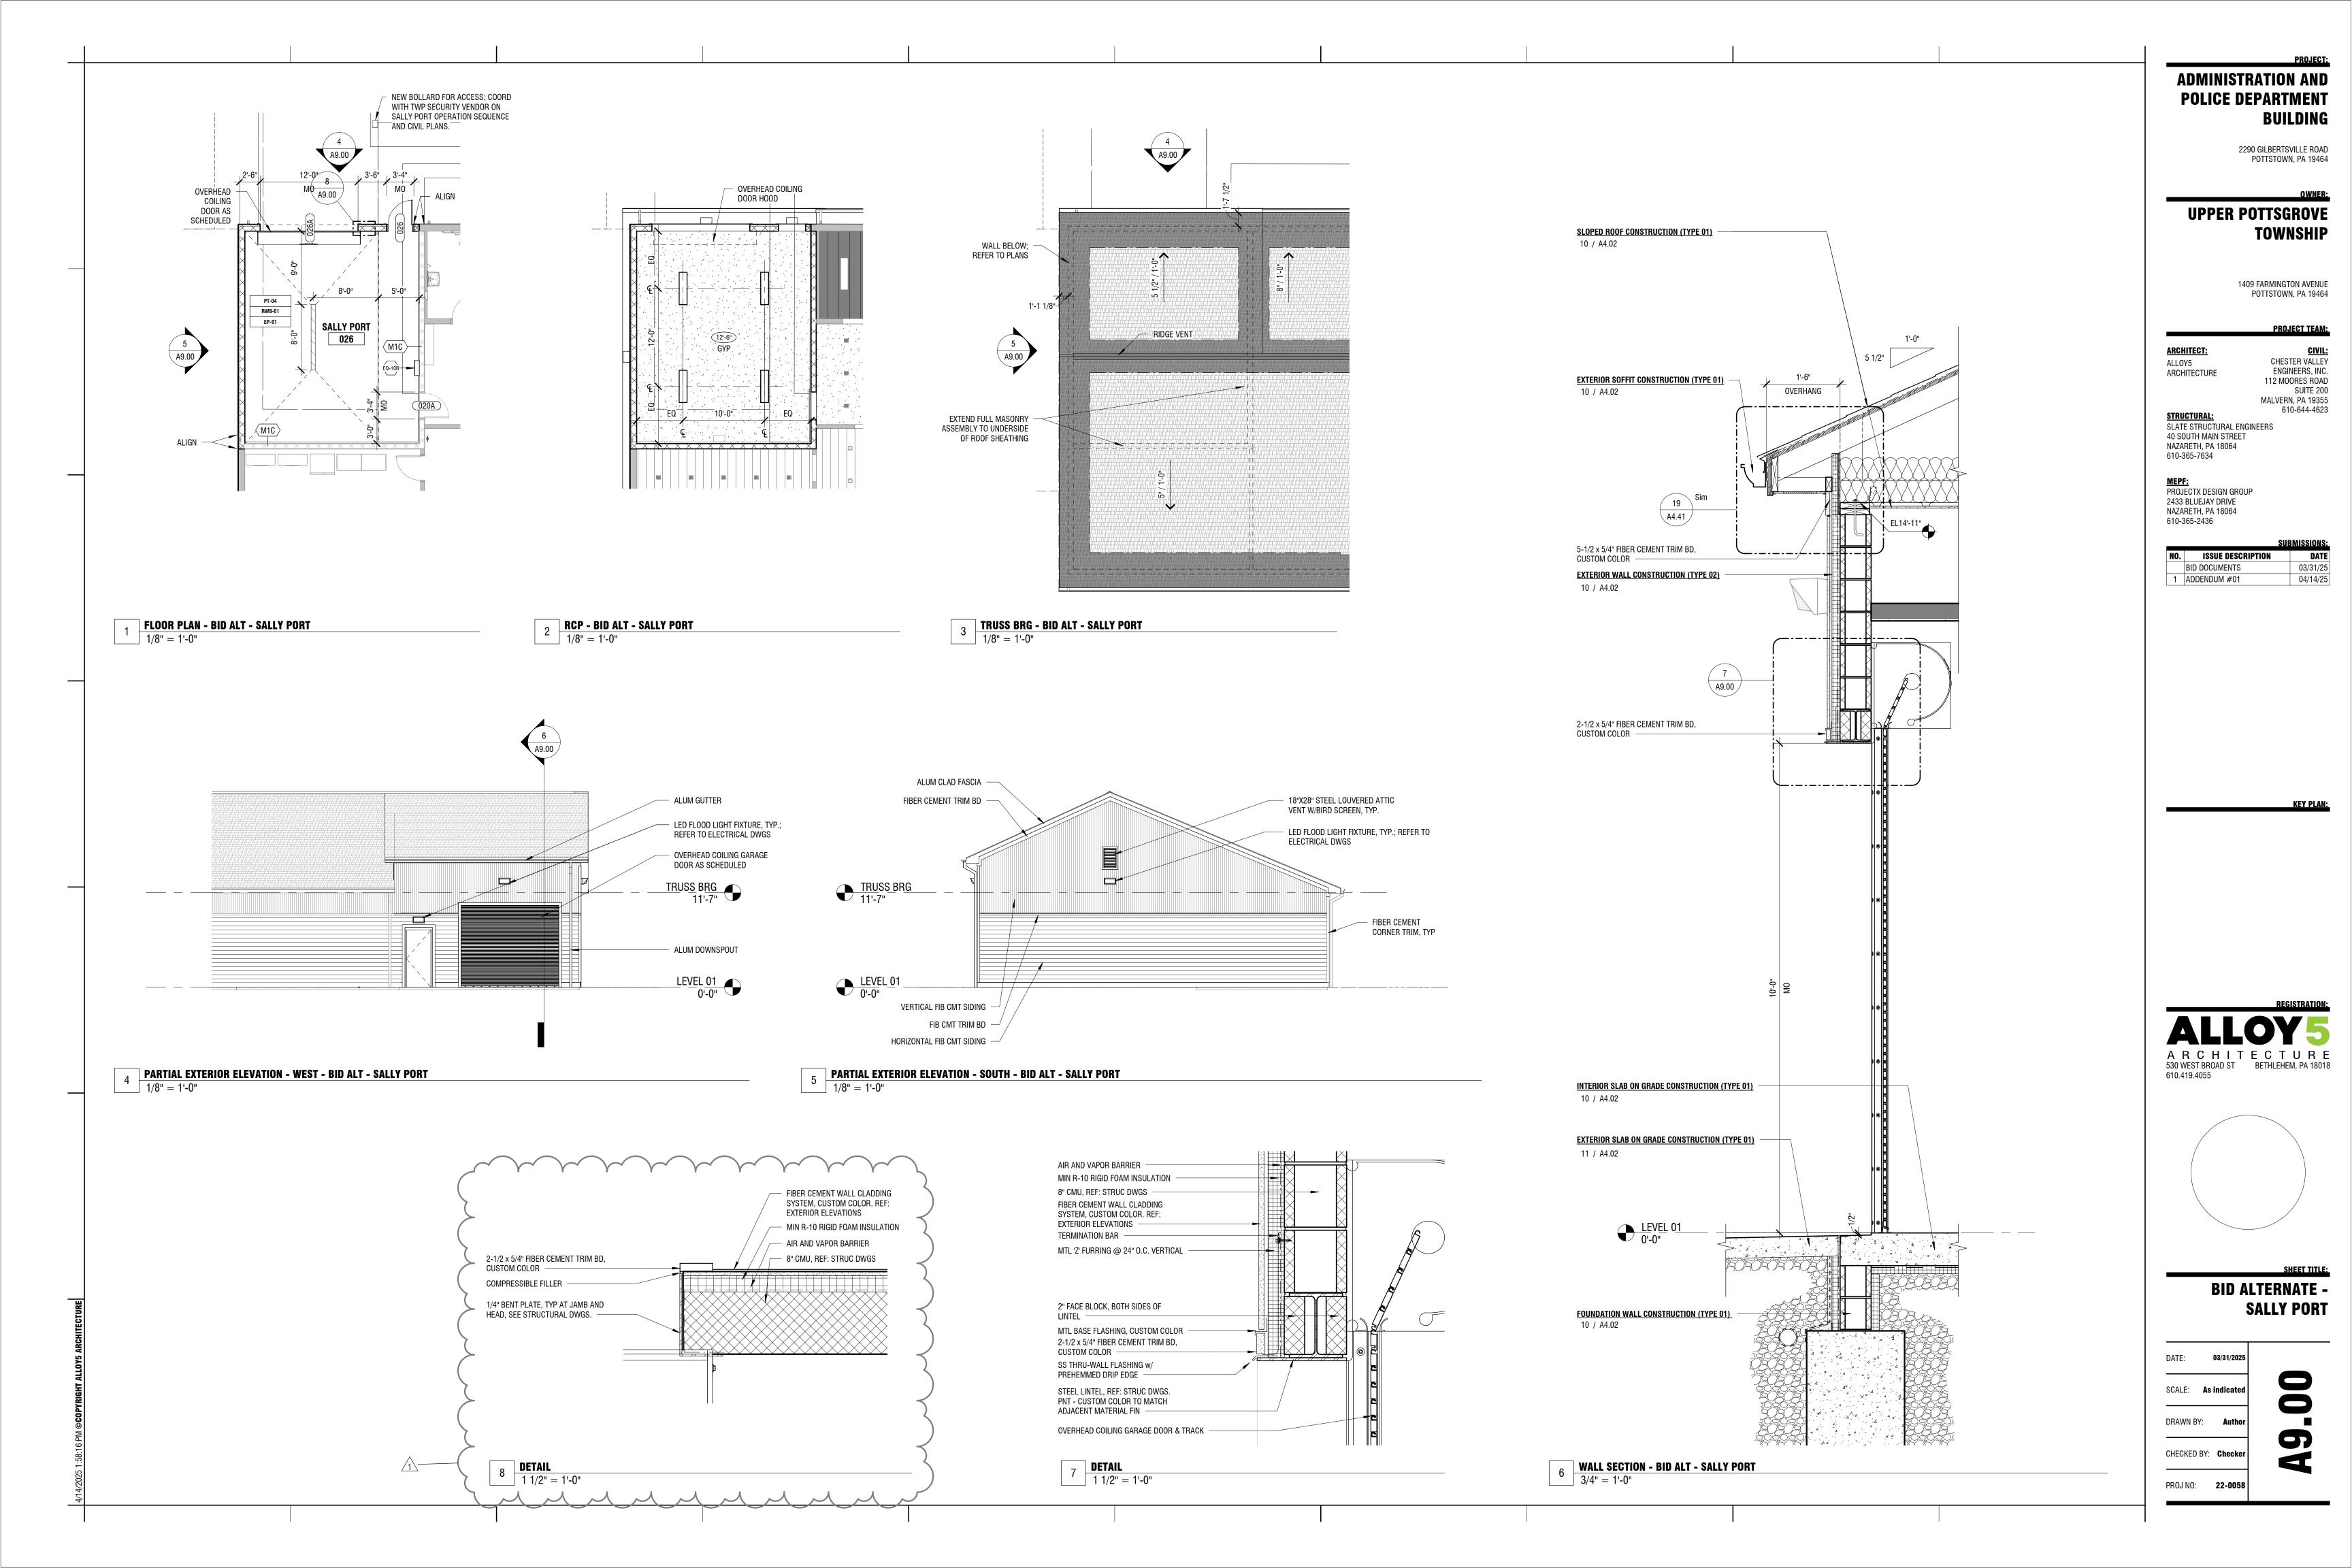

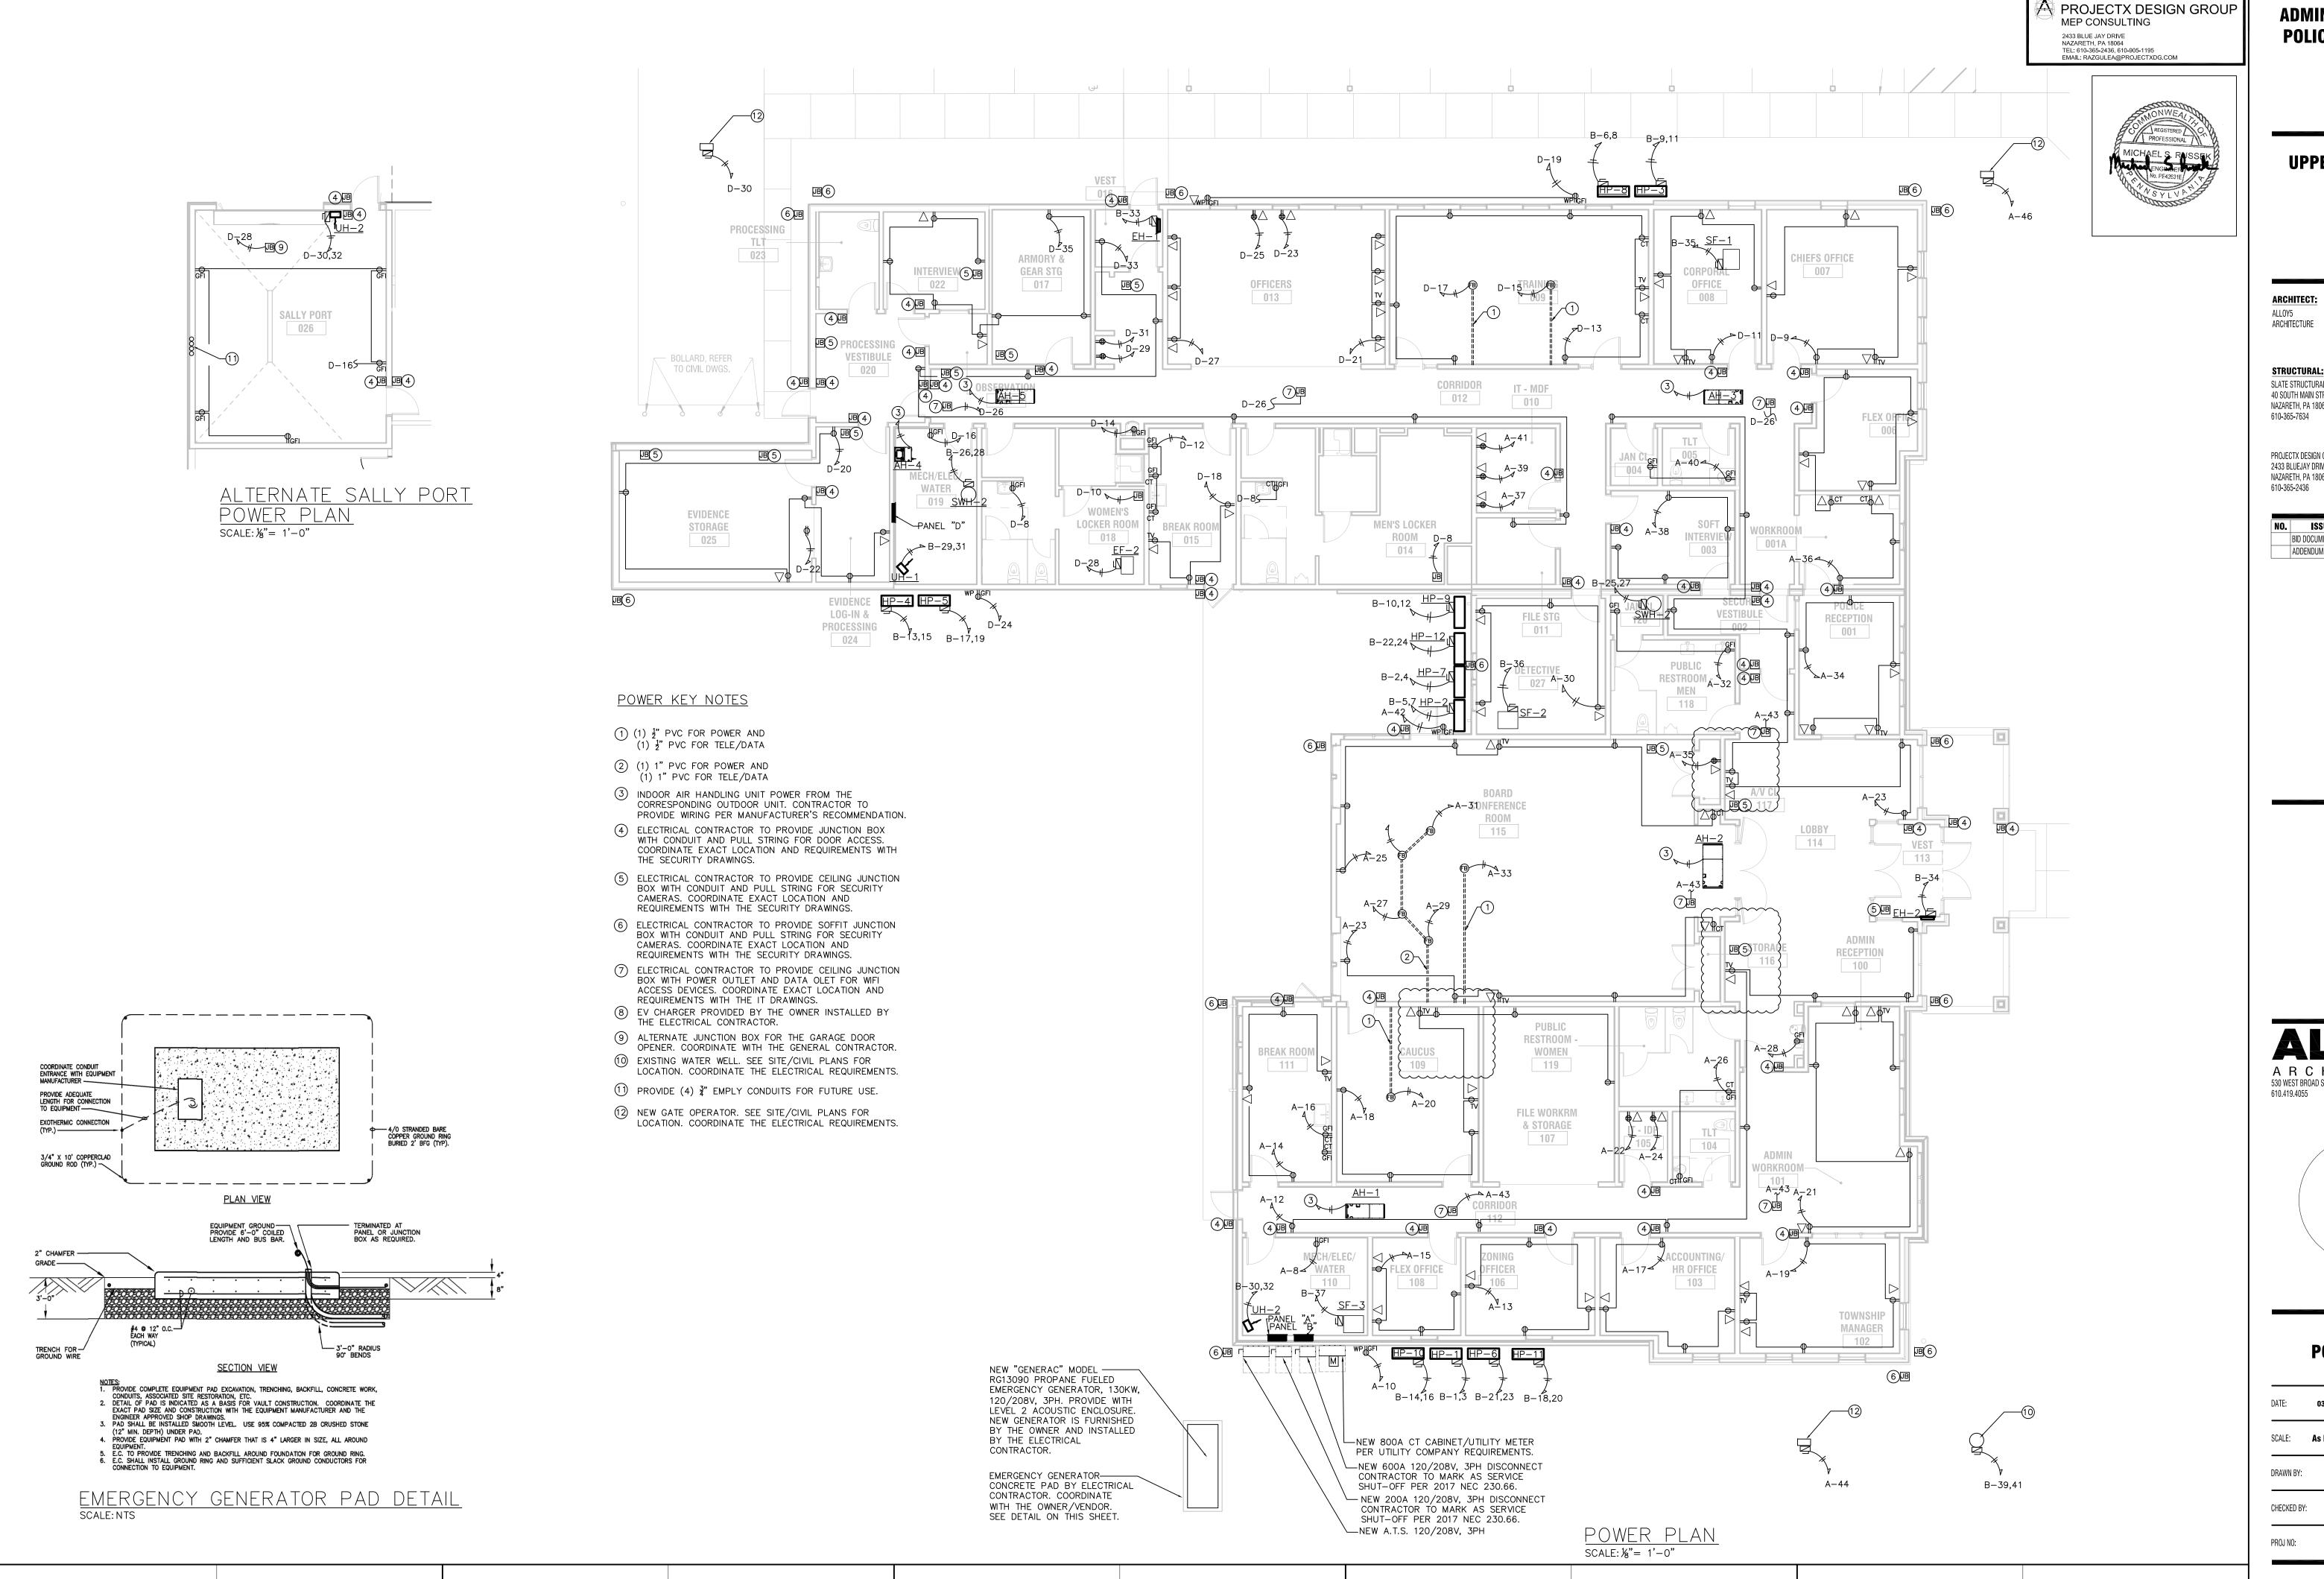

ADMINISTRATION AND POLICE DEPARTMENT

BUILDING

UPPER POTTSGROVE TOWNSHIP

> 1409 FARMINGTON AVENUE POTTSTOWN, PA 19464

> > PROJECT TEAM:

2290 GILBERTSVILLE ROAD POTTSTOWN, PA 19464

CHESTER VALLEY ENGINEERS, INC. 112 MOORES ROAD SUITE 200 MALVERN, PA 19355 610-644-4623


SLATE STRUCTURAL ENGINEERS 40 SOUTH MAIN STREET NAZARETH, PA 18064

PROJECTX DESIGN GROUP 2433 BLUEJAY DRIVE NAZARETH, PA 18064

		SUB	MISSIONS:
NO.	ISSUE DESCRIPTION		DATE
	BID DOCUMENTS		03/28/25
	ADDENDUM #01		04/14/25






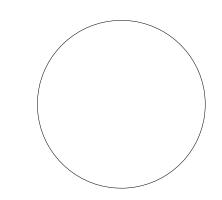

POWER PLAN

DATE: 03/31/2025 SCALE: As Indicated

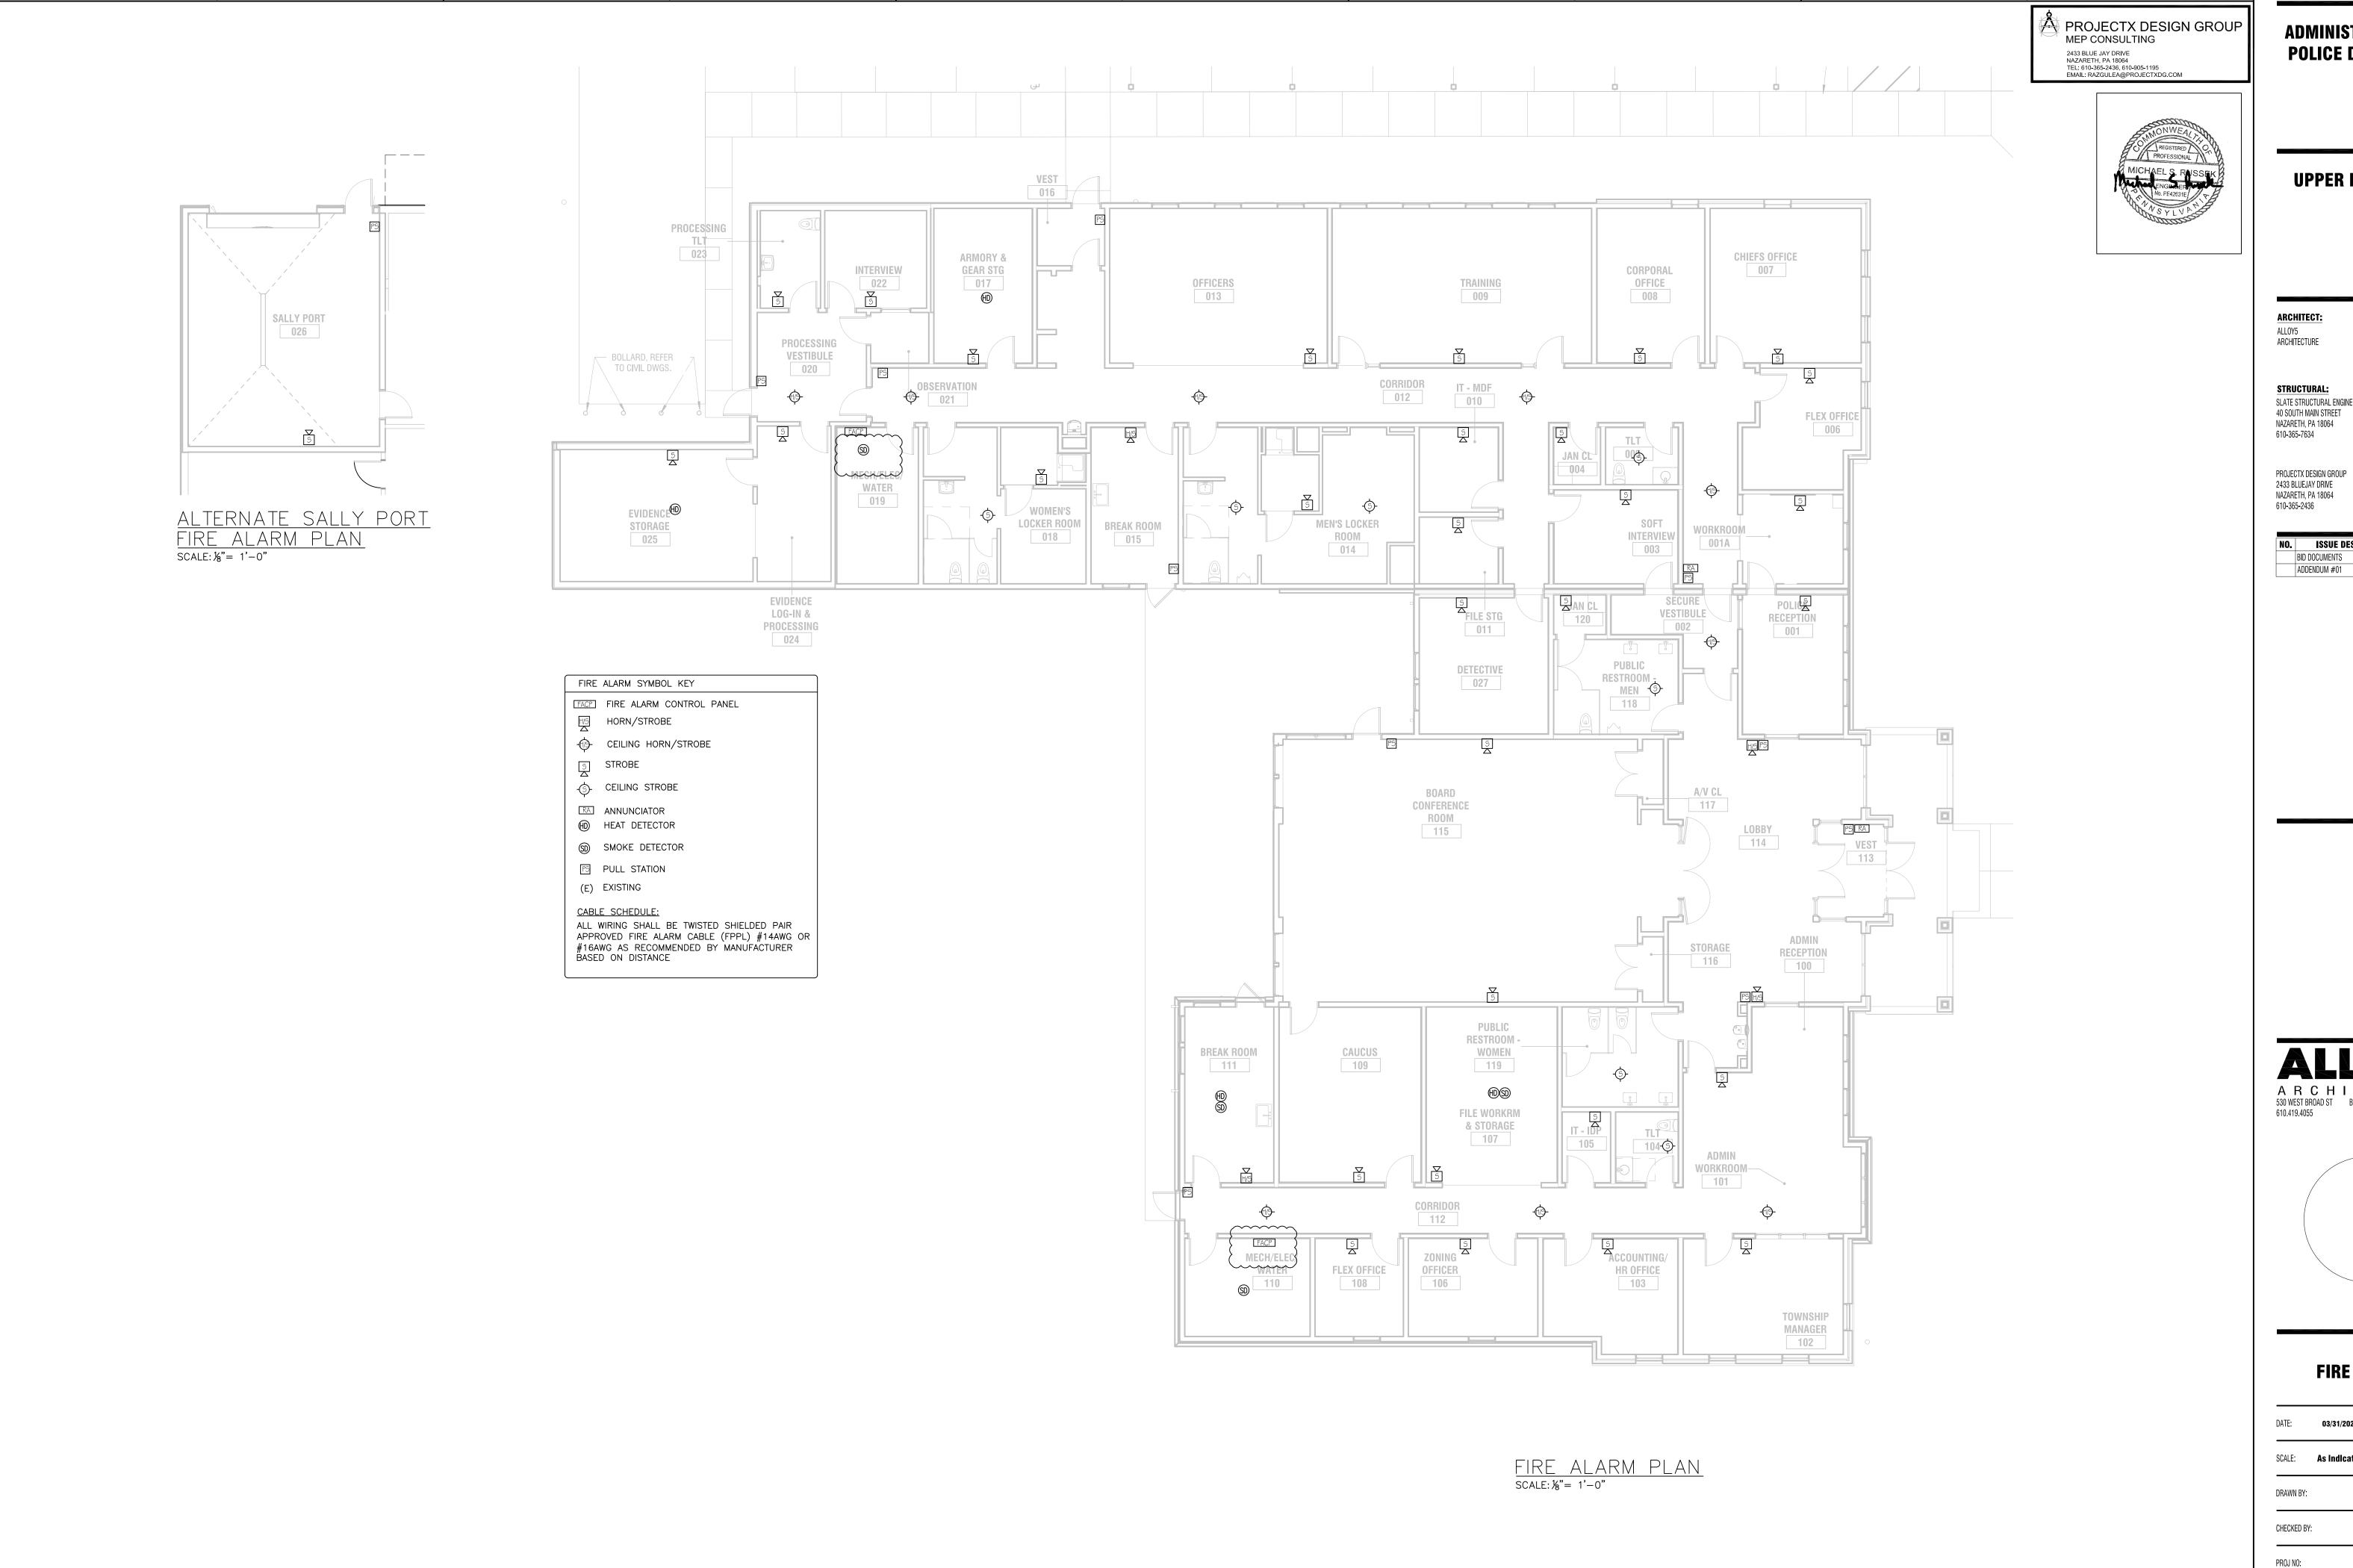

ADMINISTRATION AND POLICE DEPARTMENT

BUILDING

UPPER POTTSGROVE TOWNSHIP

1409 FARMINGTON AVENUE POTTSTOWN, PA 19464

PROJECT TEAM:

2290 GILBERTSVILLE ROAD POTTSTOWN, PA 19464


CIVIL: CHESTER VALLEY ENGINEERS, INC. 112 MOORES ROAD SUITE 200 MALVERN, PA 19355 610-644-4623

SLATE STRUCTURAL ENGINEERS 40 SOUTH MAIN STREET

		SUBMISSIONS:
NO.	ISSUE DESCRIPTION	DATE
	BID DOCUMENTS	03/28/25
	ADDENDUM #01	04/14/25






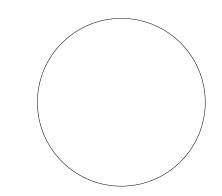


FIRE ALARM PLAN

03/31/2025 SCALE: As Indicated

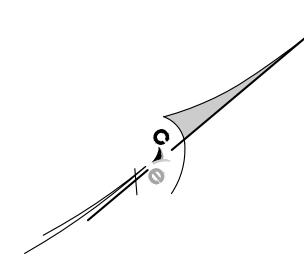

CONSTRUCTION PLANS FOR UPPER POTTSGROVE MUNICIPAL COMPLEX


UPPER POTTSGROVE TOWNSHIP - MONTGOMERY COUNTY - PENNSYLVANIA

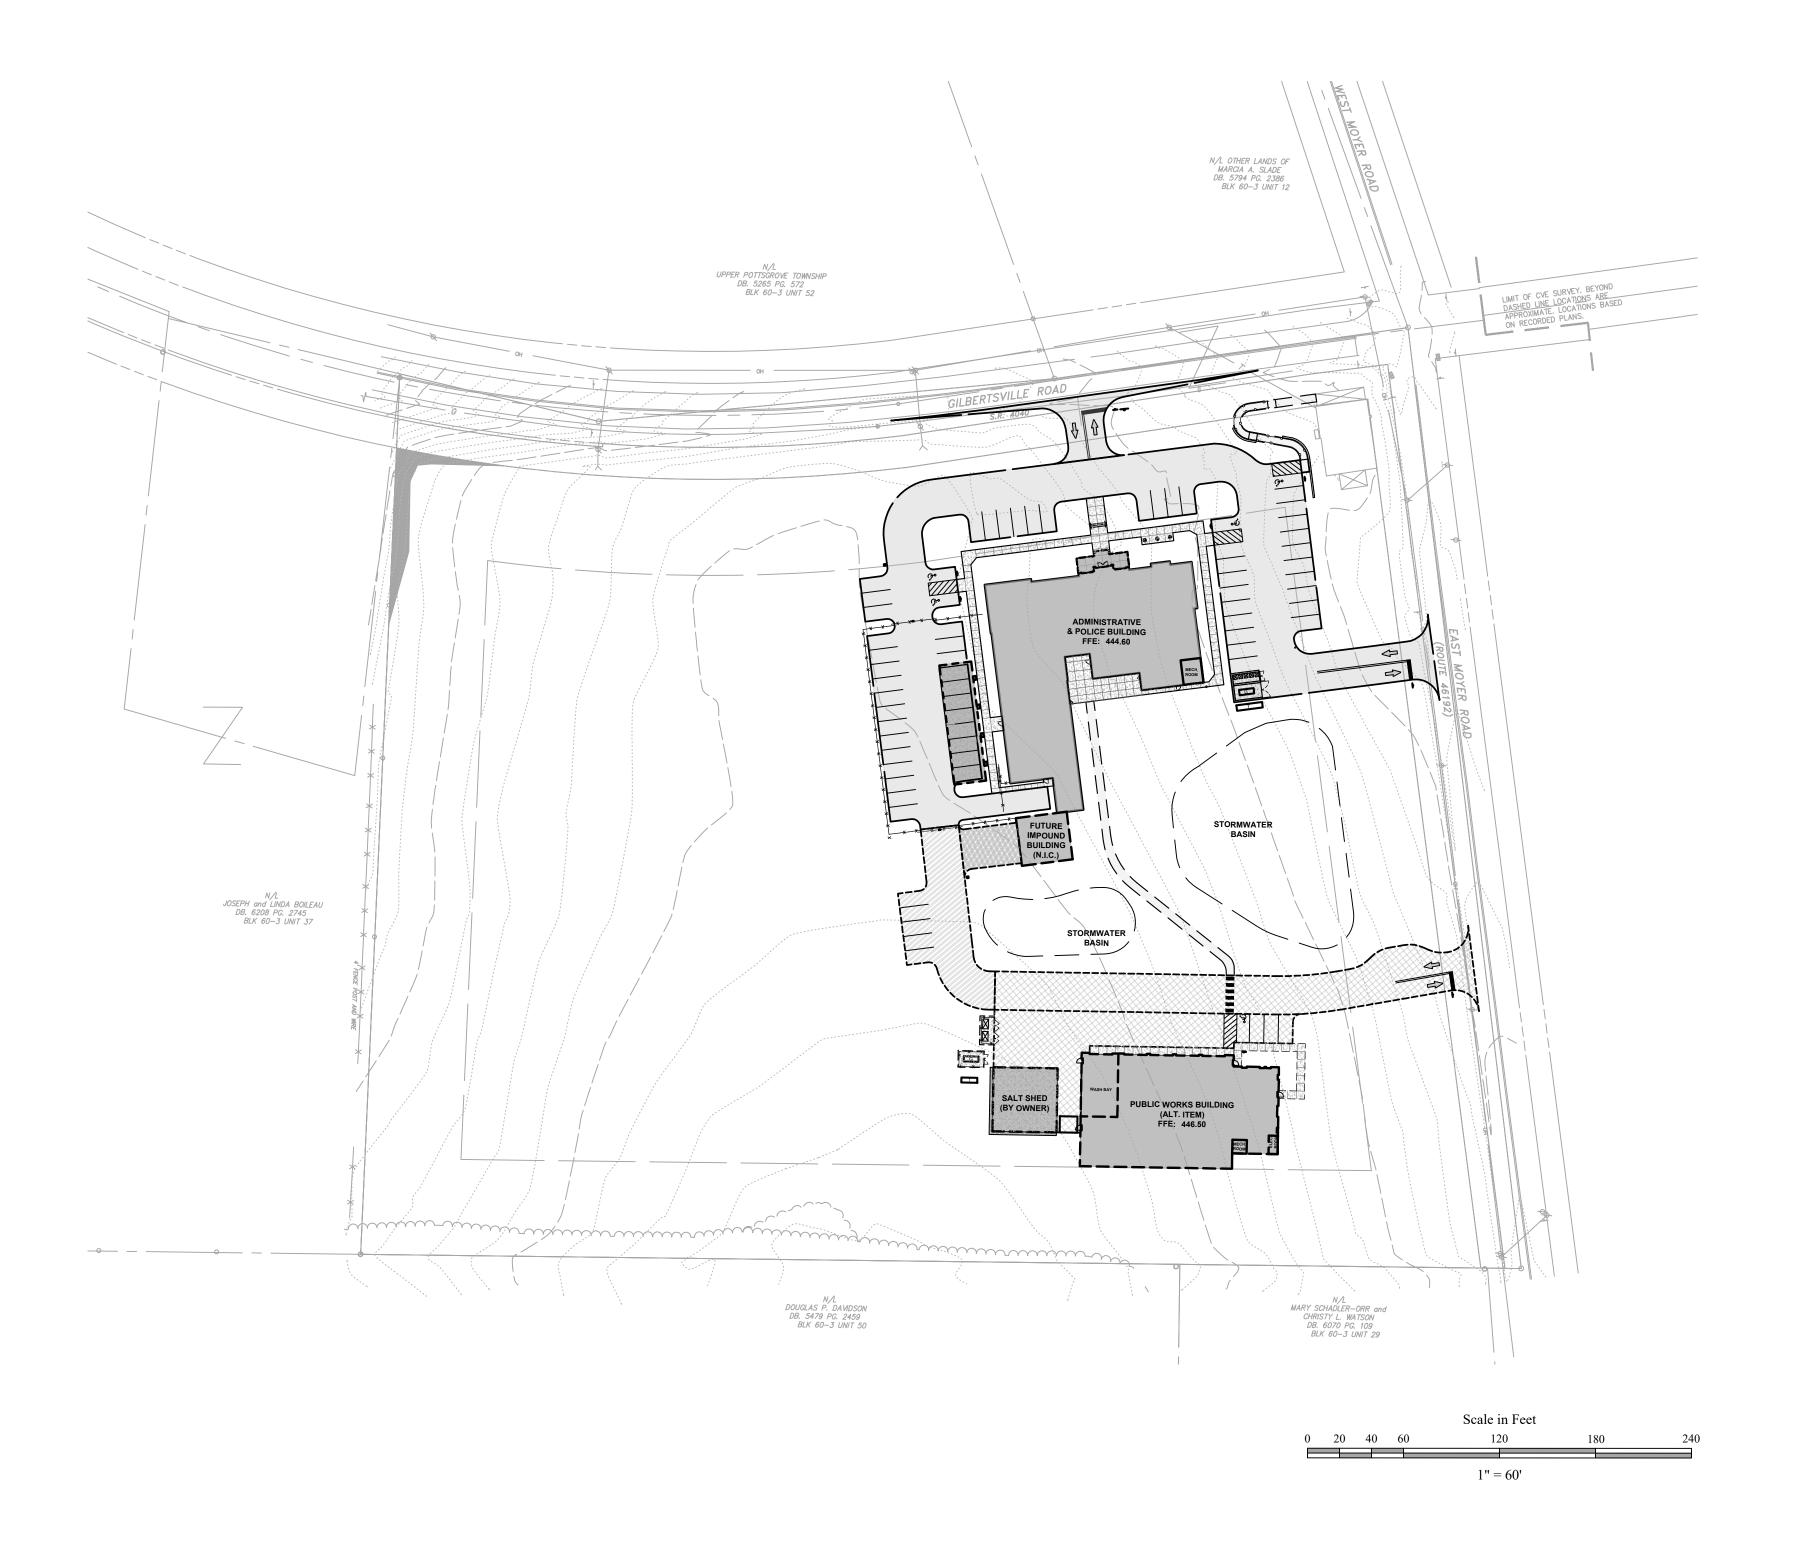



112 Moores Road, Suite 200, Malvern, PA 19355 610-644-4623 | 610-889-3143 Fax www.chesterv.com SITE ADDRESS: 2290 GILBERTSVILLE RD, POTTSTOWN, PA 19464

OWNER: UPPER POTTSGROVE TOWNSHIP 1409 FARMINGTON AVENUE, POTTSTOWN, PA, 19464 PHONE - (610) 323-8675

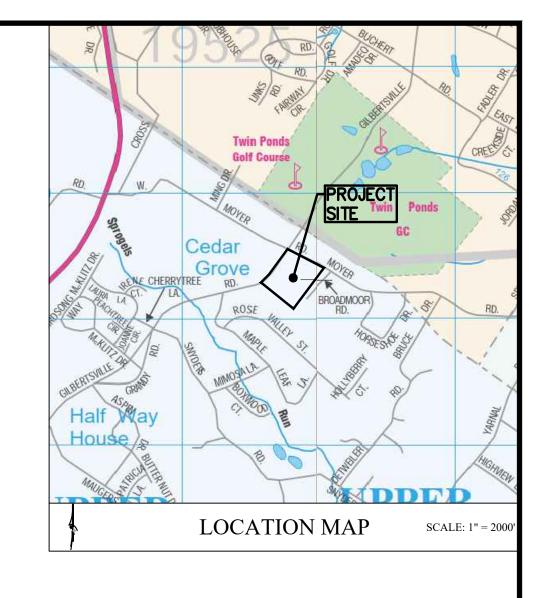

SHEET INDEX

SHEET NO.	LAST REVISED	TITLE
01	04/11/2025	COVER SHEET
02	04/11/2025	NOTES
03	04/11/2025	EXISTING FEATURES PLAN
04	04/11/2025	DEMOLITION PLAN
05	04/11/2025	SITE PLAN & DETAILS
06	04/11/2025	EROSION AND SEDIMENTATION CONTROL PLAN
07	04/11/2025	EROSION AND SEDIMENTATION CONTROL NOTES
08	04/11/2025	EROSION AND SEDIMENTATION CONTROL DETAILS
09	04/11/2025	UTILITY PLAN
10	04/11/2025	UTILITY DETAILS (SANITARY)
11	04/11/2025	UTILITY DETAILS (WATER & ELECTRIC)
12	04/11/2025	UTILITY DETAILS (ELECTRIC & GAS)
13	04/11/2025	GRADING/ STORMWATER MANAGEMENT PLAN
14	04/11/2025	PROFILES
15	04/11/2025	POST-CONSTRUCTION STORMWATER MANAGEMENT PLAN
16	04/11/2025	POST-CONSTRUCTION STORMWATER MANAGEMENT NOTES/DETAILS
17	04/11/2025	POST-CONSTRUCTION STORMWATER MANAGEMENT DETAILS
18	04/11/2025	LANDSCAPE PLAN/ DETAILS
19	04/11/2025	LIGHTING PLAN/ NOTES
20	04/11/2025	LIGHTING DETAILS
21	04/11/2025	CONSTRUCTION DETAILS
22	04/11/2025	CONSTRUCTION DETAILS
23	04/11/2025	CONSTRUCTION DETAILS

(23 SHEETS TOTAL)

CONSTRUCTION PLANS FOR UPPER POTTSGROVE MUNICIPAL COMPLEX ISSUED: MARCH 31, 2025 LAST REVISED: APRIL 11, 2025 CVE PROJECT #: 22096-2000

PLANTING NOTES

THE CONTRACTOR SHALL FURNISH AND PLANT ALL PLANTS SHOWN ON THE THE DRAWINGS, AS SPECIFIED, AND IN QUANTITIES INDICATED ON THE PLANT LIST.

- 2. ALL PLANTS SHALL BE NURSERY GROWN.
- ALL PLANTS SHALL BE IN ACCORDANCE WITH THE AMERICAN STANDARD FOR NURSERY STOCK, LATEST
- 4. ALL PLANTS SHALL BE TYPICAL OF THEIR SPECIES OR VARIETY AND SHALL HAVE A NORMAL HABIT OR GROWTH. THEY SHALL BE SOUND, HEALTHY AND VIGOROUS, WELL BRANCHED AND DENSELY FOLIATED WHEN IN LEAF. THEY SHALL BE FREE OF DISEASE AND INSECT PESTS, EGGS OR LARVAE. THEY SHALL HAVE HEALTHY, WELL DEVELOPED ROOT SYSTEMS.
- 5. SUBSTITUTIONS: WHEN PLANTS OF A SPECIFIED KIND OR SIZE ARE NOT AVAILABLE WITHIN A REASONABLE DISTANCE, SUBSTITUTIONS MAY BE MADE UPON REQUEST BY THE CONTRACTOR, IF APPROVED BY THE OWNER OR HIS REPRESENTATIVE AND THE TOWNSHIP. CONTRACTOR SHALL NOTIFY THE OWNER, IN WRITING OF ANY PLANT MATERIALS WHICH THEY FEEL WILL NOT BE AVAILABLE OR LIKELY TO THRIVE IN THE LOCATIONS INDICATED ON THE PLAN.
- 6. MEASUREMENT: DIMENSIONS OF TREES AND SHRUBS SHALL CONFORM TO THE AMERICAN STANDARD FOR NURSERY STOCK, LATEST EDITION.
- 7. SIZE: ALL PLANTS SHALL CONFORM TO THE MEASUREMENT SPECIFIED ON THE PLANT LIST, UNLESS AUTHORIZED IN WRITING BY AND THE TOWNSHIP LANDSCAPE ARCHITECT/ENGINEER.
- 8. BALLED AND BURLAPPED PLANTS SHALL BE DUG WITH FIRM NATURAL BALLS OF EARTH, OF DIAMETER AND DEPTH TO INCLUDE MOST OF THE FIBROUS ROOTS. CONTAINER GROWN STOCK SHALL HAVE BEEN GROWN IN A CONTAINER LONG ENOUGH FOR THE ROOT SYSTEM TO HAVE DEVELOPED SUFFICIENTLY TO HOLD ITS SOIL TOGETHER FIRM & WHOLE. NO PLANTS SHALL BE LOOSE IN THE CONTAINER.
- 9. PLANT MATERIALS NOT PLANTED THE DAY OF DELIVERY ARE TO BE HEALED IN SO THAT ROOT SYSTEMS ARE PROTECTED FROM THE DRYING FORCES OF THE WIND AND SUN. TEMPORARY WATER SYSTEMS ARE TO BE USED FOR PLANT MATERIALS WHICH WILL BE STORED FOR MORE THAN ONE WEEK.
- 10. THE TOWNSHIP LANDSCAPE ARCHITECT/ENGINEER SHALL BE NOTIFIED PRIOR TO BEGINNING PLANTING OPERATIONS, IN WRITING.
- 11. PLANTS WITH DAMAGED OR BROKEN ROOT BALLS OR EXCESSIVE DAMAGE TO THE CROWN AS DETERMINED BY THE TOWNSHIP LANDSCAPE ARCHITECT/ENGINEER WILL NOT BE ACCEPTED AND ARE TO BE REMOVED FROM THE SITE AND REPLACED WITH ACCEPTABLE MATERIAL.
- 12. TREE STAPLING SHALL BE INSTALLED ACCORDING TO THE PLANTING DETAILS. TREE STAPLES SHALL BE INSTALLED ON ALL DECIDUOUS AND EVERGREEN TREES. THE LANDSCAPE CONTRACTOR IS RESPONSIBLE FOR ASSURING THAT TREES ARE MAINTAINED STRAIGHT AND UPRIGHT THROUGHOUT THE GUARANTEE PERIOD. THE TREE STAPLES REMAIN INSTALLED AS THEY WILL DETERIORATE WITHIN
- 13. EACH TREE AND SHRUB SHALL BE PRUNED IN ACCORDANCE WITH THE AMERICAN NURSERY AND LANDSCAPE ASSOCIATION (ANLA) STANDARDS TO PRESERVE THE NATURAL CHARACTER OF THE PLANT. ONLY DEAD WOOD OR SUCKERS AND ALL BROKEN OR BADLY BRUISED BRANCHES SHALL BE REMOVED AT TIME OF PLANTING. TREES AND SHRUBS ARE TO BE PRUNED ONE YEAR AFTER PLANTING. IT IS THE CONTRACTOR'S RESPONSIBILITY TO PRUNE TREES AND SHRUBS AT THE APPROPRIATE TIME.
- 14. MULCH FOR TREES, SHRUBS AND GROUND COVER SHALL BE FINELY SHREDDED OAK BARK, DARK BROWN IN COLOR: AGED AT LEAST ONE YEAR AND CLEAN AND FREE OF WEEDS. PRE-EMERGENT WEED KILLER SHALL BE 'TREFLAN' OR APPROVED EQUAL. APPLY WEED KILLER TO TOPSOIL PRIOR TO MULCHING BED PLANTINGS. ALL SHRUBS TO BE PLANTED IN CONTINUOUS BEDS UNLESS OTHERWISE NOTED. ALL SHRUB BEDS TO RECEIVE 3" DEEP CONTINUOUS MULCH COVER. MULCH MAY NOT TOUCH THE TRUNKS OF TREES OR THE MAIN STEMS OF SHRUBS.
- 15. TREES IN LEAF WHEN PLANTED SHALL BE TREATED WITH ANTI-DESICANT SUCH AS WILT-PROOF.
- 16. PREPARATION OF PLANTING SOIL BEFORE MIXING, CLEAN TOPSOIL OF ROOTS, PLANTS, STONES, CLAY LUMPS, AND OTHER EXTRANEOUS MATERIALS HARMFUL OR TOXIC TO PLANT GROWTH. SOIL (BACKFILL) FOR TREES, SHRUBS, AND GROUNDCOVER SHALL BE A MIXTURE BY VOLUME OF THE FOLLOWING MATERIALS IN QUANTITIES SPECIFIED: 20% PEAT MOSS, 75% TOPSOIL AND 5% ORGANIC MATTER. ADD AN ORGANIC FERTILIZER TO THE ABOVE MIXTURE AT THE RATES SPECIFIED BY THE MANUFACTURER. FOR NEW TREES AND SHRUBS.
- 17. WARRANT TREES AND SHRUBS FOR A PERIOD OF 12 MONTHS AFTER WRITTEN DATE OF ACCEPTANCE BY THE TOWNSHIP LANDSCAPE ARCHITECT AGAINST DEFECTS INCLUDING DEATH AND UNSATISFACTORY GROWTH. PLANTS THAT DIE DURING THE WARRANTY PERIOD SHALL BE REMOVED IMMEDIATELY. REPLACEMENTS SHALL BE PLACED UNDER WARRANTY AN ADDITIONAL 12 MONTH PERIOD. A PLANT SHALL BE CONSIDERED DEAD IF 25% OR MORE OF THE PLANT HAS DIED.
- 18. CONDITIONS DETRIMENTAL TO PLANTS: THE CONTRACTOR SHALL NOTIFY THE PROJECT REPRESENTATIVE AND THE TOWNSHIP ENGINEER IN WRITING OF ALL SOIL OR DRAINAGE CONDITIONS WHICH THE CONTRACTOR CONSIDERS DETRIMENTAL TO THE GROWTH OF PLANTS. HE SHALL STATE THE CONDITIONS AND SUBMIT A PROPOSAL FOR CORRECTING THE CONDITIONS, INCLUDING ANY CHANGE IN COST FOR REVIEW AND ACCEPTANCE BY THE PROJECT REPRESENTATIVE.
- 19. MINOR ADJUSTMENTS TO TREE LOCATION MAY BE NECESSARY DUE TO FIELD CONDITIONS AND FINAL GRADING. THE CONTRACTOR SHALL NOTIFY THE TOWNSHIP'S REPRESENTATIVE IF MAJOR ADJUSTMENTS ARE REQUIRED.
- 20. TOPSOIL SHALL BE REPLACED AT A THICKNESS OF APPROXIMATELY EIGHT (8) INCHES. MINIMUM OF SIX (6) INCHES IN ALL NEWLY ESTABLISHED LAWN AREAS AND A MINIMUM OF TWELVE (12) INCHES IN FOUNDATION PLANTING AREAS. THE MATERIAL MUST MEET THE REQUIREMENTS OF THE PENNSYLVANIA DEPARTMENT OF TRANSPORTATION FORM 408 SPECIFICATIONS, AS AMENDED. ANY EXCAVATED ROCK DUE TO LANDSCAPE INSTALLATION MUST BE DISPOSED OF OFF SITE.
- 21. THE CONTRACTOR SHALL CONTACT THE TOWNSHIP IN WRITING TO REQUEST A FINAL INSPECTION FOR ACCEPTANCE AT THE END OF THE GUARANTEE PERIOD. THESE INSPECTIONS WILL BE PERFORMED WHEN MATERIALS ARE IN FULL LEAF ONLY (MAY 1 THROUGH NOVEMBER 15). ALL GUARANTEE ESCROW FUNDS WILL BE RELEASED UPON ACCEPTANCE AT THE END OF THE GUARANTEE PERIOD. THE GUARANTEE WILL BE EXTENDED UNTIL THIRTY (30) DAYS AFTER RECEIPT OF THE REQUEST LETTER FOLLOWING MAY 1. SHOULD THE END OF THE GUARANTEE PERIOD OCCUR AFTER NOVEMBER 15, THE GUARANTEE SHALL BE EXTENDED TO MAY 15.
- 22. PERMANENT SEED MIX SHALL BE AS NOTED ON EROSION AND SEDIMENTATION NOTES. THE FALL PLANTING SEASON SHALL EXTEND FROM SEPTEMBER 1 TO OCTOBER 15. THE SPRING PLANTING SEASON SHALL EXTEND FROM APRIL 1 TO MAY 15.

CONSTRUCTION NOTES

- WORK IN THE SITEWORK CONSTRUCTION CONTRACT INCLUDES ALL LABOR, MATERIALS EQUIPMENT, AND SERVICES NECESSARY FOR THE CIVIL CONSTRUCTION. WORK SHALL BE DEFINED IN THE CIVIL (C-SERIES) AND HIGHWAY OCCUPANCY PERMIT (HOP) DRAWINGS, AS DESCRIBED IN THE GENERAL CONDITIONS AND SPECIFICATIONS DIVISIONS 01, 31, 32, AND 33. WORK OF THIS CONTRACT INCLUDES, BUT IS NOT LIMITED TO, THE FOLLOWING:
- 1.1. SITE PREPARATION, INCLUDING CLEARING, EARTHWORK, DEMOLITION, AND GRADING. IMPORT AND/OR EXPORT OF FILL MATERIAL
- THIS INCLUDES LOADING, HAULING, INSTALLATION, IMPORT, EXPORT, AND DISPOSAL OF FILL MATERIAL LOCATED ON THE FARM PROPERTY ACROSS MOYER ROAD AT THE EVANS SITE.
- THIS INCLUDES IMPORT OF FILL MATERIAL TO THE EVANS SITE, AND EXPORT OF FILL MATERIAL FROM THE GILBERTSVILLE SITE. SITE CONTRACTOR IS RESPONSIBLE FOR TEMPORARILY STOCKPILING APPROXIMATELY 3,600CY OF MATERIAL AND THE APPROPRIATE E&S MEASURES AT THE GILBERTSVILLE SITE AS SHOWN ON THE CVE CIVIL PLANS. IN LATE FALL OR WINTER, AS DIRECTED BY THE CONSTRUCTION MANAGER, THE SITE CONTRACTOR IS RESPONSIBLE FOR LOADING, HAULING AND DUMPING ALL MATERIAL TO 370 EVANS ROAD, POTTSTOWN, PA.
- 1.3. SITE IMPROVEMENTS INCLUDING, BUT NOT LIMITED TO, ROADWAYS, PARKING LOTS, PEDESTRIAN PAVING WHERE NOT ASSIGNED TO THE GC, SITE DEVELOPMENT FURNISHINGS, EQUIPMENT, AND LANDSCAPING. ALL CURBS, ISLANDS, ACCESS ROADS, RETAINING WALLS, FENCING, OPERABLE GATES, RAIN GARDENS, UTILITY INSTALLATION UP TO WITHIN 5 FEET OF THE BUILDING.
- ESTABLISHMENT OF BUILDING PAD TO BE PROVIDED AT FINISH FLOOR MINUS CONCRETE STAB AND STONE THICKNESS.
- SANITARY, STORM, AND WATER PIPING TO WITHIN 5 FEET OUTSIDE THE BUILDING FOOTPRINT. INCLUDING EXCAVATION, PATCHING IF REQUIRED, AND BACKFILL.
- AQUA AMERICA WILL INSTALL THE PROPOSED COPPER WATER SUPPLY PIPE, LOCATED BETWEEN THE CONNECTION WITH THE MAIN AND THE PROPOSED WATER METER, ALONG WITH MAKING THE CONNECTION AT THE MAIN. THE SITE CONTRACTOR SHALL PERFORM ALL OTHER WATER RELATED UTILITY WORK IN SUPPORT OF AQUA AMERICA'S WORK INCLUDING BUT NOT LIMITED TO ROADWAY AND NON-ROADWAY EXCAVATION/REPAIR, METER PIT/BACKFLOW PREVENTER INSTALLATION, AND ALL ON SITE WATER COMPONENTS. SITE CONTRACTOR WILL BE RE-SPONSIBLE FOR ALL SAW CUTTING, TRENCH EXCAVATION, BACKFILLING OF TRENCH, AND RESTORE EITHER IN GRASS OR PAVED AREAS FROM THE MAIN CONNECTION TO THE METER PIT. THE SITE CONTRACTOR IS RESPONSIBLE FOR FULL INSTALLATION METHODS OF THE WATER FROM THE METER PIT TO 5 FEET FROM THE BUILDING
- 2. 2. THE PUBLIC WORKS AND IMPOUND BUILDINGS, ALONG WITH THE ASSOCIATED ENTRY DRIVE AND PARKING LOT, ARE DESIGNATED AS ALTERNATE BID ITEMS; HOWEVER. ALL UTILITIES. STORMWATER MANAGEMENT FACILITIES, AND FINAL GRADING SHALL BE COMPLETED AS PART OF THE BASE BID.
- 3. ALL CONTRACTORS SHALL BE RESPONSIBLE FOR CONFIRMING THE LOCATION AND ELEVATION OF ALL EXISTING UTILITIES WITHIN THE WORK AREA BEFORE THE START OF CONSTRUCTION. IF A CONFLICT EXISTS, CONTRACTOR IS TO NOTIFY THE ENGINEER IMMEDIATELY, FOR RESOLUTION.
- 4. COST OF BUILDING REPAIRS ASSESSED TO CONTRACTOR RESPONSIBLE FOR BUILDING & FACADE DAMAGE DURING CONSTRUCTION.
- 5. IT IS THE RESPONSIBILITY OF THE CONTRACTOR TO SUBMIT SEALED DRAWINGS AND CALCULATIONS FOR THE RETAINING WALL TO THE TOWNSHIP AND LANDSCAPE ARCHITECT FOR REVIEW AND APPROVAL. ALL SUCH DOCUMENTS SHALL BE SEALED BY A PENNSYLVANIA-LICENSED STRUCTURAL ENGINEER.

DEMOLITION NOTES:

- REMOVAL OF EXISTING SANITARY INCLUDES THE REMOVAL OF THE ENTIRE SEPTIC SYSTEM AND ANY UNSUITABLE SOILS.
- CONTRACTOR SHALL BE RESPONSIBLE FOR CONFIRMING THE LOCATION AND ELEVATION OF ALL EXISTING UTILITIES WITHIN THE WORK AREA BEFORE THE START OF CONSTRUCTION. IF A CONFLICT EXISTS, CONTRACTOR IS TO NOTIFY THE ENGINEER IMMEDIATELY.
- 3. IF REQUIRED, CONTRACTOR IS RESPONSIBLE FOR GRADE ADJUSTMENT OF ALL SURFACE UTILITIES, INCLUDING BUT NOT LIMITED TO VALVES, LIDS, GRATES, RIMS, CAPS, STORM AND SANAITARY STRUCTURES WITHIN THE LIMITS OF WORK. GRADE ADJUSTMENTS SHALL BE MADE PRIOR TO THE INSTALLATION OF PAVEMENT WEARING COURSE OR PLACEMENT OF TOPSOIL IN UNPAVED AREAS.
- CONTRACTOR SHALL BE RESPONSIBLE FOR REPAIRING ALL EXISTING FEATURES WHICH ARE DAMAGED DURING CONSTRUCTION AND ARE INDICATED TO REMAIN.
- 5. REMOVAL OF EXISTING PAVED SURFACES INCLUDES THE REMOVAL OF CRUSHED STONE BASE
- DEMOLITION OF TREES AND OTHER VEGETATION INCLUDES REMOVAL OF ALL STUMPS AND ROOT SYSTEMS WITHIN 24" OF EXISTING GRADE.

GRADING NOTES:

- ALL GRADING SHALL BE PERFORMED IN ACCORDANCE WITH THE APPROVED PLANS.
- 2. ADA RAMP TO EXISTING RESIDENCE IS AN ALTERNATE ITEM. IF NOT SELECTED. A 3:1 FILL SLOPE AND SWALE AT BUILDING SHALL BE INSTALLED AS PART OF THE BASE BID.
- 3. IT IS THE RESPONSIBILITY OF THE CONTRACTOR TO VERIFY THE EXISTING SITE AND SUBSURFACE CONDITIONS PRIOR TO PROCEEDING AND WHILE PROGRESSING WITH THE WORK.
- 4. CLASSIFICATION OF EXCAVATION: IF ROCK AS HEREIN DEFINED, IS ENCOUNTERED WITHIN THE LIMITS OF EXCAVATION, THE CONTRACT PRICE WILL BE ADJUSTED UPON AN AGREED UNIT PRICE PER CUBIC YARD AND INFORM THE TOWNSHIP REPRESENTATIVE IMMEDIATELY. ROCK EXCAVATION WILL CONSIST OF THE REMOVAL AND DISPOSAL OF BOULDERS ONE CUBIC YARD OR MORE IN VOLUME: SOLID ROCK; MATERIALS THAT CANNOT BE REMOVED WITHOUT SYSTEMATIC DRILLING AND BLASTING SUCH AS ROCK MATERIAL IN LEDGES OR AGGREGATE CONGLOMERATE DEPOSITS THAT ARE SO FIRMLY CEMENTED AS TO POSSESS THE CHARACTERISTICS OF SOLID ROCK; AND CONCRETE OR MASONRY STRUCTURES EXCEEDING ONE CUBIC YARD IN VOLUME, EXCEPT SIDEWALKS AND PAVING.
- 5. HARD AND COMPACT MATERIALS SUCH AS CEMENTED-GRAVEL, GLACIAL TILL, AND RELATIVELY SOFT OR DISINTEGRATED ROCK THAT CAN BE REMOVED WITHOUT CONTINUOUS AND SYSTEMATIC DRILLING AND BLASTING WILL NOT BE CONSIDERED AS ROCK EXCAVATION. ROCK EXCAVATION WILL NOT BE CONSIDERED SUCH BECAUSE OF INTERMITTENT DRILLING AND BLASTING THAT IS PERFORMED MERELY TO INCREASE PRODUCTION. EXCAVATION OF THE MATERIAL CLAIMED AS ROCK WILL NOT BE PERFORMED UNTIL THE MATERIAL HAS BEEN CROSS-SECTIONED AND
- CONTOURED TRANSITION FROM CUT OR FILL FACES TO NATURAL GROUND AND ABUTTING CUT OR FILL SURFACES.
- 7. ALL PROPOSED CONTOUR GRADES AND SPOT ELEVATIONS SHOWN ARE TO TOP OF PAVING,

PA ONE CALL OWNERS LIST:

COMPANY:COMCAST ADDRESS:1250 HADDONFIELD-BERLIN RD. CHERRY HILL, NJ. 08034 **CONTACT:WYATT PARRISH** EMAIL:WYATT_PARRISH@CABLE.COMCAST.COM PHONE:484-368-4391

COMPANY:AQUA PENNSYLVANIA ADDRESS:762 LANCASTER AVE. BRYN MAWR, PA. 19010 CONTACT: THOMAS WADDY EMAIL:TBWADDY@AQUAAMERICA.COM PHONE:610-525-1400 EXT. 52105

COMPANY:PECO AN EXELON COMPANY C/O USIC ADDRESS:450 S HENDERSON ROAD SUITE B KING OF PRUSSIA, PA. 19406 CONTACT:NIKKIA SIMPKINS EMAIL:NIKKIASIMPKINS@USICLLC.COM PHONE:484-681-5720

COMPANY:FIRSTENERGY CORPORATION ADDRESS:21 S MAIN ST. AKRON, OH. 44308 CONTACT: MELLYSSA ADAMS EMAIL:MADAMS@FIRSTENERGYCORP.COM PHONE:330-604-4073


COMPANY:UGI UTILITIES INC ADDRESS:225 MORGANTOWN RD. READING, PA. 19611 CONTACT:KURT ZIELASKOWSKI EMAIL:KZIELASKOWSKI@UGI.COM PHONE:610-736-5571

COMPANY: UPPER POTTSGROVE TOWNSHIP ADDRESS:1409 FARMINGTON AVE. POTTSTOWN, PA. 19464 CONTACT: KEVIN SNYDER EMAIL:PUBLICWORKS@UPTOWNSHIP.ORG PHONE:610-326-9938

LEGENDS

PROPOSED GRADING FEATURES **EXISTING FEATURES** \times 443.50 PROPOSED SPOT ELEVATION EXISTING 1' CONTOURS __2%__ PROPOSED SLOPE _ — — 205 — — EXISTING 5' CONTOURS EXISTING SPOT ELEVATION PROPOSED 1' CONTOURS EXISTING PROPERTY BOUNDARY PROPOSED 5' CONTOURS EXISTING RIGHT OF WAY (LEGAL R/W) BUILDING SETBACK X X X X X X X EXISTING FENCE LINE PROPOSED STORMWATER FEATURES EXISTING EDGE OF PAVING PROPOSED STORM PIPE EcB2 SOILS LINE AND DESCRIPTION BdAPROPOSED YARD DRAIN PROPOSED TYPE 'M' INLET BOX EXISTING WATER LINE PROPOSED TRENCH DRAIN ==== EXISTING HDPE PIPE PROPOSED STORM MANHOLE PROPOSED FLARED END SECTION & RIPRAP APRON EXISTING FIRE HYDRANT EXISTING INLETS PROPOSED LANDSCAPING FEATURES EXISTING UTILITY POLE EXISTING TRAFFIC CONTROL SIGNS PROPOSED DECIDUOUS TREE INFILTRATION TESTING LOCATION EXISTING DECIDUOUS TREE EXISTING CONIFEROUS TREE EDGE OF BRUSH PROPOSED EVERGREEN TREE EXISTING MANHOLE (SAN, STORM, GAS, WATER, WATER, ELECTRIC, TELEPHONE, ETC.) PROPOSED SHRUB STEEP SLOPES 15-> PROPOSED PERENNIAL & GRASS PROPOSED DEMOLITION FEATURES

EXISTING PAVING TO BE DEMOLISHED

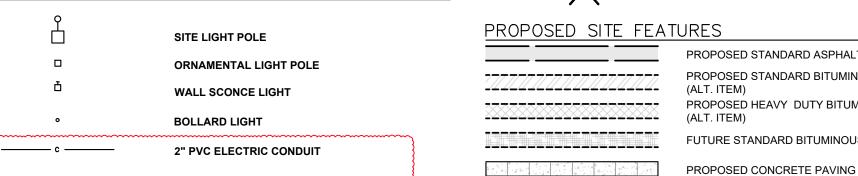

PROPOSED UTILITY FEATURES PROPOSED WATER LINE

LIGHTING LEGEND

PROPOSED SANITARY LINE PROPOSED ELECTRIC LINE PROPOSED XFMR VAULT PROPOSED GENERATOR PROPOSED PROPANE TANK

ELECTRIC PULL BOX

ITEMS INCLUDED IN 04/11/2025 REVISIONS:

LIGHTING LEGEND ITEMS ADDED

PROPOSED STANDARD ASPHALT PAVING PROPOSED STANDARD BITUMINOUS PAVEMENT PROPOSED HEAVY DUTY BITUMINOUS PAVEMENT FUTURE STANDARD BITUMINOUS PAVEMENT (N.I.C

EXISTING PLANTS TO BE DEMOLISHED

PROPOSED BUILDING PROPOSED PARKING OVERHANG PROPOSED PATIO

PROPOSED PAVEMENT MARKING PROPOSED FENCE/GATE ---- PROPOSED SPARE CONDUIT PROPOSED DRIVE PAVEMENT MARKING

PROPOSED DUMPSTER

PROPOSED SIGN PROPOSED WHEEL STOP PROPOSED HANDICAP MARKING PROPOSED BOLLARD PROPOSED FLAG POLE


PARKING STALL QUANTITY FUTURE E.V. CHARGING STATION PROPOSED POLICE PARKING ACCESS KEY PAD

PROPOSED E&S FEATURES PROPOSED CONSTRUCTION ENTRANCE PROPOSED CONCRETE WASHOUT PROPOSED TEMPORARY TOPSOIL STOCKPILE PROPOSED EROSION CONTROL BLANKET

PROPOSED LIMIT OF DISTURBANCE NPDES PROJECT SITE AREA PROPOSED TREE PROTECTION FENCE/ ********** ORANGE CONSTRUCTION FENCE

PROPOSED COMPOST FILTER SOCK PROPOSED INLET PROTECTION PROPOSED TEMPORARY INLET SEAL

DISCHARGE POINT

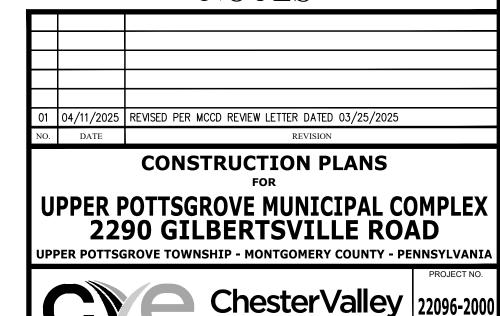

610-644-4623

www.chesterv.com DRAWN BY CHECKED BY 03/31/2025

COPYRIGHT

CHESTER VALLEY ENGINEERS, INC., CIVIL ENGINEERS & SURVEYORS, EXPRESSLY RESERVES ITS COMMON LAW COPYRIGHT AND ALL OTHER

MOTE TO USER OF THESE PLANS:






, FROM ALL CLAIMS, DAMAGES, LOSSES, AND EXPENSES ARISING THERETO OR RESULTING THEREFROM. AND VALIDATION OF THE INFORMATION CONTAINED IN THIS FILE.

MITH THE REQUIREMENTS OF THE FOLLOWING UNITED STATES DEPARTMENT OF LABOR OCCUPATIONAL SAFETY AND HEALTH ADMINISTRATION PUBLICATIONS OR THE LATEST REVISIONS THERETO:


AND EXPENSES ARISING THERETO OR RESULTING THEREFROM. AND VALIDATION OF THE INFORMATION CONTAINED IN THIS FILE.


(1) CONSTRUCTION INDUSTRY STANDARDS AND INTERPRETATIONS (OSHA 07) SUBPART "P", PART 1926/1910 – "EXCAVATIONS, TRENCHING


SEE SHEET 02 FOR FACILITY OWNER'S DESIGNATED OFFICE ADDRESS AND ELEPHONE NUMBER


PENNSYLVANIA ONE CALL SYSTEM, INC. CALL 3 WORKING DAYS BEFORE YOU DIG

- CLASSIFIED BY THE ENGINEER.
- 6. ALL PROPOSED SLOPES SHALL BE ROUNDED INTO THE EXISTING TERRAIN TO PRODUCE A
- FINISHED FLOOR OR FINISH GRADE IN LANDSCAPED AREAS.

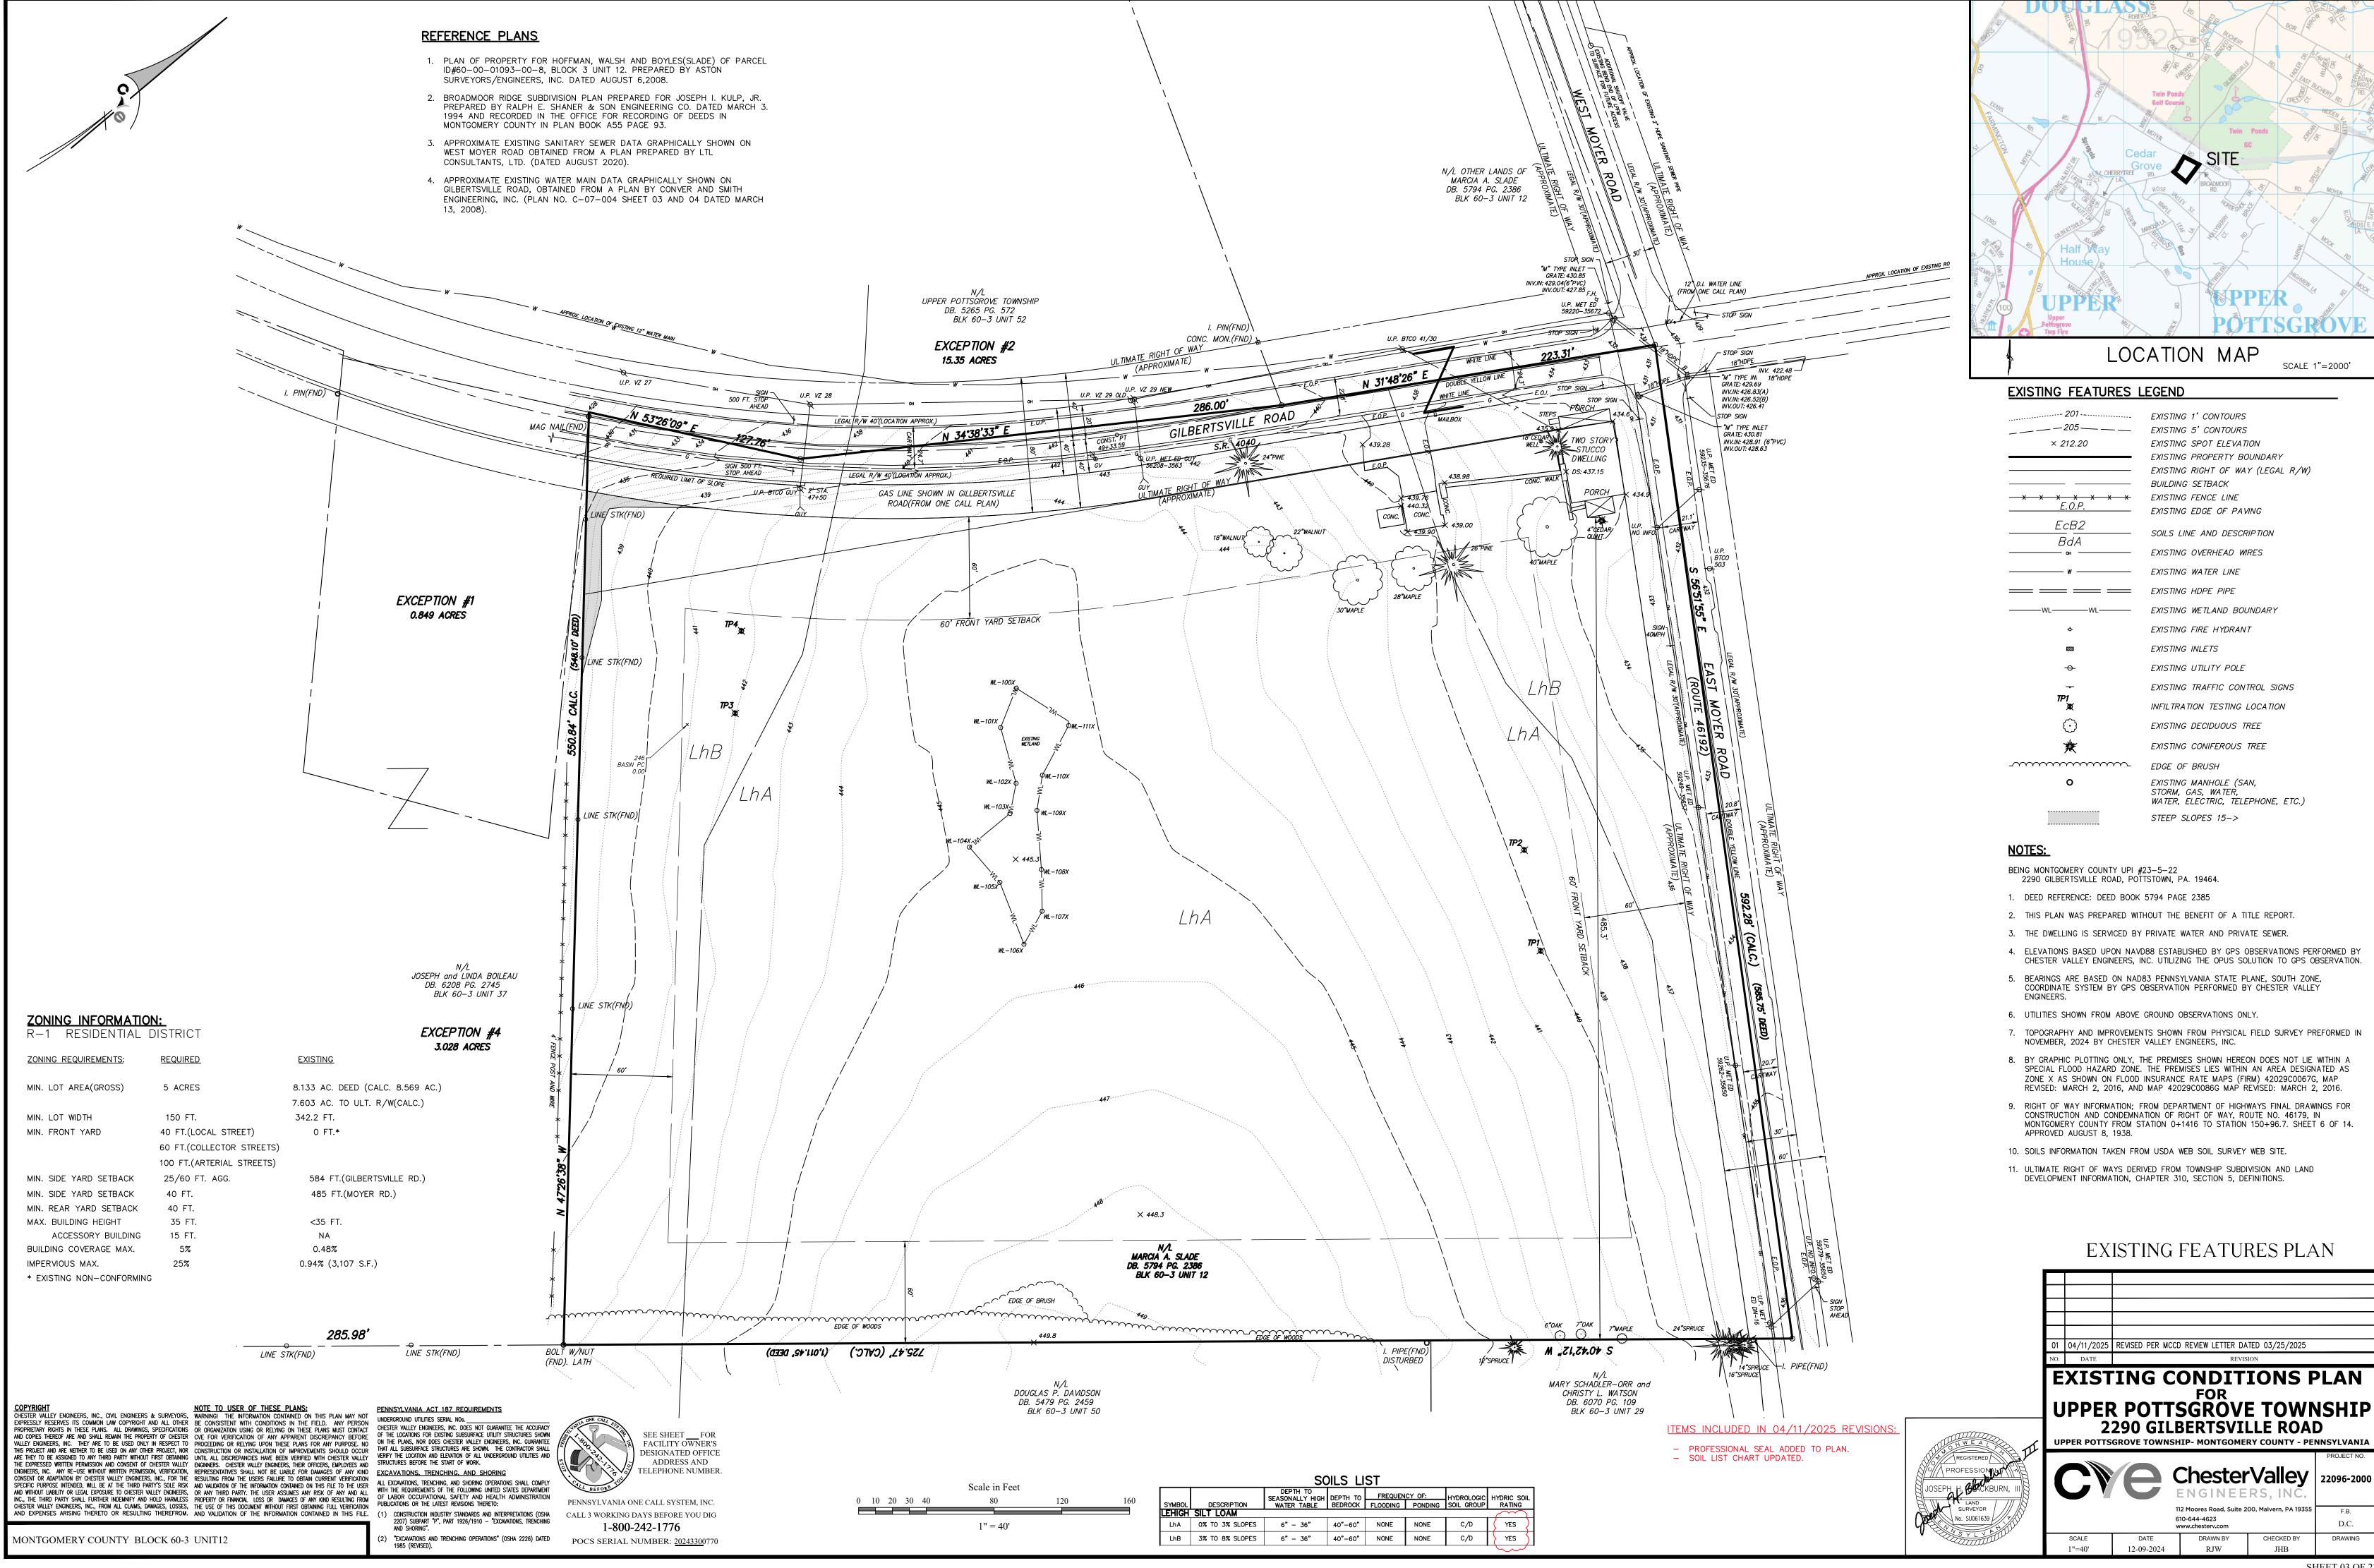

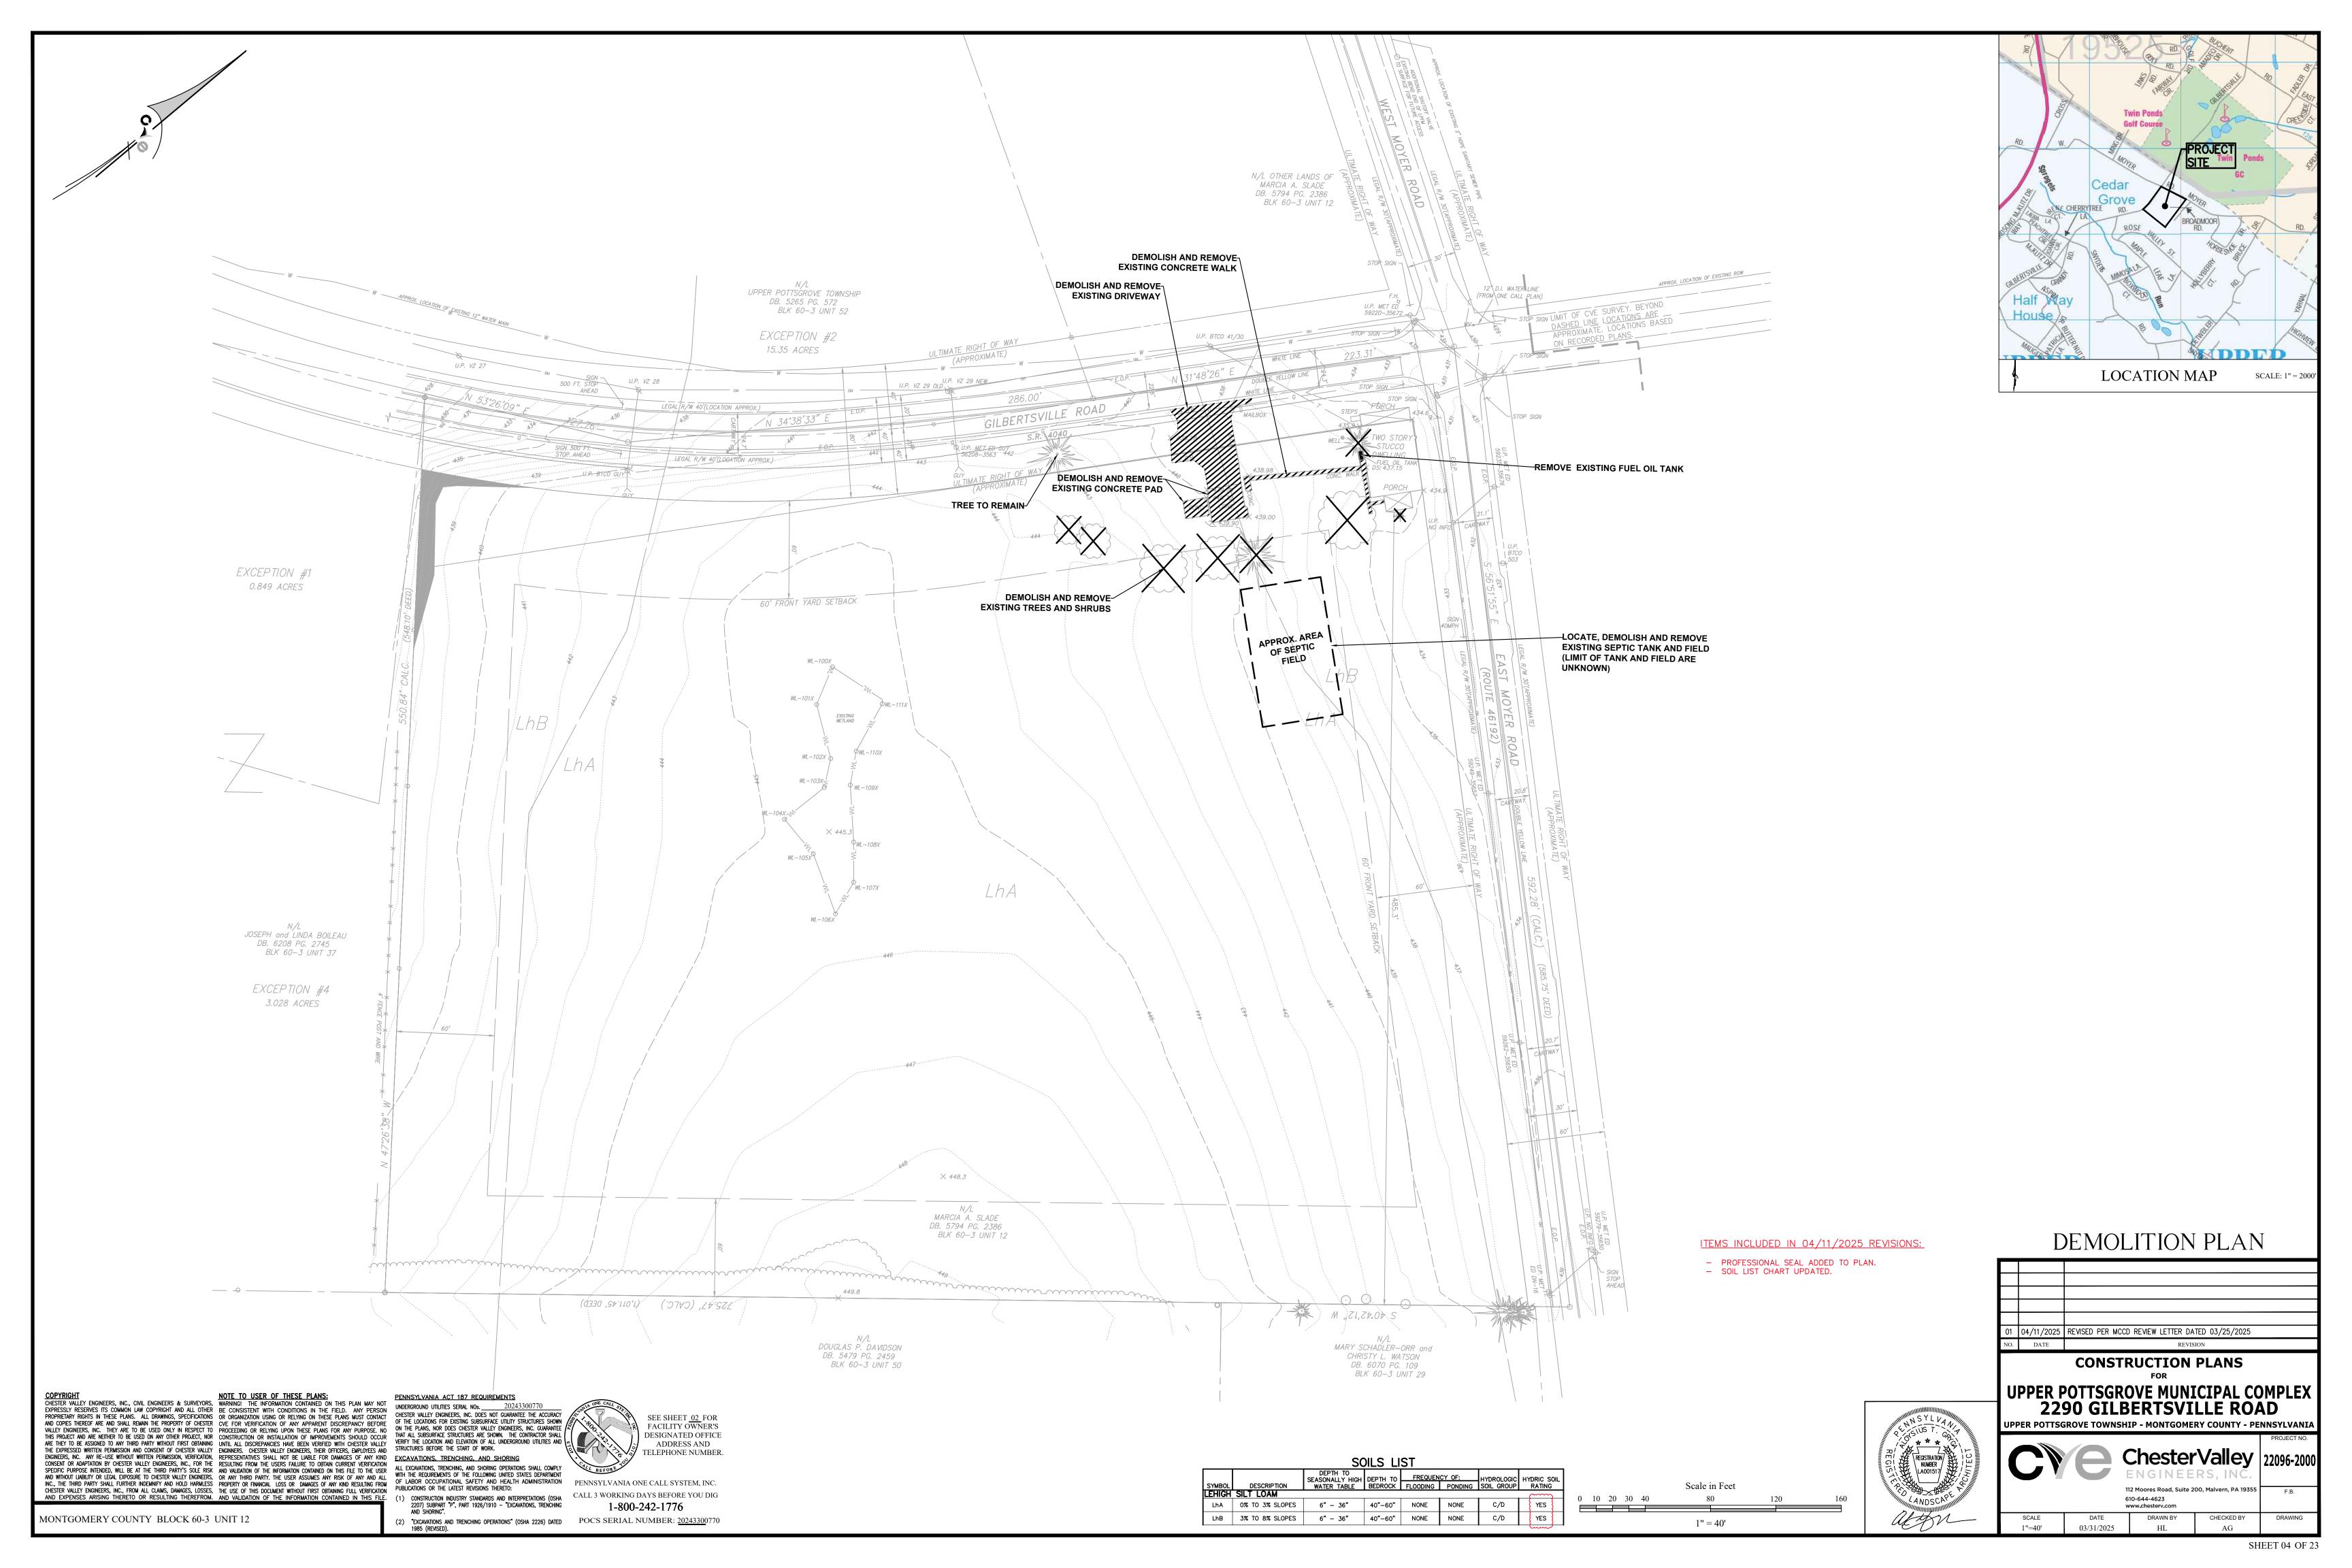

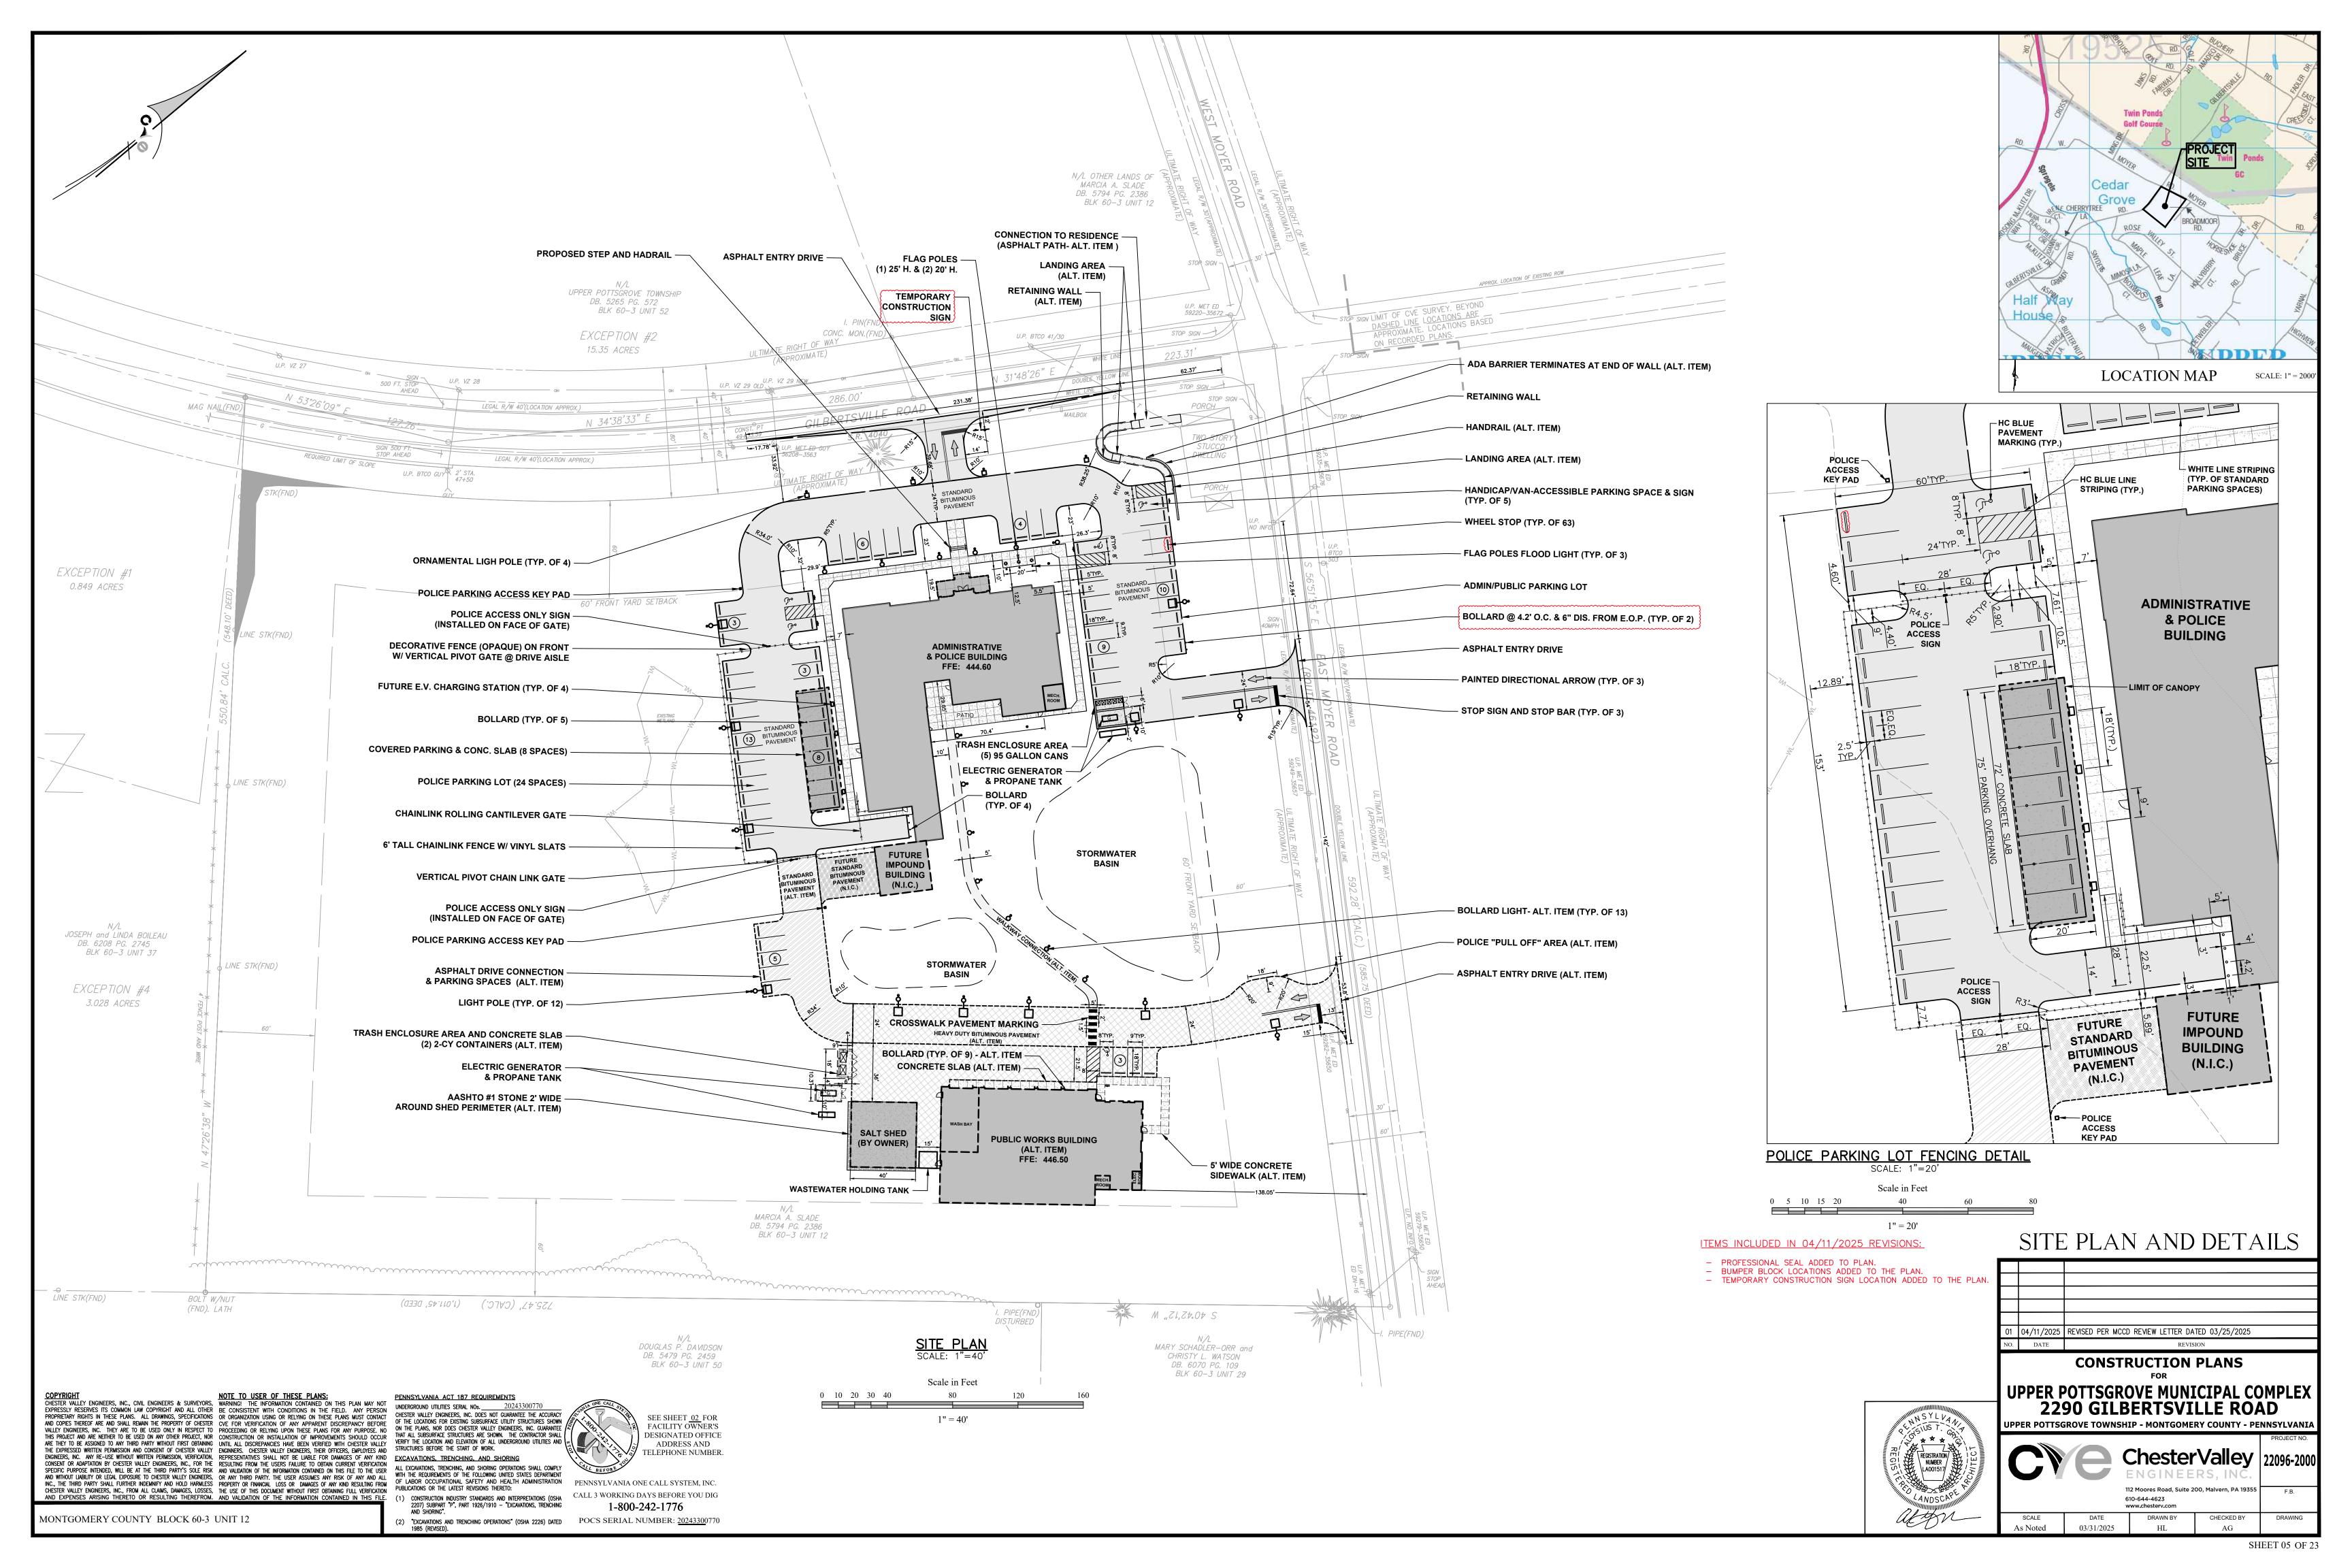

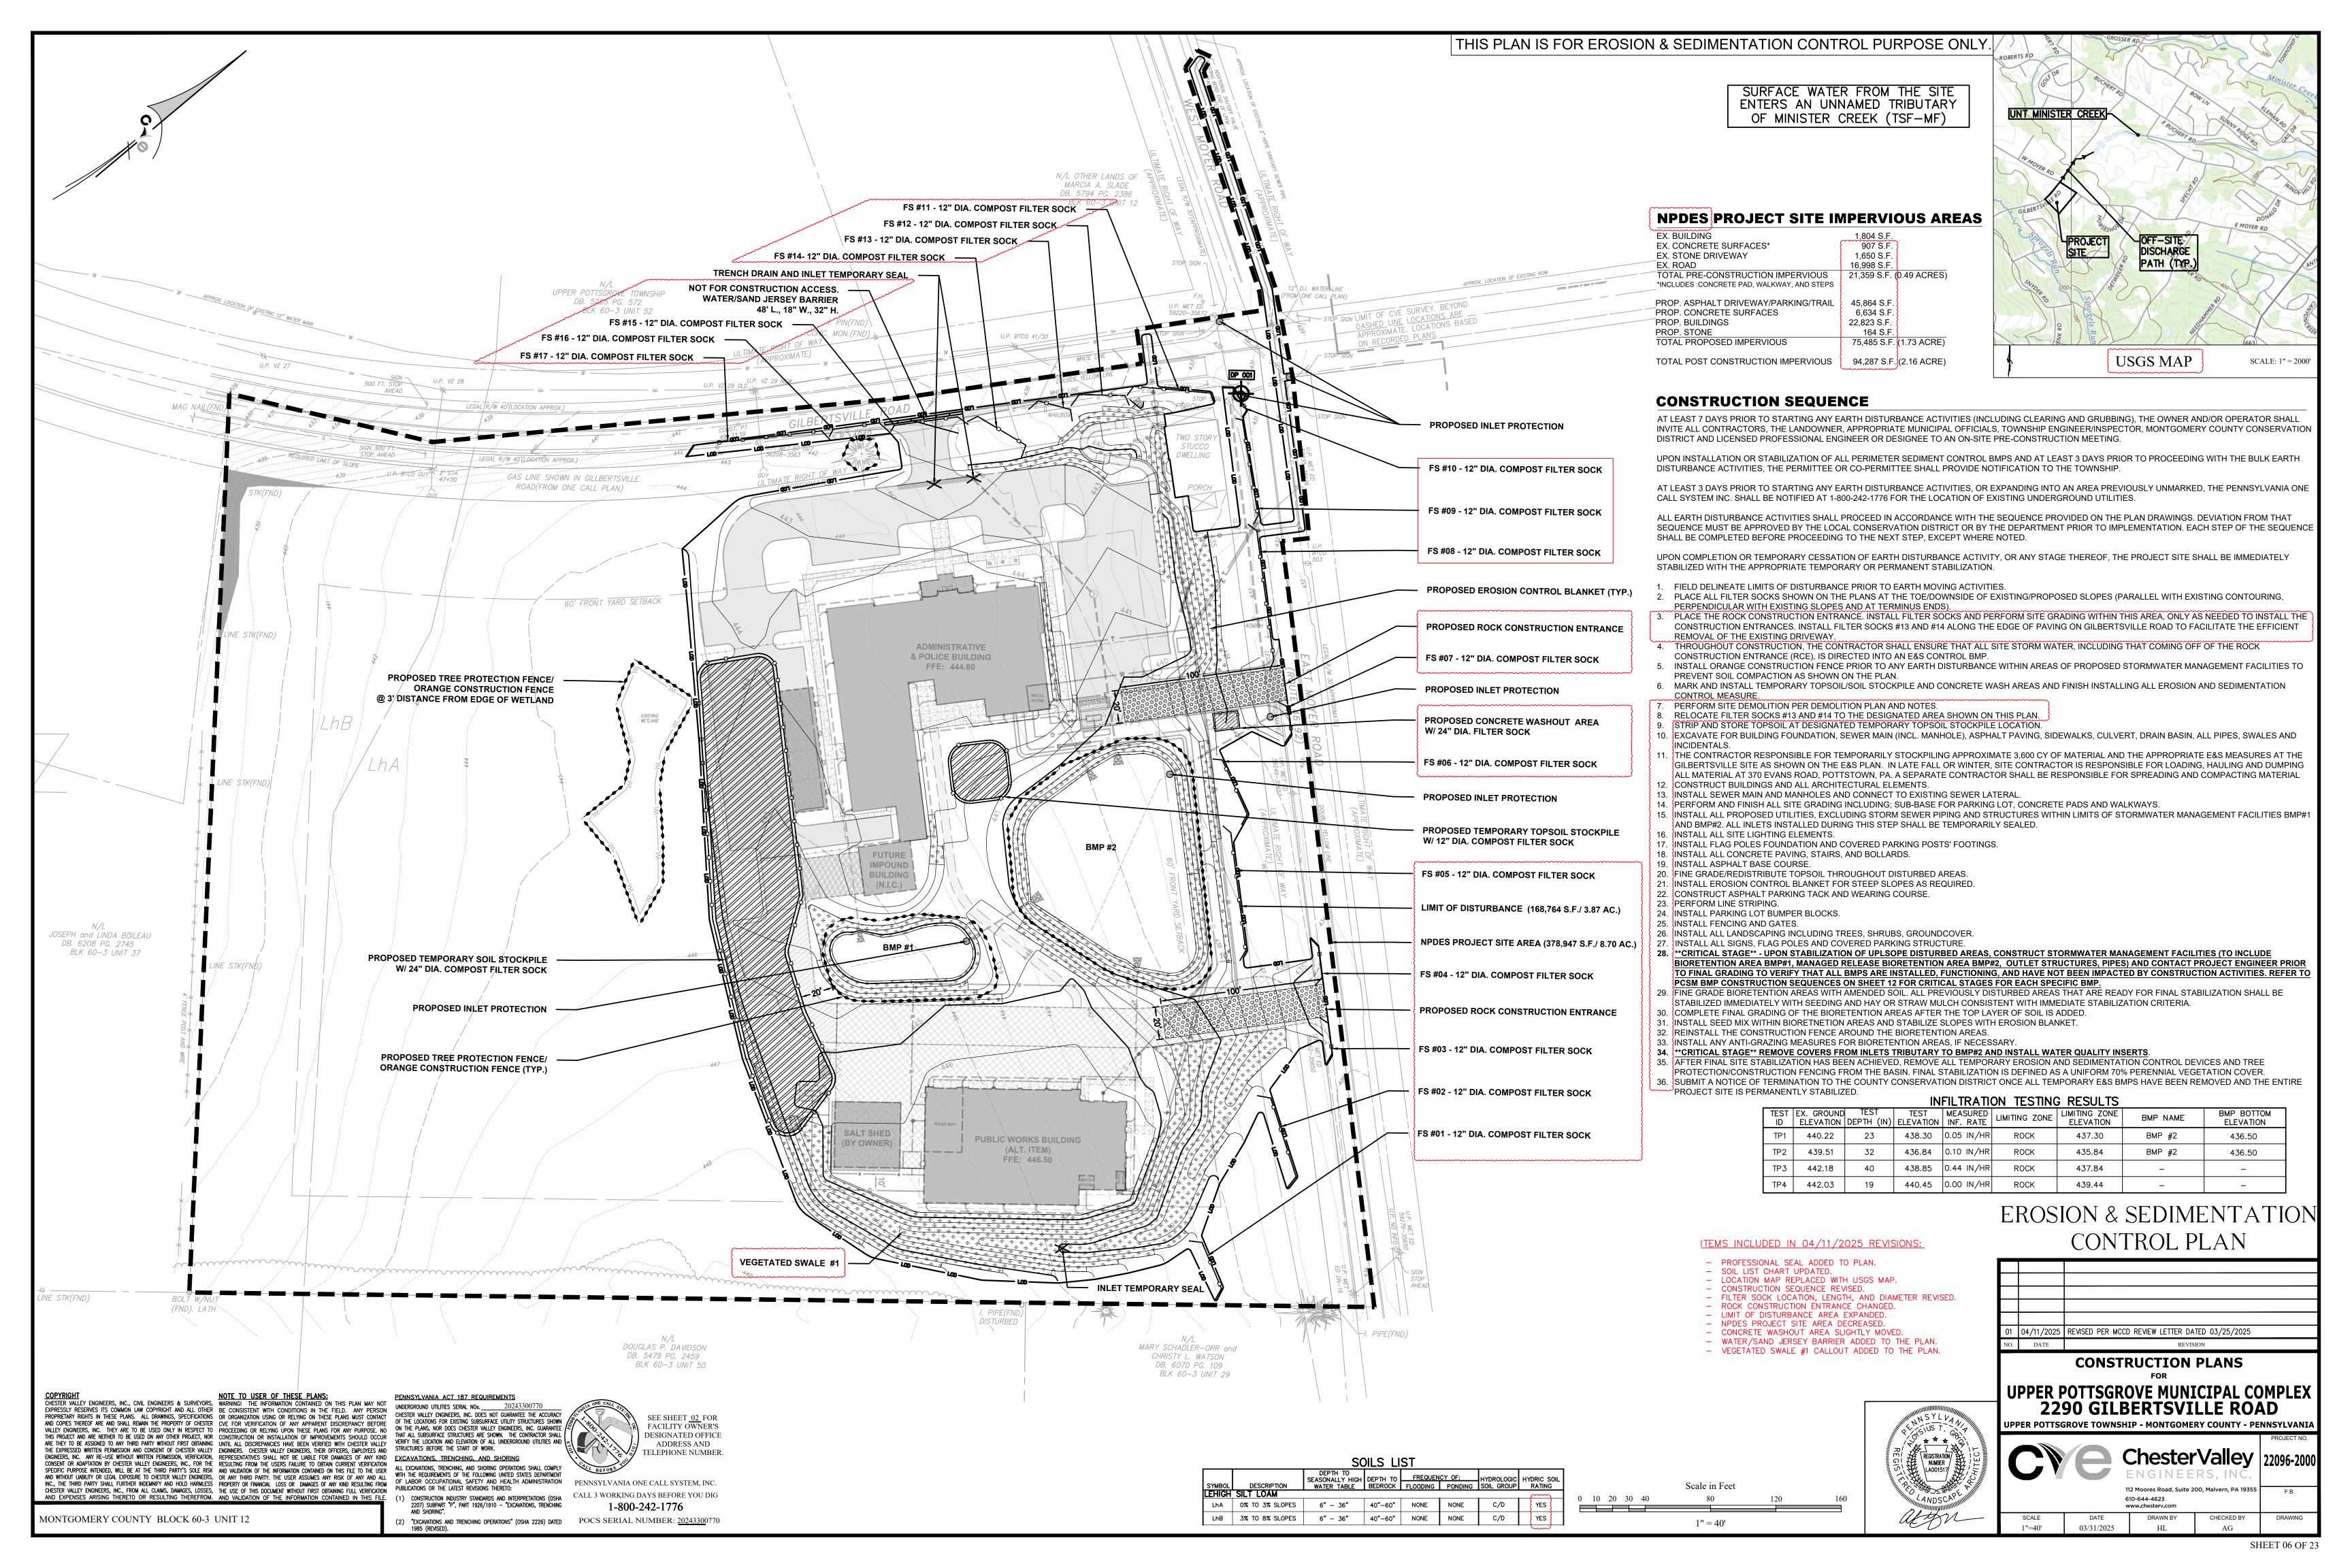

KAL CONSERVATION NOTES AND SPECIFICATIONS
OF CONSERVATION PROGRAM: THE INTENT OF THIS PROGRAM IS TO PREVENT ACCELERATED EROSION OF THE EXPOSED SITE SOILS DURING THE CONSTRUCTION AND PERMANENT LIFE PERIODS OF THE DEVELOPMENT. THE PROGRAM REQUIRES RETENTION OF ALL SEDIMENTS ON THE CONSTRUCTION SITE TO MINIMIZE THE IMPACT OF DEVELOPMENT ON EXISTING STREAMS AND ADJACENT PROPERTY OWNERS. THESE OBJECTIVES WILL BE ACHIEVED BY MINIMIZING THE EXPOSURE TIME OF POTENTIALLY EROSIVE SOILS TO RUNOFF AND INSTALLATION OF THE TEMPORARY CONSTRUCTION. THE INTENT OF THIS PROGRAM SHOULD BE UNDERSTOOD AND IMPLEMENTED THROUGHOUT THE ENTIRE DEVELOPMENT. THE VARIOUS CONSTRUCTION TRADES SHOULD BE APPRISED OF THIS PROGRAM AND DIRECTED TO PREVENT UNDUE DISTURBANCE OF PREPARED AND PROTECTED SURFACES.

SURFACE STABILIZATION CRITERIA: ALL DENUDED SOIL SURFACES, INCLUDING SOIL STOCKPILES, ARE SUBJECT TO EROSION AND SHALL BE STABILIZED EITHER TEMPORARILY OR PERMANENTLY, IMMEDIATELY DURING NON-GERMINATION PERIODS, MULCH MUST BE APPLIED AT RECOMMENDED RATES. CRUSHED STONE ON PAVEMENT SUBGRADES IS CONSIDERED ADEQUATE PROTECTION. ALL DISTURBED ZONES AND VEGETATED REGIONS SHALL BE STABILIZED, PREFERABLY WITH A PERMANENT TREATMENT AS FOLLOWS:

EROSION AND SEDIMENT CONTROL PLAN OBJECTIVES: 1. FIT THE LAND-DISTURBING ACTIVITY TO THE TERRAIN THROUGH MATCHING PROPOSED GRADES AS CLOSE TO EXISTING AS

- POSSIBLE. . MINIMIZE BARE SOIL EXPOSURE AND THE EXTENT AND DURATION OF EARTH DISTURBANCE THROUGH THE USE OF TEMPORARY STABILIZATION TECHNIQUES AND A DETAILED CONSTRUCTION SEQUENCE.
- RETAIN EXISTING VEGETATION WHENEVER FEASIBLE AND APPROPRIATE BY MAXIMIZING PROTECTION OF EXISTING DRAINAGE FEATURES AND VEGETATION.
- MINIMIZE SOIL COMPACTION BY DELINEATING LIMITS OF DISTURBANCE IN ONLY THOSE AREAS NECESSARY FOR CONSTRUCTION.
- STABILIZE DISTURBED AREAS IMMEDIATELY AFTER GRADING WITH TEMPORARY SEEDING AND MULCHING. DIRECT RUNOFF AWAY FROM BARE SOIL AREAS.
- MINIMIZE LENGTH AND STEEPNESS OF SLOPES BY IMPLEMENTING THE APPROPRIATE TEMPORARY E&S BMF
- 8. UTILIZE OTHER MEASURES OR CONTROLS THAT PREVENT OR MINIMIZE GENERATION OF INCREASED STORMWATER RUNOFF. . PREPARE DRAINAGE WAYS AND OUTLETS TO HANDLE INCREASED RUNOFF AND CONCENTRATION FLOWS.
- 10. REDUCE SEDIMENTATION BY APPLYING EROSION CONTROL AND WATER QUALITY PRACTICES ON-SITE. 11. AVOID, MINIMIZE OR MITIGATE THERMAL IMPACTS.

THE CONTRACTOR WILL BE RESPONSIBLE FOR THE PROPER CONSTRUCTION, STABILIZATION, AND MAINTENANCE OF ALL EROSION AND SEDIMENTATION CONTROLS AND RELATED ITEMS INCLUDED WITHIN THESE PLANS.

THE OPERATOR SHALL ASSURE THAT AN EROSION AND SEDIMENT CONTROL PLAN HAS BEEN PREPARED, APPROVED BY THE LOCAL COUNTY CONSERVATION DISTRICT, AND IS BEING IMPLEMENTED AND MAINTAINED FOR ALL SOIL AND/OR ROCK SPOIL AND BORROW AREAS, REGARDLESS OF THEIR LOCATIONS.

THE MONTGOMERY COUNTY CONSERVATION DISTRICT (MCCD)

- 143 LEVEL ROAD COLLEGEVILLE, PA 19426
- PHONE: (610) 489-4506 FAX: (610) 489-9795

CHAPTER 93 CLASSIFICATION OF WATERBODIES: THE RECEIVING WATERCOURSE FOR THIS PROJECT IS AN UNNAMED TRIBUTARY OF MINISTER CREEK (TSF-MF). MINISTER CREEK IS A TRIBUTARY WITHIN THE SWAMP CREEK WATERSHED WHICH IS NOT DESIGNATED AS A SPECIAL PROTECTION WATERSHED

NOTIFY THE LOCAL COUNTY CONSERVATION DISTRICT AND ARRANGE A PRE-CONSTRUCTION MEETING FOR ALL INVOLVED PARTIES (INCLUDING MCCD, APPLICANT, ENGINEER, AND TOWNSHIP OFFICIALS).

NOTIFY THE TOWNSHIP ENGINEER AT LEAST 48 HOURS PRIOR TO ANY EARTH DISTURBANCE ACTIVITIES.

CONSTRUCTION OPERATIONS SHALL BE CARRIED OUT IN A MANNER SUCH THAT ALL EROSION AND AIR/WATER POLLUTION IS MINIMIZED. STATE AND LOCAL LAWS CONCERNING ABATEMENT SHALL BE FOLLOWED.

SOIL EROSION AND SEDIMENTATION CONTROL NOTES

- ALL EARTH DISTURBANCES, INCLUDING CLEARING AND GRUBBING AS WELL AS CUTS AND FILLS SHALL BE DONE IN ACCORDANCE WITH THE APPROVED E&S PLAN. A COPY OF THE APPROVED DRAWINGS (STAMPED, SIGNED AND DATED BY THE REVIEWING AGENCY) MUST BE AVAILABLE AT THE PROJECT SITE AT ALL TIMES. THE REVIEWING AGENCY SHALL BE NOTIFIED OF ANY CHANGES TO THE APPROVED PLAN PRIOR TO IMPLEMENTATION OF THOSE CHANGES. THE REVIEWING AGENCY MAY REQUIRE A WRITTEN SUBMITTAL OF THOSE CHANGES FOR REVIEW AND APPROVAL AT ITS DISCRETION.
- AT LEAST 7 DAYS PRIOR TO STARTING ANY EARTH DISTURBANCE ACTIVITIES, INCLUDING CLEARING AND GRUBBING, THE OWNER AND/OR OPERATOR SHALL INVITE ALL CONTRACTORS, THE LANDOWNER, APPROPRIATE MUNICIPAL OFFICIALS, THE E&S PLAN PREPARER, THE PCSM PLAN PREPARER, THE LICENSED PROFESSIONAL RESPONSIBLE FOR OVERSIGHT OF CRITICAL STAGES OF IMPLEMENTATION OF THE PCSM PLAN, AND A REPRESENTATIVE FROM THE LOCAL CONSERVATION DISTRICT TO AN
- AT LEAST 3 DAYS PRIOR TO STARTING ANY EARTH DISTURBANCE ACTIVITIES, OR EXPANDING INTO AN AREA PREVIOUSLY UNMARKED, THE PENNSYLVANIA ONE CALL SYSTEM INC. SHALL BE NOTIFIED AT 1-800-242-1776 FOR THE LOCATION OF EXISTING UNDERGROUND UTILITIES.
- ALL EARTH DISTURBANCE ACTIVITIES SHALL PROCEED IN ACCORDANCE WITH THE SEQUENCE PROVIDED ON THE PLAN DRAWINGS. DEVIATION FROM THAT SEQUENCE MUST BE APPROVED IN WRITING FROM THE LOCAL CONSERVATION DISTRICT OR BY THE DEPARTMENT PRIOR TO IMPLEMENTATION.
- AREAS TO BE FILLED ARE TO BE CLEARED, GRUBBED, AND STRIPPED OF TOPSOIL TO REMOVE TREES, VEGETATION, ROOTS AND OTHER OBJECTIONABLE MATERIAL. CLEARING, GRUBBING, AND TOPSOIL STRIPPING SHALL BE LIMITED TO THOSE AREAS DESCRIBED IN EACH STAGE OF THE
- CONSTRUCTION SEQUENCE. GENERAL SITE CLEARING, GRUBBING AND TOPSOIL STRIPPING MAY NOT COMMENCE IN ANY STAGE OR PHASE OF THE PROJECT UNTIL THE E&S BMPS SPECIFIED BY THE BMP SEQUENCE FOR THAT STAGE OR PHASE HAVE BEEN INSTALLED AND ARE FUNCTIONING AS DESCRIBED IN THIS E&S PLAN.
- AT NO TIME SHALL CONSTRUCTION VEHICLES BE ALLOWED TO ENTER AREAS OUTSIDE THE LIMIT OF DISTURBANCE BOUNDARIES SHOWN ON THE PLAN MAPS. THESE AREAS MUST BE CLEARLY MARKED AND FENCED OFF BEFORE CLEARING AND GRUBBING OPERATIONS BEGIN.
- TOPSOIL REQUIRED FOR THE ESTABLISHMENT OF VEGETATION SHALL BE STOCKPILED AT THE LOCATION(S) SHOWN ON THE PLAN MAPS(S) IN THE AMOUNT NECESSARY TO COMPLETE THE FINISH GRADING OF ALL EXPOSED AREAS THAT ARE TO BE STABILIZED BY VEGETATION. EACH STOCKPILE SHALL BE PROTECTED IN THE MANNER SHOWN ON THE PLAN DRAWINGS. STOCKPILE SLOPES SHALL BE 2H:1V OR FLATTER, STOCKPILE HEIGHTS SHALL NOT EXCEED 35 FEET
- IMMEDIATELY UPON DISCOVERING UNFORESEEN CIRCUMSTANCES POSING THE POTENTIAL FOR ACCELERATED EROSION AND/OR SEDIMENT POLLUTION, THE OPERATOR SHALL IMPLEMENT APPROPRIATE BEST MANAGEMENT PRACTICES TO MINIMIZE THE POTENTIAL FOR EROSION AND SEDIMENT POLLUTION AND NOTIFY THE LOCAL CONSERVATION DISTRICT AND/OR THE REGIONAL OFFICE OF THE DEPARTMENT
- 10. BEFORE INITIATING ANY REVISION TO THE APPROVED EROSION AND SEDIMENT CONTROL PLAN OR REVISIONS TO OTHER PLANS WHICH MAY AFFECT THE EFFECTIVENESS OF THE APPROVED E&S CONTROL PLAN, THE OPERATOR MUST RECEIVE APPROVAL OF THE REVISIONS FROM THE MONTGOMERY COUNTY CONSERVATION DISTRICT. THE OPERATOR SHALL ASSURE THAT THE APPROVED EROSION AND SEDIMENT CONTROL PLAN IS PROPERLY AND COMPLETELY IMPLEMENTED.
- ALL BUILDING MATERIALS AND WASTES SHALL BE REMOVED FROM THE SITE AND RECYCLED OR DISPOSED OF IN ACCORDANCE WITH THE DEPARTMENT'S SOLID WASTE MANAGEMENT REGULATIONS AT 25 PA. CODE 260.1 ET SEQ., 271.1, AND 287.1 ET. SEG. NO BUILDING MATERIALS OR WASTES OR UNUSED BUILDING MATERIALS SHALL BE BURNED, BURIED, DUMPED, OR DISCHARGED AT THE SITE.
- 12. ALL OFF-SITE WASTE AND BORROW AREAS MUST HAVE AN E&S PLAN APPROVED BY THE LOCAL CONSERVATION DISTRICT OR THE DEPARTMENT FULLY IMPLEMENTED PRIOR TO BEING ACTIVATED. 13. THE CONTRACTOR IS RESPONSIBLE FOR ENSURING THAT ANY MATERIAL BROUGHT ON SITE IS CLEAN FILL. FORM FP-001 MUST BE RETAINED BY THE PROPERTY OWNER FOR ANY FILL MATERIAL AFFECTED BY A SPILL OR RELEASE OF A REGULATED
- SUBSTANCE BUT QUALIFYING AS CLEAN FILL DUE TO ANALYTICAL TESTING. VEHICLES AND EQUIPMENT MUST ONLY ENTER THE SITE DIRECTLY FROM MOYER ROAD AT THE SHOWN CONSTRUCTION FNTRANCES.
- 15. UNTIL THE SITE IS STABILIZED. ALL EROSION AND SEDIMENTATION BMP'S MUST BE MAINTAINED PROPERLY. MAINTENANCE MUST INCLUDE INSPECTIONS OF ALL EROSION AND SEDIMENTATION BMP'S AFTER EACH RUNOFF EVENT AND ON A WEEKLY BASIS, ALL SITE INSPECTIONS, THE COMPLIANCE INSPECTIONS, AND THE DATE, TIME, AND NAME OF THE PERSON CONDUCTING THE INSPECTION WILL BE DOCUMENTED IN AN INSPECTION LOG KEPT FOR THIS PURPOSE. THE INSPECTION LOG WILL BE KEPT ON SITE AT ALL TIMES AND MADE AVAILABLE TO THE DISTRICT UPON REQUEST. ALL PREVENTATIVE AND REMEDIAL MAINTENANCE WORK, INCLUDING CLEAN OUT, REPAIR, REPLACEMENT, REGRADING, RESEEDING, REMULCHING, AND RENETTING, MUST BE PERFORMED IMMEDIATELY. IF EROSION AND SEDIMENTATION BMP'S FAIL TO PERFORM AS EXPECTED, REPLACEMENT BMP'S OR MODIFICATIONS OF THOSE INSTALLED WILL BE NEEDED. WHERE BMP'S ARE FOUND TO FAIL TO ALLEVIATE EROSION AND SEDIMENT POLLUTION THE PERMITTEE OR CO-PERMITTEE SHALL INCLUDE THE FOLLOWING
- 15.1. THE LOCATION AND SEVERITY OF THE BMP'S FAILURE AND ANY POLLUTION EVENTS. 15.2. ALL STEPS TAKEN TO REDUCE, ELIMINATE AND PREVENT THE RECURRENCE OF THE NON-COMPLIANCE. 15.3. THE TIME FRAME TO CORRECT THE NON-COMPLIANCE, INCLUDING THE EXACT DATES WHEN THE ACTIVITY WILL RETURN TO COMPLIANCE.AFTER FINAL SITE STABILIZATION HAS BEEN ACHIEVED, TEMPORARY EROSION AND SEDIMENT BMP'S
- MUST BE REMOVED. AREAS DISTURBED DURING THEIR REMOVAL OF THE BMP'S MUST BE STABILIZED IMMEDIATELY. 16. ALL PUMPING OF WATER FROM ANY WORK AREA SHALL BE DONE ACCORDING TO THE PROCEDURE DESCRIBED IN THIS PLAN, OVER UNDISTURBED VEGETATED AREAS. 17. SEDIMENT TRACKED ONTO ANY PUBLIC ROADWAY OR SIDEWALK SHALL BE RETURNED TO THE SITE IMMEDIATELY AND
- DISPOSED IN THE MANNER DESCRIBED IN THIS PLAN. IN NO CASE SHALL THE SEDIMENT BE WASHED, SHOVELED, OR SWEPT INTO ANY ROADSIDE DITCH, STORM SEWER, OR SURFACE WATER. 18. ALL SEDIMENT REMOVED FROM BMPS SHALL BE DISPOSED OF IN THE MANNER DESCRIBED ON THE PLAN DRAWINGS 19. AREAS WHICH ARE TO BE TOP SOILED SHALL BE SCARIFIED TO A MINIMUM DEPTH OF 3 TO 5 INCHES -- 6 TO 12 INCHES ON
- COMPACTED SOILS -- PRIOR TO PLACEMENT OF TOPSOIL, AREAS TO BE VEGETATED SHALL HAVE A MINIMUM 4 INCHES OF TOPSOIL IN PLACE PRIOR TO SEEDING AND MULCHING. FILL OUTSLOPES SHALL HAVE A MINIMUM OF 2 INCHES OF TOPSOIL. 20. ALL FILLS SHALL BE COMPACTED AS REQUIRED TO REDUCE EROSION, SLIPPAGE, SETTLEMENT, SUBSIDENCE OR OTHER
- RELATED PROBLEMS. FILL INTENDED TO SUPPORT BUILDINGS, STRUCTURES AND CONDUITS, ETC. SHALL BE COMPACTED IN ACCORDANCE WITH LOCAL REQUIREMENTS OR CODES. 21. ALL EARTHEN FILLS SHALL BE PLACED IN COMPACTED LAYERS NOT TO EXCEED 8 INCHES IN THICKNESS.
- 22. FILL MATERIALS SHALL BE FREE OF FROZEN PARTICLES, BRUSH, ROOTS, SOD, OR OTHER FOREIGN OR OBJECTIONABLE MATERIALS THAT WOULD INTERFERE WITH OR PREVENT CONSTRUCTION OF SATISFACTORY FILLS.
- 23. FROZEN MATERIALS OR SOFT, MUCKY, OR HIGHLY COMPRESSIBLE MATERIALS SHALL NOT BE INCORPORATED INTO FILLS. 24. FILL SHALL NOT BE PLACED ON SATURATED OR FROZEN SURFACES.
- 25. SEEPS OR SPRINGS ENCOUNTERED DURING CONSTRUCTION SHALL BE HANDLED IN ACCORDANCE WITH THE STANDARD AND SPECIFICATION FOR SUBSURFACE DRAIN OR OTHER APPROVED METHOD.
- 26. ALL GRADED AREAS SHALL BE PERMANENTLY STABILIZED IMMEDIATELY UPON REACHING FINISHED GRADE. CUT SLOPES IN COMPETENT BEDROCK AND ROCK FILLS NEED NOT BE VEGETATED. SEEDED AREAS WITHIN 50 FEET OF A SURFACE WATER, OR AS OTHERWISE SHOWN ON THE PLAN DRAWINGS, SHALL BE BLANKETED ACCORDING TO THE STANDARDS OF THIS PLAN.

27. EROSION CONTROL BLANKETING SHALL BE INSTALLED ON ALL SLOPES 3H:1V OR STEEPER WITHIN 50 FEET OF A SURFACE

- WATER AND ON ALL OTHER DISTURBED AREAS SPECIFIED ON THE PLAN MAPS AND/OR DETAIL SHEETS. 28. IMMEDIATELY AFTER EARTH DISTURBANCE ACTIVITIES CEASE IN ANY AREA OR SUBAREA OF THE PROJECT, THE OPERATOR SHALL STABILIZE ALL DISTURBED AREAS. DURING NON-GERMINATING PROJECT. THE OPERATOR SHALL STABILIZE ALL DISTURBED AREAS. DURING NON-GERMINATING MONTHS, MULCH OR PROTECTIVE BLANKETING SHALL BE APPLIED AS DESCRIBED IN THE PLAN. AREAS NOT AT FINISHED GRADE, WHICH WILL BE REACTIVATED WITHIN 1 YEAR, MAY BE STABILIZED
- IN ACCORDANCE WITH THE TEMPORARY STABILIZATION SPECIFICATIONS. THOSE AREAS WHICH WILL NOT BE REACTIVATED WITHIN 1 YEAR SHALL BE STABILIZED IN ACCORDANCE WITH THE PERMANENT STABILIZATION SPECIFICATIONS. 29. PERMANENT STABILIZATION IS DEFINED AS A MINIMUM UNIFORM, PERENNIAL 70% VEGETATIVE COVER OR OTHER PERMANENT
- NON-VEGETATIVE COVER WITH A DENSITY SUFFICIENT TO RESIST ACCELERATED EROSION. CUT AND FILL SLOPES SHALL BE CAPABLE OF RESISTING FAILURE DUE TO SLUMPING, SLIDING, OR OTHER MOVEMENTS. 30. E&S BMPS SHALL REMAIN FUNCTIONAL AS SUCH UNTIL ALL AREAS TRIBUTARY TO THEM ARE PERMANENTLY STABILIZED OR
- UNTIL THEY ARE REPLACED BY ANOTHER BMP APPROVED BY THE LOCAL CONSERVATION DISTRICT OR THE DEPARTMENT. 31. E&S BMP'S MUST BE CONSTRUCTED, STABILIZED AND FUNCTIONAL BEFORE SITE DISTURBANCE WITHIN THE TRIBUTARY AREAS

- 32. UPON COMPLETION OF ALL EARTH DISTURBANCE ACTIVITIES AND PERMANENT STABILIZATION OF ALL DISTURBED AREAS, THE OWNER AND/OR OPERATOR SHALL CONTACT THE LOCAL CONSERVATION DISTRICT FOR AN INSPECTION PRIOR TO REMOVAL/CONVERSION OF THE E&S BMPS
- 33. AFTER FINAL SITE STABILIZATION HAS BEEN ACHIEVED, TEMPORARY EROSION AND SEDIMENT BMPS MUST BE REMOVED OR CONVERTED TO PERMANENT POST CONSTRUCTION STORMWATER MANAGEMENT BMPS. AREAS DISTURBED DURING REMOVAL OR CONVERSION OF THE BMPS SHALL BE STABILIZED IMMEDIATELY. IN ORDER TO ENSURE RAPID REVEGETATION OF DISTURBED AREAS. SUCH REMOVAL/CONVERSIONS ARE TO BE DONE ONLY DURING THE GERMINATING SEASON.
- 34. UPON COMPLETION OF ALL EARTH DISTURBANCE ACTIVITIES AND PERMANENT STABILIZATION OF ALL DISTURBED AREAS, THE OWNER AND/OR OPERATOR SHALL CONTACT THE LOCAL CONSERVATION DISTRICT TO SCHEDULE A FINAL INSPECTION.
- 35. FAILURE TO CORRECTLY INSTALL E&S BMPS, FAILURE TO PREVENT SEDIMENT-LADEN RUNOFF FROM LEAVING THE CONSTRUCTION SITE OR FAILURE TO TAKE IMMEDIATE CORRECTIVE ACTION TO RESOLVE FAILURE OF E&S BMPS MAY RESULT IN ADMINISTRATIVE, CIVIL, AND/OR CRIMINAL PENALTIES BEING INSTITUTED BY THE DEPARTMENT AS DEFINED IN SECTION 602 OF THE PENNSYLVANIA CLEAN STREAMS LAW. THE CLEAN STREAMS LAW PROVIDES FOR UP TO \$10,000 PER DAY IN CIVIL PENALTIES, UP TO \$10,000 IN SUMMARY CRIMINAL PENALTIES, AND UP TO \$25,000 IN MISDEMEANOR CRIMINAL
- 36. SHOULD ANY MEASURES CONTAINED WITHIN THIS PLAN PROVE INCAPABLE OF ADEQUATELY REMOVING SEDIMENT FROM ON-SITE FLOWS PRIOR TO DISCHARGE OR STABILIZING THE SURFACES INVOLVED, ADDITIONAL MEASURES MUST BE IMMEDIATELY IMPLEMENTED BY THE CONTRACTOR TO ELIMINATE ALL SUCH PROBLEMS. THE MONTGOMERY COUNTY CONSERVATION DISTRICT MUST BE NOTIFIED BY THE DEVELOPER OF ANY AND ALL CHANGES OR MODIFICATIONS TO THE

PENALTIES FOR EACH VIOLATION.

- 37. ALL COMPOST FILTER SOCK MUST BE INSTALLED ON UNDISTURBED GROUND, AT LEAST 8 FEET BELOW THE TOE OF THE SLOPE, AND PARALLEL TO EXISTING ELEVATION CONTOURS WITH BOTH ENDS EXTENDING UP SLOPE AT LEAST 8' AT A 45
- DEGREE ANGLE. 38. THE CONTRACTOR IS ADVISED TO BECOME THOROUGHLY FAMILIAR WITH THE PROVISION OF APPENDIX 64, EROSION CONTROL RULES AND REGULATIONS, TITLE 25, PART 1, DEPARTMENT OF ENVIRONMENTAL PROTECTION SUB-PART C.
- PROTECTION OF NATURAL RESOURCES. ARTICLE III, WATER RESOURCES, CHAPTER 102, EROSION CONTROL. 39. THE PROPOSED CONSERVATION MEASURES MUST BE IN COMPLIANCE WITH PADEP CHAPTER 102 REGULATIONS.
- 40. A COPY OF THE APPROVED EROSION AND SEDIMENTATION CONTROL PLAN MUST BE AVAILABLE AT THE PROJECT SITE AT 41. UPON THE INSTALLATION OR STABILIZATION OF ALL PERIMETER SEDIMENT CONTROL BMPS AND AT LEAST 3 DAYS PRIOR TO
- PROCEEDING WITH THE BULK EARTH DISTURBANCE ACTIVITIES, THE PERMITTEE OR CO-PERMITTEE SHALL PROVIDE NOTIFICATION TO THE DEPARTMENT OR AUTHORIZED CONSERVATION DISTRICT 42. CLEAN FILL IS DEFINED AS: UNCONTAMINATED, NON-WATER SOLUBLE, NON-DECOMPOSABLE, INERT, SOLID MATERIAL. THE TERM INCLUDES SOIL, ROCK, STONE, DREDGED MATERIAL, USED ASPHALT, AND BRICK, BLOCK OR CONCRETE FROM CONSTRUCTION AND DEMOLITION ACTIVITIES THAT IS SEPARATE FROM OTHER WASTE AND IS RECOGNIZABLE AS SUCH.
- THE TERM DOES NOT INCLUDE MATERIALS PLACED IN OR ON THE WATERS OF THE COMMONWEALTH UNLESS OTHERWISE AUTHORIZED. (THE TERM "USED ASPHALT" DOES NOT INCLUDE MILLED ASPHALT OR ASPHALT THAT HAS BEEN PROCESSED FOR RE-USE). CLEAN FILL AFFECTED BY A SPILL OR RELEASE OF A REGULATED SUBSTANCE: FILL MATERIALS AFFECTED BY A SPILL OR RELEASE OF A REGULA TED SUBSTANCE STILL QUALIFIES AS CLEAN FILL PROVIDED THE TESTING REVEALS THAT THE FILL MATERIAL CONTAINS CONCENTRATIONS OF REGULATED SUBSTANCES THAT ARE BELOW THE RESIDENTIAL LIMITS IN TABLES FP-1A AND FP-1B FOUND IN THE DEPARTMENT'S POLICY "MANAGEMENT OF FILL". ANY PERSON PLACING CLEAN FILL THAT HAS BEEN AFFECTED BY A SPILL OR RELEASE OF A REGULATED SUBSTANCE MUST USE FORM FP-001 TO CERTIFY THE ORIGIN OF THE FILL MATERIAL AND THE RESULTS OF THE ANALYTICAL TESTING TO QUALIFY THE MATERIAL AS CLEAN FILL. FORM FP-001 MUST BE RETAINED BY THE OWNER OF THE PROPERTY RECEIVING THE FILL. ENVIRONMENTAL DUE DILIGENCE: THE APPLICANT MUST PERFORM ENVIRONMENTAL DUE DILIGENCE TO DETERMINE IF THE FILL MATERIALS ASSOCIATED WITH THE PROJECT QUALIFY AS CLEAN FILL. ENVIRONMENTAL DUE DILIGENCE IS DEFINED AS: INVESTIGATIVE TECHNIQUES, INCLUDING, BUT NOT LIMITED TO, VISUAL PROPERTY INSPECTIONS, ELECTRONIC DATA BASE SEARCHES, REVIEW OF PROPERTY OWNERSHIP, REVIEW OF PROPERTY USE HISTORY, SANBORN MAPS, ENVIRONMENTAL QUESTIONNAIRES, TRANSACTION SCREENS, ANALYTICAL TESTING, ENVIRONMENTAL ASSESSMENTS OR AUDITS. ANALYTICAL TESTING IS NOT A REQUIRED PART OF DUE DILIGENCE UNLESS VISUAL INSPECTION AND/OR REVIEW OF THE PAST LAND USE OF THE PROPERTY INDICATES THAT THE FILL MAY HAVE BEEN SUBJECTED TO A SPILL OR RELEASE OF REGULATED SUBSTANCE. IF THE FILL MAY HAVE BEEN AFFECTED BY A SPILL OR RELEASE OF A REGULATED SUBSTANCE, IT MUST BE TESTED TO DETERMINE IF IT QUALIFIES AS CLEAN FILL. TESTING SHOULD BE
- PERFORMED IN ACCORDANCE WITH APPENDIX A OF THE DEPARTMENT'S POLICY "MANAGEMENT OF FILL" 43. FILL MATERIAL THAT DOES NOT QUALIFY AS CLEAN FILL IS REGULATED FILL. REGULATED FILL IS WASTE AND MUST BE MANAGED IN ACCORDANCE WITH THE DEPARTMENT'S MUNICIPAL OR RESIDUAL WASTE REGULATIONS BASED ON 25 PA. CODE CHAPTERS 287 RESIDUAL WASTE MANAGEMENT OR 271 MUNICIPAL WASTE MANAGEMENT, WHICHEVER IS APPLICABLE. THESE REGULATIONS ARE AVAILABLE ON-LINE AT www.pacode.com
- 44. CONCRETE WASH WATER SHALL BE HANDLED IN THE MANNER DESCRIBED ON THE PLAN DRAWINGS. IN NO CASE SHALL IT BE ALLOWED TO ENTER ANY SURFACE WATERS OR GROUNDWATER SYSTEMS.
- 45. ALL CHANNELS SHALL BE KEPT FREE OF OBSTRUCTIONS INCLUDING BUT NOT LIMITED TO FILL, ROCKS, LEAVES, WOODY DEBRIS, ACCUMULATED SEDIMENT, EXCESS VEGETATION, AND CONSTRUCTION MATERIAL/WASTES.
- 46. CHANNELS HAVING RIPRAP, RENO MATTRESS, OR GABION LININGS MUST SUFFICIENTLY OVER-EXCAVATED SO THAT THE DESIGN DIMENSIONS WILL BE PROVIDED AFTER PLACEMENT OF THE PROTECTIVE LINING. 47. ALL PUMPING OF WATER FROM ANY WORK AREA SHALL BE DONE ACCORDING TO PROCEDURES DESCRIBED IN THIS PLAN,
- OVER UNDISTURBED VEGETATED AREAS. 48. UNDERGROUND UTILITIES CUTTING THROUGH ANY ACTIVE CHANNEL SHALL BE IMMEDIATELY BACKFILLED AND THE CHANNEL RESTORED TO ITS ORIGINAL CROSS-SECTION AND PROTECTIVE LINING. ANY BASE FLOW WITHIN THE CHANNEL SHALL BE CONVEYED PAST THE WORK AREA IN THE MANNER DESCRIBED IN THIS PLAN UNTIL SUCH RESTORATION IS
- 49. SEDIMENT BASINS AND/OR TRAPS SHALL BE KEPT FREE OF ALL CONSTRUCTION WASTE, WASH WATER, AND OTHER DEBRIS HAVING POTENTIAL TO CLOG THE BASIN/TRAP OUTLET STRUCTURES AND/OR POLLUTE THE SURFACE WATERS. 50. SEDIMENT BASIN TRAPS SHALL BE PROTECTED FROM UNAUTHORIZED ACTS BY THIRD PARTIES. 51. ANY DAMAGE THAT OCCURS IN WHOLE OR IN PART AS A RESULT OF BASIN OR TRAP DISCHARGE SHALL BE IMMEDIATELY
- REPAIRED BY THE PERMITTEE IN A PERMANENT MANNER SATISFACTORY TO THE MUNICIPALITY, LOCAL CONSERVATION DISTRICT, AND THE OWNER OF THE DAMAGED PROPERTY. 52. FILL MATERIAL FOR EMBANKMENTS SHALL BE FREE OF ROOTS, OR OTHER WOODY VEGETATION, ORGANIC MATERIAL,
- LARGE STONES, AND OTHER OBJECTIONABLE MATERIALS. THE EMBANKMENT SHALL BE COMPACTED IN MAXIMUM 8 INCH
- 53. THE PROJECT WILL MINIMIZE THE EXTENT AND DURATION OF DISTURBANCE BY SEQUENCING THE THE CONSTRUCTION SUCH THAT THE ENTIRE SITE IS NOT DISTURBED AT ONE TIME AND BY STABILIZING DISTURBANCE AS SOON AS PRACTICAL 54. POST-CONSTRUCTION RUNOFF FROM THE PROPOSED IMPROVEMENTS WILL BE ROUTED THROUGH BMPS TO REDUCE RUNOFF VOLUME AND RATE. REDUCTION IN POST-DEVELOPMENT VOLUMES AND RATES WILL ASSIST IN MAINTAINING THE
- 55. SOIL COMPACTION WILL BE MINIMIZED TO THE EXTENT PRACTICAL, AIDED BY THE REDUCTION IN IMPERVIOUS SURFACE
- 56. MAINTENANCE OF ALL SEDIMENT AND EROSION CONTROL DEVICES IS THE RESPONSIBILITY OF THE CONTRACTOR DURING CONSTRUCTION. 57. THE CONTRACTOR IS RESPONSIBLE FOR PROVIDING DIVERSION TRENCHES, EROSION CHECKS, BERMS, ETC., OR OTHER MEANS OF ACCEPTED PRACTICE AS REQUIRED ON THE SITE TO PREVENT ACCELERATED RUNOFF AND EROSION, WHICH
- MAY NOT BE INDICATED, BUT IS WITHIN THE INTENT OF THIS PLAN. 58. THE CONTRACTOR MUST ENSURE THE PROPER OPERATION OF THE DEVICES IS NOT HINDERED DUE TO EXCESSIVE SEDIMENT BUILDUP OR UNAUTHORIZED ACTS OF THIRD PARTIES.
- 59. A LOG SHOWING DATES THAT E&S BMP'S WERE INSPECTED AS WELL AS ANY DEFICIENCIES FOUND AND THE DATE THEY WERE CORRECTED SHALL BE MAINTAINED ON THE SITE AND BE MADE AVAILABLE TO REGULATORY AGENCY OFFICIALS AT THE TIME OF INSPECTION
- 60. UPON REQUEST, THE APPLICANT OR HIS CONTRACTOR SHALL PROVIDE AN AS-BUILT (RECORD DRAWING) FOR ANY SEDIMENT BASIN OR TRAP TO THE MUNICIPAL INSPECTOR, LOCAL CONSERVATION DISTRICT OR THE DEPARTMENT.

MAINTENANCE PROGRAM FOR TEMPORARY SEDIMENTATION CONTROLS STRUCTURES

INTEGRITY OF THE RECEIVING WATERWAYS.

MAINTENANCE OF ALL TEMPORARY SEDIMENTATION CONTROL STRUCTURES SHALL BE IN ACCORDANCE WITH THESE PLANS AND THE "EROSION AND CONTROL CONTROL NARRATIVE." INSPECTION AND MAINTENANCE OF ALL FACILITIES SHALL BE MADE AFTER EACH RAIN STORM EVENT AND ON A WEEKLY BASIS.

2. UNTIL THE SITE IS STABILIZED, ALL EROSION AND SEDIMENTATION BMP'S MUST BE MAINTAINED PROPERLY. MAINTENANCE

- SHALL INCLUDE INSPECTIONS OF ALL EROSION AND SEDIMENTATION BMP'S ON A DAILY BASIS AND AFTER EACH RUNOFF EVENT. ALL SITE INSPECTIONS SHALL BE DOCUMENTED IN AN INSPECTION LOG KEPT FOR THIS PURPOSE. THE COMPLIANCE ACTIONS AND THE DATE, TIME AND NAME OF THE PERSON CONDUCTING THE INSPECTION SHALL BE NOTED. THE INSPECTION SOCK SHALL BE KEPT ON SITE AT ALL TIMES. AND MADE AVAILABLE TO THE TOWNSHIP UPON REQUEST 3. ALL PREVENTATIVE AND REMEDIAL MAINTENANCE WORK, INCLUDING CLEANOUT, REPAIR, REPLACEMENT, REGRADING.
- RESEEDING, REMULCHING, AND RENETTING MUST BE PERFORMED IMMEDIATELY. IF EROSION AND SEDIMENTATION BMPS FAIL TO PERFORM AS EXPECTED, REPLACEMENT BMPS OR MODIFICATIONS OF THOSE INSTALLED WILL BE NEEDED. 4. SEDIMENT MUST BE REMOVED WHEN ACCUMULATIONS REACH ONE-HALF THE EFFECTIVE HEIGHT OF COMPOST FILTER
- 5. SEDIMENT MUST BE REMOVED FROM SEDIMENT TRAP WHEN THE SEDIMENT REACHES THE DESIGNATED CLEANOUT
- **ELEVATION** 6. SEDIMENT MUST BE REMOVED FROM ROCK FILTERS WHEN COLLECTED SEDIMENT BEGINS TO AFFECT THE FILTER'S
- 7. INLET PROTECTION FILTER BAGS SHALL BE INSPECTED ON A WEEKLY BASIS AND AFTER EACH RAINFALL EVENT. BAGS
- SHALL BE EMPTIED AND RINSED OR REPLACED WHEN HALF FULL OR WHEN FLOW CAPACITY HAS BEEN REDUCED SO AS TO CAUSE FLOODING OR BYPASSING OF THE INLET. DAMAGED OR CLOGGED BAGS SHALL BE REPLACED. 8. SEDIMENT REMOVED FROM THE FACILITIES MAY BE REINCORPORATED INTO THE SITE'S EARTHWORK AS FILL OR TAKEN TO A SAFE, APPROVED LOCATION.UNTIL THE SITE IS STABILIZED, ALL EROSION AND SEDIMENTATION CONTROLS MUST BE MAINTAINED PROPERLY. MAINTENANCE MUST INCLUDE INSPECTIONS OF ALL CONTROLS AFTER EACH STORM EVENT AND
- ON A WEEKLY BASIS. ALL PREVENTATIVE AND REMEDIAL MAINTENANCE, REGRADING, RESEEDING, REMULCHING AND RENETTING MUST BE PERFORMED IMMEDIATELY. 9. ALL SILT AND FOREIGN MATTER SHALL BE REMOVED FROM THE TOP OF THE BINDER COURSE AND PROPERLY DISPOSED OF
- BEFORE WEARING SURFACE IS INSTALLED. 10. ALL PUMPING OF SEDIMENT LADEN WATER SHALL BE THROUGH A SUMP PIT AND A PUMPED WATER FILTER BAG,

FOODPLAINS OR DRAINAGE SWALES AND IMMEDIATELY STABILIZED OR PLACED IN TOPSOIL STOCKPILES.

DISCHARGING WATER OVER NON-DISTURBED AREAS. 11. SEDIMENT REMOVED FROM BMP'S SHALL BE DISPOSED OF IN LANDSCAPED AREAS OUTSIDE OF STEEP SLOPES, WETLANDS,

DUST AND OTHER PARTICULATES SHALL BE KEPT WITHIN TOLERABLE LIMITS BY USING WATER. APPLICATION SHALL BE AS NEEDED OR AS DIRECTED BY THE TOWNSHIP ENGINEER OR THE CONSERVATION DISTRICT.

<u>CRITICAL VEGETATION AREAS (C.V.A.):</u>
CRITICAL VEGETATION AREAS ARE TO BE GRADED, HYDROSEEDED AND MULCHED WITHIN 10 DAYS OF THE BEGINNING OF EXCAVATION. IN GENERAL, CRITICAL VEGETATION AREAS ARE DEFINED AS CUT SLOPES STEEPER THAN 3:1, ALL FILL SLOPES STEEPER THAN 4:1 AND IN ALL DRAINAGE SWALES.

ITEMS INCLUDED IN 04/11/2025 REVISIONS:

PROFESSIONAL SEAL ADDED TO PLAN. - CHAPTER 93 NOTE REVISED TO INCLUDE WATERSHED INFORMATION.

MONITORING, INSPECTION, AND REPORTING REQUIREMENTS

THE PERMITTEE AND CO PERMITTEE(S) MUST ENSURE THAT VISUAL SITE INSPECTIONS ARE CONDUCTED WEEKLY, AND WITHIN 24 HOURS AFTER EACH MEASURABLE RAINFALL EVENT THROUGHOUT THE DURATION OF CONSTRUCTION AND UNTIL THE RECEIPT AND ACKNOWLEDGEMENT OF THE NOT BY THE DEPARTMENT OR AUTHORIZED CONSERVATION DISTRICT. THE VISUAL SITE INSPECTIONS AND REPORTS SHALL BE COMPLETED IN A FORMAT PROVIDED BY THE DEPARTMENT, AND CONDUCTED BY QUALIFIED PERSONNEL, TRAINED AND EXPERIENCED IN EROSION AND SEDIMENT CONTROL, TO ASCERTAIN THAT E&S BMPS AND PCSM BMPS ARE PROPERLY CONSTRUCTED AND MAINTAINED TO EFFECTIVELY MINIMIZE POLLUTION TO THE WATERS OF THIS COMMONWEALTH. A WRITTEN REPORT OF EACH INSPECTION SHALL BE KEPT AND INCLUDE AT A MINIMUM:

- 1. A SUMMARY OF SITE CONDITIONS, E&S BMP AND PCSM BMP, IMPLEMENTATION AND MAINTENANCE AND COMPLIANCE ACTIONS 2. THE DATE, TIME, NAME AND SIGNATURE OF THE PERSON CONDUCTING THE INSPECTION.
- B. NONCOMPLIANCE REPORTING WHERE E&S, PCSM OR PPC BMPS ARE FOUND TO BE INOPERATIVE OR INEFFECTIVE DURING AN INSPECTION, OR ANY OTHER TIME, THE PERMITTEE AND COPERMITTEE(S) SHALL, WITHIN 24 HOURS, CONTACT THE DEPARTMENT OR AUTHORIZED CONSERVATION DISTRICT, BY PHONE OR PERSONAL CONTACT, FOLLOWED BY THE SUBMISSION OF A WRITTEN REPORT WITHIN 5 DAYS OF THE
- INITIAL CONTACT.NONCOMPLIANCE REPORTS SHALL INCLUDE THE FOLLOWING INFORMATION: 1. ANY CONDITION ON THE PROJECT SITE WHICH MAY ENDANGER PUBLIC HEALTH, SAFETY, OR THE ENVIRONMENT, OR INVOLVE INCIDENTS WHICH CAUSE OR THREATEN POLLUTION.
- 2. THE PERIOD OF NONCOMPLIANCE, INCLUDING EXACT DATES AND TIMES AND/OR ANTICIPATED TIME WHEN THE ACTIVITY WILL RETURN TO COMPLIANCE.
- STEPS BEING TAKEN TO REDUCE, ELIMINATE, AND PREVENT RECURRENCE OF THE NONCOMPLIANCE. 4. THE DATE OR SCHEDULE OF DATES, AND IDENTIFYING REMEDIES FOR CORRECTING NONCOMPLIANCE CONDITIONS
- WHERE BMPS ARE FOUND TO FAIL TO ALLEVIATE EROSION AND SEDIMENTATION POLLUTION, THE CONTRACTOR SHALL INCLUDE
- THE FOLLOWING INFORMATION:
- A. THE LOCATION AND SEVERITY OF THE BMP'S FAILURE AND ANY POLLUTION EVENTS
- B. ALL STEPS TAKEN TO REDUCE, ELIMINATE AND PREVENT THE RECURRENCE OF THE NON-COMPLIANCE. C. THE TIME FRAME TO CORRECT THE NON-COMPLIANCE, INCLUDING THE EXACT DATES WHEN THE ACTIVITY WILL RETURN TO

UPON PERMANENT STABILIZATION OF EARTH DISTURBANCE ACTIVITIES ASSOCIATED WITH CONSTRUCTION ACTIVITY THAT ARE AUTHORIZED BY THIS PERMIT AND WHEN BMPS IDENTIFIED IN THE PCSM PLAN HAVE BEEN PROPERLY INSTALLED, THE PERMITTEE AND/OR CO PERMITTEE OF THE FACILITY MUST SUBMIT A NOT FORM THAT IS SIGNED IN ACCORDANCE WITH PART B, SECTION 1.C, SIGNATORY REQUIREMENTS, OF THIS PERMIT. ALL LETTERS CERTIFYING DISCHARGE TERMINATION ARE TO BE SENT TO THE DEPARTMENT OR AUTHORIZED CONSERVATION DISTRICT. THE NOT MUST CONTAIN THE FOLLOWING INFORMATION: FACILITY NAME, ADDRESS, AND LOCATION, OPERATOR NAME AND ADDRESS, PERMIT NUMBER, IDENTIFICATION AND PROOF OF ACKNOWLEDGMENT FROM THE PERSON(S) WHO WILL BE RESPONSIBLE FOR OPERATION AND MAINTENANCE OF THE PCSM BMPS IN ACCORDANCE WITH THE APPROVED PCSM PLAN, AND THE REASON FOR PERMIT TERMINATION. UNTIL THE PERMITTEE HAS RECEIVED WRITTEN ACKNOWLEDGEMENT OF THE NOT, THE PERMITTEE WILL REMAIN AND WILL BE RESPONSIBLE FOR VIOLATIONS OCCURRING ON THE PROJECT SITE. FOR OPERATING AND MAINTAINING ALL E&S BMPS AND PCSM BMPS ON THE PROJECT SITE.

E. COMPLETION CERTIFICATE AND FINAL PLANS

WITHIN 30 DAYS AFTER THE COMPLETION OF EARTH DISTURBANCE ACTIVITIES AUTHORIZED BY THIS PERMIT, INCLUDING THE PERMANENT STABILIZATION OF THE SITE AND PROPER INSTALLATION OF PCSM BMPS IN ACCORDANCE WITH THE APPROVED PCSM PLAN, OR UPON SUBMISSION OF THE NOT IF SOONER, THE PERMITTEE SHALL FILE WITH THE DEPARTMENT OR AUTHORIZED CONSERVATION DISTRICT A STATEMENT SIGNED BY A LICENSED PROFESSIONAL AND BY THE PERMITTEE CERTIFYING THAT WORK HAS BEEN PERFORMED IN ACCORDANCE WITH THE TERMS AND CONDITIONS OF THIS PERMIT AND THE APPROVEDE&S AND PCSM

SOIL TYPE USE LIMITATIONS AND RESOLUTIONS

- 1. SOIL TYPES POORLY SUITED AS SOURCES OF TOPSOIL RESTRICT OR PLACE CONDITIONS ON PLANNING VEGETATIVE STABILIZATION. ACIDIC, LOW FERTILITY, EXCESSIVE DRYNESS AND EXCESSIVE WETNESS LIMIT PLANT GROWTH. RESOLUTIONS: IDENTIFYING AND RESOLVING CHARACTERISTICS, THAT RENDER THE SOIL TYPES POORLY, SUITED AS
- ACIDITY: ACIDIC SOIL TYPES EXHIBITING PH REACTION VALUES LOWER THAN ABOUT 5.5, LIMIT VEGETATIVE STABILIZATION. SOIL TESTS MIGHT BE NECESSARY TO DETERMINE SITE SPECIFIC PH REACTION RESOLUTIONS: APPLYING LIME CONSISTENT WITH RATES DETERMINED BY SOIL TESTING; SELECTING VEGETATIVE SPECIES TOLERANT TO ACIDIC SOIL CONDITIONS; AND IMPLEMENTING COMBINATIONS OF THESE AND/OR OTHER METHODS. SPECIFIC TOLERANCE INFORMATION IS PROVIDED IN TABLE 1 OF THE EROSION CONTROL & CONSERVATION PLANTINGS ON NONCROPLAND PUBLISHED BY PENN STATE.
- **POOR SOURCE OF TOPSOIL:** LOW FERTILITY SOIL TYPES LACKING IN SUFFICIENT AMOUNTS OF ESSENTIAL PLANT NUTRIENTS SUCH AS: NITROGEN, PHOSPHOROUS, POTASSIUM, SULFUR, MAGNESIUM, CALCIUM, IRON, MANGANESE, BORON, CHLORINE, ZINC, COPPER AND MOLYBDENUM, LIMIT VEGETATION STABILIZATION. SOIL TESTS MIGHT BE NECESSARY TO DETERMINE RESOLUTIONS: INCORPORATING SOIL NUTRIENTS CONSISTENT WITH RATES DETERMINED BY SOIL TESTING; SELECTIVE
- OR OTHER METHODS. SPECIFIC TOLERANCE INFORMATION IS PROVIDED IN TABLE 1 OF THE EROSION CONTROL & CONSERVATION PLANTINGS ON NONCROPLAND PUBLISHED BY PENN STATE. EASILY ERODIBLE: ERODIBLE SOIL TYPES EXHIBITING K VALUES GREATER THAN 0.36 OR PLASTICITY INDEX VALUES LOWER THAN 10, LIMIT VEGETATIVE STABILIZATION OF CHANNELS. RESOLUTIONS: PROVIDING TEMPORARY CHANNEL LINING, PROVIDING PERMANENT CHANNEL LINING, DECREASING CHANNEL

GRADE, INCREASING CHANNEL WIDTH, SELECTING VEGETATIVE WITH GREATER RETARDANCE, SELECTING PERMANENT

VEGETATIVE SPECIES TOLERANT TO LOW FERTILITY SOIL CONDITIONS, AND IMPLEMENTING COMBINATIONS OF THESE AND

- LININGS OTHER THAN GRASSES. AND IMPLEMENTING COMBINATION OF THESE AND/OR METHODS. VEGETATIVE RETARDANCE INFORMATION IS PROVIDED IN TABLES 6 AND 7 OF THE EROSION AND SEDIMENT POLLUTION CONTROL MANUAL PUBLISHED WETNESS: WET SOIL TYPES HAVE EXCESSIVE ROOT ZONE AND SOIL MOISTURES. SOME SOIL SURVEYS INDICATE WETNESS, HIGH WATER TABLE AND FLOODING. THIS INDICATOR IS AFFECTED BY SOIL DISTURBANCE.
- IMPLEMENTING COMBINATIONS OF THESE AND/OR OTHER METHODS. SPECIFIC TOLERANCE INFORMATION IS PROVIDED IN TABLE 1 OF THE EROSION CONTROL & CONSERVATION PLANTINGS ON NONCROPLAND PUBLISHED BY PENN STATE. DROUGHTY: DRY SOIL TYPES LACK SUFFICIENT ROOT ZONE SOIL MOISTURES. THIS INDICATOR IS AFFECTED BY SOIL DISTURBANCE. RESOLUTIONS: SELECTING VEGETATIVE SPECIES TOLERANT TO DRY CONDITIONS, IRRIGATING VEGETATED AREAS AND

IMPLEMENTING COMBINATION OF THESE AND/OR OTHER METHODS. SPECIFIC TOLERANCE INFORMATION IS PROVIDED IN

LININGS, LIMITING STANDING WATER DEPTHS, LIMITING RETENTION TIMES AND IMPLEMENTING COMBINATIONS OF THESE

RESOLUTIONS: SELECTING VEGETATIVE SPECIES TOLERANT TO WET CONDITIONS, TILING VEGETATIVE AREAS, AND

- TABLE 1 OF THE EROSION CONTROL & CONSERVATION PLANTINGS ON NONCROPLAND PUBLISHED BY PENN STATE. POTENTIAL SINKHOLE: SOIL TYPES SUSCEPTIBLE TO SINKHOLE AND SOLUTION CHANNEL/CHAMBER FORMATION POSE LIMITATIONS ON LOCATING RESERVOIR AREAS OF SEDIMENT BASINS, SEDIMENT TRAPS, STORMWATER RETENTION BASINS, AND STORMWATER DETENTION BASINS. RESOLUTIONS: LOCATING THOSE FACILITIES ON OTHER SOIL TYPES, LINING RESERVOIR AREAS WITH IMPERMEABLE
- PIPING: SOIL TYPES THAT EXHIBIT INSTABILITY IN POND EMBANKMENTS OR SUSCEPTIBILITY TO PIPING AND SEEPING POSE LIMITATIONS ON PLANNING EMBANKMENTS OF SEDIMENT BASINS, SEDIMENT TRAPS, STORMWATER RETENTION BASINS AND STORMWATER DETENTION BASINS. RESOLUTIONS: IMPORTING OTHER SOIL FOR EMBANKMENT OF THOSE FACILITIES, LOCATING THOSE FACILITIES ON OTHER SOIL TYPES, LIMITING EMBANKMENT SLOPE STEEPNESS AND IMPLEMENTING COMBINATIONS OF THESE AND/OR OTHER
- FROST ACTION: SOILS THAT ARE DIFFICULT TO COMPACT, UNSUITABLE FOR WINTER GRADING, OR SUSCEPTIBLE TO FROST ACTION POSE LIMITATIONS ON PLANNING EMBANKMENTS OF SEDIMENT BASINS, SEDIMENT TRAPS, STORM WATER RETENTION BASINS AND STORMWATER DETENTION BASINS. RESOLUTIONS: IMPORTING OTHER SOIL FOR EMBANKMENT OF THOSE FACILITIES, LOCATING THOSE FACILITIES ON OTHER SOILS TYPES, NOT CONSTRUCTING EMBANKMENTS DURING PERIODS PRONE TO FROST AND IMPLEMENTING COMBINATIONS

OF THESE AND/OR OTHER METHODS.

AND/OR OTHER METHODS.

- AS DISTURBED AREAS WITHIN A PROJECT APPROACH FINAL GRADE, PREPARATIONS SHOULD BE MADE FOR SEEDING AND MULCHING TO BEGIN (I.E. ANTICIPATE THE COMPLETION DATE AND SCHEDULE THE SEEDER). IN NO CASE SHOULD AN AREA EXCEEDING 15,000 SQUARE FEET, WHICH IS TO BE STABILIZED BY VEGETATION, REACH FINAL GRADE WITHOUT BEING SEEDED AND MULCHED. WAITING UNTIL EARTHMOVING IS COMPLETED BEFORE MAKING PREPARATIONS FOR SEEDING AND MULCHING IS NOT ACCEPTABLE. THIS REQUIREMENT SHOULD BE CLEARLY STATED IN THE SEEDING AND MULCHING SPECIFICATIONS CONTAINED ON THE PLAN DRAWINGS.
- BEFORE THE SEEDING BEGINS, TOPSOIL SHOULD BE APPLIED AND ANY REQUIRED SOIL AMENDMENTS WORKED INTO THE SOIL TO A DEPTH OF 4 TO 6 INCHES. IF COMPOST IS TO BE ADDED TO THE TOPSOIL, IT SHOULD BE WORKED INTO THE SOIL WITH THE OTHER SOIL AMENDMENTS UNLESS IT IS BEING APPLIED AS AN EROSION CONTROL BMP. 3. UPON COMPLETION OR TEMPORARY CESSATION OF THE EARTH DISTURBANCE ACTIVITY IN A SPECIAL PROTECTION
- WATERSHED, THAT PORTION OF THE PROJECT SITE TRIBUTARY TO THE SPECIAL PROTECTION WATERS MUST BE IMMEDIATELY STABILIZED. IN ALL OTHER WATERSHEDS, CESSATION OF ACTIVITY FOR AT LEAST 4 DAYS REQUIRES TEMPORARY STABILIZATION. 4. SURFACE ROUGHENING SHOULD BE APPLIED TO SLOPES 3H:1V OR STEEPER UNLESS A STABLE ROCK FACE IS PROVIDED.
- OR IT CAN BE SHOWN THAT THERE IS NOT A POTENTIAL FOR SEDIMENT POLLUTION TO SURFACE WATERS. FOR ROUGHENED SURFACES WITHIN 50 FEET OF A SURFACE WATER, AND WHERE BLANKETING OF SEEDED AREAS IS PROPOSED AS THE MEANS TO ACHIEVING PERMANENT STABILIZATION, SPRAY ON TYPE BLANKETS ARE RECOMMENDED 5. FILL SLOPES SHOULD BE SEEDED AND MULCHED AT REGULAR VERTICAL INCREMENTS - 15 TO 25 FEET MAXIMUM - AS THE
- VEGETATIVE BUFFERING AT THE BOTTOM OF THE SLOPE. 6. WHEREVER SEED AND MULCH IS APPLIED BY HYDROSEEDING METHODS, THE SEED AND MULCH SHOULD BE APPLIED IN SEPARATE APPLICATIONS WITH THE SEED BEING APPLIED FIRST AND THE MULCH SPRAYED ON TOP OF THE SEED. THIS IS TO ENSURE THAT THE SEED MAKES CONTACT WITH THE UNDERLYING SOIL. SOIL PREPARATION SHOULD BE COMPLETED PRIOR TO ADDING SEED TO THE HYDROSEEDING EQUIPMENT. RUNNING SEED THROUGH THE PUMPING SYSTEM CAN RESULT IN EXCESSIVE ABRASION OF THE SEED AND REDUCE THE PERCENTAGE OF PURE LIVE SEED IN THE APPLICATION. THEREFORE ALL SITE PREPARATION SHOULD BE COMPLETED PRIOR TO THE ARRIVAL OF THE HYDROSEEDER.

FILL IS BEING CONSTRUCTED. THIS WILL ALLOW THE BOTTOM OF THE FILL TO PROGRESS TOWARD STABILIZATION WHILE

WORK CONTINUES ON THE UPPER PORTION, MAKING FINAL STABILIZATION EASIER TO ACHIEVE AND PROVIDING SOME

- 7. IN CRITICAL AREAS (E.G. ADJACENT TO OR WITHIN 50 FEET OF STREAMS, PONDS, OR WETLANDS) A PROTECTIVE BLANKET SHOULD BE PROVIDED FOR ALL SEEDED AREAS. CONSIDERATION SHOULD BE GIVEN TO USE OF MULCH WITH NETTING OR PROTECTIVE BLANKETS FOR ALL SEEDED AREAS ON SLOPES 3H:1V OR STEEPER. 8. VEHICULAR TRAFFIC SHOULD BE RESTRICTED FROM AREAS TO BE SEEDED TO PREVENT SOIL COMPACTION.
- 9. AS SOON AS SLOPES, CHANNELS, DITCHES AND OTHER AREAS DISTURBED DURING CONSTRUCTION, REACH FINAL GRADE, STABILIZE IMMEDIATELY, IN ACCORDANCE WITH SEEDING, MULCHING AND STABILIZATION SPECIFICATIONS. 10. NO MORE THAN 15,000 SQUARE FEET OF DISTURBED AREA REACH FINAL GRADE BEFORE INITIATING SEEDING AND MULCHING OPERATIONS.

SEEDING SPECIFICATIONS SEEDING SHALL BE PLACED IN ACCORDANCE WITH PENNDOT PUBL. 408, SECTION 804.

2. SEED FORMULAS:					
FORMULA AND SPECIES	% BY WT	MIN. % PURITY	MIN. % GERMIN- ATION	MAX. % WEED	SEEDING RATE LBS/1000 SQ.YDS
FORMULA B					21.0 TOTAL
PERENNIAL RYEGRASS MIXTURE	20	98	90	0.15	4.0
CREEPING RED FESCUE OR CHEWINGS FESCUE	30	98	85	0.15	6.0
KENTUCKY BLUEGRASS MIXTURE	50	98	80	0.20	11.0
FORMULA C (NOT APPROVED FOR USE)					9.0 TOTAL
CROWNVETCH	45	99	70	0.10	4.0
ANNUAL RYEGRASS	55	98	90	0.15	5.0
FORMULA D					21.0 TOTAL
TALL FESCUE	70	98	85	0.15	15.0
CREEPING RED FESCUE OR CHEWINGS FESCUE	30	98	85	0.15	6.0
FORMULA E					10.0 TOTAL
ANNUAL RYEGRASS	100	98	90	0.15	10.0
FORMULA L					24.0 TOTAL
HARD FESCUE MIXTURE	55	98	85	0.15	13.0
CREEPING RED FESCUE	35	98	85	0.15	8.5
ANNUAL RYEGRASS	10	98	90	0.15	2.5
FORMULA W					10.5 TOTAL
TALL FESCUE	70	98	85	0.15	7.5
BIRDSFOOT TREFOIL MIXTURE	20	98	80*	0.10	2.0
REDTOP	10	92	80	0.15	1.0

| 10 | 92 | 80 | 0.15 | *MINIMUM 20% HARD SEED AND 60% NORMAL SPROUTS.

NOT PERMITTED

3. APPLICATION DATES: FORMULA B, D, & L -MARCH 15 TO JUNE 1 AUGUST 1 TO OCTOBER 15

LIME - AGRICULTURAL LIMESTONE

FORMULA C

FORMULA E

- MARCH 15 TO OCTOBER 15 FORMULA W APRIL 1 TO JUNE 15 **AUGUST 16 TO SEPTEMBER 15** 4. SOIL SUPPLEMENTS MAY BE ADDED IN ACCORDANCE WITH SECTION 804 OR AS FOLLOWS:

FERTILIZER - STANDARD QUALITY 0-20-20 BASIC FERTILIZER 200 LBS. PER 1000 S.Y. 10-10-10 STARTER FERTILIZER 100 LBS. PER 1000 S.Y.

90% MINIMUM OF CARBONATES 500 LBS. PER 1000 S.Y.

5. FORMULA B SHALL BE USED TO ESTABLISH PERMANENT STABILIZATION AND FORMULA E SHALL BE USED TO ESTABLISH TEMPORARY STABILIZATION.

- MULCHING SPECIFICATION MULCHING OF DISTURBED OR SEEDED AREA SHALL BE FURNISHED, PLACED, ANCHORED AND MAINTAINED IN ACCORDANCE WITH PENNDOT PUBL. 408,
- 2. MULCHING SHALL BE PLACED IMMEDIATELY AFTER SEEDING OR WITHIN 48 HOURS AFTER SEEDING IS COMPLETE. 3. HAY OR STRAW SHALL BE UNIFORMLY PLACED IN A CONTINUOUS BLANKET, AT A MINIMUM RATE OF 3.0 TONS PER ACRE.

4. STRAW MULCH SHOULD BE APPLIED IN LONG STRANDS, NOT CHOPPED OR FINELY BROKEN.

THE DIVERSIONS, CHANNELS, SEDIMENT BASINS, SEDIMENT TRAPS, AND STOCKPILES, WHEN USED, MUST BE STABILIZED IMMEDIATELY. IMMEDIATELY AFTER EARTH DISTURBANCE ACTIVITIES CEASE, THE OPERATOR SHALL STABILIZE ANY AREAS DISTURBED BY THE ACTIVITIES. DURING NON-GERMINATING PERIODS, MULCH MUST BE APPLIED AT THE SPECIFIED RATES. DISTURBED AREAS WHICH ARE NOT AT FINISHED GRADE AND WHICH WILL BE REDISTURBED WITHIN ONE YEAR MUST BE STABILIZED IN ACCORDANCE WITH THE TEMPORARY VEGETATIVE STABILIZATION

IN ACCORDANCE WITH THE PERMANENT VEGETATIVE STABILIZATION SPECIFICATIONS. 3. AN AREA SHALL BE CONSIDERED TO HAVE ACHIEVED FINAL STABILIZATION WHEN IT HAS A MINIMUM UNIFORM 70% PERENNIAL VEGETATIVE COVER OR OTHER PERMANENT NON-VEGETATIVE COVER WITH A DENSITY SUFFICIENT TO RESIST ACCELERATED SURFACE EROSION AND SUBSURFACE CHARACTERISTICS SUFFICIENT TO RESIST SLIDING AND OTHER MOVEMENTS.

SPECIFICATIONS. DISTURBED AREAS WHICH ARE AT FINISHED GRADE OR WHICH WILL NOT BE REDISTURBED WITHIN ONE YEAR MUST BE STABILIZED

- GRADED AREAS SHOULD BE SCARIFIED OR OTHERWISE LOOSENED TO A DEPTH OF 3 TO 5 INCHES TO PERMIT BONDING OF THE TOPSOIL TO THE SURFACE AREAS AND TO PROVIDE A ROUGHENED SURFACE TO PREVENT TOPSOIL FROM SLIDING DOWN SLOPE. 2. TOPSOIL SHOULD BE UNIFORMLY DISTRIBUTED ACROSS THE DISTURBED AREA TO A DEPTH OF SIX (6) INCHES MINIMUM. SPREADING SHOULD BE DONE IN SUCH A MANNER THAT SODDING OR SEEDING CAN PROCEED WITH A MINIMUM OF ADDITIONAL PREPARATION OR TILLAGE. IRREGULARITIES IN THE SURFACE RESULTING FROM TOPSOIL PLACEMENT SHOULD BE CORRECTED IN ORDER TO PREVENT FORMATION OF DEPRESSIONS UNLESS SUCH
- DEPRESSIONS ARE PART OF THE PCSM PLAN. 3. TOPSOIL SHOULD NOT BE PLACED WHILE THE TOPSOIL OR SUBSOIL IS IN A FROZEN OR MUDDY CONDITION, WHEN THE SUBSOIL IS EXCESSIVELY WET, OR IN A CONDITION THAT MAY OTHERWISE BE DETRIMENTAL TO PROPER GRADING AND SEEDED PREPARATION. COMPACTED SOILS SHOULD BE SCARIFIED 6 TO 12 INCHES ALONG CONTOUR WHEREVER POSSIBLE PRIOR TO SEEDING.

SOIL AMENDMENT APPLICATION RATE EQUIVALENTS

SOIL	PERMANENT SE	EEDING APPLICATI		
AMENDMENT	PER ACRE	PER 1,000 SF	PER 1,000 SY	
AGRICULTURAL LIME	6 TONS	240 LB.	2,480 LB.	OR AS PER SOIL TEST; MAY NOT BE REQUIRED IN AGRICULTURAL FIELDS
10-10-20 FERTILIZER	1,000 LB	25 LB.	210 LB.	OR AS PER SOIL TEST; MAY NOT BE REQUIRED IN AGRICULTURAL FIELDS
	TEMPORARY SI	EEDING APPLICATI		
AGRICULTURAL LIME	1 TON	40 LB.	410 LB.	TYPICALLY NOT REQUIRED FOR TOPSOIL STOCKPILES
10-10-10 FERTILIZER	500 LB.	12.5 LB.	100 LB.	TYPICALLY NOT REQUIRED FOR TOPSOIL STOCKPILES

MULICU ADDI ICATION DATES

MULCH APPLIC	CATION RATES	•		
	APF	PLICATION RATE (N		
MULCH TYPE	PER ACRE	PER 1,000 SF	PER 1,000 SY	
STRAW	3 TONS	140 LB.	1,240 LB.	EITHER WHEAT OR OAT STRAW, FREE OF WEEDS, NOT CHOPPED OR FINELY BROKEN
HAY	3 TONS	140 LB.	1,240 LB.	TIMOTHY, MIXED CLOVER AND TIMOTHY OR OTHER NATIVE FORAGE GRASSES
WOOD CHIPS	4-6 TONS	185-275 LB.	1,650-2,500 LB.	MAY PREVENT GERMINATION OF GRASSES AND LEGUMES
UVDDOMI II CU	1 TON	47 I D	415 I D	SEE LIMITATIONS ADOME

TOPSOIL APPLICATION RATES									
DEPTH (IN)	PER 1,000 SF	PER ACRE							
1	3.1 CY	134 CY							
2	6.2 CY	268 CY							
3	9.3 CY	403 CY							
4	12.4 CY	537 CY							
5	15.5 CY	672 CY							
6	18.6 CY	806 CY							
7	21.7 CY	940 CY							

24.8 CY

CONTRACTOR IS RESPONSIBLE FOR THE PROPER DISPOSAL OF ALL DEMOLISHED OR UNUSED CONSTRUCTION MATERIALS. GARBAGE SHALL BE COLLECTED ON-SITE UNTIL RETRIEVED BY AN APPROVED DISPOSAL OR RECYCLING COMPANY, CONTRACTOR SHALL NOT INCINERATE EXCESS MATERIALS. LIKELY WASTE TO BE GENERATED DURING CONSTRUCTION ON THIS SITE: CONCRETE, ASPHALT, STONE AND BASE COURSE FROM DEMOLITION PROCESS; EXISTING PLANTS FROM DEMOLITION PROCESS; EXCESS SILT SOCK;

MISCELLANEOUS SCRAP MATERIALS FROM BUILDING CONSTRUCTION;

GENERAL RUBBISH AND DEBRIS.

THERMAL IMPACTSTHE RUNOFF FROM THE PROJECT AREA THAT OUTLETS TO SURFACE WATERS FLOWS THROUGH COMPOST FILTER SOCKS, AND RIPRAP APRON.

1,074 CY

COMPOST FILTER SOCKS HELP MITIGATE THERMAL IMPACTS BY SLOWING STORMWATER FLOW, ALLOWING NATURAL INFILTRATION TO PREVENT HEATED RUNOFF FROM REACHING WATERWAYS. THEY ACT AS AN INSULATING BUFFER, REDUCING DIRECT SUNLIGHT EXPOSURE AND RETAINING SOIL MOISTURE, WHICH HELPS KEEP SURROUNDING AREAS COOLER. THE ORGANIC MATERIAL HOLDS WATER, PREVENTING SOIL FROM DRYING OUT AND REDUCING HEAT STRESS ON PLANTS AND WILDLIFE. BY STABILIZING SOIL AND MINIMIZING SEDIMENT TRANSPORT, THEY PREVENT HEAT-ABSORBING PARTICLES FROM ENTERING WATER BODIES, ADDITIONALLY, THEY SUPPORT VEGETATION

RIPRAP APRONS MITIGATE THERMAL IMPACTS BY REDUCING HEAT RETENTION PROVIDING PARTIAL SHADING TO WATER. AND PROMOTING INFILTRATION THROUGH VOID SPACES BETWEEN STONES. UNLIKE IMPERVIOUS SURFACES RIPRAP ALLOWS AIR CIRCULATION. MINIMIZING TEMPERATURE SPIKES IN RUNOFF. IT ALSO SLOWS WATER VELOCITY, PREVENTING THE RAPID TRANSPORT OF HEATED STORMWATER INTO STREAMS, WHILE STABILIZING

GROWTH, WHICH FURTHER PROVIDES SHADE AND NATURAL COOLING OVER

BANKS TO REDUCE SEDIMENT TRANSPORT, WHICH CAN CONTRIBUTE TO TEMPERATURE INCREASES. THESE COMBINED EFFECTS HELP REGULATE WATER TEMPERATURE AND PROTECT AQUATIC ECOSYSTEMS FROM THERMAL STRESS

EROSION & SEDIMENTATION CONTROL NOTES

| 04/11/2025 | REVISED PER MCCD REVIEW LETTER DATED 03/25/2025

CONSTRUCTION PLANS UPPER POTTSGROVE MUNICIPAL COMPLEX


UPPER POTTSGROVE TOWNSHIP - MONTGOMERY COUNTY - PENNSYLVANIA



THIS PLAN IS FOR EROSION & SEDIMENTATION CONTROL PURPOSE ONLY

MONTGOMERY COUNTY BLOCK 60-3 UNIT 12

OF THOSE BMP'S.

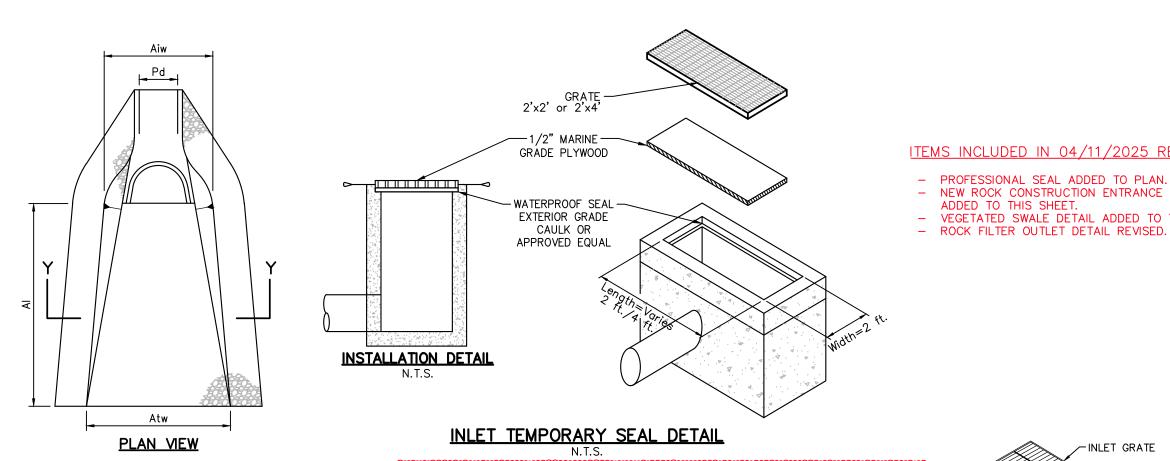

STABILIZED

WOOD POSTS -

AASHTO No. 57

BX2051

FENCING ATTACHED TO EACH-

POSTS MUST BE SET AT

LEAST 18" INTO GROUND

OF THE WORK AT THE SITE.

AND/OR SNOW-FENCE MAY BE USED).

POST IN AT LEAST 3 PLACES

TENSAR SAFETY FENCE BX 2051, 4' HT., ORANGE

TENSAR SAFETY FENCE UX 4250, 4' HT., ORANGE

FOR GENERAL USE:

FOR EXTRA PROTECTION:

-AASHTO #57

- FILTER FABRIC

HEIGHT OF ROCK FILTER =

OR FILTER FABRIC FENCE

UX4250

5/6 HEIGHT OF STRAW BALES

WOOD POST

-R-3 ROCK

UP SLOPE FACE

NOTES:

1. A ROCK FILTER OUTLET SHALL BE INSTALLED WHERE FAILURE OF A SILT FENCE

ANCHORED COMPOST LAYER SHALL BE USED ON UPSLOPE FACE IN HQ AND EV

OR STRAW BALE BARRIER HAS OCCURRED DUE TO CONCENTRATED FLOW.

2. IF INSTALLED, INSPECT WEEKLY AND AFTER EACH RUNOFF EVENT. SEDIMENT

ROCK FILTER OUTLET DETAIL

SHALL BE REMOVED WHEN ACCUMULATIONS REACH 1/3 THE HEIGHT OF THE OUTLET.

INSTALLATION: ATTACH FENCE TO 2" x 2" PINE STAKES DRIVEN AT LEAST 18" INTO

THE GROUND, SPACED 8' ON CENTER, WITH WIRE FASTENERS IN 3 PLACES PER STAKE.

<u>ORANGE CONSTRUCTION FENCE DETAIL</u>

MAX. 8' SPACING

-ANCHOR POSTS MUST BE MIN.

PROTECTION BARRIER SHALL BE 4 FEET HIGH, CONSTRUCTED OF DURABLE

AND HIGHLY VISIBLE MATERIAL (PLASTIC ORANGE CONSTRUCTION FENCE

2. PROTECTION BARRIERS SHALL BE MAINTAINED THROUGHOUT THE DURATION

TREE PROTECTION BARRIER FENCE DETAIL

2" STEEL "U" CHANNEL

OUTLET CROSS-SECTION

AREA

ELEVATION VIEW <u>RIPRAP APRON AT PIPE OUTLET</u> WITH FLARED END SECTION OR ENDWALL DETAIL


-GEOTEXTILE

SECTION Y-Y

<0% SLOPE>

		RIF	PRAP		APRON			
OUTLET NO.	PIPE DIA Pd (IN)	SIZE (R)	THICK. Rt (IN)	LENGTH AI (FT)	INITIAL WIDTH Aiw (FT)	TERMINAL WIDTH Atw (FT)		
FES100	8"	3	9	6	2	4.4		
FES200	15"	3	9	6	3.75	6.15		
FES201	10"	3	9	6	2.5	4.9		
FES202	15"	3	9	6	3.75	6.15		
FES206	12"	3	9	6	3	5.4		
FES300	8"	3	9	6	2	4.4		

- . ALL APRONS SHALL BE CONSTRUCTED TO THE DIMENSIONS SHOWN. TERMINAL WIDTHS SHALL BE ADJUSTED AS NECESSARY TO MATCH RECEIVING CHANNELS.
- 2. ALL APRONS SHALL BE INSPECTED AT LEAST WEEKLY AND AFTER EACH RUNOFF EVENT. DISPLACED RIPRAP WITHIN THE APRON SHALL BE REPLACED IMMEDIATELY.

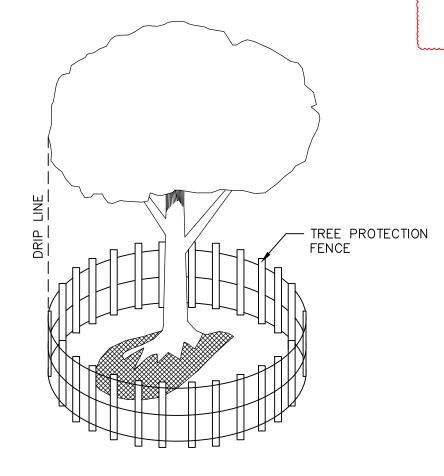

TREE PROTECTION FENCE DETAIL

ALL WOODY VEGETATION TO BE RETAINED WITHIN 25 FEET OF A BUILDING SITE, PARKING AREA, DRIVEWAY OR OTHER PROPOSED IMPROVEMENT SHALI BE PROTECTED FROM EQUIPMENT DAMAGE BY FENCING OR OTHER EFFECTIVE BARRIERS APPROVED BY THE TOWNSHIP ENGINEER / LANDSCAPE ARCHITECT. FENCING OR BARRIERS SHALL BE PLACED AS NOTED BELOW, UNLESS PRIOR DETERMINATION HAS BEEN MADE BY THE TOWNSHIP ENGINEER / LANDSCAPE ARCHITECT REGARDING A MORE APPROPRIATE

DESCRIPTION: TREES ARE OFTEN DAMAGED BY MOVING CONSTRUCTION EQUIPMENT OR BY SEDIMENT BUILDUP AROUND THE ROOTS. TREE PROTECTION FENCING, WHEN PLACED ALONG OR AROUND TREES, SERVES AS A BOUNDARY MARKER TO INDICATE THAT CLEARING AND STOCKPILING ARE NOT PERMITTED BEYOND THAT POINT.

WHEN USED: TREE PROTECTION FENCE MAY BE USED WHENEVER THERE ARE SPECIFIC TREES OR WOODED AREAS THAT MUST BE PROTECTED.

REQUIREMENTS FOR INSTALLATION: THE TREE PROTECTION FENCE IS INSTALLED BY HAMMERING WOOD OR METAL STAKES INTO THE GROUND AND CONNECTING THE FENCING MATERIAL SECURELY TO THE POSTS PER THE MANUFACTURERS' INSTRUCTIONS.

PLACE THE TREE PROTECTION FENCE ALONG THE DRIPLINES OF TREES OR 1 FOOT FROM THE TREE TRUNK FOR EVERY INCH OF TRUNK DIAMETER, WHICHEVER IS GREATER. A DRIPLINE IS AN IMAGINARY LINE EXTENDING DOWN FROM THE OUTER-MOST BRANCHES OF A TREE TO THE GROUND. THIS IS GENERALLY THE OUTER BOUNDARY FOR TREE ROOTS. IF THE TREE PROTECTION FENCE IS PLACED ANY CLOSER TO A TREE, ITS PURPOSE MAY BE DEFEATED.

MAINTENANCE: INSPECT THE TREE PROTECTION FENCING PERIODICALLY DURING CONSTRUCTION TO MAKE SURE THAT IT IS POSITIONED SECURELY.

- PROFESSIONAL SEAL ADDED TO PLAN. NEW ROCK CONSTRUCTION ENTRANCE DETAIL ADDED TO THIS SHEET. - VEGETATED SWALE DETAIL ADDED TO THIS SHEET.

ITEMS INCLUDED IN 04/11/2025 REVISIONS:

∼INLET GRATE

ISOMETRIC VIEW

EARTHEN BERM TO BE

PERMANENT VEGETATION

STORM

INLET

ELEVATION VIEW

REMAIN PERMANENTLY.

TRAFFIC HAZARDS.


NOT PASSING A NO. 40 SIEVE

MAXIMUM DRAINAGE AREA = 1/2 ACRE

STABILIZED WITH TEMPORARY OR

FOR BAG REMOVAL

FROM INLET

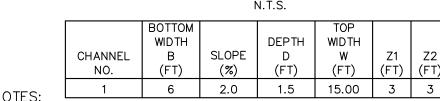

FXPANSION RESTRAINT

 $2" \times 2" \times 3/4"$

RUBBER BLOCK

INSTALLATION DETAIL

6" MIN. HEIGHT-

<u> FILTER BAG INLET PROTECTION — TYPE M INLET DETAIL</u>

INLET PROTECTION SHALL NOT BE REQUIRED FOR INLET TRIBUTARY TO SEDIMENT BASIN

SUBBASE BERM SHALL BE MAINTAINED UNTIL ROADWAY IS PAVED. EARTHEN BERM IN

CHANNEL SHALL BE MAINTAINED UNTIL PERMANENT STABILIZATION IS COMPLETED OR

AT A MINIMUM, THE FABRIC SHALL HAVE A MINIMUM GRAB TENSILE STRENGTH OF 120

STRENGTH OF 50 LBS. FILTER BAGS SHALL BE CAPABLE OF TRAPPING ALL PARTICLES

FLOW CAPACITY HAS BEEN REDUCED SO AS TO CAUSE FLOODING OR BYPASSING OF THE

ACF ENVIRONMENT SILTSACK SIZED FOR 2'X2' INLET BOX (OR APPROVED EQUAL)

<u>FLOW</u>

PLAN VIEW

5. INLET FILTER BAGS SHALL BE INSPECTED ON A WEEKLY BASIS AND AFTER EACH RUNOFF EVENT. BAGS SHALL BE EMPTIED AND RINSED OR REPLACED WHEN HALF FULL OR WHEN

INLET. DAMAGED OR CLOGGED BAGS SHALL BE REPLACED. A SUPPLY SHALL BE

DO NOT USE ON MAJOR PAVED ROADWAYS WHERE PONDING MAY CAUSE

MAINTAINED ON SITE FOR REPLACEMENT OF BAGS. ALL NEEDED REPAIRS SHALL BE INITIATED IMMEDIATELY AFTER THE INSPECTION. DISPOSE OF ACCUMULATED SEDIMENT AS

LBS, A MINIMUM BURST STRENGTH OF 200 PSI, AND A MINIMUM TRAPEZOIDAL TEAR

ROLLED EARTHEN BERM SHALL BE MAINTAINED UNTIL ROADWAY IS STONED. ROAD

OR TRAP BERMS SHALL BE REQUIRED FOR ALL INSTALLATIONS.

WELL AS ALL USED BAGS ACCORDING TO THE PLAN NOTES.

-EXPANSION

RESTRAINT

PLAN VIEW

(1/4" NYLON ROPE)

CHANNEL DIMENSIONS SHALL BE CONSTANTLY MAINTAINED. CHANNEL SHALL BE CLEANED WHENEVER TOTAL CHANNEL DEPTH IS REDUCED BY 25% AT ANY LOCATION. SEDIMENT DEPOSITS SHALL BE REMOVED WITHIN 24 HOURS OF DISCOVERY OR AS SOON AS SOIL CONDITIONS PERMIT ACCESS TO CHANNEL WITHOUT FURTHER DAMAGE. DAMAGED LINING SHALL BE REPAIRED OR REPLACED WITHIN 48 HOURS OF DISCOVERY


(LOOKING DOWNSTREAM)
SWALE CROSS-SECTION

 * SEE EROSION CONTROL BLANKET DETAIL FOR STAPLE PATTERNS,


VEGETATED SWALE DETAIL

SEED MIX SHALL BE RAIN GARDEN MIX #ERNMX-180 FROM ERNST

2. NO MORE THAN ONE THIRD OF THE SHOOT (GRASS LEAF) SHALL BE REMOVED IN ANY MOWING. GRASS HEIGHT SHALL BE MAINTAINED BETWEEN 2 AND 3 INCHES UNLESS OTHERWISE SPECIFIED. EXCESS

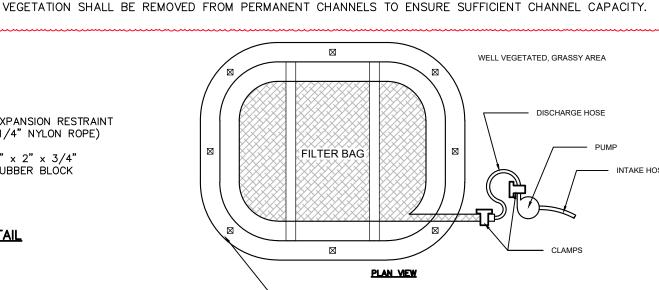


JUTE WITH SEEDING LINING

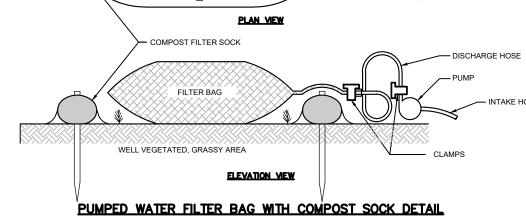

VOLUME FILTER BAGS SHALL BE MADE FROM NON-WOVEN GEOTEXTILE MATERIAL SEWN WITH HIGH STRENGTH,

PROPERTY	TEST METHOD	MINIMUM STANDARD
VG. WIDE WIDTH STRENGTH	ASTM D-4884	60 LB/IN
GRAB TENSILE	ASTM D-4632	205 LB
PUNCTURE	ASTM D-4833	110 LB
MULLEN BURST	ASTM D-3786	350 PSI
UV RESISTANCE	ASTM D-4355	70%
AOS % RETAINED	ASTM D-4751	80 SIEVE

- 2. A SUITABLE MEANS OF ACCESSING THE BAG WITH MACHINERY REQUIRED FOR DISPOSAL PURPOSES SHALL BE PROVIDED. FILTER BAGS SHALL BE REPLACED WHEN THEY BECOME 1/2 FULL OF SEDIMENT. SPARE BAGS SHALL BI KEPT AVAILABLE FOR REPLACEMENT OF THOSE THAT HAVE FAILED OR ARE FILLED. BAGS SHALL BE PLACED ON 3. BAGS SHALL BE LOCATED IN WELL-VEGETATED (GRASSY) AREA, AND DISCHARGE ONTO STABLE, EROSION RESISTANT
- AREAS. SHALL BE LUCATED IN WELL-VEGETATED (GRASST) AREA, AND DISCHARGE ONTO STABLE, EROSION RESISTANT AREAS. WHERE THIS IS NOT POSSIBLE, A GEOTEXTILE UNDERLAYMENT AND FLOW PATH SHALL BE PROVIDED. BAGS MAY BE PLACED ON FILTER STONE TO INCREASE DISCHARGE CAPACITY. BAGS SHALL NOT BE PLACED ON SLOPES GREATER THAN 5%. FOR SLOPES EXCEEDING 5%, CLEAN ROCK OR OTHER NON-ERODIBLE AND NON-POLLUTING MATERIAL MAY BE PLACED UNDER THE BAG TO REDUCE SLOPE STEEPNESS.
- NO DOWNSLOPE SEDIMENT BARRIER IS REQUIRED FOR MOST INSTALLATIONS. COMPOST BERM OR COMPOST FILTER SOCK SHALL BE INSTALLED BELOW BAGS LOCATED IN HQ OR EV WATERSHEDS, WITHIN 50 FEET OF ANY RECEIVING SURFACE WATER OR WHERE GRASSY AREA IS NOT AVAILABLE.
- 5. THE PUMP DISCHARGE HOSE SHALL BE INSERTED INTO THE BAGS IN THE MANNER SPECIFIED BY THE MANUFACTURER AND SECURELY CLAMPED. A PIECE OF PVC PIPE IS RECOMMENDED FOR THIS PURPOSE.
- . THE PUMPING RATE SHALL BE NO GREATER THAN 750 GPM OR ½ THE MAXIMUM SPECIFIED BY THE MANUFACTURER, WHICHEVER IS LESS. PUMP INTAKES SHALL BE FLOATING AND SCREENED. 7. FILTER BAGS SHALL BE INSPECTED DAILY. IF ANY PROBLEM IS DETECTED, PUMPING SHALL CEASE IMMEDIATELY AND NOT RESUME UNTIL THE PROBLEM IS CORRECTED.

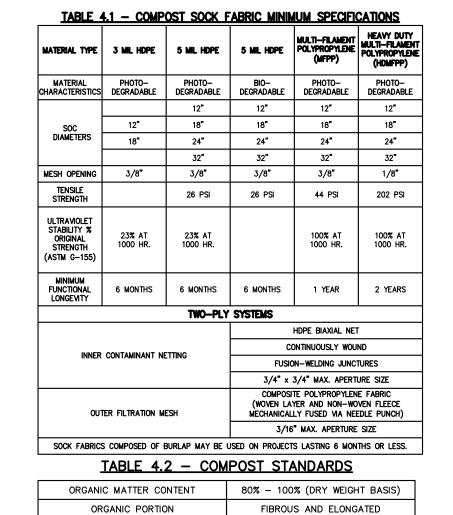

MOISTURE CONTENT

SOLUBLE SALT CONCENTRATION

~2"x2" WOODEN STAKES PLACED 10' O.C.

-2"x2" WOODEN STAKES

-18" COMPOST FILTER SOCK

UNDISTURBED AREA

SECTION VIEW

DISTURBED

AREA

UNDISTURBED

PLAN VIEW

NOTES:
1. SOCK FABRIC SHALL MEET THE STANDARDS OF TABLE 4.1. COMPOST SHALL MEET THE

STANDARDS OF TABLE 4.2.

COMPOST FILTER SOCK SHALL BE PLACED AT EXISTING LEVEL GRADE. BOTH ENDS OF THE SOCK SHALL BE EXTENDED AT LEAST 8 FEET UP SLOPE AT 45 DEGREES TO THE MAIN SOCK ALIGNMENT. STAKES MAY BE INSTALLED IMMEDIATELY DOWNSLOPE OF THE SOCK IF

SO SPECIFIED BY THE MANUFACTURER.

3. TRAFFIC SHALL NOT BE PERMITTED TO CROSS FILTER SOCKS.

4. ACCUMULATED SEDIMENT SHALL BE REMOVED WHEN IT REACHES HALF THE ABOVEGROUND HEIGHT OF TECH SOCK AND DISPOSED IN THE MATTER DESCRIBED ELSEWHERE IN THE

PLAN. 5. SOCKS SHALL BE INSPECTED WEEKLY AND AFTER EACH RUNOFF EVENT. DAMAGED SOCKS

SHALL BE REPAIRED ACCORDING TO MANUFACTURER'S SPECIFICATIONS OR REPLACED WITHIN

BIODEGRADABLE FILTER SOCKS SHALL BE REPLACED AFTER 6 MONTHS; PHOTODEGRADABLE SOCKS AFTER 1 YEAR. POLYPROPYLENE SOCKS SHALL BE REPLACED ACCORDING TO MANUFACTURER'S RECOMMENDATIONS.

UPON STABILIZATION OF THE AREA TRIBUTARY TO THE SOCK, STAKES SHALL BE REMOVED.

THE SOCK MAY BE LEFT IN PLACE AND VEGETATED OR REMOVED. IN THE LATTER CASE,

THE MESH SHALL BE CUT OPEN AND THE MULCH SPREAD AS A SOIL SUPPLEMENT.

B. REFER TO E&S PLAN FOR COMPOST SOCK LOCATIONS, SIZE, IDENTIFICATIONS AND

COMPOST FILTER SOCK DETAIL


BLOWN/PLACED FILTER MEDIA-

FILTER SOCK

24 HOURS OF INSPECTION.

CONTOURS -

DISTURBED AREA

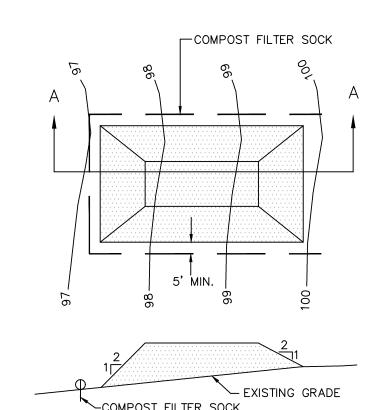

5.5 - 8.0

35% - 55%

98% PASS THROUGH 1" SCREEN

5.0 dS/m (mmhos/cm) MAXIMUM

-COMPOST FILTER SOCK

MINIMUM STABILIZATION REQUIREMENTS.


SECTION A-A . PLACE STOCKPILES AT LOCATIONS AS SHOWN ON THE EROSION AND SEDIMENTATION CONTROL PLAN. ALL SIDE SLOPES SHALL BE 2 TO 1 OR FLATTER.


3. STOCKPILE SHALL RECEIVE A VEGETATIVE COVER IN ACCORDANCE WITH

- 4. COMPOST FILTER SOCK SHALL BE INSTALLED AS DETAILED HEREON. 5. LOCATION OF PROPOSED STOCKPILE WHICH AFFECT EROSION CONTROLS ARE SHOWN SCHEMATICALLY ONLY. ACTUAL STOCKPILE LOCATION MAY CHANGE DURING CONSTRUCTION.
- STOCKPILE HEIGHTS MUST NOT EXCEED 35 FEET. STABILIZE THE STOCKPILE SURFACE WITH SURFACE ROUGHENING TEMPORARY SEEDING AND MULCHING, EROSION CONTROL BLANKETS, OR SOIL BINDERS. SOILS STOCKPILED FOR AN EXTENDED PERIOD

(TYPICALLY FORE MORE THAN 60 DAYS) SHOULD BE SEEDED AND MULCHED WITH A TEMPORARY GRASS COVER ONCE THE STOCKPILE IS PLACED (TYPICALLY WITHIN 14 DAYS). USE OF MULCH ONLY OR A SOIL BINDER IS ACCEPTABLE IF THE STOCKPILE WILL BE IN PLACE FOR A MORE LIMITED TIME PERIOD (TYPICALLY 30-60 DAYS).


<u>STOCKPILE DETAIL</u>

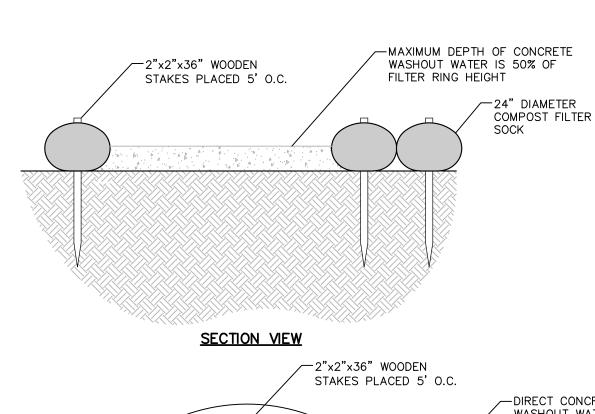

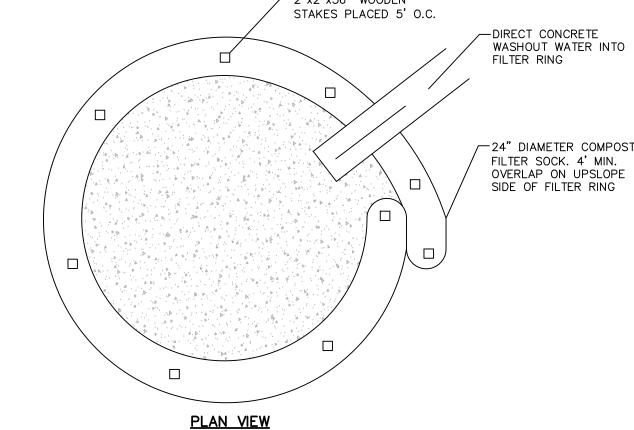

TYPICAL COMPOST SOCK WASHOUT INSTALLATION DETAIL

- INSTALL ON FLAT GRADE FOR OPTIMUM PERFORMANCE. 2. 18" DIAMETER SILT SOCK MAY BE STACKED ONTO DOUBLE 24" DIAMETER
- SILK SOCKS IN PYRAMIDAL CONFIGURATION FOR ADDED HEIGHT. 3. A SUITABLE IMPERVIOUS GEOMEMBRANE SHALL BE PLACED AT THE LOCATION OF THE WASHOUT PRIOR TO INSTALLING THE SOCKS.

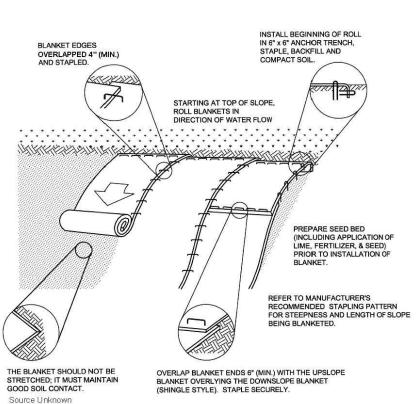

Seed and soil amendments shall be applied according to the rates in the plan drawings prior to

Provide anchor trench at toe of slope in similar fashion as at top of slope.

ULTV

Blanket shall have good continuous contact with underlying soil throughout entire length. Lay blanket loosely and stake or staple to maintain direct contact with soil. Do not stretch blanket. The blanket shall be stapled in accordance with the manufacturer's recommendations

Blanketed areas shall be inspected weekly and after each runoff event until perennial vegetation s established to a minimum uniform 70% coverage throughout the blanketed area. Damaged or displaced blankets shall be restored or replaced within 4 calendar days.

3.8 staples/yd² 2:1 SLOPES 1:1 SLOPES

1.75 staples/vd2

4:1 SLOPES

1 2 - 3' -

1.2 staples/yd

3:1 SLOPES

xx x x xx

4 * * * * * * * *


-** X X X X

* X X X

1. USE JUTE OR COIR MATTING W/ WOOD STAKES. 2. NO PLASTIC/ POLYPROPYLENE MATERIALS ARE ALLOWED.

EROSION CONTROL BLANKET DETAIL

EROSION & SEDIMENTATION CONTROL DETAILS

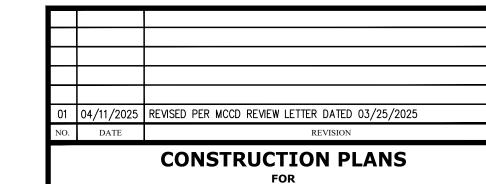

UPPER POTTSGROVE MUNICIPAL COMPLEX

JPPER POTTSGROVE TOWNSHIP - MONTGOMERY COUNTY - PENNSYLVANIA



SELECTED 50' NSP -MOUNTABLE BERM AS NECESSARY WHEN ACCESS SLOPES TOWARD ROAD PIPE AND GEOTEXTILE PROFILE VIEW 4" AASHTO #1 AGGREGATE FENCE (IF NOT IN CUT / FILL) - MOUNTABLE BERM (6" MIN.)*
(AS NEEDED) XISTING ROADWAY SELECTED 50' NSP SP - SPECIAL PROTECTION WATERSHED *MOUNTABLE BERM USED TO PROVIDE PROPER COVER FOR PIPE

- SEDIMENT BASIN OR TRAP. BERMS SHALL BE REQUIRED FOR ALL
- EARTHEN BERM IN CHANNEL SHALL BE MAINTAINED UNTIL PERMANENT STABILIZATION IS COMPLETED OR REMAIN PERMANENTLY.
- BE CAPABLE OF TRAPPING ALL PARTICLES NOT PASSING A NO. 40 SIEVE

FILTER BAG INLET PROTECTION - 2'X2' YARD DRAIN DETAIL

1. MAXIMUM DRAINAGE AREA = $\frac{1}{2}$ ACRE.

INSTALLATION DETAIL

2'X2' YARD/

DRAIN

ELEVATION VIEW

SANDBAG, FILTER LOG,

COMPOST SOCK OR FILTER

TUBE 6" MIN. HEIGHT (TYP.)

FLOW

- 2. INLET PROTECTION SHALL NOT BE REQUIRED FOR INLET TRIBUTARY TO
- 3. ROLLED EARTHEN BERM SHALL BE MAINTAINED UNTIL ROADWAY IS STONED. ROAD SUBBASE BERM SHALL BE MAINTAINED UNTIL ROADWAY IS PAVED.
- 4. AT A MINIMUM, THE FABRIC SHALL HAVE A MINIMUM GRAB TENSILE STRENGTH OF 120 LBS, A MINIMUM BURST STRENGTH OF 200 PSI, AND A MINIMUM TRAPEZOIDAL TEAR STRENGTH OF 50 LBS. FILTER BAGS SHALL
- 5. INLET FILTER BAGS SHALL BE INSPECTED ON A WEEKLY BASIS AND AFTER EACH RUNOFF EVENT. BAGS SHALL BE EMPTIED AND RINSED OR REPLACED WHEN HALF FULL OR WHEN FLOW CAPACITY HAS BEEN REDUCED SO AS TO CAUSE FLOODING OR BYPASSING OF THE INLET. DAMAGED OR CLOGGED BAGS SHALL BE REPLACED. A SUPPLY SHALL BE MAINTAINED ON SITE

FOR REPLACEMENT OF BAGS. ALL NEEDED REPAIRS SHALL BE INITIATED IMMEDIATELY AFTER THE INSPECTION. DISPOSE OF ACCUMULATED SEDIMENT AS WELL AS ALL USED BAGS ACCORDING TO THE PLAN NOTES. DO NOT USE ON MAJOR PAVED ROADWAYS WHERE PONDING MAY CAUSE TRAFFIC HAZARDS.

FULL WIDTH OF ENTRANCE OR MINIMUM OF 20 FEET. ENTERING ROCK CONSTRUCTION ENTRANCE. APPROPRIATELY FOR SIZE OF DITCH BEING CROSSED. ROCK CONSTRUCTION ENTRANCE THICKNESS SHALL BE CONSTANTLY MAINTAINED TO THE SPECIFIED DIMENSIONS BY ADDING ROCK. A STOCKPILE SHALL BE MAINTAINED ON SITE FOR THIS PURPOSE. ALL SEDIMENT DEPOSITED ON PAVED ROADWAYS SHALL BE REMOVED AND RETURNED TO THE CONSTRUCTION SITE IMMEDIATELY. WASHING THE ROADWAY OR SWEEPING THE DEPOSITS INTO ROADWAY DITCHES, SEWERS, CULVERTS, OR OTHER DRAINAGE COURSES IS NOT ACCEPTABLE.


1. THE PROJECT SITE IS LOCATED IN NON SPECIAL PROTECTION WATERSHED. CONTRACTOR SHALL CONSTRUCT THE TOTAL LENGTH OF 100 FT FOR ALL CONSTRUCTION ENTRANCES PER THIS DETAIL. REMOVE TOPSOIL PRIOR TO INSTALLATION OF ROCK CONSTRUCTION ENTRANCE. EXTEND ROCK OVER RUNOFF SHALL BE DIVERTED FROM ROADWAY TO A SUITABLE SEDIMENT REMOVAL BMP PRIOR TO MOUNTABLE BERM SHALL BE INSTALLED WHEREVER OPTIONAL CULVERT PIPE IS USED AND PROPER PIPE COVER AS SPECIFIED BY MANUFACTURER IS NOT OTHERWISE PROVIDED. PIPE SHALL BE SIZED


ROCK CONSTRUCTION ENTRANCE DETAIL

THIS PLAN IS FOR EROSION & SEDIMENTATION CONTROL PURPOSE ONL


MONTGOMERY COUNTY BLOCK 60-3 UNIT 12

SHEET 08 OF 23

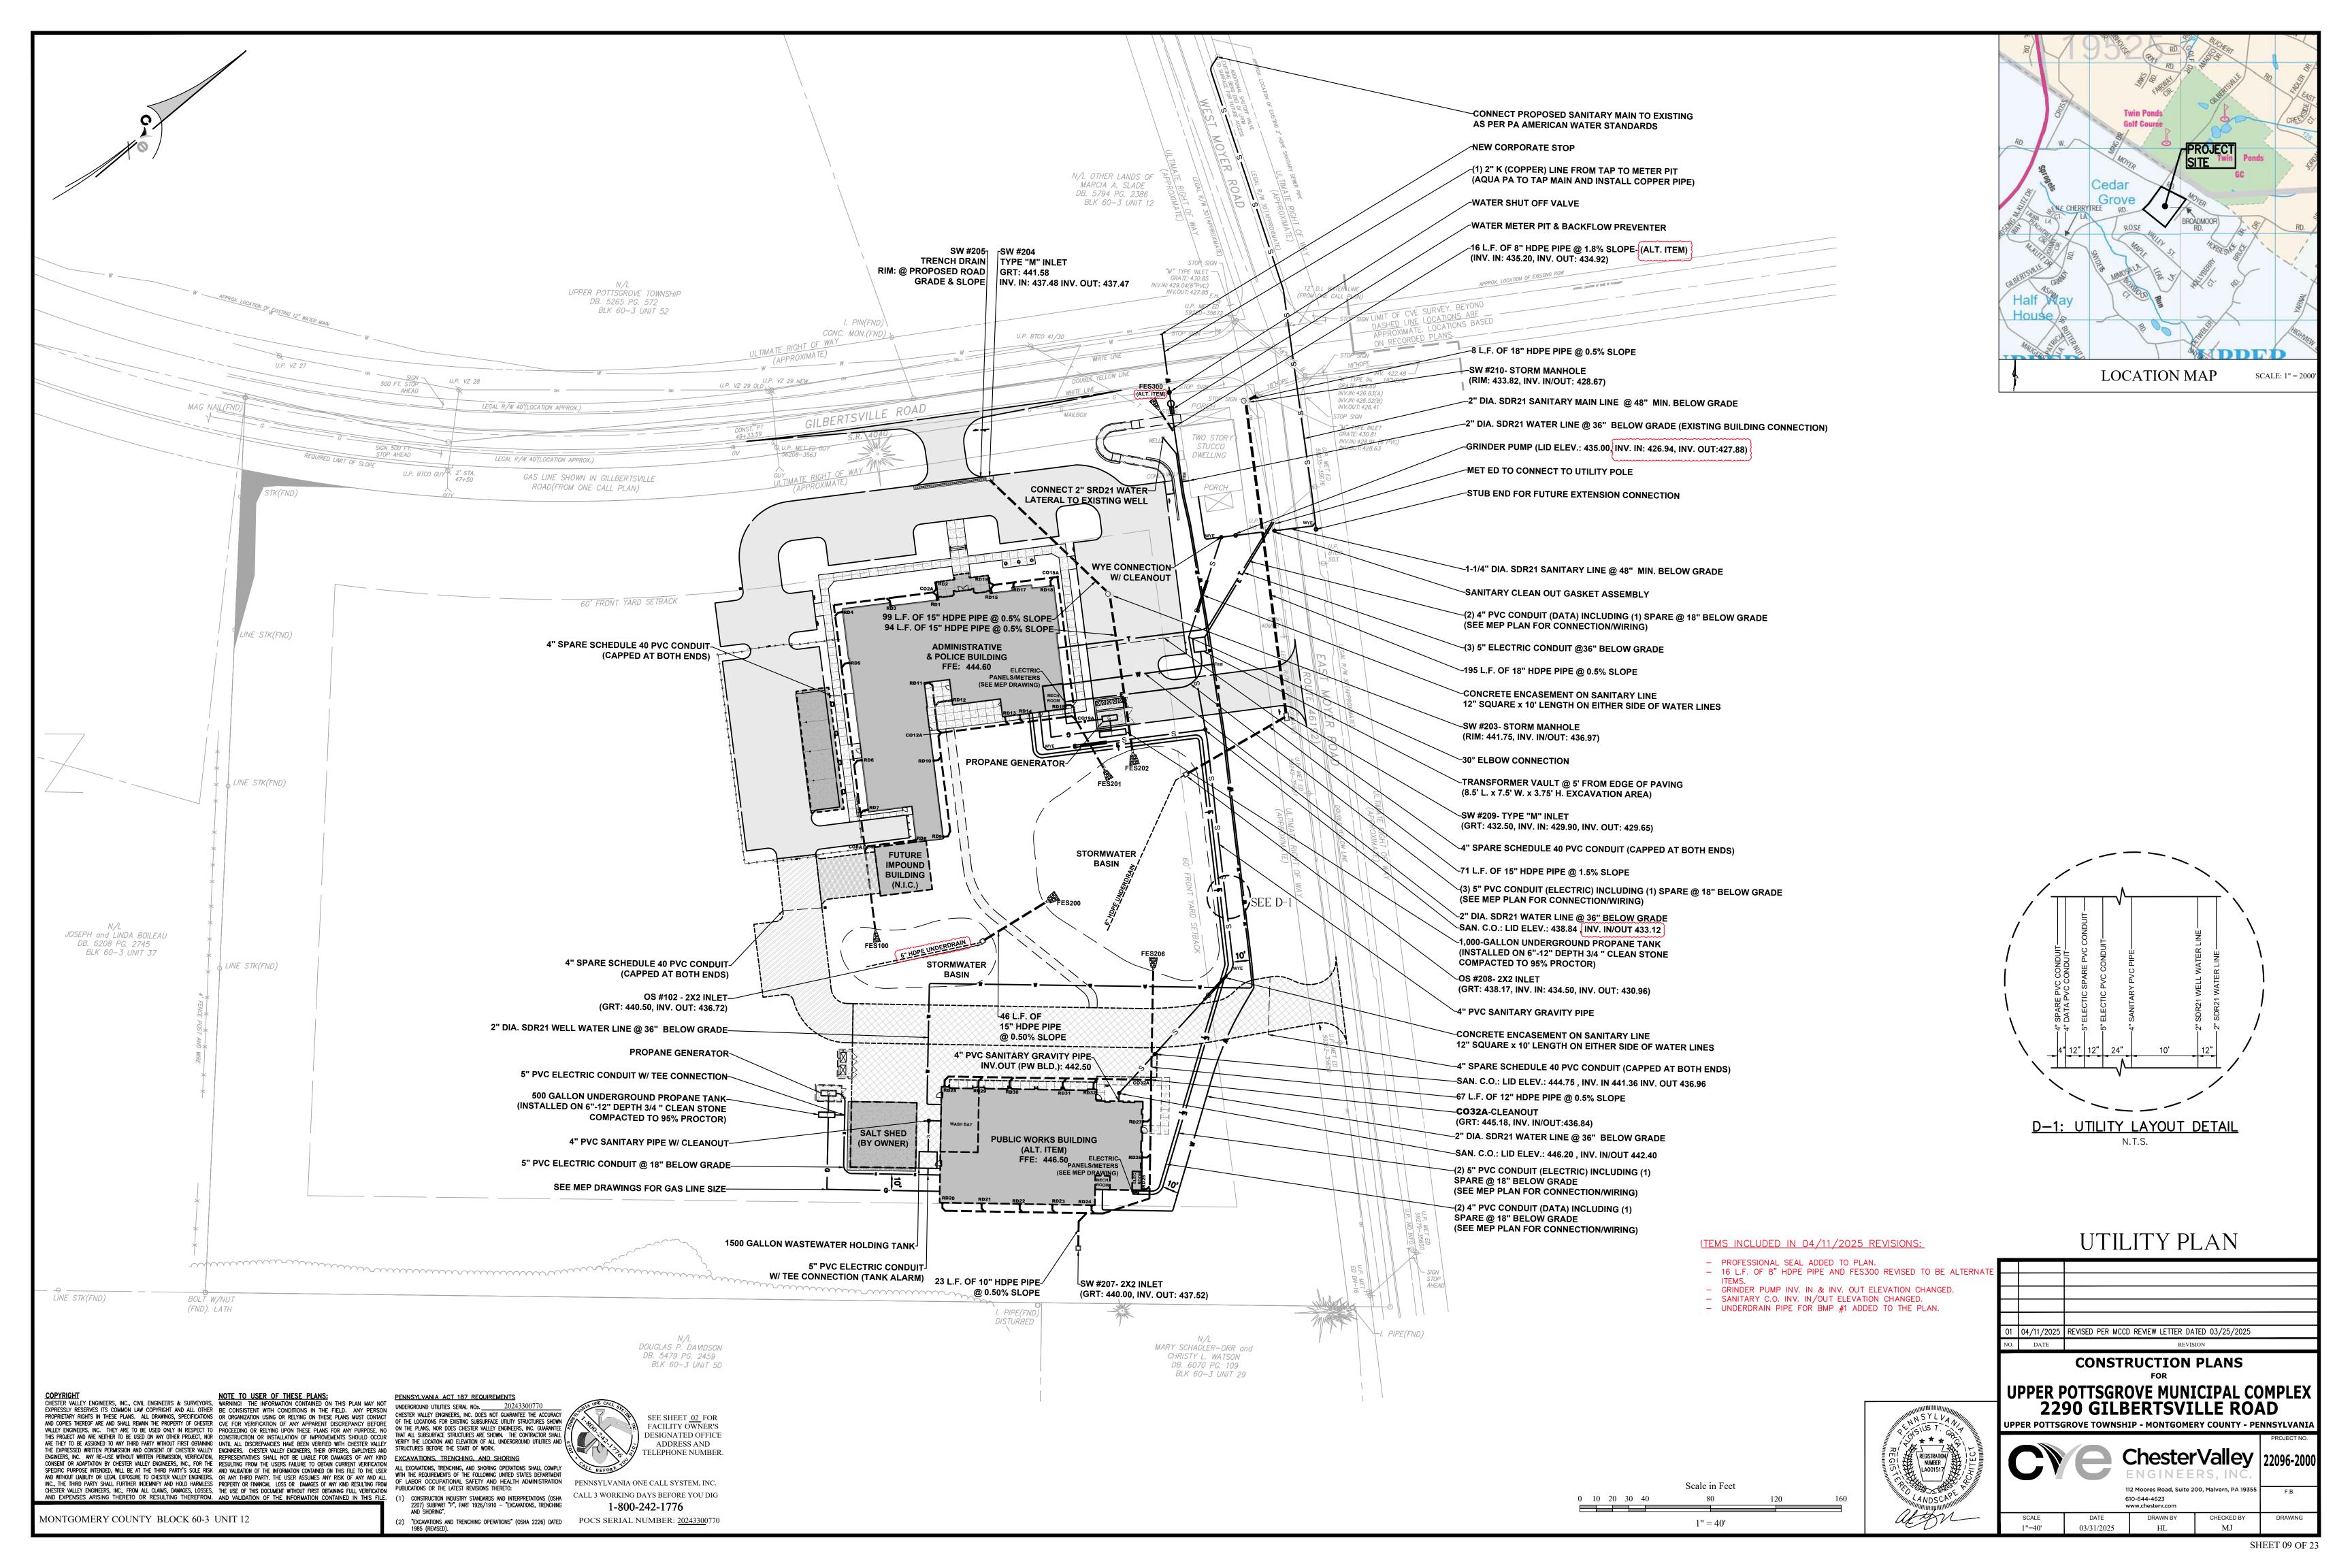


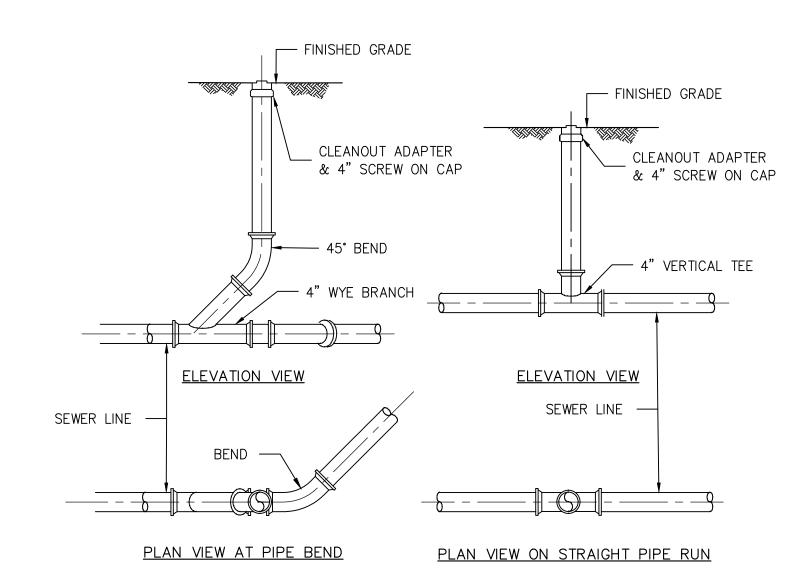

SANITARY CLEAN OUT DETAILS - GRAVITY PIPES

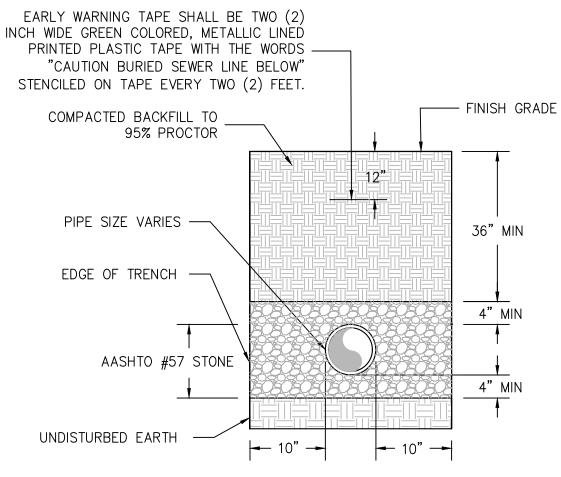


STANDARD SANITARY SEWER PIPE BEDDING DETAIL

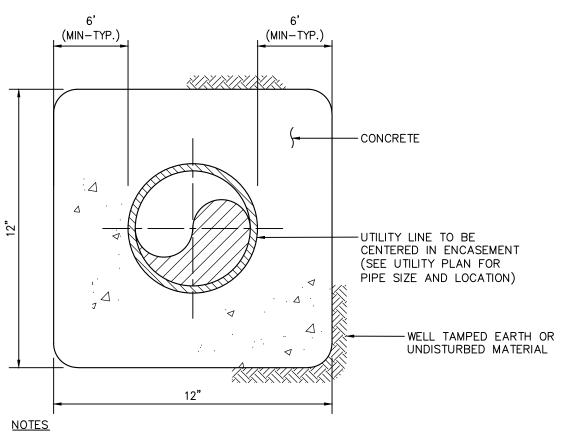


1. 20 FT. LONG ENCASEMENT SHALL BE CENTERED OVER CROSSING UTILITY.

UTILITY PIPE CONCRETE ENCASEMENT DETAIL

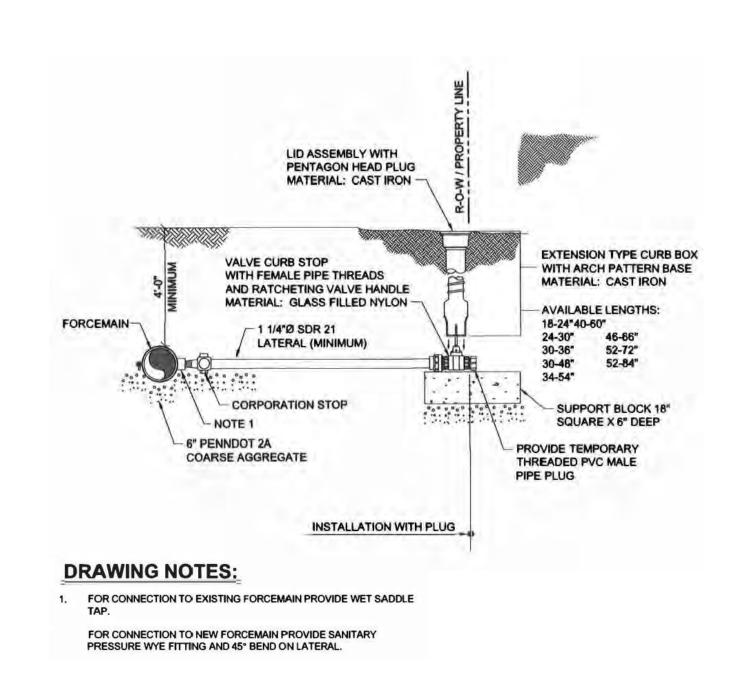

SANITARY FORCE MAIN DETAIL

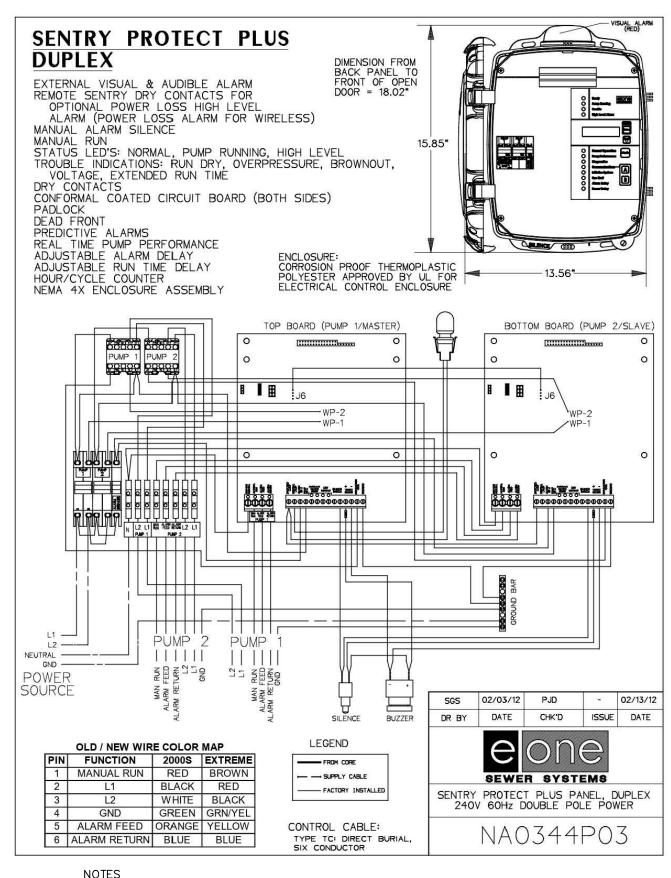

<u>NOTES</u>

MANUFACTURER: E-ONE SEWER SYSTEMS MODEL: SENTRY PROTECT PLUS PANEL, DUPLEX, 240V, 60Hz, DOUBLE POLE POWER

GRINDER PUMP ALARM PANEL DETAILS

DISCHARGE: 1-1/4 in FEMALE PIPE THREAD INLET: EPDM GROMMET FOR 4" DWV PIPE (STANDARD) CONTAINMENT DR BY CHK'D DATE ISSUE SCALE SEWER SYSTEMS MODEL DH152-129 NA0052P05 MANUFACTURER: E-ONE SEWER SYSTEMS MODEL: DH152-93 **GRINDER PUMP DETAILS** N.T.S. INSTALL CONTROL PANEL
IN THE EXISTING BUILDING BASEMENT - 1 1/470 BOR 2 CHECK VALVE ASSEMBLY -WYE CONNECTION TO POLICE/ADMIN. COAR SE AGGREGATE PUBLIC WORKS BUILDINGS

GRADE GRADE

444 . I.L . MXX

COVER OVER

DISCH

DH152-129

-FIELD ASSEMBLE-(16 PLACE)

-SIKA TAPE -FIELD LOCATE-

FIELD JOINT DETAIL

FOR FURTHER DETAILS

CONCRETE BALLAST MAY BE REQUIRED SEE INSTALLATION INSTRUCTIONS FOR DETAILS

NOTE: DIMENSIONS ARE FOR REFERENCE ONLY

GRADE MUST SLOPE AWAY FROM STATION

DRAWING NOTES: PROVIDE CONTINUOUS UPWARD SLOPE TO THE LATERAL ASSEMBLY

2. INSTALL CONCRETE AS REQUIRED TO PROPERLY ANCHOR THE UNIT. MINIMUM DIMENSIONS: 50 INCHES DIAMETER, AS HIGH AS THE FLUTED SECTIONS OF THE STATION, INSTALL TWO EMBEDDED LIFT HOOKS INTO THE TOP OF THE CONCRETE AT 180°.


TO PROVIDE THE MINIMUM 6-INCH CONCRETE FOUNDATION, PRECAST CONCRETE BASES MAY ALSO BE USED. THEY MUST BE AT LEAST 6 INCHES THICK BY 50 INCHES IN DIAMETER, AND CAST WITH AT LEAST 6 NUMBER 4 REBARS EXTENDING AT LEAST 4 INCHES (AND HOOKED) INTO THE BASE AND AT LEAST 8 INCHES (AND HOOKED) INTO THE COLLAR.

3. GRINDER PUMP SHALL BE SIZED TO EXCEED THE PRESSURE IN THE SANITARY SEWER FORCEMAIN.

GRINDER PUMP INSTALLATION DETAIL


UTILITY DETAILS (SANITARY)

SUMPS MAY BE CONNECTED TO THE SANITARY BEWER

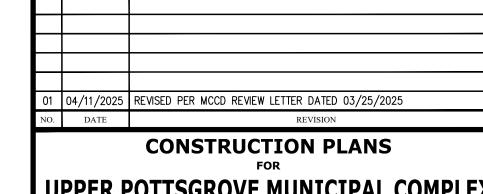



UPPER POTTSGROVE MUNICIPAL COMPLEX 2290 GILBERTSVILLE ROAD

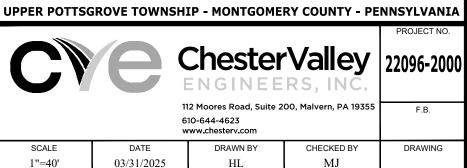

COPYRIGHT

CHESTER VALLEY ENGINEERS, INC., CIVIL ENGINEERS & SURVEYORS, EXPRESSLY RESERVES ITS COMMON LAW COPYRIGHT AND ALL OTHER PROPRIETARY RIGHTS IN THESE PLANS. ALL DRAWINGS, SPECIFICATIONS AND COPIES THEREOF ARE AND SHALL REMAIN THE PROPRETTY OF CHESTER VALLEY ENGINEERS, INC. THEY ARE TO BE USED ONLY IN RESPECT TO THIS PROJECT AND ARE NEITHER TO BE USED ON ANY OTHER PROJECT, NOR ARE THEY TO BE ASSIGNED TO ANY THIRD PARTY WITHOUT FIRST OBTAINING CONSENT OF ADAPTATION BY CHESTER VALLEY ENGINEERS, INC. 





MONTGOMERY COUNTY BLOCK 60-3 UNIT 12

SEE SHEET <u>02</u> FOR FACILITY OWNER'S DESIGNATED OFFICE ADDRESS AND TELEPHONE NUMBER. PENNSYLVANIA ONE CALL SYSTEM, INC. CALL 3 WORKING DAYS BEFORE YOU DIG


(2) "EXCAVATIONS AND TRENCHING OPERATIONS" (OSHA 2226) DATED POCS SERIAL NUMBER: $\underline{20243300}770$ 1985 (REVISED).

ITEMS INCLUDED IN 04/11/2025 REVISIONS:

- PROFESSIONAL SEAL ADDED TO PLAN.

- The contractor shall contact the Company prior to beginning work to discuss the details of the transformer foundation such as position, orientation, working clearances, barrier protection, construction specifications, and inspection procedures. The contractor is responsible for purchasing, as well as, installing, and maintaining the pre-cast transformer foundation and associated secondary rack equipment (if needed). The contractor/developer shall coordinate site preparations with the desired delivery date. The contractor shall provide a clear and firm (e.g., concrete, asphalt, or grasscrete) approach to within ten (10) feet of the point of delivery and keep the area clear of obstructions that may block the use of delivery vehicles or Company vehicles (e.g., crane access to the transformer).
- The developer/contractor is responsible for the excavation to install the transformer foundation and for backfilling afterward. The excavation shall be two (2) feet wider than the vault dimensions (shown Exhibit 25, page 2). The excavation depth shall be 45- inches deep for 42-inch high foundations bases or 57-inches deep for 54-inch high foundation bases. Six (6) inches of AASHTO #57 crushed stone shall be leveled and compacted in the bottom of the excavation as a base. Pavement (concrete, asphalt, or grass-crete) shall be provided to within ten (10) feet of the installation for Company trucks. The contractor should provide three (3) pieces of 4" X 4" X 8' lumber off to the side for temporarily unloading the foundation top at delivery time.
- Conduits shall enter near the corners of the foundation (refer to Exhibit 25, page 1) through knockouts to provide for proper cable bending radius and pulling set-up and to facilitate cable racking (when needed). Conduits shall have end bells and shall be terminated flush with the inside surface of the foundation. The customer/contractor shall re-mortar the knockout area around the conduit penetration into transformer foundation to prevent water migration.
- The developer/contractor will furnish and install all service cables as required per Exhibit 1. The developer /contractor shall allow sufficient slack, approximately five (5) feet, in the service lateral cables after they are racked. The slack allows the service cables to be trained so that the weight of the cables is supported by the cable racks and not supported by the transformer bushings. When requested, the developer /contractor shall supply and install cable racks (e.g., 30-inch rack made by A. B. Chance (Hubbell), using the inserts, on the side(s) of the foundation to support the service cables a minimum of 12 inches above floor level (per NEC Article 300.32). Refer to ANSI C135.35 for galvanized cable rack and hooks, and ASTM A153 for zinc coating (hot dip) on iron and steel hardware.
- The contractor shall seal around the service cables inside the conduits (with approved foam) to prevent migration of water or gases. All unused ducts shall also be caped. Backfill on all sides up to finish grade with 6" minimum of AASHTO #57 crushed stone to form a reservoir to contain the transformer oil in case of a leak.
- The contractor shall install a continuous loop of #2 bare, seven (7) strand, soft drawn copper ground wire connected to two (2) 5/8" X 8' ground rods installed in opposite corners of the vault excavation in undisturbed earth (refer to Exhibit 25, page 1). Both ends of the ground wire shall enter the foundation through a one (1) inch diameter hole to be drilled or chiseled in the upper right-hand corner of the knockout panel. Each ground wire tail shall extend fifteen (15) feet inside the vault beyond the knockout point.
- The decision to open the sump drainage or leave it closed will be made by the Company based on field conditions. The contractor is responsible for taking corrective action (improve drainage, sump pump, etc.) for a foundation that fills with water and water is leaking through service conduits into the customer's building. The area surrounding the foundation shall be graded so that ground water will
- The contractor shall install protective barriers when the transformer is located in an area exposed to vehicular traffic (refer to Exhibit 30), consult the Company for details.
- 0. The deeper base for the 1500-2000 kVA transformer is used when secondary conduit configuration requires a deeper wall to maintain NEC/NESC minimum cover over the conduit. . Foundation for 34.5 kV live-front transformer includes a six-inch thick dividing wall between the high voltage and the low voltage compartments centered 55-1/2" from the inside edge of the low voltage compartment side wall.


TRANSFORMER PRE-CAST CONCRETE FOUNDATION AND VAULT NOTES

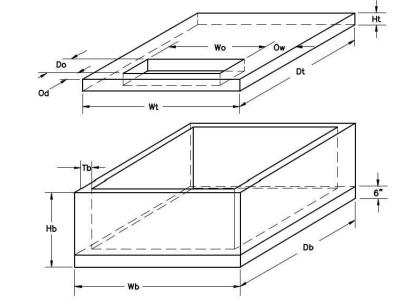

	-	— W	b —											
SELECTED														
	Pre-	Cast	Concr	ete T	rans	former Foo	undati	on Di	mens	sions				
Transformer	Found.			Bas	se				Тор		Op	ening	in T	ор
Size (kVA)	Code	Wb	DЬ	НЬ	ТЬ	WT.	Wt	Dt	Ht	WT.	Wo	Do	Ow	0
			22,94	O Gr	1/YL	4,400 Volt	& B	elow		H-		1		
45 - 150	J1	72"	54"	42"	4"	4,275#	72"	54"	6"	1,725#	55"	14"	8.5"	6
225 - 1000	J2	78"	66"	42"	4"	8,000#	78"	66"	6*	2,400#	60"	19"	9"	6
1500 - 2500	J3	96"	96"	42"	6"	12,000#	96"	96"	9"	6,400#	60"	19"	18"	9
00 - 2500 (Note 7)	J4	96"	96"	54"	6"	14,000#	96"	96"	9"	6,400#	60"	19"	18"	9
				34,50	0 Gr	dY/19,920	Volt							
1500 - 2500	J3	96"	96"	42"	6"	12,000#	96"	96"	9"	6,400#	60"	19"	18"	9
00 - 2500 (Note 7)	J4	96"	96"	54"	6	14,000#	96"	96"	9"	6,400#	60"	19"	18"	9
	34,500	Delta	yolt	Live	-Fro	nt (Include	s CEI	36	kV S	ystem)				
Il Sizes (Note 8)	J5	1.38"	120"	54"	6"	24.655#	138"	120"	9"	10.270#	102"	36"	18"	18

All Sizes (Note 8)	J5 1	38" 120" 54" 6"	24,655# 138" 12	9" 10,270#	102" 36" 18" 1	
Pre-Co	st Concr	ete Transformer F	oundation — Excav	ation Dimensions		
Transformer	Found.	Width	Depth	Height	Stone Base	
Size (kVA)	Code		Борин	riolgite	Otolio Baco	
		22,940 GrdY/	14,400 Volt & Belo	w		
45 - 150	J1	96"	78"	45"	6"	
225 - 1000	J2	102"	90"	45*	6"	
1500 - 2500	J3	120"	120"	45"	6*	
1500 - 2500 (Note 7)	J4	120"	120"	57"	6*	
		34,500 0	rdY/19,920 Volt	-	÷	
1500 - 2500	J3	120"	120"	45"	6"	
1500 - 2500 (Note 7)	J4	120"	120"	57"	6"	
	34,500	Delta Volt Live-Fr	ont (Includes CEI 3	6 kV System)		
All Sizes (Note 8)	J5	162"	144"	57"	6"	

TRANSFORMER PRE-CAST CONCRETE FOUNDATION AND VAULT DETAIL

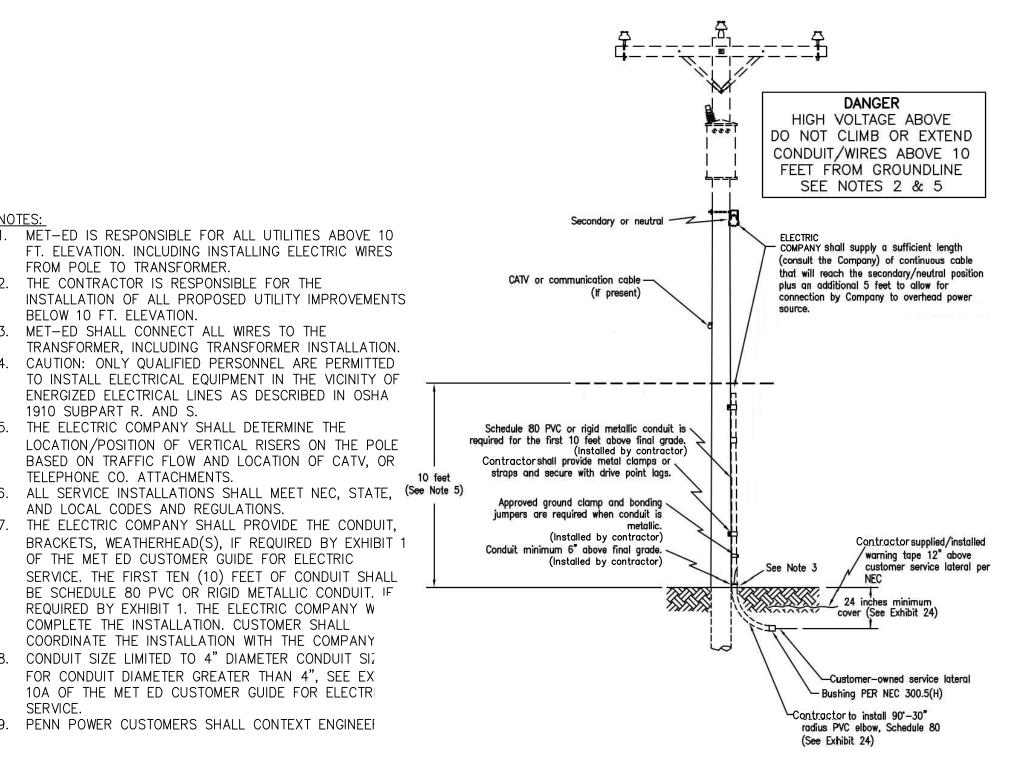

DIRECT ATTCHEMENT OF CUSTOMER-OWNED UNDERGROUND SECONDARY SERVICE LATERAL(S) ON PA OPERATING COMPANY'S POLES DETAIL

N.T.S.

EXPRESSLY RESERVES ITS COMMON LAW COPYRIGHT AND ALL OTHER
PROPRIETARY RIGHTS IN THESE PLANS. ALL DRAWINGS, SPECIFICATIONS

OR ORGANIZATION USING OR RELYING ON THESE PLANS MUST CONTACT AND WITHOUT LIABILITY OR LEGAL EXPOSURE TO CHESTER VALLEY ENGINEERS, OR ANY THIRD PARTY. THE USER ASSUMES ANY RISK OF ANY AND ALL INC., THE THIRD PARTY SHALL FURTHER INDEMNIFY AND HOLD HARMLESS PROPERTY OR FINANCIAL LOSS OR DAMAGES OF ANY KIND RESULTING FROM CHESTER VALLEY ENGINEERS, INC., FROM ALL CLAIMS, DAMAGES, LOSSES, THE USE OF THIS DOCUMENT WITHOUT FIRST OBTAINING FULL VERIFICATION AND EXPENSES ARISING THERETO OR RESULTING THEREFROM. AND VALIDATION OF THE INFORMATION CONTAINED IN THIS FILE.

MONTGOMERY COUNTY BLOCK 60-3 UNIT 12

FROM POLE TO TRANSFORMER.

BELOW 10 FT. ELEVATION.

1910 SUBPART R. AND S.

SERVICE.

TELEPHONE CO. ATTACHMENTS.

AND LOCAL CODES AND REGULATIONS.

2. THE CONTRACTOR IS RESPONSIBLE FOR THE

6. MET-ED SHALL CONNECT ALL WIRES TO THE

5. THE ELECTRIC COMPANY SHALL DETERMINE THE

OF THE MET ED CUSTOMER GUIDE FOR ELECTRIC

COMPLETE THE INSTALLATION. CUSTOMER SHALL

8. CONDUIT SIZE LIMITED TO 4" DIAMETER CONDUIT SIZ

9. PENN POWER CUSTOMERS SHALL CONTEXT ENGINEE!

REQUIRED BY EXHIBIT 1. THE ELECTRIC COMPANY W

COORDINATE THE INSTALLATION WITH THE COMPANY

FOR CONDUIT DIAMETER GREATER THAN 4", SEE EX

10A OF THE MET ED CUSTOMER GUIDE FOR ELECTR

ENERGIZED ELECTRICAL LINES AS DESCRIBED IN OSHA

PENNSYLVANIA ACT 187 REQUIREMENTS UNDERGROUND UTILITIES SERIAL NOs CHESTER VALLEY ENGINEERS INC. DOES NOT CHARANTEE THE ACCURACY AND COPIES THEREOF ARE AND SHALL REMAIN THE PROPERTY OF CHESTER VALLEY ENGINEERS, INC. THEY ARE TO BE USED ONLY IN RESPECT TO PROCEEDING OR RELYING UPON THESE PLANS FOR ANY PURPOSE. NO. ON THE PLANS, NOR DOES CHESTER VALLEY ENGINEERS, INC. GUARANTEE PLANS FOR ANY PURPOSE. NO. ON THE PLANS, NOR DOES CHESTER VALLEY ENGINEERS, INC. GUARANTEE PLANS FOR ANY PURPOSE. VALLEY ENGINEERS, INC. THEY ARE TO BE USED ON ANY OTHER PROJECT, NOR
THIS PROJECT AND ARE NEITHER TO BE USED ON ANY OTHER PROJECT, NOR
ARE THEY TO BE ASSIGNED TO ANY THIRD PARTY WITHOUT FIRST OBTAINING
THE EXPRESSED WRITTEN PERMISSION AND CONSENT OF CHESTER VALLEY
ENGINEERS, INC. ANY RE-USE WITHOUT WRITTEN PERMISSION, VERIFICATION,
CONSENT OR ADAPTATION BY CHESTER VALLEY ENGINEERS, INC., FOR THE
SPECIFIC PURPOSE INTENDED, WILL BE AT THE THIRD PARTY'S SOLE RISK
AND WITHOUT HABILITY OF LEGAL EXPOSIBLE TO CHESTER, VALLEY ENGINEERS.

PROJECTION OR INSTALLATION OF IMPROVEMENTS SHOULD OCCUR
UNTIL ALL DISCREPANCIES HAVE BEEN VERIFIED WITH CHESTER VALLEY



STRUCTURES BEFORE THE START OF WORK.


EXCAVATIONS, TRENCHING, AND SHORING OPERATIONS SHALL COMPLY
WITH THE REQUIREMENTS OF THE FOLLOWING UNITED STATES DEPARTMENT WITH THE REQUIREMENTS OF THE FOLLOWING UNITED STATES DEPARTMENT

OF LABOR OCCUPATIONAL SAFETY AND HEALTH ADMINISTRATION CONSTRUCTION INDUSTRY STANDARDS AND INTERPRETATIONS (OSHA (2) "EXCAVATIONS AND TRENCHING OPERATIONS" (OSHA 2226) DATED POCS SERIAL NUMBER: 20243300770 1985 (REVISED).


FACILITY OWNER'S DESIGNATED OFFICE ADDRESS AND TELEPHONE NUMBER. PENNSYLVANIA ONE CALL SYSTEM, INC

CALL 3 WORKING DAYS BEFORE YOU DIG


SEE SHEET <u>02</u> FOR

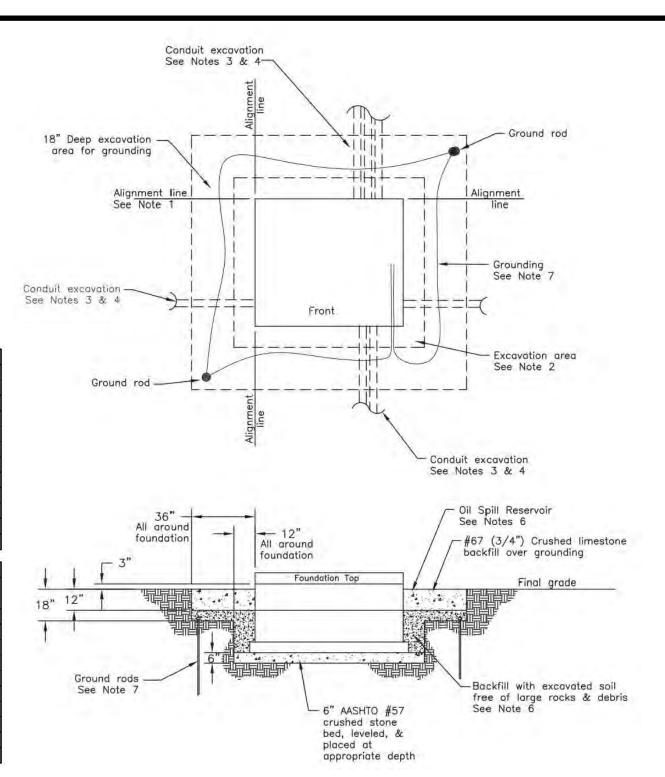

TRANSFORMER PRE-CAST CONCRETE FOUNDATION AND VAULT DETAIL

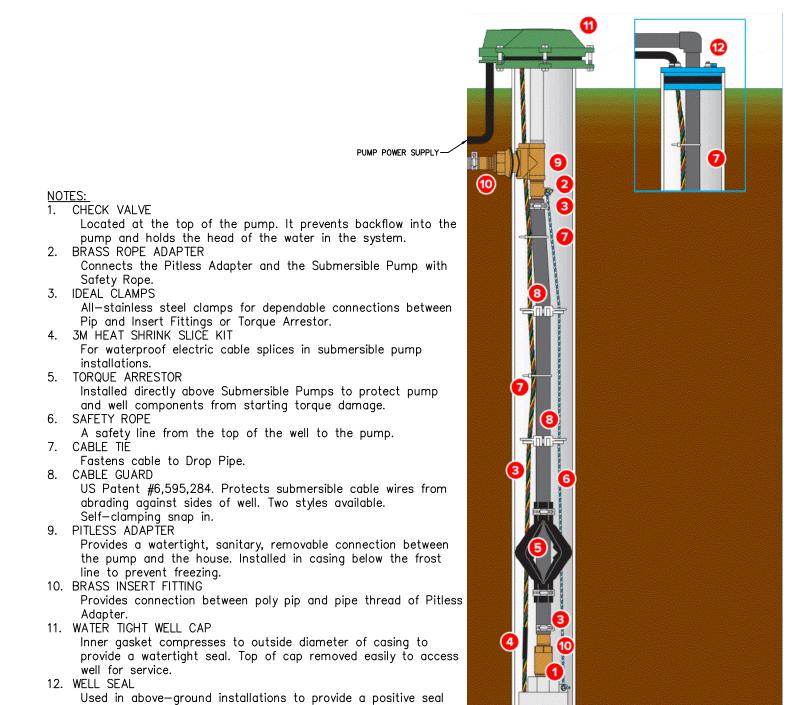


WELL WATER CONNECTION DETAIL

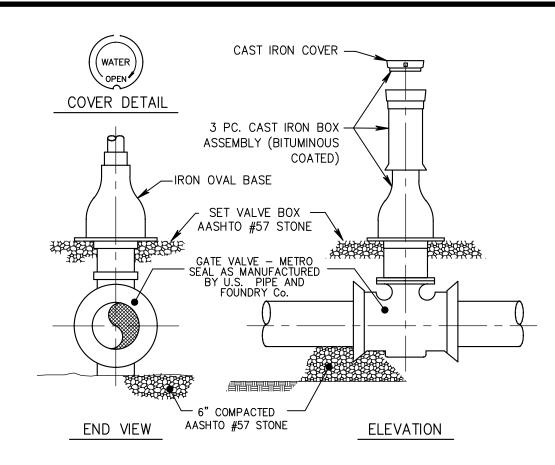


- 1. FOR STANDARD 2" CONNECTION, PROVIDE A TAPPED COUPLING WITH THREADED INSERT OR DOUBLE-STRAPPED SADDLE CLAMP.
- 2. DO NOT PLACE CURB BOX IN PAVED AREAS. 3. ALL SERVICE CONNECTIONS SHALL BE LOCATED AT THE MIDPOINT
- BETWEEN SIDE LOT LINES. 4. WHERE SIDEWALK PARALLELS ROADWAY, THE CURB BOX SHALL BE PLACED BETWEEN THE CURB AND SIDEWALK. ALL OTHER LOCATIONS, CURB BOX TO BE PLACED WHERE DIRECTED BY AUTHORITY.

GATE VALVE DETAILS

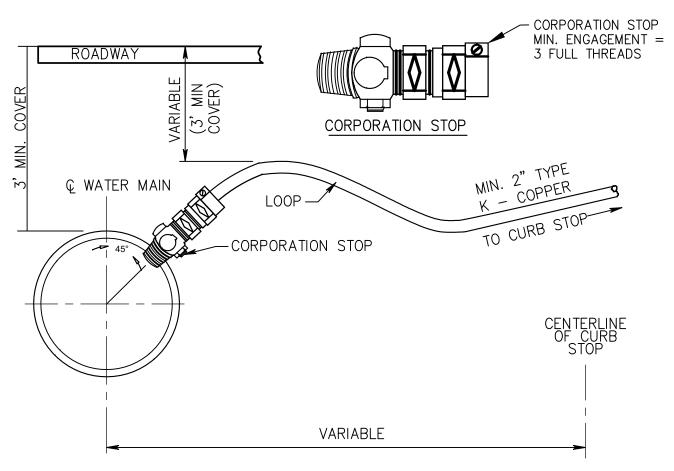

- 1. FOR STANDARD 2" CONNECTION, PROVIDE A TAPPED COUPLING WITH THREADED INSERT OR DOUBLE-STRAPPED SADDLE CLAMP.
- 2. DO NOT PLACE CURB BOX IN PAVED AREAS. 3. ALL SERVICE CONNECTIONS SHALL BE LOCATED AT THE MIDPOINT BETWEEN SIDE LOT
- 4. WHERE SIDEWALK PARALLELS ROADWAY, THE CURB BOX SHALL BE PLACED BETWEEN THE CURB AND SIDEWALK. ALL OTHER LOCATIONS, CURB BOX TO BE PLACED WHERE DIRECTED BY AUTHORITY.


CORPORATION STOP DETAILS

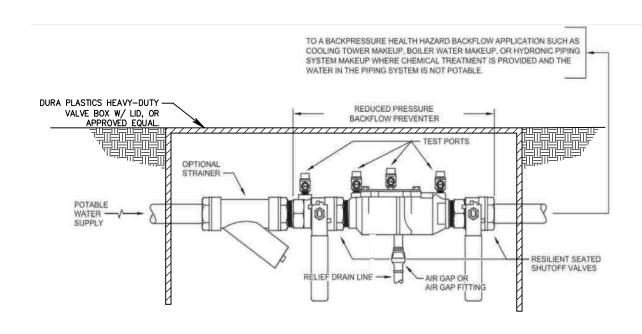

- Double check valve assemblies are not permitted for health hazard applications. 2. RP devices must not be installed in a pit or other area subject to flooding. The relief vent will create a
- cross connection if submerged.
- 3. If occasional spillage from the relief vent will cause damage or be a nuisance, the vent must be equipped with an air gap fitting and indirectly drained to an acceptable point of disposal.

BACKFLOW PREVENTER DETAILS - IN METER PIT

ITEMS INCLUDED IN 04/11/2025 REVISIONS: - PROFESSIONAL SEAL ADDED TO PLAN.

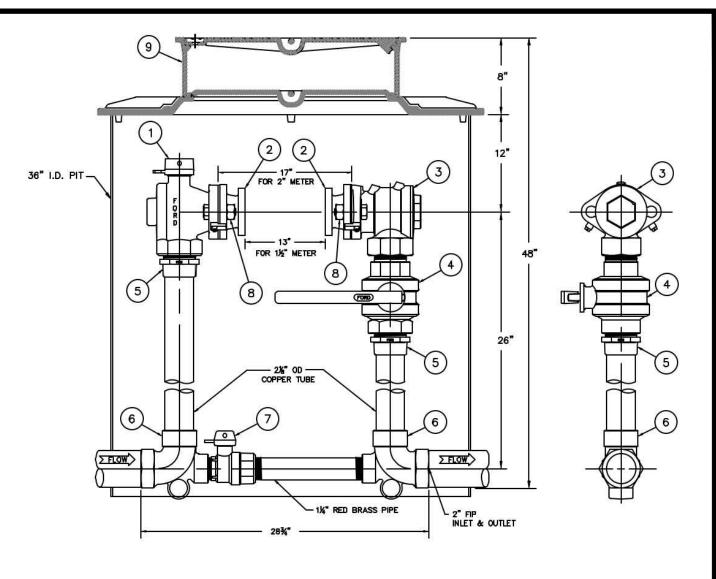


6. MARK INLET, OUTLET, & DIRECTION OF FLOW ON UNIT.

7. ALL BRASS OF 85-5-5-5 RED BRASS AWWA C800-89 ASTM 862-93.

- 5. DOMESTIC SERVICE REGIRES BACKFLOW DEVICE, BACKFLOW DEVICE TO BE LOCATED ON SERVICE LINE AT ENTRY POINT INTO BLDG. BEFORE ANY CONNECTIONS
- QTY. CAT. NO. BFAX3-777W-MSB ANGLE BALL VALVE ASSE 1024 1 HFFA3X-777-MSB BXX-777-HB-67 4 BALL VALVE CS8-77 5 SOLDER BUSHING 2 CSTEE-7B-T 6 TEE 7 BALL VALVE BXX-455W B BOLT & NUT / PR g MONITOR COVER W/ INNER LID * 1 MC-36-MB

* ORDERED SEPARATELY

WATER METER PIT DETAIL

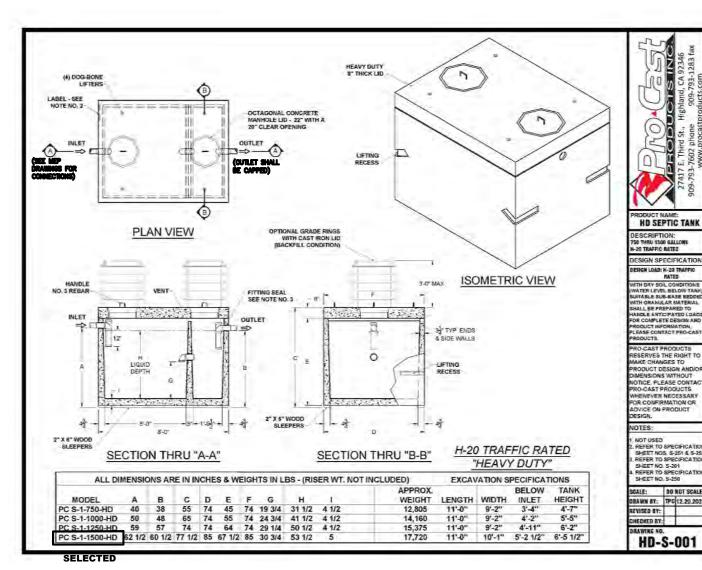


REGISTRATION NUMBER LAOO1517

alton

- 1. TANK SHALL BE INSTALLED SUBSURFACE AND SHALL BE H-20 TRAFFIC RATED "HEAVY DUTY". 2. BACK FILLING SHALL BE 8" LIFTS TO 95% COMPACTION WITH NATIVE SOIL.
- 3. TANKS TO BE INSTALLED AS PER MANUFACTORIES' SPECIFICATIONS.

HOLDING TANK DETAIL

UTILITY DETAILS (WATER & ELECTRIC)

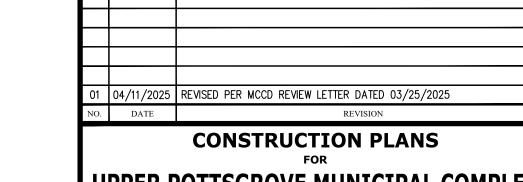


UPPER POTTSGROVE MUNICIPAL COMPLEX






SHEET 11 OF 23

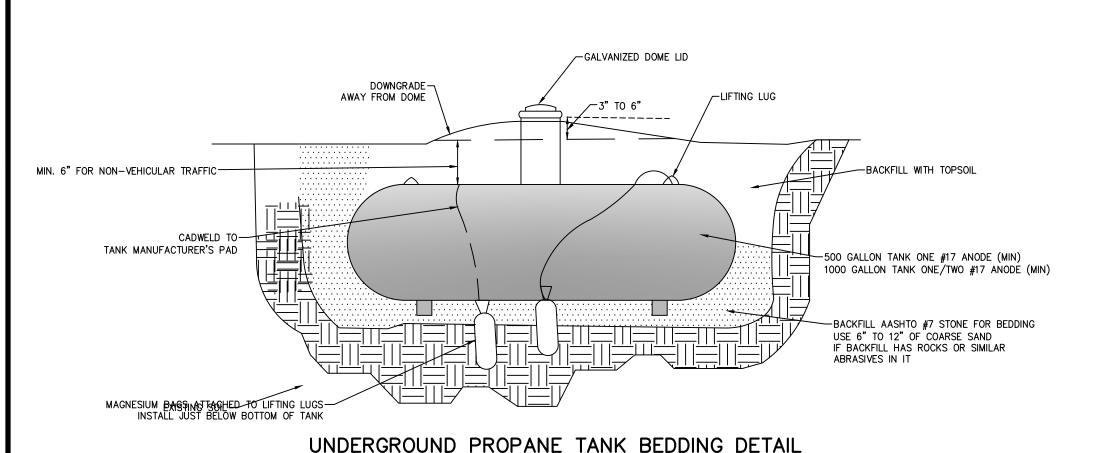

PROVIDE #5 REINFORCEMENT BAR_ AROUND PERIMETER OF FOUNDATION —24" MIN LAP----- 3' PUBLIC WORKS GENERATOR ADMIN /POLICE GENERATOR 34" CHAMFER ALL_ EXPOSED CORNERS -LIMIT OF GENERATOR CONDUIT ENTRY AREA -FOR GENERATOR LOAD LEADS (BOTTOM ENTRY) GENERATOR عرصہ کے نے کے نے بیان کے نے نے بیان کے نے بیان کے نے ا PROVIDE #5 REINFORCEMENT BAR

CONTRACTOR TO VERIFY THE CONDUIT STUB-UP AREAS, CONDUIT ENTRY AREA AND GENERATOR DIMENSIONS PRIOR TO PLACING CONCRETE.

PLAN VIEW GENERATOR SLAB

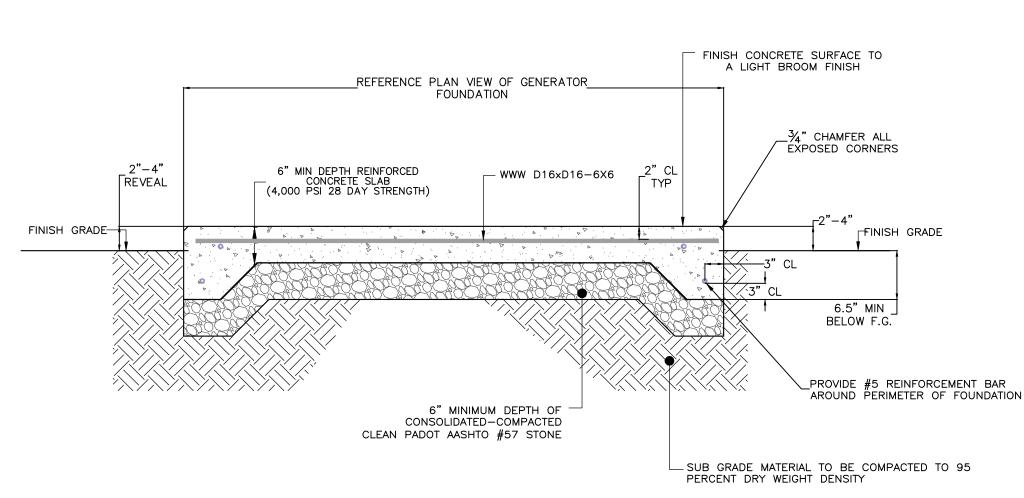

SECTION A-A GENERATOR SLAB (POLICE/ADMIN)

COPYRIGHT

CHESTER VALLEY ENGINEERS, INC., CIVIL ENGINEERS & SURVEYORS, EXPRESSLY RESERVES ITS COMMON LAW COPYRIGHT AND ALL OTHER PROPERTY PICHTS IN THESE PLANS. ALL DRAWINGS, SPECIFICATIONS AND COPIES THE FLANS. 

EXCALATIONS. TRENCHING.

AND VALIDATION OF THE INFORMATIO

MONTGOMERY COUNTY BLOCK 60-3 UNIT 12

(2) "EXCAVATIONS AND TRENCHING OPERATIONS" (OSHA 2226) DATED POCS SERIAL NUMBER: $\underline{20243300}770$ 1985 (REVISED).

SEE SHEET 02 FOR FACILITY OWNER'S DESIGNATED OFFICE ADDRESS AND TELEPHONE NUMBER. PENNSYLVANIA ONE CALL SYSTEM, INC CALL 3 WORKING DAYS BEFORE YOU DIG

AROUND PERIMETER OF FOUNDATION

STANDBY POWER RATING




<u>NOTES</u>


MANUFACTURER: GENERAC MODEL: PROTECTOR SERIES, RG10090- 100 kW, 60Hz EMERGENCY

STANDY POWER GENERATOR

GAS GENERATOR BOX DETAIL

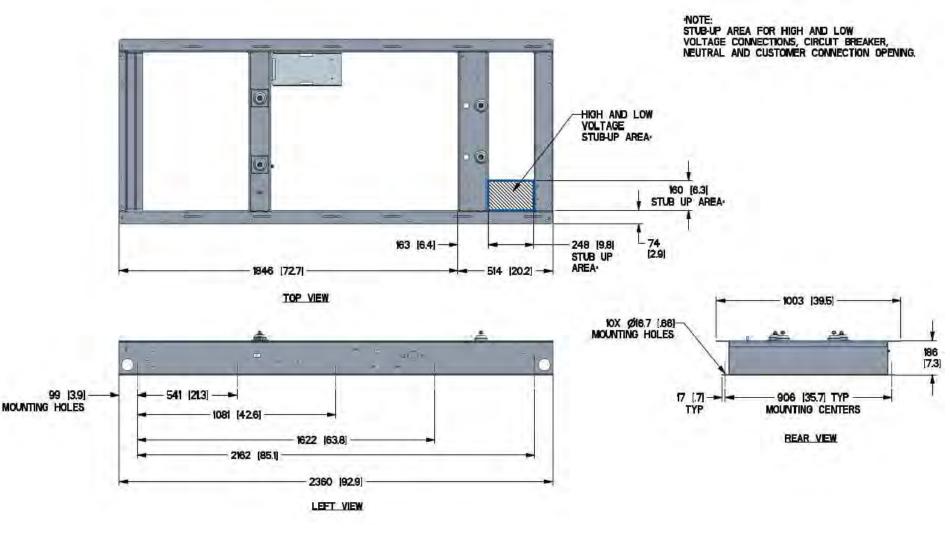

GAS GENERATOR INSTALLATION LAYOUT DETAIL

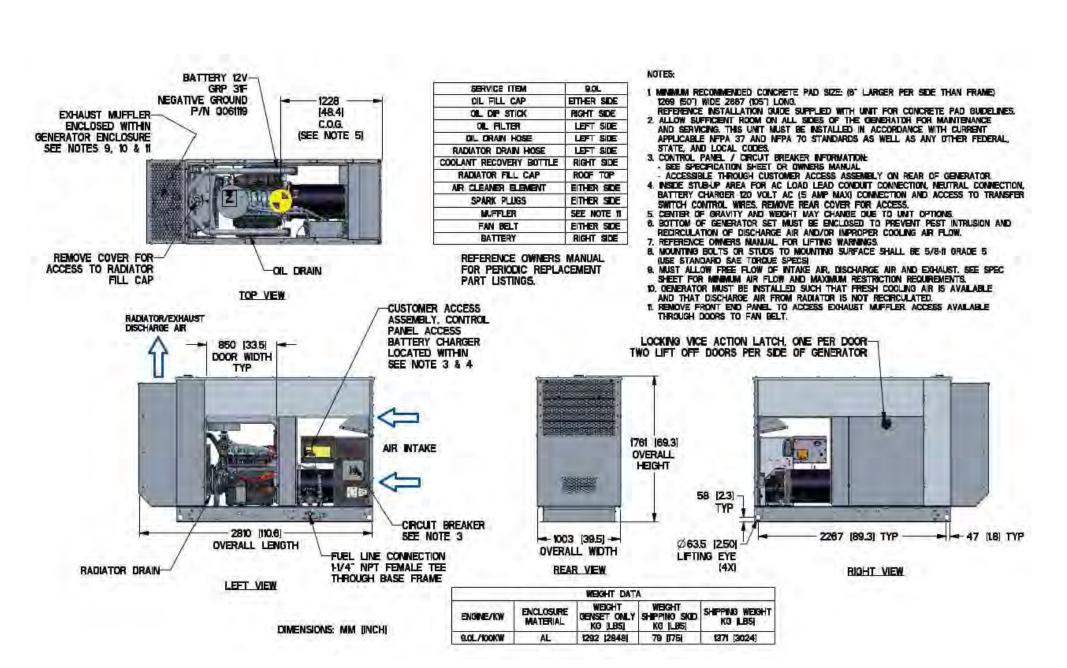

GAS GENERATOR INSTALLATION LAYOUT DETAIL

Company's approval.

construction are completed.

- 1. Contractor shall provide trenching, conduit, and backfill to Company specifications.
- 2. The contractor shall contact the Company for placement of both Company and customer electrical
- facilities and the approved trench route for connecting them. 3. The contractorshall not deviate from the Company's approved trench route unless expressly approved in writing by the Company's engineering group representative. It shall be the contractor's responsibility to notify the Company of any conflicts that the proposed electrical design creates with obstacles, other facilities, or easements. Changes requested following the design acceptance by the contractor may require the Company to be compensated
- if facilities need to be relocated or project delays 4. Before excavation begins, the excavator shall mark the proposed facilities (in white) and then notify the appropriate state One-Call agency to mark other underground facilities (refer to Sections 3.13 and 3.14).
- 5. The contractor shall also coordinate the installation of all other buried utilities that are installing their facilities nearby, jointly occupying the trench (with Company approval), or crossing the electrical supply trench.
- 6. Below are the Company's required minimum clearances between electric supply lines and the following utility lines: • Steam or cryogenic lines - six (6) feet (use of an approved thermal barrier may reduce this clearance).
- · Fuel lines: four (4) feet for low-pressure natural gas, oil, propane, or other like fuels or ten (10) feet for gas lines that are high-pressure lines or are greater than four (4) inches in diameter.
- Water, sewer, and telecommunication (i.e., telephone & CATV) lines one (1) foot.
- · Clearances from telephone and CATV lines may be reduced to zero (0) feet or no deliberate separation (a.k.a. - random lay) if all involved parties agree and NESC [2017] Rule 354 is met.
- Other utility companies (e.g., local steam, water, communication, sewer, and fuel companies) may require greater clearances than stated above. • If required clearances cannot be met (e.g., trenching through solid rock), clearances may be reduced to one (1)
- foot minimum if all involved parties agree. Other facilities are prohibited from running above/below and parallel to the electrical cable without specific
- 7. The Company's minimum cover requirements for the primary (>600 V) and secondary (<600 V) conduits are based on providing adequate cover per NESC Code (depth). It shall be the responsibility of the customer to ensure that the minimum required coverages over the conduits are always maintained. Any necessary corrections to the depth of cover or required mechanical protection to prevent damage to the conduits from surface activity shall be the responsibility of the customer. Minimum cover over the conduits shall be maintained until all stages of the

Minimum Cover Requirements


VoltageV (Φ- Φ)	Over Conduit(s)
< 600 V	24 inches
> 600 V to 50 kV	30 inches

- 8. When primary (> 600 V to 50 kV) and secondary (< 600 V) conduits share the same trench and are located side-by-side, the depth of cover for both conduits shall be to the primary conduit requirement with a minimum of two (2) inches of separation. If the conduits are stacked, the primary conduit(s) shall be on the bottom at the required primary depth. The secondary/service conduit(s) shall be on top of the primary conduit(s) with a minimum separation of two (2) inches between the conduits.
- 9. See Exhibit 24, page 1 for details on the trench dimensions (width and depth requirements). Contractor shall contact the Company representative if the trench must be more than four (4) feet deep.

- 10. The contractor shall clear the cable route of trees, tree stumps, boulders, or other obstructions at and below grade. The excavator shall grade the trench route to final grade level. The contractor shall be responsible for any damage caused by the excavator. This includes damage to any tree whose root system is subsequently damaged from the trenching operations. The excavator shall grade all trench routes to final
- 11. The contractor shall not use power-excavating equipment within 18 inches of any existing buried cables or other electrical or communications facilities.
- 12. Excavated material ("spoils") should be placed on the field side of the trench (unless directed by the Company otherwise), two (2) feet from the edge of excavations (per OSHA Standard 1926.651(j) (2)).
- 13. Standing water in the trench should be removed by pumping or draining (per OSHA Standard 1926.651(h)). 14. The bottom of the trench shall be relatively smooth, undisturbed earth, sand, or well-tamped earth which is free of rock, cinders, or sharp objects. Trench excavations in rocky soil may require a two-inch layer of select backfill on the bottom of the trench as determined by the Company.
- 15. Buried conduits shall be rigid PVC, heavy wall, sunlight resistant, listed and labeled, Schedule 40 conduit per NEMA TC2 (i.e., electrical grade). Additional requirements, such as concrete encasement of elbows or galvanized steel elbows, may be specified by the Company based on the specific design parameters of the conduit system and will be detailed in the electrical layout drawing. Contractor shall contact the Company for the proper minimum conduit diameters.

Conduit Requirements Conduit Size | Conduit Type | Conduit Bend Radius UTILITY POLE TO-6"-8" Sch40 PVC Sch40 PVC TRANSFORMER TO BUILDINGS Sch40 PVC

- 16. Customer-owned service lateral conduits (if used) shall be sized per NEC. Those conduits shall be supplied, installed, and covered by the contractor. Conduit for service laterals shall be a minimum of 3-inch diameter
- 17. Secondary/service conduit elbows shall have a minimum radius of 30 inches. Service riser conduit shall be rigid PVC, heavy wall, sunlight resistant, listed and labeled, Schedule 80 conduit per NEMA TC2. Primary conduit elbows shall have a minimum radius of 36 inches for sizes from 3" to 5". For conduits 6 inch and
- larger, the elbows shall have a minimum radius of 48 inches. 18. All joints shall be glued together. Conduit shall be cleaned and confirmed with a mandrel 1/2 inch smaller than the conduit inside diameter. Unused conduits shall be plugged at each end to keep water and dirt out. When conduit runs are greater than twenty (20) feet, a 1/4-inch unbroken nylon or polypropylene pulling rope shall be installed in each conduit. If the Company cannot pull conductors through the conduit run, or if the pulling rope is broken or unusable because it is glued to the conduit, the contractor shall make the necessary
- 19. Before backfilling, the contractor shall verify that the Company and local electrical inspector have completed all required inspections of the trench and conduit. In addition, the customer shall verify other utilities that were approved to use joint trench have completed their work.
- 20. The contractor shall backfill around all conduits with six (6) inches of select backfill. Select backfill shall be graded sand, stone dust, limestone dust, rock free earth or topsoil. Materials that "set up" such as fly ash, culm and foundry waste are not acceptable. The remainder of the trench shall be backfilled with native soil and not contain large rocks (greater than two (2) inch diameter), rocks with sharp edges or other debris. An additional six (6) inches of mounded backfill is recommended to allow for settling.
- 21. Backfill should be compacted in six-inch layers by hand or using a pneumatic or vibrating tamping equipment to lessen the effects of settling. Note: machine compaction should not be used within six inches of the conduit (per NESC Rule 353A). Do not run wheels or tracks of equipment along the trench to compact the backfill as this could damage the conduits.
- 22. The contractor shall provide and bury a red "electrical" warning tape at least three (3) inches wide directly above all conduits twelve (12) inches below final grade as shown in Exhibit 24 (refer to NEC 300.5(D)(3).
- 24 For cables located beneath roads under PennDOT jurisdiction, cables shall be installed in conduit, have a minimum of 36 inches of cover, and shall be completely backfilled with #2 RC aggregate.

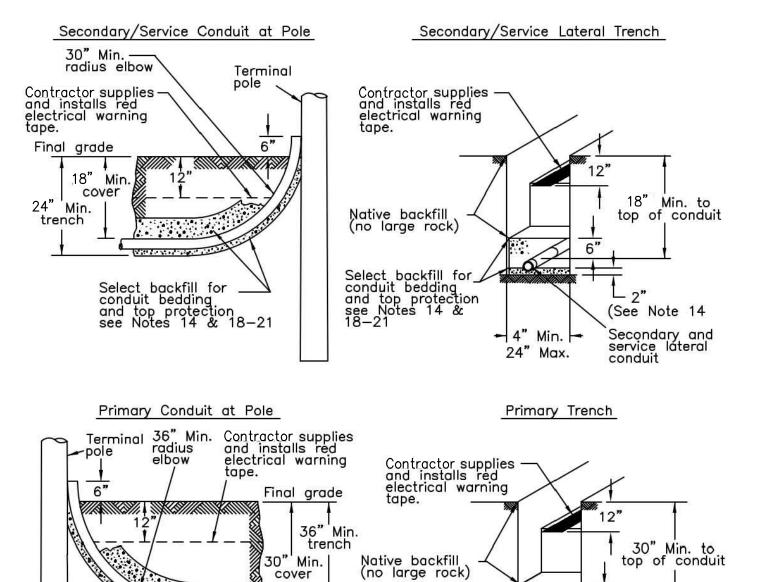



Select backfill for conduit bedding and top protection See Notes 14 & 18-21

ITEMS INCLUDED IN 04/11/2025 REVISIONS:

PROFESSIONAL SEAL ADDED TO PLAN




Select backfill for— conduit bedding and top protection

UTILITY DETAILS (ELECTRIC & GAS)

(See Note 14)


24" Max.

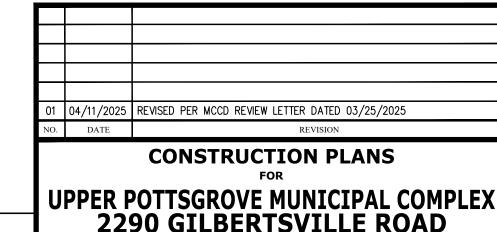


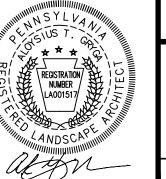


2290 GILBERTSVILLE ROAD JPPER POTTSGROVE TOWNSHIP - MONTGOMERY COUNTY - PENNSYLVANIA



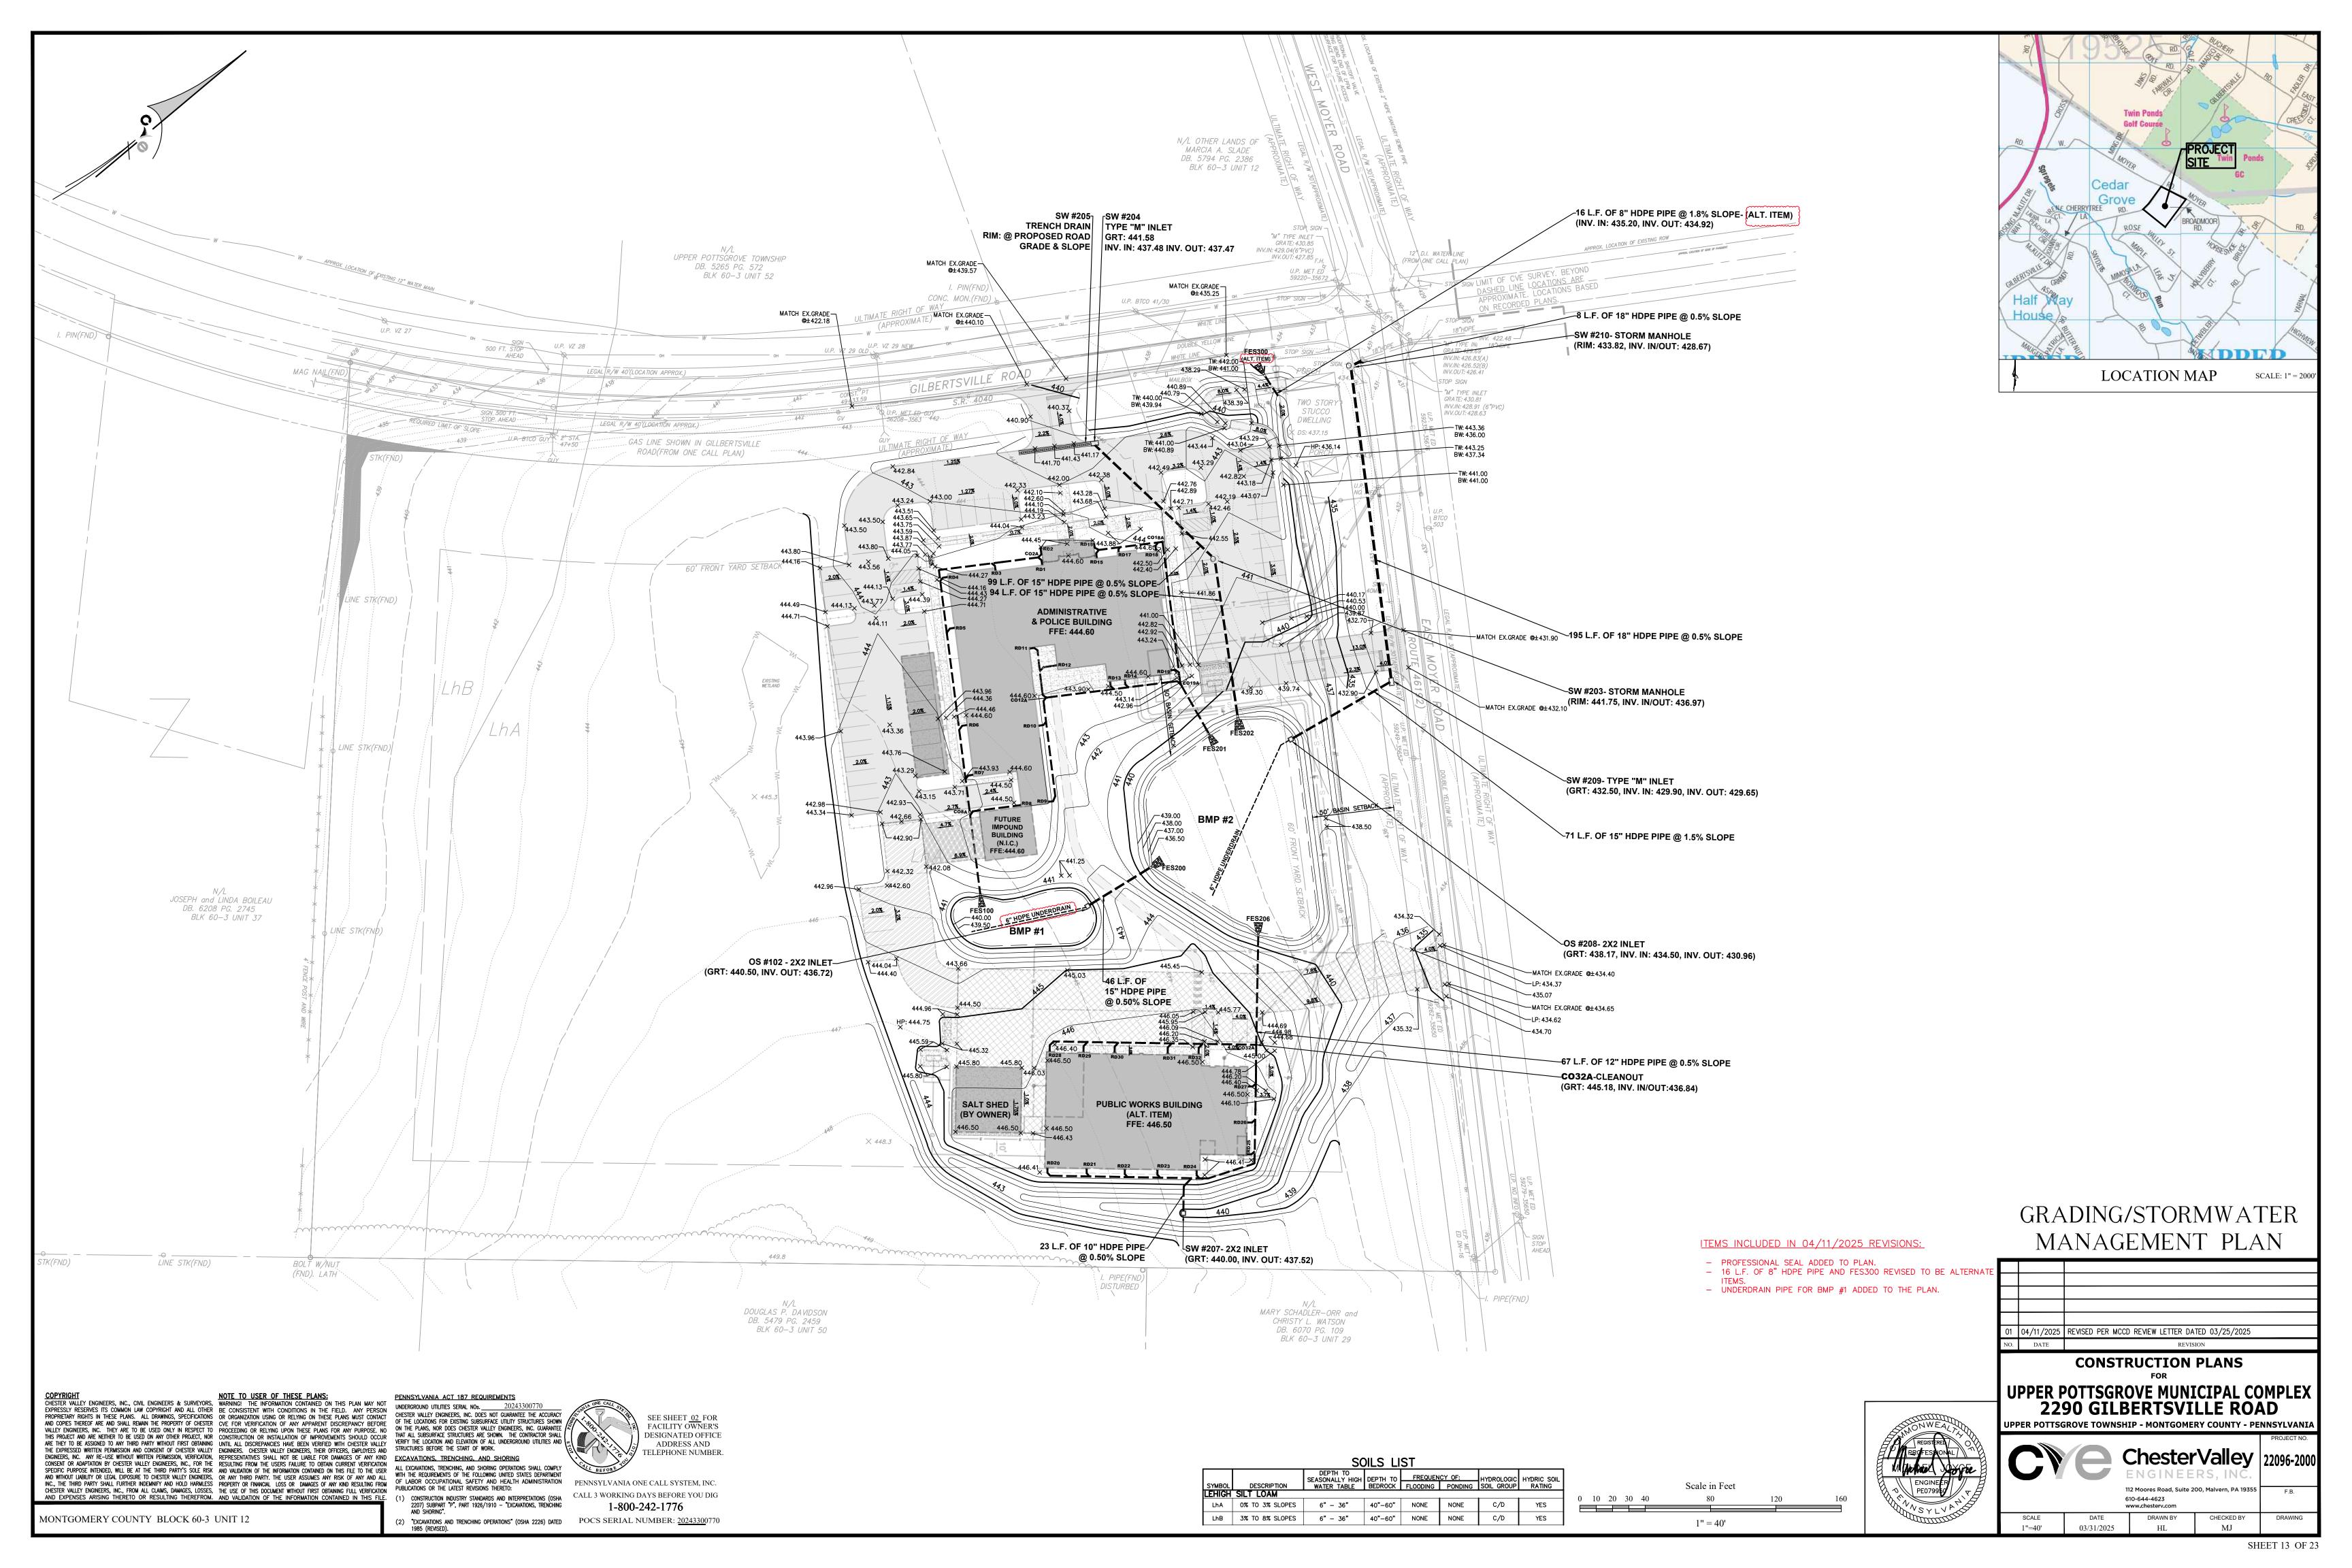

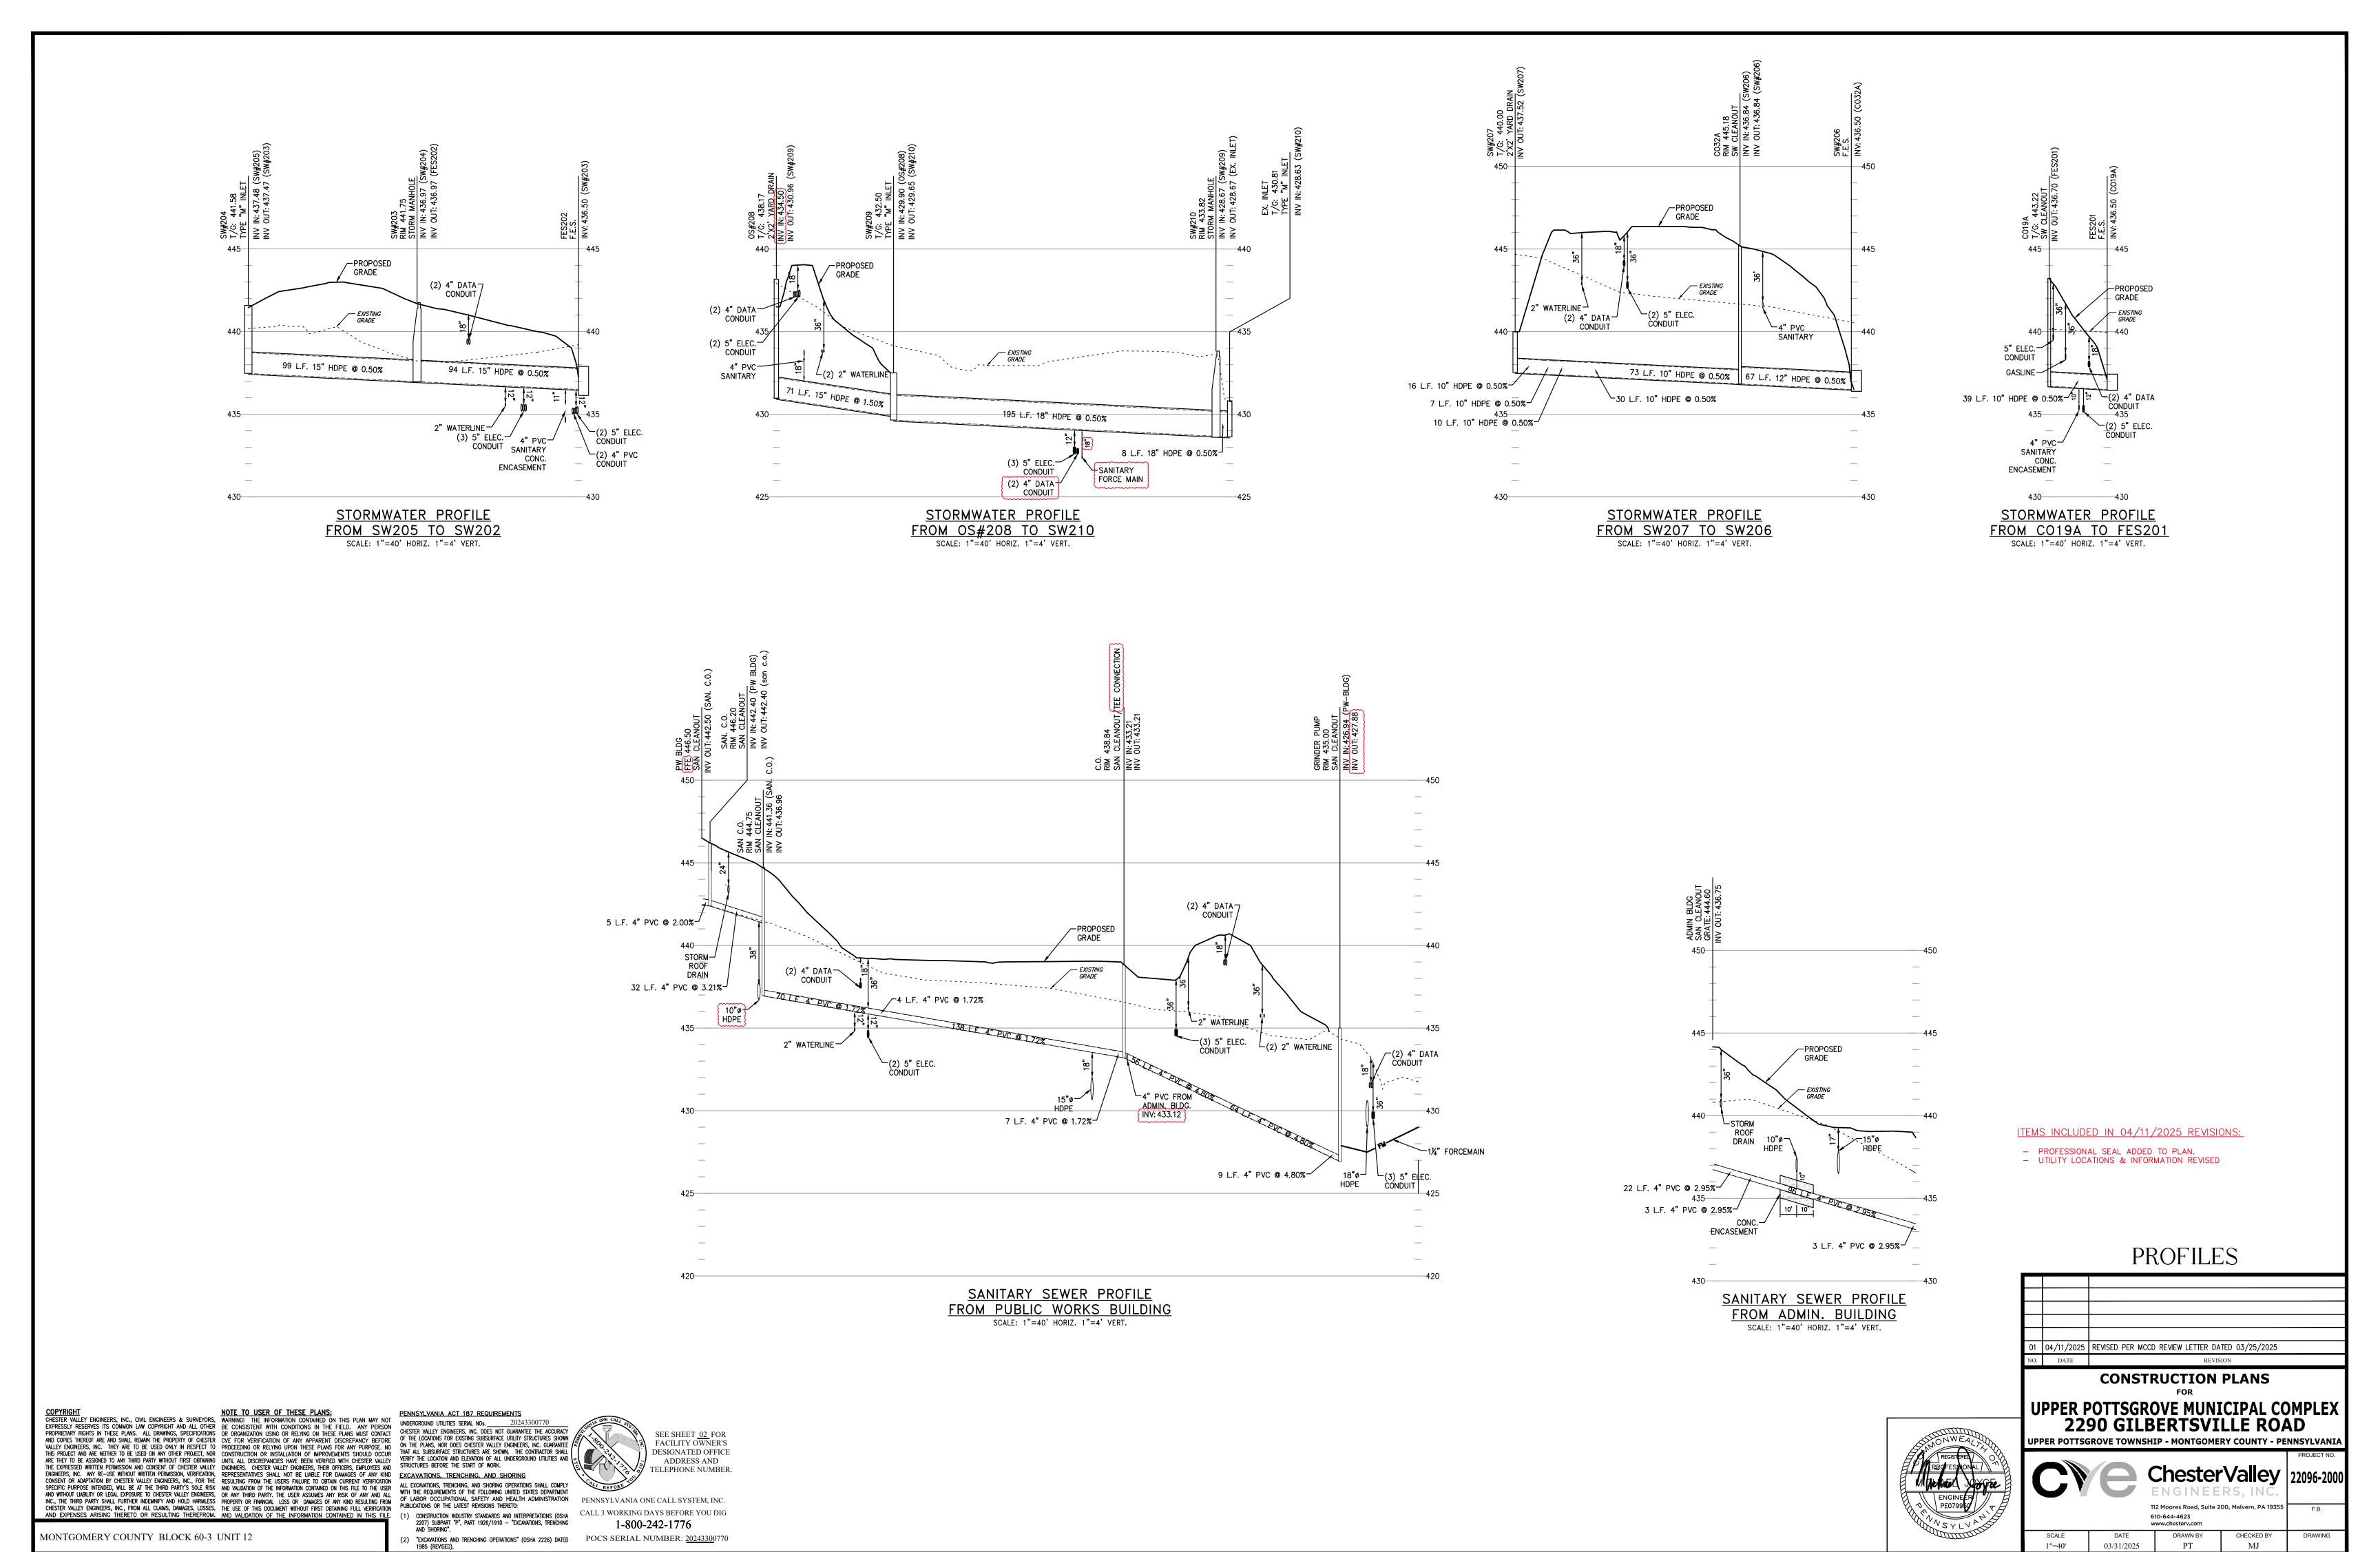

SHEET 14 OF 23

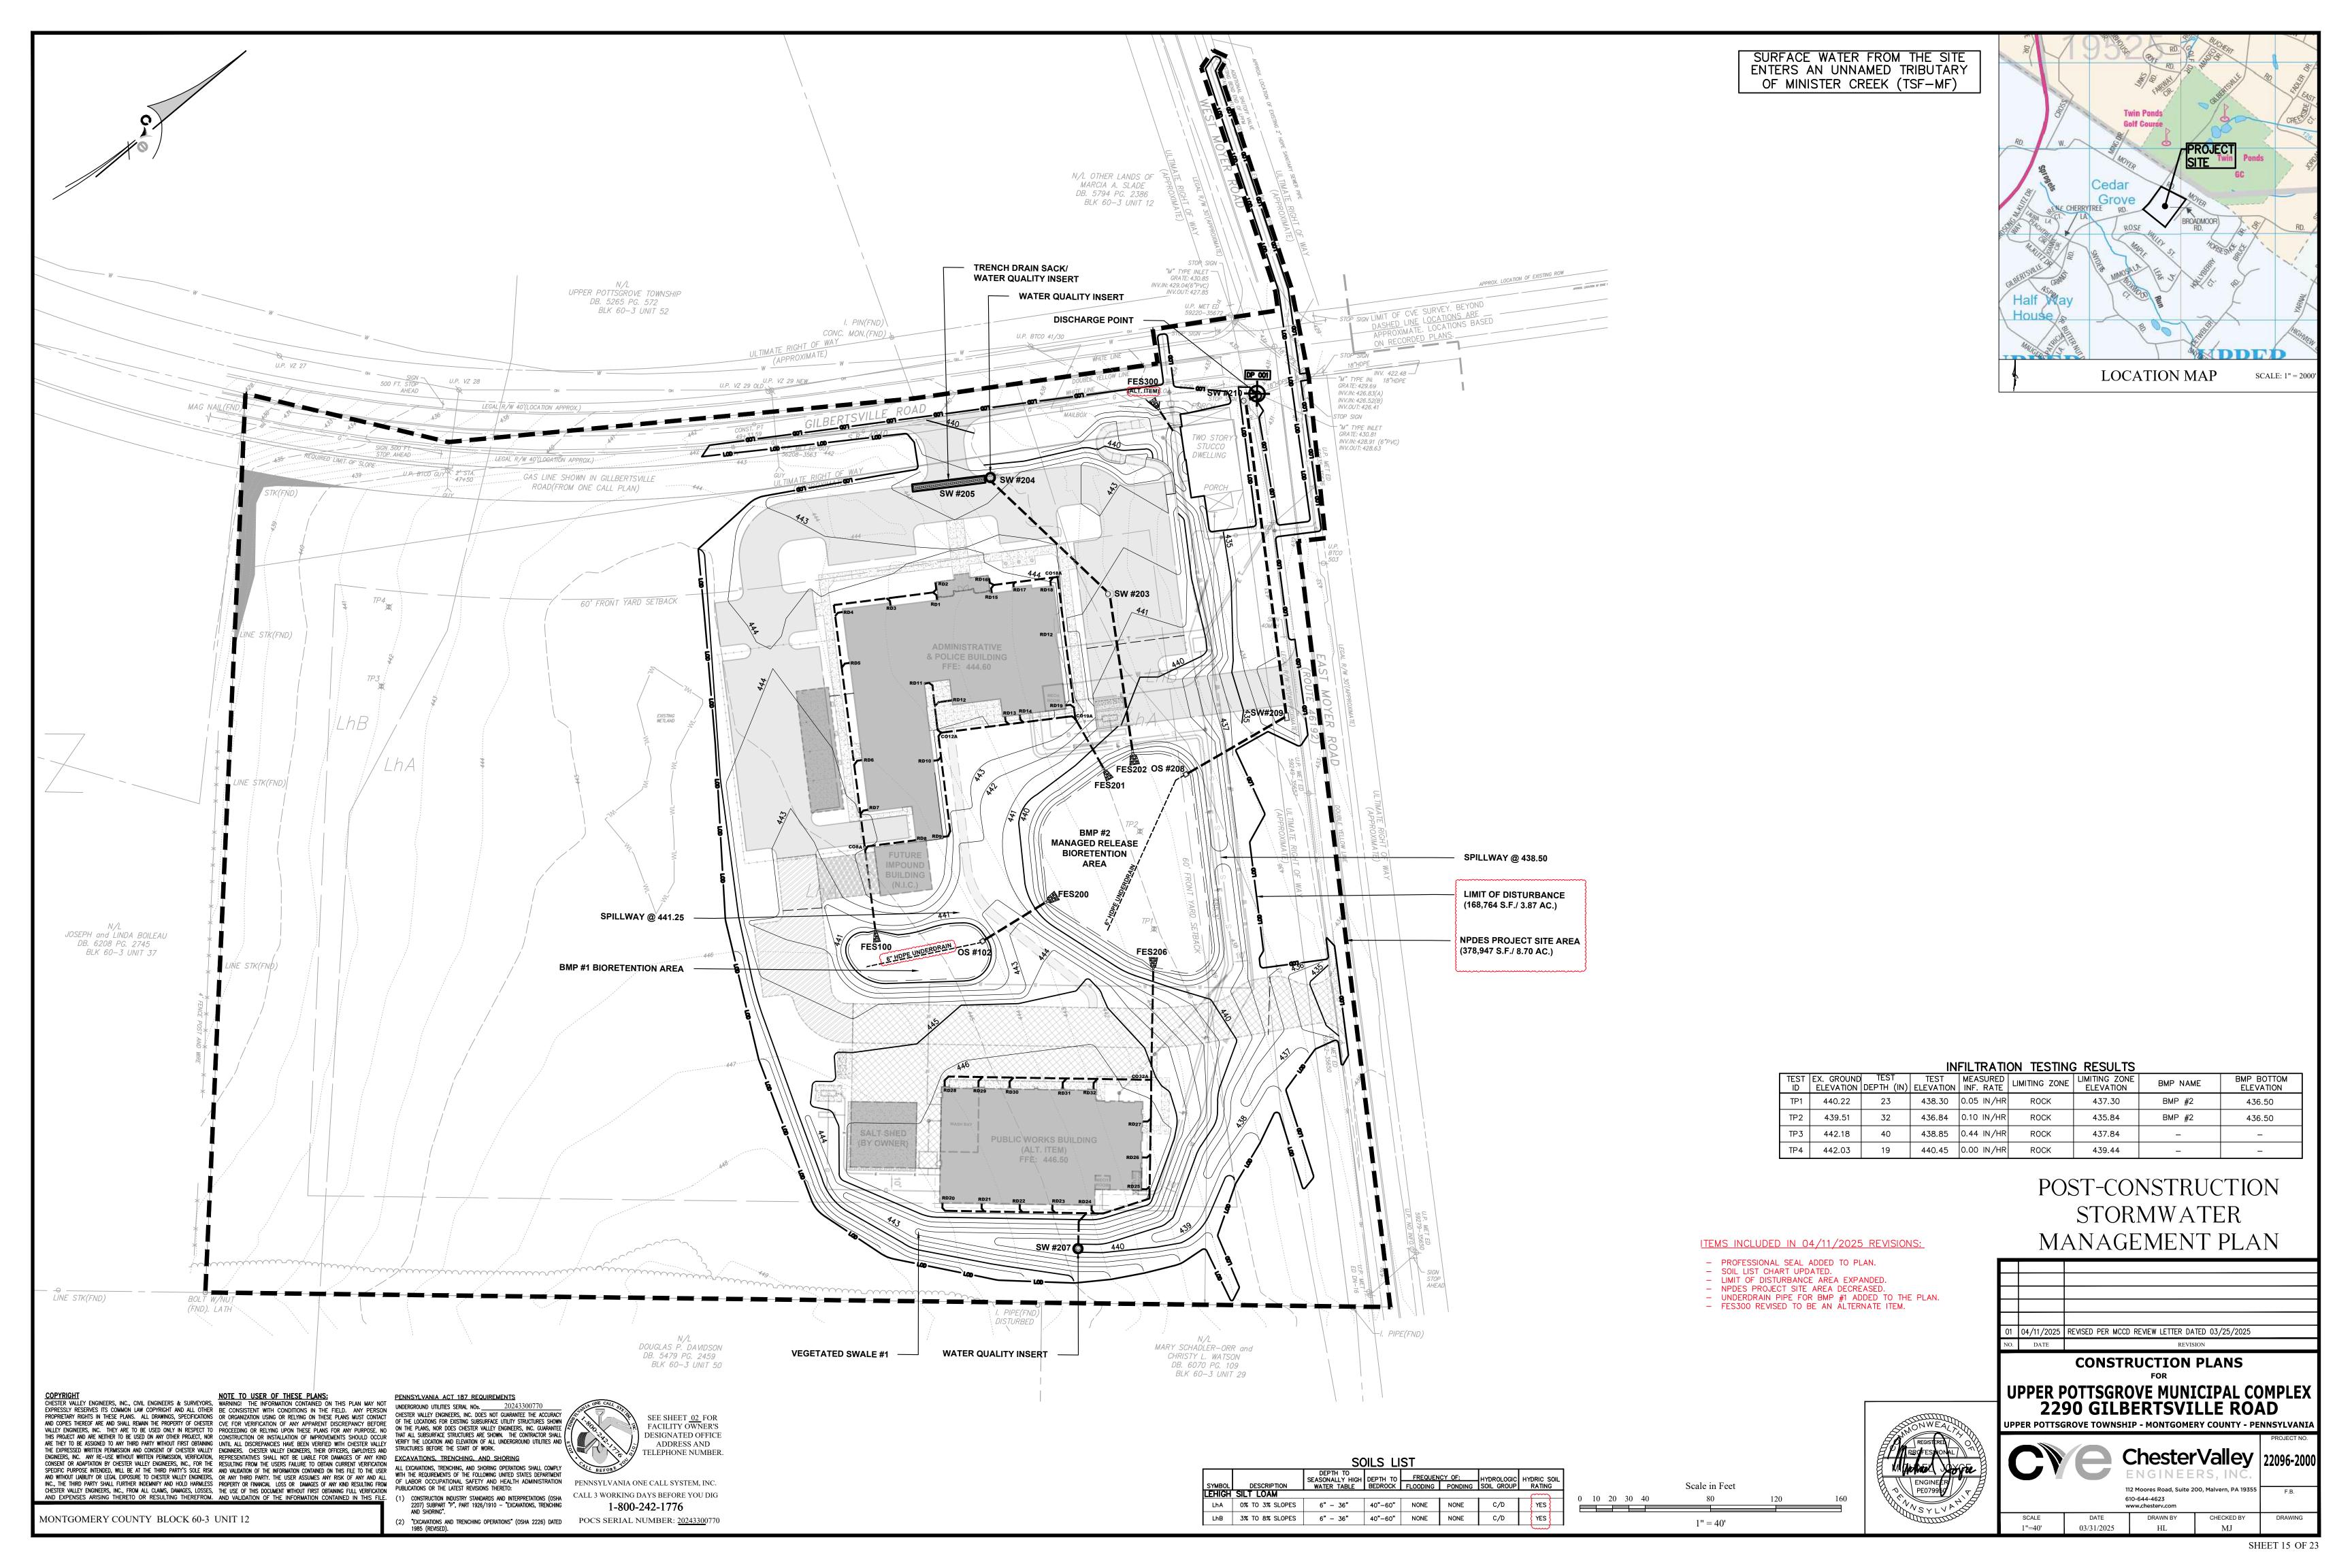

SENERAL NOTES:

IT SHALL BE THE SOLE RESPONSIBILITY OF THE <u>PROPERTY OWNER</u> TO MAINTAIN THE POST CONSTRUCTION STORMWATER MANAGEMENT FACILITIES.

STORMWATER MANAGEMENT DESIGN:

REFER TO "POST-CONSTRUCTION STORMWATER MANAGEMENT REPORT FOR PROPOSED MUNICIPAL COMPLEX," PREPARED BY CHESTER VALLEY ENGINEERS.

EROSION AND SEDIMENTATION CONTROL:

REFER TO "EROSION AND SEDIMENTATION CONTROL PLAN", PREPARED BY CHESTER VALLEY ENGINEERS.

- A. THE BMP'S LISTED BELOW WILL BE OWNED AND MAINTAINED BY THE PROPERTY OWNER. BIORETENTION AREAS
- STORM SEWER AND ASSOCIATED STRUCTURES
- THE PARTY RESPONSIBLE FOR THE LONG TERM OPERATIONS AND MAINTENANCE OF STORMWATER MANAGEMENT FACILITIES SHALL MAKE RECORDS OF THE INSTALLATION AND ALL MAINTENANCE AND REPAIRS, AND SHALL RETAIN THE RECORDS FOR AT LEAST TEN (10) YEARS. THESE RECORDS SHALL BE SUBMITTED TO THE TOWNSHIP AS ESTABLISHED BY THE OPERATION AND MAINTENANCE PLAN OR IF OTHERWISE REQUIRED BY THE TOWNSHIP
- THE POST CONSTRUCTION STORMWATER MANAGEMENT PLAN HAS BEEN DESIGNED TO MEET THE FOLLOWING GOALS AND GUIDELINES:
 - PRESERVE THE INTEGRITY OF STREAM CHANNELS AND MAINTAIN AND PROTECT THE PHYSICAL, BIOLOGICAL AND CHEMICAL QUALITIES OF RECEIVING STREAMS THROUGH THE IMPLEMENTATION OF WATER QUALITY BMP'S TO

TREAT THE RUNOFF PRODUCED BY THE PROPOSED DEVELOPMENT BEFORE DISCHARGING FROM THE SITE.

- PREVENT AN INCREASE IN THE RATE OF STORMWATER RUNOFF AT THE DISCHARGE POINTS.
- MINIMIZE ANY INCREASE IN STORMWATER RUNOFF VOLUME. MINIMIZE IMPERVIOUS AREAS TO ONLY THOSE WHICH ARE NECESSARY FOR THE SITE TO FUNCTION AS INTENDED.

UTILIZE OTHER STRUCTURAL OR NONSTRUCTURAL BMP'S TO PREVENT OR MINIMIZE CHANGES IN STORMWATER

- MAXIMIZE THE PROTECTION OF EXISTING DRAINAGE FEATURES AND EXISTING VEGETATION.
- MINIMIZE LAND CLEARING AND GRADING. MINIMIZE SOIL COMPACTION.
- RUNOFF RESULTING FROM THE CHANGE IN IMPERVIOUS AREA.
- THE RECEIVING WATERCOURSE FOR THIS PROJECT IS AN UNNAMED TRIBUTARY OF MINISTER CREEK (TSF-MF).
- THE OPERATOR SHALL REMOVE FROM THE SITE, RECYCLE, OR DISPOSE OF ALL BUILDING MATERIALS AND WASTES IN ACCORDANCE WITH THE DEPARTMENT'S SOLID WASTE MANAGEMENT REGULATIONS AT 25 PA. CODE 260.1 ET SEQ., 271.1 ET SEQ., AND 287.1 ET SEQ. THE CONTRACTOR SHALL NOT ILLEGALLY BURY, DUMP, OR DISCHARGE ANY BUILDING MATERIAL OR WASTES AT THE SITE. CONSTRUCTION WASTES MUST BE RECYCLED TO THE EXTENT PRACTICABLE, AND DISPOSAL METHODS MUST COMPLY WITH FEDERAL, STATE, AND LOCAL REQUIREMENTS.
- THE PERMITTEE SHALL PROVIDE ENGINEERING CONSTRUCTION OVERSIGHT FOR THE PROPOSED STORMWATER BMPS. A LICENSED PROFESSIONAL ENGINEER KNOWLEDGEABLE IN THE DESIGN AND CONSTRUCTION OF STORMWATER BMPS, PREFERABLY THE DESIGN ENGINEER, SHALL CONDUCT THE OVERSIGHT.
- AS-BUILT PLANS OF THE STORMWATER BMP'S SHALL BE PROVIDED WITHIN SIX MONTHS FOLLOWING THE COMPLETION OF EACH PHASE. THE AS-BUILT PLANS SHALL BE SIGNED AND SEALED BY A PA REGISTERED PROFESSIONAL ENGINEER.
- A NOTICE OF TERMINATION (NOT) WILL BE REQUIRED TO BE SUBMITTED FOLLOWING APPROVAL OF THE FINAL AS-BUILT PLANS. PRIOR TO ACCEPTING THE NOT, THE DEPARTMENT AND/OR CONSERVATION DISTRICT STAFF WILL PERFORM A FINAL INSPECTION TO ENSURE SITE STABILIZATION AND VERIFY ADEQUATE INSTALLATION AND FUNCTION OF STORMWATER BMP'S.
- PCSM REPORTING AND RECORDKEEPING. THE PCSM PLAN, INSPECTION REPORTS AND MONITORING RECORDS SHALL BE AVAILABLE FOR REVIEW AND INSPECTION BY THE DEPARTMENT OR THE CONSERVATION DISTRICT.
- FINAL CERTIFICATION. THE PERMITTEE SHALL INCLUDE WITH THE NOTICE OF TERMINATION "RECORD DRAWINGS" WITH A FINAL CERTIFICATION STATEMENT FROM A LICENSED PROFESSIONAL, WHICH READS AS FOLLOWS:

"I (NAME) DO HEREBY CERTIFY PURSUANT TO THE PENALTIES OF 18 PA.C.S.A. § 4904 TO THE BEST OF MY KNOWLEDGE, INFORMATION AND RELIEF, THAT THE ACCOMPANYING RECORD DRAWINGS ACCURATELY REFLECT THE AS-BUILT CONDITIONS. ARE TRUE AND CORRECT, AND ARE IN CONFORMANCE WITH CHAPTER 102 OF THE RULES AND REGULATIONS OF THE DEPARTMENT OF ENVIRONMENTAL PROTECTION AND THAT THE PROJECT SITE WAS CONSTRUCTED IN ACCORDANCE WITH THE APPROVED PCSM PLAN, ALL APPROVED PLAN CHANGES AND ACCEPTED CONSTRUCTION PRACTICES."

- (1) THE PERMITTEE SHALL RETAIN A COPY OF THE RECORD DRAWINGS AS A PART OF THE APPROVED PCSM PLAN. (2) THE PERMITTEE SHALL PROVIDE A COPY OF THE RECORD DRAWINGS AS A PART OF THE APPROVED PCSM PLAN TO THE PERSON IDENTIFIED IN THIS SECTION AS BEING RESPONSIBLE FOR THE LONG-TERM OPERATION AND MAINTENANCE OF THE PCSM BMPS.
- UPON PERMANENT STABILIZATION OF THE EARTH DISTURBANCE ACTIVITY UNDER § 102.22(A)(2) (RELATING TO PERMANENT STABILIZATION), AND INSTALLATION OF BMPS IN ACCORDANCE WITH AN APPROVED PLAN PREPARED AND IMPLEMENTED IN ACCORDANCE WITH §§ 102.4 AND 102.8 (RELATING TO EROSION AND SEDIMENT CONTROL REQUIREMENTS; AND PCSM REQUIREMENTS), THE PERMITTEE OR CO-PERMITTEE SHALL SUBMIT A NOTICE OF TERMINATION TO THE DEPARTMENT OR CONSERVATION DISTRICT.
 - THE NOTICE OF TERMINATION MUST INCLUDE:
 - (1) THE FACILITY NAME, ADDRESS AND LOCATION
- (2) THE OPERATOR NAME AND ADDRESS. (3) THE PERMIT NUMBER
- (4) THE REASON FOR PERMIT TERMINATION.
- (5) IDENTIFICATION OF THE PERSONS WHO HAVE AGREED TO AND WILL BE RESPONSIBLE FOR LONG-TERM OPERATION AND MAINTENANCE OF THE PCSM BMPS IN ACCORDANCE WITH §102.8(M) AND PROOF OF COMPLIANCE WITH § 102.8(M)(2).

PRIOR TO ACCEPTING THE NOT, THE DEPARTMENT AND/OR CONSERVATION DISTRICT STAFF WILL PERFORM A FINAL INSPECTION AND APPROVE OR DENY THE NOTICE OF TERMINATION.

GENERAL CONSERVATION NOTES AND SPECIFICATIONS

INTENT OF CONSERVATION PROGRAM: THE INTENT OF THIS PROGRAM IS TO PREVENT ACCELERATED EROSION OF THE EXPOSED SITE SOILS DURING THE CONSTRUCTION AND PERMANENT LIFE PERIODS OF THE DEVELOPMENT. THE PROGRAM REQUIRES RETENTION OF ALL SEDIMENTS ON THE CONSTRUCTION SITE TO MINIMIZE THE IMPACT OF DEVELOPMENT ON EXISTING STREAMS AND ADJACENT PROPERTY OWNERS. THESE OBJECTIVES WILL BE ACHIEVED BY MINIMIZING THE EXPOSURE TIME OF POTENTIALLY EROSIVE SOILS TO RUNOFF AND INSTALLATION OF THE TEMPORARY CONSTRUCTION. THE INTENT OF THIS PROGRAM SHOULD BE UNDERSTOOD AND IMPLEMENTED THROUGHOUT THE ENTIRE DEVELOPMENT. THE VARIOUS CONSTRUCTION TRADES SHOULD BE

SURFACE STABILIZATION CRITERIA: ALL DISTURBED SOIL SURFACES, INCLUDING SOIL STOCKPILES, ARE SUBJECT TO EROSION AND SHALL BE STABILIZED EITHER TEMPORARILY OR PERMANENTLY. IMMEDIATELY DURING NON-GERMINATION PERIODS. MULCH MUST BE APPLIED AT THE RECOMMENDED RATES. CRUSHED STONE ON PAVEMENT SUBGRADES IS CONSIDERED ADEQUATE PROTECTION. ALL DISTURBED ZONES AND VEGETATED REGIONS SHALL BE STABILIZED. PREFERABLY WITH A PERMANENT TREATMENT.

APPRAISED OF THIS PROGRAM AND DIRECTED TO PREVENT UNDUE DISTURBANCE OF PREPARED AND PROTECTED SURFACES.

THE OWNER IS RESPONSIBLE FOR THE PROPER DISPOSAL OF ALL WASTES ONSITE. GARBAGE SHALL BE COLLECTED ON-SITE UNTIL RETRIEVED BY AN APPROVED DISPOSAL OR RECYCLING COMPANY, CONTRACTOR SHALL NOT INCINERATE EXCESS MATERIALS.

SILT REMOVED FROM POST CONSTRUCTION STORMWATER MANAGEMENT FACILITIES SHALL BE DISPOSED OF ON-SITE IN LANDSCAPED AREAS LOCATED OUTSIDE OF VEGETATED RAIN GARDEN AREAS. AREAS OF SEDIMENT DISPOSAL SHALL BE CONSIDERED CRITICAL VEGETATION AREAS (CVA).

LIKELY WASTE TO BE GENERATED DURING MAINTENANCE OF THE POST-CONSTRUCTION BMP'S ARE:

ACCUMULATED SEDIMENT IN THE BIORETENTION AREAS AND STORM SYSTEM.

ACCUMULATED GARBAGE AND DEBRIS IN THE BIORETENTION AREAS AND STORM SEWER

CRITICAL STAGES OF CONSTRUCTION

THE PROFESSIONAL DESIGN ENGINEER, GEOTECHNICAL ENGINEER, OR SOILS PROFESSIONAL MUST BE PRESENT ON-SITE FOR THE ENTIRE INSTALLATION AND INSPECTION OF THE STORMWATER BMPs. THE SPECIFIC CRITICAL STAGES OF CONSTRUCTION FOR EACH BMP ARE

- FOR BIORETENTION AREAS: EXCAVATION OF BIORETENTION AREA, PREPARATION OF THE SUBGRADE, PLACEMENT OF THE GEOTEXTILE FABRIC, INSTALLATION OF THE UNDERDRAIN, INSTALLATION OF AMENDED SOILS, CONSTRUCTION OF THE BIORETENTION BERM, AND INSTALLATION OF THE OUTLET STRUCTURE.
- FOR ALL WATER QUALITY INLETS: VERIFY INSTALLATION PER MANUFACTURER'S RECOMMENDATIONS.

CRITICAL VEGETATION AREAS (CVA)

CRITICAL VEGETATION AREAS ARE TO BE GRADED, HYDROSEEDED, AND MULCHED WITHIN 10 DAYS OF THE BEGINNING OF EXCAVATION. IN GENERAL, CRITICAL VEGETATION AREAS ARE DEFINED AS CUT SLOPES STEEPER THAN 3:1, ALL FILL SLOPES STEEPER THAN 4:1, IN ALL DRAINAGE SWALES, BASIN AND RAIN GARDEN AREAS.

POST CONSTRUCTION STORMWATER MANAGEMENT REPORTING AND RECORD KEEPING

WRITTEN REPORT DOCUMENTING EACH INSPECTION AND ALL BMP REPAIRS AND MAINTENANCE ACTIVITIES MUST BE PROVIDED AS

PART OF THE LONG-TERM OPERATION AND MAINTENANCE PROGRAM.

THE POST CONSTRUCTION STORMWATER MANAGEMENT PLAN, INSPECTION REPORTS, AND MONITORING RECORDS SHALL BE AVAILABLE FOR REVIEW AND INSPECTION BY THE DEPARTMENT OR THE CONSERVATION DISTRICT.

BMP #1 & BMP #2, AS INDICATED ON PCSM PLAN

PLANTING NOTES AND SPECIFICATIONS:

1. DEVELOP A PLANTING MEDIUM IN ACCORDANCE WITH THE APPROVED DETAIL SHOWN ON POST-CONSTRUCTION STORMWATER MANAGEMENT DETAIL SHEET.

I. ALL STORMWATER MANAGEMENT SYSTEMS SHALL BE INSPECTED ANNUALLY FOR THE FIRST FIVE (5) YEARS AND ONCE EVERY THREE (3) YEARS THEREAFTER, FOR ACCUMULATION OF SEDIMENT, TRASH AND DEBRIS, DAMAGE TO OUTLET STRUCTURES, EROSION, SIGNS OF CONTAMINATION OR SPILLS AND BERM STABILITY.

I. THE SUGGESTED ITEMS IN THIS SECTION INCLUDE, BUT ARE NOT LIMITED TO THE THOSE LISTED

- ACCUMULATED SEDIMENT SHALL BE RESPREAD ON-SITE AS DESCRIBED IN THE DISPOSAL AND RECYCLING SECTION OF THIS PLAN SHEET;
- ANY DISCOVERED TRASH OR DEBRIS SHALL BE REMOVED IMMEDIATELY;
- REPAIR OR REPLACE OUTLET STRUCTURE AS NEEDED; STABILIZE ERODED AREAS IN ACCORDANCE WITH APPROVED E&S SEEDING AND MULCHING
- IN THE EVENT OF CONTAMINATION OR SPILL, IMMEDIATELY CONTACT AN ENVIRONMENTAL PROFESSIONAL QUALIFIED TO IDENTIFY AND EXECUTE THE REQUIRED CLEANUP METHODS
- THAT ADHERE TO LOCAL, STATE AND FEDERAL REGULATIONS; IMMEDIATELY AFTER DISCOVERY OF BERM INSTABILITY, CONTACT A GEOTECHNICAL ENGINEER AND SITE CONTRACTOR TO DETERMINE AND EXECUTE METHODS TO REMEDY THE UNSTABLE BERM.

GENERAL MAINTENANCE NOTES:

- 1. INSPECT BMP FOR SEDIMENT BUILDUP, EROSION, VEGETATIVE CONDITIONS, ETC.
- 2. WHILE VEGETATION IS BEING ESTABLISHED, PRUNING AND WEEDING MY BE REQUIRED.
- 3. RE-SPREAD MULCH WHEN EROSION IS EVIDENT AND REPLENISH AS NEEDED. REPLENISH MULCH ONCE EVERY 2 TO 3 YEARS.

DEBRIS ACCUMULATION (ADDRESS WHEN > 3 INCHES AT ANY SPOT OR COVERING VEGETATION).

- 4. INSPECT AND CORRECT EROSION PROBLEMS, DAMAGE TO VEGETATION, AND SEDIMENT AND
- WATER AS NEEDED DURING PERIODS OF EXTENDED DROUGHT
- 6. INSPECT VEGETATION ON SIDE SLOPES FOR EROSION AND FORMATION OF RILLS OR GULLIES, CORRECT AS NEEDED.
- 7. INSPECT FOR POOLS OF STANDING WATER; DEWATER AND DISCHARGE TO AN APPROVED LOCATION AND RESTORE TO DESIGN GRADE.
- 8. TRIM VEGETATION TO ENSURE SAFETY, AESTHETICS, PROPER SWALE OPERATION, OR TO SUPPRESS WEEDS AND INVASIVE VEGETATION; DISPOSE OF CUTTINGS IN A LOCAL COMPOSTING FACILITY, MOW ONLY WHEN SWALE IS DRY TO AVOID RUTTING.
- 9. INSPECT FOR LITTER; REMOVE PRIOR TO TRIMMING.

APPROPRIATE FOR VEGETATIVE SPECIES.

- 10. INSPECT FOR UNIFORMITY IN CROSS-SECTION, CORRECT AS NEEDED.
- 11. INSPECT INFLOW POINTS (CURB CUTS, INLETS, PIPES, ETC.) AND OUTLET FOR SIGNS OF EROSION OR BLOCKAGE, CORRECT AS NEEDED.
- 12. CONTACT DESIGN ENGINEER IMMEDIATELY AFTER DISCOVERY OF SINKHOLE OCCURRENCE, SINKHOLE SHOULD BE PROMPTLY AND PROPERLY REPAIRED.
- 13. THE VEGETATION (FOR BMP CONTRIBUTING DRAINAGE AREA) SHOULD BE MAINTAINED IN GOOD CONDITION, AND ANY BARE SPOTS REVEGETATED.
- 14. CARE SHOULD BE TAKEN TO AVOID EXCESSIVE COMPACTION BY MOWERS. MOW ONLY AS
- 15. INSPECT BMP #2 AT LEAST TWO TIMES PER YEAR AFTER RUNOFF EVENTS GREATER THAN 0.8 INCH AND MAKE SURE THAT RUNOFF DRAINS DOWN WITHIN THE DESIGN PARAMETERS (THE LICENSED PROFESSIONAL ENGINEER SHOULD CLEARLY IDENTIFY WHAT THESE PARAMETERS ARE).
- 16. ALL CATCH BASINS AND INLETS SHOULD BE INSPECTED AND CLEANED AT LEAST TWO (2) TIMES PER YEAR.
- 17. AS NEEDED, REMOVE ACCUMULATED SEDIMENT AS REQUIRED TO MAINTAIN INFILTRATION HROUGH THE MRC STONE MEDIA AND TO MAINTAIN WATER QUALITY FUNCTIONALITY. RESTORE ORIGINAL CROSS SECTION. PROPERLY DISPOSE OF SEDIMENT.
- 18. ALL MRC BMP COMPONENTS SHOULD BE MAINTAINED AS INDICATED IN THE STORMWATER BMP
- 19. AT LEAST TWO TIMES PER YEAR, OR MORE IF HISTORICAL MAINTENANCE INDICATE IT IS NECESSARY, INSPECT FOR ACCUMULATION OF SEDIMENT, DAMAGE TO OUTLET CONTROL STRUCTURES, EROSION, SIGNS OF WATER CONTAMINATION/SPILLS, AND INSTABILITY.
- 20. LEAF LITTER NEEDS TO BE REMOVED ANNUALLY.

21. BMP SHOULD BE INSPECTED IMMEDIATELY AFTER THE SPRING MELT, REMOVE RESIDUALS AND REPLACE DAMAGED VEGETATION.

- 22. IF ROADSIDE OR PARKING LOT RUNOFF IS DIRECTED TO THE BMP, MULCHING AND/OR SOIL AERATION/MANIPULATION MAY BE REQUIRED IN THE SPRING TO RESTORE SOIL STRUCTURE AND MOISTURE CAPACITY AND TO REDUCE THE IMPACTS OF DEICING AGENTS.
- 23. USE NONTOXIC, ORGANIC DEICING AGENTS, APPLIED EITHER AS BLENDED, MAGNESIUM CHLORIDE-BASED LIQUID PRODUCTS OR AS PRETREATED SALT.
- 24. USE SALT-TOLERANT VEGETATION.
- 25. CLOSE MOW OR TRIM PERENNIAL MATERIAL TO ALLOW PROPER GERMINATION AND TO CONTROL INVASIVE SPECIES (TO BE DONE ONCE IN LATE FALL, WINTER OR EARLY SPRING).
- 26. REPLENISH MULCH IN AREAS WHERE EROSION IS EVIDENT. REPLENISH MULCH IN ENTIRE INFILTRATION AREA AT LEAST EVERY 2 TO 3 YEARS.

- I. INSTALL FILTER SOCK AND/OR OR OTHER APPROPRIATE TEMPORARY EROSION CONTROL DEVICES TO PREVENT SEDIMENT FROM LEAVING OR ENTERING THE PRACTICE DURING CONSTRUCTION.
- 2. PRIOR TO CONSTRUCTION, BIORETENTION AREA/BIO-FILTRATION AREAS SHALL BE MARKED OFF IN THE FIELD. THE AREAS SHALL BE DELINEATED WITH CONSTRUCTION FENCING OR TAPE IN SUCH A MANNER AS TO PREVENT THE PARKING OR REPEATED MOVEMENT OF CONSTRUCTION TRAFFIC.
- 3. ALL DOWN-GRADIENT PERIMETER SEDIMENT CONTROL BMP'S MUST BE IN PLACE BEFORE ANY UP GRADIENT LAND DISTURBING ACTIVITY BEGINS.
- 4. PERFORM CONTINUOUS INSPECTIONS OF EROSION CONTROL PRACTICES.
- 6. ROUGH GRADE THE SITE. IF BIORETENTION AREAS ARE BEING USED AS TEMPORARY SEDIMENT BASINS LEAVE A MINIMUM OF 1 FOOT OF COVER OVER THE PRACTICE TO PROTECT THE UNDERLYING SOILS FROM CLOGGING.

5. INSTALL UTILITIES (WATER, SANITARY SEWER, ELECTRIC, PHONE, FIBER OPTIC, ETC) PRIOR TO

- PERFORM ALL OTHER SITE IMPROVEMENTS.
- 8. TRIM AND MULCH ALL AREAS AFTER DISTURBANCE.

SETTING FINAL GRADE OF BIORETENTION DEVICE.

- 9. CONSTRUCT BIORETENTION DEVICE UPON STABILIZATION OF CONTRIBUTING DRAINAGE AREA
- 10. CONSTRUCT CURB CUTS OR OTHER INFLOW BUT PROVIDE PROTECTION TO PROHIBIT SEDIMENT LADEN WATER FROM ENTERING THE BMP.
- 11. CRITICAL STAGE OF CONSTRUCTION: CONTACT ENGINEER TO VERIFY INSTALLATION OF BIORETENTION AREA.
- 12. IMPLEMENT TEMPORARY AND PERMANENT EROSION CONTROL PRACTICES.
- 13. PLANT AND MULCH BIORETENTION DEVICE.
- 14. REMOVE TEMPORARY EROSION CONTROL DEVICES AFTER THE CONTRIBUTING DRAINAGE AREA IS ADEQUATELY VEGETATED.

BMP FAILURE NOTES (PER PROTOCOL 2 OF THE BMP MANUAL)

- THE TERM "FAILURE" FOR THE PROPOSED BIORETENTION AREAS SHALL BE DEFINED AS: 1) THE LOSS OF FUNCTIONALITY OF THE PROPOSED OUTLET STRUCTURE, DISCHARGE PIPE, UNDERDRAIN SYSTEM OR ANY
 - OTHER DRAINAGE STRUCTURE/PIPE WITHIN THE BMP 2) THE LOSS OF STRUCTURAL INTEGRITY OF THE PROPOSED BERM
 - 3) THE INABILITY OF THE BIORETENTION AREA TO SUPPORT SURFACE VEGETATION DUE TO TOO MUCH OR TOO LITTLE
 - 4) EXCESSIVE EROSION OR ACCUMULATION OF SEDIMENT OR DEBRIS 5) STANDING WATER IS OBSERVED IN THE BIORETENTION AREA AFTER 72-HOURS.

THE PERMITTEE SHALL MAKE THE NECESSARY REPAIRS TO THE OUTLET STRUCTURE, DISCHARGE PIPING, UNDERDRAIN SYSTEM, OTHER DRAINAGE STRUCTURES/PIPES WITHIN THE BMP, SURFACE VEGETATION, AND BERM AS NEEDED. REMOVE SEDIMENT OR DEBRIS THAT HAS ACCUMULATED IN THE BMP BOTTOM AND STABILIZE EROSION USING PERMANENT STABILIZATION TECHNIQUES INDICATED ON THE EROSION AND SEDIMENT POLLUTION CONTROL PLAN. DEWATER BIORETENTION AREAS.

THE TERM "FAILURE' FOR THE PROPOSED WATER QUALITY INLETS (FILTER INSERTS) SHALL BE DEFINED AS: DISCOVER EVIDENCE OF DAMAGED FILTER MEDIA

2) DISCOVER EVIDENCE OF THE FILTER MEDIA'S INABILITY TO SUPPORT ACCUMULATED SEDIMENT OR DEBRIS.

THE PERMITTEE SHALL REPAIR BMP FAILURE BY REPLACING THE FILTER MEDIA IN ACCORDANCE WITH THE MANUFACTURERS SPECIFICATIONS.

THERE ARE SEVERAL PROPOSED/IN PLACE MEASURES INTENDED TO TREAT RUNOFF FOR THERMAL IMPACTS. FIRSTLY, THE PROPOSED LANDSCAPING TREES WITHIN AND BORDERING THE NEW BUILDING AND SIDEWALK AREAS WILL SHADE THE ADJACENT IMPERVIOUS SURFACES WHICH WILL KEEP THE AREAS COOL. SECONDLY, THE STORMWATER RUNOFF COLLECTED BY THE STORM SEWER SYSTEM WILL BE COOLED BY THE LOWER UNDERGROUND TEMPERATURE AS THE RUNOFF FLOWS THROUGH THE SYSTEM. THIRDLY, THE WATER DETAINED IN THE BIORETENTION AMENDED SOILS WILL BE COOLED AS IT IS SLOWLY RELEASED AS A RESULT OF THE LOWER UNDERGROUND TEMPERATURE AS THE POST DEVELOPMENT FLOWS ARE LOWER THAN THE PRE-DEVELOPMENT FLOWS THE REDUCED RATE MEANS THE RUNOFF WILL HAVE MORE TIME TO COOL IN THE PROPOSED BMPS. THE COOLING INFLUENCES OF THE ONSITE BMPS WILL

NEUTRALIZE/REMOVE THE HEAT ENERGY ABSORBED BY THE PROJECT SITE RUNOFF PRIOR TO DISCHARGE INTO THE RECEIVING

STORM SEWER

WATERCOURSE.

1. ALL DRAINAGE COLLECTION STRUCTURES SHALL BE INSPECTED ANNUALLY FOR THE FIRST FIVE (5) YEARS AND ONCE EVERY THREE (3) YEARS THEREAFTER, FOR TRASH, DEBRIS OR EVIDENCE OF PIPE LEAKAGE OR SAGGING; REMOVE TRASH OR DEBRIS IMMEDIATELY; IMMEDIATELY REPAIR OR REPLACE LEAKING/SAGGING DRAINAGE FEATURES.


GENERAL MAINTENANCE NOTES:


- ACCESS CAN BE GAINED TO EACH COLLECTION STRUCTURE THROUGH THE REMOVABLE INLET GRATE OR MANHOLE LID. STEEL OR OTHER APPROVED RUNGS HAVE BEEN INSTALLED ON THE INSIDE OF EACH STRUCTURE OVER FOUR FEET DEEP FOR
- ANY NECESSARY ENTRY. GRATES AND LIDS SHALL BE REPLACED SECURELY IMMEDIATELY AFTER MAINTENANCE. CONTACT DESIGN ENGINEER IMMEDIATELY AFTER DISCOVERY OF SINKHOLE OCCURRENCE, SINKHOLE SHOULD BE PROMPTLY AND PROPERLY REPAIRED.
- IF SEDIMENT/TRASH/DEBRIS IS FOUND IN THE CONVEYANCE SYSTEM, THE SYSTEM SHALL BE JETTED AND VACUUMED TO REMOVE ALL SEDIMENT/TRASH/DEBRIS AND DISPOSED OF APPROPRIATELY.
- REFER TO WATER QUALITY INLET MAINTENANCE GUIDELINES FOR ADDITIONAL DETAIL IN CLEANING OF THOSE STRUCTURES WITH WATER QUALITY APPARATUS INSTALLED.

SITE RESTORATION O&M REQUIREMENTS

ESTABLISH AND MAINTAIN VEGETATIVE COVER IN ACCORDANCE WITH PERMANENT SEEDING SPECIFICATIONS.

PERFORM ROUTINE INSPECTIONS AND CORRECT EROSION PROBLEMS, IF ENCOUNTERED.

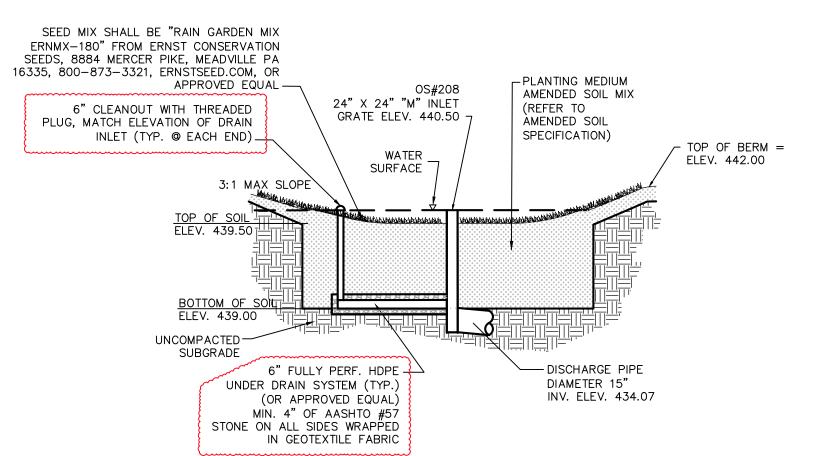

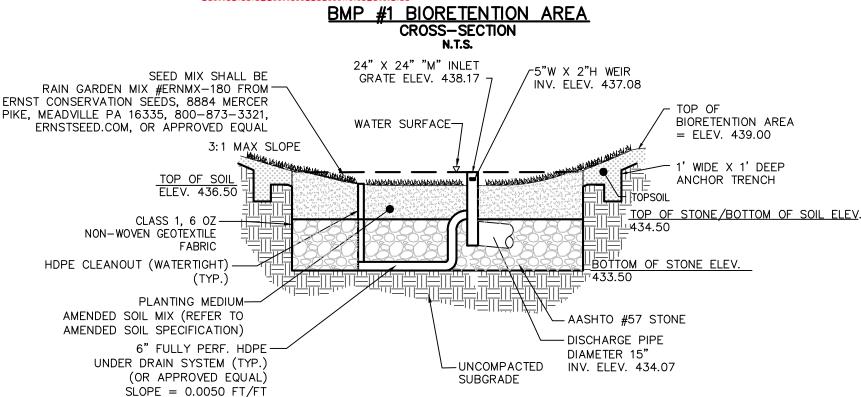

AMENDED SOILS SPECIFICATION: A WELL BLENDED MIXTURE (BY VOLUME)

*THE AMENDED SOIL MIX SHALL BE INSPECTED AND TESTED DURING INSTALLATION BY A GEOTECHNICAL ENGINEER TO VERIFY ACCEPTABILITY OF

0.50 IN/HR (MIN.) TO 1.00 IN/HR (MAX.)*


THE MIXTURE AND PERMEABILITY.

BMP #2 M.R. BIORETENTION AREA

CROSS-SECTION

TYPICAL BIORETENTION AREA NOTES:

- 1. CONTRACTOR SHALL TREAT COMPACTED SUBGRADE SOILS AS SPECIFIED IN THE SOIL AMENDMENT SPECIFICATION PRIOR TO
- PLACEMENT OF THE UNDERDRAIN AND SOIL AMENDMENT SHOWN ON SHEET 9F. 2. IN THE EVENT THAT SEDIMENT IS INTRODUCED INTO THE BMP DURING OR IMMEDIATELY FOLLOWING EXCAVATION, THIS MATERIAL SHALL BE REMOVED FROM THE PRACTICE PRIOR TO CONTINUING CONSTRUCTION.
- 3. GRADING OF AREAS SHALL BE ACCOMPLISHED USING LOW-COMPACTION EARTH-MOVING EQUIPMENT TO PREVENT COMPACTION OF UNDERLYING SOILS. 4. ALL SUB MATERIALS BELOW THE SPECIFIED BIORETENTION DEPTH (ELEVATION) SHALL BE UNDISTURBED, UNLESS OTHERWISE
- 5. CONTRACTOR SHOULD PROVIDE A ONE-YEAR 100% CARE AND REPLACEMENT WARRANTY FOR ALL PLANTING BEGINNING AFTER INSTALLATION AND INSPECTION OF ALL PLANTS.
- 6. REFER TO OPERATIONS AND MAINTENANCE PLAN FOR POST-DEVELOPMENT CONSTRUCTION SEQUENCING AND MAINTENANCE 7. ALL CONNECTIONS TO INLET/OUTLET STRUCTURES AND CLEANOUT PIPES SHALL HAVE WATERTIGHT SEALS.

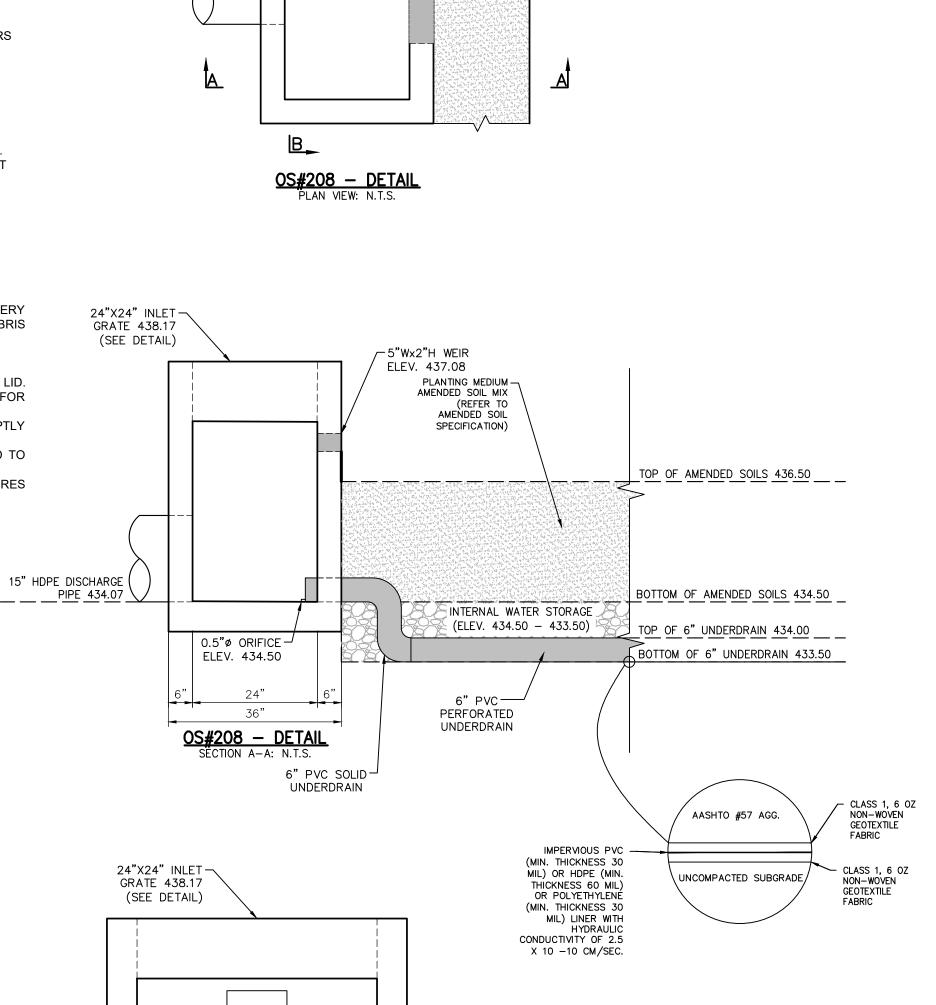

PERFORATED


DISCHARGE

UNDERDRAIN

— 5"Wx2"H WEIR, INV. 437.08

POST-CONSTRUCTION STORMWATER **MANAGEMENT** NOTES/DETAILS

| 04/11/2025 | REVISED PER MCCD REVIEW LETTER DATED 03/25/2025 CONSTRUCTION PLANS UPPER POTTSGROVE MUNICIPAL COMPLEX

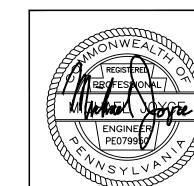

-5"Wx2"H WEIR

ELEV. 437.08

└6"ø PIPE/ 0.5"ø ORIFICE


OS#208 — DETAIL SECTION B-B: N.T.S.

ELEV. 434.50


ITEMS INCLUDED IN 04/11/2025 REVISIONS:


GEOTEXTILE FABRIC, AND CLEANOUT.

- PROFESSIONAL SEAL ADDED TO PLAN. - BMP #1 DETAIL REVISED TO INCLUDE UNDERDRAIN, STONE,

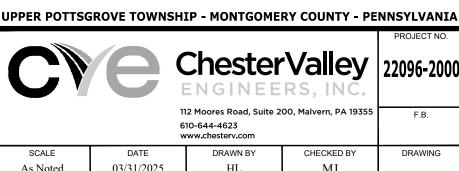

MONTGOMERY COUNTY BLOCK 60-3 UNIT 12

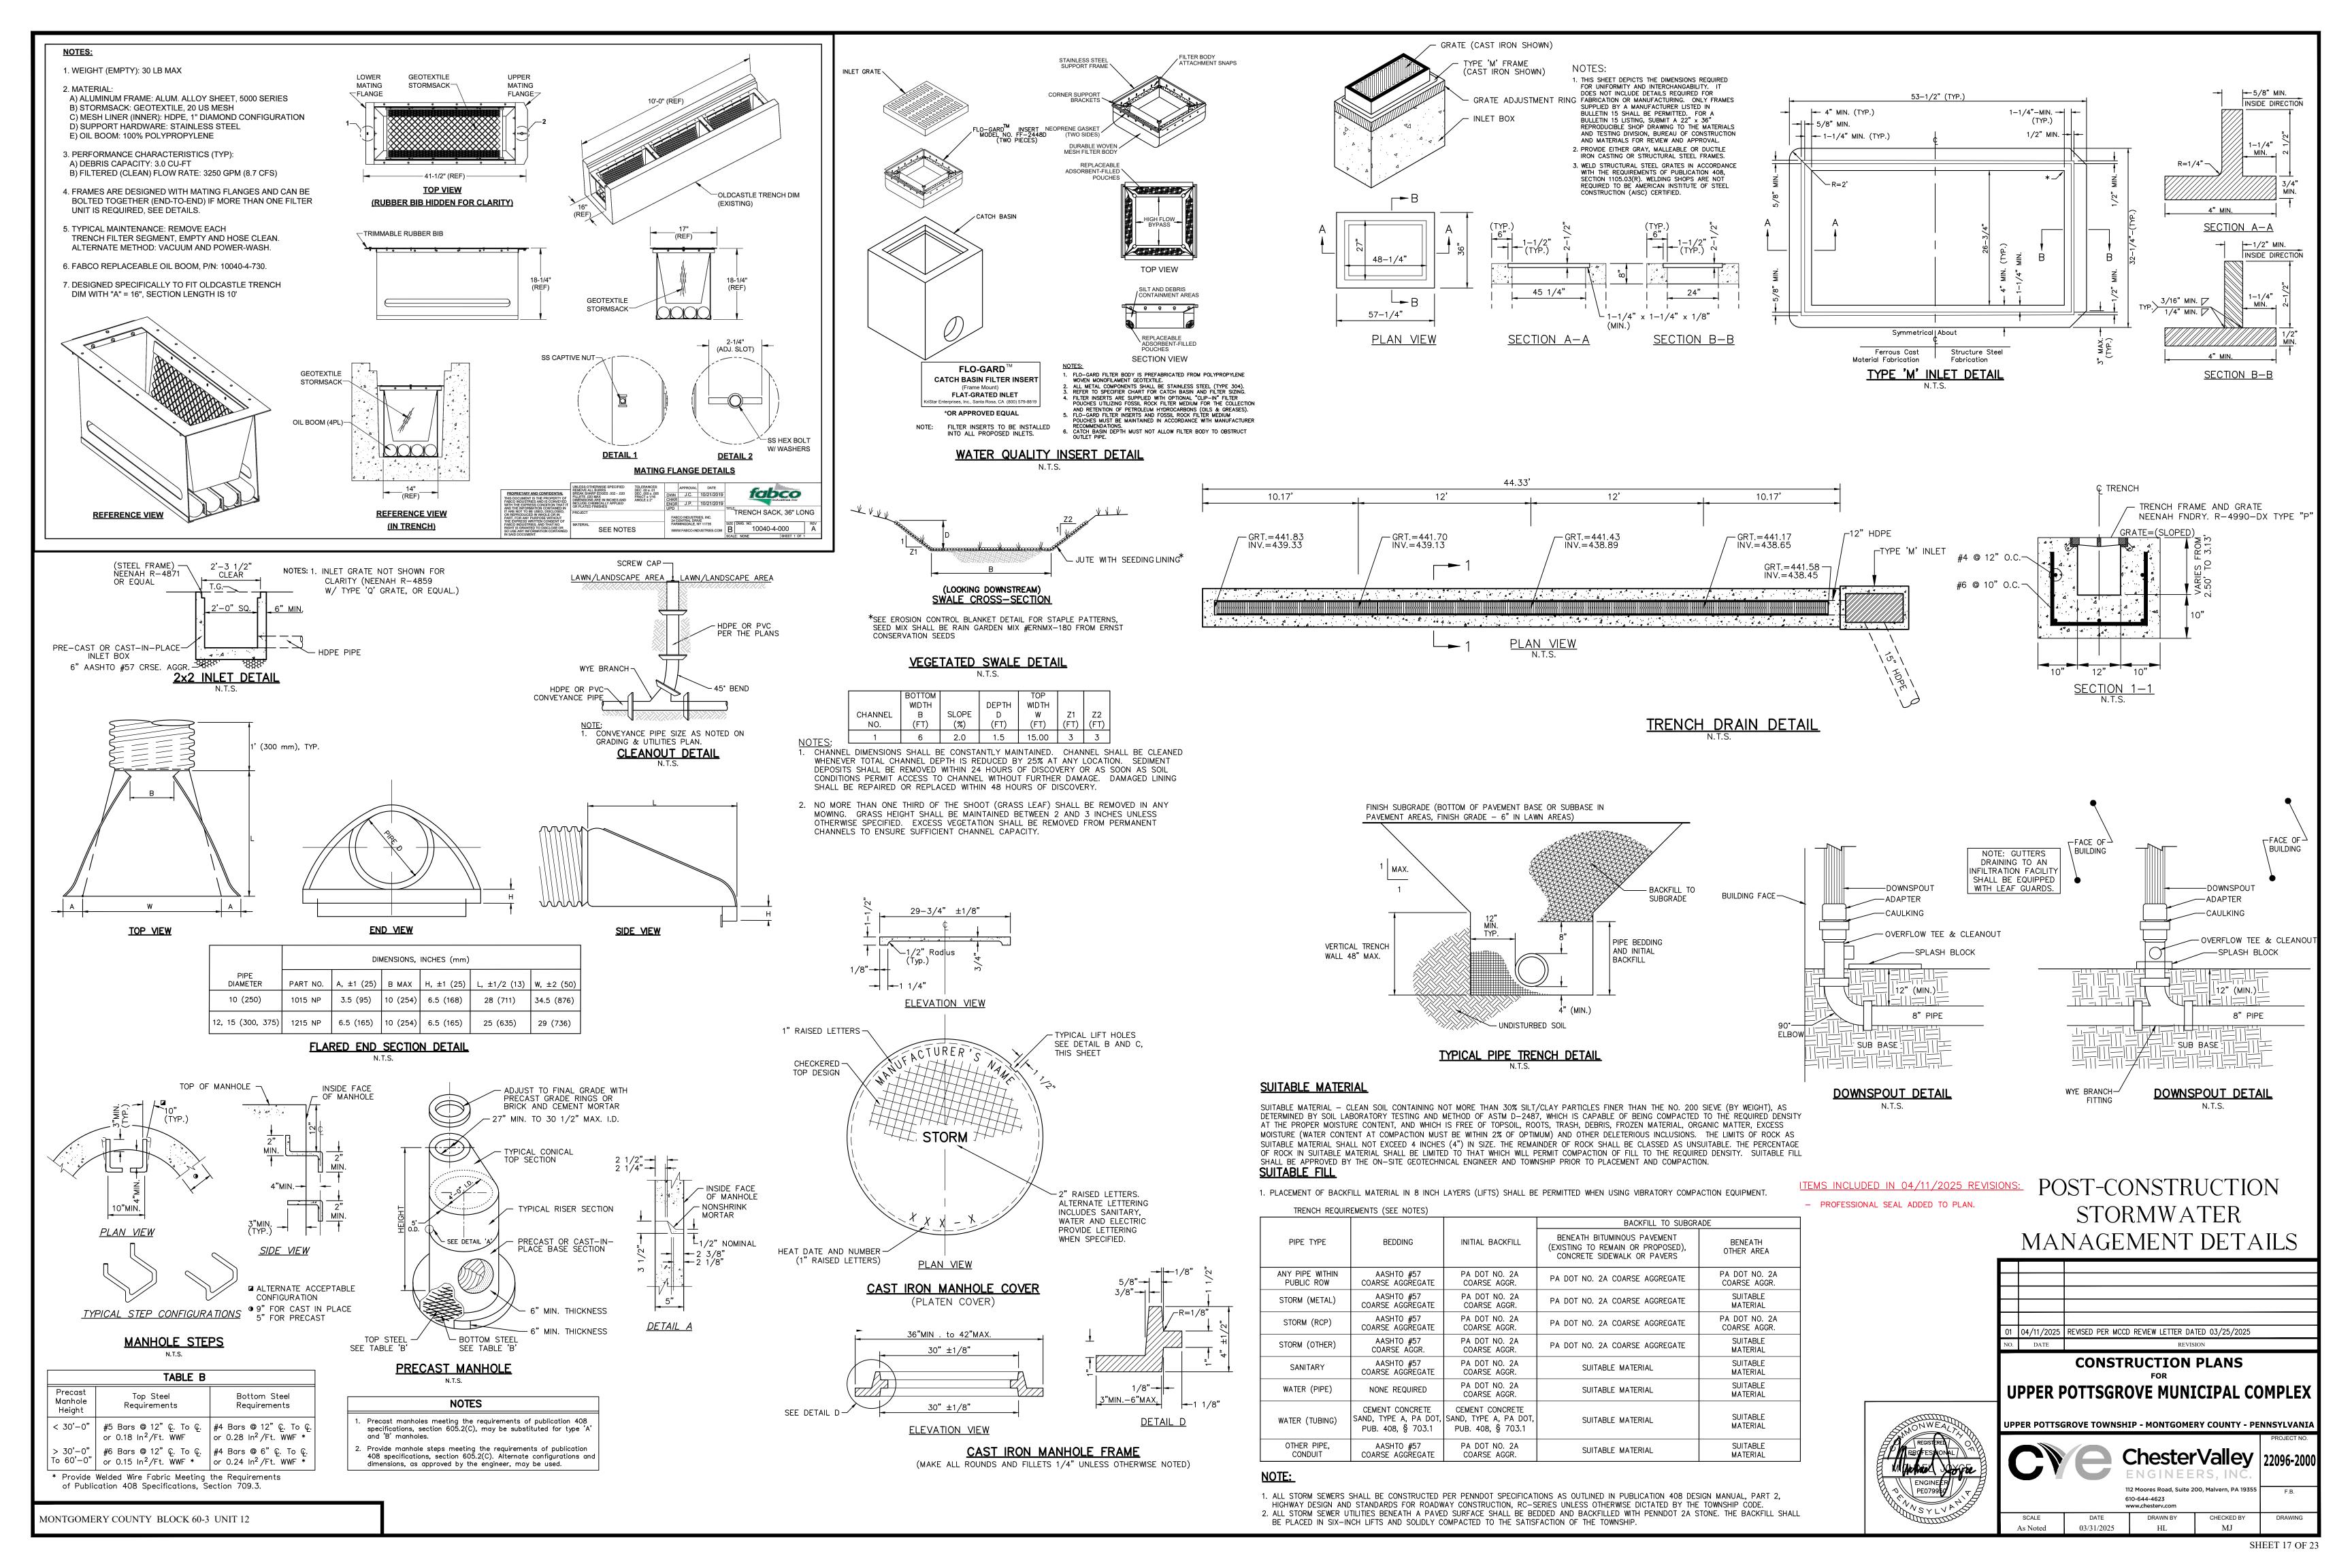

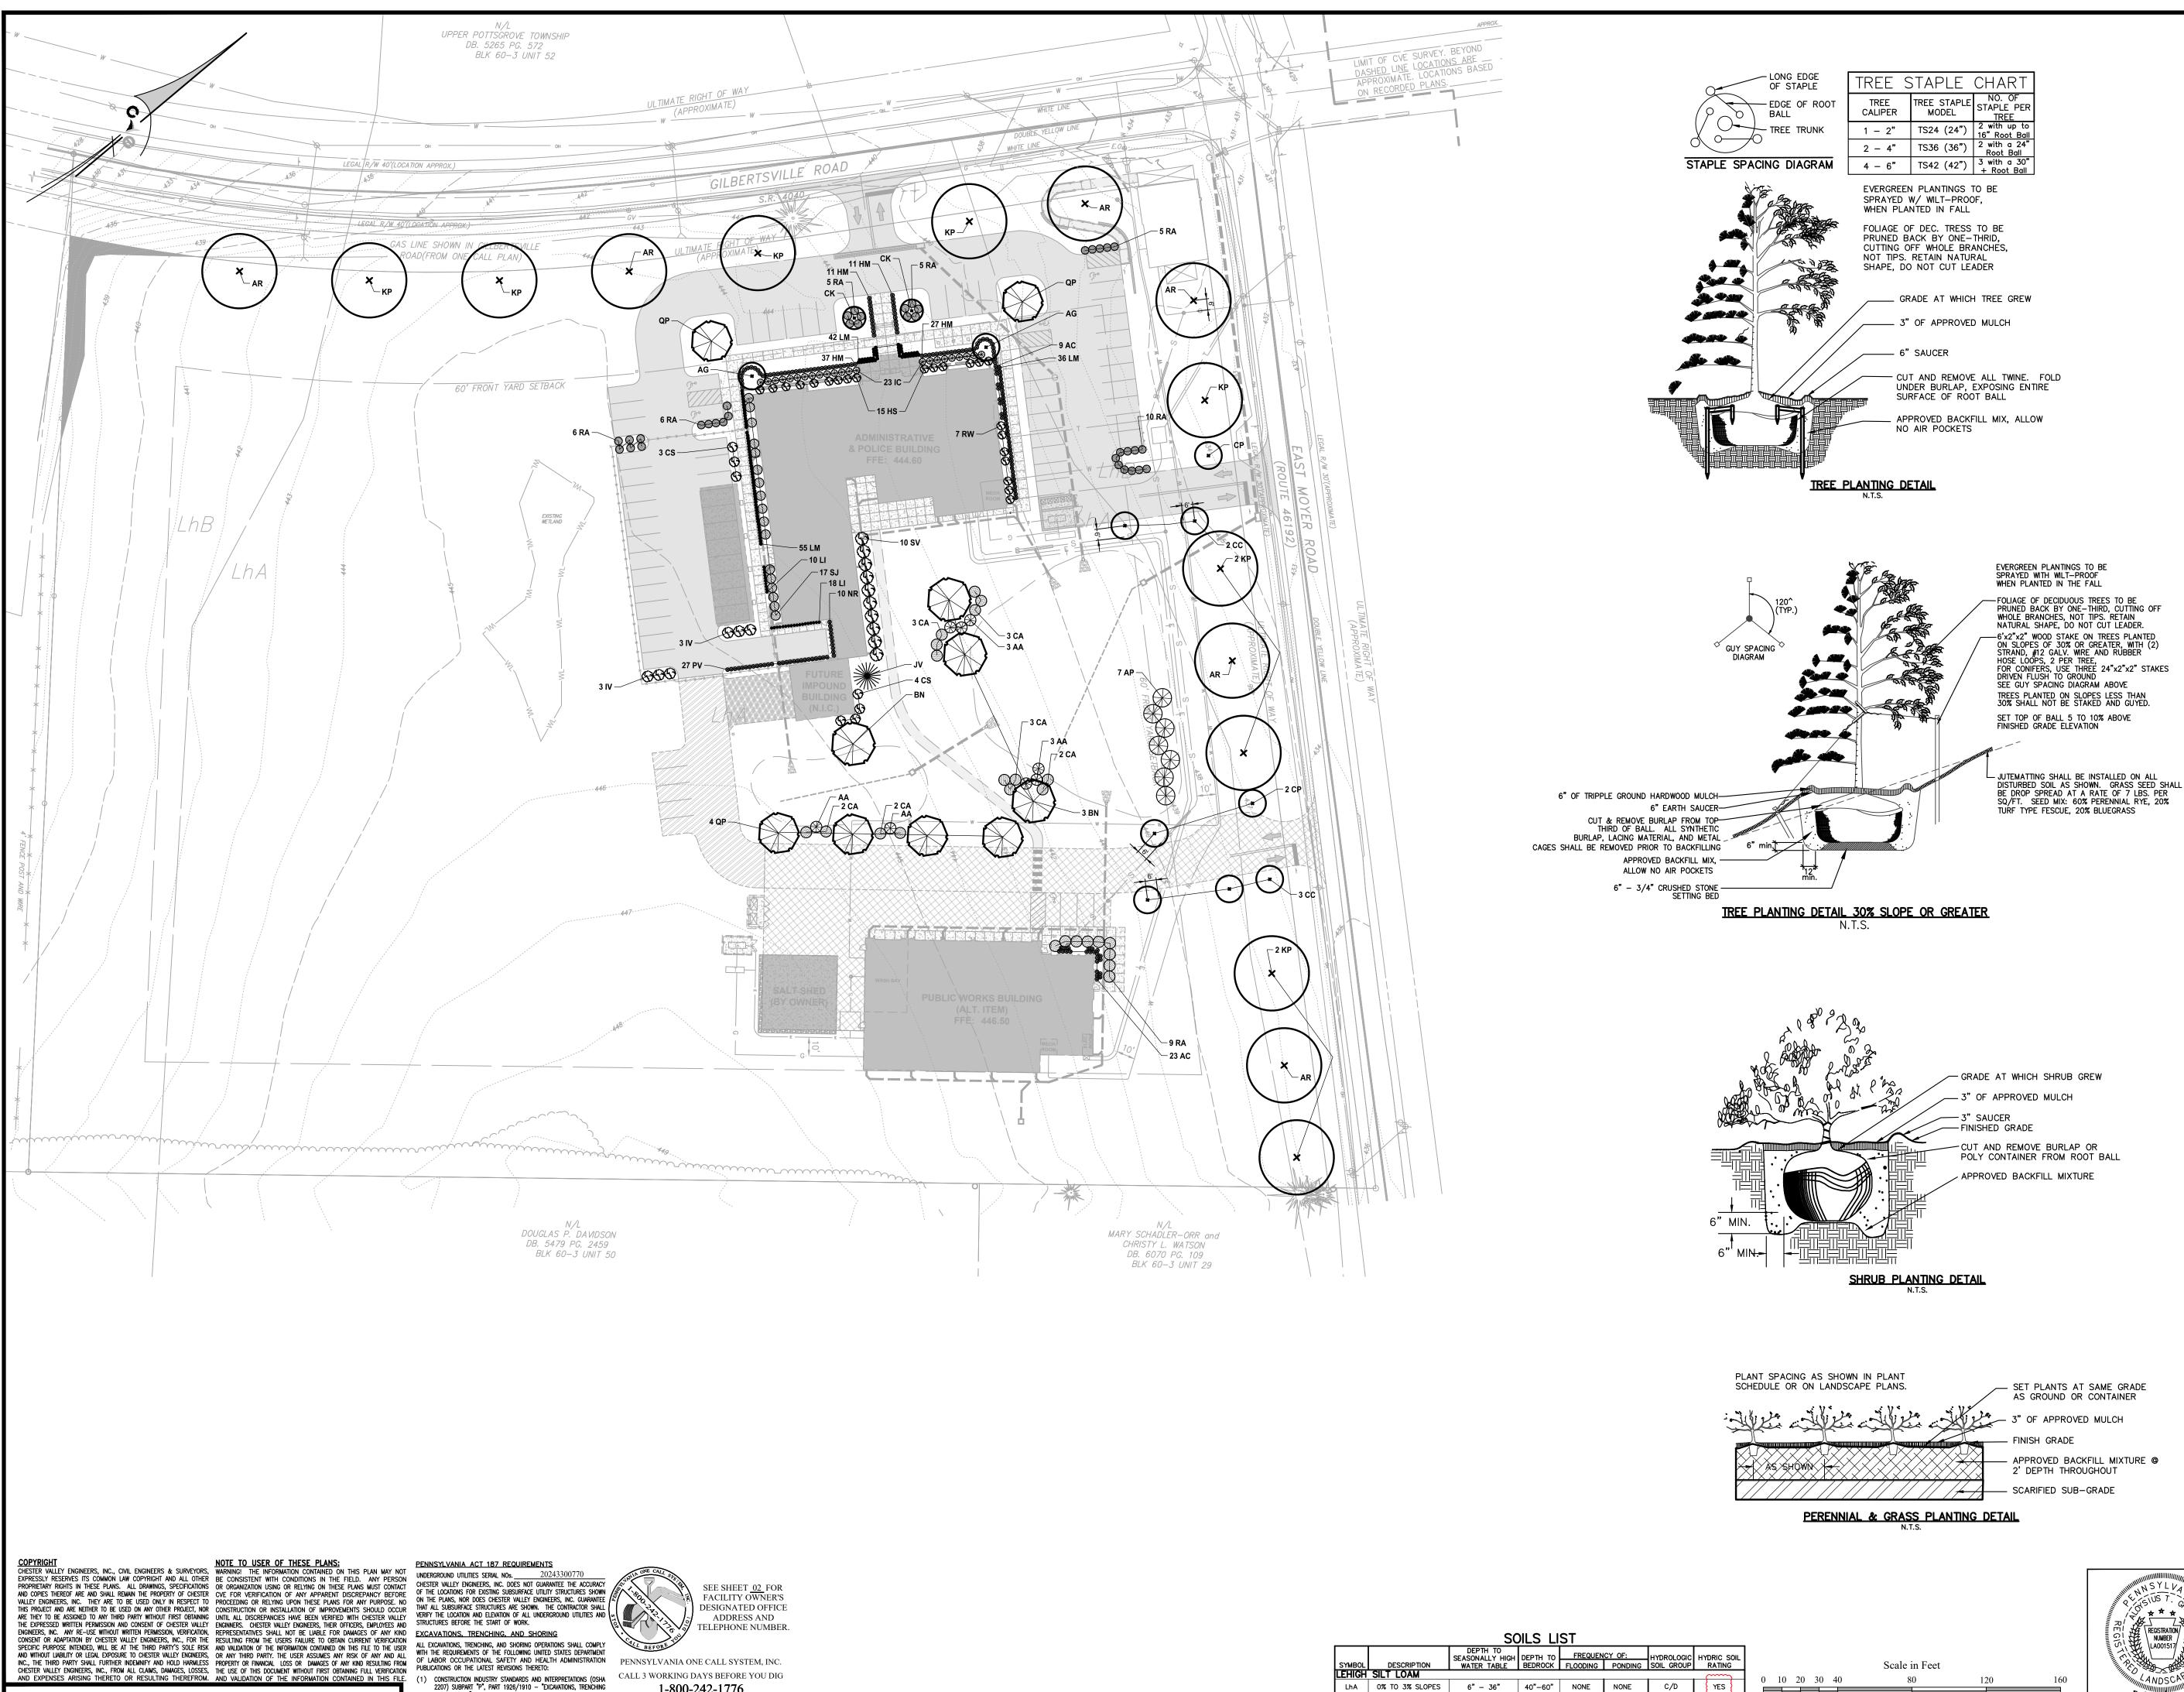


CONSTRUCTION INDUSTRY STANDARDS AND INTERPRETATIONS (OSHA 2207) SUBPART "P", PART 1926/1910 — "EXCAVATIONS, TRENCHING AND SHORING".

MONTGOMERY COUNTY BLOCK 60-3 UNIT 12

(2) "EXCAVATIONS AND TRENCHING OPERATIONS" (OSHA 2226) DATED POCS SERIAL NUMBER: 20243300770 1985 (REVISED).

1-800-242-1776

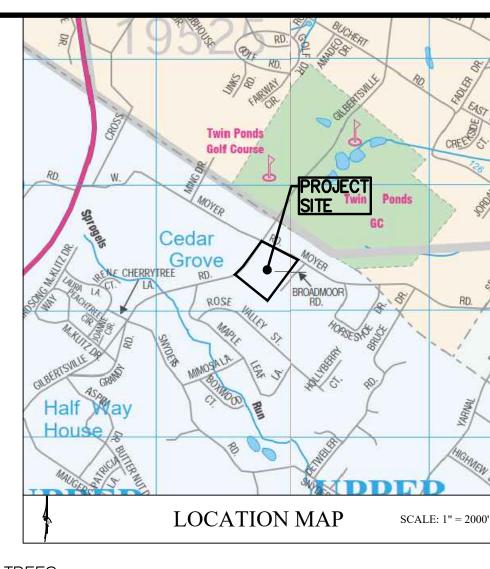

	N.L.L.O					
KEY	BOTANICAL NAME	COMMON NAME	SIZE	QTY	ZONE	DISTANCE
AG	Acer griseum	PAPERBARK MAPLE	2"-2.5" CAL.	2	4-8	AS SHOWN
AR	Acer rubrum	RED MAPLE	2"-2.5" CAL.	6	3-9	AS SHOWN
BN	Betula nigra	RIVER BIRCH	2"-2.5" CAL.	6	4-9	AS SHOWN
СС	Cercis canadensis	EASTERN REDBUD	2"-2.5" CAL.	5	4-9	AS SHOWN
СК	Cornus kousa	KOUSA DOGWOOD	2"-2.5" CAL.	2	5-8	AS SHOWN
СР	Crataegus phaenopyrum	WASHINGTON HAWTHORN	2"-2.5" CAL.	3	4-8	AS SHOWN
JV	Juniperus virginiana	EASTERN RED CEDAR	2"-2.5" CAL.	1	3-9	AS SHOWN
KP	Koelreuteria paniculata	GOLDEN RAIN TREE	2"-2.5" CAL.	9	6-9	AS SHOWN
QP	Quercus phellos	WILLOW OAK	2"-2.5" CAL.	6	6-9	AS SHOWN

SHRUBS

KEY	BOTANICAL NAME	COMMON NAME	SIZE	QTY	ZONE	DISTANCE
AA	Aronia arbutifolia	RED CHOKEBERRY	5 GAL.	13	3-9	6' O.C.
AP	Aesculus parviflora	BOTTLEBRUSH BUCKEYE	3 GAL.	8	4-8	10' O.C.
CA	Clethra alnifolia	SWEET PEPPERBUSH	4 GAL.	21	3-9	6' O.C.
cs	Cornus sericea 'Kelseyi'	REDTWIG DOGWOOD	2 GAL.	7	3-8	8' O.C.
HS	Hydrangea macrophylla 'Endless summer'	ENDLESS SUMMER HYDRANGEA	3 GAL.	15	4-9	5' O.C.
IC	llex crenata 'Compacta'	COMPACT JAPANESE HOLLY	2 GAL.	23	3-9	4' O.C.
IV	llex verticillata	WINTERBERRY	3 GAL.	6	3-9	6' O.C.
RA	Rhus aromatica 'Gro-Low'	GRO-LOW SUMAC	2 GAL.	51	3-9	AS SHOWN
RW	Rhododendron 'White Lights'	AZALEA WHITE LIGHTS	3 GAL.	7	4-8	6' O.C.
SJ	Spiraea janopica	JAPANESE SPIREA	3 GAL.	17	4-9	5' O.C.
SV	Spiraea x vanhouttei	VANHOUTTE SPIREA	4 GAL.	10	3-8	7' O.C.


PERENNIALS & GRASSES

KEY	BOTANICAL NAME	COMMON NAME	SIZE	QTY	ZONE	DISTANCE
AC	Astilbe 'Chocolate Cherry'	CHINESE ASTILBE 'CHOCOLATE CHERRY'	1 GAL.	32	3-8	2' O.C
НМ	Hakonechloa macra	HAKONE GRASS	1 GAL.	86	5-9	2' O.C.
LI	Lavandula x intermedia	PHENOMENAL LAVENDER	1 GAL.	28	5-9	2' O.C.
LM	Liriope Muscari 'Silvery Sunproof'	SILVERY SUNPROOF LILYTURF	1 GAL.	133	5-10	1.5' O.C.
NR	Nepeta racemosa	CATMINT	1 GAL.	10	4-8	2' O.C.
PV	Panicum virgatum 'Purple Tears'	PURPLE TEARS SWITCHGRASS	1 GAL.	27	4-9	2' O.C

ITEMS INCLUDED IN 04/11/2025 REVISIONS:

PROFESSIONAL SEAL ADDED TO PLAN.SOIL LIST CHART UPDATED.


LANDSCAPE PLAN/ DETAILS

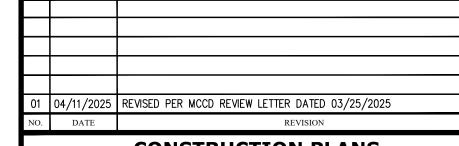

CONSTRUCTION PLANS

UPPER POTTSGROVE MUNICIPAL COMPLEX 2290 GILBERTSVILLE ROAD

UPPER POTTSGROVE TOWNSHIP - MONTGOMERY COUNTY - PENNSYLVANIA

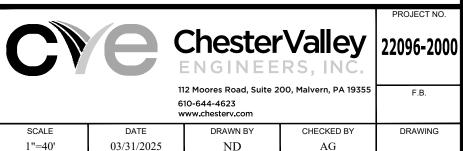

0 10 20 30 40 120 1'' = 40'


LhA 0% TO 3% SLOPES 6" - 36" 40"-60" NONE


LhB 3% TO 8% SLOPES 6" - 36" 40"-60" NONE

NONE


NONE

C/D

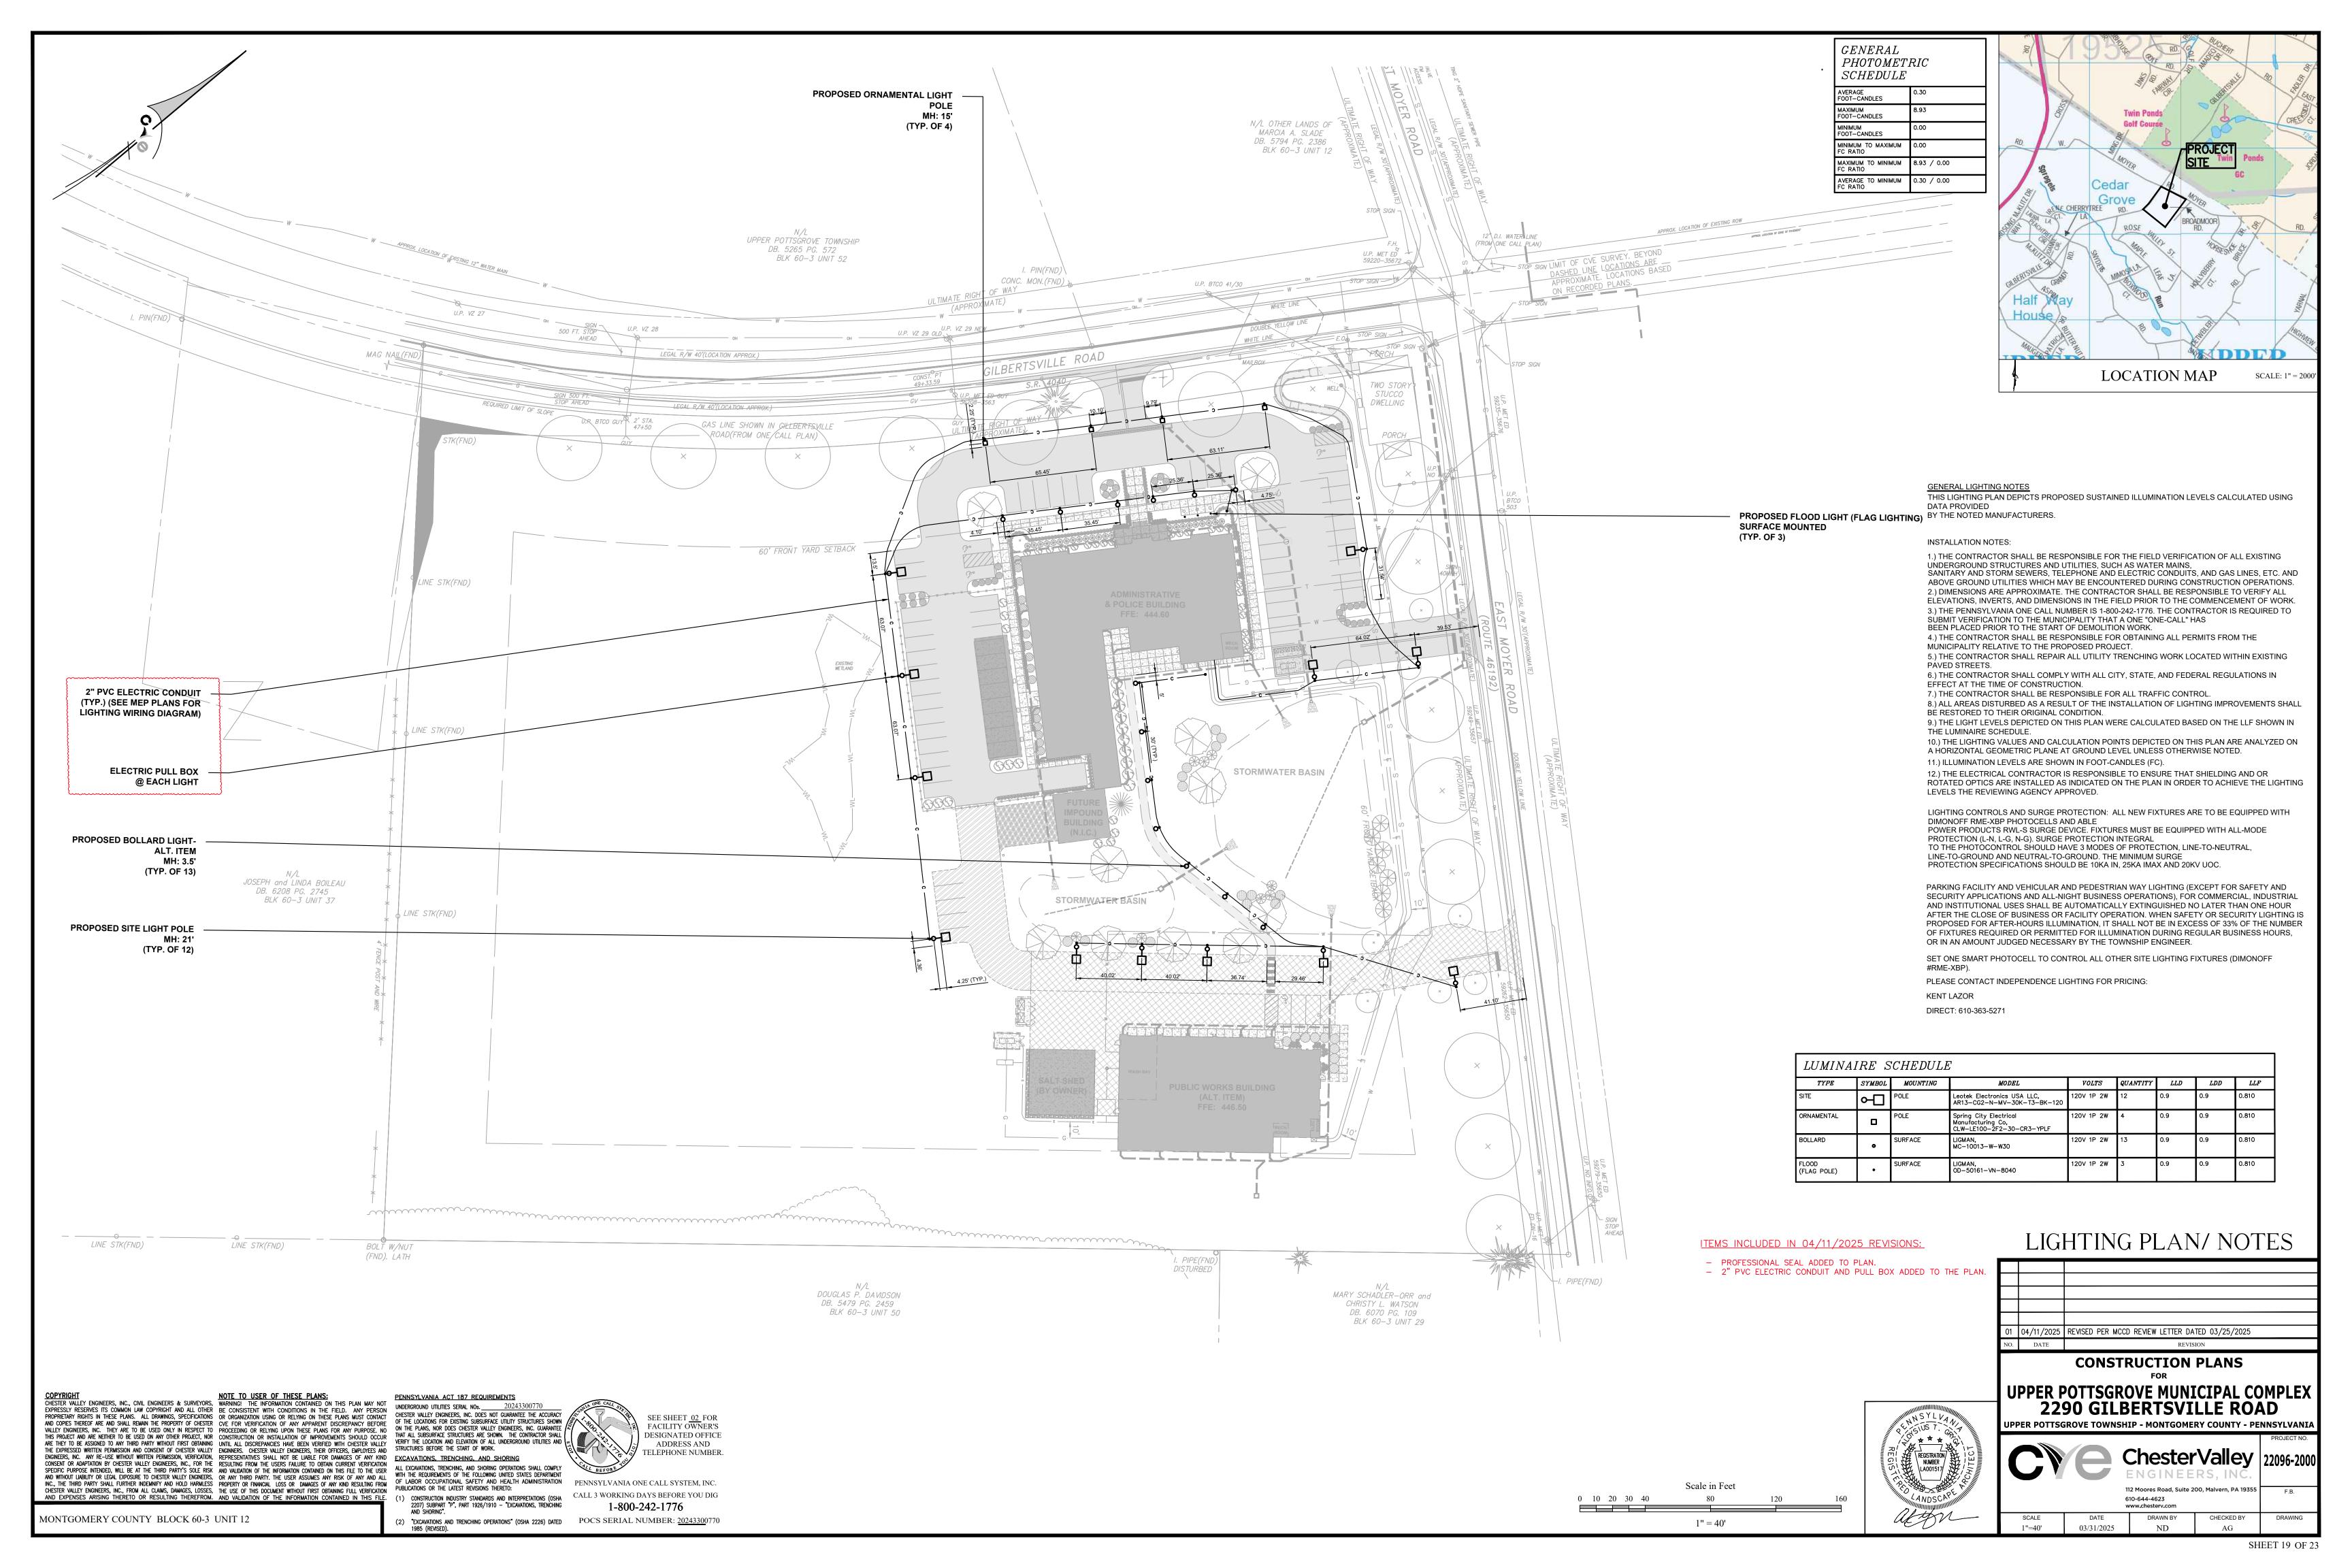


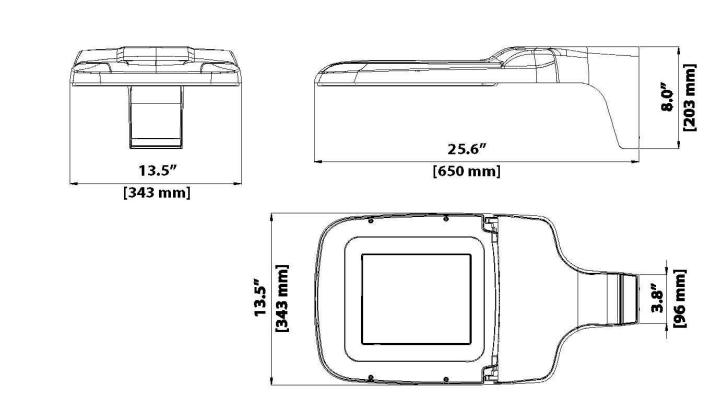

PARKING LIGHT FIXTURE DETAIL

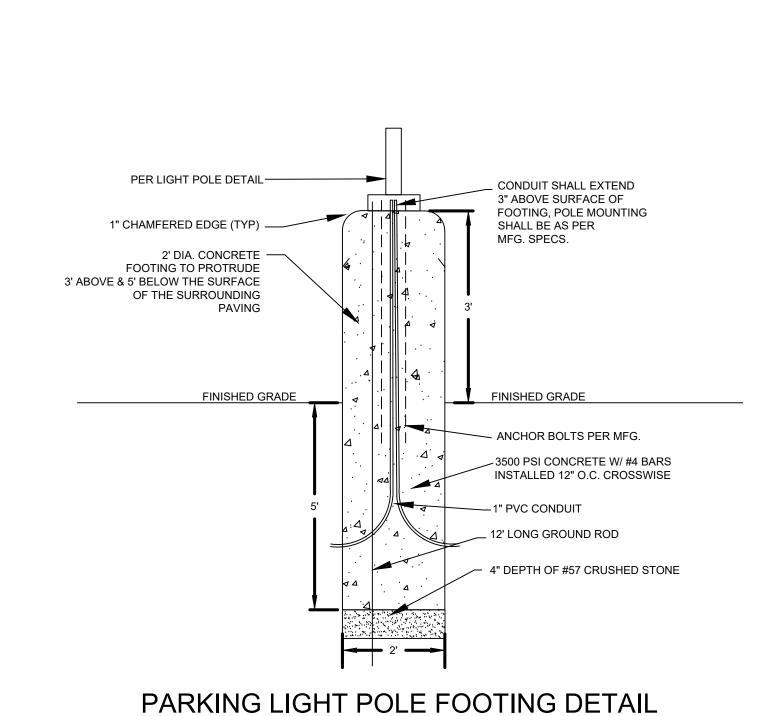


N.T.S.

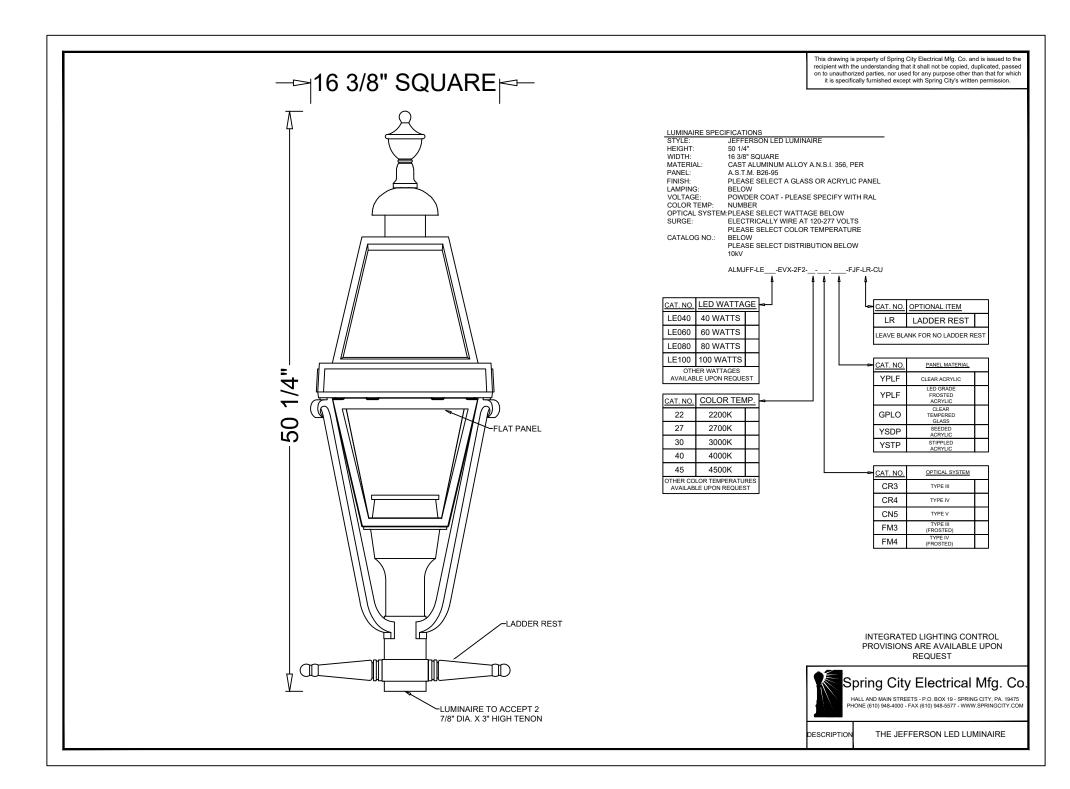

ORNAMENTAL LIGHT FIXTURE DETAIL N.T.S.

SPECIFICATION


SNSP-20-40-E2-AB

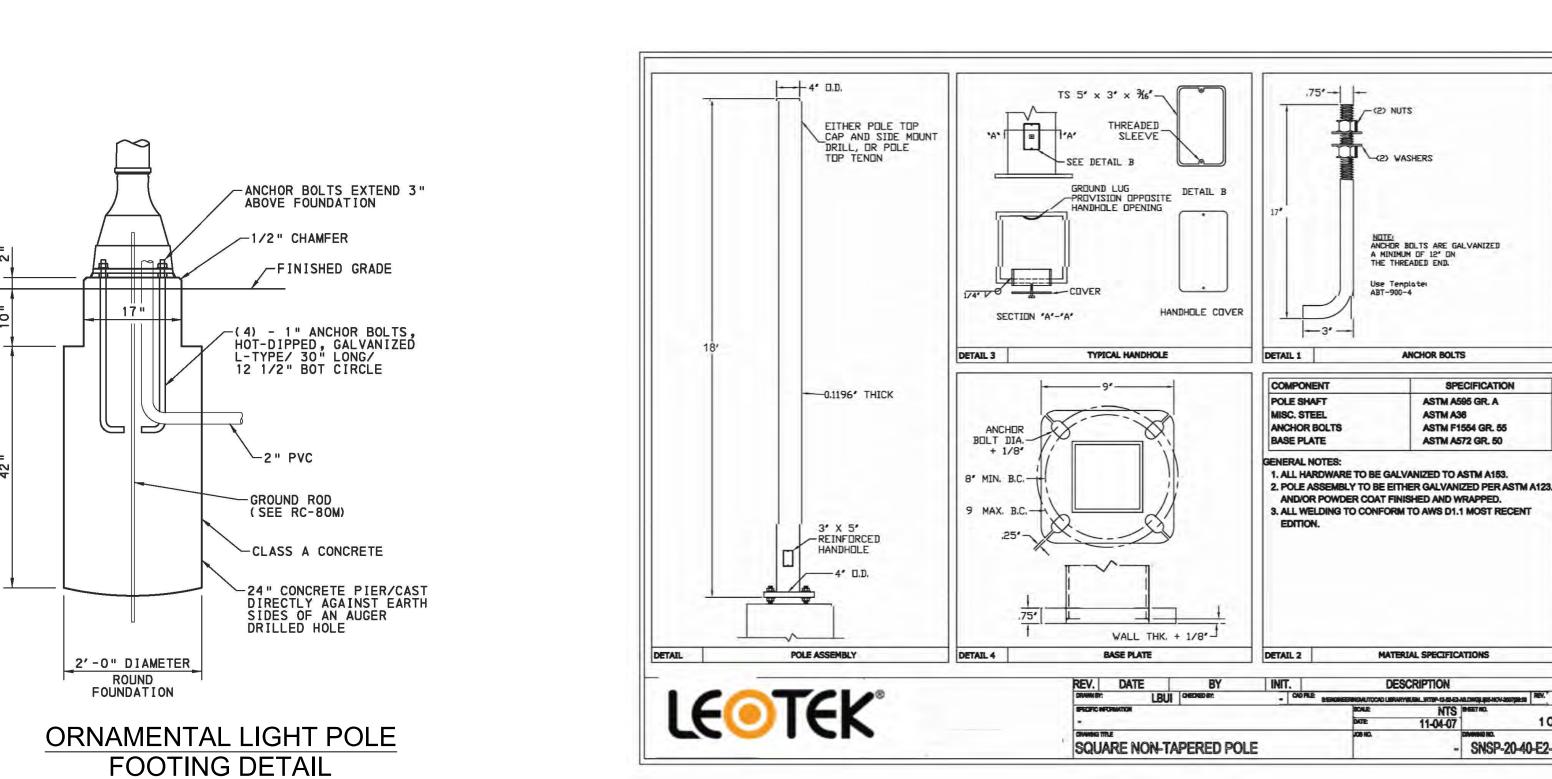


N.T.S.

MONTGOMERY COUNTY BLOCK 60-3 UNIT 12


PARKING LIGHT POLE DETAILS

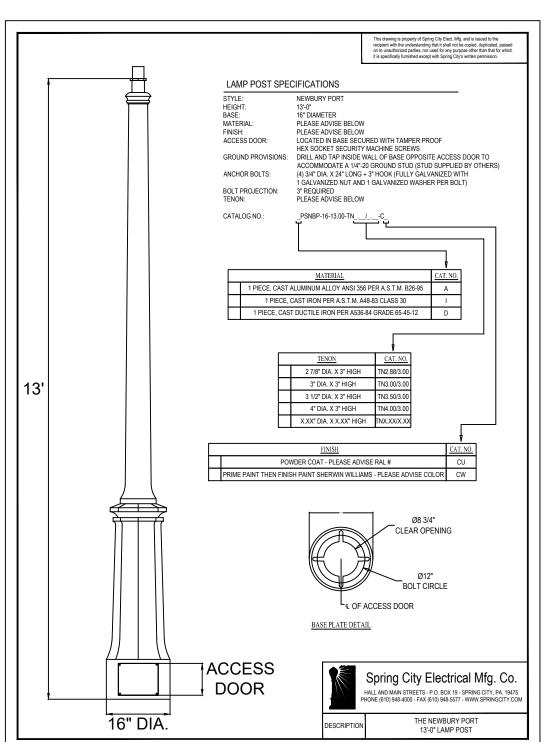


ORNAMENTAL LIGHT POLE DETAIL N.T.S.

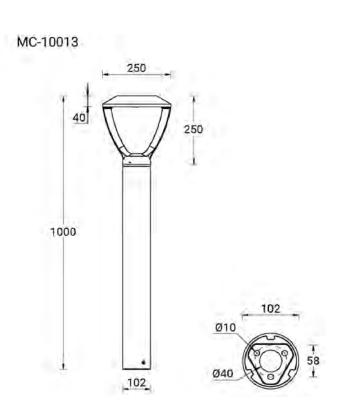

BOLLARD LIGHT DETAIL

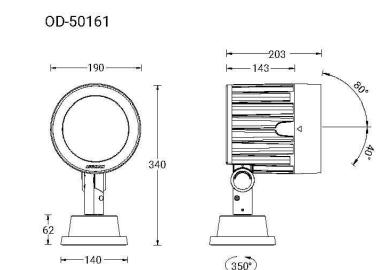

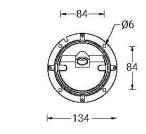


FLOOD LIGHT (FLAG POLE) DETAIL N.T.S.

ITEMS INCLUDED IN 04/11/2025 REVISIONS:

- PROFESSIONAL SEAL ADDED TO PLAN.



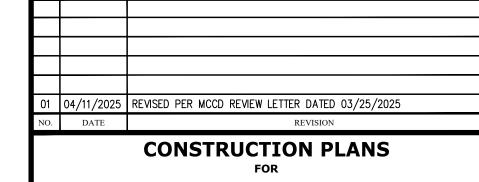

UPPER POTTSGROVE MUNICIPAL COMPLEX

UPPER POTTSGROVE TOWNSHIP - MONTGOMERY COUNTY - PENNSYLVANIA



03/31/2025

N.T.S.

alton

QTY: 3

PARKING LOT LUMINARY SPECIFICATIONS

DISTRIBUTION TYPE (SEE LUMINAIRE SCHEDULE)

OPTIONS: DIMONOFF PHOTOCELL & RWL-S SURGE DEVICE

MODEL: (SEE LUMINAIRE SCHEDULE)

BOLLARD LIGHT SPECIFICATIONS

IES FULL CUTOFF

COLOR: BRONZE

QTY: 13

LIGMAN - MACARON 5 BOLLARD LIGHT MODEL: (SEE LUMINAIRE SCHEDULE)

DISTRIBUTION TYPE (SEE LUMINAIRE SCHEDULE)

FLOOD LIGHT (FLAG POLE) SPECIFICATIONS

LIGMAN - ODESSA 14 OUTDOOR FLOODLIGHT

MODEL: (SEE LUMINAIRE SCHEDULE)

• OPTIONS: ANTI GLARE VISOR (A54431)

HIGH EFFICIENCY PMMA LENS
DISTRIBUTION TYPE: VN
COLOR: BRONZE

OPTIONS: DIMONOFF PHOTOCELL & RWL-S SURGE DEVICE

LEOTEK ARIETA LUMINARE


IES FULL CUTOFF


COLOR: BRONZE


QTY: 12

ChesterValley 22096-2000

SHEET 20 OF 23

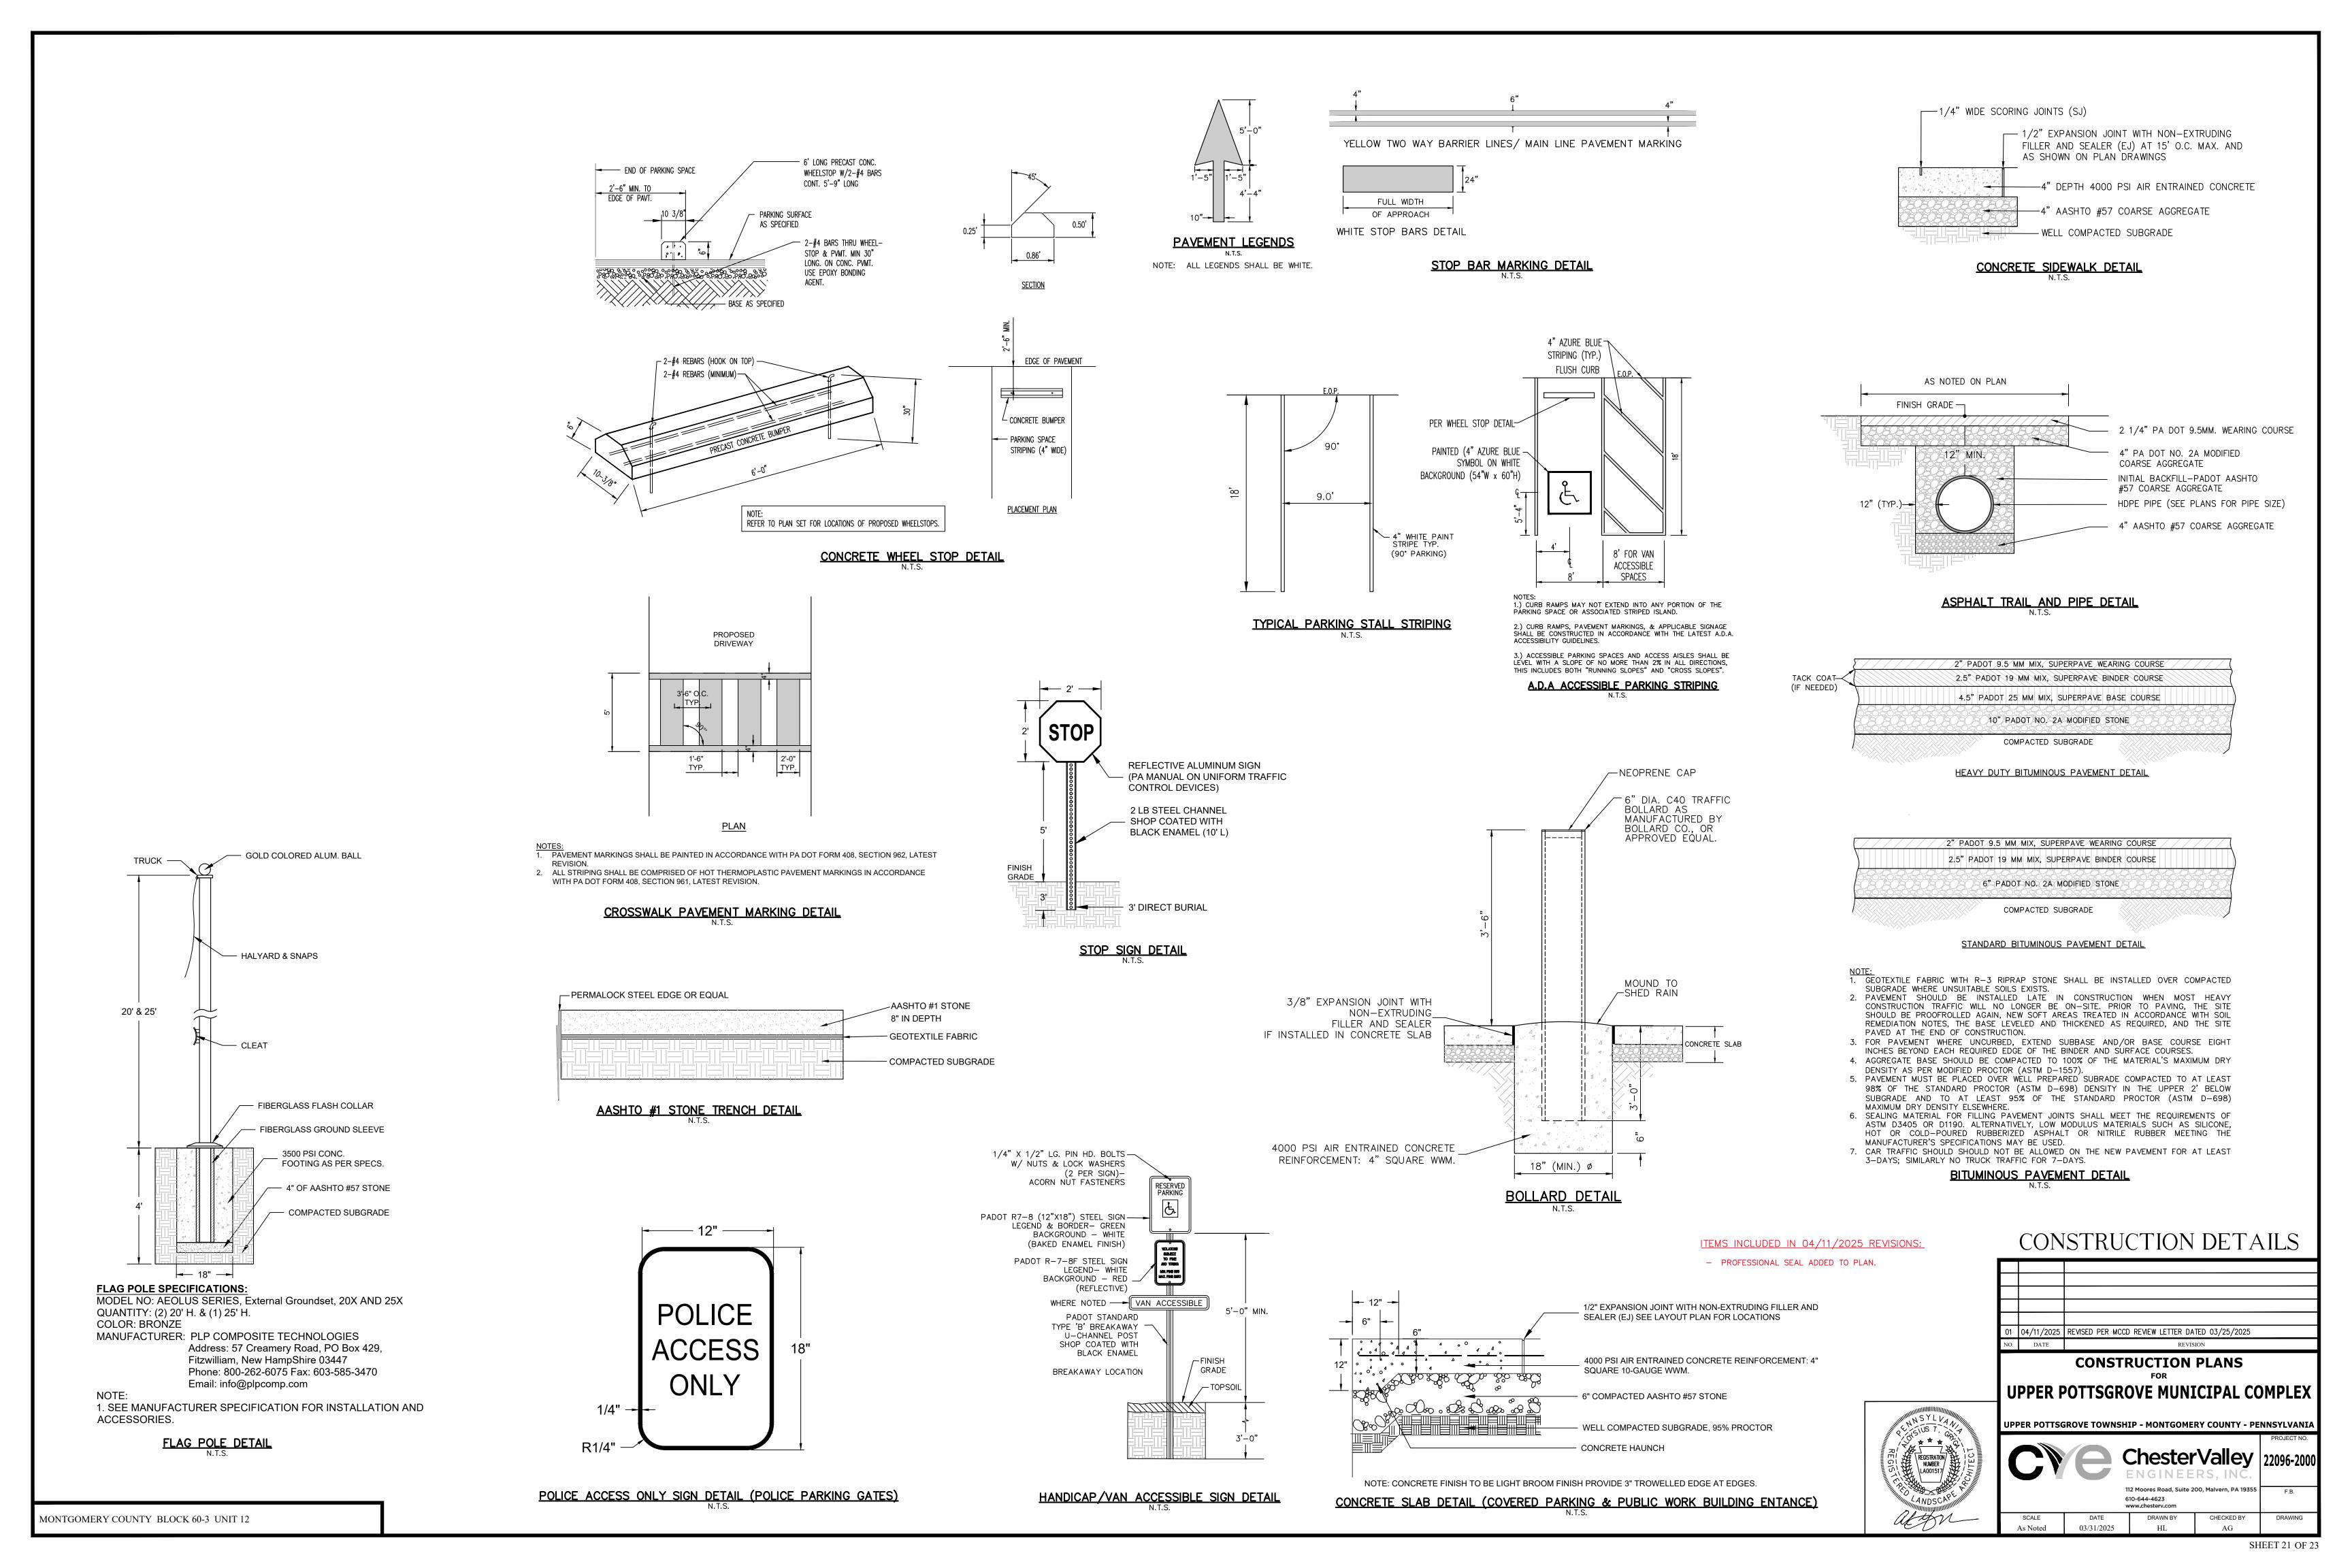

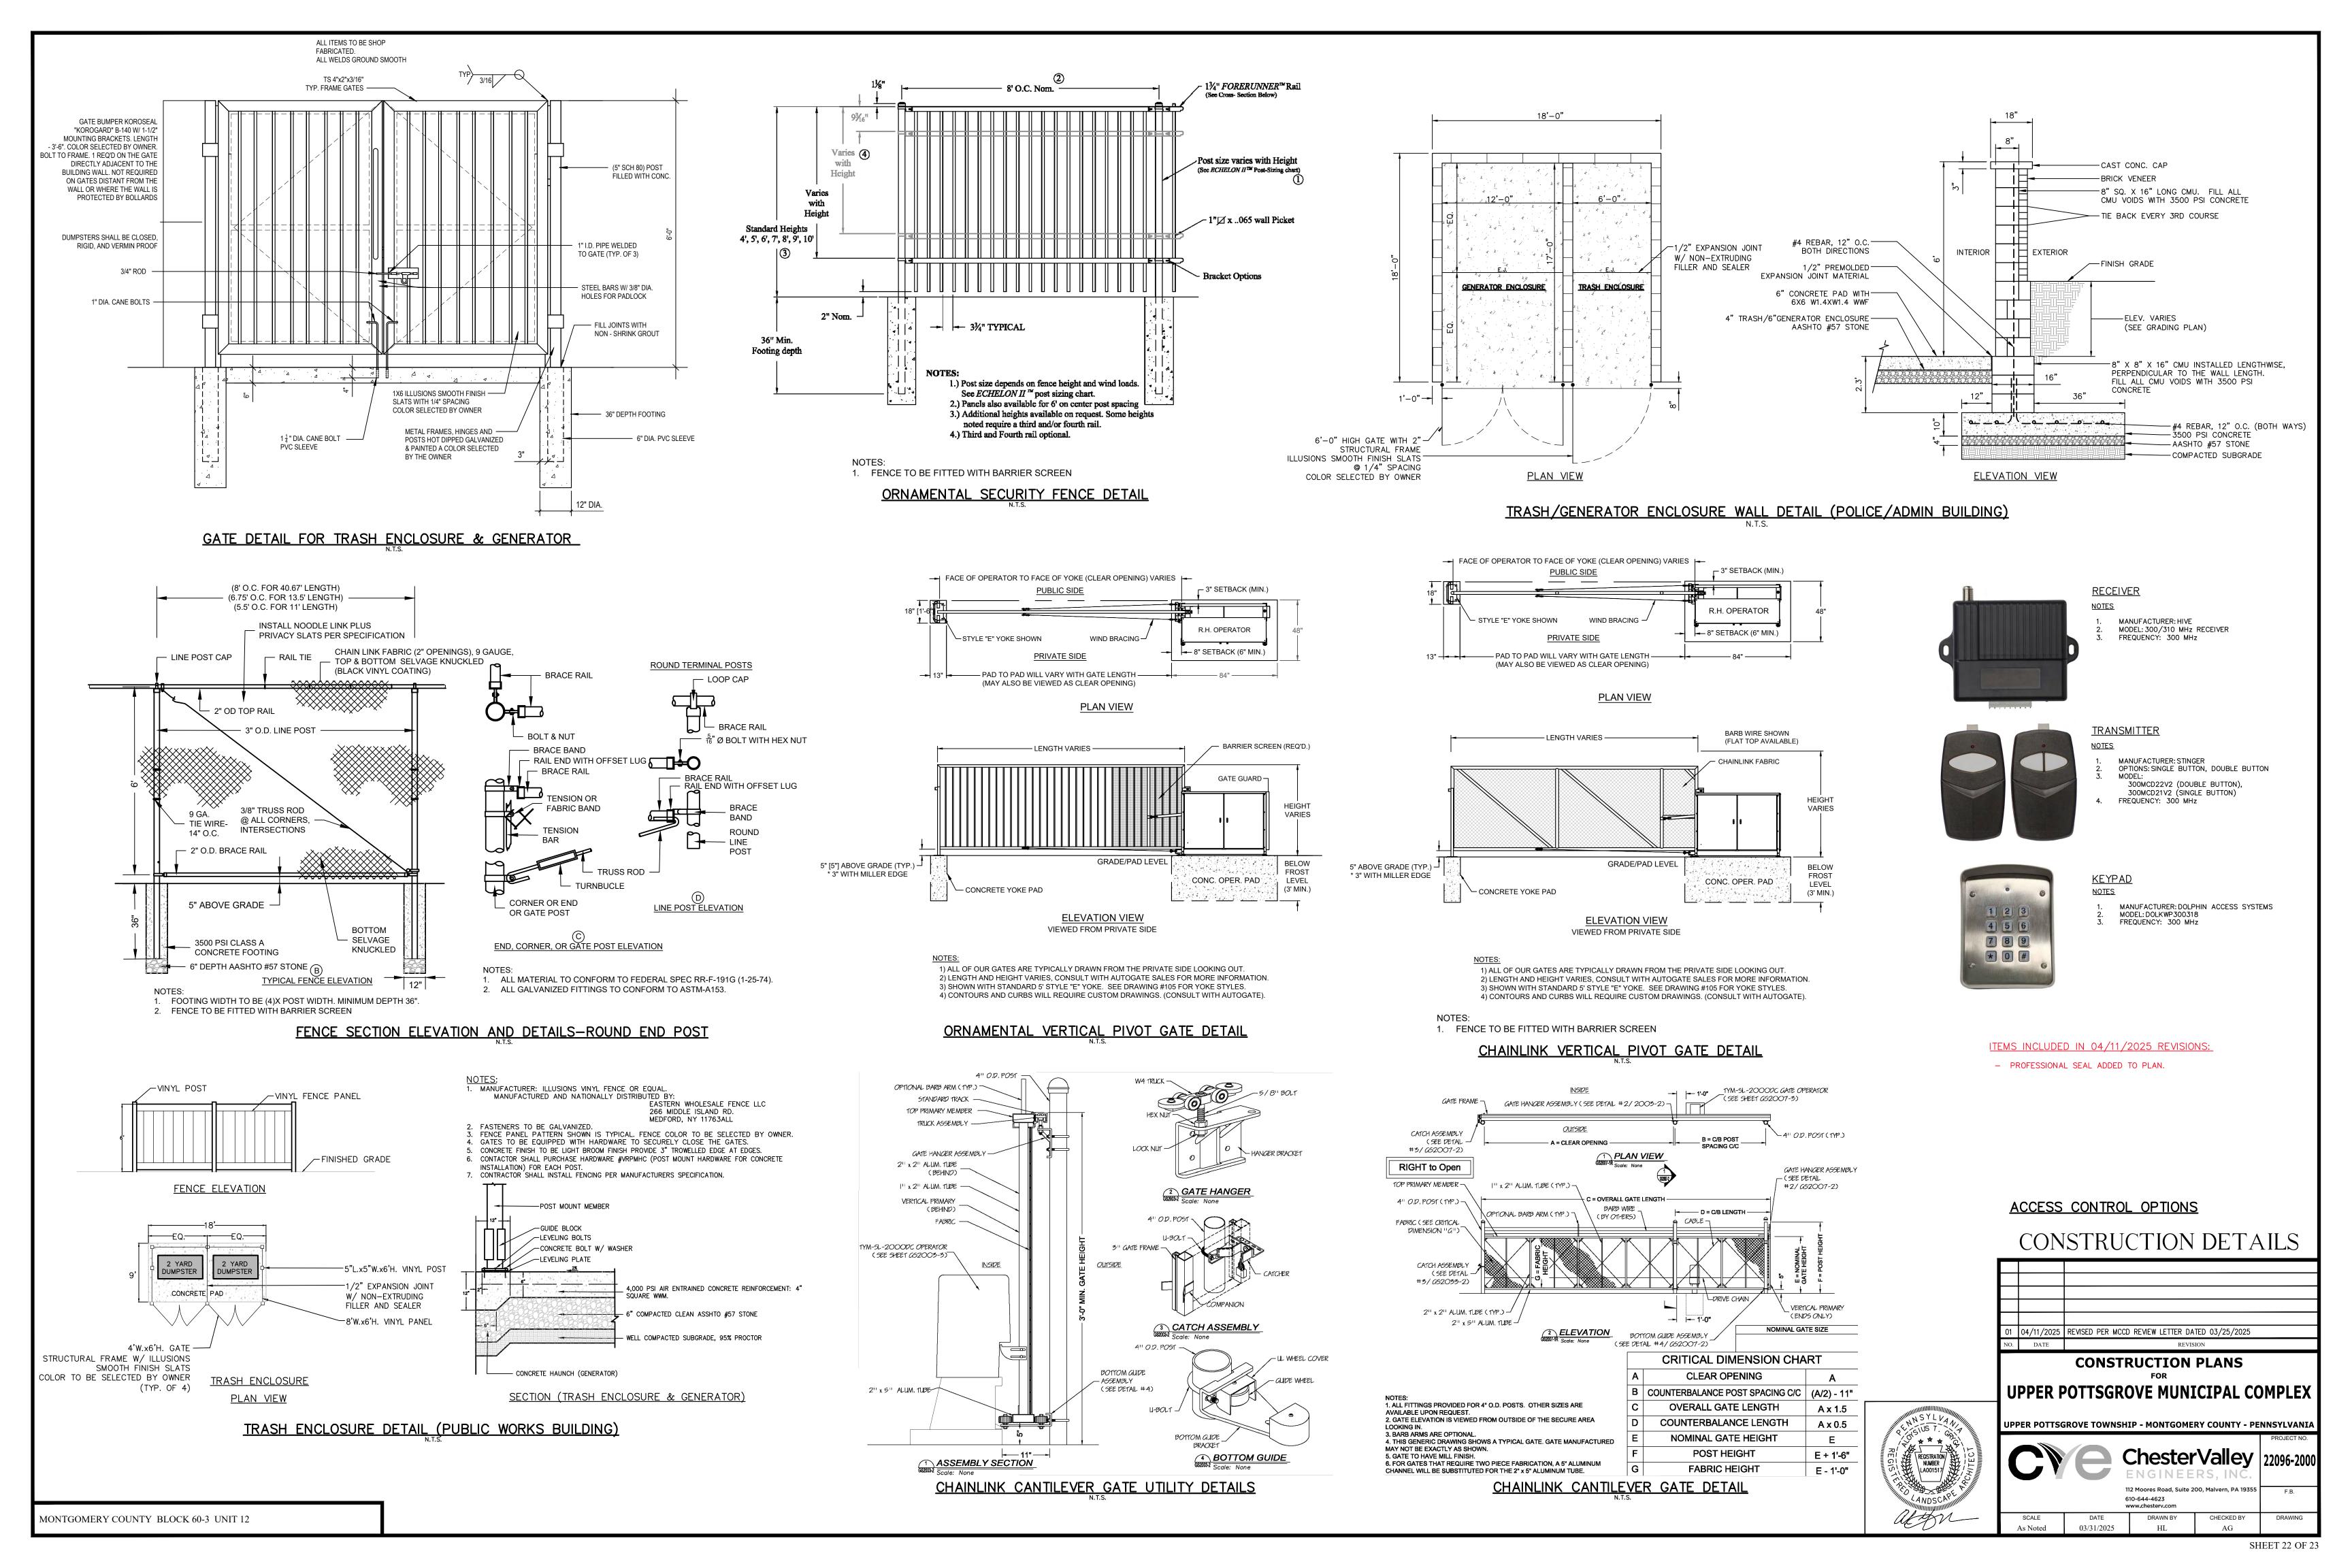

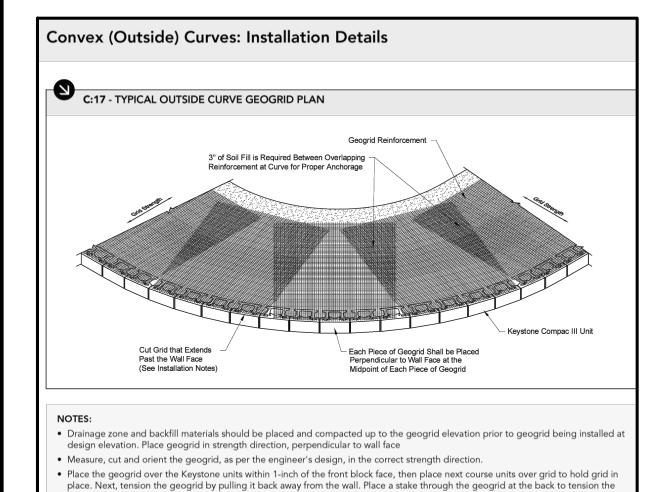



· Proceed with placement of additional Keystone units, then drainage zone and backfill material. Starting at the wall and moving away from the wall, place the drainage zone and backfill materials over the geogrid to hold the geogrid in place under tension.


• Cut grid that extends beyond curved wall face 1-inch back from wall face. The minimum geogrid length must match design length.


• Compact the backfill materials in 8-inch lifts up to the next reinforcement elevation.

• Where geogrid tail overlap naturally occurs, place 3-inches of rock or soil between the overlapping layers.

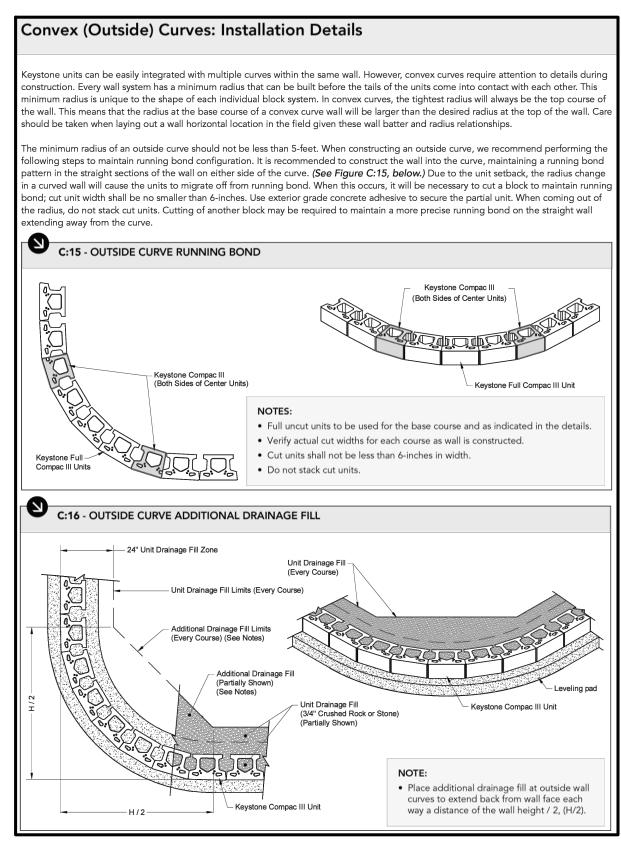

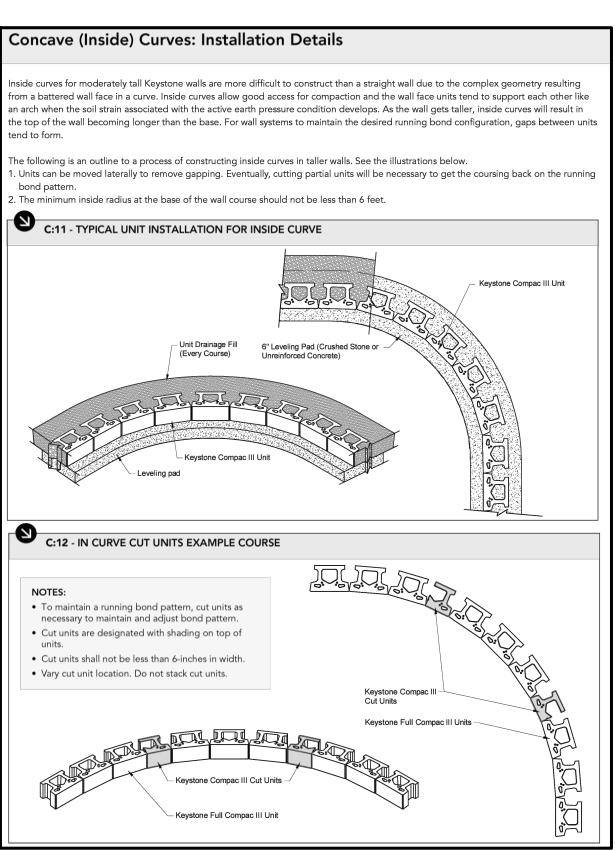


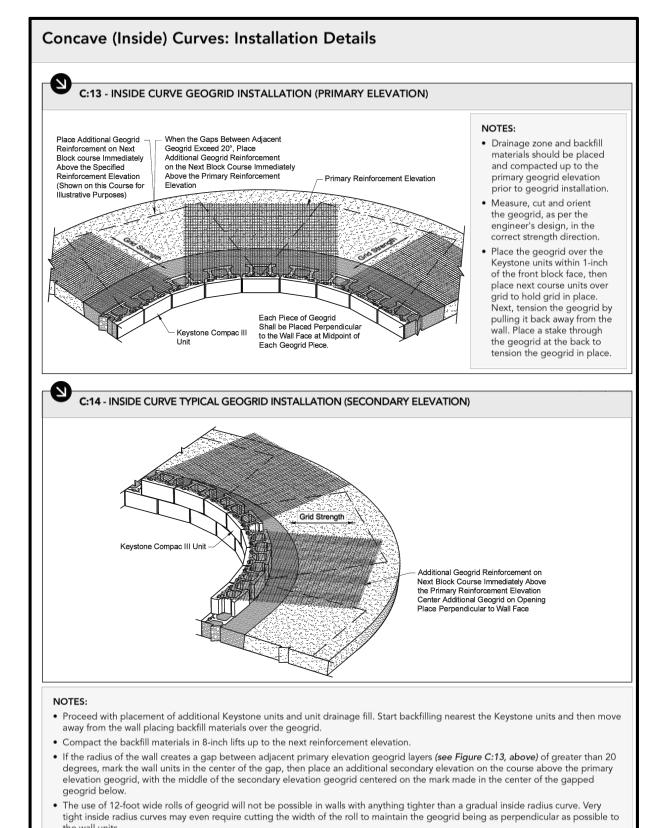

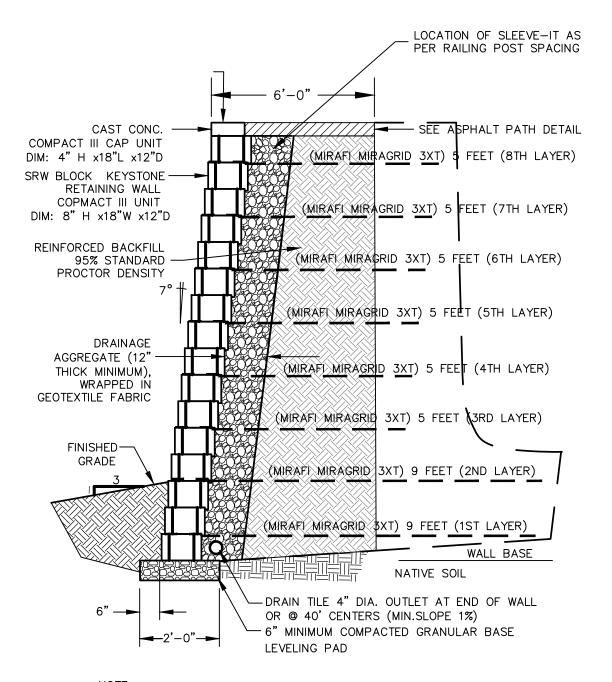



CONTRACTOR SHALL SUBMIT DETAILED DRAWINGS (SIGNED & SEALED BY REGISTERED ENGINEER) FOR REVIEW APPROVAL PRIOR TO INSTALLING PROPOSED WALLS. DETAILS SHALL INCLUDE THE PROPOSED SLEEVE AT ANCHORING SYSTEM.

KEYSTONE RETAINING WALL COMPACT III UNIT DETAIL

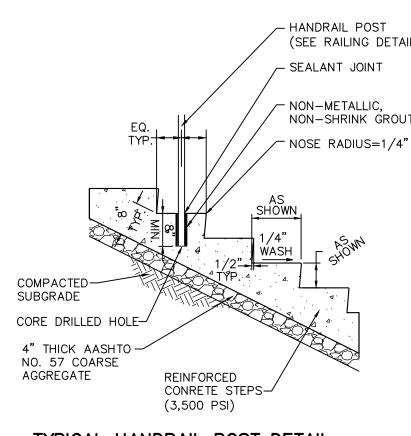


TYPICAL HANDRAIL POST DETAIL N.T.S.

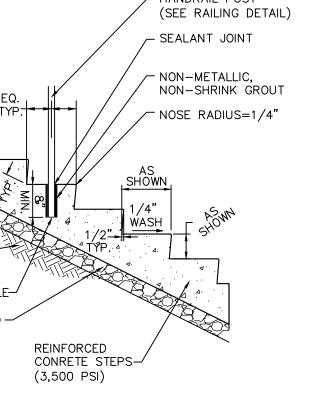

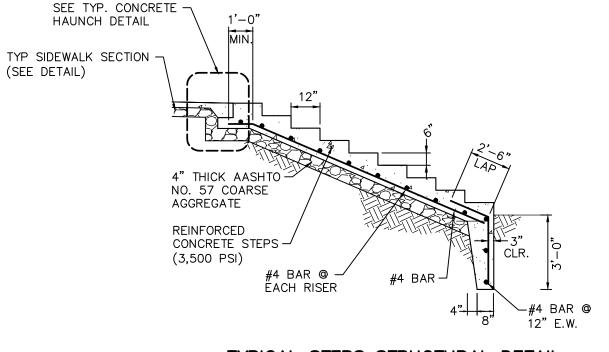

TYPICAL STEPS STRUCTURAL DETAIL N.T.S.

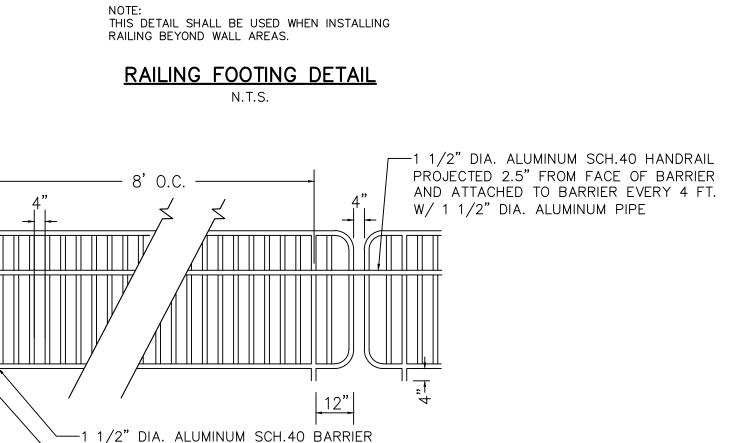

- PIPE, HEIGHT VARIES

CONCRETE FOOTING

EPOXY FILLED GAP (ALL POSTS)


ANCHOR ROD (IF NECESSARY)

COMPACTED SUBGRADE

CLASS A, 28 DAY, 3500PSI.


ADA ALUMINUM BARRIER AND HANDRAIL DETAIL

---PER RAILING FOOTING DETAL

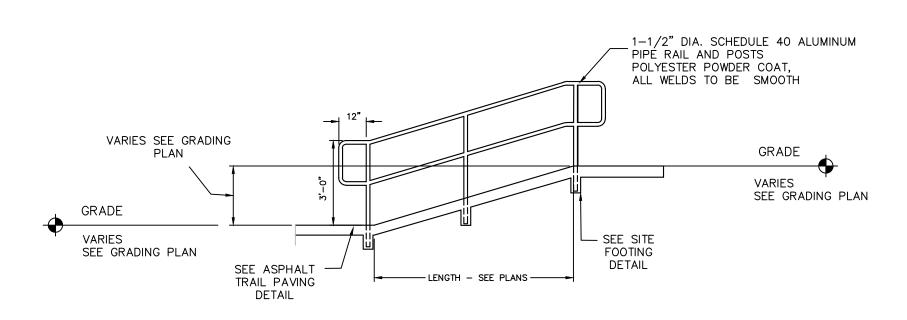


1. ALL RAMPS, LANDINGS AND RAILINGS SHALL COMPLY WITH THE APPROPRIATE BUILDING CODE.

TYPICAL HC RAMP & RAILING DETAIL N.T.S.

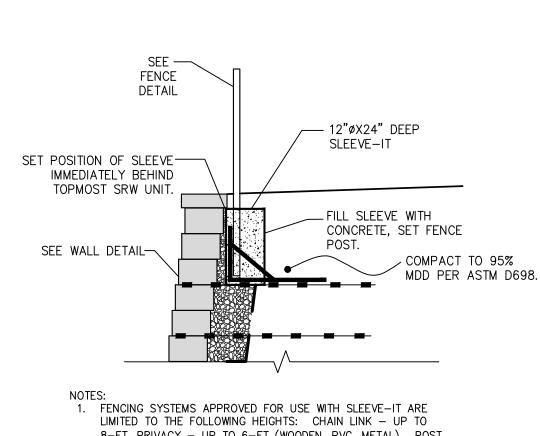

8-FT, PRIVACY - UP TO 6-FT (WOODEN, PVC, METAL). POST SIZE 4"X4" MAX. 2. THIS DETAIL SHALL BE USED FOR FENCE/RAILING INSTALLED BEHIND RETAINING WALL.

FENCE SLEEVE-IT DETAIL

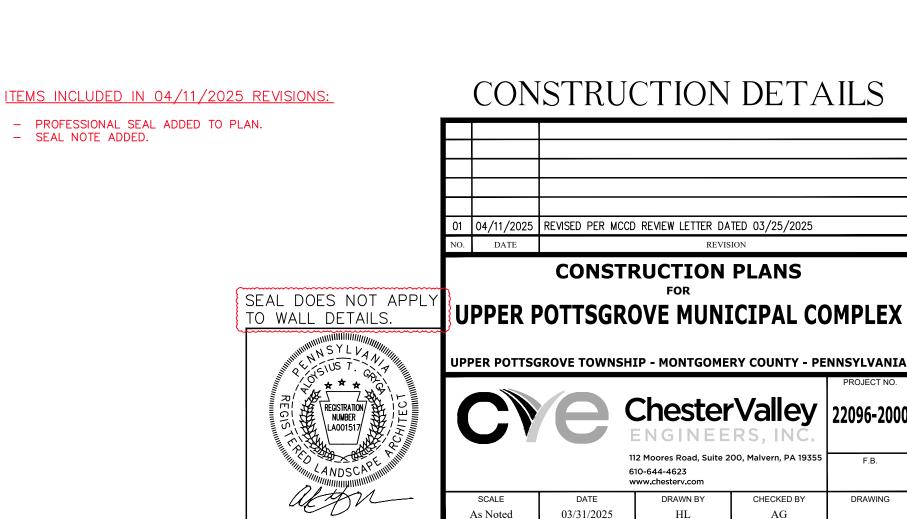

MONTGOMERY COUNTY BLOCK 60-3 UNIT 12