


1 2 3 4 5 6 7 8

A
B
C
D
E
F
G

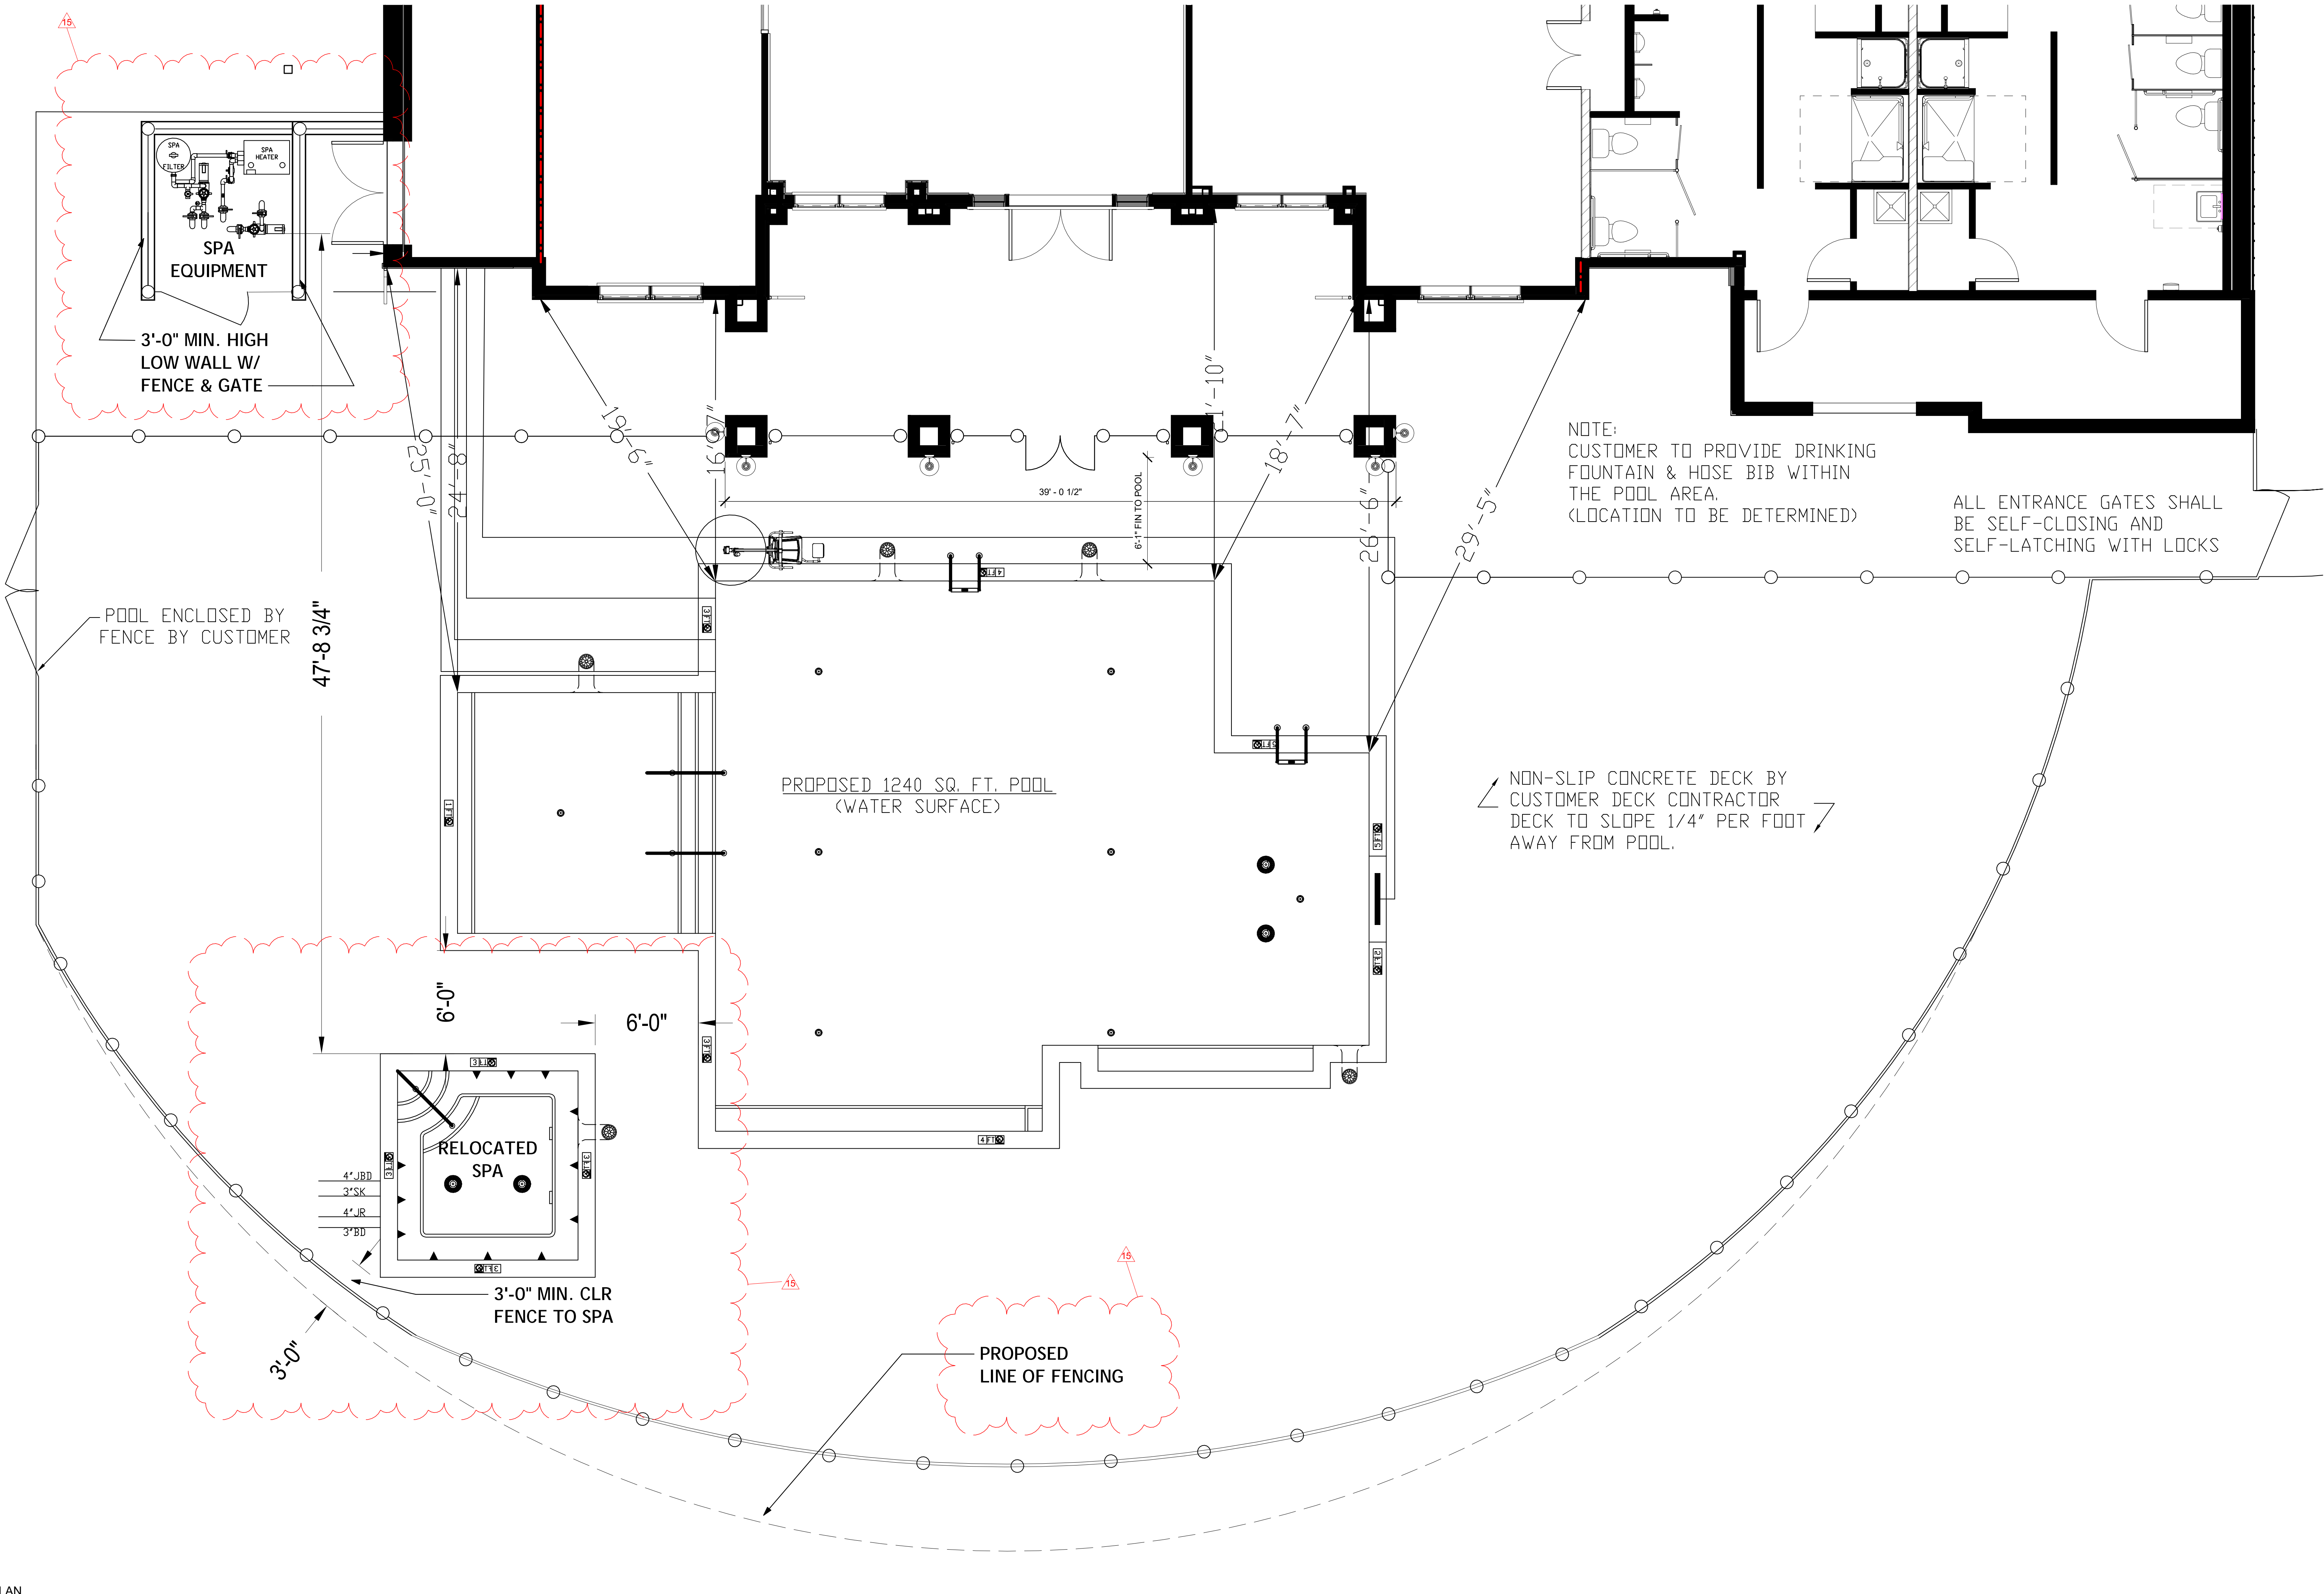


1 ARCH SITE PLAN
1/4" = 1'-0"

Stampfl Associates
architecture + planning
711 Hyde Park
Doylstown, PA 18902
215.345.4609 • 215.345.4610 f
www.stampflassociates.com

REVISIONS	
No.	Description
7	V.E. REVISIONS
8	Rev Mark-Up/BCI
15	DECK ADDITION

chk'd by
Date
2/2/21
3/16/21
3/30/22

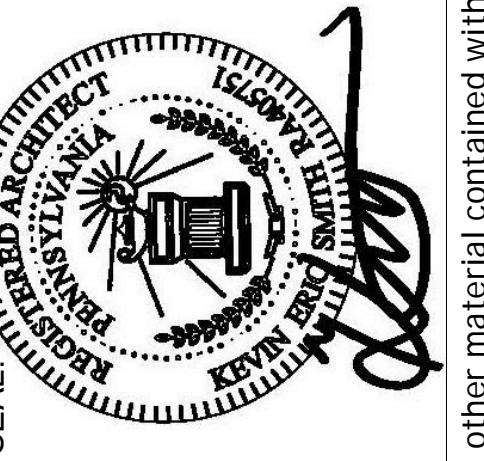

PERMIT SET
WOODLANDS AT GREYSTONE
SCULTHORPE DR. WEST GOSHEN TOWNSHIP
CHESTER COUNTY, PA

Project number: 18-053	Drawn by: Author
date: 2021-08-17	chk'd by: Checker
scale: 1/4" = 1'-0"	approv. by: Approver
sheet no.	

SP-1