


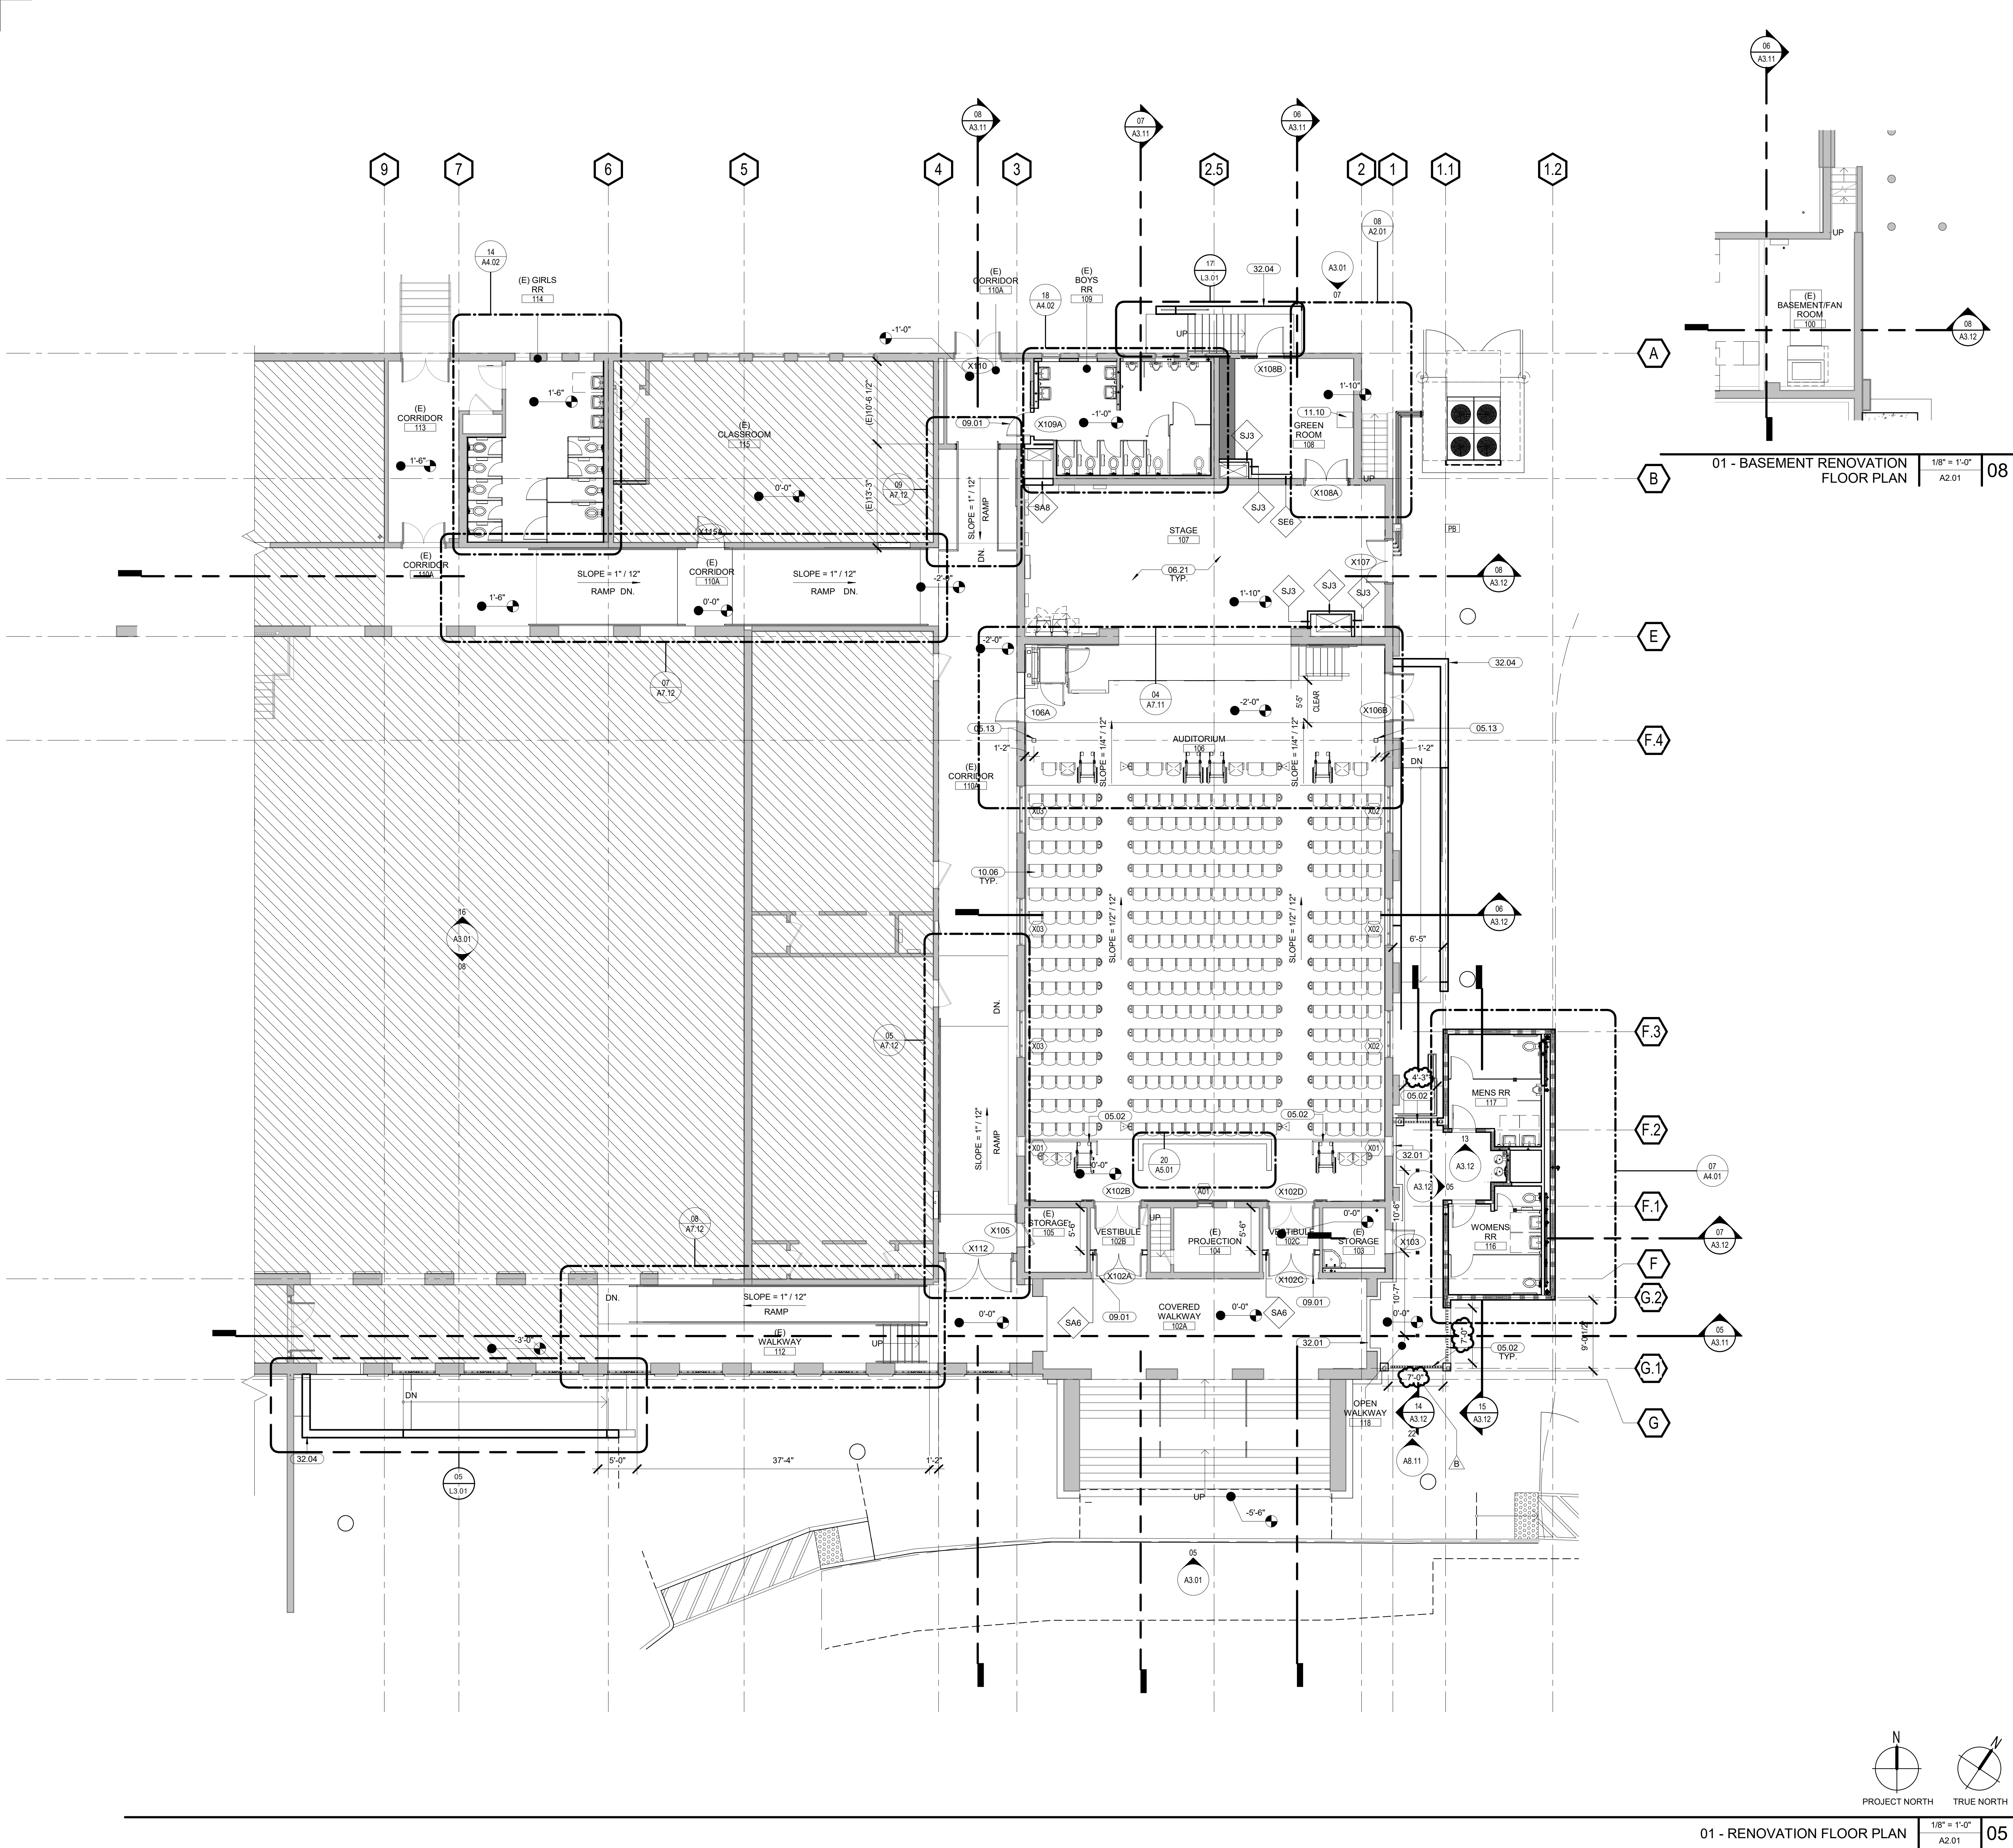

KEYNOTES

05.02 INSTALL (N) DECORATIVE METAL GUARDRAIL. RE: 22/A8.11.
05.13 (N) HSS COLUMN. REF: STRUCTURAL DWGS.
06.21 STAGE FLOOR REPAIR AND REFINISH WOOD WITH CLEAR STAIN
09.01 INSTALL SALVAGED (E) DOORS AND FRAME.
10.06 FIXED AUDITORIUM SEATING RE: THEATER DWGS.
11.10 (N) 24 X 24 SHELVES. SEE THEATER DWGS.
32.01 PROVIDE A 2" SEISMIC SEPARATION BETWEEN EXISTING BUILDING AND NEW BUILDING. RE: 05/A5.11 AND RE: STRUCTURAL DWGS.
32.04 (N) CONCRETE RAMP AND STAIRS. RE: L1.01.

LEGEND

WALL TYPE. LETTER INDICATES WALL TYPE. SEE A9.0X SERIES.

STUD SIZE. NUMBER INDICATES STUD SIZE. SEE A9.0X SERIES. REFER TO S0.91 FOR INTERIOR STUD WALL SCHEDULE

EXISTING CONCRETE WALL CONSTRUCTION
NEW METAL STUD WALL CONSTRUCTION
NEW 1 HOUR RATED WALL CONSTRUCTION
EXISTING 2 HOUR RATED WALL CONSTRUCTION
NOT IN SCOPE OF WORK
SCOPE OF WORK
DENOTES ELEVATED CONCRETE SLAB-ON-GRADE OR FLOOR SLAB CHANGE IN ELEVATION
DENOTES NEW CONCRETE RAMP/STAIRS
DENOTES MILLWORK - REFER TO INTERIOR ELEVATIONS

FE1 SEMI-RECESSED FIRE EXTINGUISHER CABINET, RE:
FE2 RECESSED FIRE EXTINGUISHER CABINET, RE:
11 OPENING TYP

GENERAL NOTES

1. ALL WALLS TO BE WALL TYPE "INSERT", UNO
2. PROVIDE 6" HIGH CONCRETE CURBS AT ALL RESTROOMS, CUSTODIAL CLOSETS, WATER HEATER CLOSETS, AND SHOWER COMPARTMENTS, UNO
3. PROVIDE MOISTURE RESISTANT GYP BD IN ALL WET LOCATIONS, UNO
4. PROVIDE CEMENTITIOUS BACKER BOARD AT ALL TILE WALL LOCATIONS, UNO
5. REFER TO G0.52 FOR TYPICAL CLEARANCE AT DOOR LOCATIONS.
6. FOR TYPICAL SWITCH AND DEVICE ALIGNMENTS, REFER TO 17/G3.03
7. REFER TO A9.15 FOR PENETRATIONS THROUGH RATED WALL CONDITIONS. FOR ALL RATED WALLS, PROVIDE THE FOLLOWING MARKINGS AND IDENTIFICATIONS PER THE APPLICABLE CODES:
A. BE LOCATED WITHIN 15 FEET OF THE END OF EACH WALL AND AT INTERVALS NOT EXCEEDING 30 FEET MEASURED HORIZONTALLY ALONG THE WALL OR PARTITION.
B. INCLUDE LETTERING NOT LESS THAN 3 INCHES IN HEIGHT WITH A MINIMUM 3/8 INCH STROKE IN A CONTRASTING COLOR INCORPORATING THE SUGGESTED WORDING, "FIRE AND/OR SMOKE BARRIER - PROTECT ALL OPENINGS", OR OTHER WORDING.
8. REFER TO EDGE OF SLAB PLANS FOR FLOOR DRAIN LOCATIONS.

KEYPLAN

01 - RENOVATION FLOOR PLAN 1/8" = 1'-0" A2.01 05

ARCHITECTURE ENGINEERING INTERIOR DESIGN
LANDSCAPE ARCHITECTURE PLANNING
949-261-1001 Office
LPA Design Studios.com
5301 California Avenue, Suite 100
Irvine, California 92617

This document and all other project documents, ideas, aesthetics and designs incorporated therein are instruments of service. All project documents are copyright protected, and are the property of LPA, Inc. LPA and cannot be lawfully used in whole or in part for any project or purpose except as set forth in the contract agreement between LPA and its Client. The unauthorized disclosure and/or use of the project documents (including the creation of derivative works), may give rise to liability for copyright infringement, unlawful disclosure, use or misappropriation of property rights held by LPA. The unauthorized use of the project documents will give rise to the recovery of monetary losses and damages including attorney fees and costs for which the unauthorized user will be held liable. Project documents describe the design intent of the work and are not a representation of as-built or existing conditions. LPA is not responsible for any discrepancies between the project documents and the existing conditions.

© LPA, Inc.

East Whittier Middle School
Emma A. Wicker Auditorium Renovation

14421 Whittier Blvd.
Whittier, CA 90605

Developed for
East Whittier City School District






Submital	Date
SCHEMATIC DESIGN	03/03/2024
CONCEPT DEVELOPMENT	08/23/2024
50% PROGRESS SET	10/23/2024
DSA SUBMITTAL	11/22/2024
DSA BACK CHECK	03/20/2025
DSA BACK CHECK V3	06/03/2025
DSA BACK CHECK V4	06/30/2025

Revision	Date
B	11/05/25

Job Number	31837
Checked By	YM
Scale	1/8" = 1'-0"

01 - RENOVATION FLOOR PLAN

A2.01

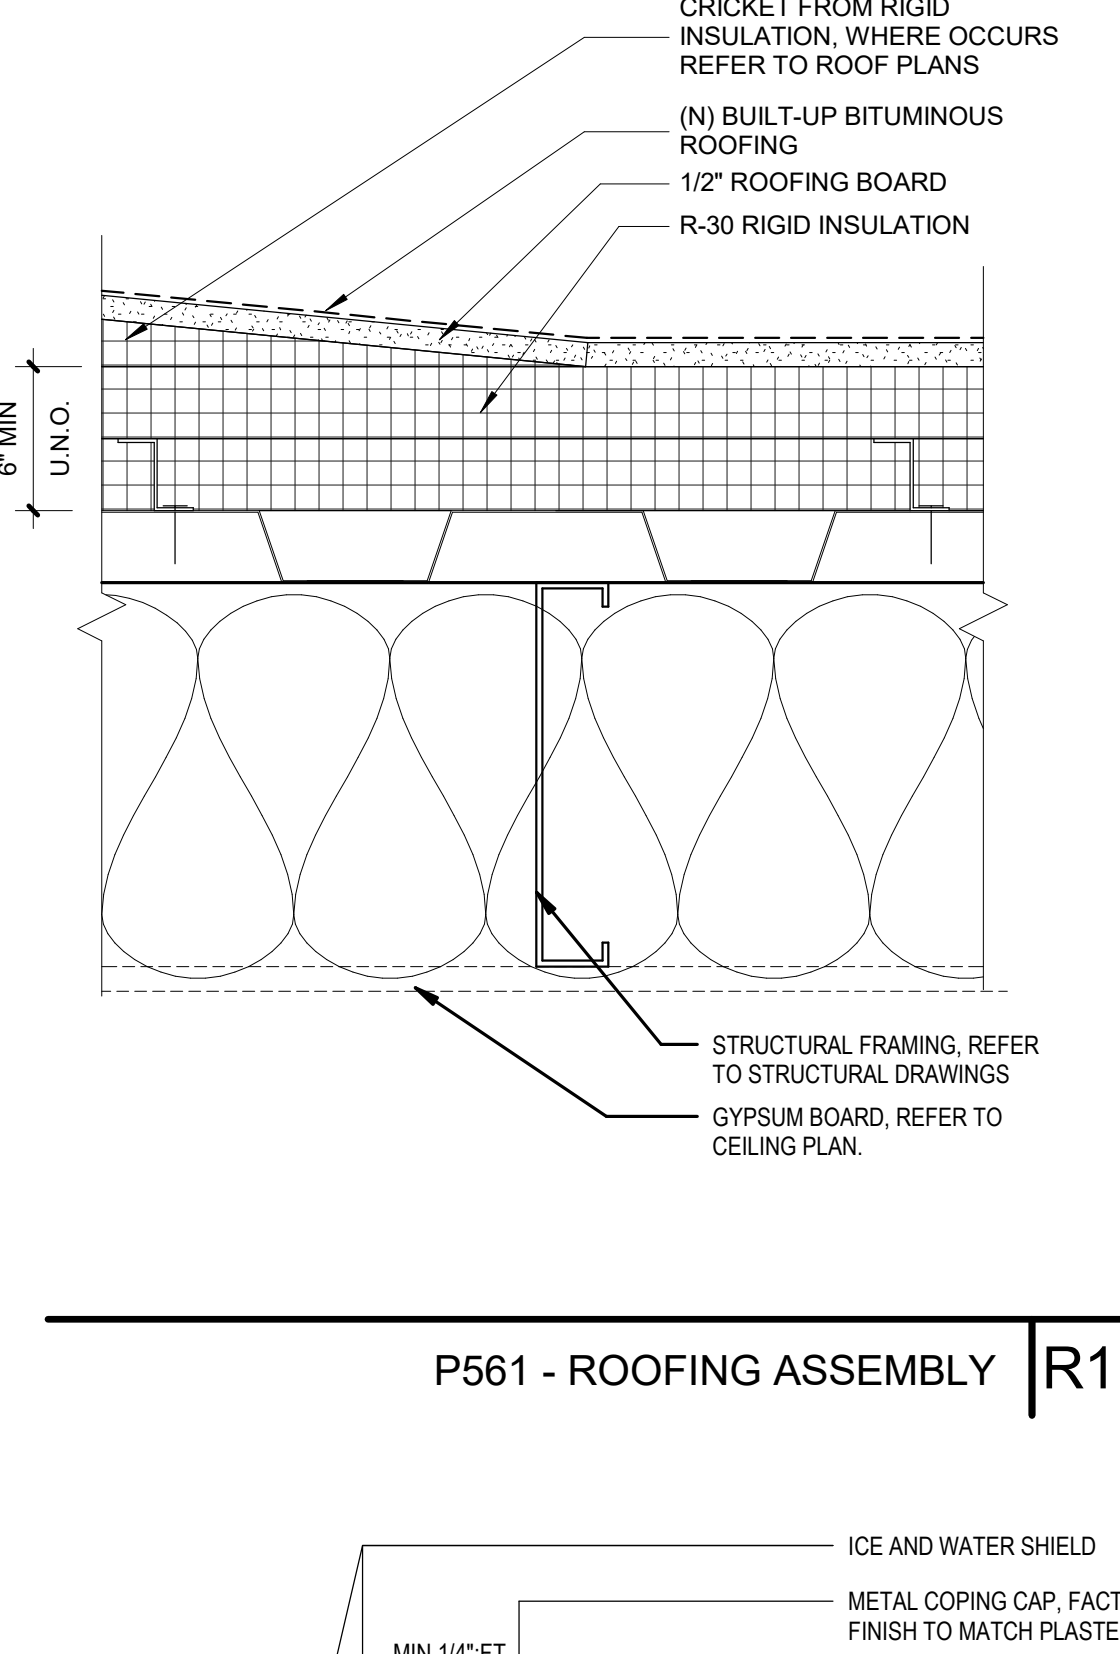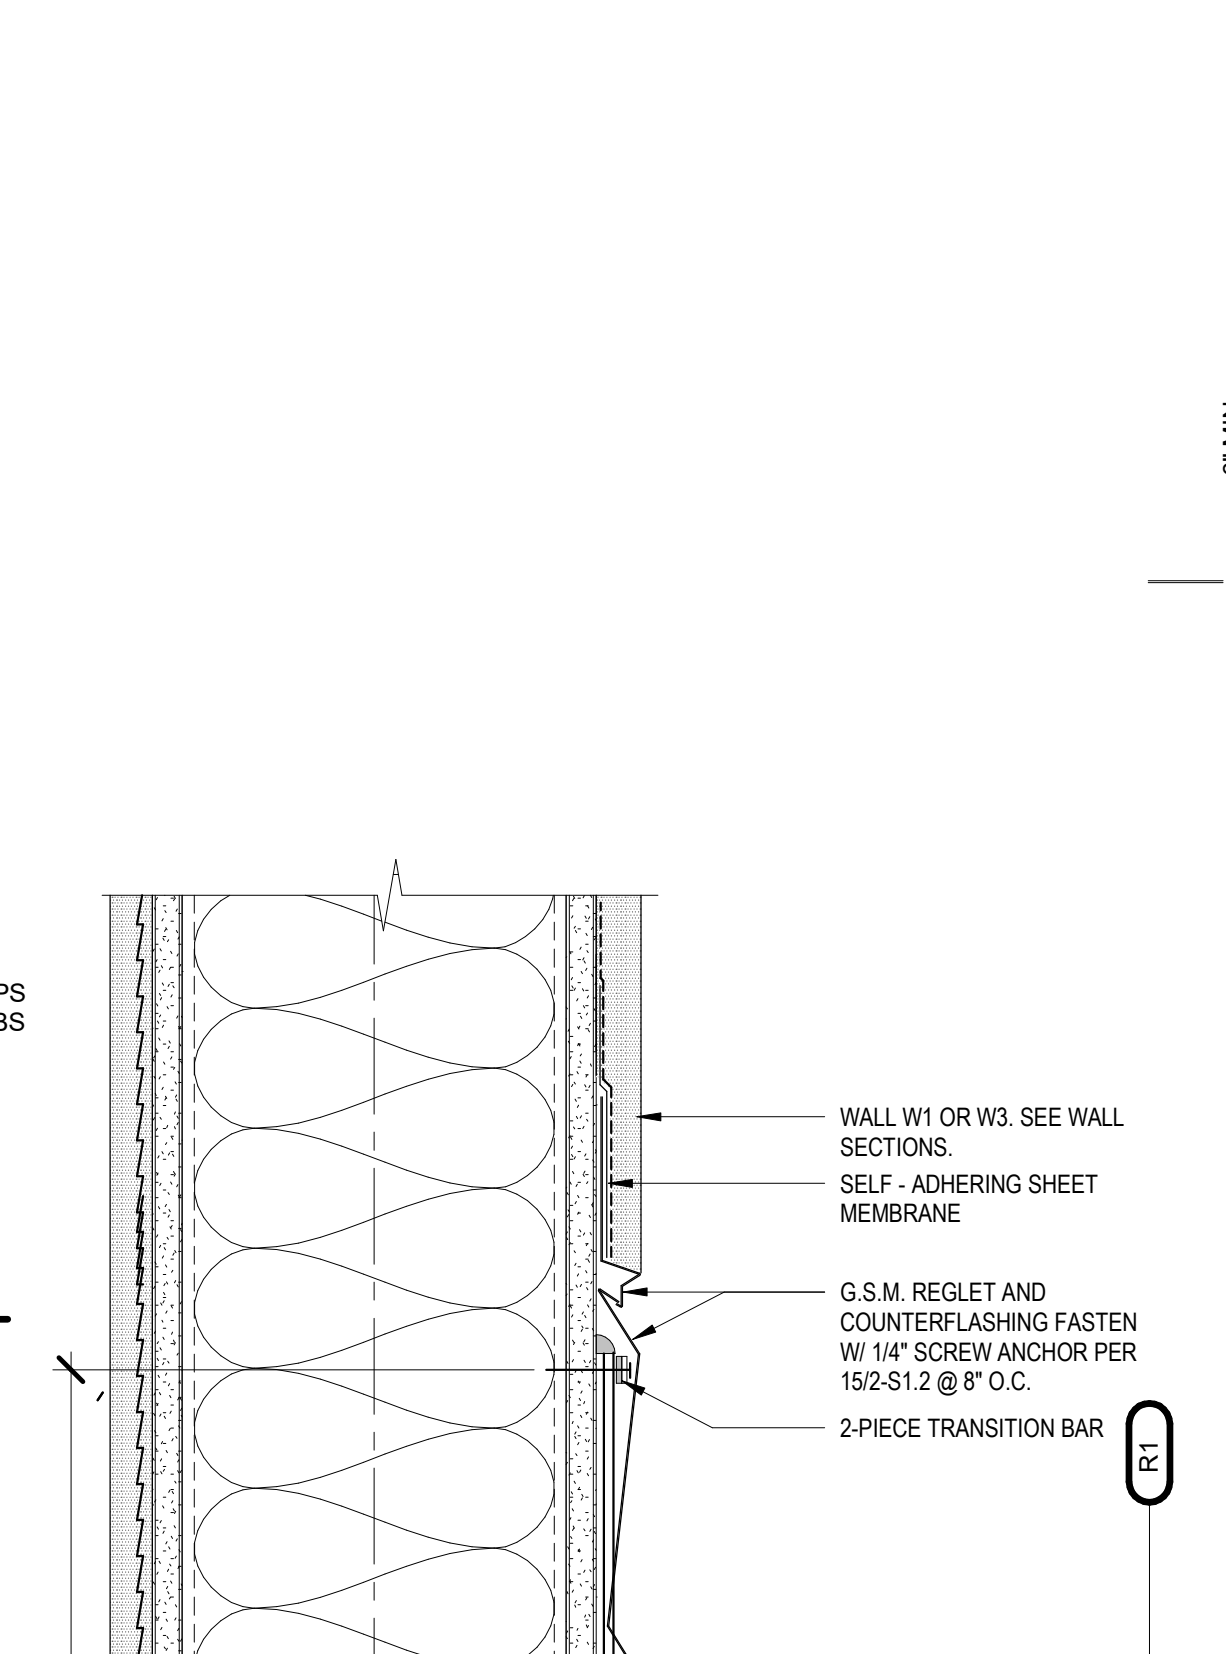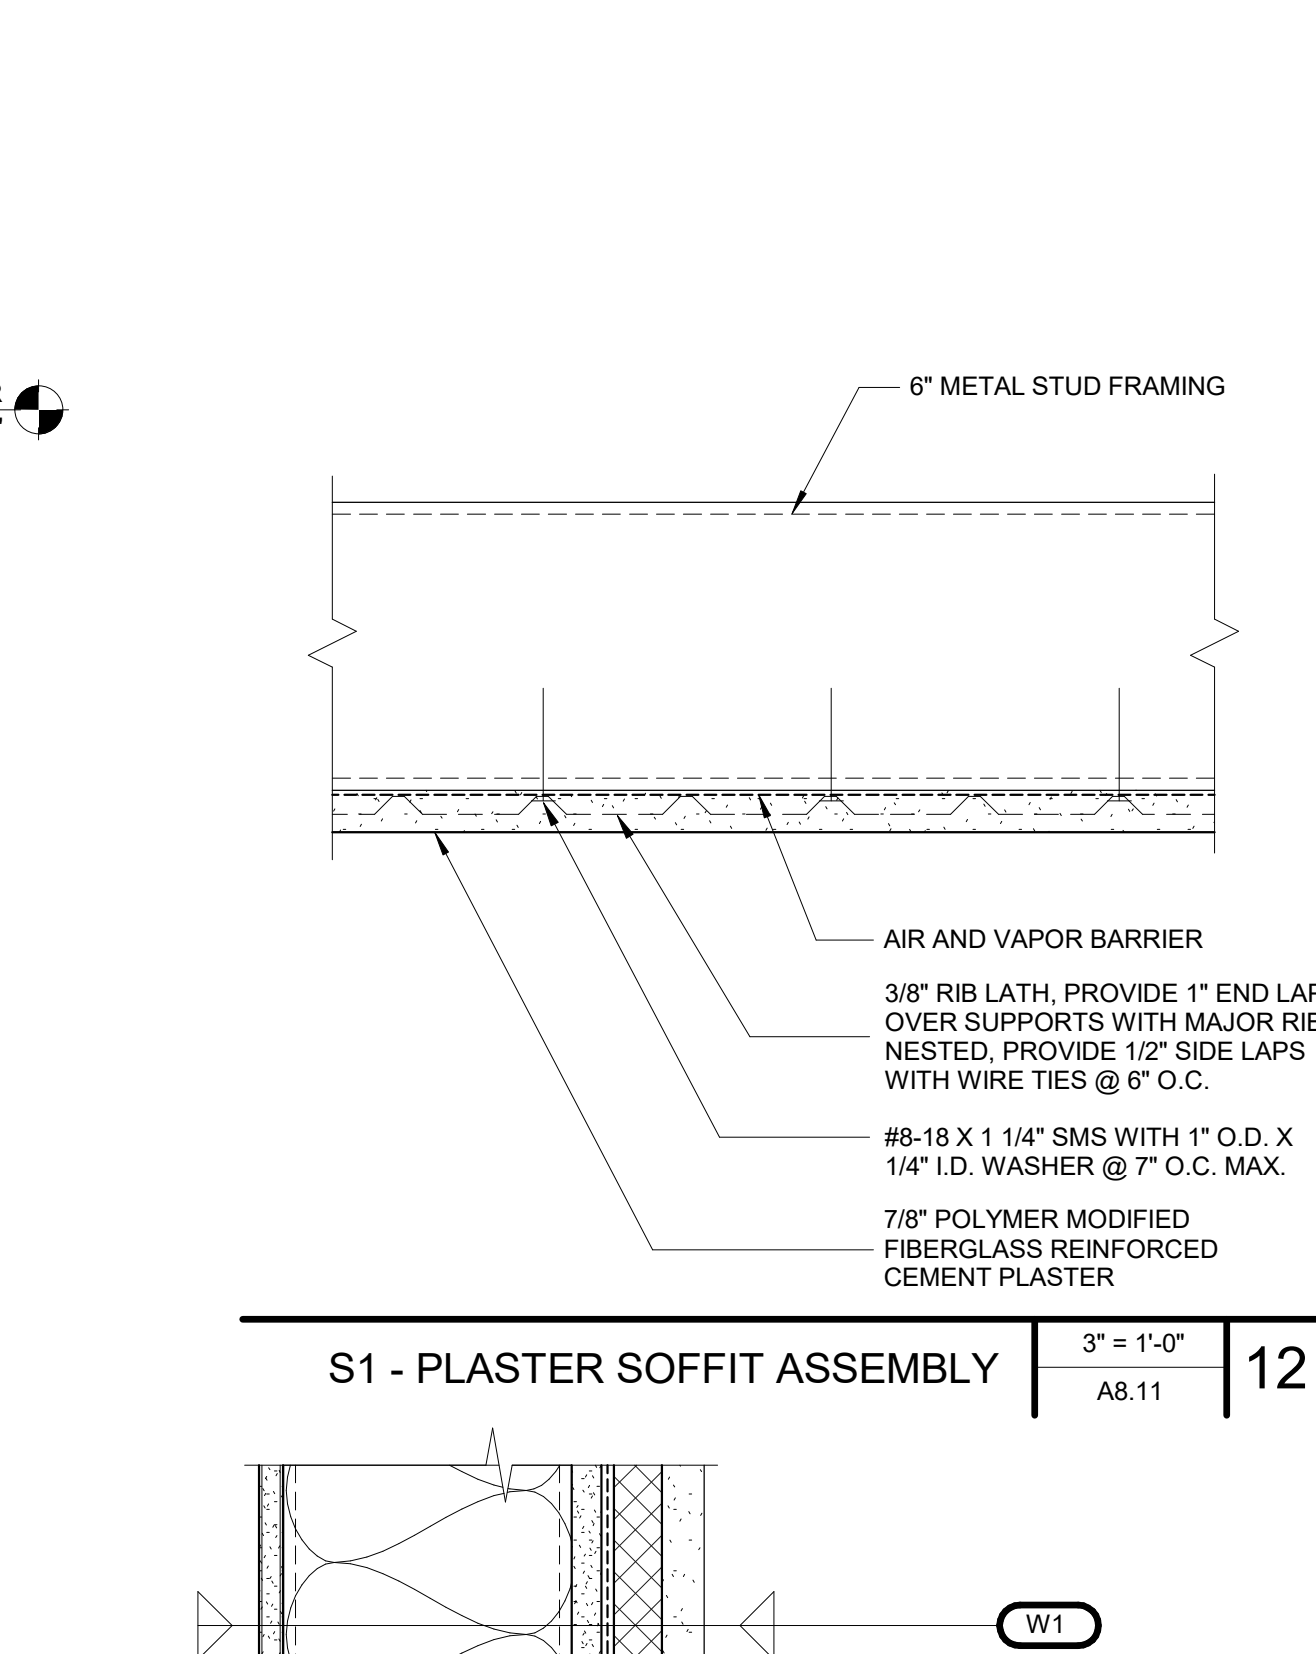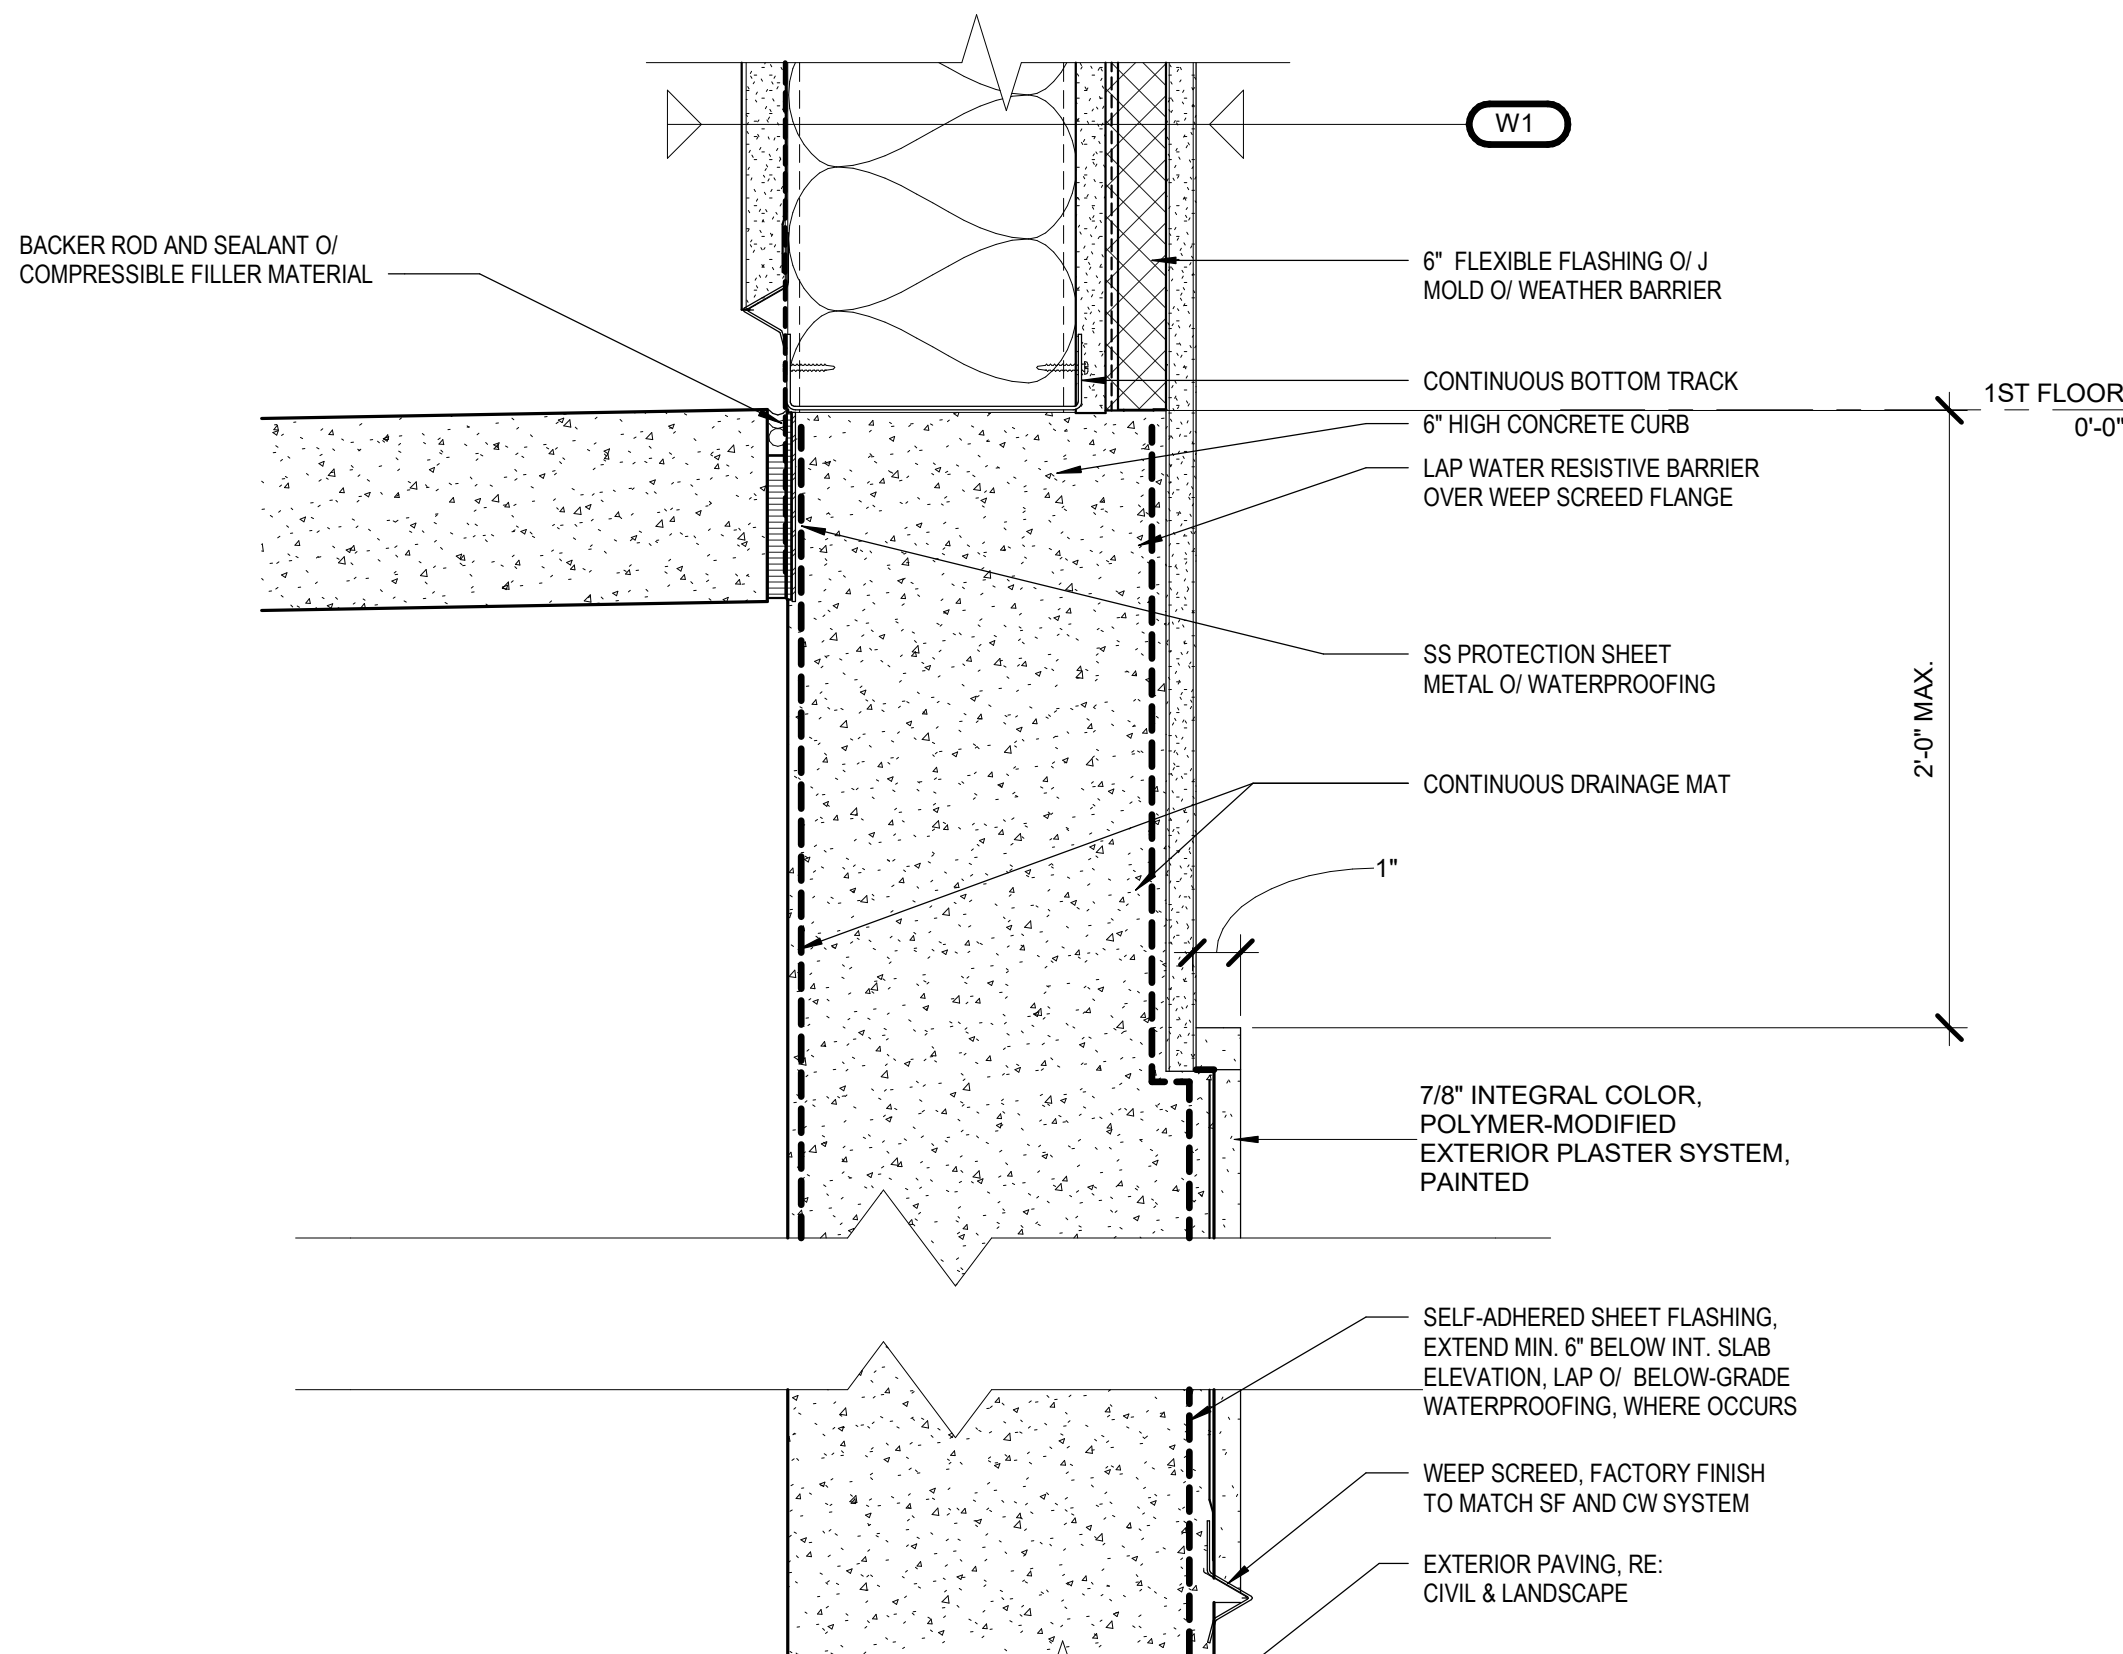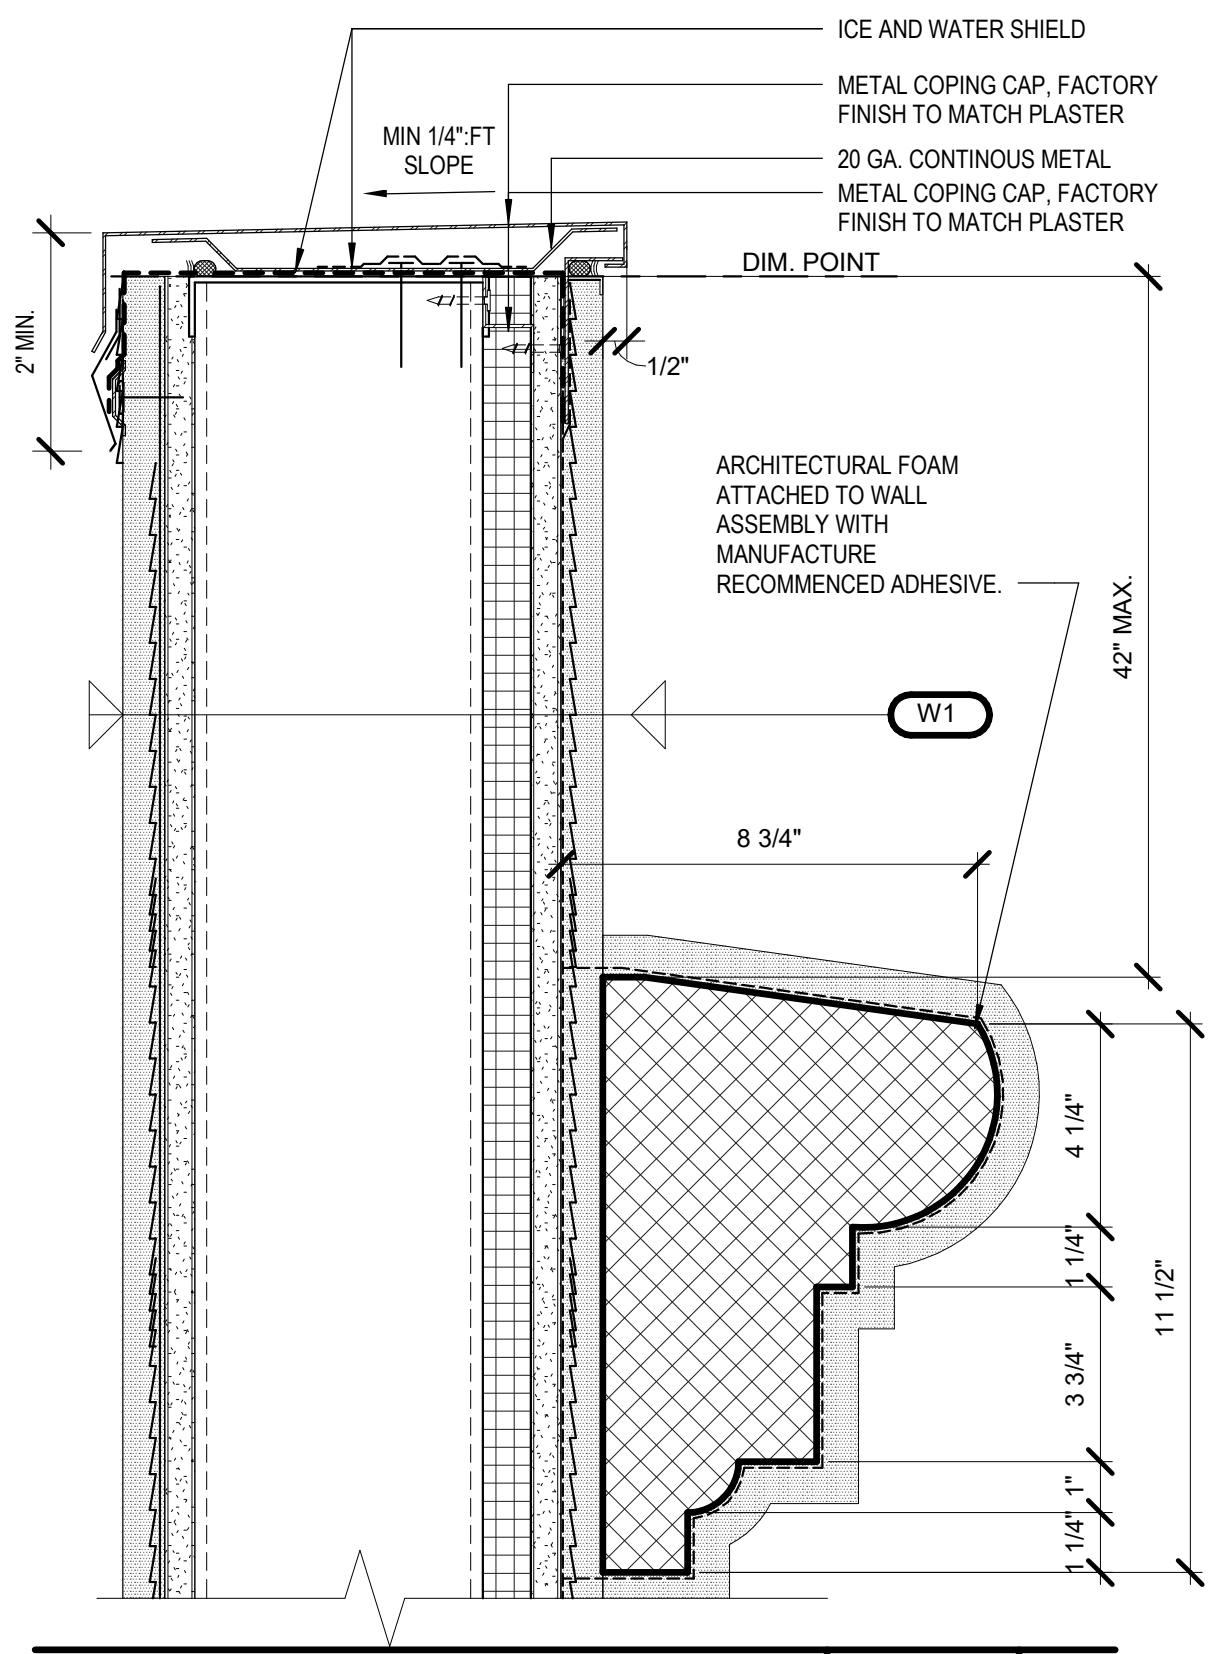



DECORATIVE DETAIL 20

WATER TABLE DETAIL 15

S1 - PLASTER SOFFIT ASSEMBLY 12

MECHANICAL WELL BASE AT ROOF 07


P561 - ROOFING ASSEMBLY R1

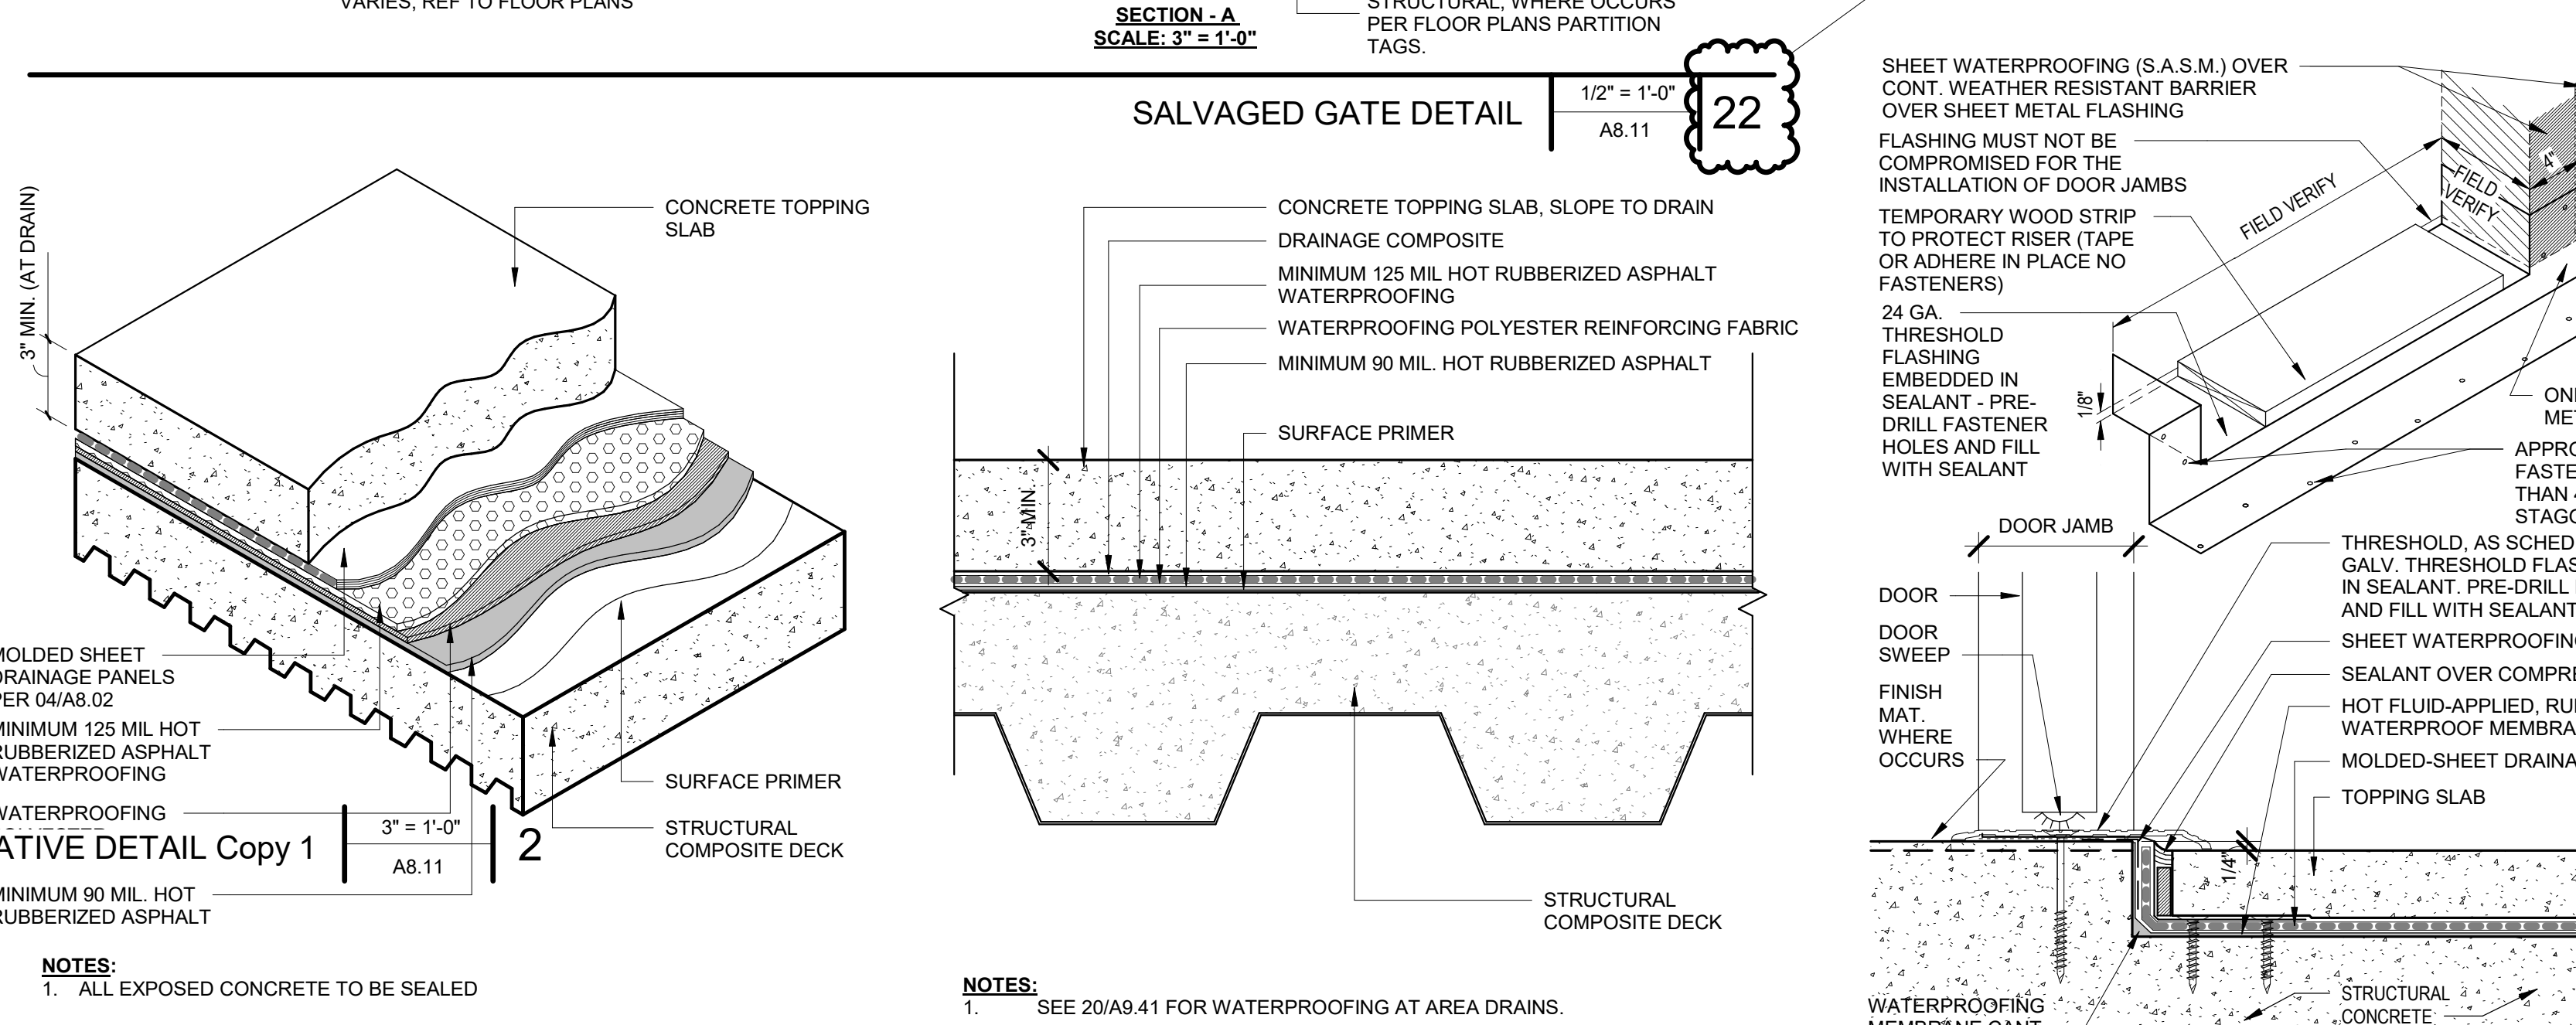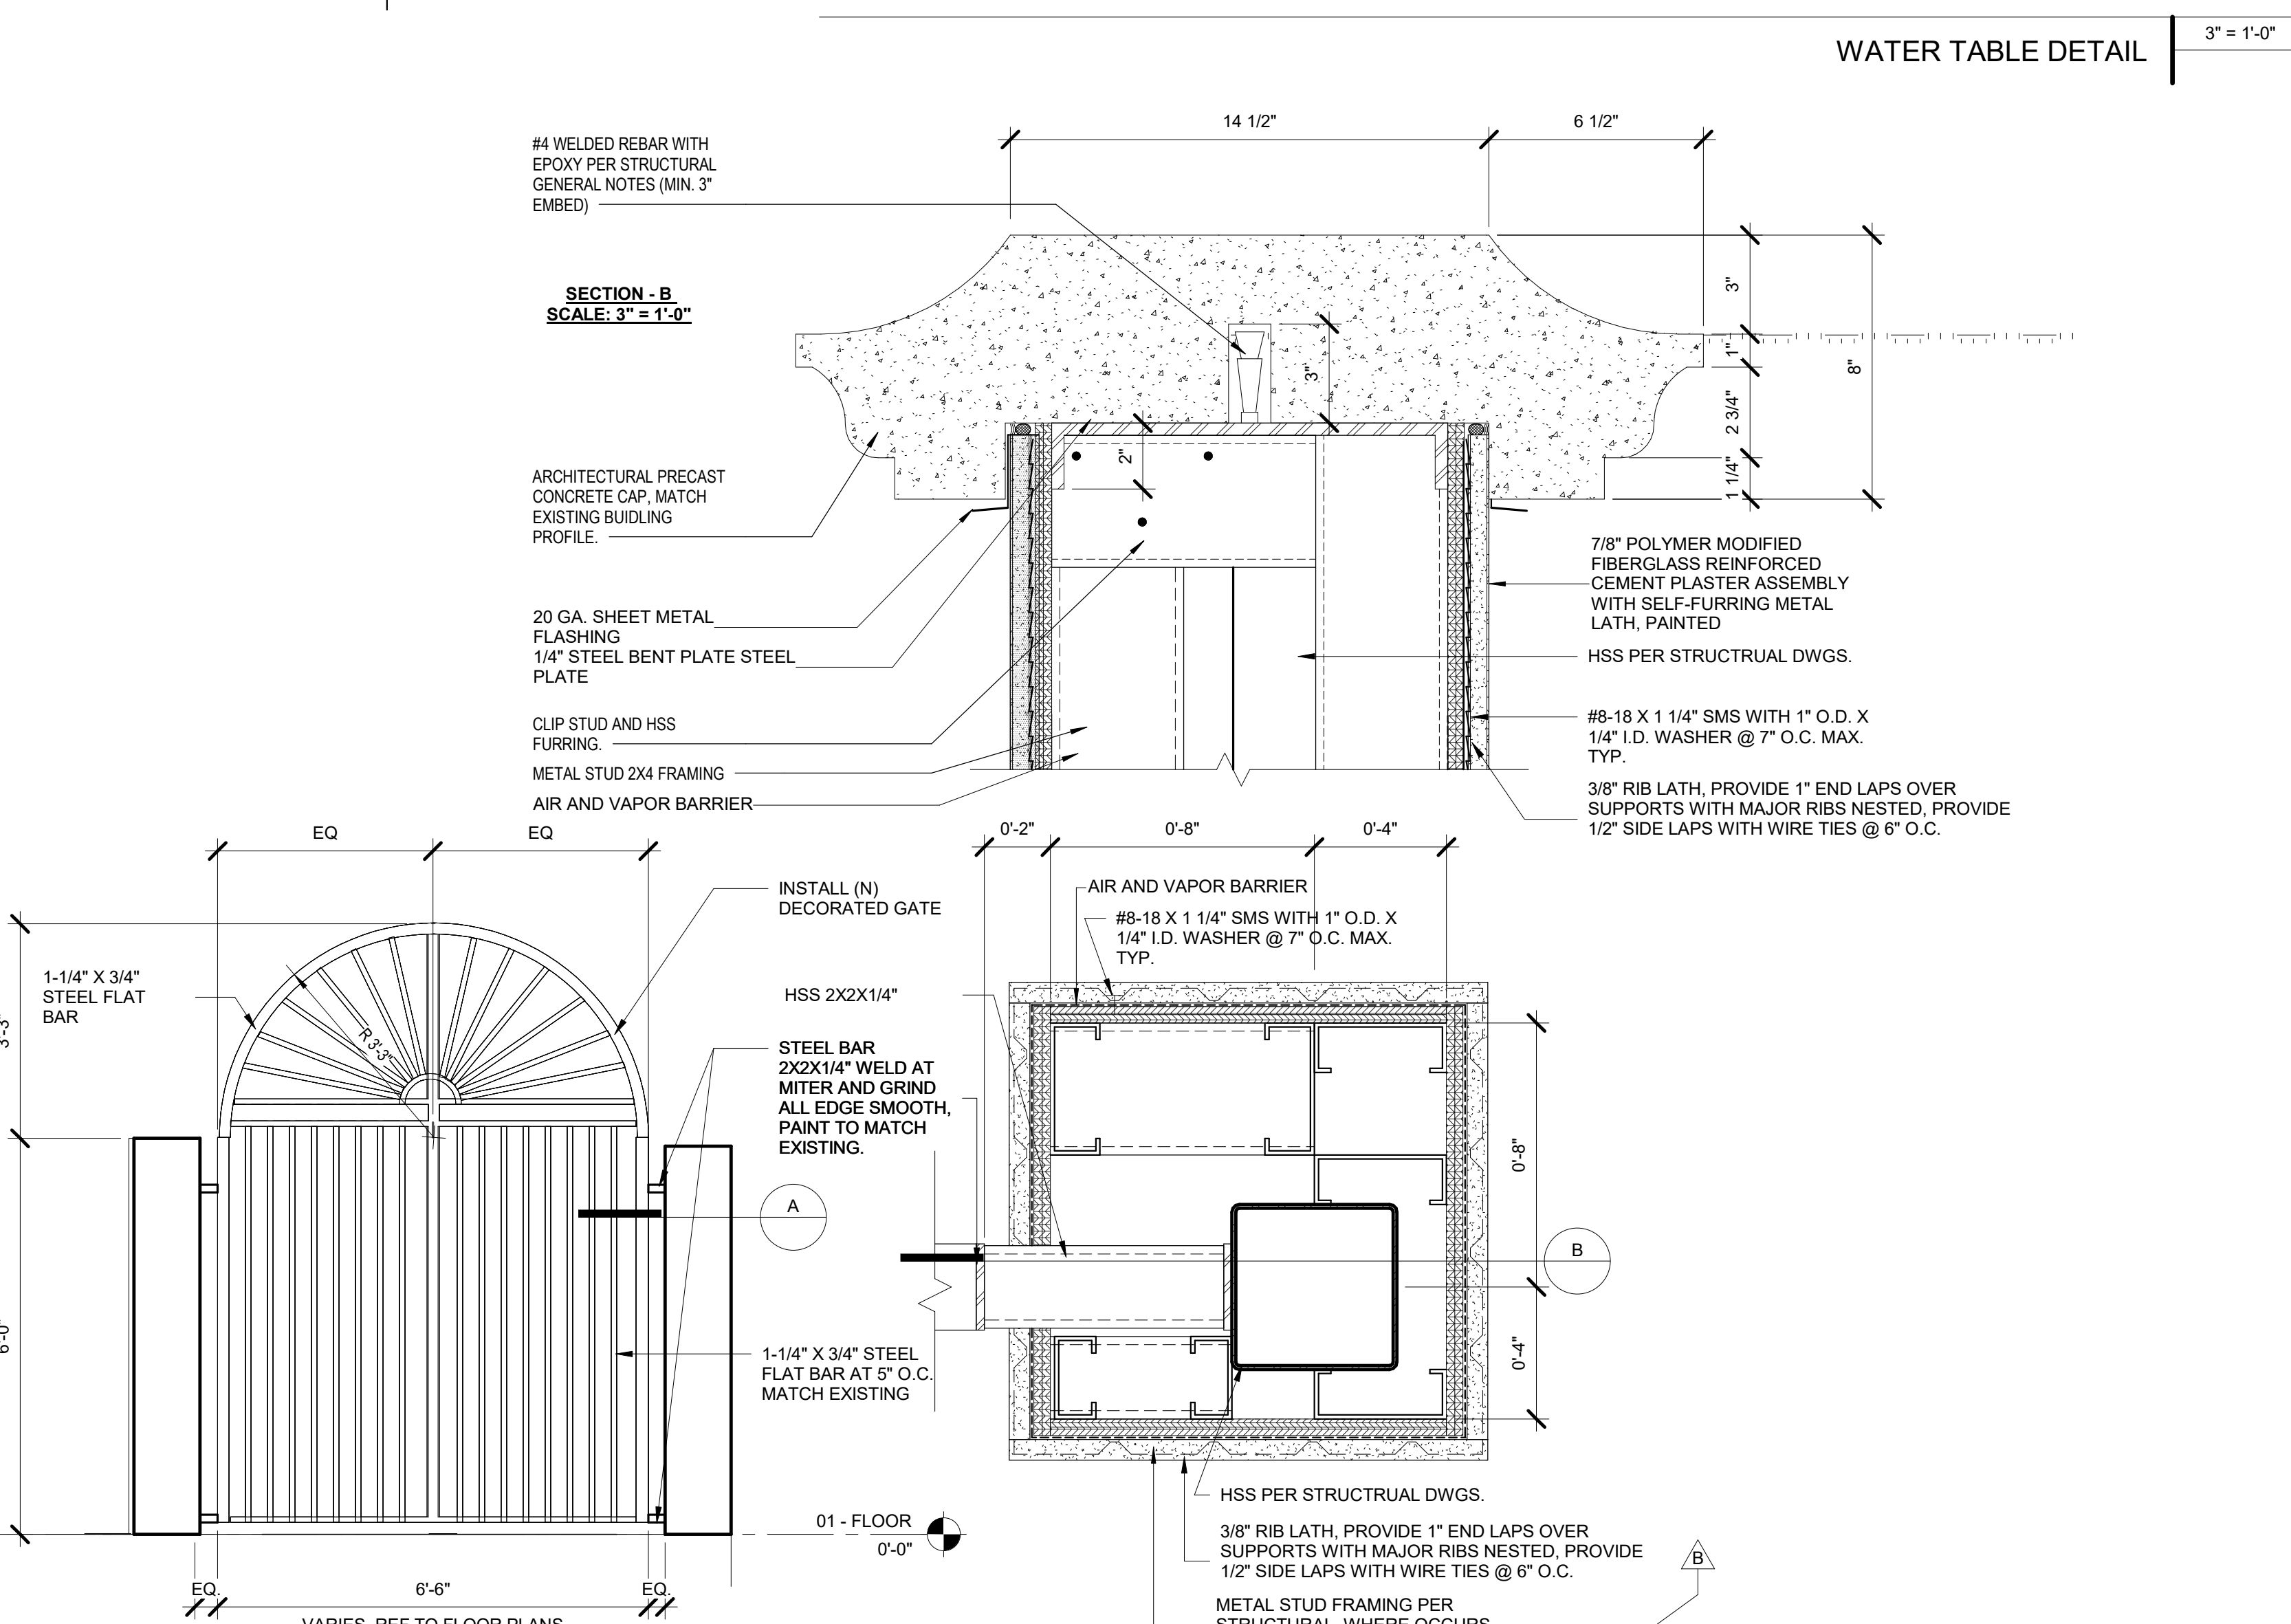


TOPPING SLAB AXON 21

TS1 - TOPPING SLAB 17



WATERPROOFING AT THRESHOLD 13

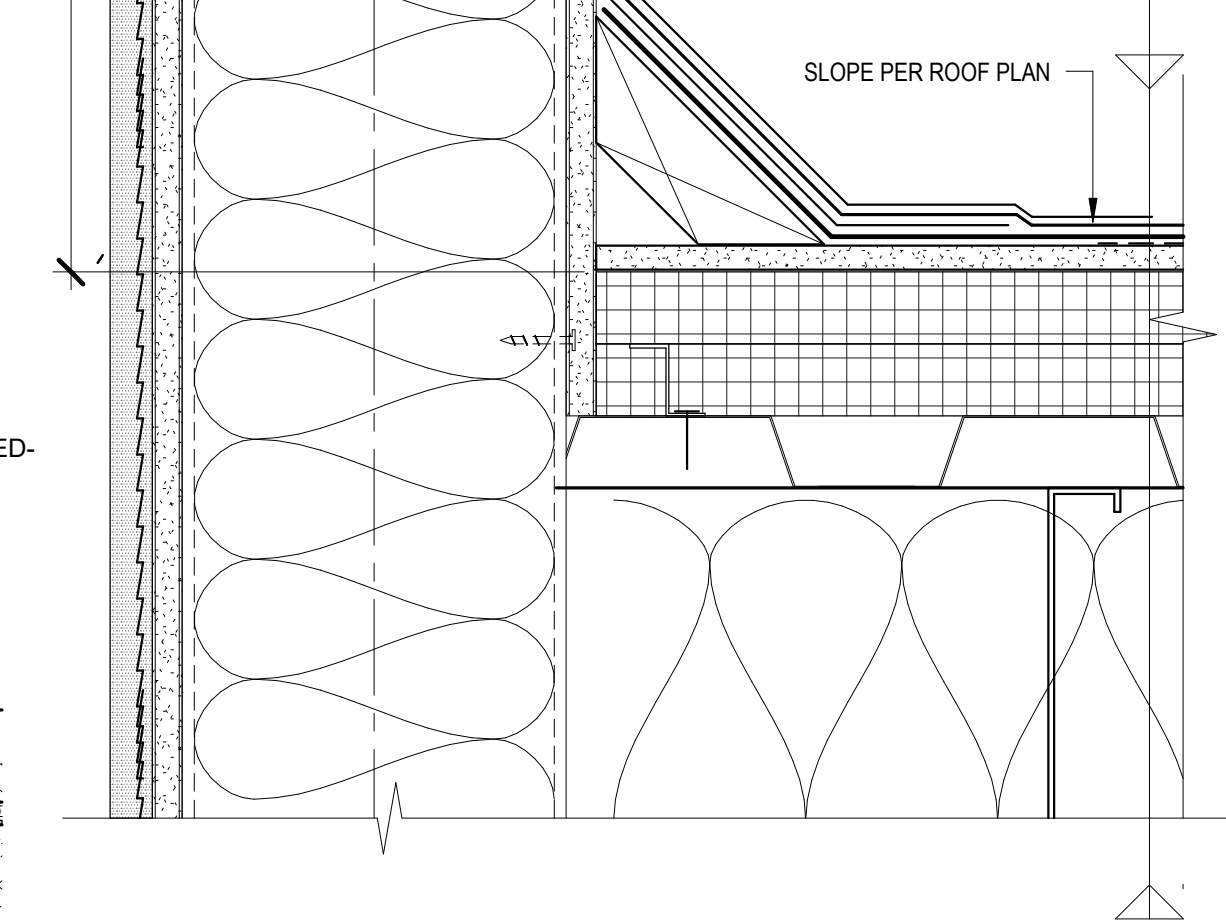

WATERPROOFING AT WALL 14

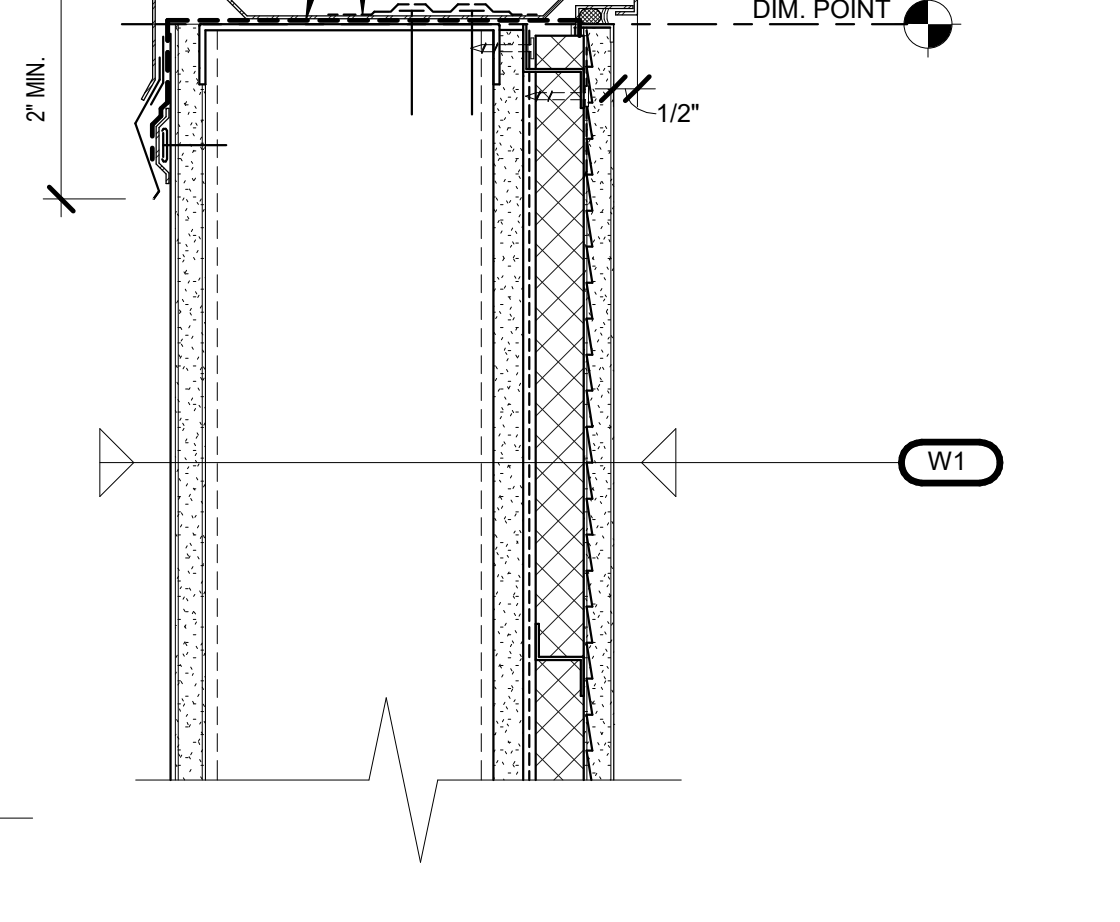


PLASTER PARAPET CAP 03

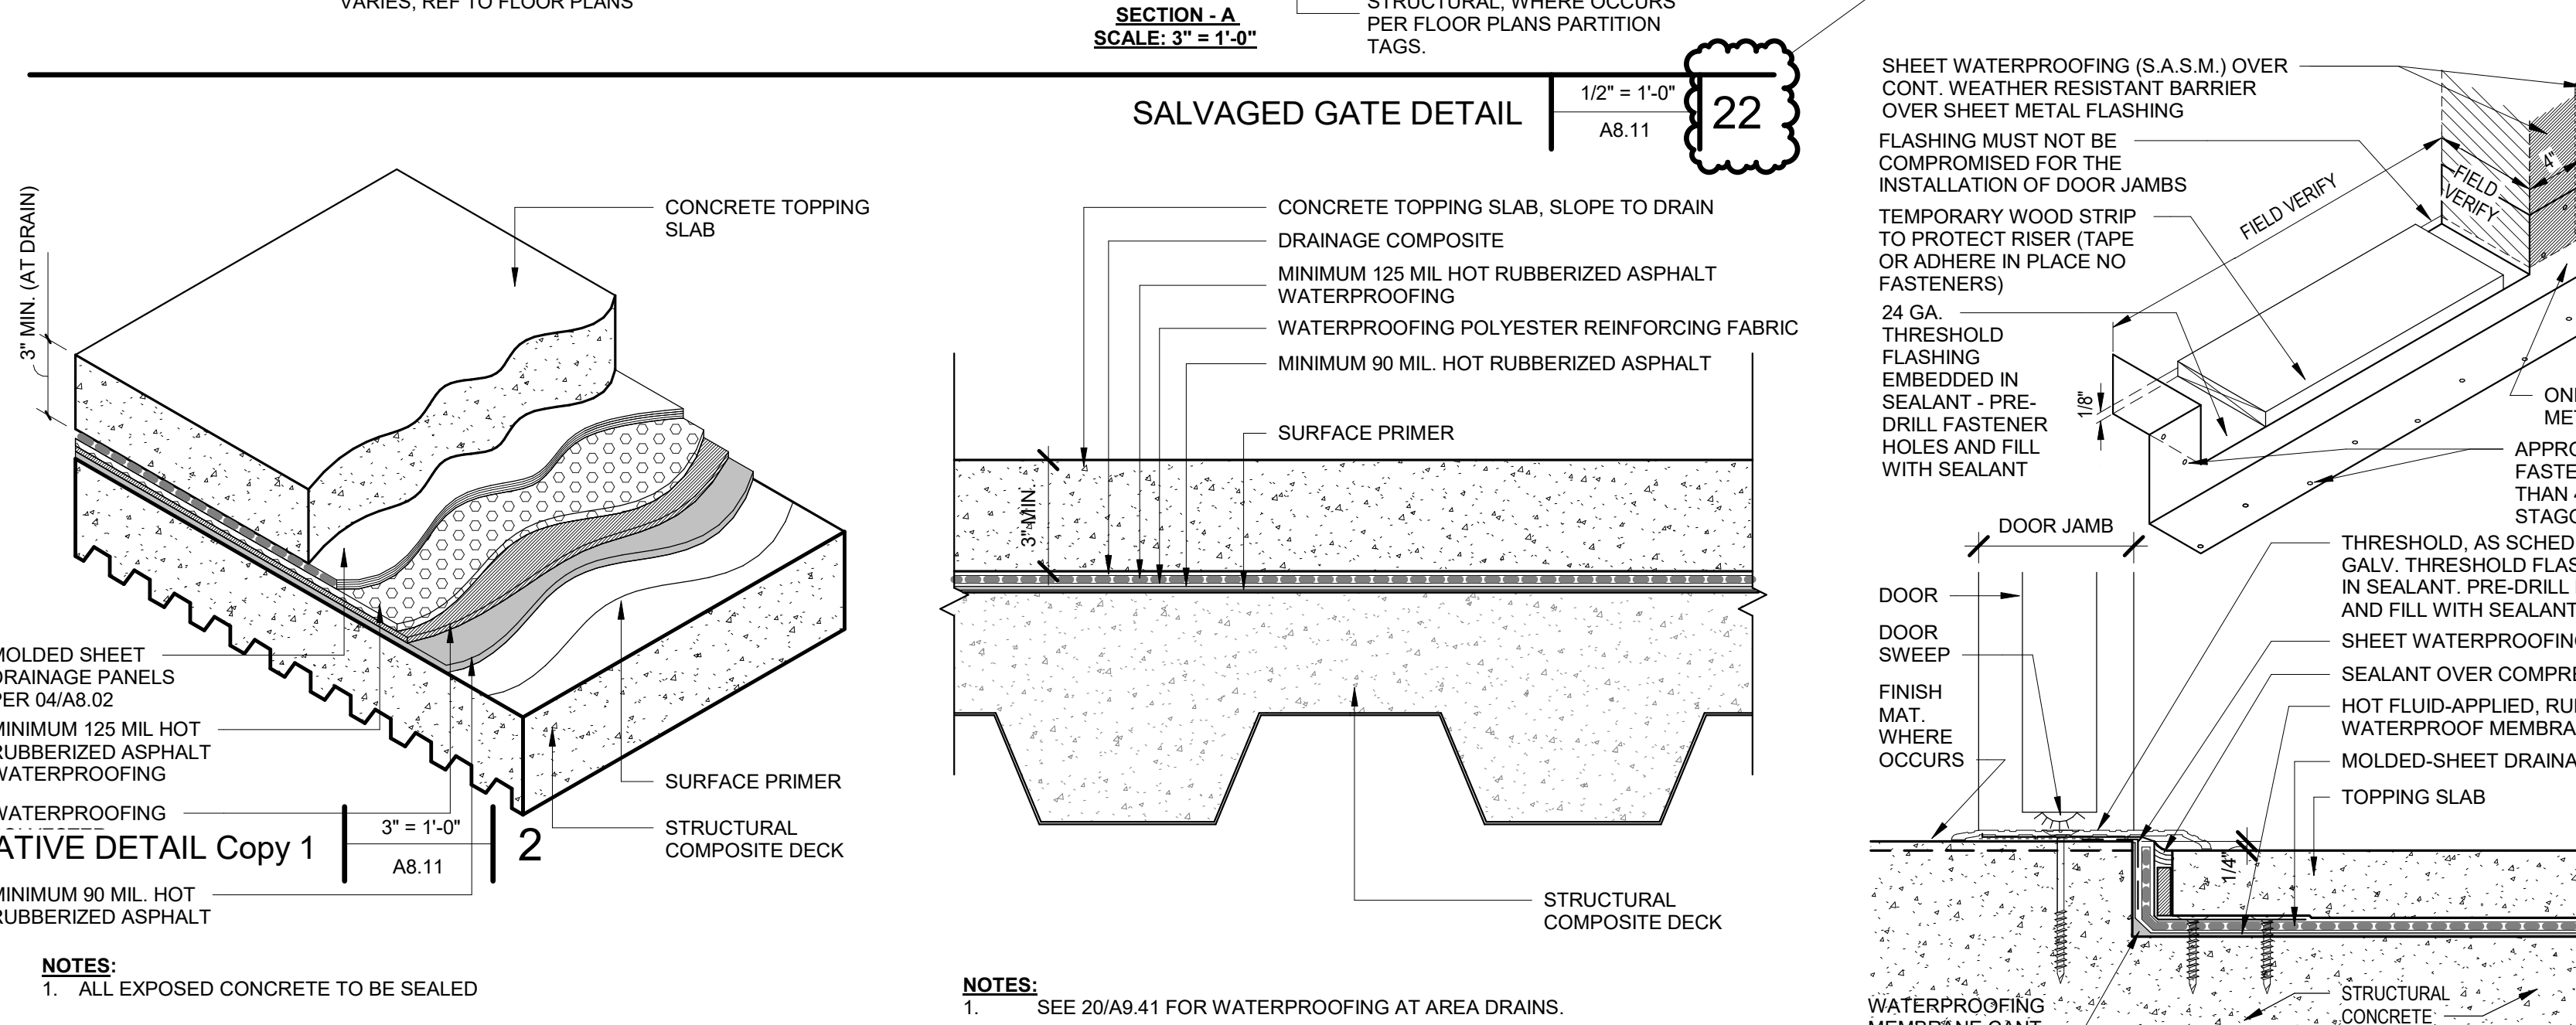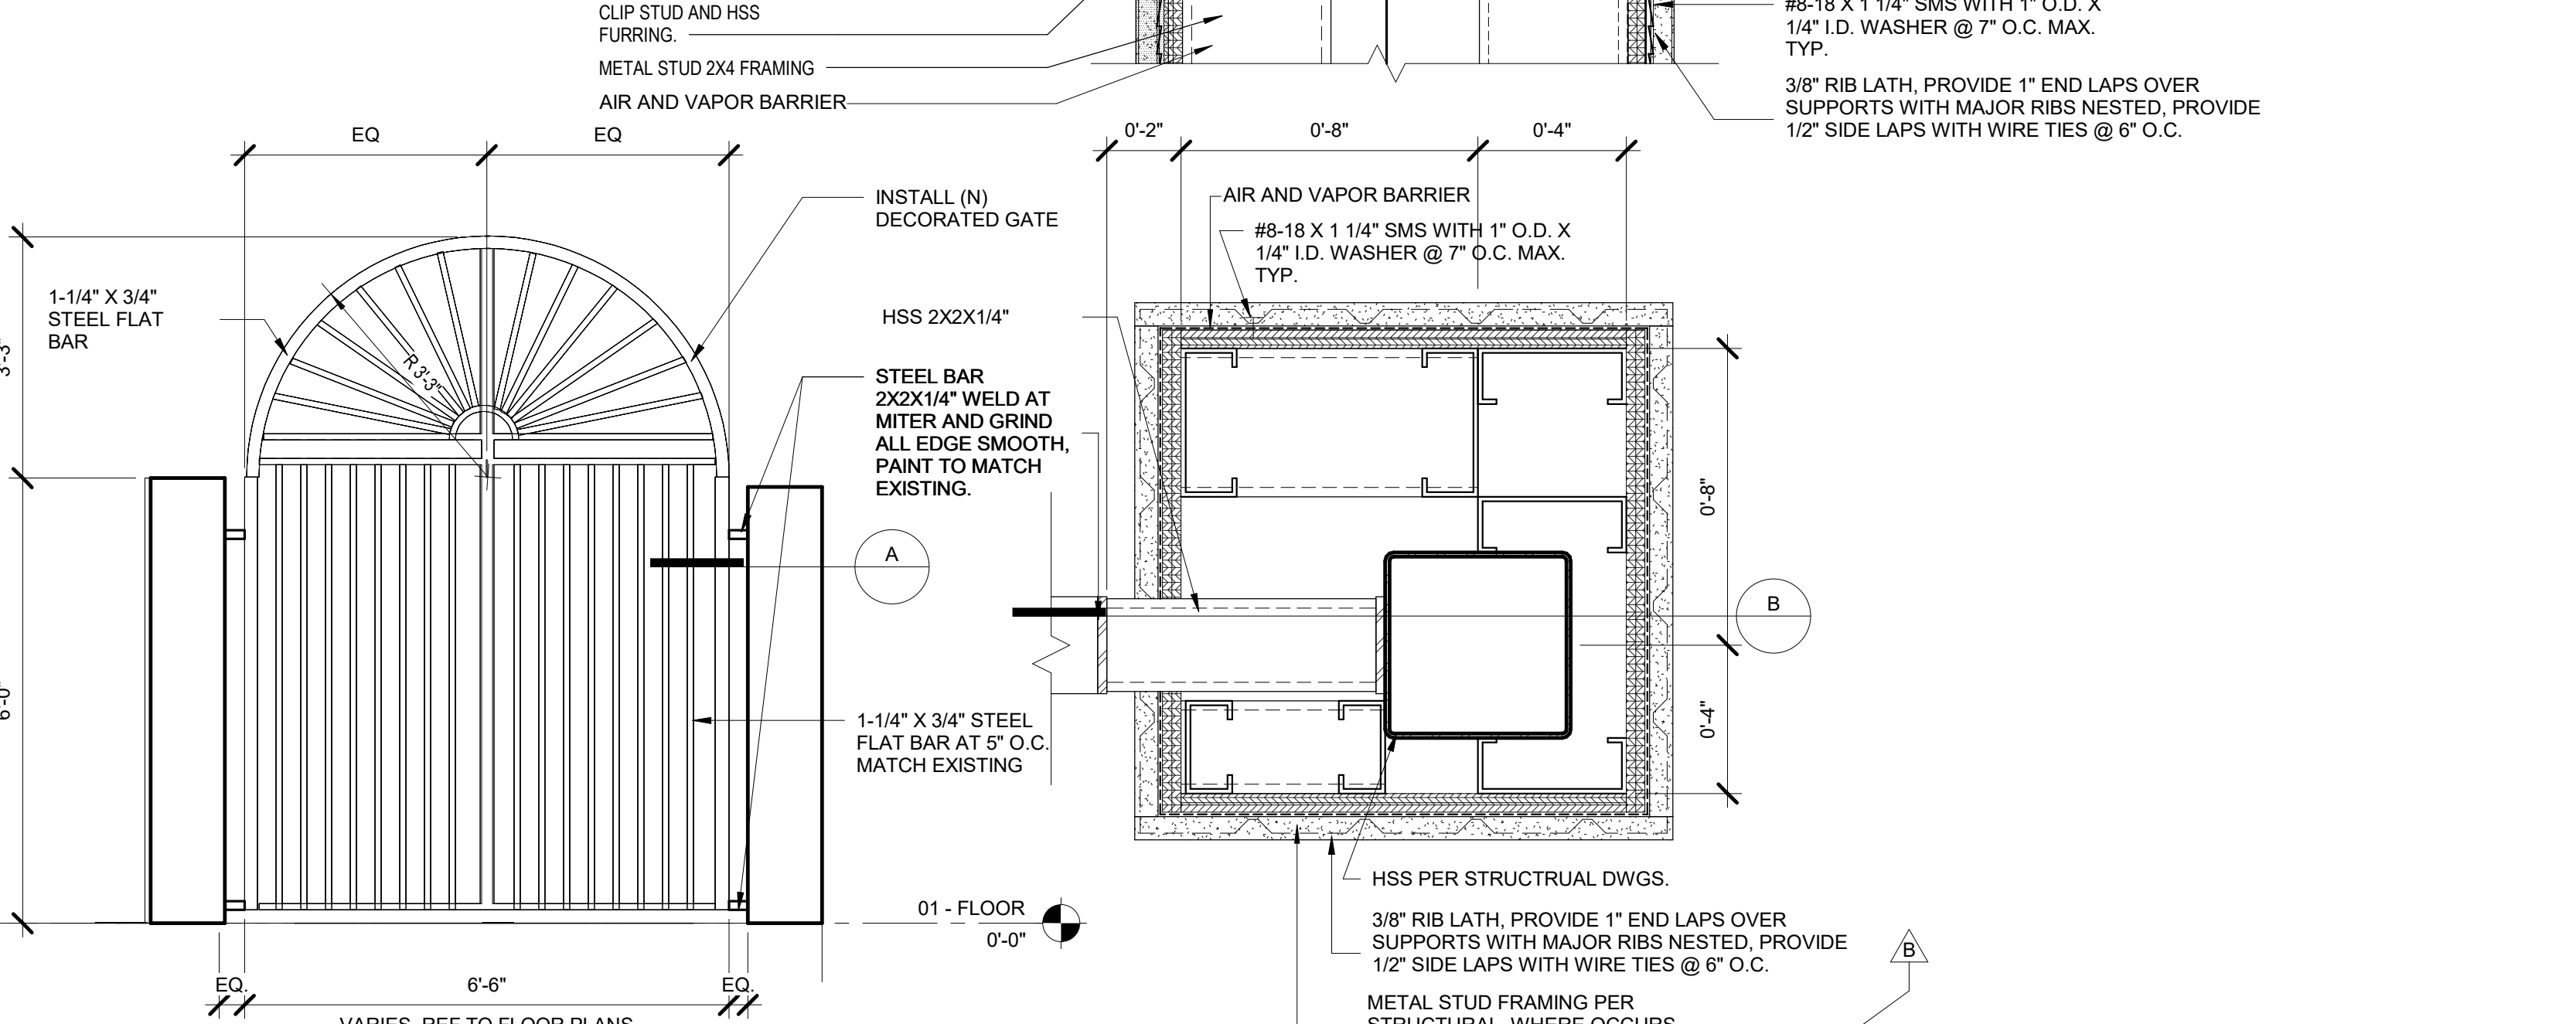


DECORATIVE DETAIL Copy 1 2

TS1 - TOPPING SLAB 17


WATERPROOFING AT THRESHOLD 13

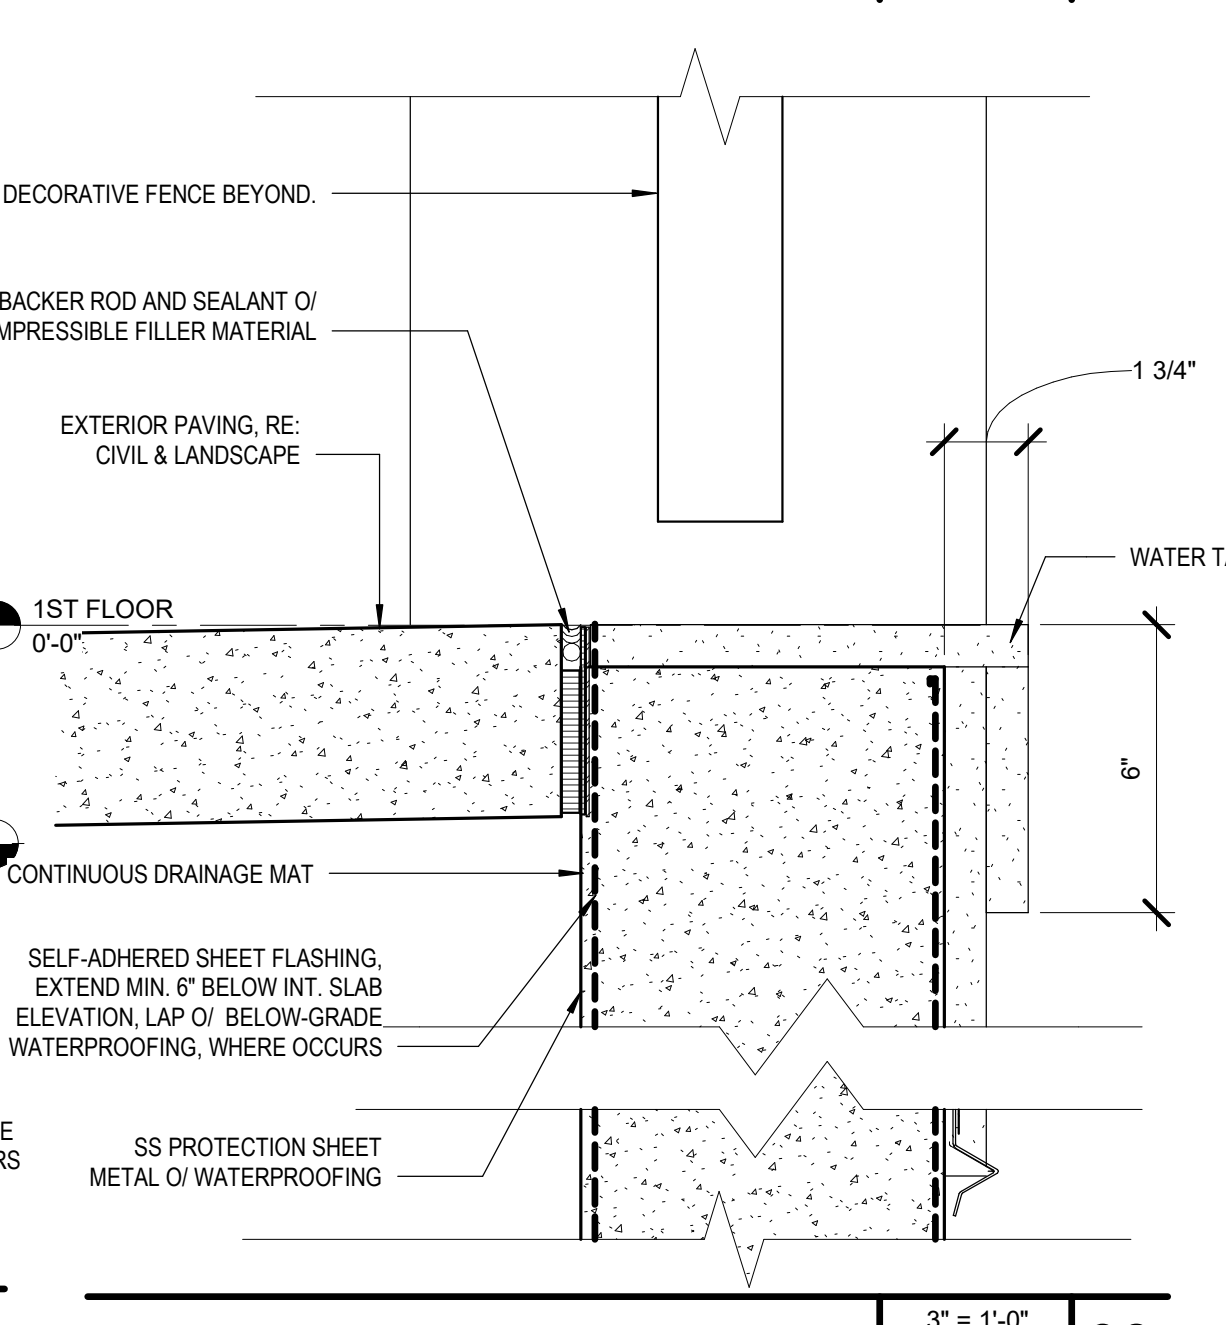

PLASTER AT BASE 10

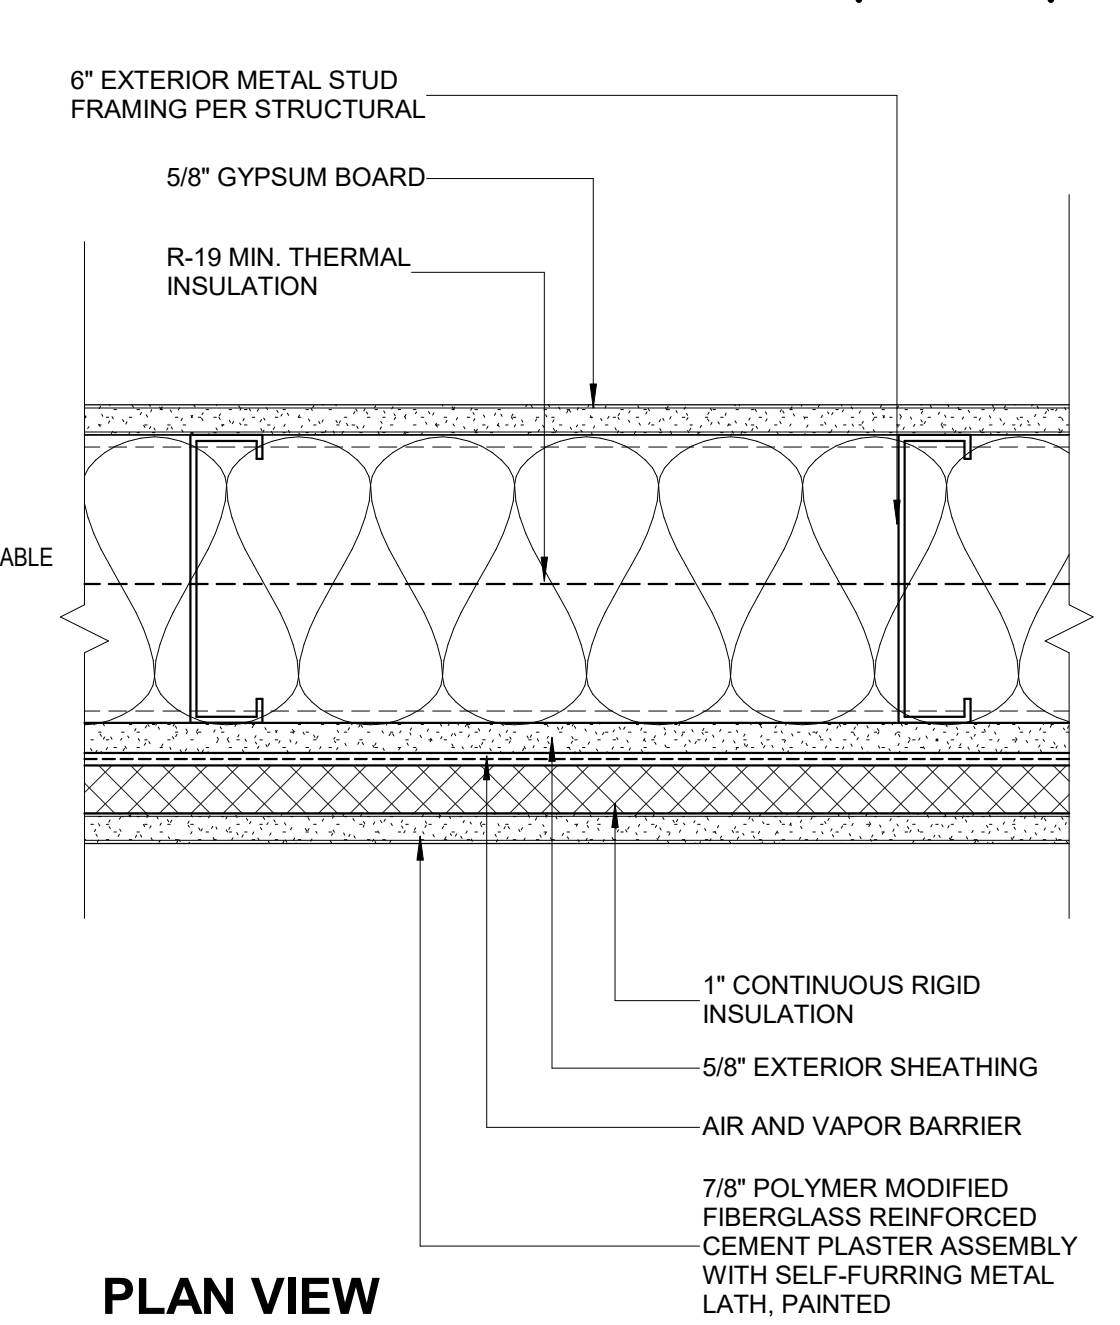


PLAN VIEW

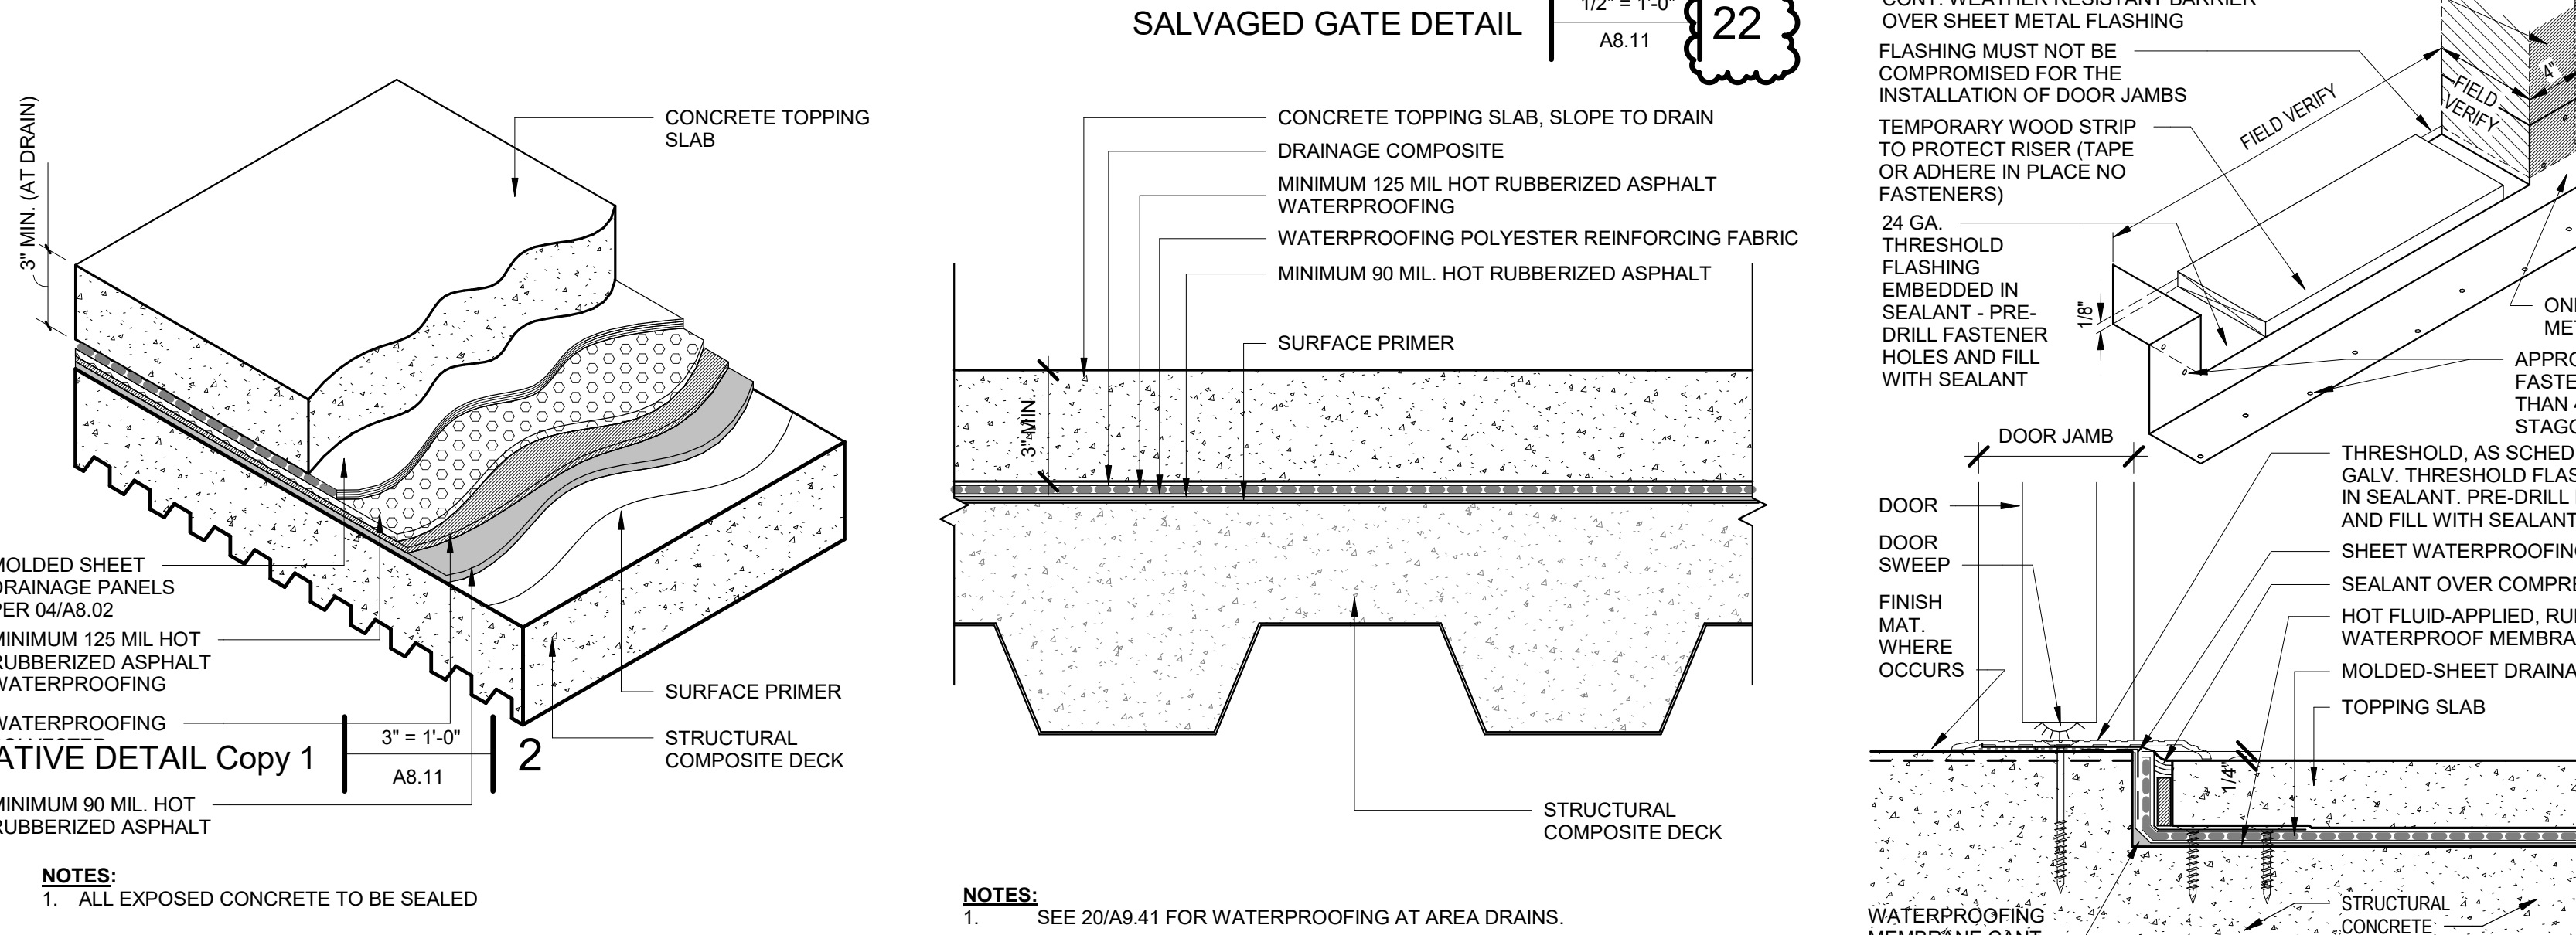


TOPPING SLAB AXON 21


TS1 - TOPPING SLAB 17

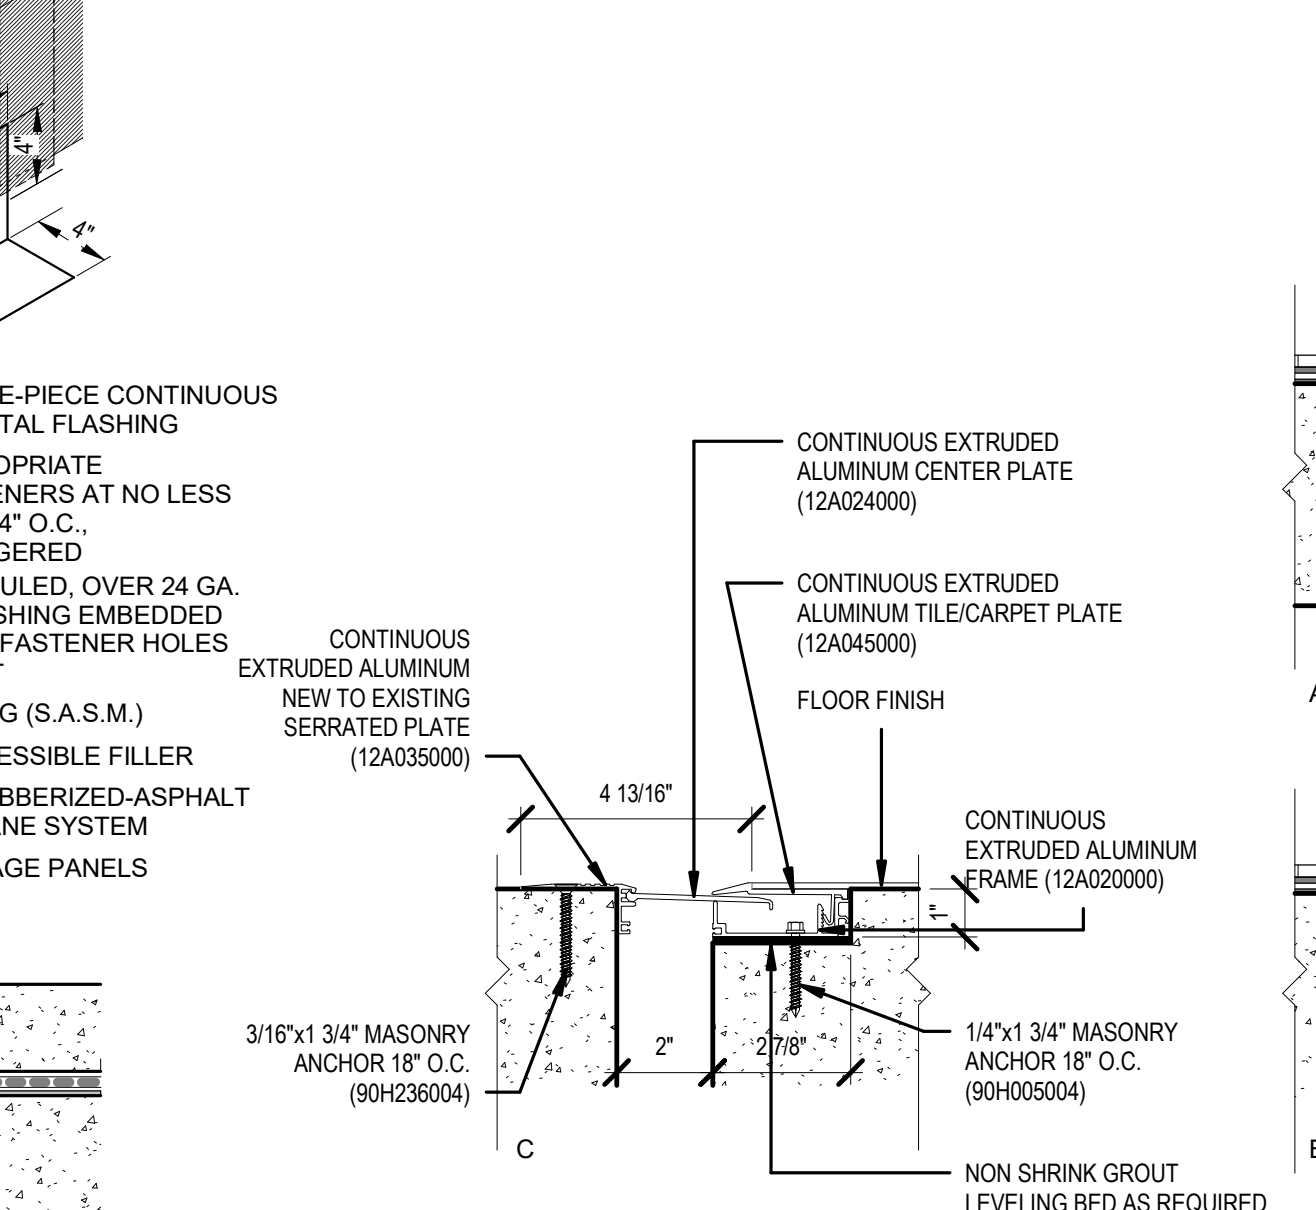


WATERPROOFING AT THRESHOLD 13

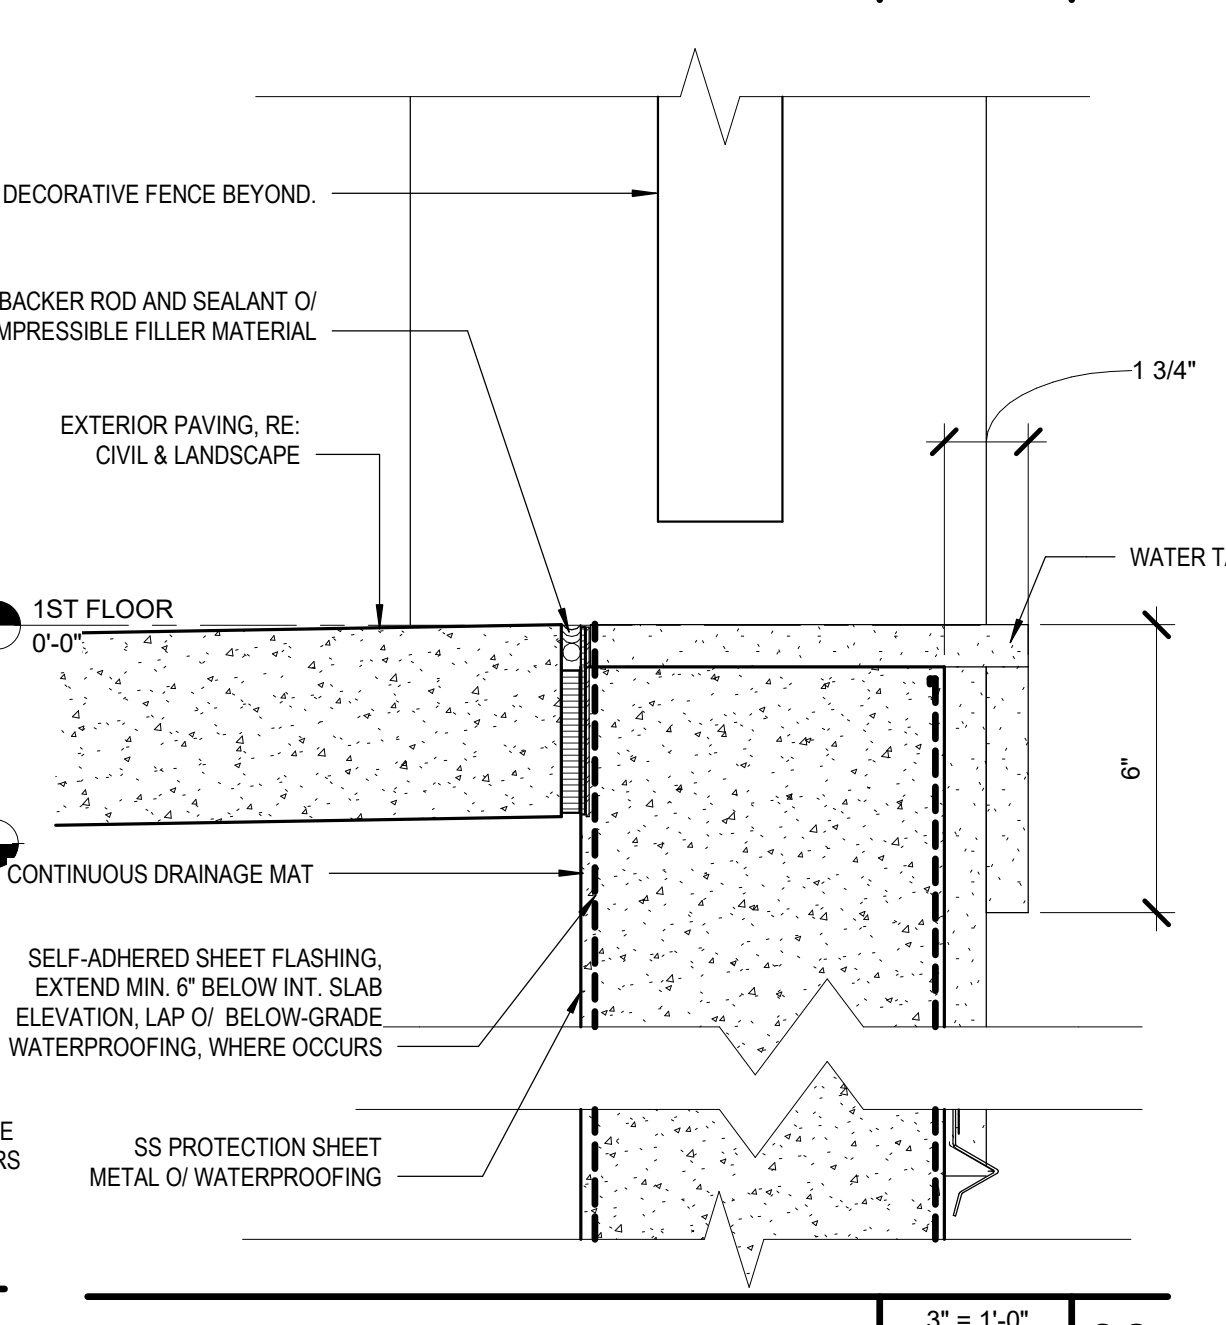

WATER TABLE DETAIL 06

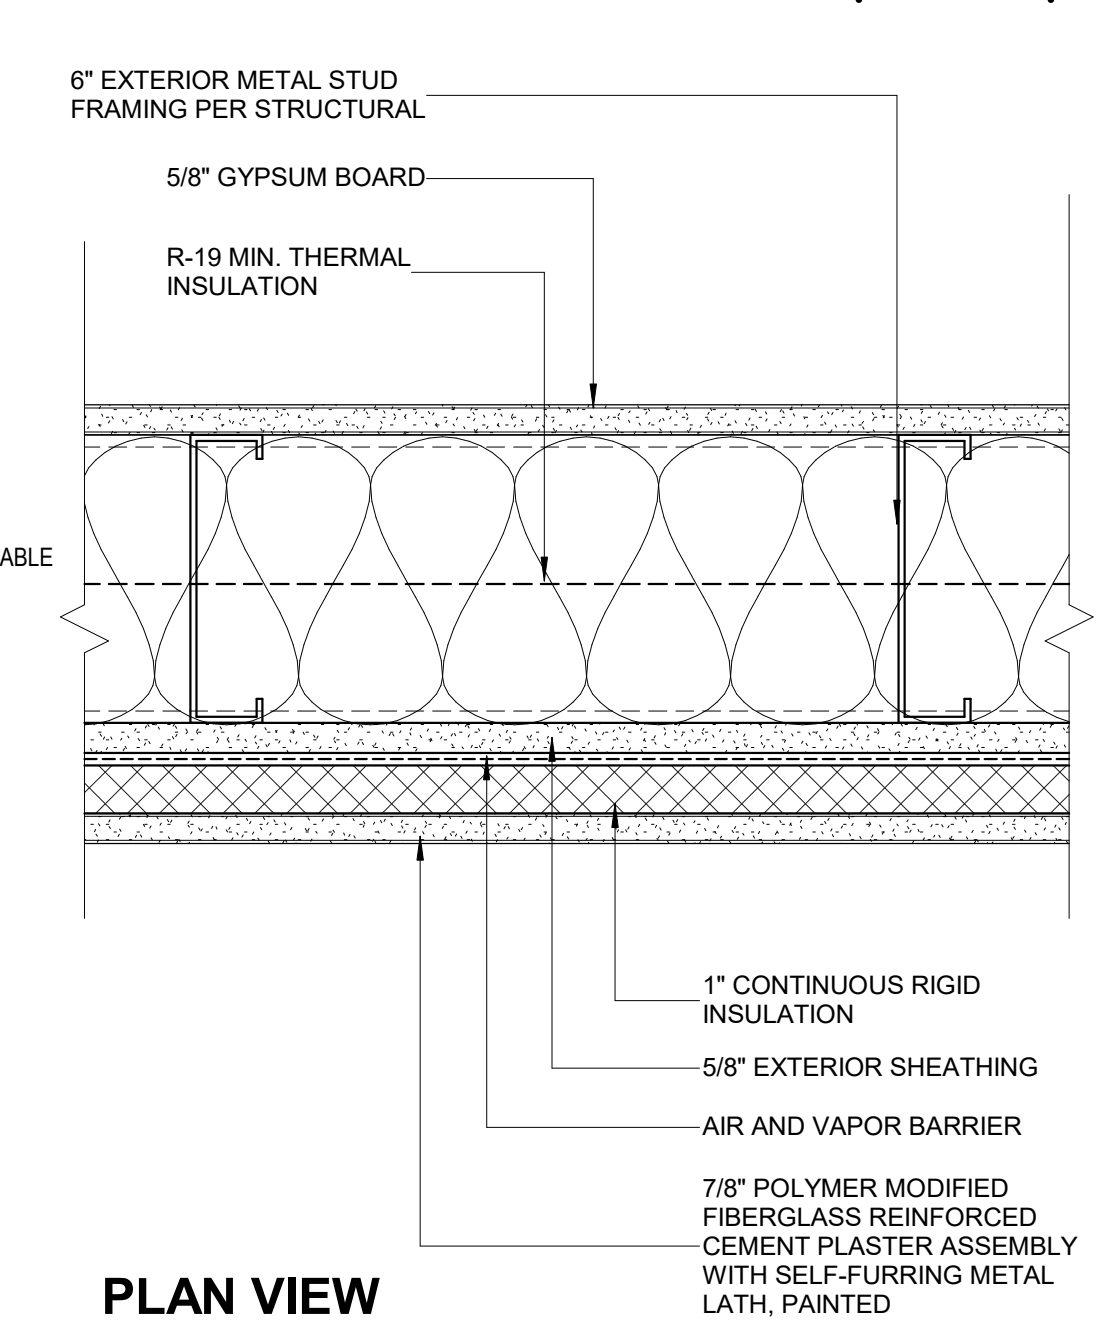


SECTION VIEW

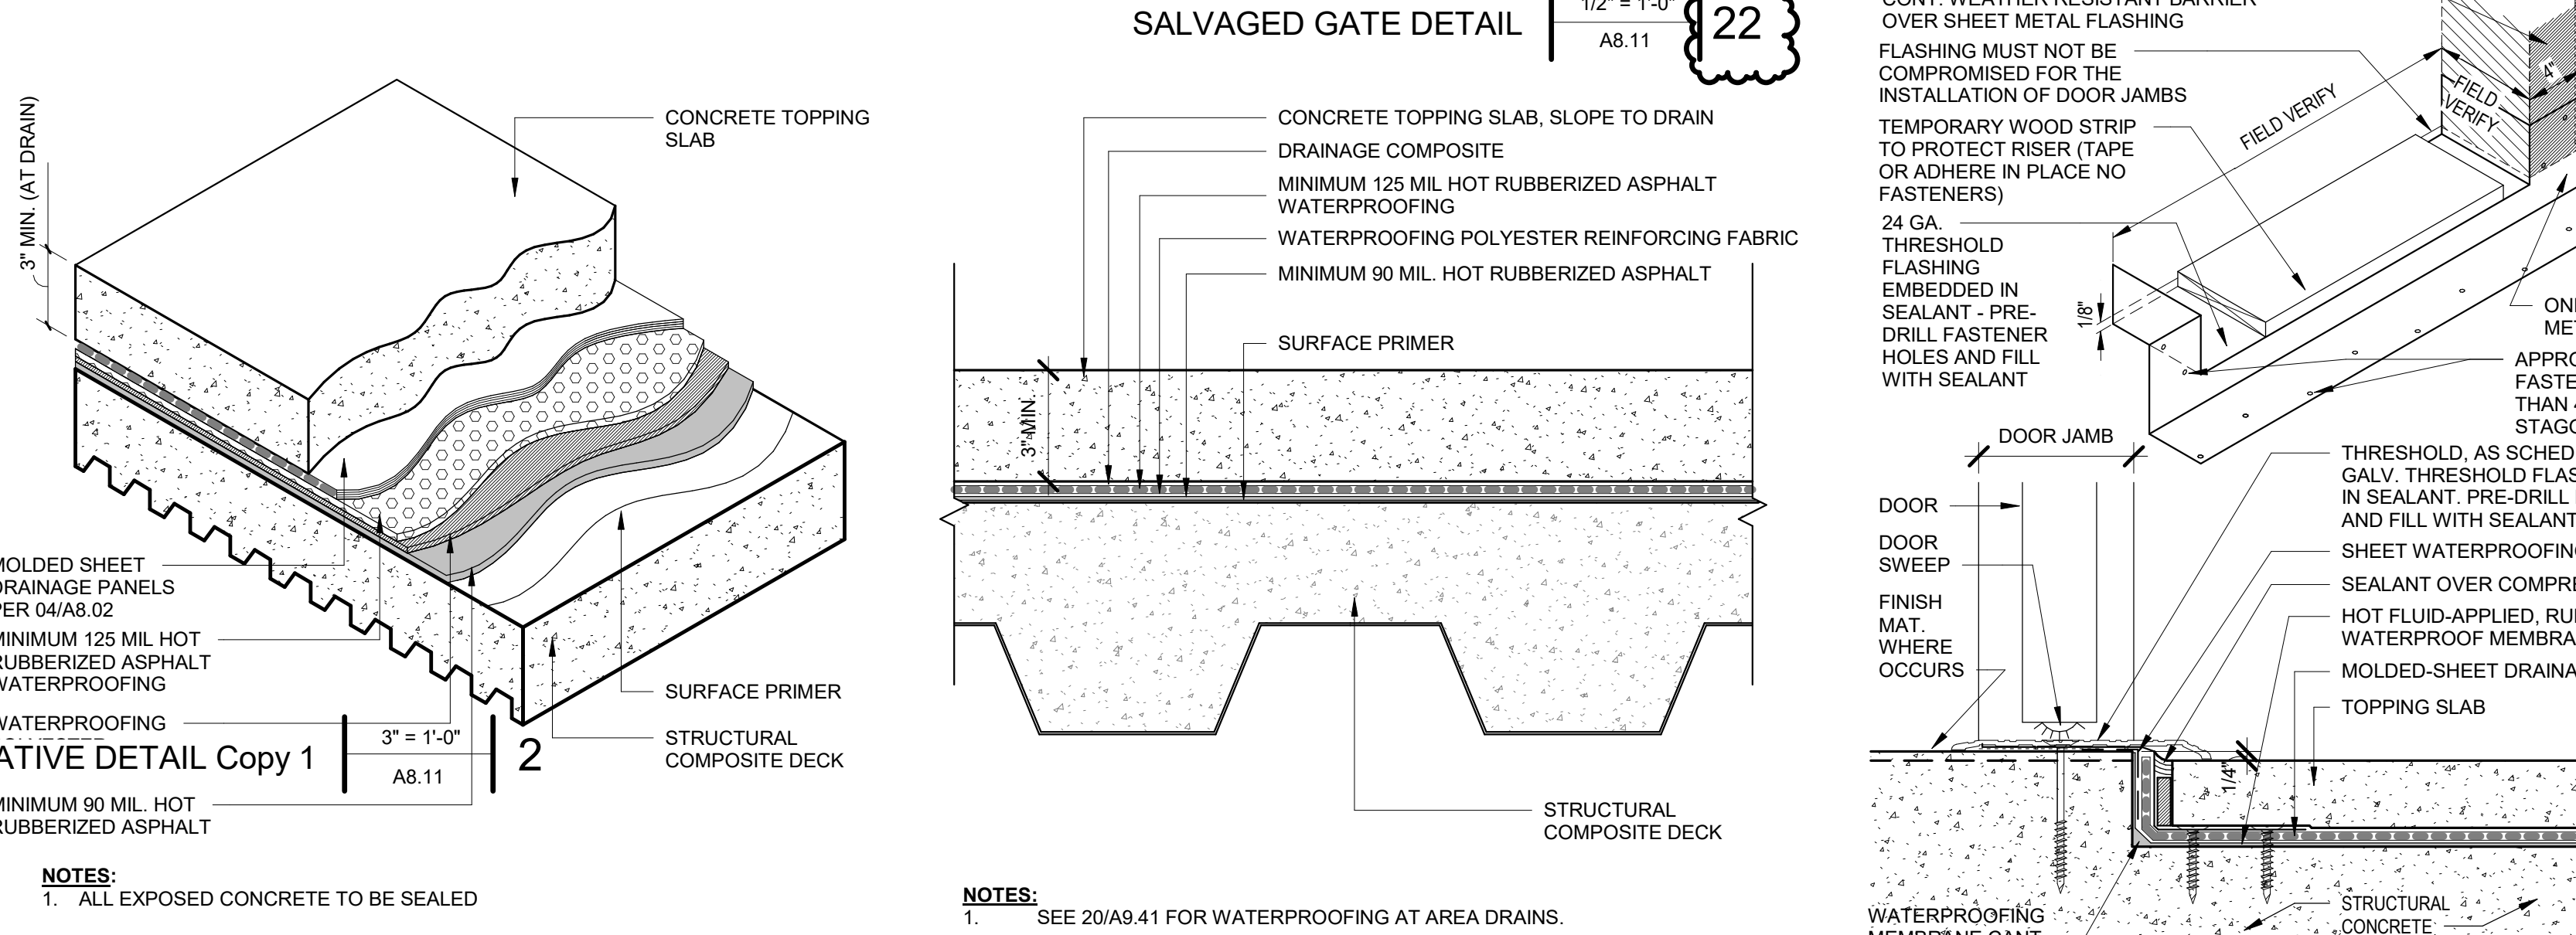


TOPPING SLAB AXON 21


TS1 - TOPPING SLAB 17

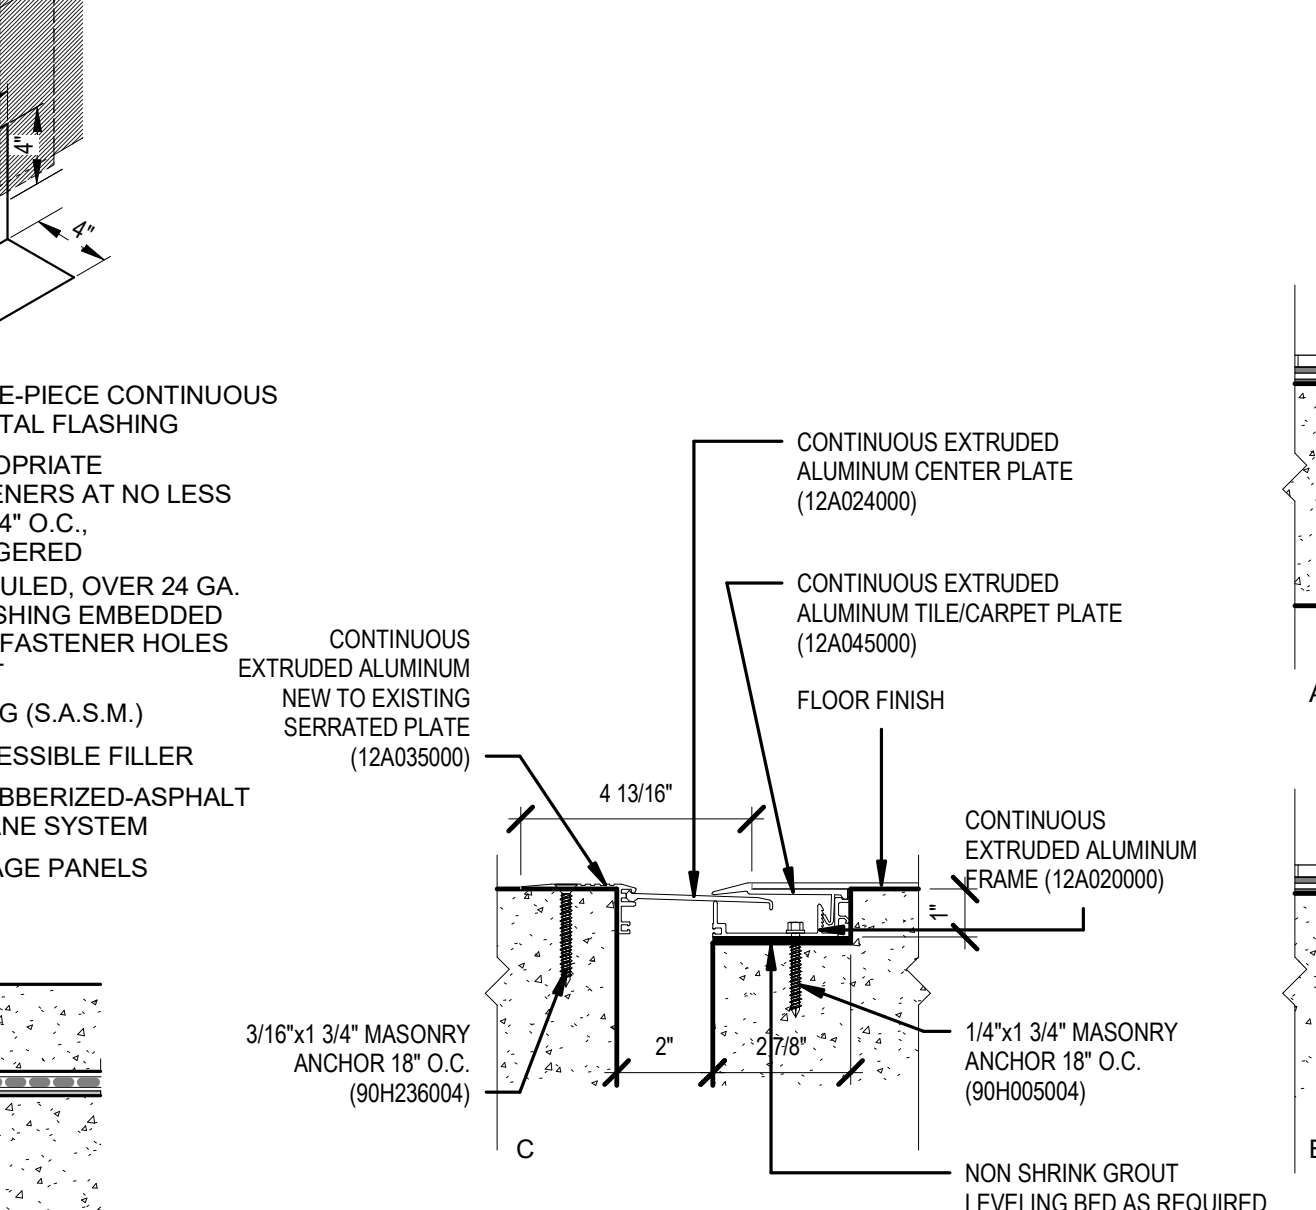


WATERPROOFING AT THRESHOLD 13

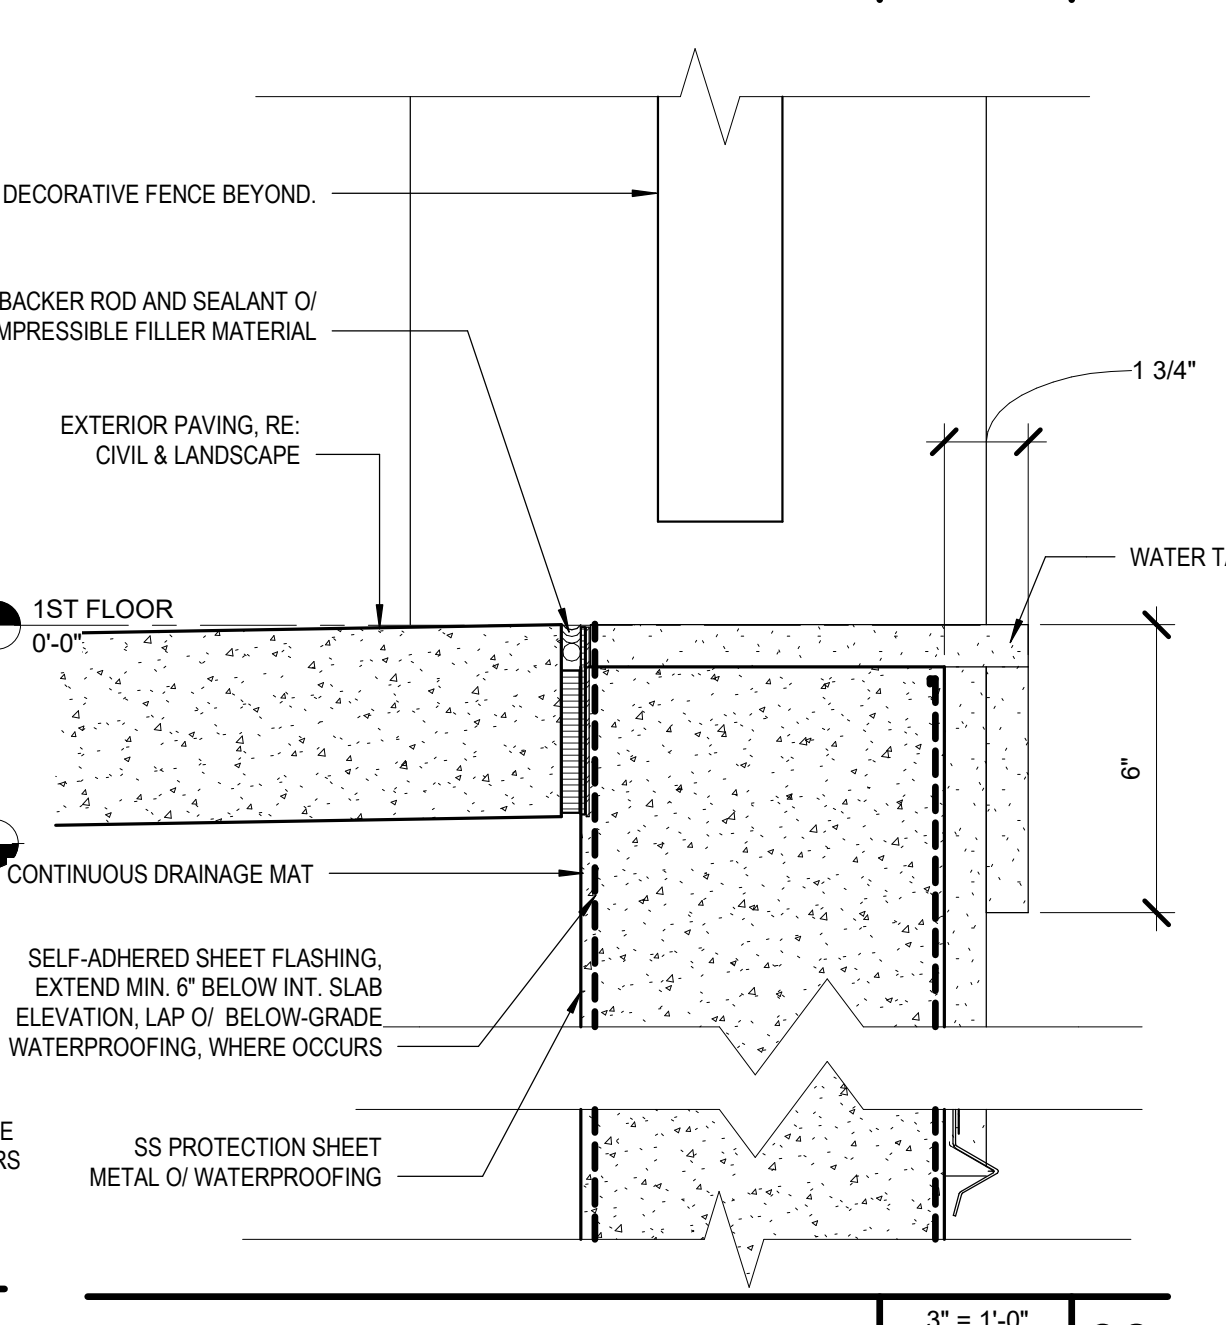

WATER TABLE DETAIL 06

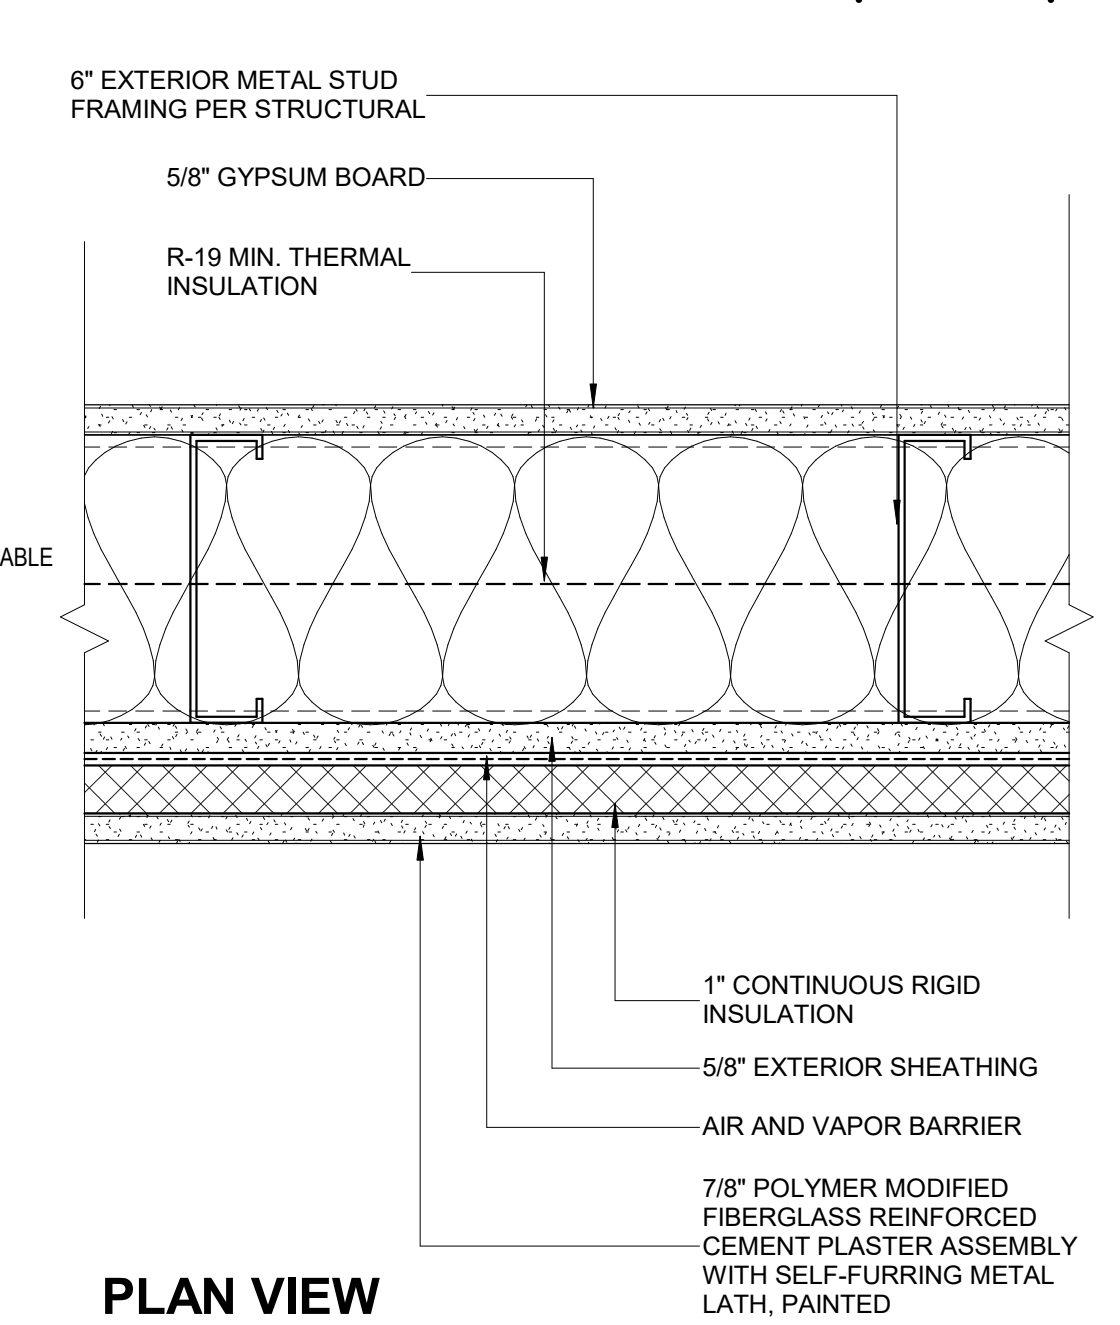


SECTION VIEW

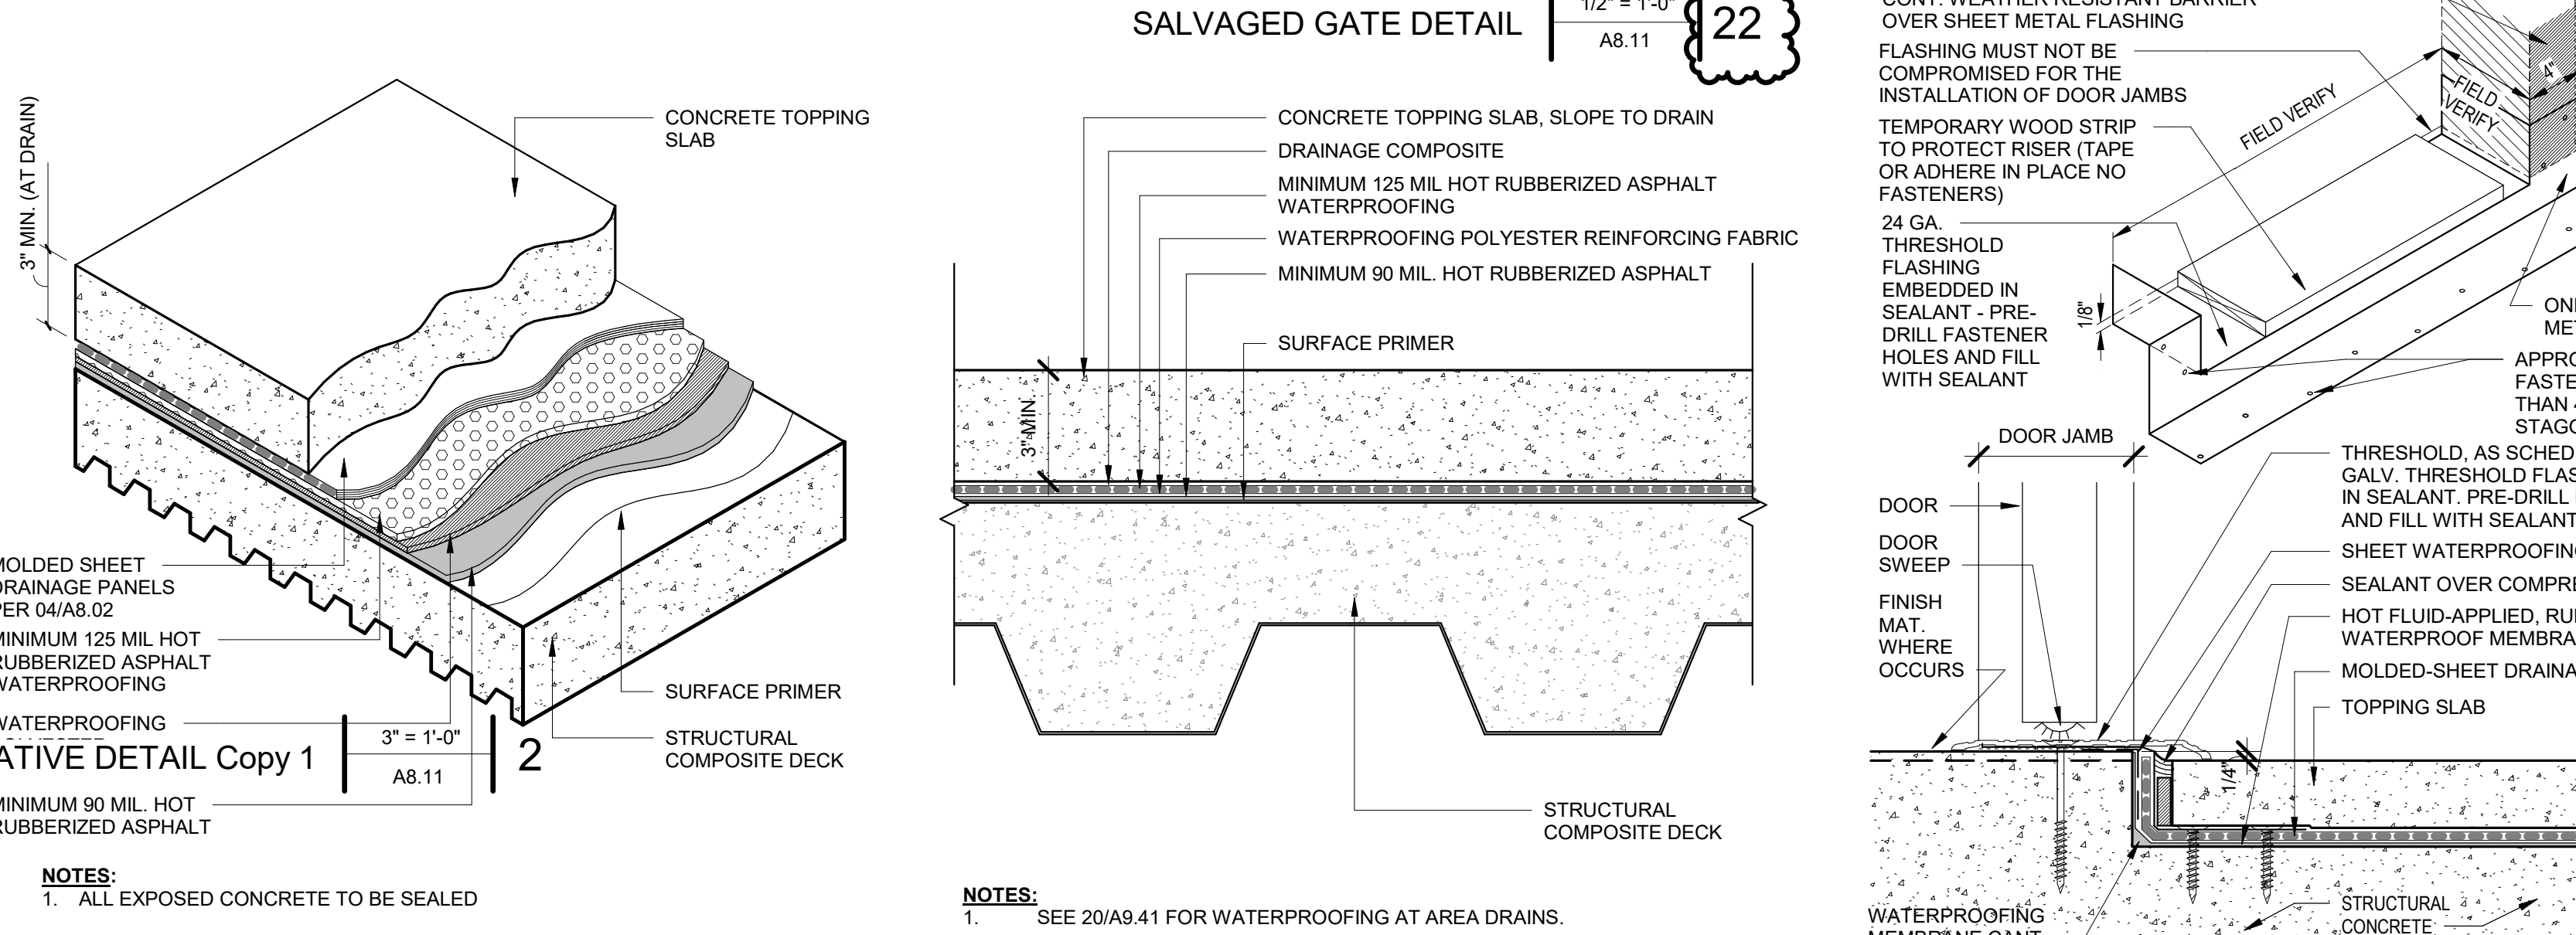


TOPPING SLAB AXON 21


TS1 - TOPPING SLAB 17

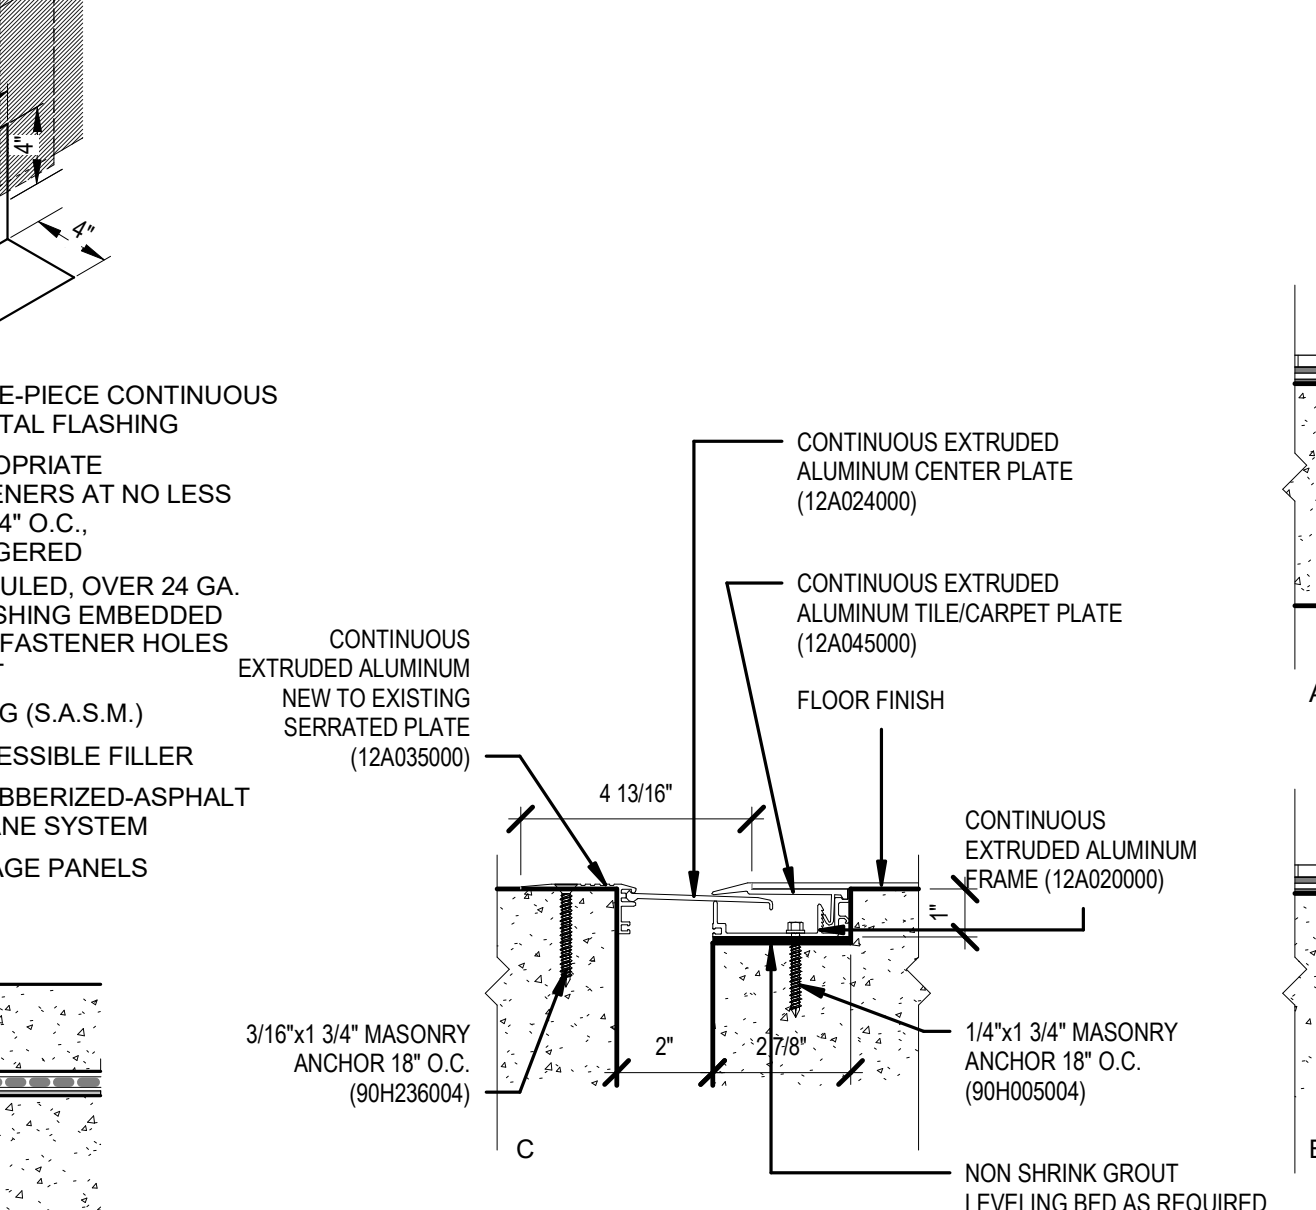


WATERPROOFING AT THRESHOLD 13

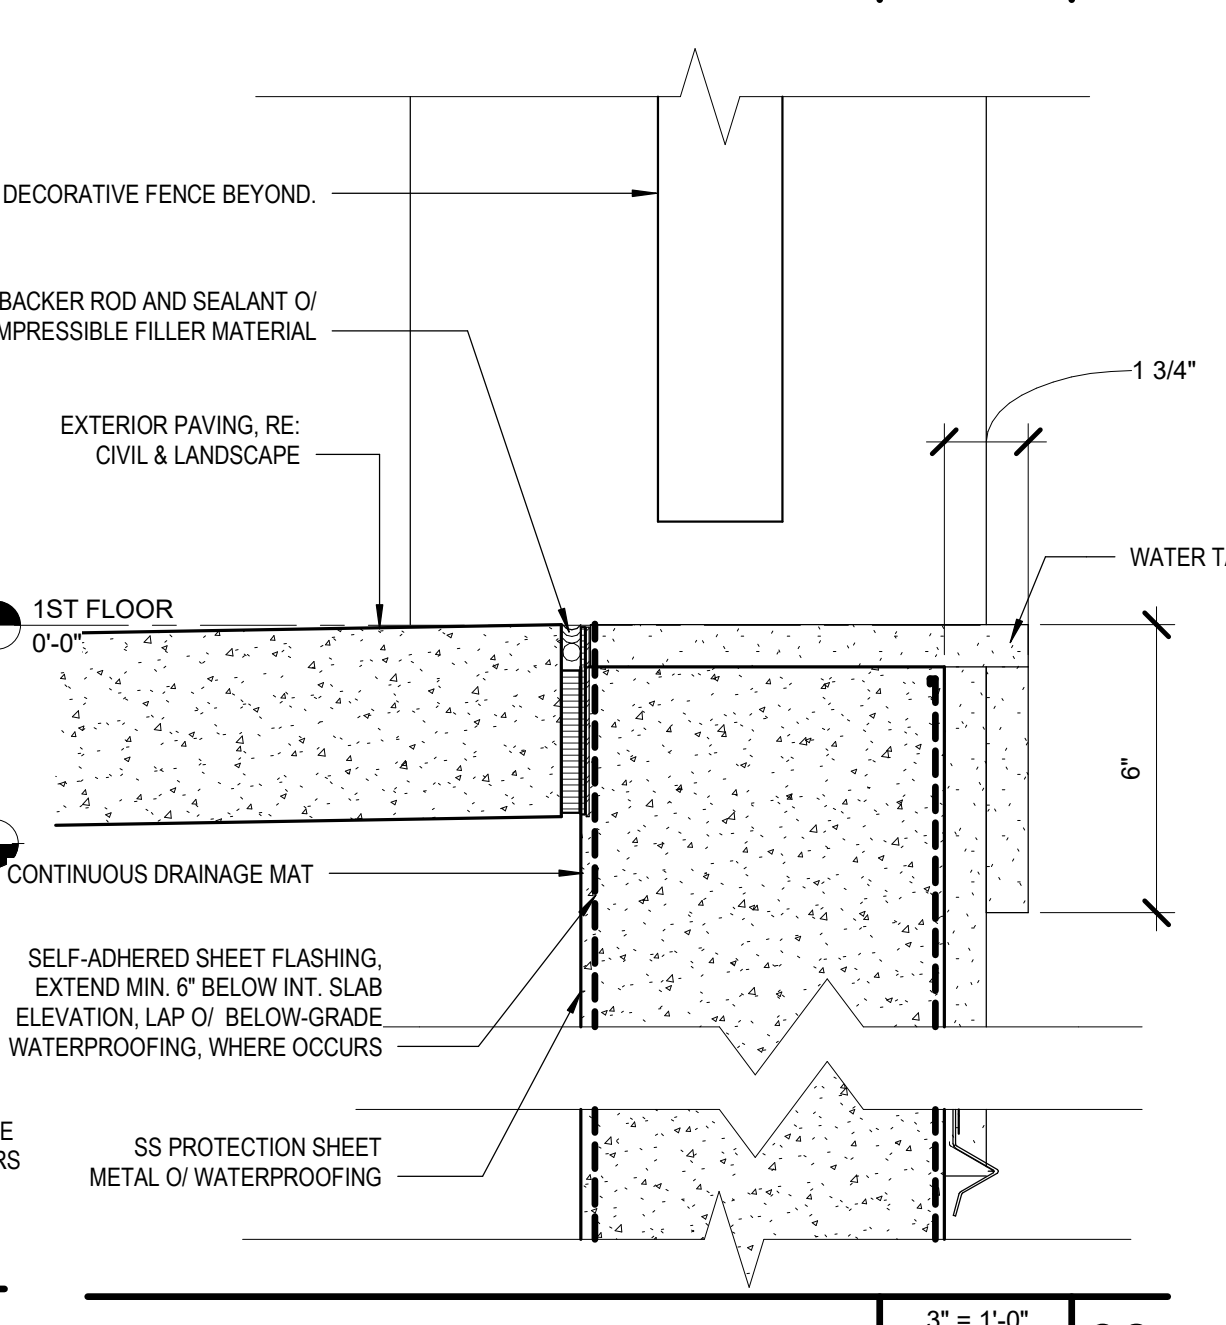

WATER TABLE DETAIL 06

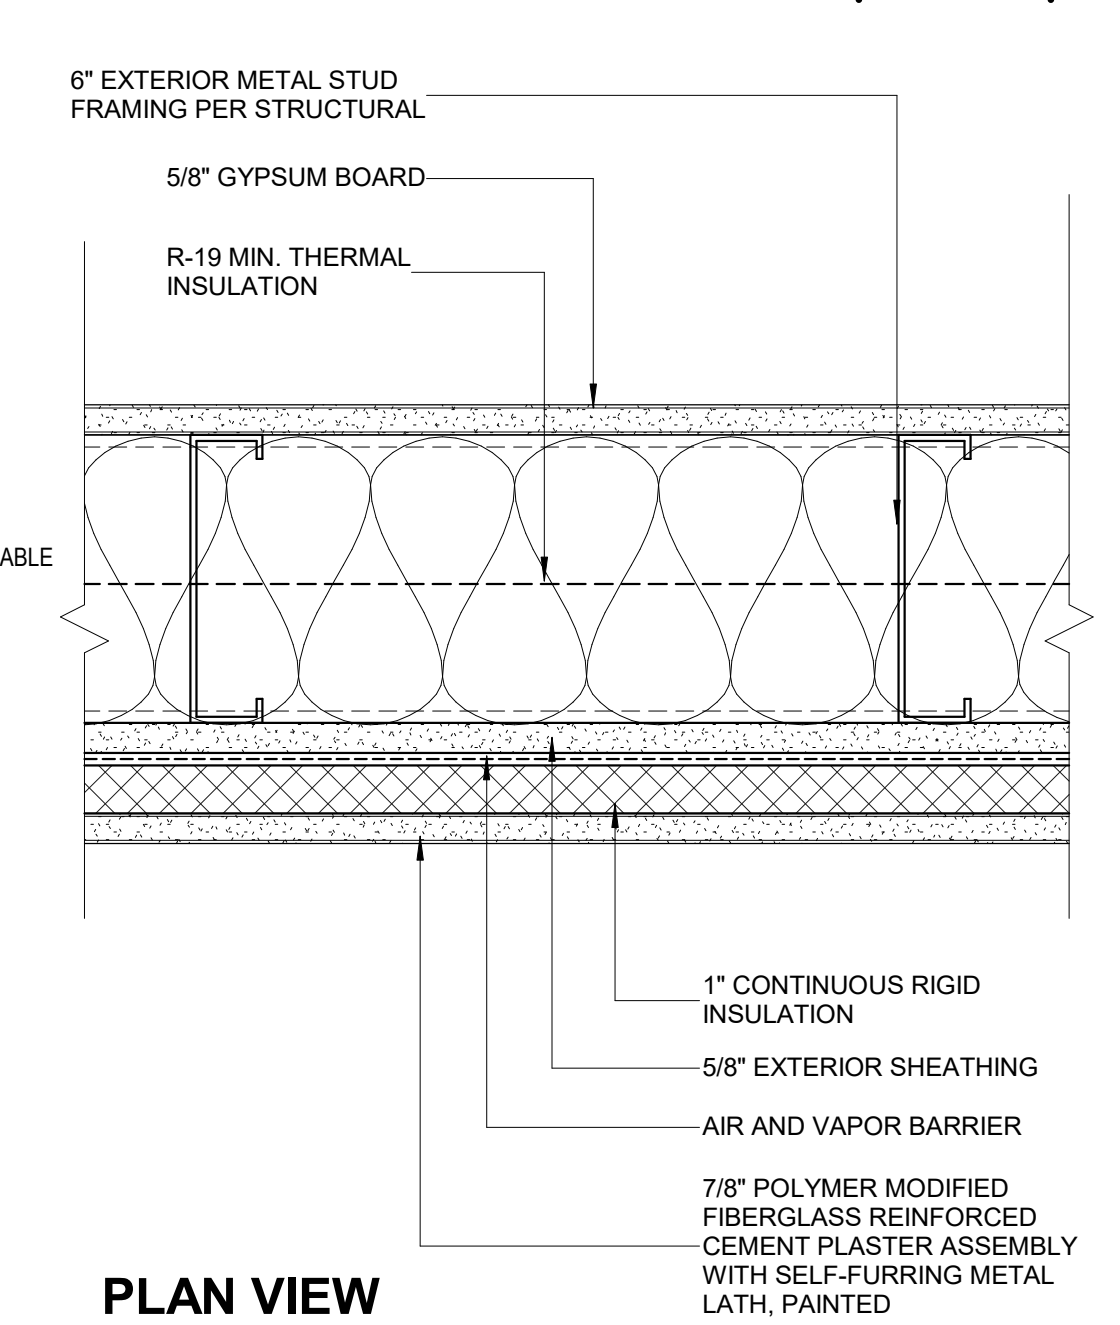


SECTION VIEW

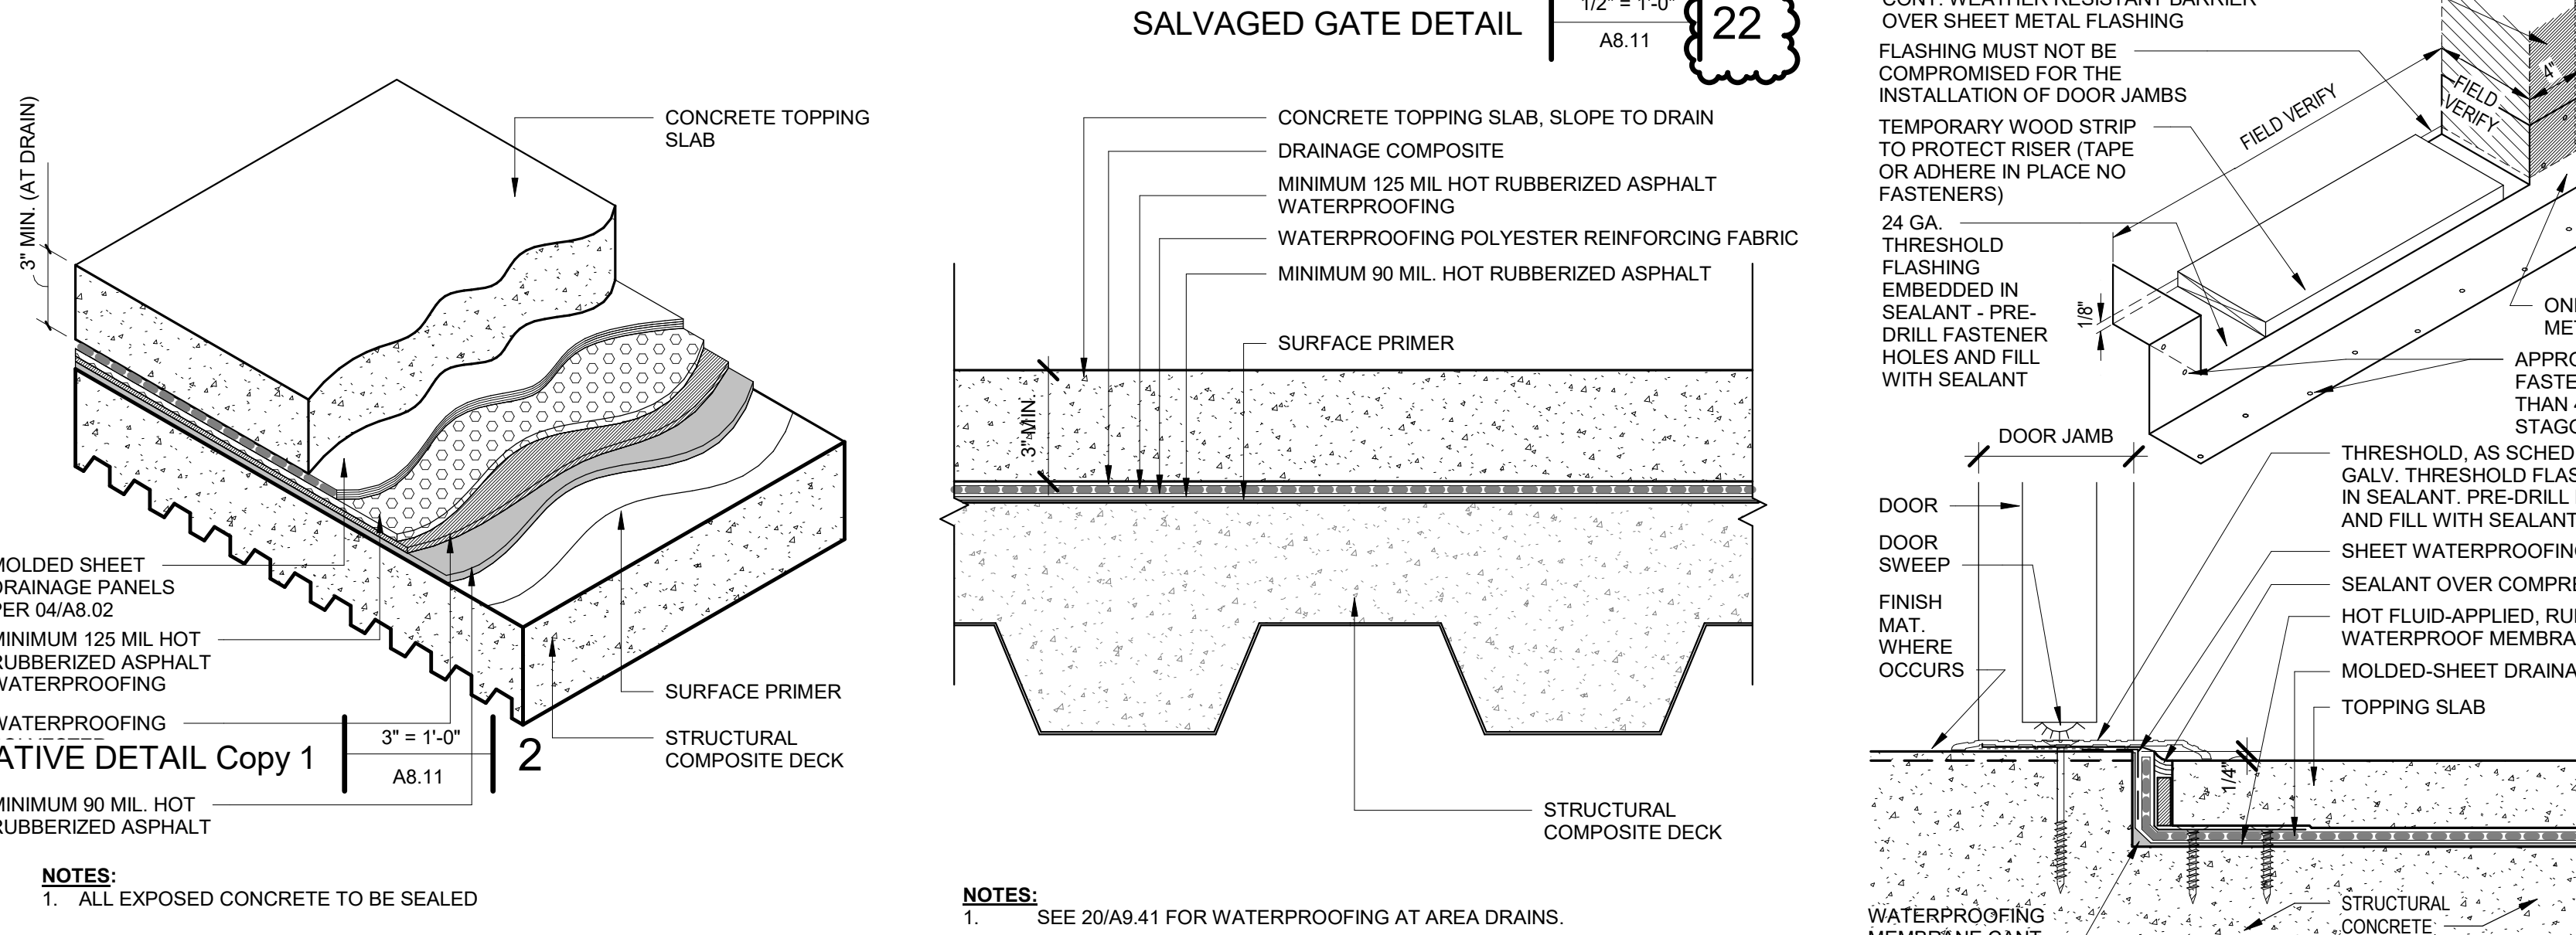


TOPPING SLAB AXON 21


TS1 - TOPPING SLAB 17

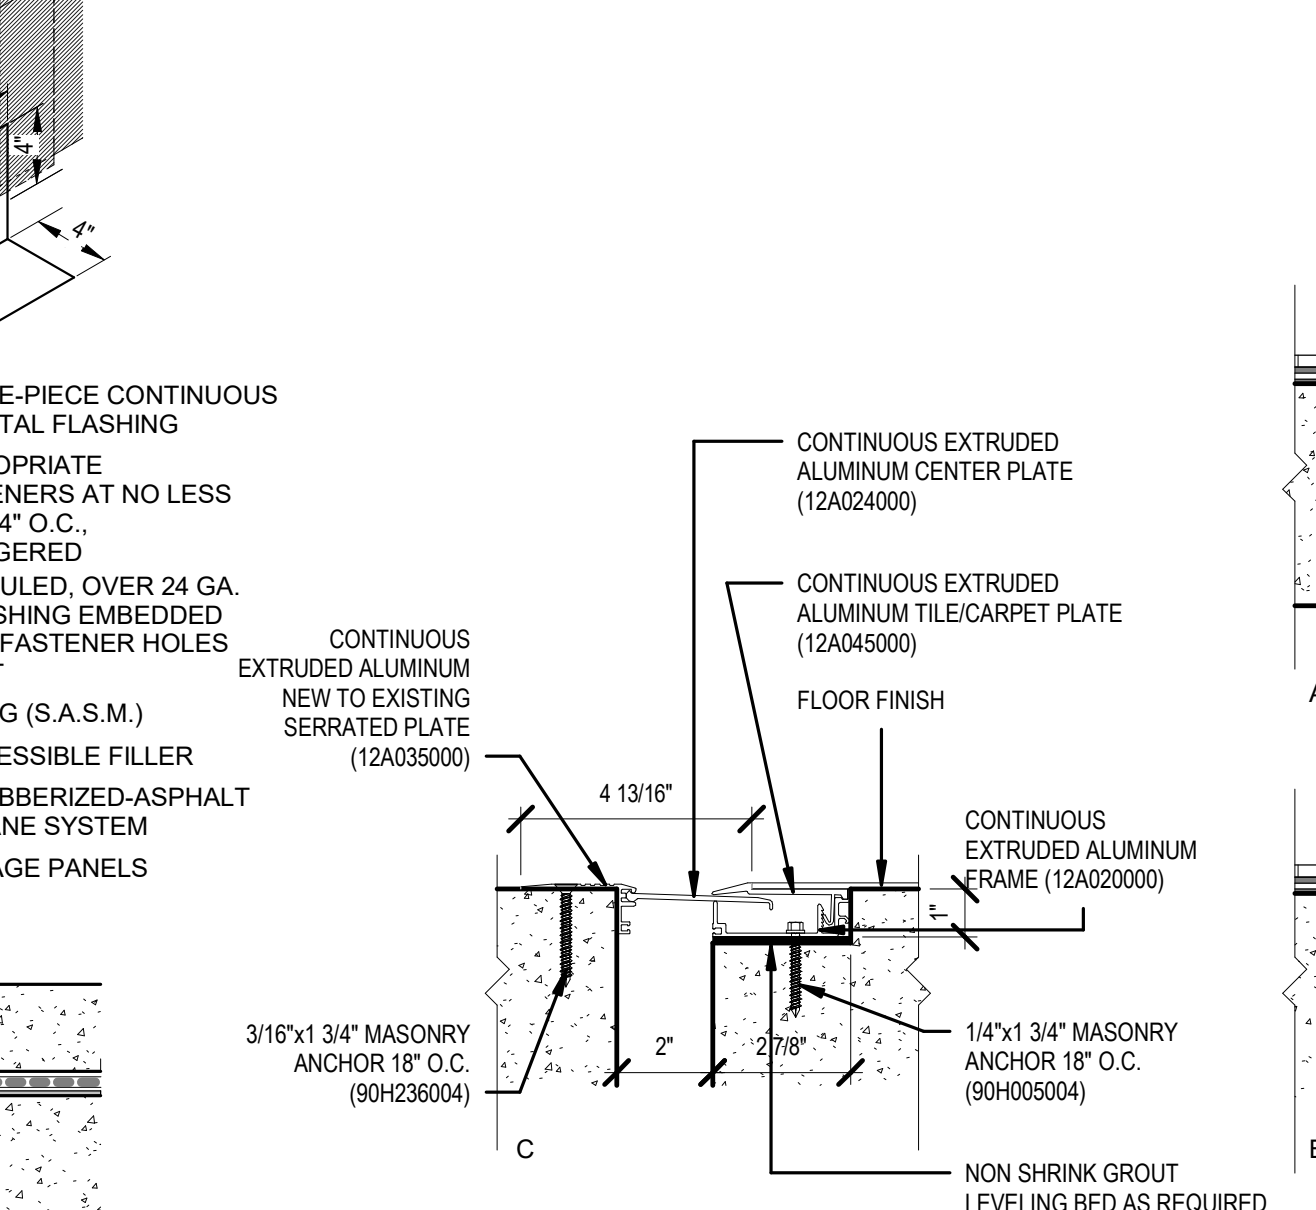


WATERPROOFING AT THRESHOLD 13

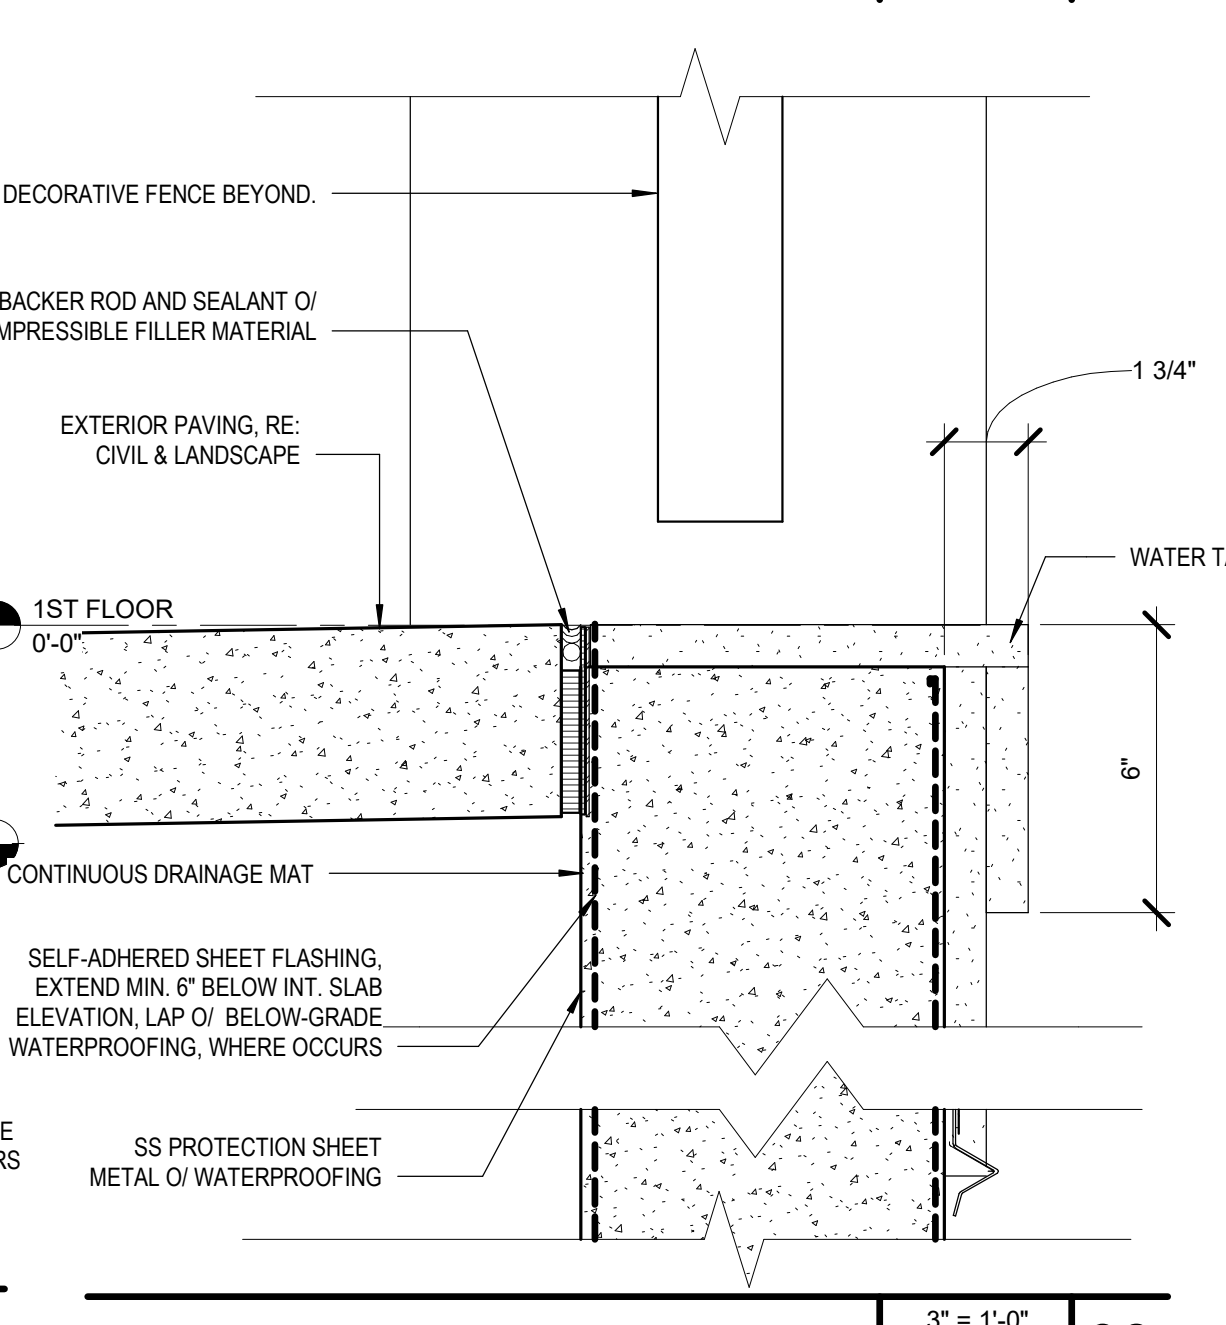

WATER TABLE DETAIL 06

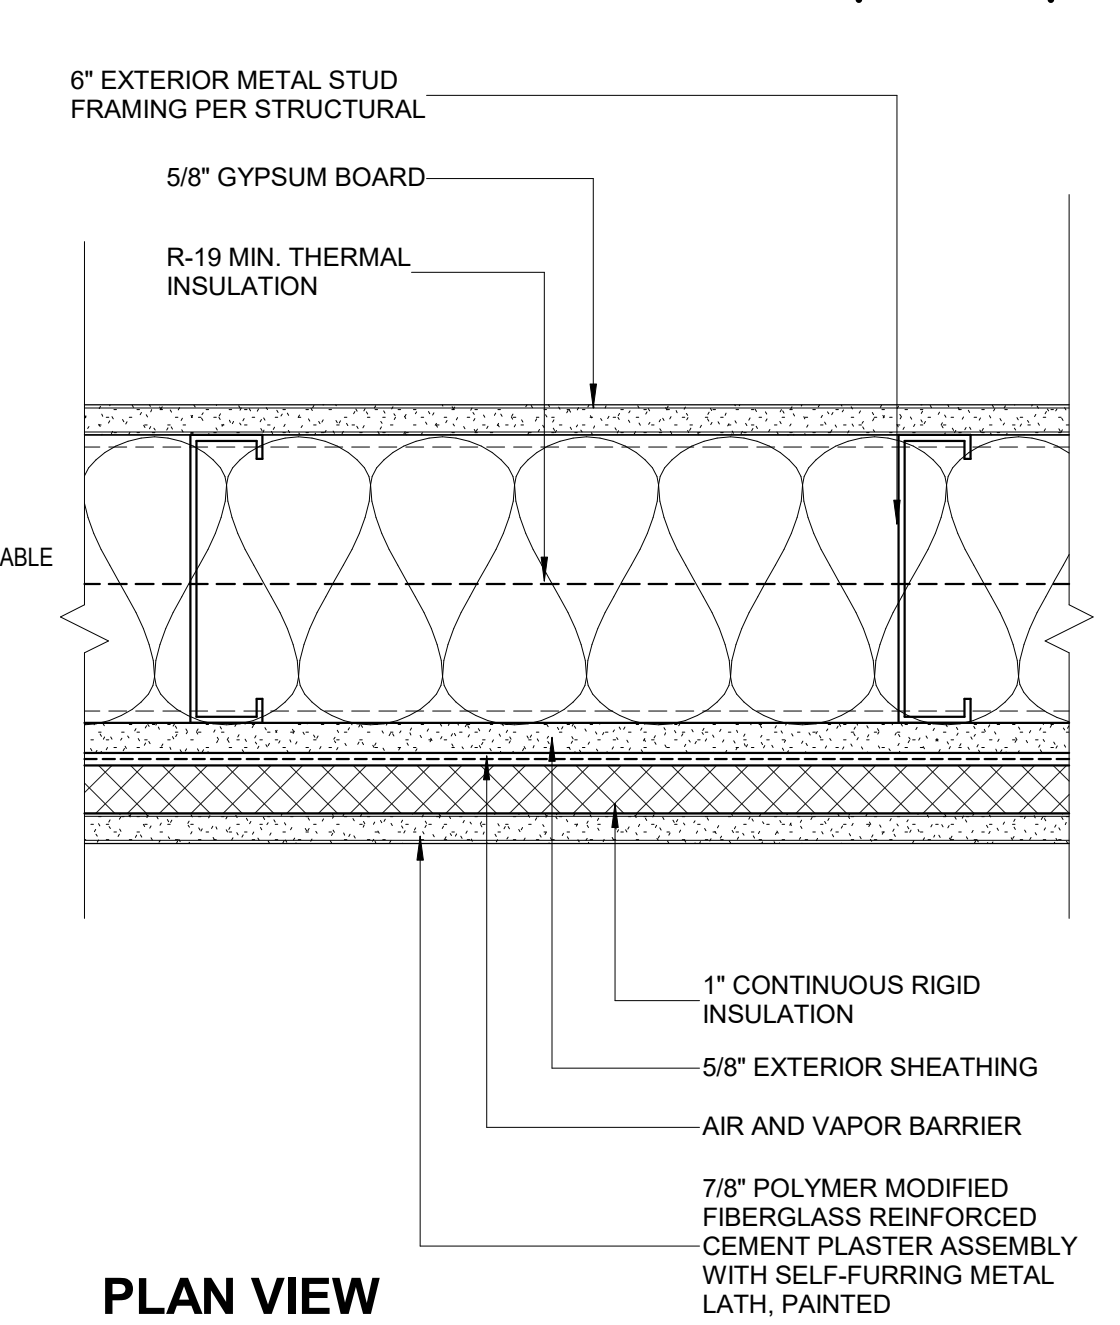


SECTION VIEW

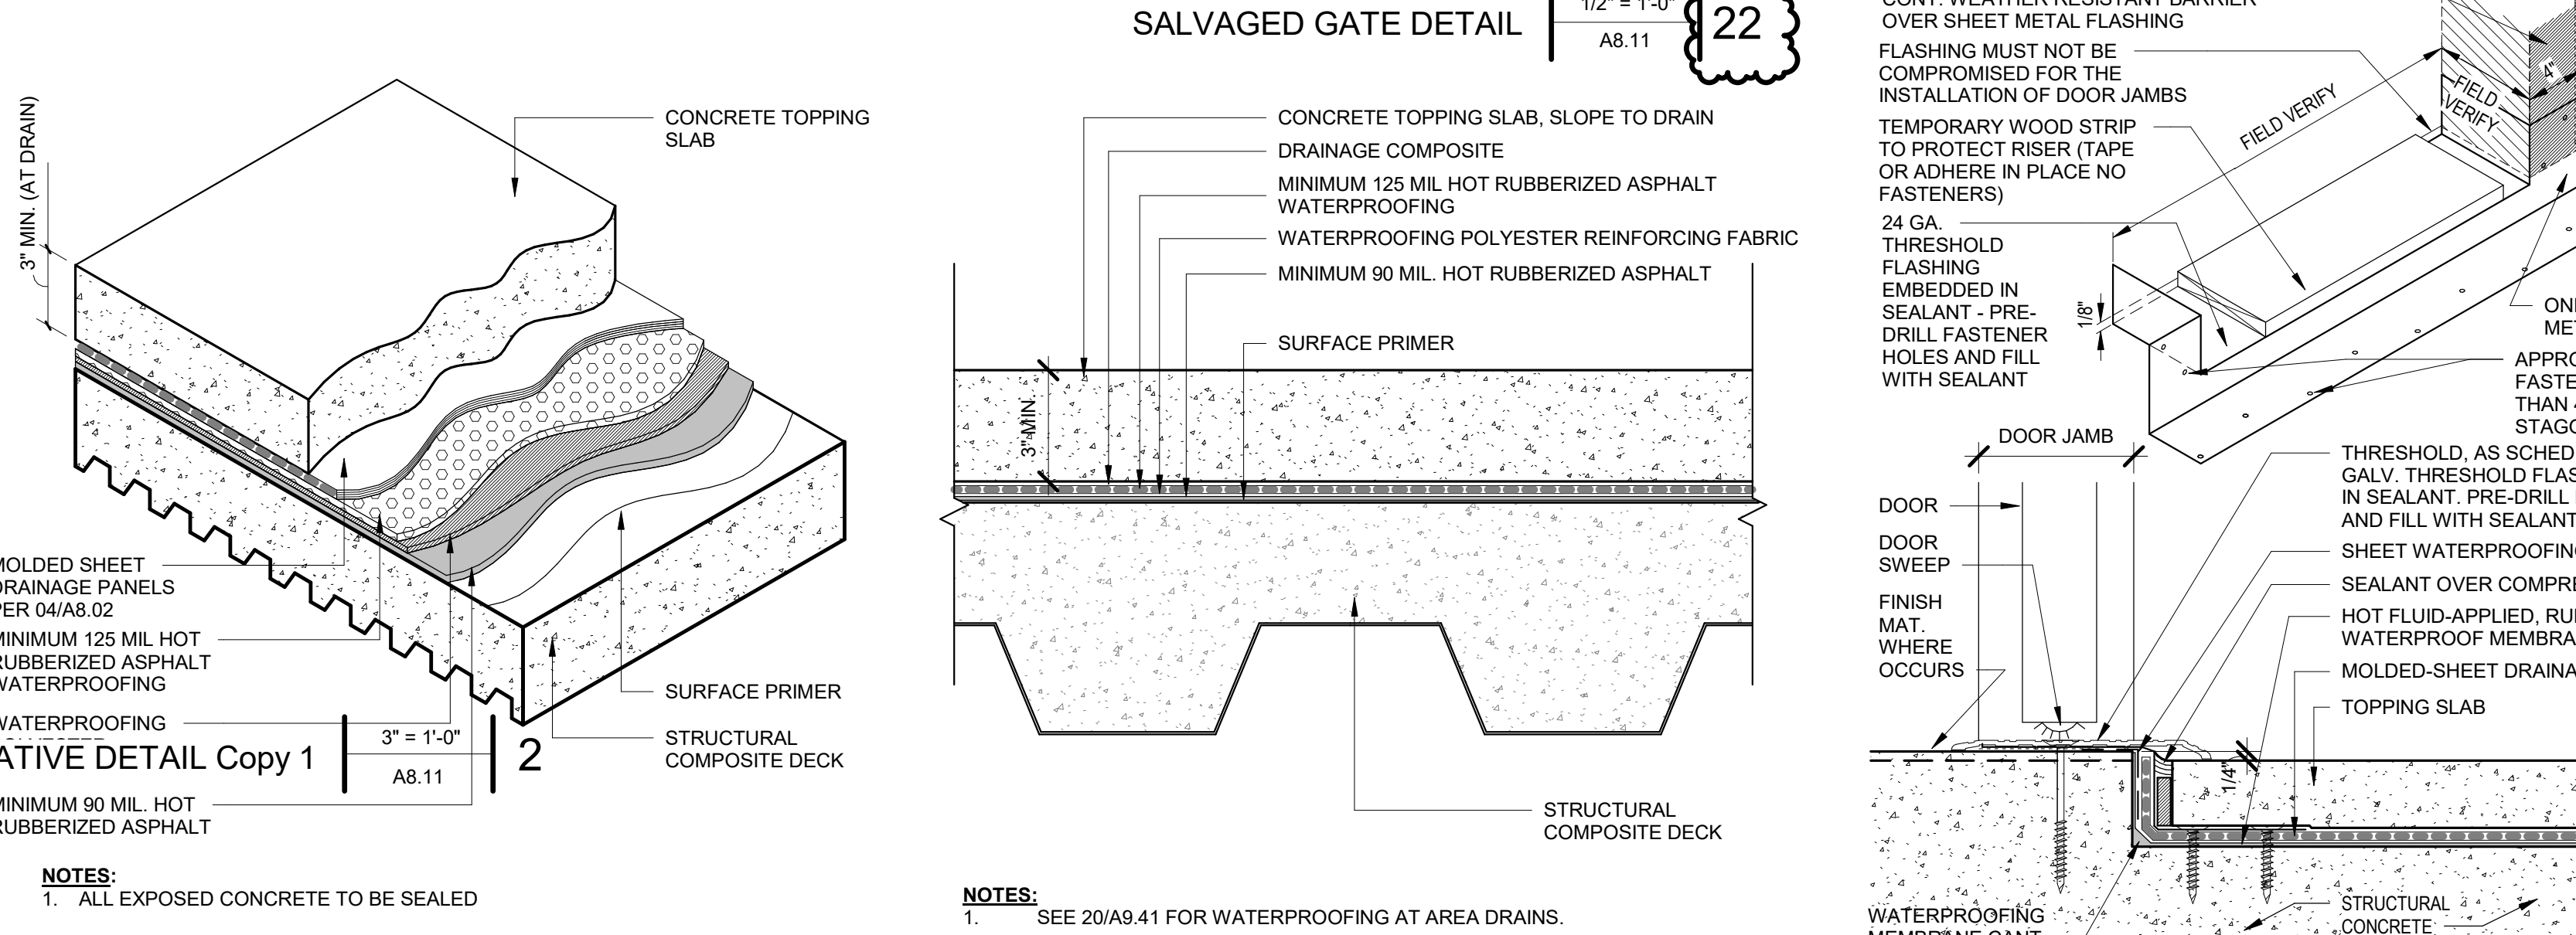


TOPPING SLAB AXON 21


TS1 - TOPPING SLAB 17

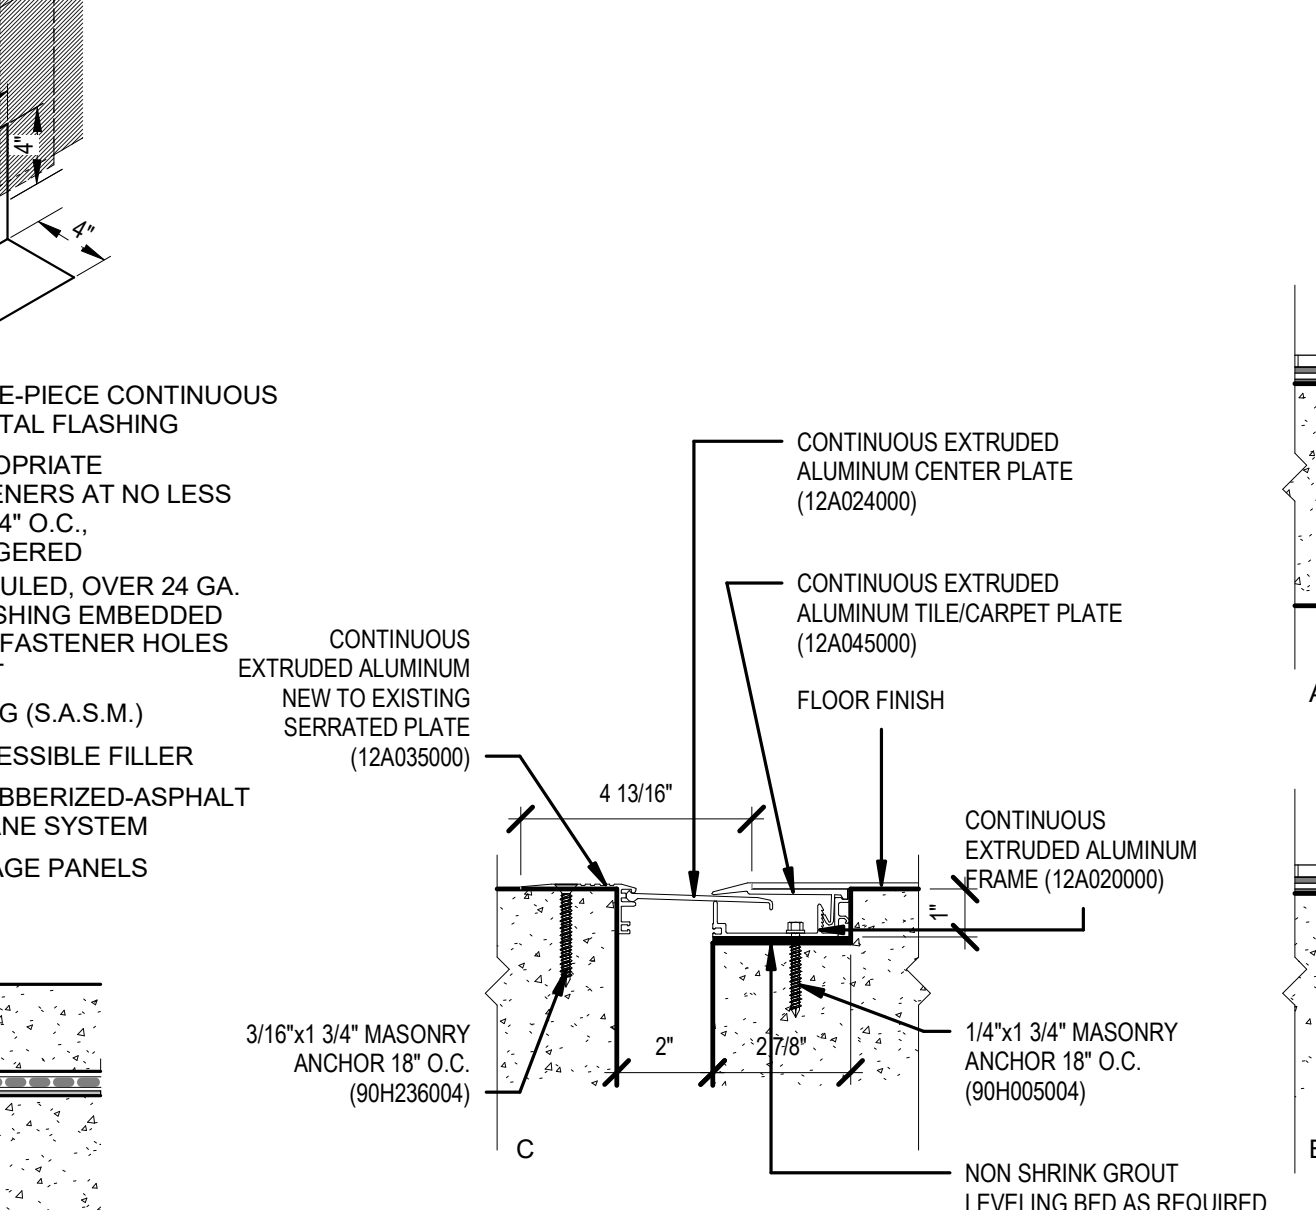


WATERPROOFING AT THRESHOLD 13

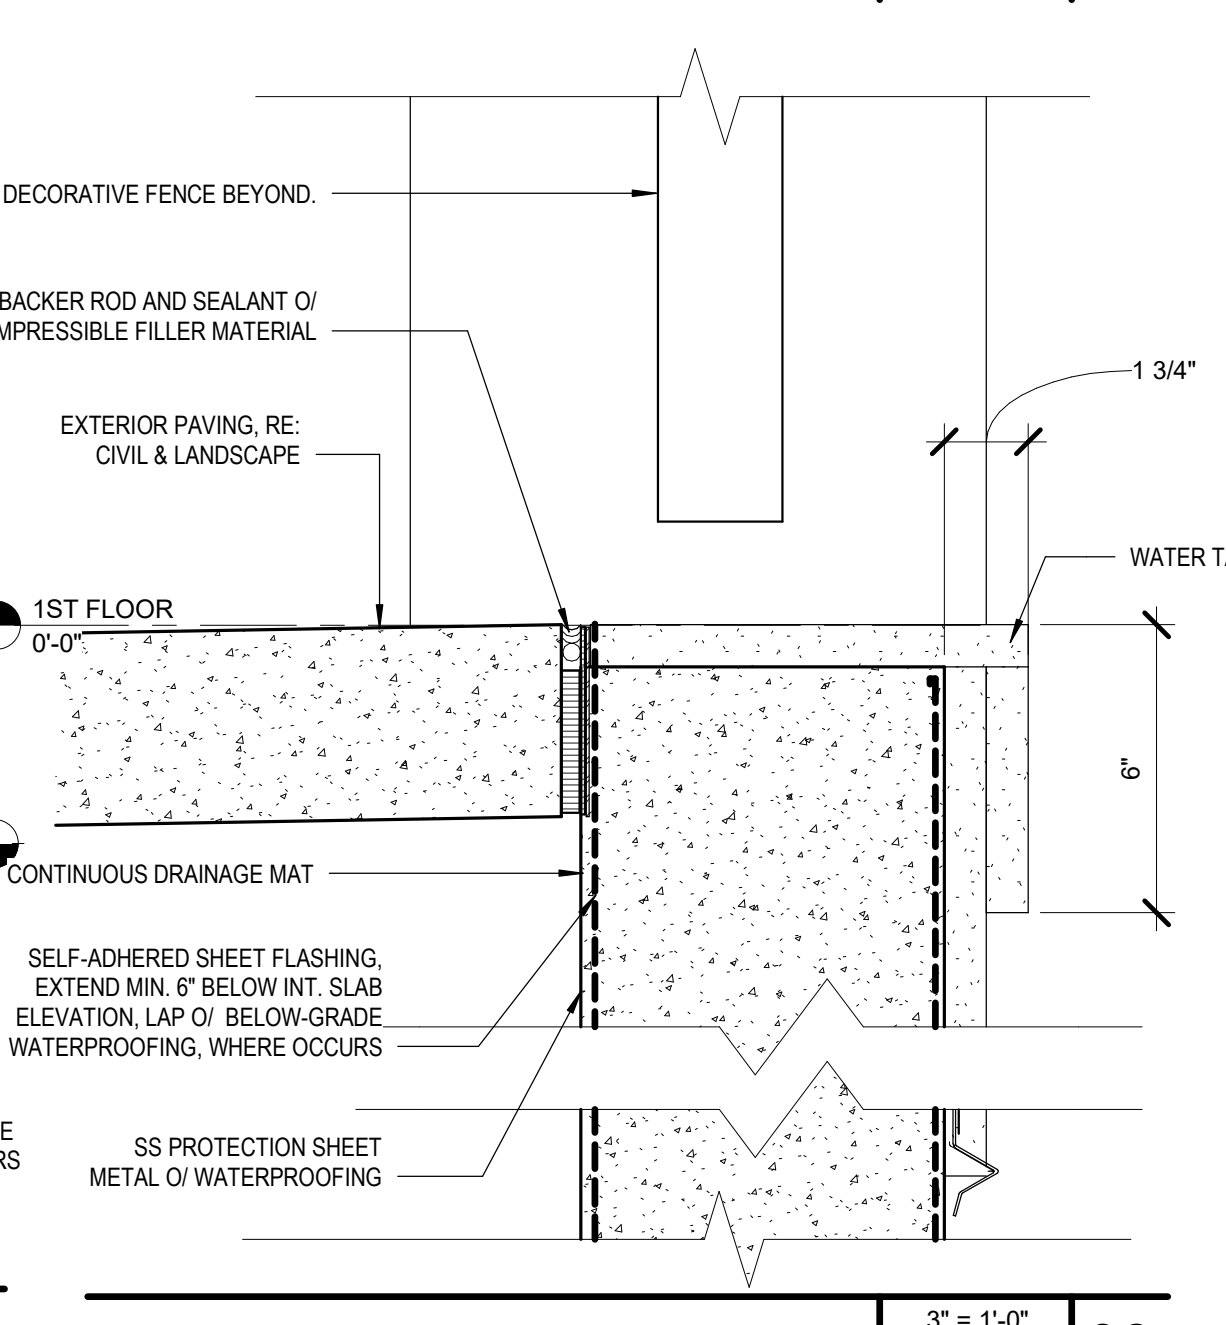

WATER TABLE DETAIL 06

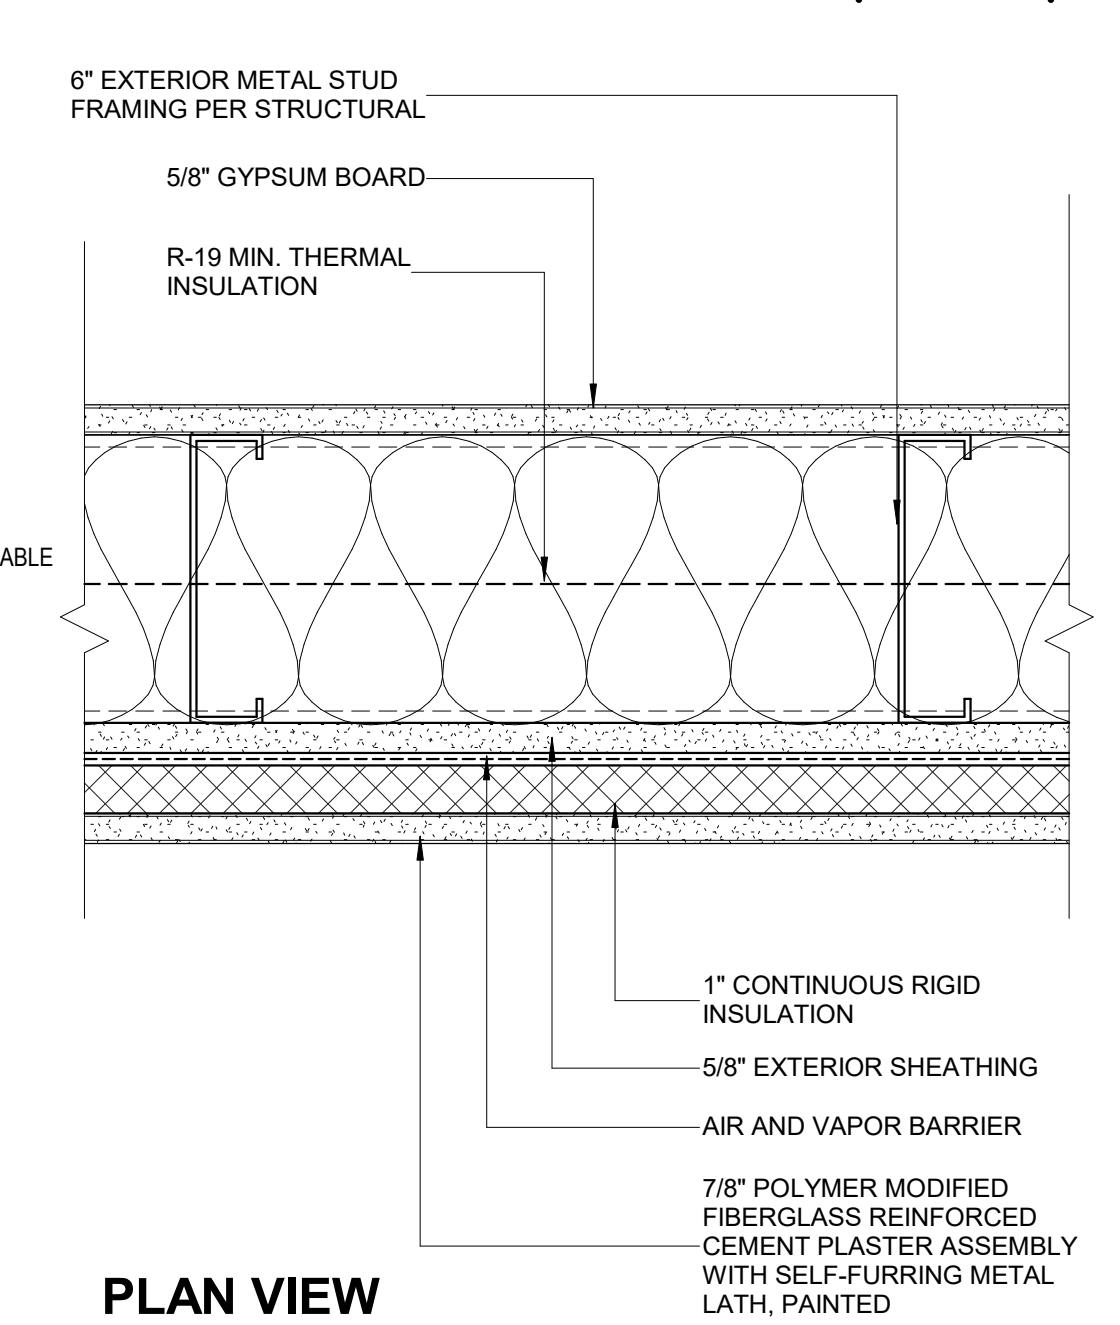


SECTION VIEW

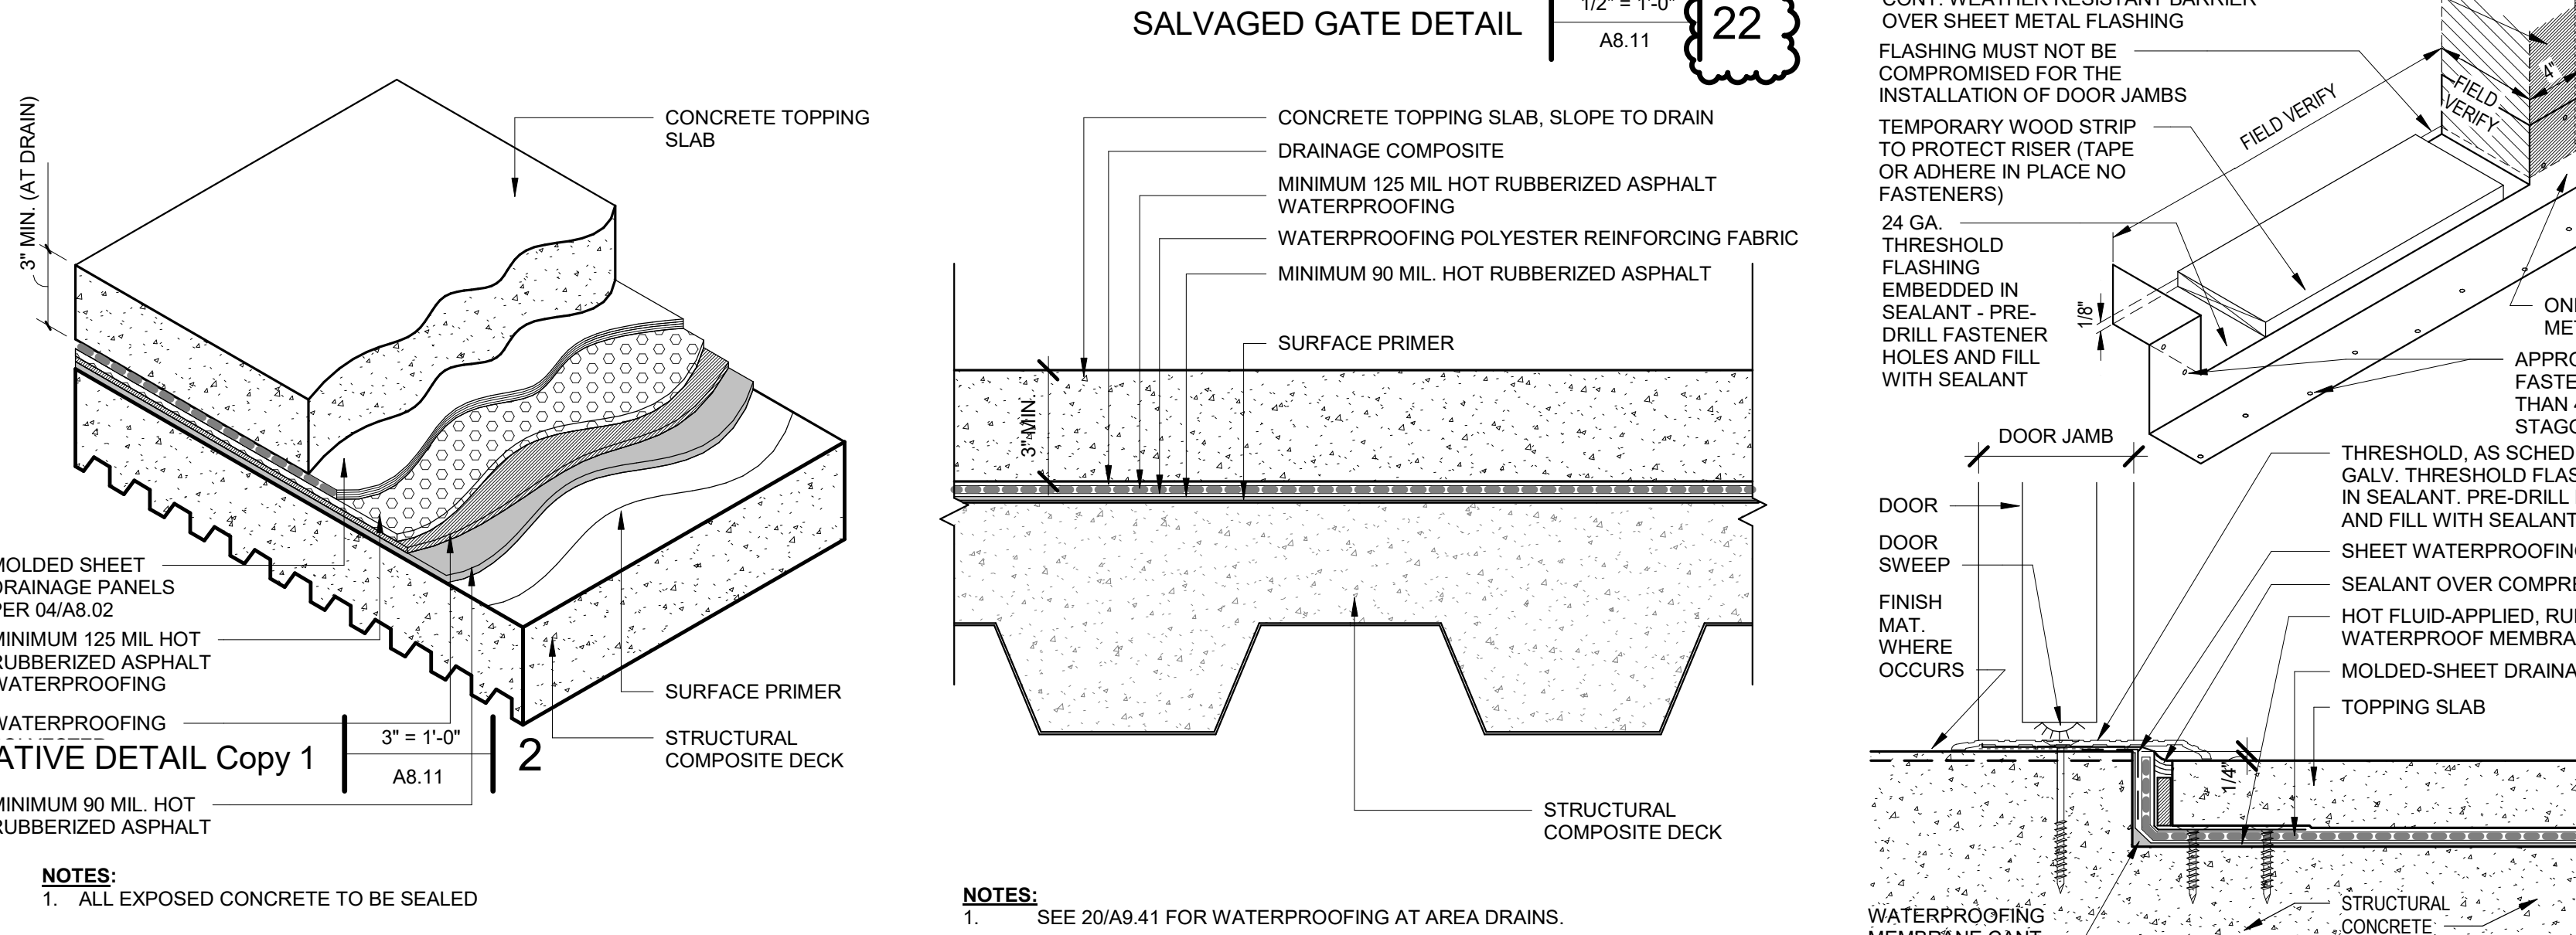


TOPPING SLAB AXON 21


TS1 - TOPPING SLAB 17

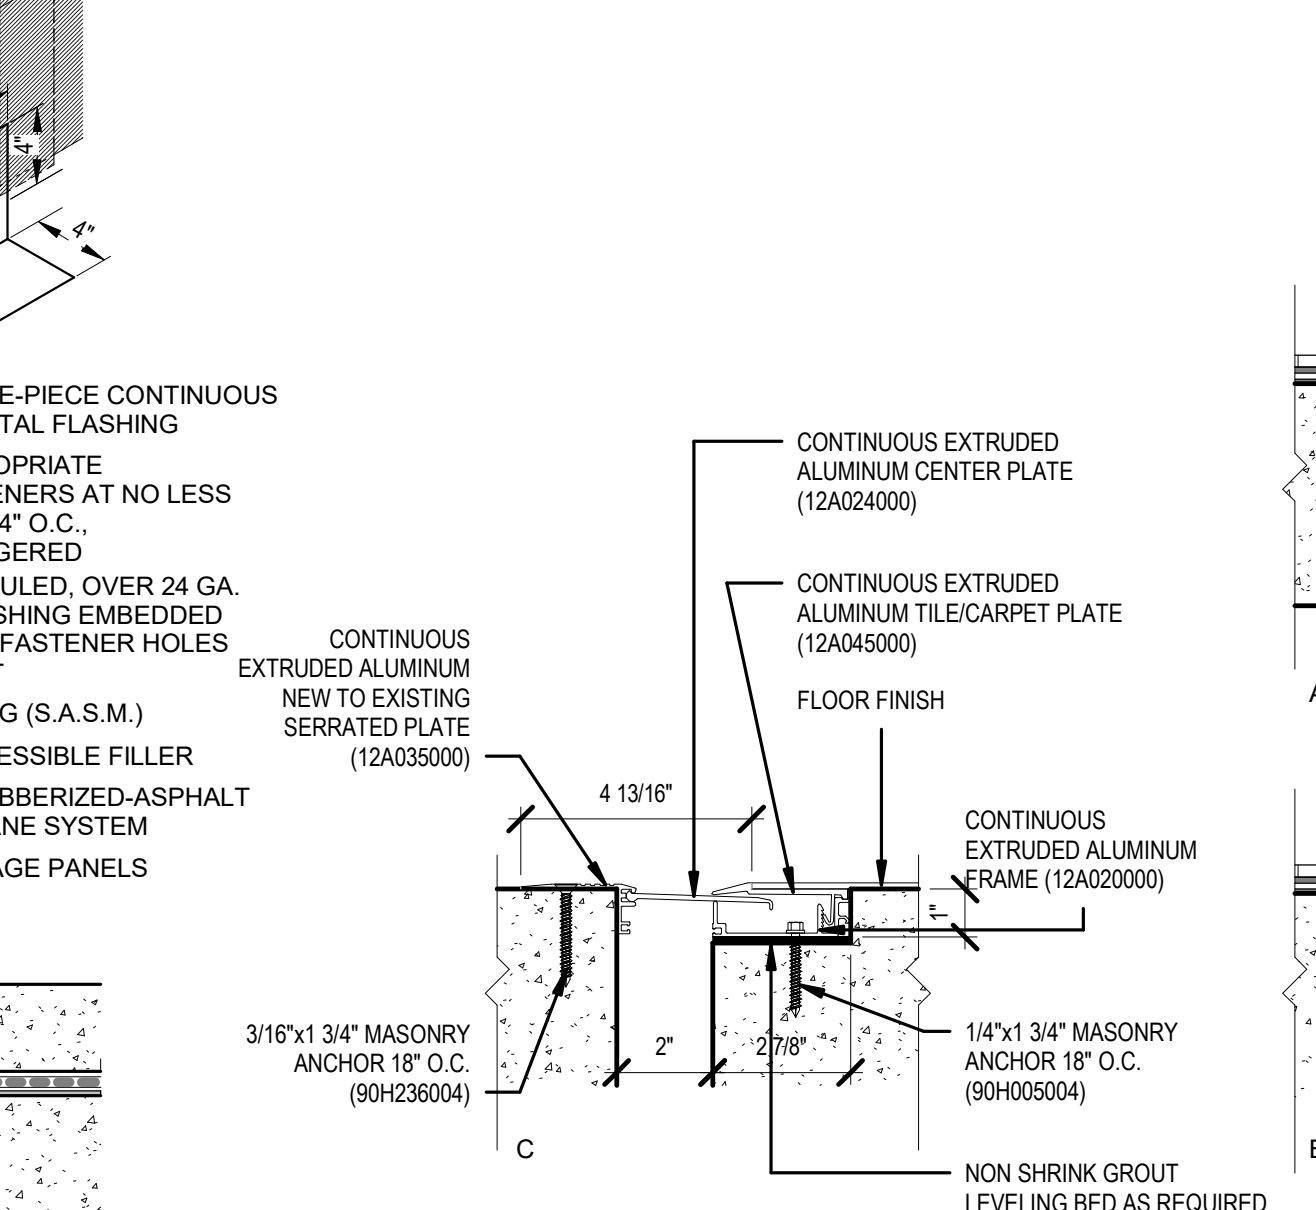


WATERPROOFING AT THRESHOLD 13

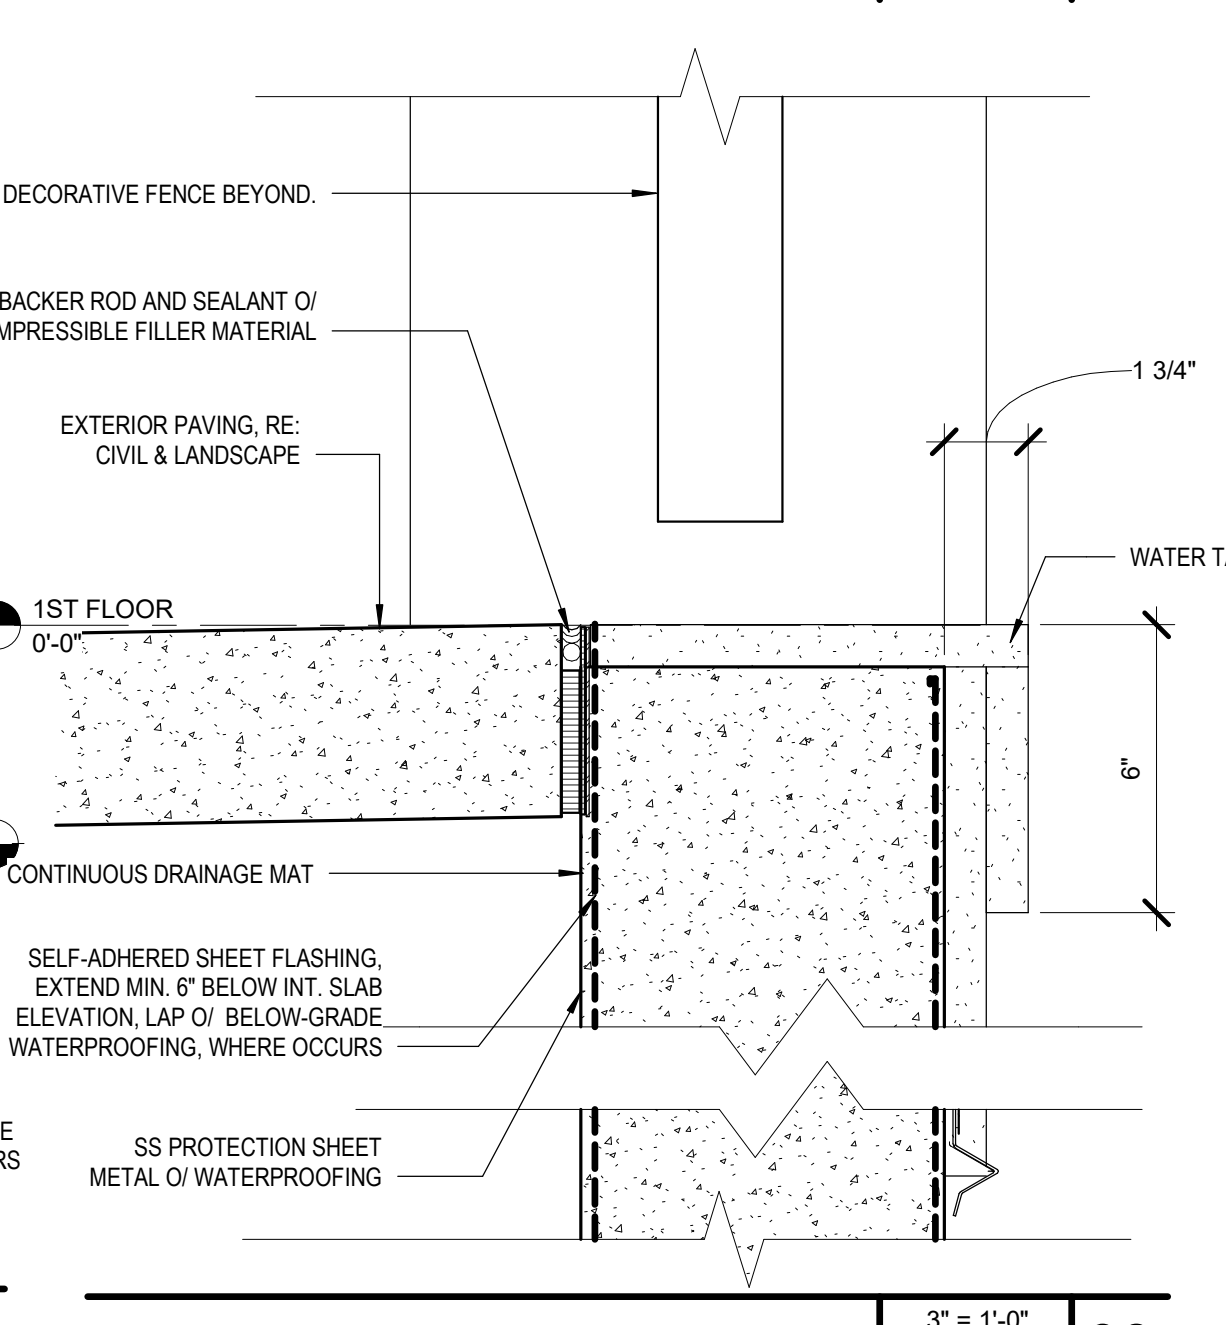

WATER TABLE DETAIL 06

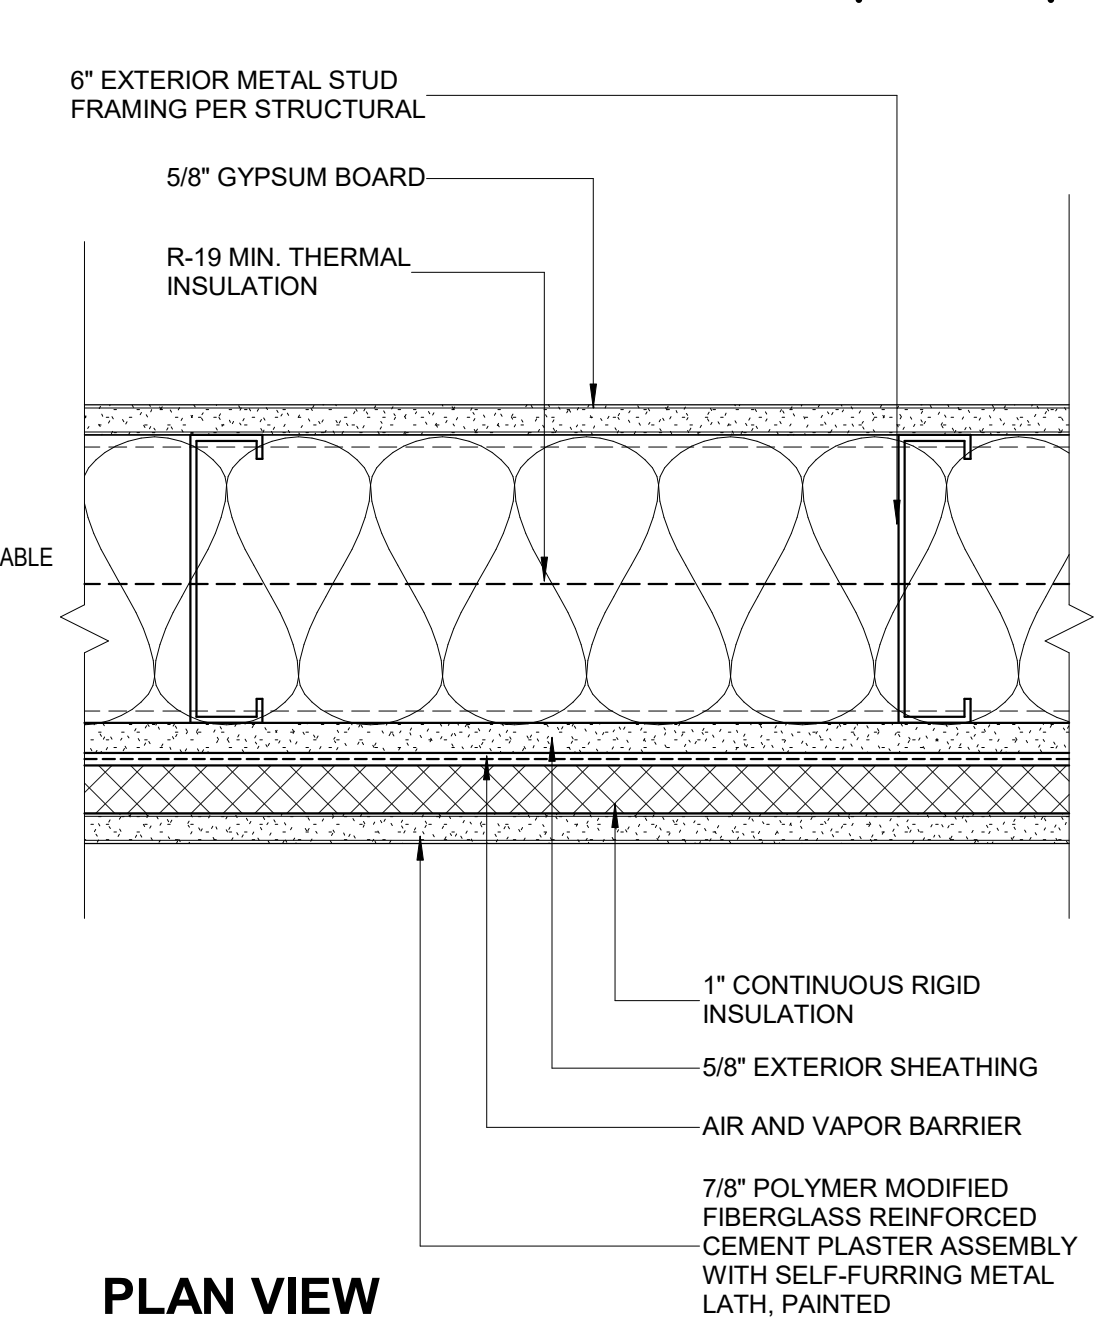


SECTION VIEW

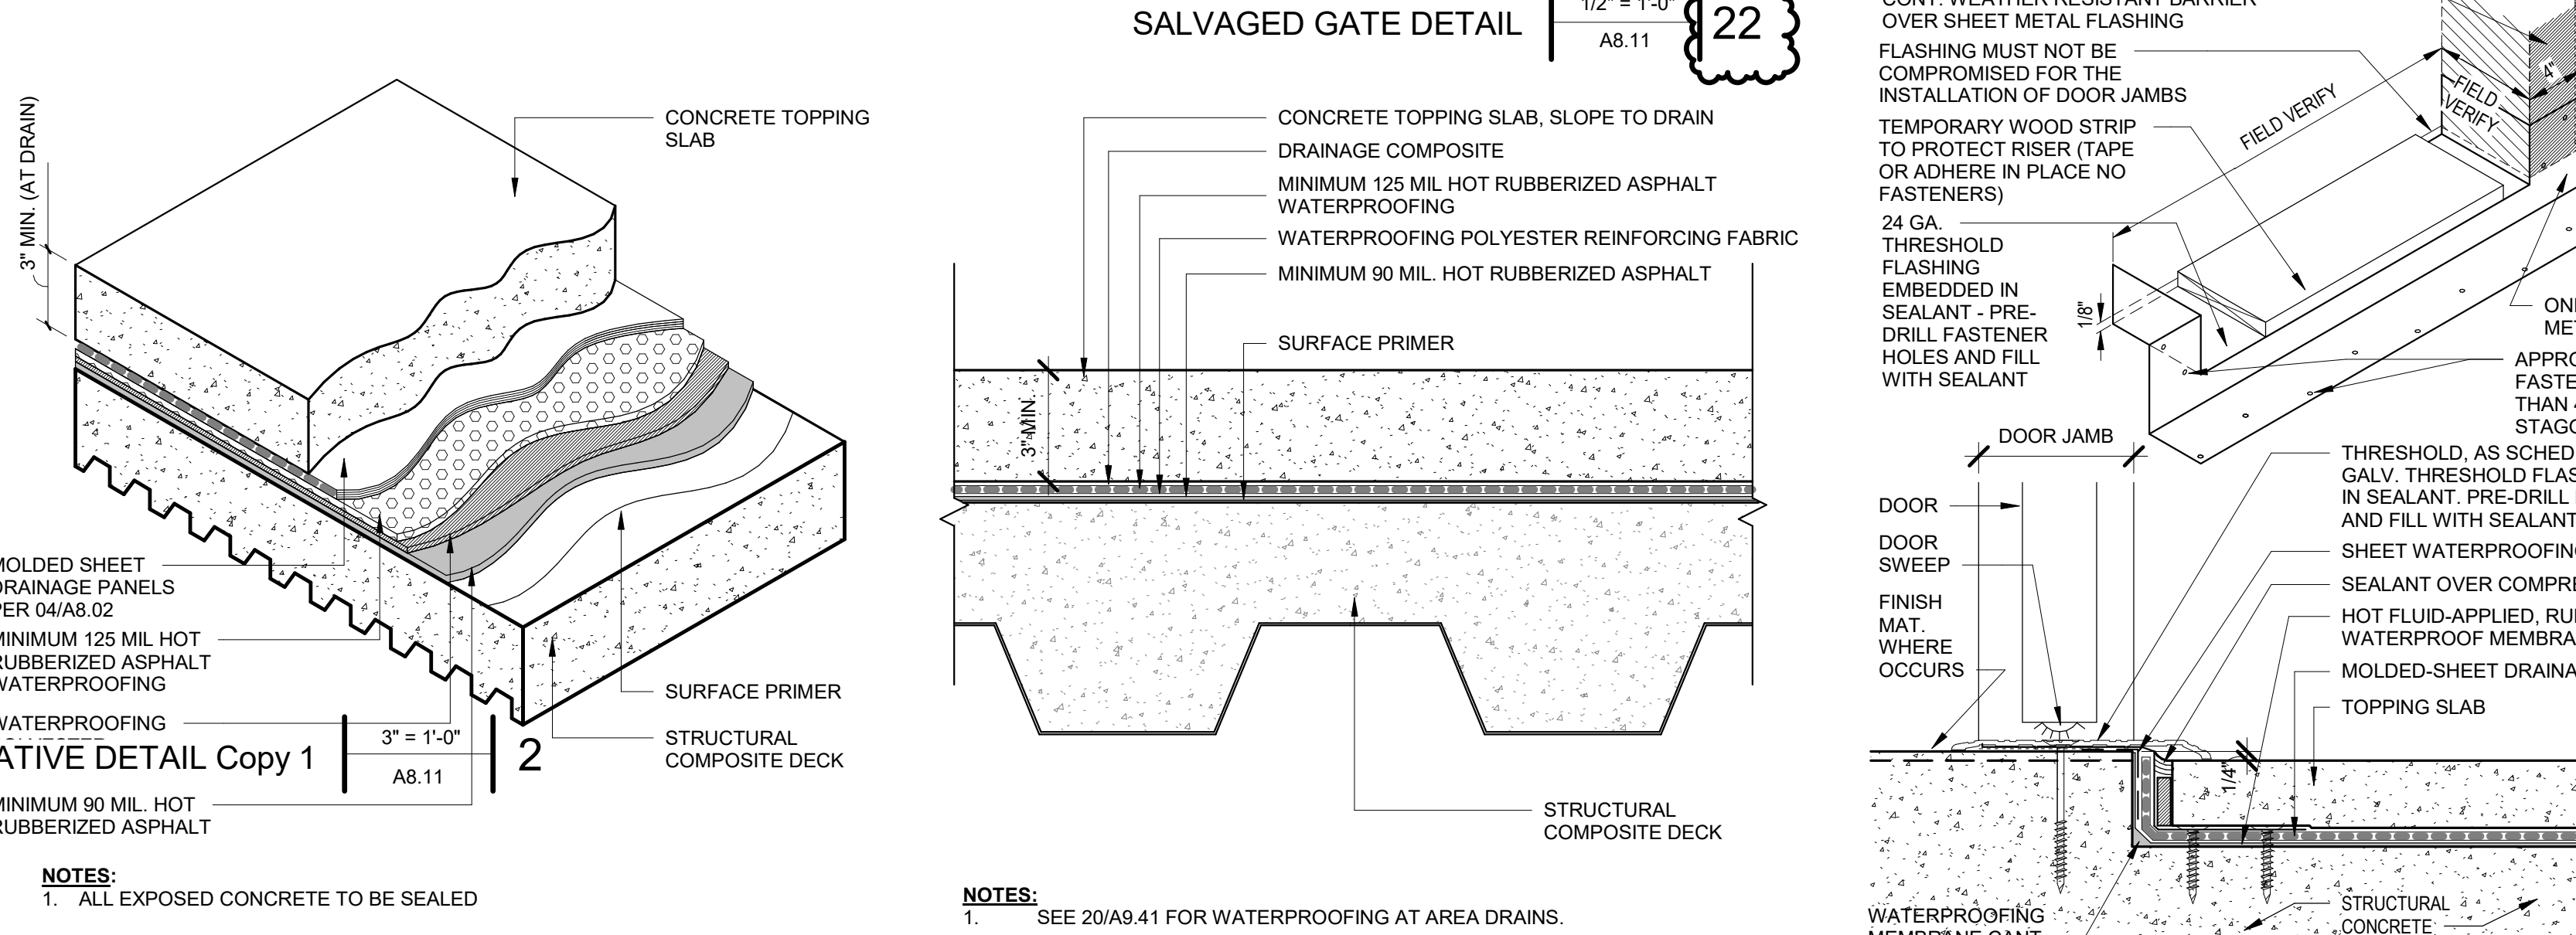


TOPPING SLAB AXON 21


TS1 - TOPPING SLAB 17

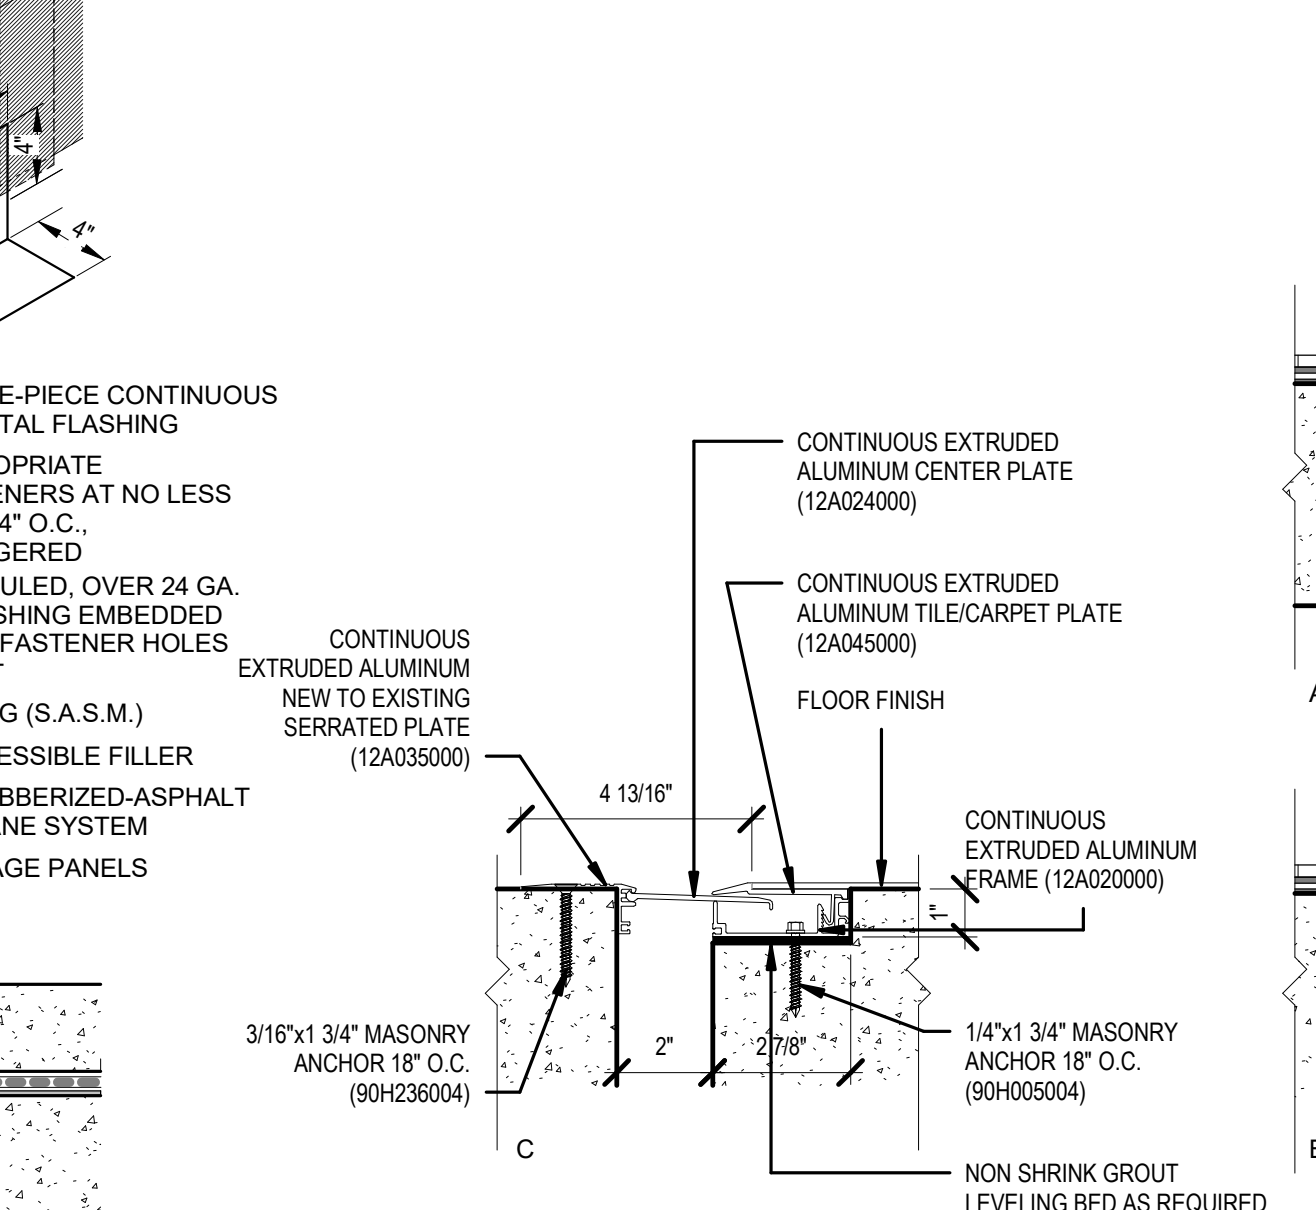


WATERPROOFING AT THRESHOLD 13

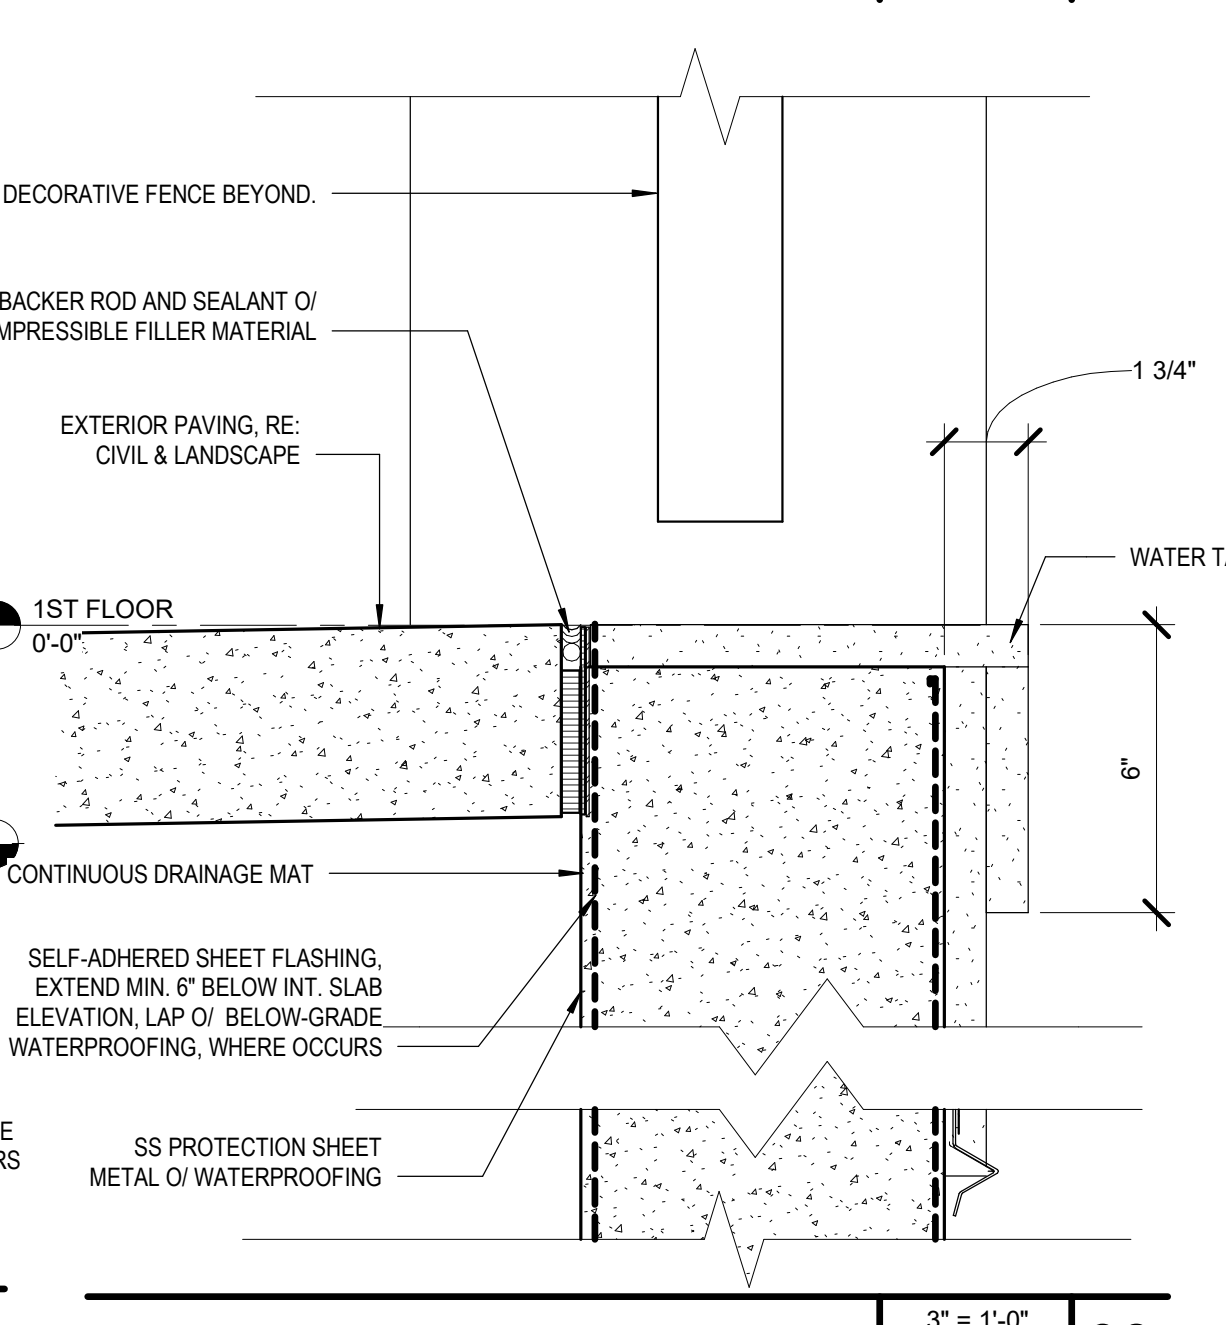

WATER TABLE DETAIL 06

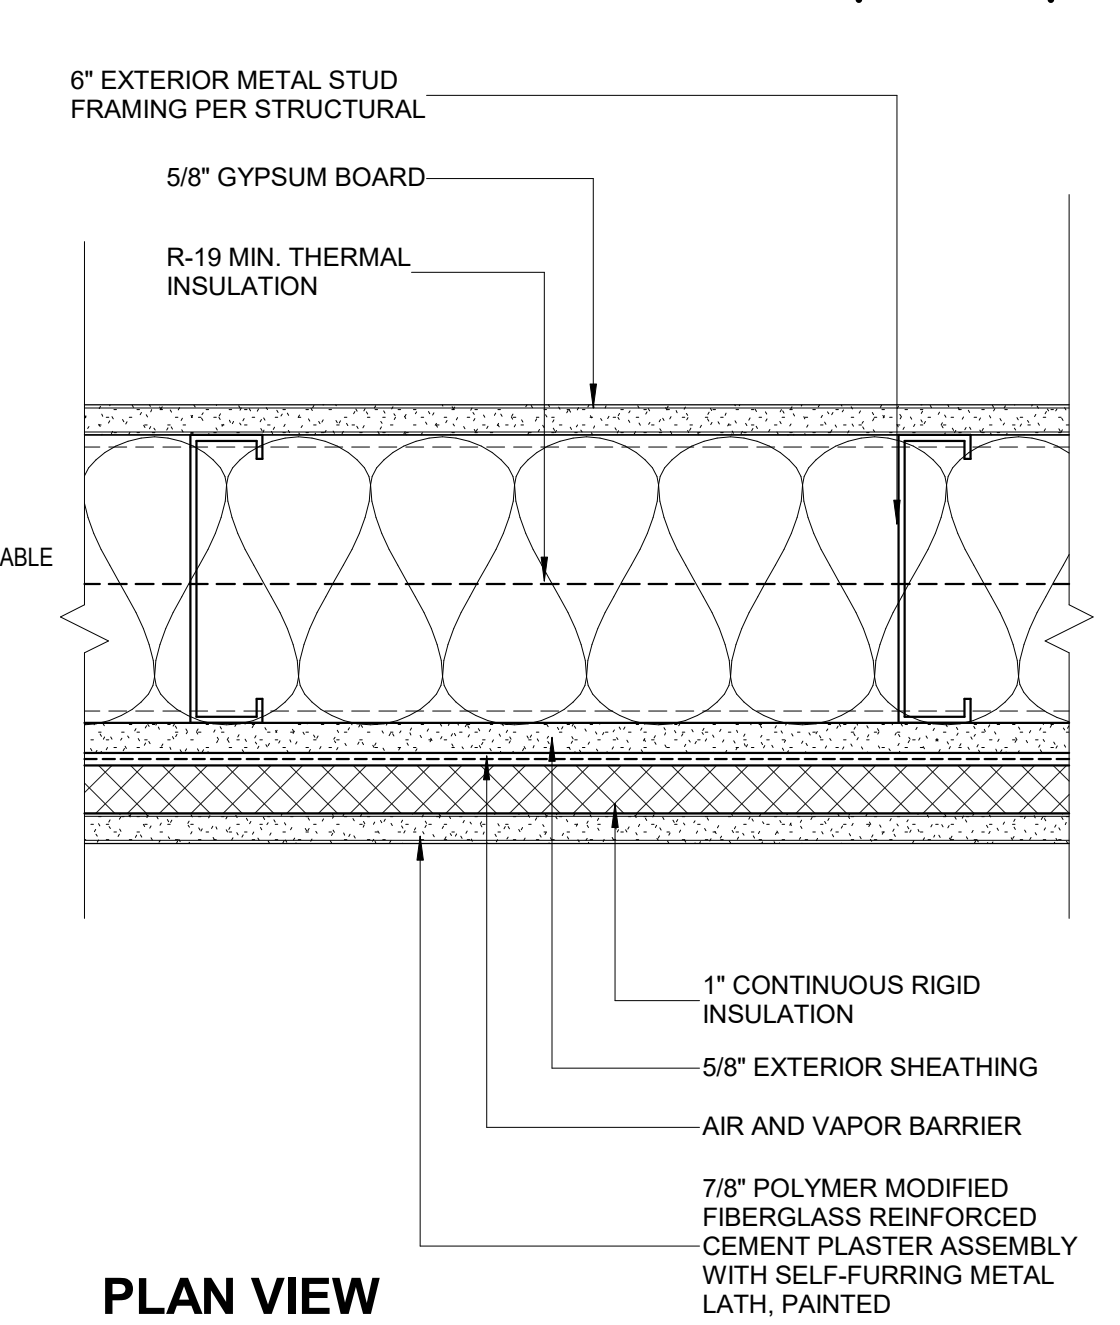


SECTION VIEW

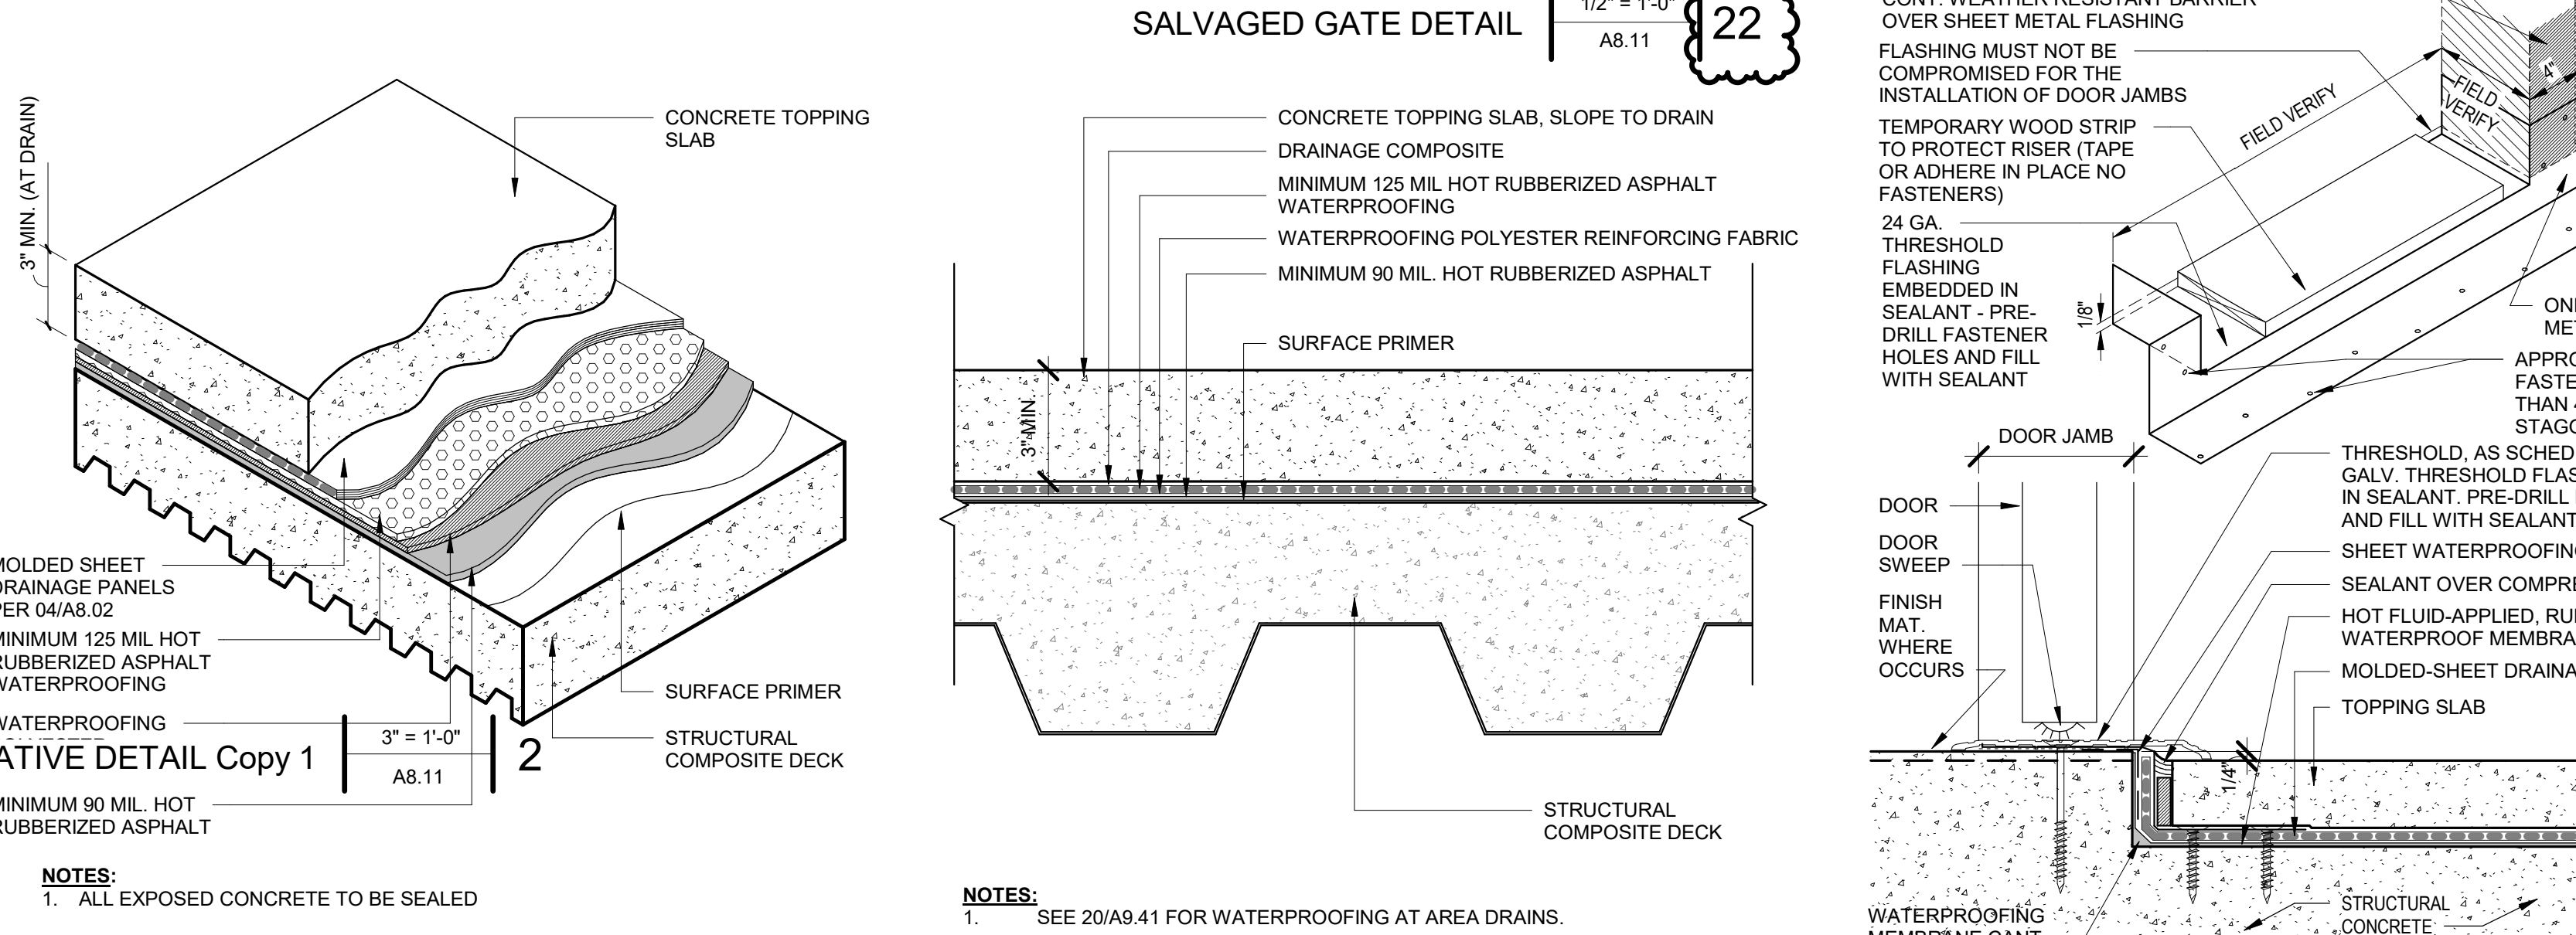


TOPPING SLAB AXON 21


TS1 - TOPPING SLAB 17

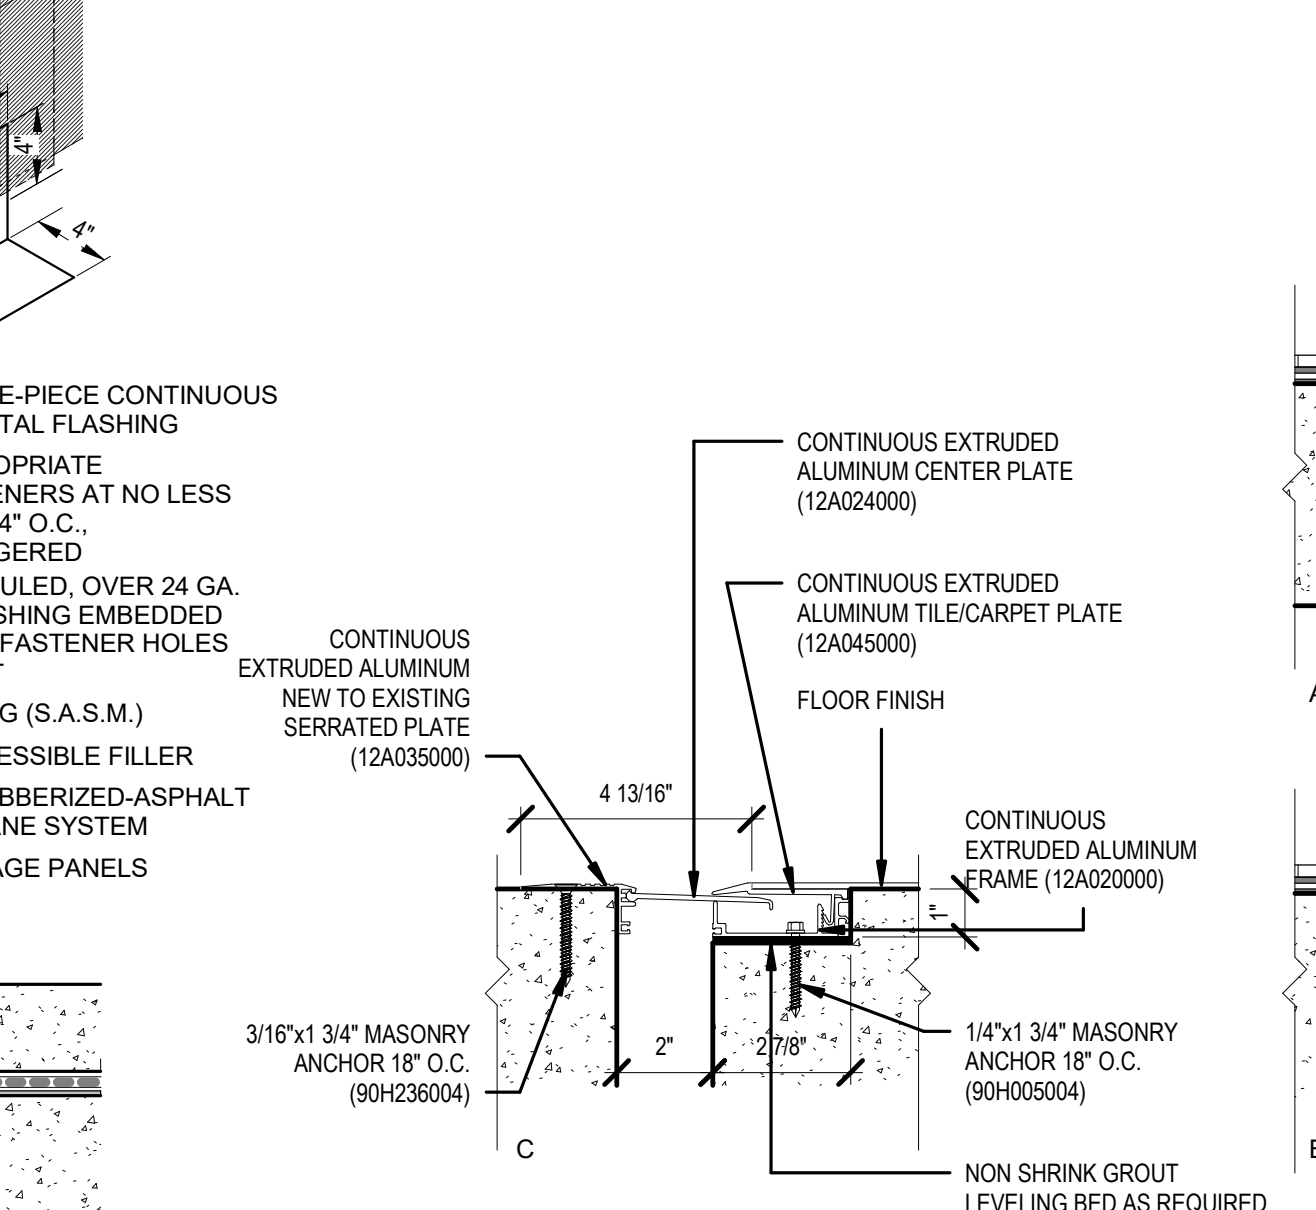


WATERPROOFING AT THRESHOLD 13

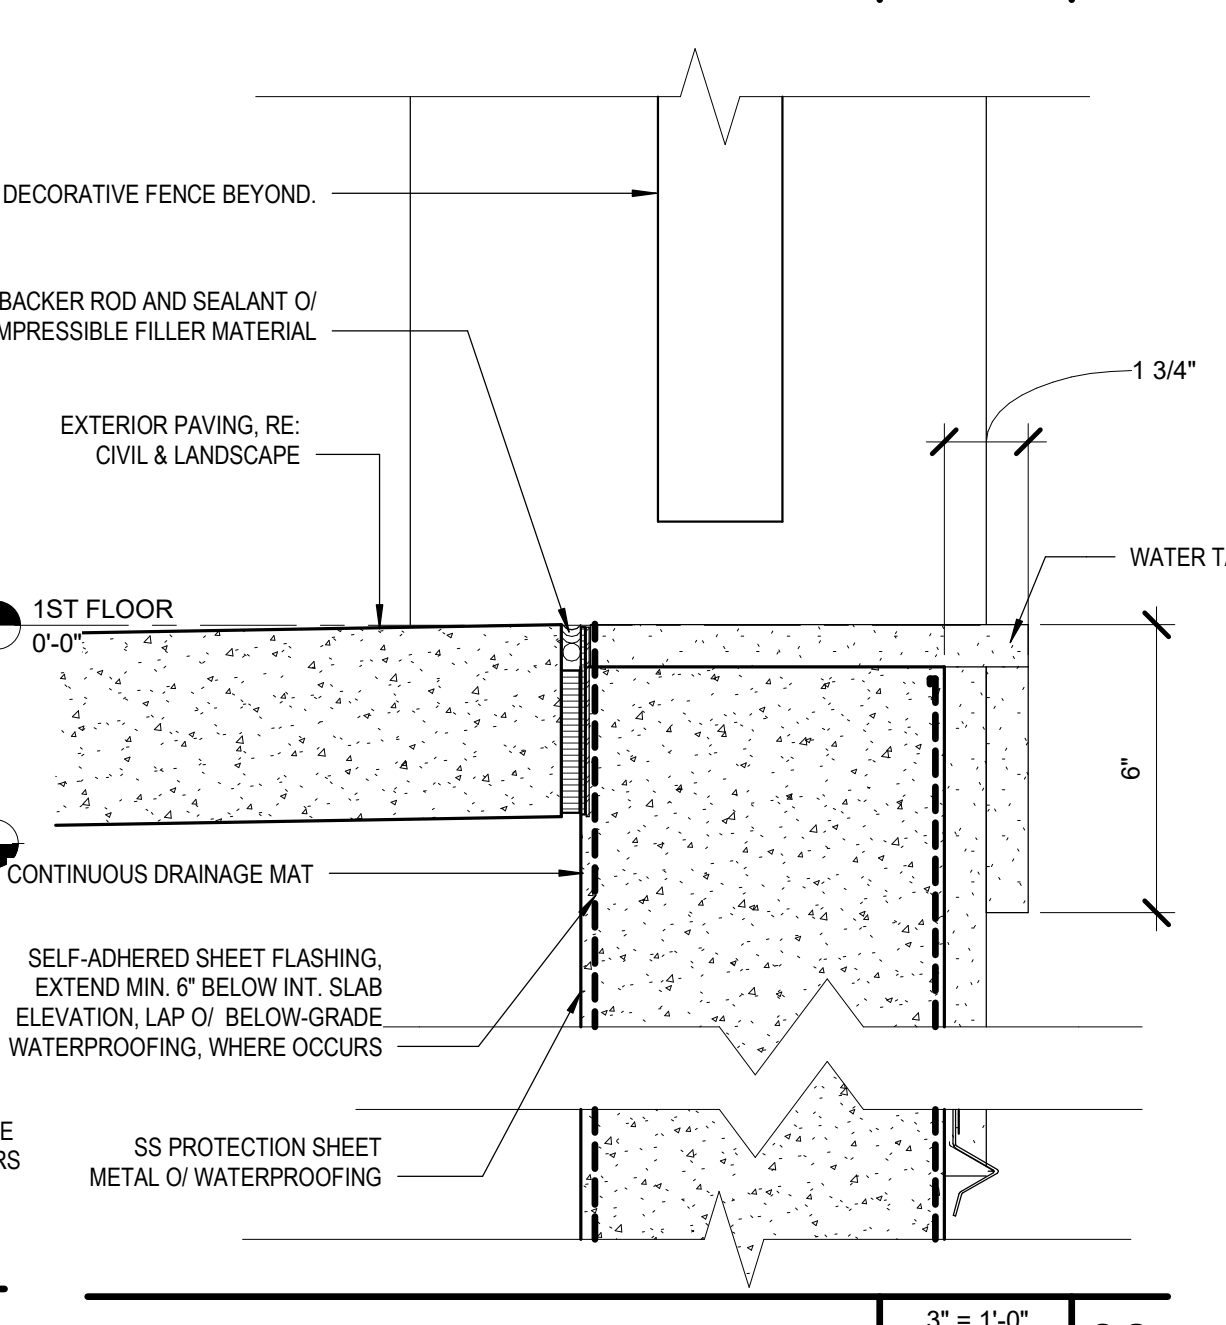

WATER TABLE DETAIL 06

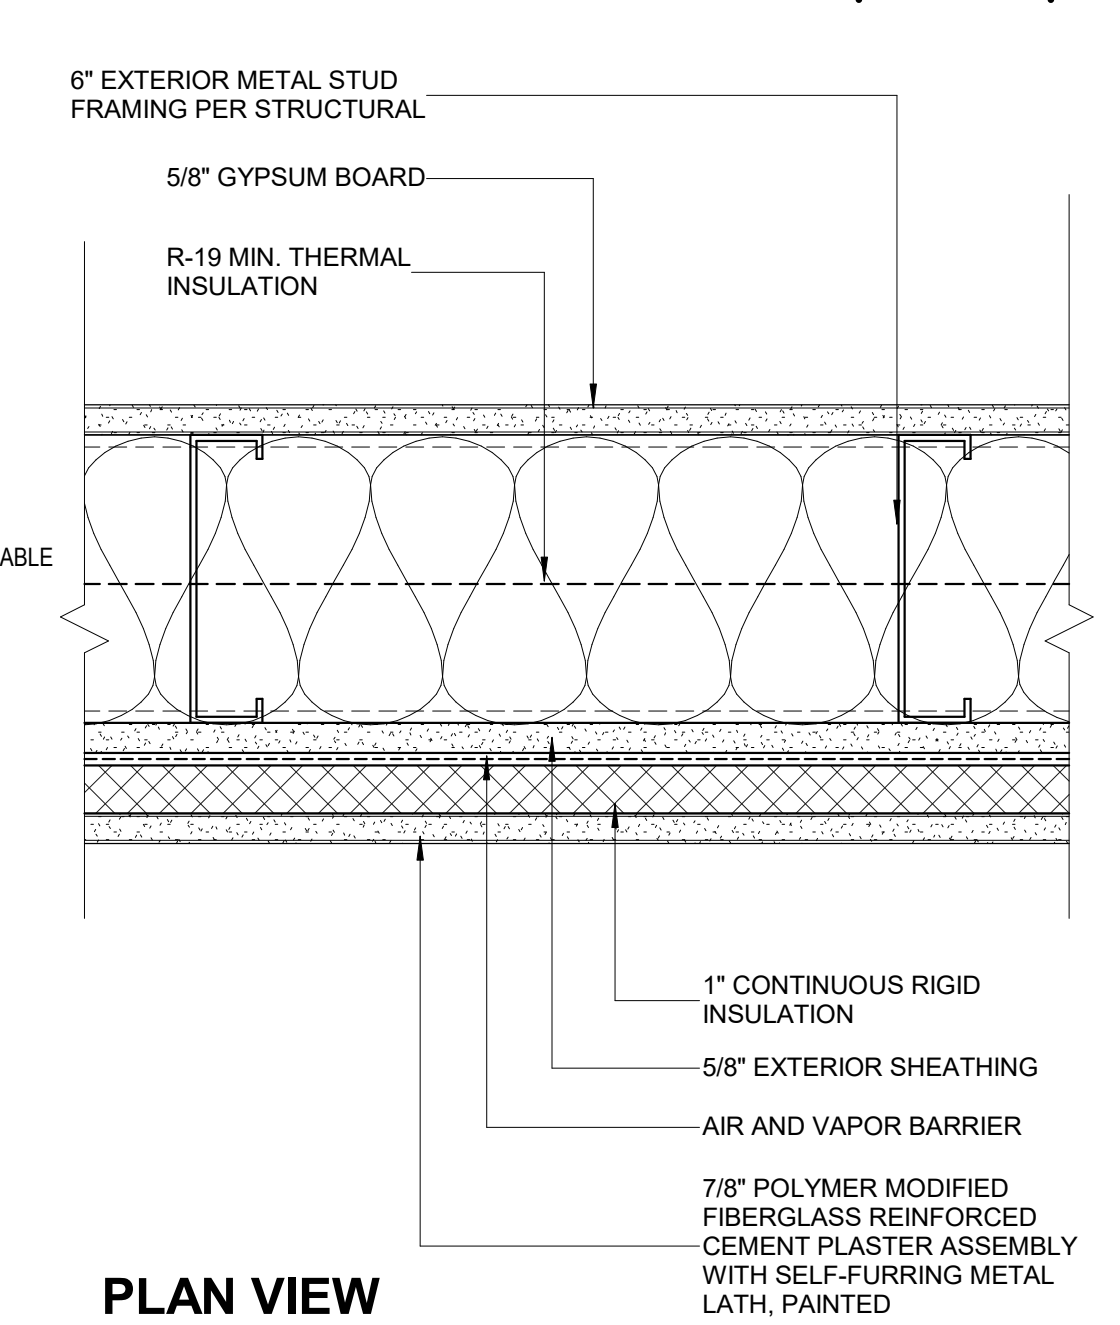


SECTION VIEW

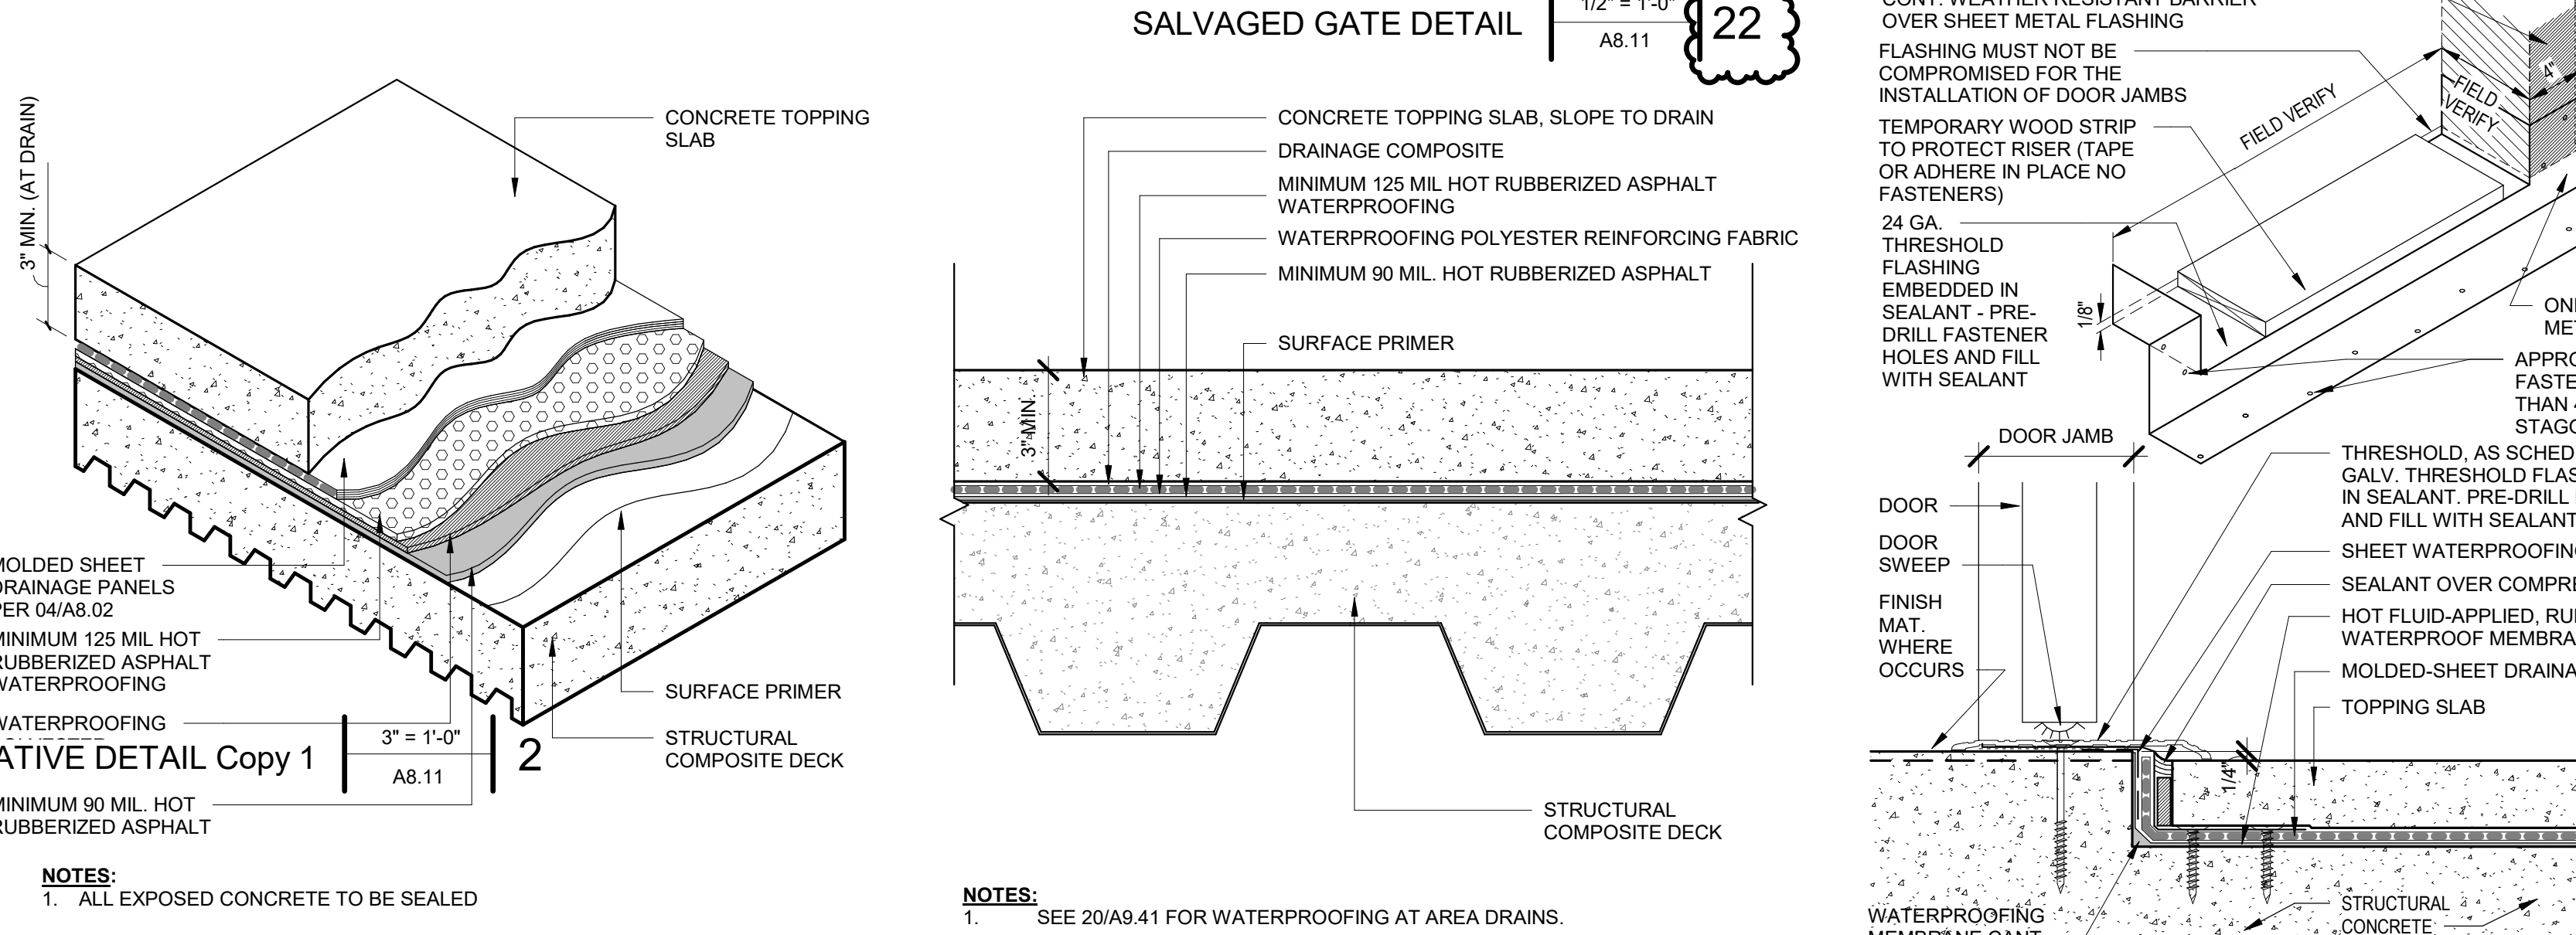


TOPPING SLAB AXON 21


TS1 - TOPPING SLAB 17

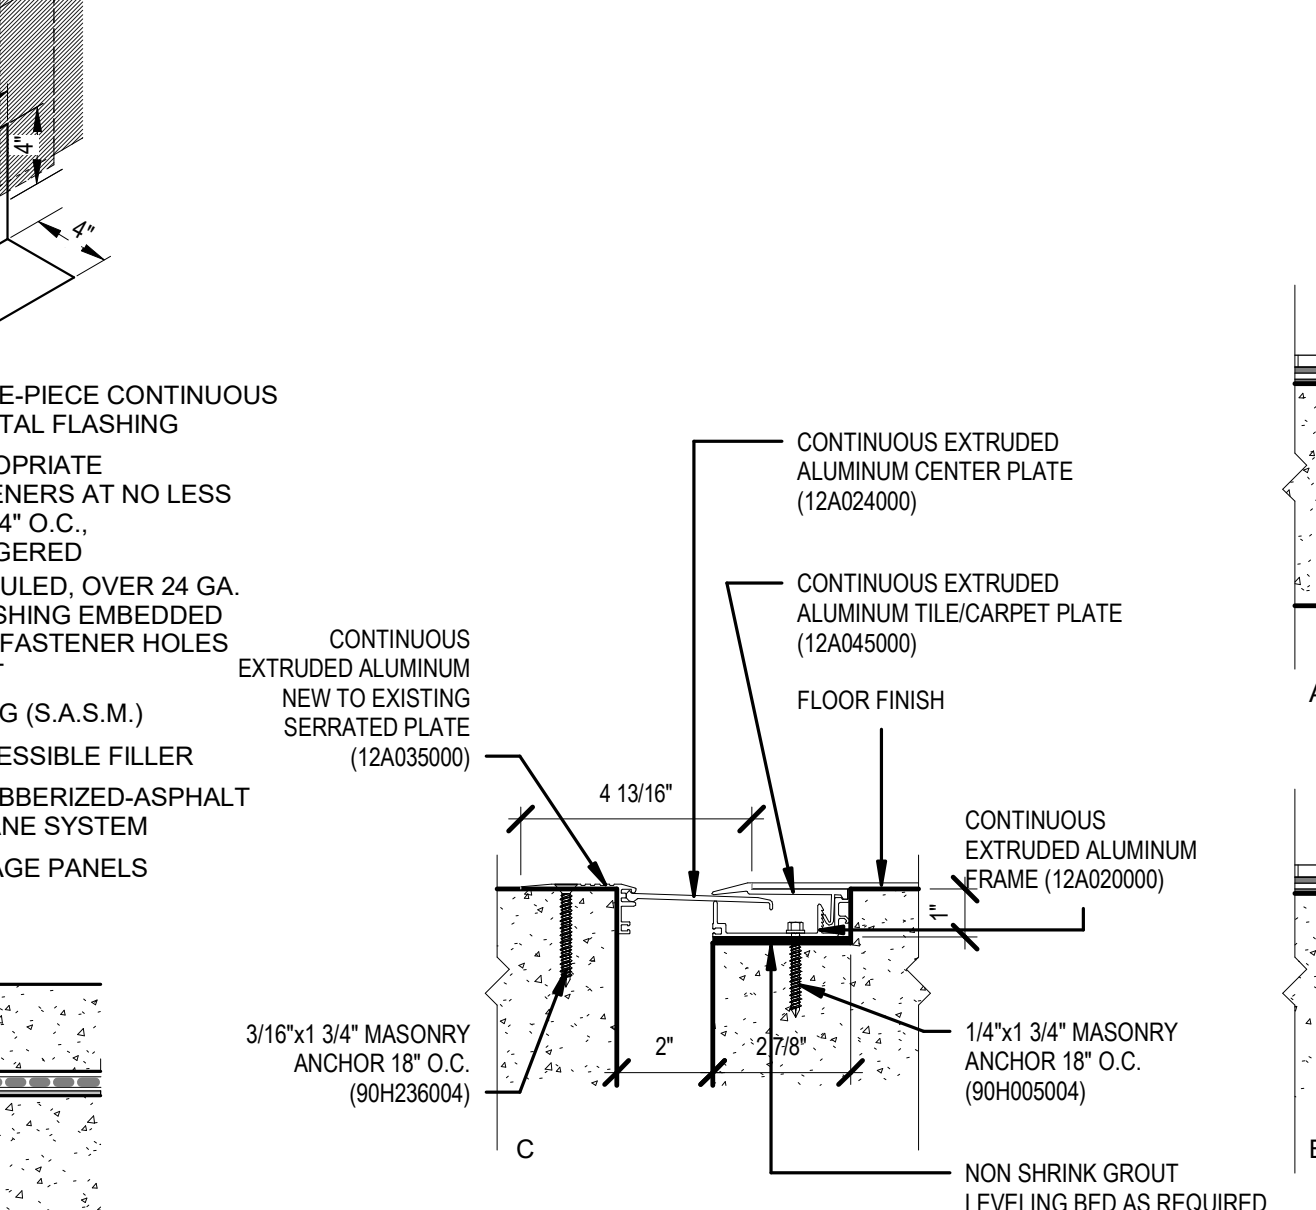


WATERPROOFING AT THRESHOLD 13

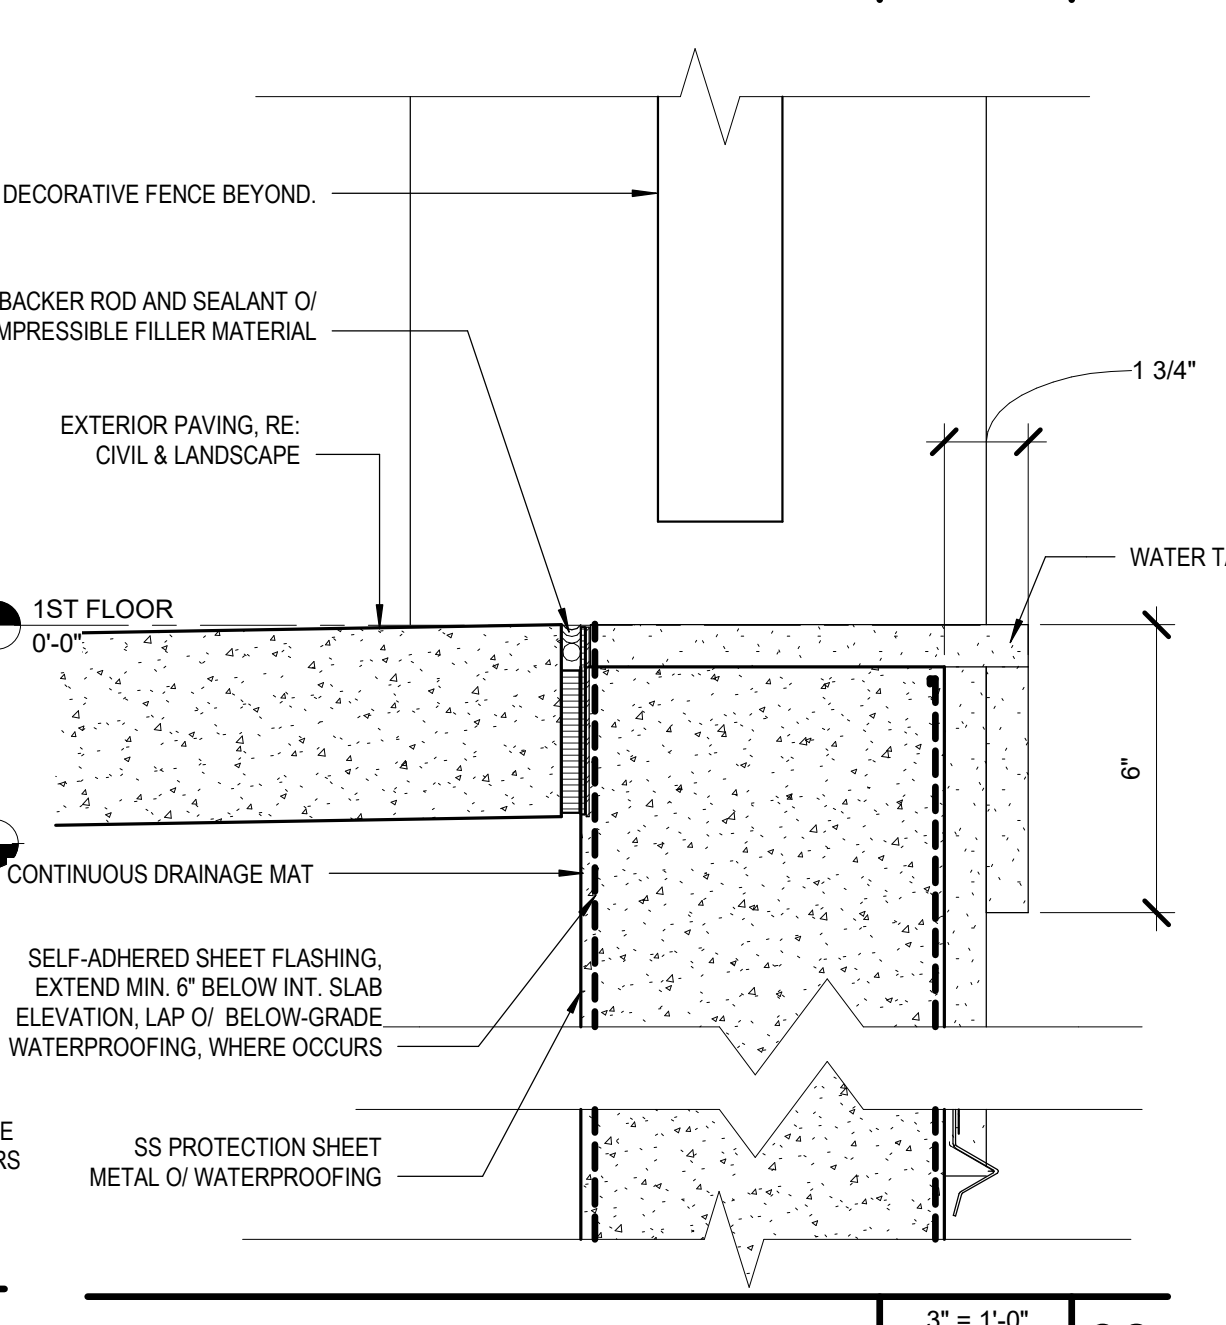

WATER TABLE DETAIL 06

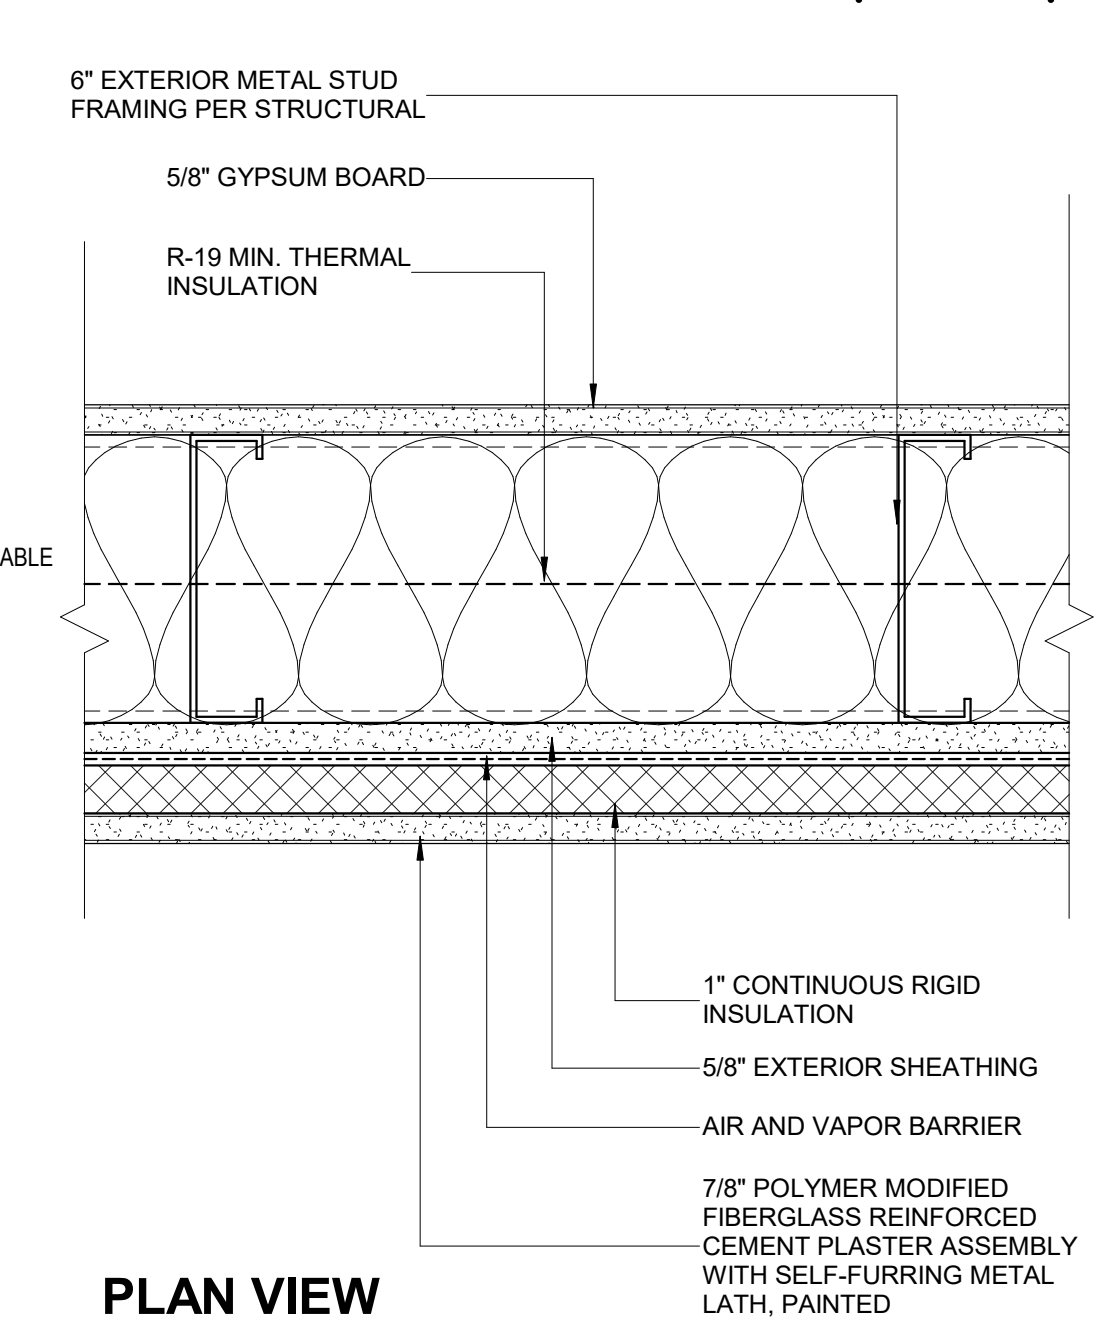


SECTION VIEW

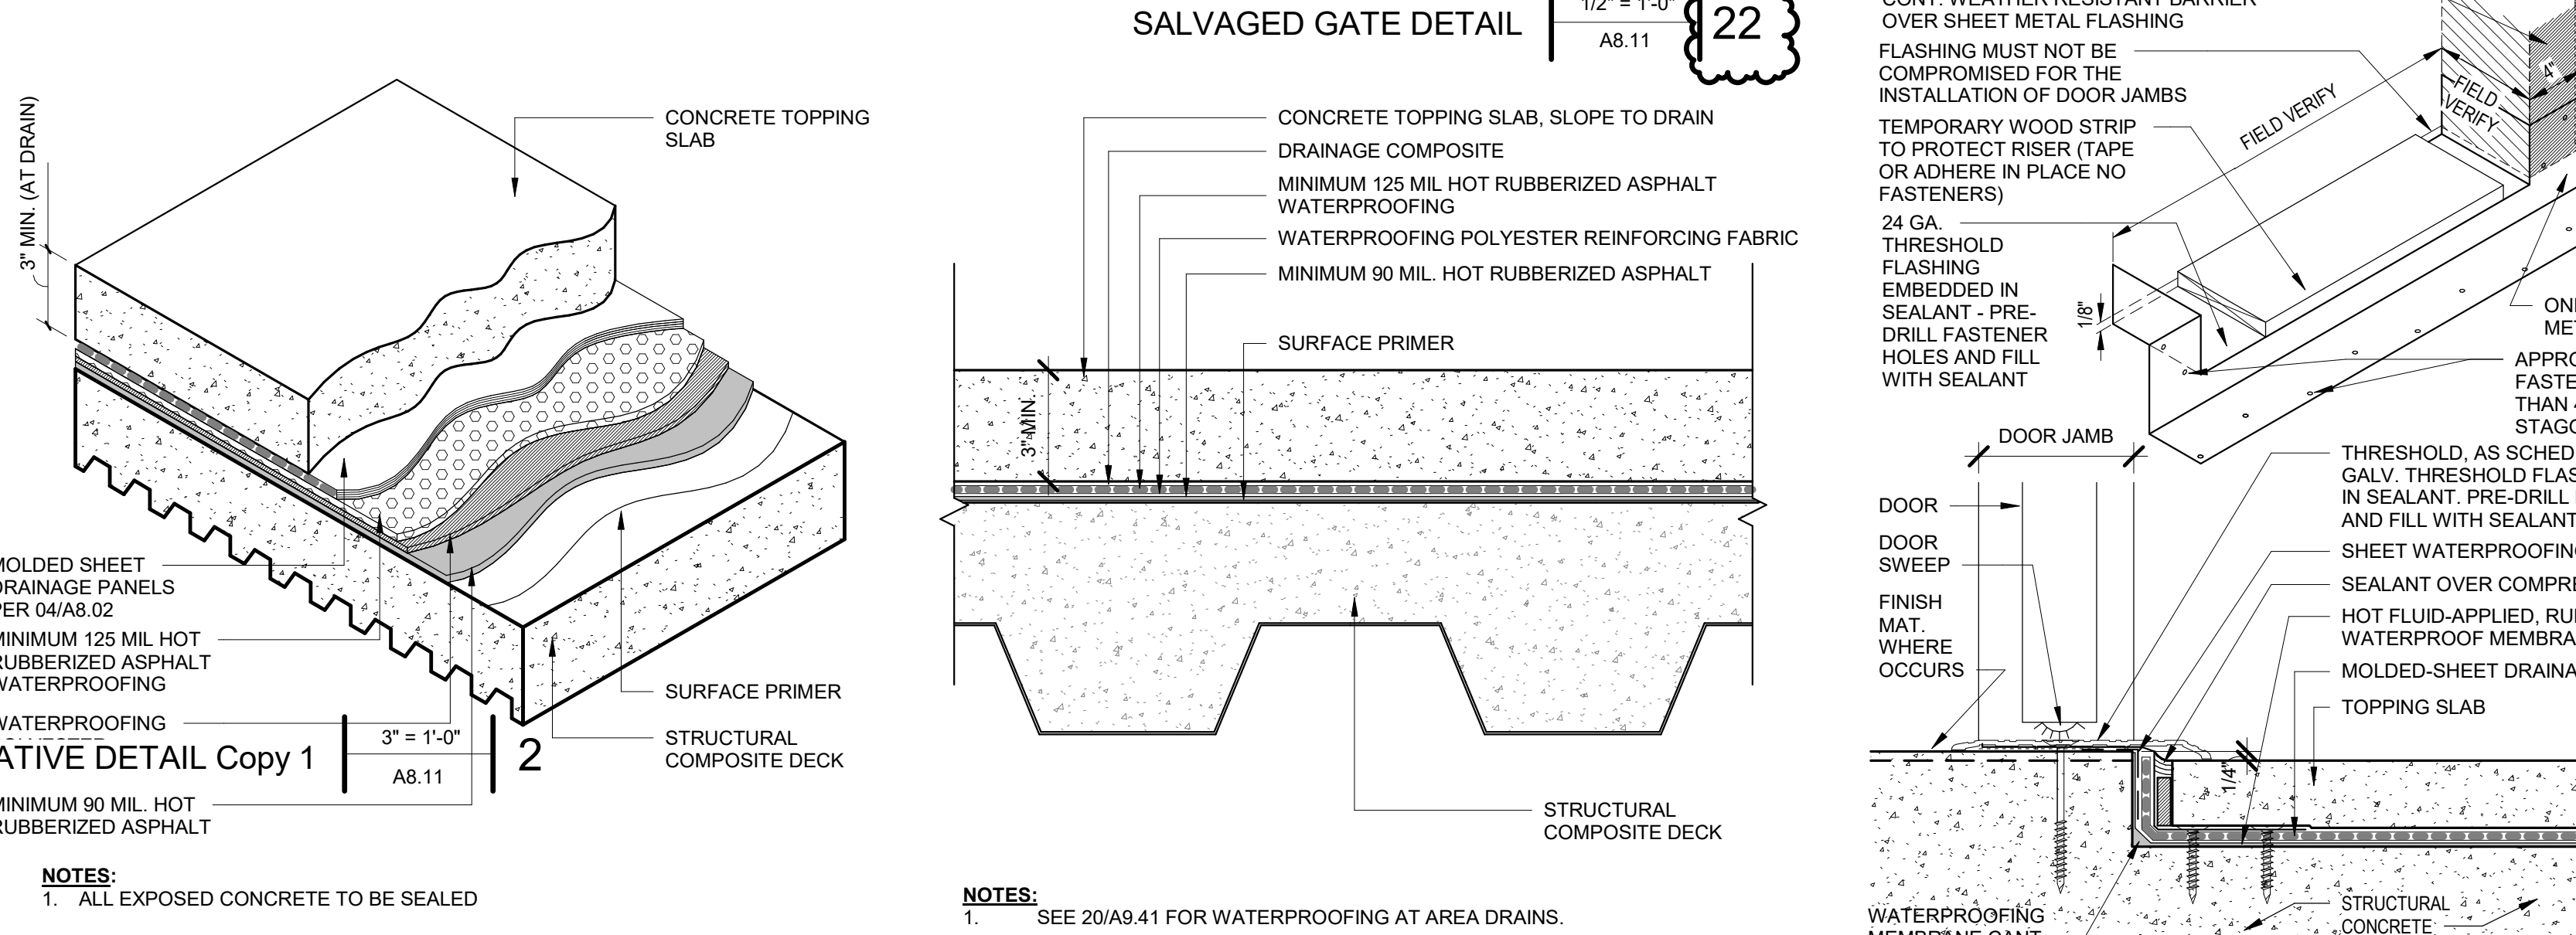


TOPPING SLAB AXON 21


TS1 - TOPPING SLAB 17

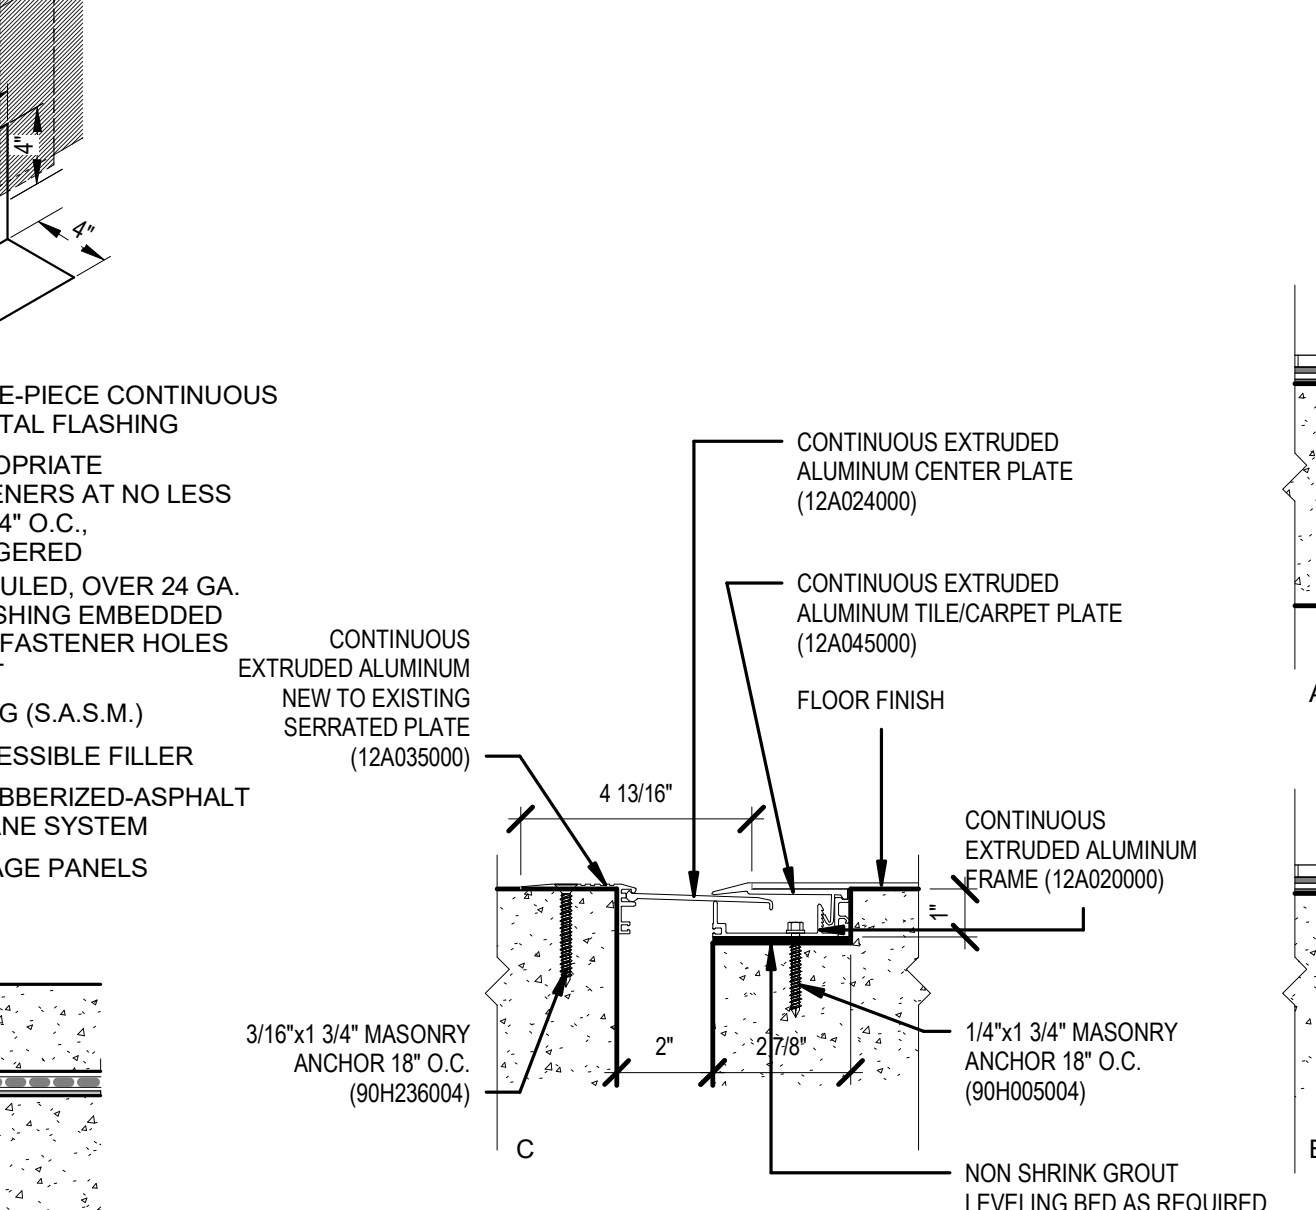


WATERPROOFING AT THRESHOLD 13

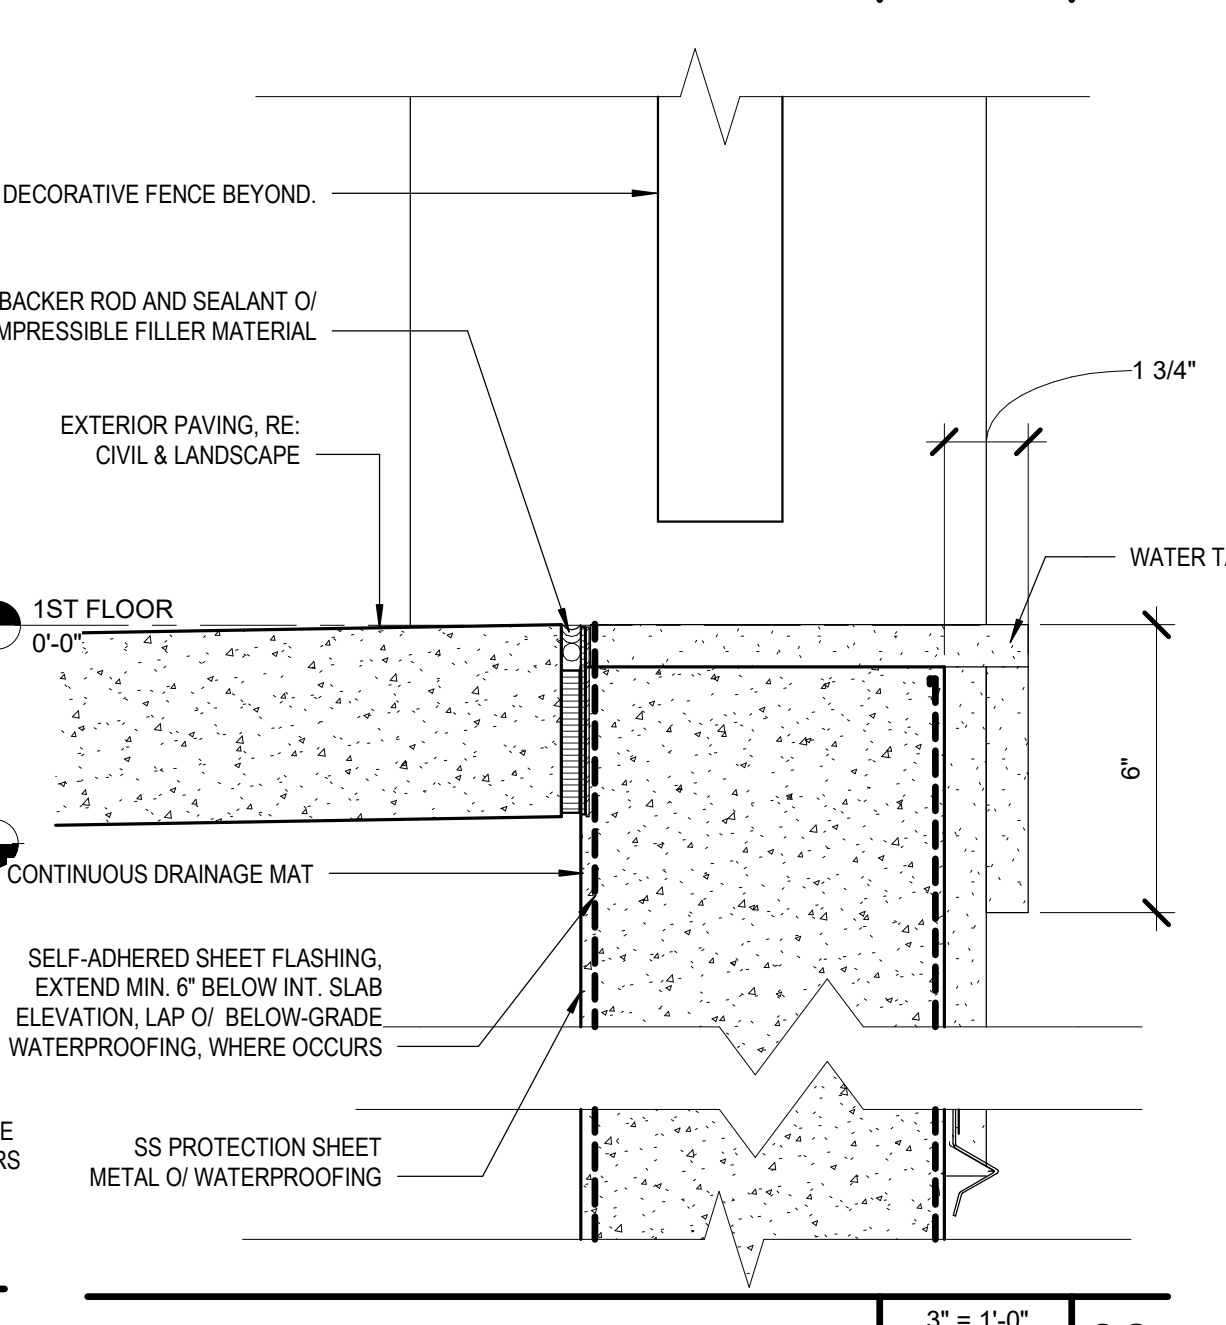

WATER TABLE DETAIL 06

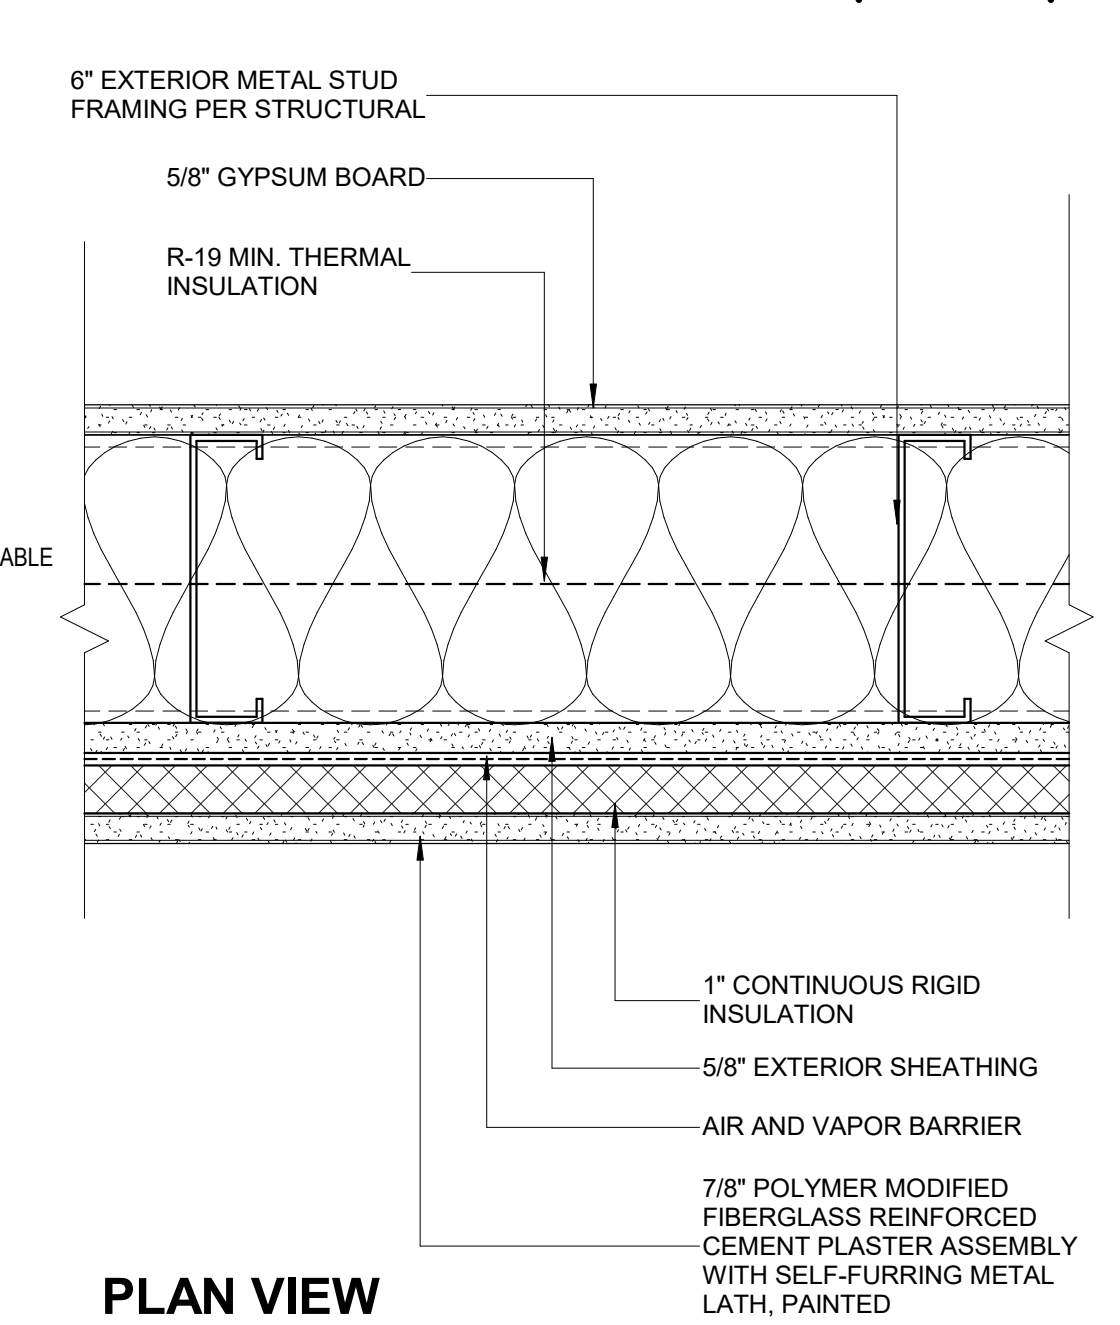


SECTION VIEW

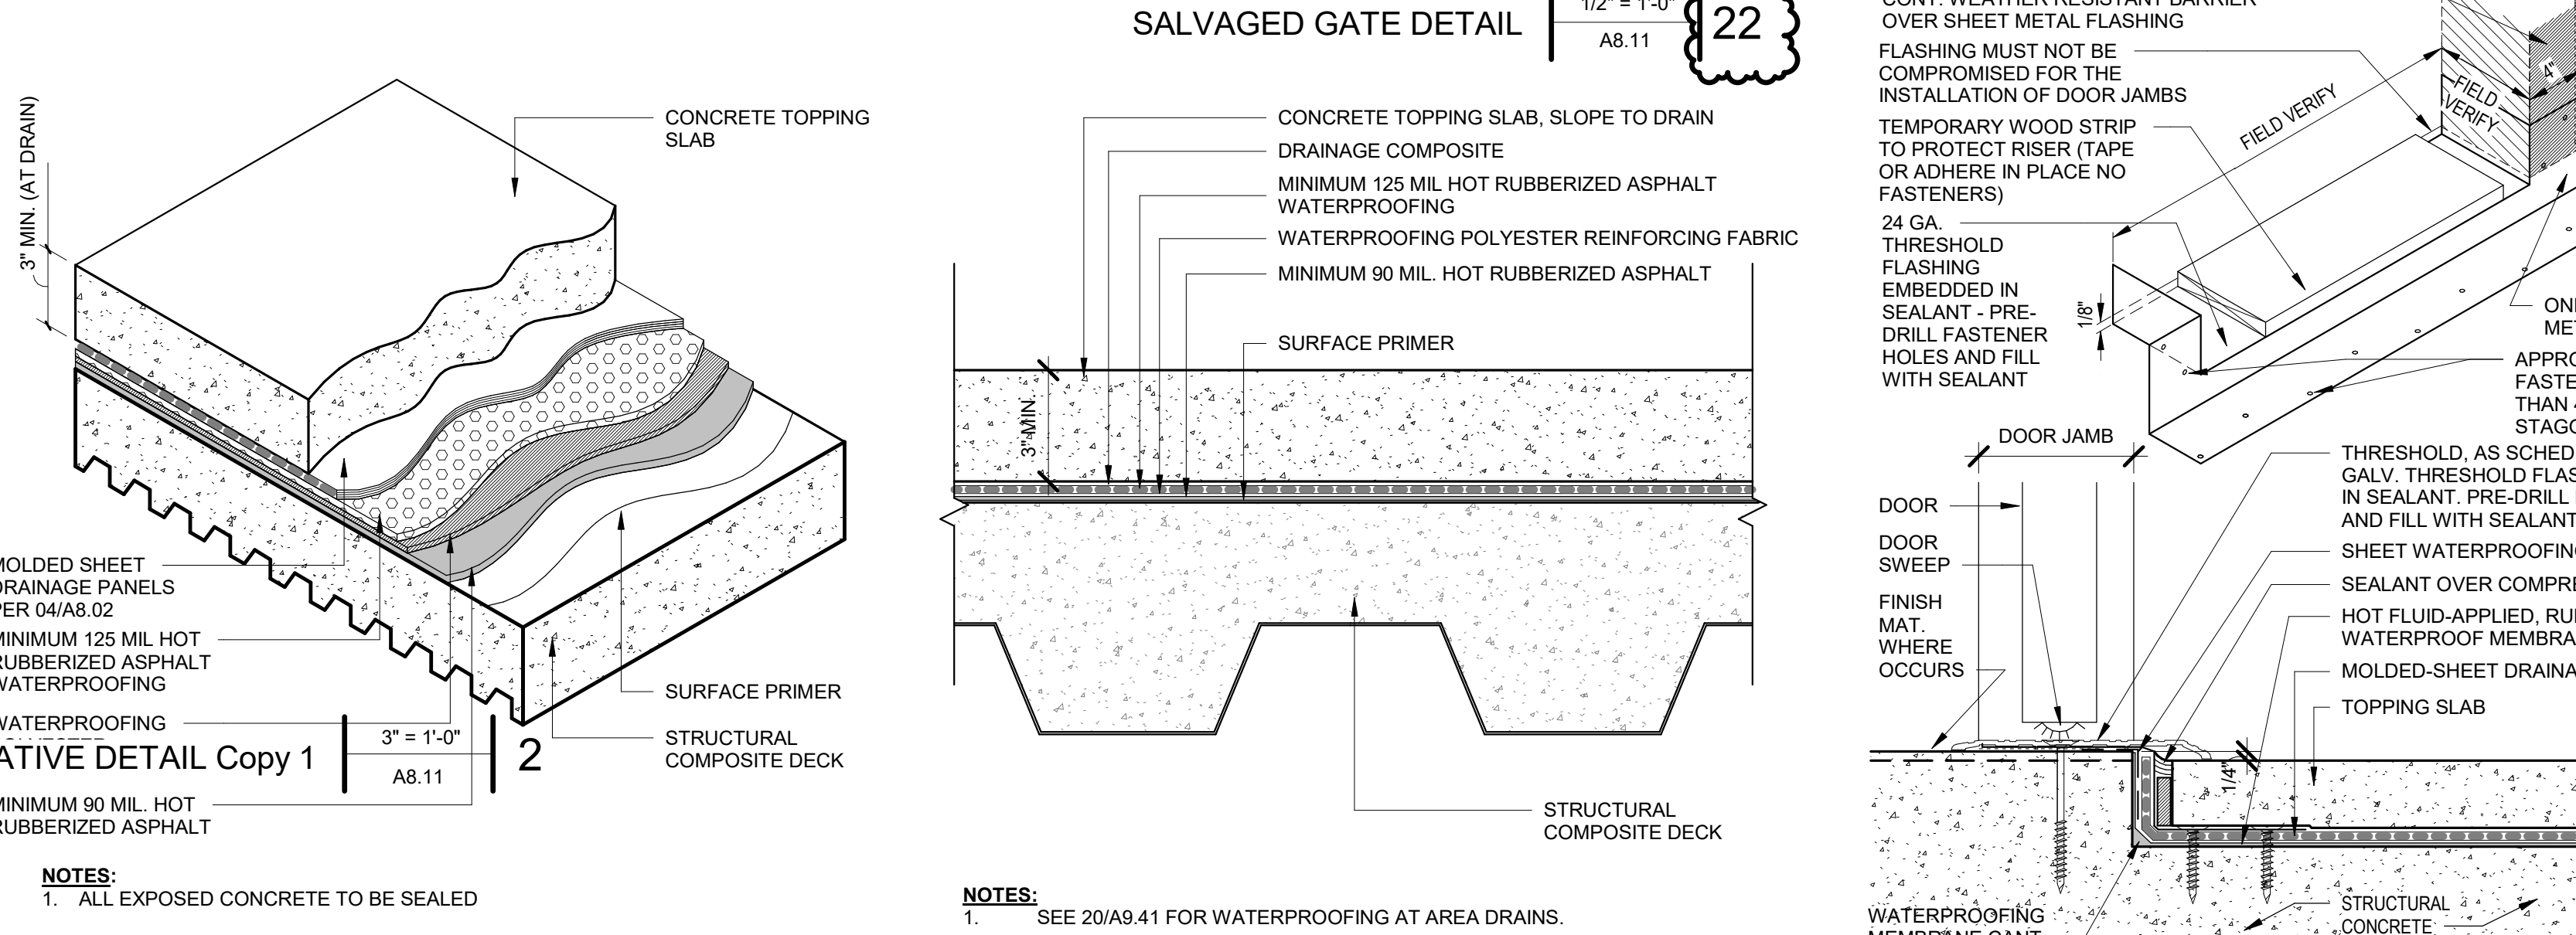


TOPPING SLAB AXON 21


TS1 - TOPPING SLAB 17

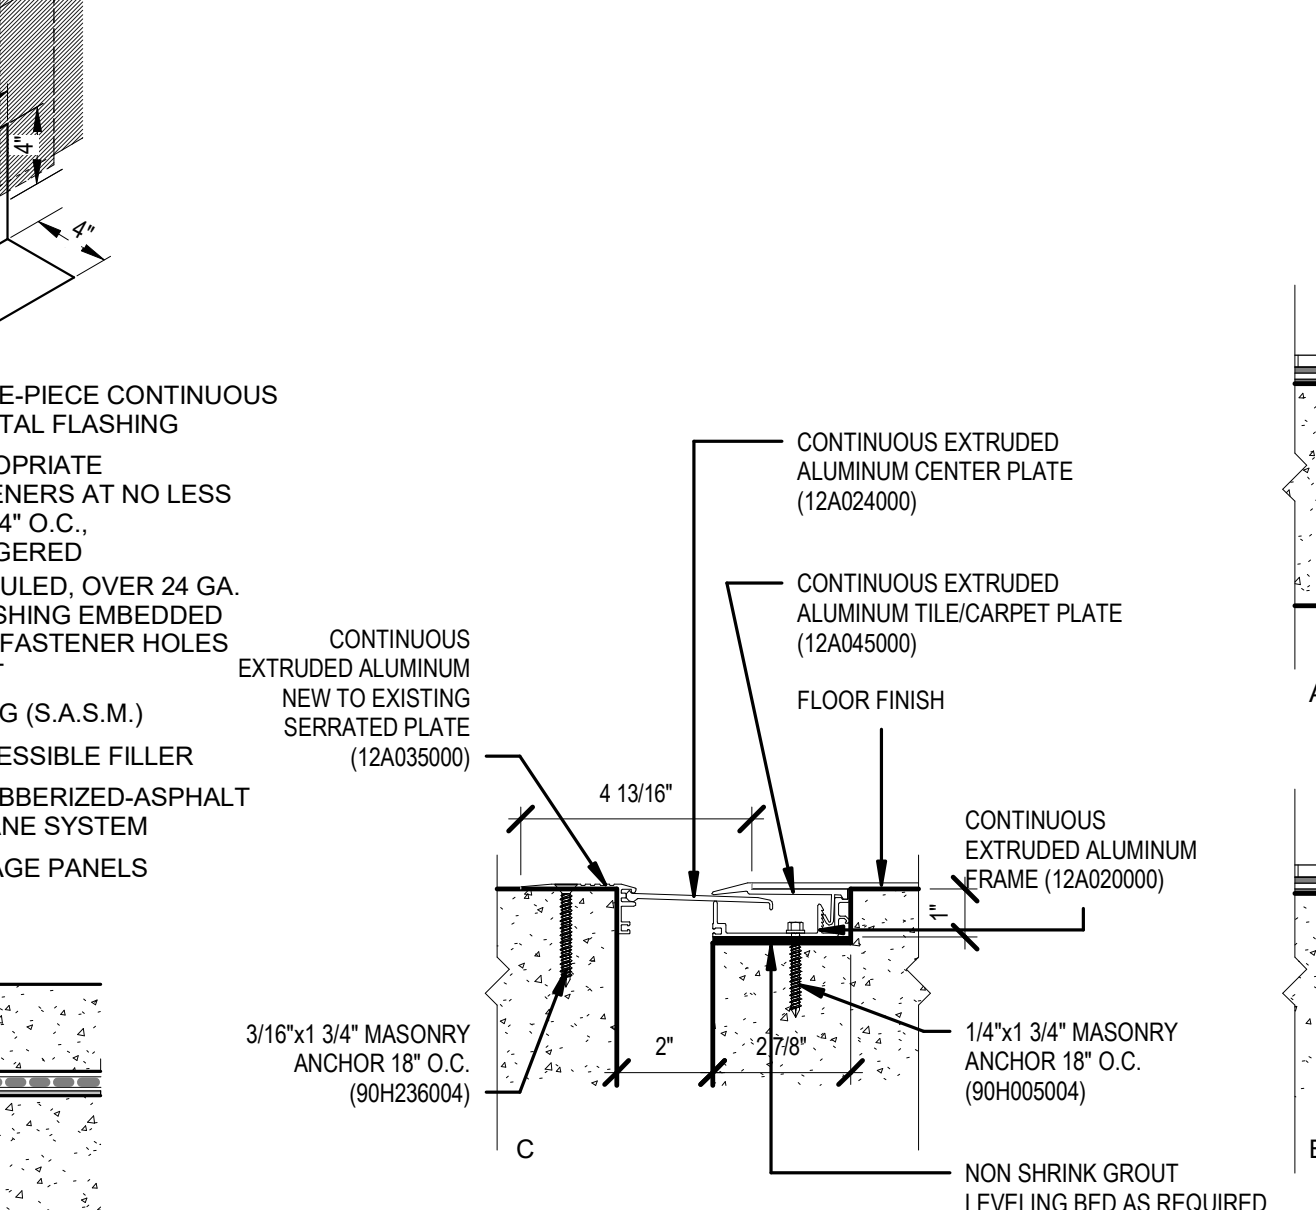


WATERPROOFING AT THRESHOLD 13

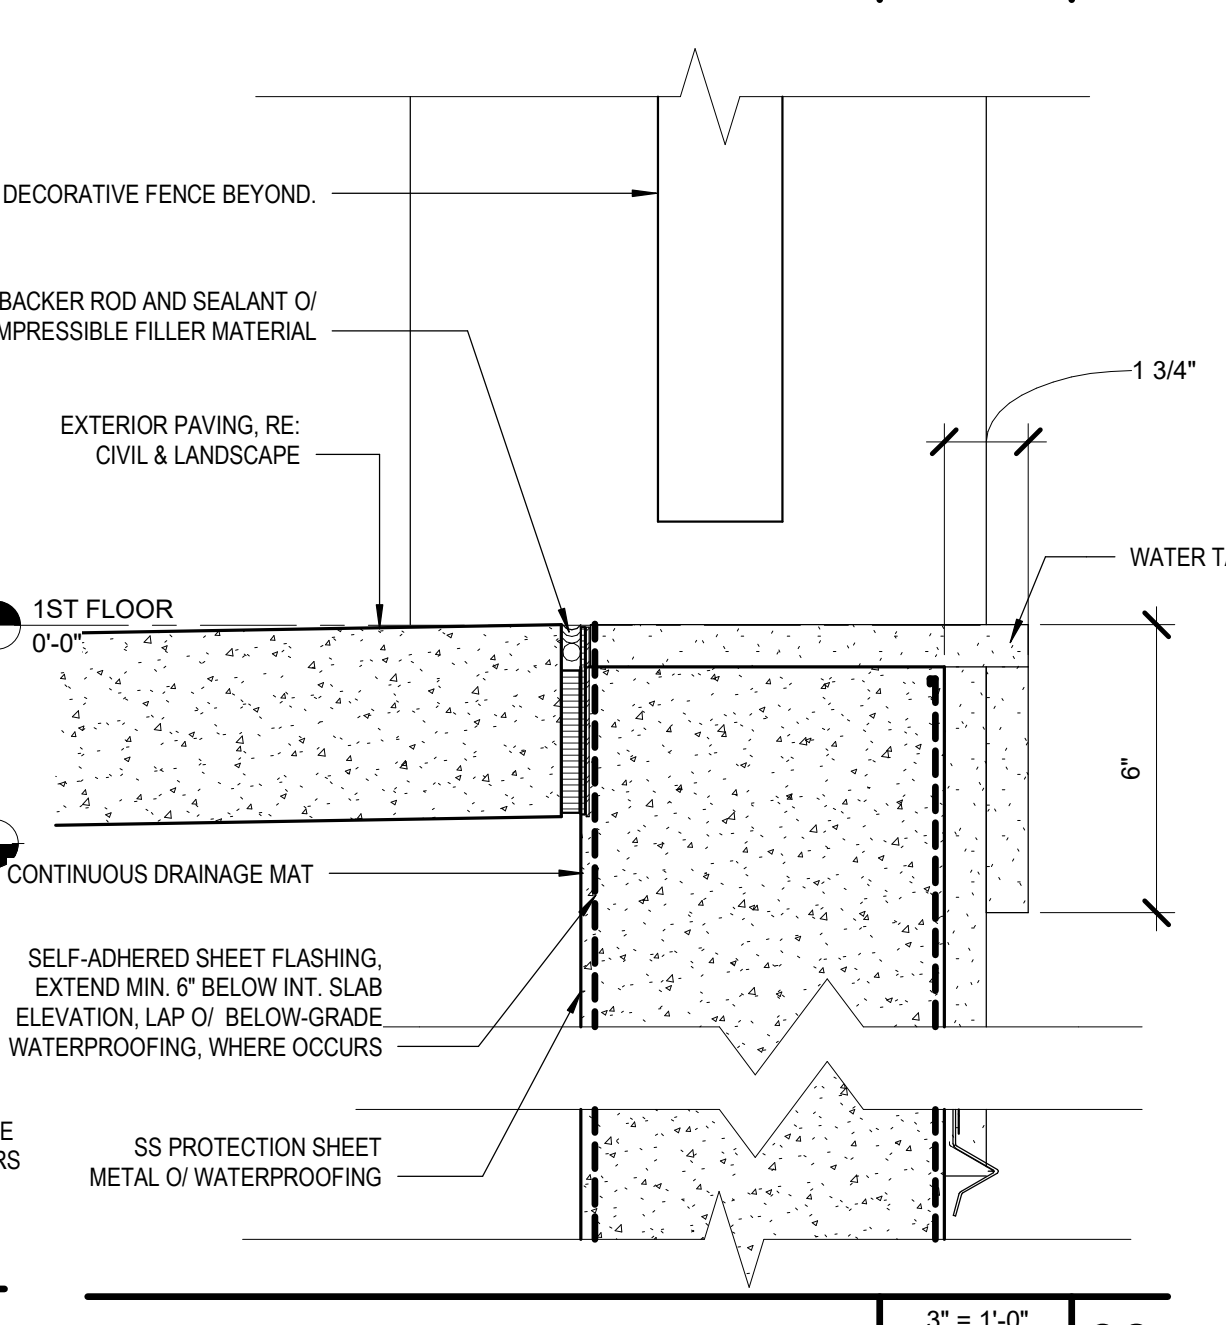

WATER TABLE DETAIL 06

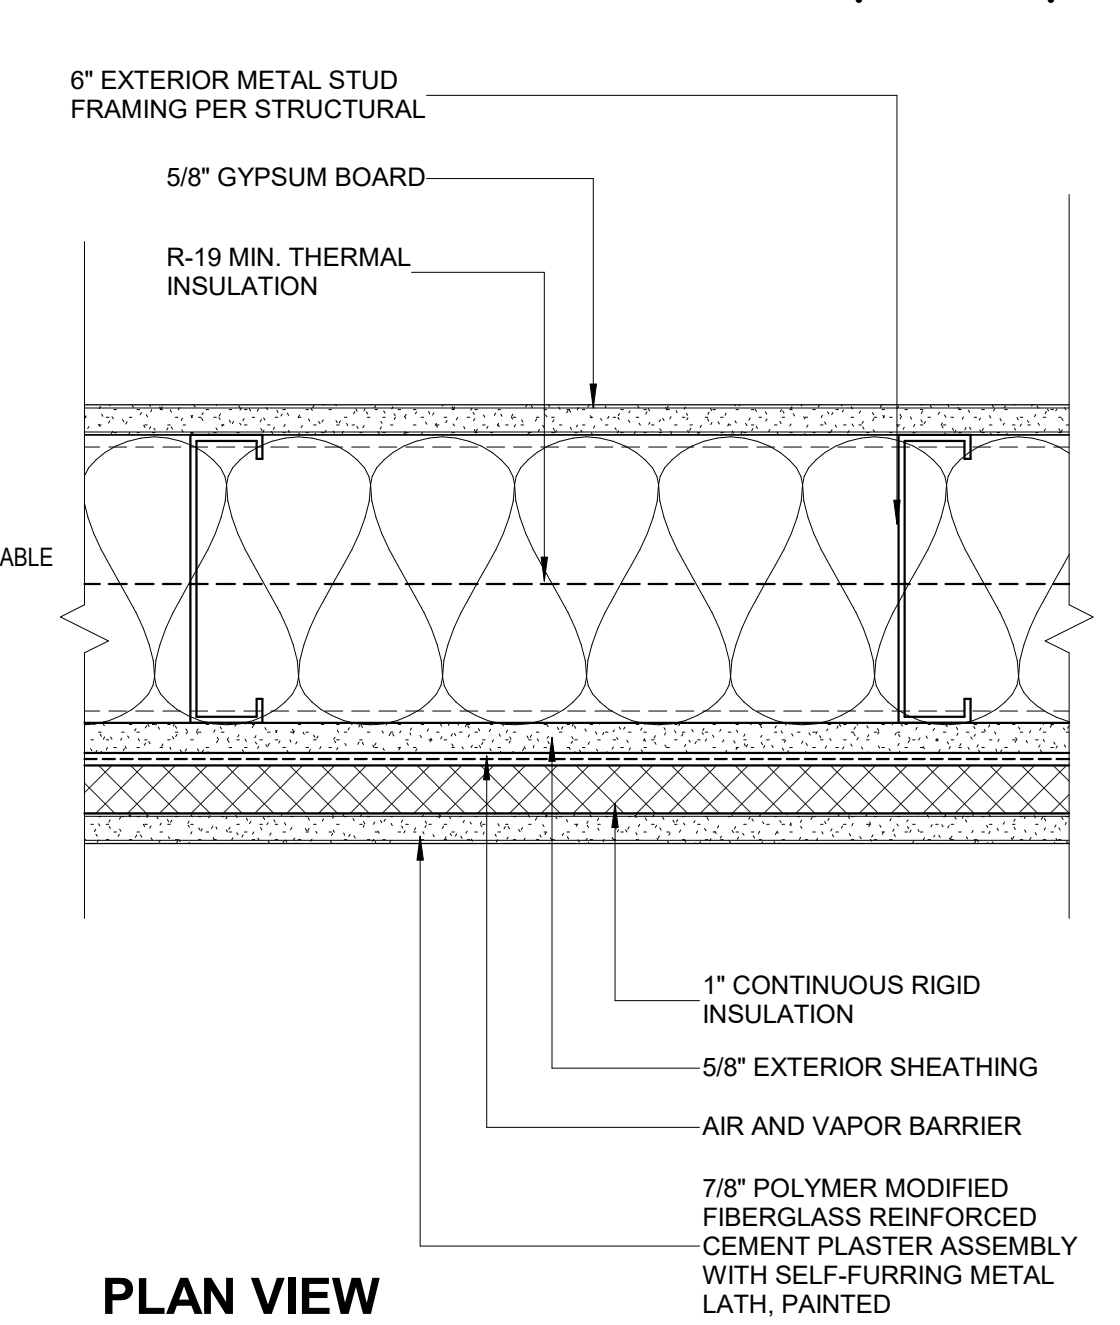


SECTION VIEW

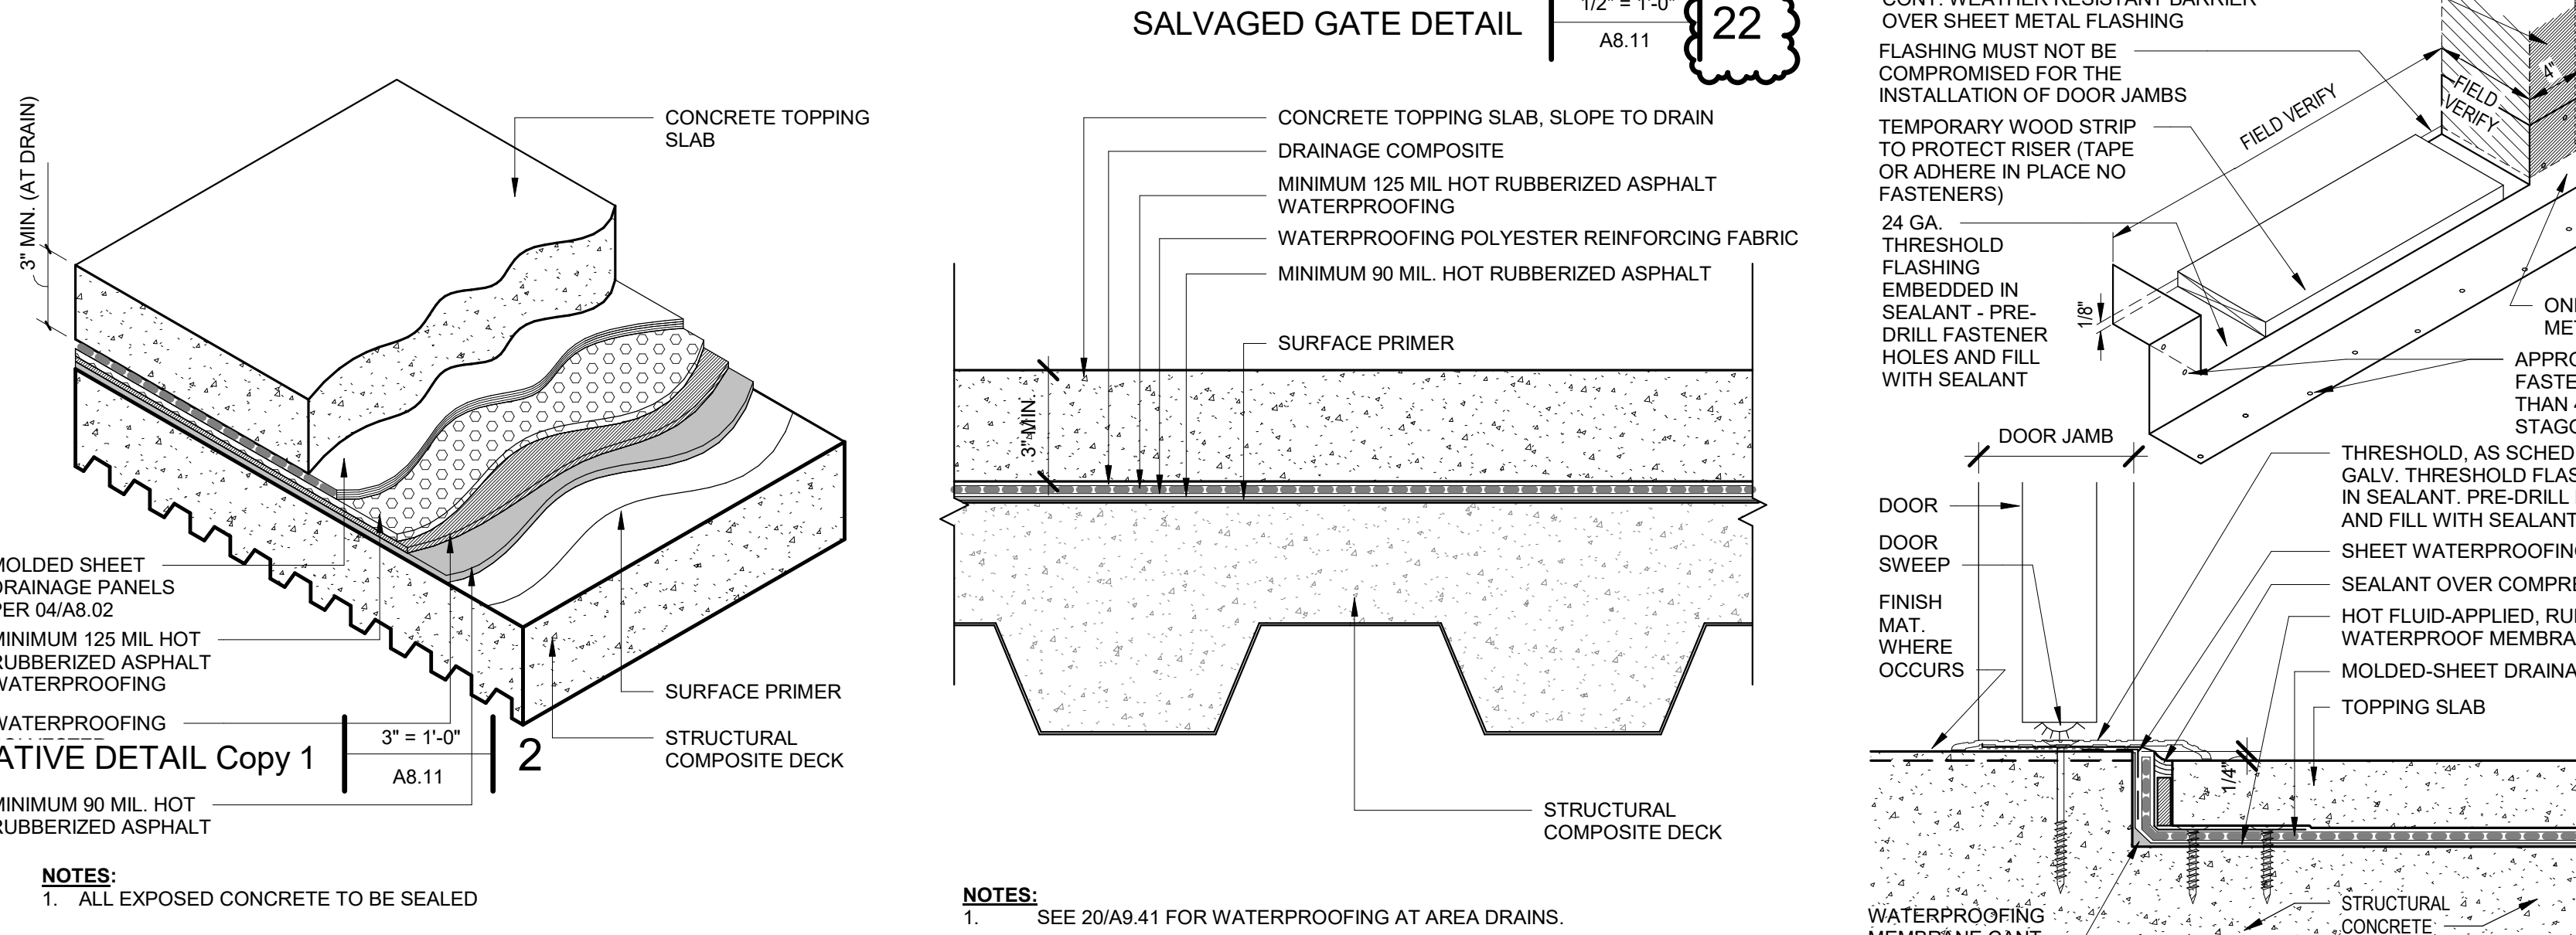


TOPPING SLAB AXON 21


TS1 - TOPPING SLAB 17

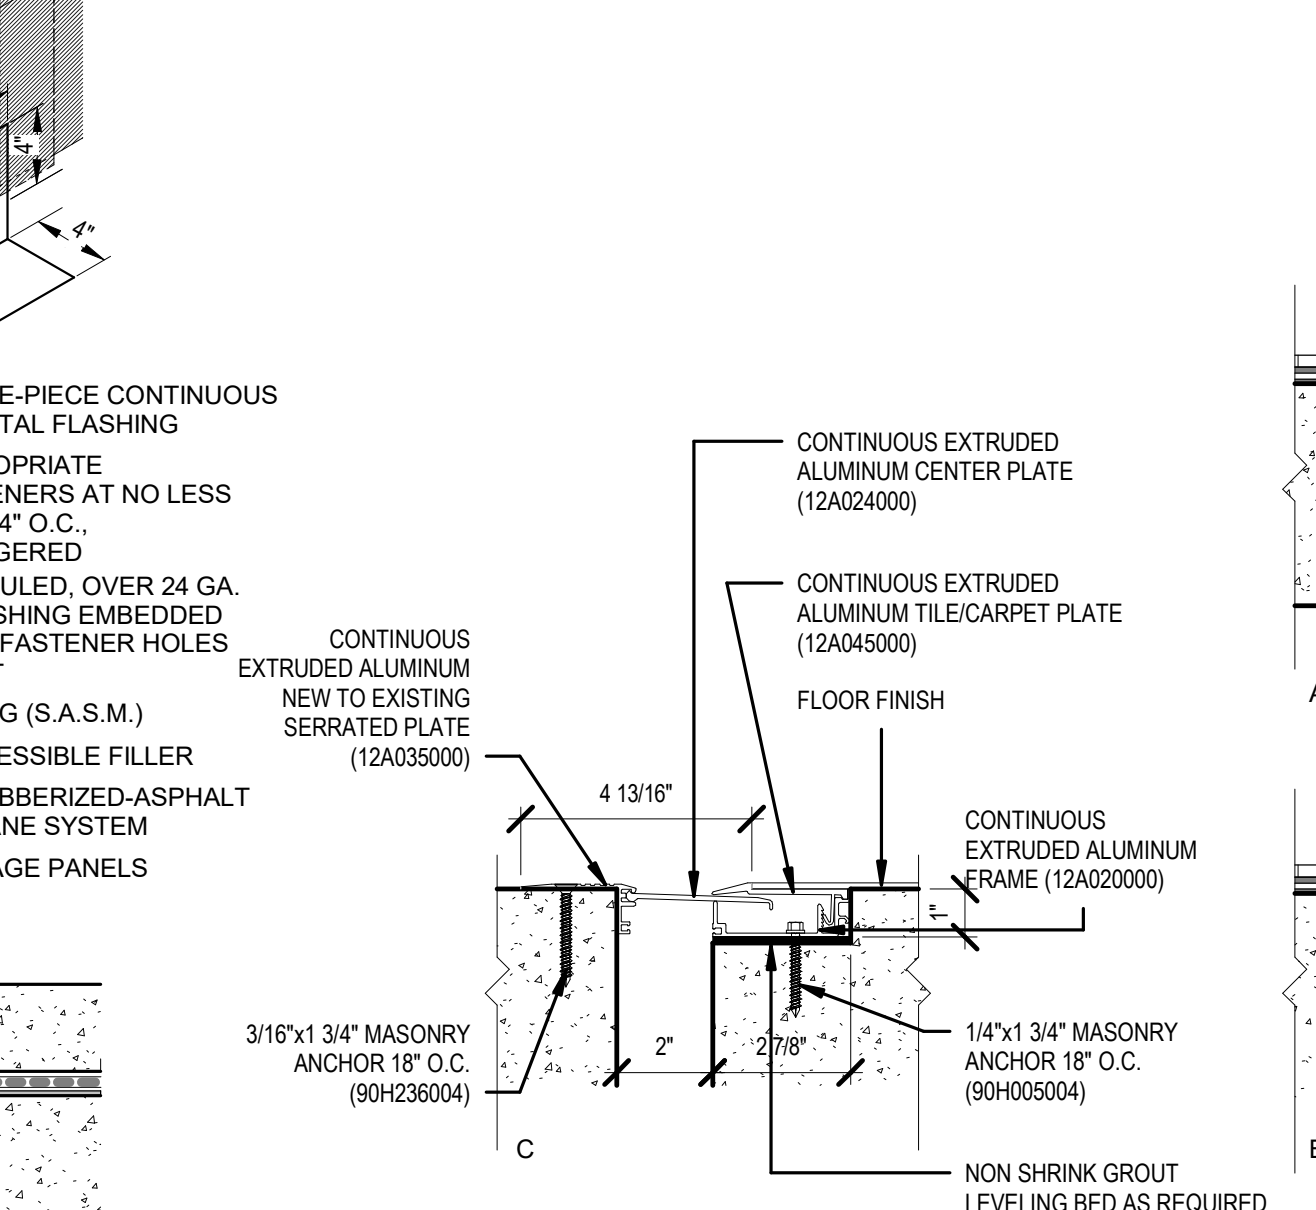


WATERPROOFING AT THRESHOLD 13

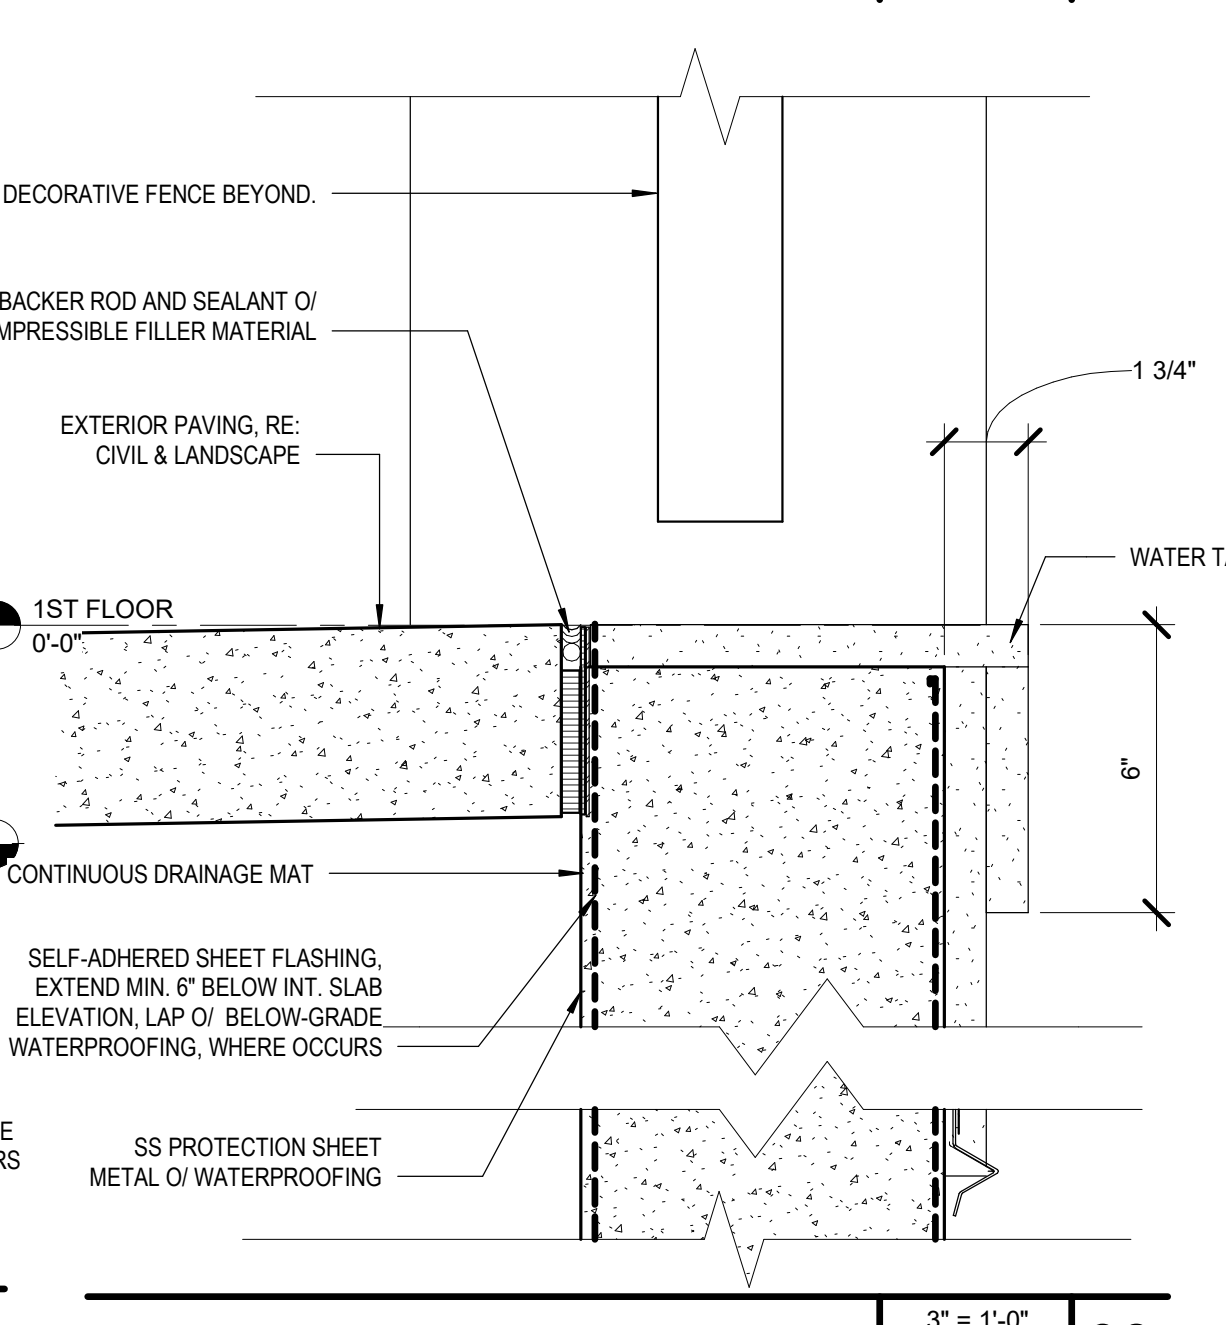

WATER TABLE DETAIL 06

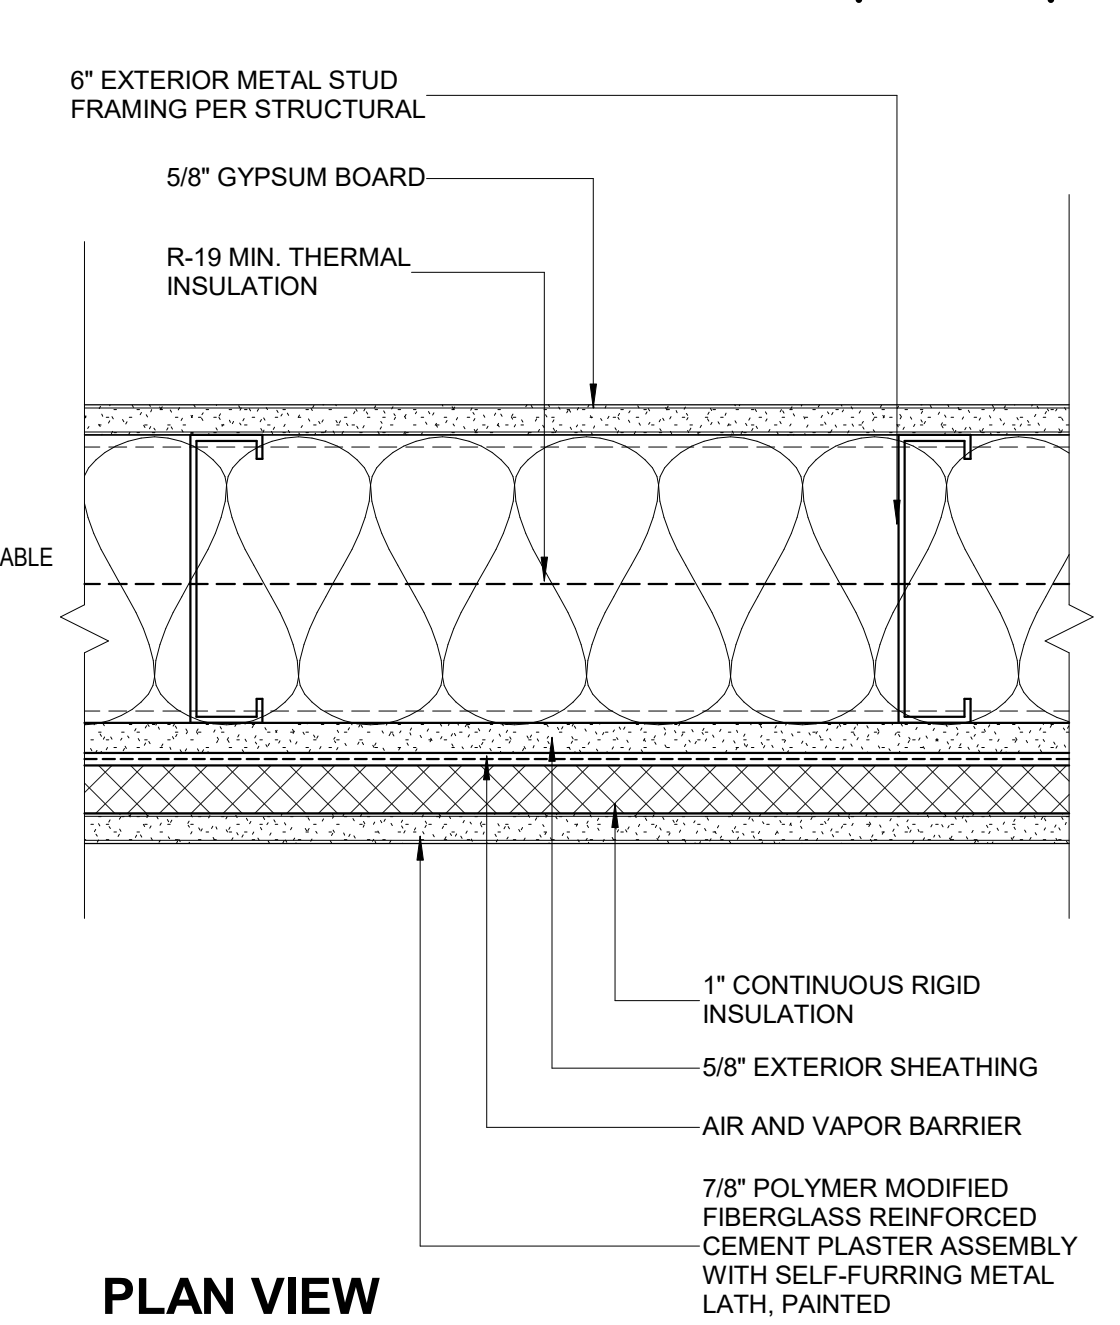


SECTION VIEW

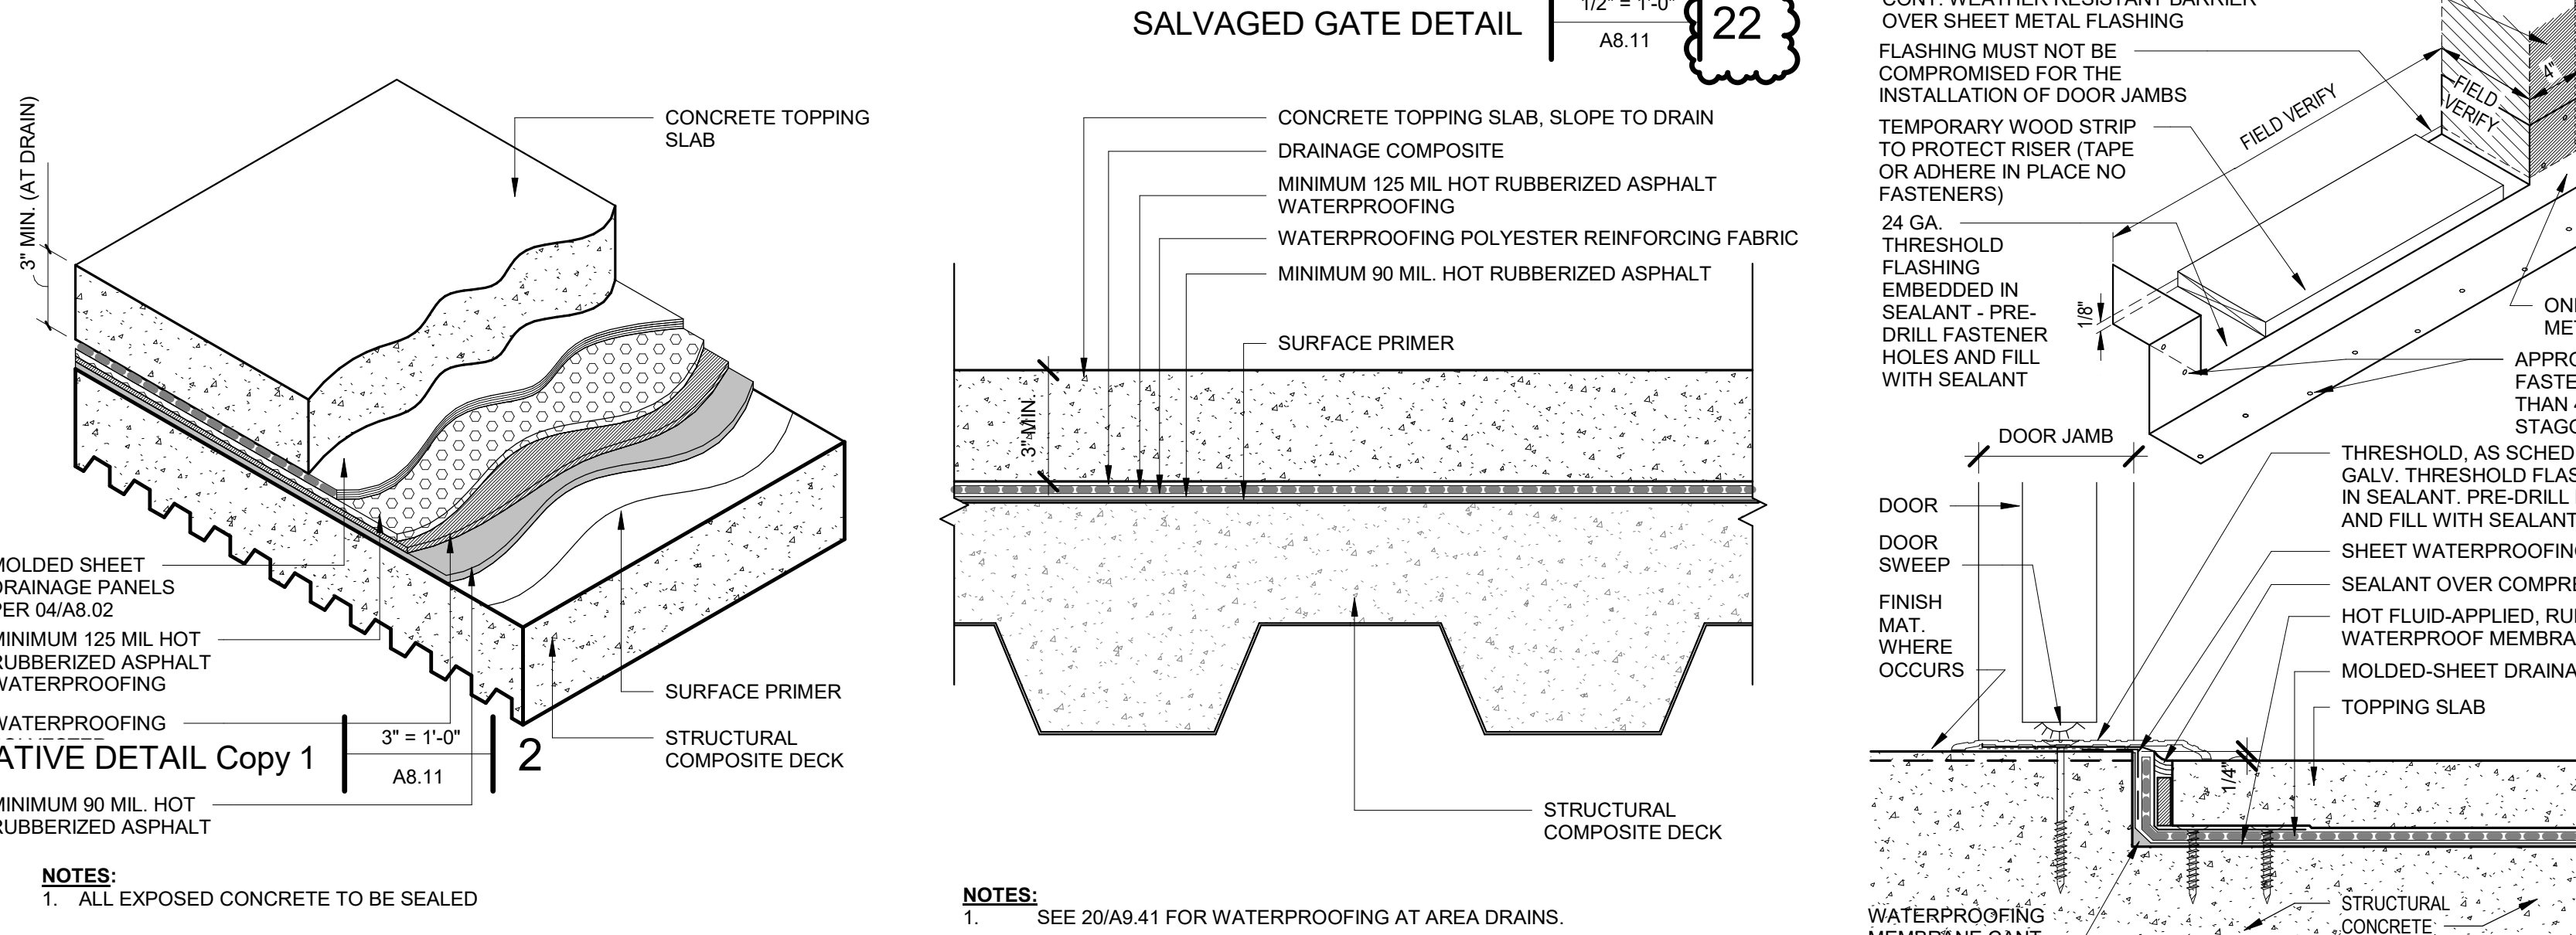


TOPPING SLAB AXON 21


TS1 - TOPPING SLAB 17

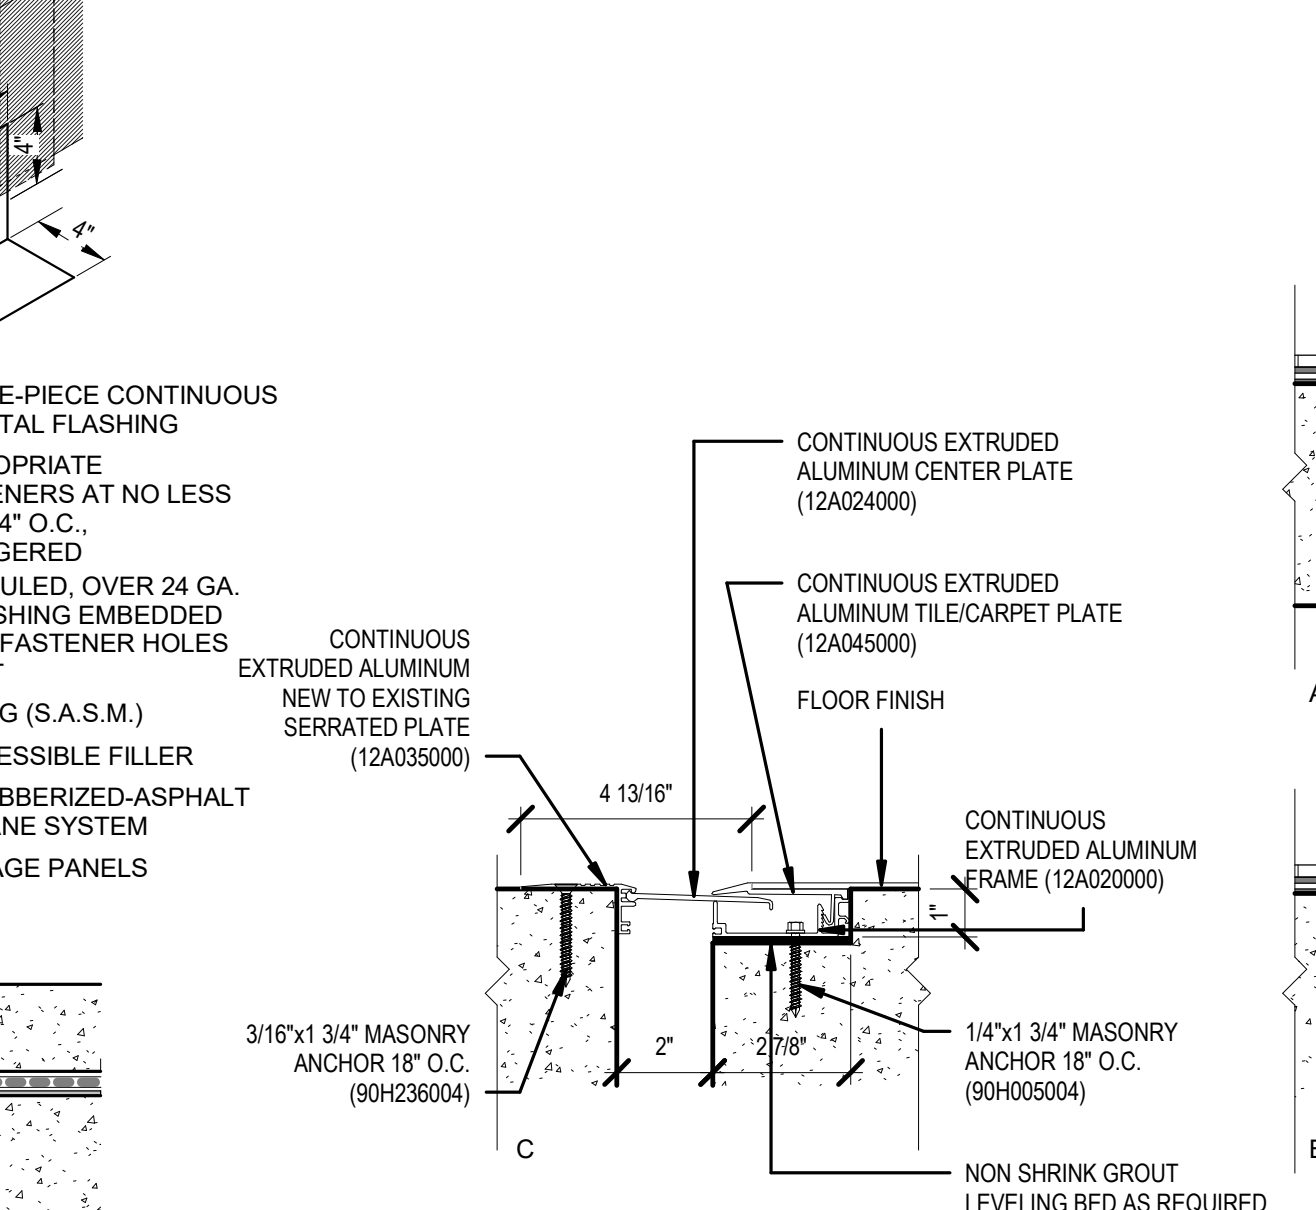


WATERPROOFING AT THRESHOLD 13

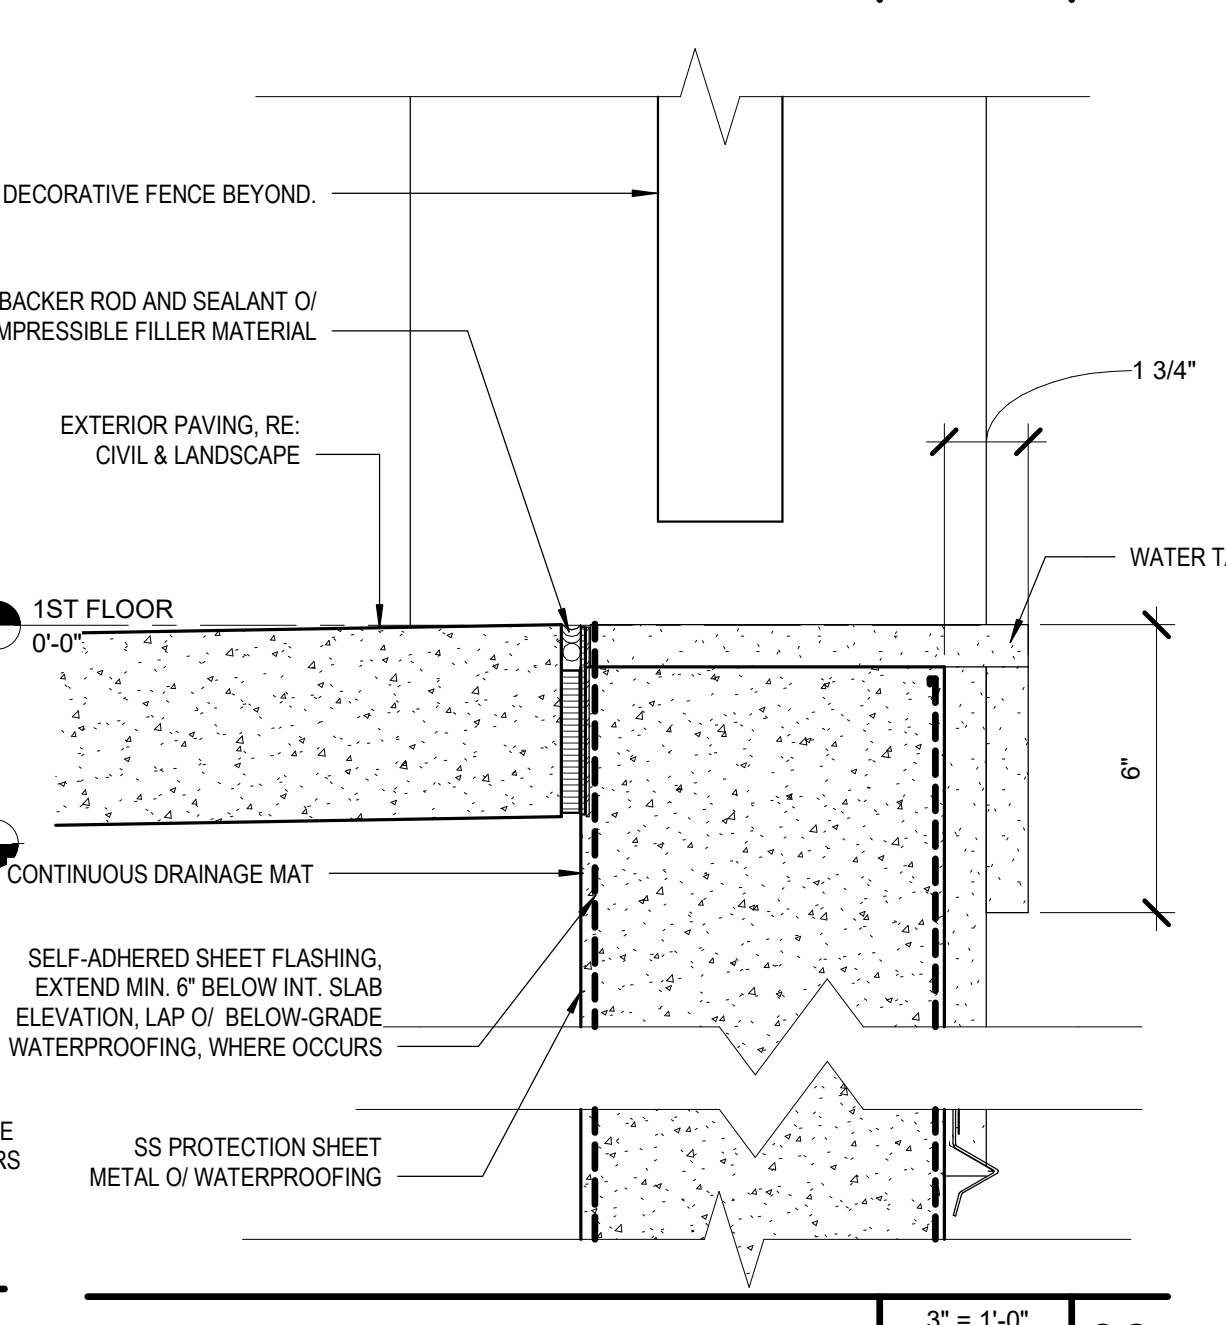

WATER TABLE DETAIL 06

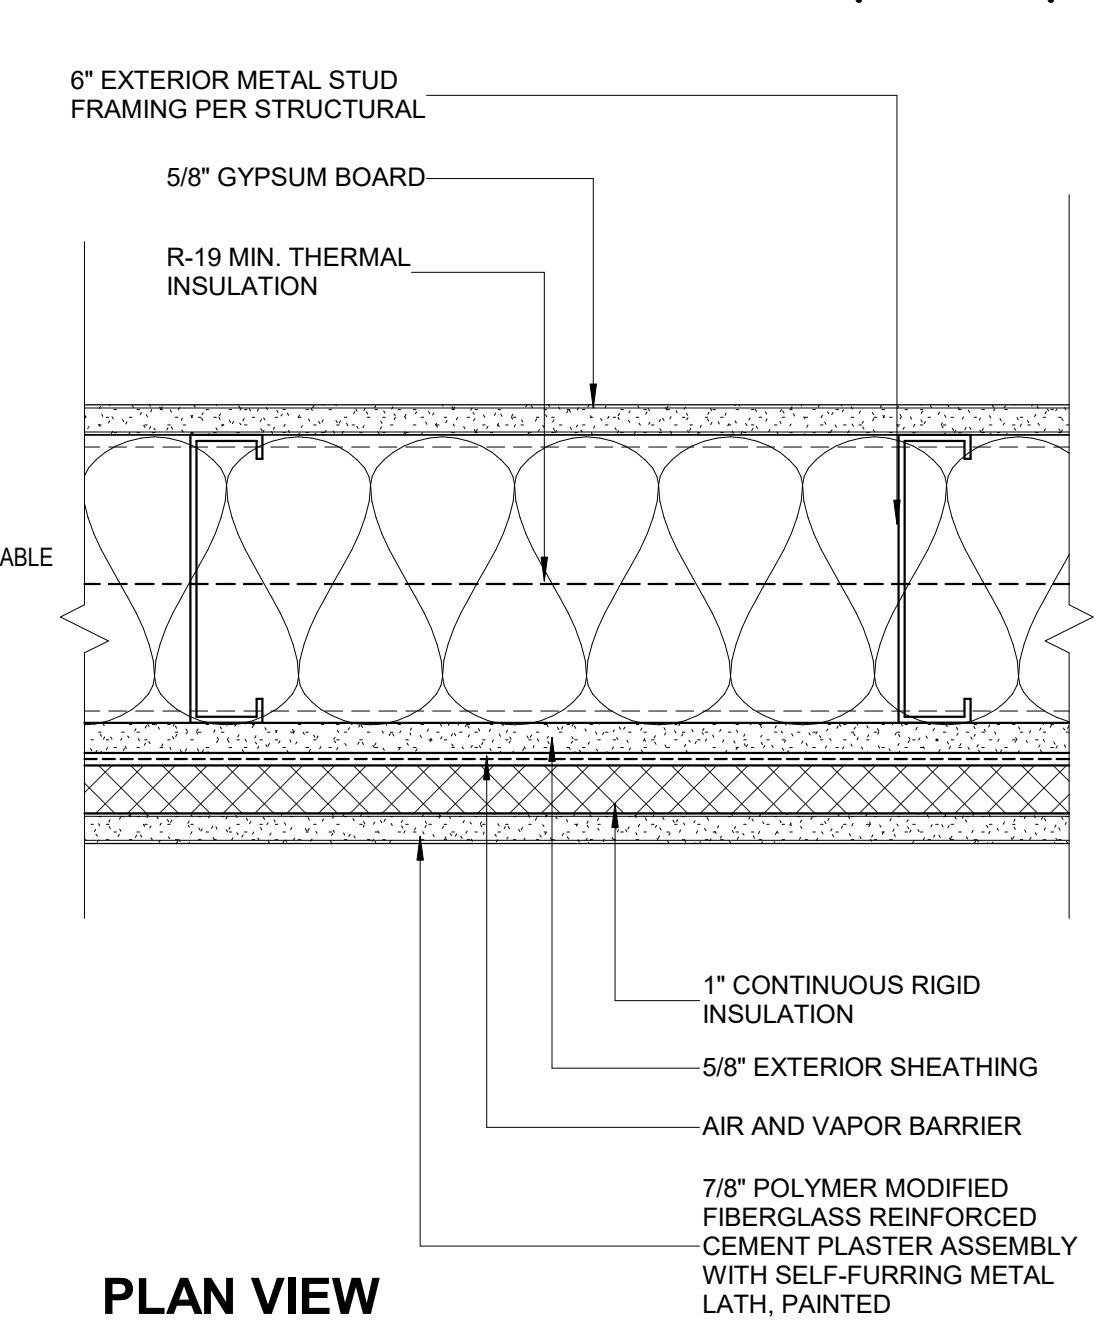


SECTION VIEW

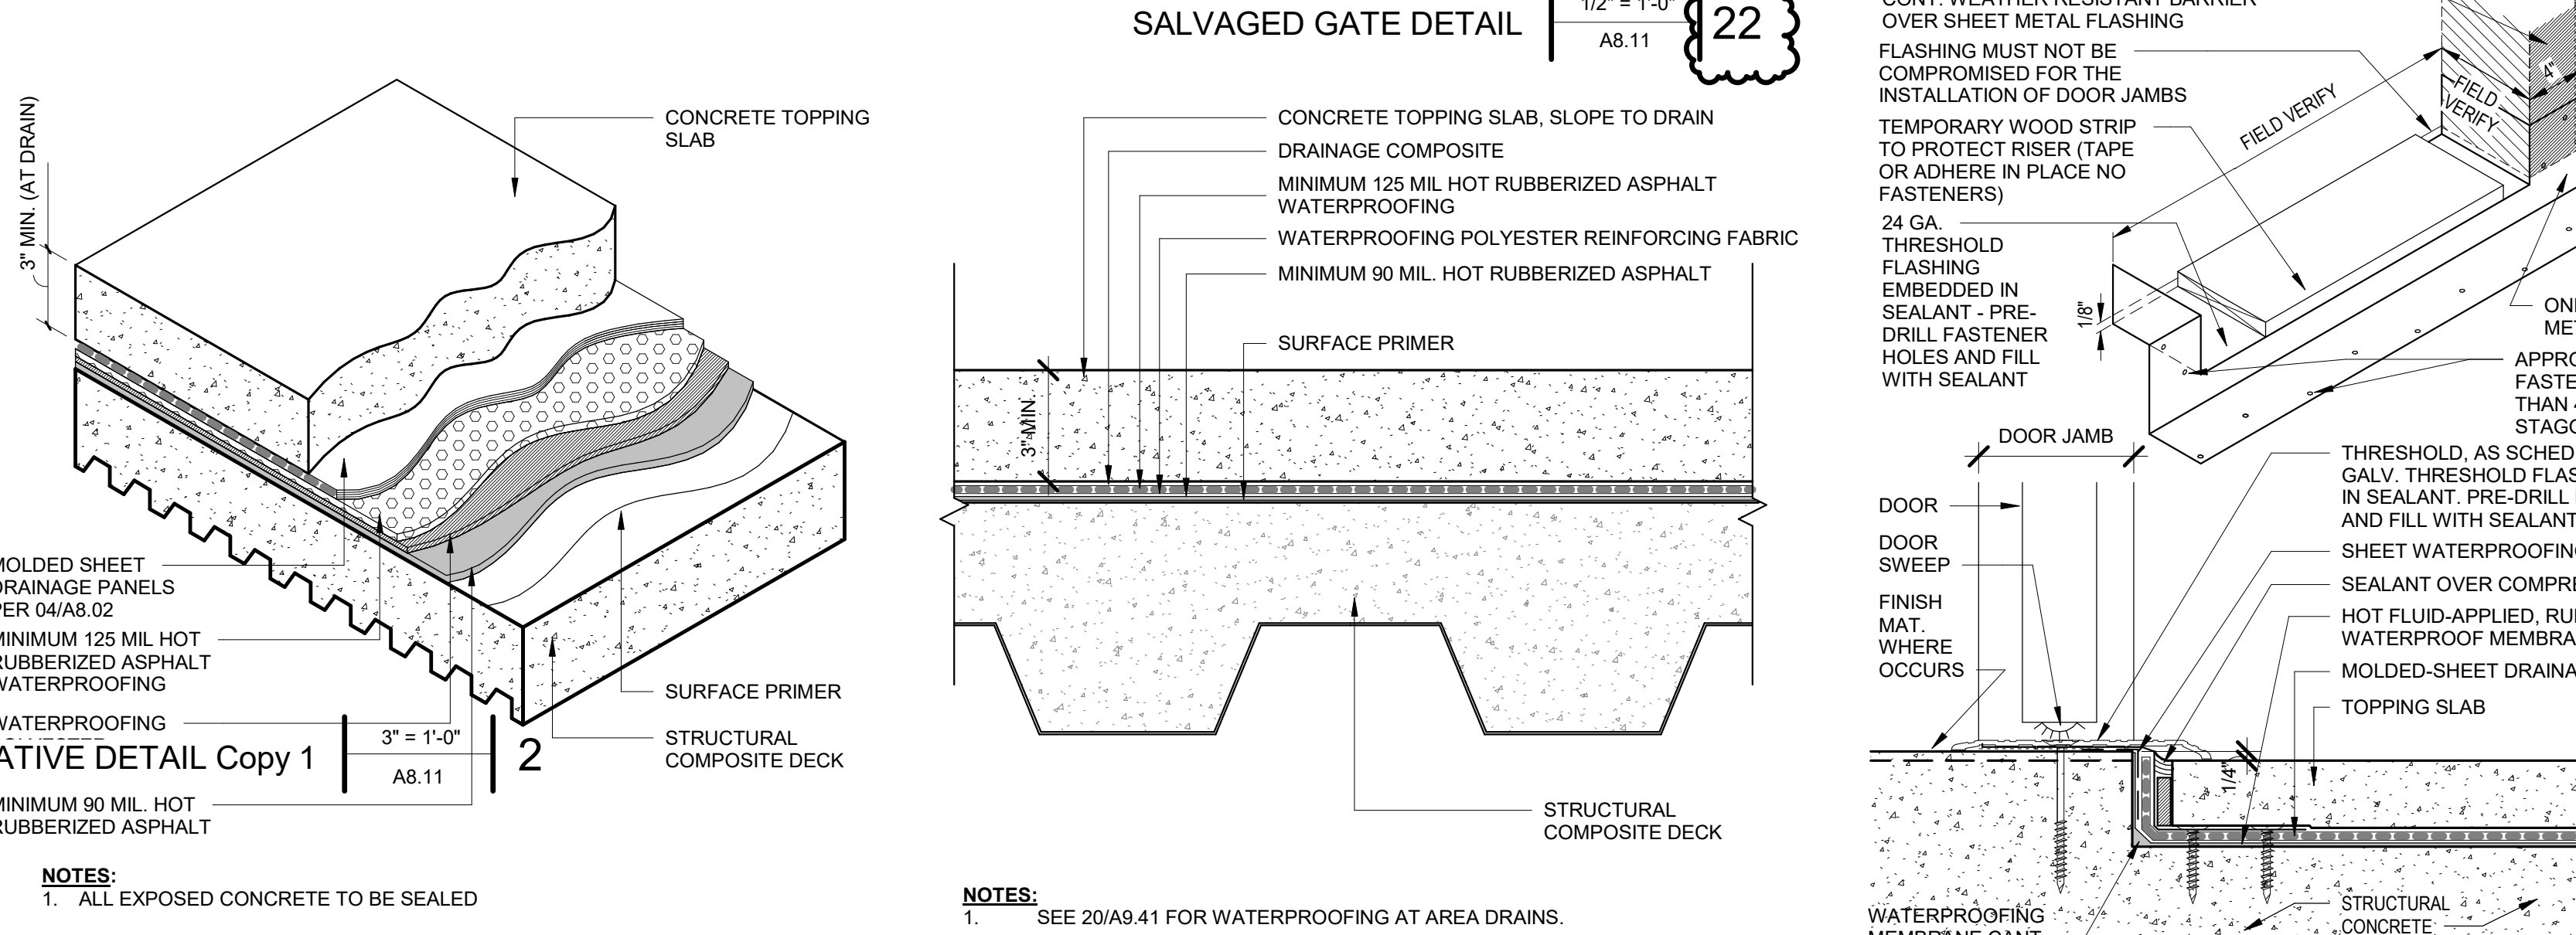


TOPPING SLAB AXON 21


TS1 - TOPPING SLAB 17

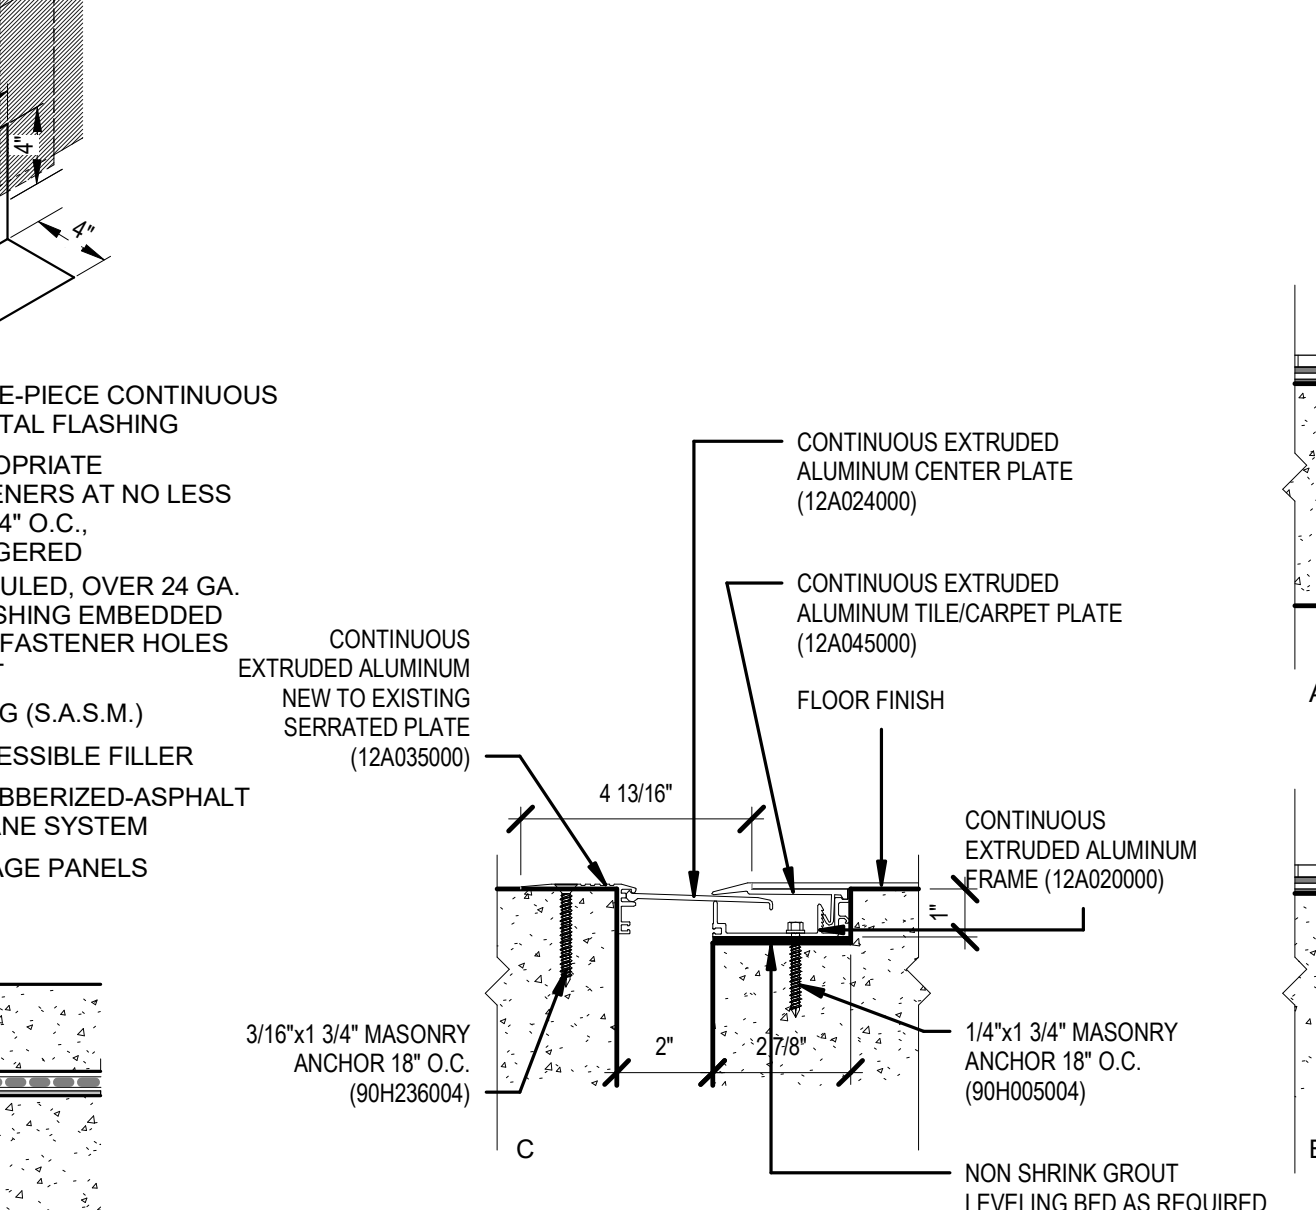


WATERPROOFING AT THRESHOLD 13

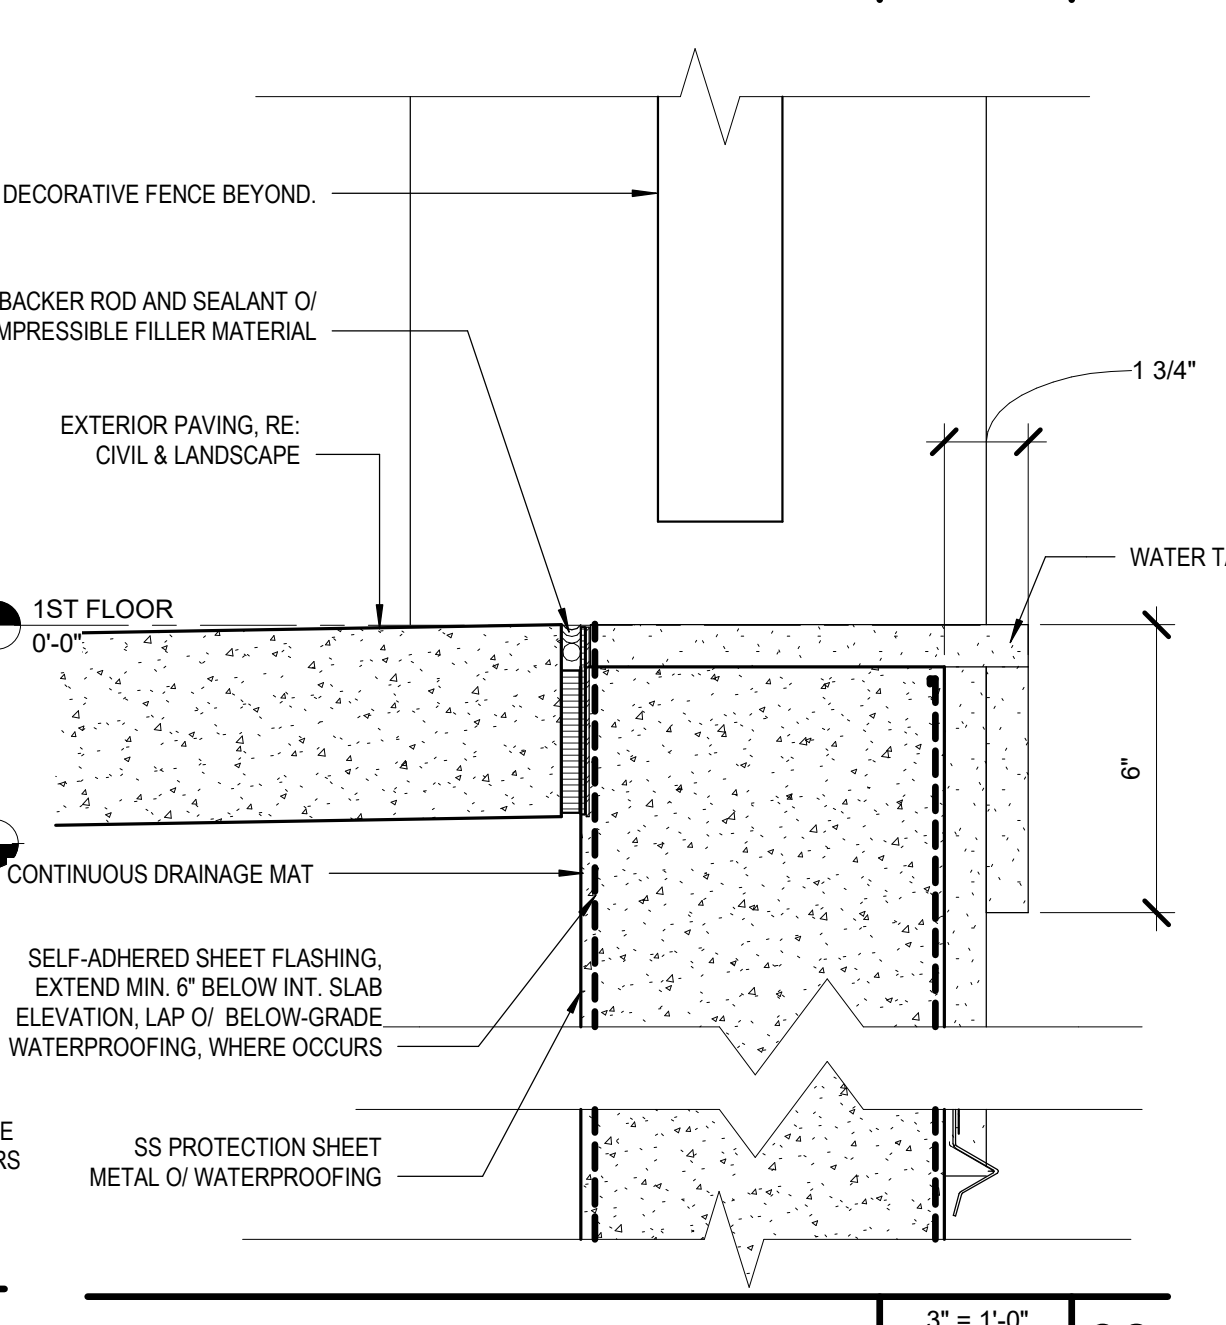

WATER TABLE DETAIL 06

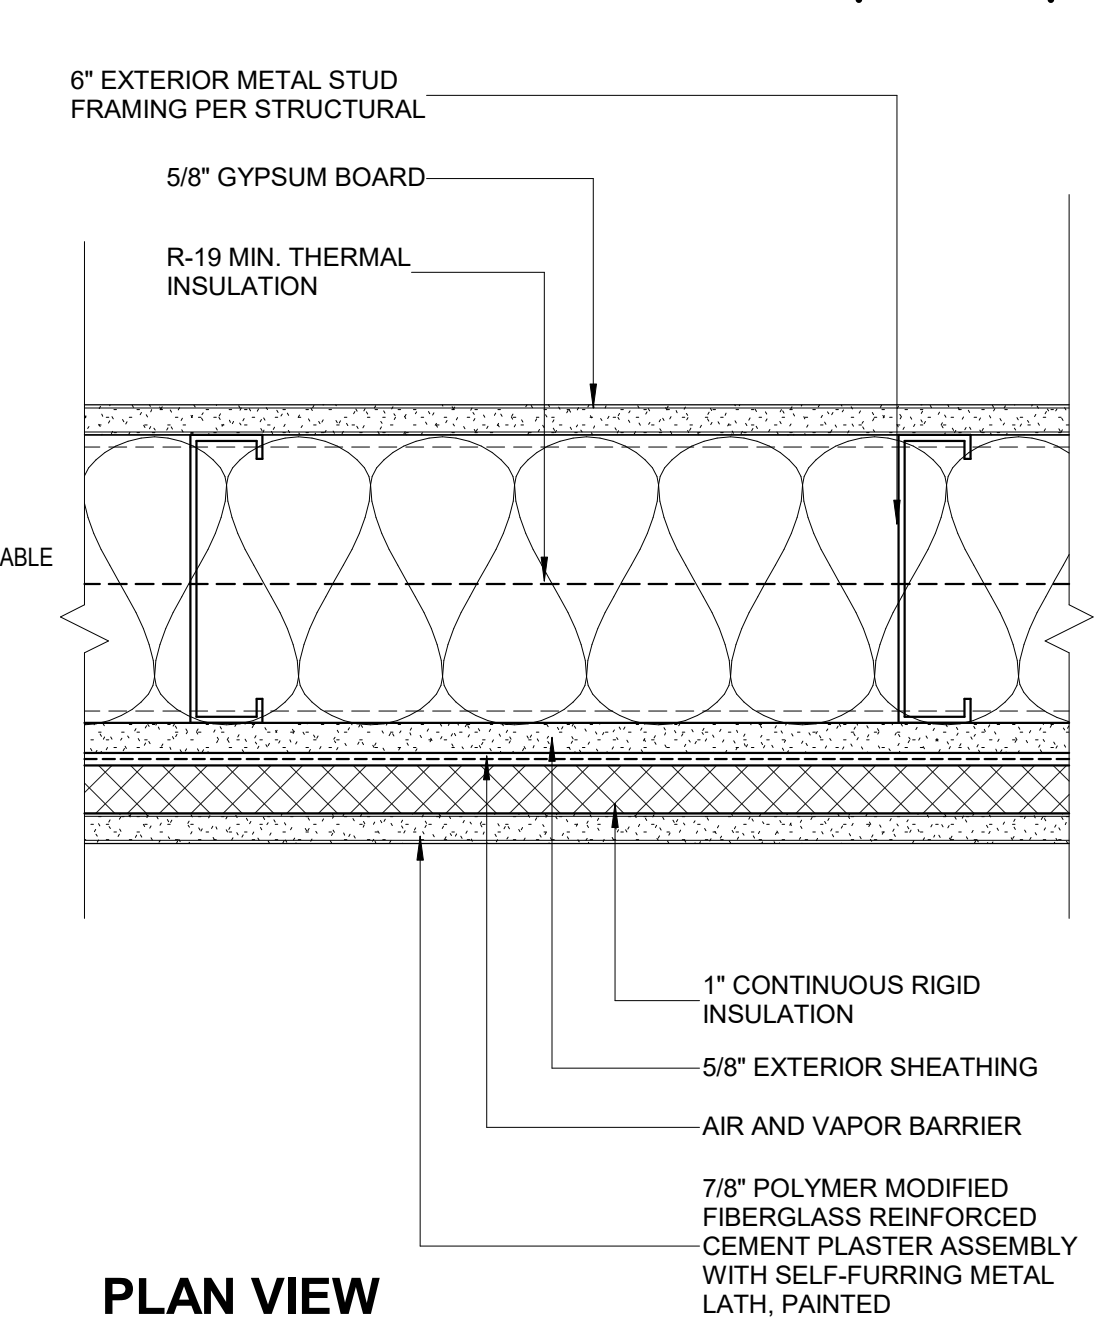


SECTION VIEW

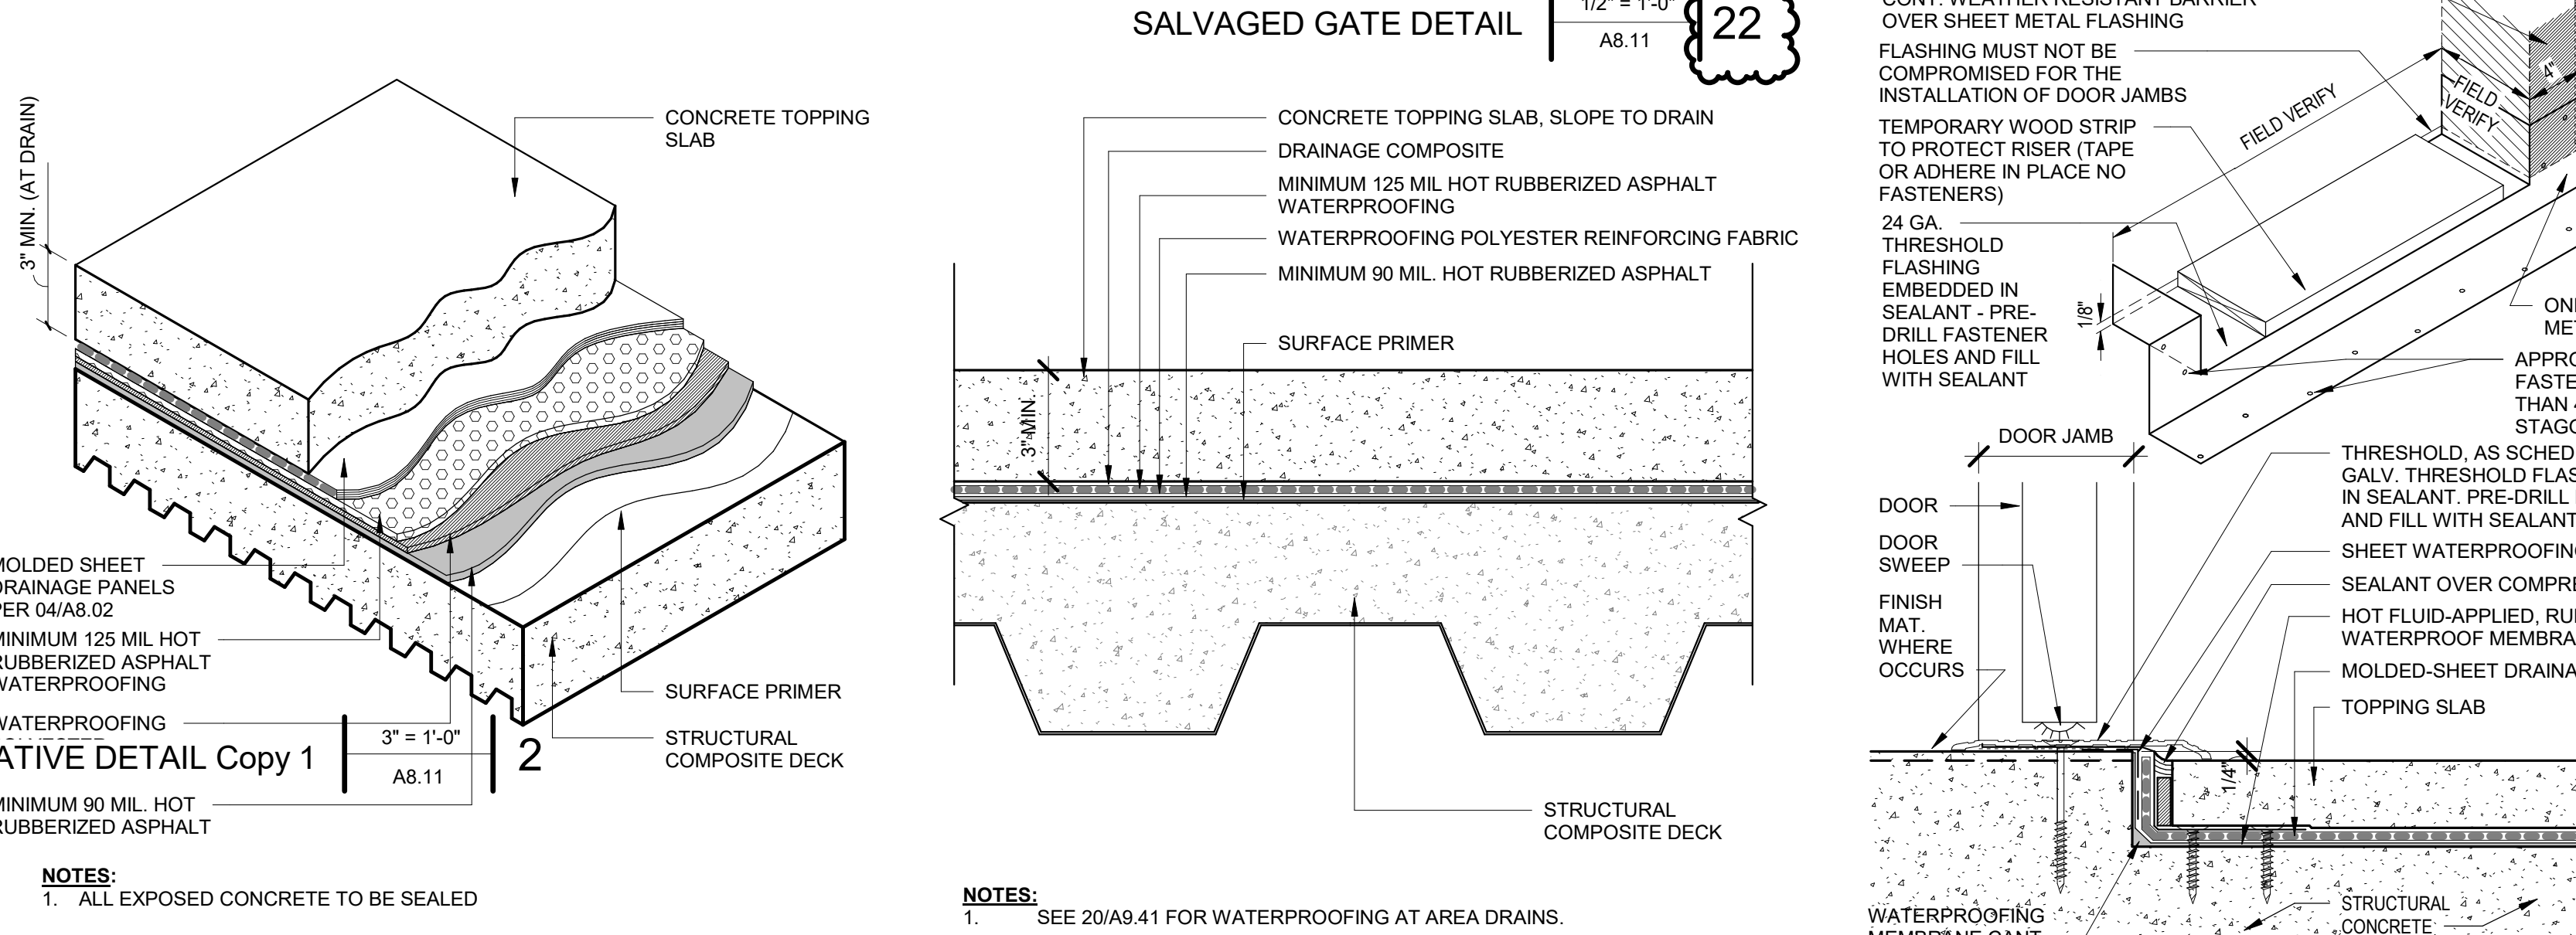


TOPPING SLAB AXON 21


TS1 - TOPPING SLAB 17

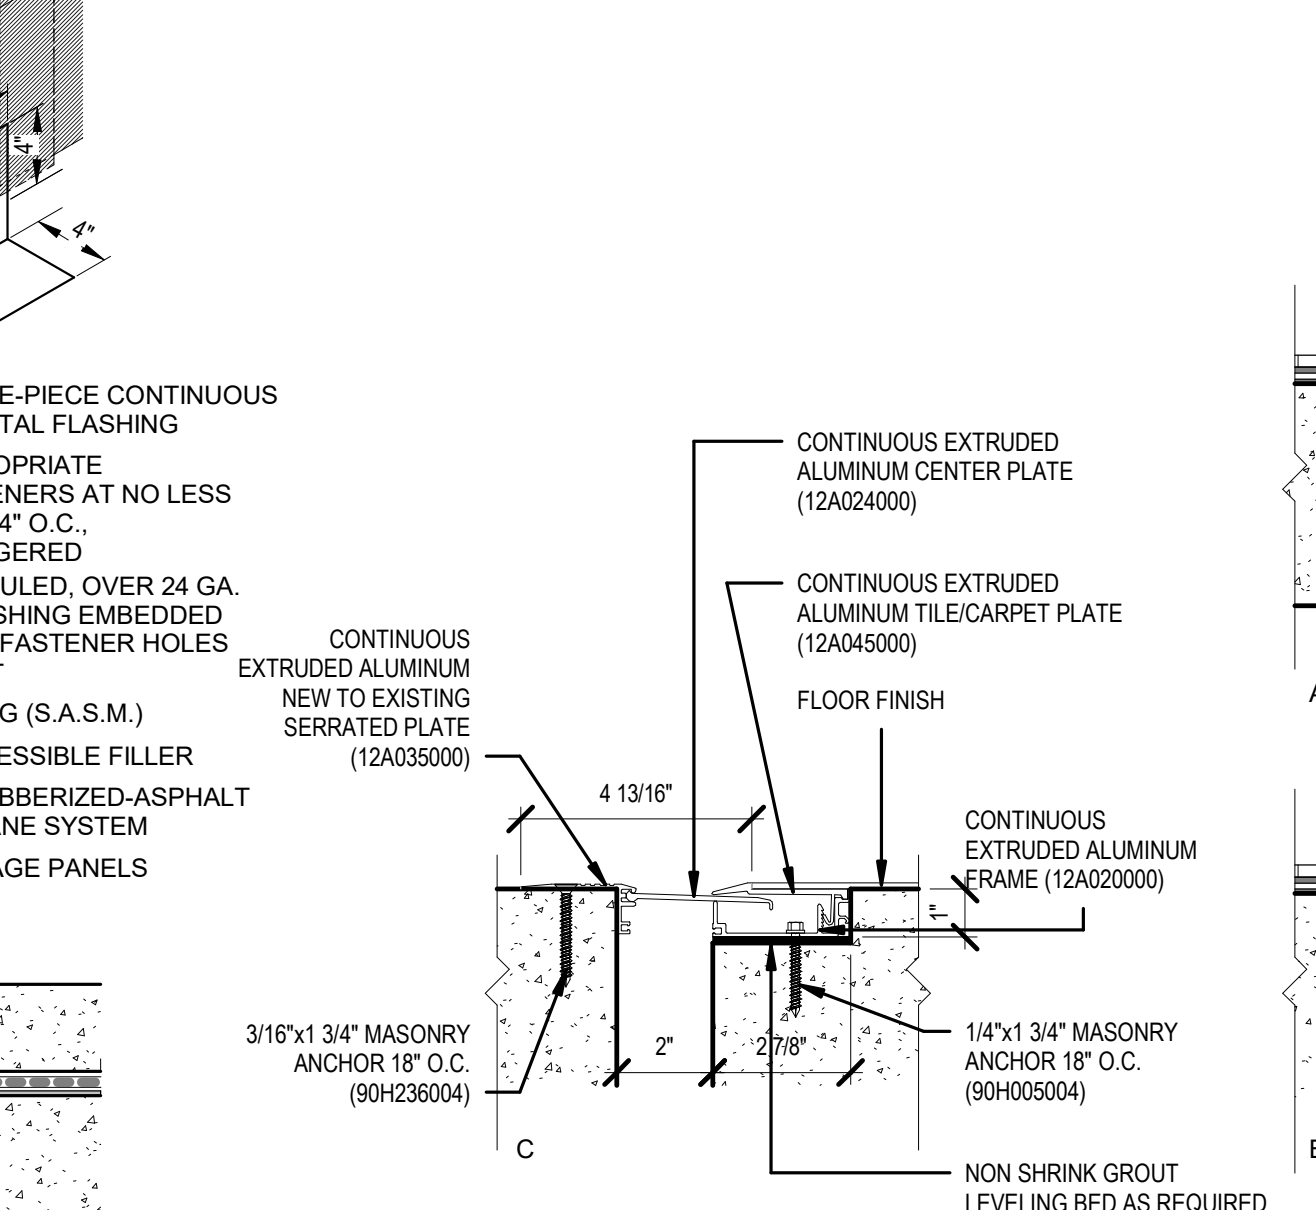


WATERPROOFING AT THRESHOLD 13

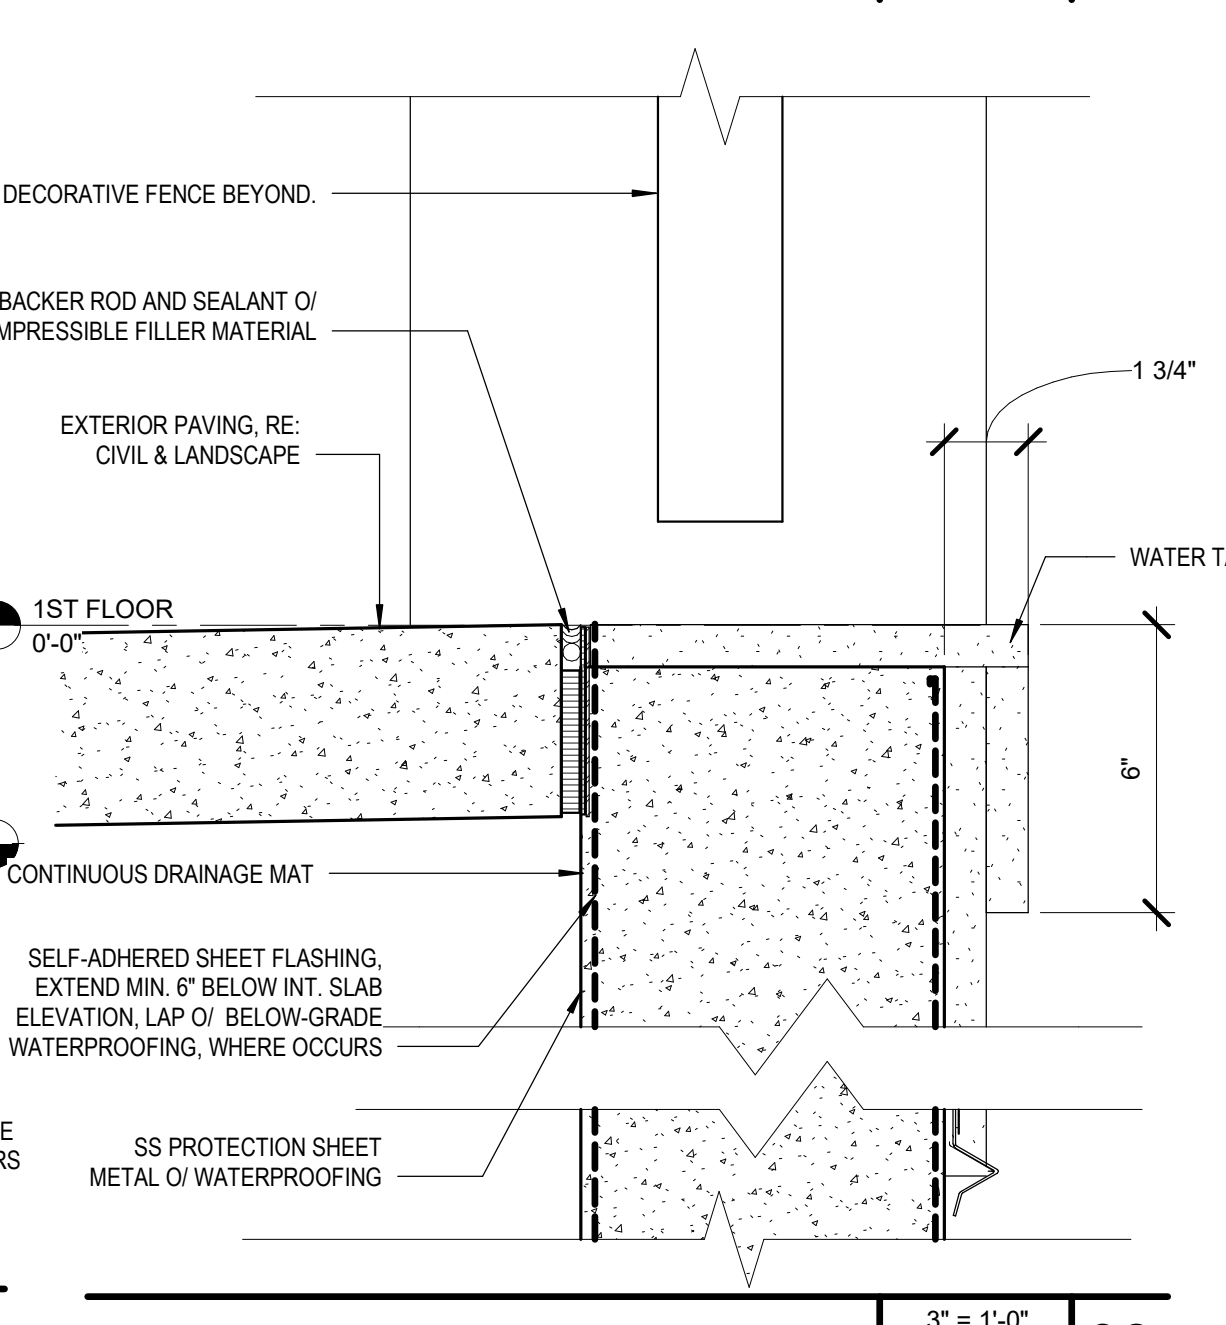

WATER TABLE DETAIL 06

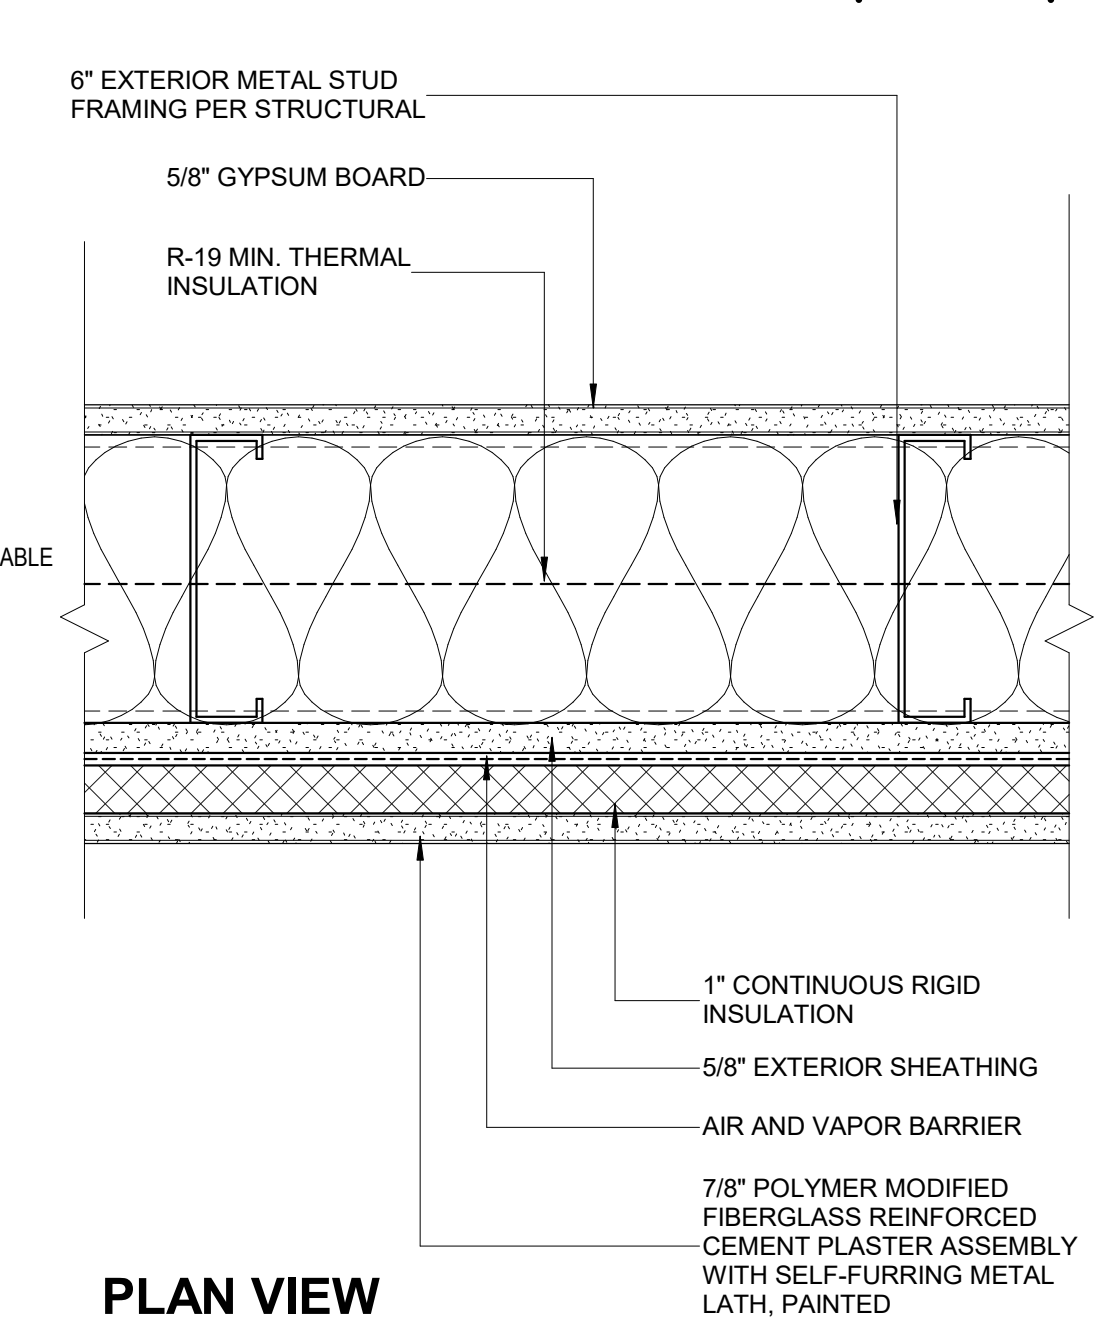


SECTION VIEW

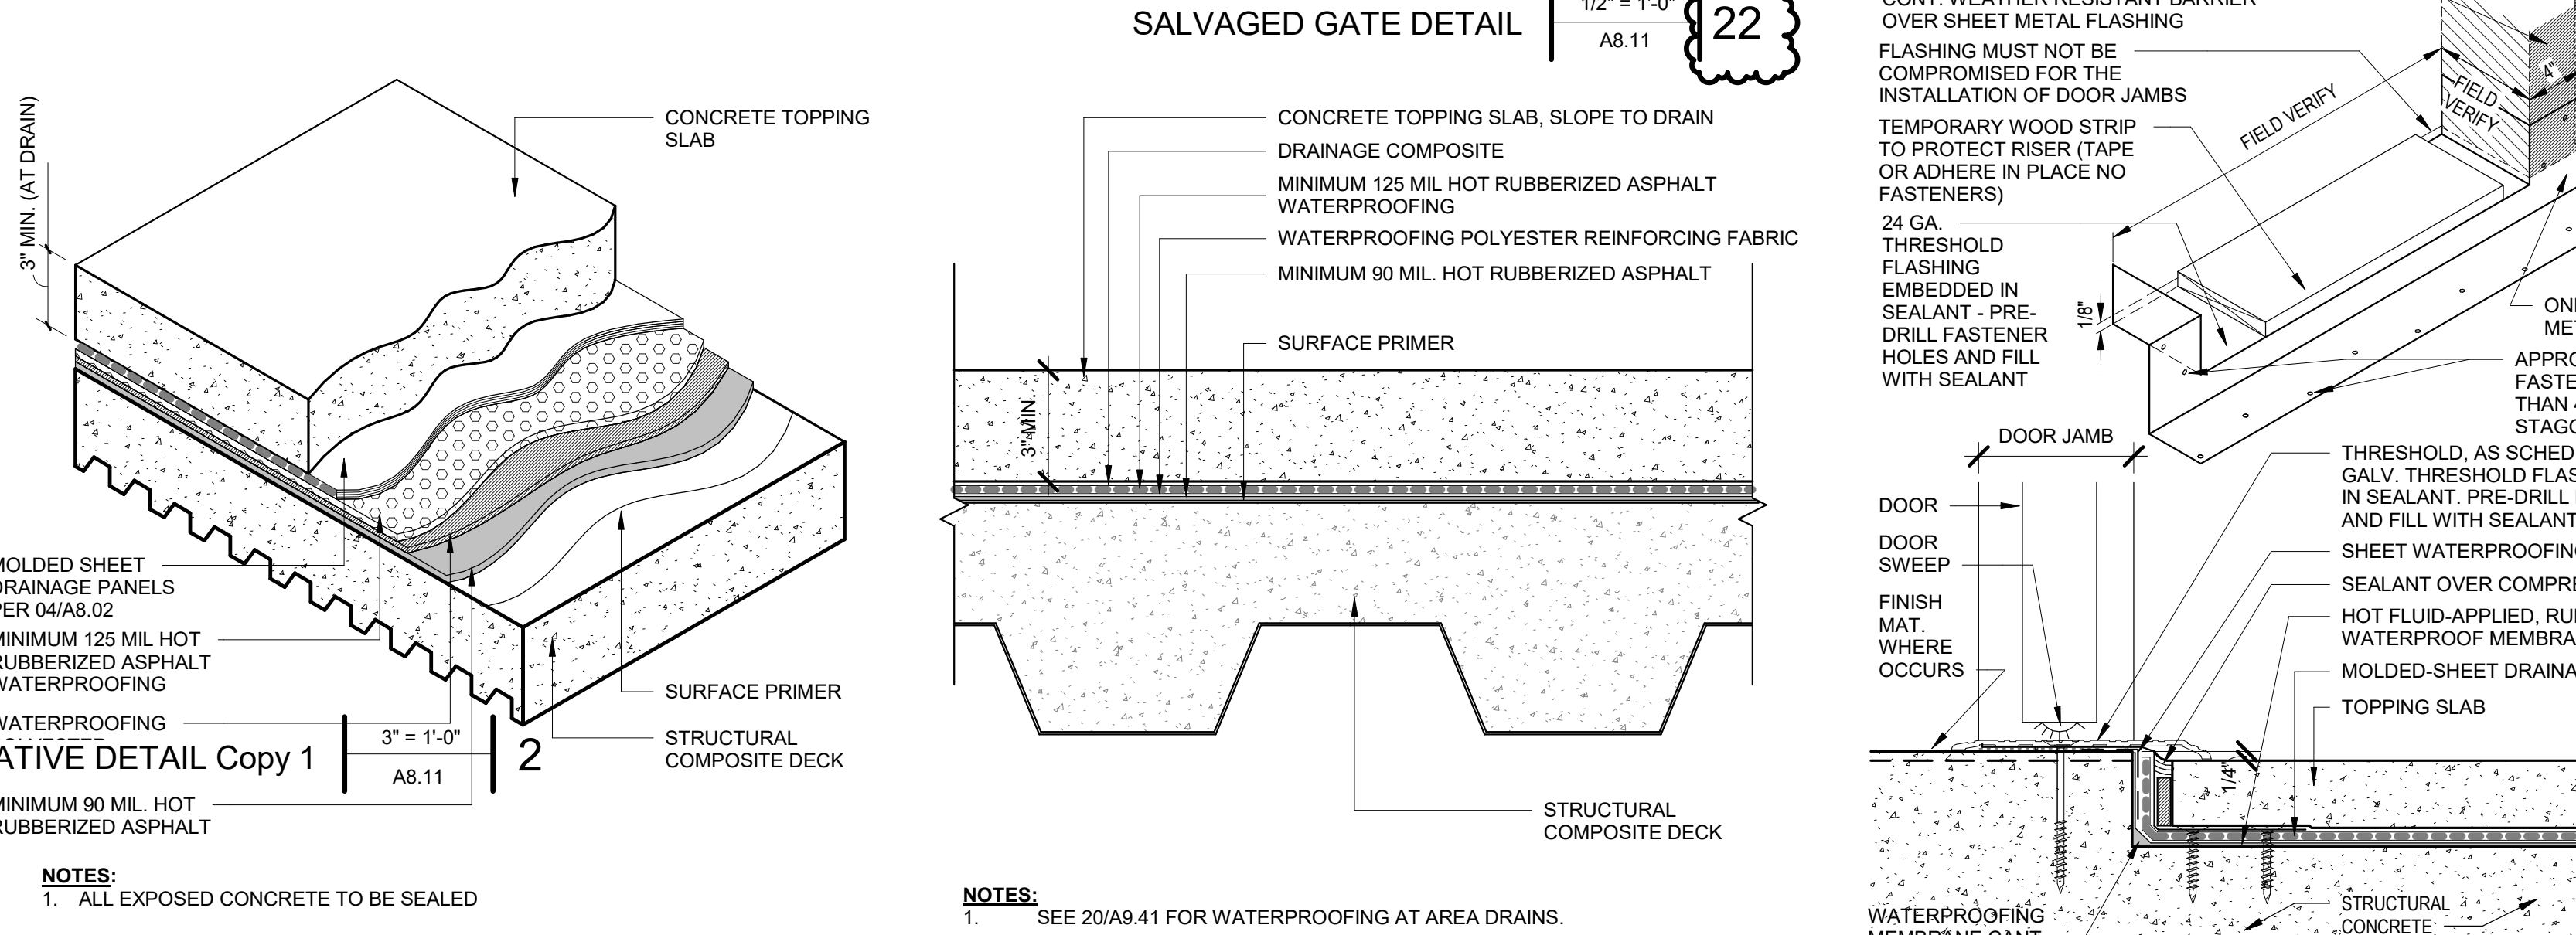


TOPPING SLAB AXON 21


TS1 - TOPPING SLAB 17

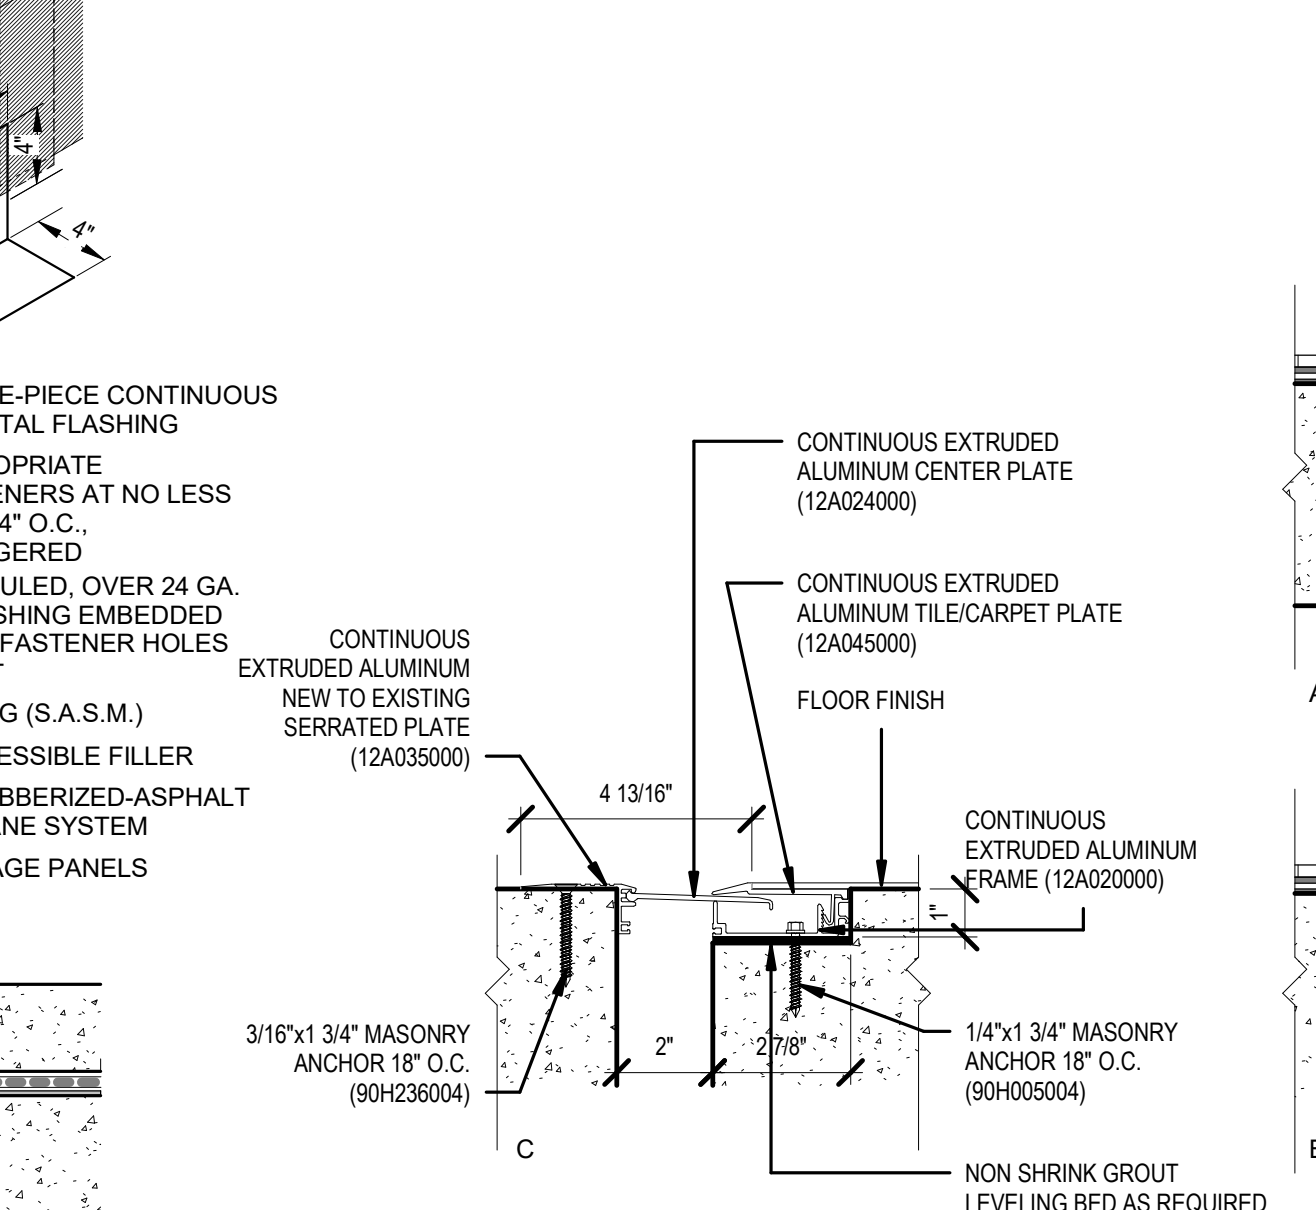


WATERPROOFING AT THRESHOLD 13

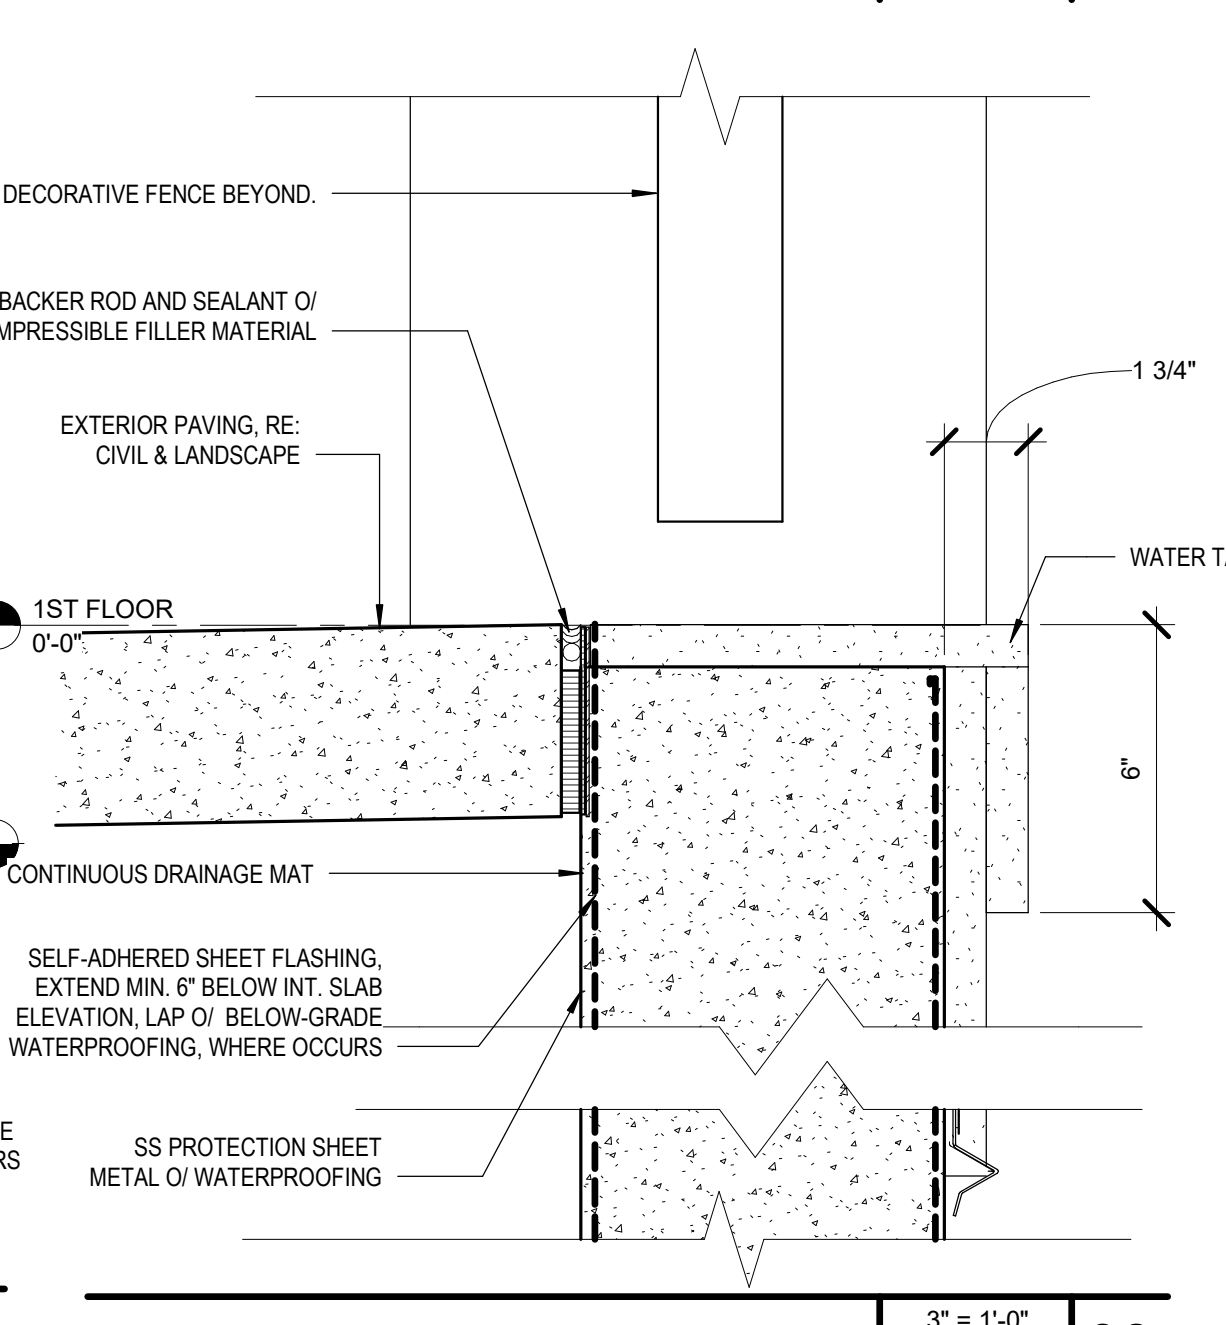

WATER TABLE DETAIL 06

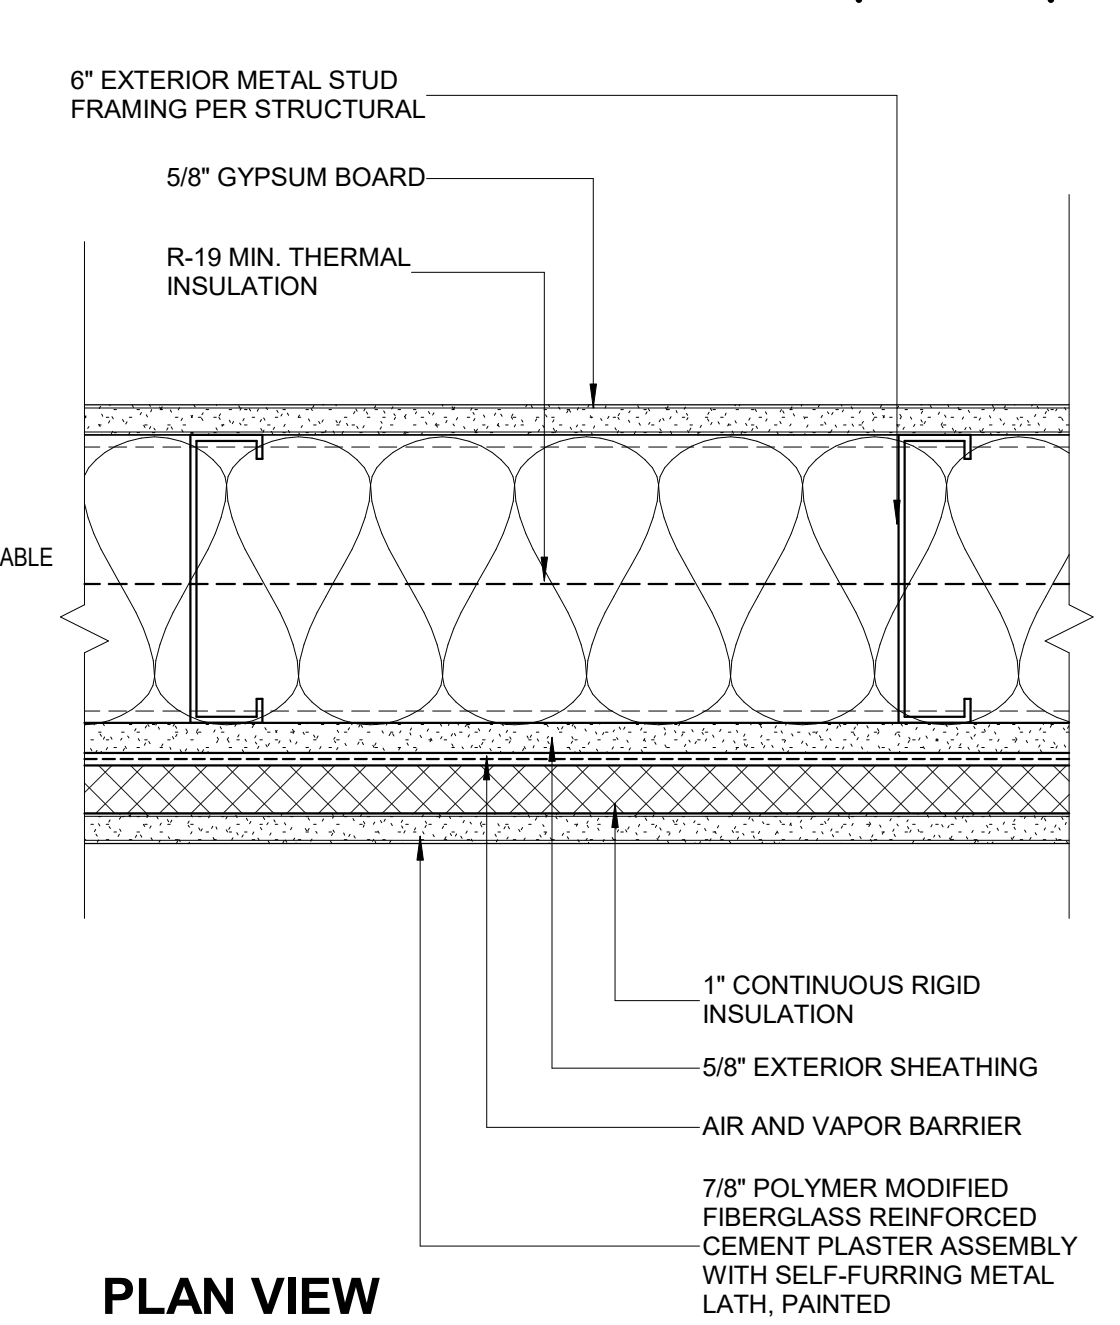


SECTION VIEW

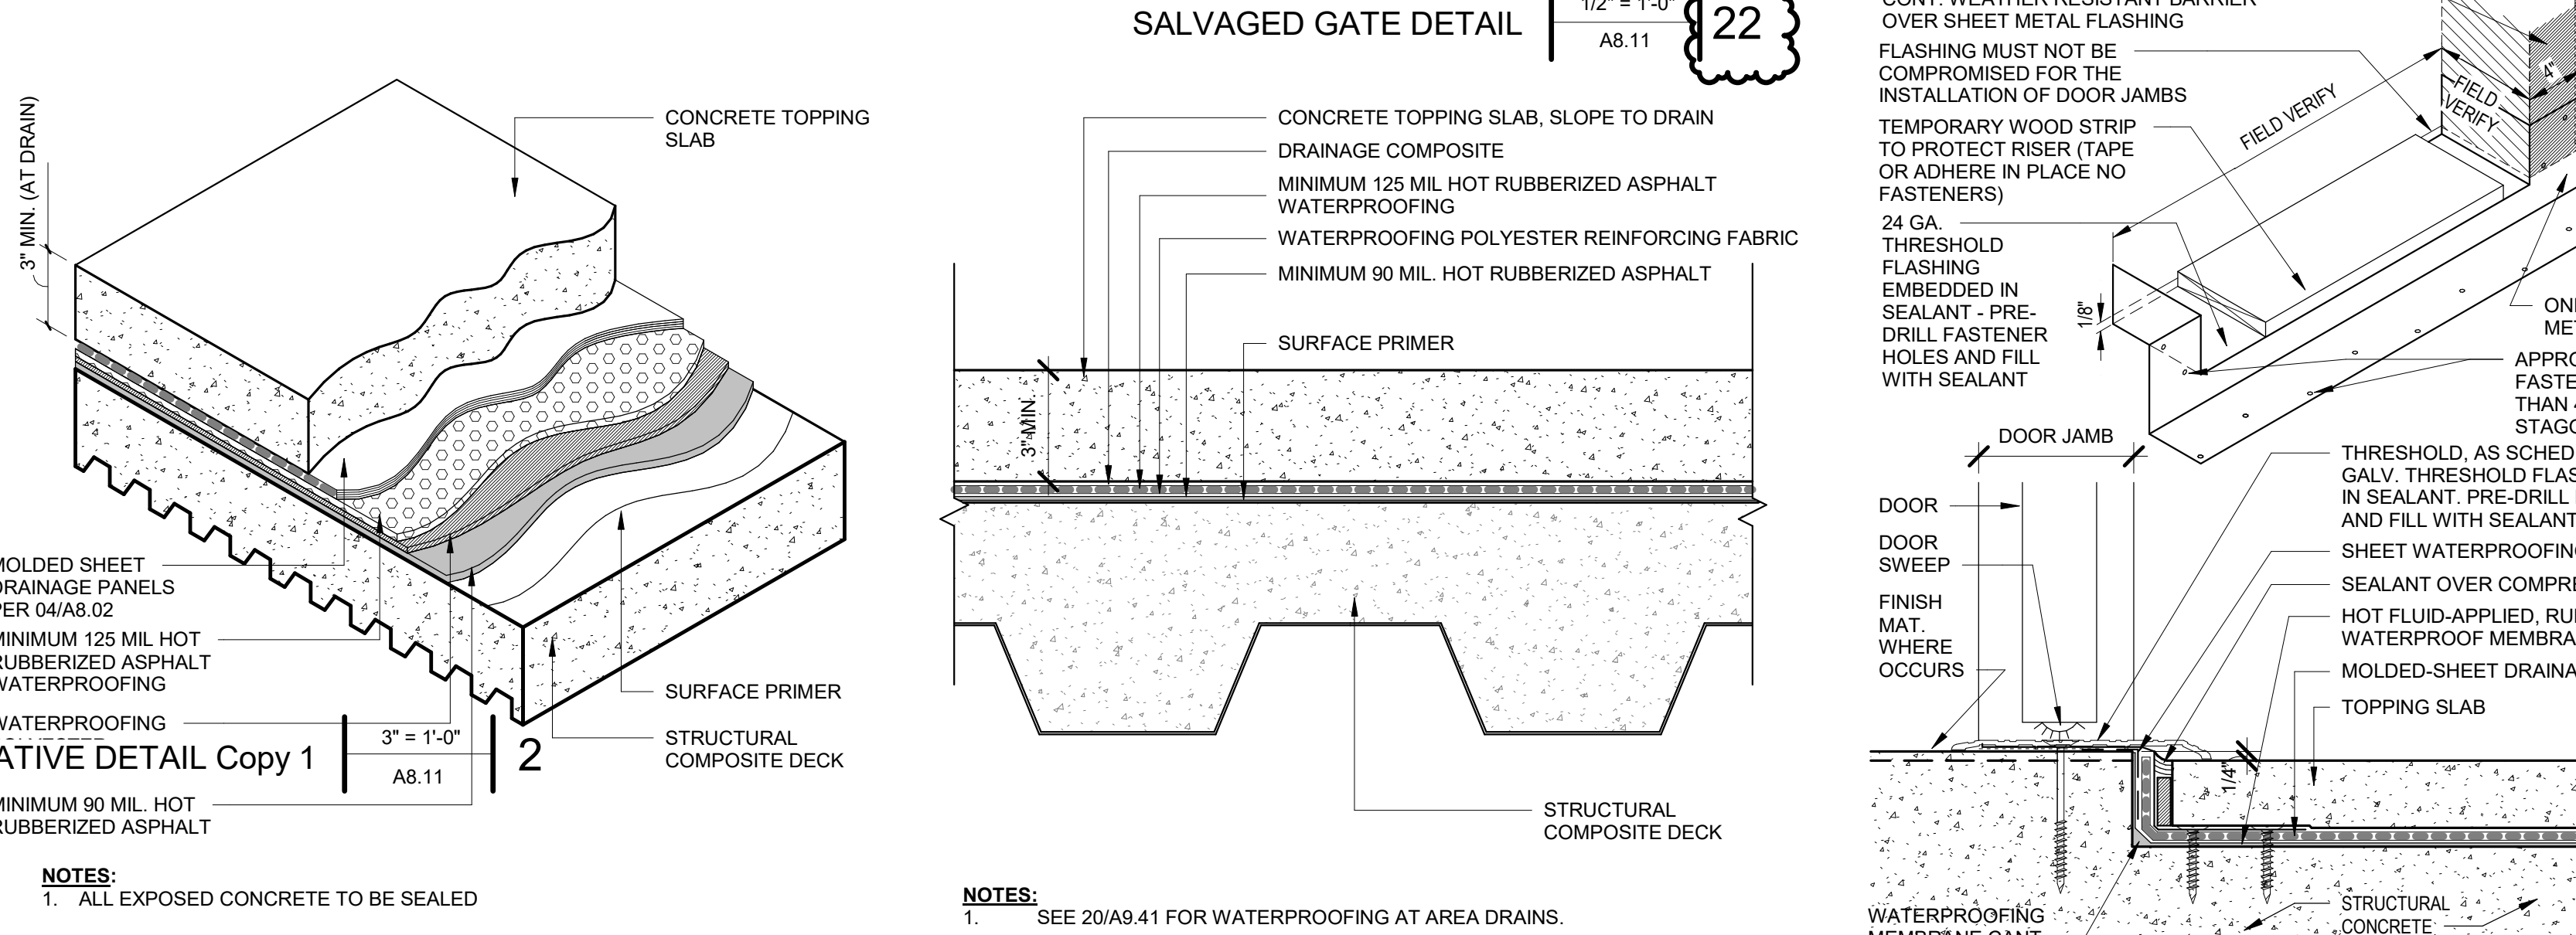


TOPPING SLAB AXON 21


TS1 - TOPPING SLAB 17

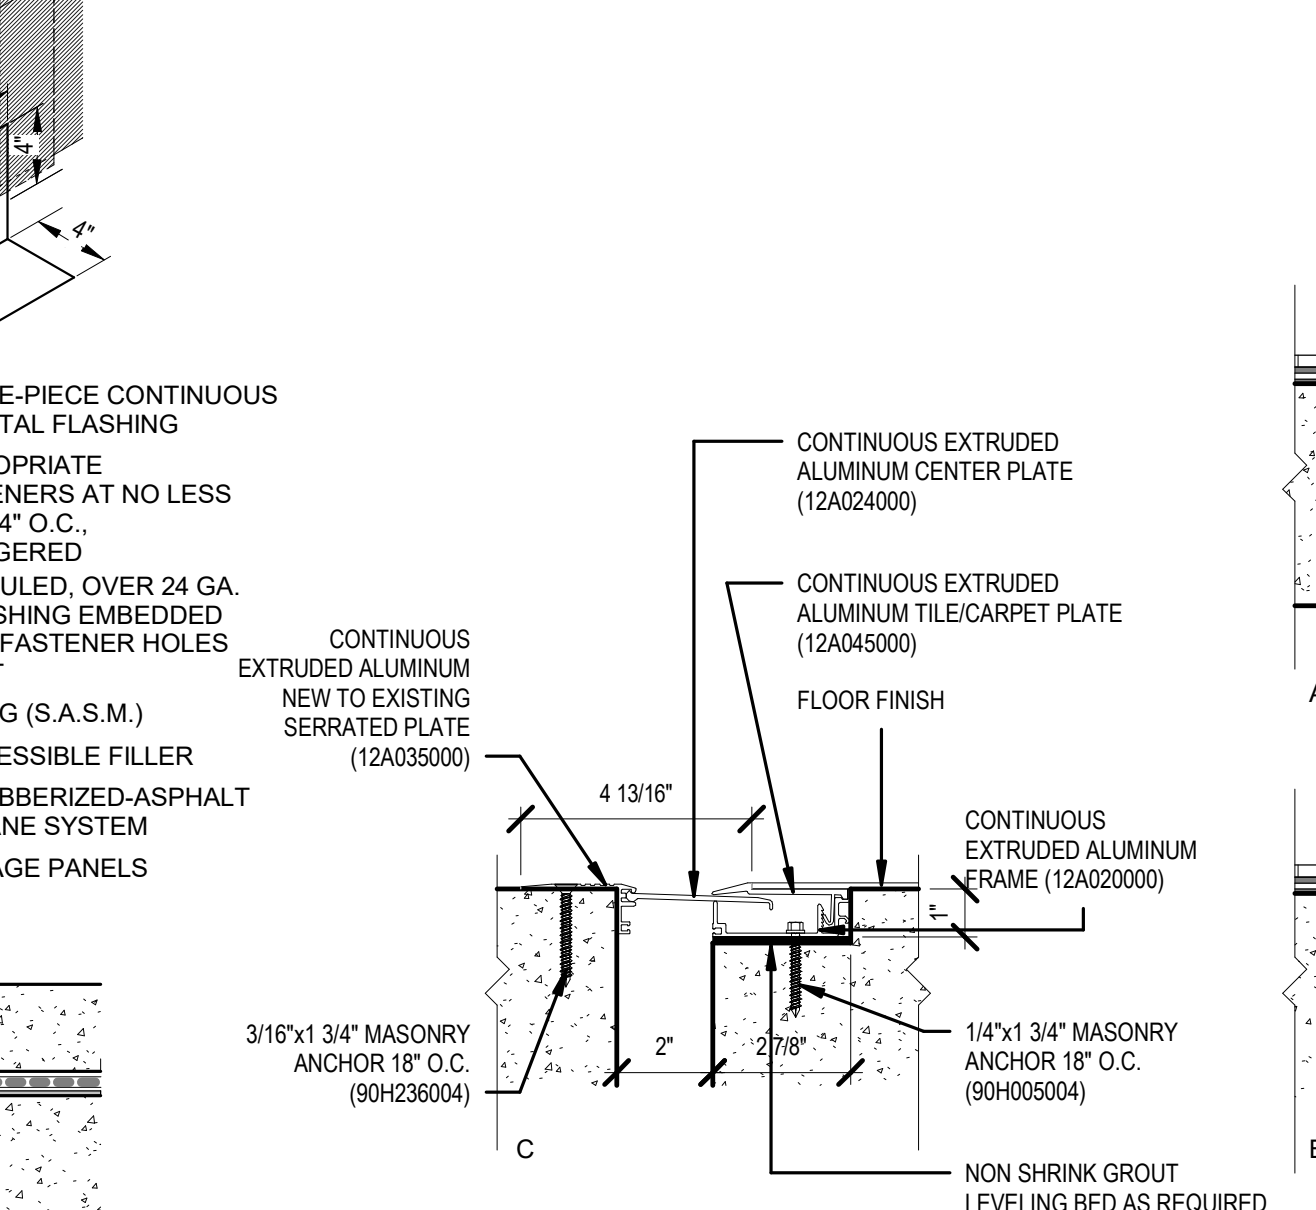


WATERPROOFING AT THRESHOLD 13

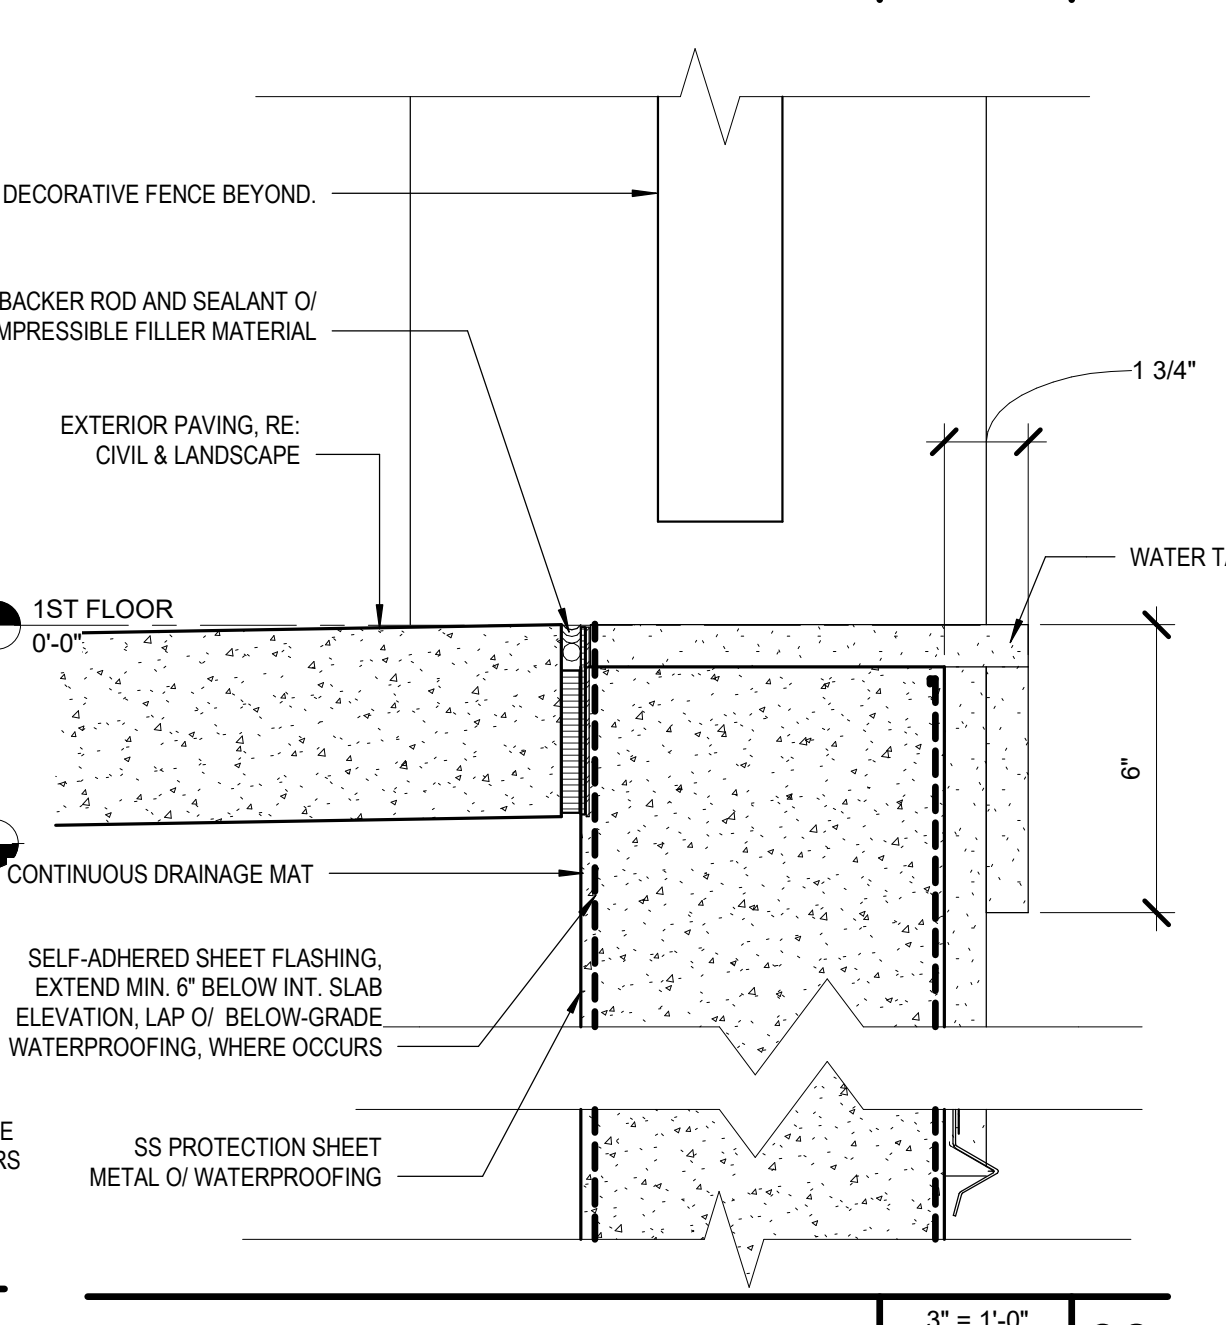

WATER TABLE DETAIL 06

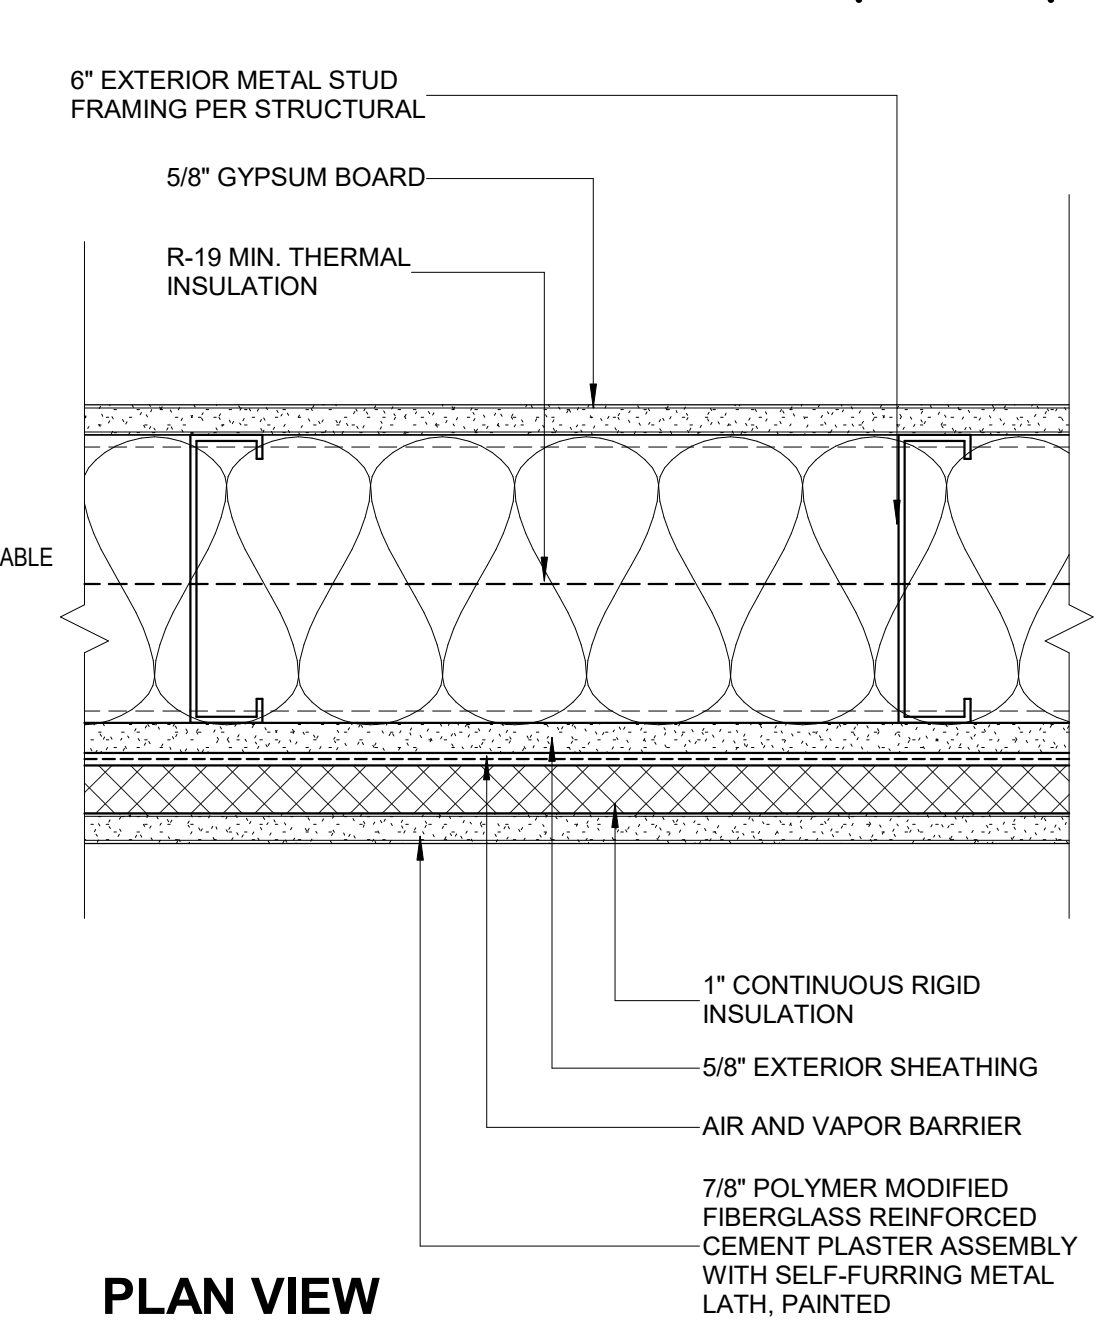


SECTION VIEW

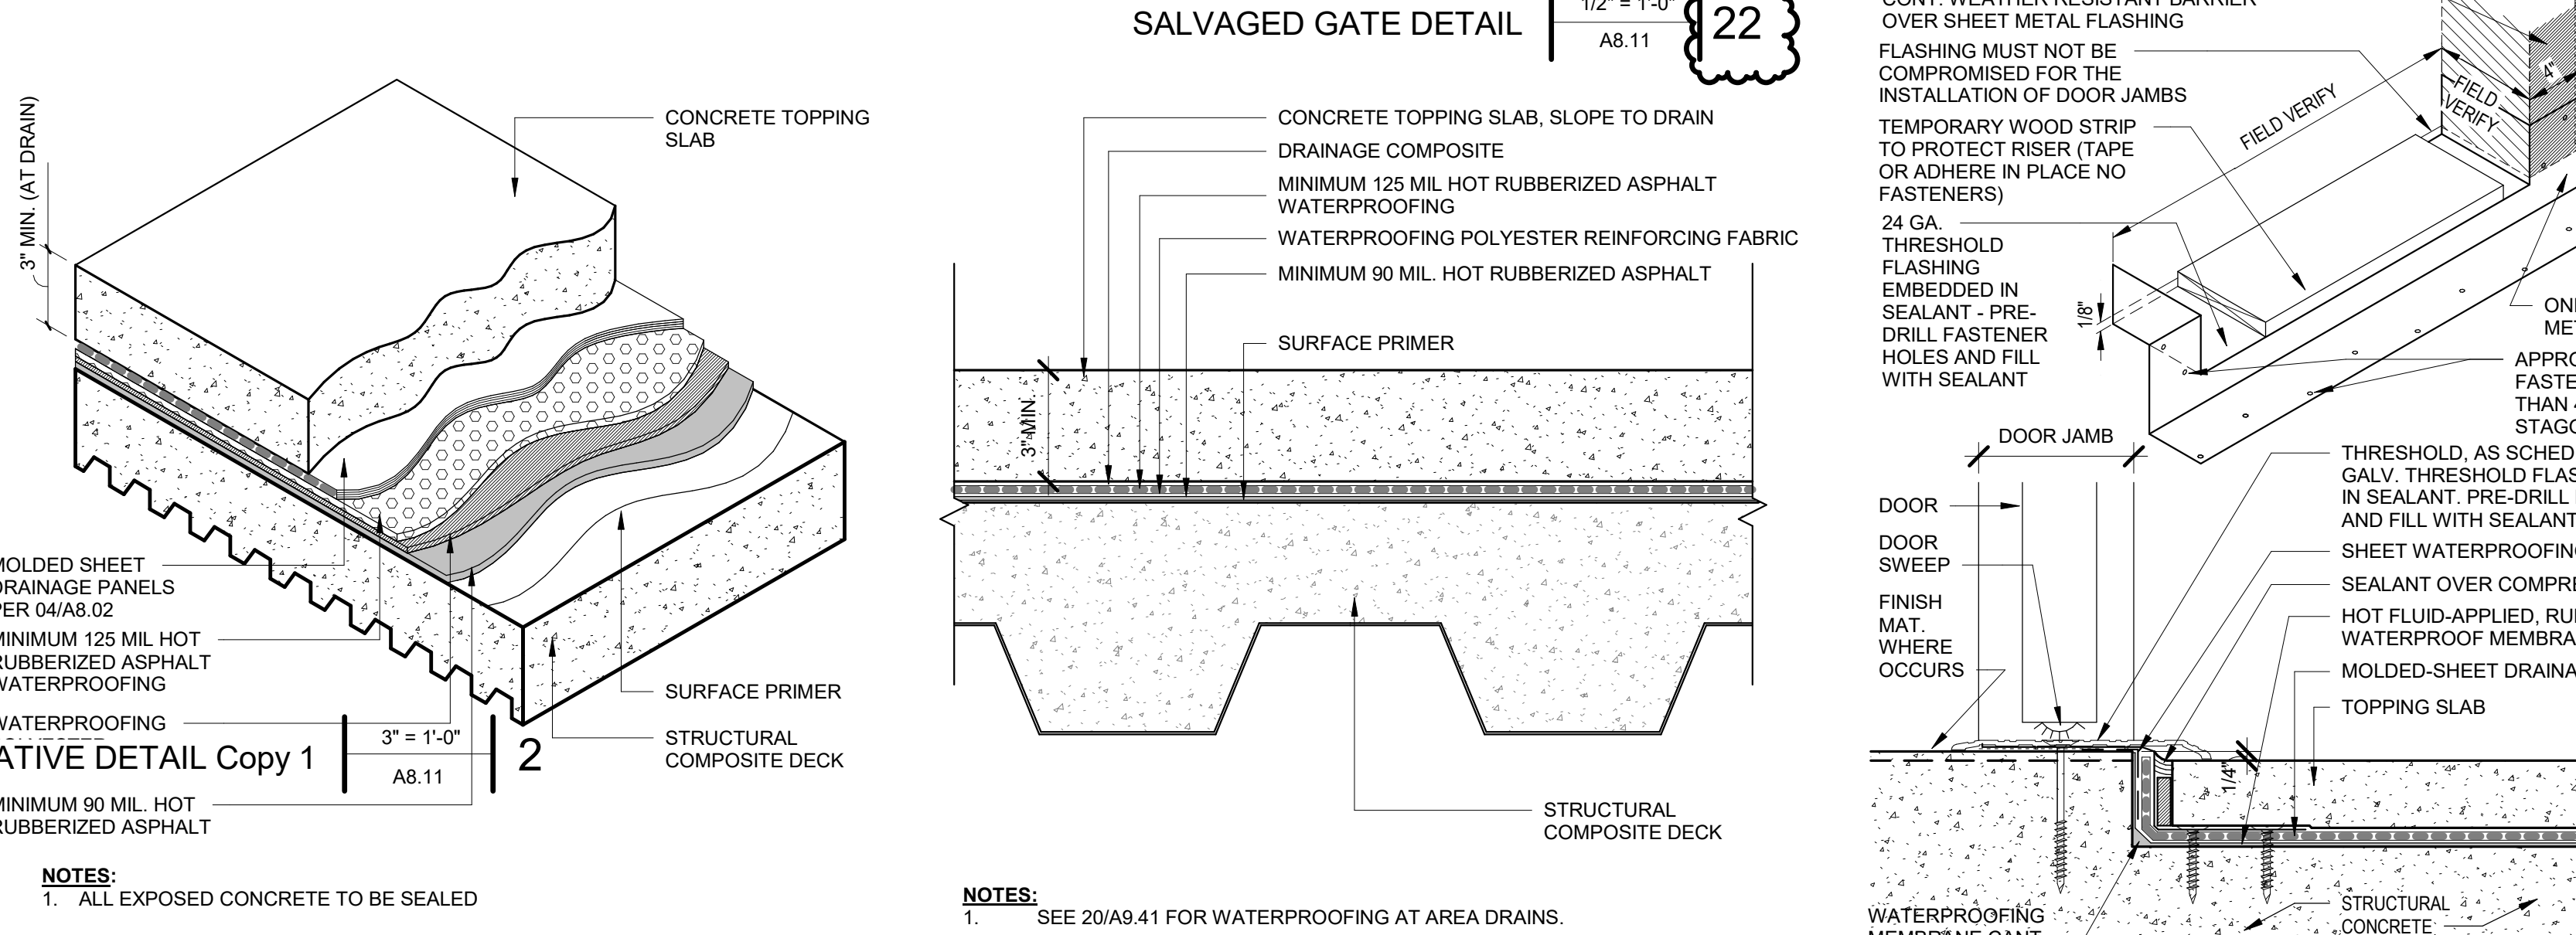




TOPPING SLAB AXON 21

TS1 - TOPPING SLAB 17

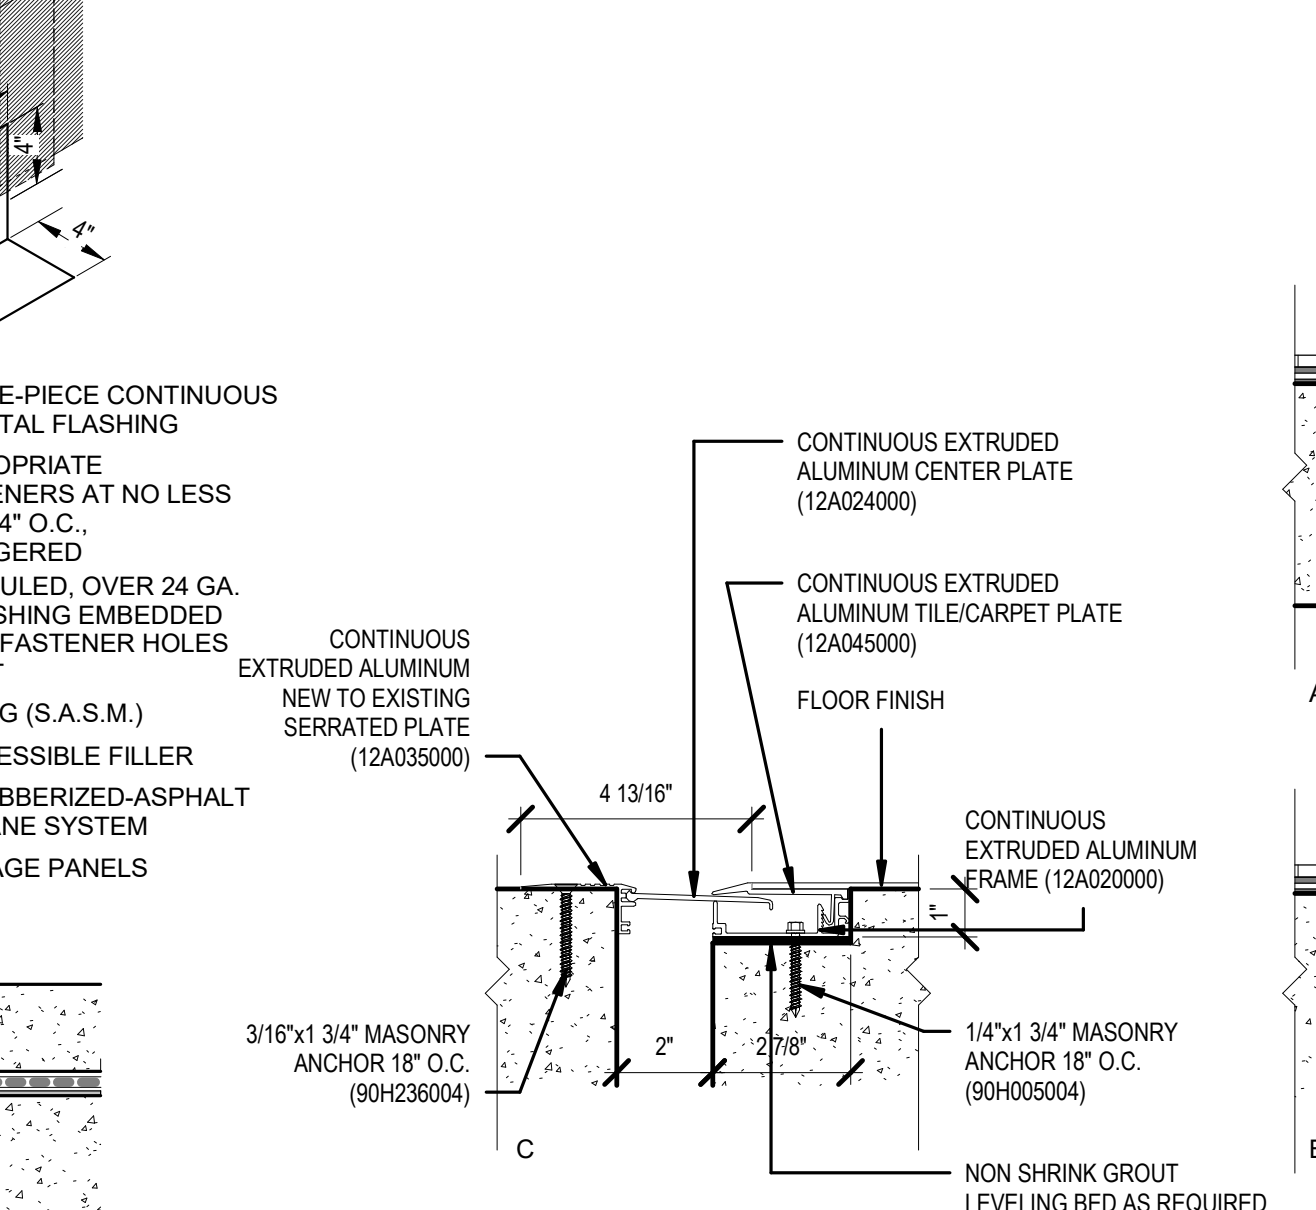


WATERPROOFING AT THRESHOLD 13

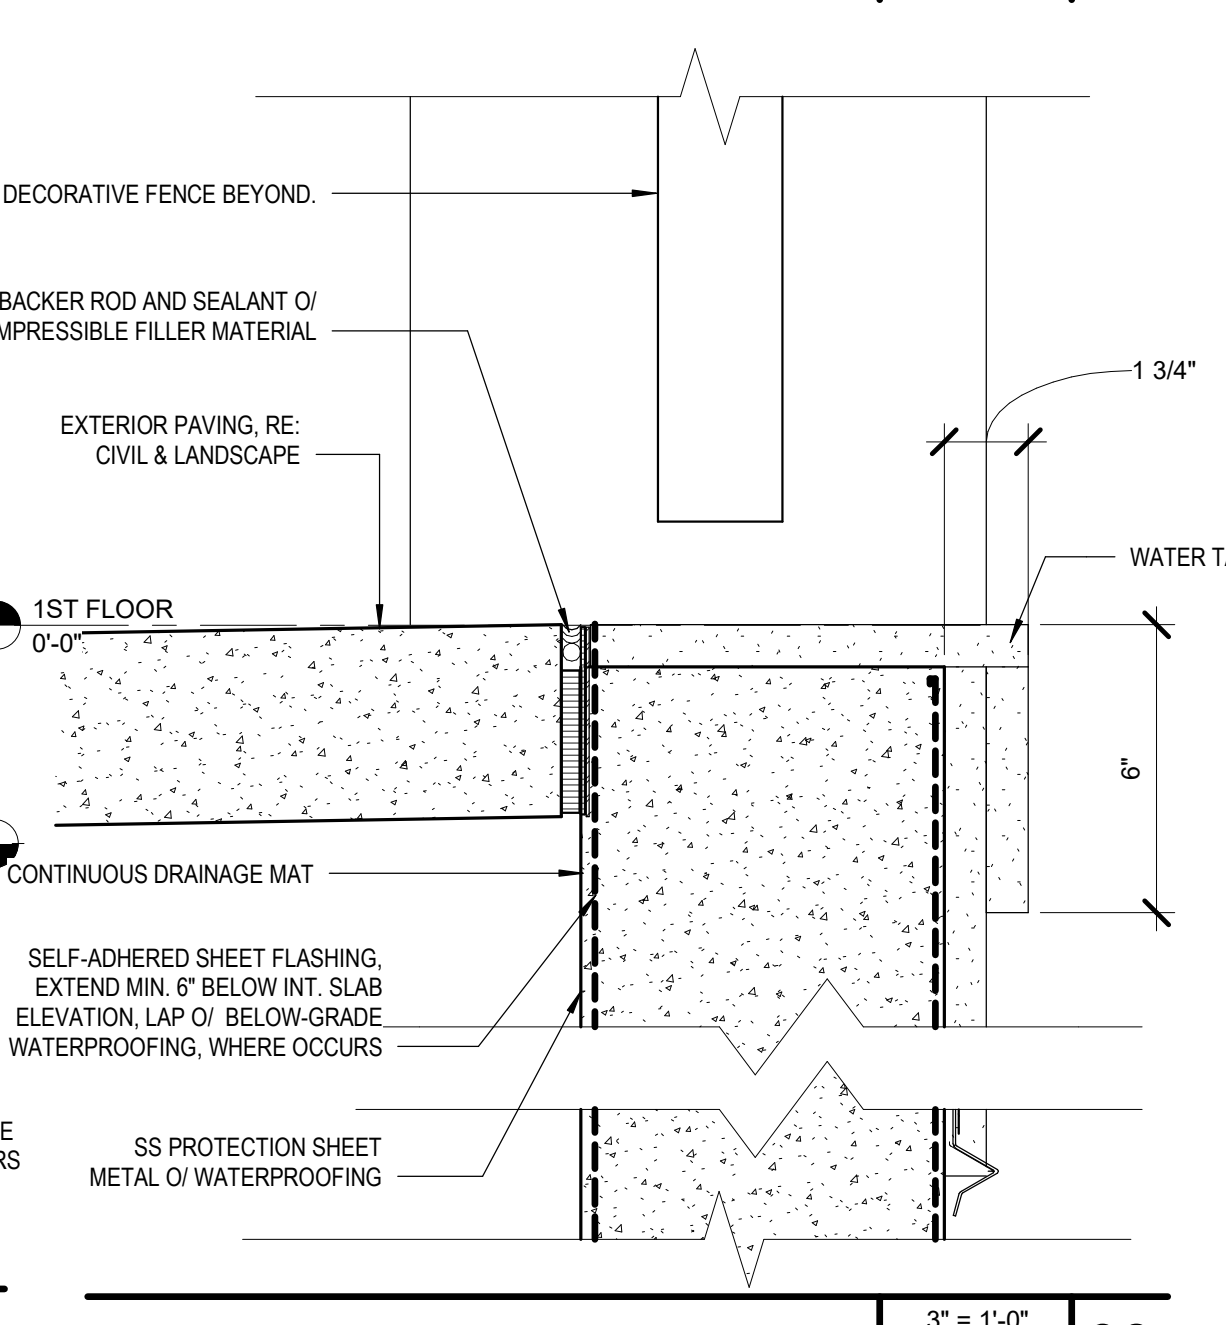

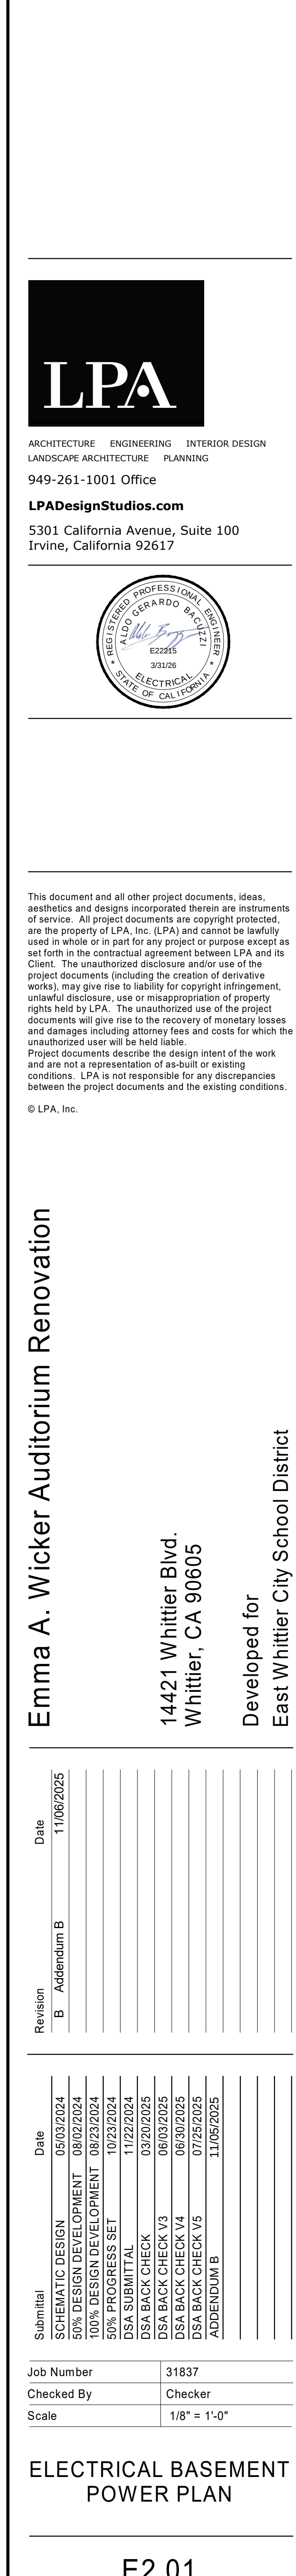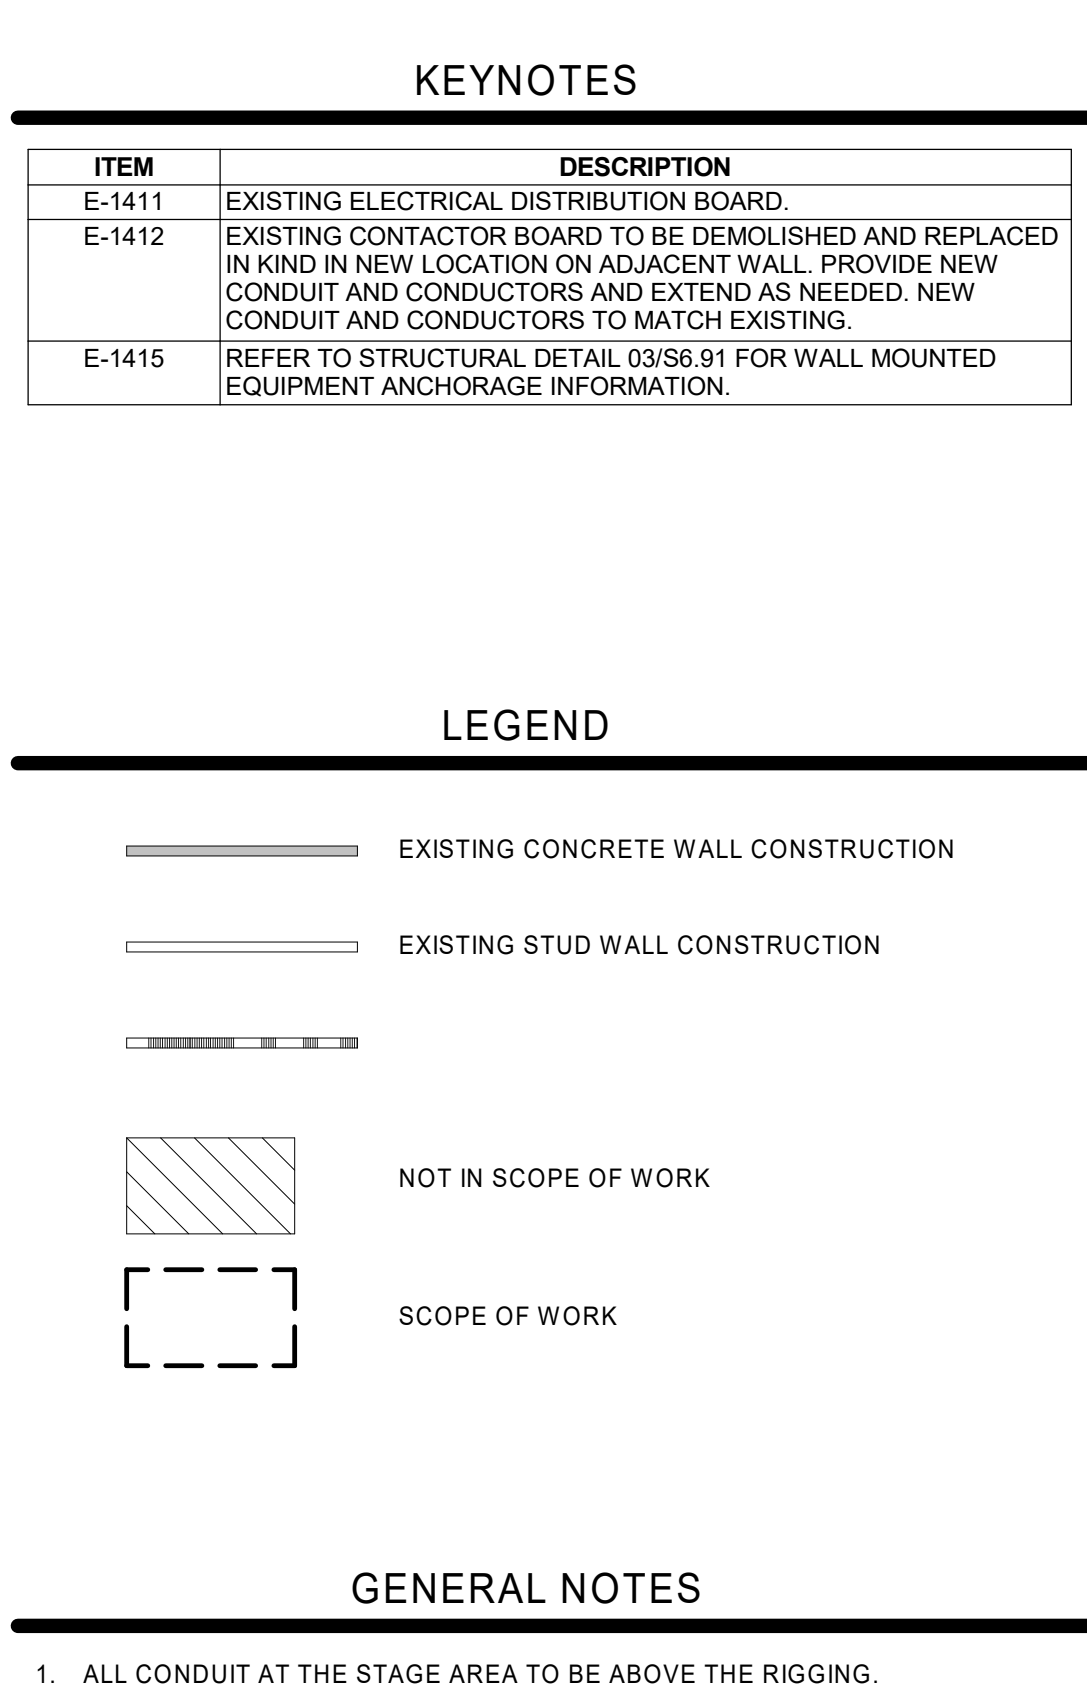

FEEDER SIZING NOTES

1. CONDUCTOR AND CONDUIT SIZE SHOWN IN THIS SCHEDULE ARE BASED ON COPPER WIRE AND INSULATION TYPE (THHN/THWN) AT ONE HUNDRED (100') FEEDER LENGTH.
2. "4" IN FEEDER TAGS SHOWN ON PLANS INDICATES A FEEDER UPSIZED DUE TO VOLTAGE DROP.
3. CONDUIT SIZES CALLED OUT ON PLANS SUPERSEDE THIS SCHEDULE.
4. "S" INDICATES A FEEDER COMING FROM A SEPARATELY DERIVED SYSTEM.
5. NOMINAL AMPERAGES GREATER THAN 100 AMPS ARE FOR 75 DEG. C TERMINALS.
6. FEEDERS CONNECTED TO THE SECONDARY OF A K-4 OR HIGHER XFMR SHALL HAVE OVERSIZED NEUTRAL (200% MIN.)
7. FEEDERS CONNECTED TO AN EMERGENCY INVERTER OR PV SHALL BE RATED AT 90 DEG. C.
8. FEEDERS WITH AN AMPACITY > 400A SHALL BE PROVIDED WITH A SPARE CONDUIT OF EQUIVALENT SIZE AND TYPE - AS NOTED.
9. NOT ALL SIZES USED.

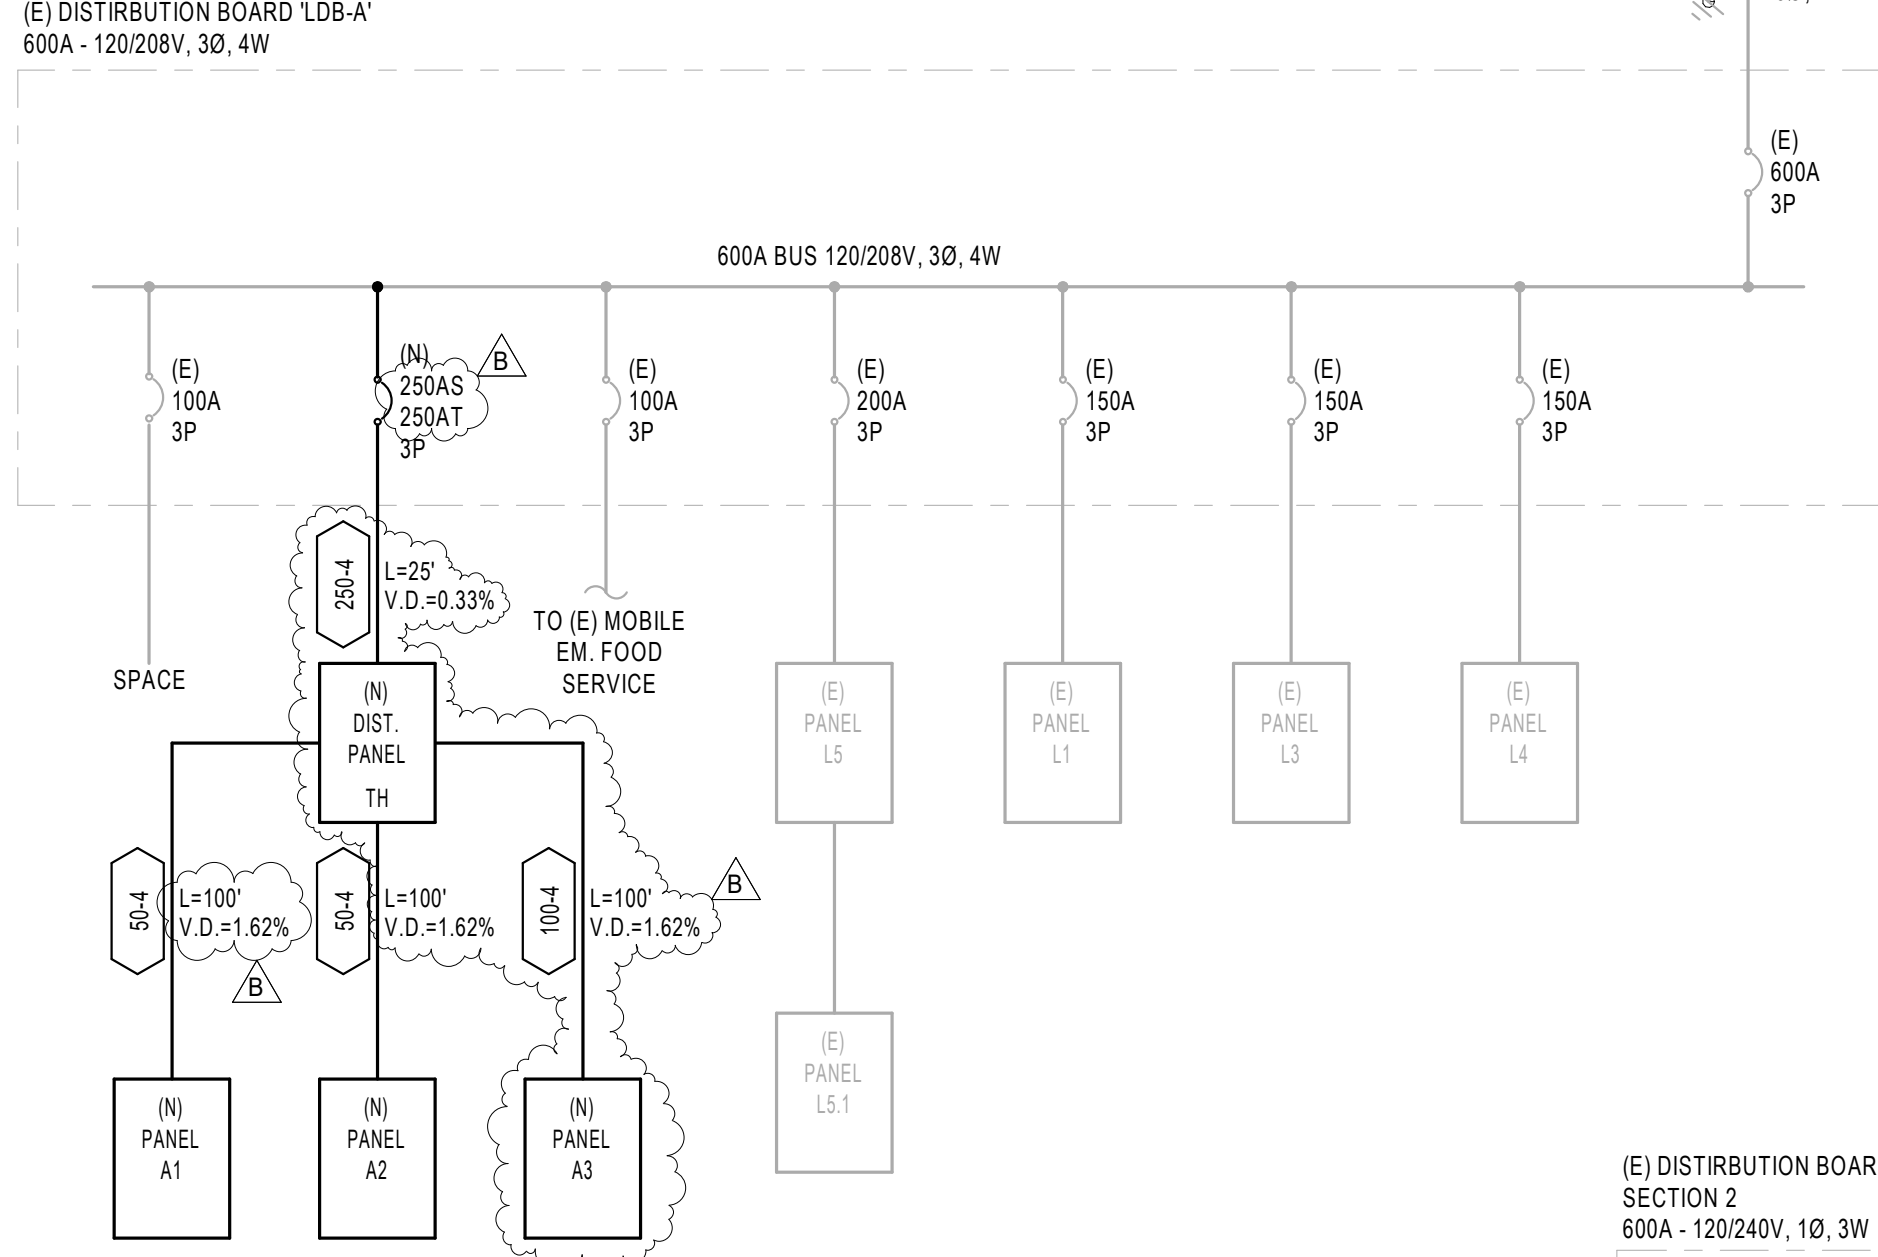

GENERAL NOTES

1. ALL EQUIPMENT TO BE SQUARE D OR EQUAL BY SIEMENS, CUTLER-HAMMER, G.E. OR RSC-SIERRA.
2. ALL ELECTRICAL EQUIPMENT SHALL BE PROVIDED WITH SPECIFIED AND APPROPRIATE UL LISTING BASED ON THE ENVIRONMENT IN WHICH THE EQUIPMENT IS TO BE MOUNTED.
3. ALL ELECTRICAL EQUIPMENT SHALL BE PROVIDED WITH AND BRACED FOR REQUIRED FAULT CURRENT RATINGS BASED ON THEIR VOLTAGE AND LOCATION WITHIN THE SYSTEM. SHOP DRAWINGS TO INCLUDE FAULT CURRENT RATINGS FOR ALL ELECTRICAL EQUIPMENT. ALL EQUIPMENT SHALL BE FULLY RATED, NO SERIES RATING SHALL BE ALLOWED.
4. ALL TERMINATIONS AND ENCLOSURES SHALL BE RATED FOR USE WITH 75 DEGREES CELSIUS CONDUCTORS.
5. ALL SERVICE ENTRANCE EQUIPMENT/DISTRIBUTION BOARDS/SWITCHBOARDS RATED AT 600A OR GREATER SHALL BE PROVIDED WITH A SOLID STATE MAIN OVER-CURRENT PROTECTIVE DEVICE AND BUSBING RATED AT 100% OPERATION.
6. ALL SWITCH/DISTRIBUTION BOARDS SHALL BE PROVIDED WITH:

11. FEEDER SPECIFICATIONS ARE BASED ON USE OF COPPER CONDUCTORS AND SHALL BE PROVIDED WITH A CODE SIZED COPPER GROUNDING CONDUCTOR.
12. ALL MAIN SWITCHBOARDS, PANELBOARDS, DISTRIBUTION BOARDS, ETC SHALL BE PROVIDED WITH A COPPER BUS RATED AT SPECIFIED AMPS. ALL SWITCHBOARDS AND DISTRIBUTION BOARDS SHALL ALIGN IN FRONT OF THE MAIN PANELBOARDS. ALL MAIN PANELBOARDS SHALL BE PROVIDED DEADFRONT COVERS WITH LOCKABLE DOORS, FACTORY INSTALLED MAIN CIRCUIT BREAKERS (IF APPLICABLE), AND PANEL DIRECTORY PER THESE DOCUMENTS.
13. TRANSIENT VOLTAGE SURGE PROTECTION SHALL BE PROVIDED IN ALL MAIN SWITCHCHARGER AND DISTRIBUTION BOARD UNLESS OTHERWISE NOTED OR IDENTIFIED ON DRAWINGS. COORDINATE WITH LOCAL UTILITY COMPANY.
14. ALL PANELBOARDS INSTALLED IN GARAGES OR AREAS COMPLYING WITH ARTICLE 500, 511, AND/OR 514 SHALL BE INSTALLED 18" ABOVE FLOOR LINE TO TOP OF PANEL. ALL PANELS SHALL BE INSTALLED 18" ABOVE FLOOR LINE WITH TOP MOST BREAKER NO HIGHER THAN 6'-7" A.F.F. PER ARTICLE 380.
15. ALL ELECTRICAL EQUIPMENT (IE, SWITCHCHARGER, TRANSFORMERS, DISTRIBUTION BOARDS, PANELBOARDS, DISCONNECT SWITCHES, ETC.) SHALL BE PROVIDED WITH IDENTIFICATION TAGS WITH ENGRAVED WITH LETTERS FOLLOWING FOLLOWING INFORMATION:

This document all of our project documents, ideas, aesthetics and designs incorporated therein are instruments of service. All project documents are copyright protected, and are the property of LPA, Inc. (LPA) and cannot be lawfully used in whole or in part for any project or purpose except as set forth in the contractual agreement between LPA and its Client. The unauthorized disclosure and/or use of the project documents (including the creation of derivative works) without the express written consent of LPA constitutes unlawful disclosure, use or misappropriation of property rights held by LPA. The unauthorized use of the project documents will give rise to the recovery of monetary losses and damages including attorney fees and costs for which the user will be held liable. LPA shall not be responsible for the Project documents describe the design intent of the work and are not a representation of as-built or existing conditions. LPA is not responsible for any discrepancies between the project documents and the existing conditions.

[illegible]

ELECTRICAL SINGLE LINE DIAGRAM

Branch Panel: A3

Location: STAGE 134

Supply From: DP-TH

Mounting: SURFACE

Enclosure: NEMA 1

Volts: 120/208V

Phases: 3

Wires: 4

A.I.C. Rating: 65kAIC

Mains Type: MCB

Mains Rating: 100 A

MCB Rating: 100 A

Notes:

CKT	Circuit Description	Trip	Poles	A	B	C	Poles	Trip	Circuit Description	CKT	
1	THEATER DMX RELAYS	20 A	1	252 VA	252 VA		1	20 A	THEATER DMX RELAYS	2	
3	THEATER DMX RELAYS	20 A	1		252 VA	252 VA		1	20 A	THEATER DMX RELAYS	4
5	THEATER DMX RELAYS	20 A	1						20 A	THEATER DMX RELAYS	6
7	THEATER DMX RELAYS	20 A	1	252 VA	252 VA		1	20 A	THEATER DMX RELAYS	8	
9	THEATER DMX RELAYS	20 A	1		252 VA	252 VA		1	20 A	THEATER DMX RELAYS	10
11	THEATER DMX RELAYS	20 A	1			252 VA	252 VA	1	20 A	THEATER DMX RELAYS	12
13	THEATER DMX RELAYS	20 A	1	252 VA	252 VA			1	20 A	THEATER DMX RELAYS	14
15	THEATER DMX RELAYS	20 A	1		252 VA	252 VA		1	20 A	THEATER DMX RELAYS	16
17	THEATER DMX RELAYS	20 A	1			252 VA	252 VA	1	20 A	THEATER DMX RELAYS	18
19	THEATER DMX RELAYS	20 A	1	252 VA	252 VA			1	20 A	THEATER DMX RELAYS	20
21	THEATER DMX RELAYS	20 A	1		252 VA	252 VA		1	20 A	THEATER DMX RELAYS	22
23	THEATER DMX RELAYS	20 A	1			252 VA	252 VA	1	20 A	THEATER DMX RELAYS	24
25	THEATER DMX RELAYS	20 A	1	252 VA	252 VA			1	20 A	THEATER DMX RELAYS	26
27	THEATER DMX RELAYS	20 A	1		252 VA	252 VA		1	20 A	THEATER DMX RELAYS	28
29	THEATER DMX RELAYS	20 A	1		252 VA	252 VA		1	20 A	THEATER DMX RELAYS	30
31	THEATER DMX RELAYS	20 A	1	252 VA	252 VA			1	20 A	THEATER DMX RELAYS	32
33	THEATER DMX RELAYS	20 A	1		252 VA	252 VA		1	20 A	THEATER DMX RELAYS	34
35	THEATER DMX RELAYS	20 A	1			252 VA	252 VA	1	20 A	THEATER DMX RELAYS	36
37	THEATER DMX RELAYS	20 A	1	252 VA	252 VA			1	20 A	THEATER DMX RELAYS	38
39	THEATER DMX RELAYS	20 A	1		252 VA	252 VA		1	20 A	THEATER DMX RELAYS	40
41	THEATER DMX RELAYS	20 A	1			252 VA	252 VA	1	20 A	THEATER DMX RELAYS	42
43	THEATER DMX RELAYS	20 A	1	252 VA	252 VA			1	20 A	THEATER DMX RELAYS	44
45	THEATER DMX RELAYS	20 A	1		252 VA	252 VA		1	20 A	THEATER DMX RELAYS	46
47	THEATER DMX RELAYS	20 A	1			252 VA	252 VA	1	20 A	THEATER DMX RELAYS	48
Total...				4032 VA	4032 VA	4032 VA					
Total...				34 A	34 A	34 A					

Legend:

Load Classification	Connected Load	Demand Factor	Estimated...	Panel Totals
CONTINUOUS LOADS	0 VA	0.00%	0 VA	Total Conn. Load: 12096 VA
KITCHEN LOADS	0 VA	0.00%	0 VA	Total Est. Demand: 15120 VA
LIGHTING LOADS	12096 VA	125.00%	15120 VA	Total Conn. Current: 34 A
MOTOR LOADS	0 VA	0.00%	0 VA	Total Est. Demand... 42 A
NON CONTINUOUS LOADS	0 VA	0.00%	0 VA	
RECEPTACLE LOADS	0 VA	0.00%	0 VA	

Notes:

Branch Panel: A2

Location: STAGE 134

Supply From: DP-TH

Mounting: SURFACE

Enclosure: NEMA 1

Volts: 120/208V

Phases: 3

Wires: 4

A.I.C. Rating: 10kAIC

Mains Type: MCB

Mains Rating: 50 A

MCB Rating: 50 A

Notes:

CKT	CIRCUIT DESCRIPTION	TRIP	P	A	B	C	P	TRIP	CIRCUIT DESCRIPTION	CKT	
1	GENERAL AV RECEPT. STAGE 134	20 A	1	360 VA	360 VA		1	20 A	GENERAL AV RECEPT. STAGE 134	2	
3	GENERAL AV RECEPT. STAGE 134	20 A	1		360 VA	360 VA		1	20 A	GENERAL AV RECEPT. STAGE 134	4
5	GEN. AV RECEPT. SOUND MIX BOOTH	20 A	1			360 VA	180 VA	1	20 A	GEN. AV RECEPT. SOUND MIX BOOTH	6
7	GEN. AV RECEPT. SOUND MIX BOOTH	20 A	1	360 VA	180 VA			1	20 A	GEN. AV RECEPT. SOUND MIX BOOTH	8
9	GEN. AV RECEPT. SOUND MIX BOOTH	20 A	1		360 VA	1200 VA		1	20 A	RECEPT. INTERCOMPAGING RM. 108	10
11	AV RACK STAGE 134	20 A	1			1200 VA	1200 VA	1	20 A	RECEPT. INTRUSION RM. 108	12
13	AV RACK STAGE 134	20 A	1	1200 VA	1200 VA			1	20 A	RECEPTACLE IDF CABINET RM. 108	14
15	AV RACK STAGE 134	20 A	1		1200 VA	0 VA		1	20 A	Spare	16
17	AV RACK STAGE 134	20 A	1			1200 VA	0 VA	1	20 A	Spare	18
19	Spare	20 A	1	0 VA	0 VA			1	20 A	Spare	20
21	Spare	20 A	1		0 VA	0 VA		1	20 A	Spare	22
23	Spare	20 A	1			0 VA	--	1	--	Space	24
25	Space	--	1	--	--			1	--	Space	26
27	Space	--	1		--	--		1	--	Space	28
29	Space	--	1			--	--	1	--	Space	30
Total...				3690 VA	3480 VA	4140 VA					
Total...				31 A	29 A	35 A					

LEGEND:

LOAD CLASSIFICATION	CONNECTED...	DEMAND...	ESTIMATED...	PANEL TOTALS
CONTINUOUS LOADS	0 VA	0.00%	0 VA	TOTAL CONN. LOAD: 11280 VA
KITCHEN LOADS	0 VA	0.00%	0 VA	TOTAL EST. DEMAND 10640 VA
LIGHTING LOADS	0 VA	0.00%	0 VA	TOTAL CONN.... 31 A
MOTOR LOADS	0 VA	0.00%	0 VA	TOTAL EST. DEMAN... 30 A
NON CONTINUOUS LOADS	0 VA	0.00%	0 VA	
RECEPTACLE LOADS	11280 VA	94.33%	10640 VA	

Notes:

Branch Panel: L1

Location: STAGE 134

Supply From: (E) DIST. BD. SEC. 2

Mounting: SURFACE

Enclosure: NEMA 1

Volts: 120/208V

Phases: 3

Wires: 4

A.I.C. Rating: 14kAIC

Mains Type: MCB

Mains Rating: 50 A

MCB Rating: 50 A

Notes:

CKT	Circuit Description	Trip	Poles	A	B	C	Poles	Trip	Circuit Description	CKT	
1	STAGE LIGHTING	20 A	1	346 VA	0 VA		1	20 A	Spare	2	
3	AUDITORIUM SEAT LIGHTING	20 A	1		1362...	0 VA		1	20 A	Spare	4
5	AUDITORIUM SEAT LIGHTING	20 A	1			1362...	0 VA	1	20 A	Spare	6
7	AUDITORIUM SEAT LIGHTING	20 A	1	754 VA	0 VA			1	20 A	Spare	8
9	EXTERIOR ARCADE & BLDG...	20 A	1		270 VA	0 VA		1	20 A	Spare	10
11	RESTROOM LIGHTING RM. 11...	20 A	1			301 VA	--	1	--	Space	12
13	INV-A	30 A	1	2392...	--			1	--	Space	14
15	Spare	20 A	1		0 VA	--		1	--	Space	16
17	Space	--	1			--	--	1	--	Space	18
Total...				3492 VA	1632 VA	1663 VA					
Total...				29 A	14 A	14 A					

Legend:

Load Classification	Connected Load	Demand Factor	Estimated...	Panel Totals
CONTINUOUS LOADS	0 VA	0.00%	0 VA	Total Conn. Load: 6787 VA
KITCHEN LOADS	0 VA	0.00%	0 VA	Total Est. Demand: 8483 VA
LIGHTING LOADS	6787 VA	125.00%	8483 VA	Total Conn. Current: 19 A
MOTOR LOADS	0 VA	0.00%	0 VA	Total Est. Demand... 24 A
NON CONTINUOUS LOADS	0 VA	0.00%	0 VA	
RECEPTACLE LOADS	0 VA	0.00%	0 VA	

Notes:

Branch Panel: DP-TH

Location: THEATER BASEMENT

Supply From: LDB-A

Mounting: SURFACE

Enclosure: NEMA 1

Volts: 120/208V

Phases: 3

Wires: 4

A.I.C. Rating: 65kAIC

Mains Type: MCB

Mains Rating: 250 A

MCB Rating: 250 A

NOTES:

CKT	CIRCUIT DESCRIPTION	TRIP	P	A	B	C	P	TRIP	CIRCUIT DESCRIPTION	CKT	
1	PANEL "A1" (GENERAL POWER)	50 A	3	4720 VA	3660 VA		3	50 A	PANEL "A2" (AV POWER)	2	
3		--	--		3200 VA	5480 VA		--	--	4	
5		--	--			3460 VA	4140 VA	--	--	6	
7	PANEL "A3" (T-MBP POWER)	100 A	3	4032 VA	1801 VA		3	20 A	FOH WINCH CONTROL DISCONNECT	8	
9		--	--		4032 VA	1801 VA		--	--	10	
11		--	--			4032 VA	1801 VA	--	--	12	
13	FOH WINCH CONTROL DISCONNECT	25 A	3	2401 VA	3603 VA		3	40 A	PROJECTOR POWER RM. 104	14	
15		--	--		2401 VA	3603 VA		--	--	16	
17		--	--			2401 VA	3603 VA	--	--	18	
19	COMPANY SWITCH	60 A	3	3528 VA	--			1	--	Space	20
21		--	--		3528 VA	--		1	--	Space	22
23		--	--			3528 VA	--	1	--	Space	24
25	Space	--	1	--	--			1	--	Space	26
27	Space	--	1		--	--		1	--	Space	28
29	Space	--	1			--	--	1	--	Space	30
Total...				23745 VA	22045 VA	22965 VA					
Total...				199 A	184 A	193 A					

LEGEND:

LOAD CLASSIFICATION	CONNECTED...	DEMAND...	ESTIMATED...	PANEL TOTALS
CONTINUOUS LOADS	10984 VA	125.00%	13730 VA	TOTAL CONN. LOAD: 68755 VA
KITCHEN LOADS	0 VA	0.00%	0 VA	TOTAL EST. DEMAND 69495 VA
LIGHTING LOADS	12096 VA	125.00%	15120 VA	TOTAL CONN. Current: 191 A
MOTOR LOADS	25615 VA	100.00%	25615 VA	TOTAL EST. DEMAN... 193 A
NON CONTINUOUS LOADS	0 VA	0.00%	0 VA	
RECEPTACLE LOADS	20060 VA	74.93%	15030 VA	

NOTES:

Branch Panel: A1

Location: STAGE 134

Supply From: DP-TH

Mounting: SURFACE

Enclosure: NEMA 1

Volts: 120/208V

Phases: 3

Wires: 4

A.I.C. Rating: 10kAIC

Mains Type: MCB

Mains Rating: 50 A

MCB Rating: 50 A

NOTES:

CKT	CIRCUIT DESCRIPTION	TRIP	P	A	B	C	P	TRIP	CIRCUIT DESCRIPTION	CKT	
1	GENERAL RECEPTACLE STAGE 134	20 A	1	360 VA	360 VA		1	20 A	GENERAL RECEPTACLE STAGE 134	2	
3	GENERAL RECEPTACLE STAGE 134	20 A	1		360 VA	360 VA		1	20 A	GENERAL RECEPTACLE STAGE 134	4
5	SCREEN CONTROL STAGE 134	20 A	1			800 VA	360 VA	1	20 A	GENERAL RECEPTACLE STAGE 134	6
7	GENERAL RECEPT. GREEN ROOM 129	20 A	1	360 VA	360 VA			1	20 A	GENERAL RECEPT. GREEN ROOM 129	8
9	GENERAL RECEPT. GREEN ROOM 129	20 A	1		360 VA	360 VA		1	20 A	GENERAL RECEPT. GREEN ROOM 129	10
11	GEN. RECEPT. AUDITORIUM 135	20 A	1			180 VA	180 VA	1	20 A	GEN. RECEPT. AUDITORIUM 135	12
13	GEN. RECEPT. AUDITORIUM 135	20 A	1	180 VA	180 VA			1	20 A	GEN. RECEPT. AUDITORIUM 135	14
15	GEN. RECEPT. AUDITORIUM 135	20 A	1		180 VA	180 VA		1	20 A	GEN. RECEPT. AUDITORIUM 135	16
17	GEN. RECEPT. SOUND MIX BOOTH	20 A	1			360 VA	180 VA	1	20 A	GEN. RECEPT. AUDITORIUM 135	18
19	GEN. RECEPT. SOUND MIX BOOTH	20 A	1	360 VA	360 VA			1	20 A	RECEPTACLES RM. 117 & 118	20
21	LIGHTING CONTROL RACK STAGE 104	20 A	1		1200 VA	200 VA		1	20 A	FACE STORAGE 159 (A/E)	22
23	LIGHTING CONTROL RACK STAGE 104	20 A	1			1200 VA	200 VA	1	20 A	FAPS-I STORAGE 159 (A/E)	24
25	WHEELCHAIR LIFT DISCONNECT	25 A	1	2200 VA	0 VA			1	20 A	Spare	26
27	Spare	20 A	1		0 VA	0 VA		1	20 A	Spare	28
29	Space	--	1			--	--	1	--	Space	30
Total...				4720 VA	3200 VA	3460 VA					
Total...				40 A	27 A	29 A					

LEGEND:

LOAD CLASSIFICATION	CONNECTED...	DEMAND...	ESTIMATED...	PANEL TOTALS
CONTINUOUS LOADS	400 VA	125.00%	500 VA	TOTAL CONN. LOAD: 11380 VA
KITCHEN LOADS	0 VA	0.00%	0 VA	TOTAL EST. DEMAND 11480 VA
LIGHTING LOADS	0 VA	0.00%	0 VA	TOTAL CONN.... 32 A
MOTOR LOADS	2200 VA	100.00%	2200 VA	TOTAL EST. DEMAN... 32 A
NON CONTINUOUS LOADS	0 VA	0.00%	0 VA	
RECEPTACLE LOADS	8780 VA	100.00%	8780 VA	

NOTES:

Branch Panel: L5

Location: (E) STORAGE 171

Supply From: LDB-A

Mounting: SURFACE

Enclosure: NEMA 1

Volts: 120/208V

Phases: 3

Wires: 4

A.I.C. Rating: 65kAIC

Mains Type: MLO

Mains Rating: 250 A

MCB Rating: 250 A

Notes:

CKT	Circuit Description	Trip	Poles	A	B	C	Poles	Trip	Circuit Description	CKT	
1	(E) FAU RM. 11	20 A	1	1332 VA	2170 VA		3	30 A	(E) PANEL LS.1	2	
3	(E) FAU RM. 12	20 A	1		1332 VA	2170 VA		--	--	4	
5	(E) FAU RM. 18	20 A	1			1332 VA	1970 VA	--	--	6	
7	(E) RECEPTACLE RM. 129	20 A	1	540 VA	360 VA		1	20 A	(E) RECEPTACLES	8	
9	(E) A/C RM. 16A	30 A	3		1518 VA	1932 VA		3	30 A	(E) A/C RM. 14	10
11		--	--			1518 VA	1932 VA	--	--	12	
13		--	--	1518 VA	1932 VA			--	--	14	
15	(E) A/C RM. 15	30 A	3		1932 VA	1932 VA		3	30 A	(E) A/C RM. 17A	16
17		--	--			1932 VA	1932 VA	--	--	18	
19		--	--	1932 VA	1932 VA			--	--	20	
21	(E) A/C RM. 12	30 A	3		1932 VA	1932 VA		3	30 A	(E) A/C RM. 13	22
23		--	--			1932 VA	1932 VA	--	--	24	
25		--	--	1932 VA	1932 VA			--	--	26	

FIRE ALARM PLAN REQUIREMENTS

1. ALL WALL-MOUNTED VISUAL SIGNALING APPLIANCES AND COMBINATION AUDIBLE/VISUAL SIGNALING APPLIANCES SHALL BE MOUNTED SUCH THAT THE ENTIRE LENS IS NOT LESS THEN 80 INCHES AND NO GREATER THEN 96 INCHES ABOVE THE FINISHED FLOOR. ALL WALL MOUNTED AUDIBLE SIGNALING APPLIANCES SHALL HAVE THEIR TOPS ABOVE FINISHED FLOOR AT HEIGHTS NOT LESS THEN 90 INCHES.
2. ALL EQUIPMENT SHALL BE U.L. AND C.S.F.M. LISTED.
3. ALL WIRING SHALL BE IN ACCORDANCE WITH THE C.E.C. AND AUTHORITIES HAVING JURISDICTION.
4. ALL JUNCTION BOXES AND CONDUITS SHALL BE SIZED IN ACCORDANCE WITH THE C.E.C. AND SHALL BE PAINTED RED WHERE APPLICABLE.
5. ELECTRICAL CONTRACTOR SHALL FURNISH ACCESS PANELS TO AREAS THAT REQUIRE SERVICING, TROUBLE SHOOTING, ETC.
6. DO NOT DEVIATE FROM CONDUIT RUNS AS SHOWN ON FLOOR PLANS WITHOUT PRIOR APPROVAL FROM ELECTRICAL ENGINEER. FACTORS SUCH AS EXCESSIVE VOLTAGE DROP, ADDITIONAL PARTS, ENGINEERING, ETC., THAT ARE A RESULT OF CONDUIT RUN DEVIATIONS SHALL BE THE SOLE RESPONSIBILITY OF THE ELECTRICAL CONTRACTOR.
7. DETECTORS SHALL NOT BE LOCATED IN A DIRECT AIR-FLOW, NOR CLOSER THEN 3 FEET (915mm) FROM AN AIR SUPPLY DIFFUSER.
8. ALL FAN SHUTDOWN FUNCTIONS, DAMPER CLOSURES AND ASSOCIATED MECHANICAL SYSTEM FIRE ALARM INTERFACE SHALL BE BY MECHANICAL CONTRACTOR, AND SHALL BE COORDINATED WITH FIRE ALARM SYSTEM.
9. ALL DUCT SMOKE DETECTORS SHALL BE MOUNTED BY THE MECHANICAL CONTRACTOR. DUCT SMOKE DETECTORS EXPOSED TO THE WEATHER SHALL BE C.S.F.M. LISTED FOR OUTDOOR INSTALLATION, AND WEATHER PROTECTED BY THE MECHANICAL CONTRACTOR. ALL AIR VELOCITY TESTING SHALL BE PERFORMED BY THE MECHANICAL CONTRACTOR.
10. ALL 120VAC POWER REQUIREMENTS FOR THE FIRE ALARM SYSTEM SHALL BE FURNISHED BY THE ELECTRICAL CONTRACTOR AND SHALL MEET ALL REQUIREMENTS OF THE AUTHORITIES HAVING JURISDICTION.
11. ALL FIRE ALARM DEVICE BACKBOXES, FIRE ALARM TERMINAL CABINETS, OUTTERS, JUNCTION BOXES, AND ASSOCIATED CONDUITS SHALL BE FURNISHED AND INSTALLED BY ELECTRICAL CONTRACTOR UNLESS OTHERWISE NOTED. REFER TO FIRE ALARM SYMBOL LIST AND/OR MOUNTING DETAILS FOR ADDITIONAL INFORMATION. SYSTEM SUPPLIER PROVIDED BACKBOXES SHALL BE INSTALLED BY ELECTRICAL CONTRACTOR UNLESS OTHERWISE NOTED. FIRE ALARM PANEL REMOTES AND COMPONENTS SHALL BE SECURED TO MOUNTING SURFACES PER MANUFACTURER'S SPECIFICATIONS. NO SINGLE DEVICE SHALL EXCEED THE WEIGHT OF 20 LBS. WITHOUT SPECIAL MOUNTING DETAILS.
12. SMOKE DETECTOR TESTING SHALL BE CONDUCTED IN ACCORDANCE WITH NFPA 72, ALL APPLICABLE CODES AND THE MANUFACTURER'S INSTRUCTIONS.
13. ALL WIRING, INITIATING DEVICES AND ANNUNCIATOR PANEL SHALL BE SUPERVISED TO THE PRINCIPAL POINT OF ANNUNCIATION. THE FIRE ALARM CONTROL PANEL TO SUPERVISE THE ANNUNCIATOR PANEL, ALL INITIATING AND INDICATING DEVICE CIRCUITS.
14. ALL WIRING SHALL BE CUT FOR IN AND OUT. WIRING SHALL NOT BE LOOPED THROUGH DEVICES PER CEC STANDARDS. ALL WIRING IS TO BE PULLED THROUGH EACH JUNCTION BOX AND CONNECTED DIRECTLY TO EACH FIRE DEVICE. DO NOT SPICE THE WIRE. THERE MUST BE AT LEAST 6" OF LEAD WIRE FROM THE BOX TO THE DEVICE.
15. POINT AND COMMON ANNUNCIATION IS PROHIBITED. SIGNALING LINE CIRCUIT (SLC) MAY BE T-TAPPED ONLY AT BUILDING FATC IF NECESSARY. INSTALL SLC LOOPED WITHIN ALL BUILDINGS AS SHOWN ON THE FLOOR PLANS.
16. PROVIDE 3/4" CONDUIT FROM FIRE ALARM CONTROL PANEL TO TELEPHONE BACKBOARD FOR OWNER PROVIDED CENTRAL STATION MONITORING.
17. CONTRACTOR TO FIELD VERIFY AND PROVIDE DECIBEL METER FOR TESTING OF AMBIENT NOISE LEVELS (MINIMUM 15db ABOVE AVERAGE AMBIENT NOISE LEVEL BUT NOT LESS 75 DBA AT 10 FEET OR MORE THAN 110 DBA AT THE MINIMUM HEARING DISTANCE - SEE NFPA 72 APPENDIX A.7.4.2.1) INSTALL ADDITIONAL AUDIBLE DEVICES AS NEEDED TO ATTAIN REQUIRED NOISE LEVELS IN ALL AREAS. PROVIDE UPDATED PLANS AND CALCULATIONS THROUGH THE "CHANGE ORDER" PROCESS WHEN INSTALLING ADDITIONAL DEVICES. INSPECTOR OF RECORD (IOR) TO WITNESS FINAL TEST OF SYSTEM. CONTRACTOR(S) TO PROVIDE FINAL TEST RESULT AND "RECORD OF COMPLETION" TO ARCHITECT OF RECORD, OWNER, DIVISION OF THE STATE ARCHITECT, IOR AND LOCAL FIRE AUTHORITY.
18. ALL FIRE ALARM CONDUITS ARE MINIMUM 3/4" U.O.N. ALL FIRE ALARM CIRCUITS SHALL BE IN CONDUIT, ABOVE CEILINGS, UNDER FLOORS AND IN WALLS IN A NEAT AND PROTECTED MANNER AS INDICATED ON DESIGN DOCUMENTS. EXPOSED CIRCUITS ARE ONLY PERMITTED WHEN NOTED AS EXPOSED ON DESIGN DOCUMENTS.
19. ALL FLOW SWITCHES SHALL BE 2 WIRE WITH NON-ELECTRONIC RETARD TYPE SIMILAR TO THE SYSTEM SENSOR MODEL "WFD SERIES" ONLY.
20. ALL DEVICES IN THE ALARM SYSTEM SHALL BE COMPATIBLE AND INSTALLED PER MANUFACTURER'S SPECIFICATIONS.
21. SYSTEM SHALL BE FURNISHED AND INSTALLED BY A MANUFACTURER'S AFFILIATE AND AUTHORIZED DISTRIBUTOR. FIRE ALARM SYSTEM INSTALLATION COMPANY SHALL BE LISTED (ULUS). INSTALLING CONTRACTOR SHALL PROVIDE SYSTEM PROGRAMMING FOR SUPERVISORY MONITORING BY AN APPROVED SUPERVISING STATION PER CEC SECTION 901.6. SUPERVISORY MONITORING SHALL BE TESTED AND VERIFIED AS SENDING CORRECT SIGNALS IN CONJUNCTION WITH FINAL ACCEPTANCE TEST. OWNER SHALL BE RESPONSIBLE FOR ESTABLISHING A FIRE SYSTEM MONITORING CONTRACT OR PROVISIONS.
22. DETECTORS SHALL NOT BE INSTALLED UNTIL AFTER THE CONSTRUCTION CLEAN-UP OF ALL TRADES IS COMPLETE AND FINAL. DETECTORS THAT HAVE BEEN INSTALLED PRIOR TO FINAL CLEAN-UP BY ALL TRADES SHALL BE CLEANED OR REPLACED IN ACCORDANCE WITH CHAPTER 17 SECTION 17.7.1.11. CLEANING OR REPLACEMENT OF DEVICES THAT WERE MOUNTED AT THE REQUEST OF THE CONTRACTOR WILL NOT BE PERFORMED WITHOUT WRITTEN AUTHORIZATION THAT ASSUMES FINANCIAL RESPONSIBILITY FOR COSTS INCURRED. SEE THE LATEST VERSION OF NFPA 72.
23. PER CBC 2022, SECTION 11B-309, CONTROLS AND OPERATING MECHANISMS AT INITIATING DEVICE "SHALL BE OPERABLE WITH ONE HAND AND SHALL NOT REQUIRE TIGHT GRASPING, PINCHING, OR TWISTING OF THE WRIST. THE FORCE REQUIRED TO ACTIVATE CONTROLS SHALL BE NO GREATER THAN 5lb (22.2N)." OPERABLE PARTS SHALL BE PLACED WITHIN THE REACH RANGES SPECIFIED IN SECTION 11B-308.
24. FIRE ALARM SYSTEM CONTROL PANEL SHALL HAVE A MEANS FOR TURNING OFF ACTIVATED ALARM NOTIFICATION APPLIANCES. WHEN OCCUPANT NOTIFICATION ALARM SIGNAL DEACTIVATION IS ACTIVATED, BOTH AUDIBLE AND VISIBLE NOTIFICATION APPLIANCES SHALL BE SIMULTANEOUSLY DEACTIVATED. THE DEACTIVATION MEANS SHALL BE KEY-OPERATED.
25. THE SYSTEM SHALL CONFORM TO CALIFORNIA CODE OF REGULATIONS (CCR) TITLES 19 AND 24 AS APPLICABLE TO THIS PROJECT.
26. AUDIBLE COVERAGE SHALL COMPLY WITH NFPA 72 AND 2022 CBC.
27. ALL FIRE ALARM SYSTEM VISUAL SIGNAL BE SYNCHRONIZED THROUGHOUT THE SITE.
28. WHERE NOTIFICATION APPLIANCES OCCUR AT WHITEBOARDS, LOCATE DEVICE(S) +4" ABOVE TOP OF WHITEBOARD, NOT TO EXCEED 96" TO TOP OF LENS.
29. PROVIDE A LABEL WITHIN THE FACP AND EACH POWER SUPPLY WITH THE PANEL NUMBER AND CIRCUIT NUMBER OF THE 120 VOLT POWER SOURCE.
30. WHERE A DETECTOR IS INSTALLED ABOVE THE CEILING, THE DETECTOR SHALL BE EASILY ACCESSIBLE AND THE LOCATION OF THE DETECTOR SHALL BE CLEARLY MARKED. FOR DUCT SMOKE DETECTORS A REMOTE TEST STATION SHALL BE PROVIDED.
31. TEMPERATURE SETTINGS OF HEAT DETECTOR DEVICES ARE TO BE SET AT A MINIMUM OF 20°F. ABOVE THE MAXIMUM EXPECTED TEMPERATURE OF THE SPACE INSTALLED PER NFPA 72, 2.2.3.
32. MECHANICAL UNIT (HVAC) SHUT DOWN SHALL UTILIZE DUCT SMOKE DETECTOR TO TRIGGER RELAY FOR HVAC UNIT SHUT DOWN (PER CMC 609).
33. UPON COMPLETION OF SYSTEM INSTALLATION, THE SYSTEM SHALL BE TESTED IN THE PRESENCE OF AND IN A MANNER ACCEPTABLE TO DSA/I.O.R. CONTRACTOR SHALL SUPPLY NECESSARY TESTING EQUIPMENT, INCLUDING A "SOUND LEVEL METER" TO CHECK ACCEPTABLE NOISE LEVELS OF AUDIBLE DEVICES. PROVIDE TEST RESULTS PER NFPA 72 TO ARCHITECT, D.S.A., I.O.R. AND TO LOCAL FIRE AUTHORITY. THE INSTALLING CONTRACTOR SHALL PROVIDE A RECORD OF COMPLETION PER NFPA72, FIGURE 7.8.2(a) THRU. 7.8.2(i).
34. THE "END OF LINE RESISTANCE" OF EACH CIRCUIT SHALL BE TESTED IN THE PRESENCE OF THE I.O.R. AND SHALL NOT EXCEED A MAXIMUM OF 10% VOLTAGE DROP, OR LISTED MANUFACTURER'S MINIMUM OPERATING VOLTAGE.
35. REFER TO MANUFACTURER'S INSTALLATION INSTRUCTIONS SHEET FOR EXTERIOR NOTIFICATION APPLIANCE MOUNTING.
36. ALL WIRING USED IN UNDERGROUND CONDUIT SHALL BE LISTED FOR WET AREA APPLICATION, IN ACCORDANCE WITH CEC 760.
37. ALL UNDERGROUND FIRE ALARM SYSTEM CONDUCTORS SHALL BE CONTINUOUS FROM END TO END. NO UNDERGROUND SPLICES WILL BE PERMITTED, NOR ACCEPTABLE.
38. FIRE ALARM SYSTEM IS FULLY AUTOMATIC SYSTEM.
39. APPLICABLE STANDARD 2022 NFPA 72 INCLUDING CALIFORNIA AMENDMENTS
40. INSTALLATION OF THE SYSTEM SHALL NOT BE STARTED UNTIL DETAILED DESIGN DOCUMENTS AND SPECIFICATION, INCLUDING STATE FIRE MARSHAL LISTING NUMBERS FOR EACH COMPONENT OF THE SYSTEM HAS BEEN APPROVED BY DSA.
41. A STAMPED SET OF APPROVED FIRE ALARM DESIGN DOCUMENTS SHALL BE ON THE JOB SITE AND USED FOR INSTALLATION.
42. ANY DISCREPANCIES BETWEEN THE DRAWINGS AND THE CODE OR RECOGNIZED STANDARDS SHALL BE BROUGHT TO THE ATTENTION OF DSA AND THE ARCHITECT/ENGINEER OF THE PROJECT.
43. DSA, ARCHITECT/ENGINEER AND OWNER SHALL BE NOTIFIED A MINIMUM OF 48 HOURS PRIOR TO THE FINAL INSPECTION AND/OR TESTING.
44. ALL PENETRATIONS THROUGH RATED ASSEMBLIES, REQUIRING OPENING PROTECTION SHALL BE PROVIDED WITH A PENETRATION FIRE STOP SYSTEM AS IDENTIFIED IN CBC CHAPTER 7, ILL OR OTHER LAB TESTING CRITERIA. APPROVED TYPE OF MATERIALS SHALL BE IDENTIFIED WITHIN THE SPECIFICATION WITHIN THE FIRE ALARM SECTION.
45. PROVIDE ALL COMPONENTS, DEVICES AND PANELS FOR A COMPLETE FUNCTIONAL FIRE ALARM SYSTEM.
46. THE CONTRACTOR SHALL ADJUST/INSTALL ALL DEVICES TO MAXIMIZE PERFORMANCE AND TO MINIMIZE FALSE ALARMS.
47. VISUAL DEVICES SHOULD NOT EXCEED 2 FLASHES PER SECOND AND SHOULD NOT BE SLOWER THAN 1 FLASH EVERY SECOND. THE DEVICE SHALL HAVE A PULSING LIGHT SOURCE NOT LESS THAN 15 CANDELLA. VISUAL DEVICES WITHIN SAME VIEW FROM EACH OTHER SHALL BE SYNCHRONIZED.
48. UNDERGROUND AND EXTERIOR CONDUITS TO HAVE WATERTIGHT FITTINGS AND WIRE TO BE APPROVED FOR WET LOCATIONS.
49. ALL FIRE ALARM WIRING SHALL BE FLP OR FPLP (FIRE POWER LIMITED OR FIRE POWER LIMITED PLENUM) AS REQUIRED FOR APPLICATION. WIRING IN CONDUIT ABOVE GROUND MAY BE THHN OR THWN.
50. ALL LED REMOTE INDICATORS FOR DUCT DETECTORS AND FIRE/SMOKE DAMPERS SHALL BE LOCATED IN CEILINGS IN COORDINATION WITH ARCHITECT PRIOR TO ANY ROUGH-IN.
51. WHEN AS PART OF CONSTRUCTION OF NEW BUILDING FIRE ALARM SYSTEM IS PLACED OUT OF SERVICE AND AFFECTS ANY PORTIONS OF THE CAMPUS, PROVIDE AND MAINTAIN FIRE WATCH AT THE AFFECTED BUILDING(S).

LIST OF APPLICABLE CODES AS

2022 CALIFORNIA ADMINISTRATIVE CODE (CAC), PART 1, TITLE 24 CCR*
2022 CALIFORNIA BUILDING CODE (CBC), PART 2, TITLE 24 CCR
2022 CALIFORNIA ELECTRICAL CODE (CEC), PART 3, TITLE 24 CCR
2022 CALIFORNIA MECHANICAL CODE (CMC), PART 4, TITLE 24 CCR
2022 CALIFORNIA PLUMBING CODE (CPC), PART 5, TITLE 24 CCR
2022 CALIFORNIA ENERGY CODE (CEC), PART 6, TITLE 24 CCR
2022 CALIFORNIA FIRE CODE (CFC), PART 8, TITLE 24 CCR
2022 CALIFORNIA EXISTING BUILDING CODE (CEBC), PART 10, TITLE 24 CCR
2022 CALIFORNIA GREEN BUILDING STANDARDS CODE (CALGREEN), PART 11, TITLE 24 CCR
2022 CALIFORNIA REFERENCED STANDARDS CODE, PART 12, TITLE 24 CCR
TITLE 19 CCR, PUBLIC SAFETY, STATE FIRE MARSHAL REGULATIONS

APPLICABLE STANDARDS

FOR THE LIST OF APPLICABLE STANDARDS, INCLUDING CALIFORNIA AMENDMENTS TO THE NFPA STANDARD, REFER TO CBC CHAPTER 36 AND CFC CHAPTER 60.













ABBREVIATIONS

- (E) EXISTING FIRE ALARM DEVICE TO REMAIN AND PROTECT
- (N) NEW DEVICE
- (D) TERMINATE AND DEMOLISH EXISTING FIRE ALARM DEVICES
- (R) RELOCATE EXISTING FIRE ALARM DEVICES


FIRE WATCH NOTE

PROVIDE FIRE WATCH ARRANGEMENT FOR MONITORING THE BUILDING TO PREVENT AND RESPOND TO FIRES WHEN BUILDING'S FIRE SAFETY SYSTEM IS OUT OF SERVICE
WHEN FIRE ALARM SYSTEM IS DISABLED DURING THE CONSTRUCTION "FIRE WATCH" SHALL BE PROVIDED

SYMBOL LEGEND

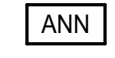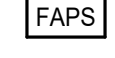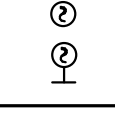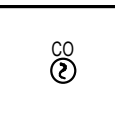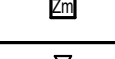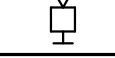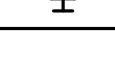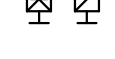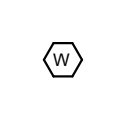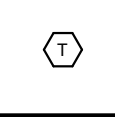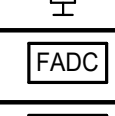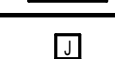SYMBOL	MODEL	MFGR	DESCRIPTION	C.S.F.M. #
	NFS2-3030	NOTIFIER	FIRE ALARM CONTROL PANEL W/DIGITAL VOICE COMMUNICATIONS	7165-0028.0224
	DAA2-7025	NOTIFIER	DIGITAL VOICE COMMAND W/FIBER MODULE 70W DIGITAL AUDIO AMPLIFIER	7165-0028.0224
	NCA-2 DVC-RPU	NOTIFIER	REMOTE ANNUNCIATOR PANEL W/REMOTE MICROPHONE	7165-0028.0243
	FCPS-24S8	NOTIFIER	FIRE ALARM POWER SUPPLY PANEL	7315-0028.0225
	FSP-951	NOTIFIER	INTELLIGENT PHOTOELECTRIC SMOKE DETECTOR	7272-0028.0503
	B300-6	NOTIFIER	DETECTOR BASE	7300-1653.0109
	FST-951-IV	NOTIFIER	INTELLIGENT HEAT DETECTOR (ABOVE ACCESSIBLE CEILING U.N.O.)	7270-0028.0502
	B300-6	NOTIFIER	DETECTOR BASE	7300-1653.0109
	FPC-951	NOTIFIER	ADDRESSABLE MULTI-CRITERIA SMOKE/CO DETECTOR	7272-0028.0510
	B200S	NOTIFIER	DETECTOR SOUNDER BASE	7300-1653.0213
	FRM-1	NOTIFIER	ADDRESSABLE RELAY MODULE	7300-0028.0219
	FMM-1	NOTIFIER	ADDRESSABLE MONITOR MODULE	7300-0028.0219
	SPSCWL	SYSTEM SENSOR	CEILING-MOUNT SPEAKER/STROBE (MULTI-CANDELA)	7320-1653.0505
	SPSWL	SYSTEM SENSOR	WALL-MOUNT SPEAKER/STROBE (MULTI-CANDELA)	7320-1653.0505
	SWL	SYSTEM SENSOR	WALL-MOUNT STROBE (MULTI-CANDELA)	7125-1653.0504
	SPWK	SYSTEM SENSOR	WALL SPEAKER (EXTERIOR)	7320-1653.0201
	NBG-12LX	NOTIFIER	ADDRESSABLE MANUAL PULL STATION	7150-0028.0199
	FS-OSI-RI	NOTIFIER	REFLECTIVE BEAM SMOKE DETECTOR	7260-0028.0509
	RTS151KEY	SYSTEM SENSOR	REMOTE TEST & RESET SWITCH W/KEY LOCK	7300-1653.0212
	-----	-----	EXISTING WATERFLOW SWITCH	-----
	FMM-101	NOTIFIER	MINI MONITOR MODULE	7300-0028.0219
	-----	-----	EXISTING TAMPER SWITCH	-----
	FMM-101	NOTIFIER	MINI MONITOR MODULE	7300-0028.0219
	-----	-----	EXISTING 120VAC EXTERIOR SPRINKLER BELL	-----
	ACE-11	SPACE AGE	FIRE ALARM DOCUMENTS CABINET	7300-0553.0110
	-----	-----	FIRE ALARM TERMINAL CABINET	-----
	-----	-----	FIRE ALARM JUNCTION BOX	-----

WIRE LEGEND

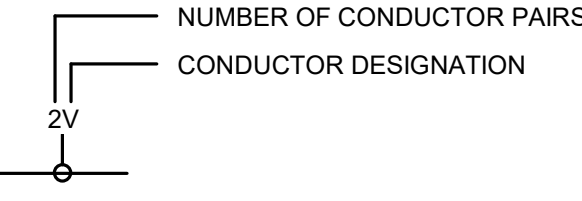CONDUCTOR DESIGNATION	WIRE IN CONDUIT	CONDUCTOR DESIGNATION	WIRE IN CONDUIT UNDERGROUND / WET LOCATION	CIRCUIT TYPE
Z	2 #16 UNSHIELDED (WEST PENN #D990)	ZU	2 #16 FPL UNSHIELDED (WEST PENN #AQ-225)	INITIATING CIRCUIT
V	2 #12 THHN STRANDED	VU	2 #12 THWN STRANDED	STROBE CIRCUIT
P	2 #12 THHN STRANDED	PU	2 #12 THWN STRANDED	24VDC POWER CIRCUIT
C	2 #16 UNSHIELDED (WEST PENN #D990)	CU	2 #16 FPL UNSHIELDED (WEST PENN #AQ-225)	NETWORK CONTROL
A	2 #16 SHIELDED (WEST PENN #D991)	AU	2 #16 FPL SHIELDED (WEST PENN #AQ-291)	SPEAKER CIRCUIT
EXAMPLE: ABOVE EXAMPLE "2V" MEANS "2 PAIRS OF #12 WIRE"				

NOTE:

1. ALL WIRE MODEL NUMBERS ARE WEST PENN. EQUIVALENT BY OTHER MANUFACTURER IS ACCEPTABLE.
2. COLOR CODE ALL FIRE ALARM CONDUCTORS PER DISTRICT STANDARDS. VERIFY COLOR SCHEMES PRIOR TO ORDERING FIRE ALARM CONDUCTORS.
3. ALL WIRING SHALL BE CLASS "B", U.O.N.
4. ALL WIRING SHALL BE IN MINIMUM 3/4" CONDUIT. CONTRACTOR SHALL BE RESPONSIBLE FOR ALL SLEEVES, LOCATION AND SIZE OF CONDUITS TO COMPLY WITH CODES AND STANDARDS.
5. UNDERGROUND CABLES SHALL BE LISTED AS UNDERGROUND BURIAL TYPE AND EXTERIOR CONDUITS SHALL HAVE WATERTIGHT FITTINGS.

FIRE ALARM SEQUENCE OF OPERATIONS

DEVICE	ACTION						
	ACTIVATE NOTIFICATION ALARM SIGNALS	ACTIVATE REMOTE ANNUNCIATOR	ACTIVATE TROUBLE OR SUPERVISORY SIGNAL	SIGNAL TO UL LISTED CENTRAL MONITORING STATION	CLOSE CSFD	SHUT DOWN AH-UNIT & HVLS FAN	ACTIVATE CO DETECTOR SOUNDER BASE
CONTROL PANEL	YES	YES	YES	YES	YES	YES	YES
MANUAL PULL STATION	YES	YES	NO	YES	NO	NO	NO
SMOKE / BEAM DETECTOR	YES	YES	NO	YES	YES	YES	NO
HEAT DETECTOR	YES	YES	NO	YES	YES	YES	NO
CARBON MONOXIDE DETECTOR	YES	YES	NO	YES	YES	YES	YES
A/C POWER FAILURE	NO	YES	YES	YES	NO	NO	NO
WIRING FAULTS / LOW BATTERY	NO	YES	YES	YES	NO	NO	NO
WATERFLOW	YES	YES	NO	YES	NO	YES	NO
TAMPER / PIV	NO	YES	YES	YES	NO	NO	NO

NOTE: PER IMC 608.1 WHEN THE AUTOMATIC ACTIVATION OF A SMOKE DAMPER OR A COMBINATION SMOKE-FIRE DAMPER OCCURS, THE HVAC SYSTEM SERVING SUCH DAMPERS SHALL IMMEDIATELY SHUT DOWN. THE HVAC SYSTEM SHALL NOT BE RESTARTED AGAIN UNTIL ALL DAMPERS ARE RESET AND FULLY OPENED.

CENTRAL STATION INFORMATION

PYRO-COMM SYSTEMS, INC.
UL # S4756
15531 CONTAINER LANE
HUNTINGTON BEACH, CA 92649
PHONE #: 1-888-815-6268
CUSTOMER ACCT. #: 692986

FIRE SPRINKLER INFORMATION

EXISTING ADMIN BUILDING IS FULLY SPRINKLERED

FIRE ALARM SCOPE OF WORK

TO PROVIDE AND INSTALL A NEW ANALOG ADDRESSABLE, VOICE EVAC, AUTOMATIC, POWER LIMITED 24V DC SUPERVISED FIRE ALARM SYSTEM WITHIN THE EXISTING ADMIN BUILDING IN EAST WHITTIER MS
EXISTING FIRE ALARM SYSTEM IN OTHER BUILDINGS SHALL BE MAINTAINED OPERATIONAL AND WILL BE RECONNECTED TO NEW FIRE ALARM CONTROL PANEL.

COMPLETE FIRE ALARM SUBMITTAL

MANUAL/AUTOMATIC FIRE ALARM SYSTEM

Emma A. Wicker Auditorium Renovation

14421 Whittier Blvd.

Whittier, CA 90605

Developed for

East Whittier City School District

Submitted	Schematic Design	Date	11/06/2025
	Design Development		
	100% Design		
	50% Progress Set		
	DSA SUBMITTAL		
Revision	DSA BACK CHECK	11/22/2024	
	DSA BACK CHECK V3	03/20/2025	
	DSA BACK CHECK V4	06/03/2025	
	DSA BACK CHECK V5	05/30/2025	
	ADDENDUM B	11/26/2025	
Job Number	31837		
	Checked By	M.N	
	Scale	1/8" = 1'-0"	

FIRE ALARM LEAD SHEET

Panel Location: Whittier MS - Building A - Basement Main ELEC/MDF Room

Panel: **FACP - NFS2-3030**

Regulated Load in Standby

Device Type	Number of Devices		Current (Amps)		Total Current (Amps)
CPU2-3030 Control Panel	1	X	0.120	=	0.120
NCA-2 Network Control Annunciator	1	X	0.800	=	0.800
RM-1 Remote Microphone	1	X	0.075	=	0.075
DVC-EM Digital Voice Command	1	X	0.300	=	0.300
Network Card NCM-F	1	X	0.110	=	0.110
DAA2-7525 Amplifier	2	X	0.012	=	0.024
UDACT-2 Transmitter	1	X	0.052	=	0.052
LCM-320 Loop Control Module	3	X	0.070	=	0.210
Control Relay	8	X	0.0018	=	0.0144
Existing Control Relays	4	X	0.0018	=	0.0072
Monitor Module	6	X	0.0108	=	0.0108
Existing Monitor Modules	4	X	0.0018	=	0.0072
Smoke Detector	180	X	0.0003	=	0.054
Existing Smoke Detectors	145	X	0.0003	=	0.04275
Heat Detector	100	X	0.0003	=	0.030
Existing Heat Detectors	80	X	0.0003	=	0.024
Beam Detector	2	X	0.020	=	0.040
Existing Beam Detectors	3	X	0.020	=	0.060
CO/Smoke Detector	24	X	0.0004	=	0.0096
Existing CO/Smoke Detector	23	X	0.0004	=	0.0092
Manual Pull Station	1	X	0.0004	=	0.0004
STANDBY LOAD =					1.8013

Regulated Load in ALARM

Device Type	Number of Devices		Current (Amps)		Total Current (Amps)
CPU2-3030 Control Panel	1	X	0.446	=	0.446
NCA-2 Network Control Annunciator	1	X	0.065	=	0.065
RM-1 Remote Microphone	1	X	0.064	=	0.064
DVC-EM Digital Voice Command	1	X	2.206	=	2.206
Network Card NCM-F	1	X	0.110	=	0.110
DAA2-7525 Amplifier	2	X	0.100	=	0.200
UDACT-2 Transmitter	1	X	0.040	=	0.040
LCM-320 Loop Control Module	3	X	0.072	=	0.216
Control Relay	8	X	0.0065	=	0.052
Existing Control Relays	4	X	0.0065	=	0.026
Monitor Module	6	X	0.005	=	0.03
Existing Monitor Modules	4	X	0.005	=	0.02
Smoke Detector	180	X	0.005	=	0.900
Existing Smoke Detectors	145	X	0.005	=	0.725
Heat Detector	100	X	0.005	=	0.500
Existing Heat Detectors	80	X	0.005	=	0.400
Beam Detector	2	X	0.024	=	0.048
Existing Beam Detectors	3	X	0.024	=	0.072
CO/Smoke Detector	24	X	0.0072	=	0.1728
Existing CO/Smoke Detector	23	X	0.0072	=	0.1656
Manual Pull Station	1	X	0.005	=	0.005
ALARM LOAD =					6.463

Battery Amp Hour Calculation

Standby Load Current (Amps)	1.8013	X	$\frac{24}{15}$	=	43.2312 AH
Alarm Load Current (Amps)	6.4634	X	$\frac{15}{15}$	=	1.62 AH
Sub Total Standby / Alarm Amp Hours					44.85 AH
Multiply by the Derating Factor X					1.3
Total Ampere Hours Required =					54 AH
(2)-55AH Batteries Required Provide 55 AH Batteries					

Panel Location: Whittier MS - Building A - Admin East

Panel Name: **POWER SUPPLY PANEL FAPS-3**

Regulated Load in Standby

Device Type	Number of Circuits/Devices		Current (Amps)		Total Current (Amps)
FCPS-2458 Main Circuit Board	1	X	0.091	=	0.091
Power Supervision Relay	0	X	0.025	=	0
Auxiliary Device (Socunder Base)	0	X	0.0003	=	0
Notification Appliance Circuit					
Bldg. "A" 1st Floor NAC# V5	1	X	0.0004	=	0.0004
Bldg. "A" 1st Floor NAC# V6	1	X	0.0004	=	0.0004
Bldg. "A" 1st Floor NAC# V7	1	X	0.0004	=	0.0004
Bldg. "A" 1st Floor NAC# V8	1	X	0.0004	=	0.0004
STANDBY LOAD =					0.0926

Regulated Load in ALARM

Device Type	Number of Devices		Current (Amps)		Total Current (Amps)
FCPS-2458 Main Circuit Board	1	X	0.145	=	0.145
Power Supervision Relay	0	X	0.025	=	0
Auxiliary Device (Socunder Base)	0	X	0.065	=	0
Notification Appliance Circuit					
Bldg. "A" 1st Floor NAC# V5	1	X	0.824	=	0.824
Bldg. "A" 1st Floor NAC# V10	1	X	0.842	=	0.842
Bldg. "A" 1st Floor NAC# V11	1	X	0.000	=	0.000
Bldg. "A" 1st Floor NAC# V12	1	X	0.000	=	0.000
ALARM LOAD =					1.611

Battery Amp Hour Calculation

Standby Load Current (Amps)	0.0926	X	$\frac{24}{15}$	=	2.2224 AH
Alarm Load Current (Amps)	1.6111	X	$\frac{15}{15}$	=	0.40 AH
Sub Total Standby / Alarm Amp Hours					2.63 AH
Multiply by the Derating Factor X					1.3
Total Ampere Hours Required =					4 AH
(2)-7AH Batteries Required Provide 7AH Batteries					

Panel Location: Whittier MS - Building A - Basement Main ELEC/MDF Room

Panel Name: **POWER SUPPLY PANEL FAPS-1**

Regulated Load in Standby

Device Type	Number of Circuits/Devices		Current (Amps)		Total Current (Amps)
FCPS-2458 Main Circuit Board	1	X	0.091	=	0.091
Power Supervision Relay	0	X	0.025	=	0
Auxiliary Device (Socunder Base)	0	X	0.0003	=	0
Notification Appliance Circuit					
Bldg. "A" Basement NAC# V1	1	X	0.0004	=	0.0004
Bldg. "A" Basement NAC# V2	1	X	0.0004	=	0.0004
Bldg. "A" Basement NAC# V3	1	X	0.0004	=	0.0004
Bldg. "A" Basement NAC# V4	1	X	0.0004	=	0.0004
STANDBY LOAD =					0.0926

Regulated Load in ALARM

Device Type	Number of Devices		Current (Amps)		Total Current (Amps)
FCPS-2458 Main Circuit Board	1	X	0.145	=	0.145
Power Supervision Relay	0	X	0.025	=	0
Auxiliary Device (Socunder Base)	0	X	0.065	=	0
Notification Appliance Circuit					
Bldg. "A" Basement NAC# V1	1	X	0.869	=	0.869
Bldg. "A" Basement NAC# V2	1	X	0.582	=	0.582
Bldg. "A" Basement NAC# V3	1	X	0.444	=	0.444
Bldg. "A" Basement NAC# V4	1	X	0.000	=	0.000
ALARM LOAD =					2.040

Battery Amp Hour Calculation

Standby Load Current (Amps)	0.0926	X	$\frac{24}{15}$	=	2.2224 AH
Alarm Load Current (Amps)	2.04	X	$\frac{15}{15}$	=	0.51 AH
Sub Total Standby / Alarm Amp Hours					2.73 AH
Multiply by the Derating Factor X					1.3
Total Ampere Hours Required =					4 AH
(2)-7AH Batteries Required Provide 7AH Batteries					

Panel Location: WHITTIER MS - ADMIN BLDG. BASEMENT

Panel: **DVC-1/AMP-1**

Regulated Load in Standby

Device Type	Number of Devices		Current (Amps)		Total Current (Amps)
DAA-7025 70W Amplifier	1	X	0.275	=	0.275
0.25 Watt Speakers	0	X	0.0001	=	0
0.5 Watt Speakers	0	X	0.0001	=	0.000
1 Watt Speakers	19	X	0.0001	=	0.0019
2 Watt Speakers	8	X	0.0001	=	0.001
STANDBY LOAD =					0.2777

Regulated Load in ALARM

Device Type	Number of Devices		Current (Amps)		Total Current (Amps)
DAA-7025 70W Amplifier	1	X	0.580	=	0.580
0.25 Watt Speakers	0	X	0.015	=	0
0.5 Watt Speakers	0	X	0.02	=	0
1 Watt Speakers	19	X	0.04	=	0.76
2 Watt Speakers	8	X	0.08	=	0.640
ALARM LOAD =					0.580

Battery Amp Hour Calculation

Standby Load Current (Amps)	0.2777	X	$\frac{24}{15}$	=	6.6648 AH
Alarm Load Current (Amps)	0.58	X	$\frac{15}{15}$	=	0.15 AH
Sub Total Standby / Alarm Amp Hours					6.81 AH
Multiply by the Derating Factor X					1.3
Total Ampere Hours Required =					9 AH
(2)-12AH Batteries Required					

Panel Location: WHITTIER MS - ADMIN BLDG. FIRST FLOOR

Panel: **DVC-2/AMP-2**

Regulated Load in Standby

Device Type	Number of Devices		Current (Amps)		Total Current (Amps)
DAA-7025 70W Amplifier	1	X	0.275	=	0.275
0.25 Watt Speakers	0	X	0.0001	=	0
0.5 Watt Speakers	0	X	0.0001	=	0.000
1 Watt Speakers	36	X	0.0001	=	0.0036
2 Watt Speakers	17	X	0.0001	=	0.002
STANDBY LOAD =					0.2803

Regulated Load in ALARM

Device Type	Number of Devices		Current (Amps)		Total Current (Amps)
DAA-7025 70W Amplifier	1	X	0.580	=	0.580
0.25 Watt Speakers	0	X	0.015	=	0
0.5 Watt Speakers	0	X	0.02	=	0
1 Watt Speakers	36	X	0.04	=	1.44
2 Watt Speakers	17	X	0.08	=	1.360
ALARM LOAD =					0.580

Battery Amp Hour Calculation

Standby Load Current (Amps)	0.2803	X	$\frac{24}{15}$	=	6.7272 AH
Alarm Load Current (Amps)	0.58	X	$\frac{15}{15}$	=	0.15 AH
Sub Total Standby / Alarm Amp Hours					6.87 AH
Multiply by the Derating Factor X					1.3
Total Ampere Hours Required =					9 AH
(2)-12AH Batteries Required					

Panel Location: WHITTIER MS - ADMIN BLDG. FIRST FLOOR

Panel: **DVC-3/AMP-3**

Regulated Load in Standby

Device Type	Number of Devices		Current (Amps)		Total Current (Amps)
DAA-7025 70W Amplifier	1	X	0.275	=	0.275
0.25 Watt Speakers	0	X	0.0001	=	0
0.5 Watt Speakers	19	X	0.0001	=	0.0019
2 Watt Speakers	13	X	0.0001	=	0.001
STANDBY LOAD =					0.2782

Regulated Load in ALARM

Device Type	Number of Devices		Current (Amps)		Total Current (Amps)
DAA-7025 70W Amplifier	1	X	0.580	=	0.580
0.25 Watt Speakers	0	X	0.015	=	0
0.5 Watt Speakers	0	X	0.02	=	0
1 Watt Speakers	19	X	0.04	=	0.76
2 Watt Speakers	13	X	0.08	=	1.040
ALARM LOAD =					0.580

Battery Amp Hour Calculation

Standby Load Current (Amps)	0.2782	X	$\frac{24}{15}$	=	6.6768 AH
Alarm Load Current (Amps)	0.58	X	$\frac{15}{15}$	=	0.15 AH
Sub Total Standby / Alarm Amp Hours					6.82 AH
Multiply by the Derating Factor X					1.3
Total Ampere Hours Required =					9 AH
(2)-12AH Batteries Required					

Panel Location: WHITTIER MS - ADMIN BUILDING - SPEAKER CIRCUITS SCHEDULE

SPEAKER CIRCUIT LOAD CALCULATION

SPEAKER CIRCUIT DESCRIPTION	PANEL CIRCUIT NUMBER	WIRE GAUGE (18, 16, 14, 12) (AWG)	CIRCUIT VOLTAGE (25 OR 70 VRMS)	SPEAKER TAPPED AT 9.25 Watts	APPLIANCES QUANTITIES / SPEAKER TAPPED AT 0.5 Watts	SPEAKER / TAP VALUES TAPPED AT 1 Watts	SPEAKER TAPPED AT 2 Watts	SPEAKER TAPPED AT 4 Watts	TOTAL CIRCUIT LOAD (WATTS)	ESTIMATED CIRCUIT LENGTH (FEET)	MAXIMUM 3-dB DROP PER CIRCUIT ACTUAL WIRELOSS (dB)	MAXIMUM ALLOWABLE CKT. LENGTH (FEET)	TOTAL CIRCUIT RESISTANCE (OHMS)
BLDG. "A" BASEMENT SPEAKER CKT. S1 (FACP Amp.)	CKT #1	16	25	0	0	13	2	0	17.00	1000	-1.75	1,858	8.2
BLDG. "A" BASEMENT SPEAKER CKT. S2 (FACP Amp.)	CKT #2	16	25	0	0	6	2	0	10.00	1000	-1.07	3,159	8.2
BLDG. "A" BASEMENT SPEAKER CKT. S3 (FACP Amp.)	CKT #3	16	25	0	0	4	0	0	8.00	1000	-0.87	3,948	8.2
BLDG. "A" BASEMENT SPEAKER CKT. S4 (FACP Amp.)	CKT #4	16	25	0	0	0	0	0	0.00	1000	0.00	0	8.2
BLDG. "A" FIRST FLOOR SPEAKER CKT. S5 (DVC-2 Amp.)	CKT #5	16	25	0	0	13	4	0	21.00	1000	-2.11	1,504	8.2
BLDG. "A" FIRST FLOOR SPEAKER CKT. S6 (DVC-2 Amp.)	CKT #6	16	25	0	0	8	5	0	18.00	1000	-1.84	1,755	8.2
BLDG. "A" FIRST FLOOR SPEAKER CKT. S7 (DVC-2 Amp.)	CKT #7	16	25	0	0	6	3	0	12.00	1000	-1.27	2,632	8.2
BLDG. "A" FIRST FLOOR SPEAKER CKT. S8 (DVC-2 Amp.)	CKT #8	16	25	0	0	9	5	0	19.00	1000	-1.93	1,662	8.2
BLDG. "A" FIRST FLOOR SPEAKER CKT. S9 (DVC-3 Amp.)	CKT #9	16	25	0	0	12	4	0	20.00	500	-1.07	1,579	4.1
BLDG. "A" FIRST FLOOR SPEAKER CKT. S10 (DVC-3 Amp.)	CKT #10	16	25	5	0	7	9	0	26.25	500	-1.38	1,203	4.1
BLDG. "A" FIRST FLOOR SPEAKER CKT. S11 (DVC-3 Amp.)	CKT #11	16	25	0	0	0	0	0	0.00	500	0.00	0	4.1
BLDG. "A" FIRST FLOOR SPEAKER CKT. S12 (DVC-3 Amp.)	CKT #12	16	25	0	0	0	0	0	0.00	500	0.00	0	4.1
Appliance Summary									Total Load (Watts)		151.25		
									5	0	74	38	0

NOTE:
LUMP SUM METHOD WAS USED TO CALCULATE MAXIMUM ALLOWABLE CIRCUIT LENGTH. THIS METHOD ALLOWS FOR A SMALL MARGIN OF SAFETY, TAKING INTO CONSIDERATION THE ACTUAL INSTALLED CIRCUIT ROUTING MAY DIFFER FROM WHAT IS SHOWN ON THE SHOP DRAWINGS. IF THE ACTUAL CIRCUIT LENGTH IS GOING TO EXCEED THE MAXIMUM ALLOWABLE CIRCUIT LENGTH, CONTACT YOUR LOCAL SIMPLEX BRANCH.

Calculation Sheet

Page 1

Submitted

05/03/2024

SCHEMATIC DESIGN

50% DESIGN DEVELOPMENT

100% DESIGN DEVELOPMENT

08/23/2024

50% PROGRESS SET

10/23/2024

DSA SUBMITTAL

11/22/2024

DSA BACK CHECK

02/20/2025

DSA BACK CHECK V3

06/30/2025

DSA BACK CHECK V4

07/25/2025

DSA BACK CHECK V5

11/05/2025

ADDENDUM B

Revision

B

Attn: Admin B

Date

11/06/2025

Job Number

31837