

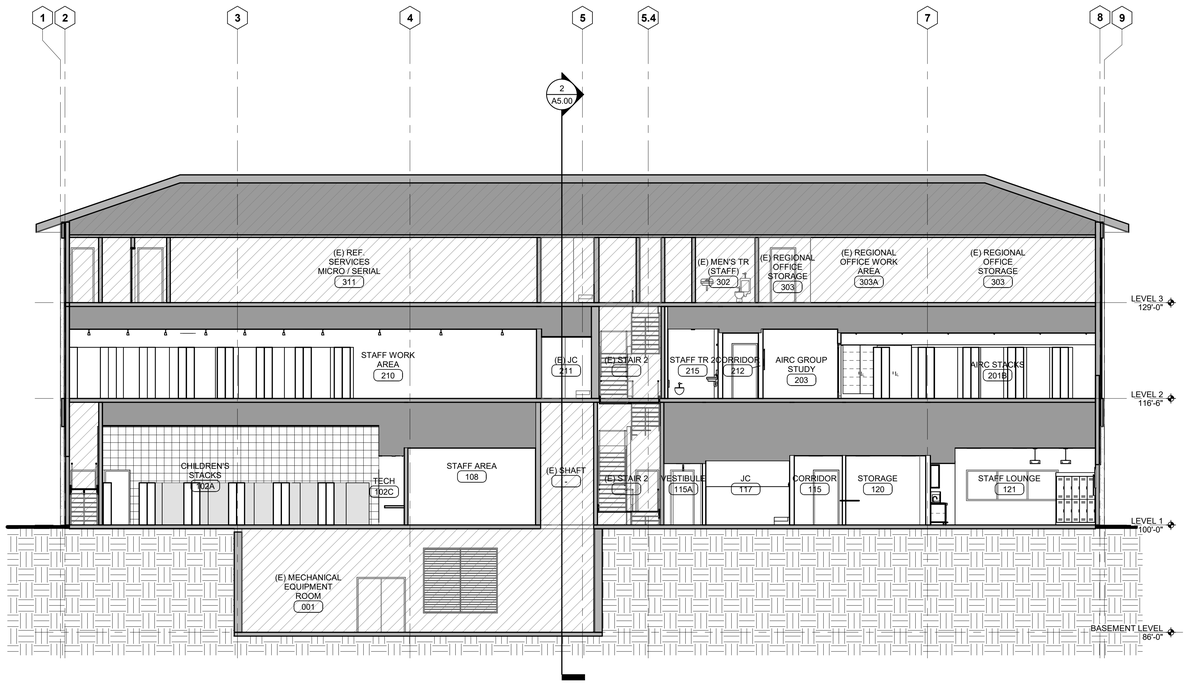



3 BUILDING SECTION 1
Scale: 1/8" = 1'-0"

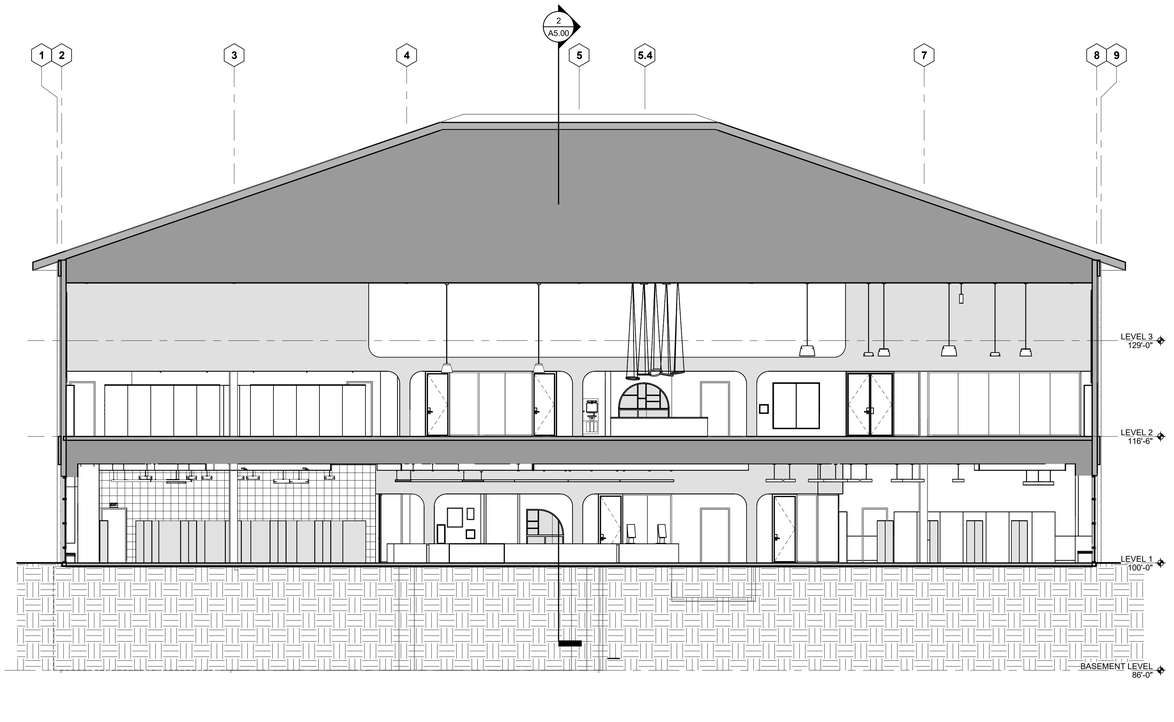

1 BUILDING SECTION 2
Scale: 1/8" = 1'-0"

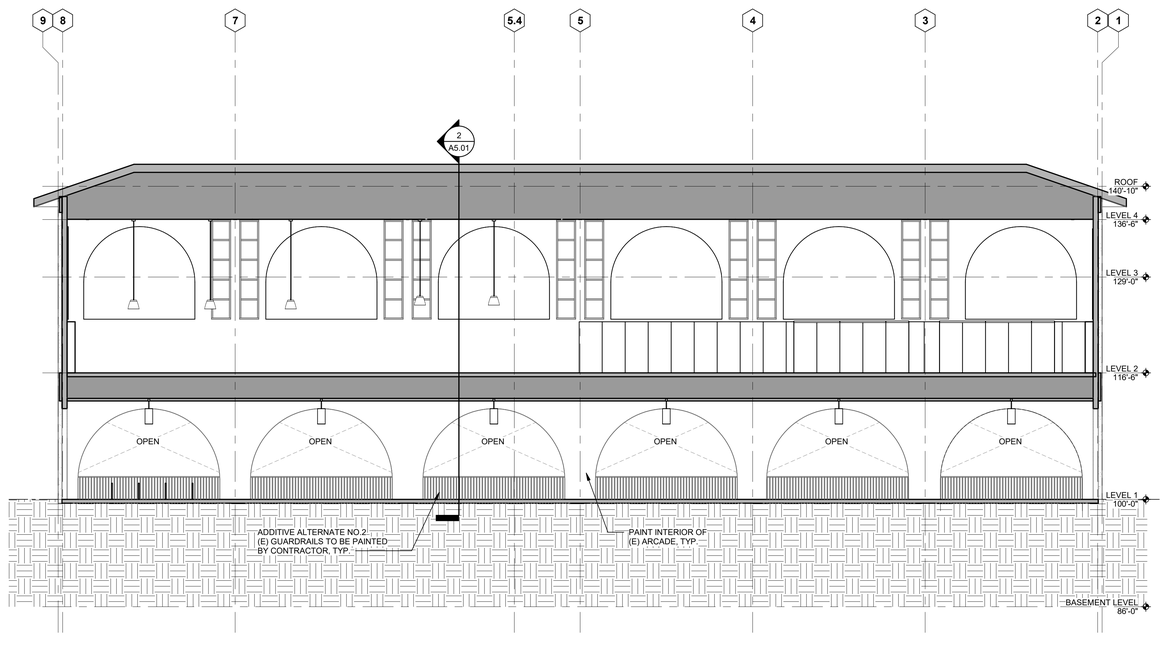

4 BUILDING SECTION 3
Scale: 1/8" = 1'-0"

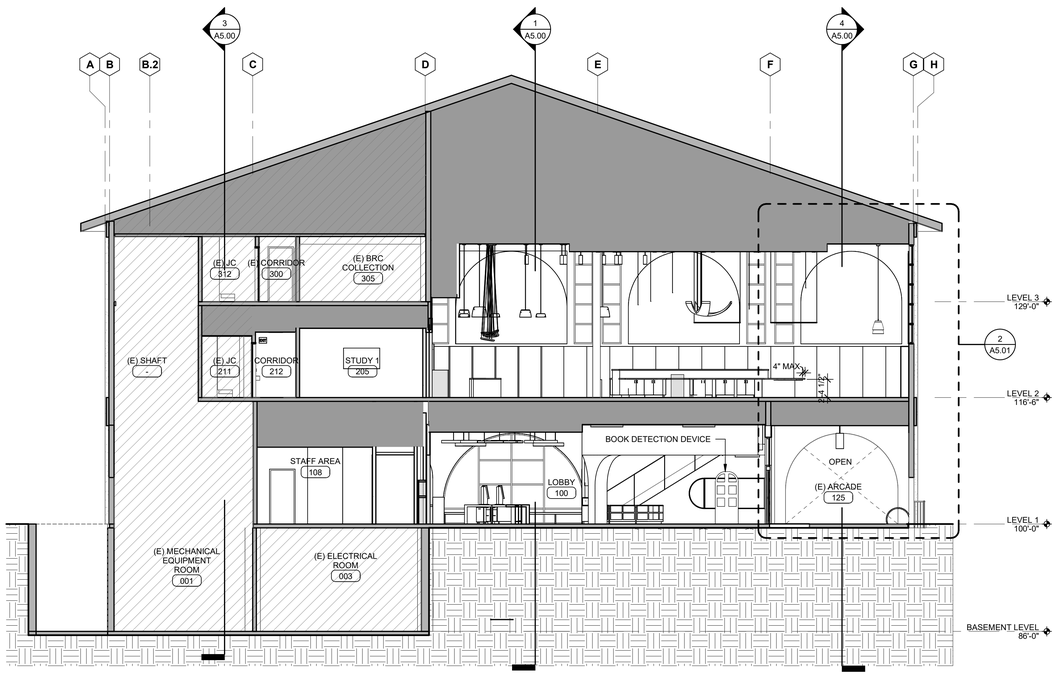

2 BUILDING SECTION 4
Scale: 1/8" = 1'-0"

REVISIONS

CONSTRUCTION DOCUMENTS

LICENSED ARCHITECT
STEVEN ORTEGA
No. C-34809
Exp. 8-31-25
STATE OF CALIFORNIA

LOS ANGELES COUNTY PUBLIC WORKS
HUNTINGTON PARK LIBRARY
6518 MILES AVE
HUNTINGTON PARK, CA 90255

COUNTY OF LOS ANGELES CALIFORNIA

LA COUNTY LIBRARY


NAC


NAC NO	161-23025
DRAWN	Author
CHECKED	Checker
DATE	11/01/2024


BUILDING SECTIONS

A5.00

© 2023 NAC Inc.

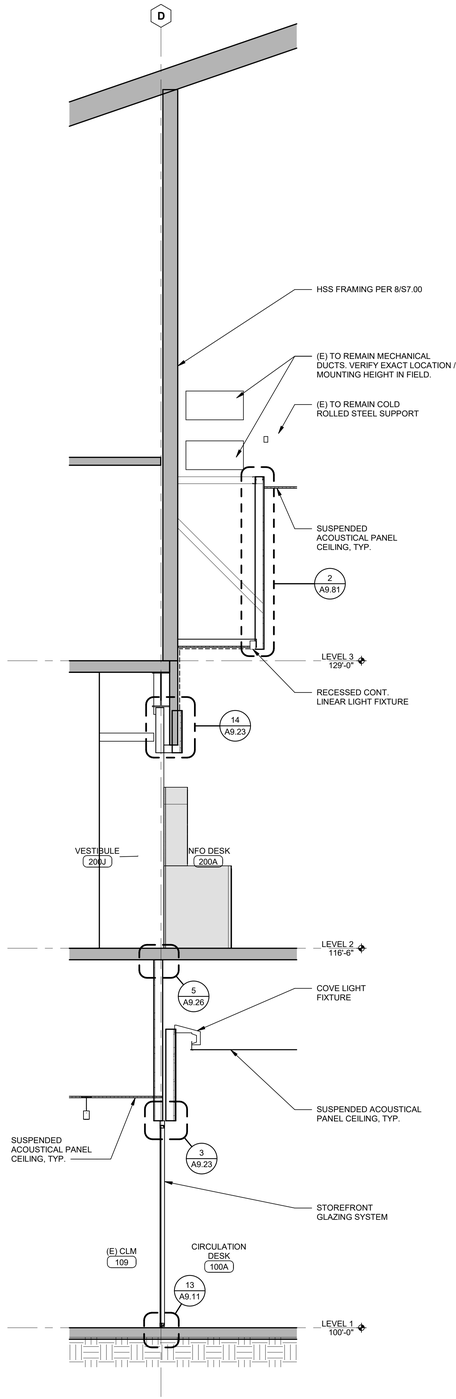

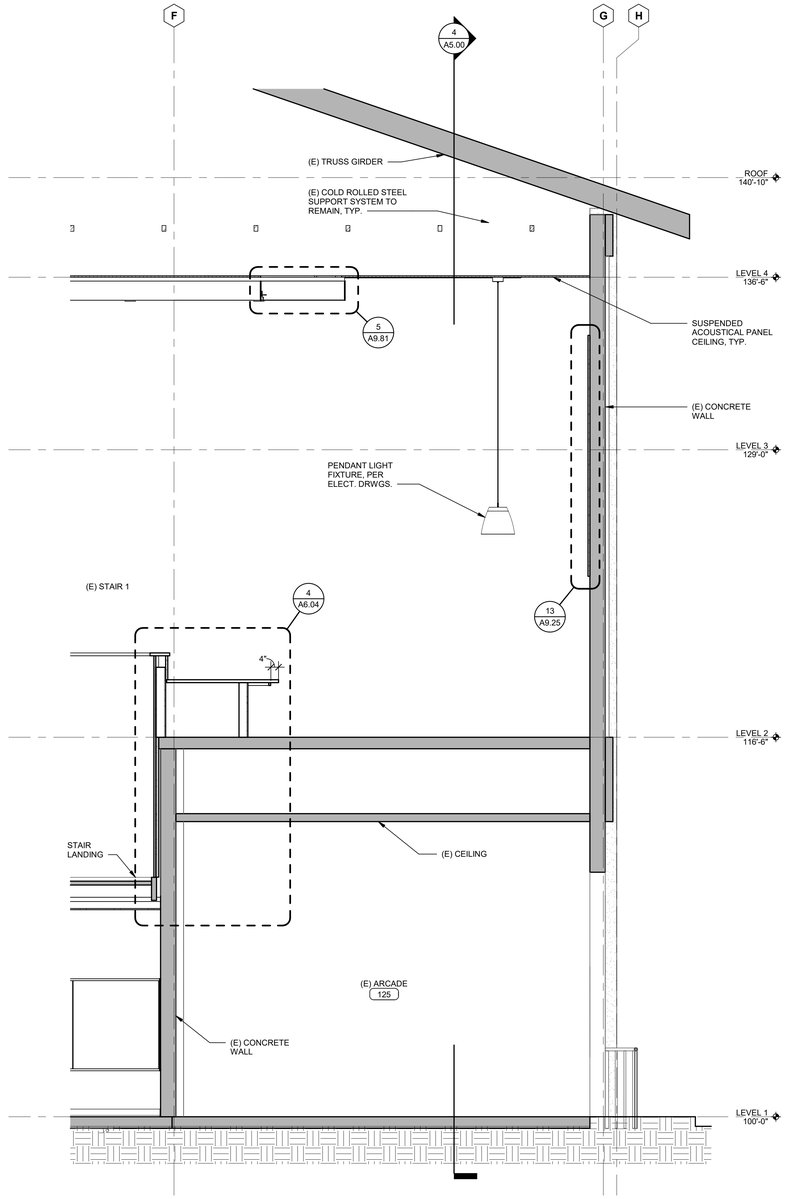

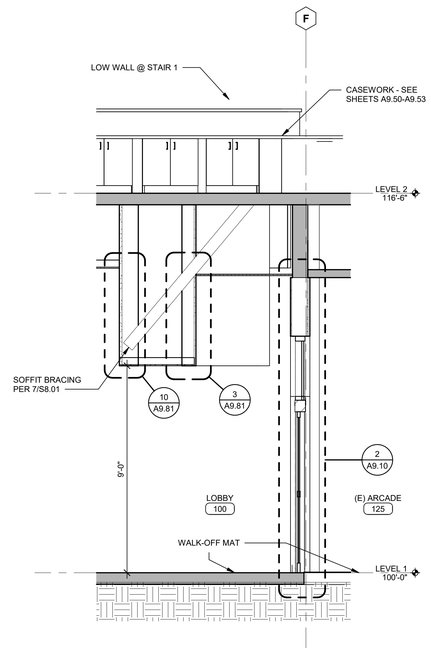

3 WALL SECTION 1
Scale: 3/8" = 1'-0"

2 WALL SECTION 2
Scale: 3/8" = 1'-0"

1 WALL SECTION 3
Scale: 3/8" = 1'-0"

REVISIONS

CONSTRUCTION DOCUMENTS

LICENSED ARCHITECT
VICTOR ORTEGA, JR.
No. C-34809
Exp. 8-31-25
STATE OF CALIFORNIA

LOS ANGELES COUNTY PUBLIC WORKS
HUNTINGTON PARK LIBRARY
6518 MILES AVE
HUNTINGTON PARK, CA 90255

COUNTY OF LOS ANGELES CALIFORNIA

LA COUNTY LIBRARY

NAC

NAC NO	161-23025
DRAWN	Author
CHECKED	Checker
DATE	11/01/2024

WALL SECTIONS & PARTIAL BUILDING SECTIONS

A5.01

© 2023 NAC Inc.

REVISIONS

CONSTRUCTION DOCUMENTS

LICENSED ARCHITECT
VICTOR ORTEGA
No. C-34809
Exp. 8-31-25
STATE OF CALIFORNIA

LOS ANGELES COUNTY PUBLIC WORKS

HUNTINGTON PARK LIBRARY

6518 MILES AVE
HUNTINGTON PARK, CA 90255

COUNTY OF LOS ANGELES CALIFORNIA

LA COUNTY LIBRARY


NAC

NAC NO	161-23025
DRAWN	Author
CHECKED	Checker
DATE	11/01/2024


WALL SECTIONS & PARTIAL BUILDING SECTIONS

A5.02

© 2023 NAC Inc

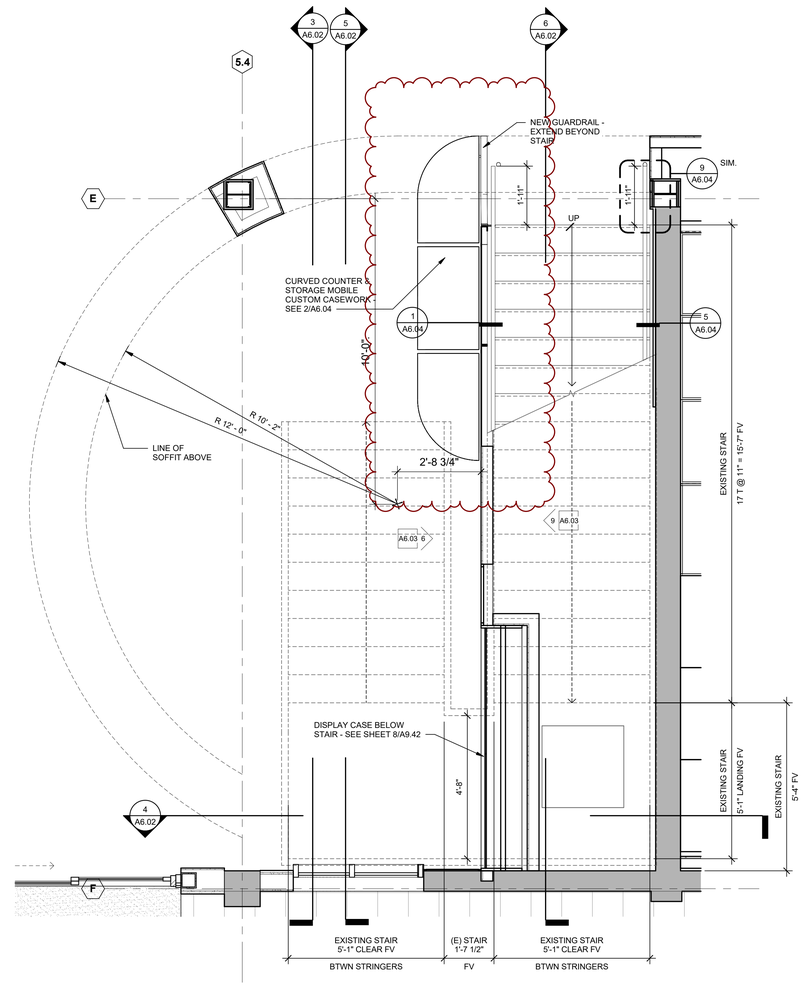

2 STAIR 1 - LEVEL 1
Scale: 1/2" = 1'-0"

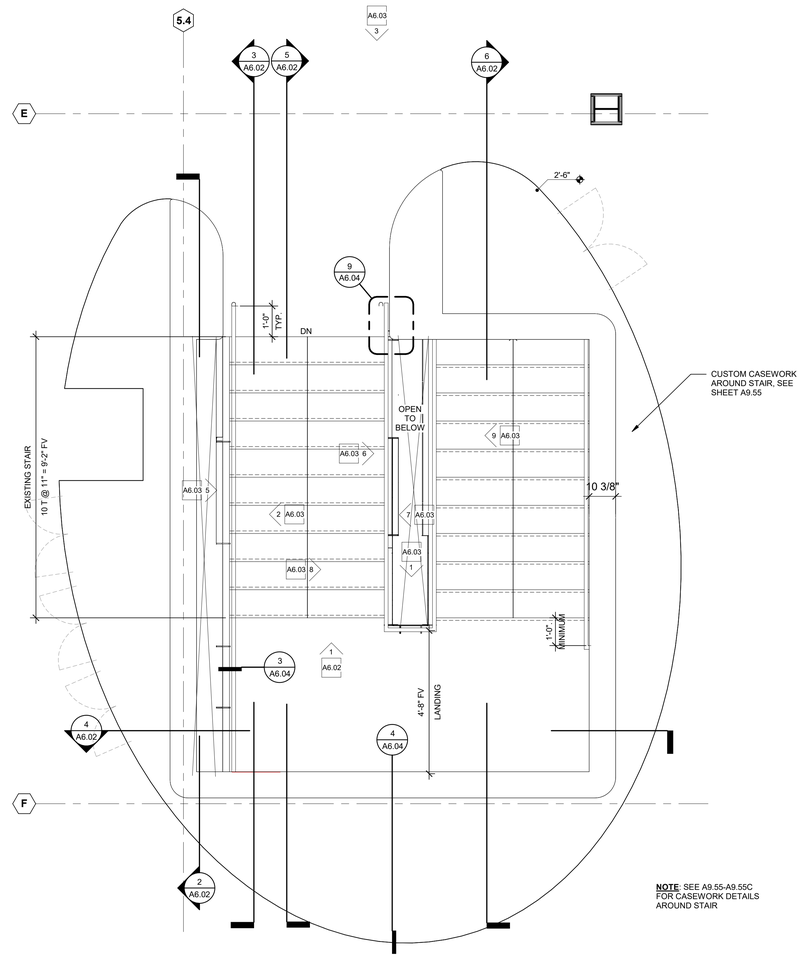

NOTE: SEE A9.55-A9.55C FOR CASEWORK DETAILS AROUND STAIR

1 STAIR 1 - LEVEL 2
Scale: 1/2" = 1'-0"

REVISIONS

2 Post-Plan Check Changes TBD

CONSTRUCTION DOCUMENTS

LICENSED ARCHITECT
VICTOR ORTEGA JR.
No. C-34809
Exp. 8-31-25
STATE OF CALIFORNIA

LOS ANGELES COUNTY PUBLIC WORKS

HUNTINGTON PARK LIBRARY

6518 MILES AVE.
HUNTINGTON PARK, CA 90255

COUNTY OF LOS ANGELES CALIFORNIA

LA COUNTY LIBRARY


NAC

NAC NO	161-23025
DRAWN	Author
CHECKED	Checker
DATE	11/01/2024


ENLARGED STAIR PLANS

A6.01


© 2023 NAC Inc.

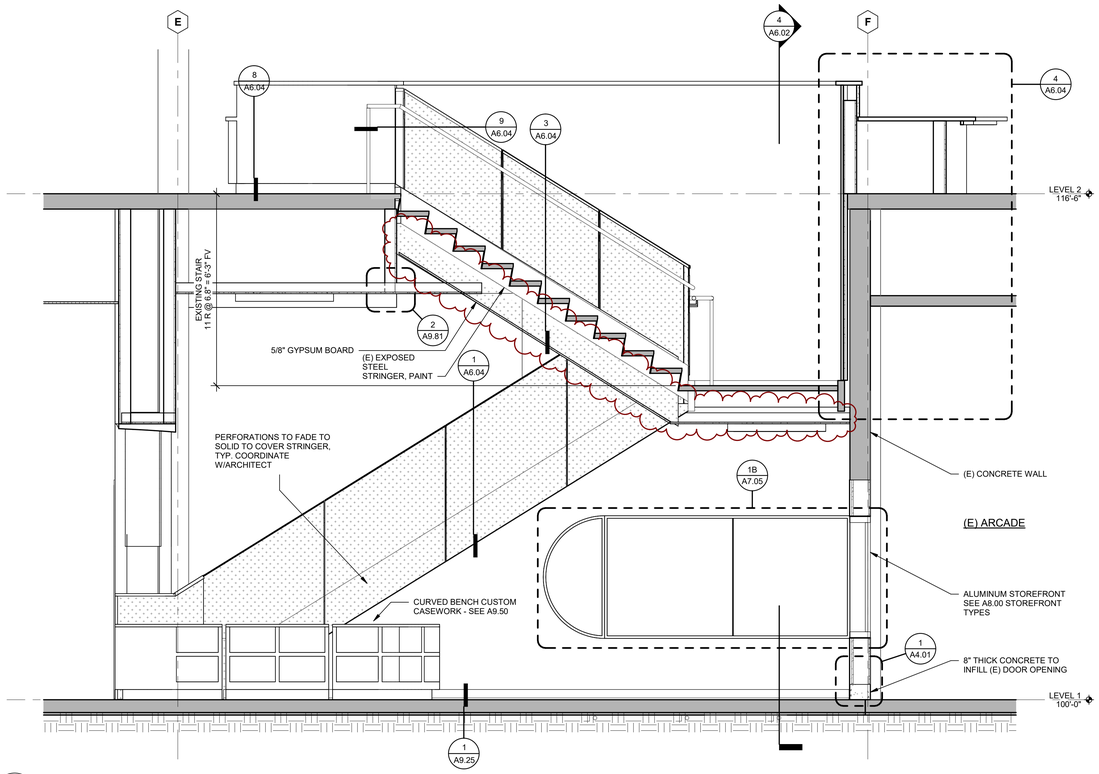


5 STAIR - SECTION 1
Scale: 1/2" = 1'-0"

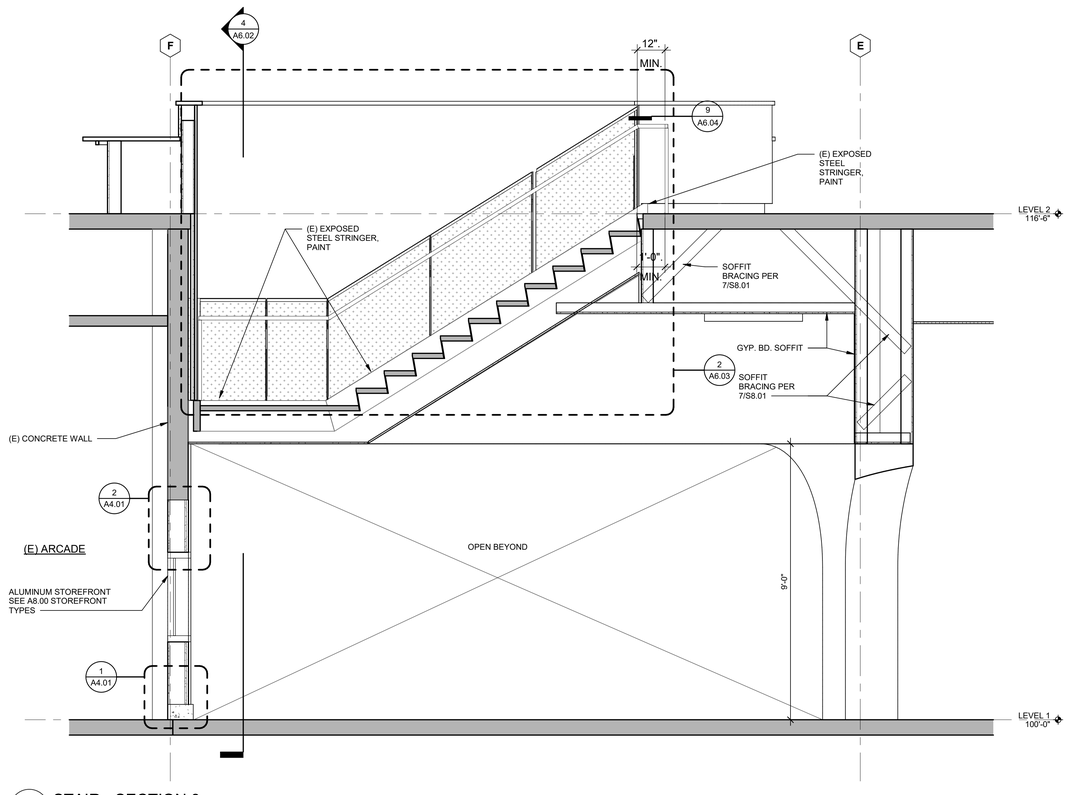


3 STAIR - SECTION 3
Scale: 1/2" = 1'-0"

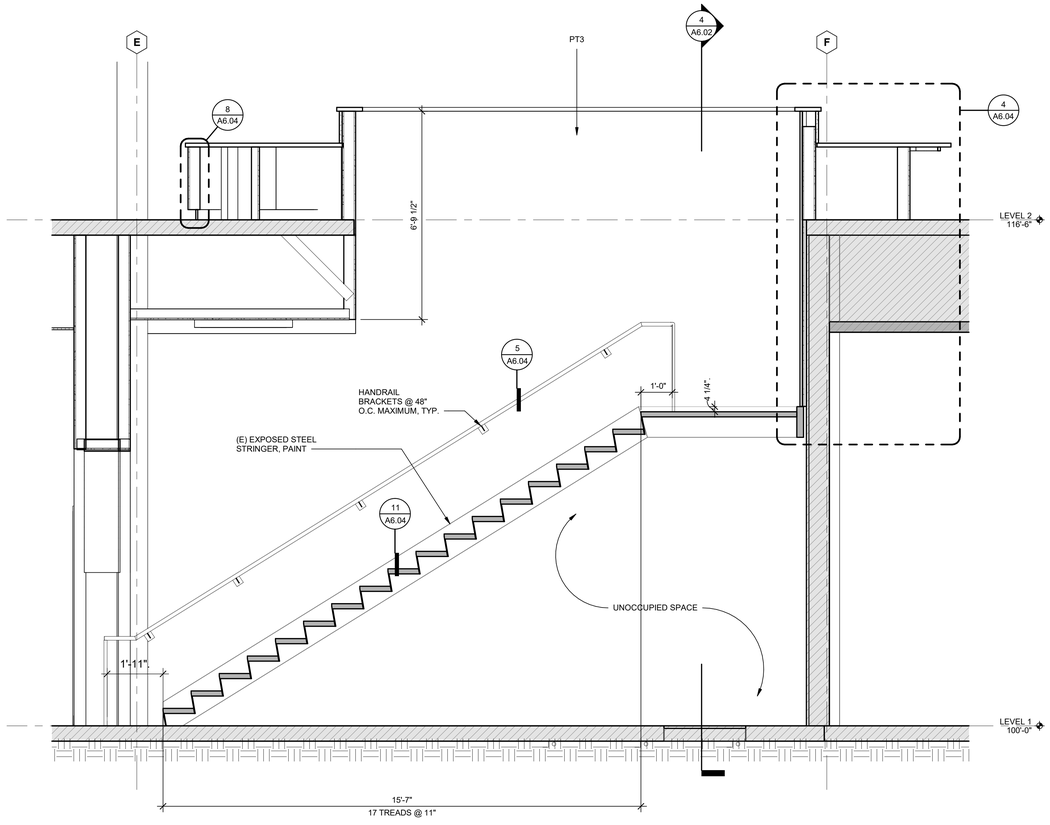


6 STAIR - SECTION 2
Scale: 1/2" = 1'-0"

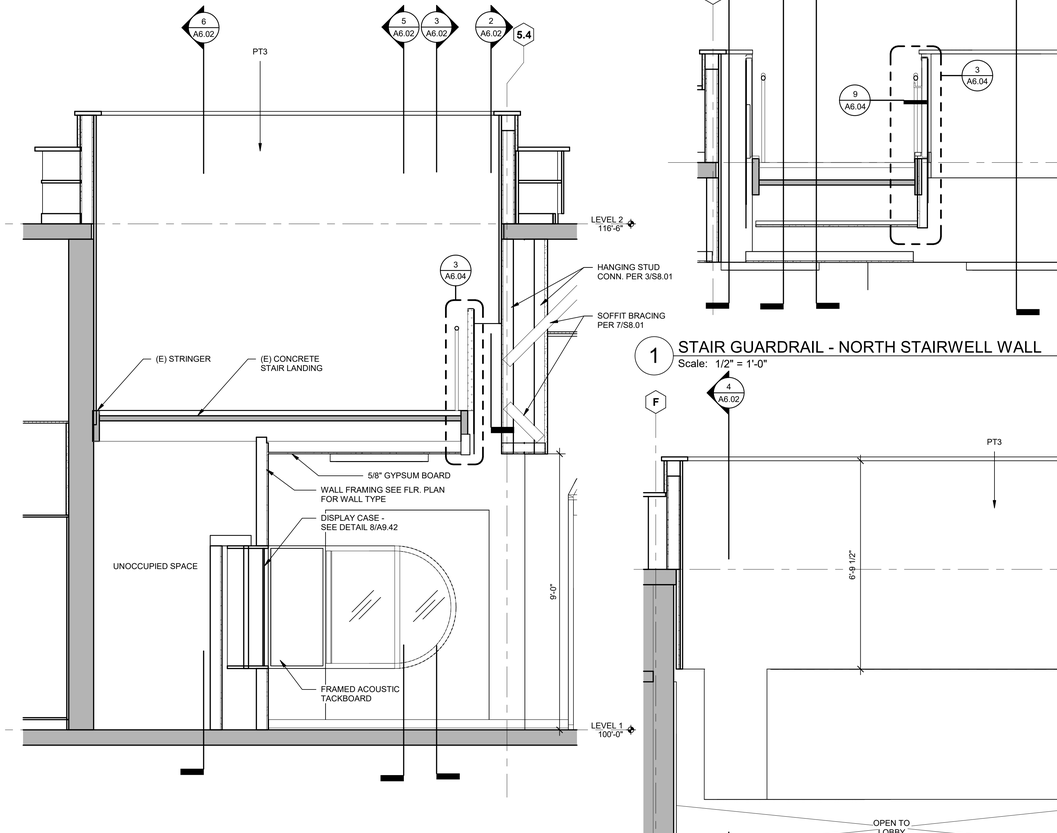

4 STAIR - SECTION 4
Scale: 1/2" = 1'-0"

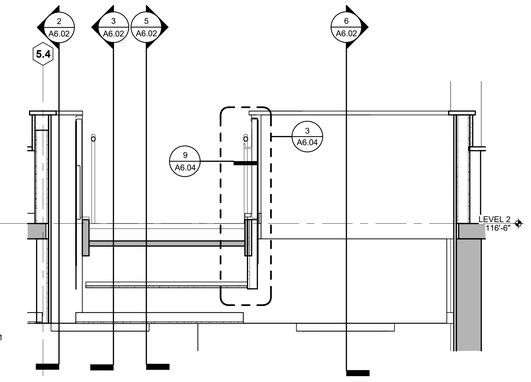

1 STAIR GUARDRAIL - NORTH STAIRWELL WALL
Scale: 1/2" = 1'-0"

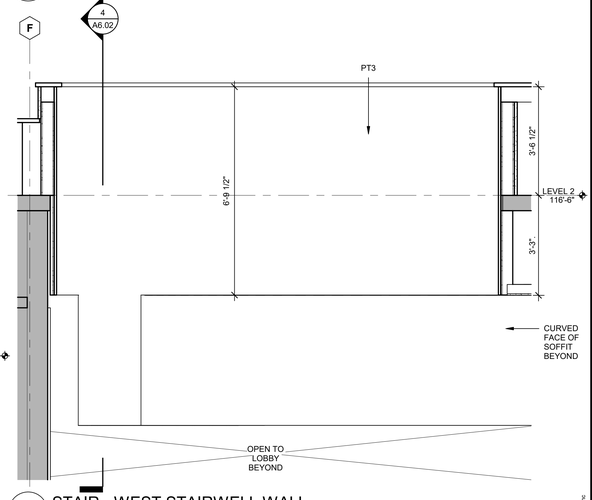

2 STAIR - WEST STAIRWELL WALL
Scale: 1/2" = 1'-0"

REVISIONS
2 Post-Plan Check Changes TBD

CONSTRUCTION DOCUMENTS

LICENSED ARCHITECT
VICTOR ORTEGA, JR.
No. C-34809
Exp. 8-31-25
STATE OF CALIFORNIA

LOS ANGELES COUNTY PUBLIC WORKS
HUNTINGTON PARK LIBRARY
6518 MILES AVE
HUNTINGTON PARK, CA 90255

COUNTY OF LOS ANGELES CALIFORNIA

LA COUNTY LIBRARY


NAC

NAC NO	161-23025
DRAWN	Author
CHECKED	Checker
DATE	11/01/2024


STAIR SECTIONS

A6.02


© 2023 NAC Inc

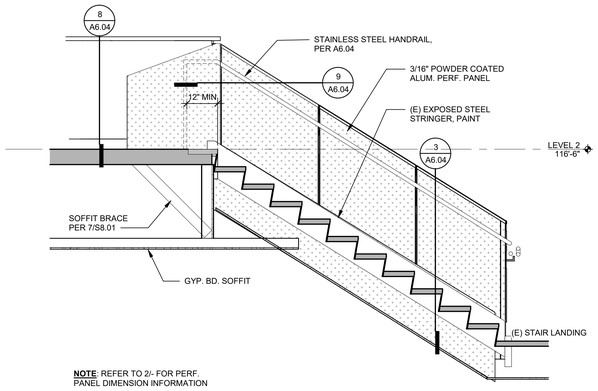


8 GUARDRAIL ELEVATION - EAST 2
Scale: 1/2" = 1'-0"

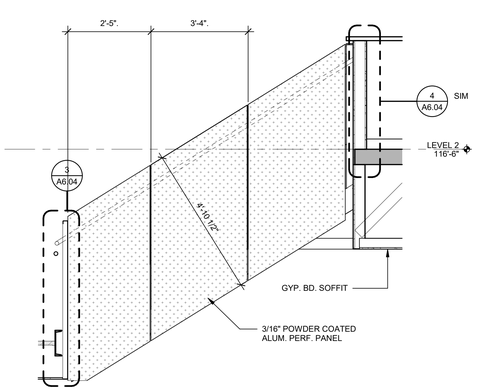


7 STAIR GUARDRAIL - CENTER GUARDRAIL
Scale: 1/2" = 1'-0"

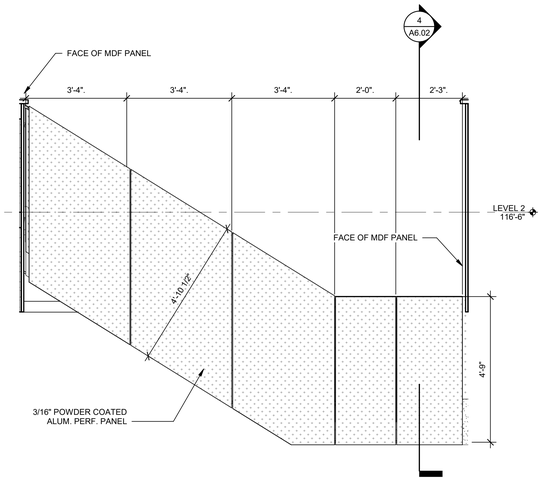


5 STAIR GUARDRAIL - WEST GUARDRAIL
Scale: 1/2" = 1'-0"

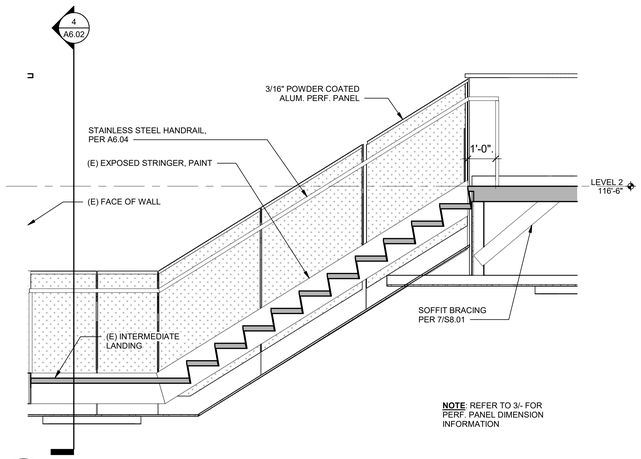


2 SE - GUARDRAIL ELEVATION - WEST 2
Scale: 1/2" = 1'-0"

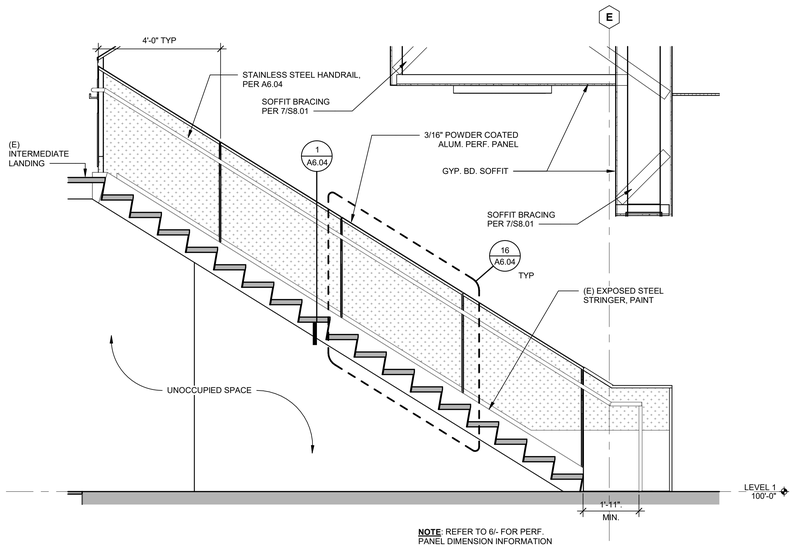

9 STAIR GUARDRAIL - EAST
Scale: 1/2" = 1'-0"

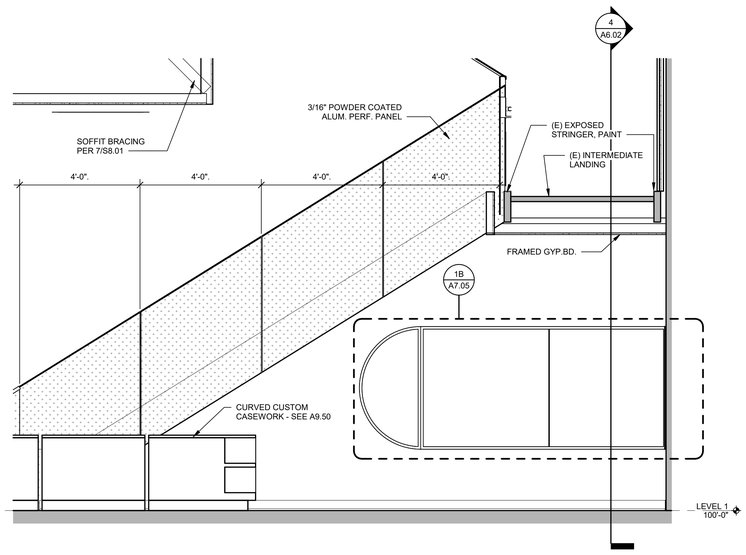

6 STAIR GUARDRAIL - EAST GUARDRAIL
Scale: 1/2" = 1'-0"

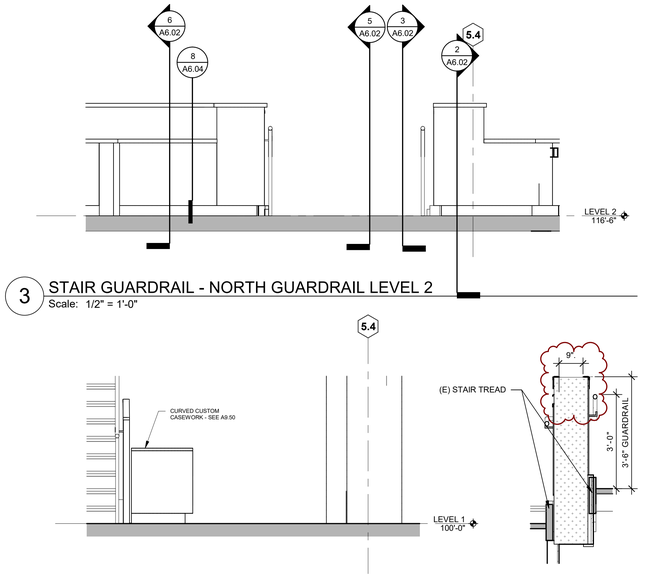

3 STAIR GUARDRAIL - NORTH GUARDRAIL LEVEL 2
Scale: 1/2" = 1'-0"

4 STAIR GUARDRAIL - NORTH GUARDRAIL
Scale: 1/2" = 1'-0"

1 GUARDRAIL - SOUTH
Scale: 1/2" = 1'-0"

REVISIONS
2 Post-Plan Check Changes TBD

CONSTRUCTION DOCUMENTS

LICENSED ARCHITECT
No. C-34809
Exp. 8-31-25
STATE OF CALIFORNIA

LOS ANGELES COUNTY PUBLIC WORKS
HUNTINGTON PARK LIBRARY
6518 MILES AVE
HUNTINGTON PARK, CA 90255

COUNTY OF LOS ANGELES CALIFORNIA

LA COUNTY LIBRARY


NAC

NAC NO	161-23025
DRAWN	Author
CHECKED	Checker
DATE	11/01/2024


GUARDRAIL ELEVATIONS

A6.03


© 2023 NAC Inc

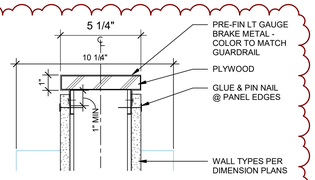


13 STAIRWELL WALL CAP
Scale: 3" = 1'-0"

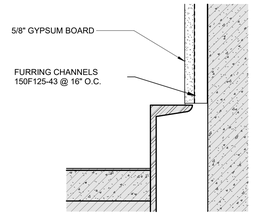


10 STRINGER TOP @ EX CONC WALL
Scale: 3" = 1'-0"

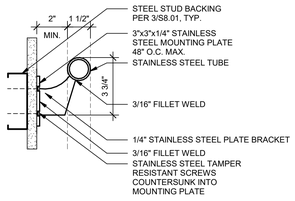


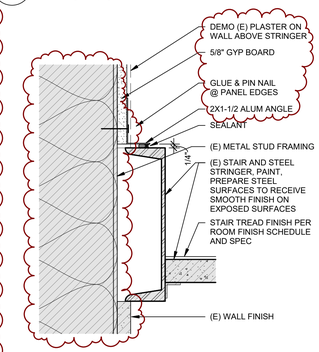


11 STAIR STRINGER @ STUD WALL
Scale: 3" = 1'-0"

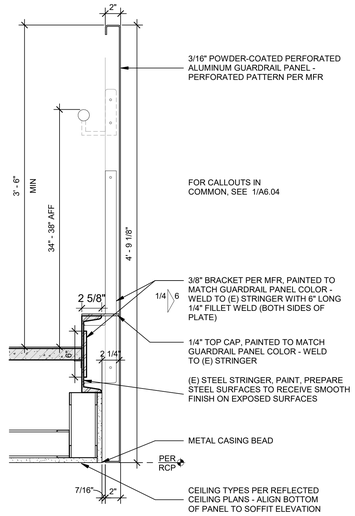


3 TYPICAL GUARDRAIL AT SOFFIT
Scale: 1 1/2" = 1'-0"

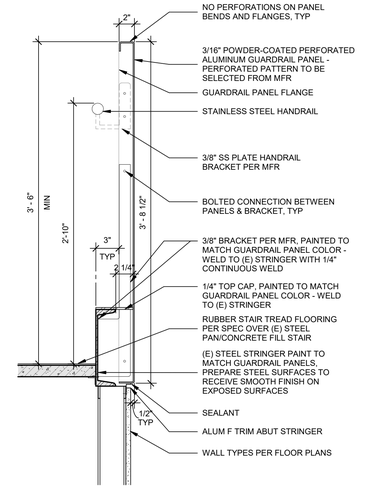


1 TYPICAL GUARDRAIL
Scale: 1 1/2" = 1'-0"

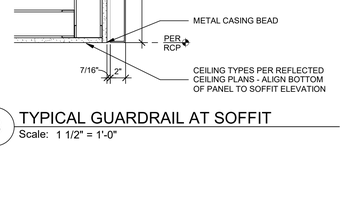


6 HANDRAIL POST @ DECK
Scale: 1 1/2" = 1'-0"

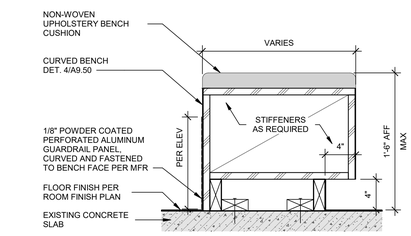


2 BENCH AT CURVED METAL PANEL
Scale: 1 1/2" = 1'-0"

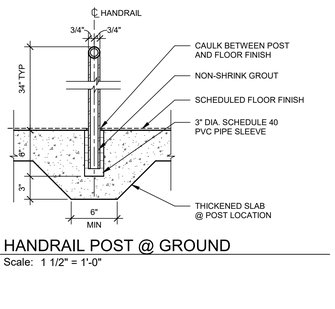


7 HANDRAIL POST @ GROUND
Scale: 1 1/2" = 1'-0"

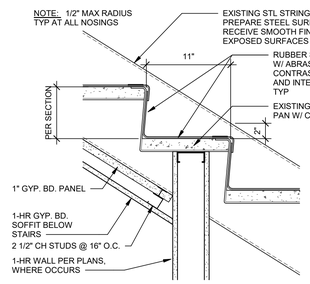


12 STL PAN STAIR
Scale: 1 1/2" = 1'-0"

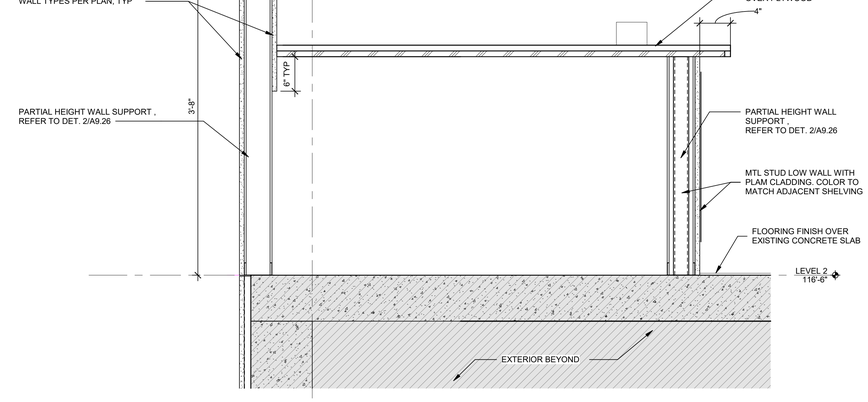


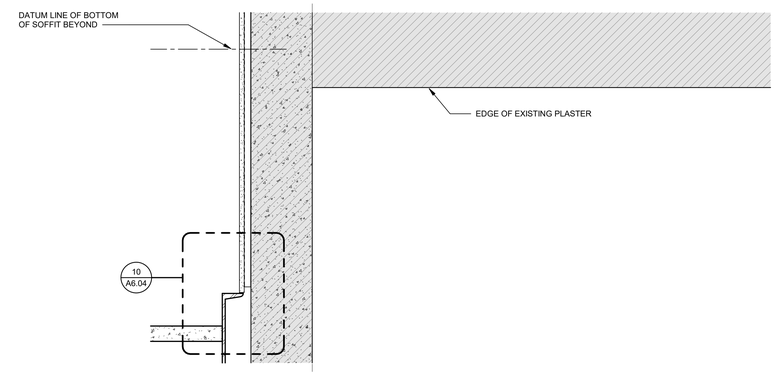


4 TYPICAL PERIMETER WALL DETAIL
Scale: 1 1/2" = 1'-0"

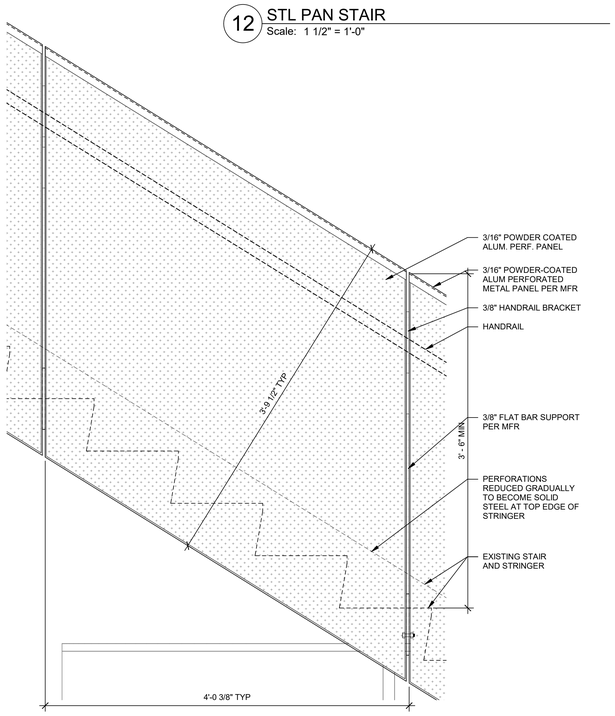

16 GUARDRAIL ELEVATION - SLOPED
Scale: 1 1/2" = 1'-0"

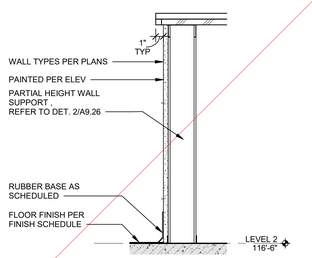

8 PERFORATED PANEL @ CASEWORK
Scale: 1 1/2" = 1'-0"

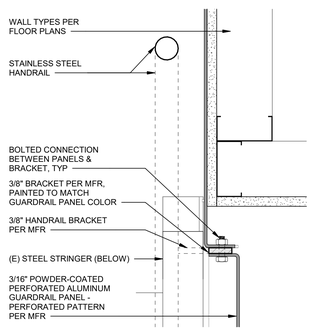

9 PLAN - GUARDRAIL AT TOP OF STAIR
Scale: 3" = 1'-0"

REVISIONS
2 Post-Plan Check TBD
Changes

CONSTRUCTION DOCUMENTS

LICENSED ARCHITECT
ELVIRA ORTEGA
No. C-34809
Exp. 8-31-25
STATE OF CALIFORNIA

LOS ANGELES COUNTY PUBLIC WORKS

HUNTINGTON PARK LIBRARY

6518 MILES AVE
HUNTINGTON PARK, CA 90255

COUNTY OF LOS ANGELES CALIFORNIA

LA COUNTY LIBRARY


NAC

NAC NO	161-23025
DRAWN	Author
CHECKED	Checker
DATE	11/01/2024


VERTICAL CIRCULATION DETAILS

A6.04


© 2023 NAC Inc.

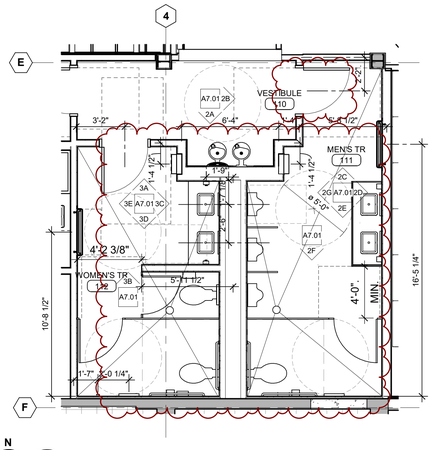


N 1A ENLARGED TOILETS 111 & 112
1/4" = 1'-0"

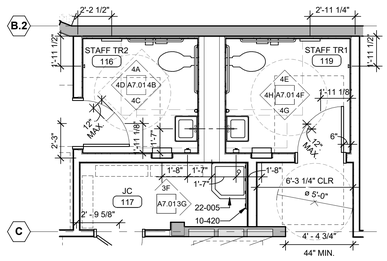

N 1B ENLARGED TOILETS 116 & 119
1/4" = 1'-0"

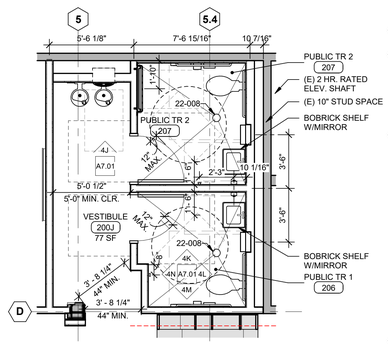

N 1C ENLARGED TOILETS 206 & 207
1/4" = 1'-0"

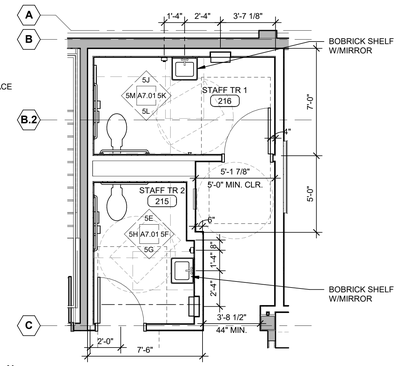


N 1D ENLARGED TOILETS 215 & 216
1/4" = 1'-0"


KEYNOTE LEGEND	
KEY VALUE	KEYNOTE TEXT
08-001	WOOD DOORS IN HOLLOW METAL FRAMES, REFER TO DOOR SCHEDULE SHEET A8.00
10-101	RESTROOM SIGNAGE REFER TO DETAIL 6/A9.31
10-102	VINYL GRAPHIC ON DOOR PER LIBRARY SIGNAGE STANDARDS MANUAL
10-402	TOILET TISSUE DISPENSER SEE SPEC. SECTION 10 2800.
10-403	WASTE RECEPTACLE, SEE SPEC. SECTION 10 2800
10-405	SANITARY NAPKIN DISPOSAL UNIT, ACCESSIBLE STALL BOBRICK B353, SURFACE MOUNTED
10-406	SOAP DISPENSER (BASIS OF DESIGN PRODUCT: BOBRICK B-2111. PROVIDE SOAP TRAY BELOW.
10-407	COAT HOOK (BASIS OF DESIGN PRODUCT: BOBRICK B-671)
10-408	TOWEL DISPENSER/WASTE RECEPTACLE (BASIS OF DESIGN PRODUCT: BOBRICK B-3944)
10-409	TOILET SEAT COVER DISPENSER (BASIS OF DESIGN PRODUCT: BOBRICK B-221)
10-410	GRAB BAR, 36" LONG (BASIS OF DESING PRODUCT: BOBRICK B-6806 SERIES)
10-411	GRAB BAR, 48" LONG (LONG (BASIS OF DESING PRODUCT: BOBRICK B-6806 SERIES)
10-412	MIRROR WITH SHELF, SIZE: 18" X 36" (BASIS OF DESIGN PRODUCT BOBRICK B-292)
10-413	HORIZONTAL STAINLESS STEEL, SURFACE- MOUNTED BABY CHANGING STATION (BASIS OF DESIGN PRODUCT: KOALA KARE KB310 SSWM)
10-420	MOP AND BROOM HOLDER (BASIS OF DESIGN PRODUCT: BOBRICK B-239)
10-451	PHENOLIC TOILET PARTITION, REFER TO DETAILS 13 & 14 SHEET A9.26
22-002	URINAL
22-003	WATER CLOSET
22-005	FLOOR MOP SINK
22-006	LAVATORY
22-008	FLOOR DRAINS, REFER TO DETAIL 12 ON A9.25
22-013	HIGH-LOW DRINKING FOUNTAINS WITH BOTTLE FILLING STATIONS BACKING PER DETAILS 14 & 15/A9.25, 11/A9.26, COORDINATE W/PLUMBING DRAWINGS

TOILET ROOM GENERAL NOTES


1. SEE SHEET A3.13, A3.14, A3.15 AND A3.16 FOR SIGNAGE TYPES AND SHEET A9.31 FOR SIGNAGE DETAILS.
2. REFER TO SHEET A3.20 FOR FINISH INFORMATION AND ACCENT TILE PERCENTAGE WHERE NOTED.
3. PROVIDE COVE BASE TO MATCH FIELD COLOR OF WALL.
4. PROVIDE BULL NOSE TILE AT ALL OUTSIDE CORNERS.
5. REFER TO P0.02 FOR PLUMBING FIXTURE SCHEDULE.

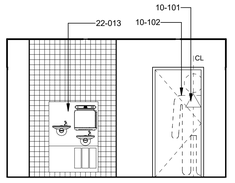


2A 110 SOUTH FF VESTIBULE
Scale: 1/4" = 1'-0"

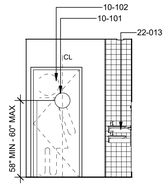


2B 110 EAST FF VESTIBULE
Scale: 1/4" = 1'-0"

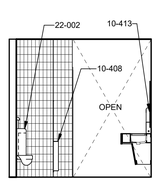


2C 111 NORTH FF WOMEN'S TR
Scale: 1/4" = 1'-0"

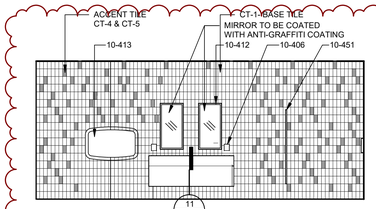


2D 111 EAST FF MEN'S TR
Scale: 1/4" = 1'-0"

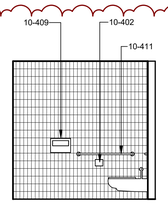


2E 111 SOUTH FF MEN'S
Scale: 1/4" = 1'-0"

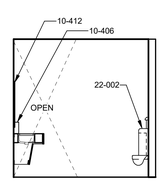


2F 111 SOUTH FF MEN'S
Scale: 1/4" = 1'-0"

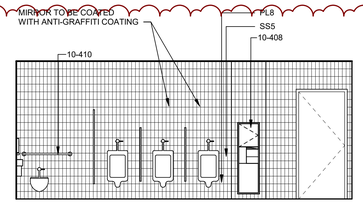


2G 111 WEST FF MEN'S TR
Scale: 1/4" = 1'-0"

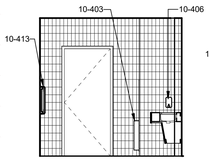


3A 112 NORTH FF WOMEN'S TR
Scale: 1/4" = 1'-0"

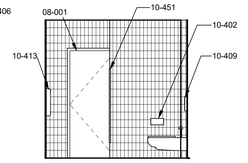


3B 112 NORTH 2 FF WOMENS TR
Scale: 1/4" = 1'-0"

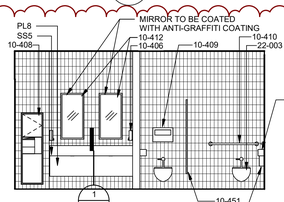


3C 112 EAST FF WOMENS TR
Scale: 1/4" = 1'-0"

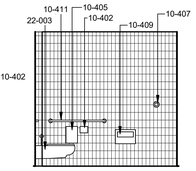


3D 112 SOUTH FF WOMENS TR
Scale: 1/4" = 1'-0"

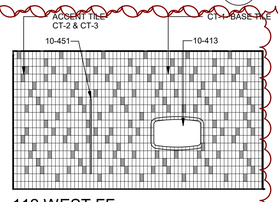


3E 112 WEST FF WOMENS TR
Scale: 1/4" = 1'-0"

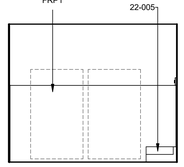


3F 117 NORTH JANITOR
Scale: 1/4" = 1'-0"

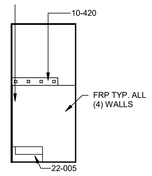


3G 117 EAST JANITOR
Scale: 1/4" = 1'-0"

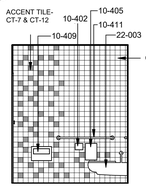


4A 116 NORTH FF STAFF TR2
Scale: 1/4" = 1'-0"

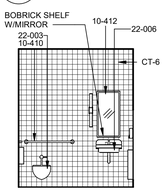


4B 116 EAST FF STAFF TR2
Scale: 1/4" = 1'-0"

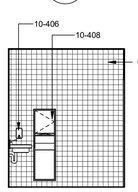


4C 116 SOUTH FF STAFF TR2
Scale: 1/4" = 1'-0"

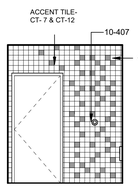


4D 116 WEST FF STAFF TR2
Scale: 1/4" = 1'-0"

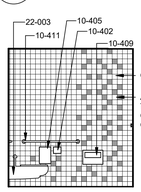


4E 119 NORTH FF STAFF TR1
Scale: 1/4" = 1'-0"

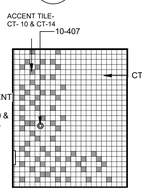


4F 119 EAST FF STAFF TR1
Scale: 1/4" = 1'-0"

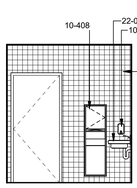


4G 119 SOUTH FF STAFF TR1
Scale: 1/4" = 1'-0"

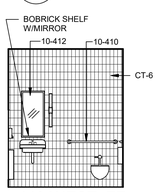


4H 119 WEST FF STAFF TR1
Scale: 1/4" = 1'-0"

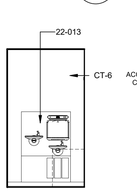


4J 200L NORTH SF VESTIBULE
Scale: 1/4" = 1'-0"

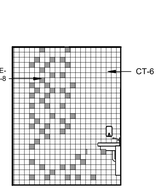


4K 206 NORTH SF PUBLIC TR1
Scale: 1/4" = 1'-0"

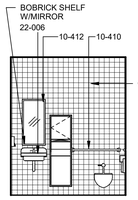


4L 206 EAST SF PUBLIC TR1
Scale: 1/4" = 1'-0"

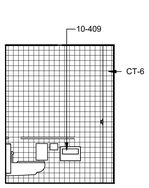


4M 206 SOUTH SF PUBLIC TR1
Scale: 1/4" = 1'-0"

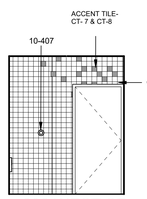


4N 206 WEST SF PUBLIC TR1
Scale: 1/4" = 1'-0"

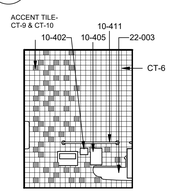


5A 207 NORTH SF PUBLIC TR2
Scale: 1/4" = 1'-0"

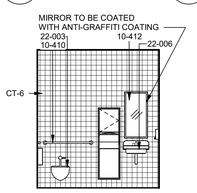


5B 207 EAST SF PUBLIC TR2
Scale: 1/4" = 1'-0"

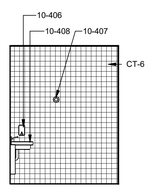


5C 207 SOUTH SF PUBLIC TR2
Scale: 1/4" = 1'-0"

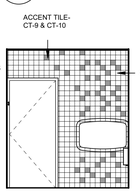


5D 207 WEST SF PUBLIC TR2
Scale: 1/4" = 1'-0"

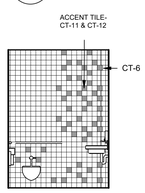


5E 215 NORTH SF STAFF TR2
Scale: 1/4" = 1'-0"

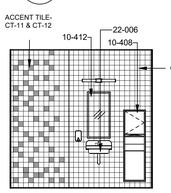


5F 215 EAST SF STAFF TR2
Scale: 1/4" = 1'-0"

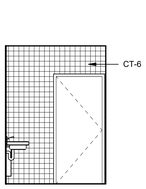


5G 215 SOUTH SF STAFF TR2
Scale: 1/4" = 1'-0"

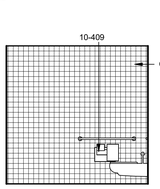


5H 215 WEST SF STAFF TR2
Scale: 1/4" = 1'-0"

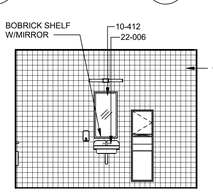


5J 216 NORTH SF STAFF TR2
Scale: 1/4" = 1'-0"

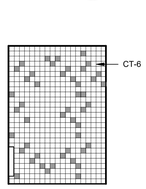


5K 216 EAST SF STAFF TR1
Scale: 1/4" = 1'-0"

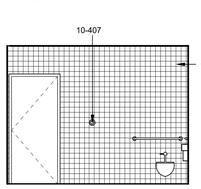


5L 216 SOUTH SF STAFF TR1
Scale: 1/4" = 1'-0"

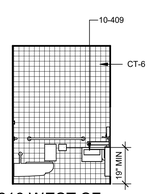


5M 216 WEST SF STAFF TR2
Scale: 1/4" = 1'-0"

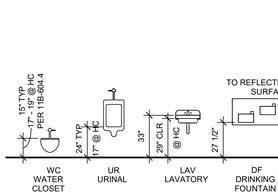

MOUNTING HEIGHTS
Scale: 1/4" = 1'-0"

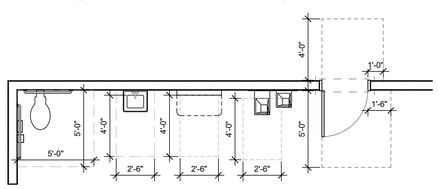

CLEAR FLOOR SPACE LEGEND
Scale: 1/4" = 1'-0"

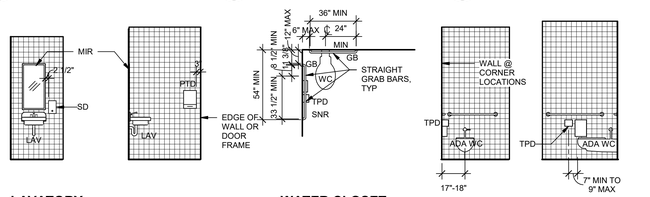

TYPICAL TOILET ROOM ACCESSORY ARRANGEMENTS
ALL DIMENSIONS TYPICAL, UNO

REVISIONS
2 Post-Plan Check TBD Changes

CONSTRUCTION DOCUMENTS

LICENSED ARCHITECT STEVEN ORTEGA No. C-34809 Exp. 8-31-25 STATE OF CALIFORNIA

LOS ANGELES COUNTY PUBLIC WORKS
HUNTINGTON PARK LIBRARY
6518 MILES AVE.
HUNTINGTON PARK, CA 90255

COUNTY OF LOS ANGELES CALIFORNIA

LA COUNTY LIBRARY


NAC

NAC NO	161-23025
DRAWN	Author
CHECKED	Checker
DATE	11/01/2024


ENLARGED TOILET PLANS & INTERIOR ELEVATIONS

A7.01


© 2023 NAC, Inc.

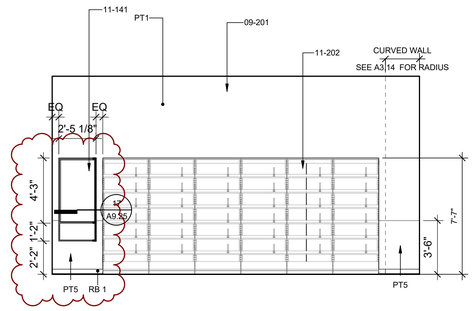


1A 100 WEST- LOBBY
Scale: 1/4" = 1'-0"

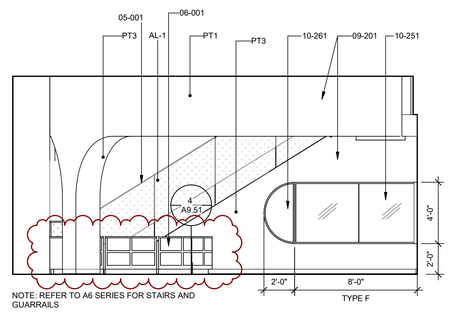


1B 100 EAST- LOBBY
Scale: 1/4" = 1'-0"

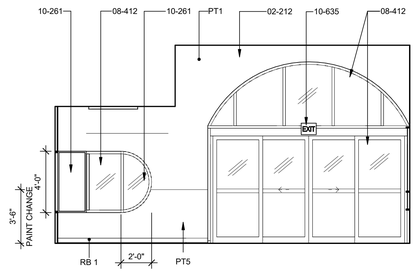


1C 100 SOUTH 2- LOBBY
Scale: 1/4" = 1'-0"

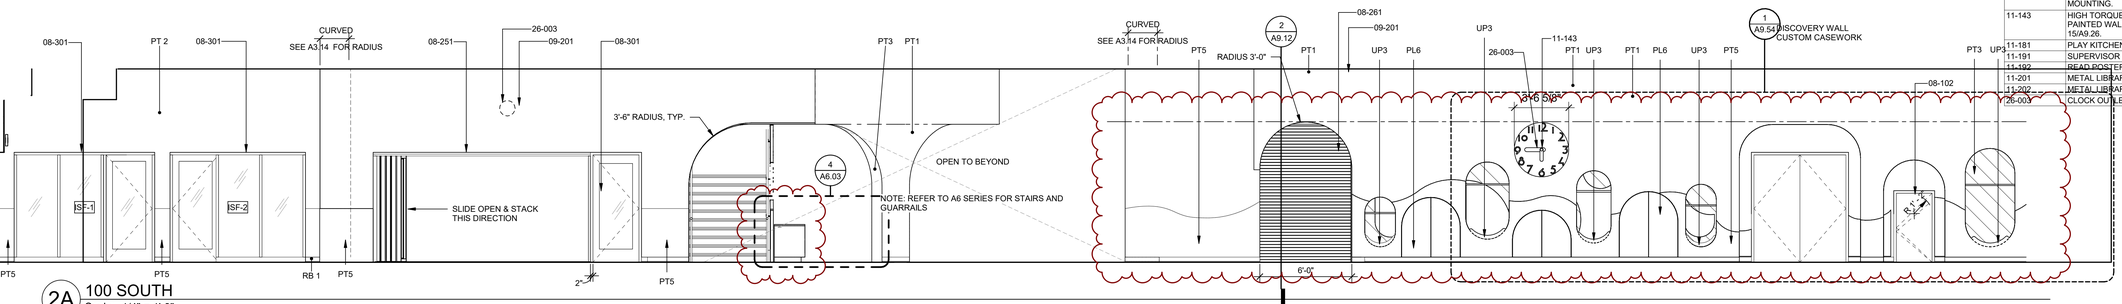


2A 100 SOUTH
Scale: 1/4" = 1'-0"

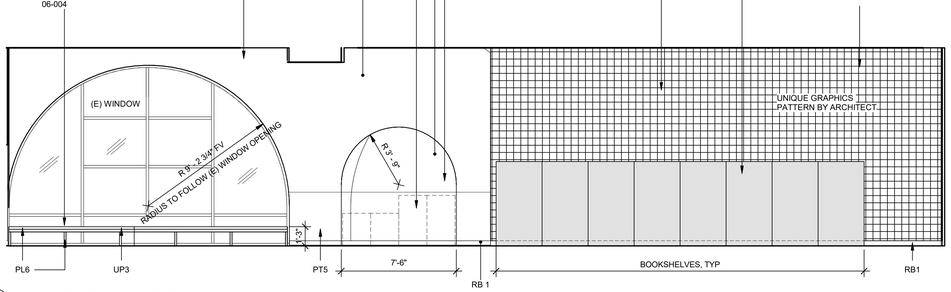


3A 102 WEST- CHILDREN'S
Scale: 1/4" = 1'-0"

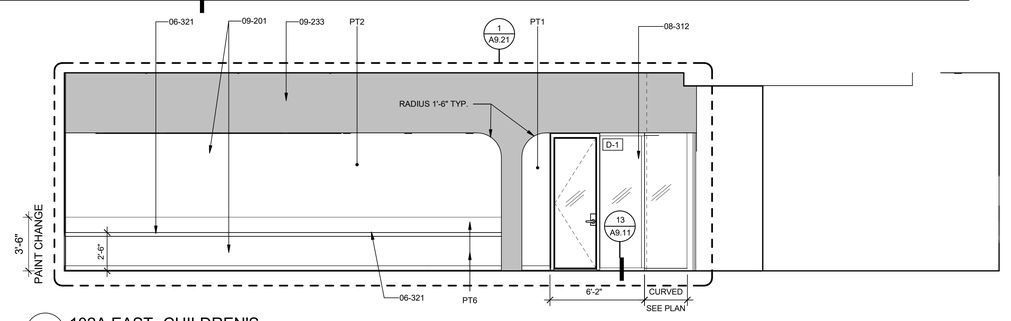


3B 102A EAST- CHILDREN'S
Scale: 1/4" = 1'-0"

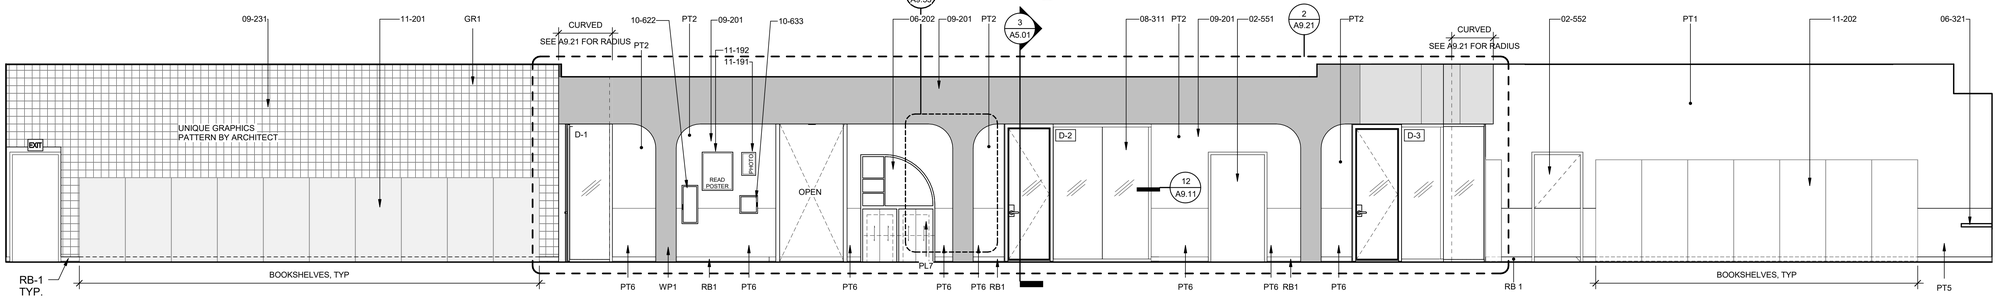

4AA 100 NORTH FULL
Scale: 1/4" = 1'-0"

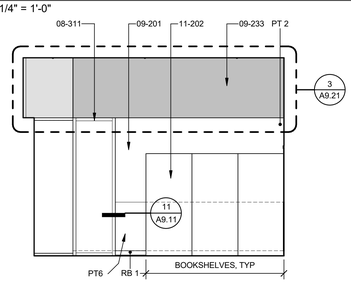

5A 101A WEST- TEENS
Scale: 1/4" = 1'-0"

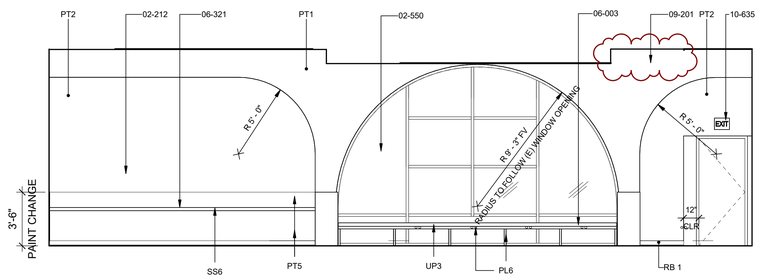

5B 101A EAST- TEENS
Scale: 1/4" = 1'-0"

7/16/2025 5:53:00 PM Autodesk Docs://161-23025 LADPW LAC Huntington Library Renovation/161-23025_Huntington-Park_Library.rvt

KEYNOTE LEGEND	
KEY VALUE	KEYNOTE TEXT
02-212	EXTERIOR CONCRETE WALLS TO BE RE-PAINTED.
02-550	WINDOWS AND WINDOW FRAMES TO REMAIN. PROTECT IN PLACE
02-551	ELEVATOR DOOR AND FRAME. PROTECT IN PLACE.
02-552	DOORS AND DOOR FRAMES TO REMAIN, REPLACE HARDWARE. PATCH, REPAIR DAMAGED SURFACES AND PAINT.
05-001	PERFORATED METAL GUARDRAIL. POWDER COATED.
06-001	MOVABLE DISPLAY CASEWORK WITH SOLID SURFACE TOP. REFER TO CASEWORK SHEETS
06-003	BUILT-IN BENCH WITH POWER OUTLETS. REFER TO DETAIL 10/A9.42
06-004	BUILT-IN BENCH. REFER TO DETAIL 10/A9.42
06-202	RECESSED, ARCHED SHELVING WITH LAPTOP CHARGING STATION IN BASE CABINET, CUSTOM MADE. REFER TO CASEWORK SHEETS.
06-321	CUSTOM P-LAM BUILT-IN COUNTER WITH INTEGRATED WIRE MANAGEMENT
08-102	SMALL ARCHED WOOD DOOR AND WOOD FRAME, REFER TO DOOR SCHEDULE SHEET A8.00 .
08-251	NON-THERMAL, ALUMINUM BI-FOLDING STOREFRONT SYSTEM, TOP HUNG, REFER TO STOREFRONT TYPES SHEET A8.00.
08-261	UPWARD COILING SECURITY GRILLE PER DETAIL 2/A9.12
08-301	NON-THERMAL, ALUMINUM STOREFRONTM REFER TO STORFRONT TYPES SHEET A8.00
08-311	DEMOUNTABLE GLASS WALL AND DOOR SYSTEM, CURVED, PER STOREFRONT TYPES SHEET A8.00
08-312	DEMOUNTABLE GLASS WALL AND DOOR SYSTEM, REFER TO STOREFRONT TYPES SHEET A8.00.
08-412	EXTERIOR STOREFRONT SYSTEM (THERMALLY SEPARATED), REFER TO STOREFRONT SCHEDULE SHEET A8.00
09-201	GYP. BOARD, PAINTED
09-231	1/2" ACOUSTICAL PANEL (PET FELT) WITH LARGE-SCALE CUSTOM GRAPHIC (FRICTION FIT AND ADHERED TO WALL). EACH PANEL HAS DIFFERENT GRAPHIC; GRAPHICS TO BE PROVIDED BY ARCHITECT.
09-233	INTERIOR WOOD VENEER LAMINATE PANEL ON Z-CLIP DETAILS SHEET A9.23
10-251	RECESSED DISPLAY CABINET IN FRAMED OPENING WITH ANODIZED ALUMINUM FRAME. 1/4" TEMPERED GLASS SLIDING DOORS WITH LOCK, ADJUSTABLE GLASS SHELVES AND INTEGRATED LIGHT FIXTURE.PER DETAIL8/A9.42
10-261	FRAMED ACOUSTIC TACKBOARD WITH ANODIZED ALUMINUM FRAME. FRAME WIDTH TO MATCH DISPLAY FRAME WIDTH.
10-622	FIRE EXTINGUISHER CABINET AND FIRE EXTINGUISHER, PER 16/A9.26
10-633	RECESSED AED CABINET PER 9/A9.26. (CABINET CFCI, EQUIPMENT OFOI)
10-635	ILLUMINATED EXIT SIGN REFER TO ELECTRICAL DRAWINGS.
11-141	DIGITAL DISPLAY SCREEN AND MOUNTING ARM IN WALL RECESS. RECESS TO BE FINISHED WITH GYP BOARD / PAINT PT-1 ON ALL SURFACES. SCREEN MTD. IN PORTRAIT ORIENTATION PROVIDE REQUIRED HARWARE. PROVIDE BACKING IN WALL FOR MOUNTING.
11-143	HIGH TORQUE QUARTZ CLOCK MOVEMENT WITH 18" HANDS, 11/16" CLOCK SHAFT LENGTH, PAINTED WALL GRAPHIC IN FIELD. PROVIDE WITH BACKING TO STUDS IN WALL PER DETAIL 15/A9.26.
11-181	PLAY KITCHEN (4 PIECE SET), OFOI
11-191	SUPERVISOR PHOTO, FRAMED (11" X 18"), OFOI
11-192	READ POSTER, FRAMED (24" X 30"), OFOI
11-201	METAL LIBRARY SHELVING, 60" TALL
11-202	METAL LIBRARY SHELVING, 82" TALL. REFER TO DETAILS SHEET S10.00
26-003	CLOCK OUTLET, PER TECHNOLOGY DRAWINGS

INTERIOR ELEVATIONS GENERAL NOTES

1. REFER TO SHEETS A3.13, A3.14, A3.15, AND A3.17 FOR SIGNAGE TYPES AND SHEET A9.70 FOR SIGNAGE DETAILS.
2. REFER TO SHEETS A3.13, A3.14, A3.15, AND A3.17 FOR ALL DIMENSIONS TO POSITION WALLS AND DOORS.
3. REFER SHEET A3.20 FOR FINISH INFORMATION WHERE NOTED.

GRAIN/ PATTERN FINISH DIRECTION

INDICATES LOCK ON CASEWORK CABINET/DRAWER
ALL CASEWORK DOORS & DRAWERS TO BE FURNISHED W/ LOCKS U.N.O

X-XX STOREFRONT / WINDOW NUMBER, REFER TO A8.00 FOR WINDOW SCHDULE

TYPE __ CASEWORK TYPE; REFER TO SHEET A9.42 FOR CASEWORK INFORMATION

REVISIONS
2 Post-Plan Check Changes TBD

CONSTRUCTION DOCUMENTS

LICENSED ARCHITECT
ELVIRA ORTEGA QUIROZ
No. C-34809
Exp. 8-31-25
STATE OF CALIFORNIA

LOS ANGELES COUNTY PUBLIC WORKS
HUNTINGTON PARK LIBRARY
6518 MILES AVE.
HUNTINGTON PARK, CA 90255

COUNTY OF LOS ANGELES CALIFORNIA

LA COUNTY LIBRARY


NAC

NAC NO	161-23025
DRAWN	Author
CHECKED	Checker
DATE	11/01/2024


INTERIOR ELEVATIONS

A7.05


© 2023 NAC Inc

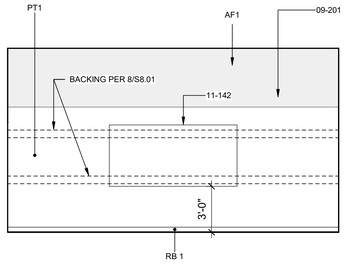


1A 113 WEST- COMMUNITY MEETING ROOM
Scale: 1/4" = 1'-0"

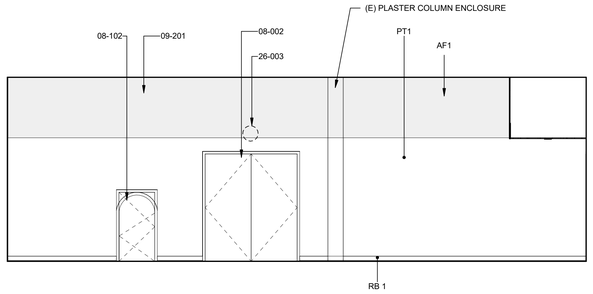


1B 113 NORTH- COMMUNITY MEETING ROOM
Scale: 1/4" = 1'-0"

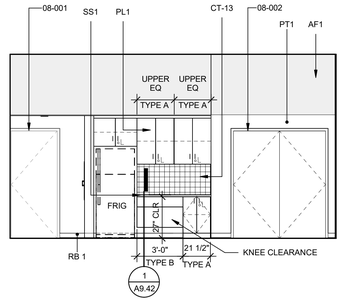


1C 113 EAST- COMMUNITY MEETING ROOM
Scale: 1/4" = 1'-0"

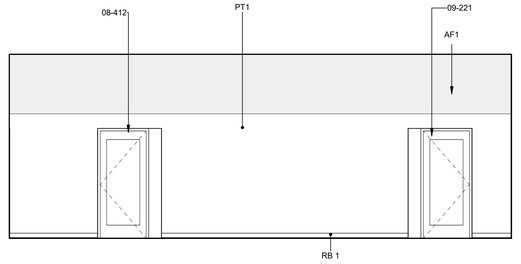


1D 113 SOUTH- COMMUNITY MEETING ROOM
Scale: 1/4" = 1'-0"

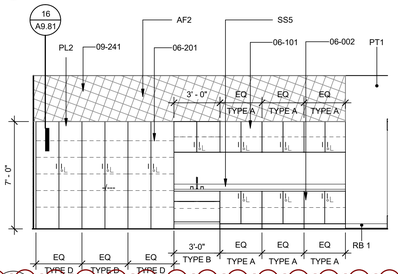


2A 103 WEST- THE STUDIO
Scale: 1/4" = 1'-0"

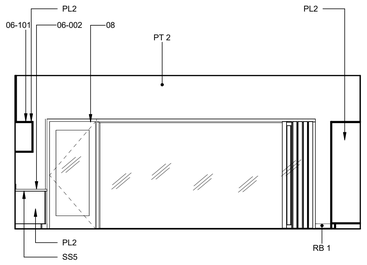

2B 103 NORTH-THE STUDIO
Scale: 1/4" = 1'-0"

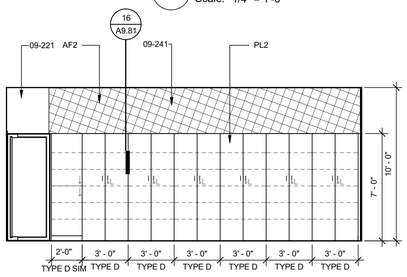

2C 103 EAST- THE STUDIO
Scale: 1/4" = 1'-0"

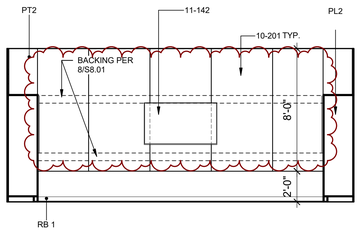

2D 103 SOUTH- THE STUDIO
Scale: 1/4" = 1'-0"

INTERIOR ELEVATIONS GENERAL NOTES


1. REFER TO SHEETS A3.13, A3.14, A3.15, AND A3.17 FOR SIGNAGE TYPES AND SHEET A9.70 FOR SIGNAGE DETAILS.
2. REFER TO SHEETS A3.13, A3.14, A3.15, AND A3.17 FOR ALL DIMENSIONS TO POSITION WALLS AND DOORS.
3. REFER SHEET A3.20 FOR FINISH INFORMATION WHERE NOTED.

GRAIN/ PATTERN FINISH DIRECTION


INDICATES LOCK ON CASEWORK CABINET/DRAWER
ALL CASEWORK DOORS & DRAWERS TO BE FURNISHED W/ LOCKS U.N.O

X-XX STOREFRONT / WINDOW NUMBER, REFER TO A8.00 FOR WINDOW SCHDULE


TYPE __ CASEWORK TYPE; REFER TO SHEET A9.42 FOR CASEWORK INFORMATION

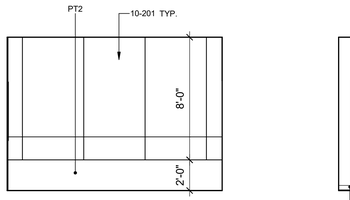


3A 104 WEST-STUDY T1
Scale: 1/4" = 1'-0"

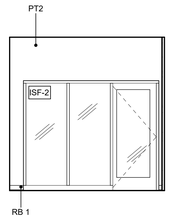


3B 104 NORTH-STUDY T1
Scale: 1/4" = 1'-0"

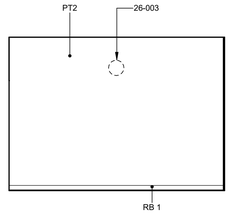


3C 104 EAST- STUDY T1
Scale: 1/4" = 1'-0"

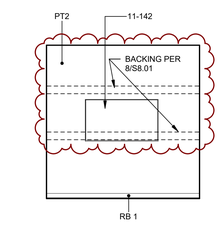


3D 104 SOUTH- STUDY T1
Scale: 1/4" = 1'-0"

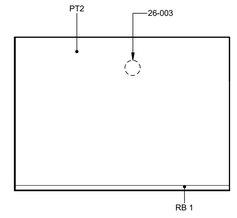


3E 105 WEST- STUDY T2
Scale: 1/4" = 1'-0"

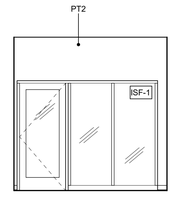


3F 105 NORTH- STUDY T2
Scale: 1/4" = 1'-0"

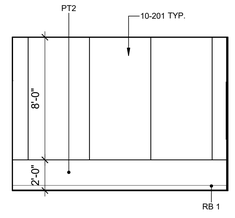


3G 105 EAST- STUDY T2
Scale: 1/4" = 1'-0"

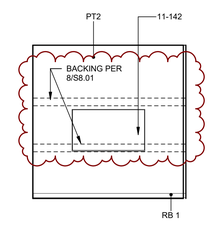


3H 105 SOUTH- STUDY T2
Scale: 1/4" = 1'-0"

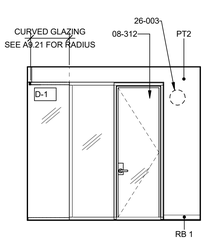


4A 107 WEST- CHILDREN'S LIBRARIAN
Scale: 1/4" = 1'-0"

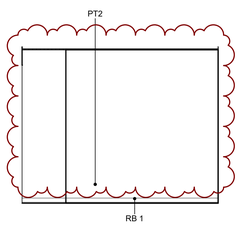


4B 107 NORTH- CHILDREN'S LIBRARIAN
Scale: 1/4" = 1'-0"

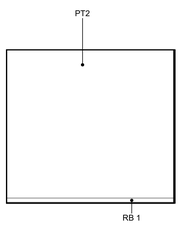


4C 107 EAST- CHILDREN'S LIBRARIAN
Scale: 1/4" = 1'-0"

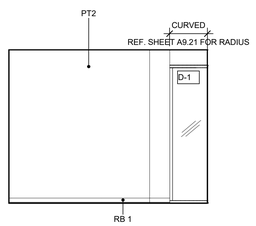


4D 107 SOUTH- CHILDREN'S LIBRARIAN
Scale: 1/4" = 1'-0"

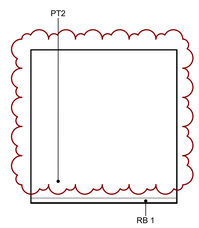


4E 109 WEST- CLM
Scale: 1/4" = 1'-0"

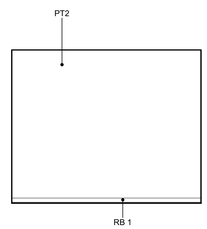


4F 109 NORTH- CLM
Scale: 1/4" = 1'-0"

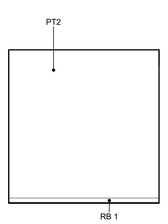


4G 109 EAST-CLM
Scale: 1/4" = 1'-0"

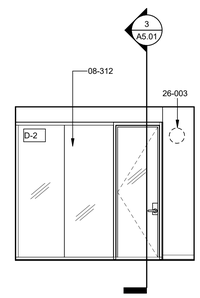


4H 109 SOUTH- CLM
Scale: 1/4" = 1'-0"

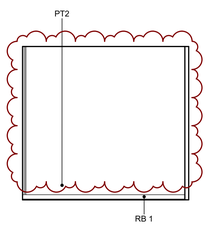


5A 106 WEST- TEENS LIBRARIAN
Scale: 1/4" = 1'-0"

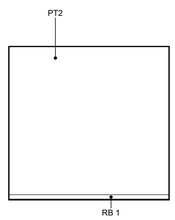

5B 106 NORTH- TEENS LIBRARIAN
Scale: 1/4" = 1'-0"

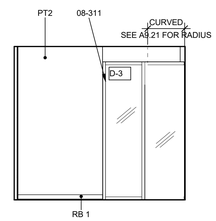

5C 106 EAST- TEENS LIBRARIAN
Scale: 1/4" = 1'-0"

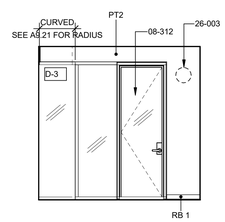

5D 106 SOUTH- TEENS LIBRARIAN
Scale: 1/4" = 1'-0"

KEYNOTE LEGEND	
KEY VALUE	KEYNOTE TEXT
06-002	BUILT-IN BASE CABINET WITH SILICA-FREE COUNTER TOP AND P-LAM FINISH.
06-101	BUILT-IN UPPER CABINET WITH P-LAM FINISH.
06-201	RECESSED, FULL-HEIGHT SHELVING
08	OPENING
08-001	WOOD DOORS IN HOLLOW METAL FRAMES, REFER TO DOOR SCHEDULE SHEET A8.00
08-002	PAIR OF WOOD DOORS IN HOLLOW METAL FRAME, REFER TO DOOR SCHEDULE SHEET A8.00
08-102	SMALL ARCHED WOOD DOOR AND WOOD FRAME, REFER TO DOOR SCHEDULE SHEET A8.00
08-311	DEMOUNTABLE GLASS WALL AND DOOR SYSTEM, CURVED, PER STOREFRONT TYPES SHEET A8.00
08-312	DEMOUNTABLE GLASS WALL AND DOOR SYSTEM, REFER TO STOREFRONT TYPES SHEET A8.00.
08-412	EXTERIOR STOREFRONT SYSTEM (THERMALLY SEPARATED), REFER TO STOREFRONT SCHEDULE SHEET A8.00
09-201	GYP. BOARD, PAINTED
09-221	LAMINATED WOOD PANEL AND Z-CLIP OVER GYP BOARD.
09-241	WOOD FIBER WALL PANEL WITH 1" ACOUSTICAL INSULATION BEHIND IT.
10-201	WALL TO WALL WHITE BOARD, 47" WIDE X 96" HIGH, FRAMELESS
11-142	TV DISPLAY SCREEN MOUNTED ON ADJUSTABLE ARM/BRACKET CFCI. PROVIDE WITH BACKING IN WALL PER DETAIL 15/A9.26.
26-003	CLOCK OUTLET, PER TECHNOLOGY DRAWINGS

REVISIONS
2 Post-Plan Check Changes TBD

CONSTRUCTION DOCUMENTS

LICENSED ARCHITECT
LISA ORTEGA-ORTIZ
No. C-34809
Exp. 8-31-25
STATE OF CALIFORNIA

LOS ANGELES COUNTY PUBLIC WORKS
HUNTINGTON PARK LIBRARY
6518 MILES AVE.
HUNTINGTON PARK, CA 90255

COUNTY OF LOS ANGELES CALIFORNIA

LA COUNTY LIBRARY


NAC

NAC NO	161-23025
DRAWN	Author
CHECKED	Checker
DATE	11/01/2024


INTERIOR ELEVATIONS

A7.06


© 2023 NAC Inc.

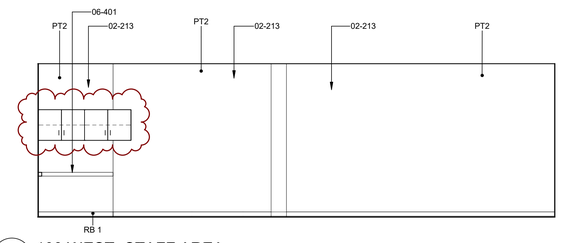


1A 108 WEST- STAFF AREA
Scale: 1/4" = 1'-0"

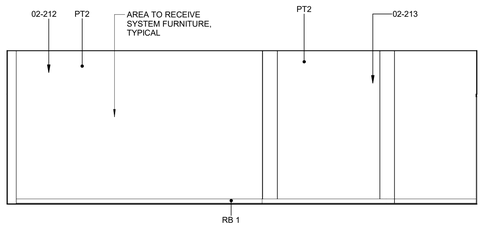


1B 108 NORTH- STAFF AREA
Scale: 1/4" = 1'-0"

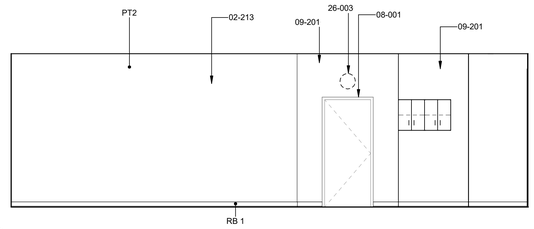


1C 108 EAST- STAFF AREA
Scale: 1/4" = 1'-0"

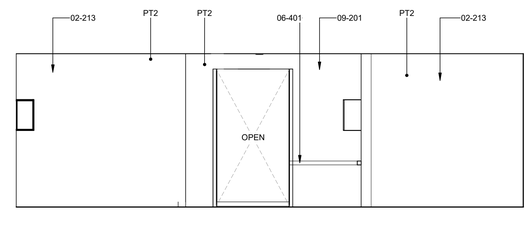


1D 108 SOUTH- STAFF AREA
Scale: 1/4" = 1'-0"

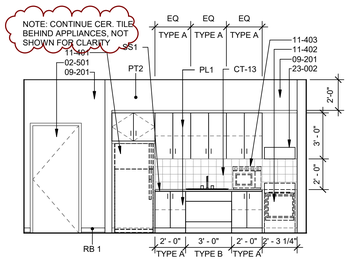


2A 121 WEST- STAFF LOUNGE
Scale: 1/4" = 1'-0"

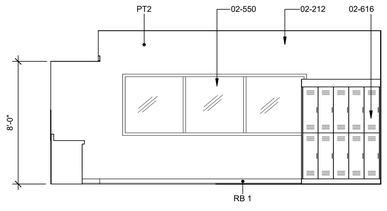

2B 121 NORTH- STAFF LOUNGE
Scale: 1/4" = 1'-0"

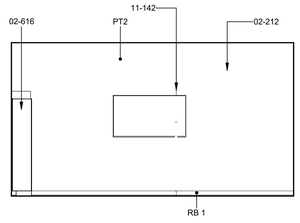

2C 121 EAST- STAFF LOUNGE
Scale: 1/4" = 1'-0"

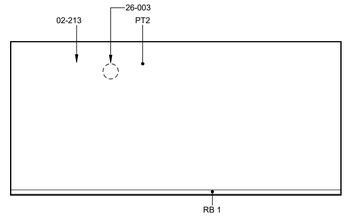

2D 121 SOUTH- STAFF LOUNGE
Scale: 1/4" = 1'-0"

INTERIOR ELEVATIONS GENERAL NOTES

1. REFER TO SHEETS A3.13, A3.14, A3.15, AND A3.17 FOR SIGNAGE TYPES AND SHEET A9.70 FOR SIGNAGE DETAILS.
2. REFER TO SHEETS A3.13, A3.14, A3.15, AND A3.17 FOR ALL DIMENSIONS TO POSITION WALLS AND DOORS.
3. REFER SHEET A3.20 FOR FINISH INFORMATION WHERE NOTED.

GRAIN/ PATTERN FINISH DIRECTION

INDICATES LOCK ON CASEWORK CABINET/DRAWER
ALL CASEWORK DOORS & DRAWERS TO BE FURNISHED W/ LOCKS U.N.O

X-XX STOREFRONT / WINDOW NUMBER, REFER TO A8.00 FOR WINDOW SCHDULE

TYPE __ CASEWORK TYPE; REFER TO SHEET A9.42 FOR CASEWORK INFORMATION

KEYNOTE LEGEND	
KEY VALUE	KEYNOTE TEXT
02-212	EXTERIOR CONCRETE WALLS TO BE RE-PAINTED.
02-213	PLASTER WALL PARTITION TO BE RE-PAINTED.
02-501	DOORS, FRAMES & HARDWARE INCLUDING ALL ANCHORS & ATTACHMENTS TO BE REMOVED
02-550	WINDOWS AND WINDOW FRAMES TO REMAIN. PROTECT IN PLACE
02-616	RELOCATED LOCKERS. RE-INSTALL, PAINT EXTERIOR AND INTERIOR.
06-401	HARDWOOD CHAIR RAIL. PAINTED TO MATCH ADJACENT WALL. MOUNTED AT 32" AFF. VERIFY MOUNTING HEIGHT WITH LIBRARY BEFORE INSTALLATION.
08-001	WOOD DOORS IN HOLLOW METAL FRAMES, REFER TO DOOR SCHEDULE SHEET A8.00
09-201	GYP. BOARD, PAINTED
11-142	TV DISPLAY SCREEN MOUNTED ON ADJUSTABLE ARM/BRACKET CFCI. PROVIDE WITH BACKING IN WALL PER DETAIL 15/A9.26.
11-401	REFRIGERATOR, CFCI.
11-402	ELECTRIC RANGE WITH OVEN. CFCI.
11-403	MICROWAVE, OFOI.
23-002	KITCHEN HOOD. CFCI.
26-003	CLOCK OUTLET, PER TECHNOLOGY DRAWINGS

REVISIONS

2	Post-Plan Check Changes	7/15/25
3	Add-01	7/31/25

CONSTRUCTION DOCUMENTS

LICENSED ARCHITECT
LEIDA ORTEGA-ORTIZ
No. C-34809
Exp. 8-31-25
STATE OF CALIFORNIA

LOS ANGELES COUNTY PUBLIC WORKS
HUNTINGTON PARK LIBRARY
6518 MILES AVE
HUNTINGTON PARK, CA 90255

COUNTY OF LOS ANGELES CALIFORNIA

LA COUNTY LIBRARY


NAC

NAC NO	161-23025
DRAWN	Author
CHECKED	Checker
DATE	11/01/2024


INTERIOR ELEVATIONS

A7.07


© 2023 NAC, Inc.

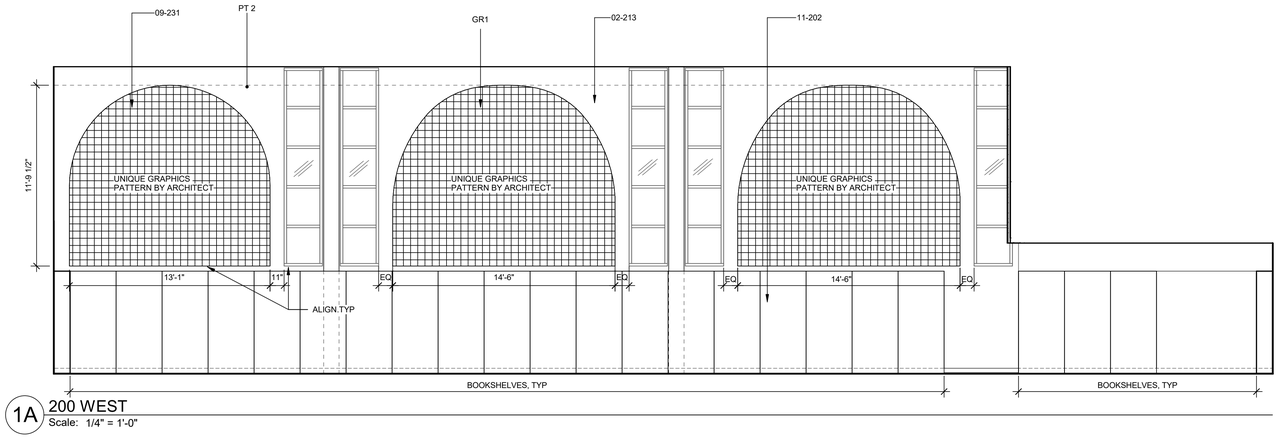


1A 200 WEST
Scale: 1/4" = 1'-0"

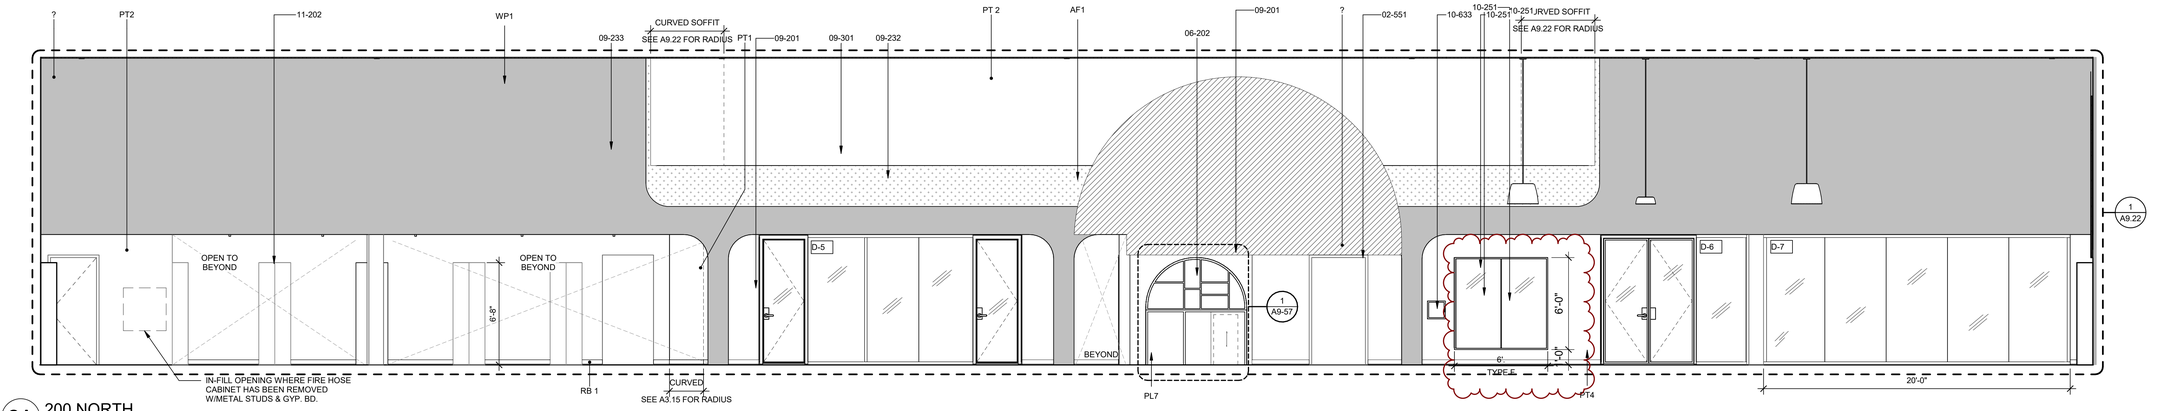

2A 200 NORTH
Scale: 1/4" = 1'-0"

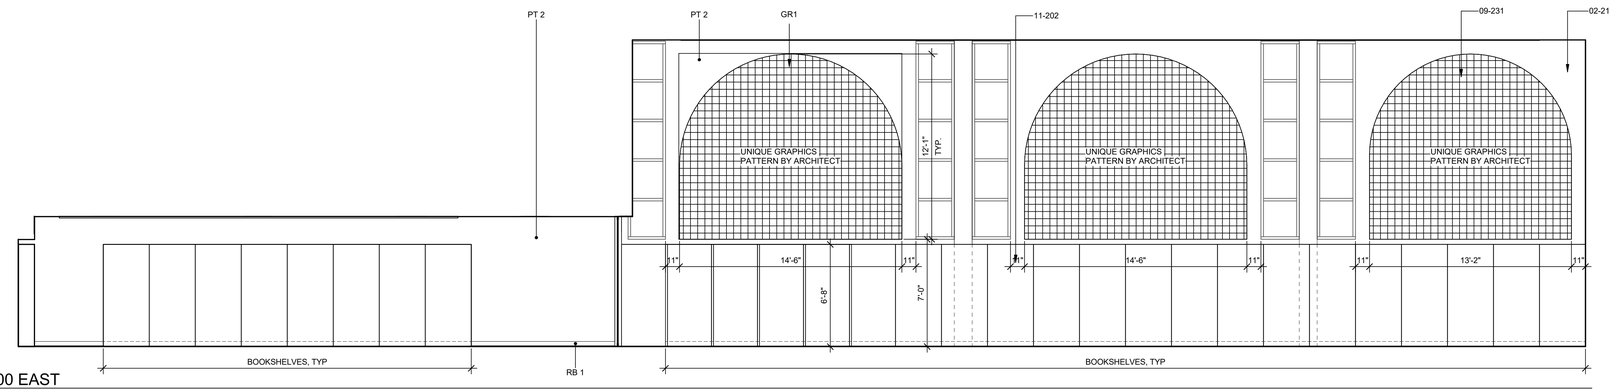

3A 200 EAST
Scale: 1/4" = 1'-0"

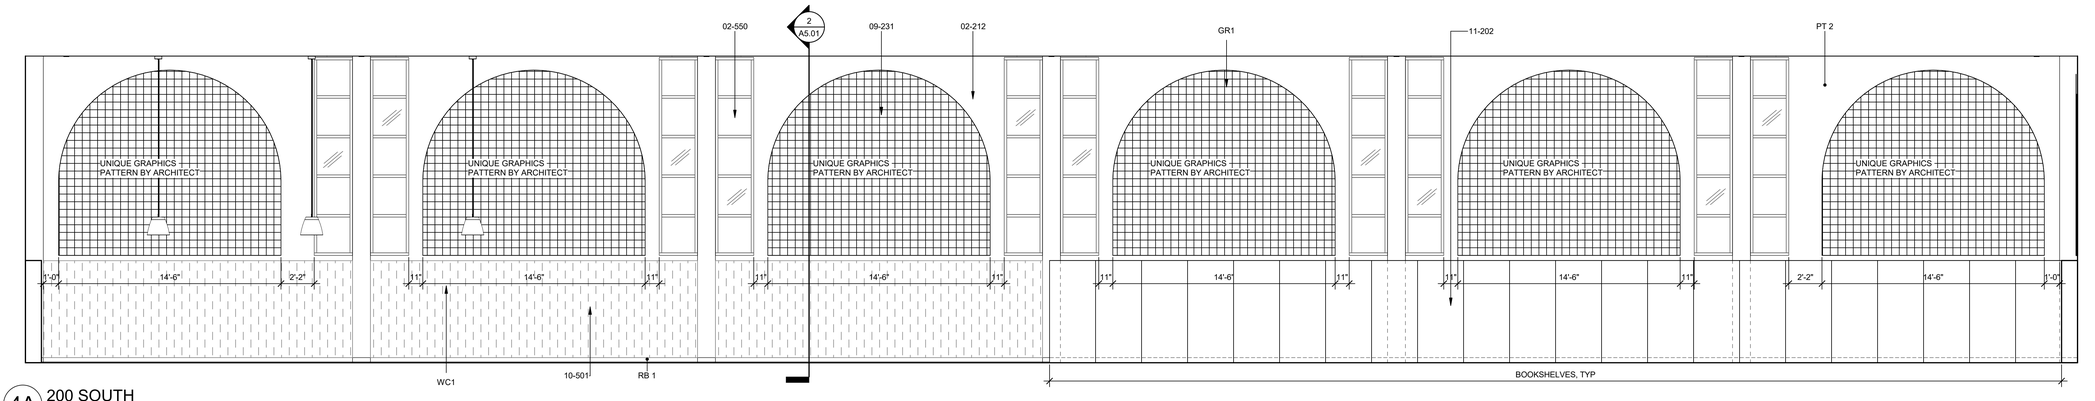

4A 200 SOUTH
Scale: 1/4" = 1'-0"

KEYNOTE LEGEND	
KEY VALUE	KEYNOTE TEXT
02-212	EXTERIOR CONCRETE WALLS TO BE RE-PAINTED.
02-213	PLASTER WALL PARTITION TO BE RE-PAINTED.
02-550	WINDOWS AND WINDOW FRAMES TO REMAIN. PROTECT IN PLACE
02-551	ELEVATOR DOOR AND FRAME. PROTECT IN PLACE.
06-202	RECESSED, ARCHED SHELVING WITH LAPTOP CHARGING STATION IN BASE CABINET, CUSTOM MADE. REFER TO CASEWORK SHEETS.
09-201	GYP. BOARD, PAINTED
09-231	1/2" ACOUSTICAL PANEL (PET FELT) WITH LARGE-SCALE CUSTOM GRAPHIC (FRICTION FIT AND ADHERED TO WALL). EACH PANEL HAS DIFFERENT GRAPHIC; GRAPHICS TO BE PROVIDED BY ARCHITECT.
09-232	1/2" ACOUSTICAL PANEL (PET FELT), PERFORATED, REFER TO DETAILS SHEET A9.25
09-233	INTERIOR WOOD VENEER LAMINATE PANEL ON Z-CLIP DETAILS SHEET A9.23
09-301	PAINTED GYP. BOARD SOFFIT, PER DETAILS 2/A9.81 @ ACT. & 10/A9.81 @ GYP.BD. CLG.
10-251	RECESSED DISPLAY CABINET IN FRAMED OPENING WITH ANODIZED ALUMINUM FRAME, 1/4" TEMPERED GLASS SLIDING DOORS WITH LOCK, ADJUSTABLE GLASS SHELVES AND INTEGRATED LIGHT FIXTURE PER DETAIL8/A9.42
10-501	WALLCOVERING. START AND STOP AT V-GROOVE OF COLUMN
10-633	RECESSED AED CABINET PER 9/A9.26. (CABINET CFCI, EQUIPMENT OFOI)
11-202	METAL LIBRARY SHELVING, 82" TALL, REFER TO DETAILS SHEET S10.00

INTERIOR ELEVATIONS GENERAL NOTES

1. REFER TO SHEETS A3.13, A3.14, A3.15, AND A3.17 FOR SIGNAGE TYPES AND SHEET A9.70 FOR SIGNAGE DETAILS.
2. REFER TO SHEETS A3.13, A3.14, A3.15, AND A3.17 FOR ALL DIMENSIONS TO POSITION WALLS AND DOORS.
3. REFER SHEET A3.20 FOR FINISH INFORMATION WHERE NOTED.

GRAIN/ PATTERN FINISH DIRECTION

INDICATES LOCK ON CASEWORK CABINET/DRAWER
ALL CASEWORK DOORS & DRAWERS TO BE FURNISHED W/ LOCKS U.N.O

X-XX STOREFRONT / WINDOW NUMBER, REFER TO A8.00 FOR WINDOW SCHDULE

TYPE __ CASEWORK TYPE; REFER TO SHEET A9.42 FOR CASEWORK INFORMATION

REVISIONS
2 Post-Plan Check Changes TBD

CONSTRUCTION DOCUMENTS

LICENSED ARCHITECT
VICTOR ORTEGA, JR.
No. C-34809
Exp. 8-31-25
STATE OF CALIFORNIA

LOS ANGELES COUNTY PUBLIC WORKS
HUNTINGTON PARK LIBRARY
6518 MILES AVE
HUNTINGTON PARK, CA 90255

COUNTY OF LOS ANGELES CALIFORNIA

LA COUNTY LIBRARY


NAC

NAC NO	161-23025
DRAWN	Author
CHECKED	Checker
DATE	11/01/2024


INTERIOR ELEVATIONS

A7.08


© 2023 NAC Inc.

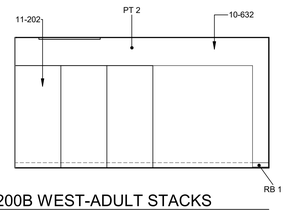


1A 200B WEST-ADULT STACKS
Scale: 1/4" = 1'-0"

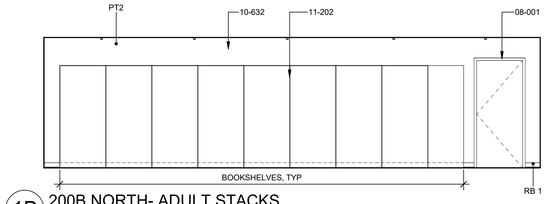


1B 200B NORTH- ADULT STACKS
Scale: 1/4" = 1'-0"

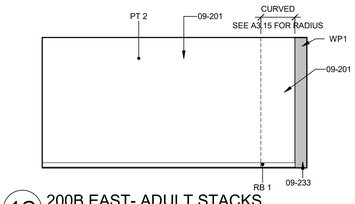


1C 200B EAST- ADULT STACKS
Scale: 1/4" = 1'-0"

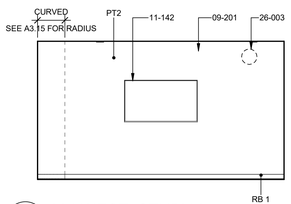


2A 204 WEST- STUDY 2
Scale: 1/4" = 1'-0"

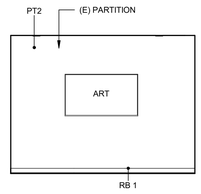


2B 204 NORTH- STUDY 2
Scale: 1/4" = 1'-0"

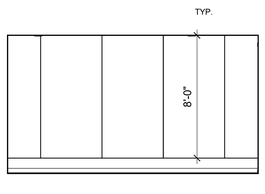


2C 204 EAST- STUDY 2
Scale: 1/4" = 1'-0"

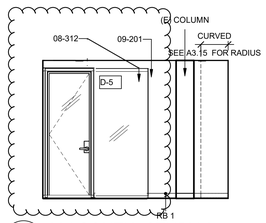


2D 204 SOUTH- STUDY 2
Scale: 1/4" = 1'-0"

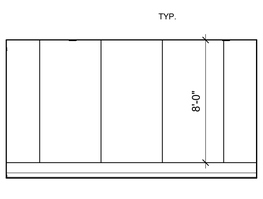


3A 205 WEST- STUDY
Scale: 1/4" = 1'-0"

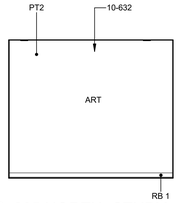


3B 205 NORTH- STUDY
Scale: 1/4" = 1'-0"

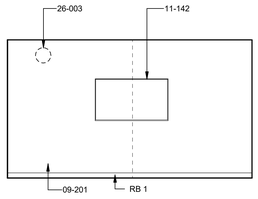


3C 205 EAST- STUDY
Scale: 1/4" = 1'-0"

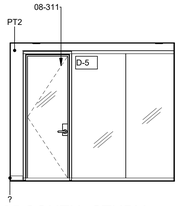


3D 205 SOUTH- STUDY
Scale: 1/4" = 1'-0"

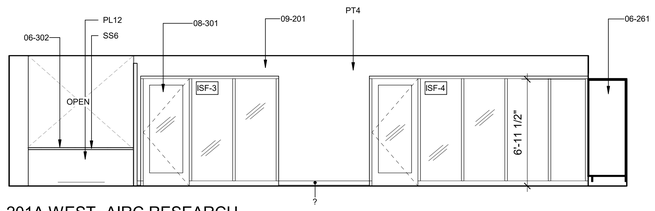


3F 201A WEST- AIRC RESEARCH
Scale: 1/4" = 1'-0"

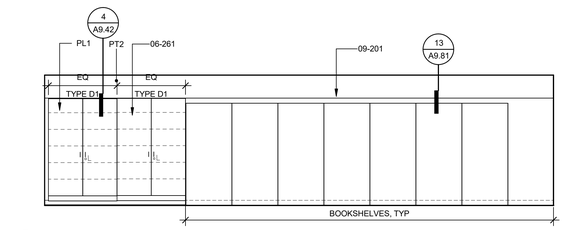


4A 201B NORTH- AIRC STACKS
Scale: 1/4" = 1'-0"

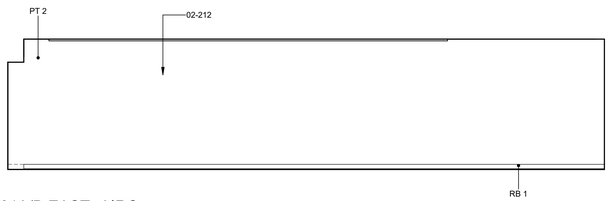


4B 201A/B EAST- AIRC
Scale: 1/4" = 1'-0"

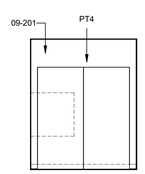


4C 201 WEST- AIRC INFO
Scale: 1/4" = 1'-0"

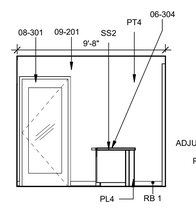


4D 201 NORTH- AIRC INFO
Scale: 1/4" = 1'-0"

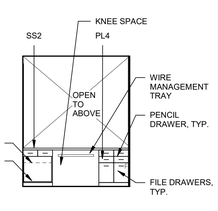


4E 201 EAST- AIRC INFO
Scale: 1/4" = 1'-0"

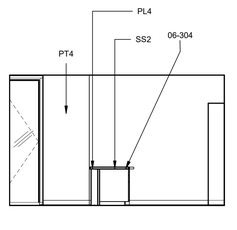


4F 201 SOUTH
Scale: 1/4" = 1'-0"

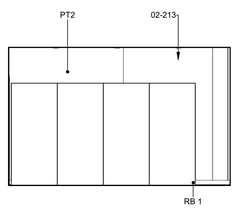


5A 202 WEST- AIRC OFFICE
Scale: 1/4" = 1'-0"

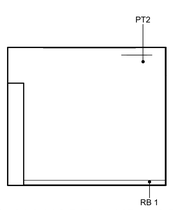


5B 202 NORTH- AIRC OFFICE
Scale: 1/4" = 1'-0"

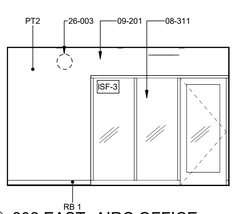


5C 202 EAST- AIRC OFFICE
Scale: 1/4" = 1'-0"

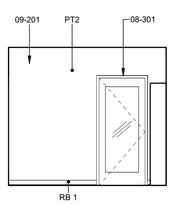


5D 202 SOUTH- AIRC OFFICE
Scale: 1/4" = 1'-0"

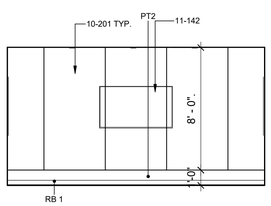


5E 203 WEST- AIRC STUDY
Scale: 1/4" = 1'-0"

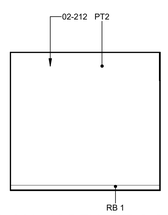

5F 203 NORTH- AIRC STUDY
Scale: 1/4" = 1'-0"

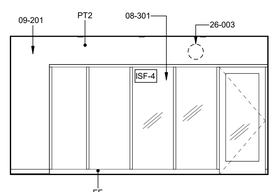

5G 203 EAST- AIRC STUDY
Scale: 1/4" = 1'-0"

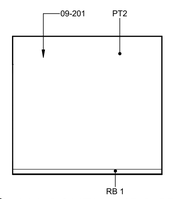

5H 203 SOUTH- AIRC STUDY
Scale: 1/4" = 1'-0"

KEYNOTE LEGEND	
KEY VALUE	KEYNOTE TEXT
02-212	EXTERIOR CONCRETE WALLS TO BE RE-PAINTED.
02-213	PLASTER WALL PARTITION TO BE RE-PAINTED.
06-261	BUILT-IN FULL HEIGHT LOCKABLE CABINET FOR MICRO FICHE, refer to 4/A9.42.
06-302	INFO DESK, SILICA-FREE SOLID SURFACE WITH PERFORATED METAL DECORATIVE PANEL, PER DETAI 1/A9.56
06-304	SILICA-FREE SOLID SURFACE COUNTER WITH UNDER COUNTER CABINETS WITH P-LAM FINISH.
08-001	WOOD DOORS IN HOLLOW METAL FRAMES, REFER TO DOOR SCHEDULE SHEET A8.00
08-301	NON-THERMAL, ALUMINUM STOREFRONTM REFER TO STORFRONT TYPES SHEET A8.00
08-311	DEMOUNTABLE GLASS WALL AND DOOR SYSTEM, CURVED, PER STOREFRONT TYPES SHEET A8.00
08-312	DEMOUNTABLE GLASS WALL AND DOOR SYSTEM, REFER TO STOREFRONT TYPES SHEET A8.00.
09-201	GYP. BOARD, PAINTED
09-233	INTERIOR WOOD VENEER LAMINATE PANEL ON Z-CLIP DETAILS SHEET A9.23
10-201	WALL TO WALL WHITE BOARD, 47" WIDE X 96" HIGH, FRAMELESS
10-632	INFILL WALL OPENING WHERE FIRE HOSE CABINET HAS BEEN REMOVED, CAP PIPING BEHIND FINISH SURFACES
11-142	TV DISPLAY SCREEN MOUNTED ON ADJUSTABLE ARM/BRACKET CFCI. PROVIDE WITH BACKING IN WALL PER DETAIL 15/A9.26.
11-202	METAL LIBRARY SHELVING, 82" TALL, REFER TO DETAILS SHEET S10.00
26-003	CLOCK OUTLET, PER TECHNOLOGY DRAWINGS

INTERIOR ELEVATIONS GENERAL NOTES

1. REFER TO SHEETS A3.13, A3.14, A3.15, AND A3.17 FOR SIGNAGE TYPES AND SHEET A9.70 FOR SIGNAGE DETAILS.
2. REFER TO SHEETS A3.13, A3.14, A3.15, AND A3.17 FOR ALL DIMENSIONS TO POSITION WALLS AND DOORS.
3. REFER SHEET A3.20 FOR FINISH INFORMATION WHERE NOTED.

GRAIN/ PATTERN FINISH DIRECTION

INDICATES LOCK ON CASEWORK CABINET/DRAWER
ALL CASEWORK DOORS & DRAWERS TO BE FURNISHED W/ LOCKS U.N.O

X-XX STOREFRONT / WINDOW NUMBER, REFER TO A8.00 FOR WINDOW SCHDULE

TYPE __ CASEWORK TYPE; REFER TO SHEET A9.42 FOR CASEWORK INFORMATION

REVISIONS

CONSTRUCTION DOCUMENTS

LICENSED ARCHITECT
LINDA ORTEGA
No. C-34809
Exp. 8-31-25
STATE OF CALIFORNIA

LOS ANGELES COUNTY PUBLIC WORKS
HUNTINGTON PARK LIBRARY
6518 MILES AVE
HUNTINGTON PARK, CA 90255

COUNTY OF LOS ANGELES CALIFORNIA

LA COUNTY LIBRARY

NAC

NAC NO	161-23025
DRAWN	Author
CHECKED	Checker
DATE	11/01/2024

INTERIOR ELEVATIONS

A7.09

© 2023 NAC Inc

ABBREVIATIONS

AL	ALUMINUM
BOF	BOTTOM OF FRAME
FF	FACTORY FINISH
GL	GLASS
H	HINGE (JAMB)
HR	HOUR
MFR	MANUFACTURER
PLAM	PLASTIC LAMINATE
PR	PAIR OF DOORS
PT	PAINT
S	STRIKE (JAMB)
SG	SAFETY GLASS
SS	STAINLESS STEEL
STL	STEEL
STN	STAIN & VARNISH
TOF	TOP OF FRAME
WD	WOOD

DOOR & WINDOW CODED NOTES


1. DOOR OR WINDOW SEALED TO PREVENT PASSAGE OF SMOKE.
2. TOTAL DOOR - VERIFY & FIT DOOR TO EXACT CORRIDOR WIDTH PRIOR TO DOOR/ FRAME FABRICATION.
3. PADDING FULL WIDTH & HEIGHT (EXCEPT AREA OF LITE) OF ROOM ### FACE OF DOOR. SEE FINISH SCHEDULE FOR COORD WITH WALL PADDING.
4. SCHEDULED DOOR WIDTH IS NOMINAL. EXACT DOOR WIDTH TO BE VERIFIED BASED ON ACTUAL MASONRY OPENING.
5. POWER ASSISTED DOOR OPERATOR.
6. PROVIDE LOUVERS IN DOOR.
7. 4" HEAD FRAME.
8. EACH PANE OF SAFETY GLAZING INSTALLED IN HAZARDOUS LOCATIONS SHALL BE IDENTIFIED BY A MANUFACTURER'S DESIGNATION SPECIFYING WHO APPLIED THE DESIGNATION, THE MANUFACTURER OR INSTALLER AND THE SAFETY-GLAZING STANDARD. THE FOLLOWING SHALL BE CONSIDERED SPECIFIC HAZARDOUS LOCATIONS FOR THE PURPOSED OF SAFETY GLAZING. (2406.4)
   - A. GLAZING IN ALL FIXED AND OPERABLE PANELS OR SWINGING, SLIDING AND BIFOLD DOORS.
   - B. FIXED OR OPERABLE PANELS ADJACENT TO A DOOR WHERE THE NEAREST VERTICAL EDGE OF THE GLAZING IS WITHIN 24-IN. ARC OF EITHER VERTICAL EDGE OF THE DOOR IN A CLOSED POSITION AND WHERE THE BOTTOM EXPOSED EDGE OF THE GLAZING IS LESS THAN 60-IN. ABOVE THE WALKING SURFACE.
   - C. FIXED OR OPERABLE PANEL WHICH MEETS ALL THE FOLLOWING CONDITIONS:
     - i. EXPOSED AREA OF AN INDIVIDUAL PANE GREATER THAN 9 SQ. FT.,
     - ii. EXPOSED BOTTOM EDGE LESS THAN 18-IN. ABOVE THE FLOOR,
     - iii. EXPOSED TOP EDGE GREATER THAN 36-IN. ABOVE THE FLOOR,
     - iv. ONE OR MORE WALKING SURFACES WITHIN 36-IN, MEASURED HORIZONTALLY AND IN A STRAIGHT LINE, OF THE PLANE OF THE GLAZING.
   - D. GUARDS AND RAILINGS REGARDLESS OF AREA OR HEIGHT ABOVE A WALKING SURFACE. INCLUDED ARE STRUCTURAL BALUSTER PANELS AND NONSTRUCTURAL IN-FILL PANELS.
   - E. WALLS, ENCLOSURES AND FENCES CONTAINING OR FACING HOT TUBS, SPAS, WHIRLPOOLS, SAUNAS, STEAM ROOMS, BATHTUBS, SHOWERS, AND SWIMMING POOLS WHERE ALL THE FOLLOWING CONDITIONS ARE PRESENT:
     - i. THE BOTTOM EDGE OF THE GLAZING IS LESS THAN 60-IN, MEASURED VERTICALLY ABOVE ANY STANDING OR WALKING SURFACE.
     - ii. THE GLAZING IS WITHIN 60-IN, MEASURED HORIZONTALLY AND IN A STRAIGHT LINE, FROM THE WATER'S EDGE OF A BATHTUB, HOT TUB, SPA, WHIRLPOOL, OR SWIMMING POOL.
   - F. ADJACENT TO STAIRWAYS, LANDINGS, AND RAMPS WITHIN 36-IN. HORIZONTALLY OF A WALKING SURFACE, WHEN THE EXPOSED SURFACE OF THE GLASS IS LESS THAN 60-IN. ABOVE THE PLANE OF THE ADJACENT WALKING SURFACE.
   - G. ADJACENT TO THE LANDING AT THE BOTTOM OF A STAIRWAY WHERE THE GLAZING IS LESS THAN 60-IN HORIZONTAL ARC THAT IS LESS THAN 180 DEGREES FROM THE BOTTOM TREAD NOSING.
   - H. FIRE DEPARTMENT GLASS ACCESS PANELS.

GENERAL DOOR, WINDOW & STOREFRONT NOTES


1. ALL DOORS TO BE 1 3/4" THICK, UNLESS NOTED OTHERWISE.
2. SEE SPECIFICATIONS FOR ALL DOOR, RELITE, SIDELITE AND TRANSOM GLAZING TYPES.
3. SEE SHEET A9.10, A9.11, AND A9.12 FOR DOOR FRAME / DOOR, SIDELITE AND STOREFRONT DETAILS.
4. "FIRE RATING" COLUMN NUMBERS INDICATES THE RATING IN MINUTES, UNLESS NOTED OTHERWISE.
5. GLAZING DIMENSIONS FOR DOOR TYPES ARE TO INSIDE OF FRAME (CLEAR GLAZING AREA). ACTUAL CUTOUT AND TOTAL FRAME WILL BE SLIGHTLY LARGER.
6. RELITE GLAZING AND STOP TO OCCUR ON CORRIDOR SIDE OF FRAME, UNLESS NOTED OTHERWISE.
7. ALL DOOR HANDLES TO BE LEVER TYPE COMPLYING WITH ADA.
8. ALL RELITE GLAZING AND LITES IN DOORS TO BE TEMPERED GLASS.
9. EXISTING DOORS LISTED IN THIS SCHEDULE ARE RECEIVING NEW HARDWARE. EXISTING DOORS AND EXISTING FRAMES TO BE PATCHED AND REPAIRD AND TO BE PAINTED.
10. EXISTING FIRE RATED DOORS ARE LIMITED TO FIELD MODIFICATIONS ALLOWED IN NFPA 80. ANY FIELD MODIFICATIONS OUTSIDE OF THESE ALLOWANCES WILL REQUIRE THE DOOR TO BE RE-CERTIFIED IN THE FIELD OR THE DOOR/FRAME MAY NEED TO BE REPLACED TO MAINTAIN FIRE RATING OF OPENING.
11. REFER TO SPECIFICATIONS FOR LOCATIONS OF LAMINATED AND TEMPERED GLASS.
12. STOREFRONT DIMENSIONS SHOWN INDICATE ROUGH OPENING DIMENSION.
13. ALL EXTERIOR GLAZING TO BE CERIFIED BY INDEPENDENT AGENCY FOR SOLAR HEAT GAIN COEFFICIENT AND U-VALUE.
14. WINDOW DIMENSIONS SHOWN INDICATE ROUGH OPENINGS. FIELD VERIFY ACTUAL OPENING DIMENSION.

DOOR SCHEDULE

DOOR NO	ROOM REFERENCE	PR	DOOR LEAF A	DOOR LEAF B	DOOR HT	DOOR TYPE	DOOR MATERIAL	DOOR FINISH	FRAME TYPE	FRAME MATERIAL	FRAME FINISH	DETAILS HEAD	DETAILS HINGE JAMB	DETAILS STRIKE JAMB	DETAILS SILL	FIRE RATING	ACCESS CONTROL	HARDWARE NOTES	HARDWARE GROUP	REMARKS	DOOR NO
BASEMENT LEVEL																					
B02	ELEVATOR EQUIP		3'-0"		7'-0"	(E) A	(E) HM		F-1	(E) HM	-	(E)	(E)	(E)	-						B02
B03	ELECTRICAL ROOM		3'-0"		7'-0"	(E) A	(E) HM		F-1	(E) HM	-	(E)	(E)	(E)	-						B03
EX001	BASEMENT MECH	PR	3'-0"	3'-0"	7'-0"	A	(E) HM	PT	F-2	(E) HM	PT	(E)	(E)	(E)	-			LEVER, LOCK, DEADBOLT ON INACTIVE LEAF	19	MAIN DOOR BASEMENT / UTILITY RM ONLY	EX001
LEVEL 1																					
100	MAIN ENTRANCE		12'-10"		7'-6"	-	AL	FF	F-#	AL	AL	2/A9.10	3/A9.10	3/A9.10	2/A9.10		INTRUSION		01	MAIN ENTRY DOOR / SLIDING DOOR	100
101B	EXIT TEENS		3'-0"		7'-0"	A	HM	PT	F-1	HM	PT	6/A9.10	8/A9.10	8/A9.10	7/A9.10		INTRUSION / LOCALIZED ALARM	PH, CLOSER	03	EXIT DOOR FROM TEENS	101B
103A	EGRESS MAKER SPACE		3'-0"		7'-0"	B	AL/GL	FF	F-1	STL	PT	6/A9.11	8/A9.11	8/A9.11	6/A9.11		--	LEVER, NO CLOSER	06	EGRESS DOOR MAKER SPACE	103A
104	STUDY T1		3'-0"		7'-0"	B	AL		-	-	-	6/A9.11	8/A9.11	8/A9.11	6/A9.11				05		104
105	STUDY T2		3'-0"		7'-0"	B	AL		-	-	-	6/A9.11	8/A9.11	8/A9.11	6/A9.11				05		105
106	TEEN LIBRARIAN		3'-0"			B	AL/GL		F-1	AL	FF	3/A9.23	11/A9.11	11/A9.11	13/A9.11		CARD READER		08	DOOR WITHIN STOREFRONT SYSTEM	106
107	(E) CHILDREN'S LIBRARIAN					B	AL/GL		F-1	AL	FF	3/A9.23	11/A9.11	11/A9.11	13/A9.11		CARD READER		08	DOOR WITHIN STOREFRONT SYSTEM	107
108	STAFF AREA		3'-0"		7'-0"	A	WD	FF (SEALED)	F-1	HM	PT	2/A9.11	1/A9.11	1/A9.11	5/A9.25		CARD READER	CLOSER, HOLD OPEN, PROTECTION PLATE ON PUSH SIDE, WALL MOUNTED DOOR STOP	12		108
108A	STAFF AREA		3'-0"		7'-0"	A	WD	PT	F-1	HM	PT	2/A9.11	1/A9.11	1/A9.11	5/A9.25		--	CLOSER, HOLD OPEN, PROTECTION PLATE ON PUSH SIDE, WALL MOUNTED DOOR STOP	16		108A
109	(E) CLM					B	AL/GL		F-1	AL	FF	3/A9.23	11/A9.11	11/A9.11	13/A9.11		CARD READER		08	DOOR WITHIN STOREFRONT SYSTEM	109
110	VESTIBULE		6'-0"		9'-6"	D	-	FF (SEALED)		-	-	2/A9.12	1/A9.12	3/A9.12	2/A9.12			ALL HARDWARE BY THE ROLL UP GRILLE MANUFACTURER	N/A	DOOR AND ALL ASSOCIATED HARDWARE BY DOOR MANUFACTURER	110
111	WOMEN'S TR		3'-0"		7'-0"	A	WD	FF (SEALED)	F-1	HM	PT	2/A9.11	1/A9.11	1/A9.11	10/A9.25		DOOR RELEASE	LEVER, CLOSER, HOLD OPEN, PROTECTION PLATES BOTH SIDES, WALL MOUNTED DOOR STOP	15	DOOR RELEASE BACK TO CIRCULATION DESK / WHAT IS MOST DURABLE HOLD OPEN OPTION (CLOSER, WALL OR FLOOR MOUNTED. PROVIDE OPTION FOR CLIENT REVIEW) VINYL GRAPHICS ON DOOR, REFER TO SIGNAGE PLAN	111
112	MEN'S TR		3'-0"		7'-0"	A	WD	FF (SEALED)	F-1	HM	PT	2/A9.11	1/A9.11	1/A9.11	10/A9.25		DOOR RELEASE	LEVER, CLOSER, HOLD OPEN, PROTECTION PLATES BOTH SIDES, WALL MOUNTED DOOR STOP	15	DOOR RELEASE BACK TO CIRCULATION DESK / WHAT IS MOST DURABLE HOLD OPEN OPTION (CLOSER, WALL OR FLOOR MOUNTED. PROVIDE OPTION FOR CLIENT REVIEW) PROVIDE VINYL GRAPHIC ON DOOR. REFER TO SIGNAGE PLAN	112
113	COMMUNITY MTG RM		3'-0"		7'-0"	A	WD	FF (SEALED)	F-1	HM	PT	2/A9.11	1/A9.11	1/A9.11	5/A9.25		CARD READER	LOCK, LEVER, NO CLOSER	13		113
113A	COMMUNITY MTG TO CHILDREN'S	PR	3'-0"	3'-0"	7'-0"	A	WD	FF (SEALED)	F-2	HM	PT	2/A9.11	1/A9.11	1/A9.11	5/A9.25		CARD READER	LOCK, LEVER, NO CLOSER, DEADBOLT ON INACTIVE LEAF (NO CENTER MULLION), DOOR STOP,	14	AFTER HOUR USE OF MTG RM	113A
113B	COMMUNITY MTG RM		3'-0"		7'-0"	B	AL/GL	FF	F-1	AL	FF	4/A9.10	5/A9.10	5/A9.10	8/A9.10		INTRUSION	PH, CLOSER	11	GLASS DOOR TO EXTERIOR	113B
113C	COMMUNITY MTG RM		3'-0"		7'-0"	B	AL/GL	FF	F-1	AL	FF	4/A9.10	5/A9.10	5/A9.10	8/A9.10		INTRUSION, CARD READER	PH, CLOSER	10	GLASS DOOR TO EXTERIOR	113C
113D	COMMUNITY MTG RM		2'-4"		4'-6"	F	WD	FF (SEALED)	F-1	WD	PT	7/A9.11	7/A9.11	7/A9.11	5/A9.25		--	LOCK, LEVER, NO CLOSER	18		113D
113E	COMMUNITY MTG RM KITCHENETTE		2'-0"	0"	8'-0"	E	WD	FF (SEALED)		-	-	22/A9.11			22/A9.11			LOCK, TOP-HUNG		FOLDING DOOR WITH HAEFELE HARDWARE ITEM 943.29.010 OR EQUAL. PROVIDE LOCK. DOOR CONTAINS 4 EQUAL LEAVES.	113E
114	STORAGE	PR	3'-0"	3'-0"	7'-0"	A	WD	FF (SEALED)	F-2	HM	PT	2/A9.11	1/A9.11	1/A9.11	5/A9.25			LOCK, DEAD BOLT ON INACTIVE LEAF, NO CENTER MULLION	17		114
115A	BOH CORRIDOR		3'-0"		7'-0"	A	WD	PT	F-1	HM	PT	2/A9.11	1/A9.11	1/A9.11	5/A9.25	1 HR		PH, CLOSER, PROTECTION PLATE ON PUSH SIDE, HOLD OPEN WITH MAGNET TIED TO FA	20		115A
116	STAFF TR2		3'-0"		7'-0"	A	WD	PT	F-1	HM	PT	2/A9.11	1/A9.11	1/A9.11	5/A9.25			PRIVACY LOCK, LEVER, CLOSER, HOLD OPEN, PROTECTION PLATES BOTH SIDES, WALL MOUNTED DOOR STOP	22	WHAT IS MOST DURABLE HOLD OPEN OPTION (CLOSER, WALL OR FLOOR MOUNTED. PROVIDE OPTION FOR CLIENT REVIEW)	116
117	JANITOR		3'-0"		7'-0"	A	WD	PT	F-1	HM	PT	2/A9.11	1/A9.11	1/A9.11	5/A9.25			LEVER, CLOSER, HOLD OPEN, PROTECTION PLATE ON PUSH SIDE	26		117
118	STORAGE		3'-0"		7'-0"	A	WD	PT	F-1	HM	PT	2/A9.11	1/A9.11	1/A9.11	5/A9.25			PRIVACY LOCK, LEVER, NO CLOSER	18		118
119	STAFF TR1		3'-0"		7'-0"	A	WD	PT	F-1	HM	PT	2/A9.11	1/A9.11	1/A9.11	5/A9.25			PRIVACY LOCK, LEVER, CLOSER, HOLD OPEN, PROTECTION PLATES BOTH SIDES, WALL MOUNTED DOOR STOP	22		119
120	STORAGE		3'-0"		7'-0"	A	WD	PT	F-1	HM	PT	2/A9.11	1/A9.11	1/A9.11	5/A9.25			LEVER, NO CLOSER, DOOR STOP	18		120
B05	MAKER SPACE					C	AL/GL	FF	F-3	AL	FF	24/A9.11	25/A9.11	25/A9.11	24/A9.11		--		07	FOLDING GLASS DOOR	B05
EX102	CHILDREN'S		3'-0"		7'-0"	(E) A	(E) HM	PT	F-1	(E) HM	PT	(E)	(E)	(E)	-	(E) 45 MINS	INTRUSION / LOCAL ALARM	PH, CLOSER	04	EXISTING EXTERIOR DOOR / REPAINT DOOR AND FRAME	EX102
EX115	BOH CORRIDOR (TEENS)		3'-0"		7'-0"	(E) A	(E) WD	PT	F-1	(E) HM	PT	(E)	(E)	(E)	-		CARD READER	LEVER, CLOSER, PROTECTION PLATE ON PUSH SIDE	28	CONVENIENCE DOOR FOR STAFF ONLY / REPAINT DOOR AND FRAME	EX115
EX115A	STAIR 2		3'-0"		7'-0"	(E) A	(E) WD	PT	F-1	(E) HM	PT	(E)	(E)	(E)	-	(E) 1 HR		PH, CLOSER, PROTECTION PLATE ON PUSH SIDE, DOOR STOP	23		EX115A
EX115B	CORRIDOR		3'-0"		7'-0"	(E) A	(E) HM	PT	F-1	(E) HM	PT	(E)	(E)	(E)	-	(E) 45 MINS	INTRUSION / CARD READER	PH, CLOSER, PROTECTION PLATE ON PUSH SIDE, DOOR STOP	25	(E) DOOR TO EXTERIOR / REPAINT DOOR AND FRAME	EX115B
EX121	STAFF LOUNGE		3'-0"		7'-0"	(E) A	(E) WD	PT	F-1	(E) HM	PT	(E)	(E)	(E)	-			LEVER, CLOSER, PROTECTION PLATE ON PUSH SIDE, WALL MOUNTED DOOR STOP	29		EX121
EX130	STAIR 3		3'-0"		7'-0"	(E) A	(E) HM	PT	F-1	(E) HM	PT	(E)	(E)	(E)	-	(E) 45 MINS	INTRUSION	PH, CLOSER, PROTECTION PLATE ON PUSH SIDE	27	(E) DOOR TO EXTERIOR / REPAINT DOOR AND FRAME	EX130
EXEL1	PUBLIC ELEVATOR		3'-6"		7'-0"	-	(E) AL		-	(E) HM	FF	(E)	(E)	(E)	-					(E) ELEVATOR DOOR / NO WORK	EXEL1
EXEL2	STAFF ELEVATOR		3'-6"		7'-0"	-	(E) AL		-	(E) HM	FF	(E)	(E)	(E)	-					(E) ELEVATOR DOOR / NO WORK	EXEL2
LEVEL 2																					
200	AIRC RESEARCH	PR	3'-0"	3'-0"	7'-0"	B	AL/GL	FF	F-1	AL	FF	27/A9.23	11/A9.11	11/A9.11	13/A9.11				05A		200
201	AIRC INFO		3'-0"		7'-0"	B	AL/GL	FF	F-1	AL	FF	6/A9.11	8/A9.11	8/A9.11	6/A9.11			LEVER, NO CLOSER, DOOR STOP	24		201
202	AIRC OFFICE		3'-0"		7'-0"	B	AL		-	-	-	6/A9.11	8/A9.11	8/A9.11	6/A9.11				08		202
203	AIRC GROUP STUDY		3'-0"		7'-0"	B	AL		-	-	-	6/A9.11	8/A9.11	8/A9.11	6/A9.11				05		203
204	STUDY 2				7'-0"	B	AL/GL	FF	F-1	AL	FF	3/A9.23	11/A9.11	11/A9.11	13/A9.11				05	DOOR WITHIN STOREFRONT SYSTEM	204
205	STUDY 1				7'-0"	B	AL/GL	FF	F-1	AL	FF	3/A9.23	11/A9.11	11/A9.11	13/A9.11				05	DOOR WITHIN STOREFRONT SYSTEM	205
206	PUBLIC TR 1		3'-0"		7'-0"	A	WD	FF (SEALED)	F-1	HM	PT	2/A9.11	1/A9.11	1/A9.11	5/A9.25		DOOR RELEASE	PRIVACY LOCK, LEVER, CLOSER, HOLD OPEN, PROTECTION PLATES BOTH SIDES, WALL MOUNTED DOOR STOP	33	DOOR RELEASE BACK TO INFO DESK / WHAT IS MOST DURABLE HOLD OPEN OPTION (CLOSER, WALL OR FLOOR MOUNTED. PROVIDE OPTION FOR CLIENT REVIEW)	206
207	PUBLIC TR 2		3'-0"		7'-0"	A	WD	FF (SEALED)	F-1	HM	PT	2/A9.11	1/A9.11	1/A9.11	5/A9.25		DOOR RELEASE	PRIVACY LOCK, LEVER, CLOSER, HOLD OPEN, PROTECTION PLATES BOTH SIDES, WALL MOUNTED DOOR STOP	33	DOOR RELEASE BACK TO INFO DESK / WHAT IS MOST DURABLE HOLD OPEN OPTION (CLOSER, WALL OR FLOOR MOUNTED. PROVIDE OPTION FOR CLIENT REVIEW)	207
210	BOH STAFF AREA		3'-0"		7'-0"	A	WD	PT	F-1	HM	PT	2/A9.11	1/A9.11	1/A9.11	5/A9.25			PH, CLOSER, PROTECTION PLATE ON PUSH SIDE, WALL MOUNTED DOOR STOP, HOLD OPEN	21		210
210A	STAFF AREA		3'-0"		7'-0"	A	WD	FF (SEALED)	F-1	HM	PT	2/A9.11	1/A9.11	1/A9.11	5/A9.25		CARD READER	LEVER, CLOSER, PROTECTION PLATE ON PUSH SIDE, DOOR STOP	09	BOH ACCESS	210A
215	STAFF TR2		3'-0"		7'-0"	A	WD	PT	F-1	HM	PT	2/A9.11	1/A9.11	1/A9.11	5/A9.25			PRIVACY LOCK, LEVER, CLOSER, HOLD OPEN, PROTECTION PLATES BOTH SIDES, WALL MOUNTED DOOR STOP	22		215
216	STAFF TR1		3'-0"		7'-0"	A	WD	PT	F-1	HM	PT	2/A9.11	1/A9.11	1/A9.11	5/A9.25			PRIVACY LOCK, LEVER, CLOSER, HOLD OPEN, PROTECTION PLATES BOTH SIDES, WALL MOUNTED DOOR STOP	22		216
EX200A	STAIR 3		3'-0"		7'-0"	(E) A	(E) WD		F-1	(E) HM	PT	(E)	(E)	(E)	-		LOCAL ALARM	PH, CLOSER, PROTECTION PLATE ON PUSH SIDE	32		EX200A
EX211	JANITOR		2'-8"		7'-0"	(E) A	WD		F-1	(E) HM	PT	(E)	(E)	(E)	-			(E) DOOR LOUVER WITH FIRE SHUTTER	30		EX211
EX212	STAIR 2		3'-0"		7'-0"	(E) A	(E) WD		F-1	(E) HM	PT	(E)	(E)	(E)	-	(E) 1 HR		PH, CLOSER, PROTECTION PLATE ON PUSH SIDE	31		EX212
EXEL3	PUBLIC ELEVATOR		3'-6"		7'-0"	-	(E) AL		-	(E) HM	FF	(E)	(E)	(E)	-					(E) ELEVATOR DOOR / NO WORK	EXEL3
EXEL4	STAFF ELEVATOR		3'-6"		7'-0"	-	(E) AL		-	(E) HM	FF	(E)	(E)	(E)	-					(E) ELEVATOR DOOR / NO WORK	EXEL4
LEVEL 3																					
300	STAIR 3		3'-0"		7'-0"	(E) A	(E) HM		F-1	STL	PT	(E)	(E)	(E)	-				23		300
304	MCR		3'-0"		7'-0"	A	HM	PT	F-1	HM	-	2/A9.11	1/A9.11	1/A9.11	-				26		304

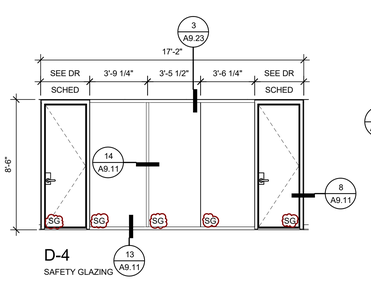


D-4
SAFETY GLAZING

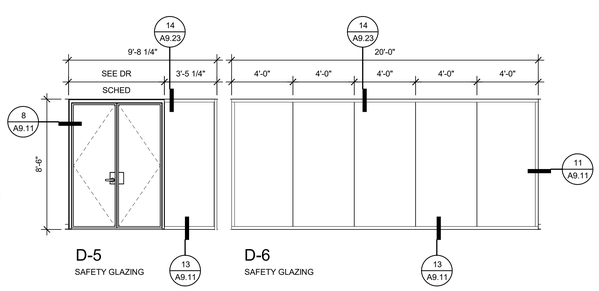


D-5
SAFETY GLAZING


D-6
SAFETY GLAZING

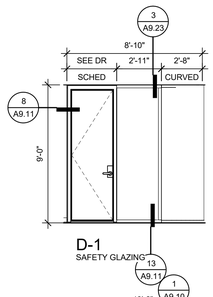


D-1
SAFETY GLAZING

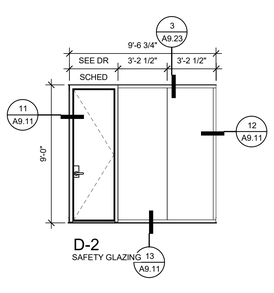


D-2
SAFETY GLAZING

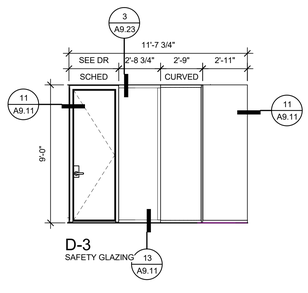


D-3
SAFETY GLAZING

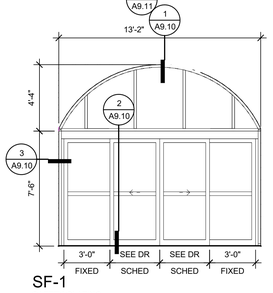


SF-1
SAFETY GLAZING

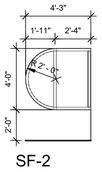

SF-2

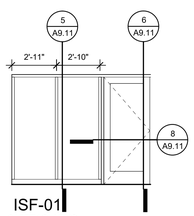


ISF-01
SAFETY GLAZING

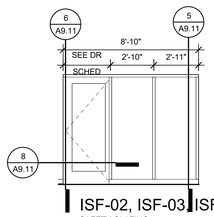


ISF-02, ISF-03 ISF-04
SAFETY GLAZING

STOREFRONT TYPES


Scale: 1/4" = 1'-0"

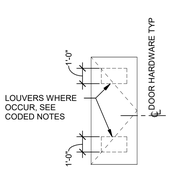

A

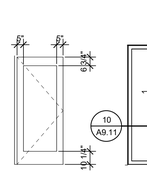


B
SAFETY GLAZING

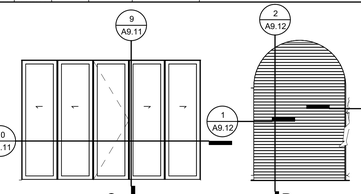

C
SAFETY GLAZING

D

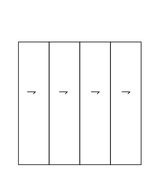


E



F

DOOR TYPES

Scale: 1/4" = 1'-0"

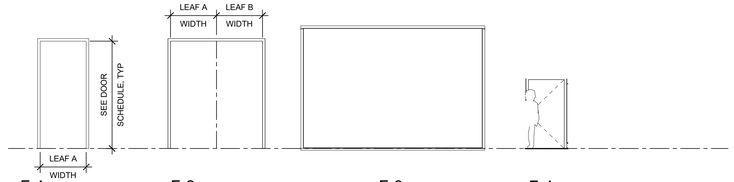

F-1 F-2 F-3 F-4

FRAME TYPES - DOOR

Scale: 1/4" = 1'-0"

REVISIONS

2 Post-Plan Check Changes TBD

CONSTRUCTION DOCUMENTS

LICENSED ARCHITECT
STEVEN ORTEGA
No. C-34809
Exp. 8-31-25
STATE OF CALIFORNIA

LOS ANGELES COUNTY PUBLIC WORKS
HUNTINGTON PARK LIBRARY
651 R MILES AVE
HUNTINGTON PARK, CA 90255

COUNTY OF LOS ANGELES CALIFORNIA

LA COUNTY LIBRARY


NAC

NAC NO	161-23025
DRAWN	Author
CHECKED	Checker
DATE	11/01/2024


DOOR & STOREFRONT TYPES & SCHEDULES

A8.00


© 2023 NAC Inc.

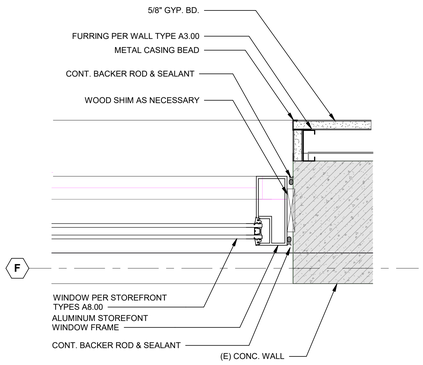


9 EW - WDW JAMB @ GRID F
Scale: 3" = 1'-0"

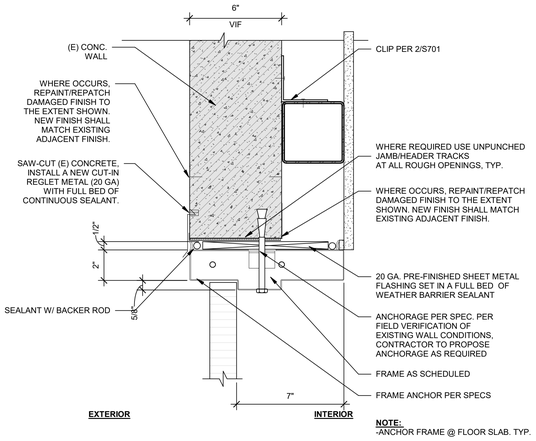


6 PUNCH AND DIMPLE HEAD AT (E) CONC WALL
Scale: 3" = 1'-0"

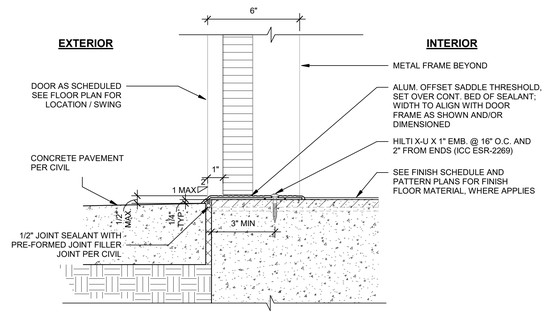


7 HM DOOR THRESHOLD @ (E) CONC WALL
Scale: 3" = 1'-0"

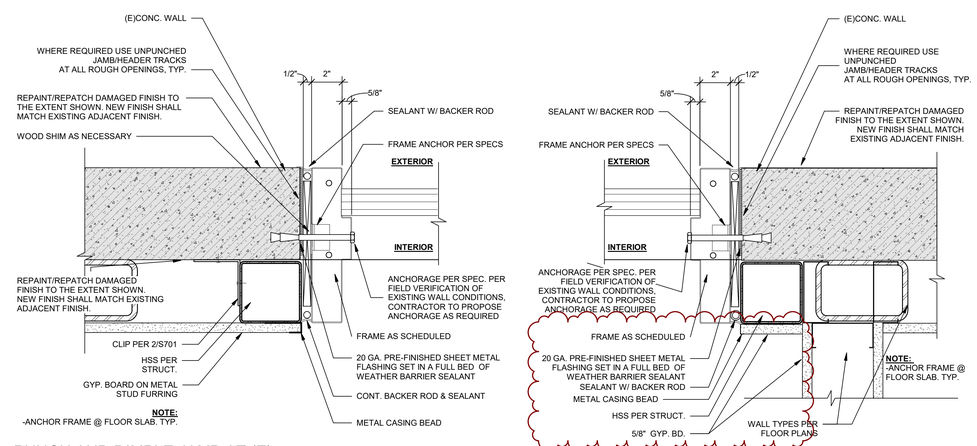


8 PUNCH AND DIMPLE JAMB AT (E) CONC WALL
Scale: 3" = 1'-0"

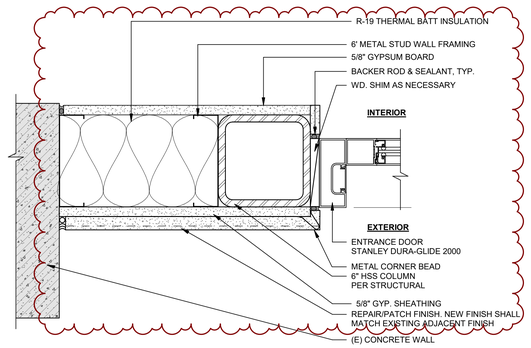


3 EF - ENTRY WALL AND SF JAMB
Scale: 3" = 1'-0"

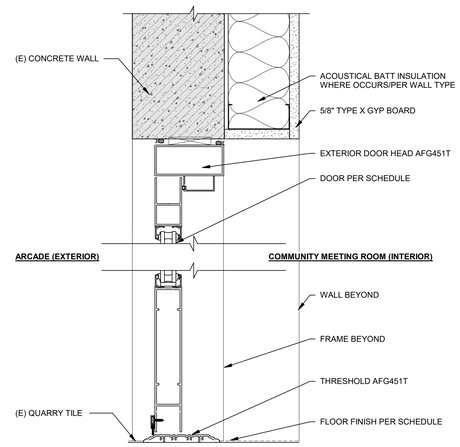


4 HEADER AND THRESHOLD AT STOREFRONT DOOR TO EXTERIOR
Scale: 3" = 1'-0"

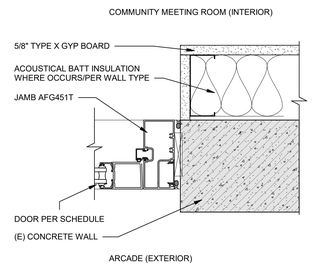

5 ED - TYP EXT DOOR JAMB @ MEETING ROOM
Scale: 3" = 1'-0"

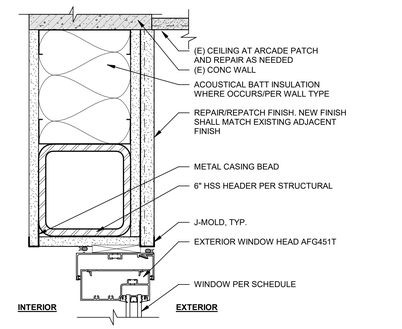

1 EW - ENTRY SF HEAD
Scale: 3" = 1'-0"

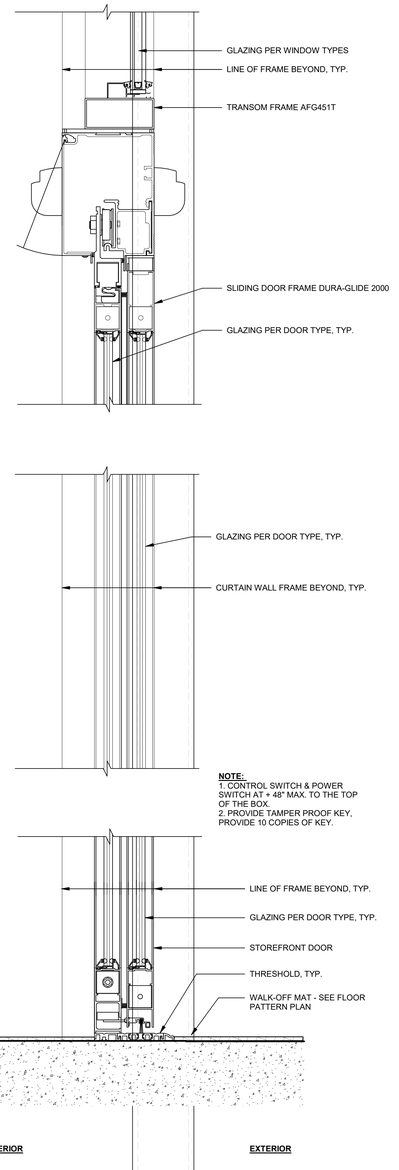

2 PUNCH AND DIMPLE HEAD AT (E) CONC WALL
Scale: 3" = 1'-0"

REVISIONS
2 Post-Plan Check Changes TBD

CONSTRUCTION DOCUMENTS

LICENSED ARCHITECT
VICTOR ORTEGA, JR.
No. C-34809
Exp. 8-31-25
STATE OF CALIFORNIA

LOS ANGELES COUNTY PUBLIC WORKS
HUNTINGTON PARK LIBRARY
6518 MILES AVE.
HUNTINGTON PARK, CA 90255

COUNTY OF LOS ANGELES CALIFORNIA

LA COUNTY LIBRARY


NAC

NAC NO	161-23025
DRAWN	Author
CHECKED	Checker
DATE	11/01/2024


EXTERIOR DETAILS

A9.10

© 2023 NAC, Inc.

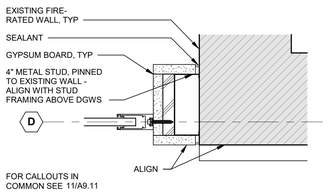


12 DGWS - TYP JAMB AT EX RATED WALL
Scale: 3" = 1'-0"

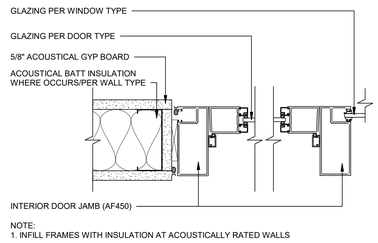


NOTE:
1. INFILL FRAMES WITH INSULATION AT ACOUSTICALLY RATED WALLS

8 INTERIOR DOOR JAMB
Scale: 3" = 1'-0"

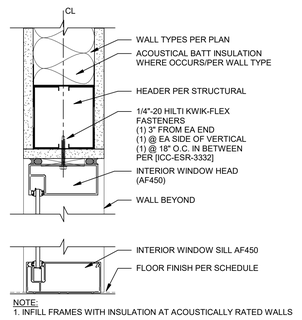


NOTE:
1. INFILL FRAMES WITH INSULATION AT ACOUSTICALLY RATED WALLS

5 INTERIOR STOREFRONT HEAD & SILL
Scale: 3" = 1'-0"

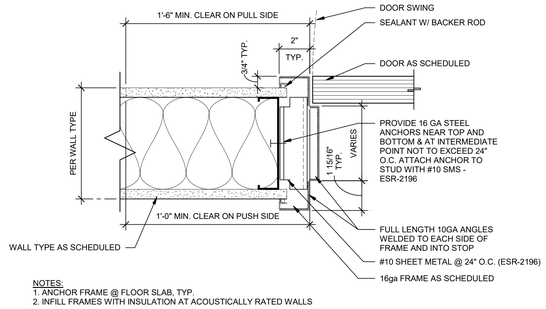


NOTES:
1. ANCHOR FRAME @ FLOOR SLAB, TYP.
2. INFILL FRAMES WITH INSULATION AT ACOUSTICALLY RATED WALLS


1 INT DOOR JAMB
Scale: 3" = 1'-0"

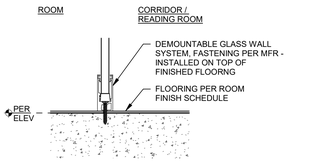

13 TYPICAL DGWS AT SILL
Scale: 3" = 1'-0"

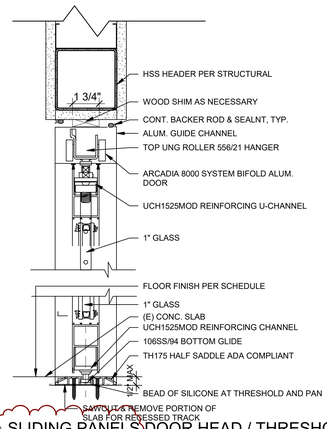


9 SLIDING PANELS DOOR HEAD / THRESHOLD
Scale: 3" = 1'-0"

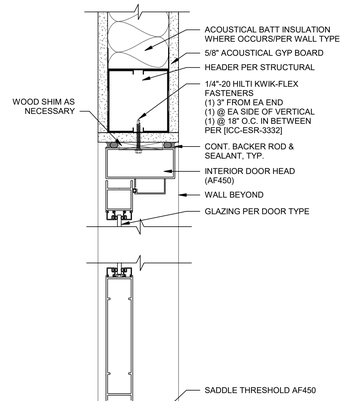


NOTE:
1. INFILL FRAMES WITH INSULATION AT ACOUSTICALLY RATED WALLS

6 INTERIOR DOOR HEAD & SILL
Scale: 3" = 1'-0"

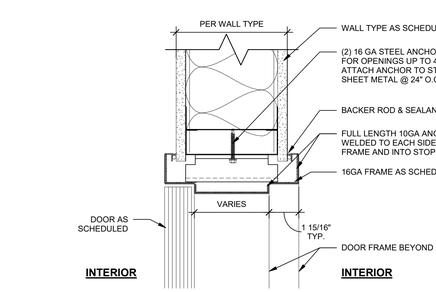


2 INT DOOR HEAD
Scale: 3" = 1'-0"

14 DGWS JAMB AT WALL INTERSECTION
Scale: 3" = 1'-0"

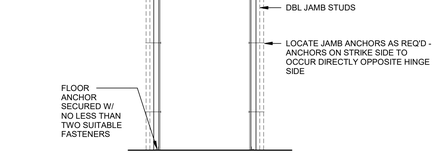

3 TYPICAL HM DOOR FRAME
Scale: 1/2" = 1'-0"

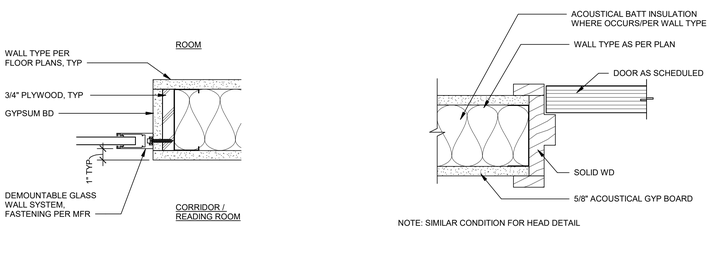


10 STOREFRONT & SLIDING PANELS DOOR JAMB DETAIL
Scale: 3" = 1'-0"

11 TYPICAL DGWS AT JAMB
Scale: 3" = 1'-0"

NOTE: SIMILAR CONDITION FOR HEAD DETAIL

7 WD JAMB DETAIL
Scale: 3" = 1'-0"

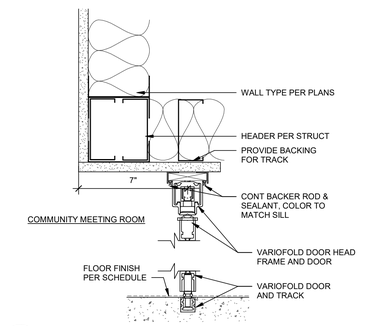

4 VARIOFOLD DOOR HEAD AND TRACK DETAIL
Scale: 3" = 1'-0"

REVISIONS

1	Revision 2	Date 2
2	Post-Plan Check Changes	7/15/25

CONSTRUCTION DOCUMENTS


LOS ANGELES COUNTY PUBLIC WORKS

HUNTINGTON PARK LIBRARY

6518 MILES AVE
HUNTINGTON PARK, CA 90255

COUNTY OF LOS ANGELES CALIFORNIA

LA COUNTY LIBRARY


NAC

NAC NO	161-23025
DRAWN	Author
CHECKED	Checker
DATE	11/01/2024


INTERIOR DOOR, RELITE, AND STOREFRONT DETAILS

A9.11


© 2023 NAC Inc

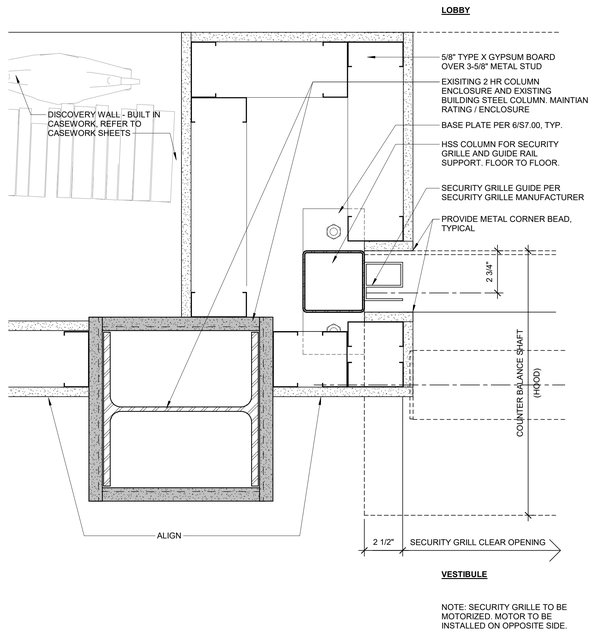

3 UPWARD ROLLING GRILLE - JAMB (WEST)
Scale: 3" = 1'-0"

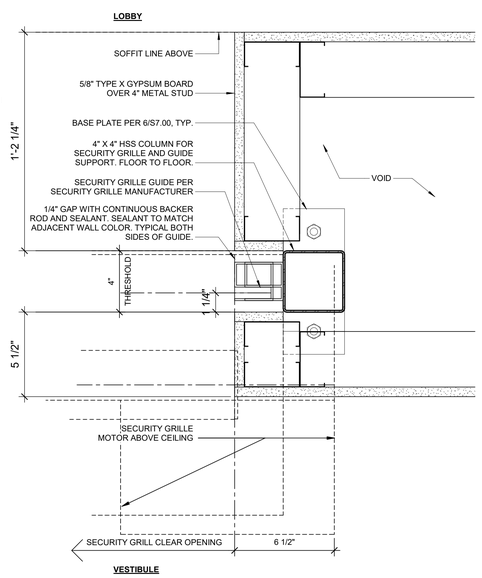


1 UPWARD ROLLING GRILLE - JAMB (EAST)
Scale: 3" = 1'-0"

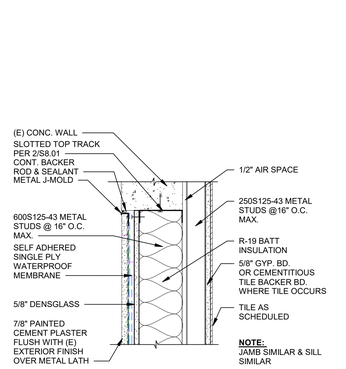


5 VENT OPENING INFILL
Scale: 1 1/2" = 1'-0"

2 UPWARD ROLLING GRILLE DOOR - SECTION
Scale: 1" = 1'-0"

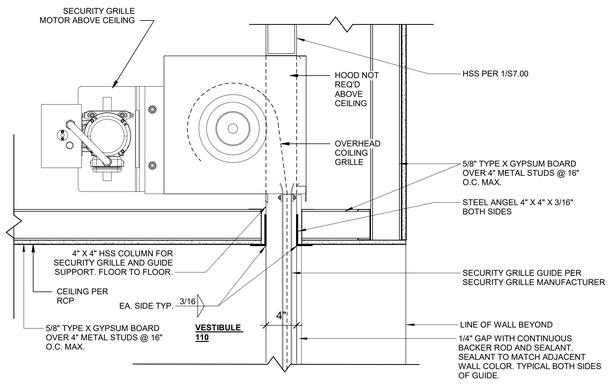

6 ROLLING GRILLE HEAD @ CEILING
Scale: 1 1/2" = 1'-0"

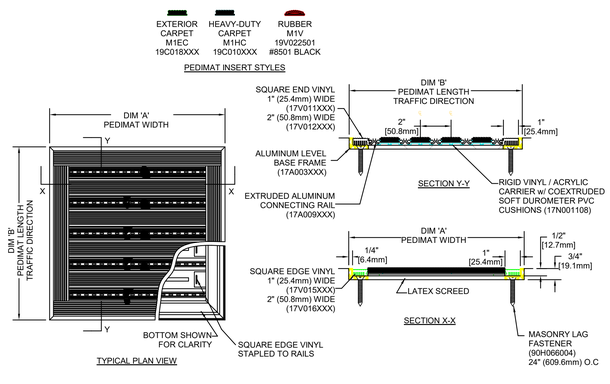

4 WALK-OFF MAT EXTERIOR
Scale: 3" = 1'-0"

REVISIONS

CONSTRUCTION DOCUMENTS

LICENSED ARCHITECT
No. C-34809
Exp. 8-31-25
STATE OF CALIFORNIA

LOS ANGELES COUNTY PUBLIC WORKS
HUNTINGTON PARK LIBRARY
6518 MILES AVE
HUNTINGTON PARK, CA 90255

COUNTY OF LOS ANGELES CALIFORNIA

LA COUNTY LIBRARY


NAC

NAC NO	161-23025
DRAWN	Author
CHECKED	Checker
DATE	11/01/2024


INTERIOR DOOR DETAILS

A9.12


© 2023 NAC Inc

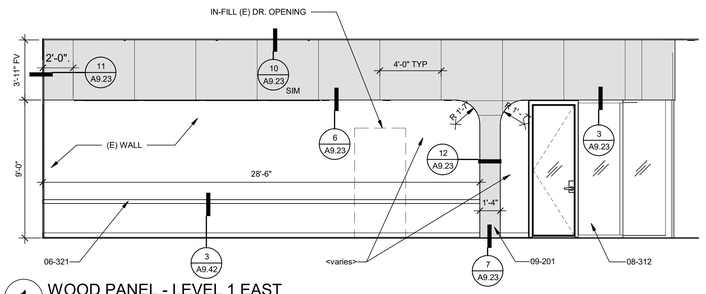


1 WOOD PANEL - LEVEL 1 EAST
Scale: 1/4" = 1'-0"

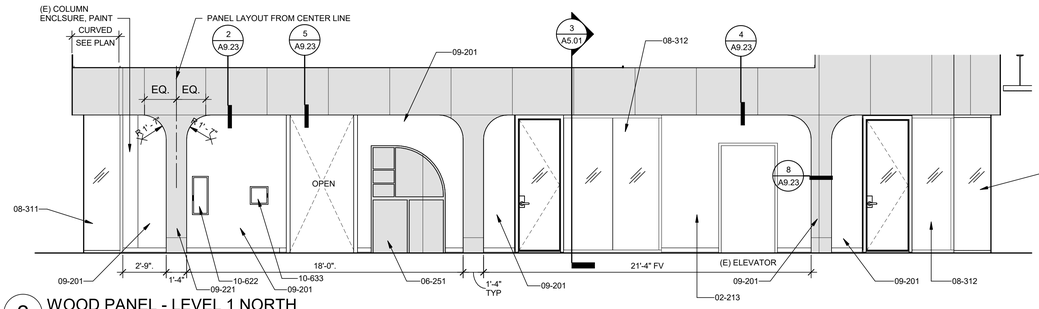


2 WOOD PANEL - LEVEL 1 NORTH
Scale: 1/4" = 1'-0"

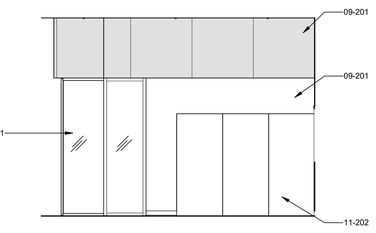


3 WOOD PANEL - LEVEL 1 WEST
Scale: 1/4" = 1'-0"

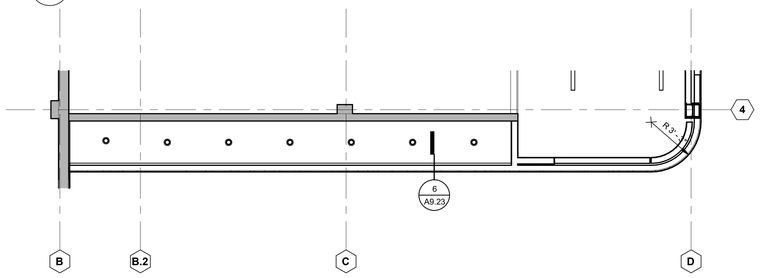


4 LEVEL 1 - ENLARGED PLAN AT 10 FEET AFF (EAST)
Scale: 1/4" = 1'-0"

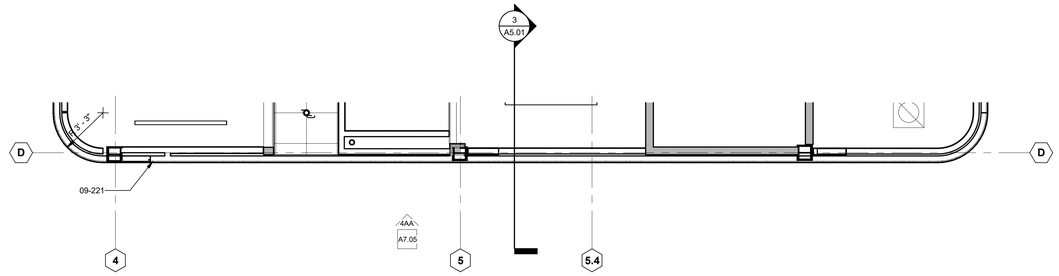


5 LEVEL 1 - ENLARGED PLAN AT 10 FEET AFF (SOUTH)
Scale: 1/4" = 1'-0"

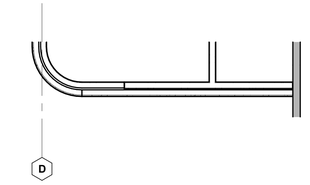


6 LEVEL 1 - ENLARGED PLAN AT 10 FEET AFF (WEST)
Scale: 1/4" = 1'-0"

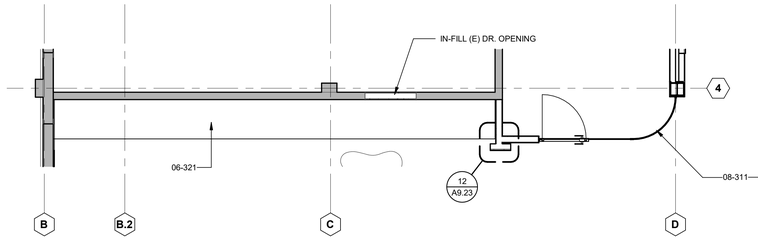


7 LEVEL 1 - ENLARGED PLAN AT 5 FEET AFF (EAST)
Scale: 1/4" = 1'-0"

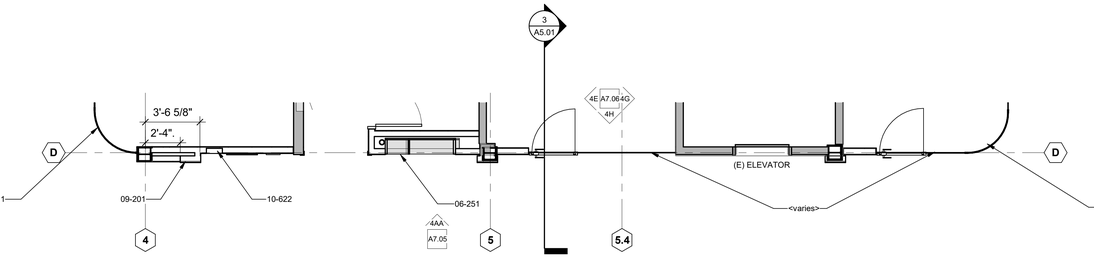


8 LEVEL 1 - ENLARGED PLAN AT 5 FEET AFF (SOUTH)
Scale: 1/4" = 1'-0"

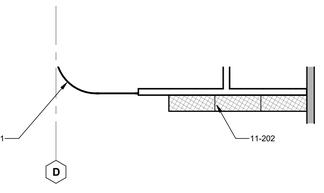


9 LEVEL 1 - ENLARGED PLAN AT 5 FEET AFF (WEST)
Scale: 1/4" = 1'-0"

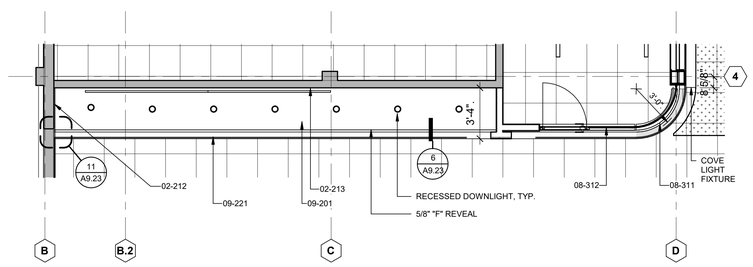

10 LEVEL 1 - ENLARGED RCP (WEST)
Scale: 1/4" = 1'-0"

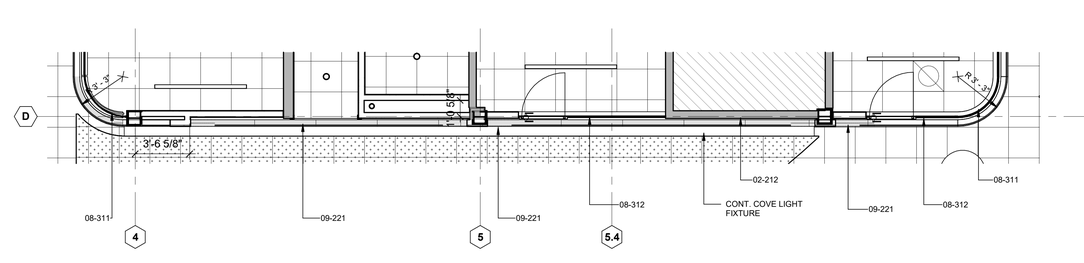

11 LEVEL 1 - ENLARGED RCP (SOUTH)
Scale: 1/4" = 1'-0"

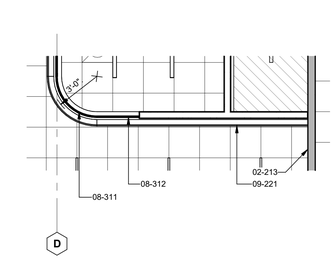

12 LEVEL 1 - ENLARGED RCP (EAST)
Scale: 1/4" = 1'-0"

KEYNOTE LEGEND	
KEY VALUE	KEYNOTE TEXT
02-212	EXTERIOR CONCRETE WALLS TO BE RE-PAINTED.
02-213	PLASTER WALL PARTITION TO BE RE-PAINTED.
06-251	RECESSED, ARCHED DISPLAY CASE, CUSTOM MADE. REFER TO CASEWORK SHEETS.
06-321	CUSTOM P-LAM BUILT-IN COUNTER WITH INTEGRATED WIRE MANAGEMENT
08-311	DEMOUNTABLE GLASS WALL AND DOOR SYSTEM, CURVED, PER STOREFRONT TYPES SHEET A8.00
08-312	DEMOUNTABLE GLASS WALL AND DOOR SYSTEM, REFER TO STOREFRONT TYPES SHEET A8.00.
09-201	GYP. BOARD, PAINTED
09-221	LAMINATED WOOD PANEL AND Z-CLIP OVER GYP BOARD.
10-622	FIRE EXTINGUISHER CABINET AND FIRE EXTINGUISHER, PER 16/A9.26
10-633	RECESSED AED CABINET PER 9/A9.26. (CABINET CFCI, EQUIPMENT OFOI)
11-202	METAL LIBRARY SHELVING, 82" TALL, REFER TO DETAILS SHEET S10.00
<varies>	

REVISIONS

CONSTRUCTION DOCUMENTS

LICENSED ARCHITECT
ROBERT ORTEGA CHUNG
No. C-34809
Exp. 8-31-25
STATE OF CALIFORNIA

LOS ANGELES COUNTY PUBLIC WORKS
HUNTINGTON PARK LIBRARY
6518 MILES AVE
HUNTINGTON PARK, CA 90255

COUNTY OF LOS ANGELES CALIFORNIA

LA COUNTY LIBRARY


NAC

NAC NO	161-23025
DRAWN	Author
CHECKED	Checker
DATE	11/01/2024


FIRST FLOOR WOOD PANELING ENLARGED PLANS AND ELEVATIONS

A9.21


© 2023 NAC Inc

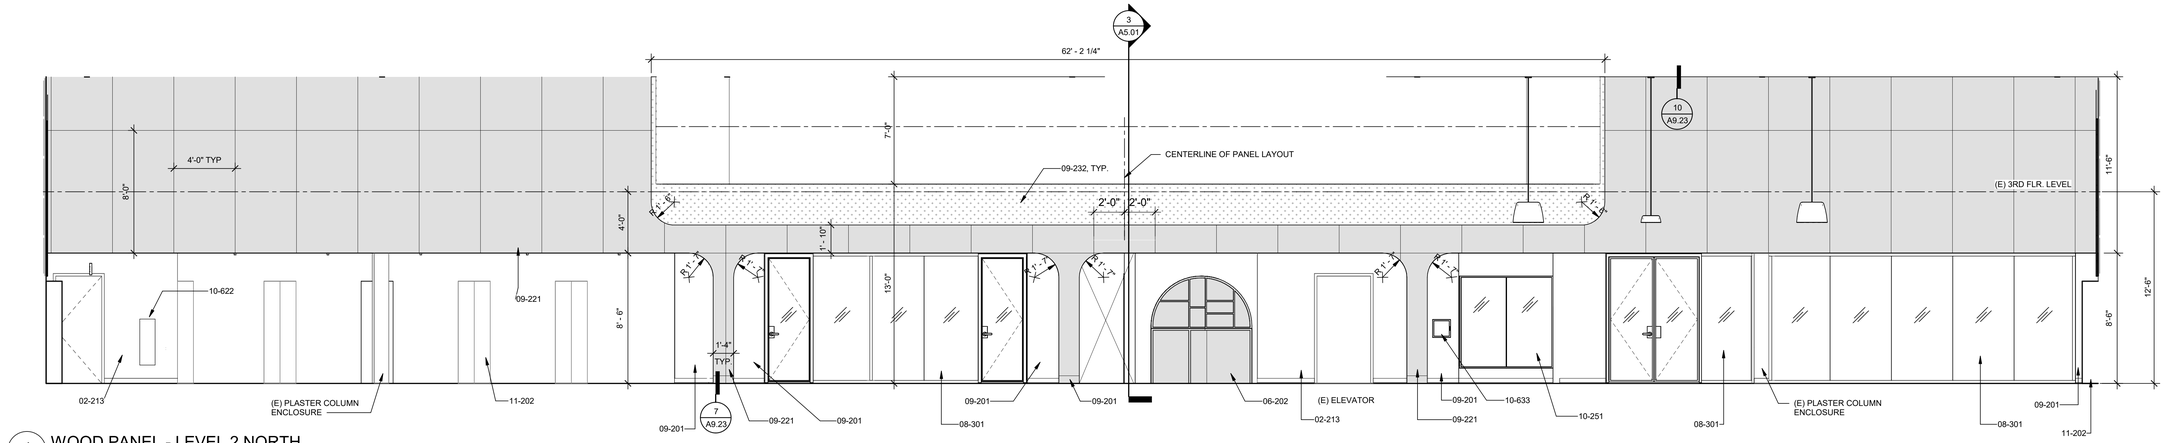


1 WOOD PANEL - LEVEL 2 NORTH
Scale: 1/4" = 1'-0"

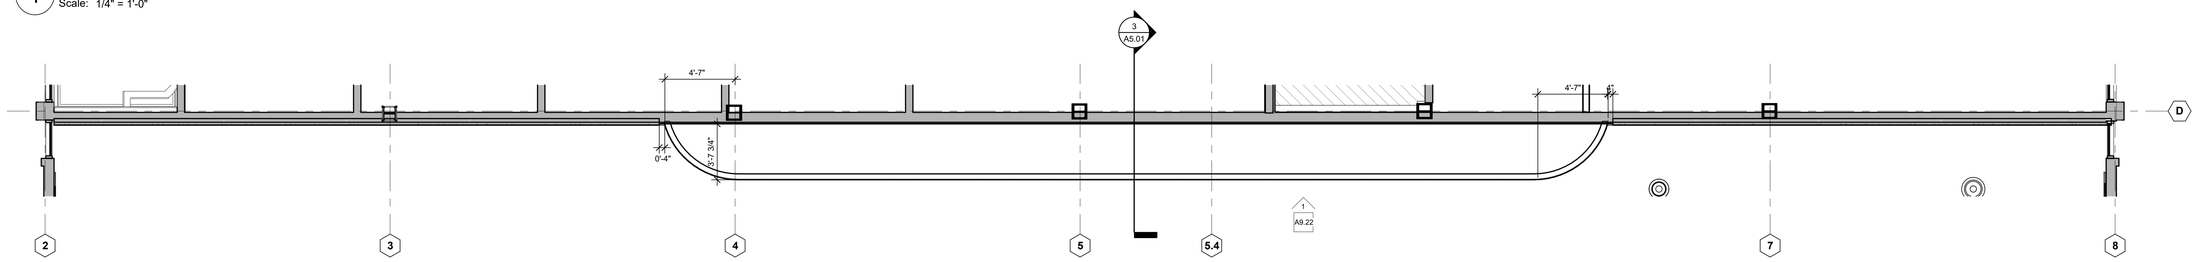

2 LEVEL 2 - ENLARGED PLAN AT 15 FEET AFF
Scale: 1/4" = 1'-0"

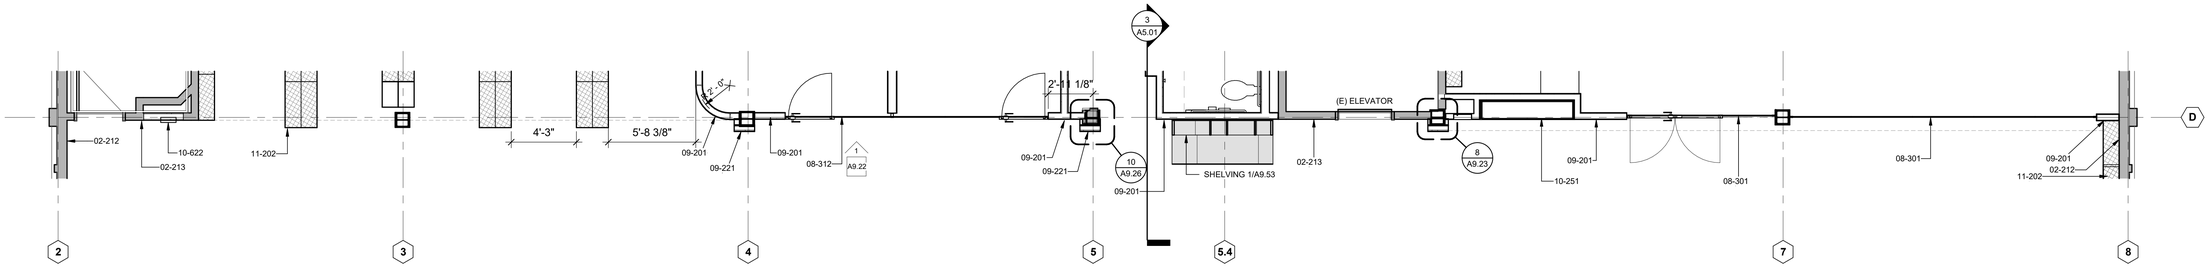

3 LEVEL 2 - ENLARGED PLAN AT 5 FEET AFF
Scale: 1/4" = 1'-0"

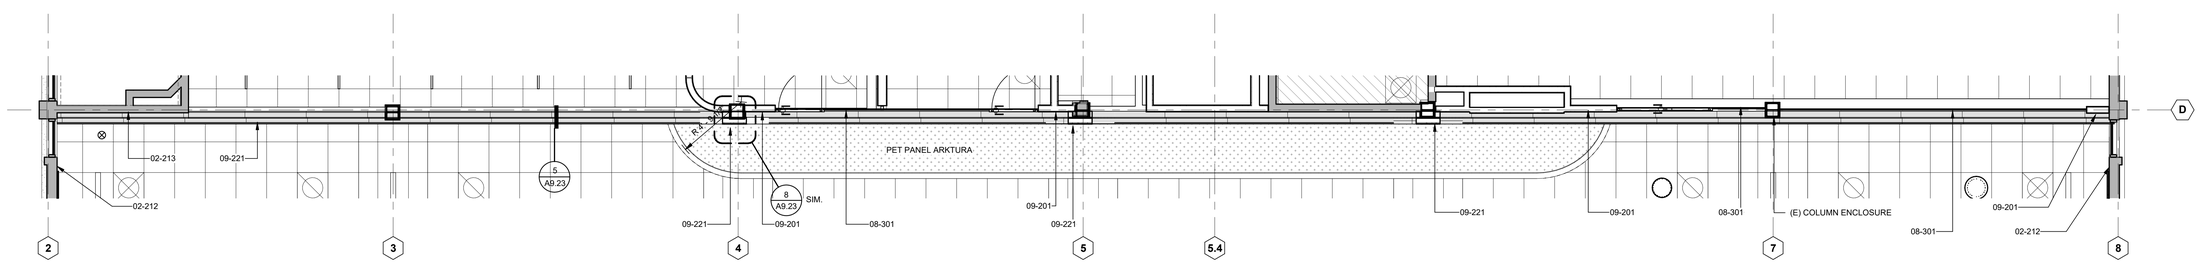

4 LEVEL 2 - ENLARGED RCP
Scale: 1/4" = 1'-0"

KEYNOTE LEGEND	
KEY VALUE	KEYNOTE TEXT
02-212	EXTERIOR CONCRETE WALLS TO BE RE-PAINTED.
02-213	PLASTER WALL PARTITION TO BE RE-PAINTED.
06-202	RECESSED, ARCHED SHELVING WITH LAPTOP CHARGING STATION IN BASE CABINET, CUSTOM MADE. REFER TO CASEWORK SHEETS.
08-301	NON-THERMAL, ALUMINUM STOREFRONTM REFER TO STORFRONT TYPES SHEET A8.00
08-312	DEMOUNTABLE GLASS WALL AND DOOR SYSTEM, REFER TO STOREFRONT TYPES SHEET A8.00
09-201	GYP. BOARD, PAINTED
09-221	LAMINATED WOOD PANEL AND Z-CLIP OVER GYP BOARD.
09-232	1/2" ACOUSTICAL PANEL (PET FELT), PERFORATED, REFER TO DETAILS SHEET A9.25
10-251	RECESSED DISPLAY CABINET IN FRAMED OPENING WITH ANODIZED ALUMINUM FRAME, 1/4" TEMPERED GLASS SLIDING DOORS WITH LOCK, ADJUSTABLE GLASS SHELVES AND INTEGRATED LIGHT FIXTURE PER DETAILS/A9.42
10-622	FIRE EXTINGUISHER CABINET AND FIRE EXTINGUISHER, PER 16/A9.26
10-633	RECESSED AED CABINET PER 9/A9.26. (CABINET CFCI, EQUIPMENT OFOI)
11-202	METAL LIBRARY SHELVING, 82" TALL, REFER TO DETAILS SHEET S10.00

REVISIONS

CONSTRUCTION DOCUMENTS

LICENSED ARCHITECT
VICTOR ORTEGA, JR.
No. C-34809
Exp. 8-31-25
STATE OF CALIFORNIA

LOS ANGELES COUNTY PUBLIC WORKS
HUNTINGTON PARK LIBRARY
6518 MILES AVE
HUNTINGTON PARK, CA 90255

COUNTY OF LOS ANGELES CALIFORNIA

LA COUNTY LIBRARY


NAC

NAC NO.	161-23025
DRAWN	Author
CHECKED	Checker
DATE	11/01/2024


SECOND FLOOR WOOD PANELING ENLARGED PLANS AND ELEVATIONS

A9.22


© 2023 NAC Inc

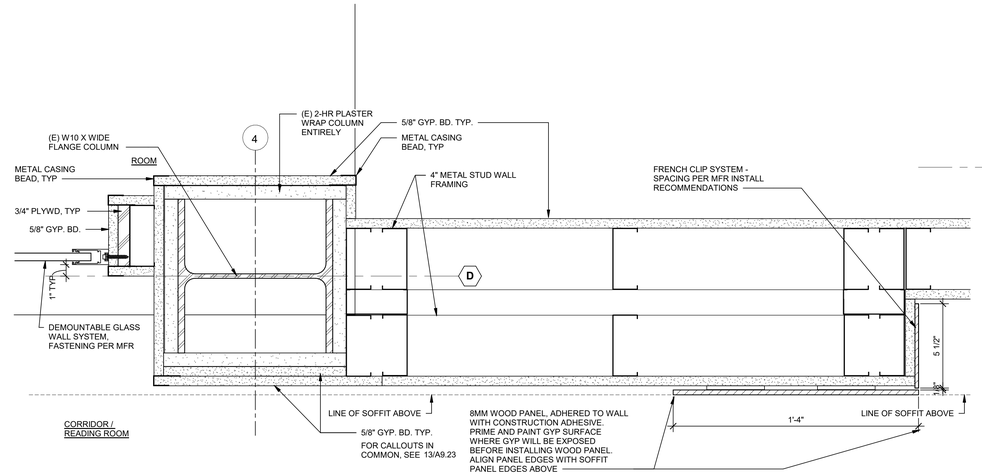


18 WP COLUMN WRAP @ D4 GRID
Scale: 3" = 1'-0"

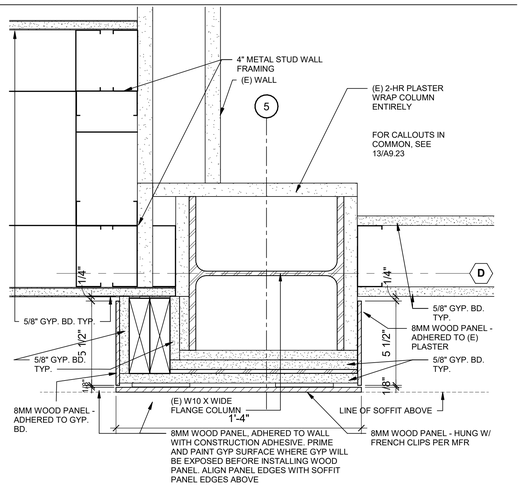


16 TYP WP COLUMN WRAP
Scale: 3" = 1'-0"

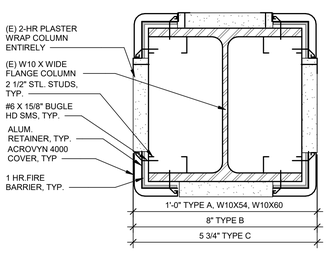


TYPES A, B & C

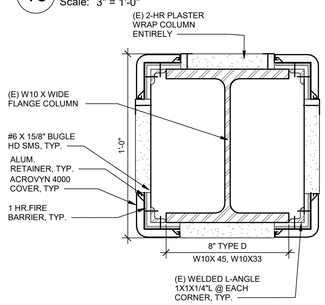

TYPE D

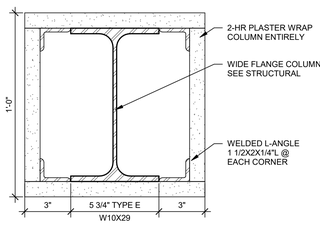


TYPE E

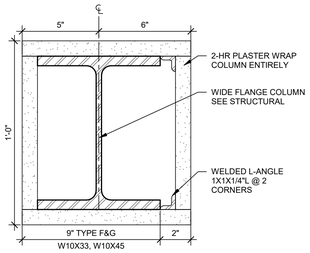


TYPES F & G


15 COLUMN WRAP PLAN DETAILS
Scale: 3" = 1'-0"

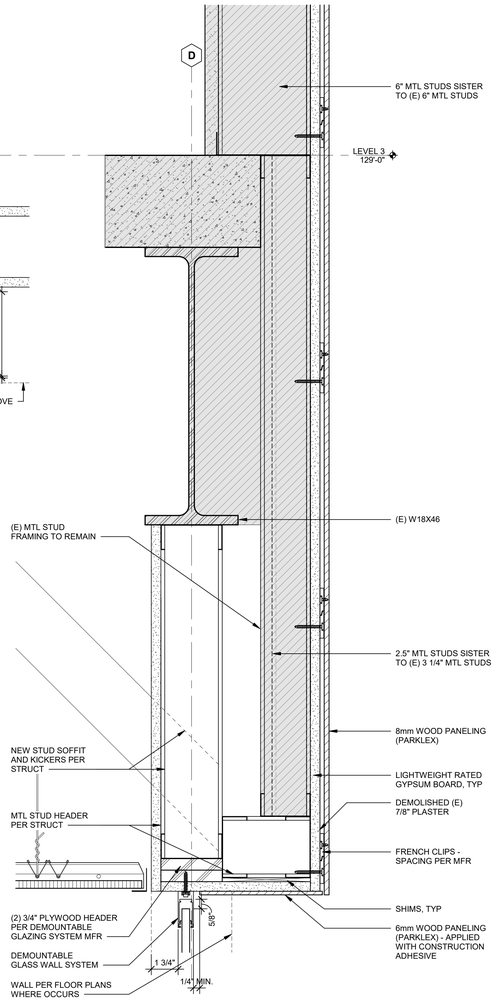


14 TYPICAL WOOD PANEL SOFFIT AT LEVEL 2
Scale: 3" = 1'-0"

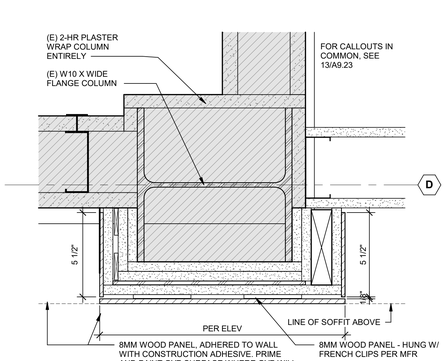


8 TYP WP COLUMN WRAP
Scale: 3" = 1'-0"

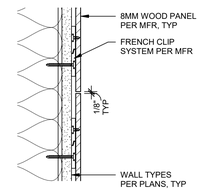


9 PANEL REVEAL - SECTION
Scale: 3" = 1'-0"

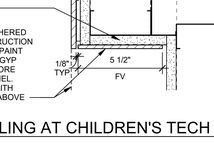


10 WP - TOW @ ACT
Scale: 3" = 1'-0"

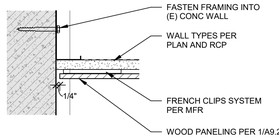


11 WP - PANEL EDGE @ EX CONC
Scale: 3" = 1'-0"

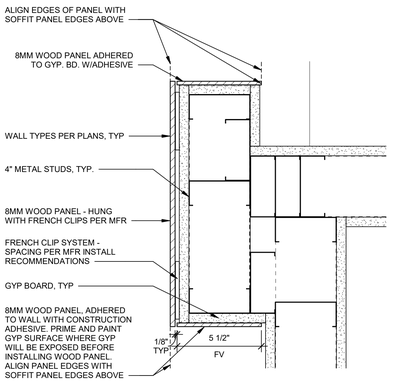


12 WOOD PANELING AT CHILDREN'S TECH - PLAN
Scale: 3" = 1'-0"

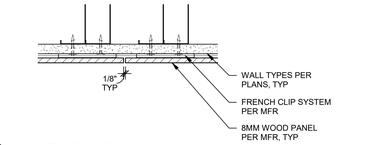


1 PANEL REVEAL - PLAN
Scale: 3" = 1'-0"

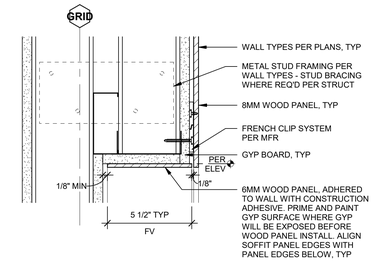


2 WP - TYP WP SOFFIT @ WALL
Scale: 3" = 1'-0"

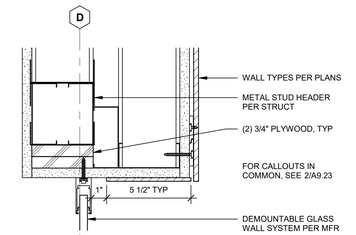


3 WP - TYP WP SOFFIT @ GLAZING SYSTEM
Scale: 3" = 1'-0"

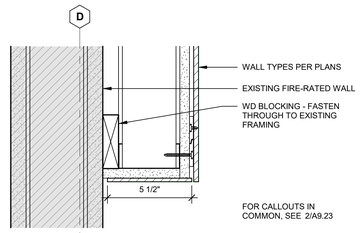


4 WP - TYP WP AND SOFFIT @ EXISTING WALL
Scale: 3" = 1'-0"

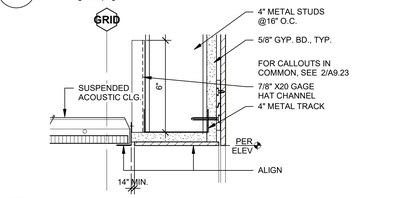

5 WP - TYP WP SOFFIT AT ACT
Scale: 3" = 1'-0"

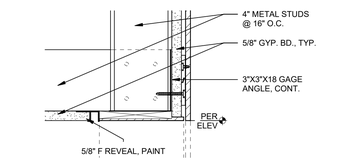

6 CL - WP - L1 SOFFIT @ CHILD TECH
Scale: 3" = 1'-0"

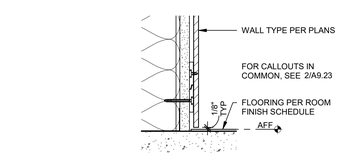

7 IW - TYP WP TO FLOOR
Scale: 3" = 1'-0"

REVISIONS

CONSTRUCTION DOCUMENTS

LICENSED ARCHITECT
STEVEN ORTEGA
No. C-34809
Exp. 8-31-25
STATE OF CALIFORNIA

LOS ANGELES COUNTY PUBLIC WORKS
HUNTINGTON PARK LIBRARY
6518 MILES AVE
HUNTINGTON PARK, CA 90255

LA COUNTY LIBRARY


NAC

NAC NO	161-23025
DRAWN	Author
CHECKED	Checker
DATE	11/01/2024


WOOD PANELING DETAILS

A9.23


© 2023 NAC Inc

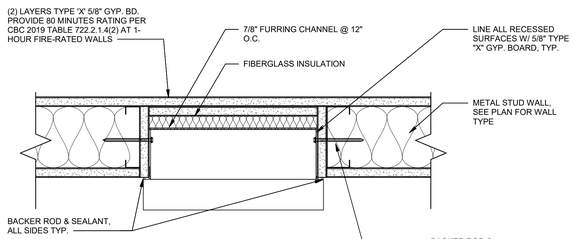

PLAN AT FIRE-RATED WALL

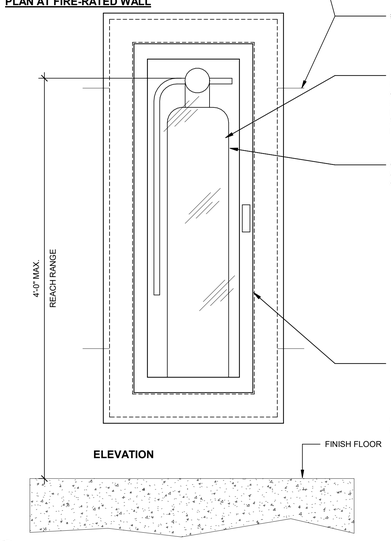


ELEVATION

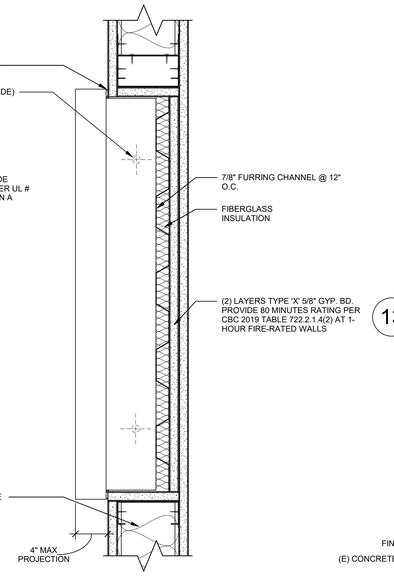


SECTION AT FIRE-RATED WALL

16 SEMI-RECESSED FIRE EXT. CABINET

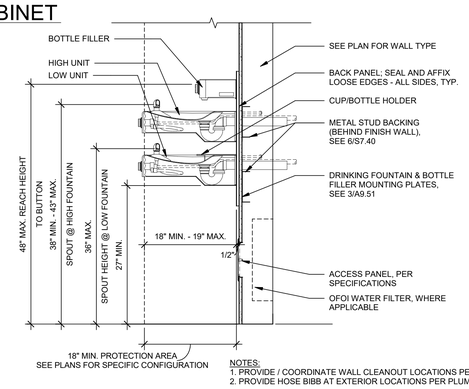


NOTES:
1. PROVIDE / COORDINATE WALL CLEANOUT LOCATIONS PER PLUMBING.
2. PROVIDE HOSE BIBB AT EXTERIOR LOCATIONS PER PLUMBING.


15 HI LO DRINKING FOUNTAIN & BOTTLE FILLER - SECTION
Scale: 1" = 1'-0"

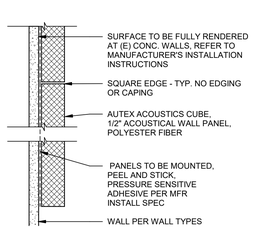


13 ACOUSTICAL WALL PANEL
Scale: 3" = 1'-0"

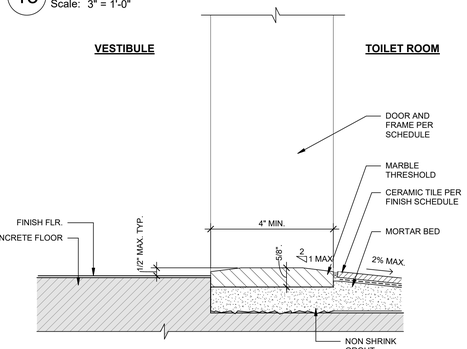


10 MARBLE THRESHOLD
Scale: 3" = 1'-0"

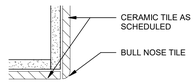


6 OUTSIDE CORNER - TILE TO TILE
Scale: 3" = 1'-0"

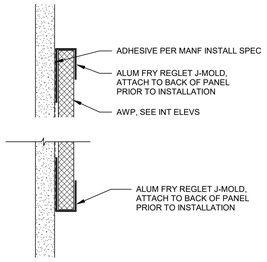


7 ACOUSTIC WALL PANEL EDGE
Scale: 6" = 1'-0"

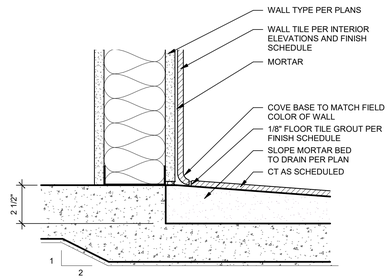


8 THICK SET MORTAR BED @ SLAB ON GRADE
Scale: 3" = 1'-0"

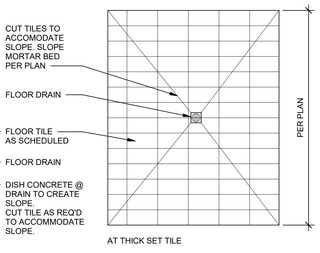


11 TYP CT @ FLOOR DRAIN
Scale: 1/2" = 1'-0"

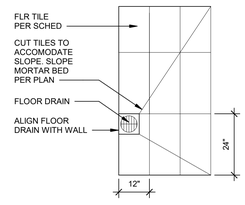


9 TYP CT @ OFFSET FLOOR DRAINS
Scale: 1/2" = 1'-0"

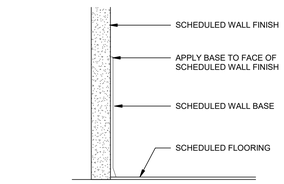


1 TYP WALL BASE
Scale: 6" = 1'-0"

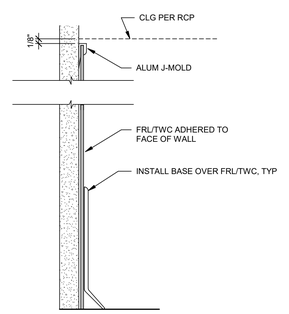


2 FRL WALL FINISH BASE & TOP
Scale: 6" = 1'-0"

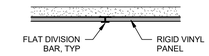

3 RIGID VINYL PANEL JOINT
Scale: 3" = 1'-0"

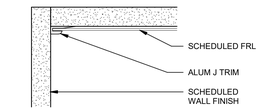

4 INSIDE CORNER - FRL TO GYP
Scale: 6" = 1'-0"

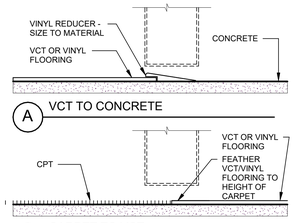


A VCT TO CONCRETE

B CARPET TO VCT


C NOT USED

D NOT USED

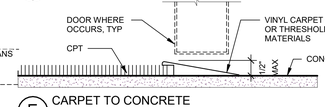


E CARPET TO CONCRETE

NOTES:
1. REFER TO ROOM FINISH SCHEDULE & PLANS FOR SPECIAL FLOOR FINISHES
2. REFER TO DOOR HARDWARE SETS FOR OTHER SPECIFIED TRANSITIONS / THRESHOLDS

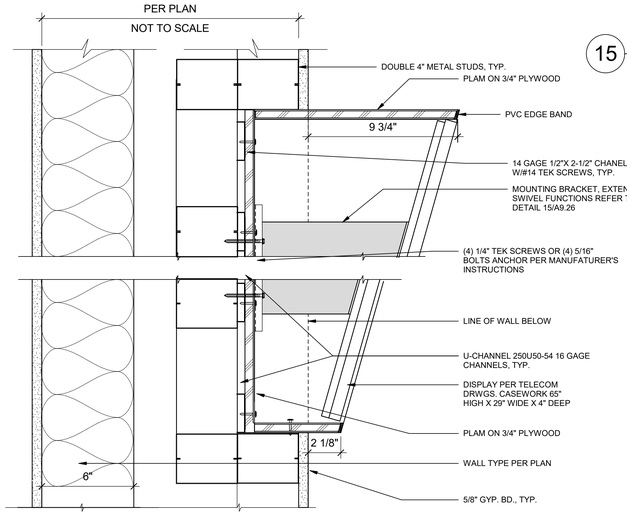


17 RECESSED WALL DEVICES AT RATED WALL
Scale: 3" = 1'-0"

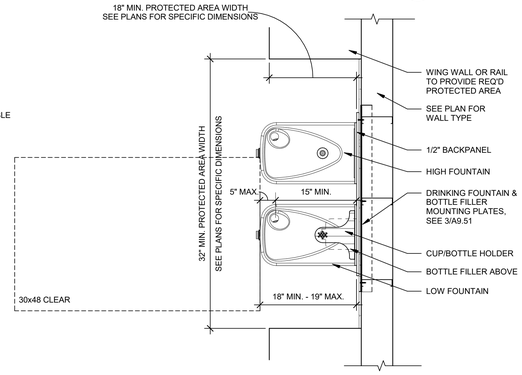

NOTES:
WATER FLOW REQUIREMENTS PER 11B-602.6: AT LOW FOUNTAIN THE SPOUT SHALL PROVIDE A FLOW OF WATER AT LEAST 4 INCHES (102MM) HIGH MINIMUM AND SHALL BE LOCATED 5 INCHES (127MM) MAXIMUM FROM THE FRONT OF THE UNIT. THE ANGLE OF THE WATER STREAM SHALL BE MEASURED HORIZONTALLY RELATIVE TO THE FRONT FACE OF THE UNIT. WHERE SPOUTS ARE LOCATED LESS THAN 3 INCHES (76MM) OF THE FRONT OF THE UNIT, THE ANGLE OF THE WATER STREAM SHALL BE 30 DEGREES MAXIMUM. WHERE SPOUTS ARE LOCATED BETWEEN 3 INCHES (76MM) AND 5 INCHES (127 MM) MAXIMUM FROM THE FRONT OF THE UNIT, THE ANGLE OF THE WATER STREAM SHALL BE 15 DEGREES MAXIMUM.

14 HI LO DRINKING FOUNTAIN & BOTTLE FILLER - PLAN
Scale: 1" = 1'-0"

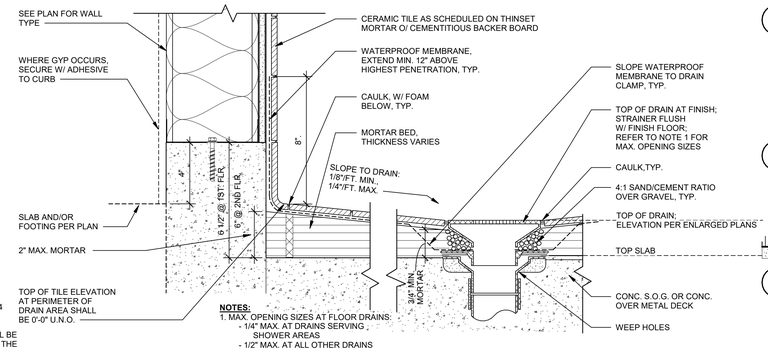

NOTES:
1. MAX. OPENING SIZES AT FLOOR DRAINS:
- 1/4" MAX. AT DRAINS SERVING SHOWER AREAS
- 1/2" MAX. AT ALL OTHER DRAINS

12 CURB & FLOOR DRAIN @ PUBLIC RESTROOM
Scale: 3" = 1'-0"

5 TYP FLOOR TRANSITIONS
Scale: 6" = 1'-0"

REVISIONS

CONSTRUCTION DOCUMENTS

LICENSED ARCHITECT VICTOR ORTEGA No. C-34809 Exp. 8-31-25 STATE OF CALIFORNIA

LOS ANGELES COUNTY PUBLIC WORKS
HUNTINGTON PARK LIBRARY
6518 MILES AVE
HUNTINGTON PARK, CA 90255

COUNTY OF LOS ANGELES CALIFORNIA

LA COUNTY LIBRARY


NAC

NAC NO	161-23025
DRAWN	Author
CHECKED	Checker
DATE	11/01/2024


INTERIOR FINISH DETAILS

A9.25


© 2023 NAC Inc

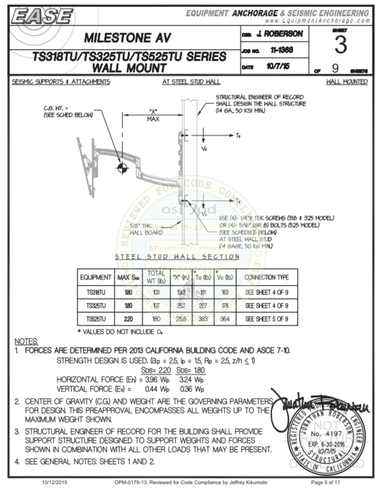


15 DISPLAY MTG. BRACKET ANCHORAGE
NOT TO SCALE

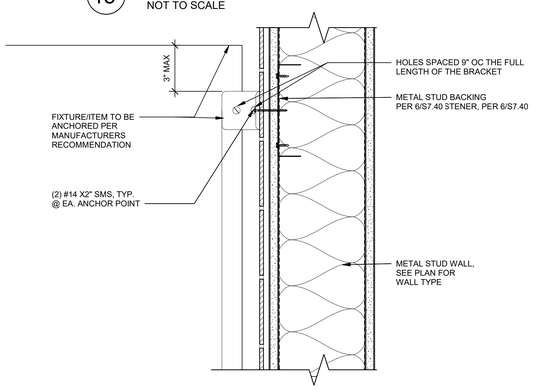

14 BACKING FOR ANCHORAGE AT TOILET PARTITION
Scale: 3" = 1'-0"

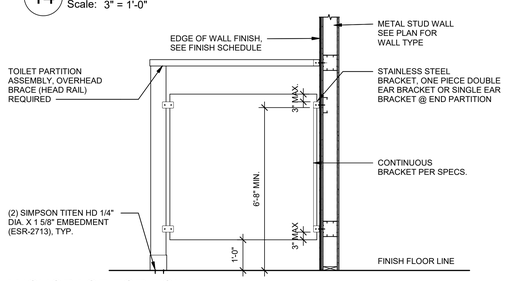


13 ANCHORAGE FOR TOILET PARTITIONS
Scale: 1/2" = 1'-0"

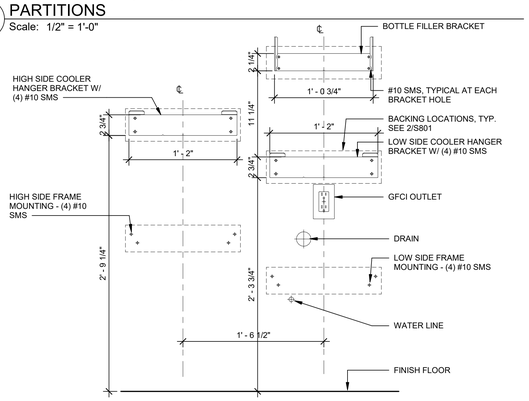


NOTE:
1. INSTALL MOUNTING PLATE BEFORE FINISH WORK.
2. MOUNTING PLATE SUPPLIED BY MANUFACTURER.

11 DRINKING FOUNTAIN MOUNTING PLATE Copy 1
Scale: 1 1/2" = 1'-0"

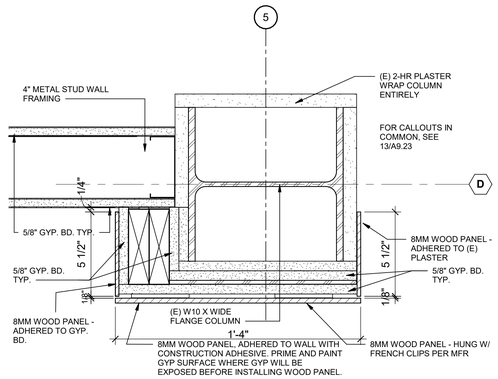

10 TYP WP COLUMN WRAP
Scale: 3" = 1'-0"

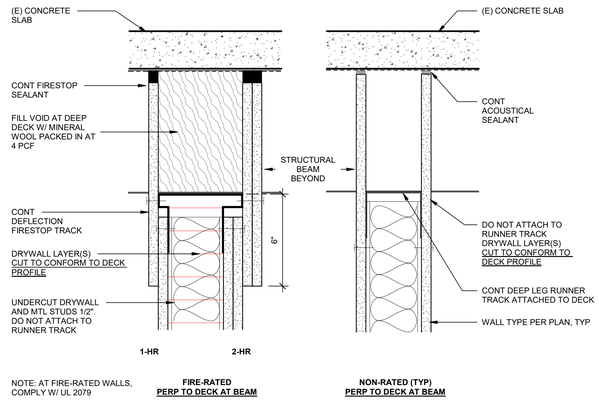


NOTE: AT FIRE-RATED WALLS, COMPLY W/ UL 2079


FIRE-RATED
PERP TO DECK AT BEAM

NON-RATED (TYP)
PERP TO DECK AT BEAM


5 RATED & NON-RATED WALLS PERPENDICULAR TO STRUCTURAL BEAM
Scale: 3" = 1'-0"

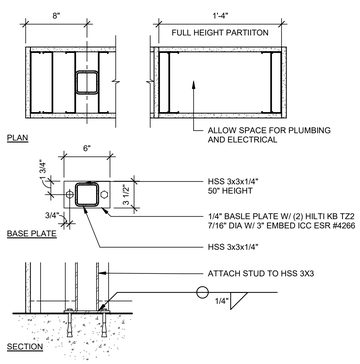

1 PARTIAL HEIGHT WALL ANCHOR
Scale: 1 1/2" = 1'-0"

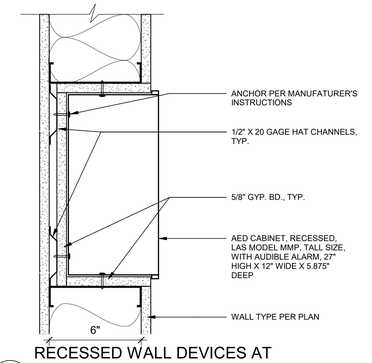


9 RECESSED WALL DEVICES AT RATED WALL
Scale: 3" = 1'-0"

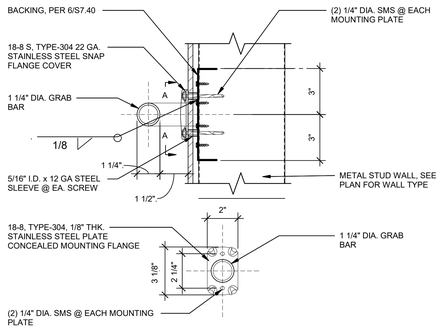


A MOUNTING FLANGE DETAIL

15 GRAB BAR @ STUD WALL
Scale: 3" = 1'-0"

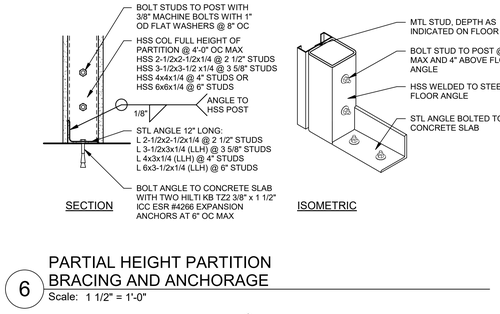


6 PARTIAL HEIGHT PARTITION BRACING AND ANCHORAGE
Scale: 1 1/2" = 1'-0"

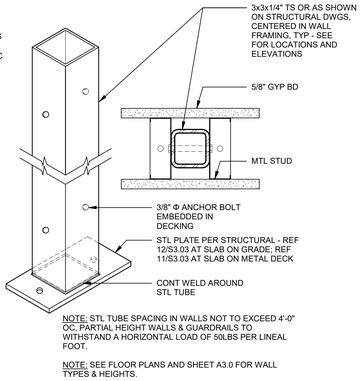


NOTE: STL TUBE SPACING IN WALLS NOT TO EXCEED 4'-0" OC, PARTIAL HEIGHT WALLS & GUARDRAILS TO WITHSTAND A HORIZONTAL LOAD OF 50LBS PER LINEAL FOOT.

NOTE: SEE FLOOR PLANS AND SHEET A3.0 FOR WALL TYPES & HEIGHTS.


2 PARTIAL HEIGHT WALL SUPPORT
Scale: 3" = 1'-0"

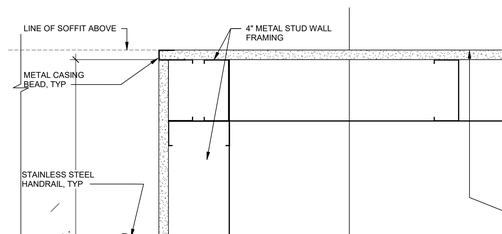


8 COLUMN ENCLOSURSE @ GRID E/6
Scale: 3" = 1'-0"

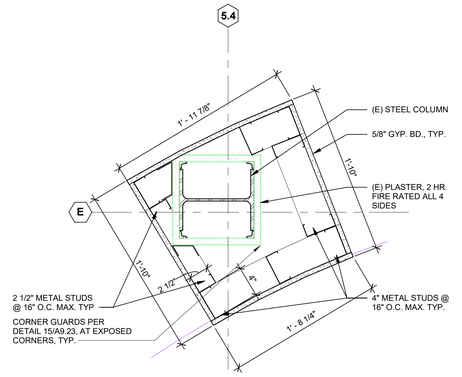


7 COLUMN FRAMING AT GRIDS E/5.4
Scale: 1 1/2" = 1'-0"

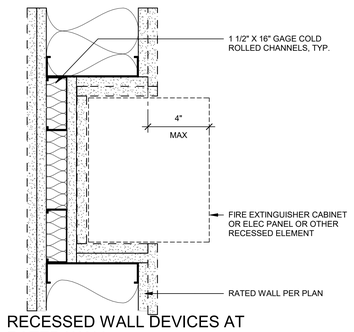

3 RECESSED WALL DEVICES AT RATED WALL
Scale: 3" = 1'-0"

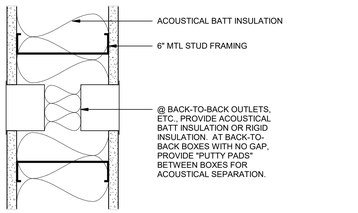

4 BACK-TO-BACK OUTLETS
Scale: 3" = 1'-0"

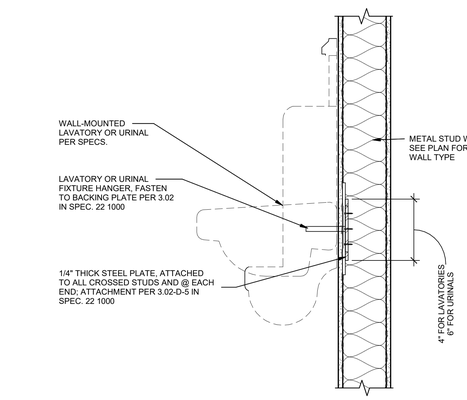

12 ANCHORAGE FOR LAVATORY, TYP.
Scale: 1 1/2" = 1'-0"

REVISIONS

CONSTRUCTION DOCUMENTS

LICENSED ARCHITECT
STEVEN ORTEGA
No. C-34809
Exp. 8-31-25
STATE OF CALIFORNIA

LOS ANGELES COUNTY PUBLIC WORKS
HUNTINGTON PARK LIBRARY
6518 MILES AVE
HUNTINGTON PARK, CA 90255

COUNTY OF LOS ANGELES CALIFORNIA

LA COUNTY LIBRARY


NAC

NAC NO	161-23025
DRAWN	Author
CHECKED	Checker
DATE	11/01/2024

INTERIOR DETAILS


A9.26

© 2023 NAC Inc

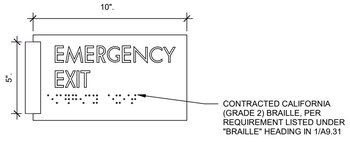

NOTE:
SEE DETAIL 1/A9.31 FOR ADDITIONAL PERMANENT TACTILE SIGN REQUIREMENTS
REFER TO COUNTY OF LOS ANGELES PUBLIC LIBRARY SIGN STANDARDS MANUAL FOR SIGN DESIGN REQUIREMENTS.

10 EXIT SIGNAGE
Scale: 1/2" = 1'-0"

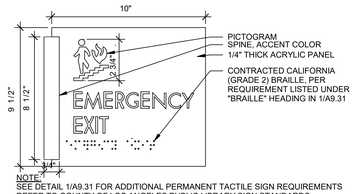


NOTE:
SEE DETAIL 1/A9.31 FOR ADDITIONAL PERMANENT TACTILE SIGN REQUIREMENTS
REFER TO COUNTY OF LOS ANGELES PUBLIC LIBRARY SIGN STANDARDS MANUAL FOR SIGN DESIGN REQUIREMENTS.

11 EMERGENCY EXIT SIGNAGE AT EXIT STAIRS
Scale: 11/2" = 1'-0"




10" x 14", 55 MIL THICK PLASTIC W/ ROUNDED CORNERS, PRE-PUNCHED HOLES FOR MOUNTING

12 NO SMOKING SIGN
Scale: 6" = 1'-0"

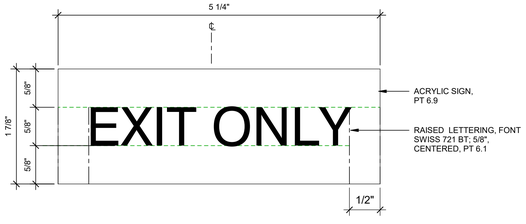

13 EXIT ONLY SIGN
Scale: 12" = 1'-0"

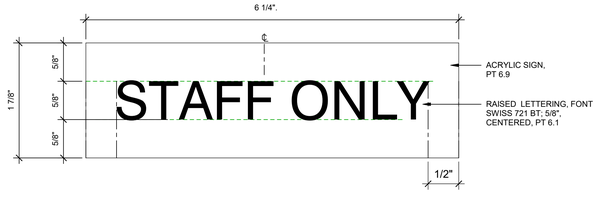

Scale: 12" = 1'-0"



NOTES:
ASSISTIVE LISTENING SYSTEM WITH REMOTE DEVICES TO BE PROVIDED PER SPECS 27 4113 (CLASSROOMS & CONFERENCE ROOMS) OR 27 5129 (GYMS).

DEVICES WILL BE AVAILABLE AT THE ADMINISTRATION OFFICE AND SHALL COMPLY WITH THE REQUIREMENTS OF CBC 2019 11B-706 AS LISTED BELOW:


11B-706.2 Receiver jacks. *Receivers required for use with an assistive listening system shall include a 1/8 inch (3.2 mm) standard mono jack.*
11B-706.3 Receiver hearing-aid compatibility. *Receivers required to be hearing-aid compatible shall interface with telecoils in hearing aids through the provision of neckloops.*
11B-706.4 Sound pressure level. *Assistive listening systems shall be capable of providing a sound pressure level of 110 dB minimum and 118 dB maximum with a dynamic range on the volume control of 50 dB.*
11B-706.5 Signal-to-noise ratio. *The signal-to-noise ratio for internally generated noise in assistive listening systems shall be 18 dB minimum.*
11B-706.6 Peak clipping level. *Peak clipping shall not exceed 18 dB of clipping relative to the peaks of speech.*

FINAL DESIGN OF THE SIGN TO BE PROVIDED BY ARCHITECT

VISUAL CHARACTERS SHALL COMPLY WITH CBC 11B-703.5


A MINIMUM OF TWO PORTABLE DEVICES, BOTH OF WHICH SHALL BE HEARING-AID COMPATIBLE, SHALL BE PROVIDED PER SPECS 27 4113 (CLASSROOMS & CONFERENCE ROOMS) OR 27 5129 (GYMS).

7 ASSISTIVE LISTENING (L)
Scale: 3" = 1'-0"

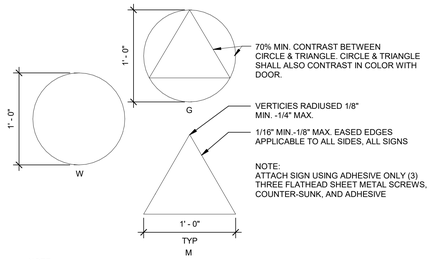

NOTE:
SEE DETAIL 1/A9.70 FOR ADDITIONAL PERMANENT TACTILE SIGN REQUIREMENTS

8 RESTROOM DOOR SIGNS (NON-TACTILE)('W', 'M' OR "G")
Scale: 1 1/2" = 1'-0"

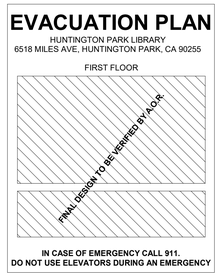


NOTES:
SIGNAGE SHALL BE POSTED IN A PROMINENT PLACE INDICATING THE EVACUATION ROUTE.

FINAL DESIGN AND PLACEMENT TO BE PROVIDED BY ARCHITECT.


SIGN IS AN INFORMATIONAL SIGN PER CBC 11B-216.3 AND SHALL HAVE VISUAL CHARACTERS COMPLYING WITH CBC 11B-703.5

9 EVACUATION PLAN SIGNAGE
Scale: 3" = 1'-0"

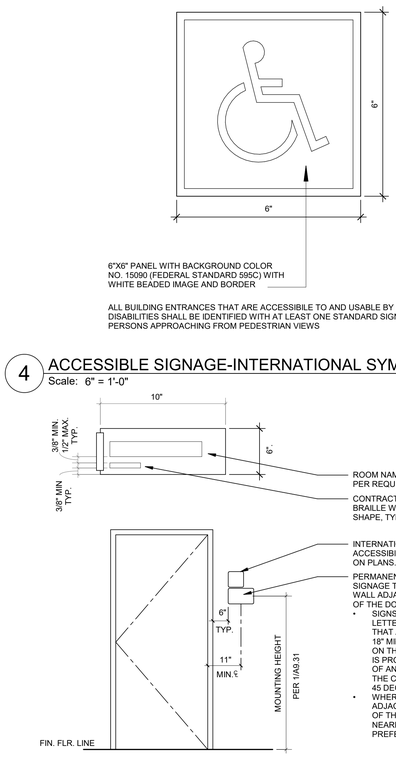

ALL BUILDING ENTRANCES THAT ARE ACCESSIBLE TO AND USABLE BY PERSONS WITH DISABILITIES SHALL BE IDENTIFIED WITH AT LEAST ONE STANDARD SIGN TO BE VISIBLE TO PERSONS APPROACHING FROM PEDESTRIAN VIEWS


4 ACCESSIBLE SIGNAGE-INTERNATIONAL SYMBOL
Scale: 6" = 1'-0"

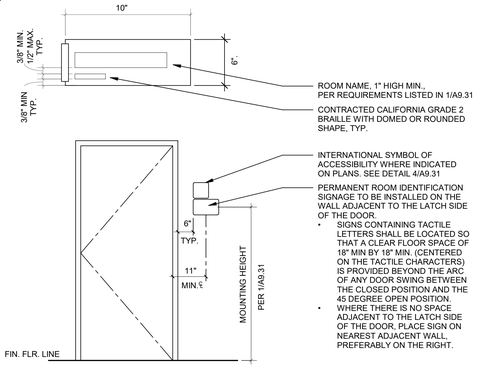

ELEVATION

NOTE:
REFER TO DETAIL 1/A9.31 FOR TEXT/BRAILLE REQUIREMENTS.
REFER TO COUNTY OF LOS ANGELES PUBLIC LIBRARY SIGN STANDARDS MANUAL FOR SIGN DESIGN REQUIREMENTS.

5 PERMANENT ROOM SIGN ELEVATION
Scale: 1/2" = 1'-0"

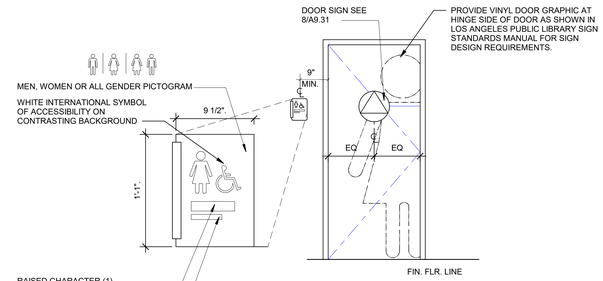

NOTE:
REFER TO DETAIL 1/A9.31 FOR TEXT/BRAILLE REQUIREMENTS.
REFER TO COUNTY OF LOS ANGELES PUBLIC LIBRARY SIGN STANDARDS MANUAL FOR SIGN DESIGN REQUIREMENTS.

6 RESTROOM SIGNAGE ELEVATION
Scale: 1/2" = 1'-0"

EDGES AND VERTICES
EDGES AND VERTICES ON GEOMETRIC SYMBOLS SHALL BE EASED OR ROUNDED AT 1/16" MINIMUM, OR CHAMFERED AT 1/8" MINIMUM. VERTICES SHALL BE RADIUSES BETWEEN 1/8" MINIMUM AND 1/4" MAXIMUM. (11B-703.7.2.6.4)

PROPORTIONS
RAISED CHARACTERS ON SIGNS SHALL BE SELECTED FROM FONTS WHERE THE WIDTH OF THE UPPER CASE LETTER "O" IS 60% MINIMUM AND 110% MAXIMUM OF THE HEIGHT OF THE UPPERCASE LETTER "I". STROKE THICKNESS OF THE UPPERCASE LETTER "I" SHALL BE 15% MAXIMUM OF THE HEIGHT OF THE CHARACTER.

FINISH AND CONTRAST
CHARACTERS, SYMBOLS AND BACKGROUNDS SHALL HAVE A NON-GLARE FINISH. CHARACTERS & SYMBOLS SHALL HAVE CONTRAST WITH THEIR BACKGROUND WITH EITHER USING CHARACTERS ON A DARK BACKGROUND OR DARK CHARACTERS ON A LIGHT BACKGROUND


BRAILLE (CBC 11B-703.3)
BRAILLE SHALL BE CONTRACTED (GRADE 2) AND SHALL COMPLY WITH SECTIONS 11B-703.3 & 11B-703.4.
DIMENSIONS AND CAPITALIZATION (CBC 11B-703.3.1): BRAILLE DOTS SHALL HAVE A DOMED OR ROUNDED SHAPE AND SHALL COMPLY WITH TABLE 11B-703.3.1. THE INDICATION OF AN UPPERCASE LETTER OR LETTERS SHALL ONLY BE USED BEFORE THE FIRST WORD OF SENTENCES, PROPER NOUNS AND NAMES, INDIVIDUAL LETTERS OF THE ALPHABET, INITIALS, AND ACRONYMS.
POSITION (CBC 11B-703.3.2): BRAILLE SHALL BE POSITIONED BELOW THE CORRESPONDING TEXT IN A HORIZONTAL FORMAT, FLUSH LEFT OR CENTERED. IF TEXT IS MULTI-LINED, BRAILLE SHALL BE PLACED BELOW THE ENTIRE TEXT. BRAILLE SHALL BE SEPARATED 3/8" MIN. AND 1/2" MAX. FROM ANY OTHER TACTILE CHARACTERS AND 3/8" MIN. FROM RAISED BORDERS AND DECORATIVE ELEMENTS.
EXCEPTION: BRAILLE PROVIDED ON ELEVATOR CAR CONTROLS SHALL BE SEPARATED 3/16" MIN. AND SHALL BE LOCATED EITHER DIRECTLY BELOW THE CORRESPONDING RAISED CHARACTERS OR SYMBOLS

RAISED CHARACTERS
INTEGRAL LETTERS, SYMBOL & BRAILLE RAISED 1/32" BY ETCHING OR SAND BLASTING AND SHALL BE SANS SERIF UPPERCASE CHARACTERS ACCOMPANIED BY GRADE 2 BRAILLE COMPLYING WITH 11B-703.3 AND 11B-703.4 TYP FOR ALL SIGNS


CHARACTER HEIGHT
MEASURED VERTICALLY FROM THE BASELINE OF THE CHARACTER, SHALL BE A MINIMUM OF 5/8" AND MAXIMUM OF 2" HIGH. BASED ON THE HEIGHT OF THE UPPERCASE LETTER "I"

MOUNTING HEIGHT
TACTILE CHARACTERS (INCLUDING RAISED TEXT AND BRAILLE CHARACTERS) ON SIGNS SHALL BE LOCATED 49 INCHES (48 INCHES MIN.) ABOVE THE FINISH FLOOR OR GROUND SURFACE MEASURED FROM THE BASELINE OF THE LOWEST BRAILLE CELLS CHARACTER, AND 59 INCHES (60 INCHES MAX.) ABOVE THE FINISH FLOOR OR GROUND SURFACE MEASURED FROM THE BASELINE OF THE HIGHEST LINE OF RAISED CHARACTERS

1 PERMANENT TACTILE ROOM SIGNAGE
Scale: 1 1/2" = 1'-0"

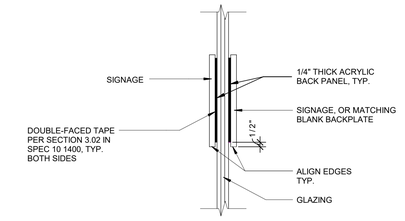

2 SIGNAGE @ GLAZING
Scale: 3" = 1'-0"

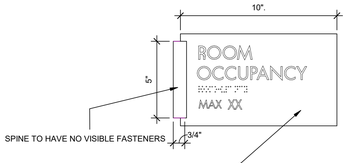

NOTE:
1. SEE DETAIL 1/A9.31 FOR SIGNAGE INFORMATION
2. SIGN SHALL COMPLY WITH CBC 1004.9
3. REFER TO COUNTY OF LOS ANGELES PUBLIC LIBRARY SIGN STANDARDS MANUAL FOR SIGN DESIGN REQUIREMENTS

3 MAX. OCCUPANCY LOAD (O)
Scale: 3" = 1'-0"

REVISIONS

CONSTRUCTION DOCUMENTS

LICENSED ARCHITECT
STEVEN ORTEGA
No. C-34809
Exp. 8-31-25
STATE OF CALIFORNIA

LOS ANGELES COUNTY PUBLIC WORKS
HUNTINGTON PARK LIBRARY
6518 MILES AVE
HUNTINGTON PARK, CA 90255

COUNTY OF LOS ANGELES CALIFORNIA

LA COUNTY LIBRARY


NAC

NAC NO	161-23025
DRAWN	Author
CHECKED	Checker
DATE	11/01/2024


INTERIOR SIGNAGE DETAILS

A9.31


© 2023 NAC Inc

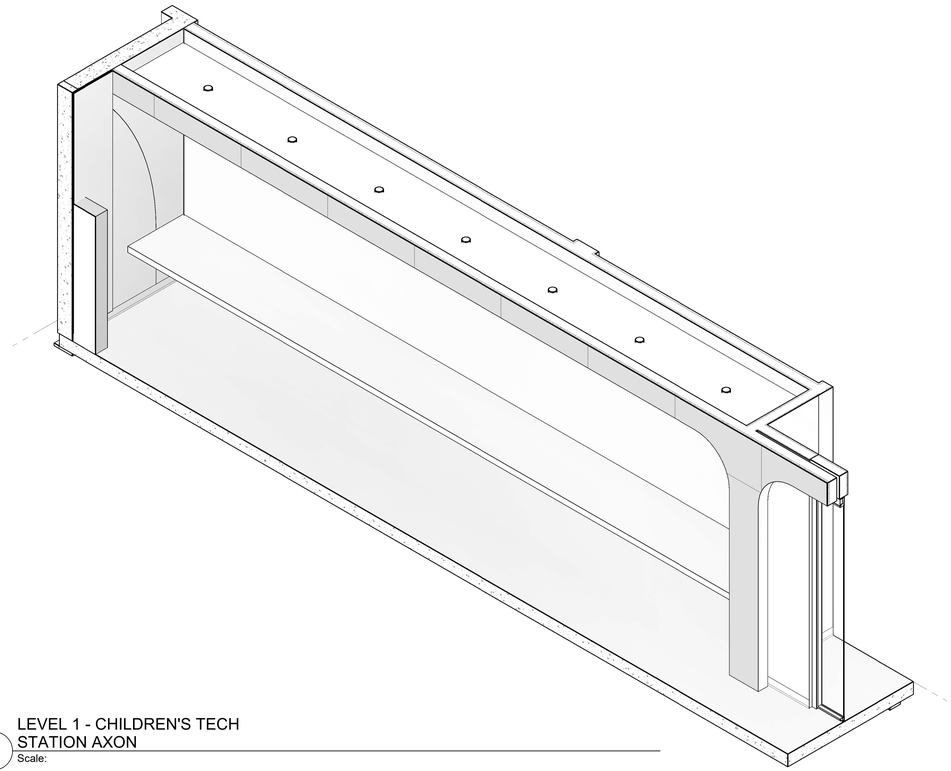


3 LEVEL 1 - CHILDREN'S TECH STATION AXON
Scale:

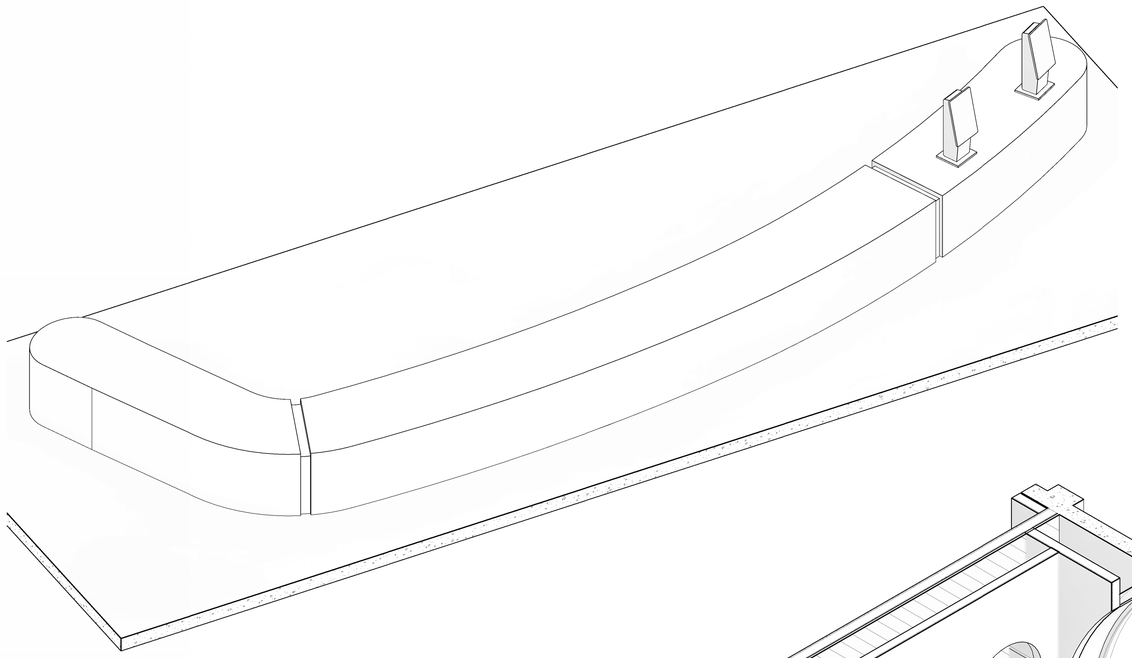

1 LEVEL 1 - CIRCULATION DESK AXON
Scale:

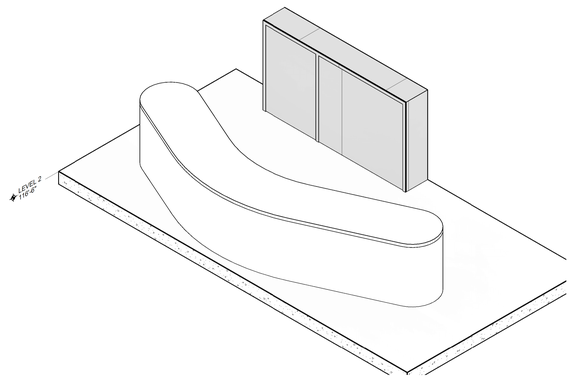

4 LEVEL 2 - INFO DESK AXON
Scale:

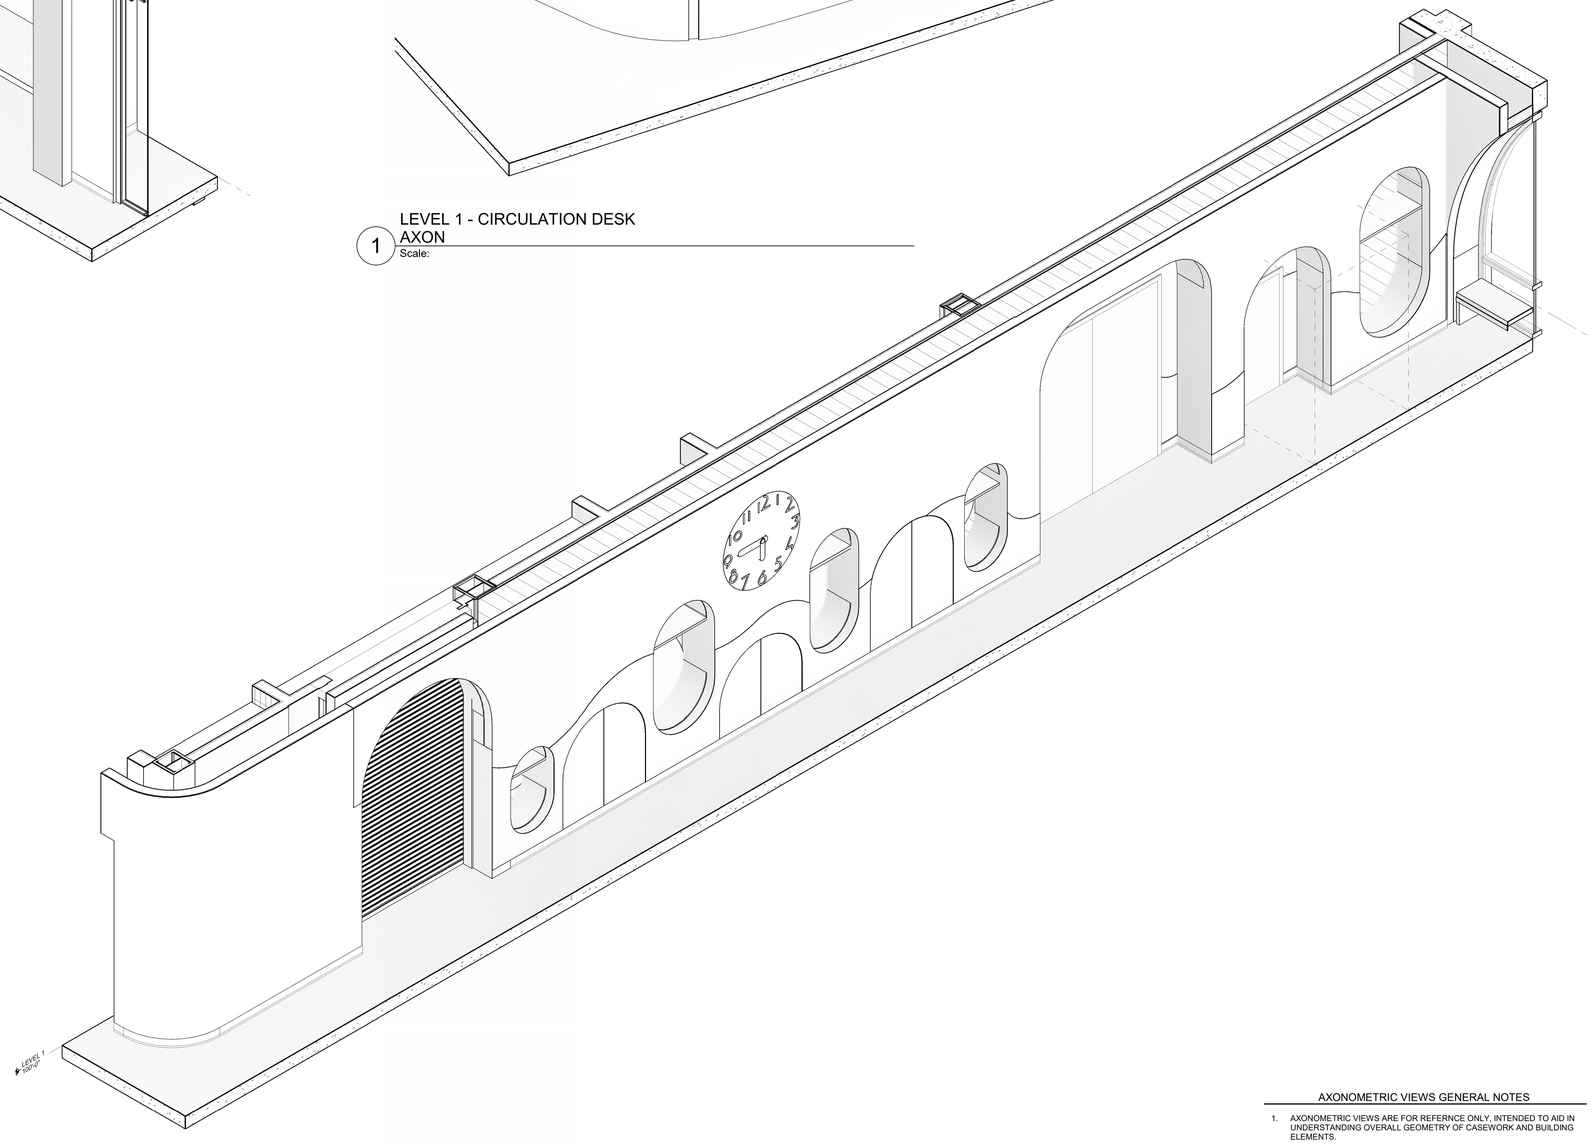

2 LEVEL 1 - DISCOVERY WALL AXON
Scale:

AXONOMETRIC VIEWS GENERAL NOTES

1. AXONOMETRIC VIEWS ARE FOR REFERNCE ONLY, INTENDED TO AID IN UNDERSTANDING OVERALL GEOMETRY OF CASEWORK AND BUILDING ELEMENTS.
2. REFER TO SHEETS A9.42 AND A9.50 SERIES FOR CASEWORK DETAILS.

REVISIONS

CONSTRUCTION DOCUMENTS

LICENSED ARCHITECT
No. C-34809
Exp. 8-31-25
STATE OF CALIFORNIA

LOS ANGELES COUNTY PUBLIC WORKS
HUNTINGTON PARK LIBRARY
6518 MILES AVE
HUNTINGTON PARK, CA 90255

COUNTY OF LOS ANGELES CALIFORNIA

LA COUNTY LIBRARY


NAC

NAC NO	161-23025
DRAWN	Author
CHECKED	Checker
DATE	11/01/2024


CASEWORK - AXONOMETRIC VIEWS

A9.40

© 2023 NAC Inc

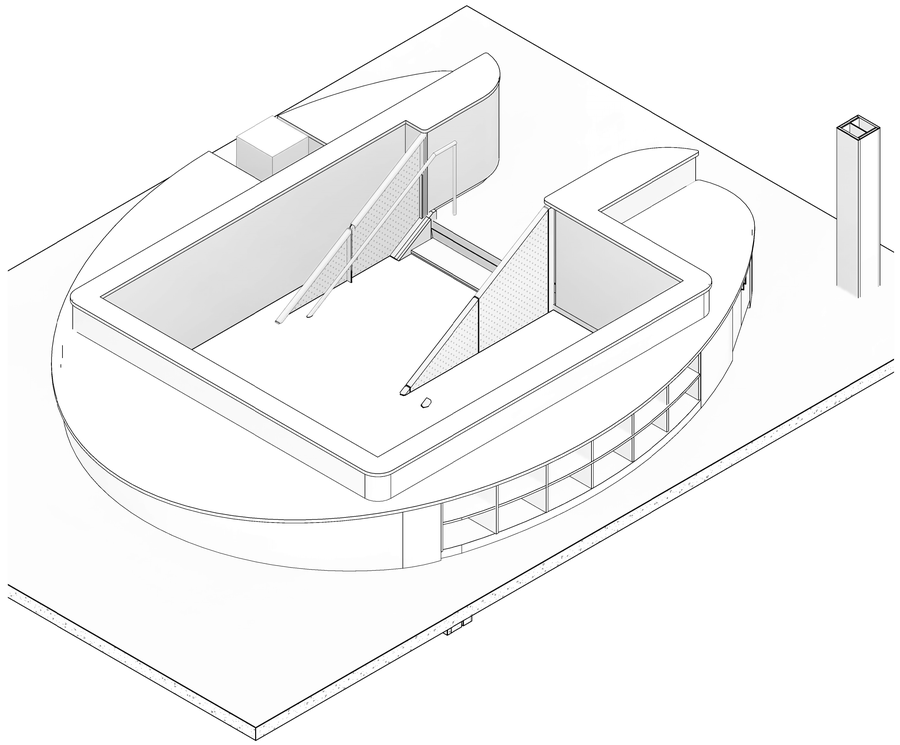


3 LEVEL 2 - CASEWORK AT STAIR
AXON 1
Scale:

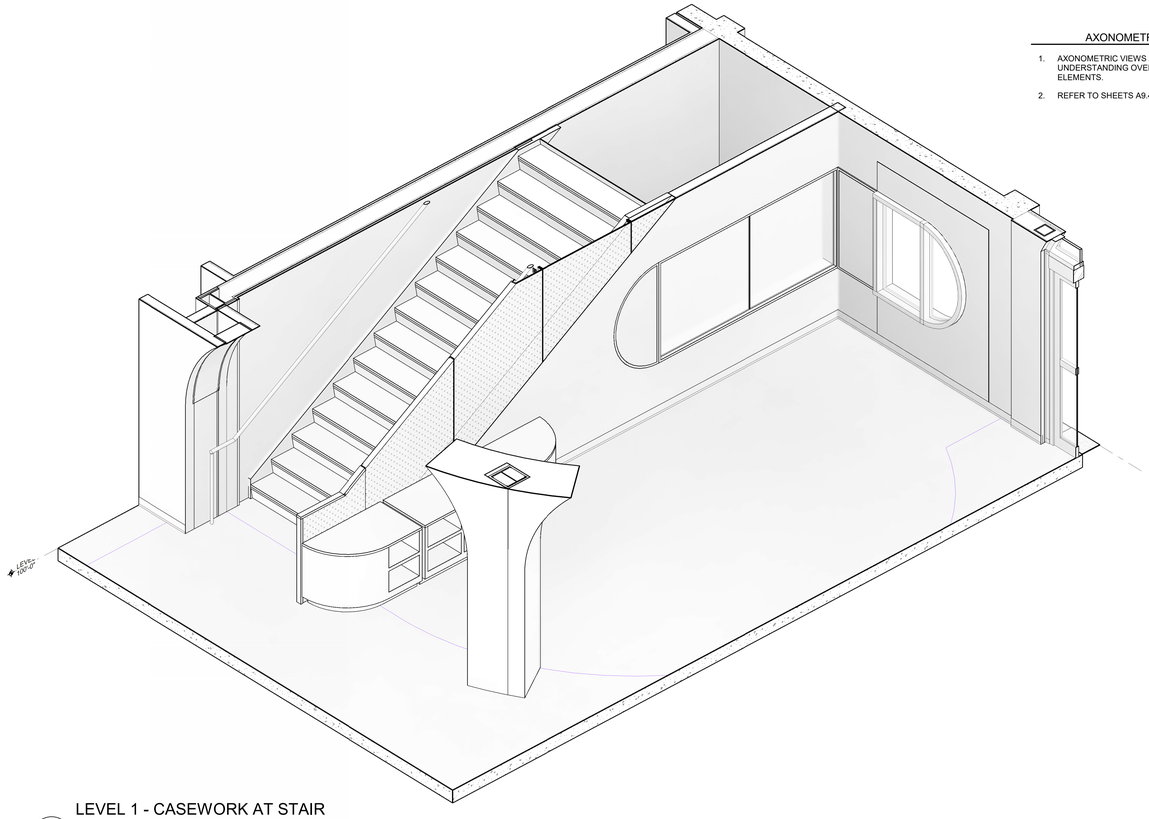


1 LEVEL 1 - CASEWORK AT STAIR
AXON 1
Scale:

AXONOMETRIC VIEWS GENERAL NOTES

1. AXONOMETRIC VIEWS ARE FOR REFERNCE ONLY. INTENDED TO AID IN UNDERSTANDING OVERALL GEOMETRY OF CASEWORK AND BUILDING ELEMENTS.
2. REFER TO SHEETS A9.42 AND A9.50 SERIES FOR CASEWORK DETAILS.

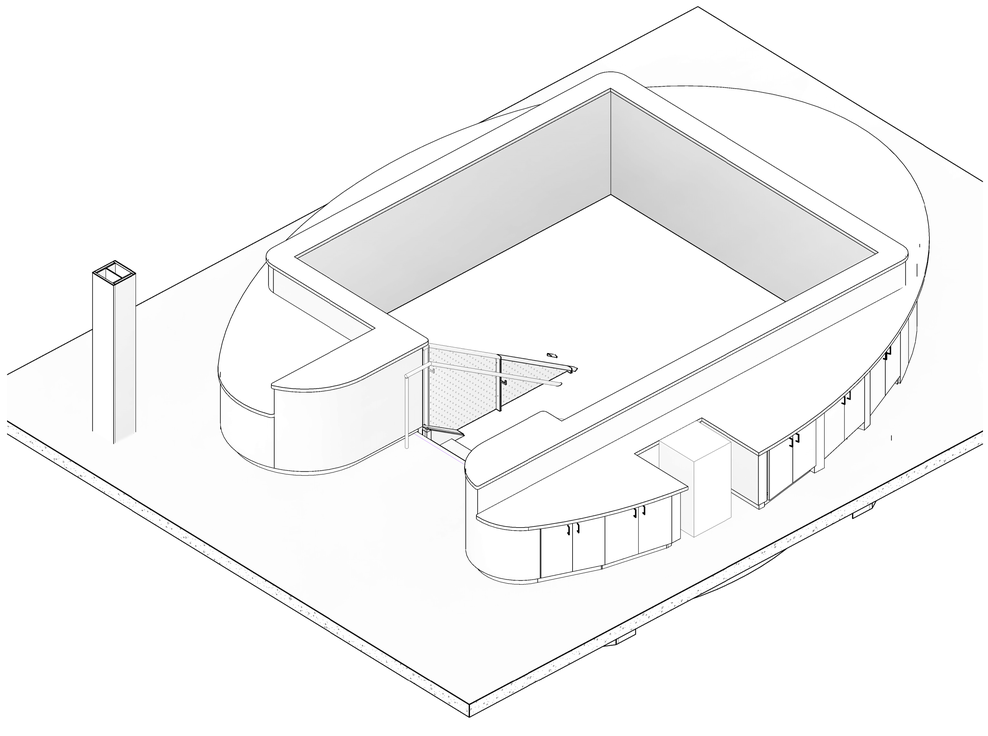

4 LEVEL 2 - CASEWORK AT STAIR
AXON 2
Scale:

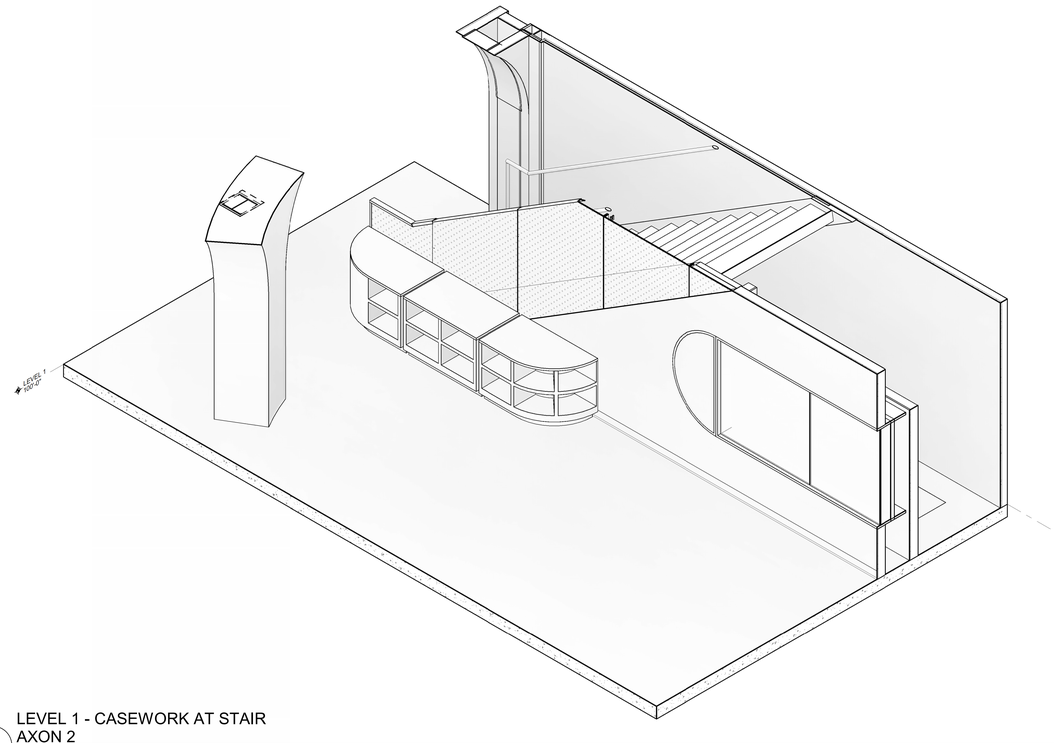

2 LEVEL 1 - CASEWORK AT STAIR
AXON 2
Scale:

REVISIONS

CONSTRUCTION DOCUMENTS

LICENSED ARCHITECT
VICTOR ORTEGA, JR.
No. C-34809
Exp. 8-31-25
STATE OF CALIFORNIA

LOS ANGELES COUNTY PUBLIC WORKS
HUNTINGTON PARK LIBRARY
6518 MILES AVE
HUNTINGTON PARK, CA 90255

COUNTY OF LOS ANGELES CALIFORNIA

LA COUNTY LIBRARY


NAC

NAC NO	161-23025
DRAWN	Author
CHECKED	Checker
DATE	11/01/2024


CASEWORK - AXONOMETRIC VIEWS

A9.41


© 2023 NAC Inc

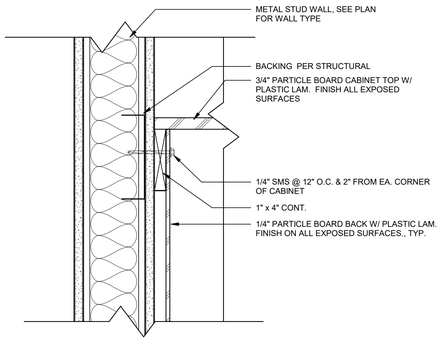


11 CABINET UPPER AT STUD WALL
Scale: 3" = 1'-0"

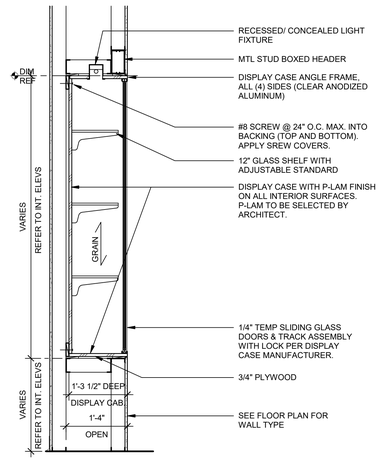


8 DISPLAY CASE TYPE "F"
Scale: 3/4" = 1'-0"

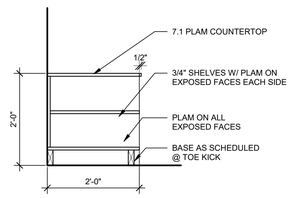


6 SHORT BOOKSHELF - TYPE 'L'
Scale: 3/4" = 1'-0"

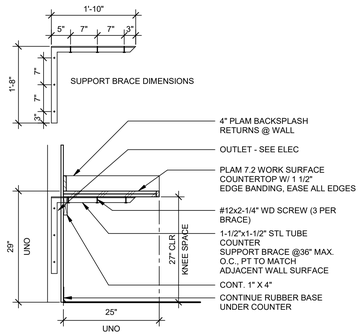


3 TECHNOLOGY COUNTER - TYPE 'E'
Scale: 3/4" = 1'-0"

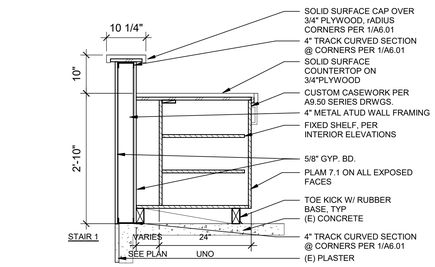


14 TYPICAL CABINET SECTION AT STAIR 1
Scale: 3/4" = 1'-0"

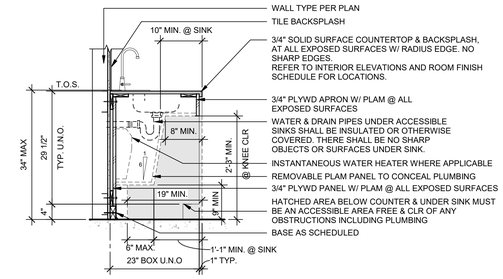


1 SINK CABINET - TYPE B
Scale: 3/4" = 1'-0"

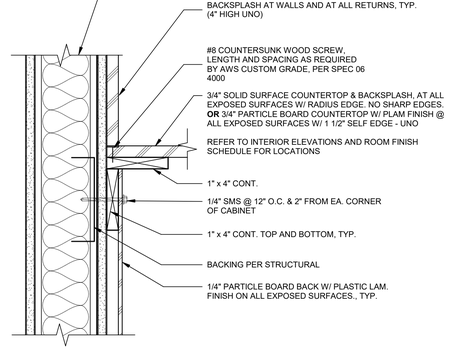


12 CABINET BASE TOP AT STUD WALL
Scale: 3" = 1'-0"

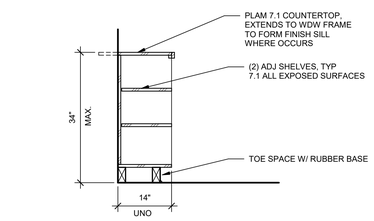


9 LOW LIBRARY SHELVING - TYPE 'N'
Scale: 3/4" = 1'-0"

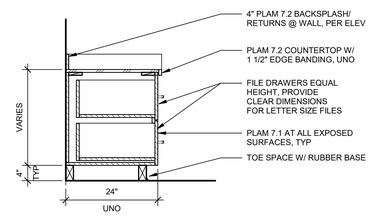


7 FILE CABINET SECTION - TYPE 'H'
Scale: 3/4" = 1'-0"

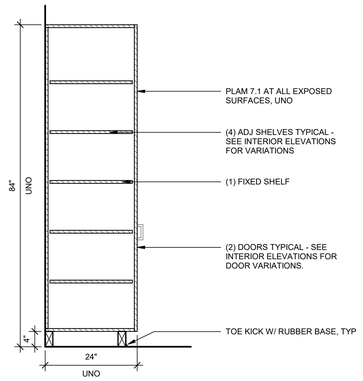


4 TALL STORAGE - TYPE 'D'
Scale: 3/4" = 1'-0"

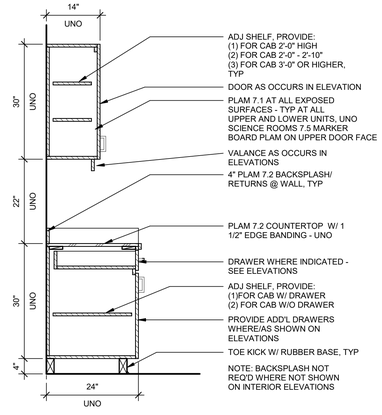


2 TYP CABINET SECTION - TYPE 'A'
Scale: 3/4" = 1'-0"

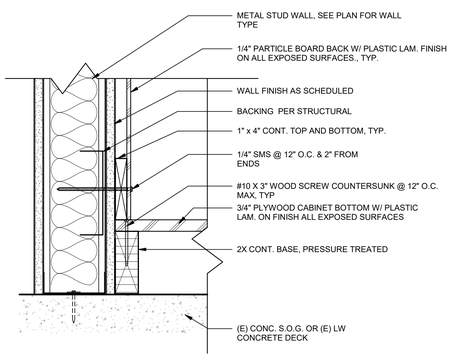

13 CABINET BASE AT STUD WALL
Scale: 3" = 1'-0"

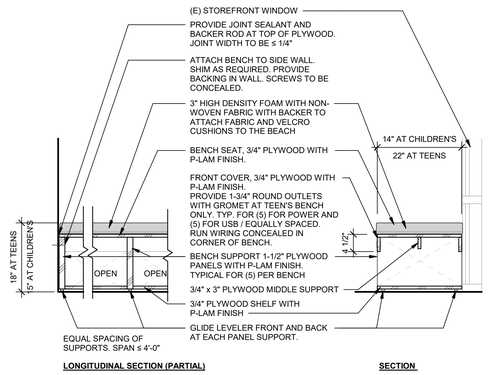

10 BUILT-IN BENCH AT WINDOW
Scale: 3/4" = 1'-0"

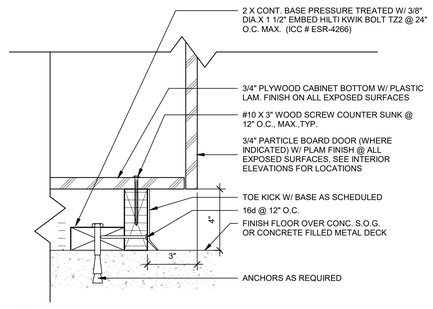

5 CABINET BASE
Scale: 3" = 1'-0"

NOTE FOR CASEWORK ANCHORAGE:
REFER TO DETAILS 5, 11, 12, AND 13 ON THIS SHEET FOR ANCHORAGE INFORMATION. TYPICAL FOR BASE AND WALL HUNG CABINETS.

REVISIONS

CONSTRUCTION DOCUMENTS

LICENSED ARCHITECT — STEVEN ORTEGA — No. C-34809 Exp. 8-31-25 — STATE OF CALIFORNIA

LOS ANGELES COUNTY PUBLIC WORKS
HUNTINGTON PARK LIBRARY
6518 MILES AVE
HUNTINGTON PARK, CA 90255

COUNTY OF LOS ANGELES PUBLIC WORKS CALIFORNIA

LA COUNTY LIBRARY


NAC

NAC NO	161-23025
DRAWN	Author
CHECKED	Checker
DATE	11/01/2024


CASEWORK - TYPICAL DETAILS

A9.42


© 2023 NAC Inc

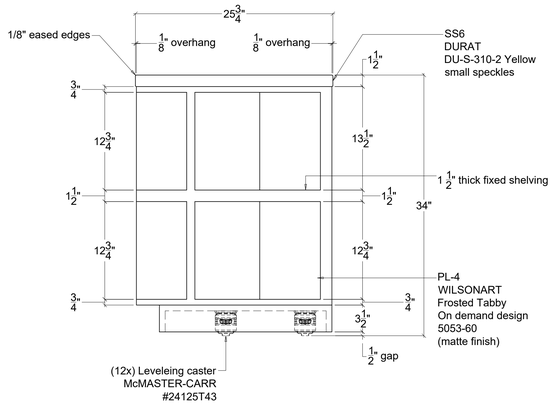


3 WAITING 100B LOW SHELVING - ELEVATION
Scale: 1 1/2" = 1'

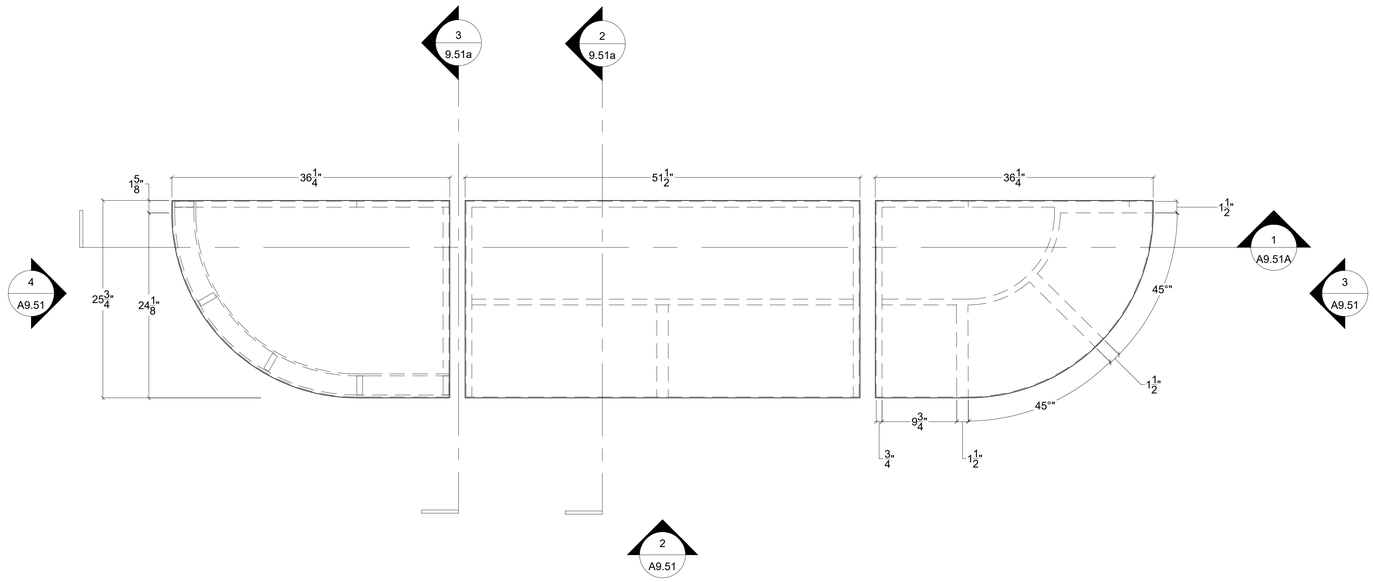

1 WAITING 100B LOW SHELVING - PLAN
Scale: 1 1/2" = 1'

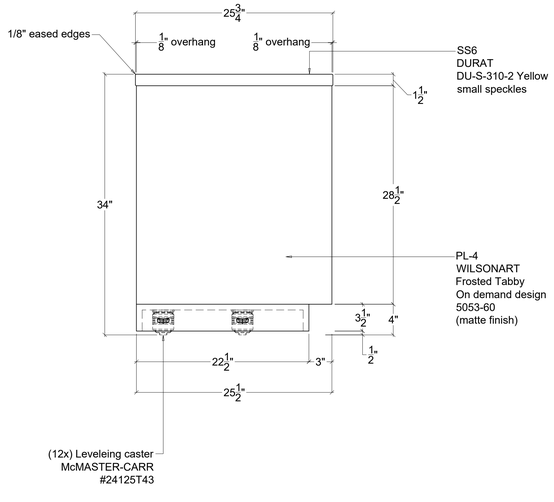

4 WAITING 100B LOW SHELVING - SECTION
Scale: 1 1/2" = 1'

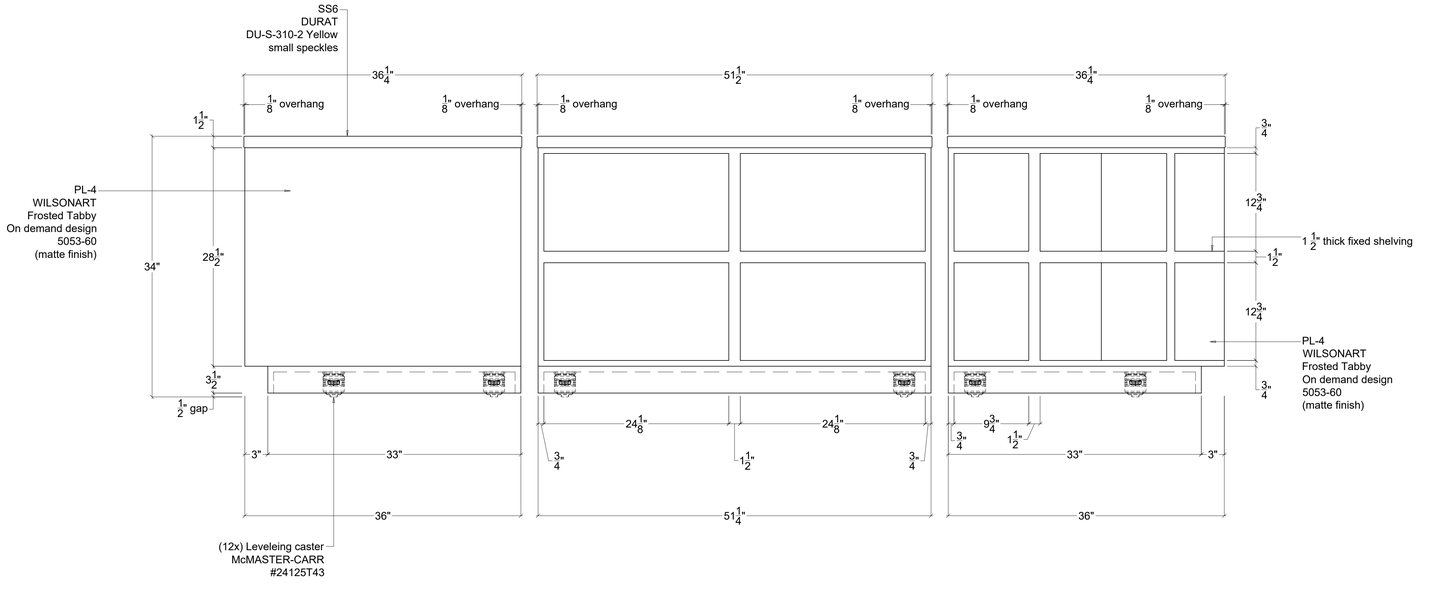

2 WAITING 100B LOW SHELVING - ELEVATION
Scale: 1 1/2" = 1'

REVISIONS

CONSTRUCTION DOCUMENTS

LOS ANGELES COUNTY PUBLIC WORKS
HUNTINGTON PARK LIBRARY
6518 MILES AVE
HUNTINGTON PARK, CA 90255

COUNTY OF LOS ANGELES CALIFORNIA

LA COUNTY LIBRARY

NAC


NAC NO	161-23025
DRAWN	Author
CHECKED	Checker
DATE	07/24/2025

CASEWORK - LEVEL 1


WAITING 100B LOW SHELVING

A9.51


©2023 NAC Inc.

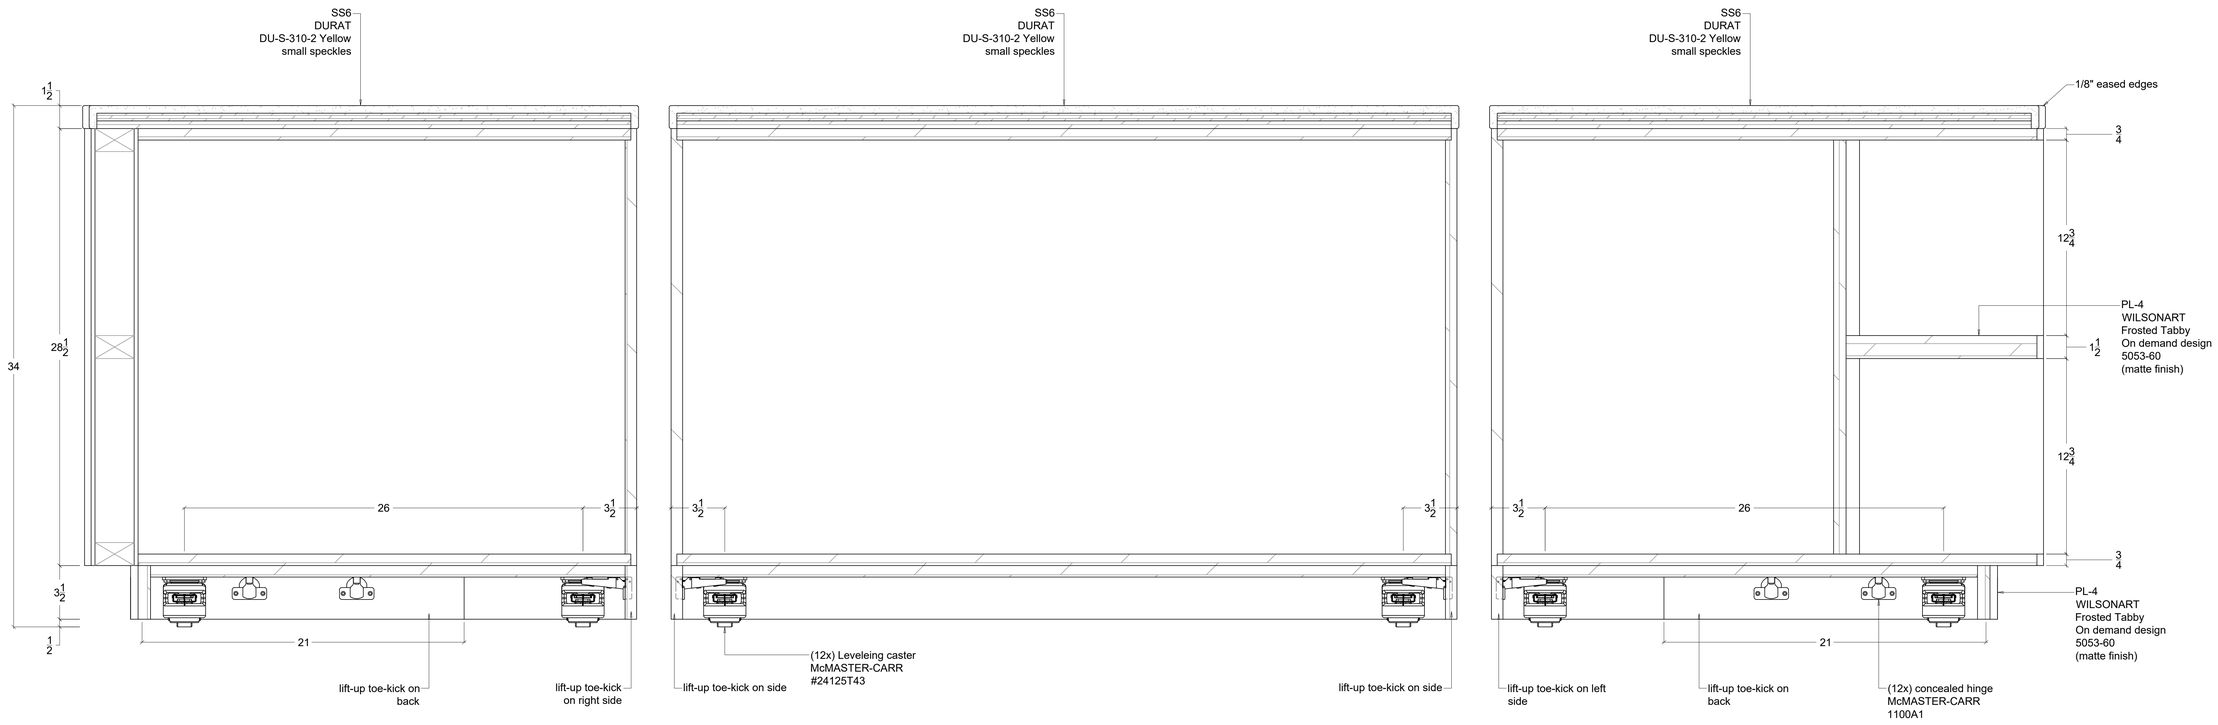

1 WAITING 100B LOW SHELVING - SECTION
Scale: 3" = 1'

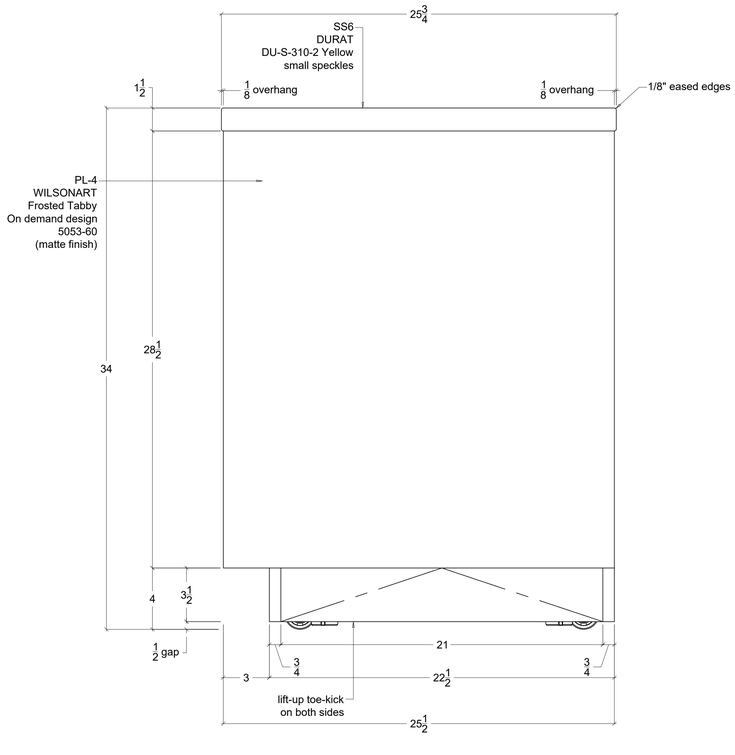

3 WAITING 100B LOW SHELVING - SECTION
Scale: 3" = 1'

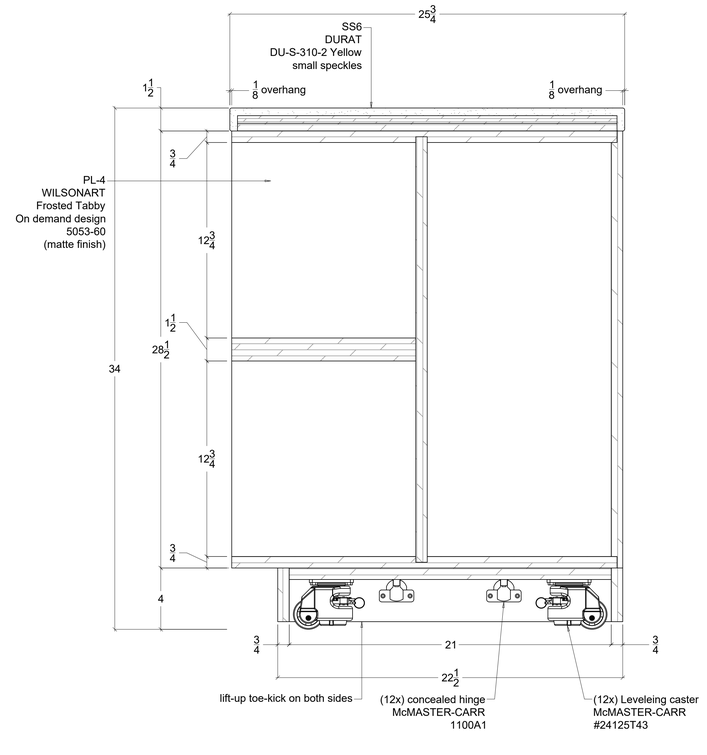

2 WAITING 100B LOW SHELVING - SECTION
Scale: 3" = 1'

REVISIONS

CONSTRUCTION DOCUMENTS

LOS ANGELES COUNTY PUBLIC WORKS
HUNTINGTON PARK LIBRARY
6518 MILES AVE
HUNTINGTON PARK, CA 90255


NAC NO 161-23025
DRAWN Author
CHECKED Checker
DATE 07/24/2025

CASEWORK - LEVEL 1


WAITING 100B LOW SHELVING

A9.51a

©2023 NAC Inc.

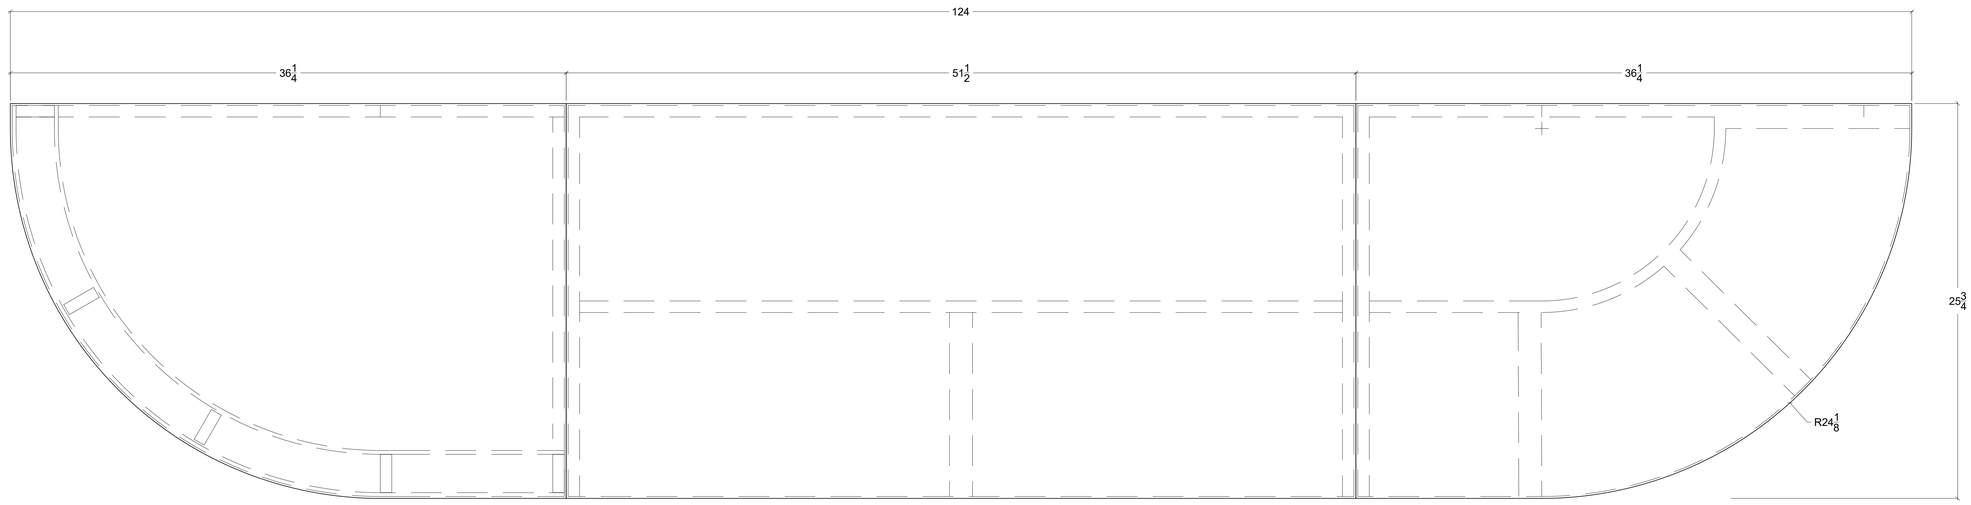

1 WAITING 100B LOW SHELVING - PLAN (layout)
Scale: 3" = 1'

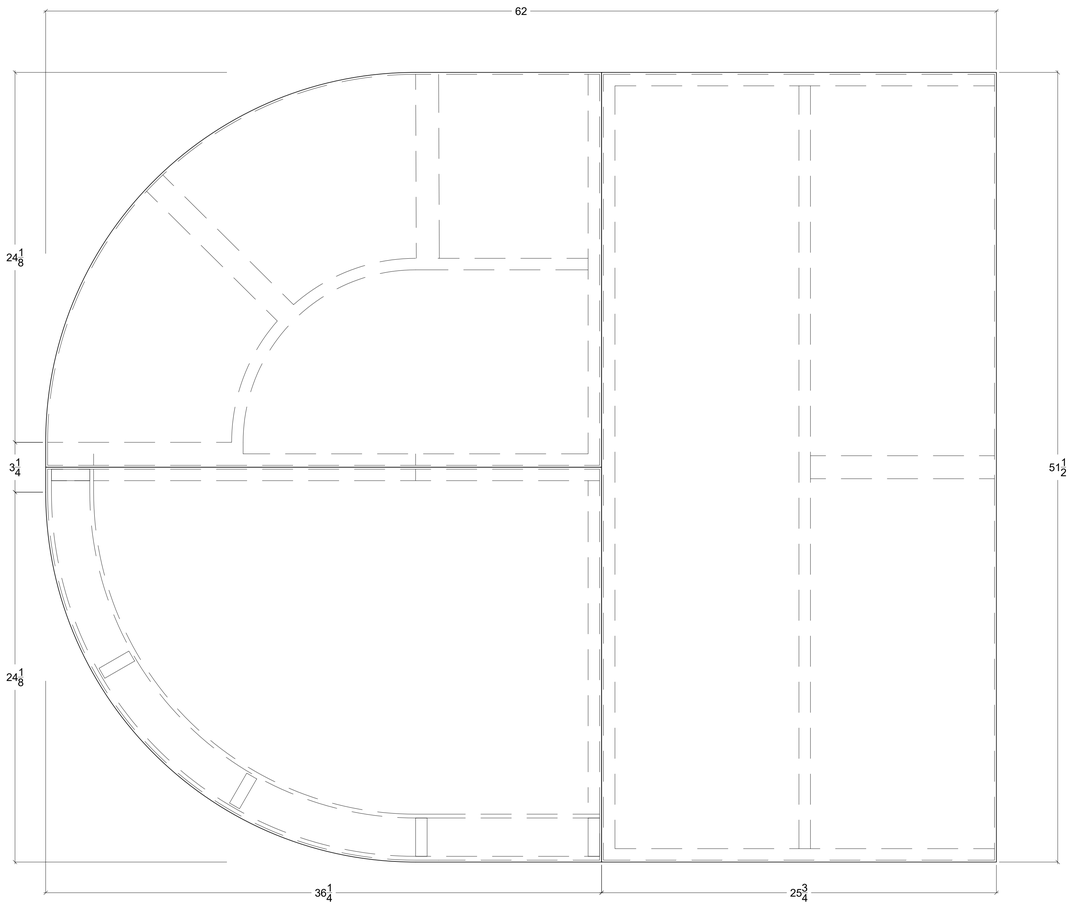

2 WAITING 100B LOW SHELVING - PLAN (alternative layout)
Scale: 3" = 1'

REVISIONS

CONSTRUCTION DOCUMENTS

LOS ANGELES COUNTY PUBLIC WORKS

HUNTINGTON PARK LIBRARY

6518 MILES AVE
HUNTINGTON PARK, CA 90255

COUNTY OF LOS ANGELES CALIFORNIA

LA COUNTY LIBRARY

NAC


NAC NO	161-23025
DRAWN	Author
CHECKED	Checker
DATE	07/24/2025

CASEWORK - LEVEL 1


WAITING 100B LOW SHELVING

A9.51b

© 2023 NAC, Inc.

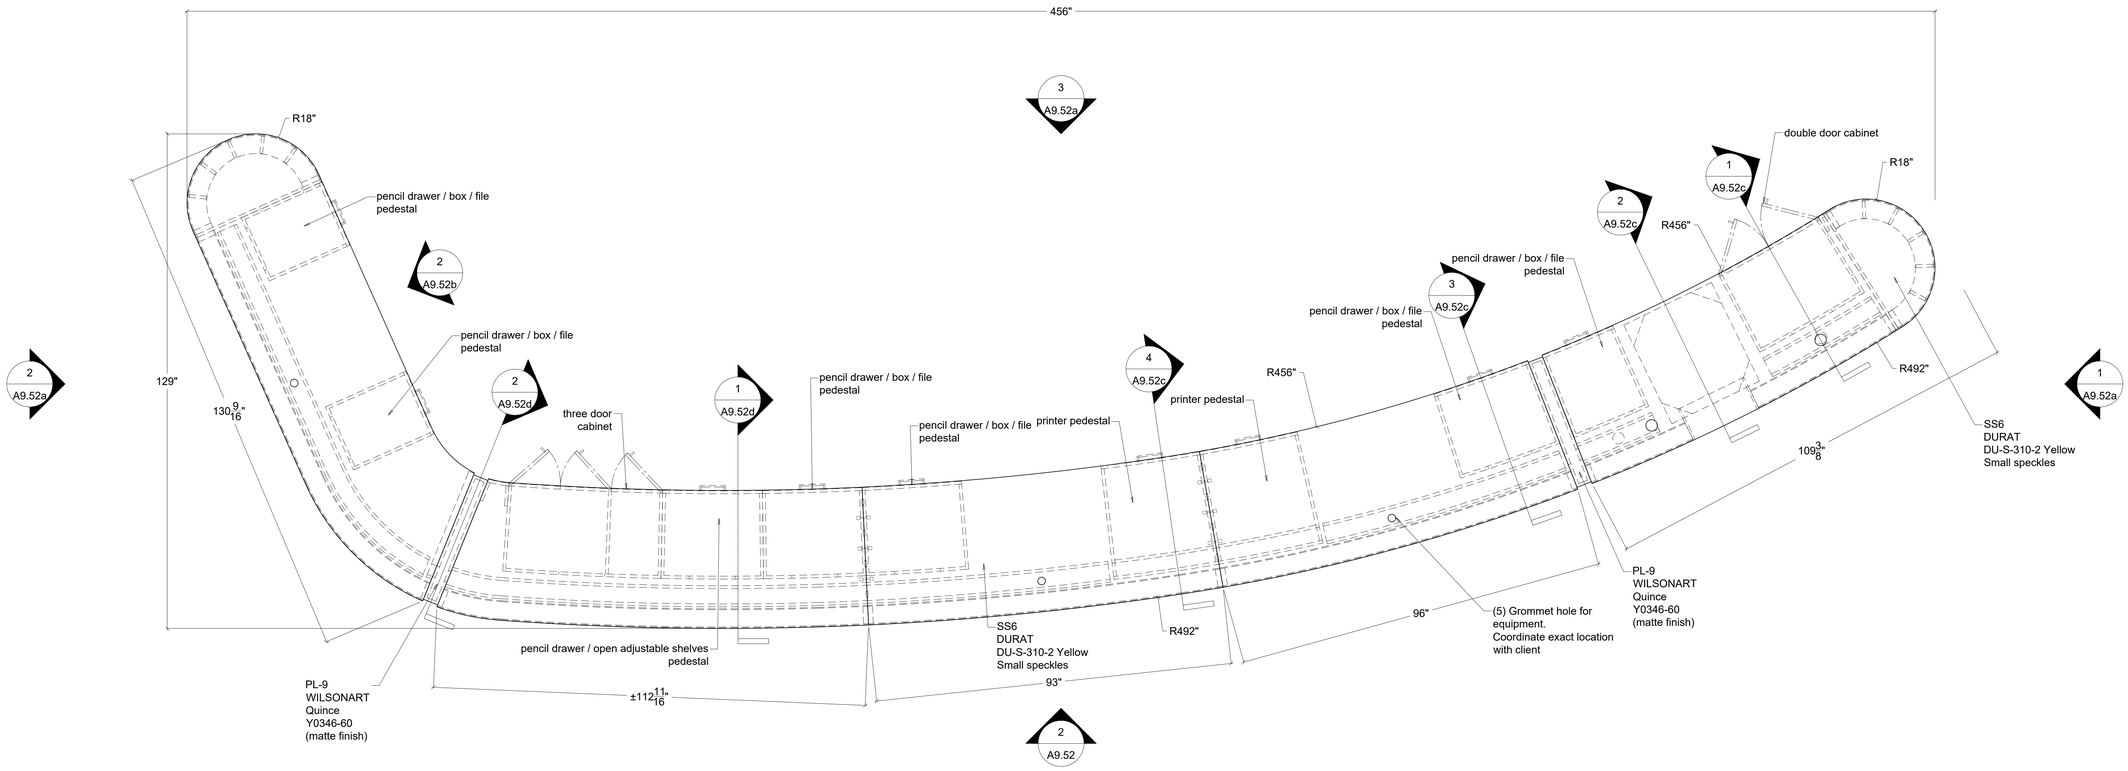

1 CIRCULATION DESK 100A - PLAN
Scale: 3/4" = 1'

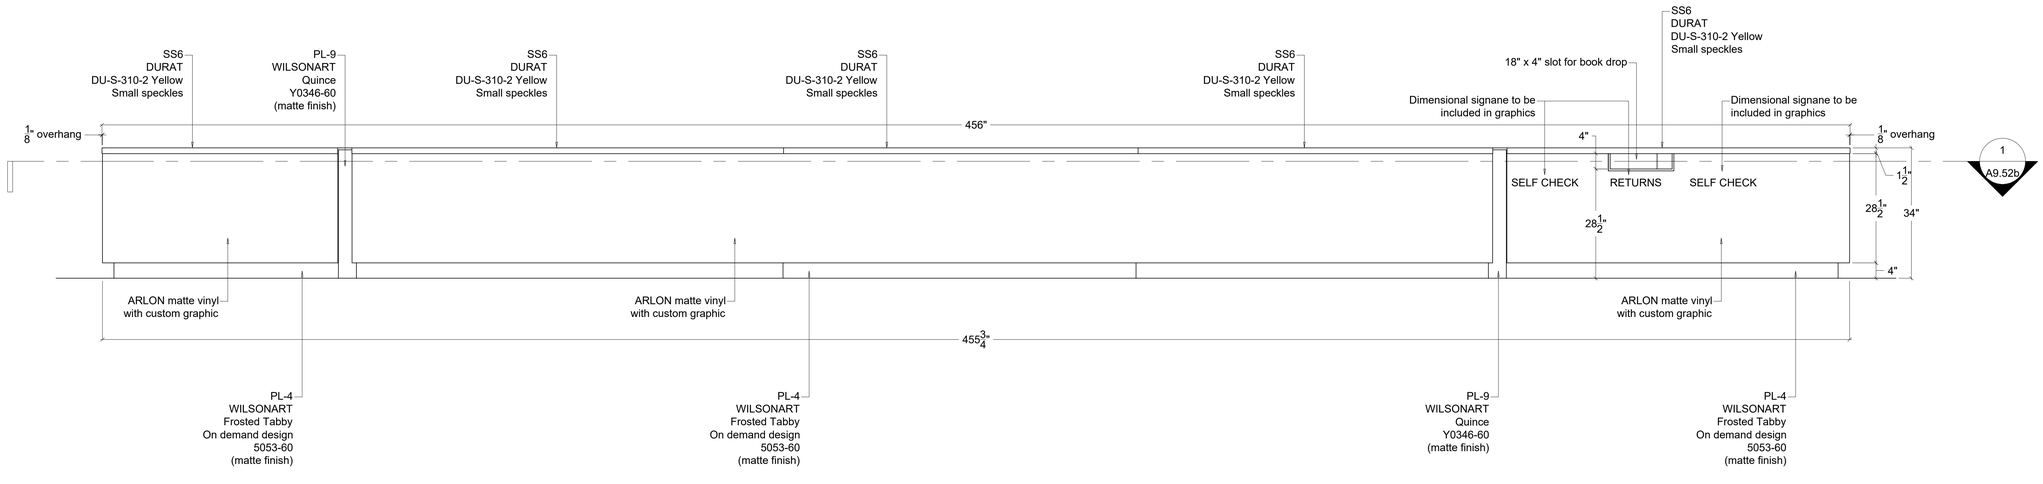

2 CIRCULATION DESK 100A - ELEVATION
Scale: 3/4" = 1'

REVISIONS

CONSTRUCTION DOCUMENTS

LOS ANGELES COUNTY PUBLIC WORKS
HUNTINGTON PARK LIBRARY
6518 MILES AVE
HUNTINGTON PARK, CA 90255

COUNTY OF LOS ANGELES CALIFORNIA

LA COUNTY LIBRARY

NAC


NAC NO	161-23025
DRAWN	Author
CHECKED	Checker
DATE	07/28/2025

CASEWORK - LEVEL 1


CIRCULATION DESK 100A

A9.52


© 2023 NAC Arc

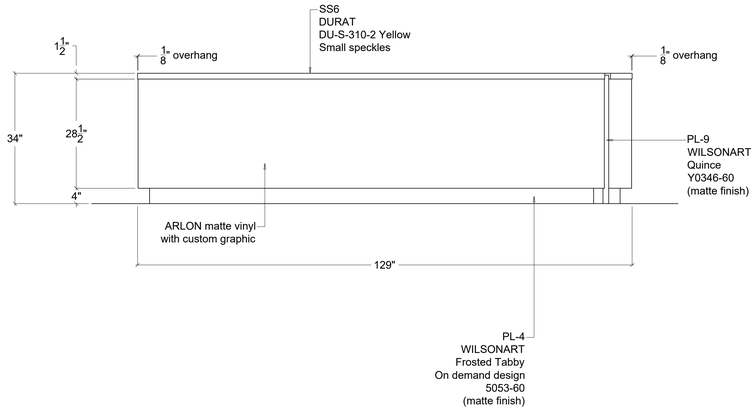

2 CIRCULATION DESK 100A - ELEVATION
Scale: 3/4" = 1'

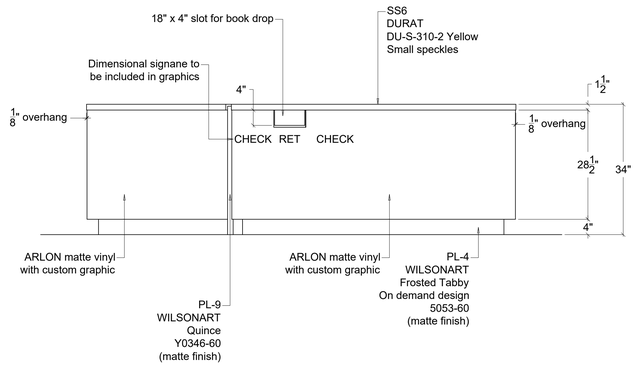

1 CIRCULATION DESK 100A - ELEVATION
Scale: 3/4" = 1'

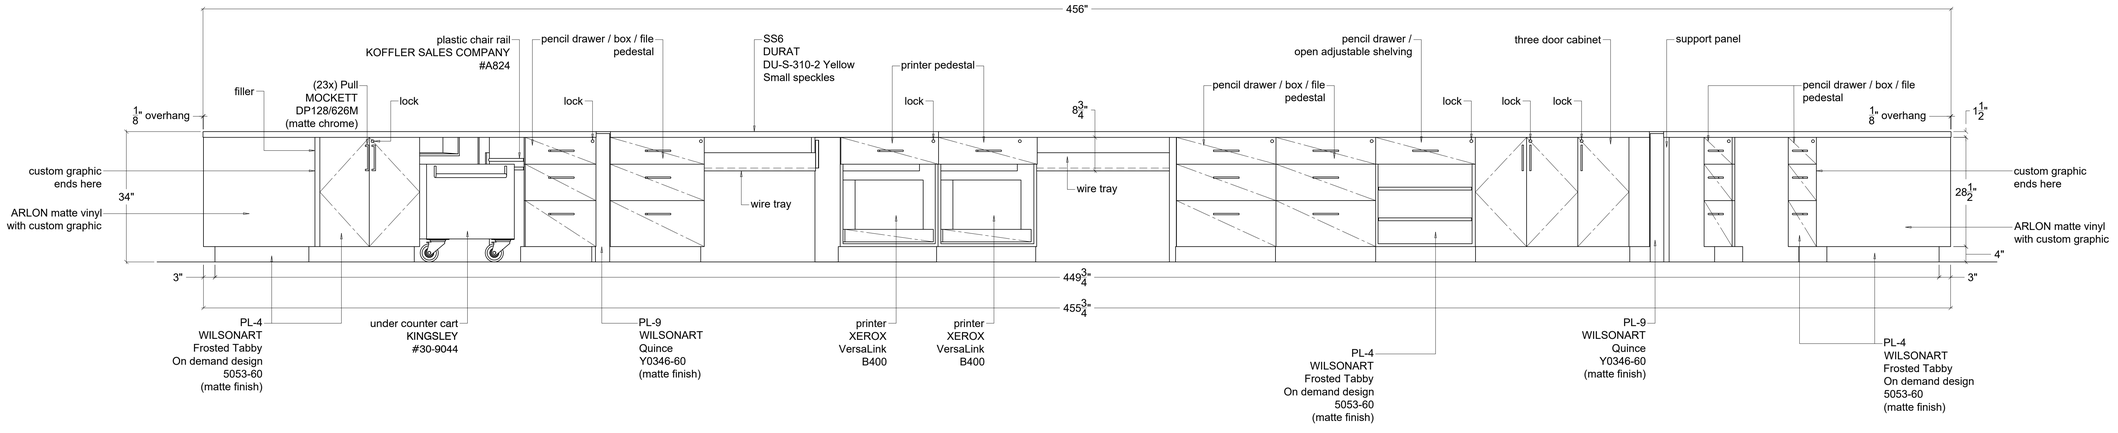

3 CIRCULATION DESK 100A - ELEVATION
Scale: 3/4" = 1'

REVISIONS

CONSTRUCTION DOCUMENTS

LOS ANGELES COUNTY PUBLIC WORKS
HUNTINGTON PARK LIBRARY
6518 MILES AVE
HUNTINGTON PARK, CA 90255

NAC


NAC NO	161-23025
DRAWN	Author
CHECKED	Checker
DATE	07/28/2025

CASEWORK - LEVEL 1


CIRCULATION DESK 100A

A9.52a


©2023 NAC Arc

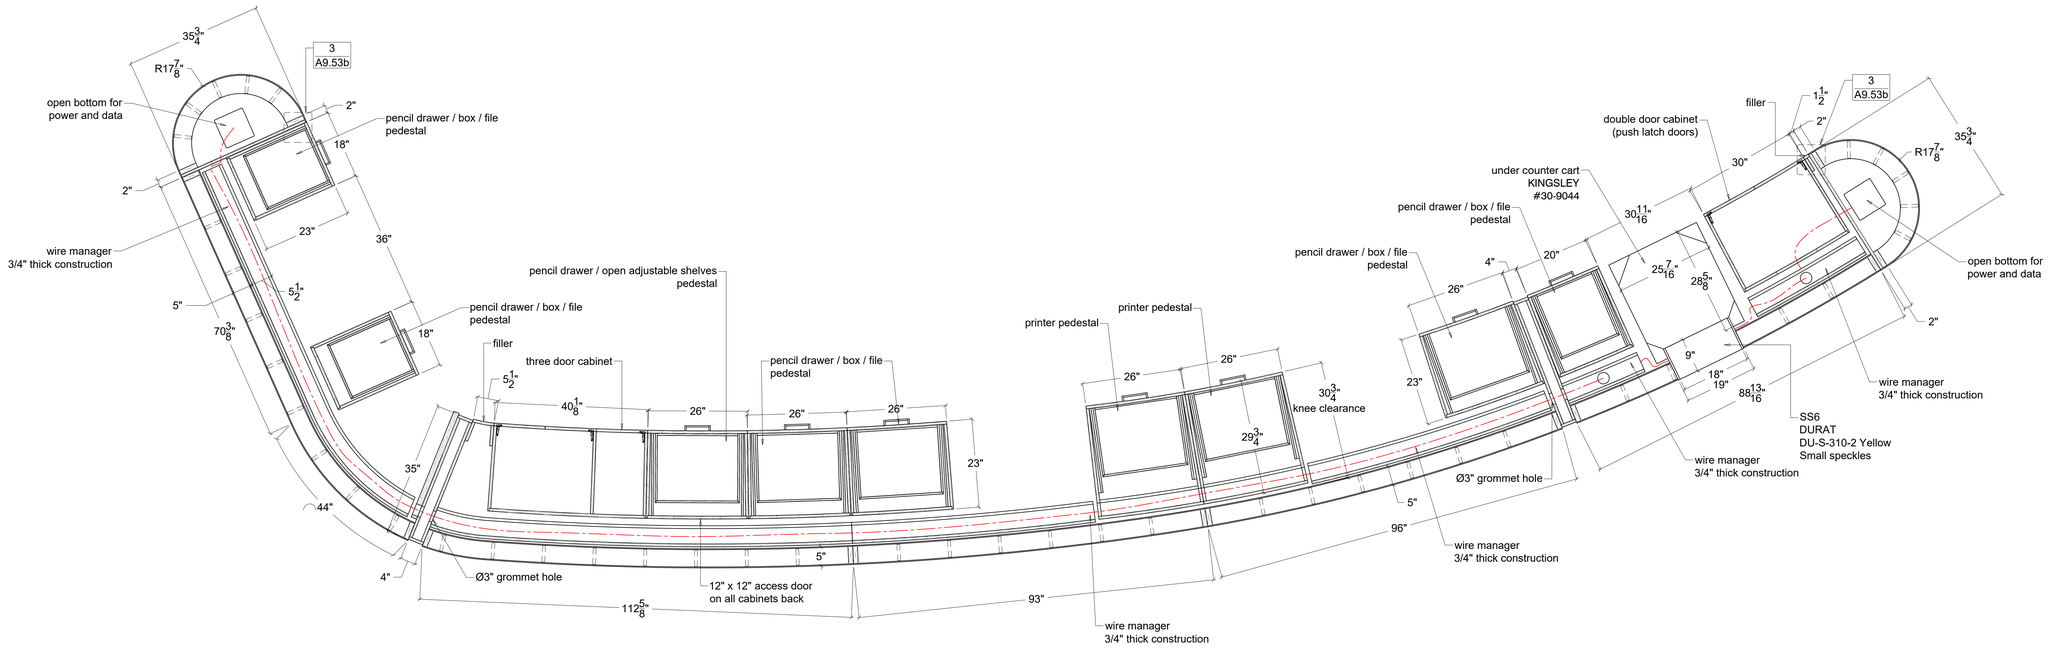

1 CIRCULATION DESK 100A - SECTION
Scale: 3/4" = 1'

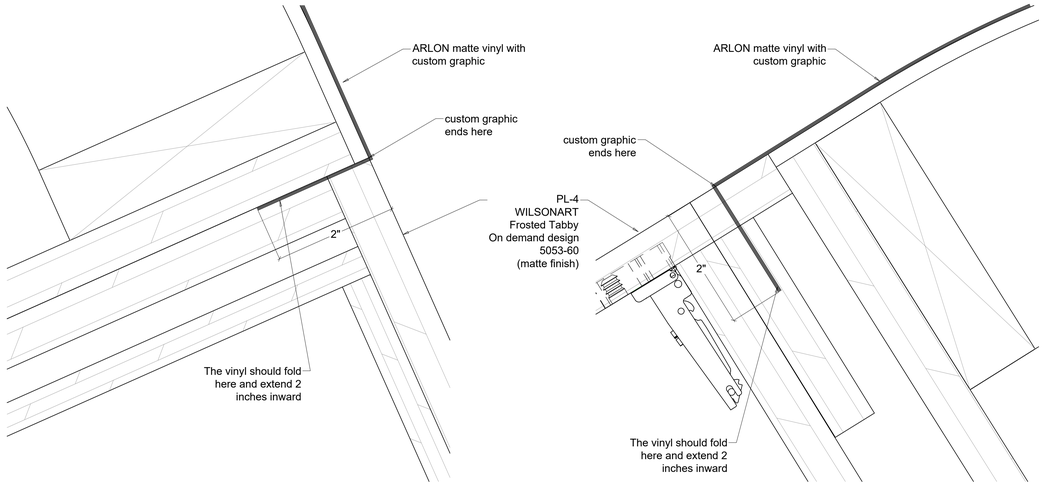

3 CIRCULATION DESK 100A - DETAILS
Scale: 1' = 1'

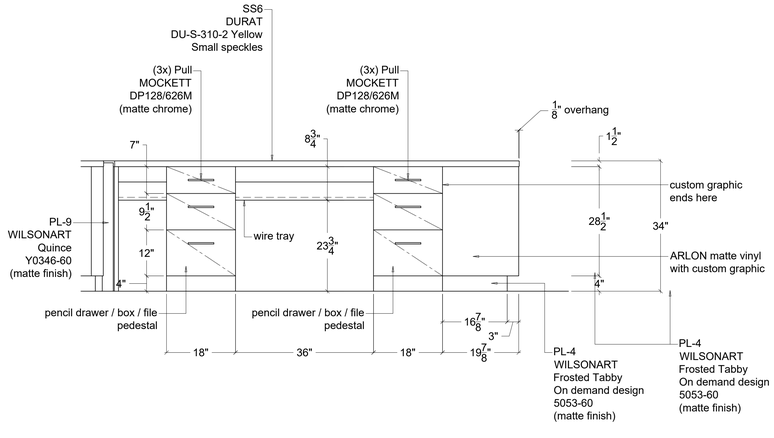

2 CIRCULATION DESK 100A - ELEVATION
Scale: 3/4" = 1'

REVISIONS

CONSTRUCTION DOCUMENTS

LOS ANGELES COUNTY PUBLIC WORKS
HUNTINGTON PARK LIBRARY
6518 MILES AVE
HUNTINGTON PARK, CA 90255


NAC NO	161-23025
DRAWN	Author
CHECKED	Checker
DATE	07/28/2025

CASEWORK - LEVEL 1


CIRCULATION DESK 100A

A9.52b


©2023 NAC Inc

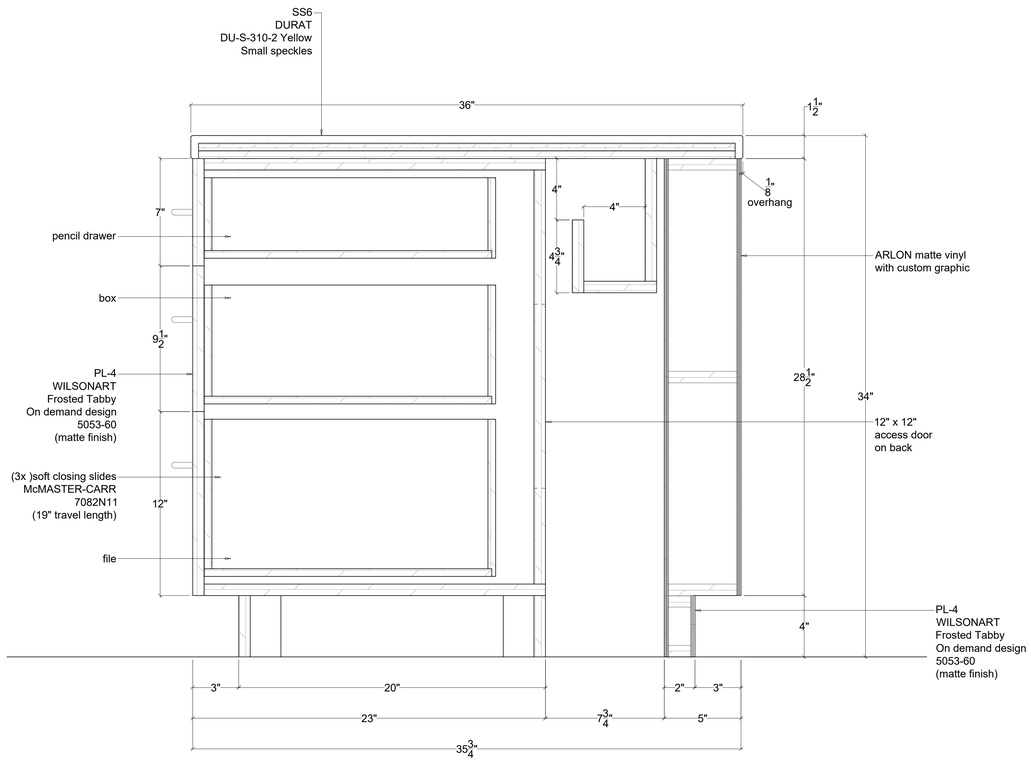


3 CIRCULATION DESK 100A - SECTION
Scale: 3" = 1'

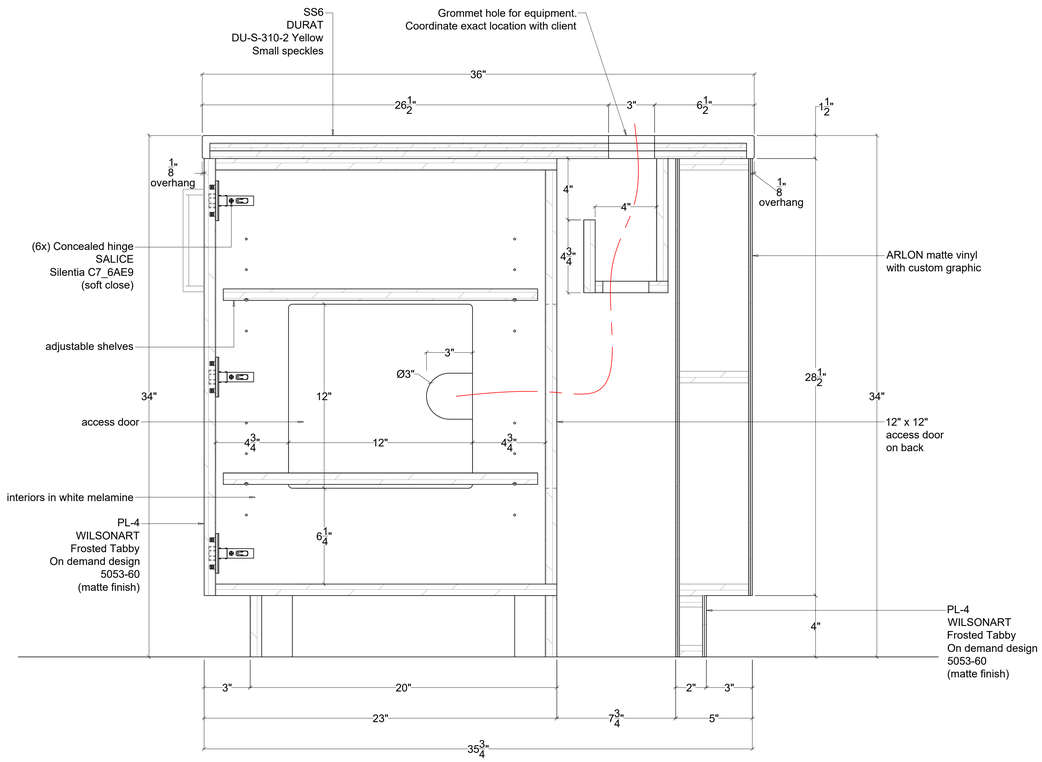

1 CIRCULATION DESK 100A - SECTION
Scale: 3" = 1'

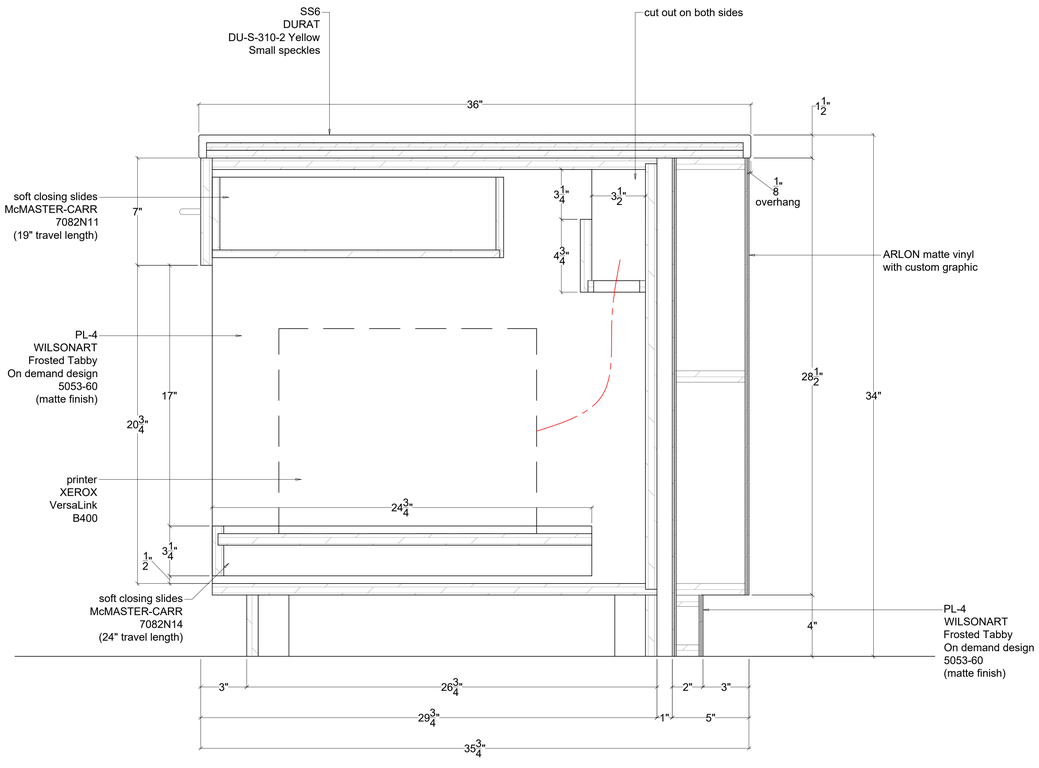

4 CIRCULATION DESK 100A - SECTION
Scale: 3" = 1'

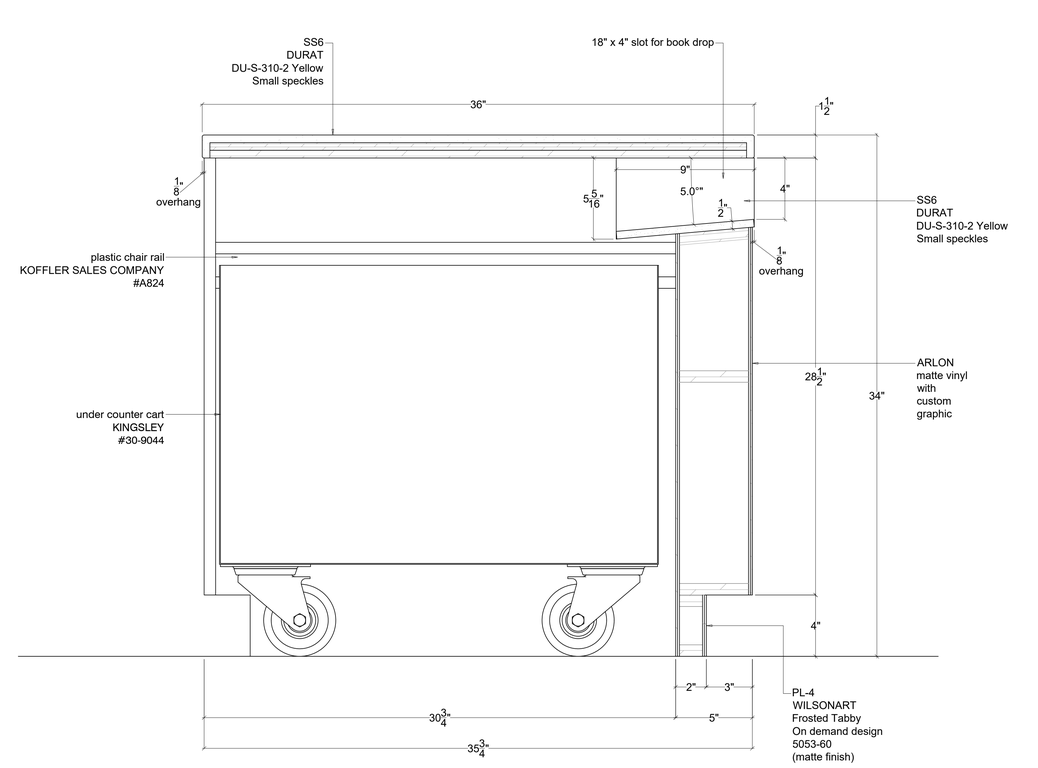

2 CIRCULATION DESK 100A - SECTION
Scale: 3" = 1'

REVISIONS

CONSTRUCTION DOCUMENTS

LOS ANGELES COUNTY PUBLIC WORKS

HUNTINGTON PARK LIBRARY

6518 MILES AVE
HUNTINGTON PARK, CA 90255


NAC NO	161-23025
DRAWN	Author
CHECKED	Checker
DATE	07/28/2025

CASEWORK - LEVEL 1


CIRCULATION DESK 100A

A9.52c


©2023 NAC Inc.

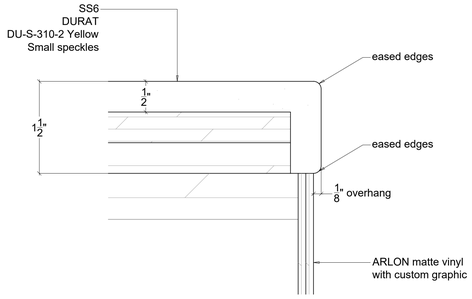

3 CIRCULATION DESK 100A - DETAIL
Scale: 1" = 1'

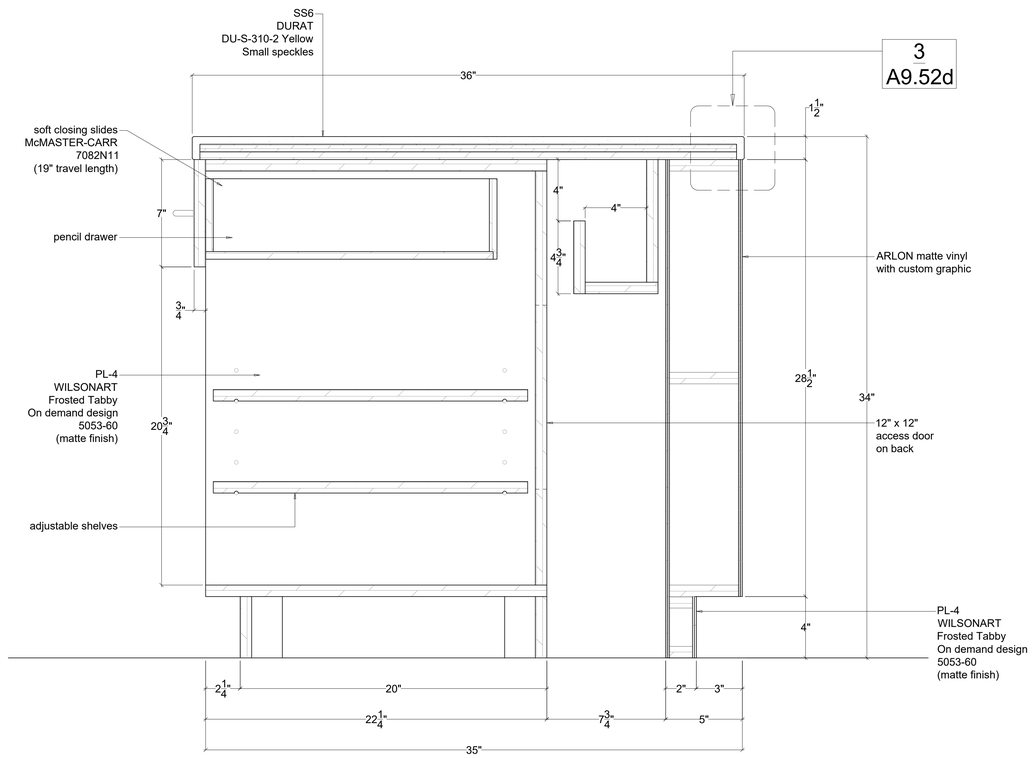

1 CIRCULATION DESK 100A - SECTION
Scale: 3" = 1'

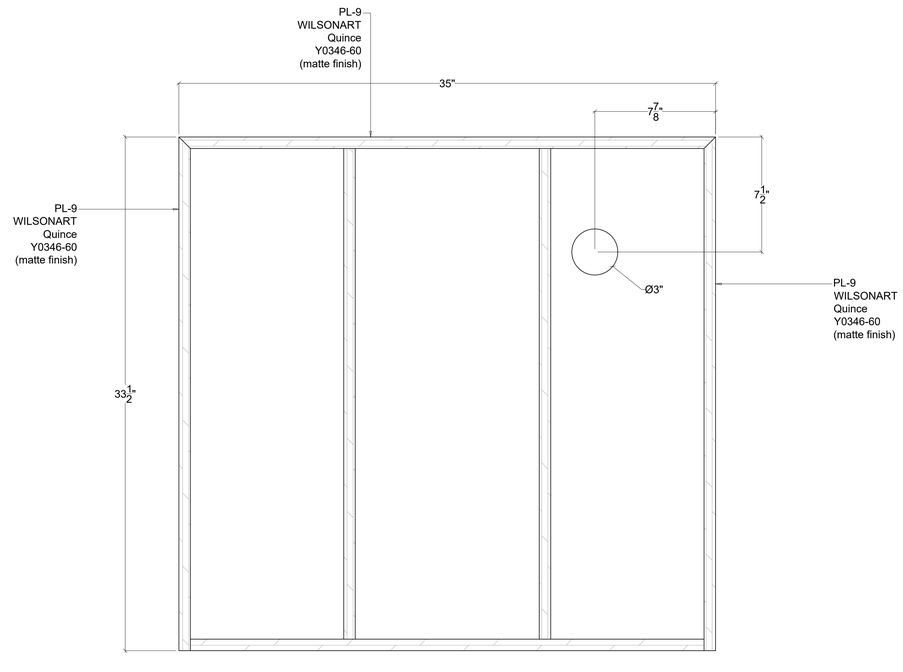

2 CIRCULATION DESK 100A - SECTION
Scale: 3" = 1'

REVISIONS

CONSTRUCTION DOCUMENTS

LOS ANGELES COUNTY PUBLIC WORKS

HUNTINGTON PARK LIBRARY

6518 MILES AVE
HUNTINGTON PARK, CA 90255

COUNTY OF LOS ANGELES CALIFORNIA

LA COUNTY LIBRARY

NAC


NAC NO	161-23025
DRAWN	Author
CHECKED	Checker
DATE	07/28/2025

CASEWORK - LEVEL 1


CIRCULATION DESK 100A

A9.52d

© 2023 NAC Arc

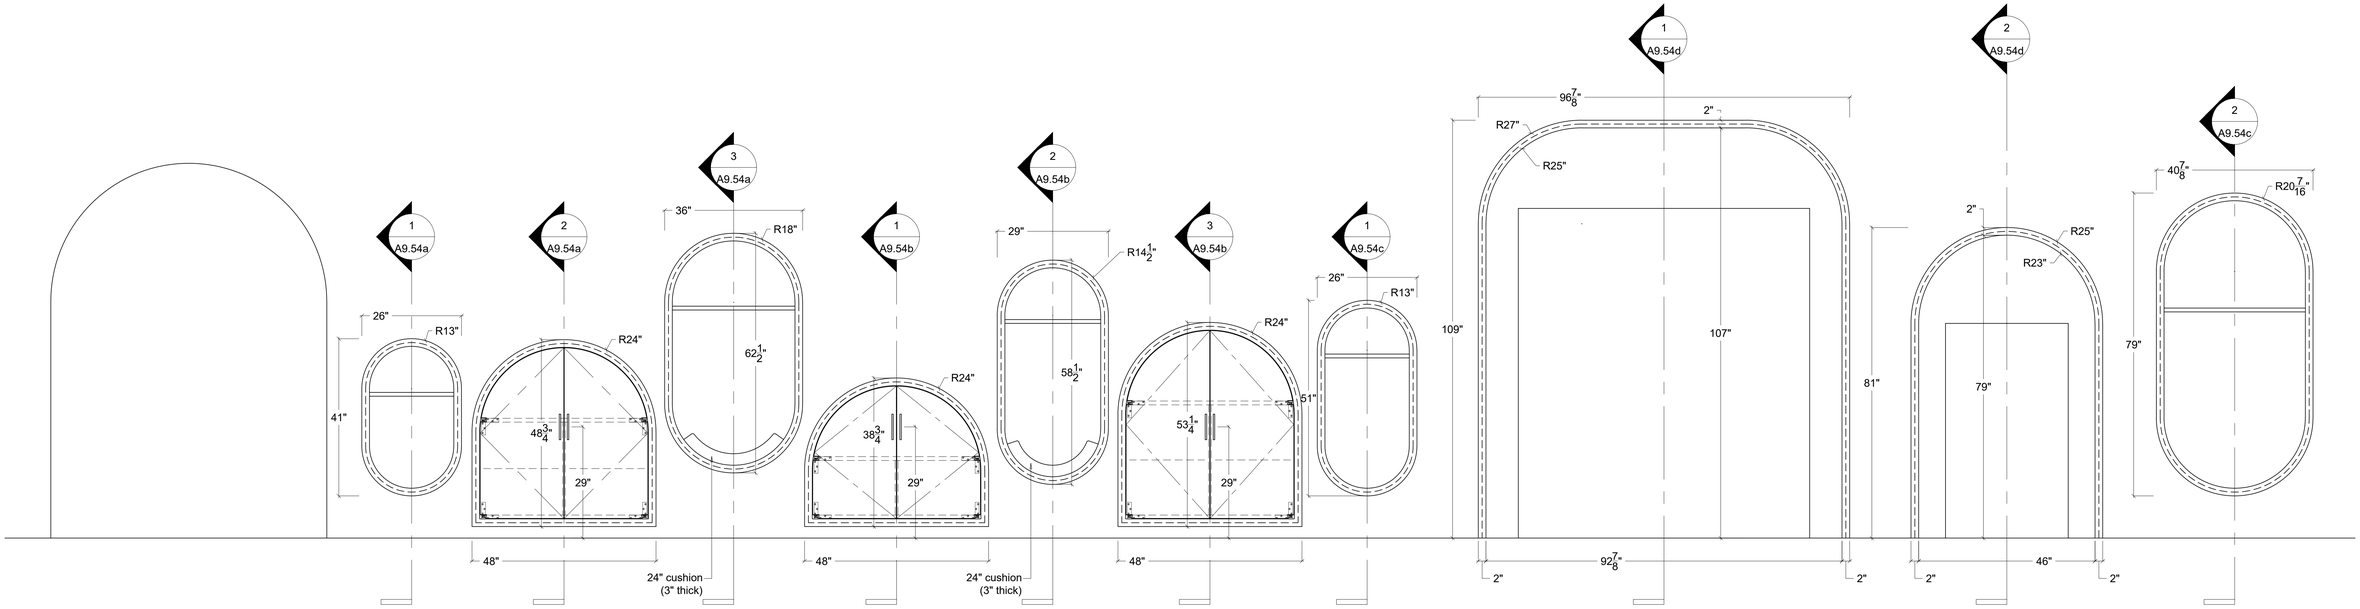

1 PLAY 102B DISCOVERY WALL - ELEVATION
Scale: 3/4" = 1'

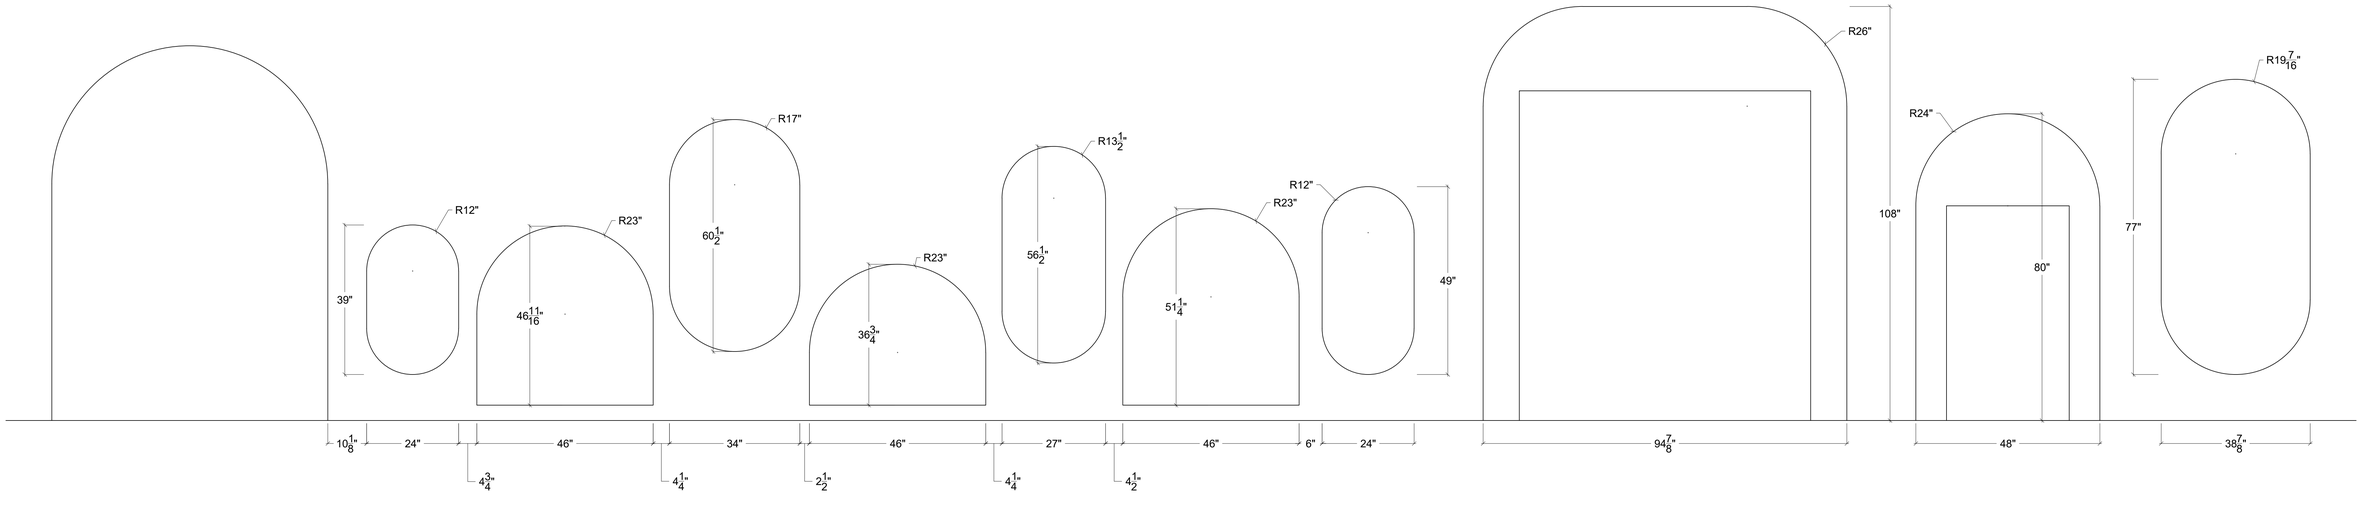

2 PLAY 102B DISCOVERY WALL - ELEVATION (without cabinets)
Scale: 3/4" = 1'

REVISIONS

CONSTRUCTION DOCUMENTS

LOS ANGELES COUNTY PUBLIC WORKS

HUNTINGTON PARK LIBRARY

6518 MILES AVE
HUNTINGTON PARK, CA 90255

COUNTY OF LOS ANGELES CALIFORNIA

LA COUNTY LIBRARY

NAC


NAC NO	161-23025
DRAWN	Author
CHECKED	Checker
DATE	07/23/2025

CASEWORK - LEVEL 1


PLAY 102B DISCOVERY WALL

A9.54


© 2023 NAC Inc.

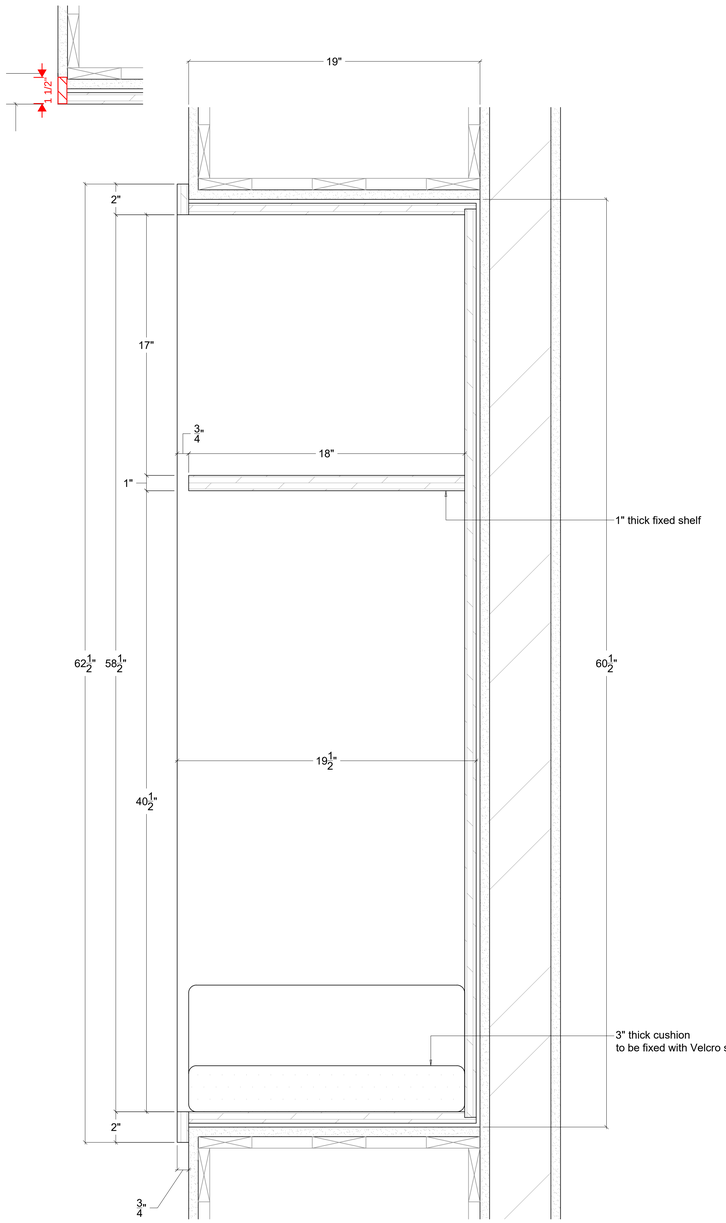

3 PLAY 102B DISCOVERY WALL - SECTION
Scale: 3" = 1'

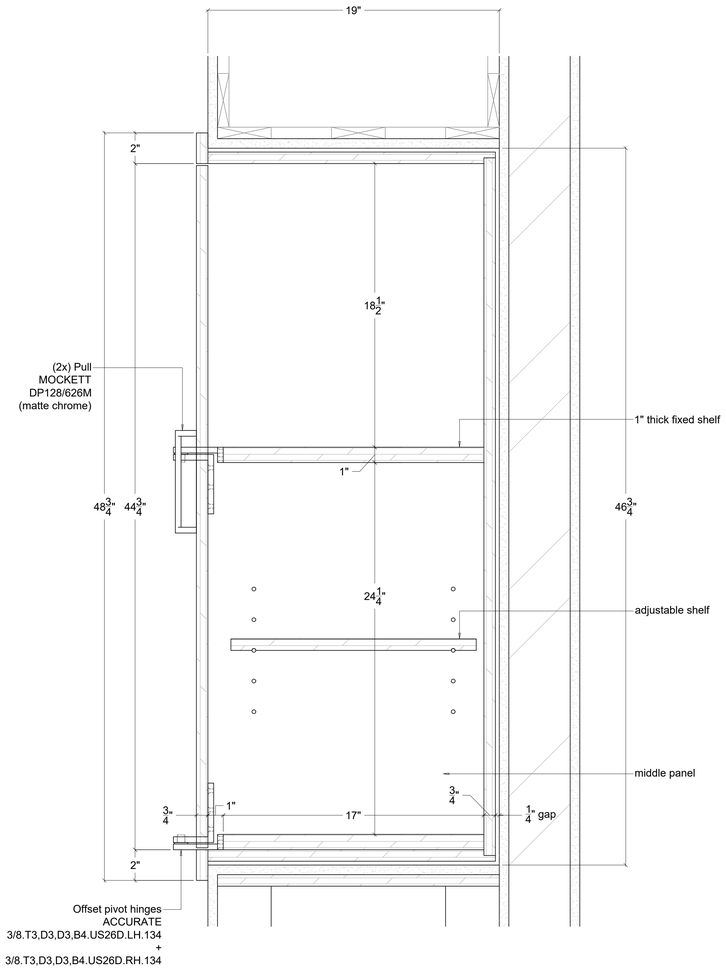

2 PLAY 102B DISCOVERY WALL - SECTION
Scale: 3" = 1'

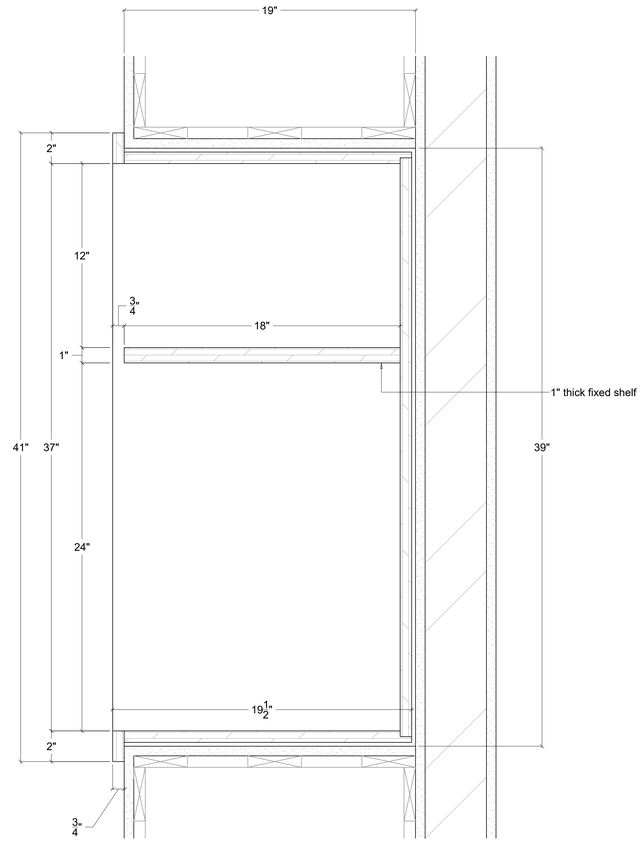

1 PLAY 102B DISCOVERY WALL - SECTION
Scale: 3" = 1'

REVISIONS

CONSTRUCTION DOCUMENTS

LOS ANGELES COUNTY PUBLIC WORKS

HUNTINGTON PARK LIBRARY

6518 MILES AVE
HUNTINGTON PARK, CA 90255

COUNTY OF LOS ANGELES CALIFORNIA

LA COUNTY LIBRARY

NAC


NAC NO	161-23025
DRAWN	Author
CHECKED	Checker
DATE	07/23/2025


CASEWORK - LEVEL 1


PLAY 102B DISCOVERY WALL

A9.54a

© 2023 NAC, Inc.

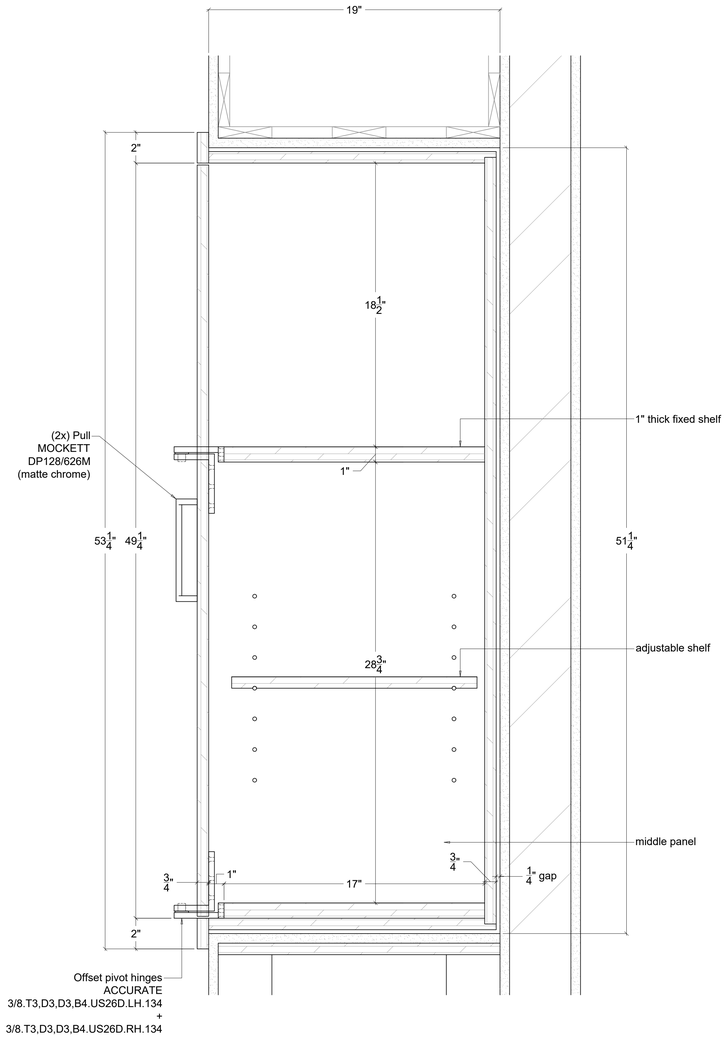

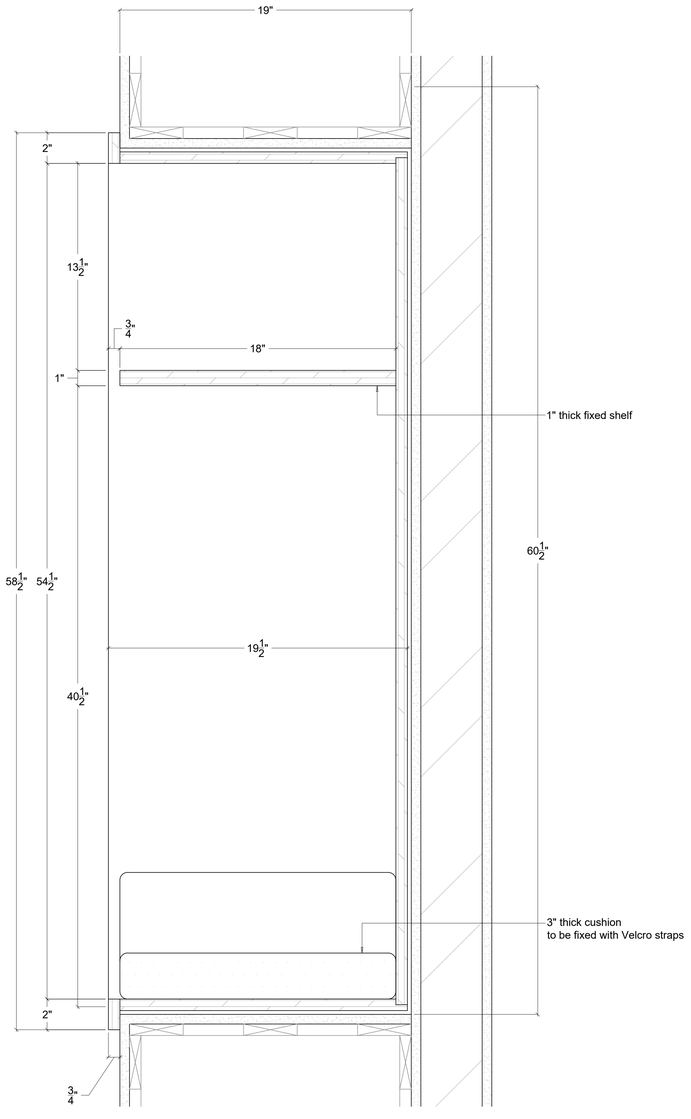

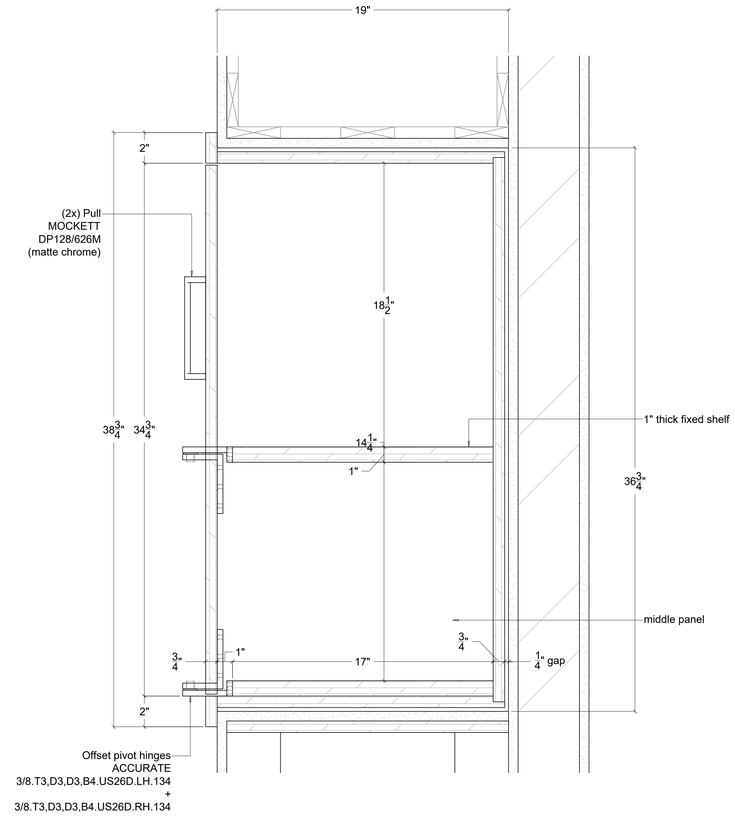

3 PLAY 102B DISCOVERY WALL - SECTION
Scale: 3" = 1'

2 PLAY 102B DISCOVERY WALL - SECTION
Scale: 3" = 1'

1 PLAY 102B DISCOVERY WALL - SECTION
Scale: 3" = 1'

REVISIONS

CONSTRUCTION DOCUMENTS

LOS ANGELES COUNTY PUBLIC WORKS

HUNTINGTON PARK LIBRARY

6518 MILES AVE
HUNTINGTON PARK, CA 90255

LA COUNTY LIBRARY

NAC


NAC NO	161-23025
DRAWN	Author
CHECKED	Checker
DATE	07/23/2025

CASEWORK - LEVEL 1


PLAY 102B DISCOVERY WALL

A9.54b

© 2023 NAC Arc

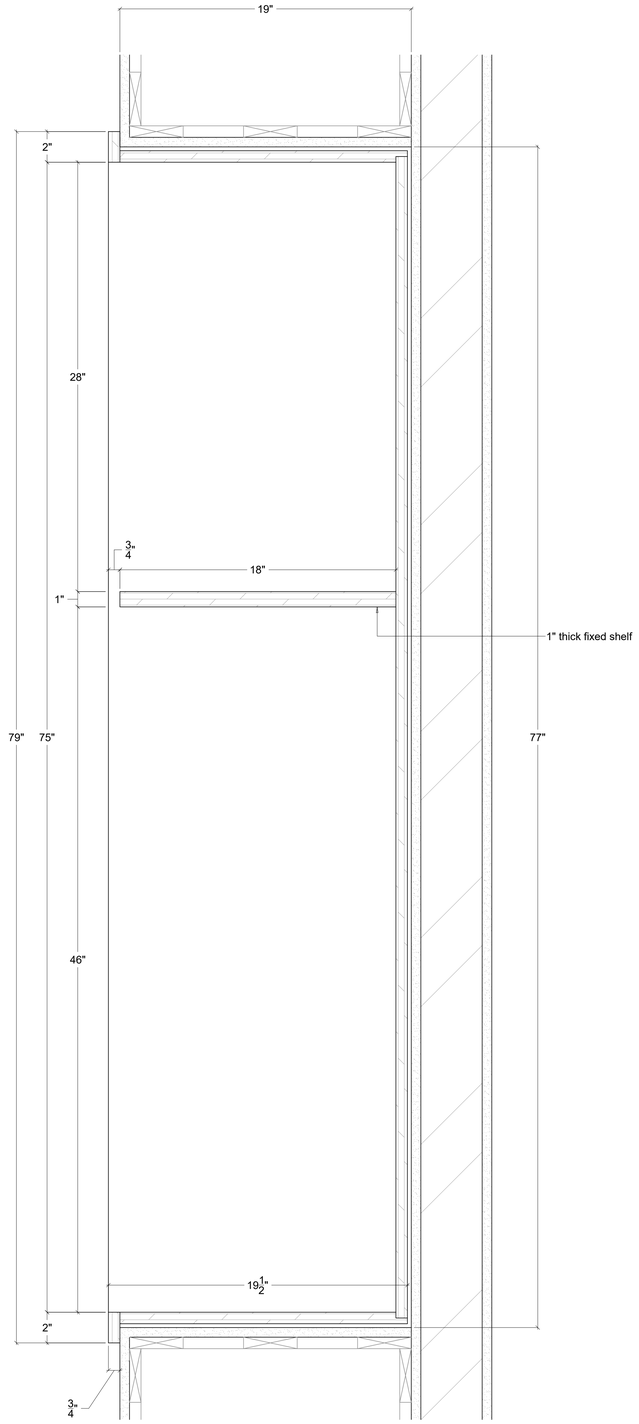

2 PLAY 102B DISCOVERY WALL - SECTION
Scale: 3" = 1'

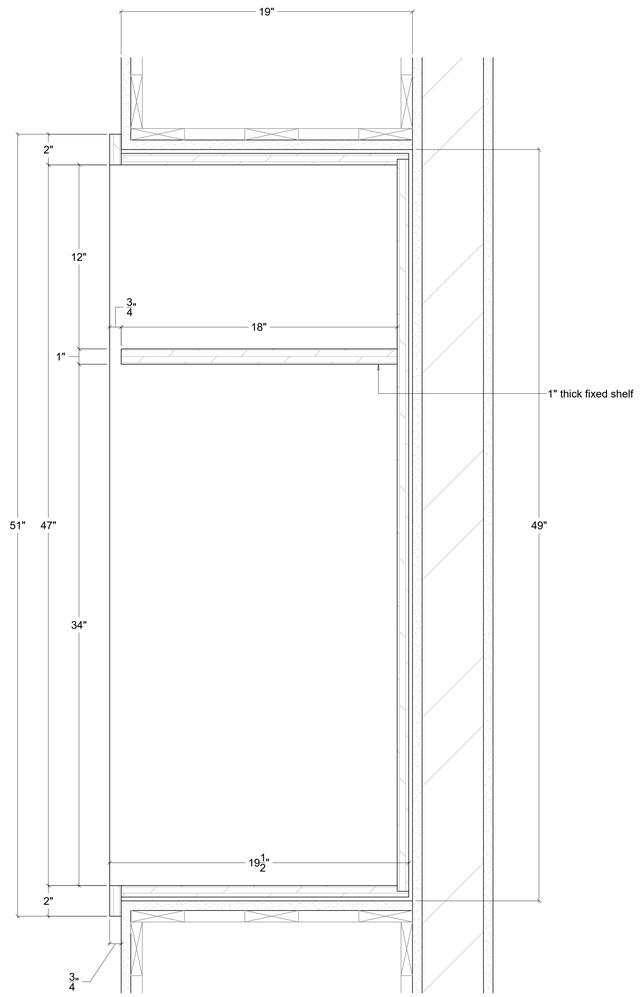

1 PLAY 102B DISCOVERY WALL - SECTION
Scale: 3" = 1'

REVISIONS

CONSTRUCTION DOCUMENTS

LOS ANGELES COUNTY PUBLIC WORKS

HUNTINGTON PARK LIBRARY

6518 MILES AVE
HUNTINGTON PARK, CA 90255

LA COUNTY LIBRARY

NAC


NAC NO	161-23025
DRAWN	Author
CHECKED	Checker
DATE	07/23/2025

CASEWORK - LEVEL 1


PLAY 102B DISCOVERY WALL

A9.54c

© 2025 NAC Inc

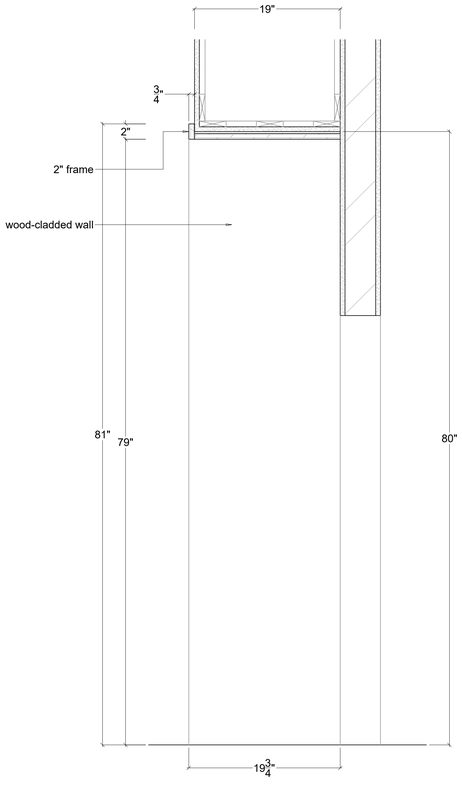

2 PLAY 102B DISCOVERY WALL - SECTION
Scale: 1 1/2" = 1'

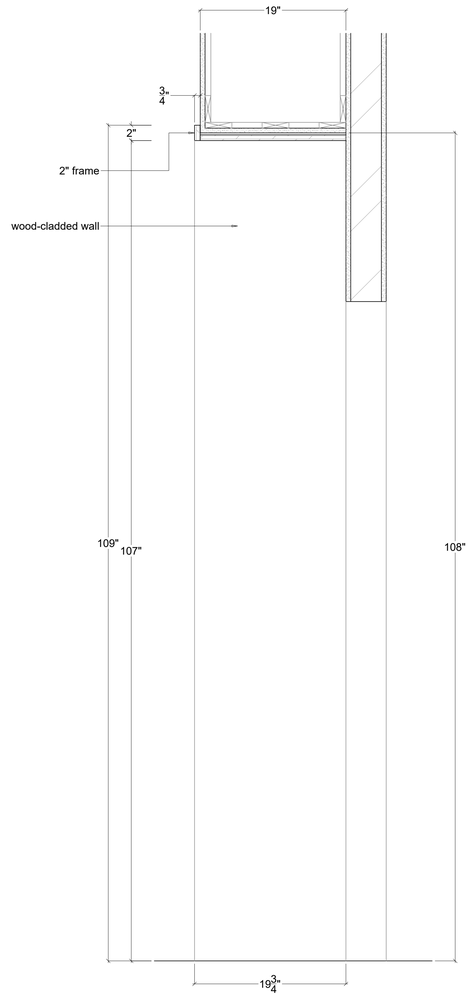

1 PLAY 102B DISCOVERY WALL - SECTION
Scale: 1 1/2" = 1'

REVISIONS

CONSTRUCTION DOCUMENTS

LOS ANGELES COUNTY PUBLIC WORKS

HUNTINGTON PARK LIBRARY

6518 MILES AVE
HUNTINGTON PARK, CA 90255

COUNTY OF LOS ANGELES CALIFORNIA

LA COUNTY LIBRARY

NAC


NAC NO	161-23025
DRAWN	Author
CHECKED	Checker
DATE	07/23/2025

CASEWORK - LEVEL 1

PLAY 102B DISCOVERY WALL

A9.54d

©2023 NAC Inc

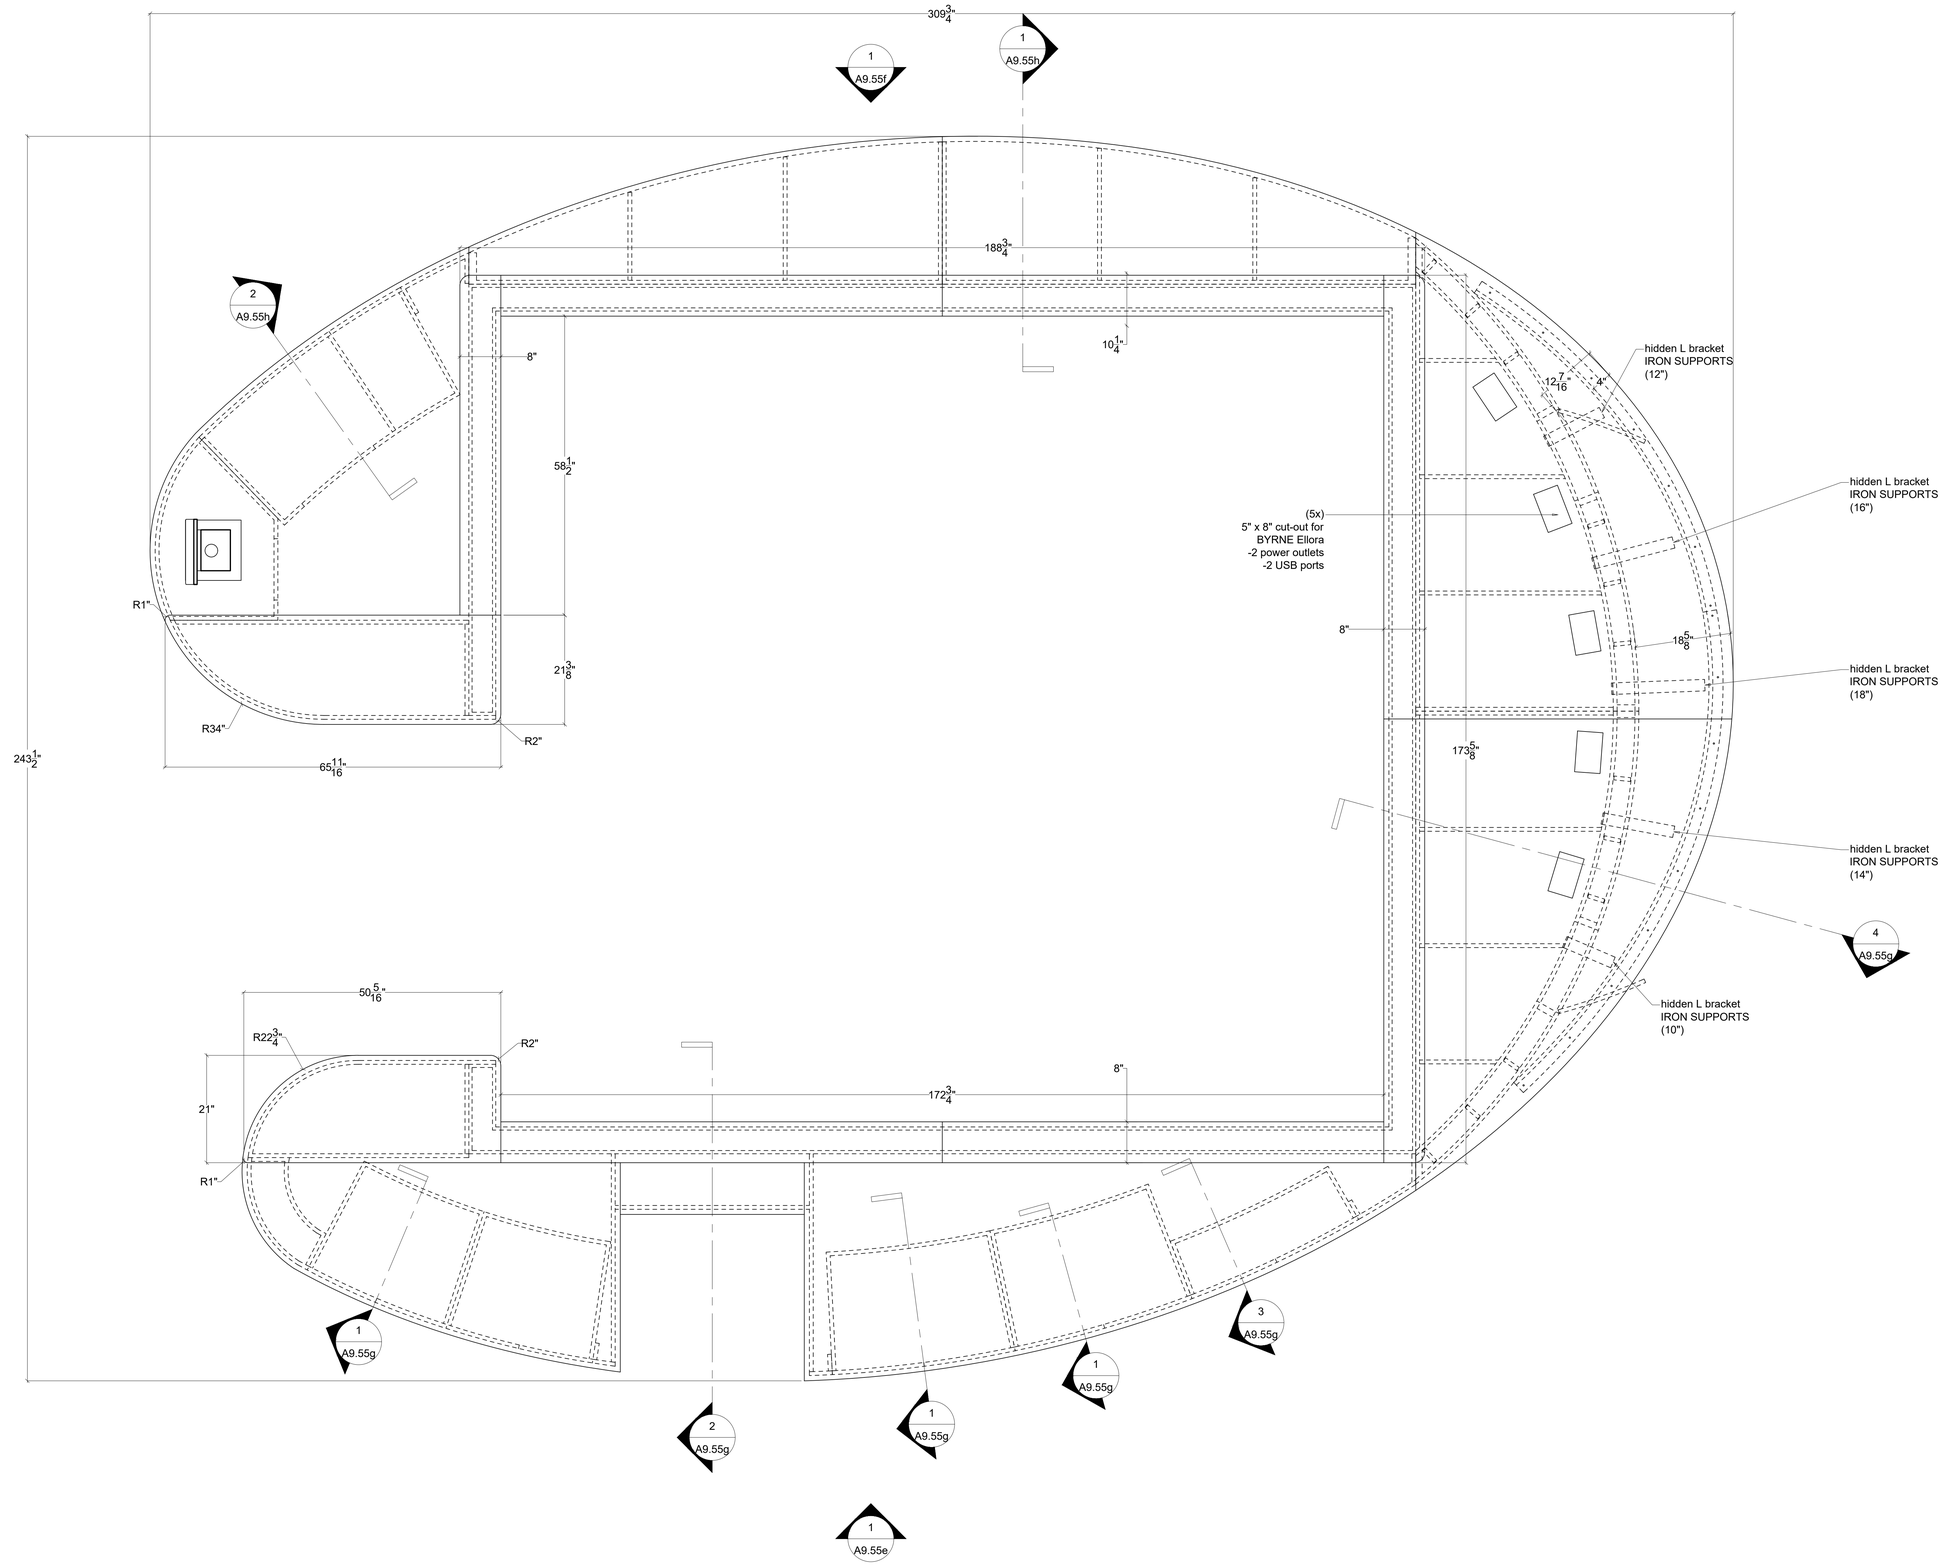

1 200 STAIR COUNTER - PLAN
Scale: 1" = 1'

REVISIONS

CONSTRUCTION DOCUMENTS

LOS ANGELES COUNTY PUBLIC WORKS

HUNTINGTON PARK LIBRARY

6518 MILES AVE
HUNTINGTON PARK, CA 90255

NAC

NAC NO	161-23025
DRAWN	Author
CHECKED	Checker
DATE	07/28/2025


CASEWORK - LEVEL 2

200 STAIR COUNTER

A9.55

© 2023 NAC, Inc.

NOTES:
Wall measurements must be verified

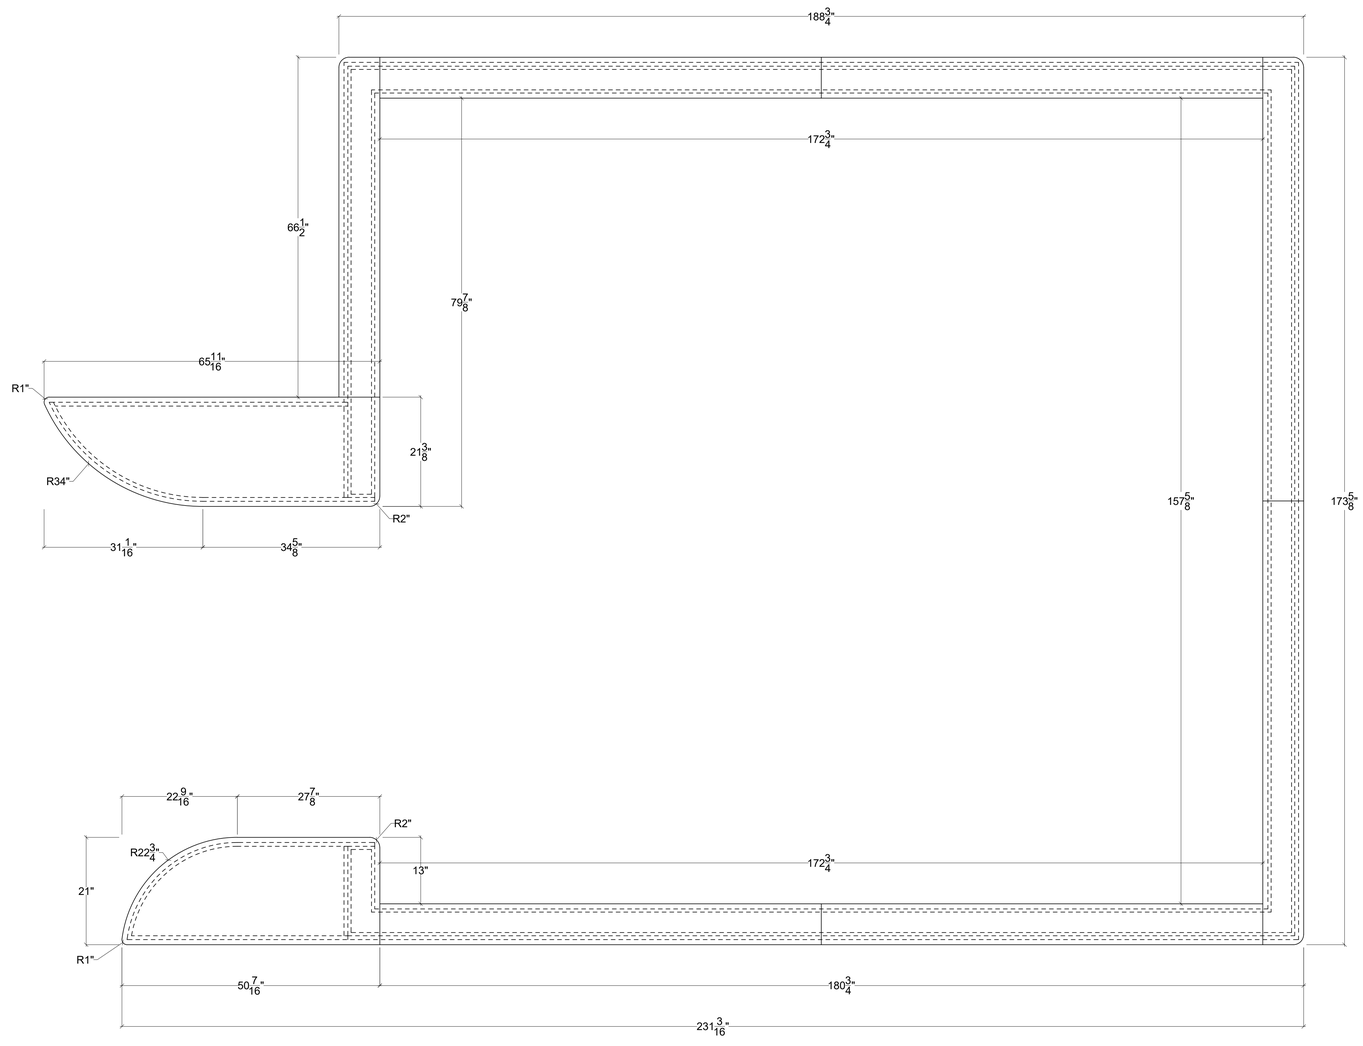

1 200 STAIR COUNTER - PLAN (transaction)
Scale: 1" = 1'

REVISIONS

CONSTRUCTION DOCUMENTS

LOS ANGELES COUNTY PUBLIC WORKS

HUNTINGTON PARK LIBRARY

6518 MILES AVE
HUNTINGTON PARK, CA 90255

COUNTY OF LOS ANGELES CALIFORNIA

LA COUNTY LIBRARY

NAC


NAC NO	161-23025
DRAWN	Author
CHECKED	Checker
DATE	07/28/2025

CASEWORK - LEVEL 2

200 STAIR COUNTER

A9.55a

© 2023 NAC Inc

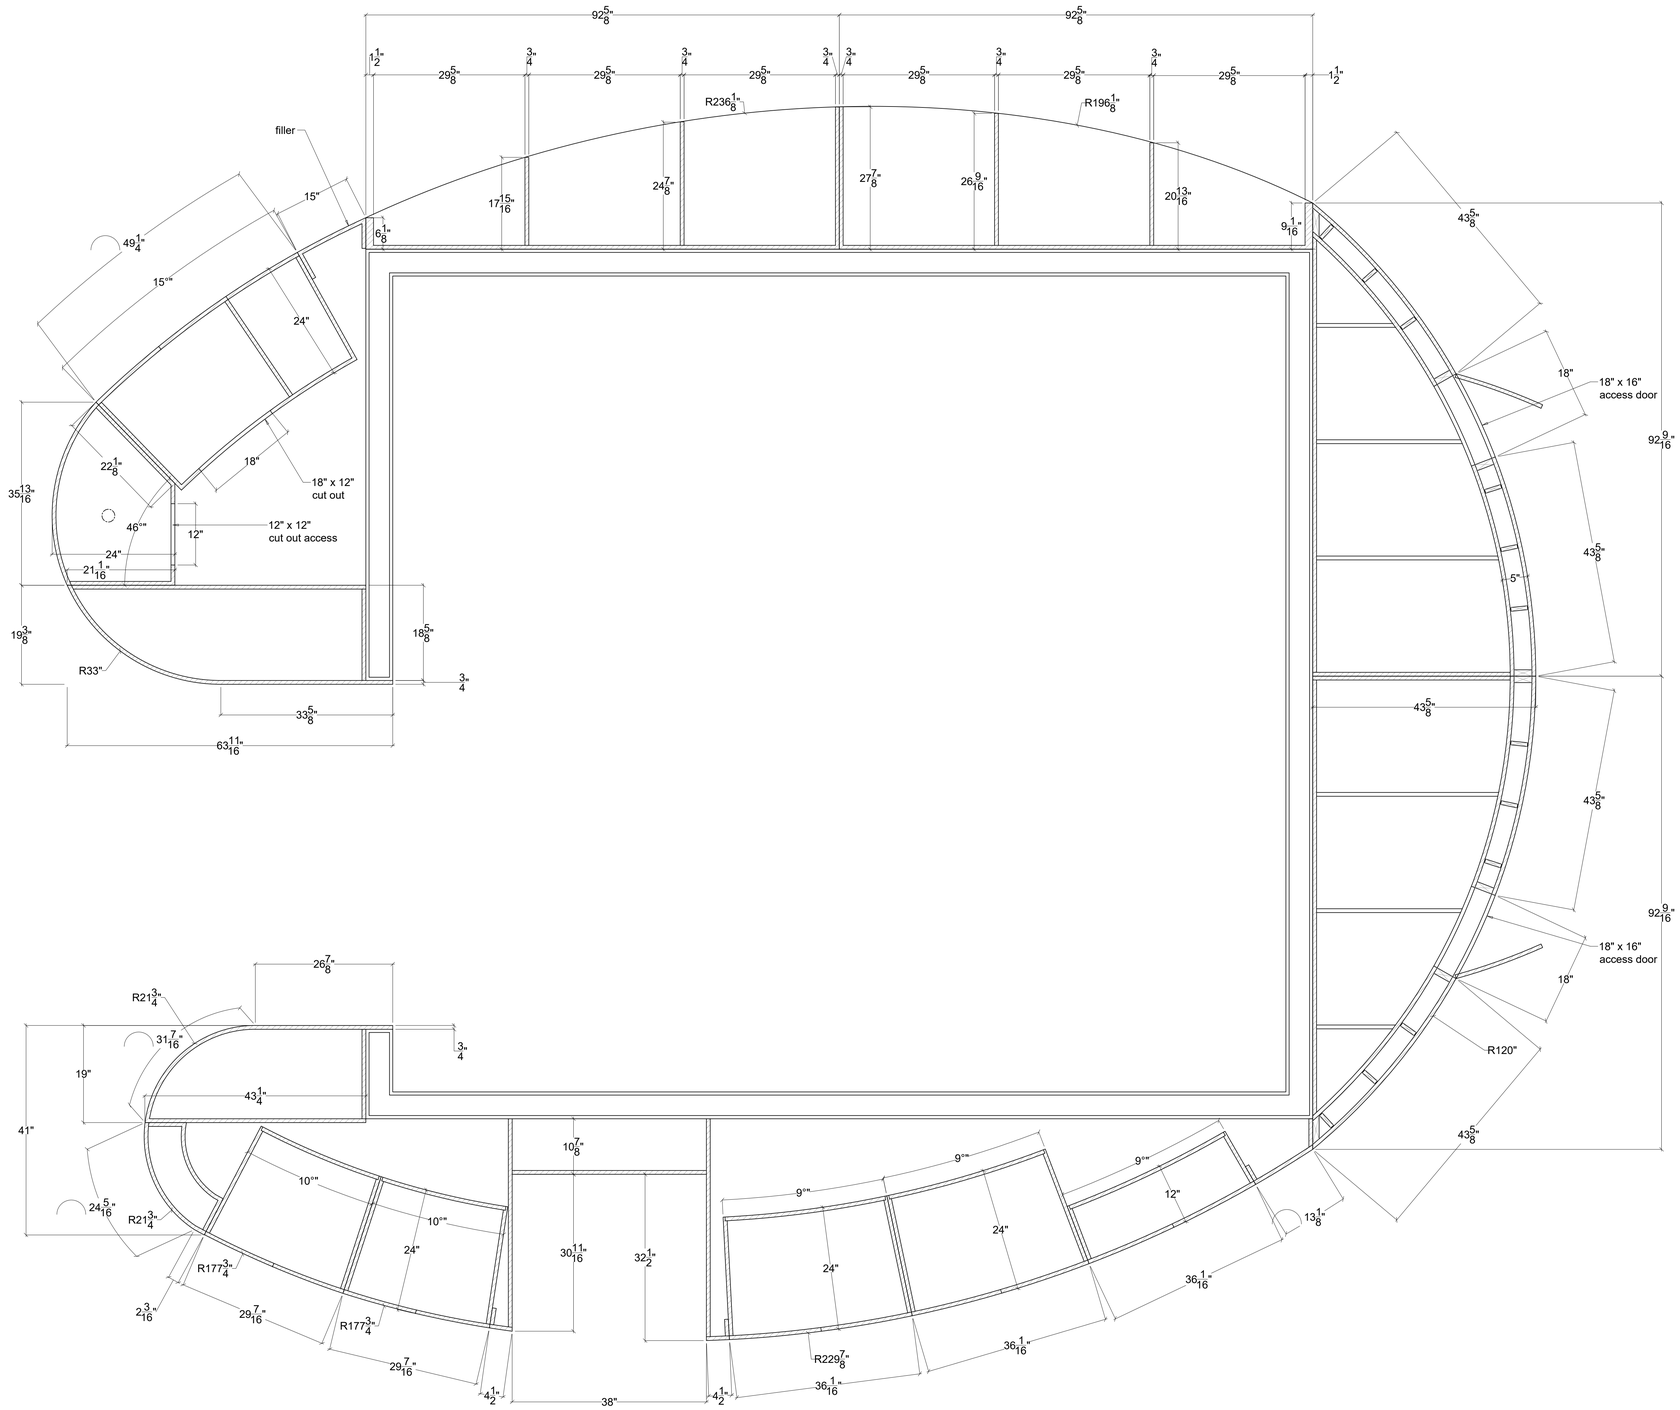

1 200 STAIR COUNTER - PLAN (lower cabinets)
Scale: 1" = 1'

REVISIONS

CONSTRUCTION DOCUMENTS

LOS ANGELES COUNTY PUBLIC WORKS

HUNTINGTON PARK LIBRARY

6518 MILES AVE
HUNTINGTON PARK, CA. 90255

COUNTY OF LOS ANGELES CALIFORNIA

LA COUNTY LIBRARY

NAC


NAC NO	161-23025
DRAWN	Author
CHECKED	Checker
DATE	07/28/2025

CASEWORK - LEVEL 2

200 STAIR COUNTER

A9.55b

©2023 NAC, Inc.

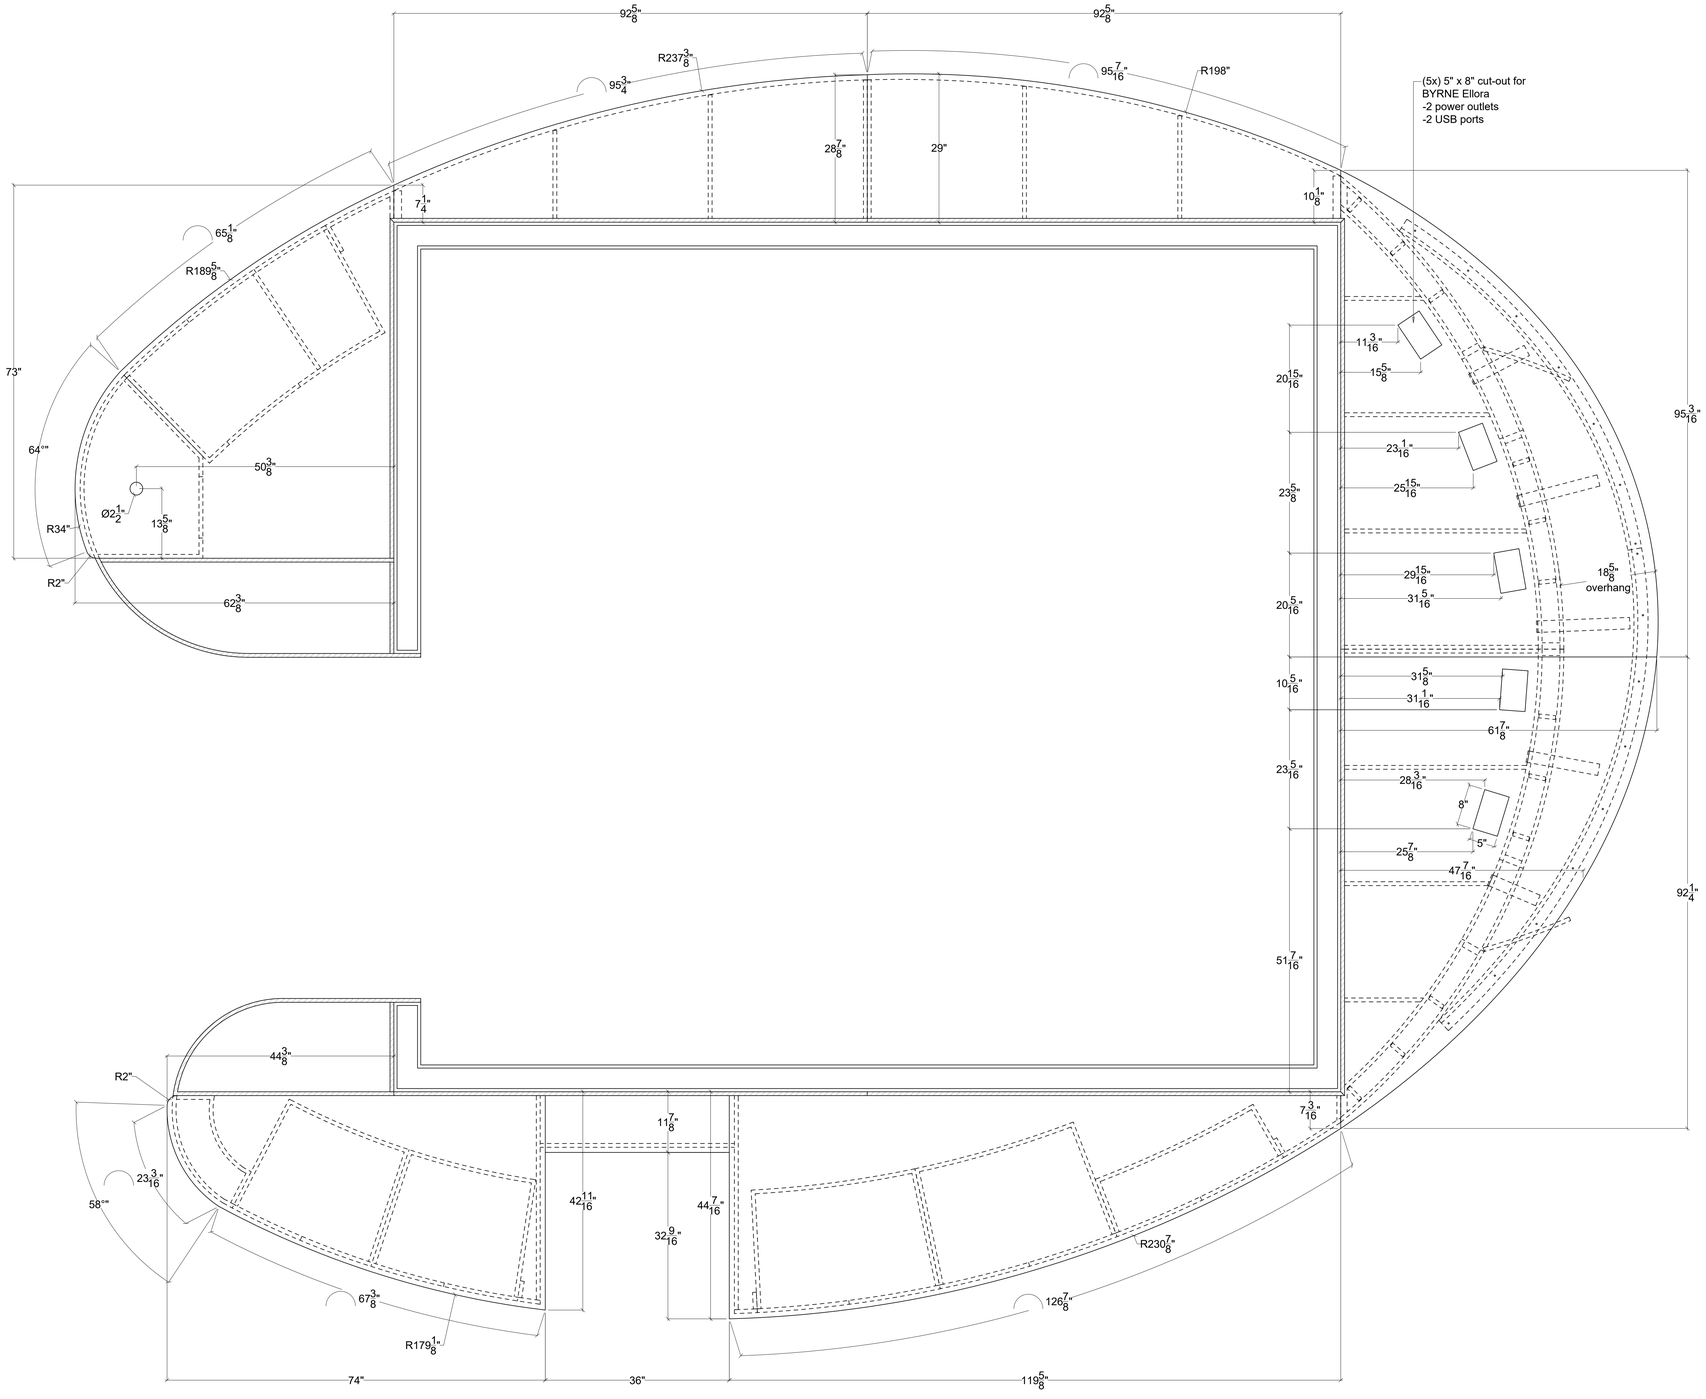

1 200 STAIR COUNTER - PLAN (cabinets top)
Scale: 1" = 1'

REVISIONS

CONSTRUCTION DOCUMENTS

LOS ANGELES COUNTY PUBLIC WORKS

HUNTINGTON PARK LIBRARY

6518 MILES AVE
HUNTINGTON PARK, CA 90255

COUNTY OF LOS ANGELES CALIFORNIA

LA COUNTY LIBRARY

NAC


NAC NO	161-23025
DRAWN	Author
CHECKED	Checker
DATE	07/28/2025

CASEWORK - LEVEL 2

200 STAIR COUNTER

A9.55c

© 2023 NAC Inc.

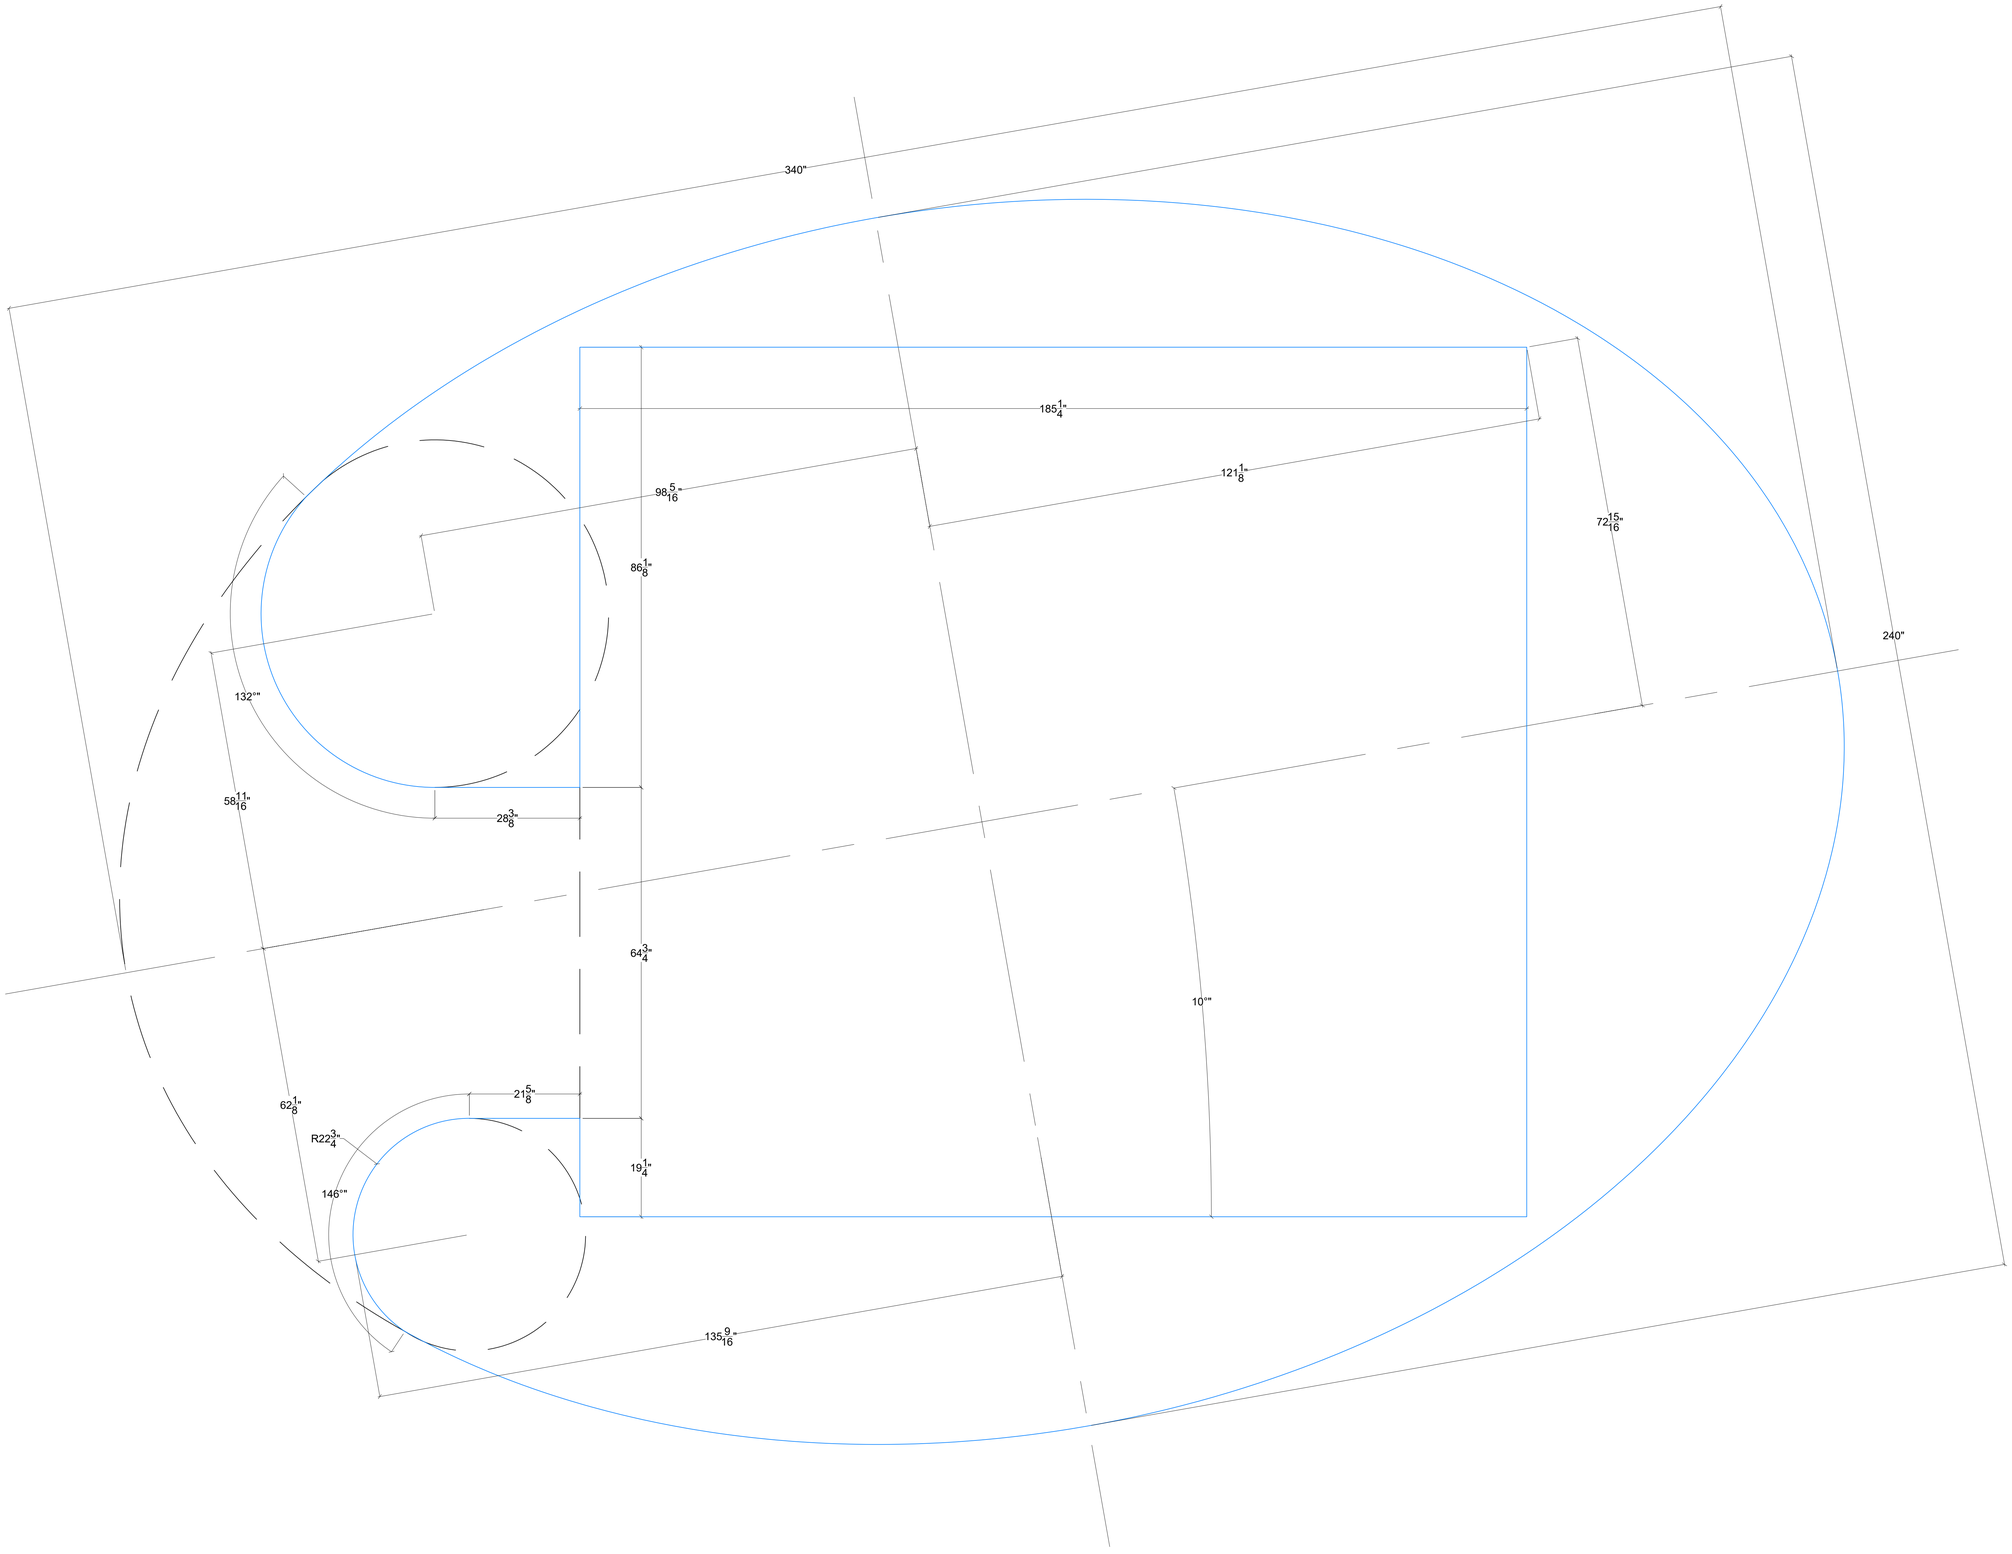

1 200 STAIR COUNTER - PLAN (geometry)
Scale: 1" = 1'

REVISIONS

CONSTRUCTION DOCUMENTS

LOS ANGELES COUNTY PUBLIC WORKS

HUNTINGTON PARK LIBRARY

6518 MILES AVE
HUNTINGTON PARK, CA 90255

COUNTY OF LOS ANGELES CALIFORNIA

LA COUNTY LIBRARY

NAC


NAC NO	161-23025
DRAWN	Author
CHECKED	Checker
DATE	07/28/2025

CASEWORK - LEVEL 2


200 STAIR COUNTER

A9.55d

© 2022 NAC Inc.

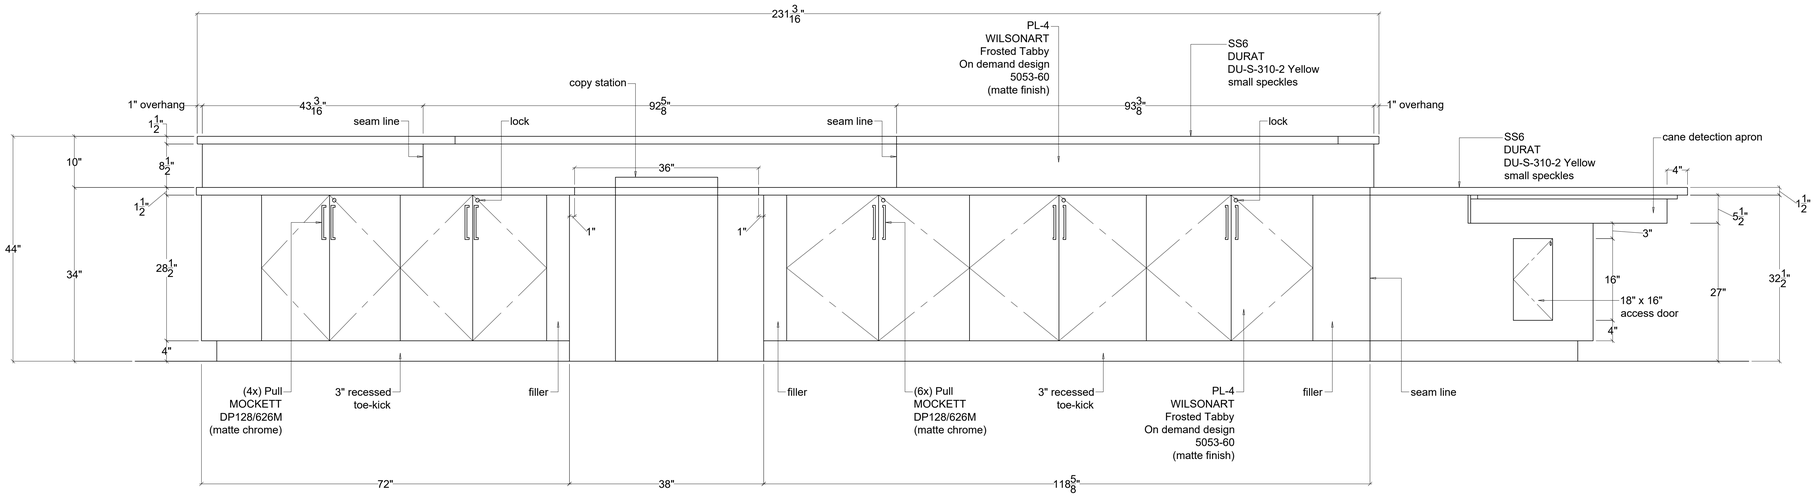

1 200 STAIR COUNTER - ELEVATION
Scale: 1" = 1'

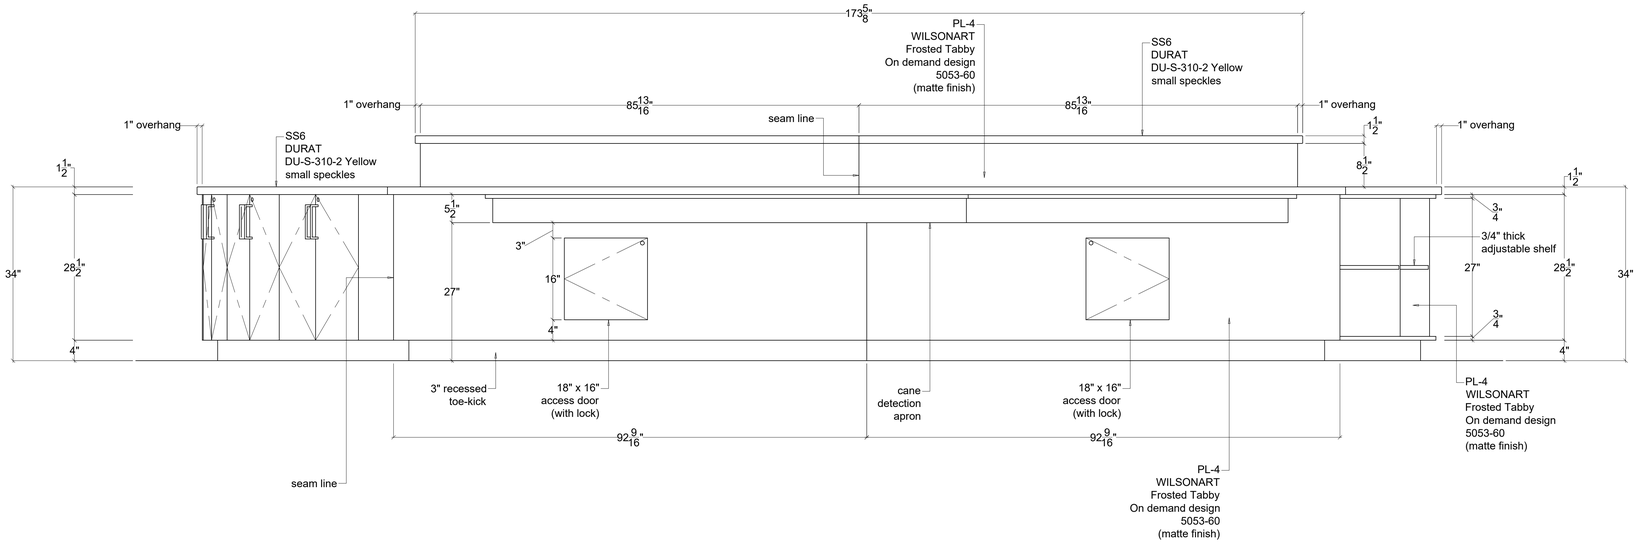

2 200 STAIR COUNTER - ELEVATION
Scale: 1" = 1'

REVISIONS

CONSTRUCTION DOCUMENTS

LOS ANGELES COUNTY PUBLIC WORKS

HUNTINGTON PARK LIBRARY

6518 MILES AVE
HUNTINGTON PARK, CA 90255

COUNTY OF LOS ANGELES CALIFORNIA

LA COUNTY LIBRARY

NAC


NAC NO	161-23025
DRAWN	Author
CHECKED	Checker
DATE	07/28/2025

CASEWORK - LEVEL 2


200 STAIR COUNTER

A9.55e

©2023 NAC Inc.

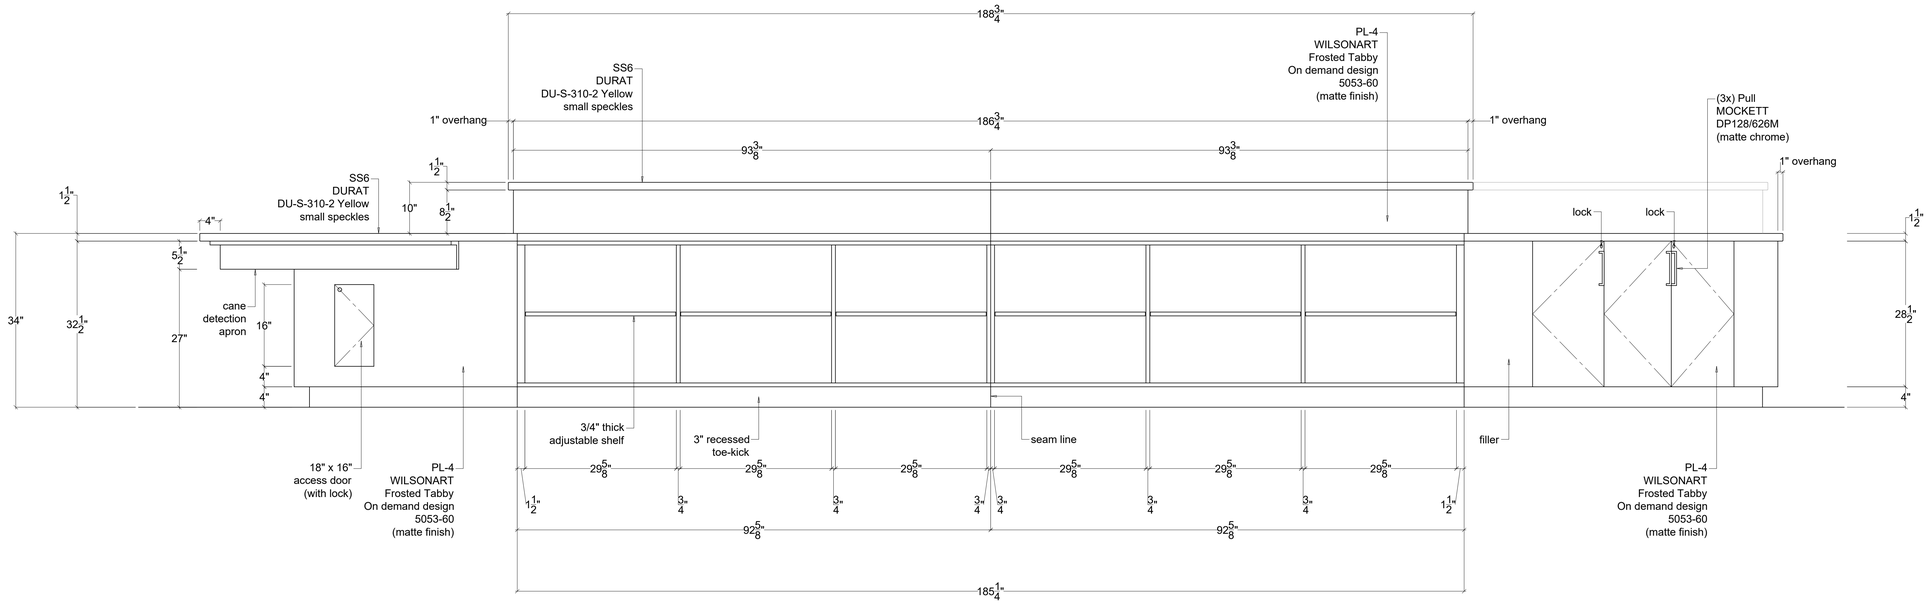

1 200 STAIR COUNTER - ELEVATION
Scale: 1" = 1'

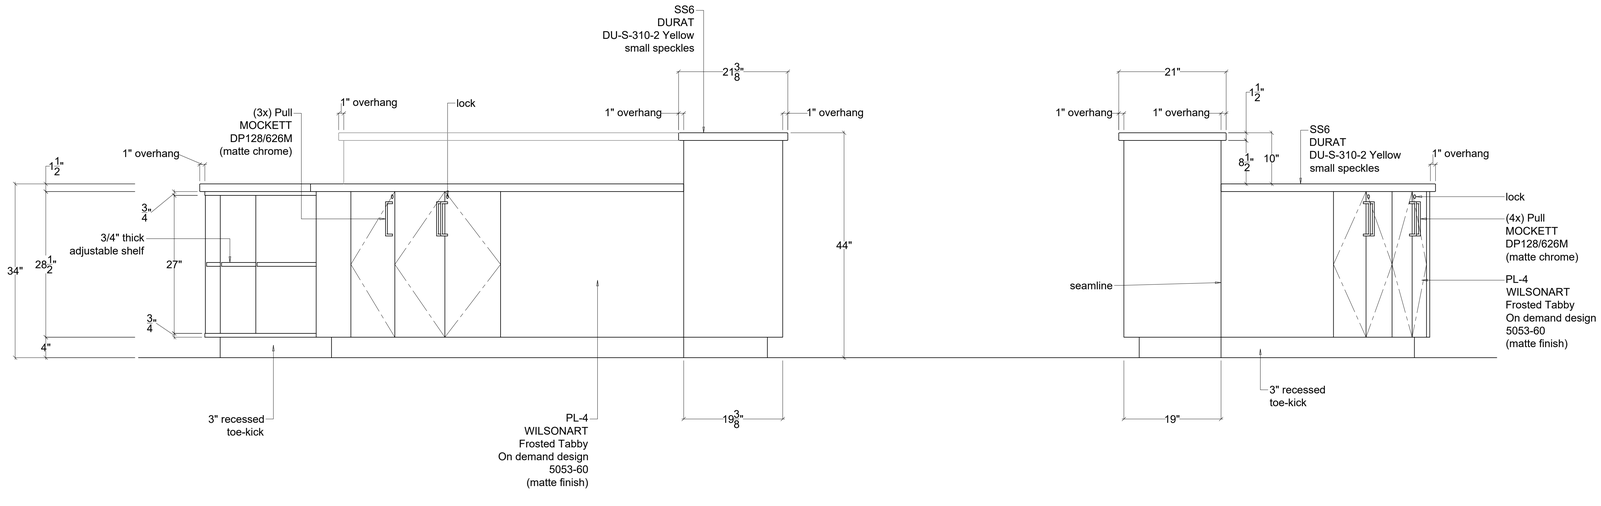

2 200 STAIR COUNTER - ELEVATION
Scale: 1" = 1'

REVISIONS

CONSTRUCTION DOCUMENTS

LOS ANGELES COUNTY PUBLIC WORKS
HUNTINGTON PARK LIBRARY
6518 MILES AVE
HUNTINGTON PARK, CA 90255

NAC


NAC NO	161-23025
DRAWN	Author
CHECKED	Checker
DATE	07/28/2025

CASEWORK - LEVEL 2


200 STAIR COUNTER

A9.55f


©2023 NAC Arc

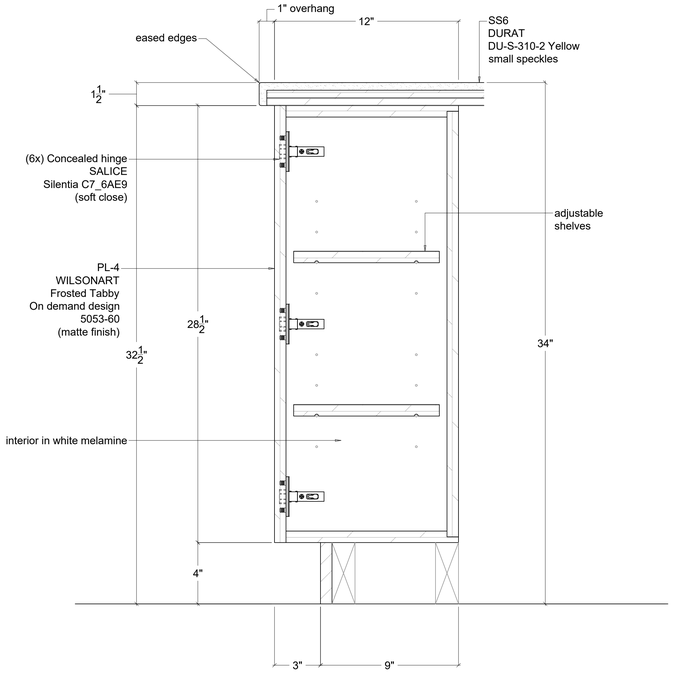


3 200 STAIR COUNTER - SECTION
Scale: 3" = 1'

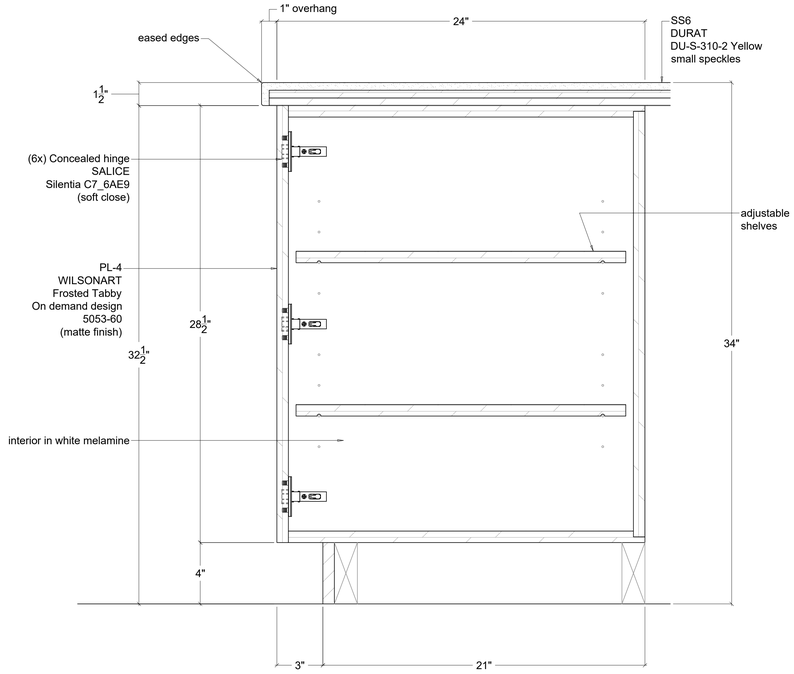

1 200 STAIR COUNTER - SECTION
Scale: 3" = 1'

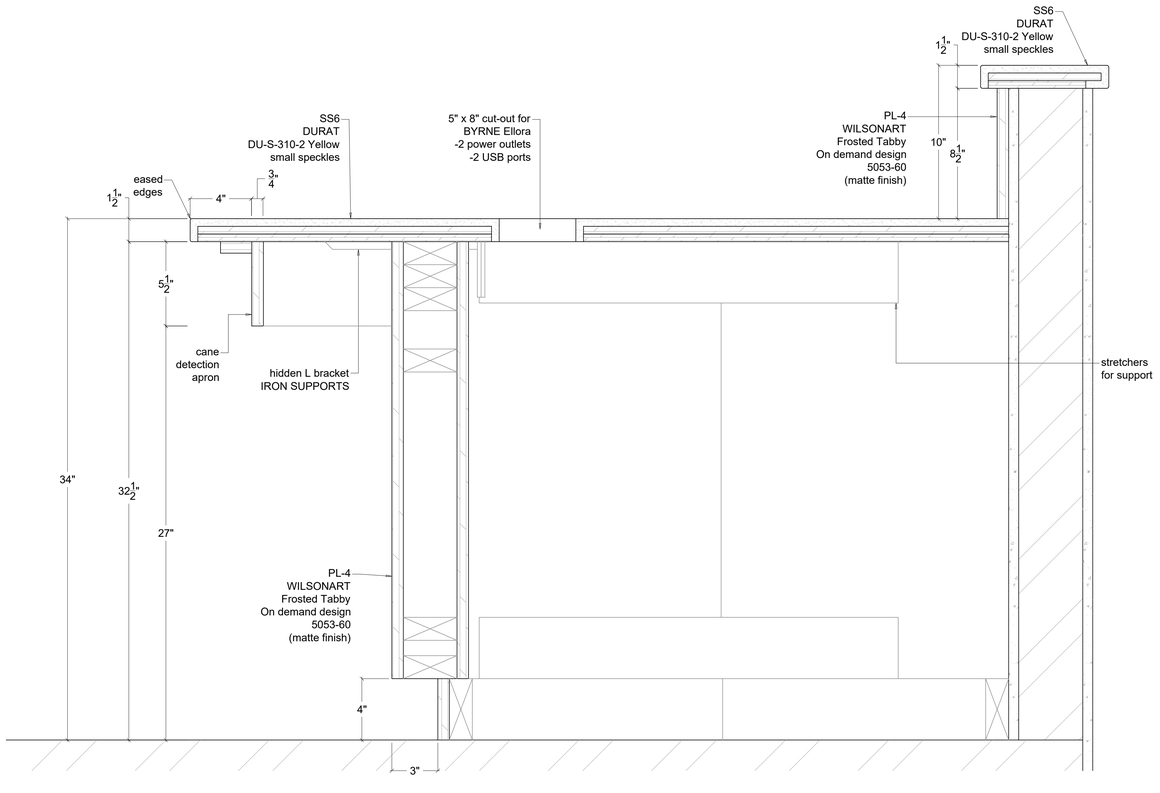

4 200 STAIR COUNTER - SECTION
Scale: 3" = 1'

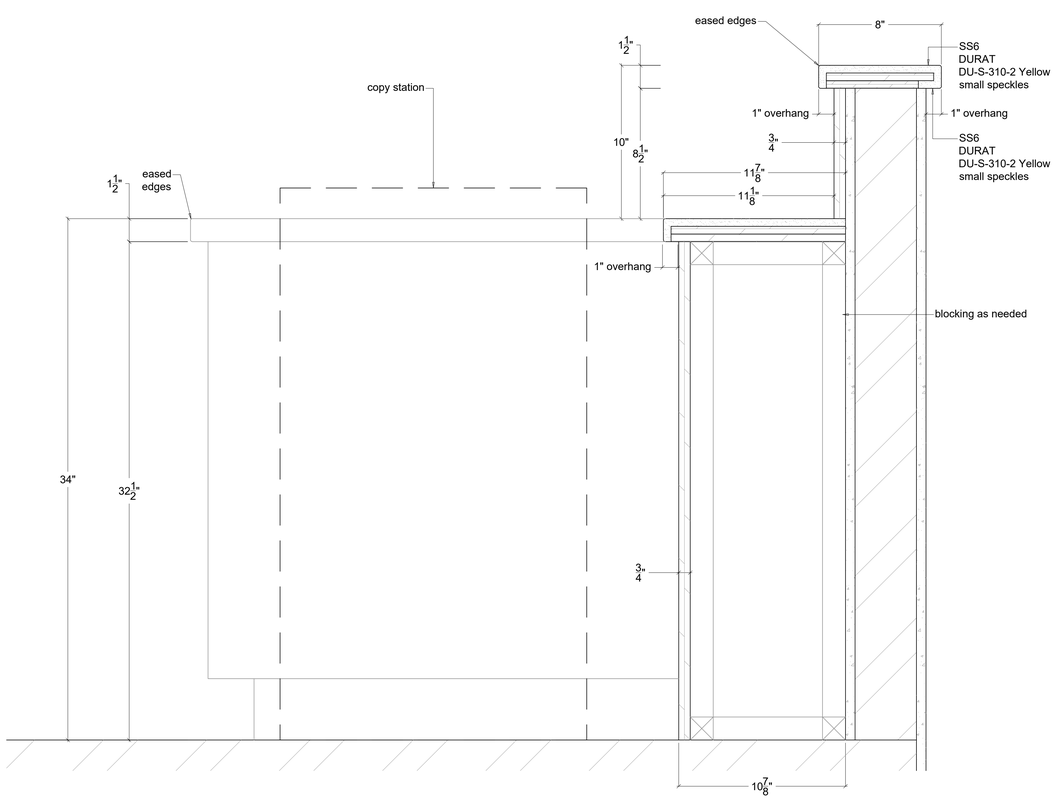

2 200 STAIR COUNTER - SECTION
Scale: 3" = 1'

REVISIONS

CONSTRUCTION DOCUMENTS

LOS ANGELES COUNTY PUBLIC WORKS
HUNTINGTON PARK LIBRARY
6518 MILES AVE
HUNTINGTON PARK, CA 90255

COUNTY OF LOS ANGELES CALIFORNIA

LA COUNTY LIBRARY

NAC


NAC NO	161-23025
DRAWN	Author
CHECKED	Checker
DATE	07/28/2025

CASEWORK - LEVEL 2


200 STAIR COUNTER

A9.55g

©2023 NAC Arc

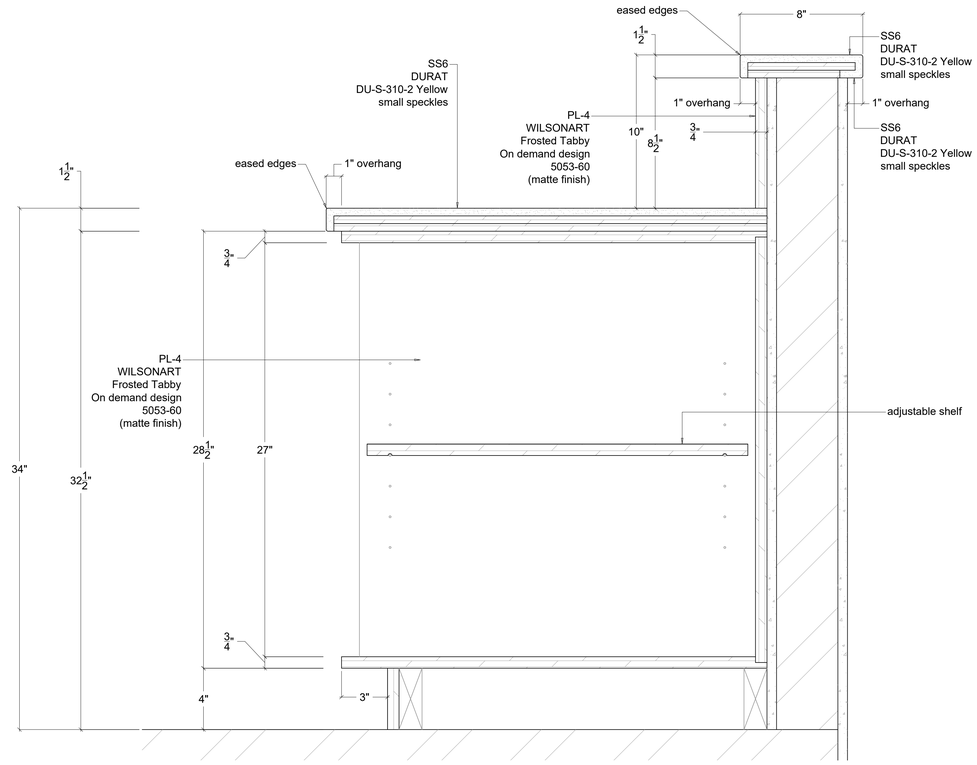

1 200 STAIR COUNTER - SECTION
Scale: 3" = 1'

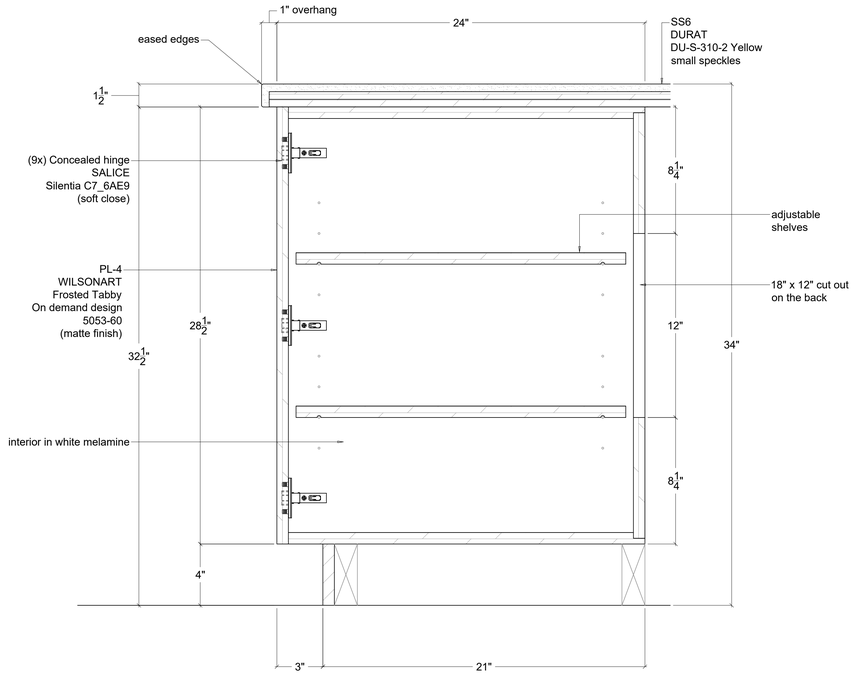

2 200 STAIR COUNTER - SECTION
Scale: 3" = 1'

REVISIONS

CONSTRUCTION DOCUMENTS

LOS ANGELES COUNTY PUBLIC WORKS

HUNTINGTON PARK LIBRARY

6518 MILES AVE
HUNTINGTON PARK, CA 90255

NAC


NAC NO	161-23025
DRAWN	Author
CHECKED	Checker
DATE	07/28/2025

CASEWORK - LEVEL 2


200 STAIR COUNTER

A9.55h


© 2023 NAC Arc

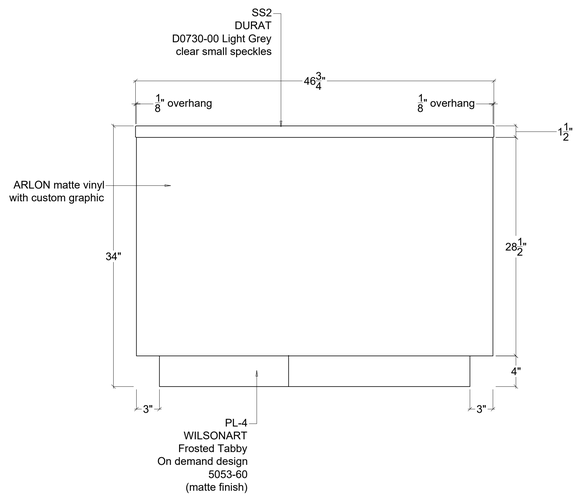


3 INFO DESK 200 - ELEVATION
Scale: 1 1/2" = 1'

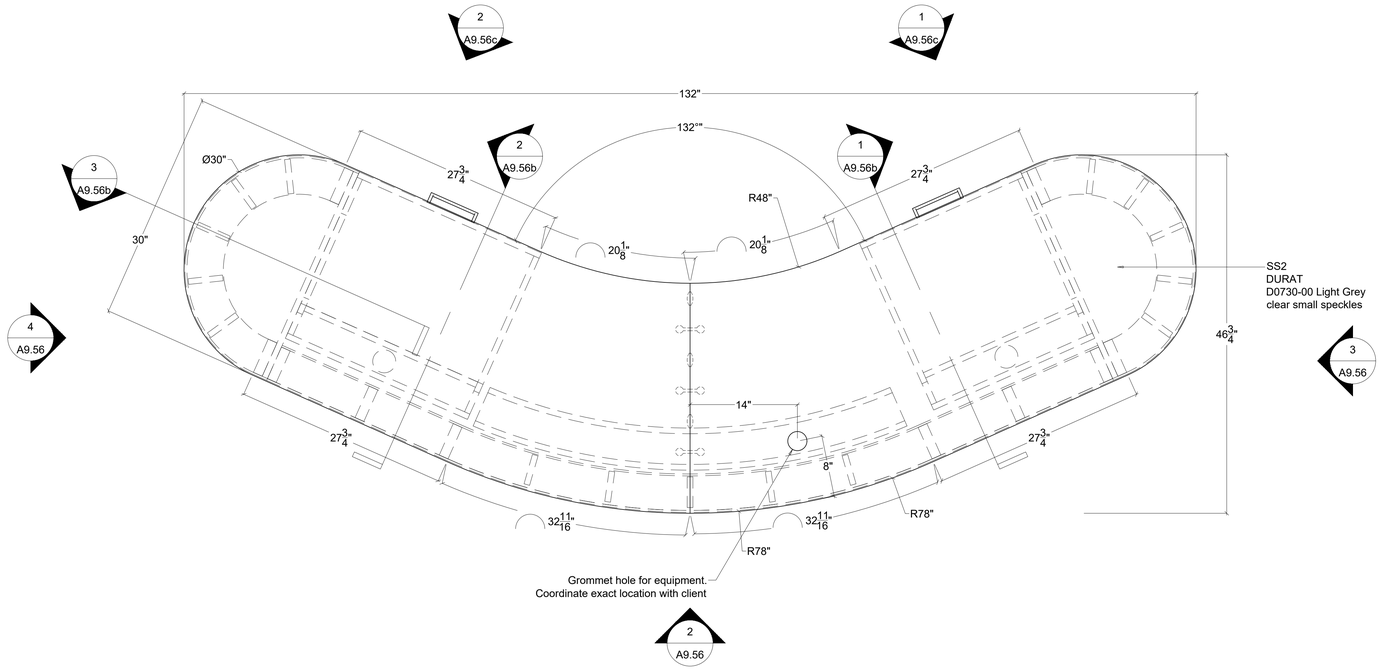

1 INFO DESK 200 - PLAN
Scale: 1 1/2" = 1'

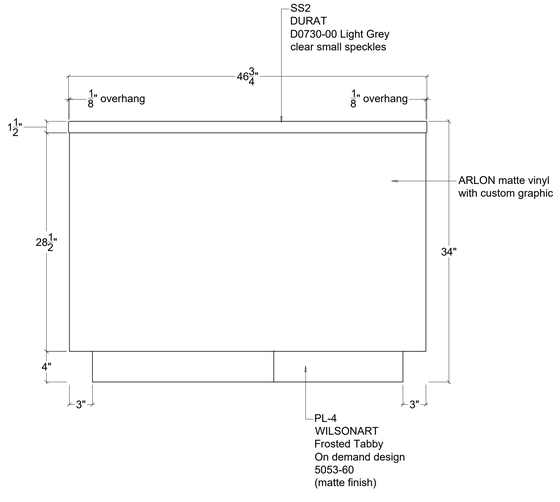

4 INFO DESK 200 - ELEVATION
Scale: 1 1/2" = 1'

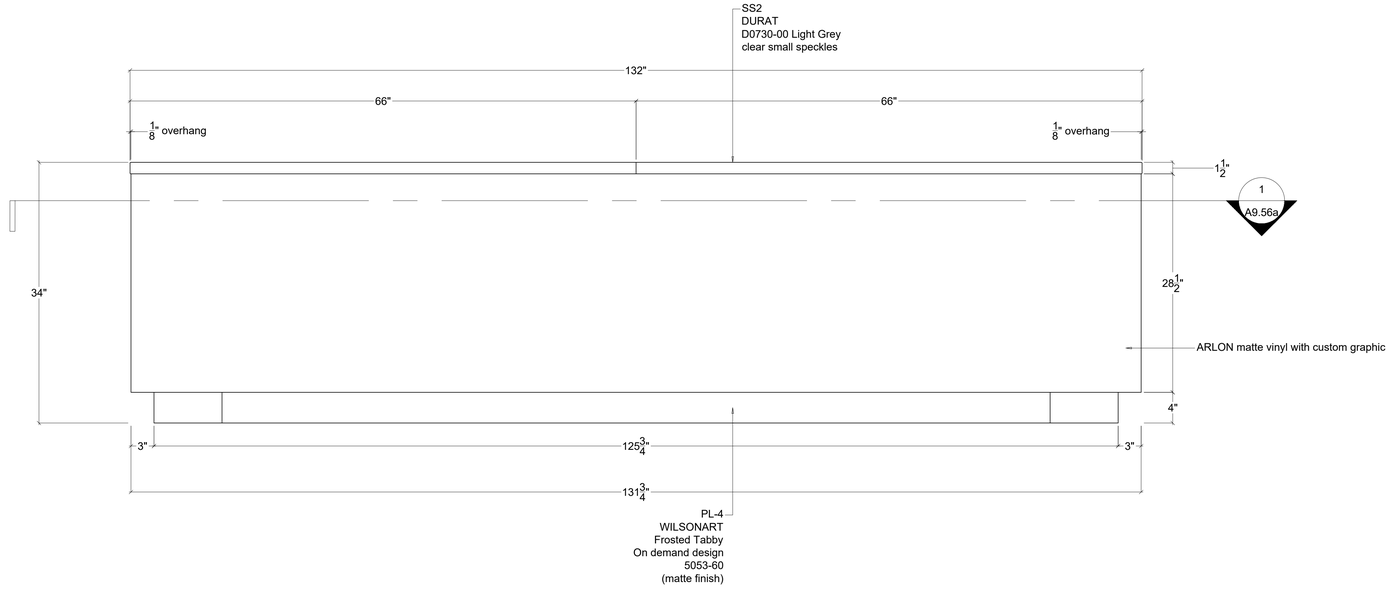

2 INFO DESK 200 - ELEVATION
Scale: 1 1/2" = 1'

REVISIONS

CONSTRUCTION DOCUMENTS

LOS ANGELES COUNTY PUBLIC WORKS
HUNTINGTON PARK LIBRARY
6518 MILES AVE
HUNTINGTON PARK, CA 90255


NAC NO	161-23025
DRAWN	Author
CHECKED	Checker
DATE	07/25/2025

CASEWORK - LEVEL 2


INFO DESK 200


A9.56

© 2023 NAC Arc

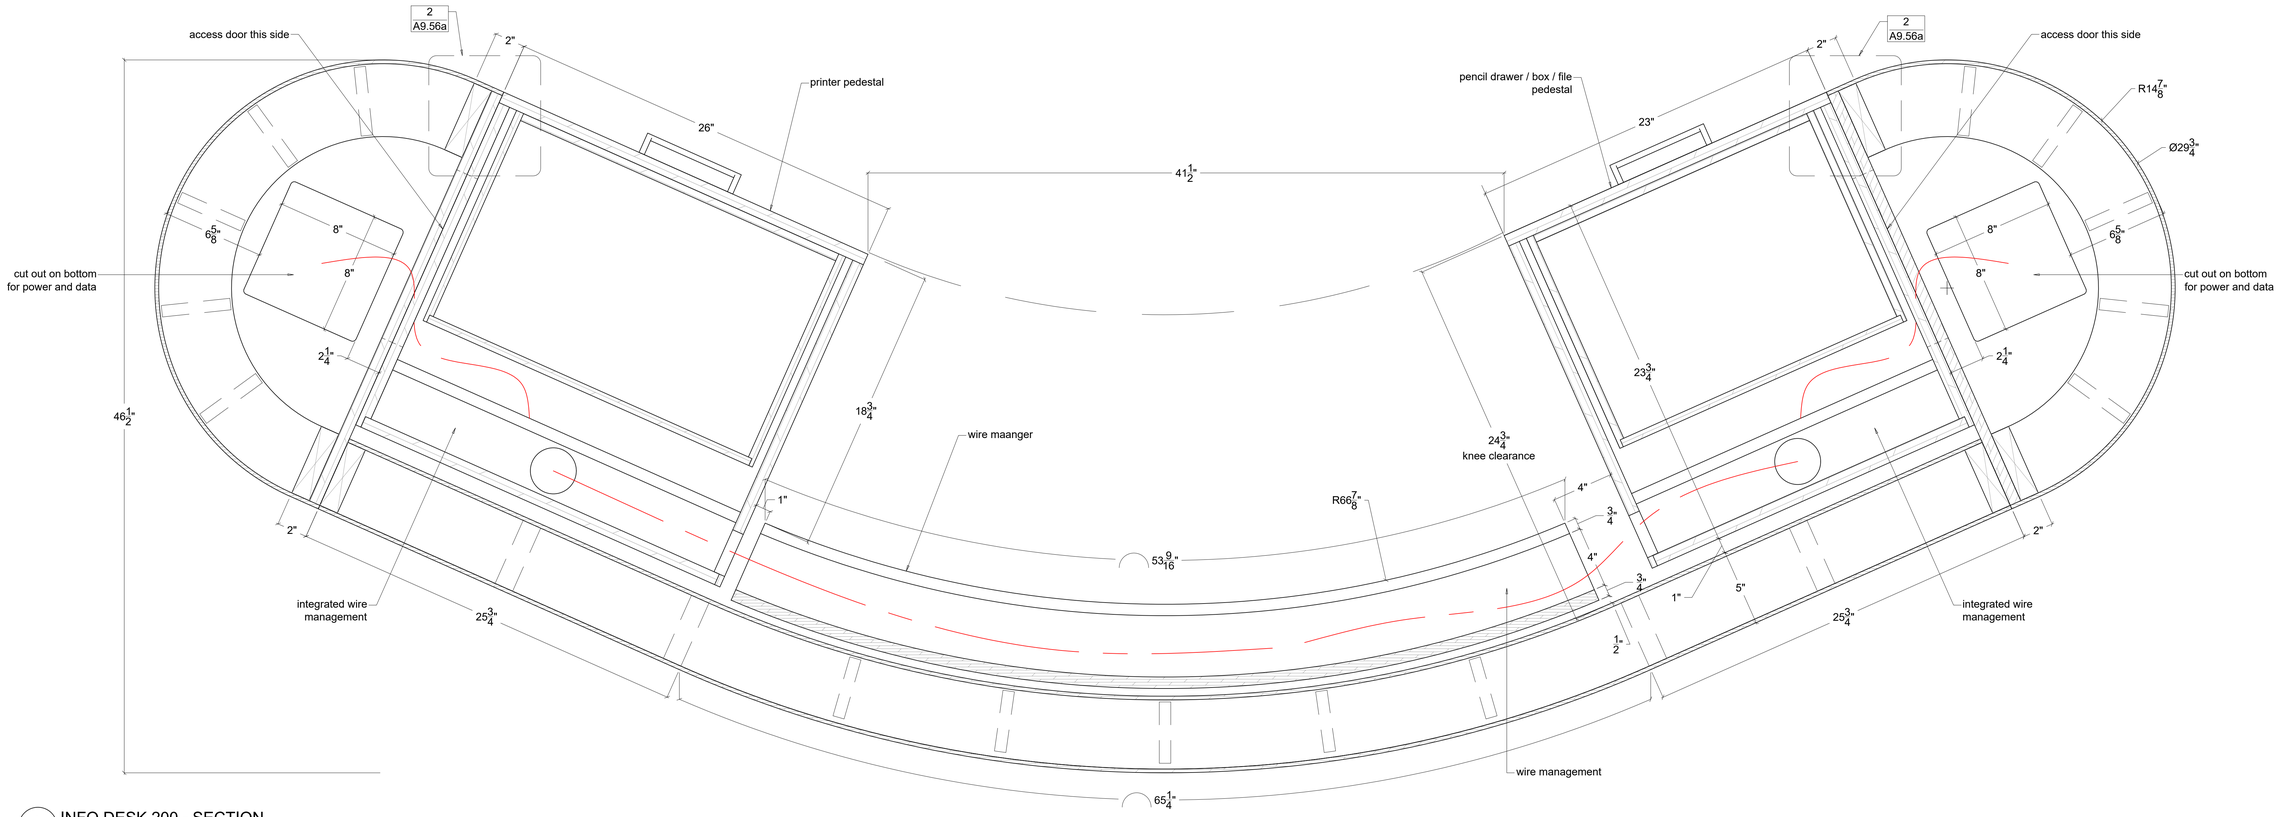

1 INFO DESK 200 - SECTION
Scale: 3" = 1'

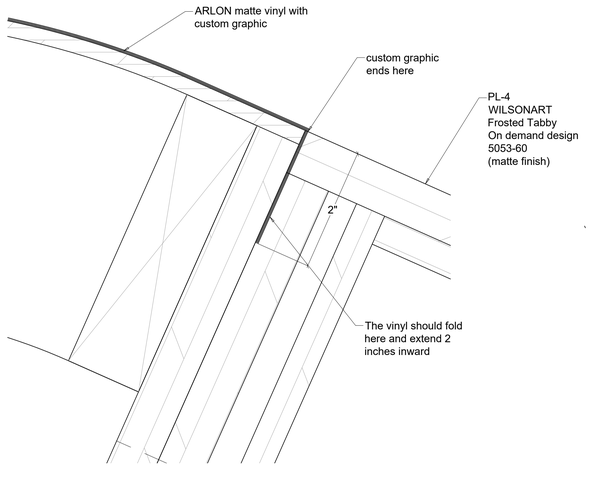

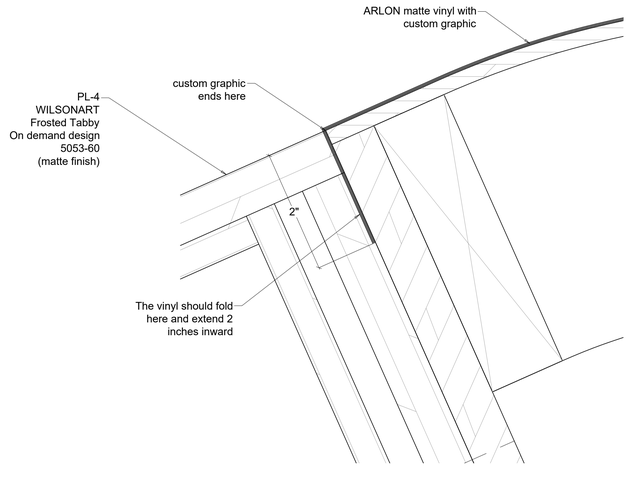

2 INFO DESK 200 - DETAIL
Scale: 1' = 1'

REVISIONS

CONSTRUCTION DOCUMENTS

LOS ANGELES COUNTY PUBLIC WORKS

HUNTINGTON PARK LIBRARY

6518 MILES AVE
HUNTINGTON PARK, CA 90255


NAC NO 161-23025
DRAWN Author
CHECKED Checker
DATE 07/25/2025

CASEWORK - LEVEL 2


INFO DESK 200

A9.56a


©2023 NAC Arc

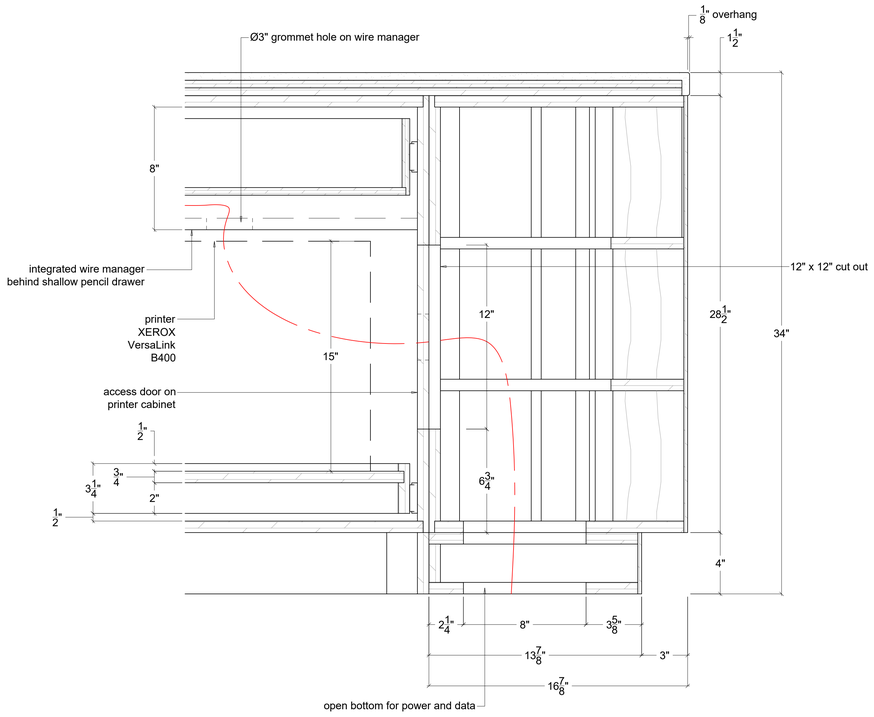

3 INFO DESK 200 - SECTION
Scale: 3" = 1'

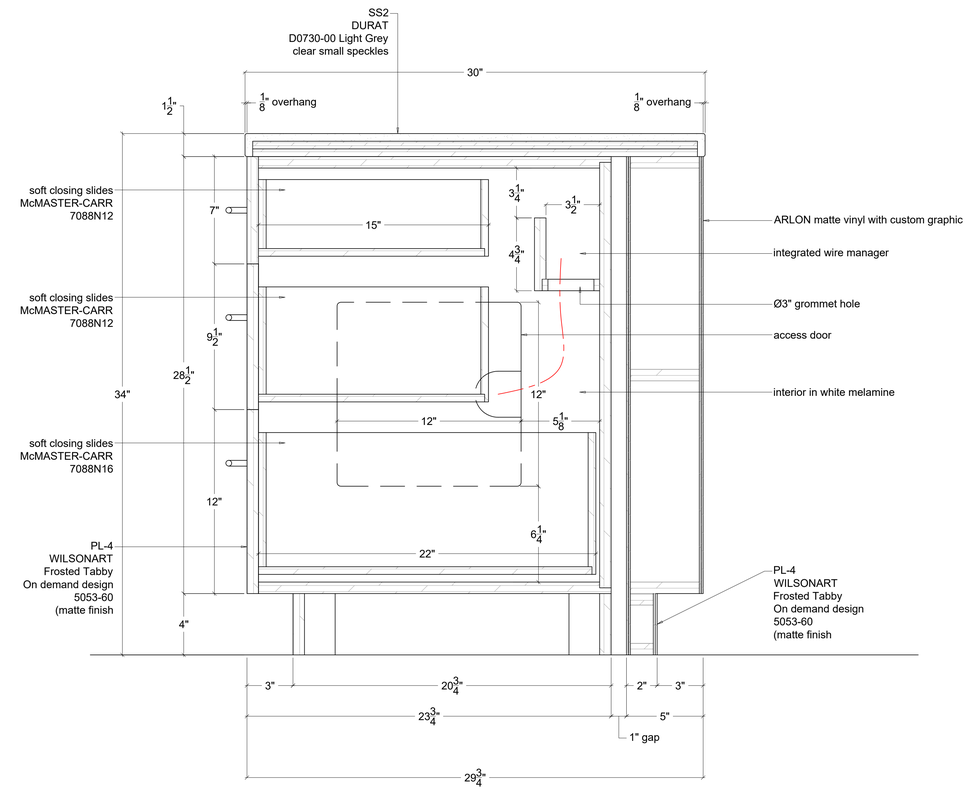

1 INFO DESK 200 - SECTION
Scale: 3" = 1'

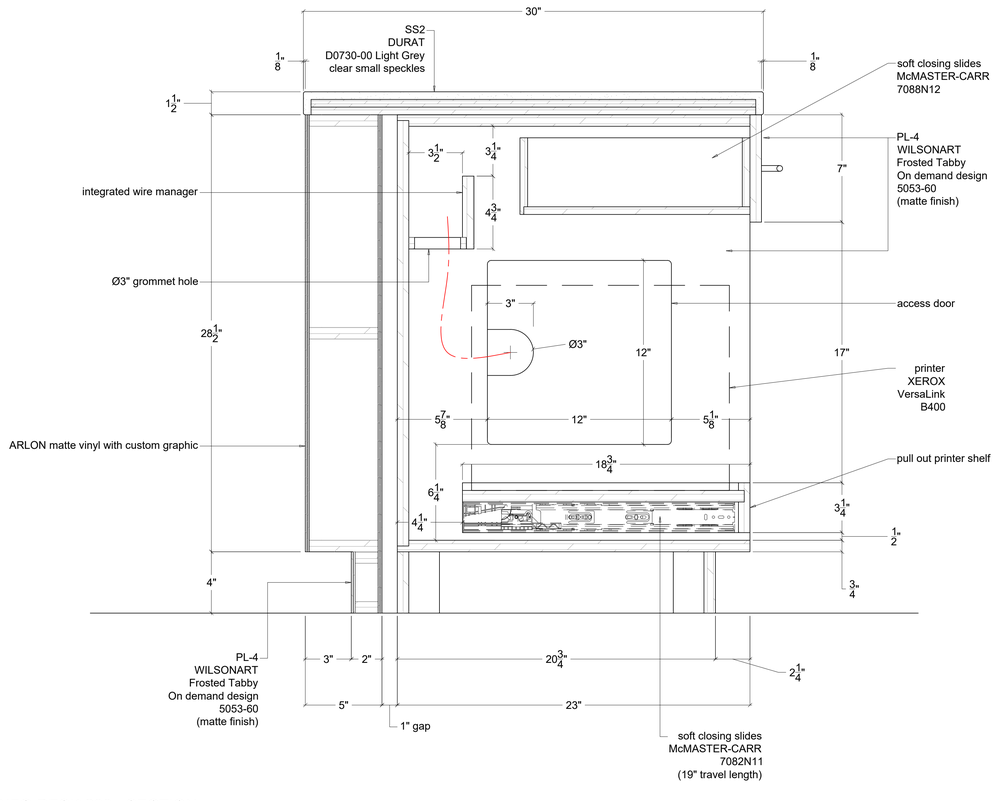

2 INFO DESK 200 - SECTION
Scale:

REVISIONS

CONSTRUCTION DOCUMENTS

LOS ANGELES COUNTY PUBLIC WORKS

HUNTINGTON PARK LIBRARY

6518 MILES AVE
HUNTINGTON PARK, CA 90255

COUNTY OF LOS ANGELES CALIFORNIA

LA COUNTY LIBRARY

NAC


NAC NO	161-23025
DRAWN	Author
CHECKED	Checker
DATE	07/25/2025

CASEWORK - LEVEL 2


INFO DESK 200

A9.56b


©2023 NAC Arc

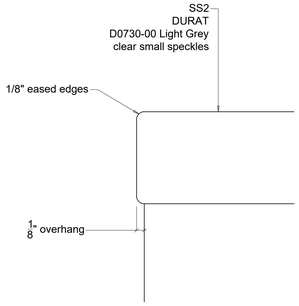

3 INFO DESK 200 - DETAIL
Scale: 1" = 1'

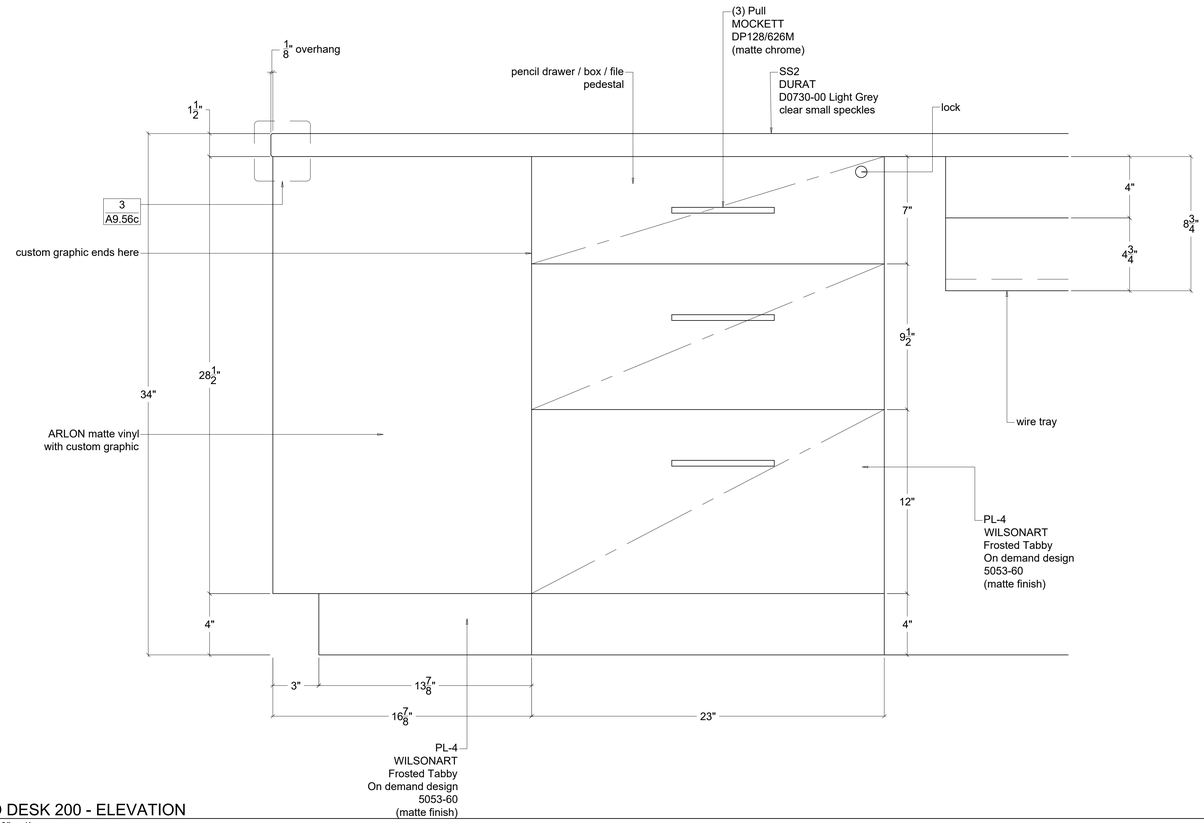

1 INFO DESK 200 - ELEVATION
Scale: 3" = 1'

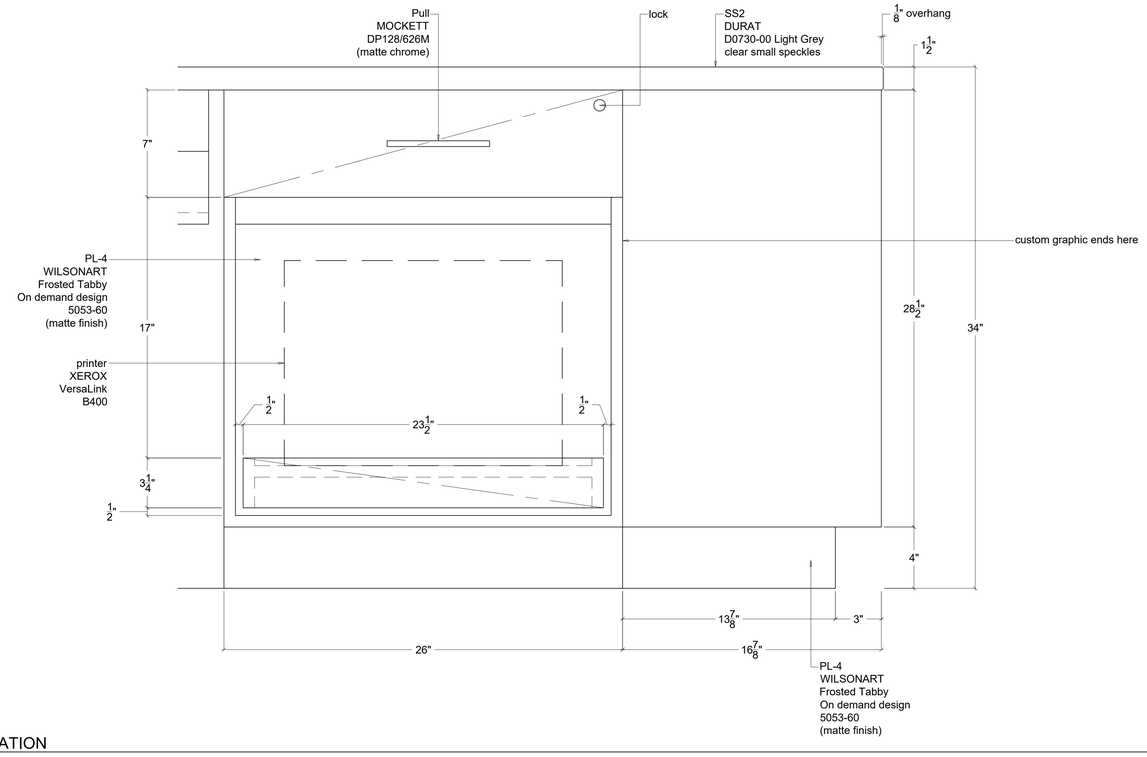

2 INFO DESK 200 - ELEVATION
Scale: 3" = 1'

REVISIONS

CONSTRUCTION DOCUMENTS

LOS ANGELES COUNTY PUBLIC WORKS

HUNTINGTON PARK LIBRARY

6518 MILES AVE
HUNTINGTON PARK, CA 90255


NAC NO	161-23025
DRAWN	Author
CHECKED	Checker
DATE	07/25/2025

CASEWORK - LEVEL 2


INFO DESK 200

A9.56c

© 2023 NAC Inc.

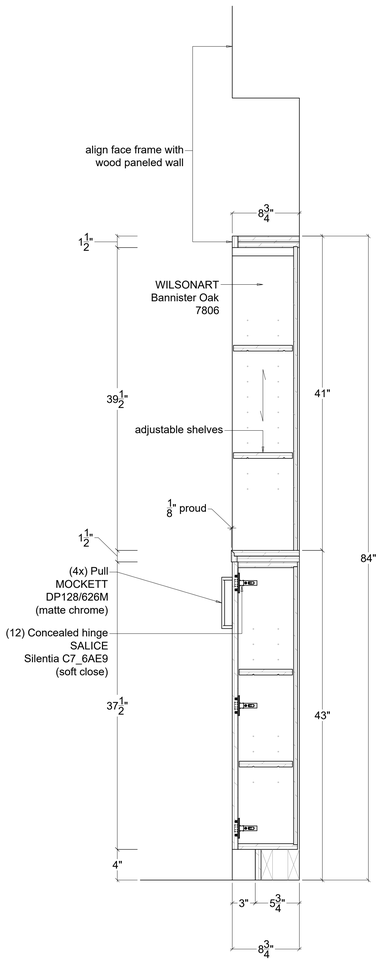

2 BUILT-IN SHELVING - SECTION
Scale: 1 1/2" = 1'

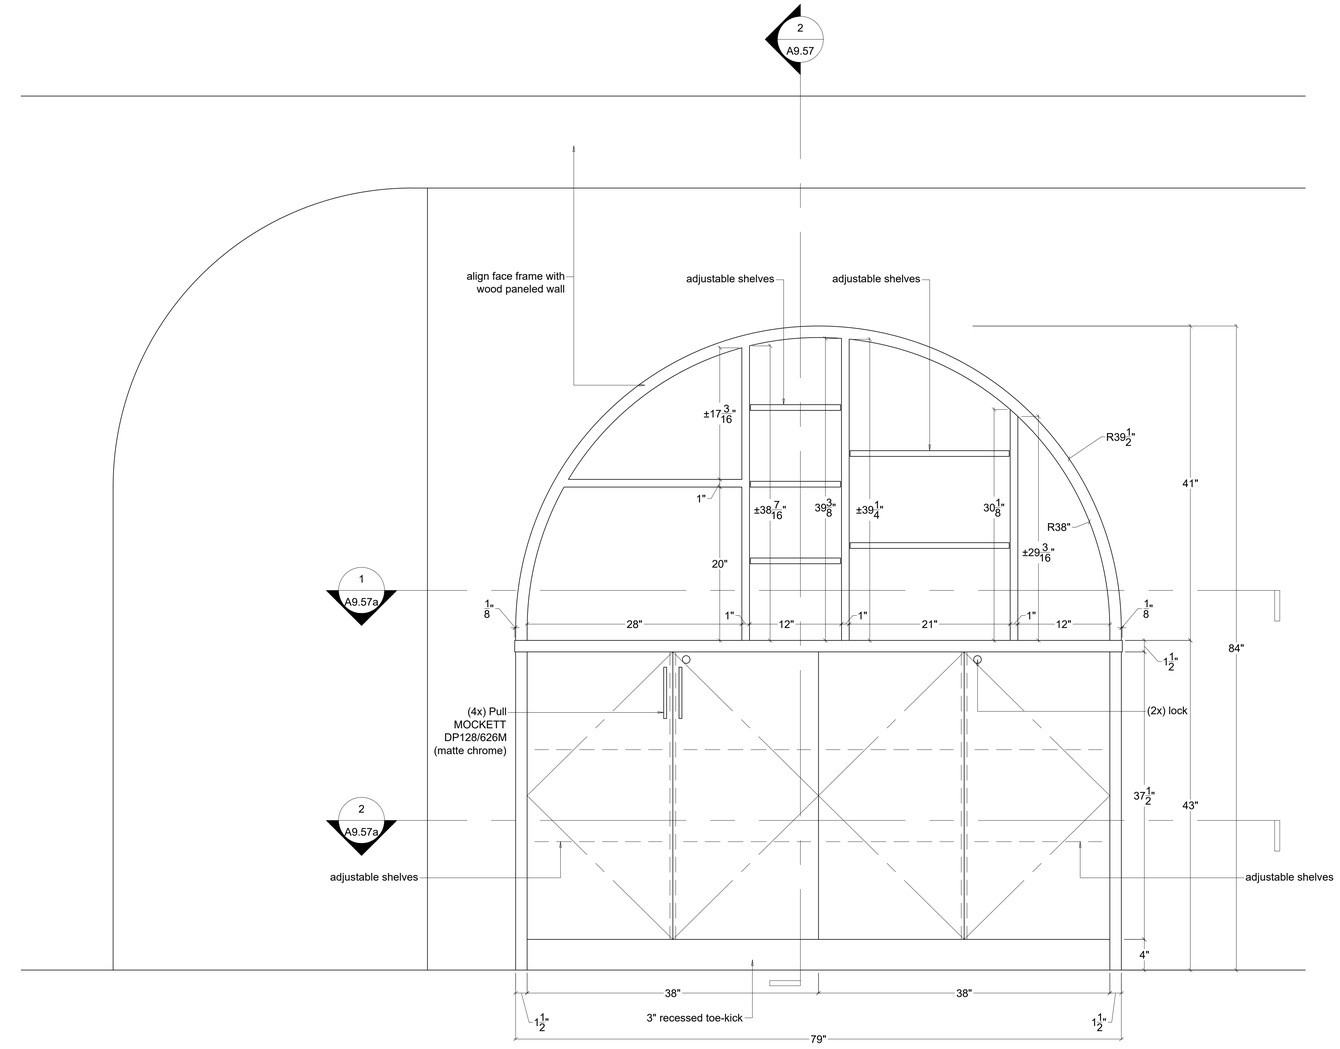

1 BUILT-IN SHELVING - ELEVATION
Scale: 1 1/2" = 1'

REVISIONS

CONSTRUCTION DOCUMENTS

LOS ANGELES COUNTY PUBLIC WORKS
HUNTINGTON PARK LIBRARY
6518 MILES AVE
HUNTINGTON PARK, CA 90255

LA COUNTY LIBRARY

NAC


NAC NO	161-23025
DRAWN	Author
CHECKED	Checker
DATE	07/24/2025

CASEWORK - LEVEL 2


BUILT-IN SHELVING 200

A9.57

© 2025 NAC Inc

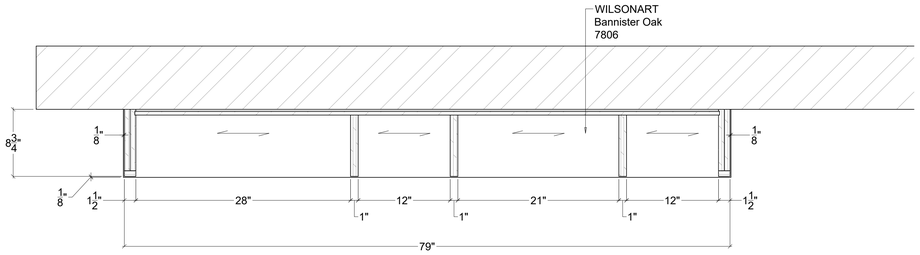

1 BUILT-IN SHELVING - SECTION
Scale: 1 1/2" = 1'

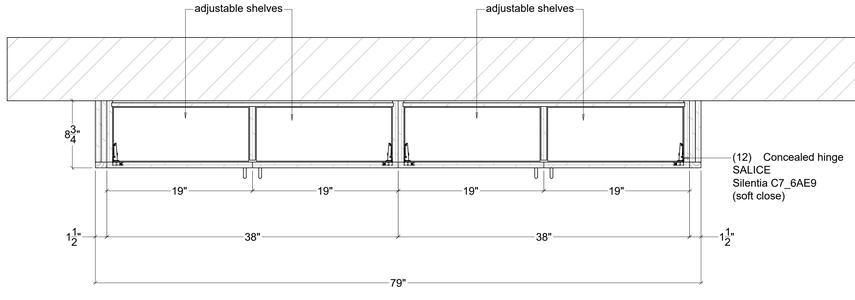

2 BUILT-IN SHELVING - SECTION
Scale: 1 1/2" = 1'

REVISIONS

CONSTRUCTION DOCUMENTS

LOS ANGELES COUNTY PUBLIC WORKS
HUNTINGTON PARK LIBRARY
6518 MILES AVE
HUNTINGTON PARK, CA 90255

NAC

NAC NO	161-23025
DRAWN	Author
CHECKED	Checker
DATE	07/24/2025

CASEWORK - LEVEL 2

BUILT-IN SHELVING 200

A9.57a

©2023 NAC Inc