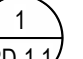

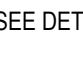



412 E. VanderBilt Way  
San Bernardino, CA 92408  
Phone: 909.890.3703  
Fax: 909.890.3770  
Email: cadd@designwesting.com

**DESIGN WEST ENGINEERING**  
MECHANICAL - ELECTRICAL - ENERGY CONSULTANTS

**RUHNAU  
CLARKE**  
ARCHITECTS

### GENERAL NOTES

- FOR LINE TYPES, SYMBOLS & ABBREVIATIONS SEE LEGEND ON PD-1.0.
- ROUTE HOT WATER LOOP AS CLOSE AS POSSIBLE TO ALL FIXTURES.
- NEW OR REPAIRED POTABLE WATER SYSTEMS SHALL BE DISINFECTED PRIOR TO USE, ACCORDING TO THE METHOD SET IN SECTION 609.9 OF THE CPC.
- CONTRACTOR SHALL PATCH FLOORS, WALLS & CEILINGS TO MATCH NEW CONSTRUCTION PER ARCHITECTS SPECIFICATIONS.
- SHUT-OFF VALVES SHALL BE PROVIDED ON ALL MAIN BRANCHES, RUNS TOO RISERS AND WHERE SHOWN ON DRAWING. LOCATE SHUT-OFF VALVES OVER T-BAR CEILING WHEN POSSIBLE. PROVIDE ACCESS PANELS WHEN SHUT-OFF VALVES ARE LOCATED OVER HARD LID CEILINGS.
- FOR PIPE SUPPORT, SEE DETAIL  PD-1.1
- FOR HOSE BIB, SEE DETAIL  PD-1.1
- FOR WATER HAMMER ARRESTOR, SEE DETAIL  PD-1.1
- FOR PIPE THRU RATED WALL, SEE DETAIL  PD-1.2

### CONSTRUCTION NOTES

- CONNECT NEW PIPE TO EXISTING PIPE AT P.O.C. FIELD VERIFY FOR EXACT LOCATION OF CONNECTION.
- NEW 3/4" CW & HW DN IN WALL TO PLUMBING FIXTURE
- NEW 3/4" CW & HW DN IN WALL TO PLUMBING FIXTURES
- NEW 3/4" HW DN IN WALL TO PLUMBING FIXTURE
- NEW 1-1/2" CW DN IN WALL TO FULLSIZE HEADER WITH SOV ON RISER BEHIND A.P.

### RATED ASSEMBLY LEGEND

 1-HR FIRE RATED WALL ASSEMBLY

PLUMBING REMODEL FLOOR PLAN - CW, HW & GAS

SCALE: 1/4" = 1'-0" 1

**RUHNAUCLARKE.COM**

**INDIAN SPRINGS HIGH SCHOOL HEALTH  
CENTER**  
INDIAN SPRINGS HIGH SCHOOL  
650 N DEL ROSA DR, SAN BERNARDINO, CA 92410  
SAN BERNARDINO CITY UNIFIED SCHOOL DISTRICT

**PLUMBING REMODEL  
FLOOR PLAN - CW, HW  
& GAS**

**P1-2.2**

PRINTED: 9/9/2025 5:08:15 PM  
PATH: \\SAN-BERN-2007\17502-Wellness\_Center\24-04-SBCUSD-15-15-WC-Mod-Exp\_Redisgn\_MEP\_Central\_A21.rvt

PROJECT No. :  
9/9/2025 5:08:15 PM

DRAWN BY:	JJO	CHECKED BY:	SJ
DELTA #	3	ADD	AFD
DATE	09/05/25	AFD	CCD
DELTA #		ADD	AFD
DATE		AFD	CCD
DELTA #		ADD	AFD
DATE		AFD	CCD

3775 TENTH STREET, RIVERSIDE CALIFORNIA 92503 (951) 684-4664 / 5751 PALMER WAY, SUITE C, CARLSBAD CALIFORNIA 92010 (760) 438-5899











LUMINAIRE SCHEDULE									
TYPE	VOLTS	WATTAGE	LAMPS	MOUNTING	FIXTURE DESCRIPTION	MFR.	CATALOG #	NOTES	
F1	277 V	15 W	LED 5000K 2,241 LUMENS	RECESSED	ZXZ LAY-IN FIXTURE WITH CENTER ELEMENT	LITHONIA	STAK-ZXZ-2000M-90CR1-35K-C OL-MINI-Z1-277-5LD-LN-2AIR2		
F1E	277 V	15 W	LED 5000K 2,241 LUMENS	RECESSED	ZXZ LAY-IN FIXTURE WITH CENTER ELEMENT AND CONNECTED TO LIGHTING INVERTER FOR EMERGENCY EGRESS.	LITHONIA	STAK-ZXZ-2000M-90CR1-35K-C OL-MINI-Z1-277-5LD-LN-2AIR2		
F2A	277 V	19 W	LED 5000K 1,500 LUMENS	RECESSED	RECESSED 2" LED DOWNLIGHT WITH 0-10V DIMMING BALLAST	GOTHAM LIGHTING	EV02-3515-AR-LSS-MMD-MVOL T-UZG-LN2AIR2		
F2AE	277 V	19 W	LED 5000K 1,500 LUMENS	RECESSED	RECESSED 2" LED DOWNLIGHT WITH 0-10V DIMMING BALLAST AND CONNECTED TO LIGHTING INVERTER FOR EMERGENCY EGRESS.	GOTHAM LIGHTING	EV02-3515-AR-LSS-MMD-MVOL T-UZG-LN2AIR2		
F2B	277 V	28 W	LED 5000K 2,094 LUMENS	RECESSED	RECESSED 2" LED DOWNLIGHT WITH 0-10V DIMMING BALLAST	GOTHAM LIGHTING	EV02-3520-AR-LSS-MMD-MVOL T-UZG-LN2AIR2		
F2BE	277 V	28 W	LED 5000K 2,094 LUMENS	RECESSED	RECESSED 2" LED DOWNLIGHT WITH 0-10V DIMMING BALLAST AND CONNECTED TO LIGHTING INVERTER FOR EMERGENCY EGRESS.	GOTHAM LIGHTING	EV02-3520-AR-LSS-MMD-MVOL T-UZG-LN2AIR2		
F3	277 V	26 W	LED 4000K 5,000 LUMENS	PENDANT	4" STRIP FIXTURE WITH WHITE FINISH, 0-10V DIMMING DRIVER AND MOUNTED WITH AIRCRAFT CABLE SUSPENSION	LITHONIA	CLX148-5000M-SFF-WDLMV OLT-G21-40K-80CR-WH-ZACHV M-10V CLXCE-148-50-SS-50-W-277- DP-1DS	BOTTOM OF FIXTURE MOUNTED AT 10'-0"	
F4	277 V	15 W	LED 5000K 1,584 LUMENS	RECESSED	RECESSED LINEAR LUMINAIRE WITH WHITE TRIM.	AXIS LIGHTING	TB3DILEDPT-04-X167XK2-CP R145-300-300-30-SS-SO-LN- AP-277P-1-CA367-D	VERIFY PATTERN PRIOR TO ORDERING. BOTTOM OF FIXTURE MOUNTING AT 10'-0".	
F5	277 V	55 W	LED 3500K 4,800 LUMENS	PENDANT	3" BEAM PENDANT FIXTURE IN X PATTERN, WITH ALUMINUM PAINTED FINISH, AIRCRAFT CABLE SUSPENSION AND 0-10V DIMMER.	AXIS LIGHTING	LS14-35-LUM-LUN-DB-W-SMT B9-FL-ACMNA	VERIFY MOUNTING PRIOR TO ORDERING. MAY BE ORDERED AS A CONTINUOUS RUN.	
F6A	277 V	26 W	LED 3500K 3,488 LUMENS	RECESSED	RECESSED LINEAR LUMINAIRE WITH WHITE TRIM.	CORONET	LS18-35-LUM-LUN-DB-W-SMT B9-FL-ACMNA	VERIFY MOUNTING PRIOR TO ORDERING. MAY BE ORDERED AS A CONTINUOUS RUN.	
F6AE	277 V	26 W	LED 3500K 3,488 LUMENS	RECESSED	RECESSED LINEAR LUMINAIRE WITH WHITE TRIM AND CONNECTED TO LIGHTING INVERTER FOR EMERGENCY EGRESS.	CORONET	LS18-35-LUM-LUN-DB-W-SMT B9-FL-ACMNA	VERIFY MOUNTING PRIOR TO ORDERING. MAY BE ORDERED AS A CONTINUOUS RUN.	
F6BE	277 V	32 W	LED 3500K 5,232 LUMENS	RECESSED	RECESSED LINEAR LUMINAIRE WITH WHITE TRIM AND CONNECTED TO LIGHTING INVERTER FOR EMERGENCY EGRESS.	CORONET	LS11-35-LUM-LUN-DB-W-SM T89-FL-ACMNA	VERIFY MOUNTING PRIOR TO ORDERING.	
F6C	277 V	21 W	LED 3500K 2,616 LUMENS	RECESSED	RECESSED LINEAR LUMINAIRE WITH WHITE TRIM.	CORONET	LS14-35-LUM-LUN-DB-W-SMT B9-FL-ACMNA	VERIFY MOUNTING PRIOR TO ORDERING.	
S1E	277 V	14 W	LED	WALL	MEDIUM WEDGE SCIENCE IN STONE FINISH AND CONNECTED TO LIGHTING INVERTER FOR EMERGENCY EGRESS.	LIGMAN	LEEDSULEW-30011-14W-T4-W3 O-SU-301077-F-2 DIM		
S2	277 V	6 W	LED	KNUCKLE	KNUCKLE MOUNT SIGN LIGHT IN BLACK FINISH, SOFT GLARE LENS AND 14.5 DEGREE HOOD.	HYDREL	SAF1LED-P1-80CR-30K-MVOL A-WH-IP27-P2F T-C3-BL		
S3	277 V	208 W	LED	POLE TOP	ARCHITECTURAL POLE TOP SHEBOOX-TYPE FIXTURE ON 25' POLE	VISIONAIRE LIGHTING	SGS-3174-128C-5-4K-LVN-UBO A-WH-IP27-P2F SNTS-55-25-128C-136-S1-W-HW		

## LUMINAIRE NOTES

- EQUALS SHALL BE CONSIDERED UPON SUBMITTAL REVIEW AND APPROVAL. PLEASE NOTE THAT IF AN ALTERNATE IS CONSIDERED.
- a. THE CONTRACTOR IS COMPLETELY AND SOLELY RESPONSIBLE FOR ALL ASPECTS OF THE SUBSTITUTION INCLUDING UPDATING CONSTRUCTION DOCUMENTS, OBTAINING APPROVALS AND PERMITS FROM LOCAL AUTHORITY, AND COORDINATING WITH ALL TRADES TO ENSURE CHANGES TO AFFECTED BUILDING SYSTEM ARE ACCOUNTED FOR AND ACCEPTABLE TO THE ENGINEERING TEAM. CONTRACTOR SHALL ENSURE SUBSTITUTED EQUIPMENT MEETS OR EXCEEDS DESIGN INTENT REGARDING RATINGS, PERFORMANCE, DIMENSIONAL, CLEARANCES, PHYSICAL, DIMENSIONS (MAXIMUM), WEIGHT LIMITATIONS, AND OTHER ASPECTS. PROOVING SUBSTITUTION IS SUITABLE TO THE APPLICATION, ENGINEERS WILL REVIEW THE RATING AND PERFORMANCE OF SUBSTITUTED EQUIPMENT ONLY AND WILL NOT ASSUME RESPONSIBILITY FOR SUBSTITUTION AT ANY LEVEL.
- b. IF CONTRACTOR CANNOT MAKE SUBSTITUTED EQUIPMENT WORK IN THIS PROJECT, CONTRACTOR SHALL REVERT TO REQUIREMENTS OF PERMITTED CONSTRUCTION DOCUMENTS AT THEIR EXPENSE.
- c. IT IS UNDERSTOOD BY ALL PARTIES THAT ANY SUBSTITUTIONS OF SPECIFIED PRODUCTS ARE DONE FOR THE PURPOSE OF COST SAVINGS TO THE OWNER. THEREFORE, ANY MATERIAL, SUBSTITUTION OR DEVIATIONS PROPOSED BY THE CONTRACTOR SHALL BE INCLUDED WITH THE INITIAL BID AND SHALL SHOW A LINE ITEMS CREDIT TO THE OWNER FOR EACH SUBSTITUTION IN LIEU OF SPECIFIED PRODUCTS.
- d. CONTRACTOR SHALL PROVIDE A POINT BY POINT PHOTOMETRIC STUDY FOR ALL AREAS WHERE ALTERNATE FIXTURES ARE SUBMITTED. LIGHT LEVELS WILL BE REVIEWED FOR COMPLIANCE WITH PROJECT REQUIREMENTS AND BASIS OF DESIGN VALUES.
2. THE FIXTURE SCHEDULE INDICATES DETAILED DESCRIPTION OF LIGHTING FIXTURES AND MANUFACTURERS CATALOG NUMBERS. IT SHALL BE THE CONTRACTORS RESPONSIBILITY TO DETERMINE THE CORRECT CEILING CONFIGURATION AND PROVIDE THE FIXTURES WITH ALL NECESSARY TRIMS AND MOUNTING HARDWARE SO THAT BOTH THE CEILING SYSTEM AND THE FIXTURE CONSTRUCTION MATCHES. PROVIDE SEISMIC HANGERS AS REQUIRED.
3. IT SHALL BE CONTRACTORS RESPONSIBILITY TO VERIFY THE EXACT LOCATION OF ALL LIGHTING FIXTURES AND TYPE OF CEILING WITH ARCHITECTURAL REFLECTED CEILING PLAN PRIOR TO ANY WORK. SEE ARCHITECTURAL REFLECTED CEILING PLAN PRIOR TO ANY WORK. SEE ARCHITECTURAL ELEVATION DRAWING FOR MOUNTING HEIGHTS OF WALL MOUNTED FIXTURES.
4. A JUNCTION BOX MUST BE PROVIDED WITH ALL EXIT LIGHTS CONNECTED TO MORE THAN ONE SET OF CONDUCTORS UNLESS THE EXIT LIGHT FIXTURE IS FURNISHED WITH AN APPROVED OUTLET BOX FOR THROUGH WIRING.
5. A COMPLETE TITLE 24 COMPLIANT LIGHTING CONTROL SYSTEM SHALL BE PROVIDED TO CONTROL ALL INTERIOR AND EXTERIOR LIGHTING SYSTEMS. REFER TO LIGHTING CONTROL DIAGRAMS, SCHEDULES AND DETAILS.
6. BATTERY PACK EMERGENCY TEST SWITCHES SHALL BE INTEGRAL TO LIGHT FIXTURE. COORDINATION OF SWITCH LOCATION IS REQUIRED WITH DESIGN TEAM IF INTEGRAL INSTALLATION IS NOT POSSIBLE.
7. FIXTURES DESIGNATED AS EMERGENCY SHALL BE SUPPLIED WITH INTEGRAL BATTERY PACK CAPABLE OF POWERING TWO T8 LAMPS FOR 90 MINUTES WITH A TOTAL LIGHT OUTPUT OF 1100 LUMENS OR ONE F31 BIAX FOR 90 MINUTES WITH A TOTAL LIGHT OUTPUT OF 520 LUMENS.
8. PROVIDE ALL REQUIRED MOUNTING HARDWARE ANCHORAGE AND SUPPORTS TO INSTALL LIGHTING FIXTURES.
9. PROVIDE SWIVEL BASE AND STEMS LENGTHS AS REQUIRED TO MOUNT THE PENDANT MOUNTED FIXTURES. THE INSTALLATION SHALL COMPLY WITH TITLE 24 SEISMIC AND APPLICABLE UBC REQUIREMENTS.
10. THE CONTRACTOR SHALL PROVIDE A COMPLETE AND OPERABLE LIGHTING SYSTEM AS PART OF THIS BUILDING CONTRACT.
11. SUSPENSION SYSTEM FOR LIGHT FIXTURES WHICH HAVE PASSED SHAKING TABLE TESTS APPROVED BY THE OFFICE OF THE STATE OF ARCHITECT, OR WHICH, AS INSTALLED, ARE FREE TO SWING A MINIMUM OF 45 FROM THE VERTICAL IN ALL DIRECTIONS WITHOUT CONTACTING OBSTRUCTIONS. SHALL BE ASSUMED TO COMPLY WITH THE LATERAL FORCE REQUIREMENTS FOR SECTION 205, PART 2.12 24, OR, UNLESS OF THE CABLE TYPE FREE SWING SUSPENSION SYSTEM SHALL HAVE A SAFETY WIRE OR CABLE ATTACHED TO THE FIXTURE AND STRUCTURE AT EACH SUPPORT CAPABLE OF SUPPORTING FOUR TIMES THE SUPPORTED LOAD.
12. FOR SUSPENDED AND SURFACE MOUNTED LIGHT FIXTURES, THE PRODUCT OF ICP NEED NOT EXCEED 12 FOR ANY VALUE OF 1.
13. IT SHALL BE THE CONTRACTORS RESPONSIBILITY TO VERIFY THAT THE FIXTURE BALLAST OR DRIVER VOLTAGE MATCHES THE CIRCUIT VOLTAGE SUPPLYING FIXTURE PRIOR TO ORDERING.
14. IT SHALL BE THE CONTRACTORS RESPONSIBILITY TO VERIFY BALLAST/DRIVER DIMENSION CONFIGURATION IS COMPATIBLE WITH CONTROLS BEING PROVIDED PRIOR TO ORDERING FIXTURES. EX. 2 WIRE, 3 WIRE, 4 WIRE, 0-10V, CAT 5, ETC.
15. LED LIGHT FIXTURES SHALL BE IN ACCORDANCE WITH IES, NFPA, UL, AS SHOWN ON THE DRAWINGS, AND AS SPECIFIED.
16. LED LIGHT FIXTURES SHALL BE REDUCTION OF HAZARDOUS SUBSTANCES (RHQS)-COMPLIANT.
17. LED DRIVERS SHALL INCLUDE THE FOLLOWING FEATURES UNLESS OTHERWISE INDICATED:
- MINIMUM EFFICIENCY: 85% AT FULL LOAD
  - MINIMUM OPERATING AMBIENT TEMPERATURE: -20 DEG C. (-4 DEG F)
  - INPUT VOLTAGE: 120 -277V (+10%) AT 60 HZ., UNLESS OTHERWISE INDICATED.
  - INTEGRAL SHORT CIRCUIT, OPEN CIRCUIT, AND OVERLOAD PROTECTION.
  - POWER FACTOR: >=0.95
  - TOTAL HARMONIC DISTORTION: <=20%,
  - COMPLY WITH FCC 47 CFR PART 15.
18. LED MODULES SHALL INCLUDE THE FOLLOWING FEATURES UNLESS OTHERWISE INDICATED:
- COMPLY WITH IES LM-79 AND LM-80 REQUIREMENTS.
  - MINIMUM CRI 80 AND COLOR TEMPERATURE 4000K UNLESS OTHERWISE SPECIFIED IN LUMINAIRE SCHEDULE.
  - MINIMUM RATED LIFE: 50,000 HOURS PER IES L70.
  - LIGHT OUTPUT LUMENS AS INDICATED IN THE LUMINAIRE SCHEDULE.
19. 23.
  - LED DOWNLIGHTS:
  - HOUSING, LED DRIVER, AND LED MODULE SHALL BE PRODUCTS OF THE SAME MANUFACTURER.
20. 24.
  - LED TROFFERS:
  - LED DRIVERS, MODULES, AND REFLECTOR SHALL BE ACCESSIBLE, SERVICEABLE, AND REPLACEABLE FROM BELOW THE CEILING.
  - HOUSING, LED DRIVER, AND LED MODULE SHALL BE PRODUCTS OF THE SAME MANUFACTURER.
21. ALL FIXTURES MOUNTED OUTDOORS SHALL BE LISTED FOR WET LOCATION
22. ALL REMOTE DRIVERS SHALL BE CONCEALED ABOVE CEILING OR PLACED IN A REMOTE LOCATION WHEN ATTIC SPACE IS NOT AVAILABLE.

LIGHTING CONTROLS SEQUENCE OF OPERATIONS						
LIGHT CONTROLS SHALL PERFORM AS FOLLOWS:						
ZONE	DELAY TO OFF (MIN)	ON/OFF METHOD	TECHNOLOGY	DAYLIGHTING	NOTES	
RESTROOMS	5	AUTO ON/AUTO OFF	DUAL	N/A	TUNE FOR NOISE, DO NOT LOCATE NEAR AIR VENTS	
OFFICE	10	AUTO ON TO 50%MANUAL ON TO 100%AUTO OFF	DUAL	DIM TO ALLOW 30 FC ON WORK SURFACE		
CONFERENCE ROOM	10	AUTO ON/AUTO OFF	DUAL	DIM TO ALLOW 35 FC ON WORK SURFACE		
NURSES STATION	10	AUTO ON/AUTO OFF	DUAL	DUAL		
CORRIDORS	15	TIME CLOCK ON/OFF, DIM TO 50% AFTER DELAY	DUAL	DIM TO ALLOW 10 FC ON WORK SURFACE		
LOBBY	15	AUTO ON/AUTO OFF	DUAL	DIM TO ALLOW 20 FC ON WORK SURFACE		
EXAM ROOM	15	AUTO ON/AUTO OFF	DUAL	DIM TO ALLOW 40 FC ON WORK SURFACE		
EXTERIOR LIGHTING	10	PHOTOCELL, ON/TIME CLOCK OFF, DIM TO 50% AFTER DELAY	INFRARED	N/A		
NOTE: FOR ZONES WITH PLUG CONTROLLERS, DELAY TO OFF SHALL BE THE SAME AS THE LIGHTING IN THAT ZONE.						

NOTE: FOR ZONES WITH PLUG CONTROLLERS, DELAY TO OFF SHALL BE THE SAME AS THE LIGHTING IN THAT ZONE

**PROJECT No. :**  
9/10/2025 1:38:25 PM

DRAWN BY: JM/ST      CHECKED BY: BK

DELTA # 1	DATE 09/05/25	<input type="checkbox"/> ADD	<input type="checkbox"/> AFO	<input type="checkbox"/> CCD	<input type="checkbox"/> REV
DELTA #	DATE	<input type="checkbox"/> ADD	<input type="checkbox"/> AFO	<input type="checkbox"/> CCD	<input type="checkbox"/> REV
DELTA #	DATE	<input type="checkbox"/> ADD	<input type="checkbox"/> AFO	<input type="checkbox"/> CCD	<input type="checkbox"/> REV
DELTA #	DATE	<input type="checkbox"/> ADD	<input type="checkbox"/> AFO	<input type="checkbox"/> CCD	<input type="checkbox"/> REV

**RUHNAUCLARKE.COM**


3775 TENTH STREET, RIVERSIDE CALIFORNIA 92501 (951) 684 4664 / 5751 PALMER WAY, SUITE C, CARLSBAD CALIFORNIA 92010 (760) 438 5899

# INDIAN SPRINGS HIGH SCHOOL HEALTH CENTER


**INDIAN SPRINGS HIGH SCHOOL  
650 N DEL ROSA DR, SAN BERNARDINO, CA 92410  
SAN BERNARDINO CITY UNIFIED SCHOOL DISTRICT**

## LUMINAIRE SCHEDULE

# E0-0.2

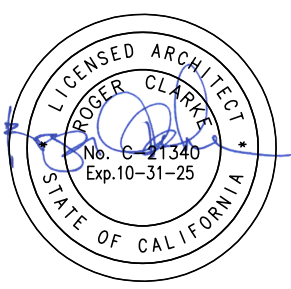

STAMPS

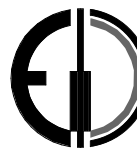

412 E. Vanderbilt Way  
San Bernardino, CA 92408  
Phone: 909.890.3700  
Fax: 909.890.3770  
Email: [codd@designwesteng.com](mailto:codd@designwesteng.com)

DESIGN WEST ENGINEERING  
MECHANICAL • ELECTRICAL • ENERGY CONSULTANTS

### CONSULTANT BRANDING


RUHNAU  
CLARKE  
ARCHITECTS

**INDIAN SPRINGS HIGH SCHOOL HEALTH CENTER:**







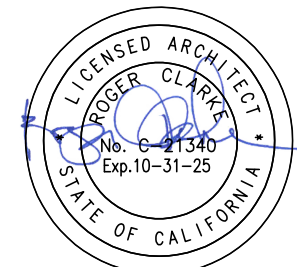

100



CONSULTANT BRANDIN

INDIAN SPRINGS HIGH SCHOOL HEALTH CENTER:



## CRITICAL NOTES

$$\frac{1}{AD}$$
 1-HR FIRE RATED WALL ASSEMBLY

9/10/2025 1:38:28 PM

DRAWN BY: JM/ST      CHECKED BY: BK

DELTA # 1	DATE 09/05/25	<input type="checkbox"/> ADD	<input type="checkbox"/> AFO	<input type="checkbox"/> CCD	<input type="checkbox"/> REV
DELTA #	DATE	<input type="checkbox"/> ADD	<input type="checkbox"/> AFO	<input type="checkbox"/> CCD	<input type="checkbox"/> REV
DELTA #	DATE	<input type="checkbox"/> ADD	<input type="checkbox"/> AFO	<input type="checkbox"/> CCD	<input type="checkbox"/> REV
DELTA #	DATE	<input type="checkbox"/> ADD	<input type="checkbox"/> AFO	<input type="checkbox"/> CCD	<input type="checkbox"/> REV

3725 TENTH STREET, RIVERSIDE CALIFORNIA 92501 (951) 684-4664 / 5751 PALMER WAY, SUITE C, CARLSBAD CALIFORNIA 92010 (760) 438-5800

## LIGHTING REMODEL CONTROL LAYOUT

24.094







MOUNTING: SURFACE FED FROM: HA2 NEMA: 1 AIC RATING: 10KAIC										LIGHTING INVERTER 'INV1' NEW LOCATION: ELECTRICAL ROOM										VOLTAGE: 277V 1PH 2W BUS: 20 A MAIN: MLO FEEDER: 20-B	
REMARKS	DESCRIPTION															DESCRIPTION															NOTES	
EM LTO - CLING INTERIOR	L	1	20 A	#10	130'	0.16	3/4"	1	










PRINTED: 9/10/2025 1:38:36 PM  
PATH: C:\BIM\200\17552\_Webless\_Center\24-094\_SCHOOL 15 HS WC Mod Exp - Revision.dwg - MEP Central - 21.dwg

PROJECT No. :  
9/10/2025 1:38:36 PM

DRAWN BY: JM/ST	CHECKED BY:	BK
DATE: 09/05/25	ADD	REV
DATE: 09/05/25	ADD	REV
DATE: 09/05/25	ADD	REV
DATE: 09/05/25	ADD	REV

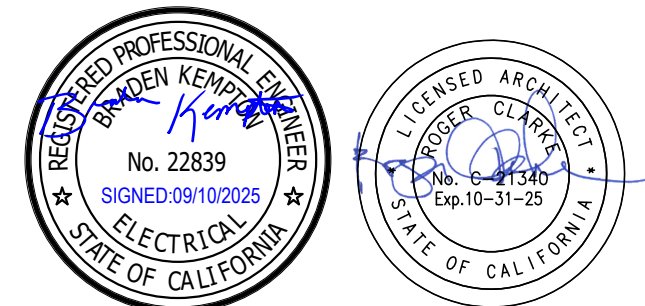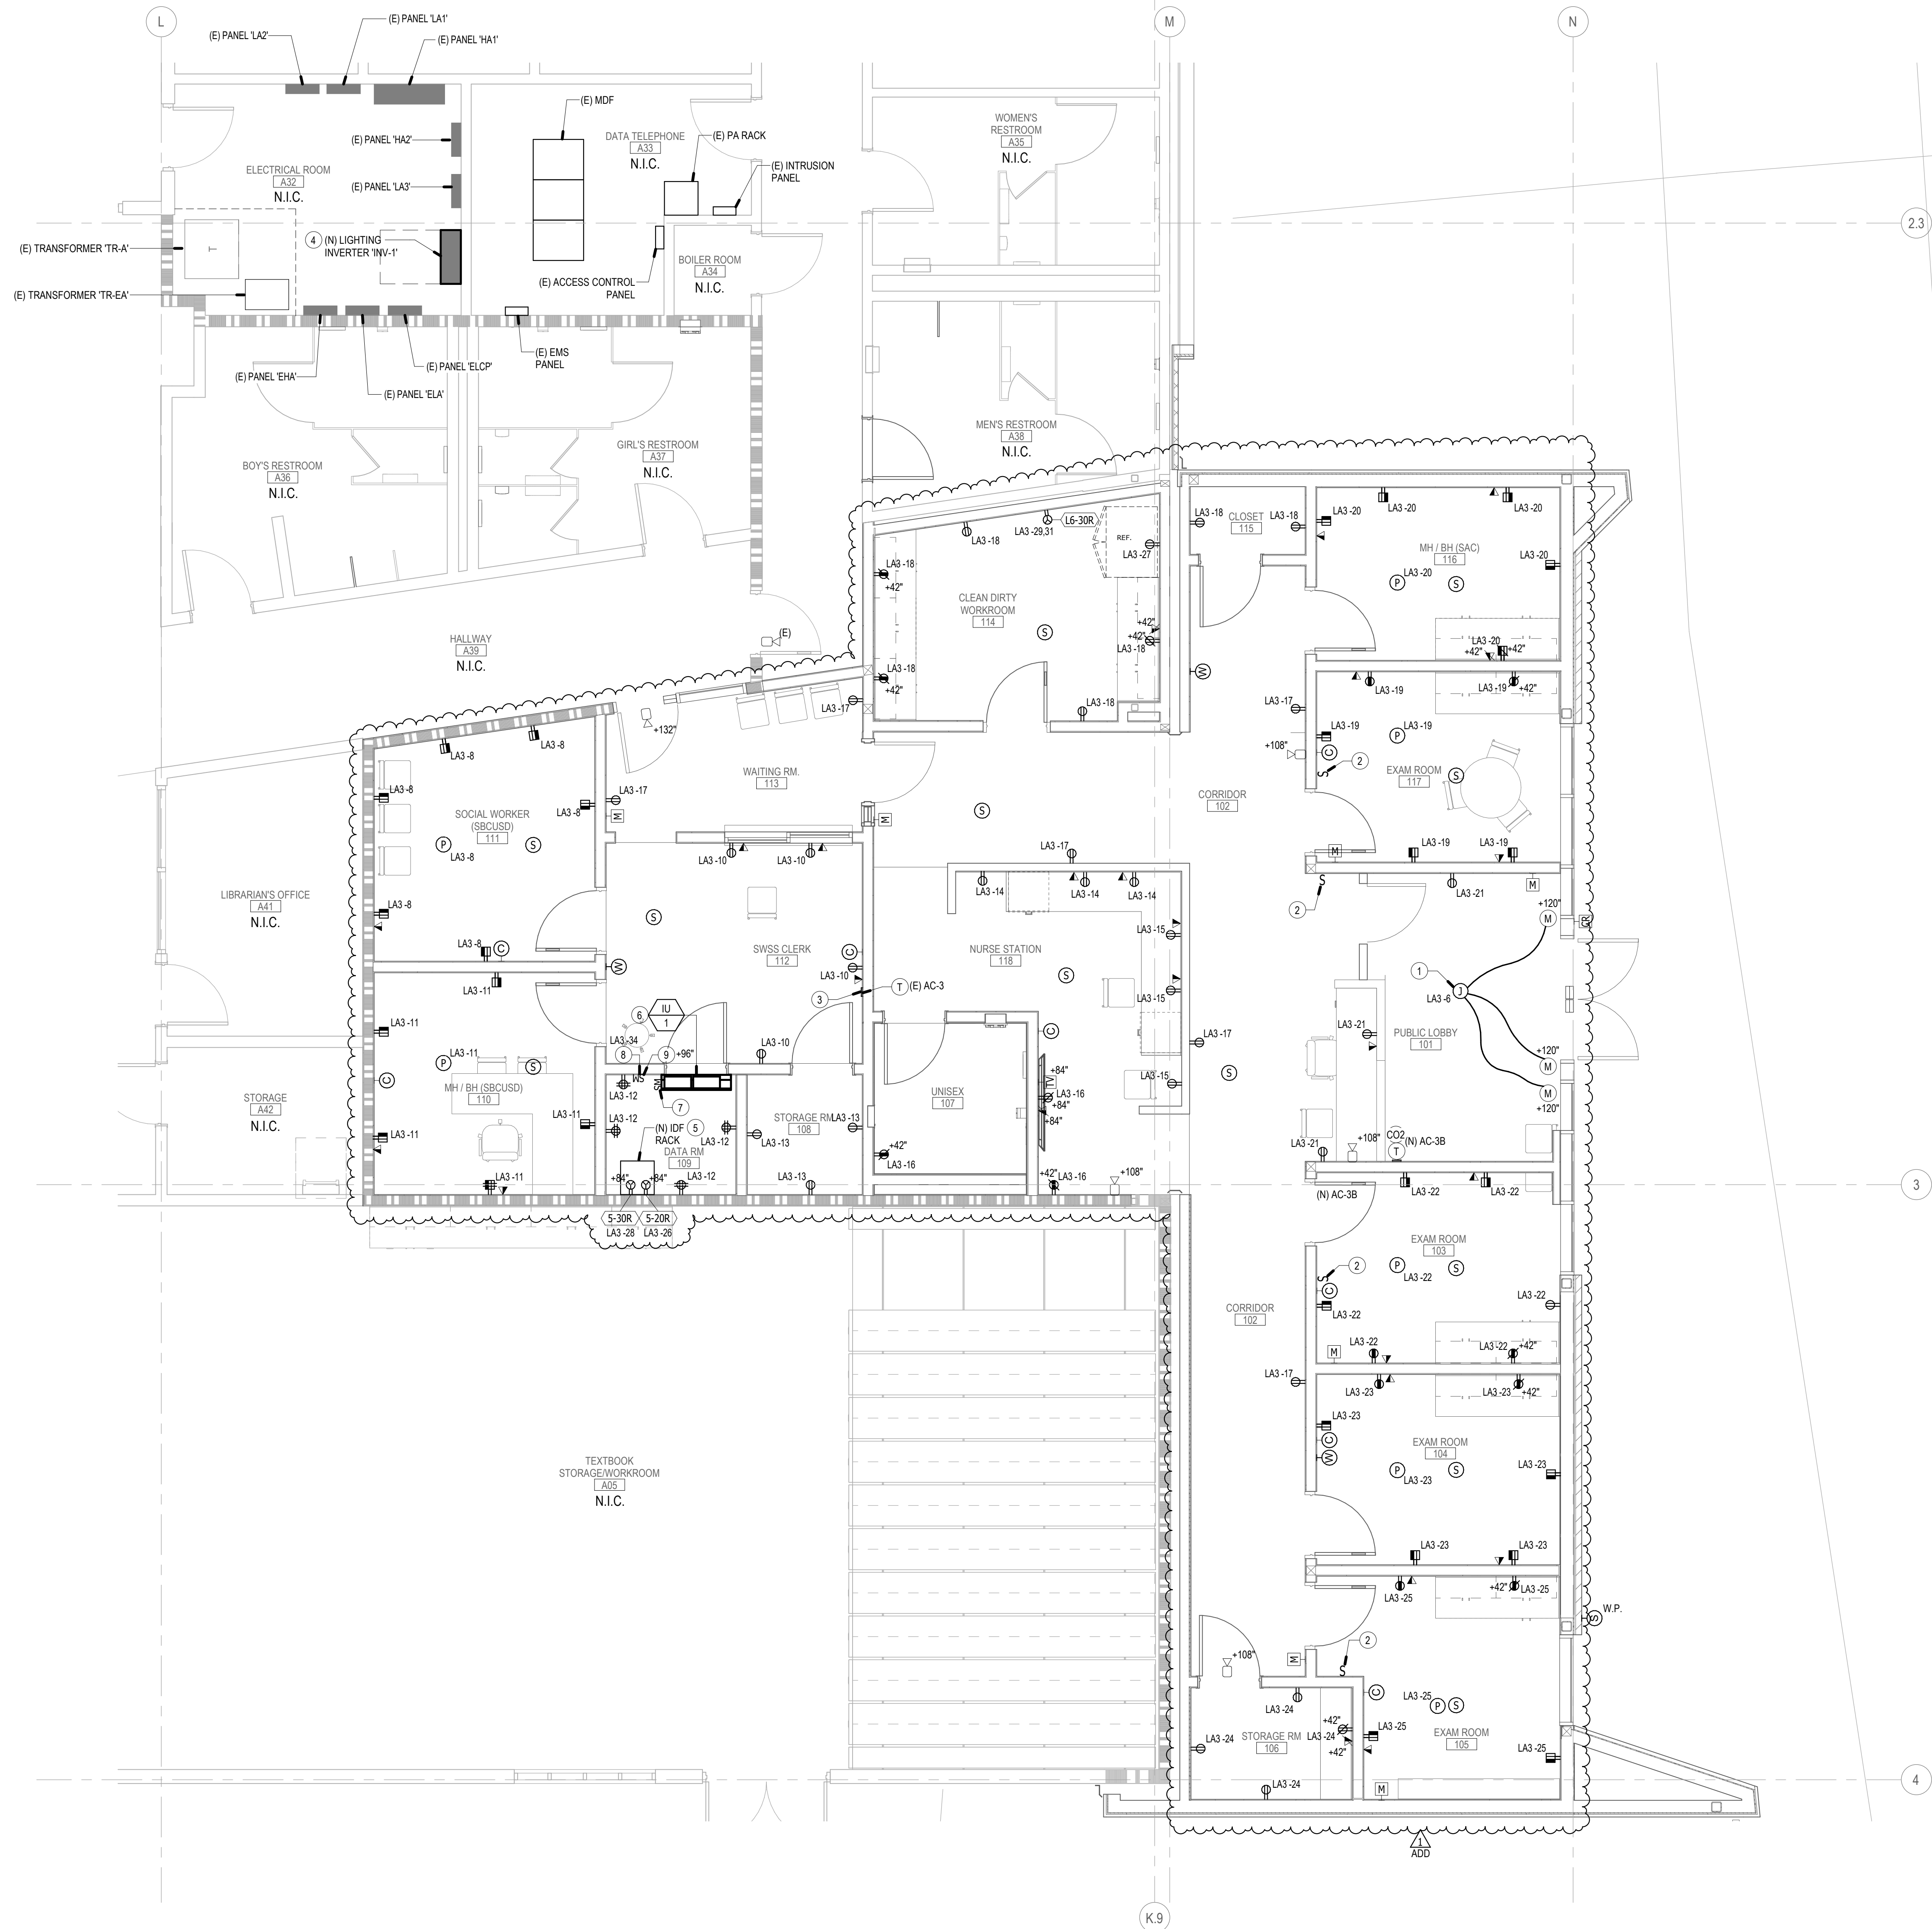

STAMPS

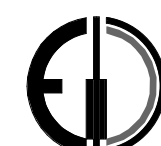

412 E. Vanderbilt Way  
San Bernardino, CA 92408  
Phone: 909.890.3703  
Fax: 909.890.3770  
Email: cadd@designwesteng.com

DESIGN WEST ENGINEERING  
MECHANICAL - ELECTRICAL - ENERGY CONSULTANTS

CONSULTANT BRANDING

RUHNAU  
CLARKE  
ARCHITECTS

## GENERAL NOTES

- REFER TO 'GENERAL NOTES' ON ELECTRICAL LEGENDS AND NOTES SHEET.
- COORDINATE POWER AND DATA DEVICE LOCATIONS, AND DEVICE PLATE COLOR WITH ARCHITECT.
- NO PIPING, DUCTS OR EQUIPMENT FOREIGN TO ELECTRICAL EQUIPMENT SHALL BE PERMITTED TO BE LOCATED WITHIN A SPACE EXTENDING FROM FLOOR TO A HEIGHT OF 6' ABOVE THE EQUIPMENT. CEC 110.26(E)1.
- ALL EXTERIOR ELECTRICAL EQUIPMENT SHALL BE NEMA 3R.
- FOR ANY FIRE WALL PENETRATIONS 2" AND UNDER:  
REFER TO DETAIL:

## CONSTRUCTION NOTES

- PROVIDE A DEDICATED 120VAC CIRCUIT FOR WINDOW ROLLER-SHADE MOTORS.
- PROVIDE WALL SWITCH TO CONTROL ROLLER-SHADES IN THIS ROOM.
- NEW LOCATION OF EXISTING THERMOSTAT. EXTEND CONDUIT AND LOW VOLTAGE CABLING AS NECESSARY FOR A COMPLETE RECONNECTION TO EXISTING ROOF AC UNIT. CONDUIT AND CABLING SIZES TO MATCH EXISTING.
- PROVIDE LIGHTING INVERTER MOUNTED ON WALL.  
REFER TO DETAIL:
- PROVIDE IDF RACK ON WALL.  
REFER TO DETAIL:
- INDOOR UNIT SHALL BE POWERED BY OUTDOOR UNIT. REFER TO MANUFACTURER'S SPECIFICATIONS FOR WIRING REQUIREMENTS.
- PROVIDE NEMA 1 208V 2P MOTOR RATED SNAP SWITCH.
- PROVIDE A DEDICATED CIRCUIT FOR CONDENSATE PUMP.
- PROVIDE NEMA 1 120V 1P MOTOR RATED SNAP SWITCH.

## RATED ASSEMBLY LEGEND

POWER REMODEL FLOOR PLAN

SCALE: 1/4" = 1'-0"

1

RUHNAUCLARKE.COM

3775 TENTH STREET, RIVERSIDE CALIFORNIA 92503 (951) 684-4664 / 5751 PALMER WAY, SUITE C, CARLSBAD CALIFORNIA 92008 (760) 438-5899

INDIAN SPRINGS HIGH SCHOOL HEALTH  
CENTER

650 N DEL ROSA DR, SAN BERNARDINO, CA 92410  
SAN BERNARDINO CITY UNIFIED SCHOOL DISTRICT

POWER & SIGNAL  
REMODEL PLAN



E1-2.1




PRINTED: 9/10/2025 1:38:37 PM  
PATH: \\BH-SAN-200\\17552-Wellness\_Center\\24-04-SBC-USD-15-16-WC-Mod Exp\_Redisgn\_MEP\_Central\_A21.rvt

PROJECT No. :  
9/10/2025 1:38:37 PM

DRAWN BY: J.M./ST	CHECKED BY:	B.K.
DELTA # 1 DATE 09/05/25	<input type="checkbox"/> ADD <input type="checkbox"/> AFO <input type="checkbox"/> CDD <input type="checkbox"/> REV	<input type="checkbox"/> CDD <input type="checkbox"/> REV
DELTA # 1 DATE	<input type="checkbox"/> ADD <input type="checkbox"/> AFO <input type="checkbox"/> CDD <input type="checkbox"/> REV	<input type="checkbox"/> CDD <input type="checkbox"/> REV
DELTA # 1 DATE	<input type="checkbox"/> ADD <input type="checkbox"/> AFO <input type="checkbox"/> CDD <input type="checkbox"/> REV	<input type="checkbox"/> CDD <input type="checkbox"/> REV

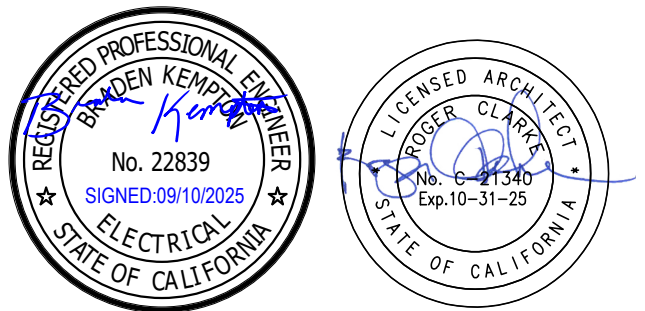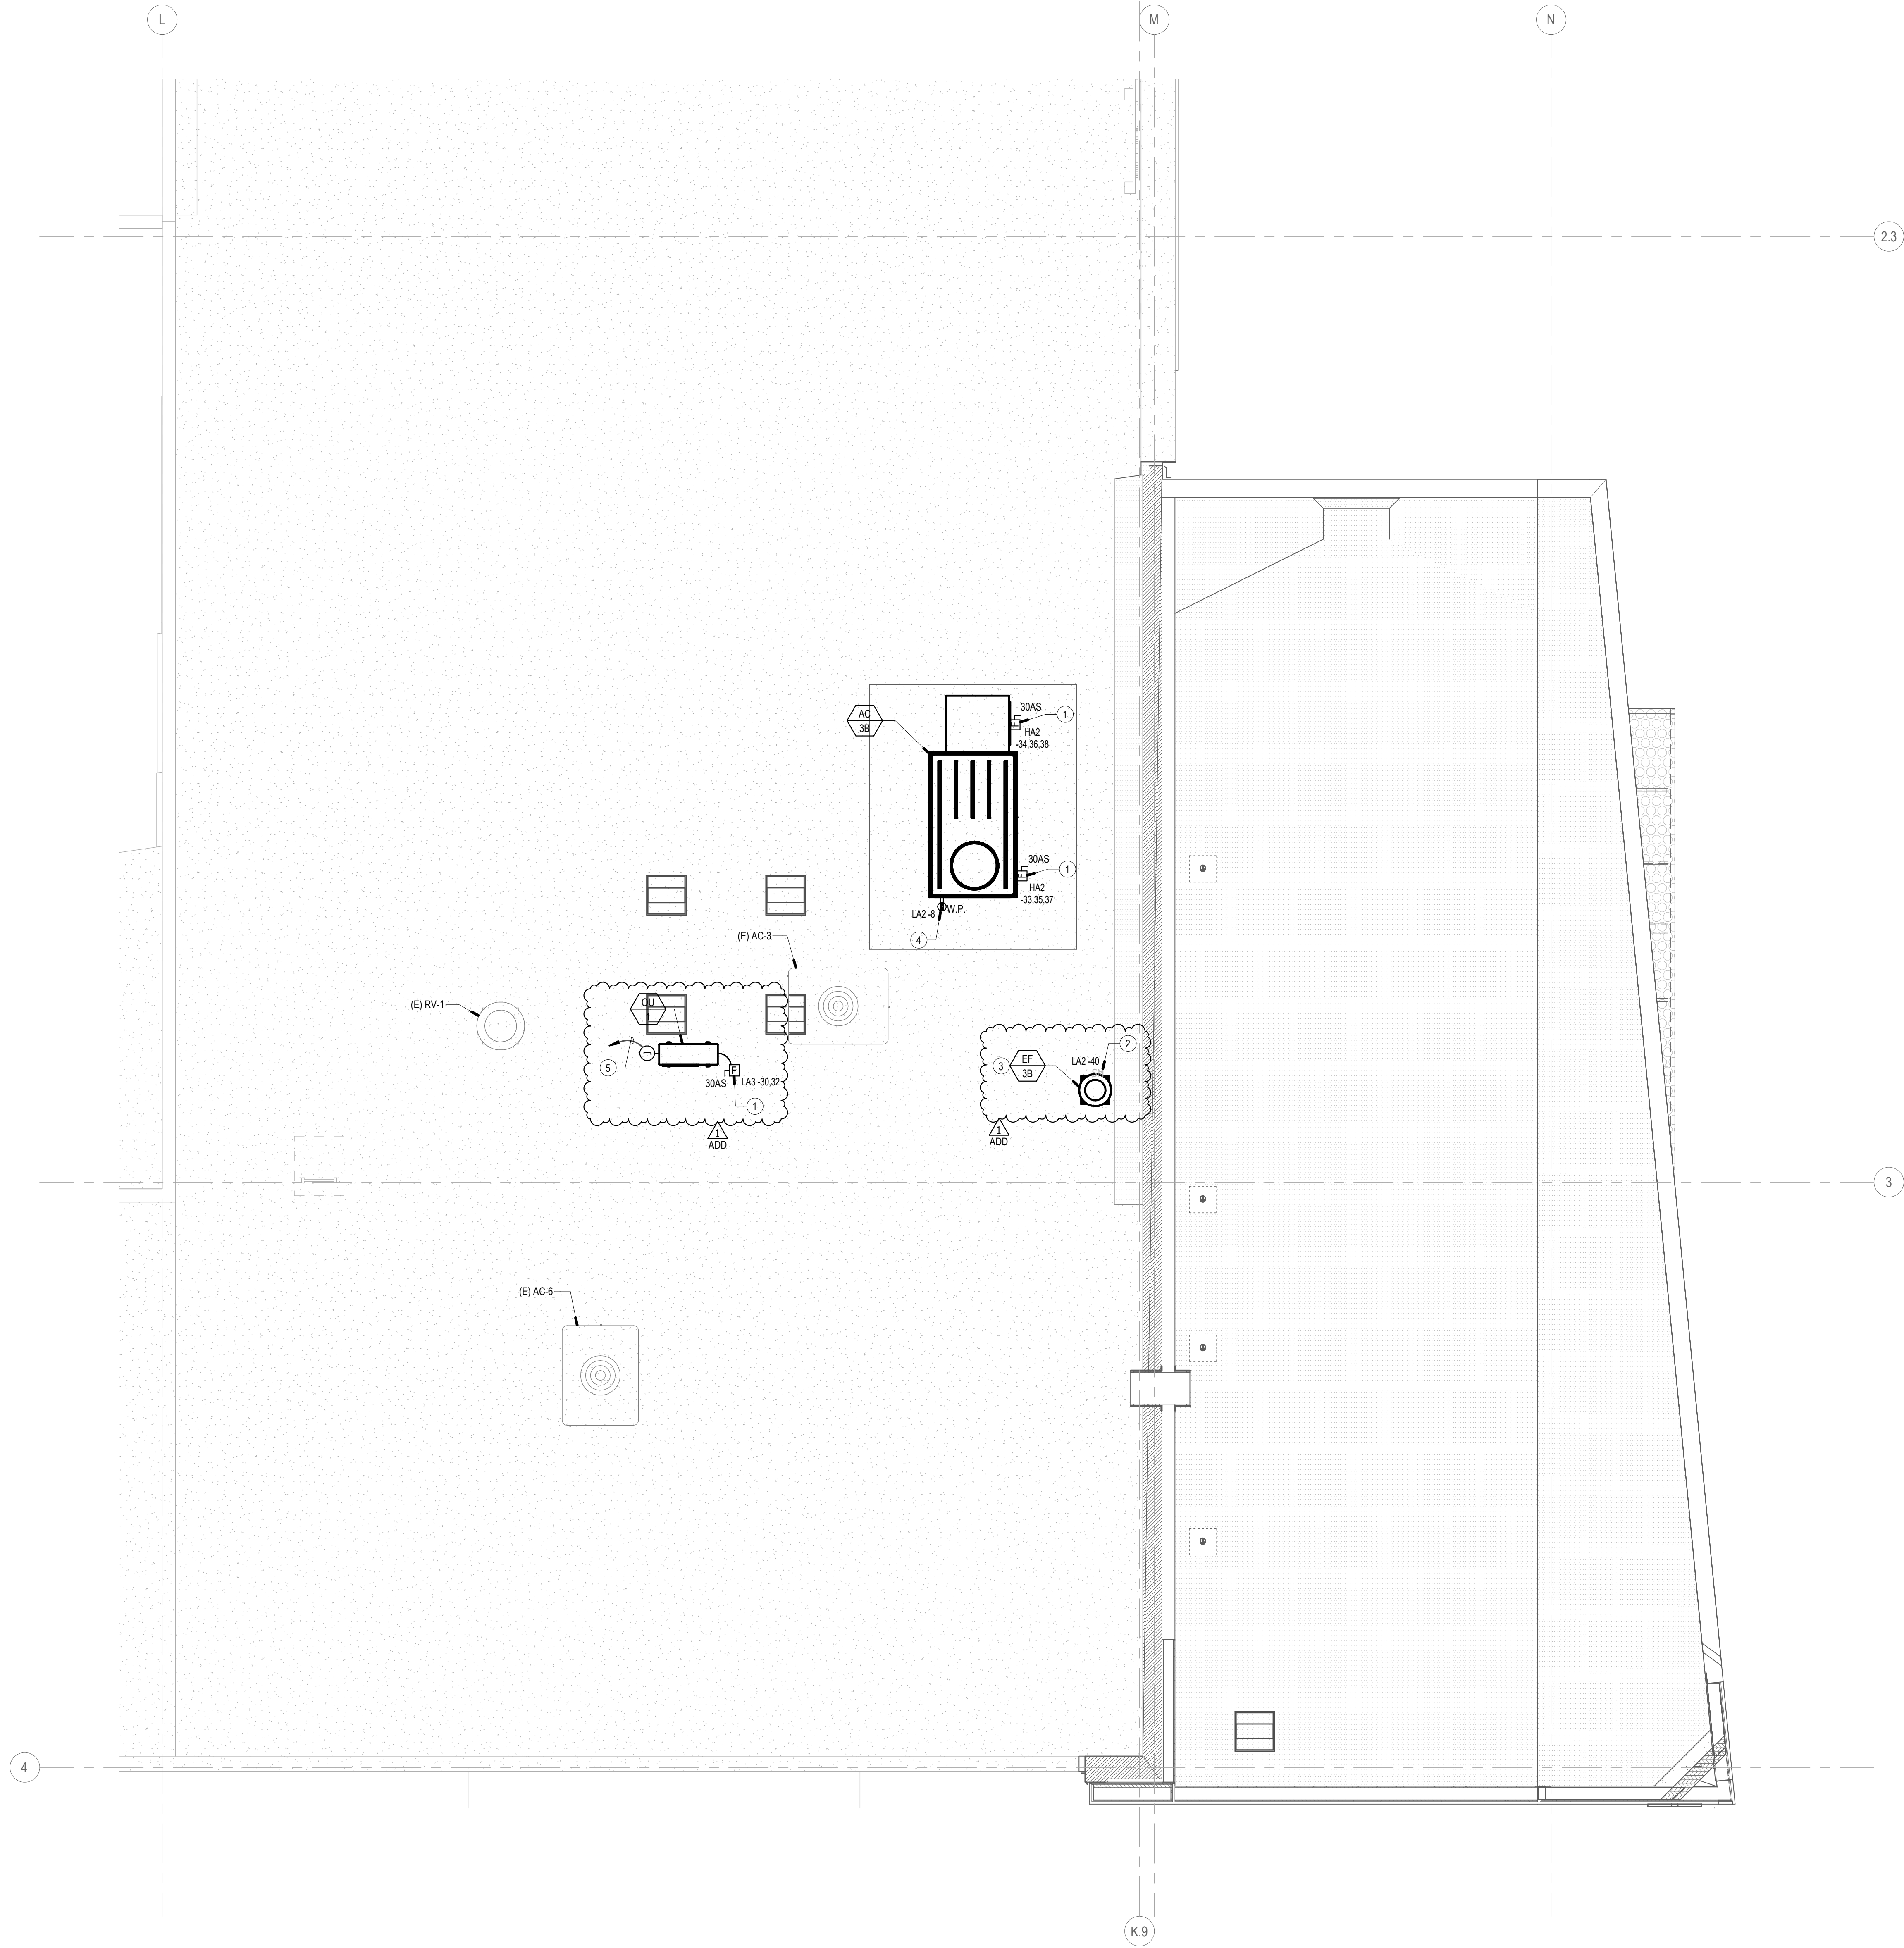

AGENCY APPROVAL  
FOR THE: \*\*\*\*\*

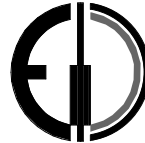

412 E. Vanderbilt Way  
San Bernardino, CA 92408  
Phone: 909.890.3703  
Fax: 909.890.3770  
Email: cadd@designwesteng.com

DESIGN WEST ENGINEERING  
MECHANICAL - ELECTRICAL - ENERGY CONSULTANTS

CONSULTANT BRANDING

RUHNAU  
CLARKE  
ARCHITECTS

### GENERAL NOTES

- REFER TO 'GENERAL NOTES' ON ELECTRICAL LEGENDS AND NOTES SHEET.
- ALL CONDUITS SHALL BE INSTALLED IN THE CEILING BELOW U.O.N.
- REFER TO MECHANICAL AND PLUMBING PLANS FOR THE EXACT LOCATION OF HVAC EQUIPMENT AND ADDITIONAL WIRING REQUIREMENTS.
- PROVIDE DUCT DETECTOR'S F.D. POWER AND CONNECTIONS AS INDICATED ON MECHANICAL DRAWINGS.
- PROVIDE FLEXIBLE SEAL TYPE CONDUIT FOR CONNECTION TO ALL HVAC EQUIPMENT.
- MOUNT ALL DISCONNECT SWITCHES INDEPENDENT OF THE HVAC UNIT.
- ALL EXTERIOR ELECTRICAL EQUIPMENT SHALL BE NEMA 3R.
- ALL EXTERIOR RECEPTACLE OUTLETS SHALL BE GFCI TYPE.
- PROVIDE HEAVY DUTY DISCONNECT SWITCHES WITH DUAL ELEMENT FUSES TO MATCH MOTOR H.P. RATING.

### CONSTRUCTION NOTES

- PROVIDE AND INSTALL H.D. WEATHERPROOF NEMA 3R RATED FUSED DISCONNECT MOUNTED ON UNISTRUT RACK. FUSING PER MECHANICAL EQUIPMENT MANUFACTURERS REQUIREMENTS. VERIFY EXACT LOCATION AND REQUIREMENTS WITH MECHANICAL CONTRACTOR.  
REFER TO DETAIL:
- PROVIDE 120V 1P NEMA 3R MOTOR RATED SNAP SWITCH.
- EXHAUST FAN SHALL BE CONTROLLED BY LIGHT SWITCH IN RESTROOM BELOW.
- PROVIDE WEATHER PROOF GFCI WORK OUTLET AS REQUIRED WITHIN 25'-0" OF MECHANICAL EQUIPMENT. EXTEND EXISTING RECEPTACLE CIRCUIT FROM NEAREST ROOF RECEPTACLE AS NECESSARY FOR A COMPLETE CIRCUIT.  
REFER TO DETAIL:
- PROVIDE 3/4" CONDUIT TO INDOOR UNIT WITH CONTROL WIRING. REFER TO MECHANICAL SPECIFICATIONS FOR WIRING REQUIREMENTS.

ADD

ELECTRICAL ROOF PLAN

SCALE: 1/4" = 1'-0"

1

RUHNAUCLARKE.COM

3775 TENTH STREET, RIVERSIDE CALIFORNIA 92503 (951) 684-4664 / 5751 PALMER WAY, SUITE C, CARLSBAD CALIFORNIA 92010 (760) 438-5899

INDIAN SPRINGS HIGH SCHOOL HEALTH  
CENTER


INDIAN SPRINGS HIGH SCHOOL  
650 N DEL ROSA DR, SAN BERNARDINO, CA 92410  
SAN BERNARDINO CITY UNIFIED SCHOOL DISTRICT

ELECTRICAL REMODEL  
ROOF PLAN

E1-2.2

INDIAN SPRINGS HIGH SCHOOL HEALTH CENTER:



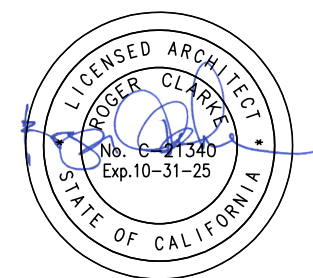

STAM



DESIGN WEST ENGINEERING  
MECHANICAL • ELECTRICAL • ENERGY CONSULTANTS

CONSULTANT BRANDIN

RUHNAU  
CLARKE  
ARCHITECTS


## GENERAL NOTES

- |    |  |
|----|--|
| 1. | COORDINATE LIGHT FIXTURE LOCATIONS AND LIGHT SWITCH LOCATIONS. COLOR, AND STYLE WITH ARCHITECT.  |
| 2. | WHERE OCCUPANCY SENSORS ARE SHOWN ON PLANS, VERIFY WATTAGE AND COVERAGE OF PRODUCT PROVIDED IS ADEQUATE FOR SPACE TO BE CONTROLLED. COVERAGE IS TO BE ADJUSTED TO AVOID ACCIDENTAL ACTIVATION OUTSIDE OF AREA. VERIFY WIRING REQUIREMENTS TO ADDITIONAL SENSORS, ROOM CONTROLLERS, RELAY PACKS, ETC WITH PRODUCT BEING PROVIDED. OCCUPANCY SENSORS SHALL NOT BE LOCATED WITHIN FOUR FEET OF ANY HVAC DIFFUSER. |
| 3. | WHERE DAYLIGHT SENSORS ARE SHOWN ON PLANS, LOCATION SHOWN IS DIAGRAMMATICAL. VERIFY LOCATION IS PER MANUFACTURER RECOMMENDATIONS BASED ON TYPE OF SENSOR (OPEN/CLOSED LOOP). VERIFY WIRING REQUIREMENTS TO ADDITIONAL SENSORS, ROOM CONTROLLERS, RELAY PACKS, ETC WITH PRODUCT BEING PROVIDED.   |
| 4. | PROVIDE NON-SWITCHED HOT POWER WIRE TO BATTERY PACK CHARGING/SENSOR IN FIXTURE.  |
| 5. | REFER TO LIGHTING CONTROL DETAILS FOR WIRING AND CONDUIT REQUIREMENTS. CONTRACTOR SHALL PROVIDE ALL WIRING AND CONDUITS REQUIRE BY MANUFACTURER TO FIXTURES AND CONTROLS.  |
| 6. | FINAL MOUNTING LOCATIONS OF ALL OCCUPANCY AND PHOTOCELL DEVICES SHALL COORDINATED WITH MANUFACTURERS RECOMMENDATIONS AND FIELD ADJUSTED WITH REPRESENTATIVE AS NECESSARY.  |

## CONSTRUCTION NOTES

- ① ROUTE THROUGH LIGHT SYSTEM FOR PHOTOCELL AND TIME CLOCK CONTROL. VERIFY SETTINGS WITH DISTRICT MAINTENANCE PRIOR TO SYSTEM START UP.
- ② PRIMARY DAYLIGHTING ZONE.
- ③ SECONDARY DAYLIGHTING ZONE.
- ④ TOTAL INSTALLED WATTS IN PRIMARY SIDELIT DAYLIT ZONE DOES NOT EXCEED 120 WATTS, THEREFORE, AUTOMATIC DAYLIGHTING CONTROLS ARE NOT REQUIRED. SECTION 13.01(D)
- ⑤ TOTAL INSTALLED WATTS IN SECONDARY SIDELIT DAYLIT ZONE DOES NOT EXCEED 120 WATTS, THEREFORE, AUTOMATIC DAYLIGHTING CONTROLS ARE NOT REQUIRED. SECTION 13.01(D)

## RATED ASSEMBLY LEGEND

 1-HR FIRE RATED WALL ASSEMBLY

## LIGHTING REMODEL PLAN

SCALE: 1/4" = 1'-0"


--	--

**INDIAN SPRINGS HIGH SCHOOL HEALTH  
CENTER**

**INDIAN SPRINGS HIGH SCHOOL**  
**650 N DEL ROSA DR, SAN BERNARDINO, CA 92410**  
**SAN BERNARDINO CITY UNIFIED SCHOOL DISTRICT**


### E1-3.1

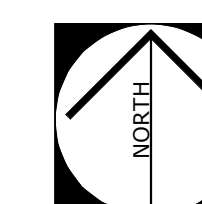

PROJECT No. :

DRAWN BY: JM/ST      CHECKED BY: BK


DELTA # 1	DATE 09/05/25	<input type="checkbox"/> ADD	<input type="checkbox"/> AFO	<input type="checkbox"/> CCD	<input type="checkbox"/> REV
DELTA #	DATE	<input type="checkbox"/> ADD	<input type="checkbox"/> AFO	<input type="checkbox"/> CCD	<input type="checkbox"/> REV
DELTA #	DATE	<input type="checkbox"/> ADD	<input type="checkbox"/> AFO	<input type="checkbox"/> CCD	<input type="checkbox"/> REV
DELTA #	DATE	<input type="checkbox"/> ADD	<input type="checkbox"/> AFO	<input type="checkbox"/> CCD	<input type="checkbox"/> REV

**RUHNAUCLARKE.COM**

3725 TENTH STREET, RIVERSIDE, CALIFORNIA 92501 (951) 684-4664 / 5751 PALMER WAY, SUITE C, CARLSBAD, CALIFORNIA 92010 (760) 438-5800

INDIAN SPRINGS HIGH SCHOOL HEALTH CENTER:



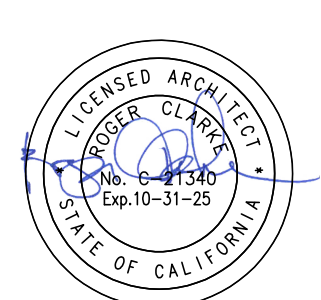




CONSULTANT BRANDIN

**INDIAN SPRINGS HIGH SCHOOL HEALTH CENTER:**[illegible]



--	--

## E1-3.2

DRAWN BY: JM/ST  
DELTA # 1 DATE 09/05  
DELTA # DATE  
DELTA # DATE  
DELTA # DATE

3775 TENTH STREET, RIVERSIDE CALIFORNIA 92501 (951) 684 4664 / 5751 PALMER WAY, SUITE C, CARLSBAD CALIFORNIA 92010 (760) 438 5899



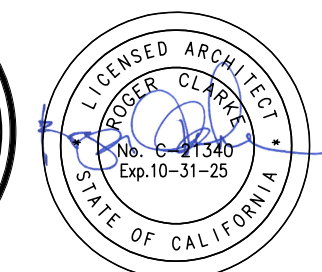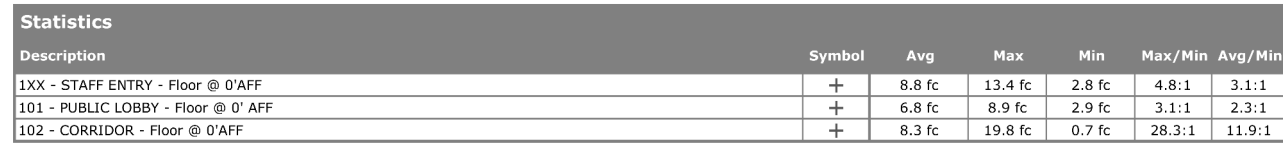

STAMP



CONSULTANT BRANDIN

RUHNAU  
CLARKE  
ARCHITECTS

## EMERGENCY EGRESS PHOTOMETRY PLAN

## E1-3.3

DRAWN BY: JM/ST      CHECKED BY: BK

DELTA # 1	DATE 09/05/25	<input type="checkbox"/> ADD	<input type="checkbox"/> AFO	<input type="checkbox"/> CCD	<input type="checkbox"/> REV
DELTA #	DATE	<input type="checkbox"/> ADD	<input type="checkbox"/> AFO	<input type="checkbox"/> CCD	<input type="checkbox"/> REV
DELTA #	DATE	<input type="checkbox"/> ADD	<input type="checkbox"/> AFO	<input type="checkbox"/> CCD	<input type="checkbox"/> REV
DELTA #	DATE	<input type="checkbox"/> ADD	<input type="checkbox"/> AFO	<input type="checkbox"/> CCD	<input type="checkbox"/> REV

**RUHNAUCLARKE.COM**

3725 TENTH STREET, RIVERSIDE CALIFORNIA 92501 (951) 684-4664 / 5751 PALMER WAY, SUITE C, CARLSBAD CALIFORNIA 92010 (760) 438-5861

**INDIAN SPRINGS HIGH SCHOOL HEALTH  
CENTER**

**INDIAN SPRINGS HIGH SCHOOL  
650 N DEL ROSA DR, SAN BERNARDINO, CA 92410  
SAN BERNARDINO CITY UNIFIED SCHOOL DISTRICT**

24.094
















1. FORWARD AND FRONT APPROACH FOR DEVICE MOUNTED ABOVE COUNTER ASSUMES THAT DIRECTLY BELOW THE DEVICE THE COUNTER HAS A 30" MINIMUM WIDE X 27" MINIMUM HIGH X 19" MINIMUM DEEP CLEAR OPENING. (CBC SECTIONS 11B-306 & 11B-308)

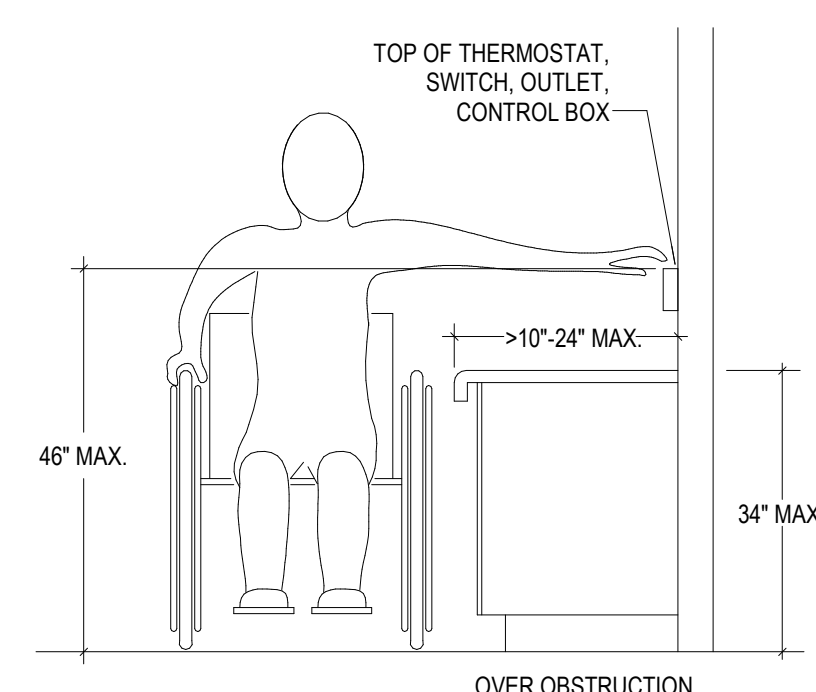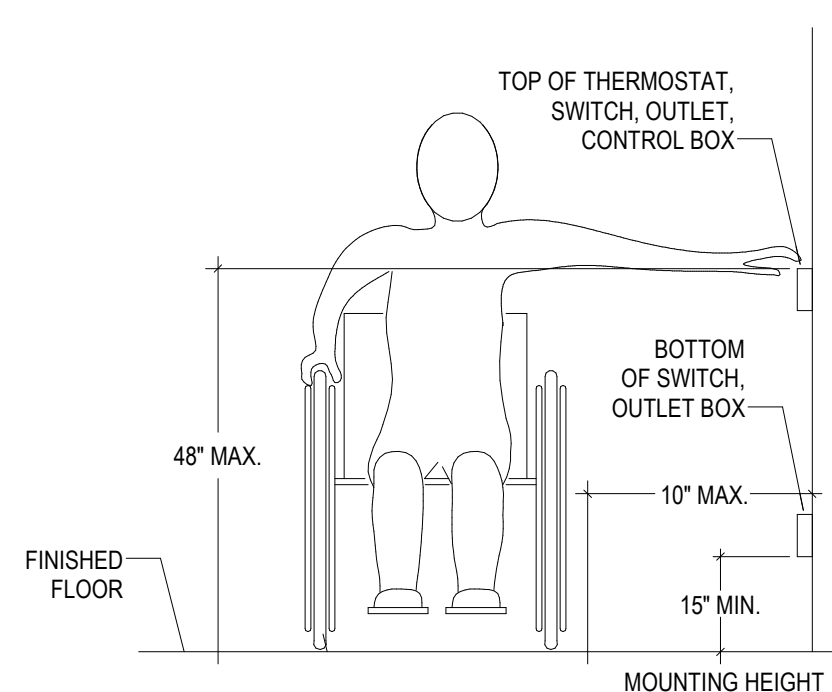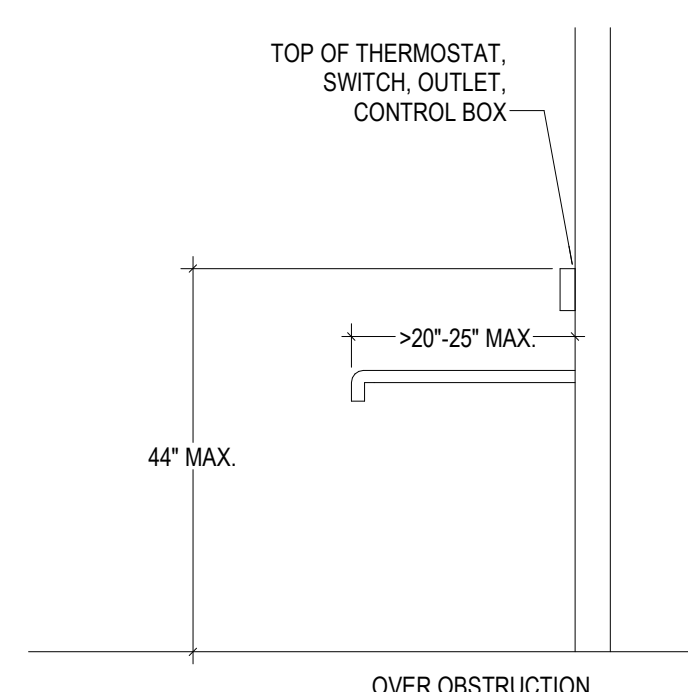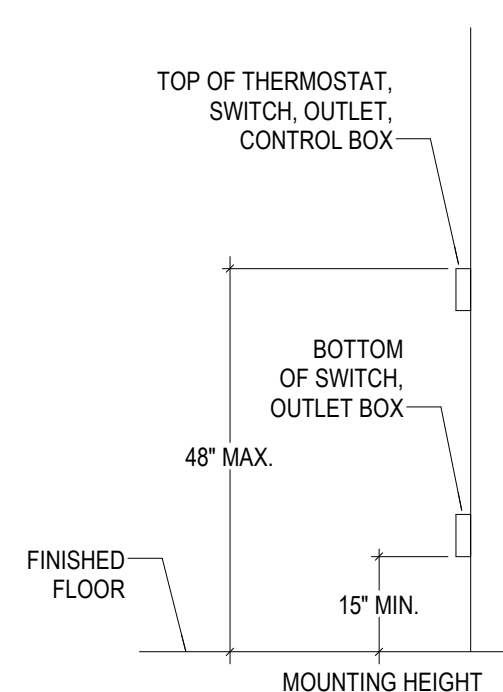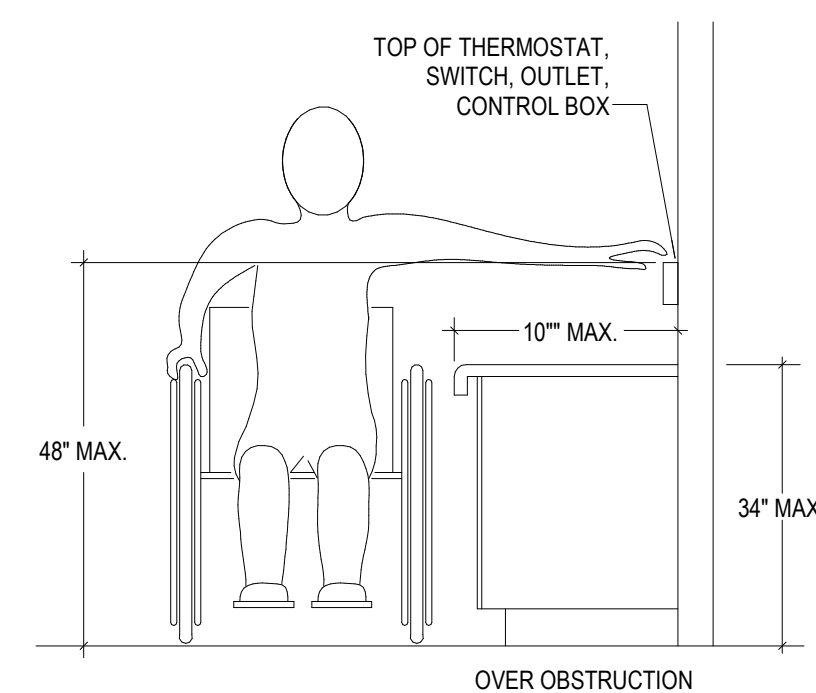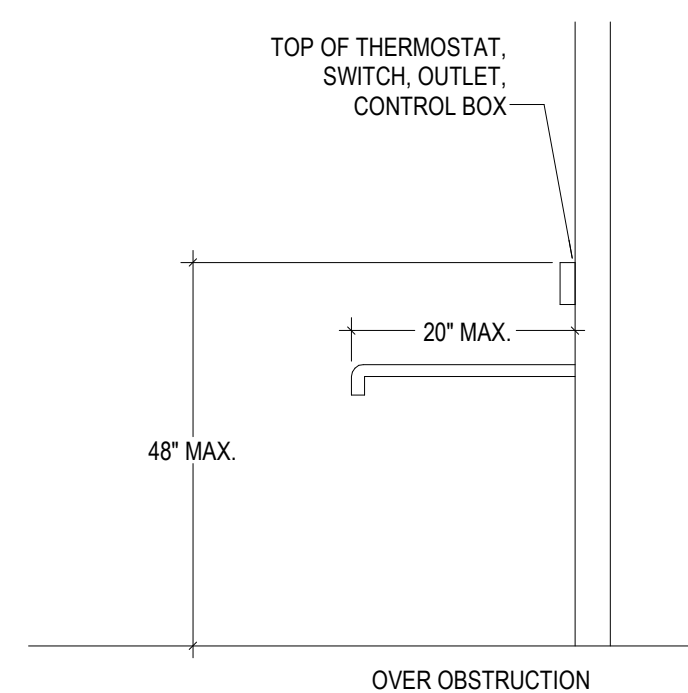


### SWITCH MOUNTING DETAIL

1

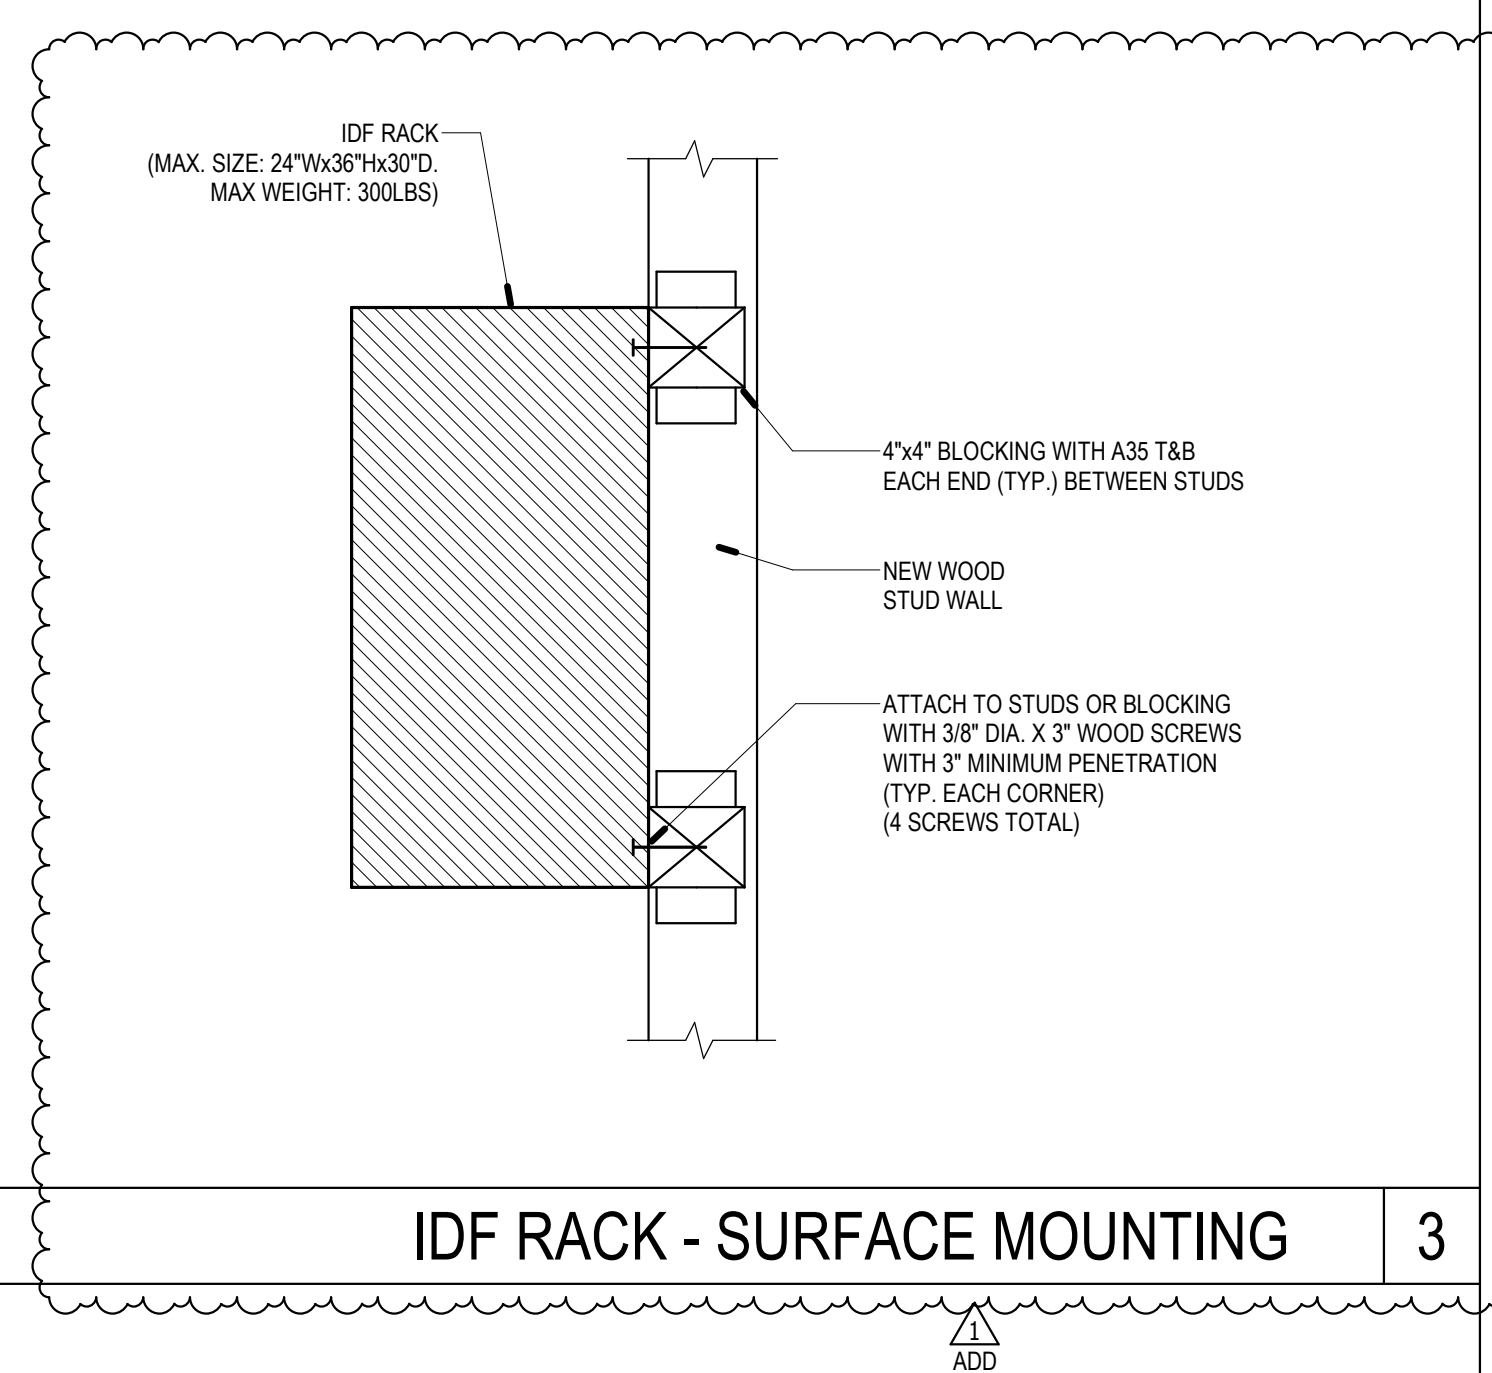

## IDF RACK - SURFACE MOUNTING

3

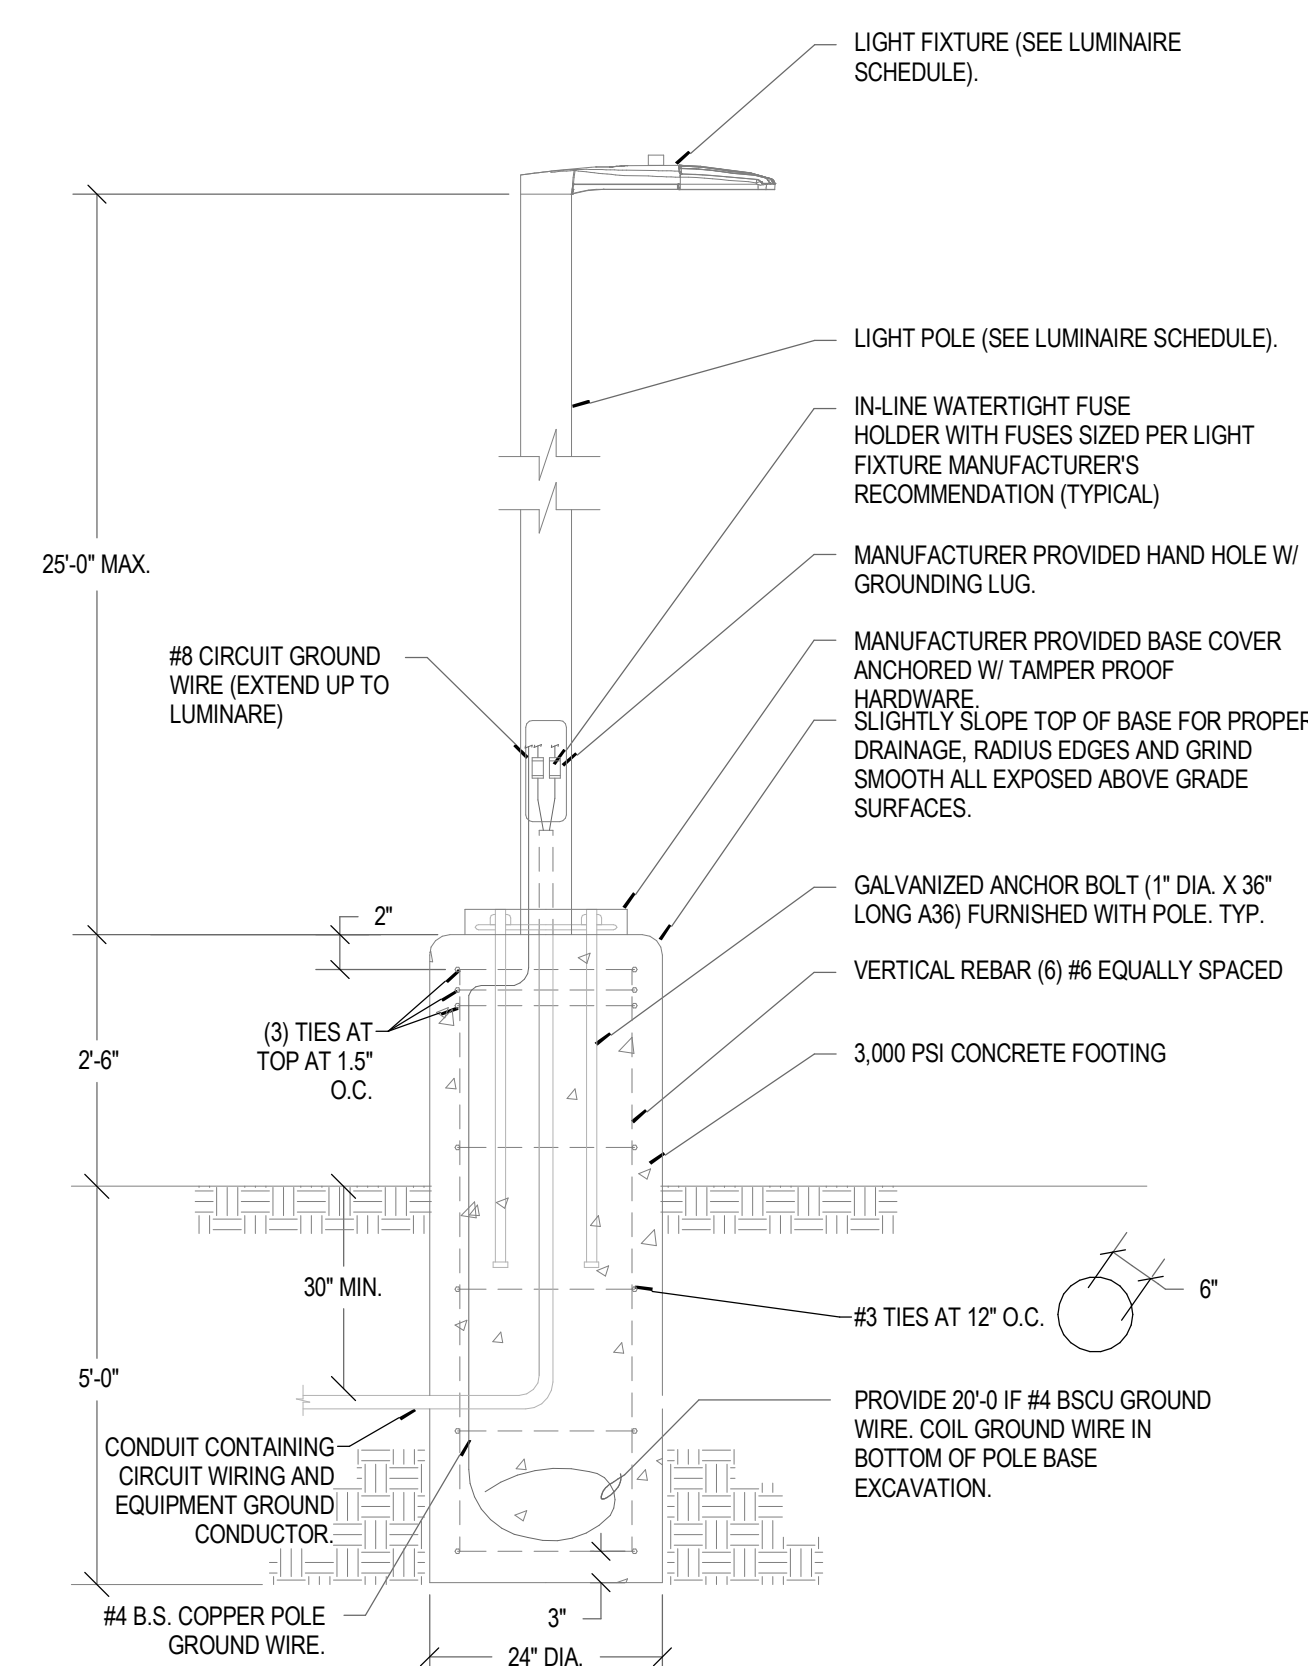

### GENERAL NOTES

1. GROUND POLE TO GROUND CONDUCTORS IN CONDUITS.
2. REFER TO LANDSCAPE ARCHITECTURAL FOR FINAL SITE FIXTURE LOCATIONS.
3. LOCATE ALL SITE POLE TOP FIXTURES SO THAT THEY LINE UP WITH THE NEAREST PARKING STRIPE.
4. LIGHT POLES LESS THAN 30'-0" ABOVE GRADE ARE EXEMPT FROM DSA REVIEW AND APPROVAL.

ABOVE GRADE POLETOP LIGHTING

2



PRINTED: 9/10/2025 9:29:08 AM  
Path: BH 26011755C Wireless\_Center\24-09A\_SBC\20 15 15 Wc\_Net Exp - Redesign - MEP Central\_A21.rvt

PROJECT No. :		9/10/2025 9:29:08 AM	
DRAWN BY: J.M./ST		CHECKED BY: B.K.	
DELTA # 1	DATE: 09/05/25	<input type="checkbox"/> ADD	<input type="checkbox"/> REV
DELTA # 2	DATE: _____	<input type="checkbox"/> ADD	<input type="checkbox"/> REV
DELTA # 3	DATE: _____	<input type="checkbox"/> ADD	<input type="checkbox"/> REV
DELTA # 4	DATE: _____	<input type="checkbox"/> ADD	<input type="checkbox"/> REV
DELTA # 5	DATE: _____	<input type="checkbox"/> ADD	<input type="checkbox"/> REV

FIRE ALARM NOTES	
1.	THE FIRE ALARM SYSTEM AND EQUIPMENT INDICATED ON THESE DRAWINGS SHALL BE APPROVED BY THE LOCAL FIRE AUTHORITY AND SHALL BE INSTALLED AS DESCRIBED ON THESE DRAWINGS AND AS NOTED IN THE SPECIFICATIONS. ANY CHANGES TO THESE PLANS, SUCH AS DELETION, RELOCATION, ADDING OF DEVICES OR EQUIPMENT SUBSTITUTIONS SHALL BE RESUBMITTED TO THE LOCAL FIRE AUTHORITY FOR APPROVAL AT NO ADDITIONAL COST TO THE OWNER.
2.	ALL INITIATING DEVICES MUST BE SUPERVISED AT THE ANNUNCIATOR PANEL(S) AND CONTROLLED BY THE FIRE ALARM CONTROL PANEL (FACP).
3.	WIRING SHALL NOT BE LOOPED THROUGH DEVICES; WIRE MUST BE CUT FOR IN AND FOR OUT.
4.	EXPOSED CONDUIT BELOW CEILING SHALL NOT BE ACCEPTED. WIRING SHALL BE IN SURFACE MOUNT WIREMOLD IF NECESSARY BELOW CEILING ONLY WITH COUNTY'S WRITTEN APPROVAL.
5.	ALL TERMINATIONS IN JUNCTION BOXES, PULL BOXES AND TERMINAL CABINETS SHALL BE ON BOX MOUNTED TERMINAL BLOCKS. DO NOT USE WIRE NUTS FOR SPLICING. DO NOT SPLICE WIRES IN ANY BOXES.
6.	ALL CONDUIT SIZES INDICATED IN DRAWINGS ARE MINIMUM. CONTRACTOR TO ADJUST SIZE FOR FIELD CONDITIONS BUT SHALL NOT BE SMALLER THAN 3/4 INCH.
7.	ALL FIRE ALARM WIRING MUST TEST FREE OF OPENS, SHORTS AND GROUNDS.
8.	FIRE ALARM DRAWINGS ARE SCHEMATIC IN NATURE ONLY. CONTRACTOR TO ROUTE CONDUIT AS FIELD CONDITIONS INDICATE.
9.	CONDUIT AND JUNCTION/BACK BOXES ARE NOT TO BE USED FOR UNRELATED WIRING.
10.	THE SYSTEM SHALL CONFORM TO TITLES 19 AND 24 AS APPLICABLE TO THIS PROJECT.
11.	UPON COMPLETION OF SYSTEM INSTALLATION, THE SYSTEM SHALL BE TESTED IN THE PRESENCE OF, AND IN A MANNER ACCEPTABLE, TO THE ENFORCING AGENCY.
12.	CONDUCTOR LENGTHS AND DEVICE QUANTITIES ARE SHOWN SOLELY FOR CALCULATION PURPOSES ONLY, AND SHALL NOT BE USED FOR BID TAKE-OFF.
13.	THE FIRE ALARM SYSTEM SHALL CONFORM TO ARTICLE 780 OF CALIFORNIA ELECTRICAL CODE. INSTALLATION OF THE FIRE ALARM SYSTEM SHALL NOT BE STARTED UNTIL DETAILED PLANS AND SPECIFICATIONS, INCLUDING CALIFORNIA STATE FIRE MARSHAL LISTING NUMBERS FOR EACH COMPONENT OF THE SYSTEM HAVE BEEN APPROVED BY ENGINEER OF RECORD (E.O.R.) UPON COMPLETION OF THE INSTALLATION OF THE FIRE ALARM SYSTEM A SATISFACTORY TEST OF THE ENTIRE SYSTEM SHALL BE MADE IN THE PRESENCE OF THE FIRE AUTHORITY HAVING JURISDICTION.
14.	PENETRATIONS OF PIPES, CONDUITS, ETC., IN WALLS REQUIRING PROTECTED OPENINGS SHALL BE FIRE STOPPED. FIRE STOP MATERIAL SHALL BE A TEST ASSEMBLY ACCEPTABLE TO LOCAL FIRE MARSHALL.
15.	ALL FIRE ALARM AND COMMUNICATIONS WIRES AND CABLES SHALL BE ONE CONTINUOUS LENGTH FROM A BUILDING TERMINAL CABINET TO ANOTHER BUILDING TERMINAL CABINET OR JUNCTION BOX. ABSOLUTELY NO UPGRADE SPLICES WILL BE PERMITTED. PROVIDE TERMINAL BLOCKS WITH MOUNTINGS IN TERMINAL CABINETS ONLY AS REQUIRED.
16.	EVERY ALARM SIGNALING DEVICE INSTALLED SHALL BE OF THE SAME BASIC TYPE (BELLS, HORNS, CHIMES, SPEAKERS, ECT.) AS ALL OTHER SIGNALING DEVICES IN THE FACILITY. (EXCEPTION: ANY SIGNALING DEVICES REQUIRED FOR THE DEAF OR HEARING IMPAIRED (NFPA PAMPHLET 72)).
17.	THE FIRE ALARM DEVICE SUPPLIER SHALL FURNISH ALL SURFACE MOUNT ENCLOSURES FOR PULL STATIONS AND SKIRTS FOR ALL VISUAL AND AUDIO VISUAL DEVICES TO CONCEAL AS BACK BOXES.
18.	AFTER THE SYSTEM IS COMPLETED, ALL ADDRESSABLE DEVICES SHALL BE PROGRAMMED AT THE FACP ACCORDING TO THE ACTUAL BUILDING ROOM NUMBER OR LOCATION DESCRIPTIONS AS INDICATED BY THE OWNER.
19.	POWER SERVICES SHALL BE ON A DEDICATED BRANCH CIRCUIT WITH A RED MARKING AND IDENTIFIED AS "FIRE ALARM".
20.	AUDIBLE FIRE ALARM SOUND LEVEL SHALL BE AT LEAST 15 dBA ABOVE THE AVERAGE AMBIENT SOUND LEVEL IN ALL OCCUPIABLE AREAS.
21.	FIRE ALARM CONTRACTOR SHALL PROVIDE A "RECORD OF COMPLETION" TO THE INSPECTOR OF RECORD (I.O.R.) AFTER COMPLETION OF OPERATION ACCEPTANCE TEST.
22.	THERE SHALL BE PRE-WIRE INSPECTION REQUIRED BY THE SAN BERNARDINO COUNTY FIRE DEPARTMENT FOR EACH SYSTEM TO BE INSTALLED IN BUILDING. CONTRACTOR SHALL MAKE ALL NECESSARY ARRANGEMENTS WITH SAN BERNARDINO COUNTY FIRE DEPARTMENT FOR THE PRE-WIRE INSPECTION OF EACH SYSTEM. APPROVAL BY THE COUNTY FIRE DEPARTMENT SHALL BE OBTAINED BEFORE FURTHER INSTALLATIONS ARE COMMENCED.
23.	EACH NEW SYSTEM, UPON COMPLETION, SHALL BE CERTIFIED AS PER DISTRICT & AHJ FIRE DEPARTMENT REQUIREMENTS.
24.	CONTRACTOR SHALL APPLY FOR ALL PERMITS AND INSPECTION REQUIRED BY LEGAL AUTHORITIES.
25.	WORKS AND MATERIALS SHALL BE IN FULL COMPLIANCE WITH THE LATEST AND MOST STRINGENT APPLICABLE CODE OR REGULATION.
26.	CONTRACTOR SHALL BE SOLELY AND COMPLETELY RESPONSIBLE FOR ANY ADDITIONAL COSTS FOR MATERIAL OR LABOR TO COMPLY WITH THESE CODES OR REGULATIONS.
27.	CONTRACTOR SHALL BE SOLELY AND COMPLETELY RESPONSIBLE FOR THE CONDITION OF THE PREMISES ON WHICH THE WORK IS PERFORMED AND FOR THE SAFETY OF ALL PERSONS AND PROPERTY DURING PERFORMANCE OF THE CONTRACT.
28.	EQUIPMENT AND MATERIALS SHALL BE LISTED, LABELED AND INSTALLED PER RECOGNIZED ELECTRICAL TESTING LABORATORY.
29.	AUTOMATIC FIRE ALARM SYSTEMS SHALL TRANSMIT THE ALARM, SUPERVISORY AND TROUBLE SIGNALS TO AN APPROVED SUPERVISORY STATION AS REQUIRED BY NFPA 71 AS AMENDED BY ARTICLE 91. THE SUPERVISORY STATION SHALL BE LISTED AS EITHER ULFJX OR ULJJS BY UL OR SHALL MEET THE REQUIREMENTS OF FM STANDARD 3011.
30.	DESIGN DRAWINGS ARE DIAGRAMMATIC ONLY AND SHALL BE FOLLOWED AS CLOSELY AS ACTUAL CONSTRUCTION CONDITIONS WILL PERMIT.
31.	NOTHING ON THE DESIGN DRAWINGS SHALL BE DEEMED AS TO VIOLATE THE LATEST AND MOST STRINGENT APPLICABLE CODES OR REGULATIONS.
32.	ALL DIMENSIONS, ELEVATIONS AND EXISTING CONDITIONS SHALL BE CHECKED AND VERIFIED ON THE SITE BY GENERAL CONTRACTOR, AND EACH SUB-CONTRACTOR BEFORE THE WORK BEGINS. ANY ERROR, OMISSION OR DESIGN DISCREPANCY ON THE PLANS SHALL BE BROUGHT TO THE ATTENTION OF THE ELECTRICAL ENGINEER FOR CLARIFICATION OR CORRECTION BEFORE CONSTRUCTION.
33.	OPENINGS AROUND ELECTRICAL PENETRATIONS THROUGH FIRE RESISTANCE RATED WALLS, PARTITIONS, FLOORS OR CEILINGS SHALL BE FIRE STOPPED USING APPROVED METHODS AS DETERMINED BY CODE OR REGULATION.
34.	PROVIDE INDICATES ITEM TO BE FURNISHED, INSTALLED AND CONNECTED.
35.	ALL USABLE EXISTING FIRE ALARM COMPONENTS REMOVED FROM THE PROJECT SHOULD BE RETURNED TO THE LOCAL MAINTENANCE AND OPERATIONS AREA FOR SALVAGE. THE LOCAL MAINTENANCE ELECTRICAL SUPERVISOR SHOULD BE CONSULTED TO DETERMINE IF ANY COMPONENTS ARE SALVAGEABLE.
36.	LOCATION AND PLACEMENT OF FIRE ALARM DEVICES ARE NOT DIAGRAMMATIC IN NATURE. ANY CHANGE IN THE LOCATION OR PLACEMENT OF BOTH DETECTION AND NOTIFICATION DEVICES MUST BE REVIEWED AND APPROVED BY DSA FIRE & LIFE SAFETY. FINAL APPROVAL OF DEVICE PLACEMENT IS SUBJECT TO FIELD VERIFICATION FOR CODE COMPLIANCE.
37.	CONDUIT SHALL COMPLY WITH THE REQUIREMENTS OF UNDERWRITER'S LABORATORIES. CONDUIT SHALL BE RIGID GALVANIZED STEEL BELOW OR IN CONCRETE SLAB, OR IN WET LOCATION. CONDUIT SHALL BE SUPPORTED ACCORDING TO CODE.
38.	WHERE EXISTING STRUCTURAL WALLS ARE CORED FOR NEW CONDUIT RUNS, SEPARATION BETWEEN CORED HOLES SHALL BE THREE INCHES FROM NEW OR EXISTING HOLES, UNLESS DIRECTED OTHERWISE BY THE ENGINEER AND DSA FIELD ENG.
39.	IT IS THE INTENTION OF THE PLANS AND SPECIFICATIONS TO COVER ALL THINGS REQUIRED TO MAKE A COMPLETE AND OPERATIVE SYSTEM. CONTRACTOR SHALL FURNISH ALL LABOR MATERIALS, EQUIPMENT, OR MISCELLANEOUS SERVICE REQUIRED TO ACCOMPLISH THIS RESULT.
40.	CONTRACTOR SHALL BID THE PROJECT AS INDICATED AND SPECIFIED ON THE DRAWINGS. WHEN SUBSTITUTING MATERIALS OR EQUIPMENT OTHER THAN AS SPECIFIED ON THE DRAWINGS CONTRACTOR SHALL SUBMIT CATALOG CUTS AND AMOUNT OF CREDIT FOR SUBSTITUTION TO BID, FOR APPROVAL.
41.	NOTES AND SCHEDULES LISTED ON DRAWINGS OR OTHER SECTIONS OF THIS PROJECT WITH REFERENCE TO ELECTRICAL CONTRACTOR OR ELECTRICIAN APPLY TO THIS SECTION OF CONTRACT.
42.	THE REPRESENTATION OF PHYSICAL PLACEMENT OF EXISTING CONDUITS HAS BEEN DEVELOPED FROM THE BEST INFORMATION AVAILABLE TO THE DISTRICT AT THE TIME THE DRAWINGS WERE PREPARED. THE DISTRICT PROVIDES THIS ONLY AS A GENERAL GUIDELINE FOR THE CONVENIENCE OF BIDDERS/CONTRACTORS AND DOES NOT GUARANTEE OR WARRANT IN ANY WAY EXPRESSLY OR IMPLIED, THE ACCURACY OF THESE REPRESENTATIONS. NOTHING IN THIS DISCLAIMER AFFECTS IN ANY WAY THE DUTY OF THE CONTRACTOR TO FURNISH ACCURATE "AS BUILT" DRAWINGS AFTER THE COMPLETION OF THE CONTRACT.
43.	BEFORE FINAL ACCEPTANCE OF WORK CONTRACTOR IS TO ENSURE ALL EQUIPMENT AND SYSTEMS ARE INSTALLED AND FUNCTIONING PROPERLY BY PERFORMING REQUIRED FIELD TESTS.
44.	"OR EQUAL" MEANS EQUIVALENT OR SUPERIOR IN PERFORMANCE, MATERIALS, WORKMANSHIP AND APPEARANCE TO THE SPECIFIED EQUIPMENT.
45.	IN EXISTING BUILDINGS, CONTRACTORS SHALL NOT WORK IN AREAS CONTAMINATED BY MATERIALS MADE OF ASBESTOS UNTIL THE ASBESTOS MATERIALS HAVE BEEN REMOVED OR ENCAPSULATED.
46.	REFER TO THE SPECIFICATIONS FOR ADDITIONAL REQUIREMENTS AND EQUIPMENT AND MATERIAL APPROVED FOR USE UNDER THIS CONTRACT.
47.	EXISTING FIRE ALARM SYSTEM MUST REMAIN IN OPERATION UNTIL NEW SYSTEM IS COMPLETE, APPROVED AND OPERATIONAL.
48.	INCLUDE ALL NECESSARY DEMOLITION AS PART OF THIS WORK.
49.	DO NOT RUN CONTINUOUS "WIREMOLD" RACEWAY ON CEILING WITH GLUE-ON ACOUSTIC TILES. RUN TRUNK RACEWAYS ON WALLS.
50.	QUANTITY OF WIRES SHOWN IN ALL CONDUITS IS FOR GENERAL GUIDELINE. SUPPLIER OF AUXILIARY SYSTEM (FA, INTERCOMPA, TEL, SECURITY) SHALL PREPARE CONSTRUCTION DRAWINGS SHOWING ALL NECESSARY WIRES AND CABLES AND VERIFY SIZES OF ALL CONDUITS SHOWN. PROVIDE ALL SPARE WIRES BETWEEN BUILDINGS.
51.	CONTRACTOR SHALL APPLY FOR ALL PERMITS AND INSPECTION REQUIRED BY LEGAL AUTHORITIES.
52.	WORKS AND MATERIALS SHALL BE IN FULL COMPLIANCE WITH THE LATEST AND MOST STRINGENT APPLICABLE CODE OR REGULATION.
53.	CONTRACTOR SHALL BE SOLELY AND COMPLETELY RESPONSIBLE FOR ANY ADDITIONAL COSTS FOR MATERIAL OR LABOR TO COMPLY WITH THESE CODES OR REGULATIONS.

ABBREVIATIONS	
A	AMPERE
AMP	AMPERE FRAME RATING
AF	ABOVE FINISHED FLOOR
AIC	AMPERE INTERRUPTING CAPACITY
AFG	ABOVE FINISHED GRADE
ASSY	ASSEMBLY
AT	AMPERE TRIP RATING
AWG	AMERICAN WIRE GAUGE
BKBD	BACKBOARD
BLDG	BUILDING
BKR	BREAKER
C	CONDUIT
CAB	CABINET
CB	CIRCUIT BREAKER
CKT	CIRCUIT
CFSD	COMBINATION FIRE SMOKE DAMPER
CON	CONDUIT ONLY
CT	CURRENT TRANSFORMER
CU	COPPER
CL	CENTERLINE
DISC	DISCONNECT
DN	DOWN
DWG	DRAWING
EA	EACH
EC	ELECTRICAL CONTRACTOR
EQUIP	EQUIPMENT
EMERG	EMERGENCY
EXIST. (E)	EXISTING
F	FUSE
FA	FIRE ALARM
FACP	FIRE ALARM CONTROL PANEL
FF	FINISHED FLOOR
FG	FINISHED GRADE
FLA	FULL LOAD CURRENT
GEN	GENERATOR
GFI	GROUND FAULT INTERRUPTER
GND	GROUND
HP	HORSE POWER
HT	HEIGHT
HV	HIGH VOLTAGE
J-BOX	JUNCTION BOX
KCMIL	THOUSAND CIRCULAR MILS
KW	KILOWATT
KV	KILO VOLT
KVA	KILO VOLT-AMPERE
LDC	LOCAL DISTRIBUTION CABINET
LOC	LOCAL DISTRIBUTION FRAME
LCL	LONG CONTINUOUS LOAD
LTG	LIGHTING
LV	LOW VOLTAGE
MFR	MANUFACTURER
MAX	MAXIMUM
MCC	MOTOR CONTROL CENTER
MIN	MINIMUM
MH	MOUNTING HEIGHT

DEMOLITION NOTES	
1.	DEMOLISH/PATCH/REPAIR/REPLACE AS REQUIRED. ALL EXISTING CONSTRUCTION, FINISHES, LANDSCAPING, AND SITE CONSTRUCTION AFFECTED BY NEW WORK TO MATCH EXISTING ADJACENT CONSTRUCTION COMPLETE. PREPARE & PAINT AFFECTED SURFACES AS REQUIRED. ENTIRE SURFACE PLANE, UNLESS NOTED OTHERWISE.
2.	EXISTING ARCHITECTURAL, STRUCTURAL, MECHANICAL, ELECTRICAL, CIVIL, OR LANDSCAPE COMPONENTS INCLUDING BUT NOT LIMITED TO SITE PAVING, CURBS, CONCRETE WALKWAYS, PLANTERS, PLANTINGS/TREES, AND UNDERGROUND UTILITIES TO REMAIN UNLESS NOTED OTHERWISE. COMPONENTS TO REMAIN WHICH ARE REMOVED BY CONTRACTOR IN THE PERFORMANCE OF THE SCOPE OF WORK FOR ANY REASON ARE TO BE REPLACED TO MATCH EXISTING AT CONTRACTOR'S EXPENSE.
3.	PATCH AND REPAIR SUBSTRATE AND/OR FINISHES TO MATCH EXISTING WHERE EACH MECHANICAL, ELECTRICAL OR ARCHITECTURAL COMPONENT IS REMOVED, ADDED OR REPLACED.
4.	REMOVE, STORE, CLEAN AND PROTECT EXISTING FURNISHING, EQUIPMENT, CABINETS, ETC. AS REQUIRED TO PERFORM SCOPE OF WORK. PATCH, REPAIR, PAINT, REINSTALL OR REPLACE AS REQUIRED TO MATCH EXISTING.
5.	VERIFY ALL PAINT COLOR SELECTIONS WITH DISTRICT PROJECT MANAGER PRIOR TO APPLICATION.
6.	SUCCESSFUL BIDDER SHALL REQUEST THE DISTRICT TO FURNISH A SET OF AVAILABLE "RECORD DRAWINGS". CONTRACTOR SHALL USE DRAWINGS AS GENERAL GUIDELINE TO GENERALLY LOCATE EXISTING UNDERGROUND UTILITY LINES (ELECTRIC CONDUITS, PIPING, SPRINKLER LINES, SEWER LINES, ETC.). CONTRACTOR SHALL VERIFY EXACT LOCATION OF ALL LINES IN FIELD PRIOR TO TRENCHING. USE ELECTRONIC LOCATING DEVICES. USE DIGI-ALERT SERVICE, ETC. INCLUDE THIS LOCATING WORK IN BID. BE RESPONSIBLE FOR REPAIRING ANY DAMAGED LINES.
7.	INCLUDE ALL DEMOLITION WORK AS PART OF THIS CONTRACT. DEMOLITION SHALL INCLUDE, BUT NOT LIMITED TO THE FOLLOWING: FIRE ALARM SYSTEM.
8.	EXISTING FIRE ALARM SYSTEM MUST REMAIN IN OPERATION UNTIL NEW SYSTEM IS COMPLETE, APPROVED AND OPERATIONAL. DURING CONSTRUCTION, "PROVIDE 24 HOUR FIRE WATCH" PER CFC CHAPTER 33. FIRE WATCH FOR IMPAIRMENT OF SYSTEM. SHOULD EXISTING SYSTEM NEED TO BE INTERRUPTED, EXISTING FA SYSTEM TO BE DEMOLISHED. DEMOLITION SHALL INCLUDE: REMOVAL OF ALL DEVICES-PULL STATIONS, BELLS, SWITCHES, DETECTORS, ETC. PROVIDE BLANK COVER PLATES ON ALL EXISTING BOXES WITH DEVICES REMOVED, PATCH AND PAINT WALLS AND CEILING AS REQUIRED. REMOVAL OF ALL WIRES IN EXISTING CONDUITS TO EXISTING DEVICES. REMOVAL OF ALL WIRES INCLUDE WIRES IN CONDUITS BETWEEN BUILDINGS AND WITHIN BUILDINGS.
9.	ANY DAMAGE CAUSED BY DEMOLITION OPERATIONS TO ADJACENT FACILITIES SHALL BE PROMPTLY REPAIRED AT NO ADDITIONAL COST TO THE BID. ALL ITEMS MOVED OR TEMPORARILY DISASSEMBLED SHALL BE REPLACED OR REASSEMBLED TO AT LEAST THE CONDITION IN LIKE QUALITY PRIOR TO REMOVAL OR DISASSEMBLY.
10.	ALL ABANDONED CIRCUITS AND WIRINGS SHOULD BE REMOVED COMPLETELY RATHER THAN LABELED. THIS WILL ELIMINATE ANY CONFUSION WHEN TROUBLE SHOOTING AT LATER DATE.
11.	ALL DEMOLITION SHALL COMPLY WITH CH.33 CBC AND CH.9833 CFC.
12.	CONTRACTOR SHALL PROVIDE A DIGITAL PHOTOGRAPH IN .JPG (JPEG, JOINT PHOTOGRAPHIC EXPERT GROUP) FORMAT OF ALL AREAS WHERE DEMOLITION OR EXCAVATION WILL REQUIRE REPLACEMENT. PRIOR TO BEGINNING DEMOLITION, CONTRACTOR SHALL USE DIGITAL PHOTOGRAPHS AS GUIDELINE TO RETURN THE AFFECTED AREA TO THE ORIGINAL CONDITION.
13.	CONTRACTOR SHALL NOT RELY ON ANY RECORD DRAWINGS FOR LOCATING EXISTING SUBSURFACE STRUCTURES. CONTRACTOR SHALL POT-HOLE AND USE EXTREME CAUTION DURING EXCAVATION AND SHALL BE RESPONSIBLE FOR LOCATING EXISTING UNDERGROUND UTILITY LINES (ELECTRIC CONDUITS, PIPING, SPRINKLER LINES, SEWER LINES, ETC.). CONTRACTOR SHALL VERIFY EXACT LOCATION OF ALL LINES IN THE FIELD PRIOR TO TRENCHING. USE ELECTRONIC LOCATING DEVICES. USE DIGI-ALERT SERVICE, ETC. INCLUDE THIS LOCATING WORK IN BID. CONTRACTOR IS RESPONSIBLE FOR REPAIRING ANY DAMAGED LINES WITHIN 24 HOURS.
14.	PERFORM THE NECESSARY DEMOLITION WORK WITH GREAT CARE AND WITH SMALL TOOLS IN ORDER NOT TO JEOPARDIZE EXISTING STRUCTURE AND EQUIPMENT TO REMAIN.
15.	COORDINATE THE DEMOLITION WORK AND NEW CONSTRUCTION TO PERMIT CONTINUED OPERATION OF ALL FACILITIES NECESSARY TO BE KEPT IN OPERATION.

LEGEND AND SYMBOLS	
SYMBOL	DESCRIPTION
	ABOVE CEILING, CONCEALED, JUNCTION BOX, WITH COVER, PER NATIONAL ELECTRICAL CODE (NEC) TABLE 370-9(a), 4" SQUARE DEEP, WITH PLASTER RING
	RECESSED WALL MOUNTED, JUNCTION BOX, WITH COVER, PER NATIONAL ELECTRICAL CODE (NEC) TABLE 370-9(a), 4" SQUARE DEEP, WITH PLASTER RING
	BRANCH PANELBOARD, WALL MOUNTED, SEE PLANS AND SCHEDULE. (RECESSED MOUNTED)
	BRANCH PANELBOARD, WALL MOUNTED, SEE PLANS AND SCHEDULE. (SURFACE MOUNTED)
	MAIN SWITCHBOARD, POWER OR LIGHT, FLOOR STANDING ENCLOSURE, (SEE SINGLE LINE DIAGRAM AND LOAD SUMMARY)
	CONDUIT TURN DOWN
	CONDUIT TURN UP
	CONDUIT STUBBED AND CAPPED
	RACEWAY CONCEALED IN WALLS OR ABOVE CEILING
	CONDUIT CONCEALED IN OR UNDER FLOOR, COORDINATE WITH G.C.; OR, BURIAL CONDUIT UNDERGROUND IN SCHEDULE - 40 PVC UNLESS NOTED OTHERWISE. VERIFY DEPTH AND TRENCHING WITH G.C.
	EXISTING DEVICE TO REMAIN
	REMOVE EXISTING DEVICE AND ASSOCIATED CONDUIT AND WIRE
	REMOVE EXISTING DEVICE AND RELOCATE AS SHOWN ON PLAN
	NEW LOCATION OF RELOCATED DEVICE
	HOMERUN TO CIRCUITS #1 AND #3 IN PANEL "A" (CROSSMARKS INDICATE NUMBER OF WIRES AND DOTTED CROSSMARK INDICATES GROUND WIRE.)
	EXISTING (DASH INDICATES) ELECTRICAL EQUIPMENT
	TELEPHONE BACKBOARD 2'X4'X3/4" PLYWOOD, PROVIDE 2" CONDUIT TO TELEPHONE POC.
	EXISTING FIRE ALARM CONTROL PANEL
	EXISTING FIRE ALARM ANNUNCIATOR

FIRE ALARM SHEET INDEX	
SHEET NUMBER	SHEET NAME
F0-0.1	FIRE ALARM LEGENDS & NOTES
F0-0.2	FIRE ALARM LEGENDS & NOTES CONT.
F0-0.3	FIRE ALARM RISER DIAGRAM
FS-1.1	FIRE ALARM DEMOLITION SITE PLAN
FS-1.2	FIRE ALARM REMODEL SITE PLAN
F1-1.1	FIRE ALARM DEMOLITION PLAN
F1-2.1	FIRE ALARM REMODEL PLAN
FD-1.1	FIRE ALARM DETAILS

FIRE ALARM EQUIPMENT LIST					
SYMBOL	MFG.	PART NO.	DESCRIPTION	REMARKS	CSFM LISTING
	EDWARDS	EST-3	EXISTING ADDRESSABLE FIRE ALARM CONTROL PANEL, W/KEYPAD & 160 CHARACTER LCD DISPLAY		7165-1657.186
	EDWARDS	3-LCANN	EXISTING FIRE ALARM NETWORK GRAPHIC ANNUNCIATOR (REMOTE) 80 CHARACTER LCD W/KEYPAD		7165-1657.193
	EDWARDS	SIGMA-PO	NEW ADDRESSABLE PHOTOELECTRIC SMOKE DETECTOR 6.1 INCH BASE	COMPATIBLE WITH FACP	SMOKE DETECTOR: 7272-1657.331 BASE 7300-1657.120
	EDWARDS	SIGA-CR	NEW ADDRESSABLE RELAY CONTROL MODULE	MOUNT INTO A 4" SQUARE BOX	7300-1657.121
	EDWARDS	GCFR-VM	NEW MULTI-CANDELA STROBE SET AT CANDELA SHOWN ON PLAN	CEILING MOUNT, RED	7125-1657.219
	EDWARDS	GCFR-HDM	NEW MULTI-CANDELA HORNSTROBE SET AT CANDELA SHOWN ON PLAN	CEILING MOUNT, RED	7125-1657.202
	EDWARDS	WG4RF-H	NEW EXTERIOR WALL MOUNTED HORN	WALL MOUNT, RED	7135-1657.310
NOTE: CONTRACTOR SHALL SUPPLY EQUIPMENT AS PER LISTING OR APPROVED EQUAL. SUBSTITUTE OF ANY KIND OTHER THAN THE LISTED ABOVE REQUIRE CONTRACTOR TO RE-SUBMIT TO DSA FOR APPROVAL.					
NOTE: FIRE ALARM SYSTEM IS ADDRESSABLE. NAC CIRCUITS SHALL BE SYNCHRONIZED PER FLOOR.					
NOTE: ALL NEW FIRE ALARM DEVICES ARE COMPATIBLE WITH EXISTING FIRE ALARM SYSTEM.					
NOTE: PROVIDE AND INSTALL NEW FIRE ALARM DEVICES AND CONNECT TO EXISTING FIRE ALARM SYSTEM AS SHOWN ON DRAWINGS. ALL WIRING TO BE CLASS B. WIRING IS STYLE Y FOR NOTIFICATION APPLIANCE CIRCUITS, AND STYLE B FOR INITIATING DEVICES AND STYLE Y FOR SIGNALING CIRCUITS. THE ENTIRE SYSTEM IS NON-POWER LIMITED. DESIGN PER PLANS AND SPECS.					
NOTE TO CONTRACTOR					
DO NOT SCALE DRAWINGS					
CONTRACTOR SHALL VERIFY PLANS AND EXISTING CONDITIONS ON THE JOB SITE AND SHALL IMMEDIATELY NOTIFY THE ELECTRICAL ENGINEER IN WRITING OF ANY DISCREPANCIES BEFORE PROCEEDING WITH THE WORK OR BE RESPONSIBLE FOR THE SAME.					
APPLICABLE CODES					
2022 BUILDING STANDARDS ADMINISTRATIVE CODE, PART 1, TITLE 24 C.C.R.					
2022 CALIFORNIA BUILDING CODE (CBC), PART 2, TITLE 24 C.C.R.					
2022 CALIFORNIA ELECTRICAL CODE (CEC), PART 3, TITLE 24 C.C.R.					
2022 CALIFORNIA FIRE CODE (CFC), PART 9, TITLE 24 C.C.R.					
2022 CALIFORNIA REFERENCED STANDARDS CODE, PART 12, TITLE 24 C.C.R.					
TITLE 19 C.C.R., PUBLIC SAFETY, STATE FIRE MARSHAL REGULATIONS.					
PARTIAL LIST OF APPLICABLE STANDARDS					
NFPA 72	NATIONAL FIRE ALARM AND SIGNALING CODE (CALIFORNIA AMENDED)				2022 EDITION
NFPA 92	STANDARD FOR SMOKE CONTROL SYSTEMS				2018 EDITION
NFPA 253	CRITICAL RADIANT FLUX OF FLOOR COVERING SYSTEMS				2018 EDITION
UL 464	AUDIBLE SIGNALING DEVICES FOR FIRE ALARM AND SIGNALING SYSTEMS, INCLUDING ACCESSORIES				2003 EDITION
UL 521	STANDARD FOR HEAT DETECTORS FOR FIRE PROTECTIVE SIGNALING SYSTEMS				1999 EDITION
UL 1971	STANDARD FOR SIGNALING DEVICES FOR THE HEARING IMPAIRED				2002 EDITION

AGENCY APPROVAL  
FIS No.: 00000000000000000000

STAMPS

412 E. Vanderbilt Way  
San Bernardino, CA 92408  
Phone: 909.890.3703  
Fax: 909.890.3770  
Email: cadd@designwesting.com

DESIGN WEST ENGINEERING  
MECHANICAL - ELECTRICAL - ENERGY CONSULTANTS



CONSULTANT BRANDING

RUHNAU  
CLARKE  
ARCHITECTS



FIRE ALARM WIRING SCHEDULE			
TYPE	DESCRIPTION	MANUFACTURE/CATALOG #	PURPOSE
D	2 #16 UTP	INDOOR/WEST PENN NO. D990 OUTDOOR/WEST PENN NO. AQ225	SLC LOOP CIRCUIT
H	2 #12 THHN/THWN, CU	VINYLON THHN/THWN-2	HORN CIRCUIT
V	2 #12 THHN/THWN, CU	VINYLON THHN/THWN-2	STROBE ALARM CIRCUIT
P	2 #12 THHN/THWN, CU	VINYLON THHN/THWN-2	L.V. POWER CIRCUIT
N	2 #18 UTP	INDOOR/WEST PENN NO. D980 OUTDOOR/WEST PENN NO. AQ224	NETWORK CIRCUIT

NOTE: -NUMERAL ADJACENT TO CABLE TYPE INDICATES QUANTITY OF CABLES.  
-EXAMPLE: "3F" DENOTES 3 PAIR OF 2#12 CABLE.  
-ALL CONDUIT IS 3/4" U.O.N.  
-ALL CABLES SHALL BE THHN/THWN (FOR UNDERGROUND).  
-FIRE ALARM WIRES SHALL BE UNCOATED SOLID COPPER THHN/THWN.  
-FIRE ALARM CABLES SHALL BE FPLR TYPE SUITABLE FOR ENVIRONMENT.  
-REFER TO SPECIFICATIONS FOR NETWORK CABLES AND FOR WIRES COLOR CODE.

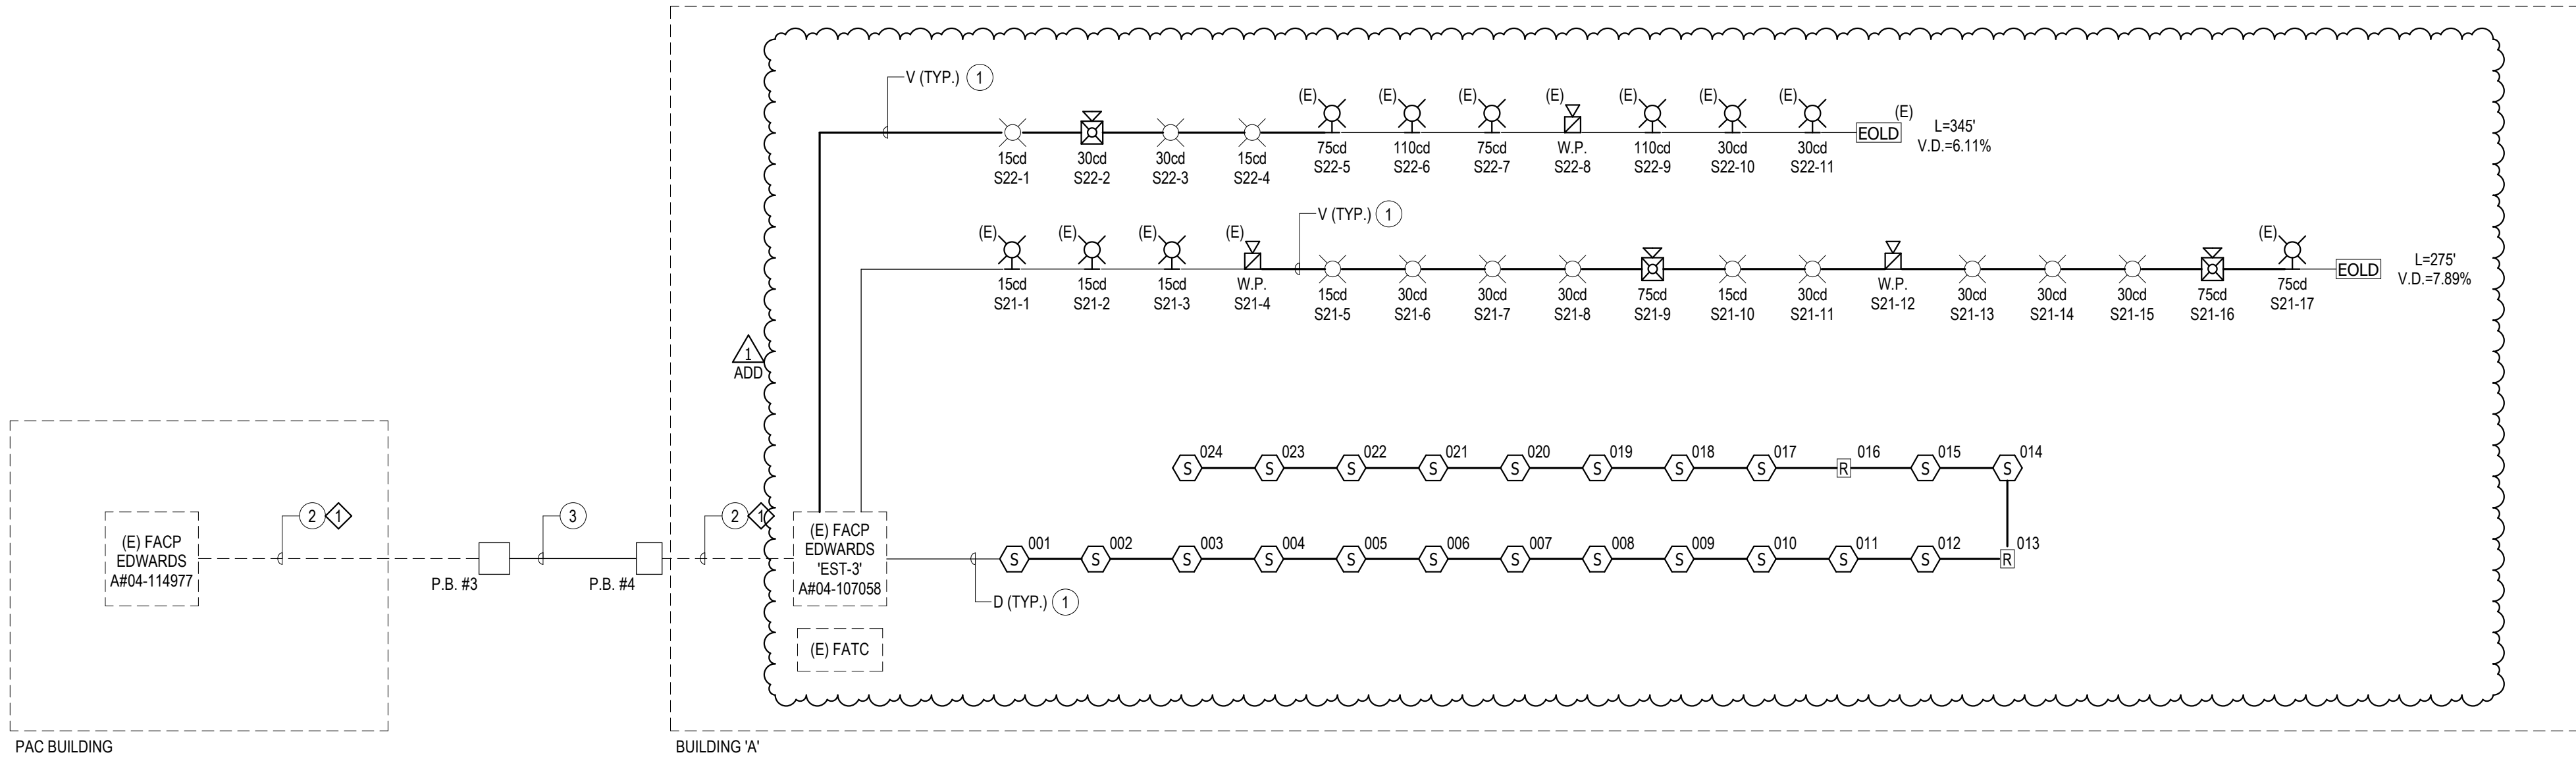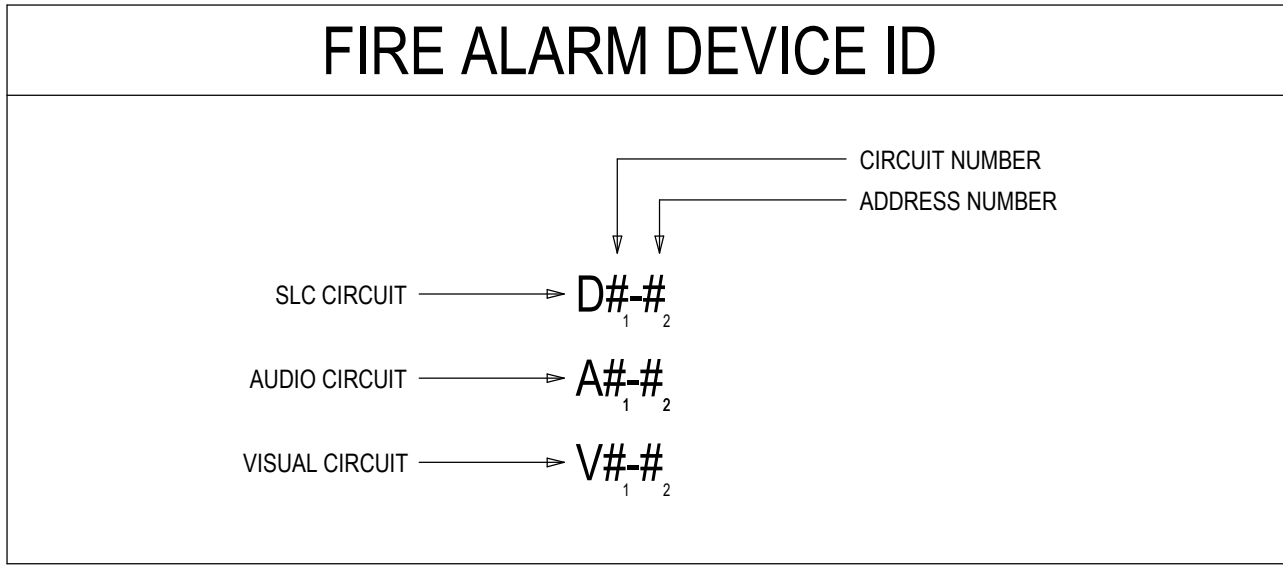

FIRE ALARM RISER DIAGRAM

1

GENERAL NOTES

- REFER TO 'FIRE ALARM NOTES' ON FIRE ALARM LEGENDS AND NOTES SHEETS.
- ALL STROBES AND SMOKE DETECTORS SHALL BE IDENTIFIED AS 'FIRE ALARM CIRCUIT', PER NFPA 72 10.6.5.2.2.
- STORAGE BATTERY CELLS SHALL BE INSULATED AGAINST GROUNDS FAULTS THAT MIGHT OCCUR, PER NFPA 72 10.6.10.2.1.
- BATTERIES SHALL BE PROTECTED AGAINST EXCESSIVE CHARGING AND LOAD CURRENTS BY MEANS OF AN OVERCURRENT DEVICE, PER NFPA 72 10.6.10.4.
- THE SECONDARY POWER SUPPLY SHALL AUTOMATICALLY PROVIDE POWER TO THE PROTECTED PREMISES SYSTEM WITHIN 10 SECONDS AND THE SUPERVISING SYSTEM WITHIN 60 SECONDS OF PRIMARY POWER FAILURE, TO MEET MINIMUM VOLTAGE REQUIREMENTS FOR OPERATION (PER NFPA 72 10.6.6.).
- PROVIDE A LISTED BREAKER LOCKING DEVICE FOR THE REMOTE POWER SUPPLY CIRCUIT BREAKER AND FIRE ALARM CONTROL UNIT, PER NFPA 72 10.6.5.4. PROVIDE CIRCUIT BREAKER WITH RED MARKING AND IDENTIFICATION FOR FIRE ALARM CIRCUIT. LOCATION OF CIRCUIT BREAKER TO BE PERMANENTLY IDENTIFIED AT FACP/FATC.

DEMOLITION NOTES

- ◇ REMOVE EXISTING CABLING BACK TO HEAD END EQUIPMENT IN PAC BUILDING. EXISTING CONDUIT TO REMAIN.

CONSTRUCTION NOTES

- VERIFY WITH FIRE ALARM WIRING SCHEDULE FOR ALL FA CABLING REQUIREMENTS.
- PROVIDE NEW FIRE ALARM CABLING IN EXISTING CONDUITS AND RECONNECT EXISTING EQUIPMENT IN P.A.C. BUILDING TO EXISTING HEAD END EQUIPMENT IN BUILDING 'A'. QUANTITY AND SIZE OF CABLING TO MATCH EXISTING. CONTRACTOR SHALL PROVIDE ALL NECESSARY CONDUIT, CABLING, HARDWARE, SOFTWARE, PROGRAMMING AND TESTING AS NECESSARY FOR A COMPLETE RECONNECTION.
- PROVIDE NEW FIRE ALARM CABLING IN NEW CONDUIT PATHWAY. REFER TO REMODEL SITE PLAN FOR CONDUIT SIZE.

VOLTAGE DROP CALCS CIRCUIT 'FACP-S21'					Location: BUILDING 'A'				
DEVICE	QTY	VOLTAGE	AMPS PER UNIT	TOTAL ALARM AMPS	WIRE SIZE	RES.	DIST.	VOLT DROP	%
EXISTING 15cd WALL STROBE	3	24	0.059	0.177	--	--	--	--	--
EXISTING 75cd WALL STROBE	1	24	0.152	0.152	--	--	--	--	--
NEW 15cd CEILING STROBE	2	24	0.063	0.126	--	--	--	--	--
NEW 30cd CEILING STROBE	7	24	0.168	1.176	--	--	--	--	--
NEW 75cd CEILING HORN/STROBE	2	24	0.180	0.360	--	--	--	--	--
EXISTING EXTERIOR HORN	1	24	0.040	0.040	--	--	--	--	--
NEW EXTERIOR HORN	1	24	0.049	0.049	--	--	--	--	--
TOTALS		24		2.080	#12	1.6550	275	1.89	7.89
STARTING VOLTAGE =		20.4				VOLTAGE AT END OF LINE =			18.5
						MINIMUM VOLTAGE PER MANUFACTURER SPECIFICATIONS =			16.0

BATTERY CALCULATIONS (E) 'FACP'

TYPE	QTY	SUPERVISORY CURRENT		ALARM CURRENT	
		EACH	TOTAL	EACH	TOTAL
EXISTING FACP	1	1.362	1.362	5.647	5.647
NEW SMOKE DETECTOR	22	0.000051	0.001122	0.000068	0.001496
NEW RELAY MODULE	2	0.0001	0.0002	0.0001	0.0002
NEW 15cd CEILING STROBE	4	----	----	0.063	0.252
NEW 30cd CEILING STROBE	8	----	----	0.168	1.344
NEW 30cd CEILING HORN/STROBE	1	----	----	0.101	0.101
NEW 75cd CEILING HORN/STROBE	2	----	----	0.180	0.36
NEW EXTERIOR HORN	1	----	----	0.049	0.049
TOTALS			1.363322		7.754696
TOTAL SUPERVISORY CURRENT		1.363 A			
SUPERVISORY STANDBY TIME		24.0 HRS			
REQUIRED BATTERY (SUPERVISORY)		32.720 AH			
TOTAL FIRE ALARM CURRENT		7.765 A			
FIRE ALARM STANDBY TIME		0.0833 HRS			
REQUIRED BATTERY (FIRE ALARM)		0.646 AH			
TOTAL REQUIRED (WITH 25% SAFETY MARGIN)		41.707 AH			
NEW BATTERY		50.0 AH			
BATTERY REMAINING SPARE CAPACITY		8.293 AH			

VOLTAGE DROP CALCS CIRCUIT 'FACP-S22'									
Location: BUILDING 'A'									
DEVICE	QTY	VOLTAGE	AMPS PER UNIT	TOTAL ALARM AMPS	WIRE SIZE	RES.	DIST.	VOLT DROP	%
EXISTING 30cd WALL STROBE	2	24	0.082	0.164	--	--	--	--	--
EXISTING 75cd WALL STROBE	2	24	0.152	0.304	--	--	--	--	--
EXISTING 110cd WALL STROBE	2	24	0.191	0.382	--	--	--	--	--
NEW 15cd CEILING STROBE	2	24	0.063	0.126	--	--	--	--	--
NEW 30cd CEILING STROBE	1	24	0.168	0.168	--	--	--	--	--
NEW 30cd CEILING HORN/STROBE	1	24	0.101	0.101	--	--	--	--	--
EXISTING EXTERIOR HORN	1	24	0.040	0.040	--	--	--	--	--
TOTALS		24		1.285	#12	1.6550	345	1.47	6.11
STARTING VOLTAGE =		20.4		VOLTAGE AT END OF LINE =				18.9	
				MINIMUM VOLTAGE PER MANUFACTURER SPECIFICATIONS =				16.0	

FIRE ALARM CALCULATIONS

2

PROJECT No. :  
9/10/2025 9:29:10 AM

DRAWN BY: J.M./ST  
CHECKED BY: B.K.

DELTA # 1 DATE 09/05/25  
DELTA # 2 DATE  
DELTA # 3 DATE  
DELTA # 4 DATE

ADD AFO CDD REV  
ADD AFO CDD REV  
ADD AFO CDD REV  
ADD AFO CDD REV

RUHNAUCLARKE.COM

3775 TENTH STREET, RIVERSIDE CALIFORNIA 92503 (951) 684-4664 / 5751 PALMER WAY, SUITE C, CARLSBAD CALIFORNIA 92010 (760) 438-5899



INDIAN SPRINGS HIGH SCHOOL HEALTH CENTER

INDIAN SPRINGS HIGH SCHOOL  
650 N DEL ROSA DR, SAN BERNARDINO, CA 92410  
SAN BERNARDINO CITY UNIFIED SCHOOL DISTRICT

FIRE ALARM RISER  
DIAGRAM

F0-0.3



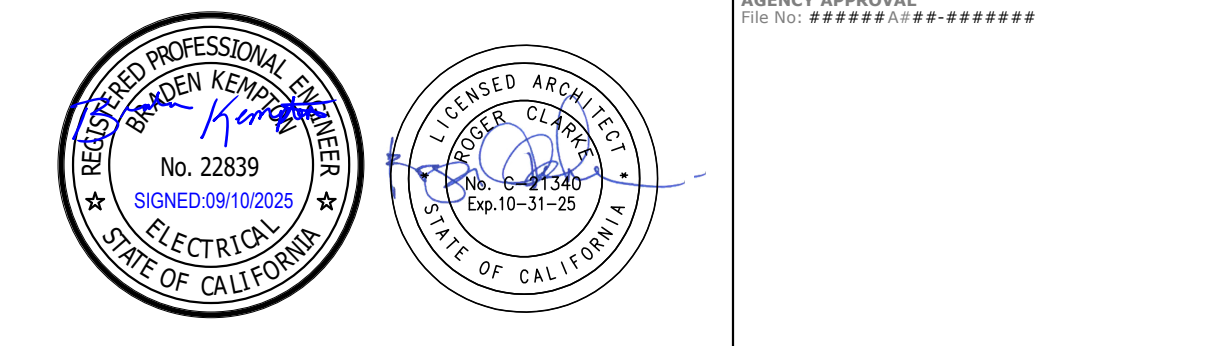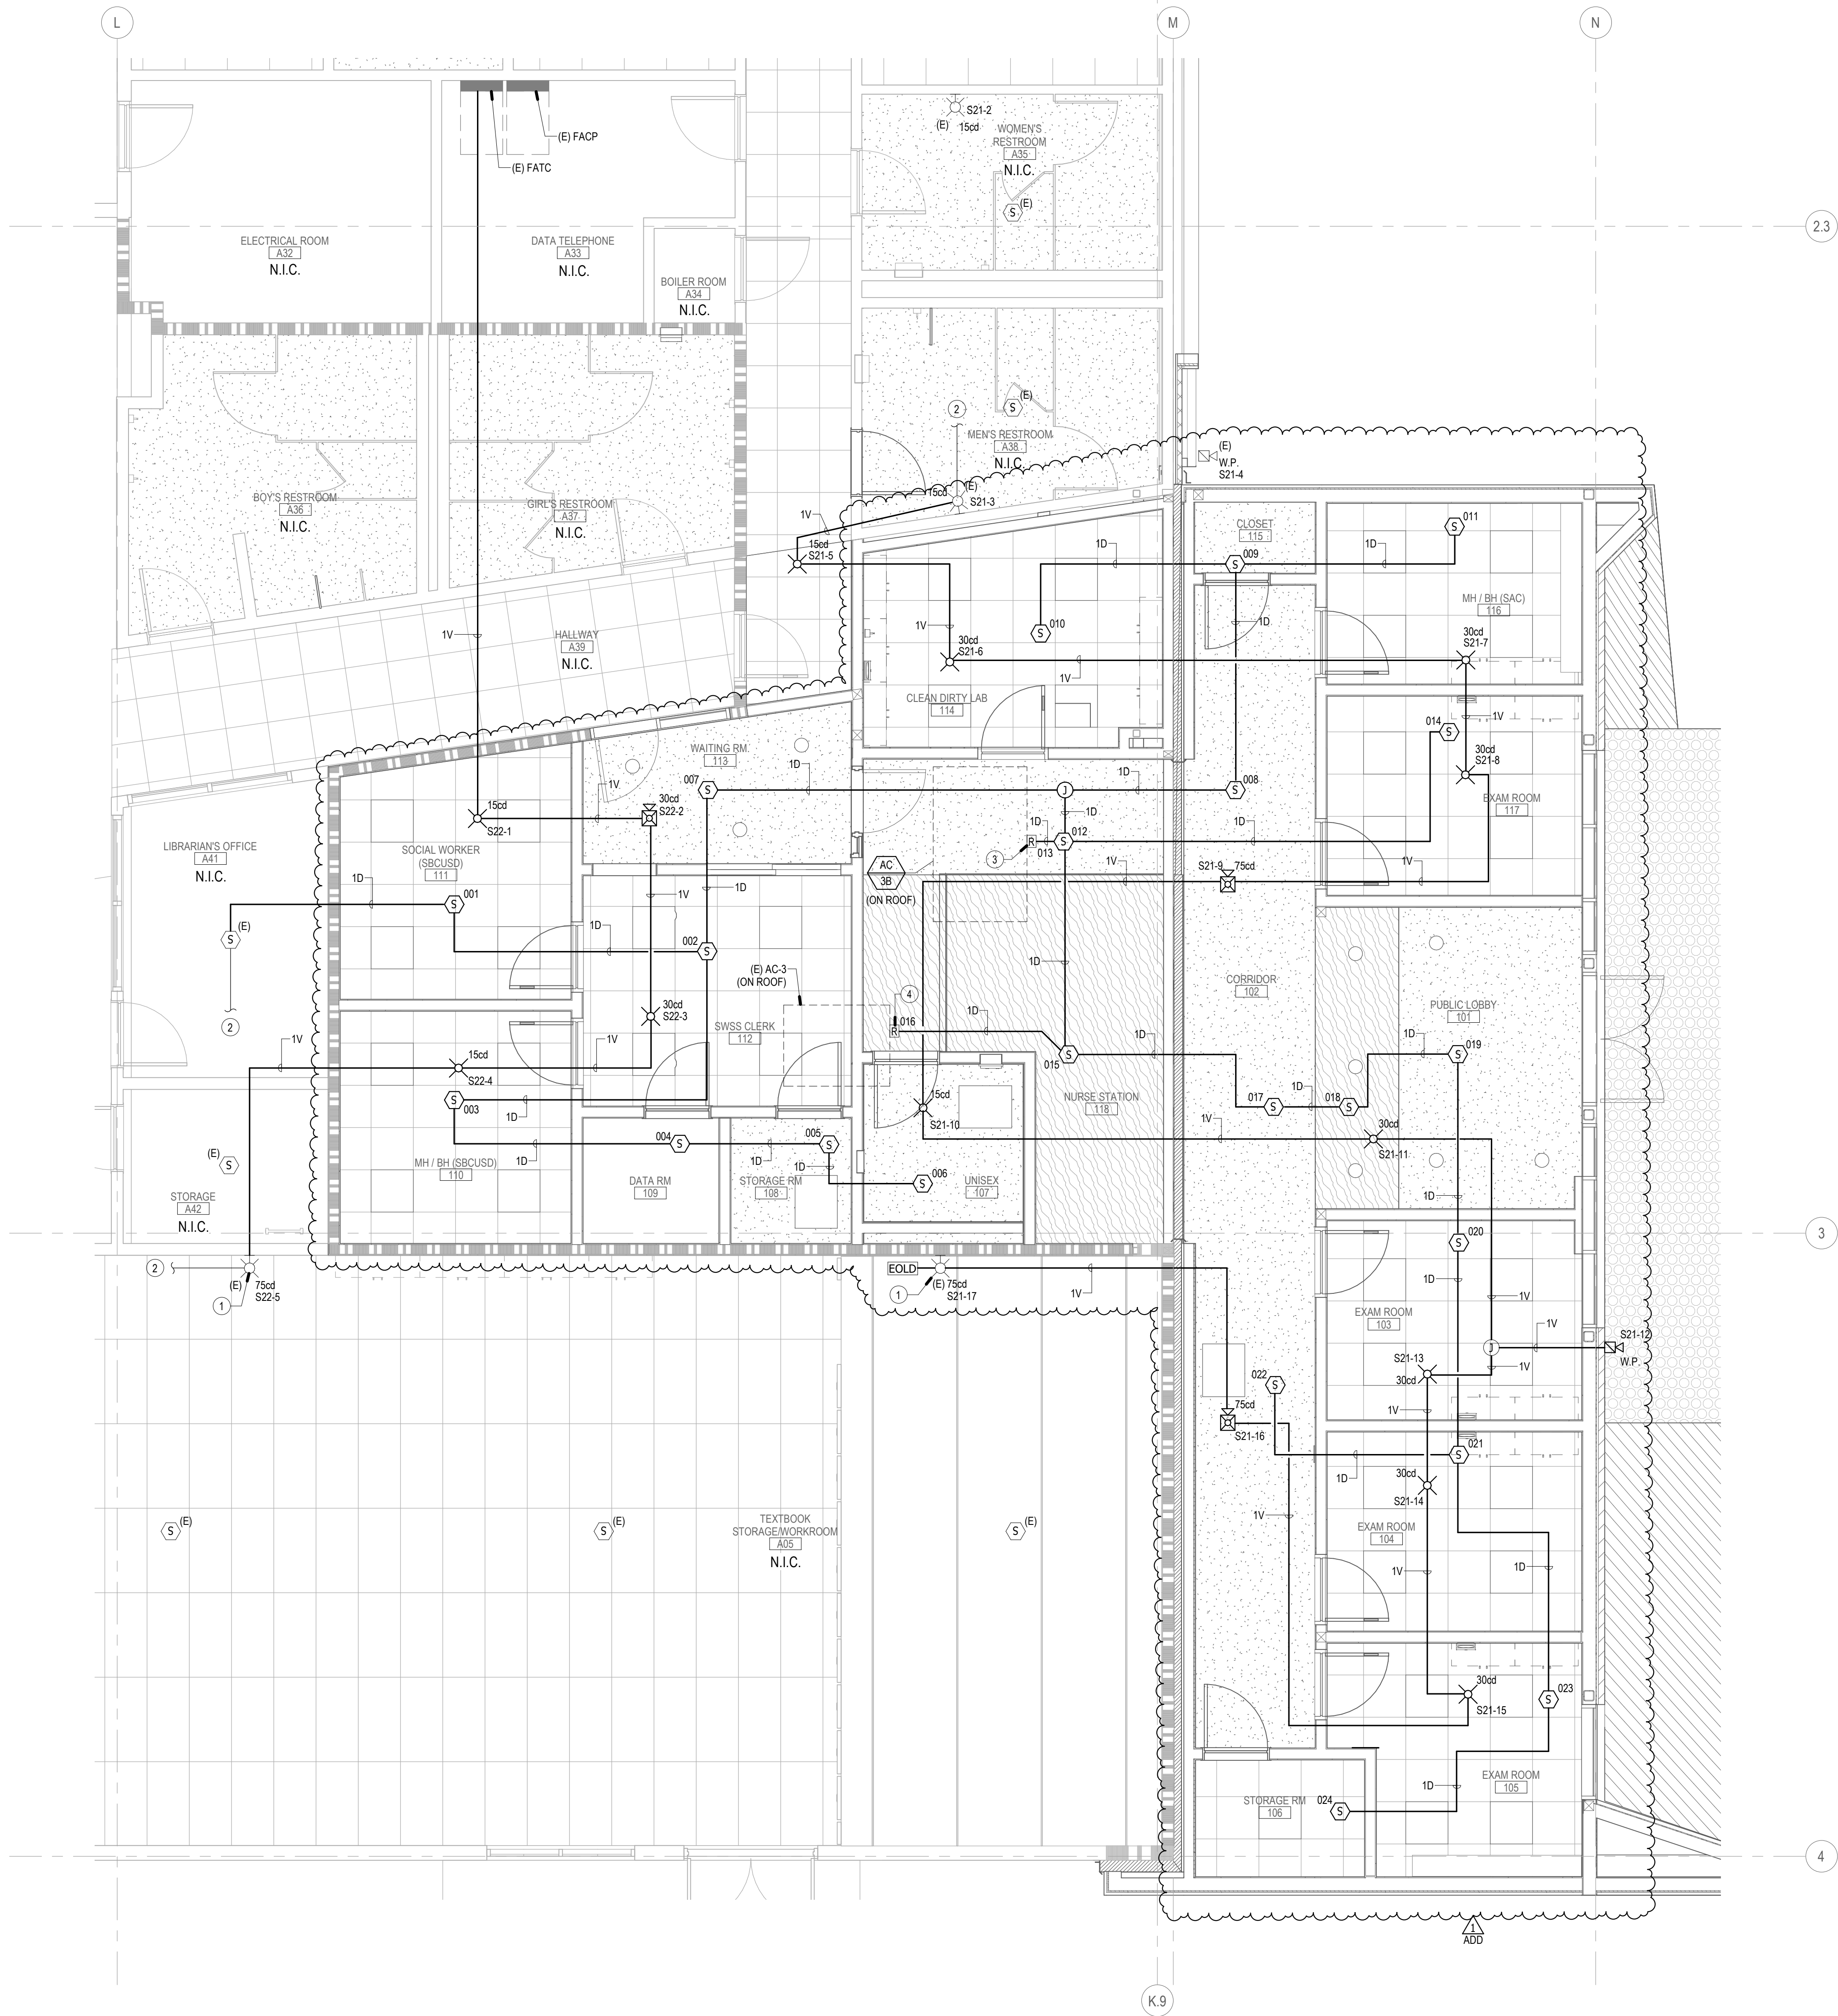

**RUHNAU CLARKE ARCHITECTS**  
412 E. Vanderbilt Way  
San Bernardino, CA 92408  
Phone: 909.890.3703  
Fax: 909.890.3770  
Email: cadd@designwesting.com  
DESIGN WEST ENGINEERING  
MECHANICAL - ELECTRICAL - ENERGY CONSULTANTS  
CONSULTANT BRANDING

### GENERAL NOTES

- REFER TO 'GENERAL NOTES' ON FIRE ALARM LEGENDS AND NOTES SHEET.
- FOR ANY FIRE WALL PENETRATIONS 2" AND UNDER:  
REFER TO DETAIL

### CONSTRUCTION NOTES

- EXTEND EXISTING FIRE ALARM CIRCUIT TO EXISTING STROBE. PROVIDE ALL NECESSARY CABLING, CONDUIT, JUNCTION BOXES, PROGRAMMING AND TESTIN FOR A COMPLETE AND OPERABLE CIRCUIT.
- EXISTING FIRE ALARM CIRCUIT TO REMAIN. REFER TO AS-BUILT DRAWINGS UNDER A#04-107058 FOR MORE INFORMATION.
- PROVIDE RELAY MODULE FOR NEW HVAC UNIT SHUT-DOWN.  
REFER TO DETAIL
- PROVIDE RELAY MODULE FOR EXISTING HVAC UNIT SHUT-DOWN.  
REFER TO DETAIL

### RATED ASSEMBLY LEGEND

1-HR FIRE RATED WALL ASSEMBLY

FIRE ALARM REMODEL PLAN

SCALE: 1/4" = 1'-0" 1

**RUHNAUCLARKE.COM**

**INDIAN SPRINGS HIGH SCHOOL HEALTH CENTER**  
650 N DEL ROSA DR, SAN BERNARDINO, CA 92410  
SAN BERNARDINO CITY UNIFIED SCHOOL DISTRICT

**FIRE ALARM REMODEL PLAN**  
**F1-2.1**

PRINTED: 9/10/2025 9:29:13 AM  
PATH: BH-BN-280/17552-Wellness\_Center/24-04-SBCUSD-15-15-WC-Mod-Exp\_Redisgn\_MEP\_Central\_A21.rvt

**PROJECT No. :**  
9/10/2025 9:29:13 AM

DATE	BY	REVISION
09/05/25	JM/ST	1

CHECKED BY: BJK  
AFO CDD REV  
AFO CDD REV  
AFO CDD REV  
AFO CDD REV

3775 TENTH STREET, RIVERSIDE CALIFORNIA 92503 (951) 684-4664 / 5751 PALMER WAY, SUITE C, CARLSBAD CALIFORNIA 92008 (760) 438-5899

INDIAN SPRINGS HIGH SCHOOL HEALTH CENTER:





STAMPS



**DESIGN WEST ENGINEERING**  
MECHANICAL • ELECTRICAL • ENERGY CONSULTANTS

### CONSULTANT BRANDING

RUHNAU  
CLARKE  
ARCHITECTS

## GENERAL NOTES

## CONSTRUCTION NOTES



FIRE PROTECTION HYDRAULIC REF PLAN

$$1/8'' = 1'-0''$$

TH ER HOOL	FIRE SPRINKLER HYD. REF. CEILING PLAN
------------------	--

## FP-1.2

PATH: BIM 360:///17850\_Wellness\_Center/24-094\_SBCUSD\_IS\_HS\_WC\_Mod\_Exp\_Redesign\_Fp\_Central\_R21.rvt

**PROJECT No. :1-78-50**  
 9/10/2025 12:26:54 PM

DRAWN BY: KM/AD      CHECKED BY: MS

DELTA # 1	DATE 09/09/2025	<input type="checkbox"/> ADD	<input type="checkbox"/> AFO	<input type="checkbox"/> CCD	<input type="checkbox"/> REV
DELTA # _____	DATE _____	<input type="checkbox"/> ADD	<input type="checkbox"/> AFO	<input type="checkbox"/> CCD	<input type="checkbox"/> REV
DELTA # _____	DATE _____	<input type="checkbox"/> ADD	<input type="checkbox"/> AFO	<input type="checkbox"/> CCD	<input type="checkbox"/> REV
DELTA # _____	DATE _____	<input type="checkbox"/> ADD	<input type="checkbox"/> AFO	<input type="checkbox"/> CCD	<input type="checkbox"/> REV

**RUHNAUCLARKE.COM**

3775 TENTH STREET, RIVERSIDE CALIFORNIA 92501 (951) 684 4664 / 5751 PALMER WAY, SUITE C, CARLSBAD CALIFORNIA 92010 (760) 438 5899


**INDIAN SPRINGS HIGH SCHOOL HEALTH CENTER**  
INDIAN SPRINGS HIGH SCHOOL  
650 N DEL ROSA DR, SAN BERNARDINO, CA 92410  
SAN BERNARDINO CITY UNIFIED SCHOOL DISTRICT

94 1-78-50








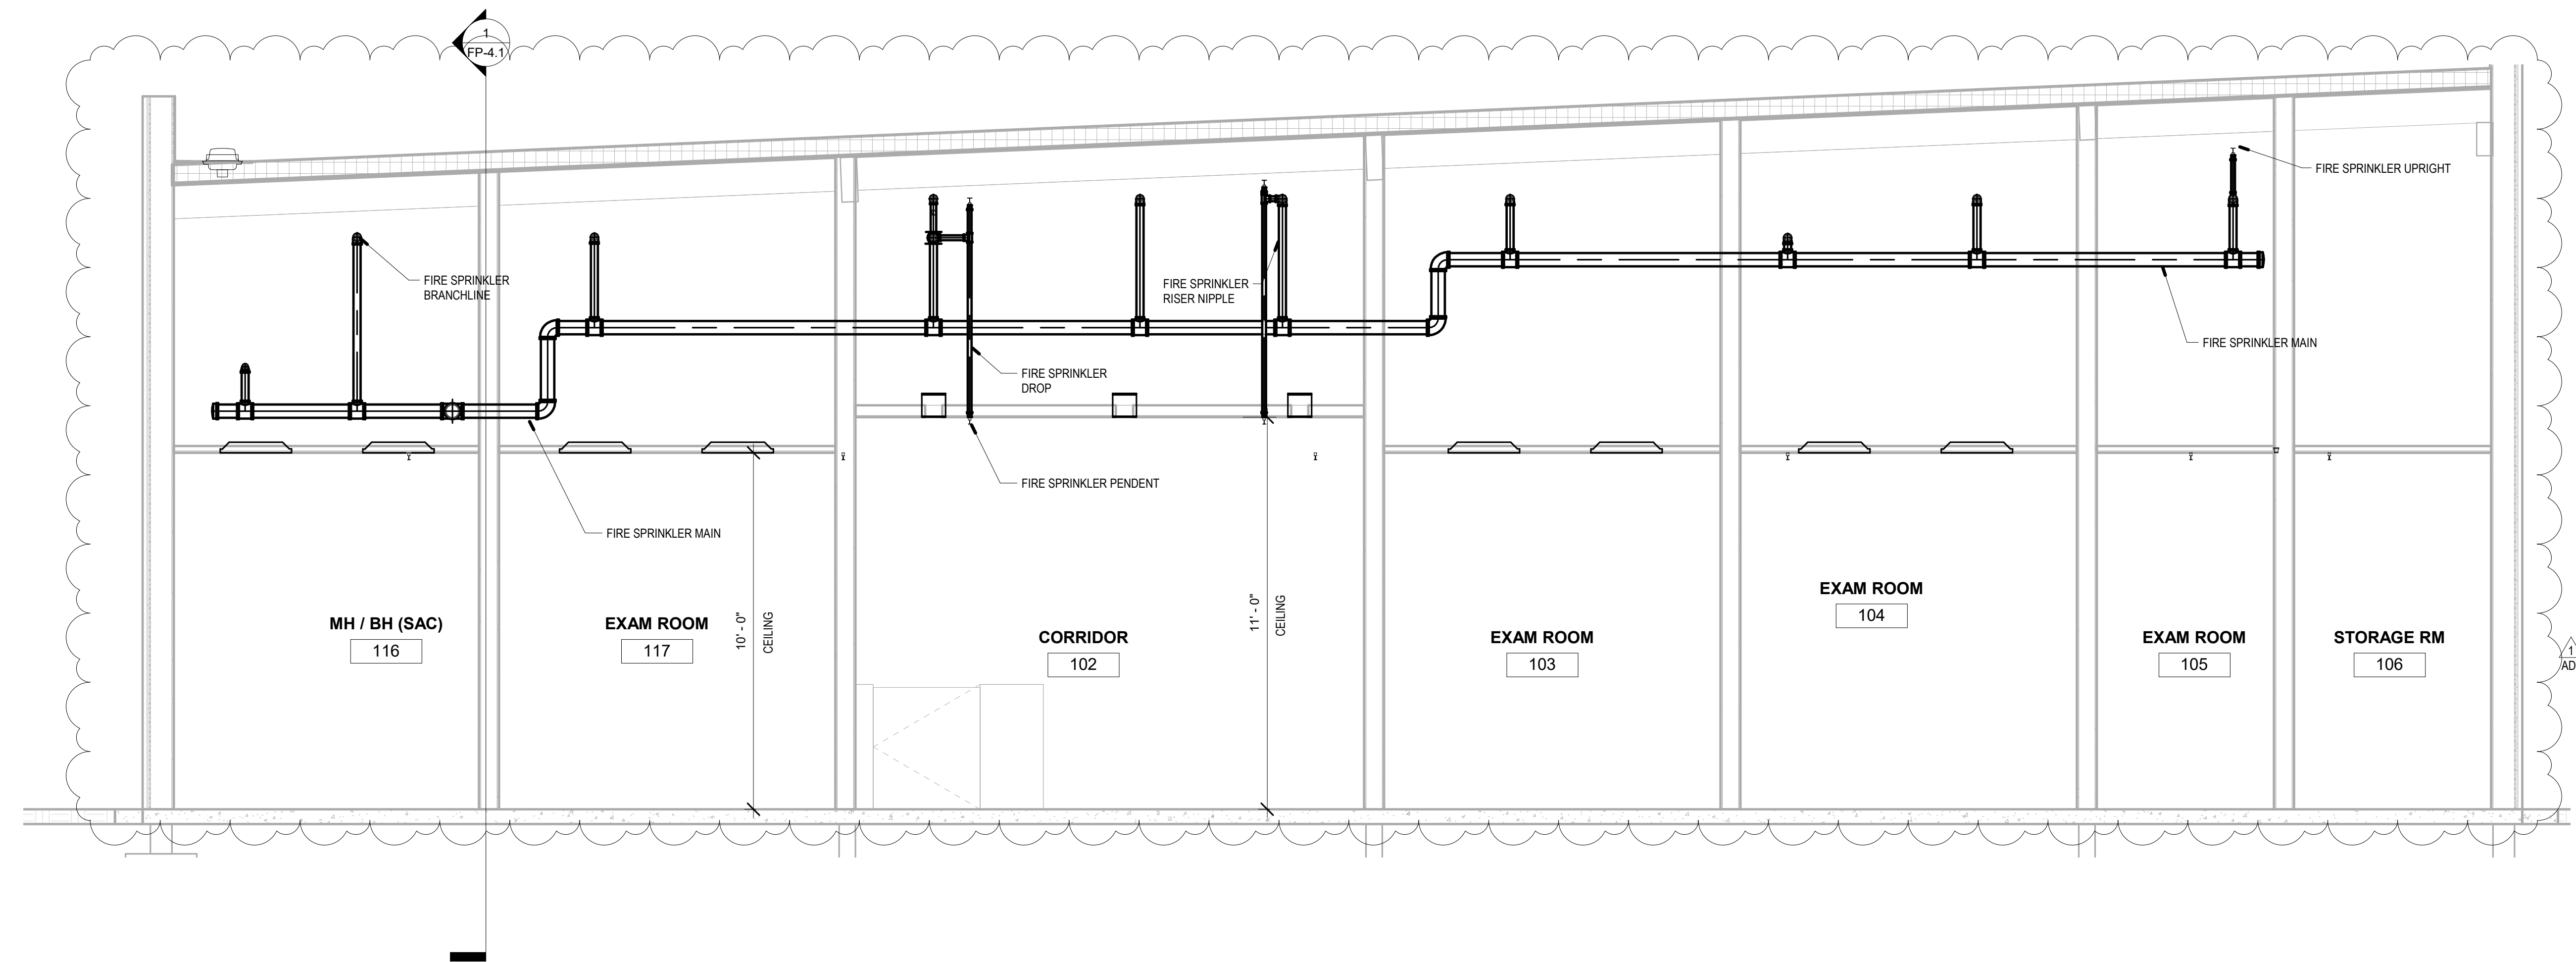

BUILDING SECTION 2

$$3/8'' = 1'-0''$$

2

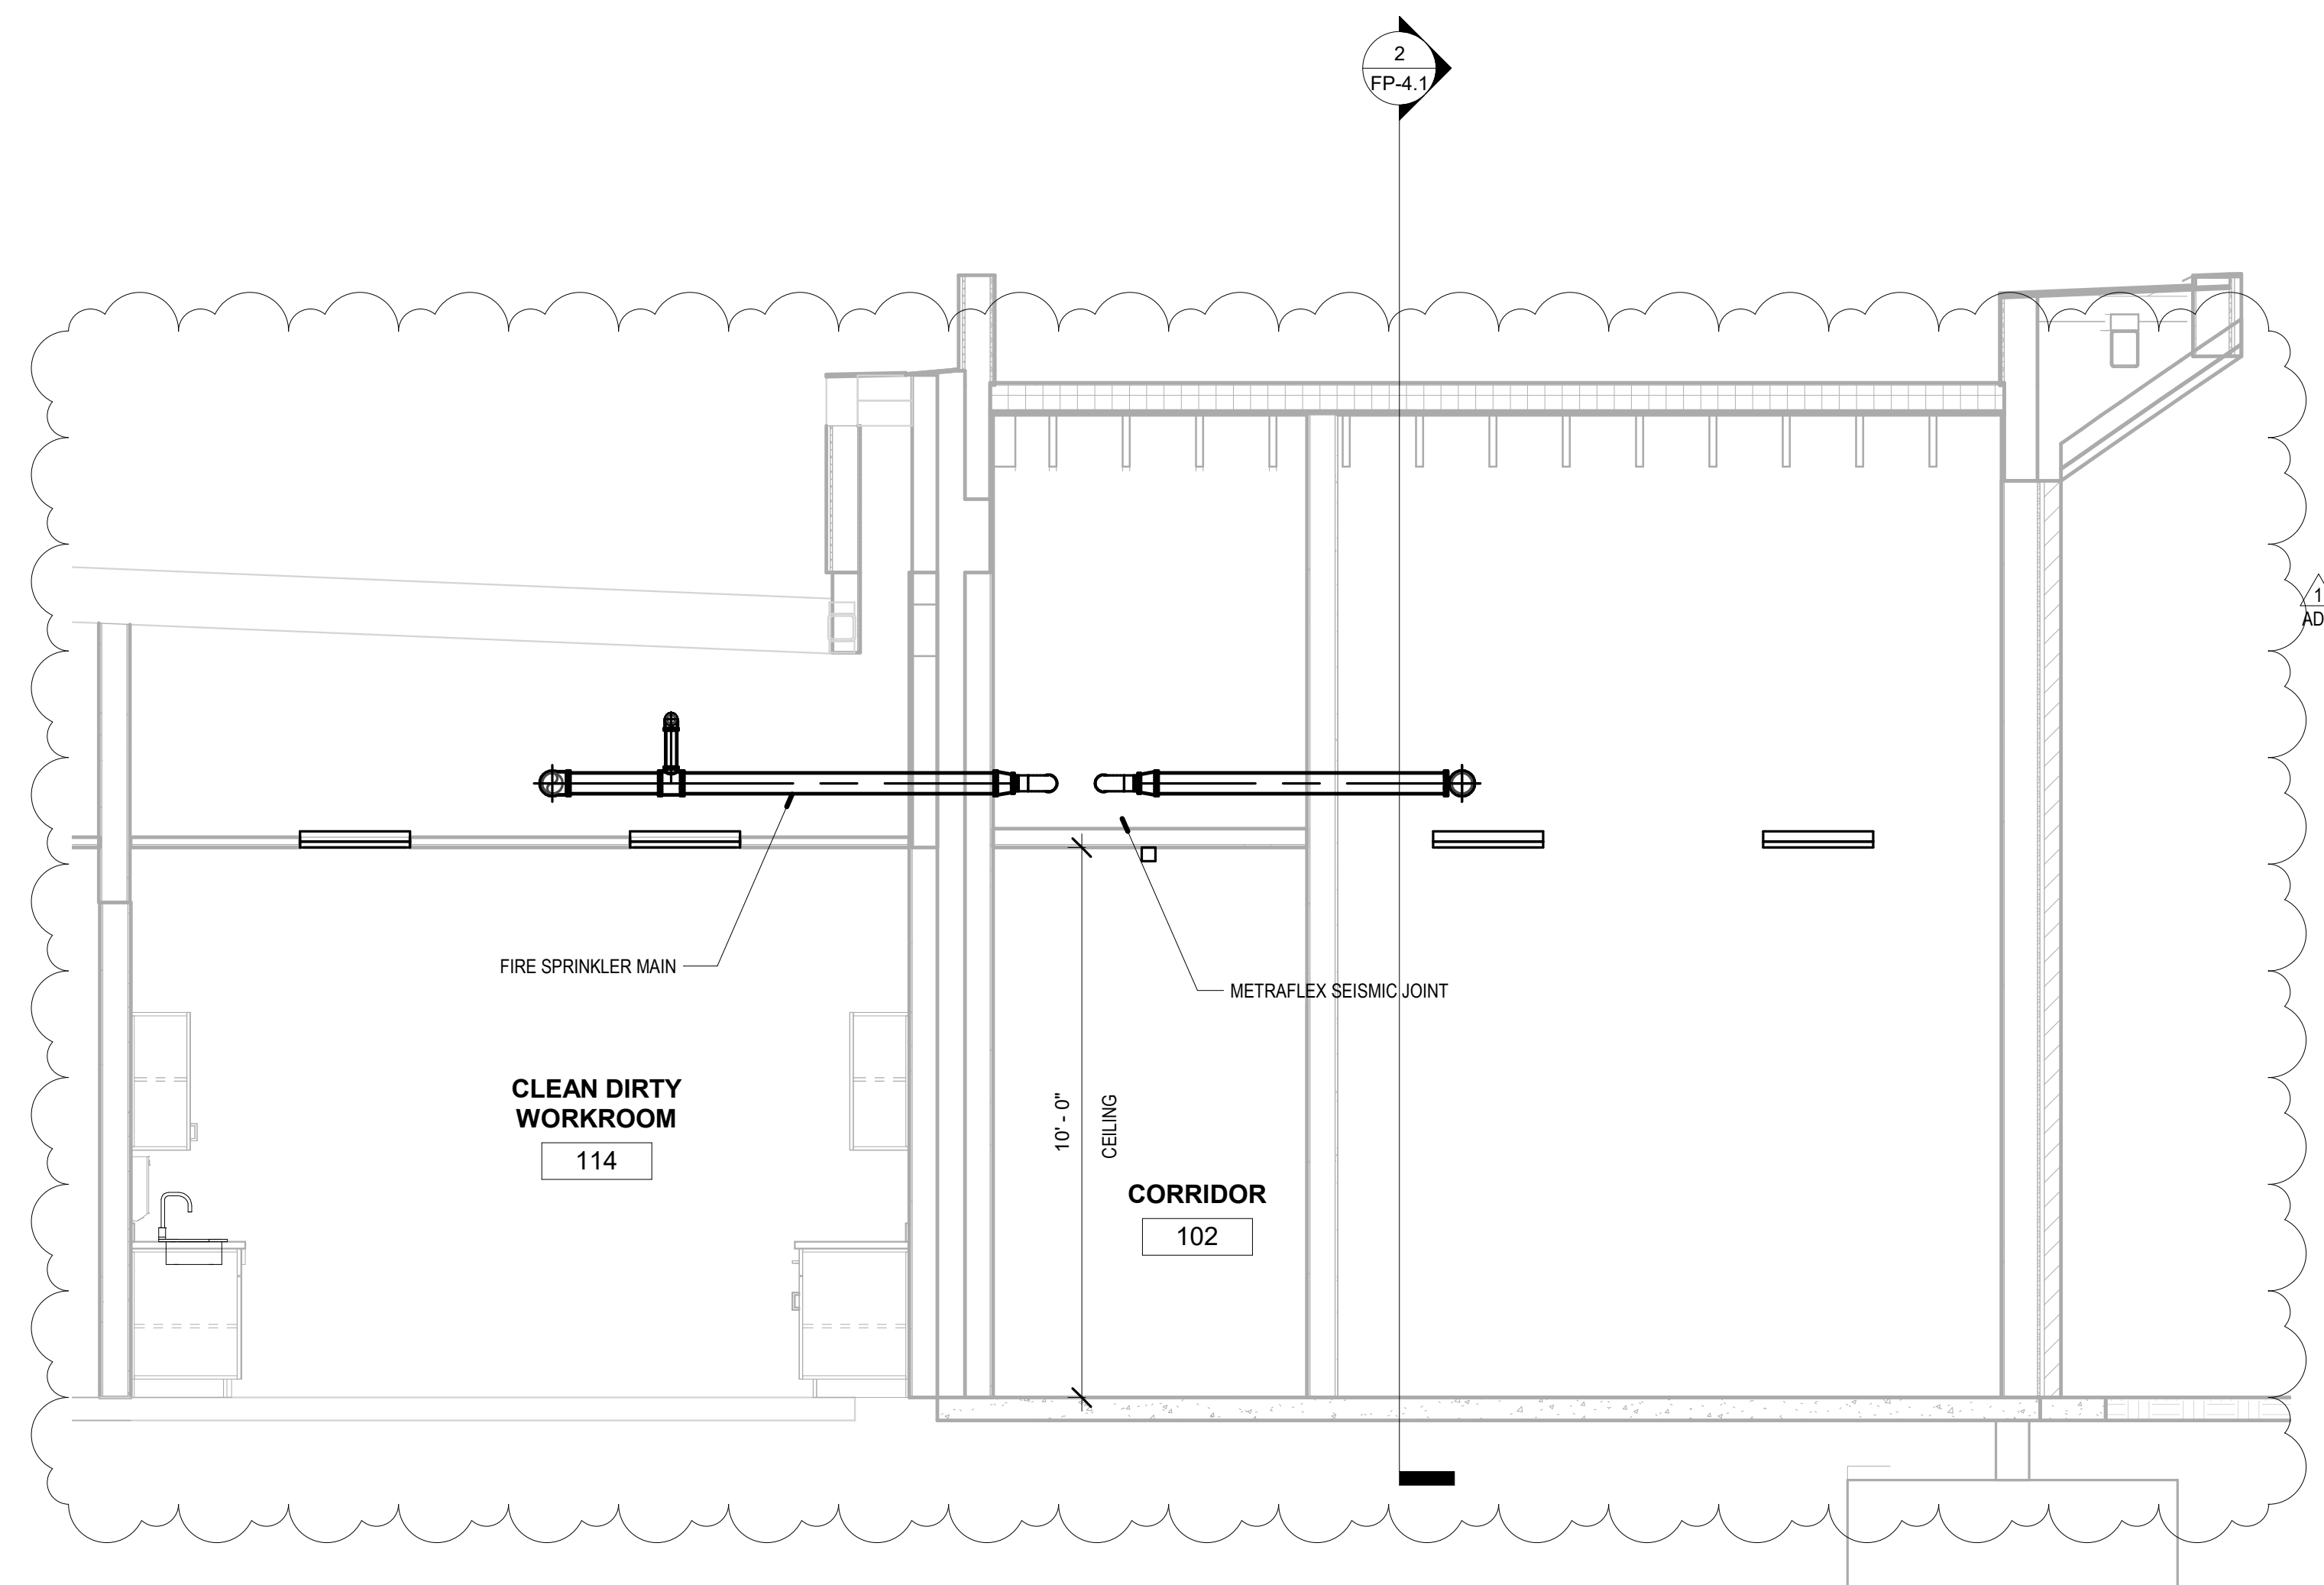

BILDING SECTION 1

$$3/8'' = 1'-0''$$

	1
--	---

**PROJECT No. :1-78-50**  
9/10/2025 12:26:56 PM

DRAWN BY: KM/AD      CHECKED BY: MS

DELTA # 1	DATE 09/09/2025	<input type="checkbox"/> ADD	<input type="checkbox"/> AFO	<input type="checkbox"/> CCD	<input type="checkbox"/> REV
DELTA # _____	DATE _____	<input type="checkbox"/> ADD	<input type="checkbox"/> AFO	<input type="checkbox"/> CCD	<input type="checkbox"/> REV
DELTA # _____	DATE _____	<input type="checkbox"/> ADD	<input type="checkbox"/> AFO	<input type="checkbox"/> CCD	<input type="checkbox"/> REV
DELTA # _____	DATE _____	<input type="checkbox"/> ADD	<input type="checkbox"/> AFO	<input type="checkbox"/> CCD	<input type="checkbox"/> REV

**RUHNAUCLARKE.COM**

3775 TENTH STREET, RIVERSIDE CALIFORNIA 92501 (951) 684 4664 / 5751 PALMER WAY, SUITE C, CARLSBAD CALIFORNIA 92010 (760) 438 5899

**INDIAN SPRINGS HIGH SCHOOL HEALTH CENTER**


**INDIAN SPRINGS HIGH SCHOOL**  
**650 N DEL ROSA DR, SAN BERNARDINO, CA 92410**  
**SAN BERNARDINO CITY UNIFIED SCHOOL DISTRICT**

## FIRE SPRINKLER BUILDING SECTIONS

## FP-4.1



STAMPS

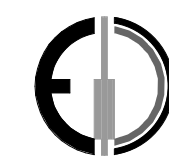

 412 E. Vanderbilt Way  
San Bernardino, CA 92408  
Phone: 909.890.3700  
Fax: 909.890.3770  
Email: [codd@designwesteng.com](mailto:codd@designwesteng.com)

---

**DESIGN WEST ENGINEERING**  
MECHANICAL • ELECTRICAL • ENERGY CONSULTANTS

### CONSULTANT BRANDING

RUHNAU  
CLARKE  
ARCHITECTS

## GENERAL NOTES

## CONSTRUCTION NOTES

PRINTED : 9/10/2025 12:26:56 PM  
 PATH: BIM 360://17850\_Wellness\_Center/24-094\_SBCUSD IS HS WC Mod Exp Redesign\_FP Central\_R21.rvt

**INDIAN SPRINGS HIGH SCHOOL HEALTH CENTER:**