

# ADDENDUM

Date Issued:	Nov 13, 2020			
Project:	Intermountain Healthcare Intermountain Logan Regional Hospital - ASC 1350 North 500 East Logan, UT 84341			
Addendum Number:	1			
The Contractors submitting proposals on the above-captioned project shall be governed by the				

The Contractors submitting proposals on the above-captioned project shall be governed by the following addendum, changes and explanations to the drawings and specifications and shall submit their bids in accordance therewith.

ltem Number	General Items Description
1	Questions by contractors and their response:
	Question #1: What is the man and material access that is being allowed to the project location? Is Stair #2 available for construction use? Is an existing building elevator available for construction use? Response: Yes, the west elevator is a freight elevator for construction use. Stair # 2 can be
	used for construction use.
	<b>Question # 2:</b> Does emergency egress through the project area have to be provided to other tenants to Stair #2?
	<b>Response:</b> No, the Fire Marshal deemed it is not a required exit after construction is complete and would not be required during construction either.
	<b>Question #3:</b> Are there any time limitations during the day when loud demolition work occurs and when work is required in other occupied spaces (i.e. – sanitary plumbing lines below the floor deck)?
	<b>Response:</b> Yes, there will be work restrictions to limit impact to an occupied health care facility. This will be addressed during the Pre-Bid walkthrough.
	Question # 4: Section 01 50 00 – Temporary Facilities and Controls states that the contractor is to pay for all utility charges. Unless the project space is metered separately from the rest of the building, is it possible to measure those costs? Response: The GC should not need to bring in any separate utilities from the facility. Power should be available in the shelled space and will not need to be metered separately. The Owner can back charge the project for additional monthly average costs. Water can be provided from an exterior hydrant as needed.
	Question # 5: What is the type membrane material and manufacturer of the existing roofing system? Does the existing roofing warranty require us to use the original membrane roof installer? Response: I have added the existing roofing submittal for the Budge Clinic to the same folder as the drawings for your reference.



ltem Number	General Items Description
	Question # 6: What is the height of the existing curtain walls at all locations? Are there existing exterior building elevations available to determine quantities? <b>Response:</b> I have included existing building drawings/elevations and photos of existing space in the same folder as the drawings for your reference. Existing drawings were provided to us by owner.
	Question # 7: Are there any windows to remain exposed in Prep / Recovery 4 similar to the other Prep / Recovery rooms? Response: Yes the top portion of the windows on the west side to remain exposed to view. Reference elevation detail 1,3, and 4 on sheet A251 and section detail 14/A503A. See attached picture of west side of the existing shelled space below.
	<b>Question # 8:</b> The Invitation to Bid states that a Bid Form is included in the Project Manual, but none has been found. Please provide. We need one for each project. <b>Response:</b> See attached Bid Forms for both projects.
	Question # 9: Bid Alternate #2 stated on G002 is differently worded then the Bid Alternate #2 stated on M001. Which is correct? Response: Revised Bid Alternates 1 and 2 on architectural sheet G002 to match mechanical. See attached Sheet G002
	Question # 10: What exterior site area is available for material unloading and construction use? Response: An outdoor staging area will be identified prior to or during the pre-bid walkthrough.



Sheet Number	Drawings
Architectu	ral Drawings
G002	Revised Bid Alternates 1 and 2 on architectural sheet G002 to match mechanical.
A141A	Added ICRA barriers
A143A, A144A, A147A, A149A	Per owner request, added counter mounted Omnicell in PACU # 1. Revised depth of counter and column furring wall to accommodate Omnicell. Provide two in-wall countertop supports per detail 5/A505B
A145A	Added ceiling mounted camera above Omnicell.
A251, A252	Per owner's request, deleted wall mounted light fixture in the Pre/Recovery and PACU bays.
Mechanic	al Drawings
	See attached mechanical addendum.
Electrical [	Drawings
	See attached electrical addendum.

## Attachments:

Architectural Drawings: G002, A141A, A143A, A144A, A145A, A147A, A149A, A251, and A252

### BID FORM

- TO: Shannon Brown Email: <u>Shannon.Brown@imail.org</u>
- PROJECT: Intermountain Healthcare LRH Campus Reconfiguration ASC 1350 North, 500 East Logan, UT 84341

BIDDER ADDRESS: \_\_\_\_\_

## DATE:\_\_\_\_\_

The undersigned, in compliance with your Invitation To Bid, having examined the Drawings and Specifications (Contract Documents) and related documents and the site of the proposed work and being familiar with all of the conditions surrounding the construction of the proposed project, including the availability of labor, hereby propose to furnish all labor, materials, services, equipment and appliances required in connection with or incidental to the construction of the above named project in strict conformance with the following specification and drawings:

Bidding and Contract Requirements, Intermountain Healthcare General Conditions, Specification Divisions as shown and all applicable addenda and Drawings as listed on the drawing cover sheets as prepared by NJRA Architects.

I/We certify, by signing this BID FORM, that I/We have a working relationship with the proposed subcontractors and that Bids we're not solicited from; and/or the received Contract Documents were not listed in any Plan Rooms for distribution to subcontractors broadly.

# **BASE BID** – for the Logan Regional Hospital, Ambulatory Surgical Center (ASC) Project for Intermountain Healthcare:

For Work of the contract listed above and shown on the Drawings and described in the Project Manual, I/We agree to perform for the sum of:

\_\_\_\_\_Dollars (\$\_\_\_\_\_\_)

(In the case of discrepancy, written amount shall govern)

# CONTRACTOR'S PROPOSED CONSTRUCTION TIME PERIOD:

This Bid requires a construction time in **calendar days** from the date of authorization of

calendar days. The anticipated date of Substantial Completion is thus \_\_\_\_\_, 20\_\_\_.

The above Bid includes \_\_\_\_\_\_ winter weather delay days.

## ALTERNATES:

Provide cost for each of the add alternates listed below

### Bid Alternate # 01:

Prefabricated modular ceiling system for operating rooms 1 and 2.

	Dollars \$	(Add)
(In the case of discrepancy, written amount shall ge	overn)	
<b>Bid Alternate # 02:</b> Prefabricated modular ceiling system for operating	rooms 1, 2 and 3.	
	Dollars \$	(Add)
(In the case of discrepancy, written amount shall ge	overn)	
<b>Bid Alternate # 03:</b> Stainless steel modular wall panel system for opera	ating rooms 1, 2 and 3.	
	Dollars \$	(Add)
(In the case of discrepancy, written amount shall ge	overn)	

## ADDENDA:

I/We acknowledge receipt of the following addenda for the above noted project:

Addendum #01: Addendum #02: Addendum #03:

## SCHEDULE OF VALUES:

I/We have attached with this Bid Form our Schedule of Values (Section 01 4373) which reflects the above Base Bid. We submit this for Owner review of subcontractors that are being proposed for this Project.

## **TYPE OF ORGANIZATION:**

(Corporation, Partnership, Individual, etc.)

SEAL (If a Corporation)

Respectfully Submitted,

Name of Bidder

Authorized Signature

### BID FORM

- TO: Shannon Brown Email: <u>Shannon.Brown@imail.org</u>
- PROJECT: Intermountain Healthcare LRH Campus Reconfiguration Sleep Lab 550 East, 1400 North, Suite R Logan, UT 84341

## NAME OF BIDDER: \_\_\_\_\_

BIDDER ADDRESS: \_\_\_\_\_

## DATE:\_\_\_\_\_

The undersigned, in compliance with your Invitation To Bid, having examined the Drawings and Specifications (Contract Documents) and related documents and the site of the proposed work and being familiar with all of the conditions surrounding the construction of the proposed project, including the availability of labor, hereby propose to furnish all labor, materials, services, equipment and appliances required in connection with or incidental to the construction of the above named project in strict conformance with the following specification and drawings:

Bidding and Contract Requirements, Intermountain Healthcare General Conditions, Specification Divisions as shown and all applicable addenda and Drawings as listed on the drawing cover sheets as prepared by NJRA Architects.

I/We certify, by signing this BID FORM, that I/We have a working relationship with the proposed subcontractors and that Bids we're not solicited from; and/or the received Contract Documents were not listed in any Plan Rooms for distribution to subcontractors broadly.

# **BASE BID** – for the Logan Regional Hospital, Sleep Lab Project for Intermountain Healthcare:

For Work of the contract listed above and shown on the Drawings and described in the Project Manual, I/We agree to perform for the sum of:

Dollars (\$\_\_\_\_\_)

(In the case of discrepancy, written amount shall govern)

# CONTRACTOR'S PROPOSED CONSTRUCTION TIME PERIOD:

This Bid requires a construction time in **calendar days** from the date of authorization of

calendar days. The anticipated date of Substantial Completion is thus \_\_\_\_\_, 20\_\_\_\_,

The above Bid includes \_\_\_\_\_\_ winter weather delay days.

## ALTERNATES:

None

## ADDENDA:

I/We acknowledge receipt of the following addenda for the above noted project:

Addendum #01: Addendum #02: Addendum #03:

## SCHEDULE OF VALUES:

I/We have attached with this Bid Form our Schedule of Values (Section 01 4373) which reflects the above Base Bid. We submit this for Owner review of subcontractors that are being proposed for this Project.

## TYPE OF ORGANIZATION:

(Corporation, Partnership, Individual, etc.)

SEAL (If a Corporation)


Respectfully Submitted,

Name of Bidder

Authorized Signature

&ANDDWL.DOV@ATDN.DOVØDIAMETERDN.DOVØDIAMETERD.S.DOV(E), EXIST.EXISTINGD.W.V.DRA(N)NEWDWG.DRAdPENNYE#POUND OR NUMBEREAACACOUSTICACACOUSTICEL.ADDADDENDUMELEV.A/CAIR CONDITIONINGEQ.ALT.ALTERNATEEQUIP.ALALUMINUMEXH.A.B.ANCHOR BOLTEXIST.ARCHARCHITECT(URAL)E.J.ASP.ASPHALTETBFBSMT.BASEMENTFI.FEET	ACE ON THE ERATING IATED E FOOTAGE AL, THE AL, THE NG ROOMS 1 IG, CEILING ARD LID BOOM AS DRAWINGS. NG ROOMS 1, TING, CEILING I'S 1 AND 2 TO G MOUNTED CEILING WITH SEE ING ROOMS 4-715-4426. E- DWN ON THE
AMBULATORY SURGERY CENTER (ASC) IN THE REFVIOUSLY SHILLED SHIP FOURT HOOR OF THE BUDGE CUINC. THE ASC WILL HAVE THREE OPER SOMS, FOUR PACU BAYS, RIGHT PREP/RECOVERY BAYS AND ASSOCU- SUPPORTS PACES FOR STAFF AND PATIENTS. THE APPROXIMATE SQUARE OF THE PROJECT IS 11.454 SF.         REVIEWING AGENCY: SINCE THIS IS AN OUTFATIENT CLINIC BUT LICENSED UNDER THE HOSPITZ PROJECT WILL BE REVIEWED BY THE FOLLOWING AGENCIES: 1. LOGAN CITY         2. UTAH DEPARTMENT OF HEALTH         3. STATE FIRE MARSHAL    BID ALTERNATE # 1 PROVIDE A PRE-FABRICATED MODULAR CEILING SYSTEM FOR OPERATIN AND 2. CEILING COMPONENTS TO INCLUDE SUPPLY DIFFUSES, LIGHTIM STRUUGE SUPPORTS AND RELATED ESCING SERVICES. 







AEA.ACACOUSTICADDADDENDUMA/CAIR CONDITIONINGA/CAIR CONDITIONINGALALUMINUMA.B.ANCHOR BOLTARCHARCHITECT(URAL)ASP.ASPHALTBFBSMT.BASEMENTFI.FET	AINAGE WASTE VE AWING
B F BSMT. BASEMENT FT. FEET	C. WATER COOLE CTRIC VATION JAL JIPMENT IAUST STING VANSION JOINT
BLKG.BLOCKINGF.E.FIREBD.BOARDF.E.C.FIREB.O.BOTTOM OFFIXT.FIXTLBLDCBUILDINGFIXTLFIXTL	t Sh(ED) E EXTINGUISHER E EXTINGUISHER C.
C.I.P.CAST IN PLACEGA.GAUC.B.CATCH BASING.C.GENCLG.CEILINGG.S.N.GENCLCENTER LINEGL.GLAC.T.CERAMIC TILEGD.GRACHCHANNELGRL.GRILC.O.CLEAN OUTGRD.GRC	NERAL CONTRACT NERAL STRUCTURA ASS ADE ILLE OUND
CL.CLOSETCOL.COLUMNHCONC.CONCRETEHDW.CMUCONCRETE MASONRY UNITHDWD.HARCOND.CONDITIONCONN.CONNECTIONHTR.HEATCONST.CONSTRUCTIONCONTCONTINUOUSH.M.CJCONTROL JOINTHORIZ.	rdware Rdwood Ater
D     H.W. HOT       D.P.     DAMP PROOFING       D.B.     DECK BEARING       DIAG.     DIAGONAL	T WATER UR
DIA. DIAMETER IN. INCH DIM. DIMENSION I.D. INSIE	CH IDE DIAMETER
	CAB'TCABINETGALV.GALC.I.P.CAST IN PLACEGA.GALC.B.CATCH BASING.C.GENCLG.CEILINGG.S.N.GENCLCENTER LINEGL.GL.C.T.CERAMIC TILEGD.GR.C.HCHANNELGRD.GRD.C.O.CLEAN OUTGRD.GRD.CL.CLOSETGYP.GYP.CONC.CONCRETEHDW.HARCOND.CONCRETE MASONRY UNITHDWD.HARCOND.CONDITIONHTR.HEACOND.CONTECTIONHT.HIGCONT.CONTROL JOINTHORIZ.HORDD.P.DAMP PROOFINGH.W.HOTDIAG.DIAGONALIIDIA.DIAGONALIN.IN.

# VICINITY MAP

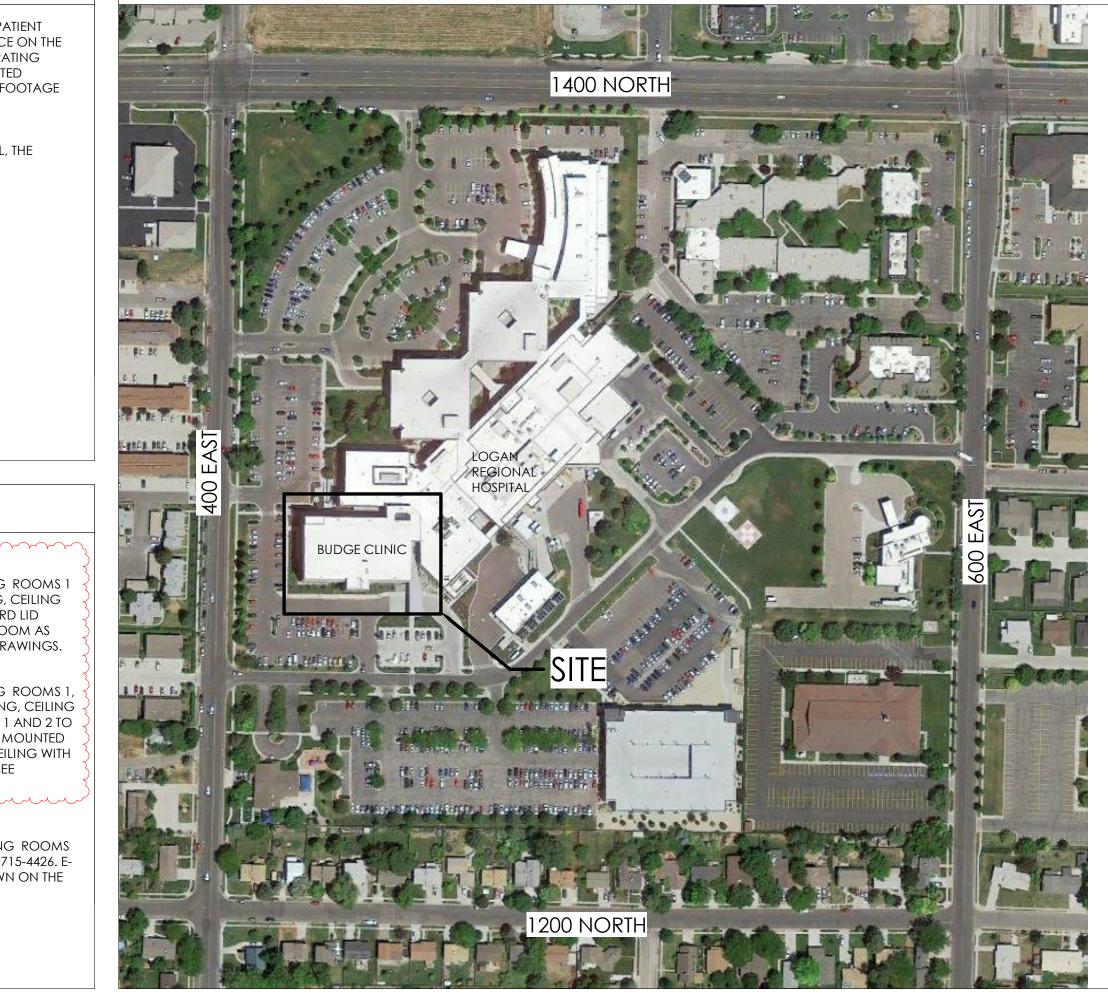

3

SER Spout GE WASTE VENT G ATER COOLER ON **NENT** ION JOINT INGUISHER INGUISHER CABIN ١G NIZED AL CONTRACTOR AL STRUCTURAL NO

4

		LAMINATED LANDING LAVATORY LIGHT LIGHT WEIGHT CONCR LOUVER
NET	MFR. M.O. MAT'L MAX. MECH. MTL. MIN.	MACHINE BOLT MANUFACTURER MASONRY OPENING MATERIAL MAXIMUM MECHANICAL METAL MINIMUM MOLDING MULLION
r NOTES	N/A N.I.C.	NATURAL GRADE NOMINAL NOT APPLICABLE NOT IN CONTRACT NOT TO SCALE
	0.D. 0.F.S.	ON CENTER OUTSIDE DIAMETER OVERFLOW SCUPPER OWNER FURNISHED, C INSTALLED
	<b>p</b> Pt. Ptd.	PAINT PAINTED

INSUL.

INT.

INV.

L

INSULATION

INTERIOR

INVERT

<b>J</b> JAN. JT. JST.	JANITOR JOINT JOIST
L LAM. LDG. LAV. LT. L.W.C. LVR.	LAMINATED LANDING LAVATORY LIGHT LIGHT WEIGHT CONCRETE LOUVER
MFR. M.O. MAT'L MAX. MECH. MTL. MIN. MLDG.	MACHINE BOLT MANUFACTURER MASONRY OPENING MATERIAL MAXIMUM MECHANICAL METAL MINIMUM MOLDING MULLION
N N.G. NOM. N/A N.I.C. N.T.S.	NATURAL GRADE NOMINAL NOT APPLICABLE NOT IN CONTRACT NOT TO SCALE
O.D.	ON CENTER OUTSIDE DIAMETER OVERFLOW SCUPPER OWNER FURNISHED, CONTRACTOR INSTALLED

PR. PAIR PNL. PANEL PENNY PLASTIC LAMINATE P.L.

# P.S.F. POUNDS PER SQUARE FOOT

RADIUS RECOMMENDATION REGISTER REQ'D REQUIRED RETURN AIR REVISION **ROOF DRAIN** ROOFING ROOM ROUGH ROUND

R

RAD.

REC.

REG.

R.A.

REV.

R.D.

RFG.

RM.

S

SEL.

SHT.

SIM.

SM.

SPL.

SQ.

S.S.

STD.

Т

T.G.

T&G

T&B

T.O.

U

V

ν.

VEST. VESTIBULE

RGH.

RND.

scr. sect. SCREW Section SELECT SHEET SIMILAR SLDG. sliding Smooth SPEC. SPECIFICATION SPLASH SQUARE STAINLESS STEEL STANDARD STRUC. STRUCTURE S.A. SUPPLY AIR SUSP. SUSPENDED sw.bd. switchboard

TELCO TELEPHONE COMPANY TEMPERED GLASS TONGUE & GROOVE top & Bottom TOP OF T.O.C. TOP OF CURB T.O.D. TOP OF DECK T.O.P. TOP OF PARAPET TYP. TYPICAL

VENT V.T.R. VENT THROUGH ROOF VERT. VERTICAL V.G. VERTICAL GRAIN

U.N.O. UNLESS NOTED OTHERWISE

# V.C.T. VINYL COMPOSITION TILE V.C.P. VITREOUS CLAY PIPE

NORTH

WATER HEATER WATER RESISTANT WIDE FLANGE WITHOUT WOOD

WELDED WIRE FABRIC

W.C. WATER CLOSET WATERPROOF W.W.F. WDW. WINDOW WITH

W.H.

W.R.

W.P.

W.F.

W/

W/O

WD.

**SPECIAL INSPECTIONS** 

d

PL.

1. SEE STRUCTURAL DRAWINGS FOR SPECIAL INSPECTIONS REQUIRED. 2. FIRESTOPPING PENETRATIONS

PLATE

P.S.I. POUND PER SQUARE INCH

PLBG. PLUMBING

# DEFINITIONS


1. GENERAL: BASIC CONTRACT DEFINITIONS ARE INCLUDED IN THE CONDITIONS OF THE CONTRACT. 2. "APPROVED": WHEN USED TO CONVEY ARCHITECT'S ACTION ON CONTRACTOR'S SUBMITTALS, APPLICATIONS, AND REQUESTS, "APPROVED" IS LIMITED TO ARCHITECT'S DUTIES AND RESPONSIBILITIES AS STATED IN THE CONDITIONS OF THE CONTRACT.


- 3. "DIRECTED": A COMMAND OR INSTRUCTION BY ARCHITECT. OTHER TERMS INCLUDING "REQUESTED," "AUTHORIZED," "SELECTED," "REQUIRED," AND "PERMITTED" HAVE THE SAME MEANING AS "DIRECTED." 4. "INDICATED": REQUIREMENTS EXPRESSED BY GRAPHIC REPRESENTATIONS OR IN
- WRITTEN FORM ON DRAWINGS, IN SPECIFICATIONS, AND IN OTHER CONTRACT documents. Other terms including "Shown," "Noted," "Scheduled," and "SPECIFIED" HAVE THE SAME MEANING AS "INDICATED."
- 5. "REGULATIONS": LAWS, ORDINANCES, STATUTES, AND LAWFUL ORDERS ISSUED BY AUTHORITIES HAVING JURISDICTION, AND RULES, CONVENTIONS, AND AGREEMENTS WITHIN THE CONSTRUCTION INDUSTRY THAT CONTROL PERFORMANCE OF THE WORK. 6. "FURNISH": SUPPLY AND DELIVER TO PROJECT SITE, READY FOR UNLOADING,
- UNPACKING, ASSEMBLY, INSTALLATION, AND SIMILAR OPERATIONS. 7. "INSTALL": UNLOAD, TEMPORARILY STORE, UNPACK, ASSEMBLE, ERECT, PLACE, ANCHOR, APPLY, WORK TO DIMENSION, FINISH, CURE, PROTECT, CLEAN, AND SIMILAR
- OPERATIONS AT PROJECT SITE. 8. "PROVIDE": FURNISH AND INSTALL, COMPLETE AND READY FOR THE INTENDED USE. 9. "PROJECT SITE": SPACE AVAILABLE FOR PERFORMING CONSTRUCTION ACTIVITIES. THE
- EXTENT OF PROJECT SITE IS SHOWN ON DRAWINGS AND MAY OR MAY NOT BE IDENTICAL WITH THE DESCRIPTION OF THE LAND ON WHICH PROJECT IS TO BE BUILT.

# DRAWING INDEX

2

		SE001	General Structural Notes
















PAUD     Pumbing Defails       PRODE     Med Gas Schedules       PRODE     Sheet Index, Abbreviations, And General Notes       EEAOI     Level 4 Overal Plan       EEAOI     Level 4 Overal Plan       EEAOI     Level 4 Overal Plan       EEAOI     Typical Mauning Heigh Defails       EEAOI     Level 4 Overal Plan       EEAOI     Typical Mauning Heigh Defails       EEAOI     Level 4 Electrical Demolition Plan       EEAOI     Basement Power Plan       EPAOI     Basement Power Plan       EPAOI     Basement Power Plan       EPAOI     Revel 4 Electrical Demolition Plan       EPAOI     Level 4 Power Plan       EPAOI     Power Plan       EPAOI     Power Plan       EPAOI     Level 4 Staedules       EPAOI     Foreal Schedules       EPAOI     Level 4 Elever Plan       EPAOI     Level 4 Elever Plan       EPAOI     Cone Line Diagram       EPAOI     Foreal Schedules       EPAOI     Cone Line Diagram       EPAOI     Level 4 Elever Non	Stol     Plumbing Defaults       Mod Gas Schedules       Mod Gas Schedules       EECTRICAL       EECTRICAL       EECTRICAL       EECTRICAL       EEADIO     Sched Index. Abbreviations, and General Notes       EEADIO     Electrical Details       EEADIO     Electrical Demolition Plan       EEADIO     Electrical Demolition Plan       EPADIO     Electrical Demolition Plan       EPADIO     Electrical Demolition Plan       EPADIO     Electrical Plane Plane       EPADIO     Electrical Plane Plane       EPADIO     Electrical Plane       EPADI	P143A	-










Plan         TS501       Telecom Schedules and Notes         ETA101       Level 4 Telecommunications Floor Plan         TS502       Telecom Equipment Rack Elevations         ETA503       Telecom Riser Diagram         ETA601       Telecom Rack Grounding Details         ETA601       Telecom Rack Grounding Details         ETA601       Telecom Riser Diagram         ETA601       Level 4 Auxiliary Plan         Auxiliary Schedules		
EPA602One-Line DiagramEPA603Equipmentil SchedulesEPA604Panel SchedulesEPA605Panel SchedulesEPA606Panel SchedulesEPA607Panel SchedulesELA01Level 4 Lighting PlanELA601Interior Lighting Fixture ScheduleELA602Lighting Relay Diagrams & SchedulesETA001Telecom Schedules and NotesETA0101Level 4 Telecommunications Floor PlanETA502Telecom Equipment Rack ElevationsETA503Telecom Equipment Rack Schedulig 












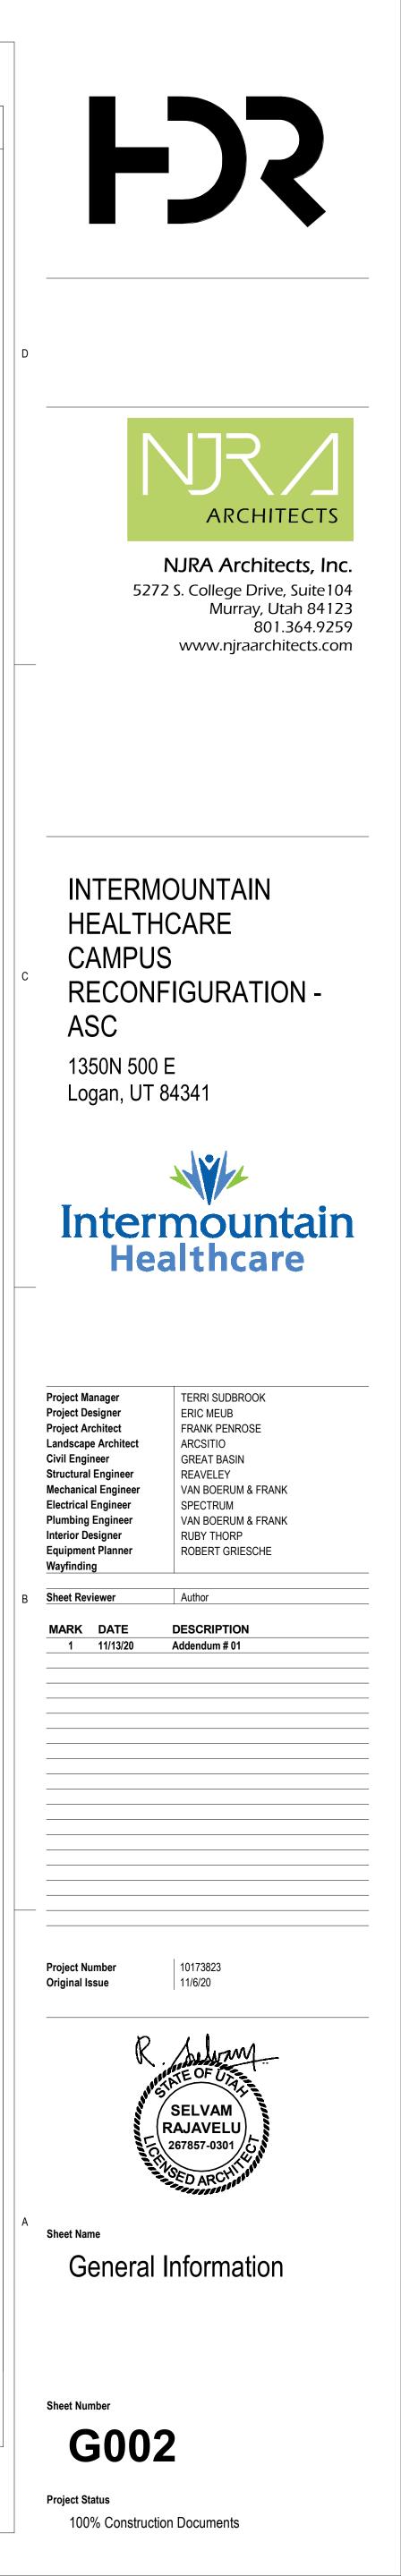

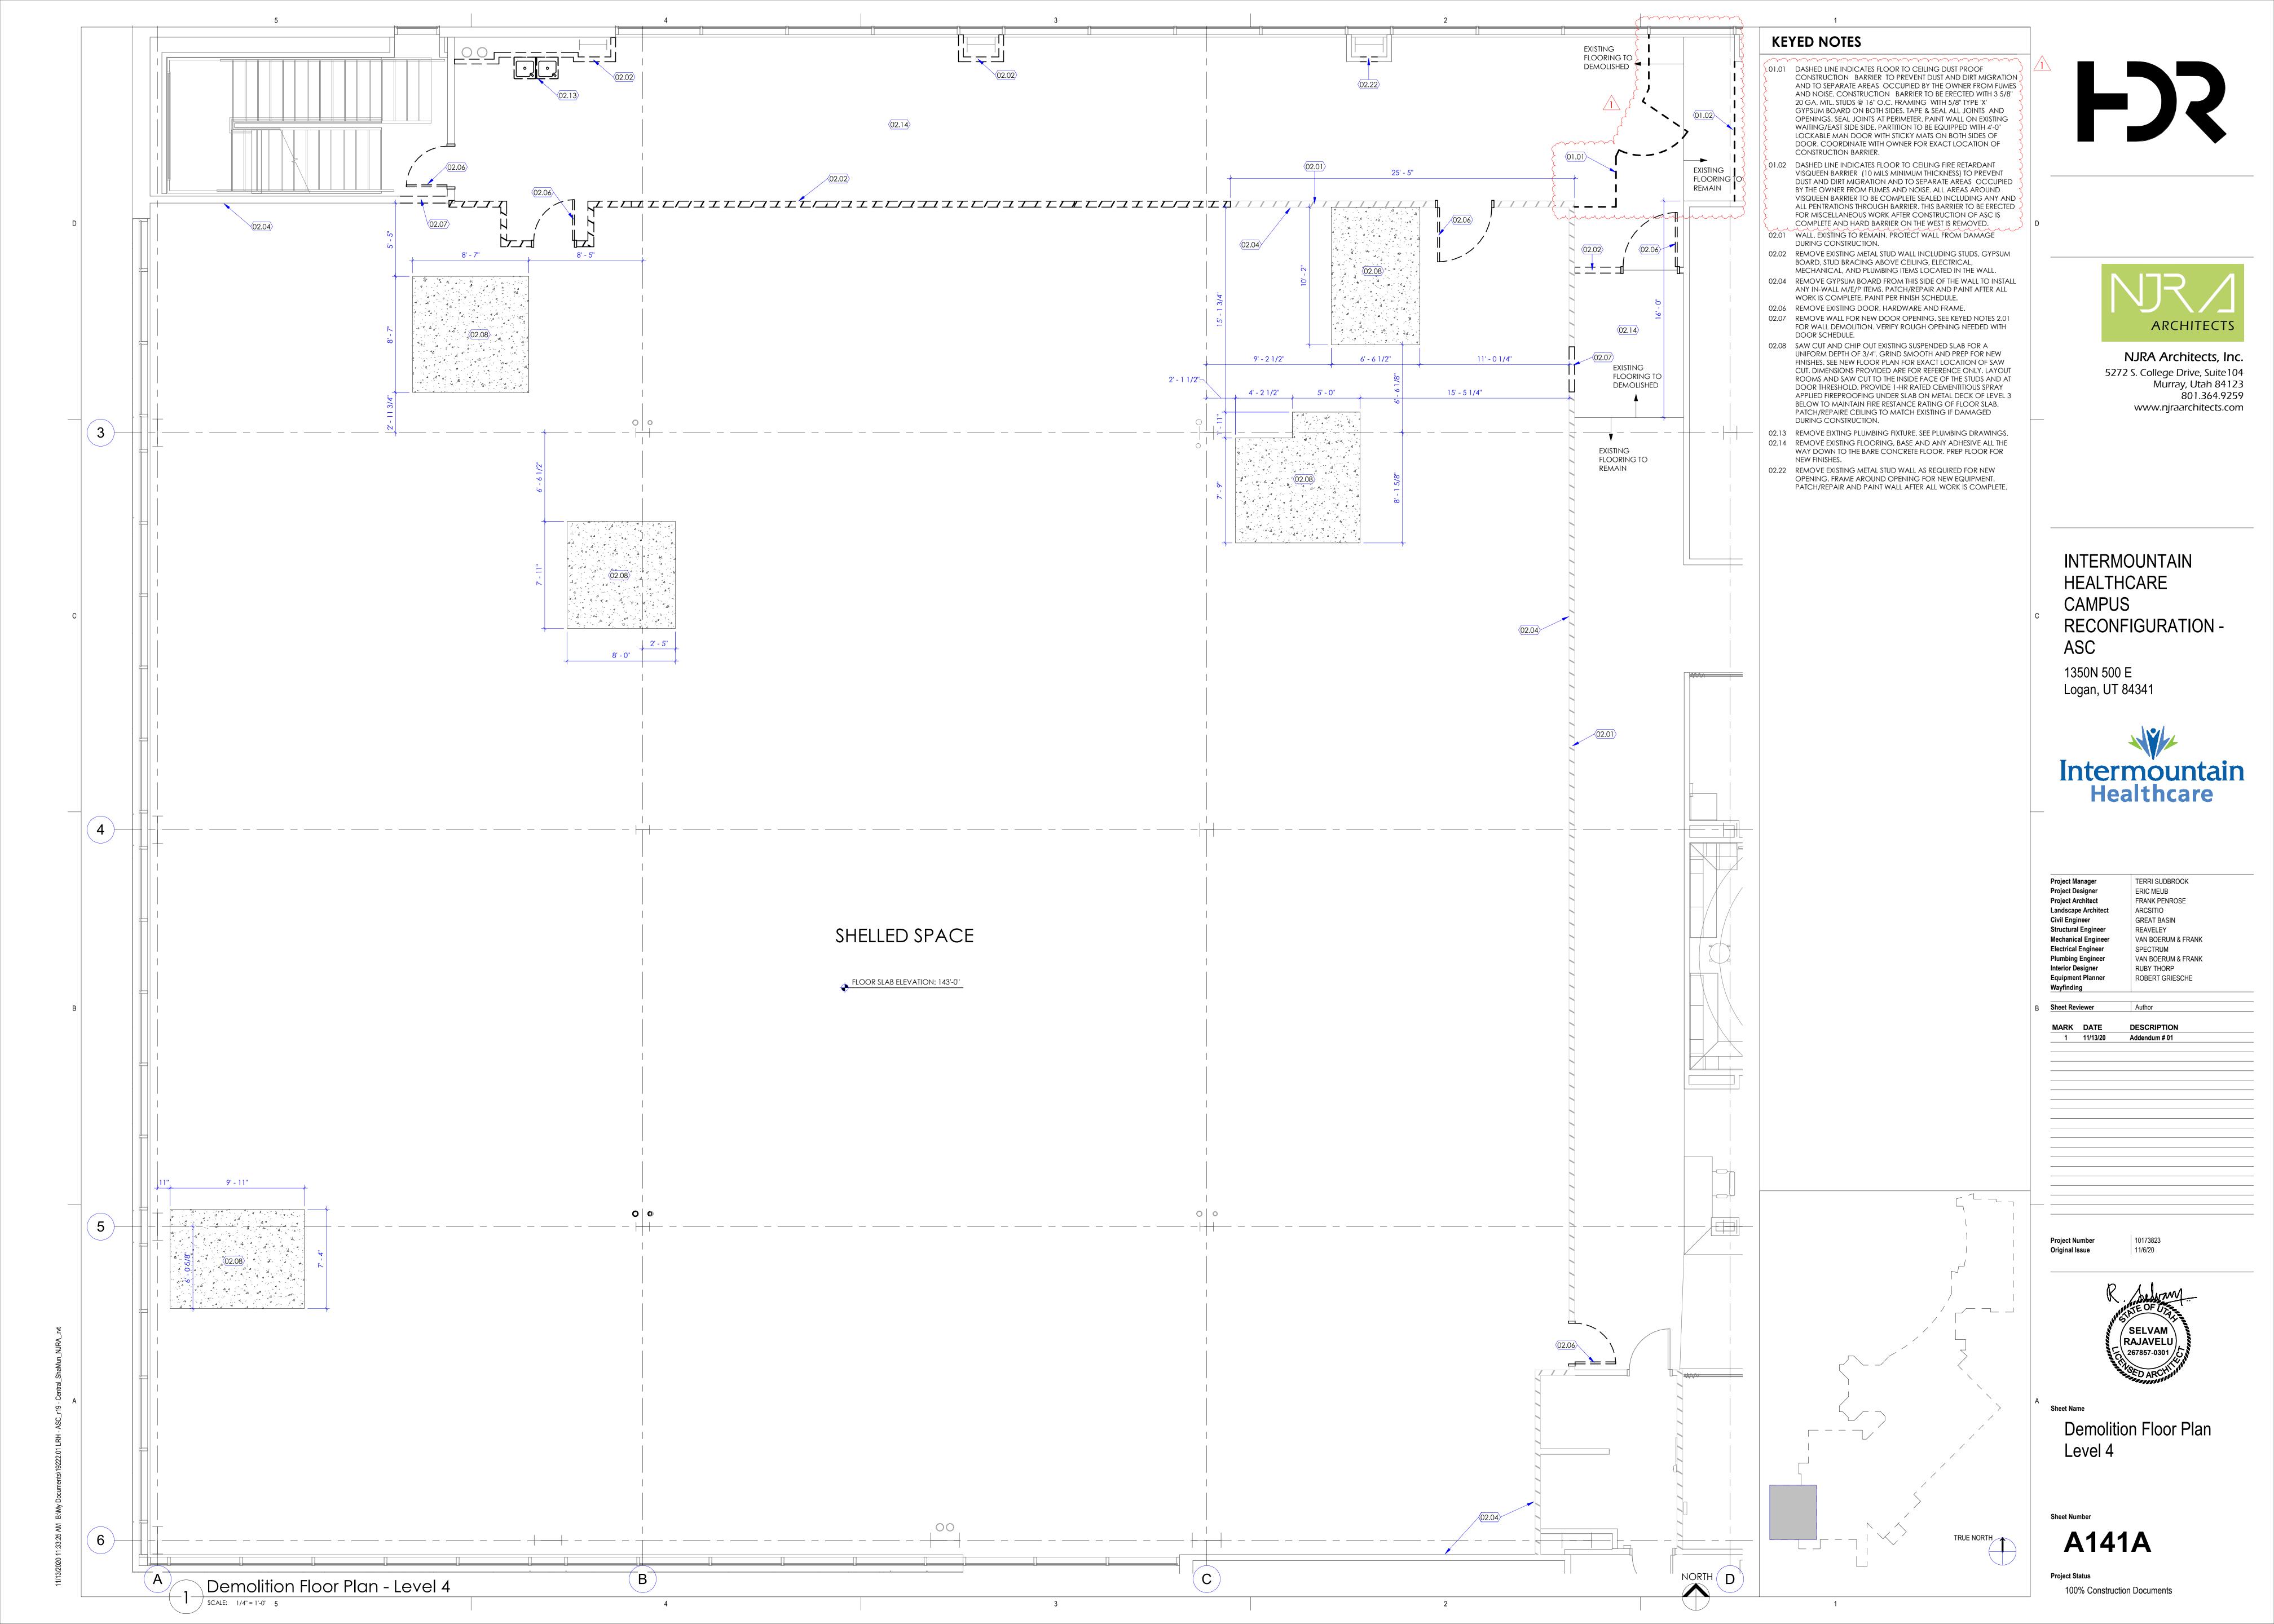



# **KEYED NOTES**

01.08 SEE PACU BAY #4 FOR TYPICAL NOTES. CONTRACTOR TO MOCK UP ONE BAY ON SITE FOR REVIEW BEFORE MOVING FORWARD WITH ALL BAYS. 01.09 SEE PREP/REC. BAY #5 FOR TYPICAL NOTES. CONTRACTOR TO MOCK UP ONE BAY ON SITE FOR REVIEW BEFORE MOVING FORWARD WITH ALL BAYS.

01.10 SEE PREP/RECOVERY BAY #2 FOR TYPICAL NOTES. 01.11 SEE BID ALTERNATES ON SHEET G002 FOR THE MODULAR CEILING AND THE STAINLESS STEEL WALL PANEL SYSTEM. ALSO SEE M/E/P DRAWINGS. CONTRACTOR TO MOCK UP ONE 'OR' ON SITE BEFORE MOVING FORWARD

WITH THE REST OF THE OR'S 05.07 FORMED ALUMINUM SILL EXTENDER. SEE DETAIL 6/A506A. 05.08 4" X 4" X 1/4" TUBE STEEL POST. ANCHOR TO STRUCTURE ABOVE. SEE DETAIL 8/A504A.

06.03 PLASTIC LAMINATE LOCKERS, 15"W X 18"D X 72"H (3-TIER). PROVIDE P-LAM CLOSER PANEL TO CEILING ABOVE AND 6" HIGH BASE. COORDINATE WITH OWNER FOR NUMBERING. 5% OF THE LOCKERS TO BE ADA ACCESSIBLE. 06.06 SOLID SURFACE COUNTER WITH FULL BULLNOSE EDGE AND INTEGRAL BACKSPLASH. SEE DETAIL 6/A505B. PROVIDE INTEGRAL SIDE SPLASH WHERE

COUNTER ABUTS PERPENDICULAR WALL/CABINET. 06.07 STAINLESS STEEL SINK. SEE PLUMBING DRAWINGS.

06.08 SOLID SURFACE INTEGRAL SINK. BASIS OF DESIGN: SAMSUNG, STARON A3181 SINK, COLOR "BRIGHT WHITE" BW010. ALSO SEE PLUMBING DWGS. 06.11 42" W X 20" D SOLID HARDWOOD ADA BENCH WITH FULL BULLNOSE EDGE. TOP OF BENCH TO BE AT 18" AFF. PROVIDE IN-WALL BRACKETS TO SUPPORT

BENCH. SEE DETAIL 5/A505C. STAIN WOOD TO MATCH P-LAM. 06.13 8" D WALL TO WALL SOLID SURFACE SHELF WITH FULL BULLNOSE EDGE - NO BACKSPLASH. PROVIDE TWO IN-WALL STEEL BRACKETS. SEE DETAIL 6/A505C.

06.14 18" D WALL TO WALL SOLID SURFACE SHELF WITH FULL BULLNOSE EDGE - NO BACKSPLASH. PROVIDE THREE IN-WALL STEEL BRACKETS. SEE DETAIL 6/A505C. 06.16 SOLID SURFACE TRANSACTION COUNTER WITH FULL BULLNOSE EDGE. SEE FINISH SCHEDULE. SEE DETAIL 7/A506A.

06.17 2'-0" WIDE X 6'-0" HIGH MIRROR WITH 1.5" WIDE X 1" THICK SOLID WOOD TRIM ALL AROUND. STAIN WOOD TO MATCH P-LAM.

08.01 NEW DOOR AND DOOR FRAME. SEE DOOR SCHEDULE. 08.03 ALUMINUM-FRAMED STOREFRONT SYSTEM. BASIS OF DESIGN: KAWNEER TRIFAB VERSA GLAZE 451. GLAZING TO BE 1/4" THICK, CLEAR TEMPERED,

CENTER GLAZED, WITH 2" SIGHTLINES AND 4-1/2" FRAME DEPTH. FINISH: ARCHITECTURAL CLASS 1 - CLEAR ANODIZED. 08.07 OVERHEAD AUTOMATED ROLL DOWN SECURITY GRILL. BASIS OF DESIGN

CORNELL ROLLING GRILLS, VISION AIRE, MODEL ESG10. SEE ELECTRICAL DRAWINGS FOR POWER REQUIREMENTS. 09.13 PARTIAL HEIGHT WALL WITH SOLID SURFACE TRANSACTION TOP. SEE WALL

TYPES AND FINISH SCHEDULE. 09.15 PARTIAL HEIGHT WALL WITH GLAZING ABOVE. SEE DETAIL 14/A506A. 09.18 ADD PRIVACY/ SUN CONTROL FILM ON EXISTING GLAZING FROM ROOM

SIDE. BASIS OF DESIGN 3M FASARA FILM. COLOR: SH2MAOW OPAQUE WHITE. TYPICAL AT ALL EXTERIOR WINDOWS WITH FURRING WALL IN FRONT. 10.01 GRAB BAR. PROVIDE GRAB BARS REQUIRED FOR WATER CLOSET, SHOWER, ETC. SEE RELEVANT DETAILS 1/G003 AND 1/G004 FOR MOUNTING HEIGHT, LOCATION, ETC. PROVIDE 'TYPE 2' BACKING PER DETAIL 5/A502A.

10.02 TOILET PAPER DISPENSER, OFCI. SEE SHEET G003 FOR MOUNTING HEIGHT. 10.03 PAPER TOWEL DISPENSER, OFCI. . SEE SHEET G003 FOR MOUNTING HEIGHT. 10.04 SOAP DISPENSER, OFCI. . SEE SHEET G003 FOR MOUNTING HEIGHT. 10.05 TOILET SEAT COVER DISPENSER. SEE SPECIFICATIONS. SEE SHEET GOO3 FOR

MOUNTING HEIGHT. 10.06 SANITARY NAPKIN DISPOSAL. SEE SPECIFICATIONS. 10.08 FOLD DOWN SHOWER SEAT. SEE RELEVANT DETAILS 1/G003 AND 1/G004 FOR

MOUNTING HEIGHT, LOCATION, ETC. ALSO SEE DETAIL 5/A506A. 10.09 SHOWER CURTAIN WITH CEILING MOUNTED TRACK. SEE DETAIL 13/A503A. 10.10 SHARPS DISPOSAL. OFCI. SEE SHEET G003 FOR MOUNTING HEIGHT.

10.11 GLOVES DISPENSER, OFCI. SEE SHEET G003 FOR MOUNTING HEIGHT. 10.12 COAT HOOK. BASIS OF DESIGN BOBRICK B-7672 DOUBLE ROBE HOOK.

10.17 METAL LOCKERS, 15"W X 18"D X 72"H (TWO TIER). PROVIDE SLOPED TOP AND 6 INCH HIGH BASE. 5% OF THE LOCKERS TO BE ADA ACCESSIBLE. 10.18 FULLY RECESSED FIRE EXTINGUISHER CABINET WITH EXTINGUISHER. SEE 9/A502A.

11.01 REFRIGERATOR, OFCI. SEE ELECTRICAL DRAWINGS.

2 MICROWAVE, OFCI. SEE ELECTRICAL DRAWINGS. FOR MICROWAVE IN WALL CABINET PROVIDE OUTLET IN THE CABINET ABOVE WITH A GROMMET OPENING AT THE BASE OF THIS CABINET.

11.05 ICE AND WATER DISPENSER. OWNER FURNISHED CONTRACTOR INSTALLED. SEE PLUMBING DRAWINGS. CAREFULLY CUT AROUND BACKSPLASH BEHIND TO ACCOMMODATE FOR WASHER BOX. BOTTOM OF WALL BOX TO BE ONE INCH ABOVE COUNTERTOP. ALSO SEE ELECTRICAL DRAWINGS FOR POWER. 1.07 COFFEE POT, OFCI. COFFEE POT TO BE PLUMBED. SEE PLUMBING DRAWINGS. ALSO SEE ELECTRICAL DRAWINGS.

11.10 PRINTER/COPIER. OFOI. SEE ELECTRICAL DRAWINGS FOR POWER AND DATA. 1.12 WALL MOUNTED MONITOR/TELEVISION OFCI. SEE ELECTRICAL DRAWINGS. PROVIDE 3'-0" W X 2'-0" H X 18 GA SHEET METAL BACKING. COORDINATE

LOCATION OF OUTLETS WITH MONITOR MOUNTING BRACKET. 15 AUTOMATED MEDICATION DISPENSER/OMNICELL. OFCI. SEE ELECTRICAL DRAWINGS FOR POWER AND DATA. PROVIDE A CCTV CAMERA ABOVE OMNICELL. SEE CEILING PLAN AND ELECTRICAL DRAWINGS.

1.18 WASTE DISPOSAL, WALL MOUNTED, OFCI.

11.19 EXAM TABLE, OFOI. SEE ELECTRICAL DRAWINGS FOR POWER. 1.20 WALL MOUNTED DIAGNOSTIC BOARD , OFCI. COORDINATE WITH ELECTRICAL DRAWINGS FOR POWER REQUIREMENTS. PROVIDE 'TYPE -2'

BACKING PER DETAIL 5/A502A. 1.21 PNEUMATIC TUBE STATION (PTS). PROVIDED AND INSTALLED BY GENERAL CONTRACTOR. CONTRACTOR TO USE SWISSLOG AS THE SUB-CONTRACTOR

FOR PTS. (INTERMOUNTAIN HEALTHCARE STANDARD). CONTRACTOR TO FRAME AND FINISH AROUND PTS. ALSO SEE ELECTRICAL DRAWINGS FOR POWER AND DATA REQUIREMENTS. COORDINATE SIZE AND LOCATION OF REQUIRED CORE DRILLS WITH SWISSLOG AND DEPARTMENT/AREA BELOW.

11.22 HIGH DENSITY MOVABLE WIRE SHELVING, OFCI. 11.24 RAIL SYSTEM FOR DETERGENT STORAGE CONTAINERS. FURNISHED BY STERIS, INSTALLED BY CONTRACTOR. PROVIDE 'TYPE 1' BACKING PER DETAIL 5/A502A. COORDINATE EXACT LOCATION WITH STERIS.

I.25 AUTOMATED PASS THROUGH WINDOW. FURNISHED BY STERIS, INSTALLED BY CONTRACTOR. COORDINATE WITH STERIS ON ROUGH OPENING DIMENSIONS. ALSO SEE ELECTRICAL DRAWINGS.

11.26 HEIGHT ADJUSTABLE INSTRUMENT ASSEMBLY TABLES, FURNISHED BY STERIS, INSTALLED BY CONTRACTOR. SEE ELECTRICAL DRAWINGS. 11.27 THREE COMPARTMENT SINK. FURNISHED BY STERIS, INSTALLED BY

CONTRACTOR. SEE PLUMBING DRAWINGS. 11.28 ULTRASONIC CLEANER. FURNISHED BY STERIS, INSTALLED BY CONTRACTOR.

SEE PLUMBING DRAWINGS. I.30 PASS THROUGH WASHER. FURNISHED BY STERIS, INSTALLED BY CONTRACTOR SEE PLUMBING DRAWINGS. PROVIDE A 87" W X 94" H FINISHED OPENING.

COORDINATE WITH STERIS. 1.31 SCRUB SINK. OFCI. SINK AND IN-WALL CARRIER PROVIDED BY OWNER, INSTALLED BY CONTRACTOR. ALSO SEE M/E/P DRAWINGS.

1.32 WALL MOUNTED PEG BOARD, OFCI. PROVIDE 'TYPE 2' BACKING PER DETAIL 5/A502A 11.33 NEPTUNE 2 DOCKING STATION, OFCI. PROVIDE 'TYPE 1' BACKING PER DETAIL

5/A502A. ALSO SEE M/E/P DRAWINGS. 11.34 NURSE CHARTING STATION. SEE DETAIL 13/A502A. ALSO SEE ELECTRICAL

DRAWINGS FOR POWER AND DATA. 11.35 PHYSIOLOGICAL MONITOR. SEE DETAIL 13/A502A. ALSO SEE ELECTRICAL

DRAWINGS FOR POWER AND DATA. 11.36 EMESIS BAG DISPENSER, OFCI.

11.37 WIPES DISPENSER, OFCI. 11.38 ANESTHESIA WORKSTATION. SEE DETAIL 13/A502A. ALSO SEE ELECTRICAL DRAWINGS FOR POWER AND DATA.

11.39 STRETCHER/BED, OFOI. 11.40 WALL MOUNTED THEMOMETER, OFCI.

11.41 EYEWEAR DISPENSER, OFCI. 11.42 CEILING MOUNTED TELEVISION AND BRACKET, OFCI. ANCHOR TO STRUCTURE/DECK ABOVE. ALSO SEE ELECTRICAL DRAWINGS FOR POWER AND DATA.

1.52 AMSCO V-PRO MAX2 HYDROGEN PEROXIDE STERILIZER. FURNISHED BY STERIS, INSTALLED BY CONTRACTOR. SEE M/E/P DRAWINGS.

11.53 AMSCO600 SERIES STEAM STERILIZER. FURNISHED BY STERIS, INSTALLED BY CONTRACTOR. SEE M/E/P DRAWINGS.

11.54 AMSCO400 SERIES SMALL STEAM STERILIZER. FURNISHED BY STERIS, INSTALLED BY CONTRACTOR. SEE M/E/P DRAWINGS.

11.56 FULLY RECESSED DEFIBRILLATOR AND CABINET. OFCI. 12.01 FURNITURE, TO BE PROVIDED AND INSTALLED BY OWNERS VENDOR (MIDWEST - MWCI). COORDINATE WITH MIDWEST FOR LOCATION OF ELECTRICAL AND DATA OUTLETS SUCH THAT THEY ARE NOT BEHIND PEDESTALS.

2.03 CEILING MOUNTED PRIVACY CURTAIN AND TRACK. SEE FINISH SCHEDULE AND PROJECT MANUAL. SEE DETAIL 12/A503A. 04 height adjustable sit/stand desk. Provided and installed by Owners VENDOR MIDWEST COMMERCIAL INTERIORS (MWCI). SEE ELECTRICAL

DRAWINGS FOR POWER. 22.01 FLOOR MOUNTED WATER CLOSET. SEE DETAILS 1/G003 AND 1/G004 FOR MOUNTING HEIGHT, LOCATION, ETC. SEE PLUMBING DRAWINGS.

22.02 WALL MOUNTED LAVATORY (SINK). SEE DETAILS 1/G003 AND 1/G004 FOR MOUNTING HEIGHT, LOCATION, ETC. SEE PLUMBING DRAWINGS.

22.03 FLOOR MOUNTED CLINICAL SINK. SEE PLUMBING DRAWINGS. 22.04 JANITOR'S FLOOR SINK. SEE PLUMBING DRAWINGS.

22.05 FLOOR SINK. SEE PLUMBING DRAWINGS. COORDINATE EXACT LOCATION WITH STERIS EQUIPMENT.

22.06 SHOWER HEAD. SEE RELEVANT DETAILS 1/G003 AND 1/G004 FOR MOUNTING HEIGHT, LOCATION, ETC. SEE PLUMBING DRAWINGS.

DRAIN AT 1/8" PER FOOT.

22.07 FLOOR DRAIN, SEE PLUMBING DRAWINGS. SLOPE FINISHED FLOOR TOWARDS 22.09 WALL MOUNTED EMERGENCY EYE WASH. SEE PLUMBING DRAWINGS.

22.12 FULLY RECESSED MEDICAL GAS ISOLATION VALVE. SEE PLUMBING DWGS.


22.13 WALL MOUNTED MED GASES. SEE PLUMBING DRAWINGS.


23.02 LOW AIR RETURN. SEE MECHANICAL DRAWINGS. 23.10 RECESSED MED GAS ALARM PANEL. SEE M/E/P DRAWINGS.

26.06 PUSH PAD/WAVE SENSOR FOR AUTOMATED DOOR ACTIVATION.SEE ELECTRICAL DRAWINGS.


26.16 CARD ACCESS. SEE ELECTRICAL DRAWINGS. 26.17 FULLY RECESSED ELECTRICAL ISOLATION PANELS. SEE ELECTRICAL DWGS.



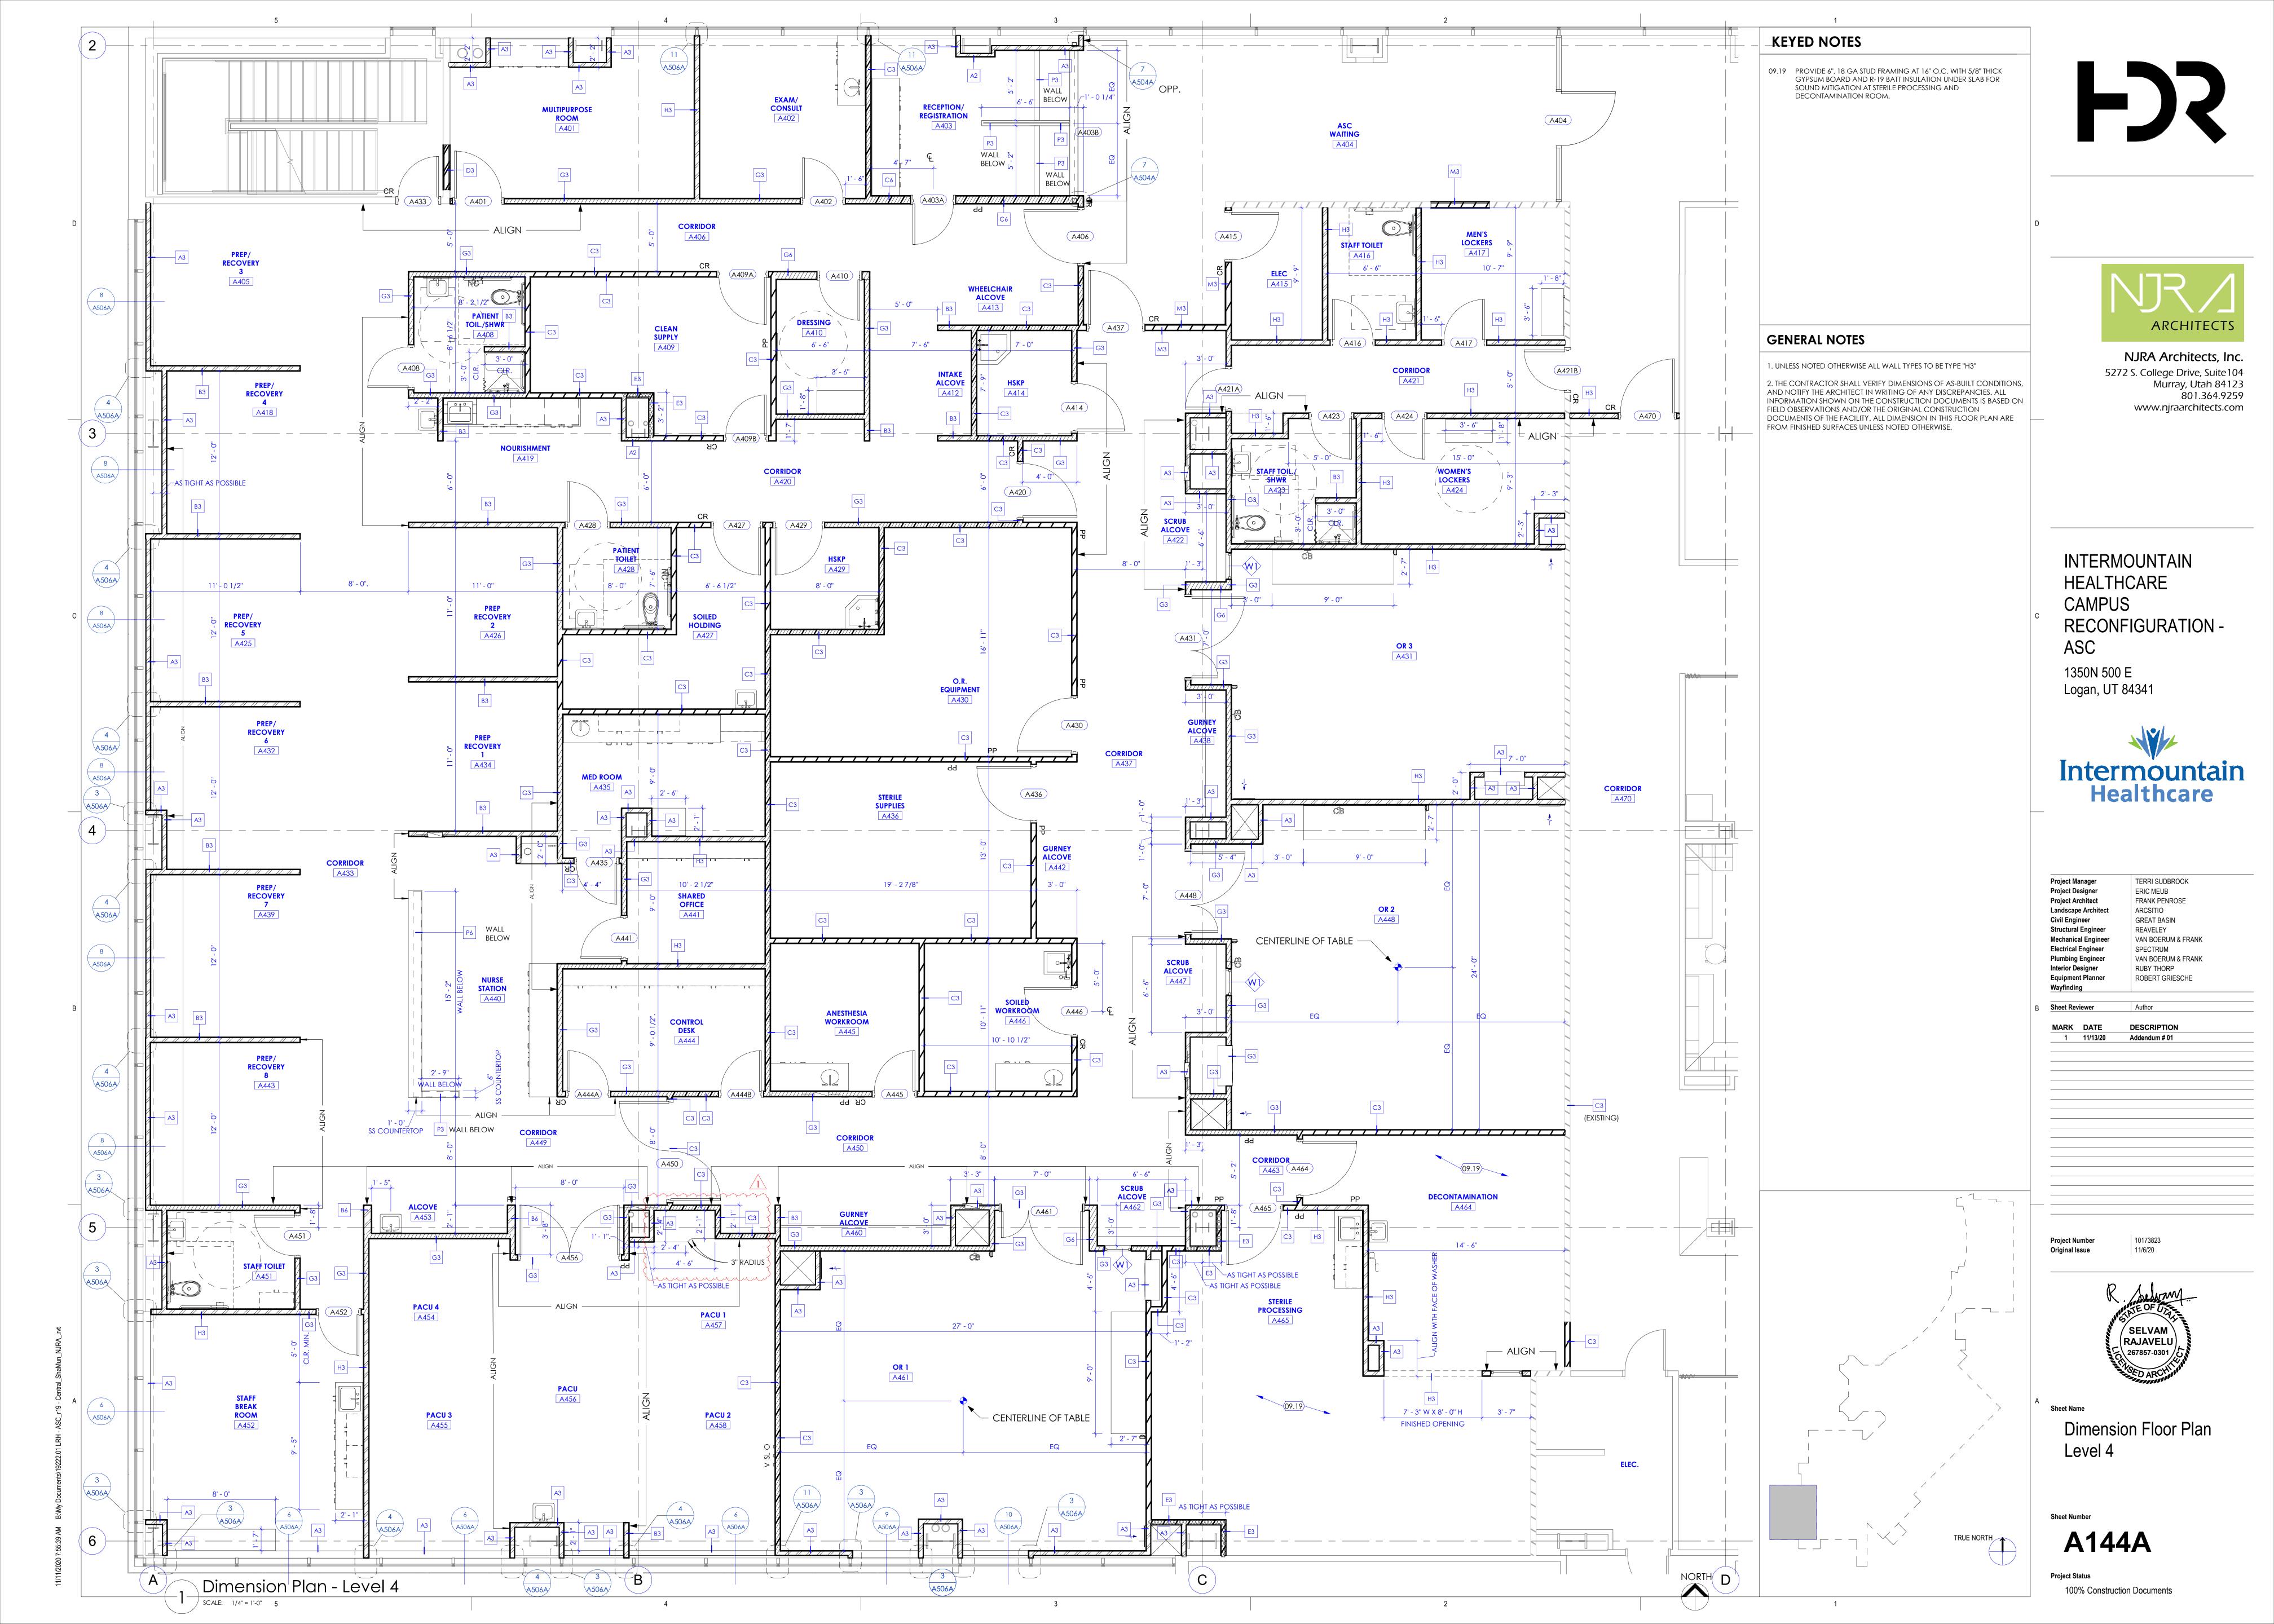

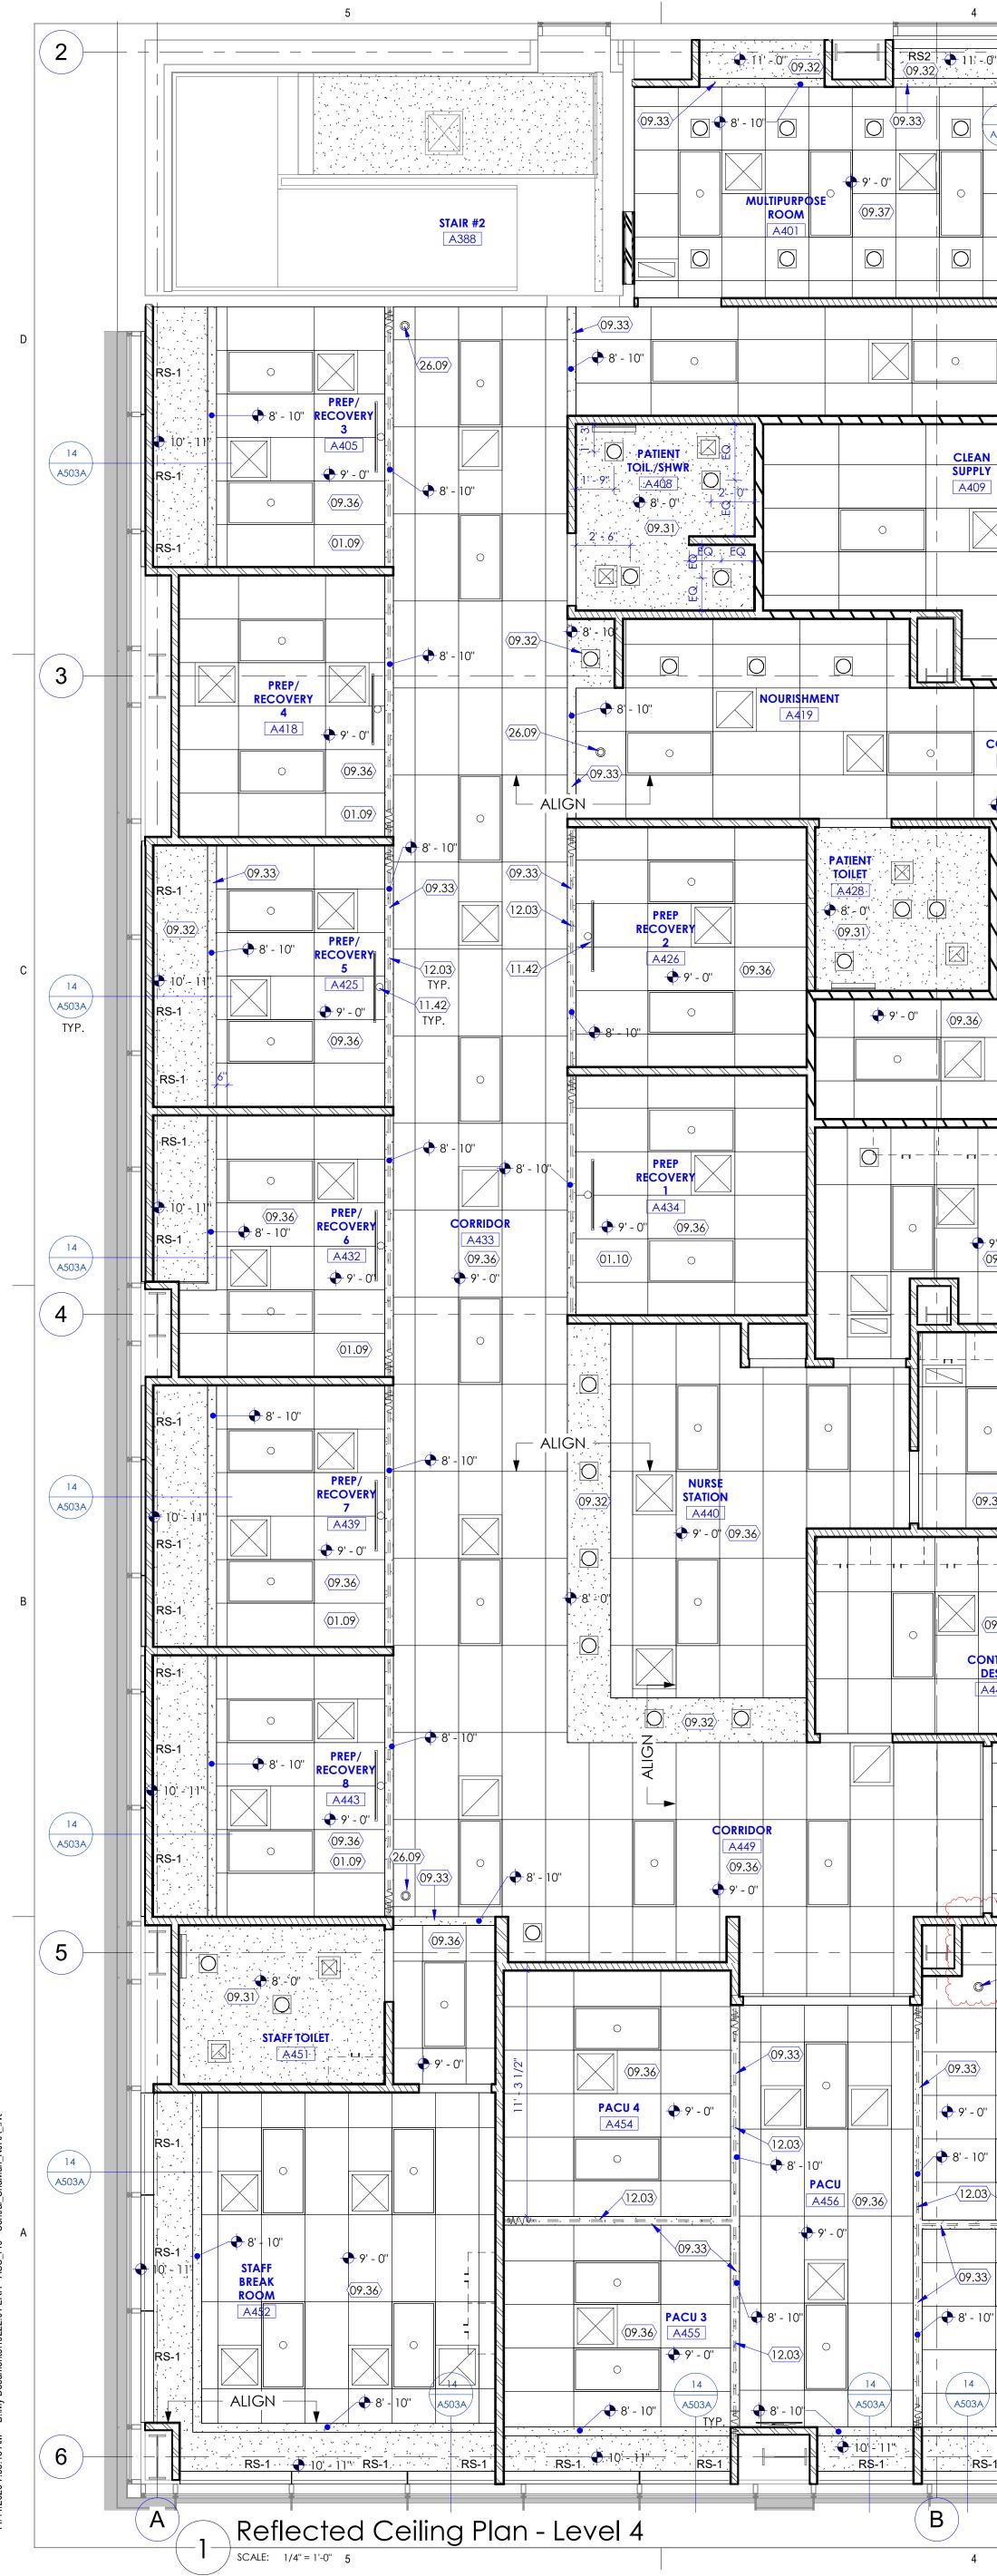



			3			
0". RS2 09.32 16 09.33 09.33 09.33	<ul> <li>↓ ↓ ↓ ↓ ↓ ↓ ↓ ↓ ↓ ↓ ↓ ↓ ↓ ↓ ↓ ↓ ↓ ↓ ↓</li></ul>	•       •	26.09 09.40 09.40 09.33	26.09 1 26.09 1 09.39 1 09.39 6 1 09.33 1 09.33	8'-6"	1'-4"
CORRIDOR A406 (09.36) N Y		26.09) TYP. • 9	<ul> <li>26.09</li> <li>26.09</li> <li>26.09</li> <li>WHEELCHAIR ALCOVE</li> </ul>	09.39	<ul> <li>♀'-0''</li> <li>♀'-0''</li> <li>♀ 8'-10''-</li> <li>♀ 8'</li></ul>	ELEC A415 09.3 01.12
<ul> <li>P</li> <li>○</li> <li>○</li> <li>○</li> </ul>	A410 9'-0" 09.36 0	CORRIDOR A411 O INTAKE ALCOVE A412	HSI (09.31) A44 (09.31) A44 (0	P		NO CEILING. OPEN TO STRUCTURE ABOVE
09.36) CORRIDOR A420	09.33 O HSKP A4229		o"	9'-0" C C C C C C C C C C C C C	09.32 09.32 09.32 0 0 8' - 16 ALCOVE A422 0	STAFF TOIL./ SHWR A423
SOILED HOLDING A427			O.R. JIPMENT A430 9' - 0' (09.36)			OR 3 A431 NO CEILING. OPEN TO STRUCTURE ABOVE
9' - 0'' 09.36 0 		STERILE SUPPLIES		GURNEY O	DR GURNEY ALCOVE A438	
<ul> <li></li></ul>	(26.09)	A436			09.41	
<ul> <li>→ + + → + + + + + + + + + + + + + + + +</li></ul>	○           ◆ 9' - 0"           ○	ANESTHESIA       WORKROOM       A445       (09.36)	○           SOILED           WORKROOM           A446           ◆ 9' - 0			
	GU ALC	9' - 0'' <b>RNEY</b>				PRRIDOR A463 ○ 09.36 • 9' - 0' □ □ □ □ □ □ □ □ □ □ □ □ □ □ □ □ □ □ □
26.09       PACU 1       A457       y"       09.36				OR 1         ▲461         ↓		○       [         Image: Sterile processing A465       ○         Image: A465       ○
3 3 0 0 0 0 0 0 0 0 0 0 0 0 0			LTS0722 Surgical Light with Monitor Arm	0 (11.43)		(09.38)       0
S-1	23.03 TYP. 10'-1	· _				

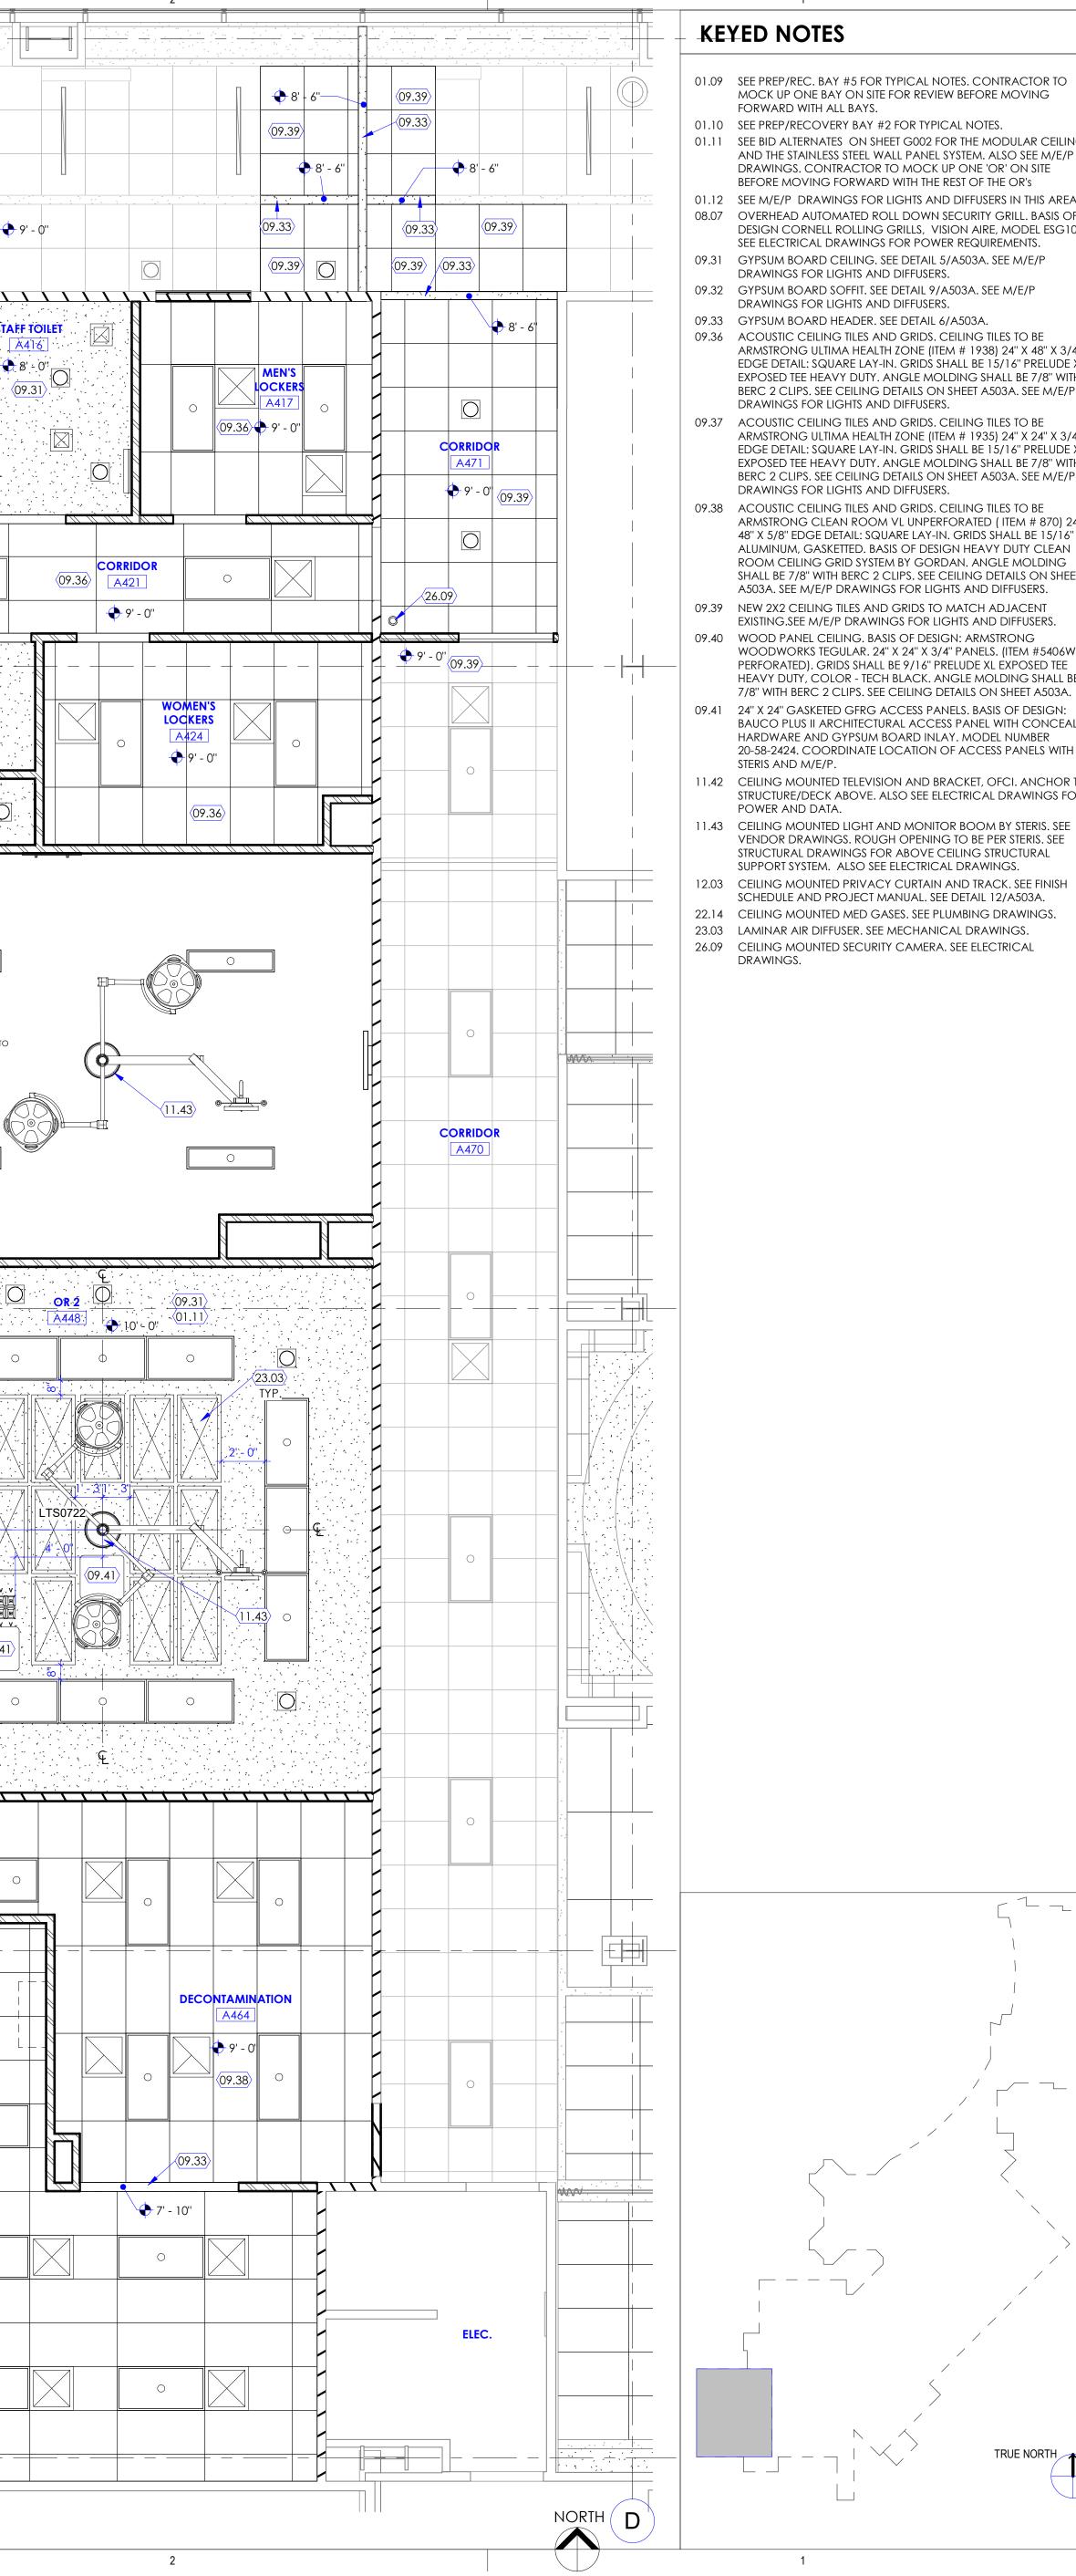


# **KEYED NOTES**

MOCK UP ONE BAY ON SITE FOR REVIEW BEFORE MOVING FORWARD WITH ALL BAYS. 01.10 SEE PREP/RECOVERY BAY #2 FOR TYPICAL NOTES. 01.11 SEE BID ALTERNATES ON SHEET G002 FOR THE MODULAR CEILING AND THE STAINLESS STEEL WALL PANEL SYSTEM. ALSO SEE M/E/P DRAWINGS. CONTRACTOR TO MOCK UP ONE 'OR' ON SITE BEFORE MOVING FORWARD WITH THE REST OF THE OR's 01.12 SEE M/E/P DRAWINGS FOR LIGHTS AND DIFFUSERS IN THIS AREA. 08.07 OVERHEAD AUTOMATED ROLL DOWN SECURITY GRILL. BASIS OF DESIGN CORNELL ROLLING GRILLS, VISION AIRE, MODEL ESG10. SEE ELECTRICAL DRAWINGS FOR POWER REQUIREMENTS. 09.31 GYPSUM BOARD CEILING. SEE DETAIL 5/A503A. SEE M/E/P DRAWINGS FOR LIGHTS AND DIFFUSERS. 09.32 GYPSUM BOARD SOFFIT. SEE DETAIL 9/A503A. SEE M/E/P DRAWINGS FOR LIGHTS AND DIFFUSERS. 09.33 GYPSUM BOARD HEADER. SEE DETAIL 6/A503A. 09.36 ACOUSTIC CEILING TILES AND GRIDS. CEILING TILES TO BE ARMSTRONG ULTIMA HEALTH ZONE (ITEM # 1938) 24" X 48" X 3/4" EDGE DETAIL: SQUARE LAY-IN. GRIDS SHALL BE 15/16" PRELUDE XL EXPOSED TEE HEAVY DUTY. ANGLE MOLDING SHALL BE 7/8" WITH BERC 2 CLIPS. SEE CEILING DETAILS ON SHEET A503A. SEE M/E/P DRAWINGS FOR LIGHTS AND DIFFUSERS. 09.37 ACOUSTIC CEILING TILES AND GRIDS. CEILING TILES TO BE ARMSTRONG ULTIMA HEALTH ZONE (ITEM # 1935) 24" X 24" X 3/4" EDGE DETAIL: SQUARE LAY-IN. GRIDS SHALL BE 15/16" PRELUDE XL EXPOSED TEE HEAVY DUTY. ANGLE MOLDING SHALL BE 7/8" WITH BERC 2 CLIPS. SEE CEILING DETAILS ON SHEET A503A. SEE M/E/P DRAWINGS FOR LIGHTS AND DIFFUSERS. 09.38 ACOUSTIC CEILING TILES AND GRIDS. CEILING TILES TO BE ARMSTRONG CLEAN ROOM VL UNPERFORATED (ITEM # 870) 24" X 48" X 5/8" EDGE DETAIL: SQUARE LAY-IN. GRIDS SHALL BE 15/16" ALUMINUM, GASKETTED. BASIS OF DESIGN HEAVY DUTY CLEAN ROOM CEILING GRID SYSTEM BY GORDAN. ANGLE MOLDING SHALL BE 7/8" WITH BERC 2 CLIPS. SEE CEILING DETAILS ON SHEET A503A. SEE M/E/P DRAWINGS FOR LIGHTS AND DIFFUSERS. 09.39 NEW 2X2 CEILING TILES AND GRIDS TO MATCH ADJACENT EXISTING.SEE M/E/P DRAWINGS FOR LIGHTS AND DIFFUSERS. 09.40 WOOD PANEL CEILING. BASIS OF DESIGN: ARMSTRONG WOODWORKS TEGULAR. 24" X 24" X 3/4" PANELS. (ITEM #5406W5 -PERFORATED). GRIDS SHALL BE 9/16" PRELUDE XL EXPOSED TEE HEAVY DUTY, COLOR - TECH BLACK. ANGLE MOLDING SHALL BE 7/8" WITH BERC 2 CLIPS. SEE CEILING DETAILS ON SHEET A503A. 09.41 24" X 24" GASKETED GFRG ACCESS PANELS. BASIS OF DESIGN: BAUCO PLUS II ARCHITECTURAL ACCESS PANEL WITH CONCEALED HARDWARE AND GYPSUM BOARD INLAY. MODEL NUMBER 20-58-2424. COORDINATE LOCATION OF ACCESS PANELS WITH STERIS AND M/E/P. 11.42 CEILING MOUNTED TELEVISION AND BRACKET, OFCI. ANCHOR TO STRUCTURE/DECK ABOVE. ALSO SEE ELECTRICAL DRAWINGS FOR POWER AND DATA. 11.43 CEILING MOUNTED LIGHT AND MONITOR BOOM BY STERIS. SEE VENDOR DRAWINGS. ROUGH OPENING TO BE PER STERIS. SEE STRUCTURAL DRAWINGS FOR ABOVE CEILING STRUCTURAL SUPPORT SYSTEM. ALSO SEE ELECTRICAL DRAWINGS. 12.03 CEILING MOUNTED PRIVACY CURTAIN AND TRACK. SEE FINISH SCHEDULE AND PROJECT MANUAL. SEE DETAIL 12/A503A. 22.14 CEILING MOUNTED MED GASES. SEE PLUMBING DRAWINGS. 23.03 LAMINAR AIR DIFFUSER. SEE MECHANICAL DRAWINGS. 26.09 CEILING MOUNTED SECURITY CAMERA. SEE ELECTRICAL DRAWINGS.

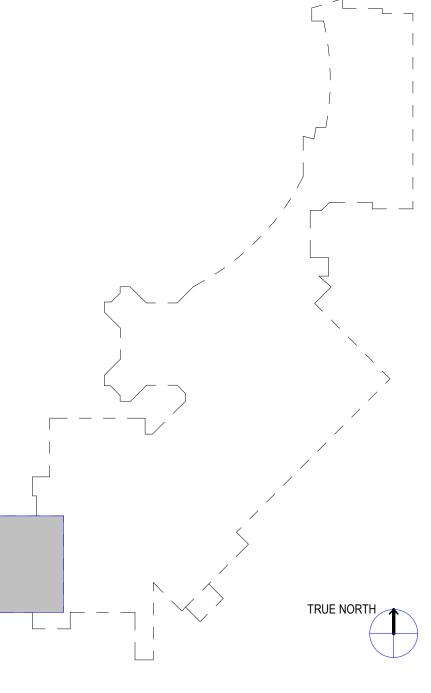

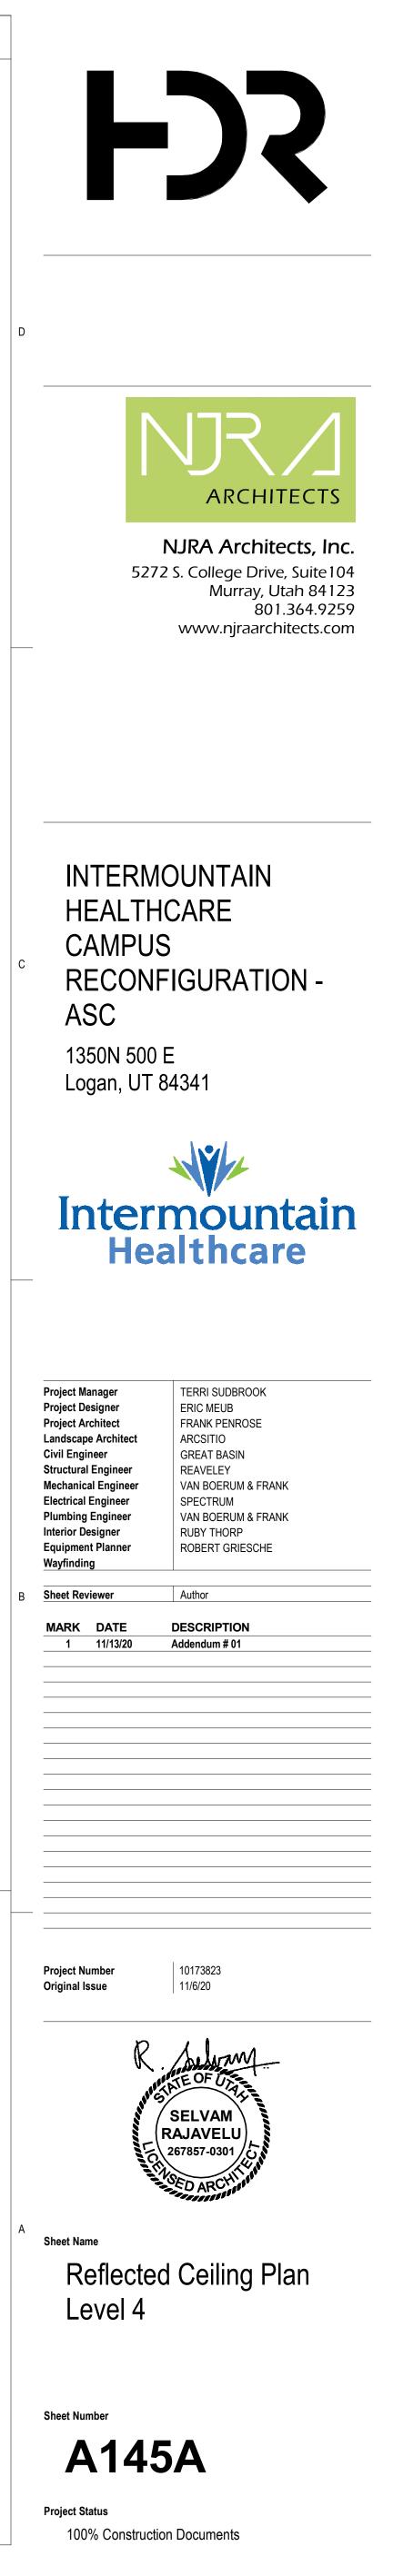

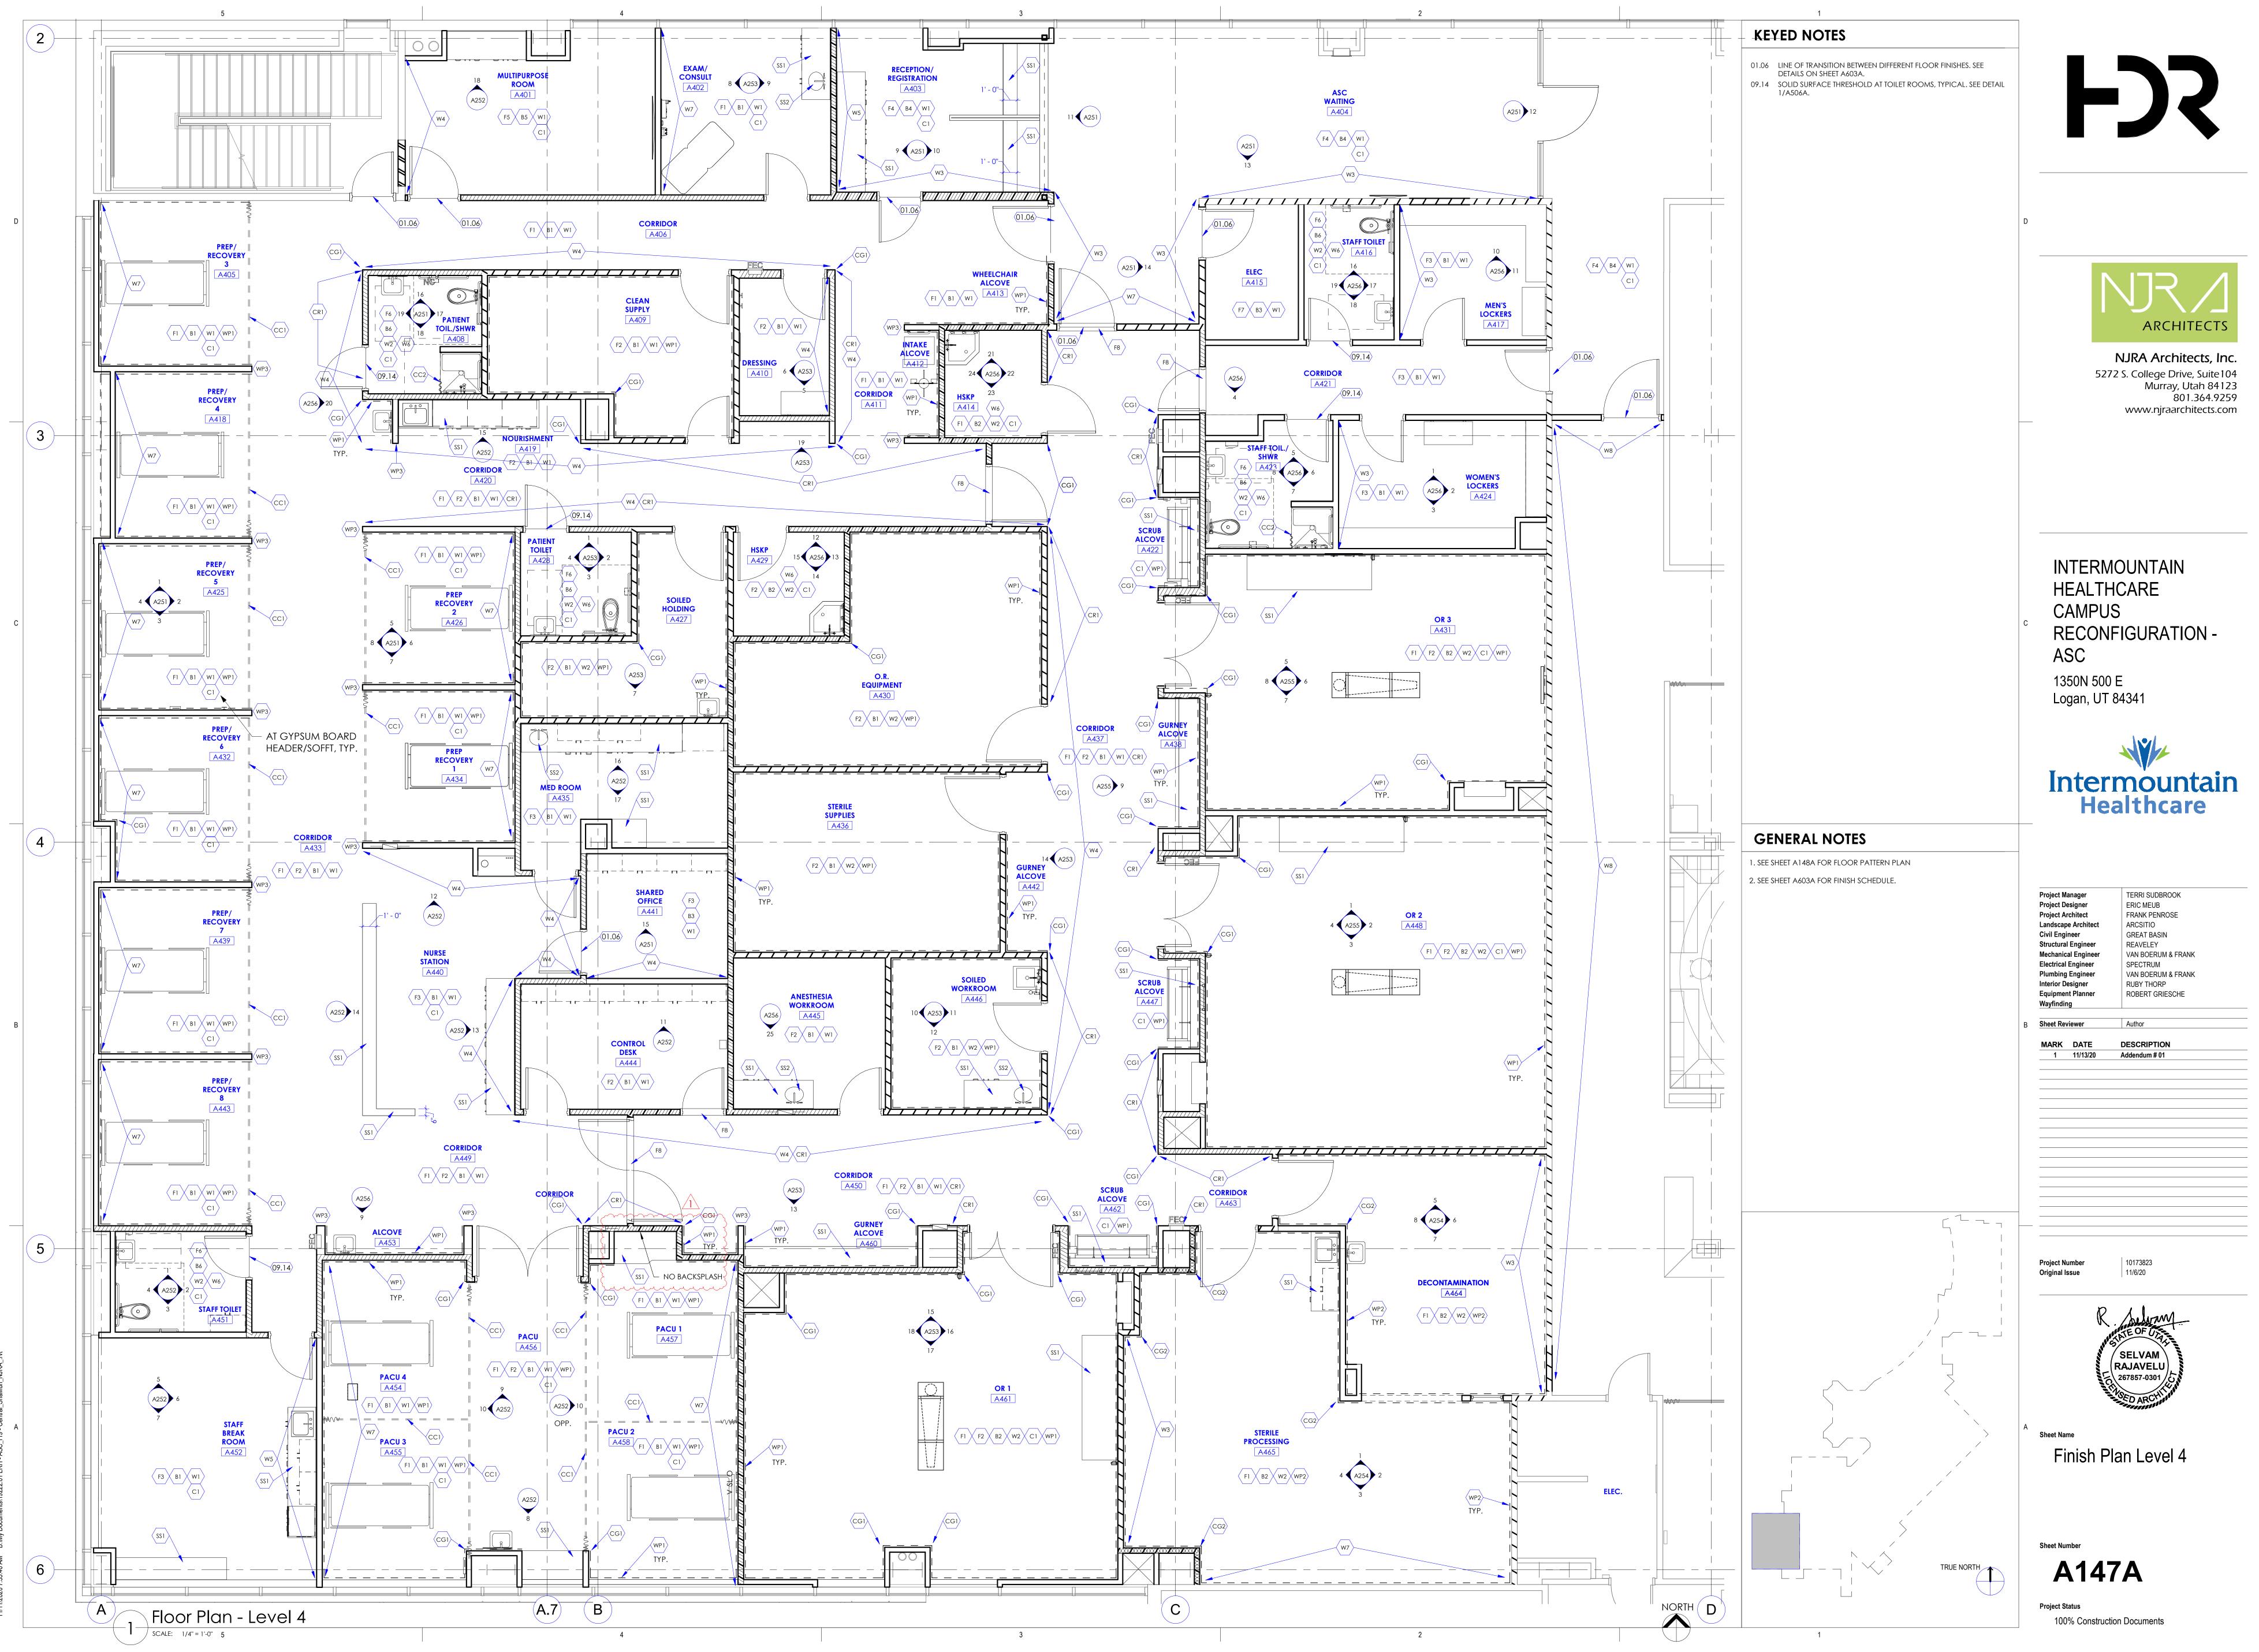


(11/2020 7:55:46 AM B:\My Documents\19222.01 LRH - ASC\_r19 - Centra



11/11/2020 7:55:52 AM B:\My Documents\19222.01 LRH - ASC\_r19 - Central\_Sh

Defibrillator

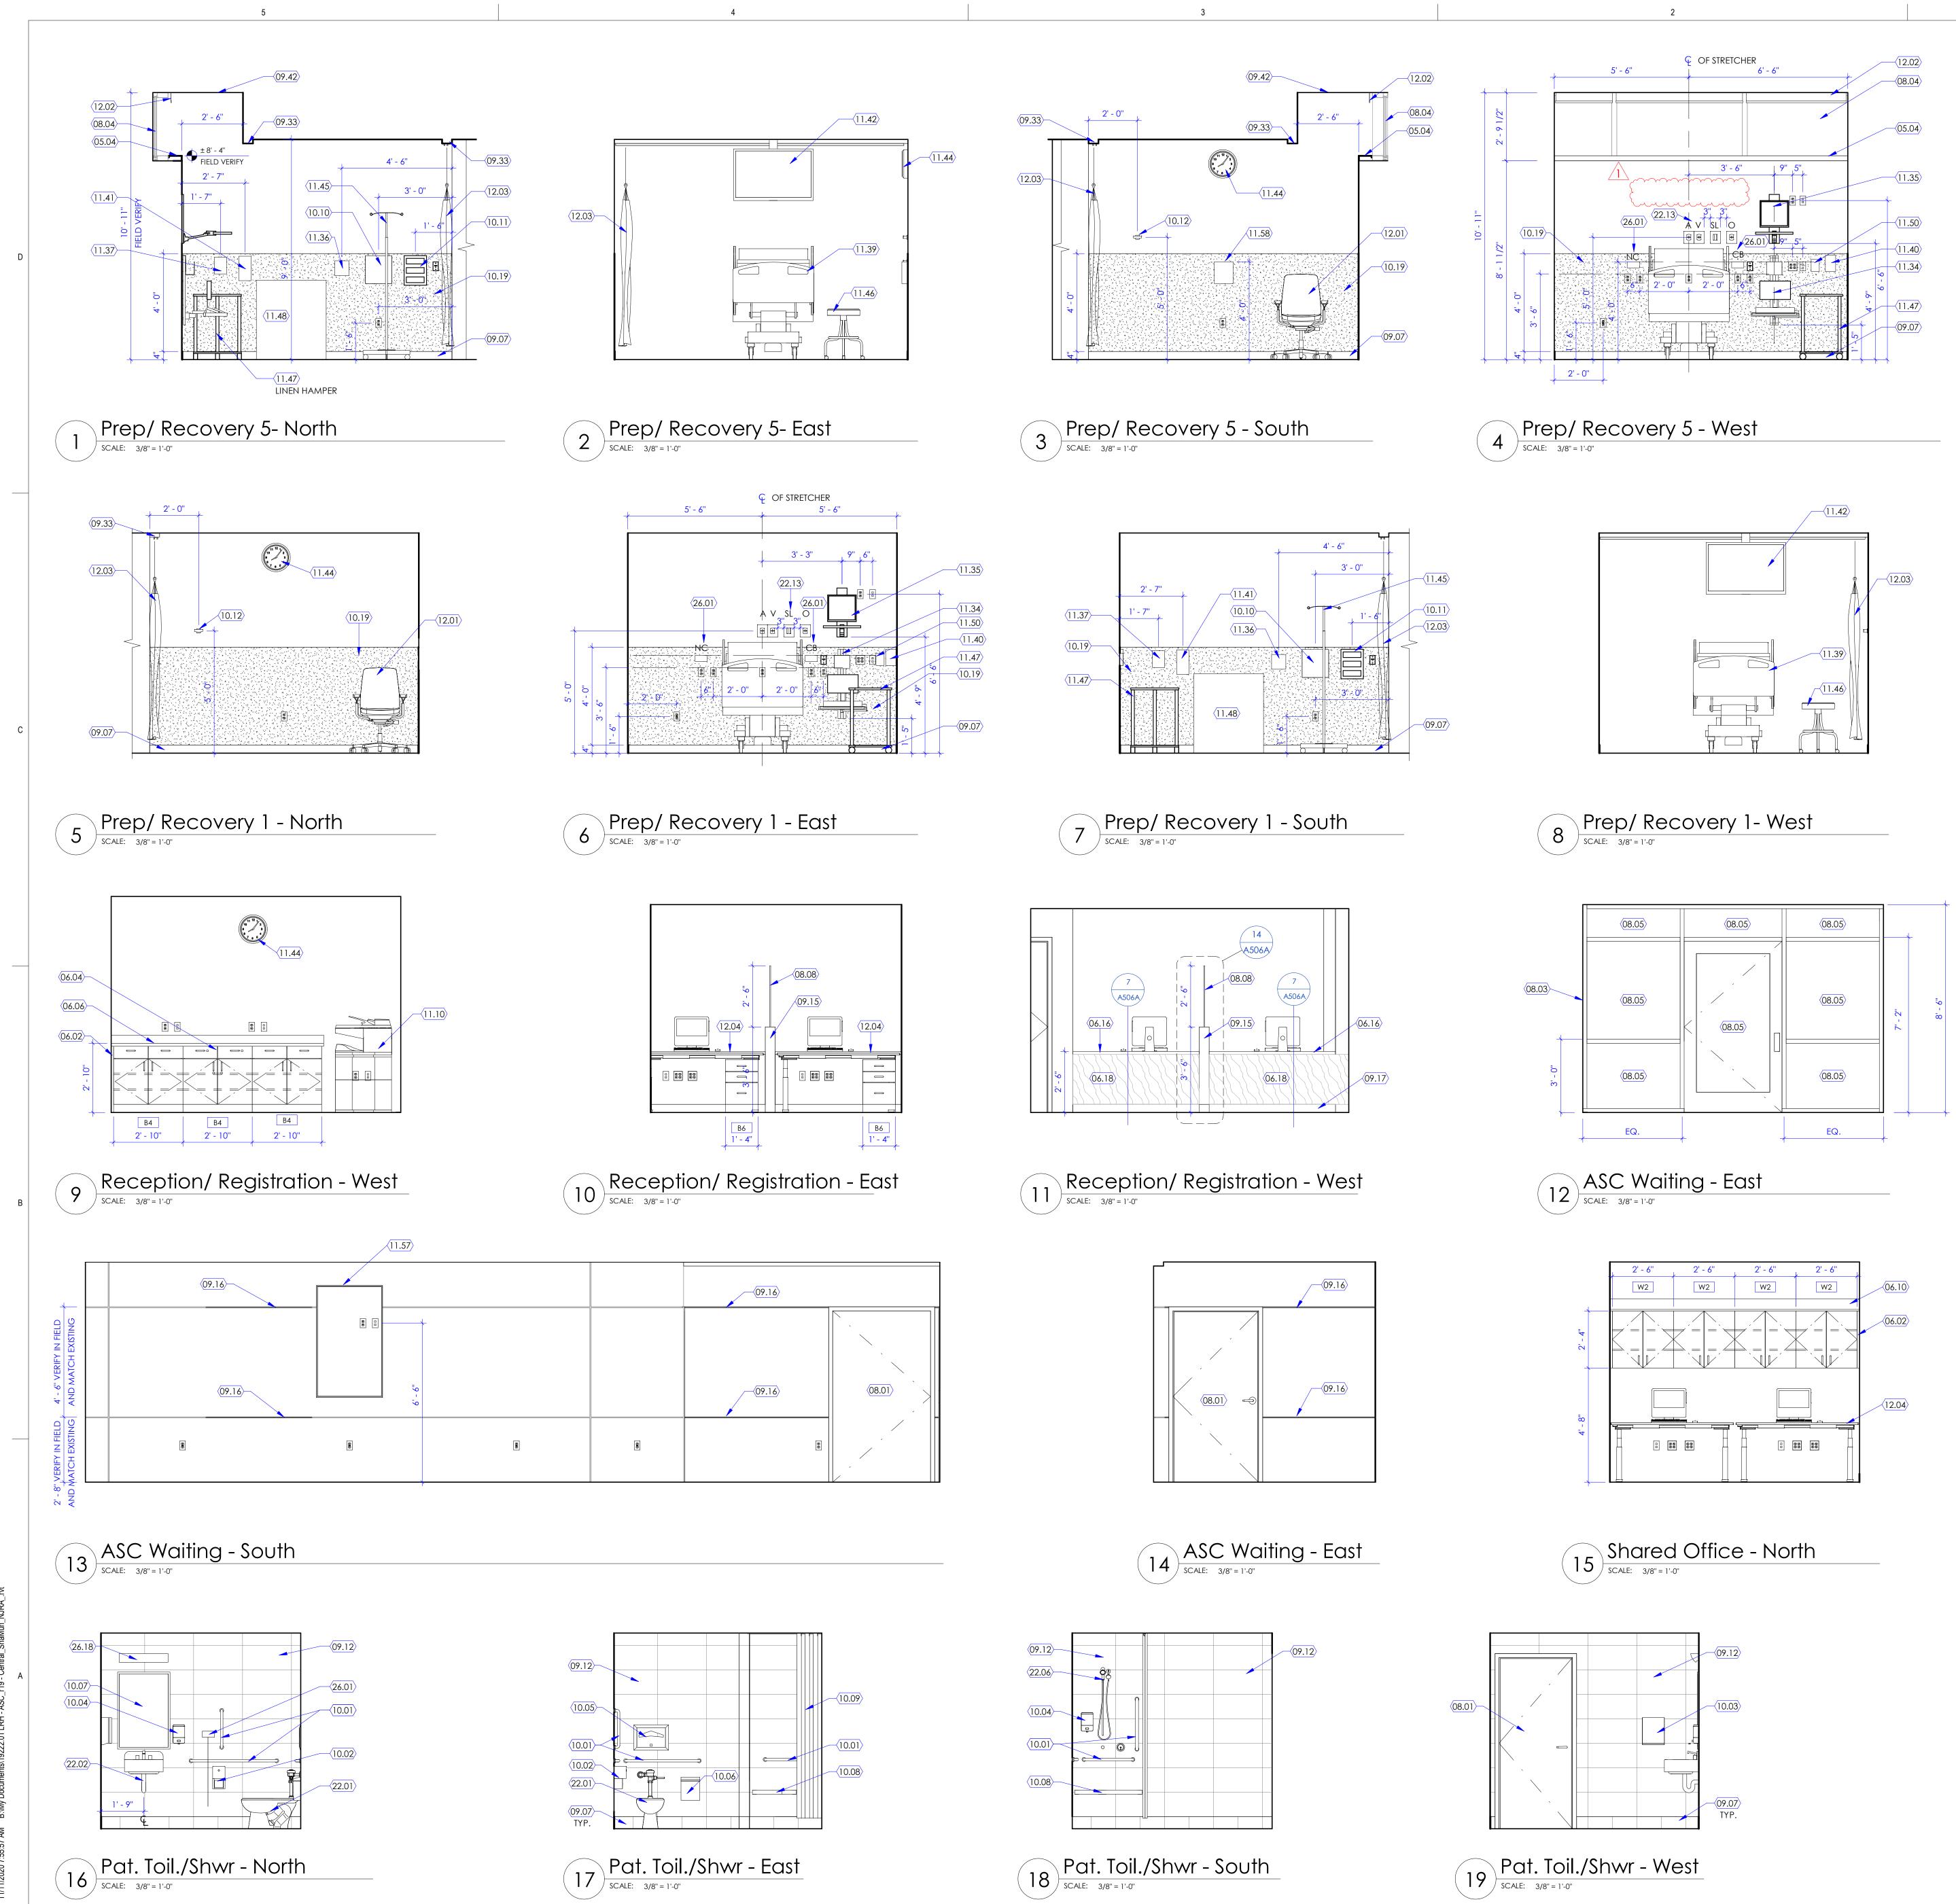


# **KEYED NOTES**

- 05.04 0.09 INCH THICK EXTRUDED ALUMINUM SILL EXTENDER. COLOR AND FINISH TO MATCH EXISTING WINDOW MULLION. ATTACHED TO MULLION VIA CONTNUOUS ALUMINUM 'Z' CLIP. SEE DETAIL 6/A506A. PROVIDE SLOPED SILL AT PREP/RECOVERY BAYS. SEE DETAIL 8/A506A. 06.02 PLASTIC LAMINATE WRAPPED FILLER PANEL. PROVIDE FILLER PANEL BETWEEN
- CABINETS AND BETWEEN CABINET AND WALL, TYPICAL. FILLER PANEL TO MATCH PROFILE AND FINISH OF ADJACENT CABINETS. 06.04 LOCK. PROVIDE KEYED LOCK FOR THIS CABINET DOOR (OR DRAWER WHERE
- OCCURS). PROVIDE REQUIRED HARDWARE FOR THE LOCK SYSTEM. 06.06 SOLID SURFACE COUNTER WITH FULL BULLNOSE EDGE AND INTEGRAL BACKSPLASH. SEE DETAIL 6/A505B. PROVIDE INTEGRAL SIDE SPLASH WHERE COUNTER ABUTS PERPENDICULAR WALL/CABINET.
- 06.10 P-LAM SLOPED DUST TOP. SEE DETAILS 1/A505B AND 2/A505B 06.16 SOLID SURFACE TRANSACTION COUNTER WITH FULL BULLNOSE EDGE. SEE FINISH SCHEDULE. SEE DETAIL 7/A506A.
- 06.18 3/4" THICK PLASTIC LAMINATE FACED PANEL SYSTEM. ATTACH TO GYPSUM BOARD WALL USING BROOKLYN HARDWARE, CONTINUOUS ALUMINUM PANEL CLIP SYSTEM OR APPROVED EQUAL. SEE DETAILS ON SHEET A505C. 08.01 NEW DOOR AND DOOR FRAME. SEE DOOR SCHEDULE.
- 08.03 ALUMINUM-FRAMED STOREFRONT SYSTEM. BASIS OF DESIGN: KAWNEER TRIFAB VERSA GLAZE 451. GLAZING TO BE 1/4" THICK, CLEAR TEMPERED, CENTER GLAZED, WITH 2" SIGHTLINES AND 4-1/2" FRAME DEPTH. FINISH: ARCHITECTURAL CLASS 1 - CLEAR ANODIZED. 08.04 EXISTING WINDOW/CURTAIN WALL TO REMAIN. PROTECT DURING
- CONSTRUCTION. 08.05 GLAZING SHALL BE 1/4" THICK, CLEAR AND TEMPERED.
- 08.08 GLAZING SHALL BE 1/2" THICK, CLEAR AND TEMPERED WITH POLISHED EDGES. 09.07 WALL BASE AS SCHEDULED. SEE FINISH FLOOR PLANS AND FINISH SCHEDULE
- FOR MATERIAL, SIZE, COLOR, ETC. 09.12 WALL TILE AS SCHEDULED. SEE FINISH FLOOR PLAN AND FINISH SCHEDULE FOR MATERIAL TYPE, SIZE, COLOR, ETC. INSTALL 5/8 INCH THICK CEMENT BACKER BOARD BEHIND WALL TILE.
- 09.15 PARTIAL HEIGHT WALL WITH GLAZING ABOVE. SEE DETAIL 14/A506A. 09.16 ALUMINUM REVEAL, 1/2" X 1/2", BETWEEN GYPSUM BOARD. PROVIDE TAPE AND JOINT COMPOUND ON GYPSUM BOARD ON EITHER SIDE OF REVEAL WITH A SMOOTH TRANSITION AND PAINT TO MATCH WALL. FIELD VERIFY HEIGHT OF EXISTING HORIZONTAL REVEALS AND MATCH ADJACENT EXISTING. VERTICAL REVEALS SHOWN ARE EXISTING TO REMAIN, PROTECT DURING
- CONSTRUCTION, IF DAMAGED, PATCH AND REPAIR TO MATCH EXISTING. 09.17 4" HIGH STAINLESS STEEL COVED BASE AT REGISTRATION, 18 GA, TYPE 304, COVED. BASIS OF DESIGN - INPRO.
- 09.33 GYPSUM BOARD HEADER. SEE DETAIL 6/A503A. 09.42 GYPSUM BOARD SOFFIT AT WINDOW. SEE DETAIL 14/A503A.
- 10.01 GRAB BAR. PROVIDE GRAB BARS REQUIRED FOR WATER CLOSET, SHOWER, ETC. SEE RELEVANT DETAILS 1/G003 AND 1/G004 FOR MOUNTING HEIGHT,
- LOCATION, ETC. PROVIDE 'TYPE 2' BACKING PER DETAIL 5/A502A.
- 10.02 TOILET PAPER DISPENSER, OFCI. SEE SHEET G003 FOR MOUNTING HEIGHT. 10.03 PAPER TOWEL DISPENSER, OFCI. . SEE SHEET G003 FOR MOUNTING HEIGHT.
- 10.04 SOAP DISPENSER, OFCI. . SEE SHEET G003 FOR MOUNTING HEIGHT. 10.05 TOILET SEAT COVER DISPENSER. SEE SPECIFICATIONS. SEE SHEET G003 FOR MOUNTING HEIGHT.
- 10.06 SANITARY NAPKIN DISPOSAL. SEE SPECIFICATIONS. 10.07 MIRROR, 2'-0" WIDE X 3'-0"HIGH, TYPICAL. SEE SPECIFICATIONS. MOUNT MIRROR SUCH THAT THE REFLECTIVE SURFACE OF MIRROR IS NO MORE THAN
- 40 INCHES AFF. SEE SHEET G003. 10.08 FOLD DOWN SHOWER SEAT. SEE RELEVANT DETAILS 1/G003 AND 1/G004 FOR
- MOUNTING HEIGHT, LOCATION, ETC. ALSO SEE DETAIL 5/A506A. 10.09 SHOWER CURTAIN WITH CEILING MOUNTED TRACK. SEE DETAIL 13/A503A.
- 10.10 SHARPS DISPOSAL. OFCI. SEE SHEET G003 FOR MOUNTING HEIGHT. 10.11 GLOVES DISPENSER, OFCI. SEE SHEET G003 FOR MOUNTING HEIGHT.
- 10.12 COAT HOOK. BASIS OF DESIGN BOBRICK B-7672 DOUBLE ROBE HOOK. 10.19 0.06 INCH THICK, WALL PROTECTION WAINSCOT, TOP OF WAINSCOT TO
- ALIGN WITH TOP OF CORNER GUARD WHERE OCCURS. SEE FINISH PLAN AND SCHEDULE. 11.10 PRINTER/COPIER. OFOI. SEE ELECTRICAL DRAWINGS FOR POWER AND DATA. 11.34 NURSE CHARTING STATION. SEE DETAIL 13/A502A. ALSO SEE ELECTRICAL
- DRAWINGS FOR POWER AND DATA. 11.35 PHYSIOLOGICAL MONITOR. SEE DETAIL 13/A502A. ALSO SEE ELECTRICAL DRAWINGS FOR POWER AND DATA.
- 11.36 EMESIS BAG DISPENSER, OFCI.
- 11.37 WIPES DISPENSER, OFCI. 11.39 STRETCHER/BED, OFOI.
- 11.40 WALL MOUNTED THEMOMETER, OFCI.
- 11.41 EYEWEAR DISPENSER, OFCI. 11.42 CEILING MOUNTED TELEVISION AND BRACKET, OFCI. ANCHOR TO STRUCTURE/DECK ABOVE. ALSO SEE ELECTRICAL DRAWINGS FOR POWER AND DATA.
- 11.44 WALL MOUNTED ANALOG CLOCK, OFCI.
- 11.45 IV STAND, OFOI. 11.46 PHYSICIAN STOOL, OFOI.
- 11.47 LINEN HAMPER, OFOI.
- 11.48 PROCEDURE CART OFOI. 11.50 WALL MOUNTED BARCODE SCANNER, OFCI. PROVIDE 'TYPE 1' BACKING PER DETAIL 5/A502A.
- 11.57 WALL MOUNTED PATIENT TRACKING MONITOR, OFCI. SEE ELECTRICAL DRAWINGS. PROVIDE 2'-0" W X 4'-0" H X 18 GA SHEET METAL BACKING. COORDINATE LOCATION OF OUTLETS WITH MONITOR MOUNTING BRACKET.
- 11.58 MAGAZINE HOLDER, OFCI. 12.01 FURNITURE, TO BE PROVIDED AND INSTALLED BY OWNERS VENDOR (MIDWEST -MWCI). COORDINATE WITH MIDWEST FOR LOCATION OF ELECTRICAL AND DATA OUTLETS SUCH THAT THEY ARE NOT BEHIND PEDESTALS.
- 12.02 RECESSED ROLLER WINDOW SHADE. SEE CEILING PLAN AND SPECIFICATIONS. 12.03 CEILING MOUNTED PRIVACY CURTAIN AND TRACK. SEE FINISH SCHEDULE AND PROJECT MANUAL. SEE DETAIL 12/A503A.
- 12.04 HEIGHT ADJUSTABLE SIT/STAND DESK. PROVIDED AND INSTALLED BY OWNERS VENDOR MIDWEST COMMERCIAL INTERIORS (MWCI). SEE ELECTRICAL DRAWINGS FOR POWER.
- 22.01 FLOOR MOUNTED WATER CLOSET. SEE DETAILS 1/G003 AND 1/G004 FOR MOUNTING HEIGHT, LOCATION, ETC. SEE PLUMBING DRAWINGS.
- 22.02 WALL MOUNTED LAVATORY (SINK). SEE DETAILS 1/G003 AND 1/G004 FOR MOUNTING HEIGHT, LOCATION, ETC. SEE PLUMBING DRAWINGS. 22.06 SHOWER HEAD. SEE RELEVANT DETAILS 1/G003 AND 1/G004 FOR MOUNTING
- HEIGHT, LOCATION, ETC. SEE PLUMBING DRAWINGS.
- 22.13 WALL MOUNTED MED GASES. SEE PLUMBING DRAWINGS. 26.01 NURSE CALL/CODE BLUE. SEE ELECTRICAL DRAWINGS.
- 26.18 WALL MOUNTED LIGHT FIXTURE. SEE ELECTRICAL DRAWINGS.

# **GENERAL NOTES**

- A. SEE SHEET G003 AND G005 FOR SYMBOLS, GENERAL NOTES AND LEGEND.
- B. SEE SHEET A505A FOR CABINET LEGEND. C. SEE SHEET A601A FOR DOOR AND WINDOW SCHEDULE.
- D. SEE SHEET A603A FOR FINISH SCHEDULE AND GENERAL NOTES.

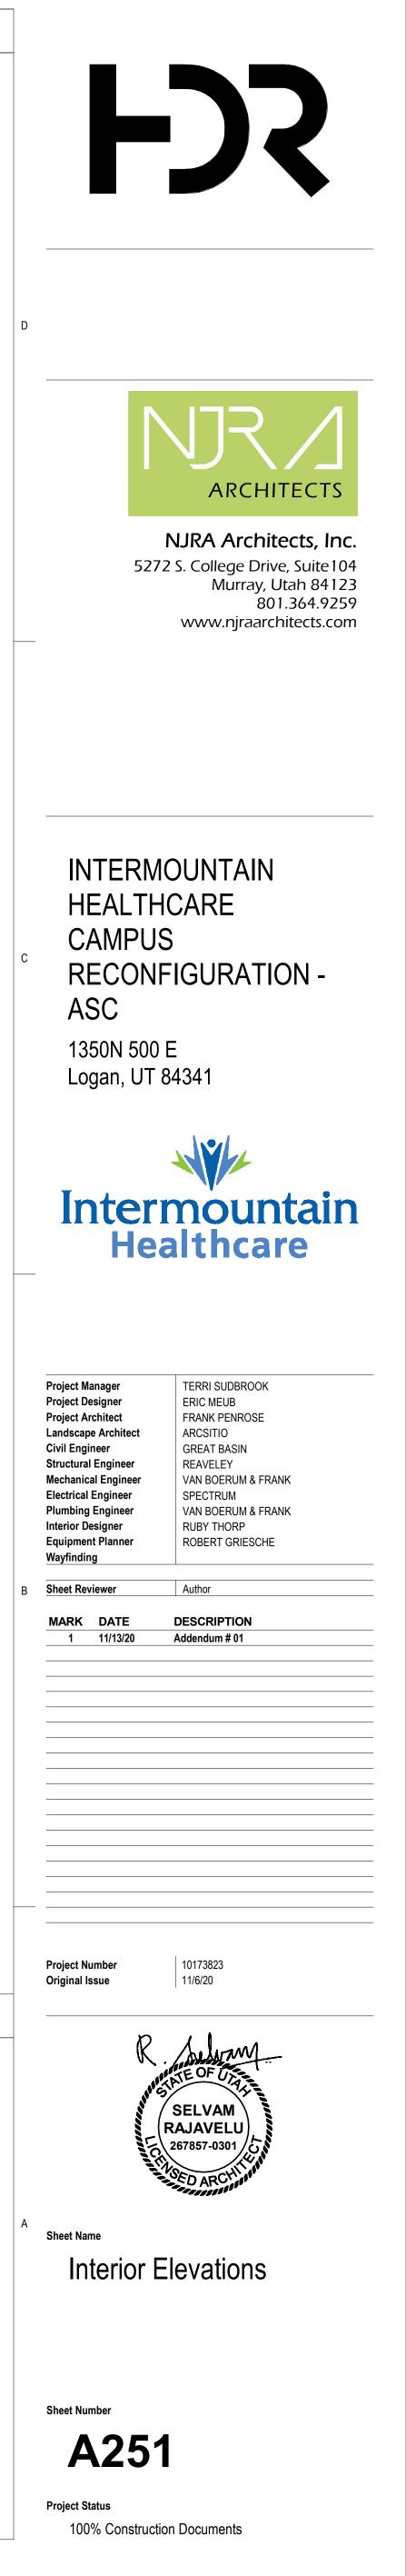




# **KEYED NOTES**

- 05.03 IN-WALL STEEL ANGLE COUNTERTOP SUPPORT AT 3'-0" (MAX) O.C. SEE DETAIL 5/A505B. PAINT TO MATCH WALL COLOR. PROVIDE 16 GA STUDS AT COUNTERTOP SUPPORT, TYPICAL. 05.04 0.09 INCH THICK EXTRUDED ALUMINUM SILL EXTENDER. COLOR AND FINISH TO
- MATCH EXISTING WINDOW MULLION. ATTACHED TO MULLION VIA CONTNUOUS ALUMINUM 'Z' CLIP. SEE DETAIL 6/A506A. PROVIDE SLOPED SILL AT PREP/RECOVERY BAYS. SEE DETAIL 8/A506A. 06.02 PLASTIC LAMINATE WRAPPED FILLER PANEL. PROVIDE FILLER PANEL BETWEEN
- CABINETS AND BETWEEN CABINET AND WALL, TYPICAL. FILLER PANEL TO MATCH PROFILE AND FINISH OF ADJACENT CABINETS. 06.04 LOCK. PROVIDE KEYED LOCK FOR THIS CABINET DOOR (OR DRAWER WHERE
- OCCURS). PROVIDE REQUIRED HARDWARE FOR THE LOCK SYSTEM. 06.06 SOLID SURFACE COUNTER WITH FULL BULLNOSE EDGE AND INTEGRAL BACKSPLASH. SEE DETAIL 6/A505B. PROVIDE INTEGRAL SIDE SPLASH WHERE COUNTER ABUTS PERPENDICULAR WALL/CABINET.
- 06.07 STAINLESS STEEL SINK. SEE PLUMBING DRAWINGS. 06.08 SOLID SURFACE INTEGRAL SINK. BASIS OF DESIGN: SAMSUNG, STARON A3181
- SINK, COLOR "BRIGHT WHITE" BW010. ALSO SEE PLUMBING DWGS.
- 06.09 P-LAM CLOSER PANEL TO CEILING ABOVE. SEE DETAIL 2/A505B 06.10 P-LAM SLOPED DUST TOP. SEE DETAILS 1/A505B AND 2/A505B
- 06.12 IV CABINET. SEE DETAIL 4/A505C. 06.16 SOLID SURFACE TRANSACTION COUNTER WITH FULL BULLNOSE EDGE. SEE
- FINISH SCHEDULE. SEE DETAIL 7/A506A. 06.18 3/4" THICK PLASTIC LAMINATE FACED PANEL SYSTEM. ATTACH TO GYPSUM BOARD WALL USING BROOKLYN HARDWARE, CONTINUOUS ALUMINUM PANEL CLIP SYSTEM OR APPROVED EQUAL. SEE DETAILS ON SHEET A505C.
- 06.19 3/16" REVEAL, TYPICAL. SEE DETAIL 7/A505C. 08.01 NEW DOOR AND DOOR FRAME. SEE DOOR SCHEDULE.
- 08.04 EXISTING WINDOW/CURTAIN WALL TO REMAIN. PROTECT DURING CONSTRUCTION.
- 09.07 WALL BASE AS SCHEDULED. SEE FINISH FLOOR PLANS AND FINISH SCHEDULE FOR MATERIAL, SIZE, COLOR, ETC. 09.12 WALL TILE AS SCHEDULED. SEE FINISH FLOOR PLAN AND FINISH SCHEDULE FOR
- MATERIAL TYPE, SIZE, COLOR, ETC. INSTALL 5/8 INCH THICK CEMENT BACKER BOARD BEHIND WALL TILE. 09.13 PARTIAL HEIGHT WALL WITH SOLID SURFACE TRANSACTION TOP. SEE WALL
- TYPES AND FINISH SCHEDULE. 09.32 GYPSUM BOARD SOFFIT. SEE DETAIL 9/A503A. SEE M/E/P DRAWINGS FOR LIGHTS AND DIFFUSERS.
- 09.33 GYPSUM BOARD HEADER. SEE DETAIL 6/A503A.
- 09.42 GYPSUM BOARD SOFFIT AT WINDOW. SEE DETAIL 14/A503A. 10.01 GRAB BAR. PROVIDE GRAB BARS REQUIRED FOR WATER CLOSET, SHOWER, ETC. SEE RELEVANT DETAILS 1/G003 AND 1/G004 FOR MOUNTING HEIGHT, LOCATION, ETC. PROVIDE 'TYPE 2' BACKING PER DETAIL 5/A502A.
- 10.02 TOILET PAPER DISPENSER, OFCI. SEE SHEET G003 FOR MOUNTING HEIGHT.
- 10.03 PAPER TOWEL DISPENSER, OFCI. . SEE SHEET G003 FOR MOUNTING HEIGHT. 10.04 SOAP DISPENSER, OFCI. . SEE SHEET G003 FOR MOUNTING HEIGHT. 10.05 TOILET SEAT COVER DISPENSER. SEE SPECIFICATIONS. SEE SHEET G003 FOR
- MOUNTING HEIGHT. 10.06 SANITARY NAPKIN DISPOSAL. SEE SPECIFICATIONS.
- 10.07 MIRROR, 2'-0" WIDE X 3'-0"HIGH, TYPICAL. SEE SPECIFICATIONS. MOUNT MIRROR SUCH THAT THE REFLECTIVE SURFACE OF MIRROR IS NO MORE THAN 40 INCHES AFF. SEE SHEET G003.
- 10.10 SHARPS DISPOSAL. OFCI. SEE SHEET G003 FOR MOUNTING HEIGHT. 10.11 GLOVES DISPENSER, OFCI. SEE SHEET G003 FOR MOUNTING HEIGHT.
- 10.19 0.06 INCH THICK. WALL PROTECTION WAINSCOT. TOP OF WAINSCOT TO ALIGN WITH TOP OF CORNER GUARD WHERE OCCURS. SEE FINISH PLAN AND SCHEDULE. 11.01 REFRIGERATOR, OFCI. SEE ELECTRICAL DRAWINGS.
- 11.02 MICROWAVE, OFCI. SEE ELECTRICAL DRAWINGS. FOR MICROWAVE IN WALL CABINET PROVIDE OUTLET IN THE CABINET ABOVE WITH A GROMMET OPENING AT THE BASE OF THIS CABINET.
- 11.05 ICE AND WATER DISPENSER. OWNER FURNISHED CONTRACTOR INSTALLED. SEE PLUMBING DRAWINGS. CAREFULLY CUT AROUND BACKSPLASH BEHIND TO ACCOMMODATE FOR WASHER BOX. BOTTOM OF WALL BOX TO BE ONE INCH ABOVE COUNTERTOP. ALSO SEE ELECTRICAL DRAWINGS FOR POWER. 11.07 COFFEE POT, OFCI. COFFEE POT TO BE PLUMBED. SEE PLUMBING DRAWINGS.
- ALSO SEE ELECTRICAL DRAWINGS. 11.10 PRINTER/COPIER. OFOI. SEE ELECTRICAL DRAWINGS FOR POWER AND DATA. 11.12 WALL MOUNTED MONITOR/TELEVISION OFCI. SEE ELECTRICAL DRAWINGS.
- PROVIDE 3'-0" W X 2'-0" H X 18 GA SHEET METAL BACKING. COORDINATE LOCATION OF OUTLETS WITH MONITOR MOUNTING BRACKET. 11.15 AUTOMATED MEDICATION DISPENSER/OMNICELL. OFCI. SEE ELECTRICAL DRAWINGS FOR POWER AND DATA. PROVIDE A CCTV CAMERA ABOVE
- OMNICELL. SEE CEILING PLAN AND ELECTRICAL DRAWINGS. 11.17 COUNTER MOUNTED WARMING CABINET, OFCI. 11.18 WASTE DISPOSAL, WALL MOUNTED, OFCI.
- 11.21 PNEUMATIC TUBE STATION (PTS). PROVIDED AND INSTALLED BY GENERAL CONTRACTOR. CONTRACTOR TO USE SWISSLOG AS THE SUB-CONTRACTOR FOR PTS. (INTERMOUNTAIN HEALTHCARE STANDARD). CONTRACTOR TO FRAME AND FINISH AROUND PTS. ALSO SEE ELECTRICAL DRAWINGS FOR
- POWER AND DATA REQUIREMENTS. COORDINATE SIZE AND LOCATION OF REQUIRED CORE DRILLS WITH SWISSLOG AND DEPARTMENT/AREA BELOW. 11.34 NURSE CHARTING STATION. SEE DETAIL 13/A502A. ALSO SEE ELECTRICAL
- DRAWINGS FOR POWER AND DATA. 11.35 PHYSIOLOGICAL MONITOR. SEE DETAIL 13/A502A. ALSO SEE ELECTRICAL DRAWINGS FOR POWER AND DATA.
- 11.36 EMESIS BAG DISPENSER, OFCI. 11.37 WIPES DISPENSER, OFCI.
- 11.38 ANESTHESIA WORKSTATION. SEE DETAIL 13/A502A. ALSO SEE ELECTRICAL DRAWINGS FOR POWER AND DATA. 11.39 STRETCHER/BED, OFOI.
- 11.40 WALL MOUNTED THEMOMETER, OFCI.
- 11.44 WALL MOUNTED ANALOG CLOCK, OFCI. 11.48 PROCEDURE CART OFOI.
- 11.50 WALL MOUNTED BARCODE SCANNER, OFCI. PROVIDE 'TYPE 1' BACKING PER DETAIL 5/A502A. 11.57 WALL MOUNTED PATIENT TRACKING MONITOR, OFCI. SEE ELECTRICAL
- DRAWINGS. PROVIDE 2'-0" W X 4'-0" H X 18 GA SHEET METAL BACKING. COORDINATE LOCATION OF OUTLETS WITH MONITOR MOUNTING BRACKET. 12.01 FURNITURE, TO BE PROVIDED AND INSTALLED BY OWNERS VENDOR (MIDWEST -MWCI). COORDINATE WITH MIDWEST FOR LOCATION OF ELECTRICAL AND DATA OUTLETS SUCH THAT THEY ARE NOT BEHIND PEDESTALS.
- 12.02 RECESSED ROLLER WINDOW SHADE. SEE CEILING PLAN AND SPECIFICATIONS. 12.03 CEILING MOUNTED PRIVACY CURTAIN AND TRACK. SEE FINISH SCHEDULE AND PROJECT MANUAL. SEE DETAIL 12/A503A.
- 12.04 HEIGHT ADJUSTABLE SIT/STAND DESK. PROVIDED AND INSTALLED BY OWNERS VENDOR MIDWEST COMMERCIAL INTERIORS (MWCI). SEE ELECTRICAL DRAWINGS FOR POWER.
- 22.01 FLOOR MOUNTED WATER CLOSET. SEE DETAILS 1/G003 AND 1/G004 FOR MOUNTING HEIGHT, LOCATION, ETC. SEE PLUMBING DRAWINGS. 22.02 WALL MOUNTED LAVATORY (SINK). SEE DETAILS 1/G003 AND 1/G004 FOR
- MOUNTING HEIGHT, LOCATION, ETC. SEE PLUMBING DRAWINGS. 22.13 WALL MOUNTED MED GASES. SEE PLUMBING DRAWINGS.
- 23.10 RECESSED MED GAS ALARM PANEL. SEE M/E/P DRAWINGS. 26.01 NURSE CALL/CODE BLUE. SEE ELECTRICAL DRAWINGS.
- 26.09 CEILING MOUNTED SECURITY CAMERA. SEE ELECTRICAL DRAWINGS. 26.13 POWER RECEPTACLE FOR MICROWAVE IN CABINET ABOVE. PROVIDE GROMMET AS NEEDED.
- 26.18 WALL MOUNTED LIGHT FIXTURE. SEE ELECTRICAL DRAWINGS. 26.20 WALL MOUNTED PHONE. SEE ELECTRICAL DRAWINGS.

# **GENERAL NOTES**

- A. SEE SHEET G003 AND G005 FOR SYMBOLS, GENERAL NOTES AND
- LEGEND. B. SEE SHEET A505A FOR CABINET LEGEND.
- C. SEE SHEET A601A FOR DOOR AND WINDOW SCHEDULE.
- D. SEE SHEET A603A FOR FINISH SCHEDULE AND GENERAL NOTES.

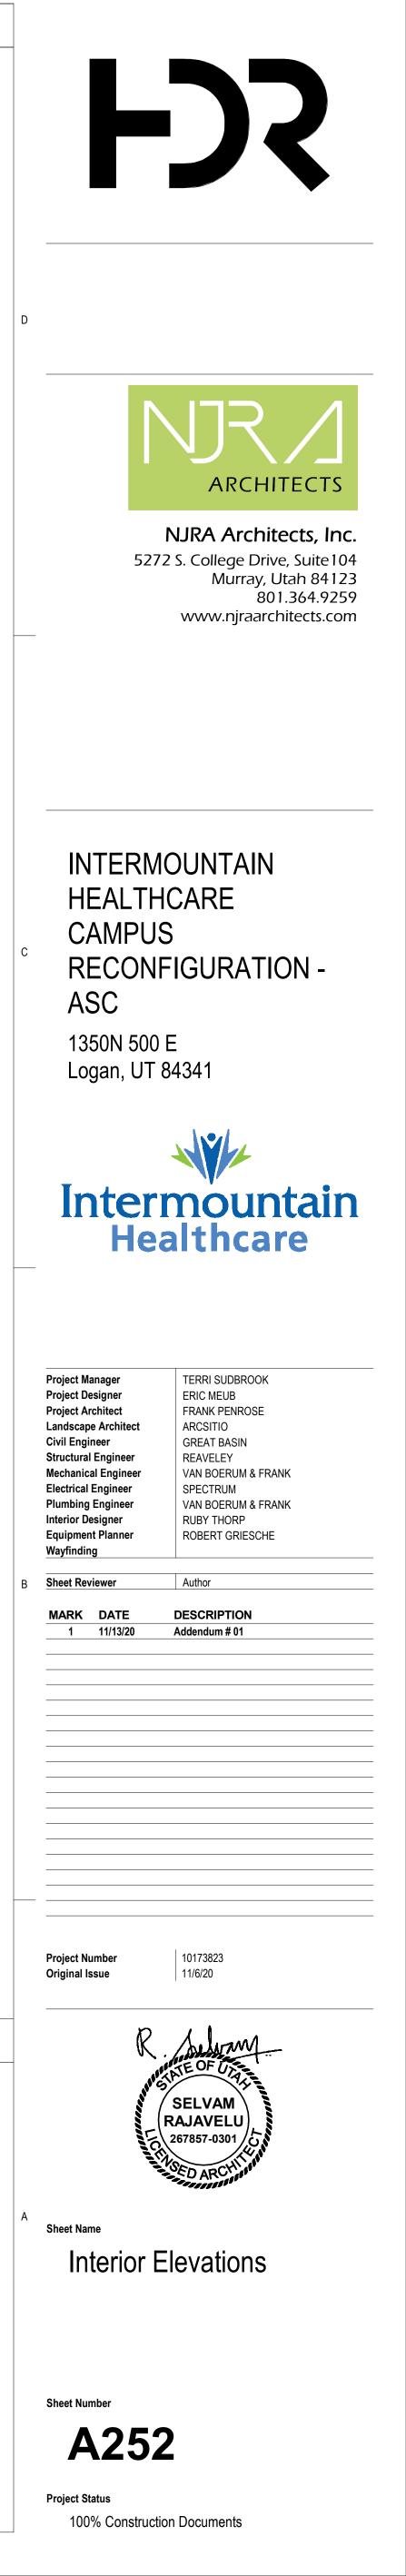



## ADDENDUM #1

DATE: November 13, 2020

**PROJECT NO:** 19296

**PROJECT:** Logan Regional Hospital - ASC

The following revision, additions, deletions, and/or items of clarification shall hereby be included as an integral part of the Contract Documents for the above-listed project and shall be fully binding. All other requirements of the original plans and specification shall remain in effect in their respective order.

### DIVISION - 21, 22, 23

### GENERAL

1.

### DRAWINGS

SHEET - M141A – MECHANICAL DEMOLITION PLAN – LEVEL 4

- 1. Keyed note #14 has been added to this sheet.
- 2. Existing VAV box VR-A4-8 is now shown being removed and salvaged for reinstallation.

SHEET - M143A – MECHANICAL NEW PLAN – LEVEL 4

- 1. The exhaust ductwork in Sterile Processing A465 has been modified to provide more room for the airflow measuring station.
- 2. The exhaust ductwork in Decontamination A464 has been modified to provide more room for the airflow measuring station.
- 3. The required maximum airflow from the two existing grilles connected to VAV box VR-A4-8 is now shown in Elec. A419.

SHEET - M146A – MECHANICAL ROOF PLAN

- 1. The automatic control valves on the heating hot water side of the steam-to-hot water heat exchanger are now shown.
- 2. The required steam traps are now shown and called out on this plan.
- 3. Exhaust fan EF-5 has been moved approximately 14 feet to the northeast of its previously shown location.
- 4. Exhaust fan EF-1 has been moved approximately 8 feet to the east of its previously shown location.

SHEET - M241A - MECHANICAL PIPING DEMOLITION PLAN - LEVEL 4

- 1. Keyed note #8 has been added to this sheet.
- 2. Existing VAV box VR-A4-8 is now shown being removed and salvaged for reinstallation.

### SHEET - M243A – MECHANICAL PIPING NEW PLAN – LEVEL 4

1. The required steam traps are now shown and called out on this plan.

### SHEET - M501 - MECHANICAL DETAILS

- 1. Detail #3 has been removed and replaced with a new single sterilizer steam fitting detail.
- 2. A washer steam fitting detail has been added to this sheet as detail #13.

### Page 2 of 3

### SHEET - M603 - MECHANICAL SCHEDULES

1. The motive pressure has been updated on the automatic pump trap schedule.

### SHEET - M604 - MECHANICAL SCHEDULES

- 1. This sheet has been added to the mechanical drawings.
- 2. The steam filter, steam separator, steam trap, and steam pressure-reducing valves schedules have all been added to this sheet.

### SHEET - M702 - MECHANICAL SCHEMATICS

- 1. The steam-to-hot water heat exchanger schematic on this sheet has been updated to more correctly show the piping. Two control valves have been added to the heating hot water piping on the supply out of the heat exchanger to match the detail on sheet M703.
- 2. The ASC steam distribution schematic on this sheet has been updated to show all of the required steam taps, pressure reducing valves, steam filters, and moisture separators.

### SHEET - M703 - MECHANICAL SCHEMATICS

- 1. A pressure reducing valve has been added to the legend of details on this sheet.
- 2. A redundant shut-off valve has been removed from the condensate return piping on the steam-to-hot water heat exchanger detail.

### SHEET - P103A

1. The DI water pipe size has been changed to 1-1/4".

### SHEET - P141A

1. Keyed note 4 has been changed on this sheet.

### SHEET - P143A

- 1. The condensate piping from Stair #2 has been modified to connect to the roof drain piping as shown.
- 2. The water hammer arrestor has been adjusted to be downstream of the isolation valves serving Patient Toile/Shower.
- 3. The hot water piping has been modified to the lavatories on this sheet.
- 4. Isolation valves have been added to the domestic hot, cold and recirculation lines on this sheet.

### SHEET - P243A

- 1. Medical gas sensors have been move to OR 2 on this sheet.
- 2. Medical gas sensors have been added to OR 3 and a medical gas alarm panel has been added for these sensors on this sheet.
- 3. Keyed note #3 has been added to this sheet.

### SHEET - P501

- 1. The DI water pipe size has been changed to 1-1/4".
- 2. The flow for pumps P-1 and P-2 has been changed to 20 GPM.
- 3. Detail 1 has been removed from this sheet.

### SHEET - P601

- 1. The DI Water Pump Schedule has been modified.
- 2. The manufacturer listed on the Pure Water System Schedule has been changed to Water Specialties.

### SHEET - P602

- 1. The MA-5 alarm panel has been added to the Medical Gas Alarm Panel Schedule.
- 2. The Medical Gas Outlet Schedule has been modified to clarify the type of connection for the ceiling mounted gas connections.

## Page 3 of 3 PRIOR APPROVALS

The following manufacturers, trade names and products are allowed to bid on a name brand only basis with the provision that they completely satisfy all and every requirement of the drawings, specifications and all addenda shall conform to the design, quality and standards specified, established and required for the complete and satisfactory installation and performance of the building and all its respective parts.

<u>ltem</u>


DI-1 Pure Water System

Manufacturer Water Specialties Comments Approved




# SHEET KEYNOTES

- THIS EXISTING VAV BOX IS TO BE REMOVED. DEMOLISH THE ASSOCIATED SUPPLY AIR DUCTWORK BACK TO THE APPROXIMATE LOCATION SHOWN.
- THIS EXISTING VAV BOX IS TO REMAIN IN SERVICE. PROTECT FROM DAMAGE. DISCONNECT THE INLET DUCTWORK FROM THE EXISTING SUPPLY AIR MAIN IN THE APPROXIMATE LOCATION SHOWN. MODIFY THE LOCATION OF THE VAV BOX AND/OR ITS CONNECTING DUCTWORK & PIPING TO PROVIDE THE REQUIRED MAINTENANCE ACCESS. COORDINATE THE VAV BOX LOCATION WITH THE NEW FLOOR PLAN. CAREFULLY COORDINATE ANY AIR HANDLER SHUTDOWN WITH THE OWNER AND HOSPITAL PERSONNEL. FIELD VERIFY THE EXTENT OF WORK.
- THIS EXISTING DUCTWORK IS TO BE DISCONNECTED FROM THE EXISTING SUPPLY AIR MAIN IN THE APPROXIMATE LOCATION SHOWN. CAREFULLY COORDINATE ANY AIR HANDLER SHUTDOWN WITH THE OWNER AND HOSPITAL PERSONNEL. FIELD VERIFY THE EXTENT OF WORK.
- DEMOLISH THE EXISTING SUPPLY AIR MAIN BACK TO THIS APPROXIMATE LOCATION AND PREPARE FOR FUTURE CONNECTION. CAREFULLY COORDINATE ANY AIR HANDLER SHUTDOWN WITH THE OWNER AND HOSPITAL PERSONNEL. FIELD VERIFY THE EXTENT OF WORK.
- THIS EXISTING TRANSFER AIR DUCT & ASSOCIATED FIRE DAMPER ARE TO BE REMOVED.
- THIS EXISTING TRANSFER AIR DUCT & ASSOCIATED FIRE DAMPER ARE TO BE REMOVED. THE WALL IS TO BE PATCHED AND REPAIRED TO MATCH THE EXISTING & NEW CONSTRUCTION IN THIS AREA.
- THIS EXISTING TRANSFER AIR DUCT & ASSOCIATED COMBINATION FIRE/SMOKE DAMPER ARE TO REMAIN IN SERVICE. PROTECT FROM DAMAGE.
- THIS EXISTING SUPPLY AIR DUCTWORK MAIN IS TO BE REMOVED IN THE APPROXIMATE LOCATIONS SHOWN. CAREFULLY COORDINATE ANY AIR HANDLER SHUTDOWN WITH THE OWNER AND HOSPITAL PERSONNEL. FIELD VERIFY THE EXTENT OF WORK.
- THIS EXISTING RETURN AIR DUCTWORK MAIN IS TO BE REMOVED AND SALVAGED IN THE APPROXIMATE LOCATIONS SHOWN. PROTECT FROM DAMAGE. CAREFULLY COORDINATE ANY AIR HANDLER SHUTDOWN WITH THE OWNER AND HOSPITAL PERSONNEL. FIELD VERIFY THE EXTENT OF WORK.
- 10. THIS EXISTING TRANSFER AIR GRILLE IS TO REMAIN IN SERVICE. PROTECT FROM DAMAGE.
- 11. THIS EXISTING LINEAR RETURN AIR GRILLE IS TO BE REMOVED AND DISCARDED.
- THIS EXISTING LINEAR RETURN AIR GRILLE IS TO BE REMOVED AND SALVAGED FOR REUSE. PROTECT FROM DAMAGE.
- 13. THE TWO EXISTING LINEAR RETURN AIR GRILLES LOCATED TO THE EAST OF THESE EXISTING LINEAR SUPPLY DIFFUSERS ARE TO BE REMOVED AND SALVAGED FOR REUSE. PROTECT FROM DAMAGE. REMOVE AND RELOCATE EXISTING VAV BOX. SEE NEW MECHANICAL PLAN FOR NEW LOCATION.

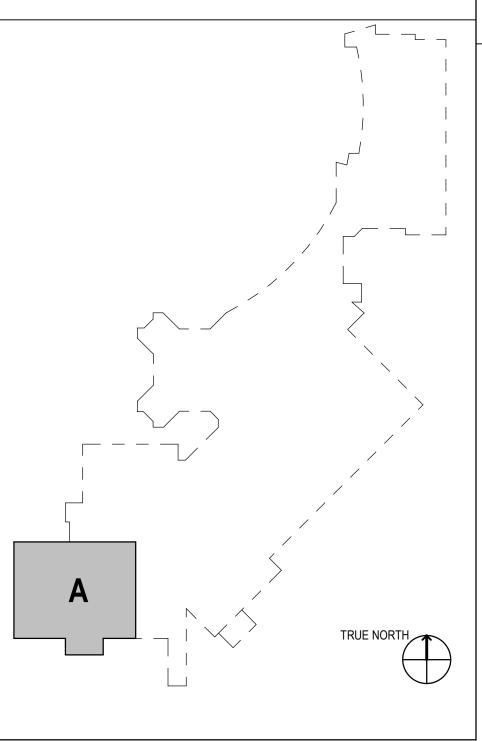



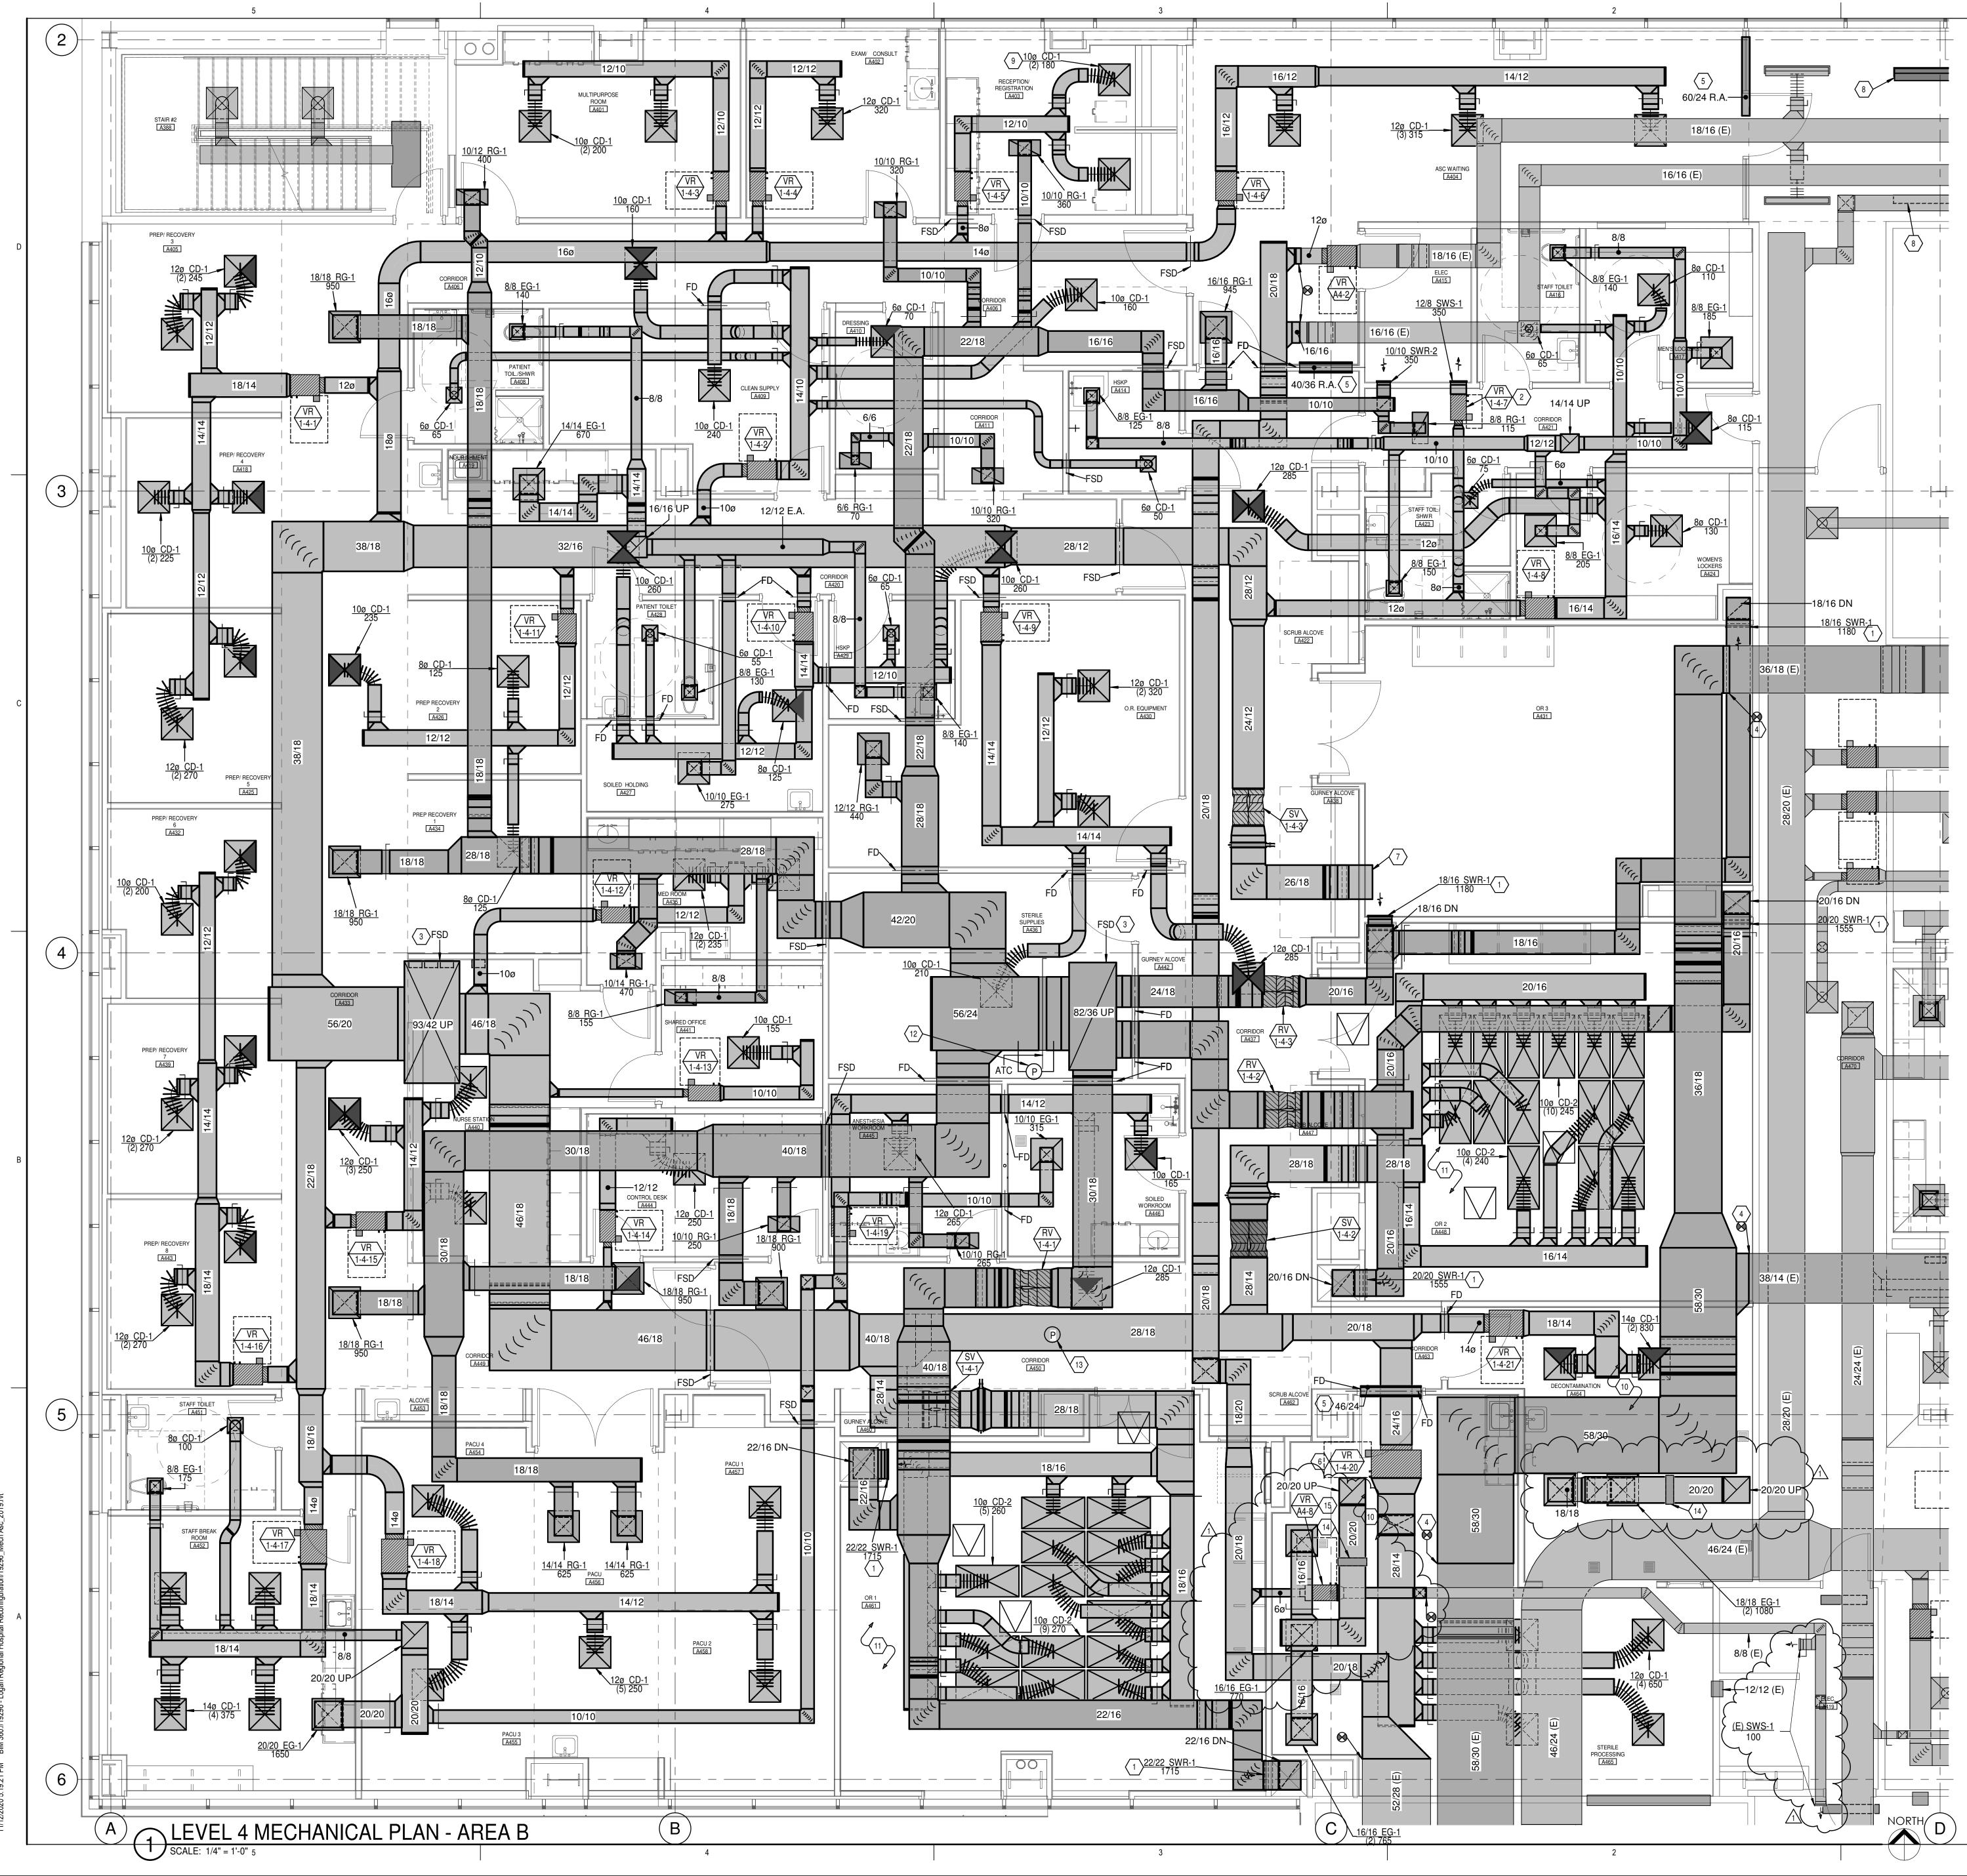

/2020 5:19:21 PM BIM 360://19296 - Logan Regional Hospital Reconfiguration/19296\_Mech Asc\_


# SHEET KEYNOTES


- INSTALL THIS SIDE WALL RETURN GRILLE SO THE BOTTOM OF THE GRILLE IS 8" ABOVE THE FINISHED FLOOR. PROVIDE ELECTRONIC TYPE REMOTE DAMPER OPERATORS FOR THE HIGH EFFICIENCY TAKE-OFF DAMPER ASSOCIATED WITH THIS GRILLE THAT ARE TERMINATED NEAR A CEILING ACCESS DOOR IN THIS ROOM. CLEARLY LABEL EACH REMOTE DAMPER OPERATOR SO IT CAN EASILY BE KNOWN WHICH OPERATOR CONTROLS WHICH GRILLE.
- THIS IS A COOLING-ONLY VAV BOX. NO REHEAT COIL OR HEATING HOT WATER CONNECTIONS ARE REQUIRED.
- CAREFULLY COORDINATE THIS DUCTWORK PENETRATION UP THROUGH THE ROOF AND CONNECT TO THE NEW AIR HANDLER ABOVE. PROVIDE A COMBINATION FIRE & SMOKE DAMPER IN THE DUCTWORK WHERE IT PENETRATES THE BOOF
- REUSE AS MUCH OF THE SALVAGED RETURN AIR DUCTWORK AS POSSIBLE WHEN INSTALLING THIS DUCTWORK. FIELD VERIFY THE EXTENT OF WORK.
- INSTALL A NEW TRANSFER AIR DUCT IN THE WALL ABOVE THE CEILING IN THIS LOCATION.
- INTERCONNECT THIS VAV BOX WITH EXHAUST FAN EF-6 TO MAINTAIN THE POSITIVE PRESSURE OFFSET AIRFLOW AS DESCRIBED ON SHEET M701. AS THE AIRFLOW THROUGH THE VAV BOX CHANGES, THE AIRFLOW THROUGH EXHAUST FAN EF-6 IS TO ALSO CHANGE ACCORDINGLY.
- STUB THIS SUPPLY DUCTWORK THROUGH THE WALL AND LEAVE OPEN TO PROVIDE SUPPLY AIRFLOW TO THE SHELLED O.R. SPACE.
- REINSTALL THE FOUR SALVAGED LINEAR RETURN AIR GRILLES IN THE CEILING BETWEEN THE REMAINING TWO SETS OF LINEAR SUPPLY DIFFUSERS IN THE HALLWAY. PROVIDE EQUAL SPACING BETWEEN THE SUPPLY DIFFUSERS AND THE REINSTALLED RETURN GRILLES. PATCH AND REPAIR THE CEILING AS REQUIRED TO MATCH THE EXISTING CONDITIONS. FIELD VERIFY THE EXTENT OF WORK.
- THESE TWO SUPPLY DIFFUSERS AND THE COVERS ON THE CONCEALED FIRE SPRINKLERS IN THIS AREA ARE TO BE PAINTED TO MATCH THE WOOD CEILING.
- THE CONTRACTOR IS TO SEAL ALL OPENINGS IN AND ABOVE THE CEILING OF THIS ROOM AIR TIGHT. THE CEILING TILES IN THIS ROOM ARE TO HAVE GASKETS ON THEM TO HELP PROVIDE AN AIR-TIGHT CEILING. THE CONTRACTOR IS TO PERFORM A BLOWER DOOR TEST IN ACCORDANCE WITH THE REQUIREMENTS NOTED ON SHEET M701 TO PROVE THE ROOM HAS BEEN PROPERLY SEALED. THE CONTRACTOR IS TO PROVIDE A WRITTEN REPORT OF THE BLOWER DOOR TEST OUTCOME TO THE OWNER, ARCHITECT, & ENGINEER.
- . THE BALANCING DAMPERS ON THE HIGH EFFICIENCY TAKE-OFFS IN THE OPERATING ROOMS ARE TO INCLUDE ELECTRONIC TYPE REMOTE DAMPER OPERATORS THAT ARE TERMINATED NEAR A CEILING ACCESS DOOR IN THAT ROOM. CLEARLY LABEL EACH REMOTE DAMPER OPERATOR SO IT CAN EASILY BE KNOWN WHICH OPERATOR CONTROLS WHICH DIFFUSER. TYPICAL FOR ALL HIGH EFFICIENCY TAKE-OFFS ABOVE OPERATING ROOM CEILINGS.
- 2. INSTALL DIFFERENTIAL PRESSURE SENSOR TO CONTROL MOTORIZED ATC DAMPER IN RETURN DUCT. SEE SECTION 230993-4 FOR RETURN DUCT CONTROL DAMPER SEQUENECE.
- B. DUCT STATIC PRESSURE SENSOR FOR AHU CONTROL
- 14. AIRFLOWMEASURING STATION TO MONITOR AND CONTROL EXHAUST FAN. PROVIDE EBTRON GTX116-P+ AND PROVIDE 2 DUCT DIAMETERS UPSTREAM/DOWNSTREAM (MINIMUM) OF STRAIGHT DUCT. SEE SEQUENCE OF OPERATIONS 230993-7 FOR MORE INFORMATION.
- 5. RELOCATED VAV BOX. EXISTING BOX IS COOLING ONLY. BALANCE TO AIRFLOW NOTED.


# **GENERAL NOTES**

DUCT LINER RESTRICTIONS: (REFER TO 233113-3.10-G) DUCT LINER EXPOSED TO AIR MOVEMENT SHALL NOT BE USED IN SUPPLY DUCTS SERVING THE FOLLOWING AREAS: A. OR1 A461 B. OR 2 A448 C. OR 3 A431


OR 3 A431 STERILE PROCESSING A465

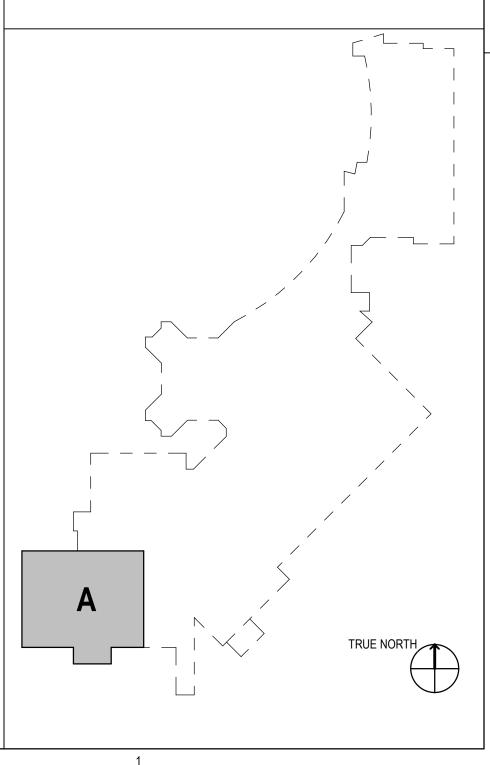

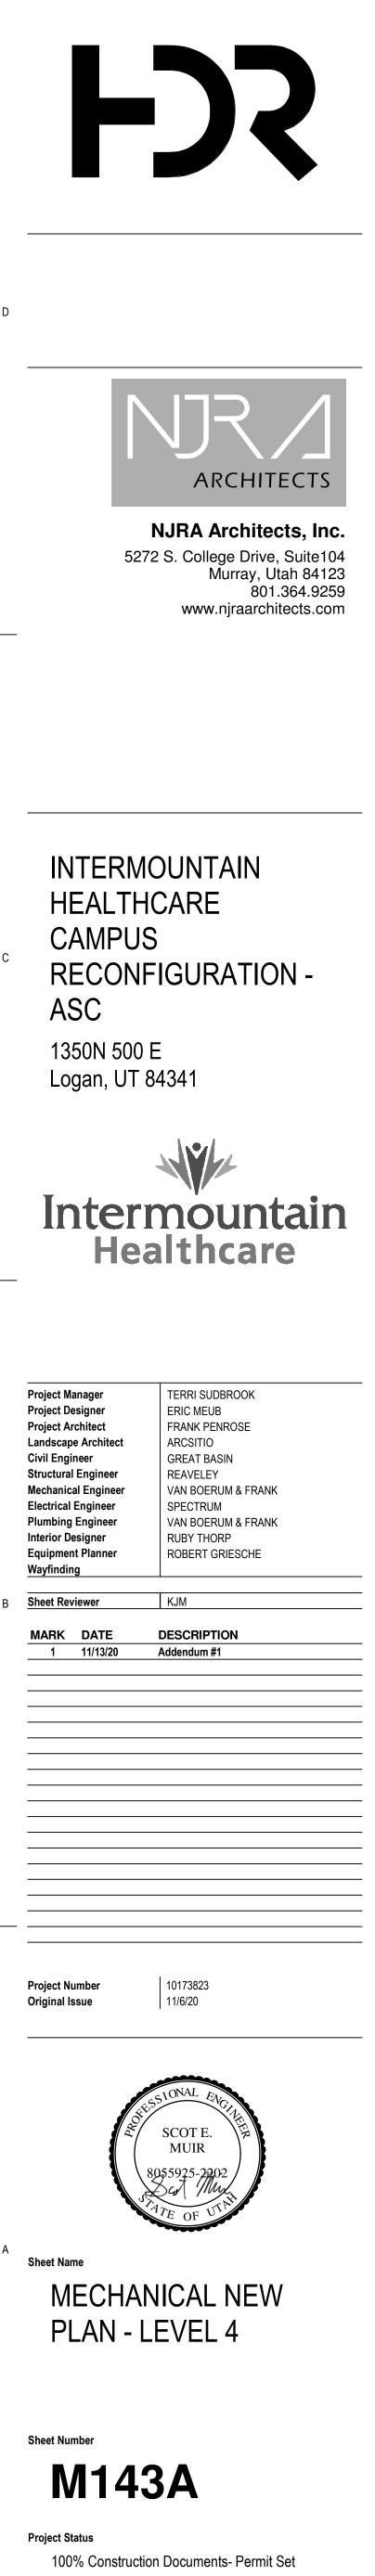


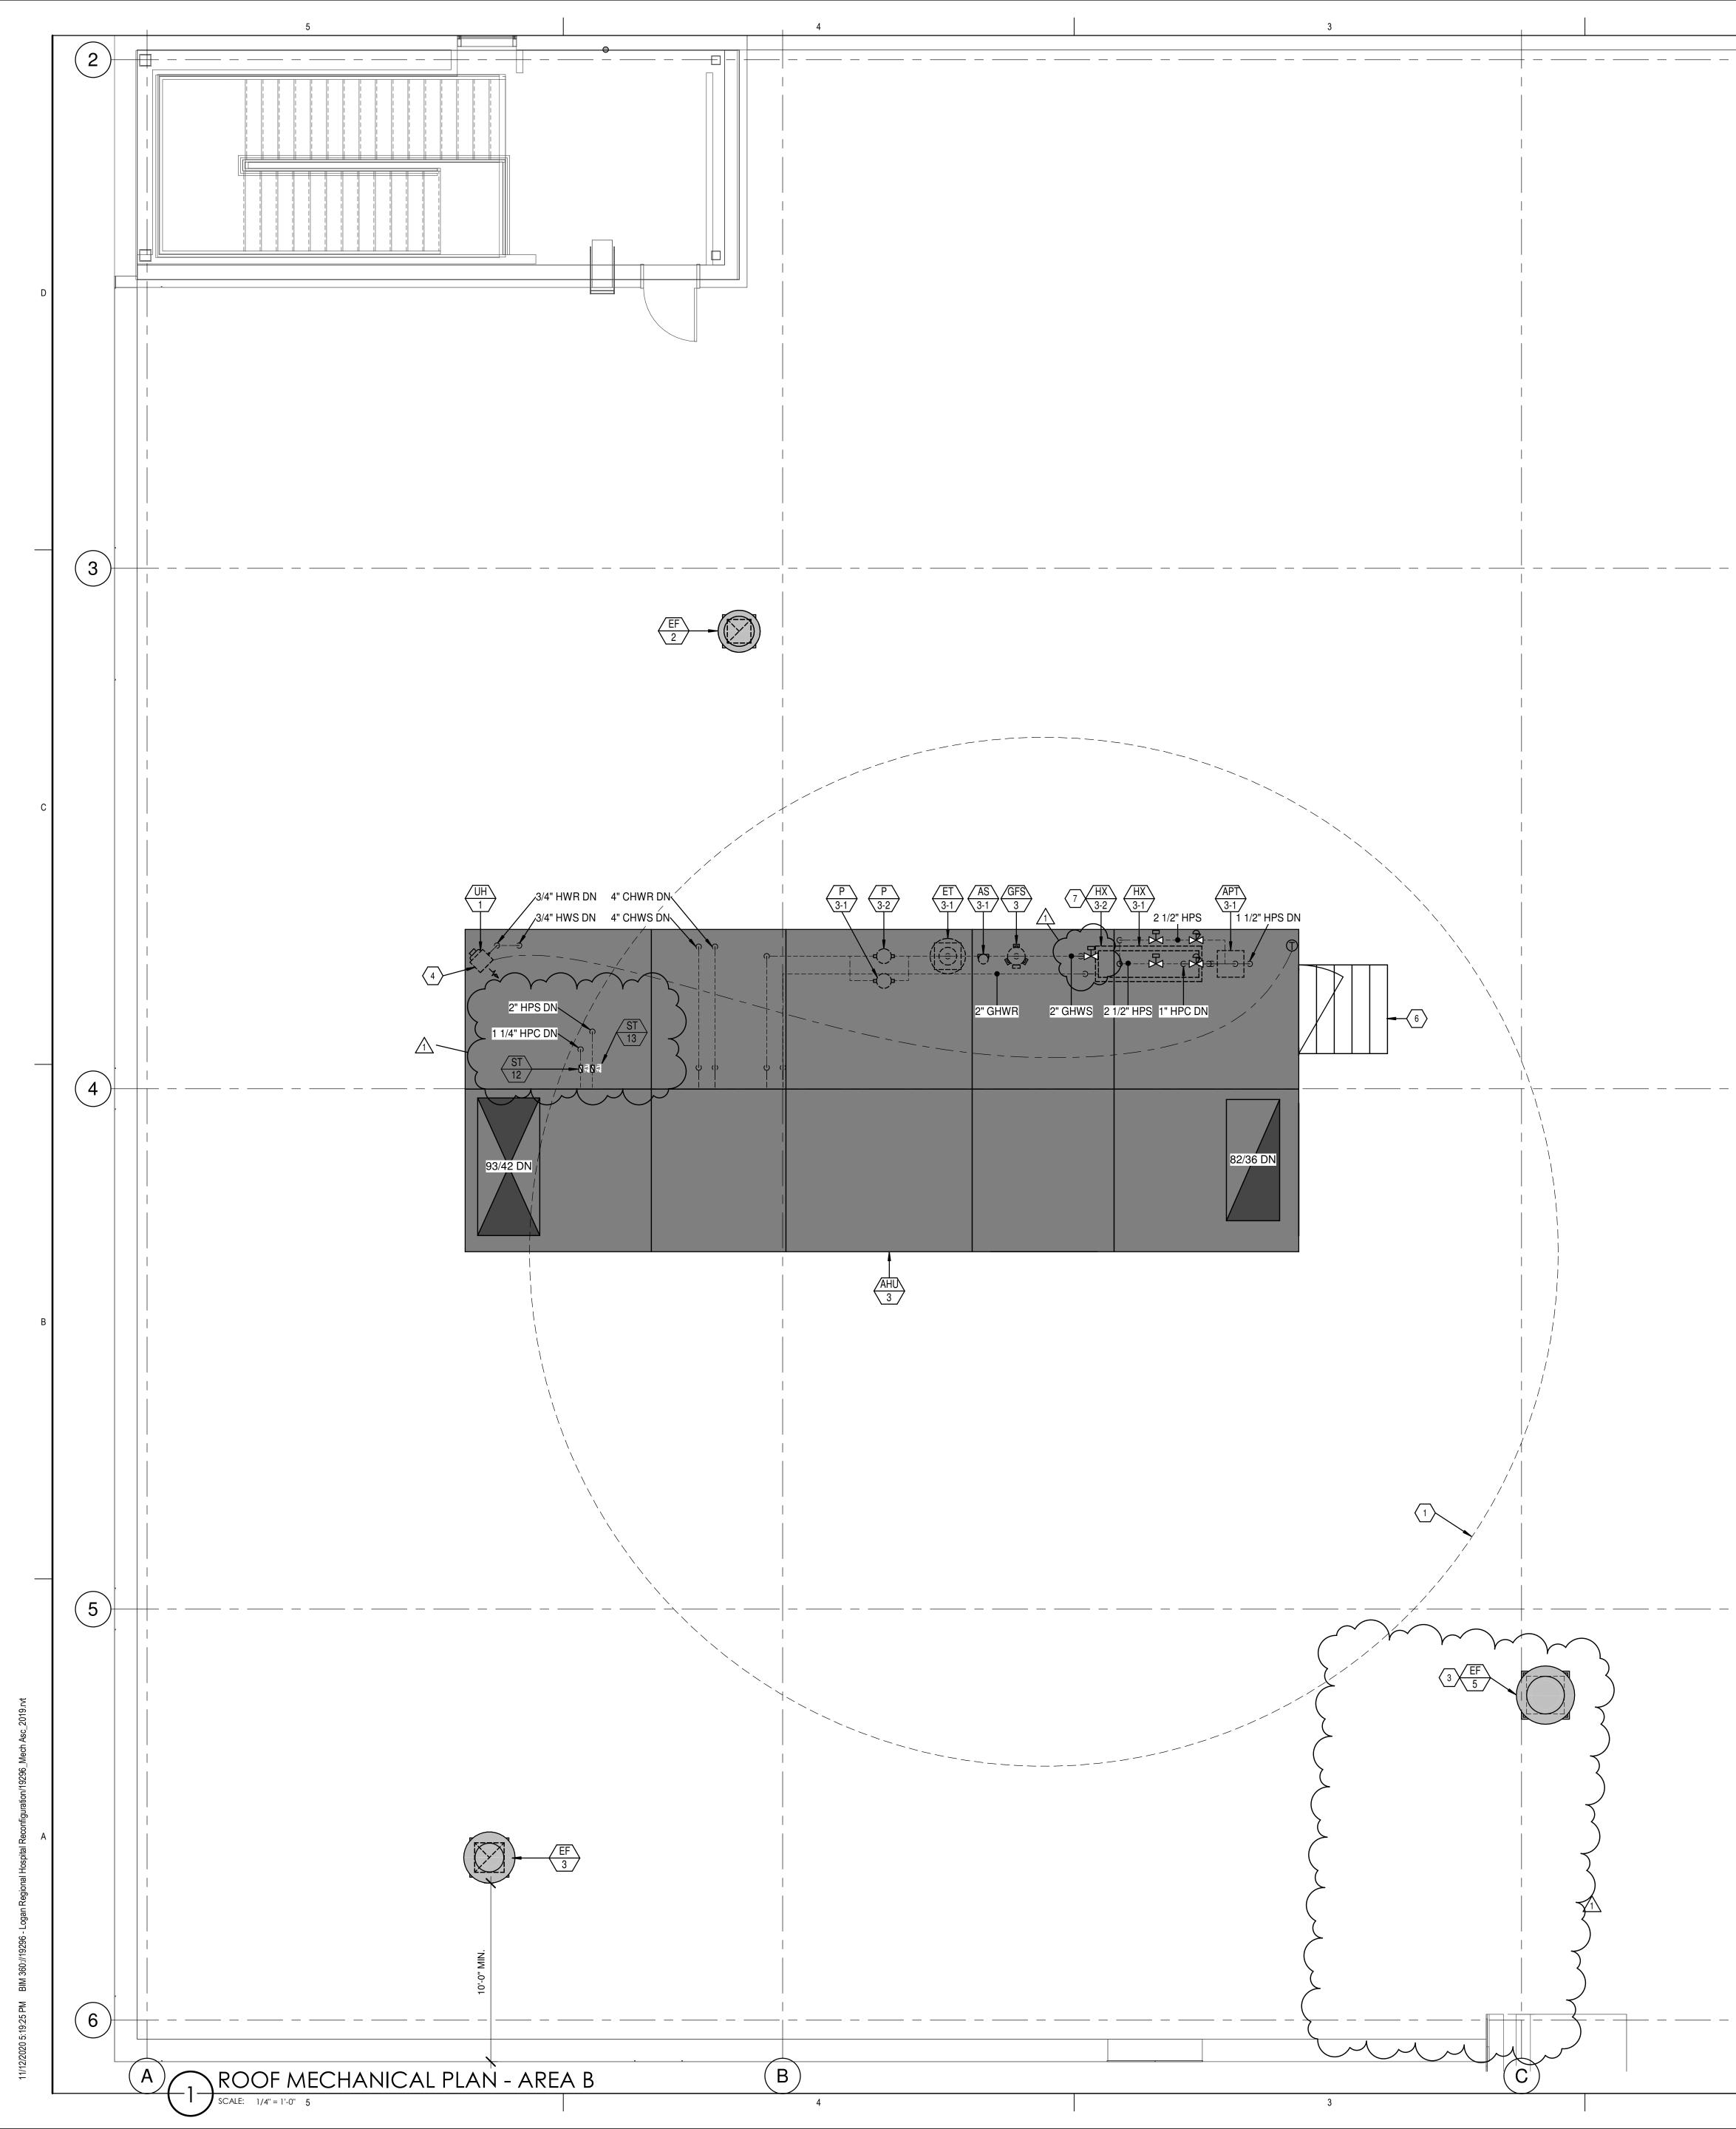



2				1
				SHEET KEYNOTES
			1.	THIS DASHED LINE REPRESENTS THE 25'-0" CLEARANCE ZONE REQUIRED FOR THE FRESH AIR INTAKE ON AIR HANDLER AHU-3. ENSURE THAT NO EXHAUST AIR OR PLUMBING VENT OUTLET IS INSTALLED WITHIN THIS CLEARANCE ZONE.
			2.	THIS EXISTING ROOFTOP EQUIPMENT IS TO REMAIN IN SERVICE. PROTECT FROM DAMAGE.
			3.	INTERCONNECT THIS EXHAUST FAN WITH VAV BOX VR-1-4-20 TO MAINTAIN THE POSITIVE PRESSURE OFFSET AIRFLOW AS DESCRIBED ON SHEET M701. AS THE AIRFLOW THROUGH THE VAV BOX CHANGES, THE AIRFLOW THROUGH THIS EXHAUST FAN IS TO ALSO CHANGE ACCORDINGLY.
			4.	PROVIDE A 3-WAY AUTOMATIC CONTROL VALVE IN THE HEATING HOT WATER RETURN PIPING FOR THIS UNIT HEATER.
			5.	INTERCONNECT THIS EXHAUST FAN WITH VAV BOX VR-1-4-21 TO MAINTAIN THE NEGATIVE PRESSURE OFFSET AIRFLOW AS DESCRIBED ON SHEET M701. AS THE AIRFLOW THROUGH THE VAV BOX CHANGES, THE AIRFLOW THROUGH THIS
			6.	EXHAUST FAN IS TO ALSO CHANGE ACCORDINGLY. ACCESS STEPS INTO THE NEW AIR HANDLER SERVICE CORRIDOR ARE TO BE PROVIDED BY THE AIR HANDLER
EF			7.	MANUFACTURER. THIS REDUNDANT HEAT EXCHANGER IS LOCATED DIRECTLY BELOW HEAT EXCHANGER HX-3-1. THEY WILL BE STACKED
				ON TOP OF EACH OTHER. REFER TO THE MECHANICAL SCHEMATICS FOR ADDITIONAL INFORMATION.
	2			
2	-			
	4 4			
< <u> </u>				
·				
•	NORTH			
2				1

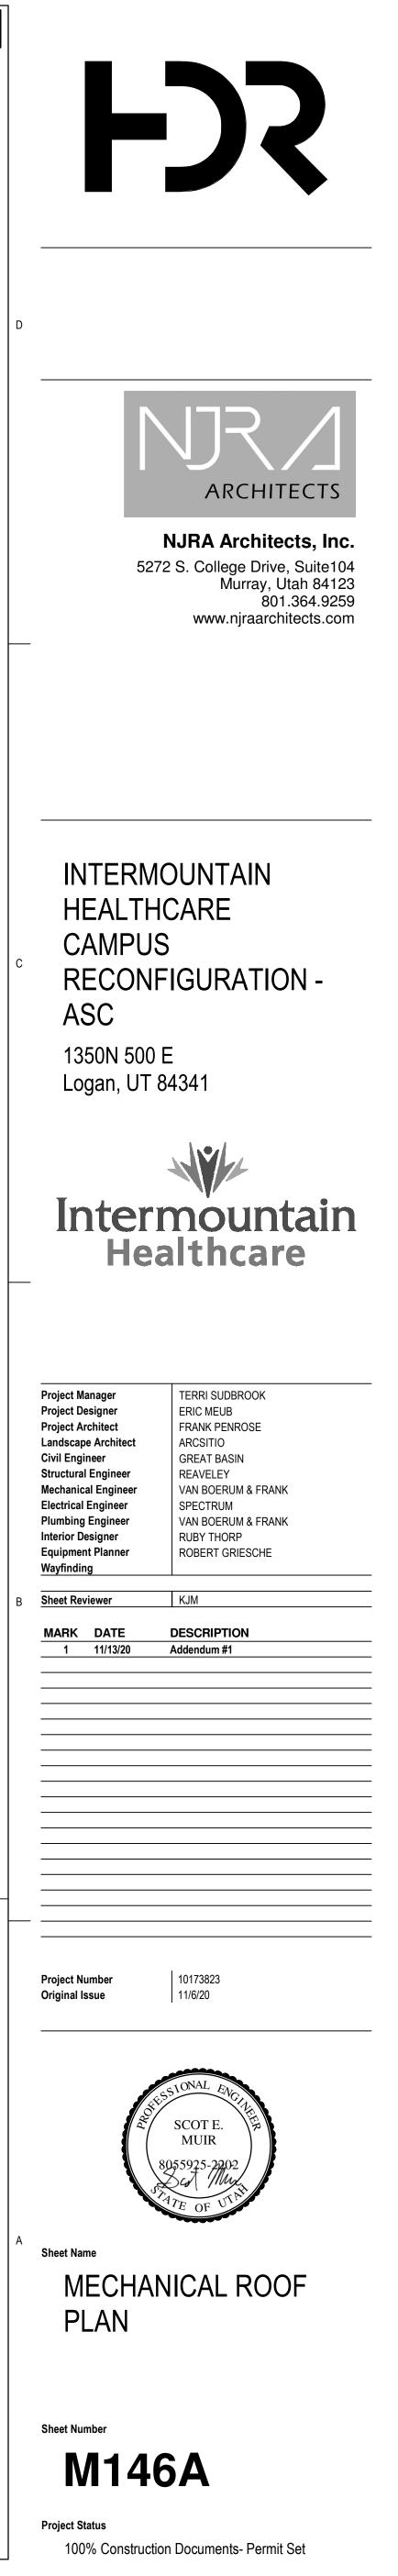




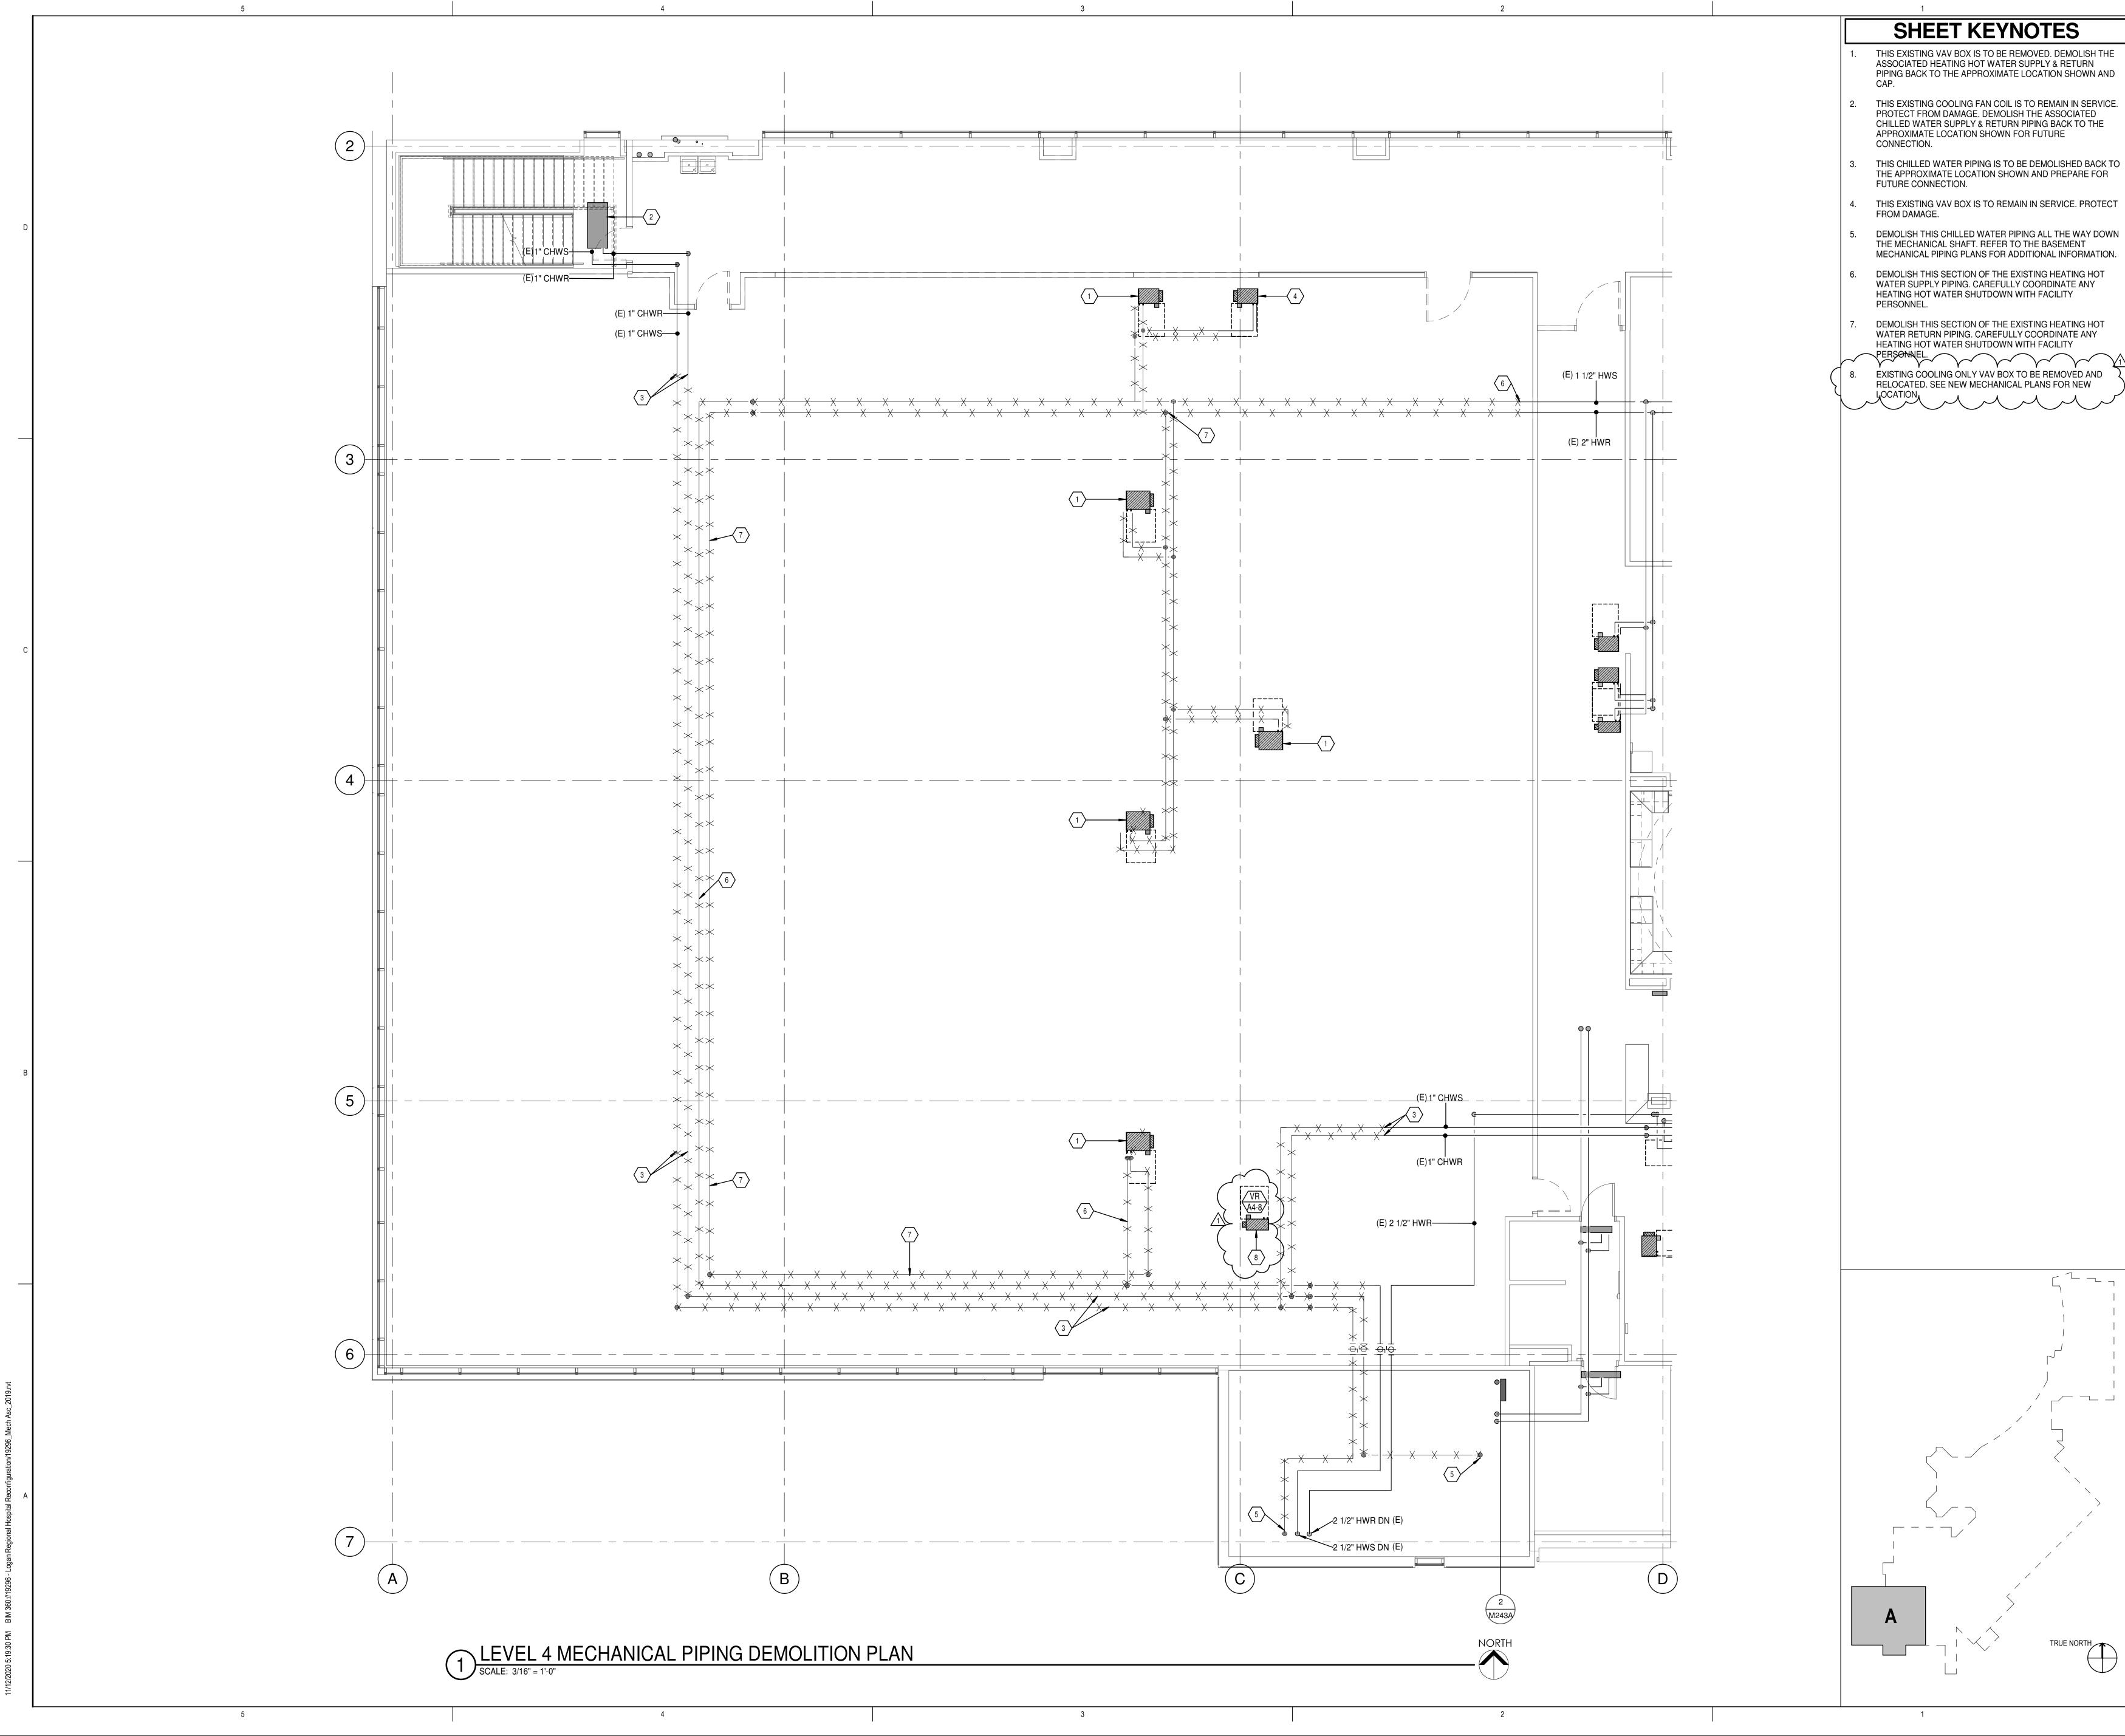

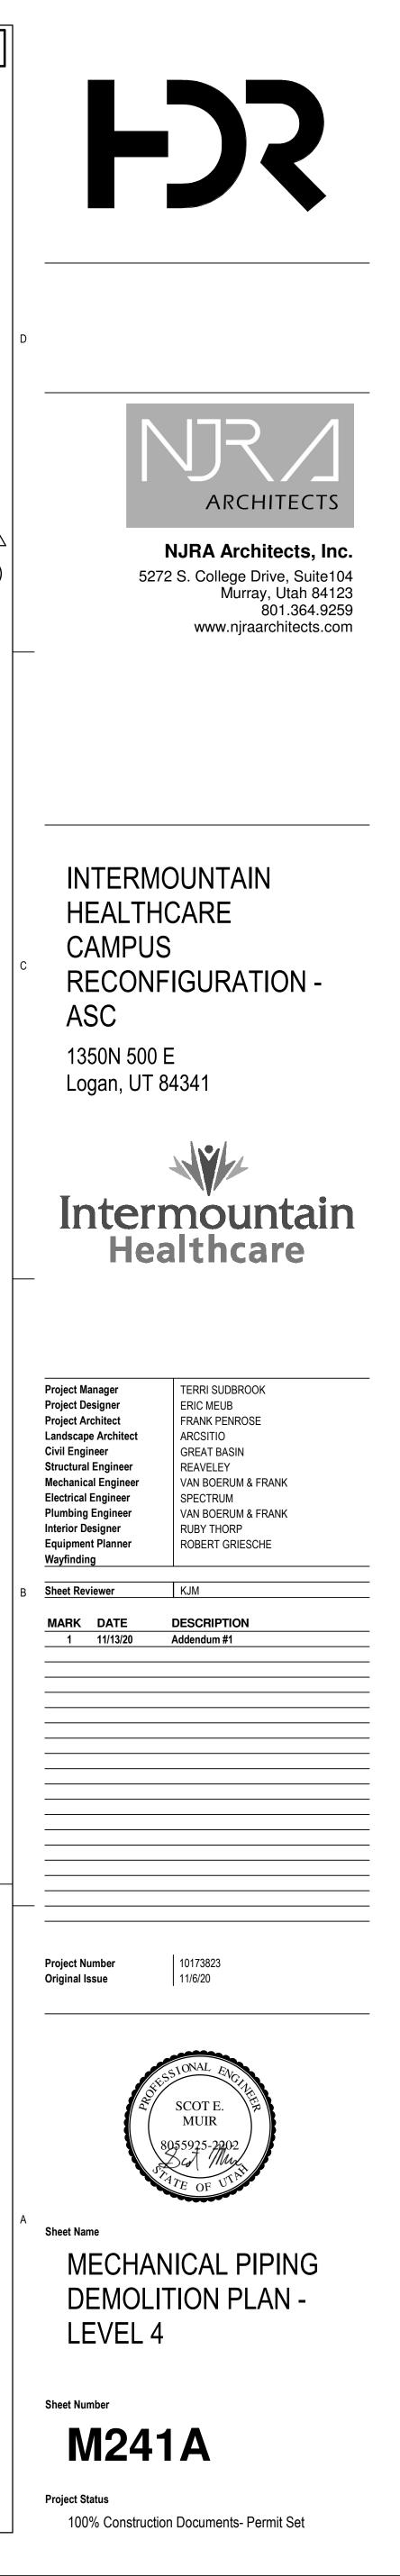

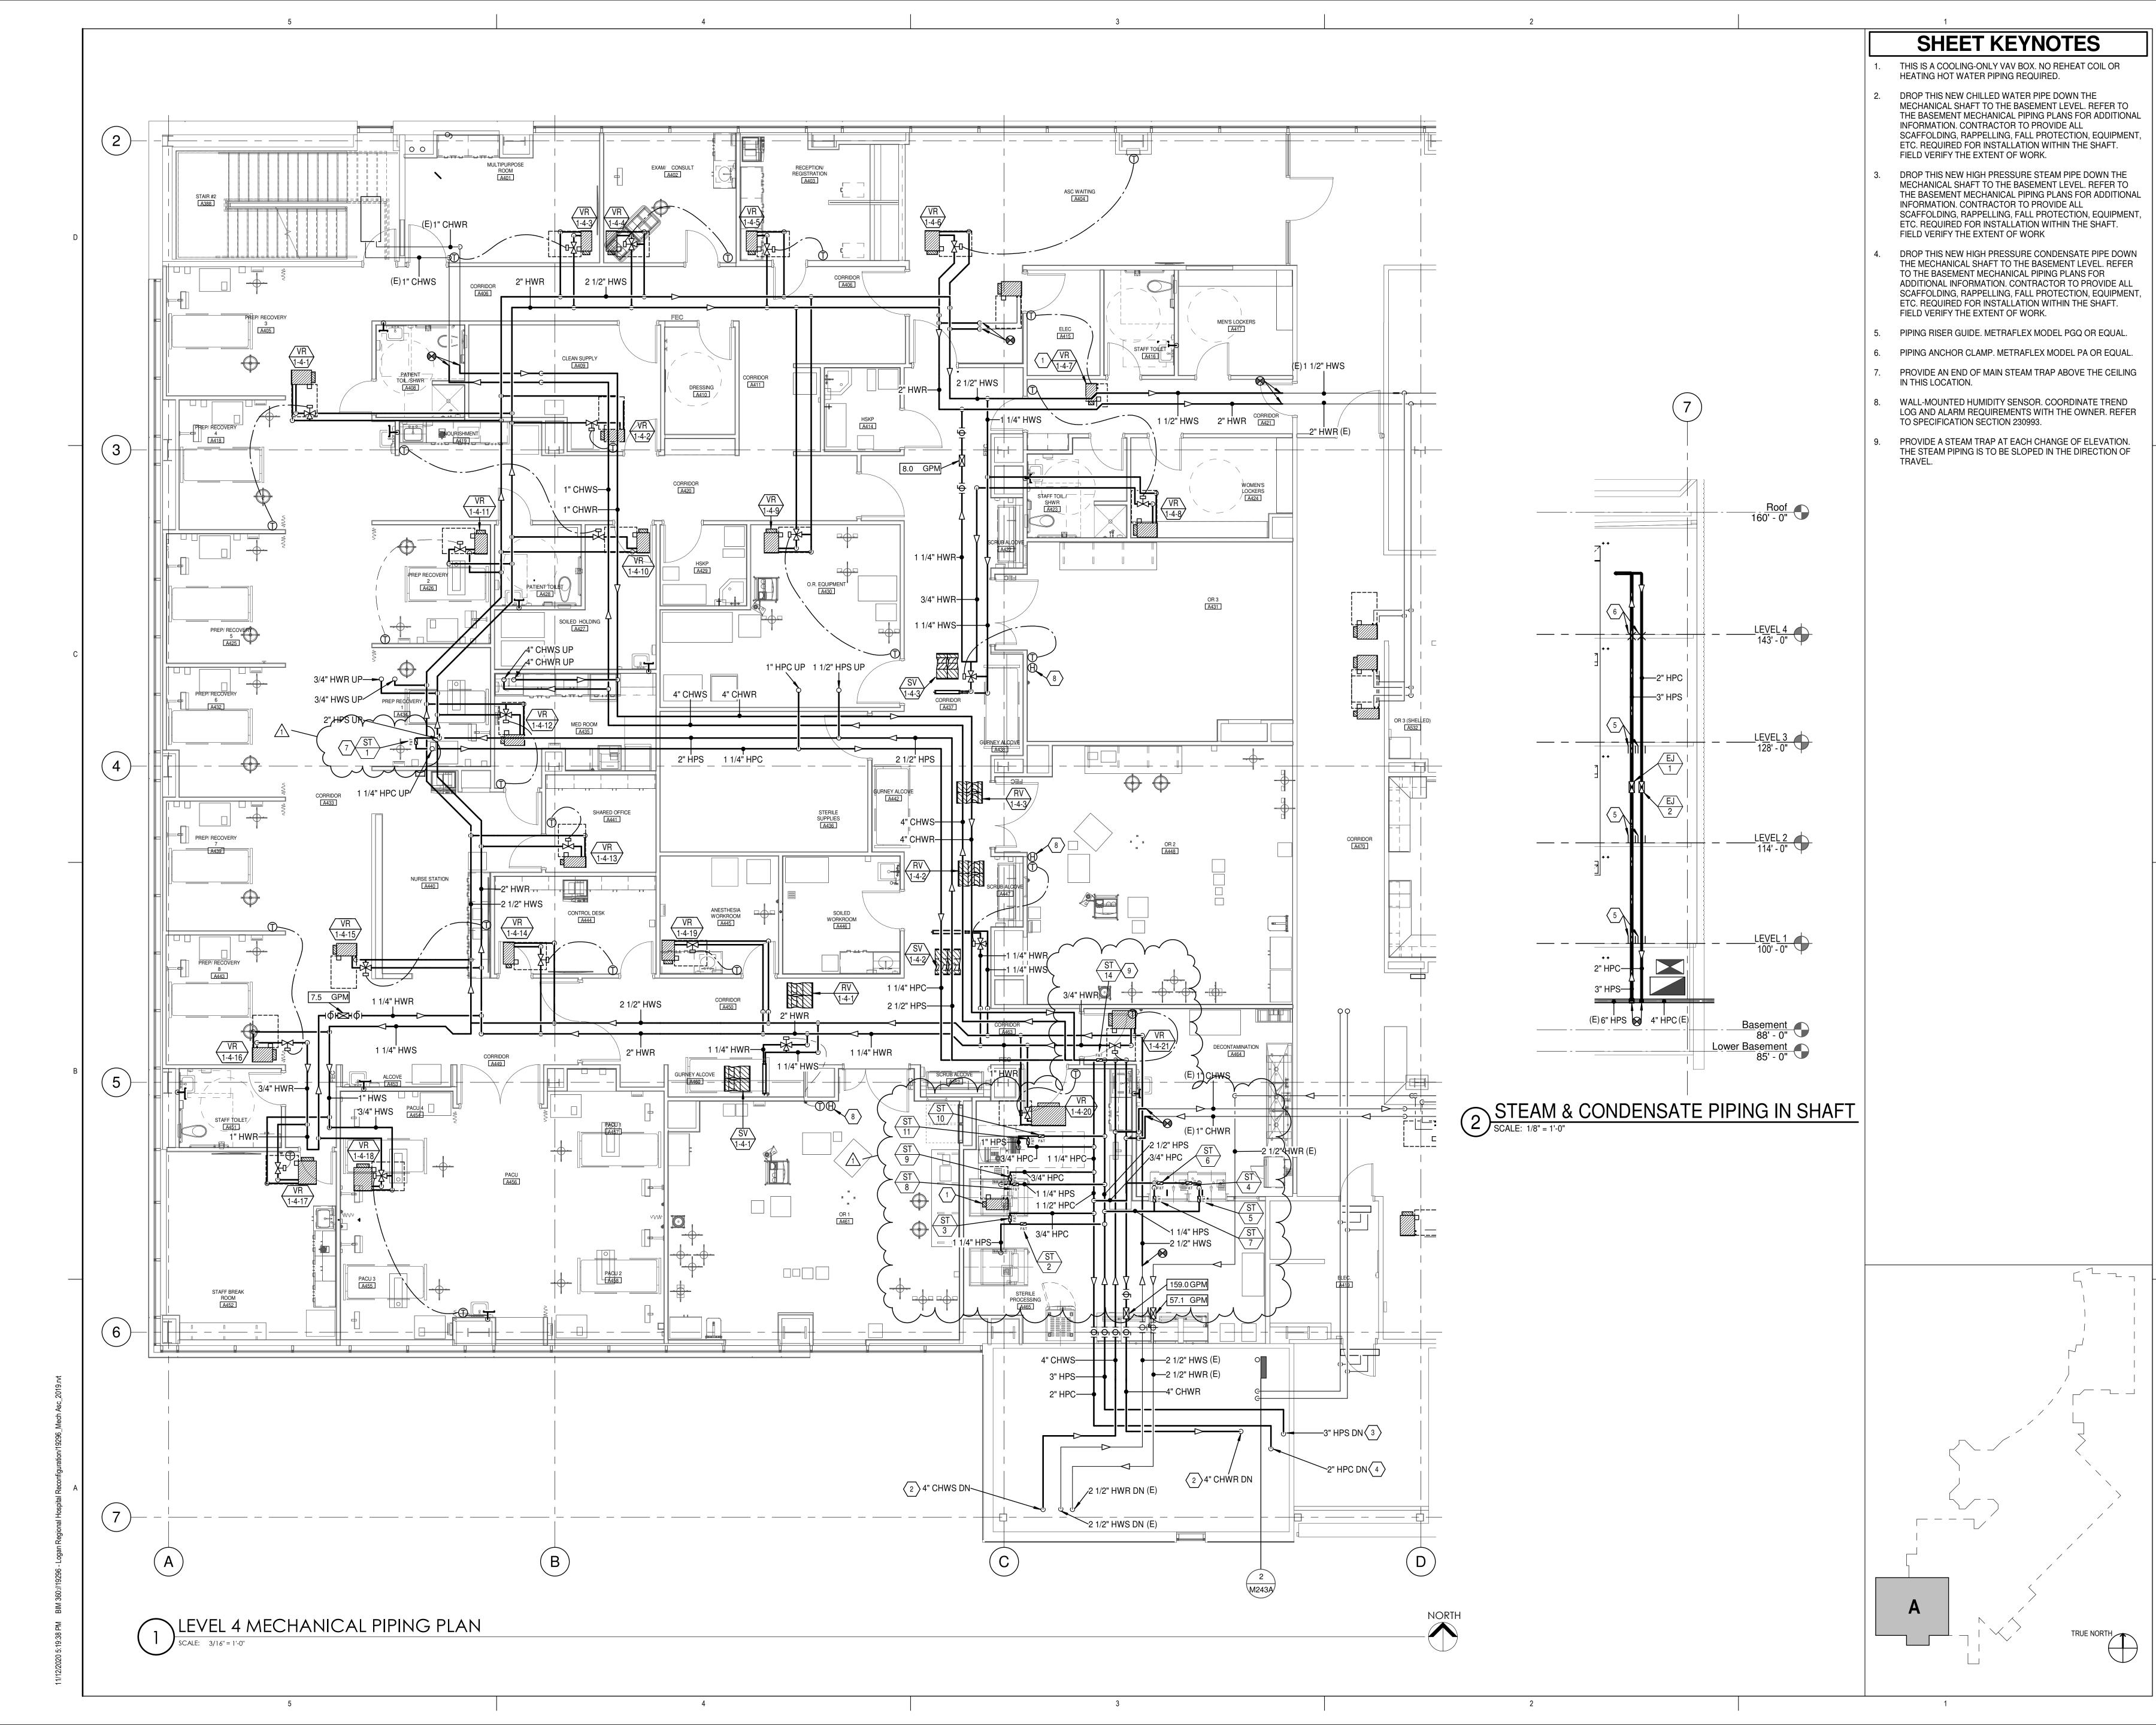



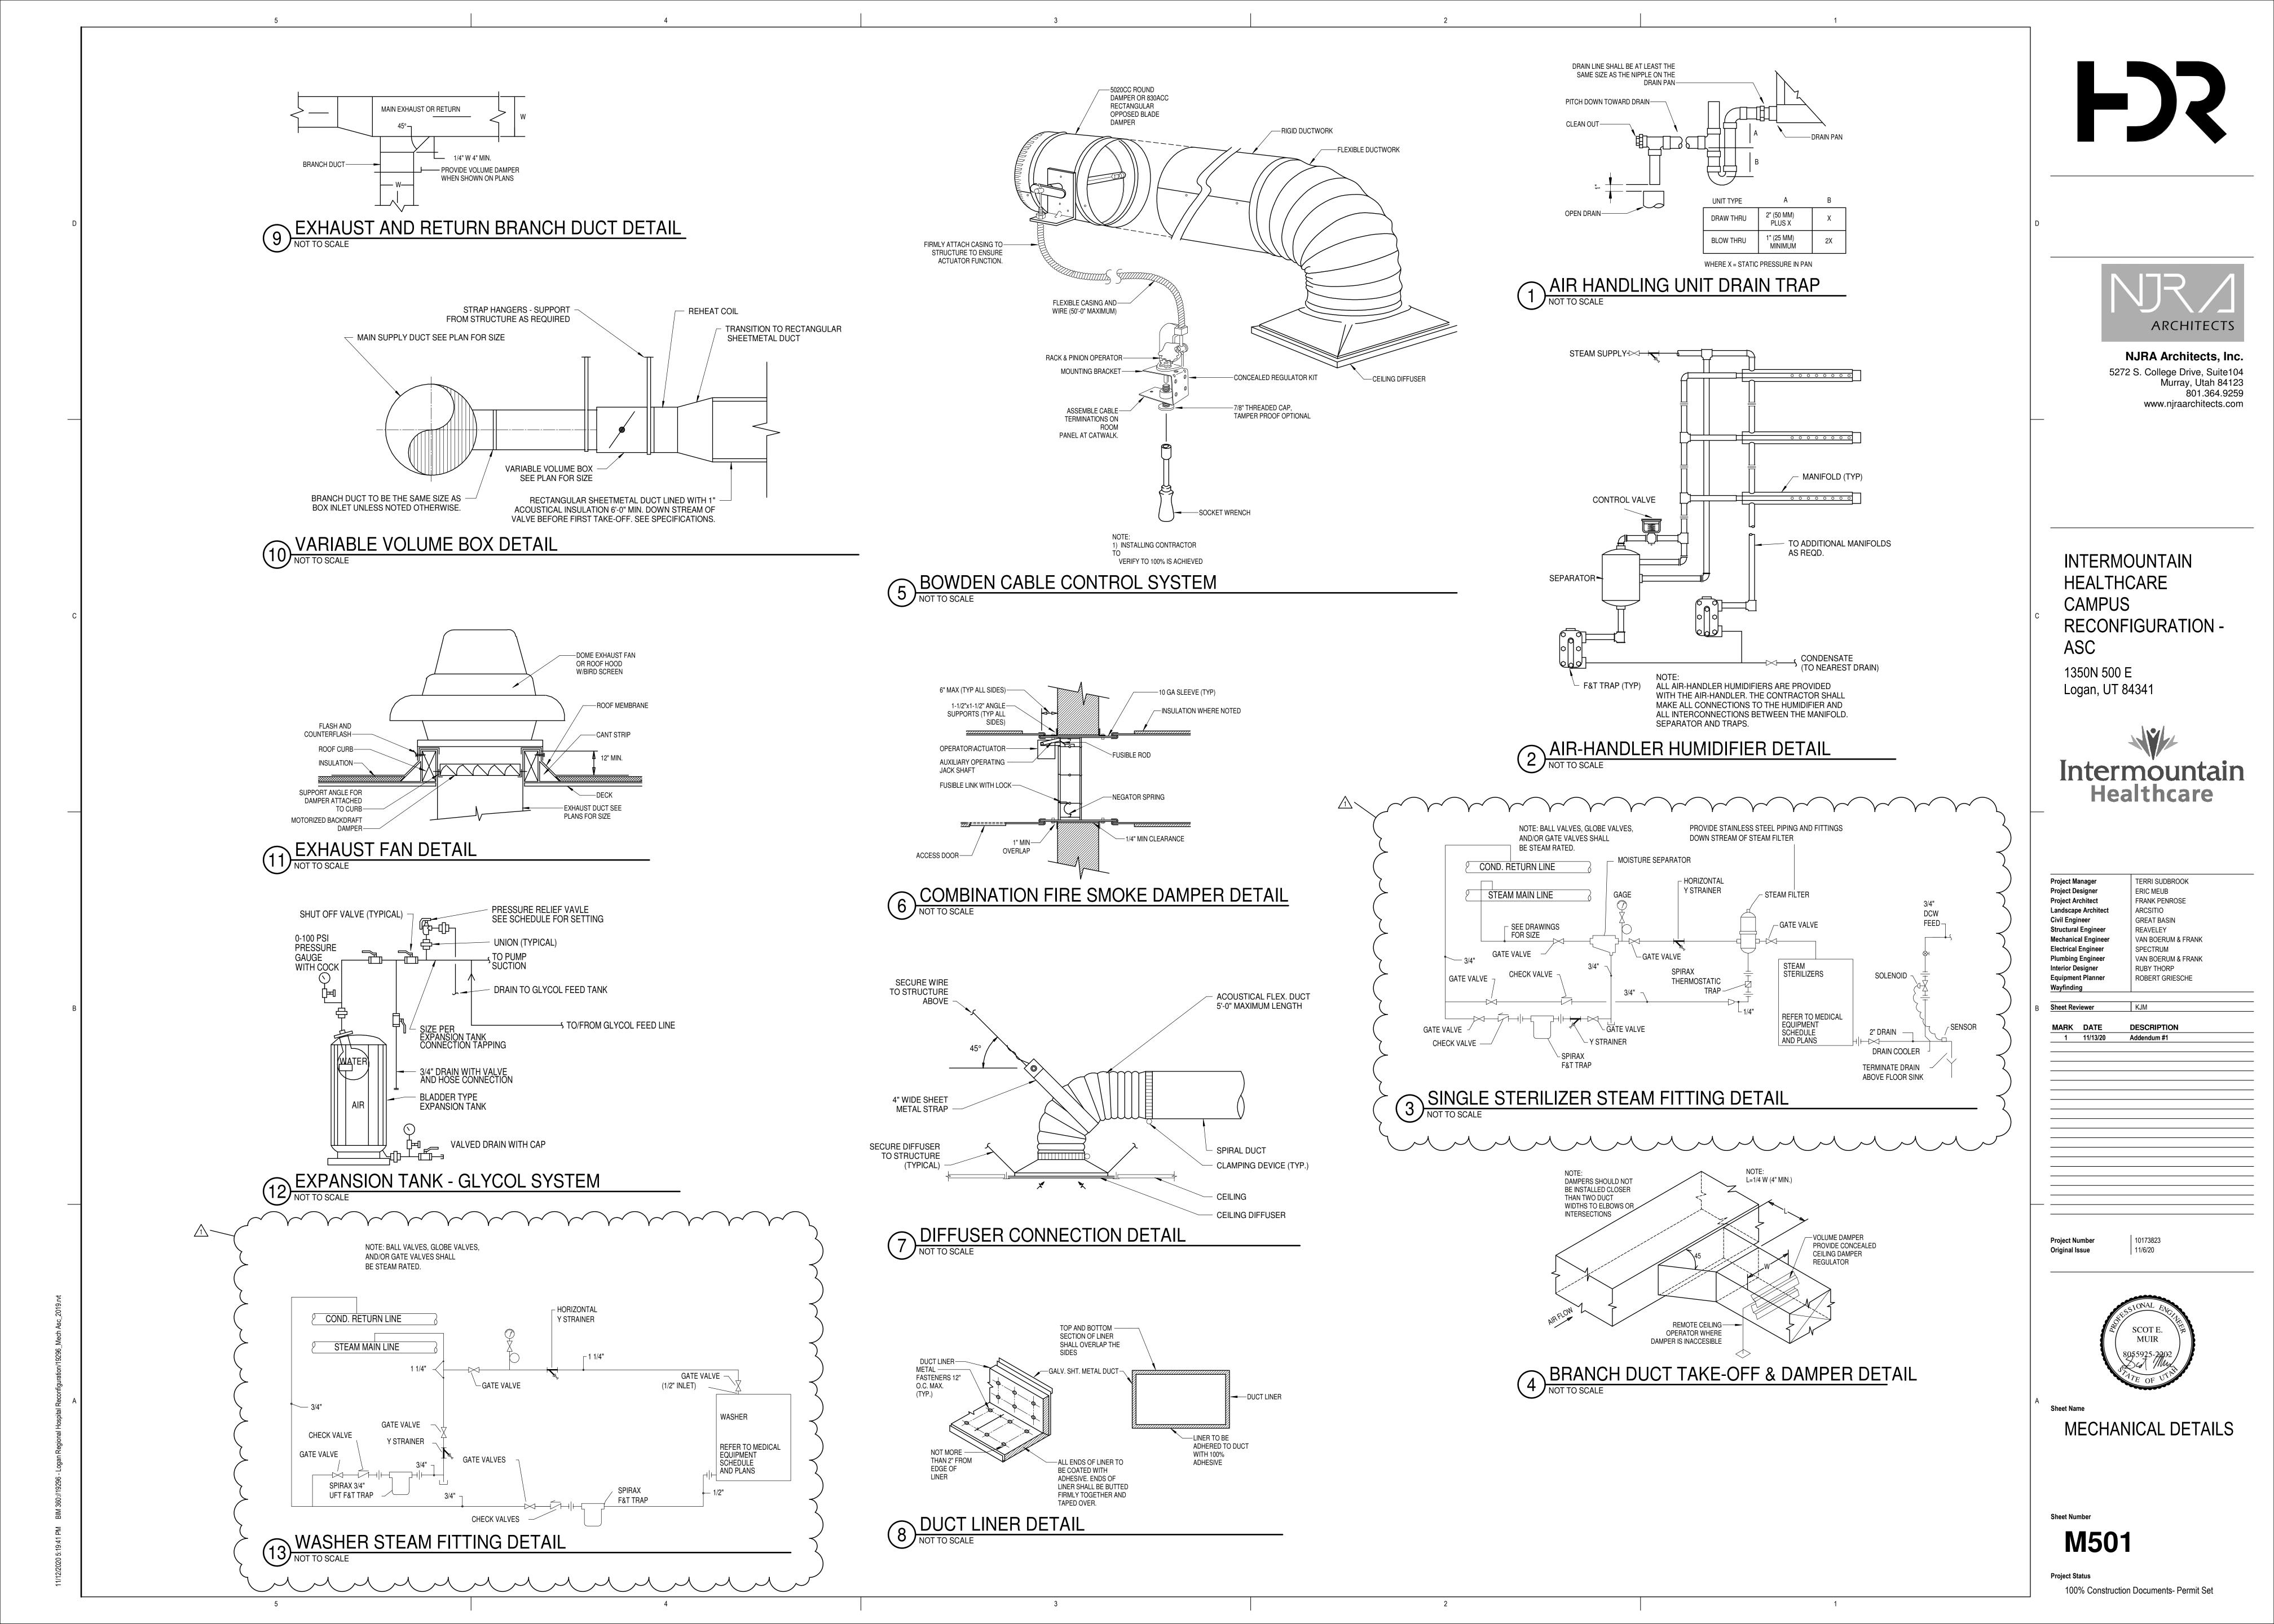

			SUPPLY																			RETURN				
				AIR								FLUID				_	COIL		_							
				COOLING	HEATING	OCCUPIED	UNOCCUPIED		ENTERING	MINIMUM	S.P. LOSS		TOTAL	ENTERING/		MAX. FLUID			COIL	MAX. AIR				OCCUPIED	UNOCCUPIED	S.P. LOSS
		MANUFACTURER	INLET	MAXIMUM	MAXIMUM	MINIMUM	MINIMUM	AIRFLOW	AIR TEMP.	LEAVING	AT MAX	HEAT	FLUID	LEAVING		PRESSURE	MIN.	MIN.	SIZE	PRESSURE	PIPE	INLET	MAXIMUM	MINIMUM	MINIMUM	AT MAX
AREA		AND	DIA.	AIRFLOW	AIRFLOW	AIRFLOW	AIRFLOW	DRIVING	DB	AIR TEMP.	CFM	LOAD	FLOW	FLUID TEMP.	WORKING	DROP	COIL	FINS	H x W	DROP	SIZE	DIA.	AIRFLOW	AIRFLOW	AIRFLOW	CFM
SERVED	ID	MODEL NUMBER	(IN)	(CFM)	(CFM)	(CFM)	(CFM)	FACTOR	(DEG. F)	(DEG. F)	(IN H20)	(BTUH)	(GPM)	(DEG. F)	FLUID	(FT)	ROWS	(FPI)	(IN)	(IN. W.G.)	(IN)	(IN)	(CFM)	(CFM)	(CFM)	(IN H20)
LEVEL 4 - ASC																										
OR #1	SV-1-4-1	TRIATEK VV214AIFAPHMU	2x14	3730	3730	2015	650	LOAD	52	90	0.6	130,401	8.7	180/150	WATER	2.0	2	8	18x32	0.4	1-1/4					
OR #1	RV-1-4-1	TRIATEK VV214ANFAPHMU																				2x14	3430	1715	350	0.6
	SV-1-4-2	TRIATEK VV214AIFAPHMU	2x14	3410	3410	2015	650	LOAD	52	90	0.6	119,214	7.9	180/150	WATER	2.0	2	8	18x32	0.4	1-1/4					
OR #2	RV-1-4-2	TRIATEK VV214ANFAPHMU																				2x14	3110	1715	350	0.6
	SV-1-4-3	TRIATEK VV212AIFAPHMU	2x12	2660	2660	1535	480	LOAD	52	90	0.6	92,994	6.2	180/150	WATER	2.0	2	8	18x26	0.4	1-1/4					
OR #3 (SHELLED)	RV-1-4-3	TRIATEK VV212ANFAPHMU																				2x12	2360	1235	180	0.6

(1) ALL CAPACITIES AT 4,500 FT ELEVATION. (2) PRESSURE INDEPENDENT LOW PRESSURE CONTROL VALVE. VALVE SHALL BE EQUIPPED WITH PRESSURE SWITCH.

4

4

5

5

						LI	EVEL 4
			AIR				
			COOLING	HEATING		ENTERING	LEAVING
	MANUFACTURER	INLET	MAXIMUM	MAXIMUM	MINIMUM	AIR TEMP.	AIR TEMP.
	AND	SIZE	AIR (5)	AIR	AIR (3)	DB	DB
ID	MODEL NUMBER	(IN)	(CFM)	(CFM)	(CFM)	(DEG. F)	(DEG. F)
V-1-4-1	TITUS-ESV-3	12	1480	860	325	52	90
V-1-4-2	TITUS-ESV-3	10	745	635	500	52	90
V-1-4-3	TITUS-ESV-3	8	400	345	145	52	90
V-1-4-4	TITUS-ESV-3	8	240	320	145	52	90
V-1-4-5	TITUS-ESV-3	8	360	300	145	52	90
V-1-4-6	TITUS-ESV-3	12	840	945	325	52	90
V-1-4-7	TITUS-ESV-3	6	350	0	80	52	52
V-1-4-8	TITUS-ESV-3	12	780	780	780	52	90
V-1-4-9	TITUS-ESV-3	12	1135	775	325	52	90
V-1-4-10	TITUS-ESV-3	10	765	765	765	52	90
V-1-4-11	TITUS-ESV-3	10	485	535	230	52	90
V-1-4-12	TITUS-ESV-3	8	470	145	145	52	90
V-1-4-13	TITUS-ESV-3	6	155	120	80	52	90
V-1-4-14	TITUS-ESV-3	6	250	120	80	52	90
V-1-4-15	TITUS-ESV-3	10	750	600	230	52	90
V-1-4-16	TITUS-ESV-3	12	1480	860	325	52	90
V-1-4-17	TITUS-ESV-3	14	1600	1350	1350	52	90
V-1-4-18	TITUS-ESV-3	14	1250	1020	450	52	90
V-1-4-19	TITUS-ESV-3	10	715	505	505	52	90
V-1-4-20	TITUS-ESV-3	24x16	2600	1260	1260	52	90
V-1-4-21	TITUS-ESV-3	14	1660	1000	1000	52	90
VR-A4-2	TITUS-ESV-3	12	1460	1460	440	52	90
VR-A4-8	TITUS-ESV-3	6	200	0	80	52	52

1. MAXIMUM DISCHARGE NC AT BOX DIFFERENTIAL PRESSURE BASED ON ARI STANDARD 880-89

2. COIL HEATING CAPACITY BASED ON HEATING MAXIMUM AIR FLOW (60% OF MAXIMUM COOLING CFM FOR THAT BOX SIZE).

3. MINIMUM CFM IS THE LOWEST CONTROLLABLE CFM SETTING (BASED ON 400 FPM INLET VELOCITY) UNLESS SHOWN HIGHER IN THIS SCHEDULE.

4. MAXIMUM STATIC PRESSURE DROP PERMISSABLE ACROSS BOX AND COIL AT MAXIMUM COOLING CFM.

5. BOX COOLING MAXIMUM IS THE SUM OF DIFFUSERS CFM VALUES AS SHOWN IN THE DRAWINGS.

6. PRESSURE INDEPENDENT TYPE BOX.

7. COOLING-ONLY VAV BOX. NO REHEAT COIL REQUIRED. 8. EXISTING VAV BOX TO BE RECONNECTED TO THE NEW DUCTWORK AS SHOWN ON THE DRAWINGS. AFTER THE CONSTRUCTION IS COMPLETE, REBALANCE TO THE VALUES SHOWN ON THIS SCHEDULE.

			UNIT	HEAT	ER SCH	HEDUI	E						
			AIR		CAPACITY			ELECTRICAL			PHYSICAL		
							ENTERING				DEPTH/		
	MANUFACTURER		AIRFLOW		HEATING	НОТ	WATER	MOTOR			WIDTH/		
	AND		RATE		OUTPUT	WATER	TEMP	SIZE		TOTAL	HEIGHT	WEIGHT	
ID	MODEL NUMBER	LOCATION	(CFM)	RPM	(BTUH)	(GPM)	(F)	(HP)	VOLT/PH/HZ	FLA	(IN)	(LBS)	NOTES
UH-1	TRANE UHSB0181TAA101A0000	AHU-3 SERVICE VESTIBULE	395	1550	12,327	1.3	180	0.02	115/1/60	0.8	10/12.25/15	26	1, 2, 3, 4

0.0

-.-

1. HEATER IS FOR FREEZE PROTECTION. SET THERMOSTAT FOR 50 DEGREES (ADJUSTABLE).

2. UNIT TO BE CONTROLLED BY A DDC THERMOSTAT IN THE LOCATION SHOWN ON THE DRAWINGS. 3. BMS TO MONITOR THE SPACE TEMPERATURE & ALARM IF THE SPACE DROPS BELOW 45 DEGREES (ADJUSTABLE).

4. UNIT HEATER IS ON EMERGENCY POWER.


3

	EXPANSION JOINT SCHEDULE												
	MANUFACTURER			PRESSURE		TOTAL	TOTAL						
	AND	LOCATION	SERVICE	RATING	DIAMETER	AXIAL	AXIAL	TYPE					
	MODEL NUMBER		LINE			EXTENSION	COMPRESSION	WITH BASE					
ID				(PSI)	(IN)	(IN)	(IN)		NOTES				
EJ-1	METRAFLEX HPF30300	MECH. SHAFT	HPS	175	3	0.50	3.00	FIXED FLANGE DUAL ANCHOR BASE	1				
EJ-2	METRAFLEX HPT30200	MECH. SHAFT	HPC	175	2	0.50	3.00	SCHEDULE 80 THREADED CONNECTION					

HPS: HIGH PRESSURE STEAM HPC: HIGH PRESSURE CONDENSATE

1.RAISED FACED SLIP-ON FLANGES, LIFTING LUG, VENT PLUG, DRAIN PLUG. 2. SWEAT ENDS BRONZE HOSE & BRAID, LEAD FREE, POTTABLE WATER USE. 3. WELD ENDS, SCHED. 40 CARBON STEEL, HOSE & BRAID - SERIES 300 STAINLESS STEEL. 4. WELDED ENDS, STAINLESS STEEL. CONTRACTOR TO SUBMIT SHOPDRAWINGS AND EXPANSION CALCULATIONS.

2

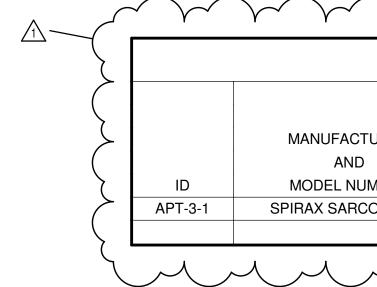

### **4 VAV BOX SCHEDULE** COIL FLUID (2) S.P. LOSS NC AT TOTAL ENT./LEAV. MAX. FLUID BALANCING AT MAX HEAT 1" H2O FLUID FLUID PRESSURE MIN. PIPE VALVE CFM (4) LOAD TEMP WORKING COIL SIZE (1) FLOW DROP SIZE ROWS (IN H20) S.P. (BTUH) (GPM) (DEG. F) FLUID (FT) (IN) (IN) REMARKS 0.65 26 30,066 2.0 180/150 H. WATER 1 2 3/4 3/4 1,2,3,4,5,6 1,2,3,4,5,6 0.65 22,200 1.5 180/150 H. WATER 3/4 1/2 28 1 2 0.65 12,061 0.8 180/150 H. WATER 2 3/4 1/2 1,2,3,4,5,6 28 1 3/4 0.65 11,187 0.7 180/150 H. WATER 2 1/2 1,2,3,4,5,6 28 1 0.65 10,488 0.7 180/150 H. WATER 2 3/4 1/2 1,2,3,4,5,6 28 1 33,037 H. WATER 3/4 0.65 26 2.2 180/150 2 3/4 1,2,3,4,5,6 1 1,3,4,5,6,7 0.5 0.0 28 0 -.--.--.--.--.--.-0.65 27,269 1.8 180/150 H. WATER 3/4 3/4 1,2,3,4,5,6 26 2 1 0.65 27,094 180/150 H. WATER 3/4 3/4 1,2,3,4,5,6 26 1.8 1 2 0.65 26 26,744 1.8 180/150 H. WATER 3/4 3/4 1,2,3,4,5,6 1 2 18,704 3/4 1,2,3,4,5,6 0.65 26 1.2 180/150 H. WATER 2 3/4 1 0.65 5,069 0.3 3/4 1,2,3,4,5,6 28 180/150 H. WATER 1 2 1/2 3/4 1,2,3,4,5,6 0.5 4,195 0.3 180/150 H. WATER 2 1/2 28 1 0.5 28 4,195 0.3 180/150 H. WATER 1 2 3/4 1/2 1,2,3,4,5,6 H. WATER 3/4 3/4 1,2,3,4,5,6 0.65 20,976 1.4 180/150 2 26 1 0.65 H. WATER 3/4 3/4 1,2,3,4,5,6 30,066 2.0 180/150 2 26 1 0.65 47,196 3.1 H. WATER 3/4 3/4 1,2,3,4,5,6 26 180/150 2 1 3/4 0.65 26 35,659 2.4 180/150 H. WATER 2 3/4 1,2,3,4,5,6 1 0.65 17,655 1.2 180/150 H. WATER 3/4 3/4 1,2,3,4,5,6 26 1 2 0.7 29 44,050 2.9 180/150 H. WATER 1 2 3/4 3/4 1,2,3,4,5,6 0.65 34,960 2.3 180/150 H. WATER 3/4 1/2 1,2,3,4,5,6 26 1 2 0.65 51,042 180/150 H. WATER 2 3/4 3/4 1,2,3,4,5,6,8 26 3.4 1

-.-

-.-

-.-

-.-

-.-

0.5

28

0


HWS: HOT WATER SUPPLY HWR: HOT WATER RETURN

DHWS: DOMESTIC HOT WATER SUPPLY DHWR: DOMESTIC HOT WATER RETURN

G(HWS): GLYCOL HOT WATER SUPPLY G(HWR): GLYCOL HOT WATER RETURN

1

	AUTO	MATIC	PUMP TR	AP SCHE	DULE			
		STEAM					PHYSICAL	
						MINIMUM	LENGTH/	_
FURER		FLOW	OPERATING	MOTIVE	BACK	FILLING	WIDTH/	
		RATE	PRESSURE	PRESSURE	PRESSURE	HEAD	HEIGHT	
MBER	LOCATION	(LB/H)	(PSIG)	(PSIG)	(PSIG)	(IN)	(IN)	NOTES
CO APT14	AHU-3	546.6	6.4	66.3	10	8	15/15/12	

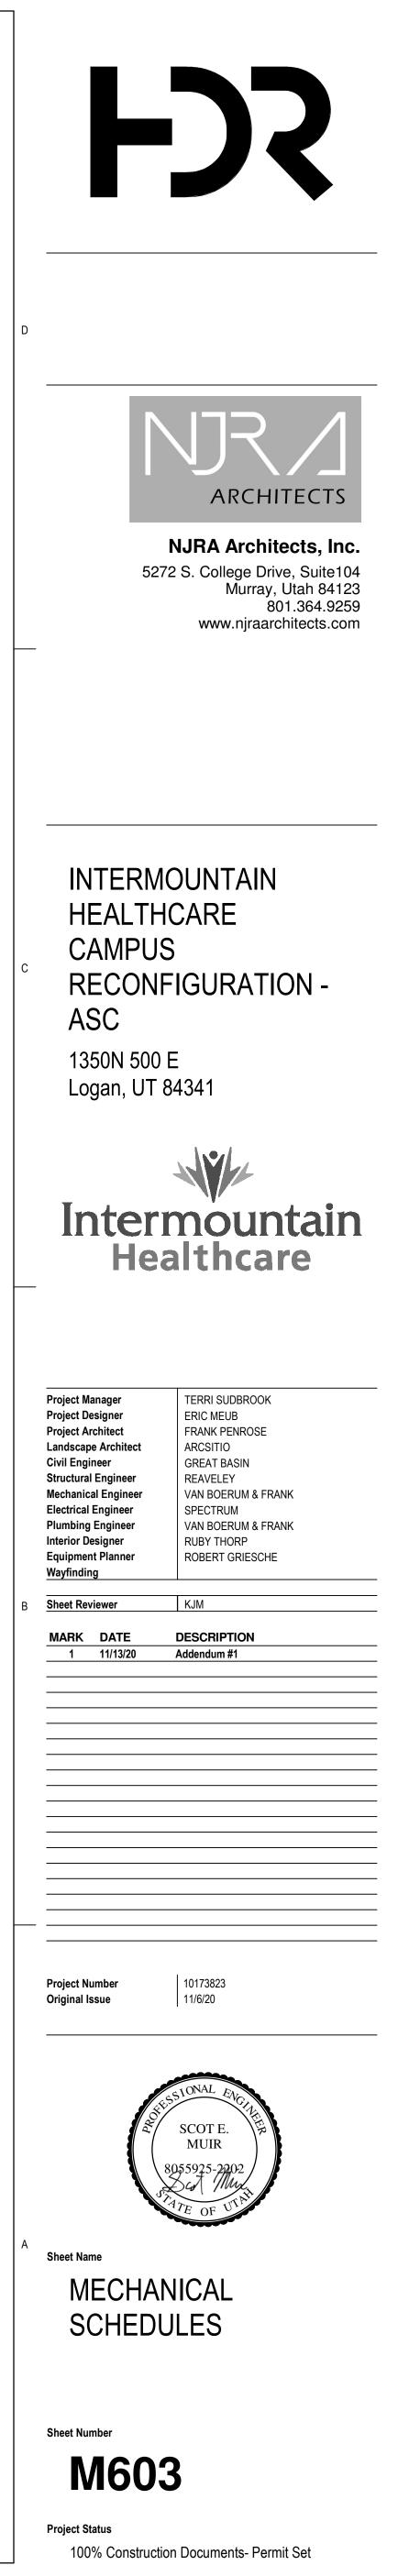

1,3,4,5,6,7,8

	D	
	C	
	В	
3:53 PM BIM 360://19296 - Logan Regional Hospital Reconfiguration/19296_Mech Asc_2019.rvt	A	


			ST	EAM FILT	ER S	CHE	DULE				
			_					STEAM		PHYSICAL	
	MANUFACTURER								LOW	CONNECT	
ID	AND MODEL NUMBER	LOCATIO	ואר		BOD CONSTRL				RATE (LB/H)	SIZE (IN)	NOTES
											NOTES
STF-1	SPIRAX SARCO FS-1-1/2	A465			STAINLESS	STEEL			310	1.25	
STF-2	SPIRAX SARCO FS-1-1/2	2 STERILE PROC	CESSING	i	STAINLESS	STEEL			310	1.25	
STF-3	SPIRAX SARCO FS-1	STERILE PROC	CESSING	i	STAINLESS	STEEL			158	1	
		ST	ΈΑ	M SEPAR	ATOF	R SCH	IEDUL	E			
								STEAM		PHYSICAL	
	MANUFACTURER AND						BODY		FLOW RATE	CONNECT SIZE	
ID	MODEL NUMBER	LOCATION	N	TYPE			TRUCTION		(LB/H)	(IN)	NOTES
SS-1	SPIRAX SARCO S2	STERILE PROCE	ESSING	HORIZ BAFFLE; CA	ST IRON	STAINLESS STEEL		310		1.25	
SS-2	SPIRAX SARCO S2	STERILE PROCE	ESSING	HORIZ BAFFLE; CAST IRON		STAINLESS STEEL		310		1.25	
00.5		STERILE PROCE	ESSING								
SS-3	SPIRAX SARCO S2	A465		HORIZ BAFFLE; CA	ST IRON	STAIN	LESS STEEL	158		0.75	
SS-4	SPIRAX SARCO S2	AHU-3		HORIZ BAFFLE; CA	ST IRON	STAIN	ESS STEEL		896	2	
		I	ST	EAM TRA	P SC	HEDU	1			1	
							STEAM	OPERATING	DIFFERENTIAL	PHYSICAL	
	MANUFACTURER AND				BC	DY	FLOW RATE	PRESSURE	PRESSURE	CONNECT SIZE	
)	MODEL NUMBER	LOCATION		TYPE			(LB/H)	(PSIG)	(PSIG)	(IN)	NOTES
		PREP RECOVERY									
-1	SPIRAX SARCO FT-125	1 A434	FLOAT	& THERMOSTATIC	CAST	IRON	100	80	3.5	3/4	
-2	SPIRAX SARCO FT-125	STERILE PROCESSING A465	FLOAT	& THERMOSTATIC	CAST	IRON	310	50	3.5	3/4	
-3	SPIRAX SARCO TD42	STERILE PROCESSING A465	ТН	ERMODYNAMIC	STAINLE	SS STEEL	100	50	3.5	3/4	
-4	SPIRAX SARCO FT-125	STERILE	FLOAT	& THERMOSTATIC	CAST	IRON	169	30	3.5	3/4	
_		PROCESSING A465									
_		STERILE	_								
-5	SPIRAX SARCO FT-125	PROCESSING A465	FLOAT	& THERMOSTATIC	CAST	IRON	169	30	3.5	3/4	
-6	SPIRAX SARCO FT-125	STERILE PROCESSING A465	FLOAT	& THERMOSTATIC	CAST	IRON	169	30	3.5	3/4	
-7	SPIRAX SARCO FT-125	STERILE	FLOAT	& THERMOSTATIC	CAST	IRON	169	30	3.5	3/4	
		PROCESSING A465									
0		STERILE		0 THEDMOOTATIO			010	<b>F</b> 0	05	0/4	
-8	SPIRAX SARCO FT-125	PROCESSING A465		& THERMOSTATIC	CAST	IRON	310	50	3.5	3/4	
-9	SPIRAX SARCO TD42	STERILE PROCESSING A465	TH	ERMODYNAMIC	STAINLE	SS STEEL	100	50	3.5	3/4	
10	SPIRAX SARCO FT-125	STERILE PROCESSING A465	FLOAT	& THERMOSTATIC	CAST	IRON	158	50	3.5	3/4	
11	SPIRAX SARCO TD42	STERILE		ERMODYNAMIC	STAINLE		100	50	3.5	3/4	
11	SFINAN SARUU 1042	PROCESSING A465			STAINLE	50 01 EEL		00	3.3	3/4	
12	SPIRAX SARCO FT-125	AHU-3	FLOAT	& THERMOSTATIC	CAST	IRON	896	15	3.5	1-1/4	
13	SPIRAX SARCO FT-125	AHU-3	FLOAT	& THERMOSTATIC	CAST	IRON	100	15	3.5	3/4	
		DECONTAMINATIO									
14	SPIRAX SARCO FT-125	N A464	FLOAT	& THERMOSTATIC	CAST	IRON	100	80	3.5	3/4	


					STEAM		PHYSICAL	
						INLET/		
	MANUFACTURER				FLOW	OUTLET	CONNECT	
	AND			BODY	RATE	PRESSURE	SIZE	
ID	MODEL NUMBER	LOCATION	TYPE	CONSTRUCTION	(LB/H)	(PSIG)	(IN)	NOTES
RV-1	SPIRAX SARCO 25P 1.25"	STERILE PROCESSING A465	PILOT-OPERATED	BRONZE	310	80/50	1.25	
RV-2	SPIRAX SARCO 25P 1.25"	STERILE PROCESSING A465	PILOT-OPERATED	BRONZE	169	80/30	1.25	
RV-3	SPIRAX SARCO 25P 1.25"	STERILE PROCESSING A465	PILOT-OPERATED	BRONZE	169	80/30	1.25	
RV-4	SPIRAX SARCO 25P 1.25"	STERILE PROCESSING A465	PILOT-OPERATED	BRONZE	310	80/50	1.25	
RV-5	SPIRAX SARCO 25P 1"	STERILE PROCESSING A465	PILOT-OPERATED	BRONZE	158	80/50	1	
RV-6	SPIRAX SARCO 25P 1.5"	AHU-3	PILOT-OPERATED	BRONZE	546.6	80/15	1.5	
RV-7	SPIRAX SARCO 25P 1.5"	AHU-3	PILOT-OPERATED	BRONZE	546.6	80/15	1.5	
RV-8	SPIRAX SARCO 25P 2"	AHU-3	PILOT-OPERATED	BRONZE	896	80/15	2	

\_\_\_\_′

Y Y	Y Y	Y Y Y	Ŷ	Ŷ Ŷ	Y Y	Y Y	Y Y							
	STEAM FILTER SCHEDULE													
					STEAM	PHYSICAL								
ACTURER					FLOW	CONNECT	_							
ND			BODY		RATE	SIZE								
NUMBER	LOCATION	CO	NSTRUCTION		(LB/H)	(IN)	NOTES							
RCO FS-1-1/2	STERILE PROCESSING A465	STA	INLESS STEEL		310	1.25								
RCO FS-1-1/2	STERILE PROCESSING A465	STA	INLESS STEEL		310	1.25								
ARCO FS-1	STERILE PROCESSING A465	STA	INLESS STEEL		158	1								

	STEAM SEPARATOR SCHEDULE												
				STEAM	PHYSICAL								
JRER				FLOW	CONNECT								
			BODY	RATE	SIZE								
<b>/</b> BER	LOCATION	TYPE	CONSTRUCTION	(LB/H)	(IN)								
CO S2	STERILE PROCESSING A465	HORIZ BAFFLE; CAST IRON	STAINLESS STEEL	310	1.25								
CO S2	STERILE PROCESSING A465	HORIZ BAFFLE; CAST IRON	STAINLESS STEEL	310	1.25								
CO S2	STERILE PROCESSING A465	HORIZ BAFFLE; CAST IRON	STAINLESS STEEL	158	0.75								
					_								

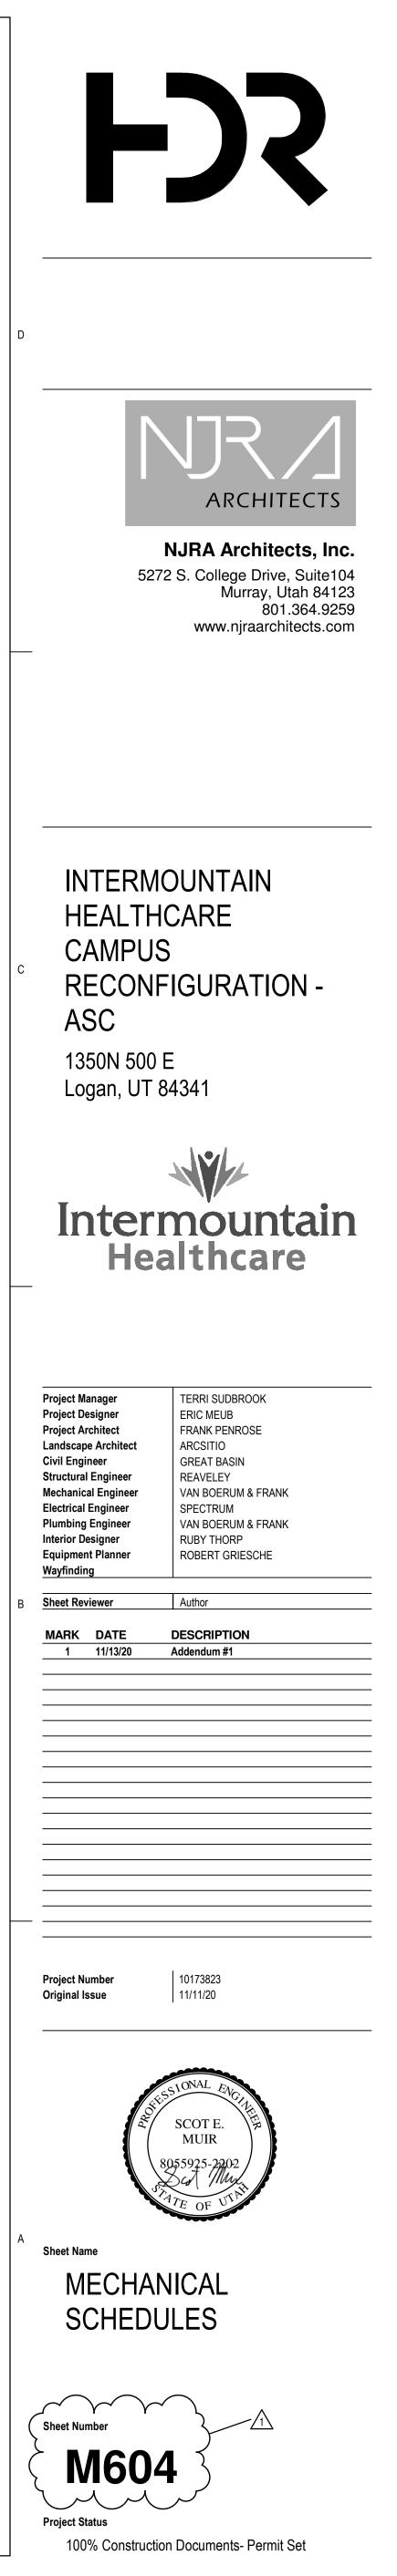


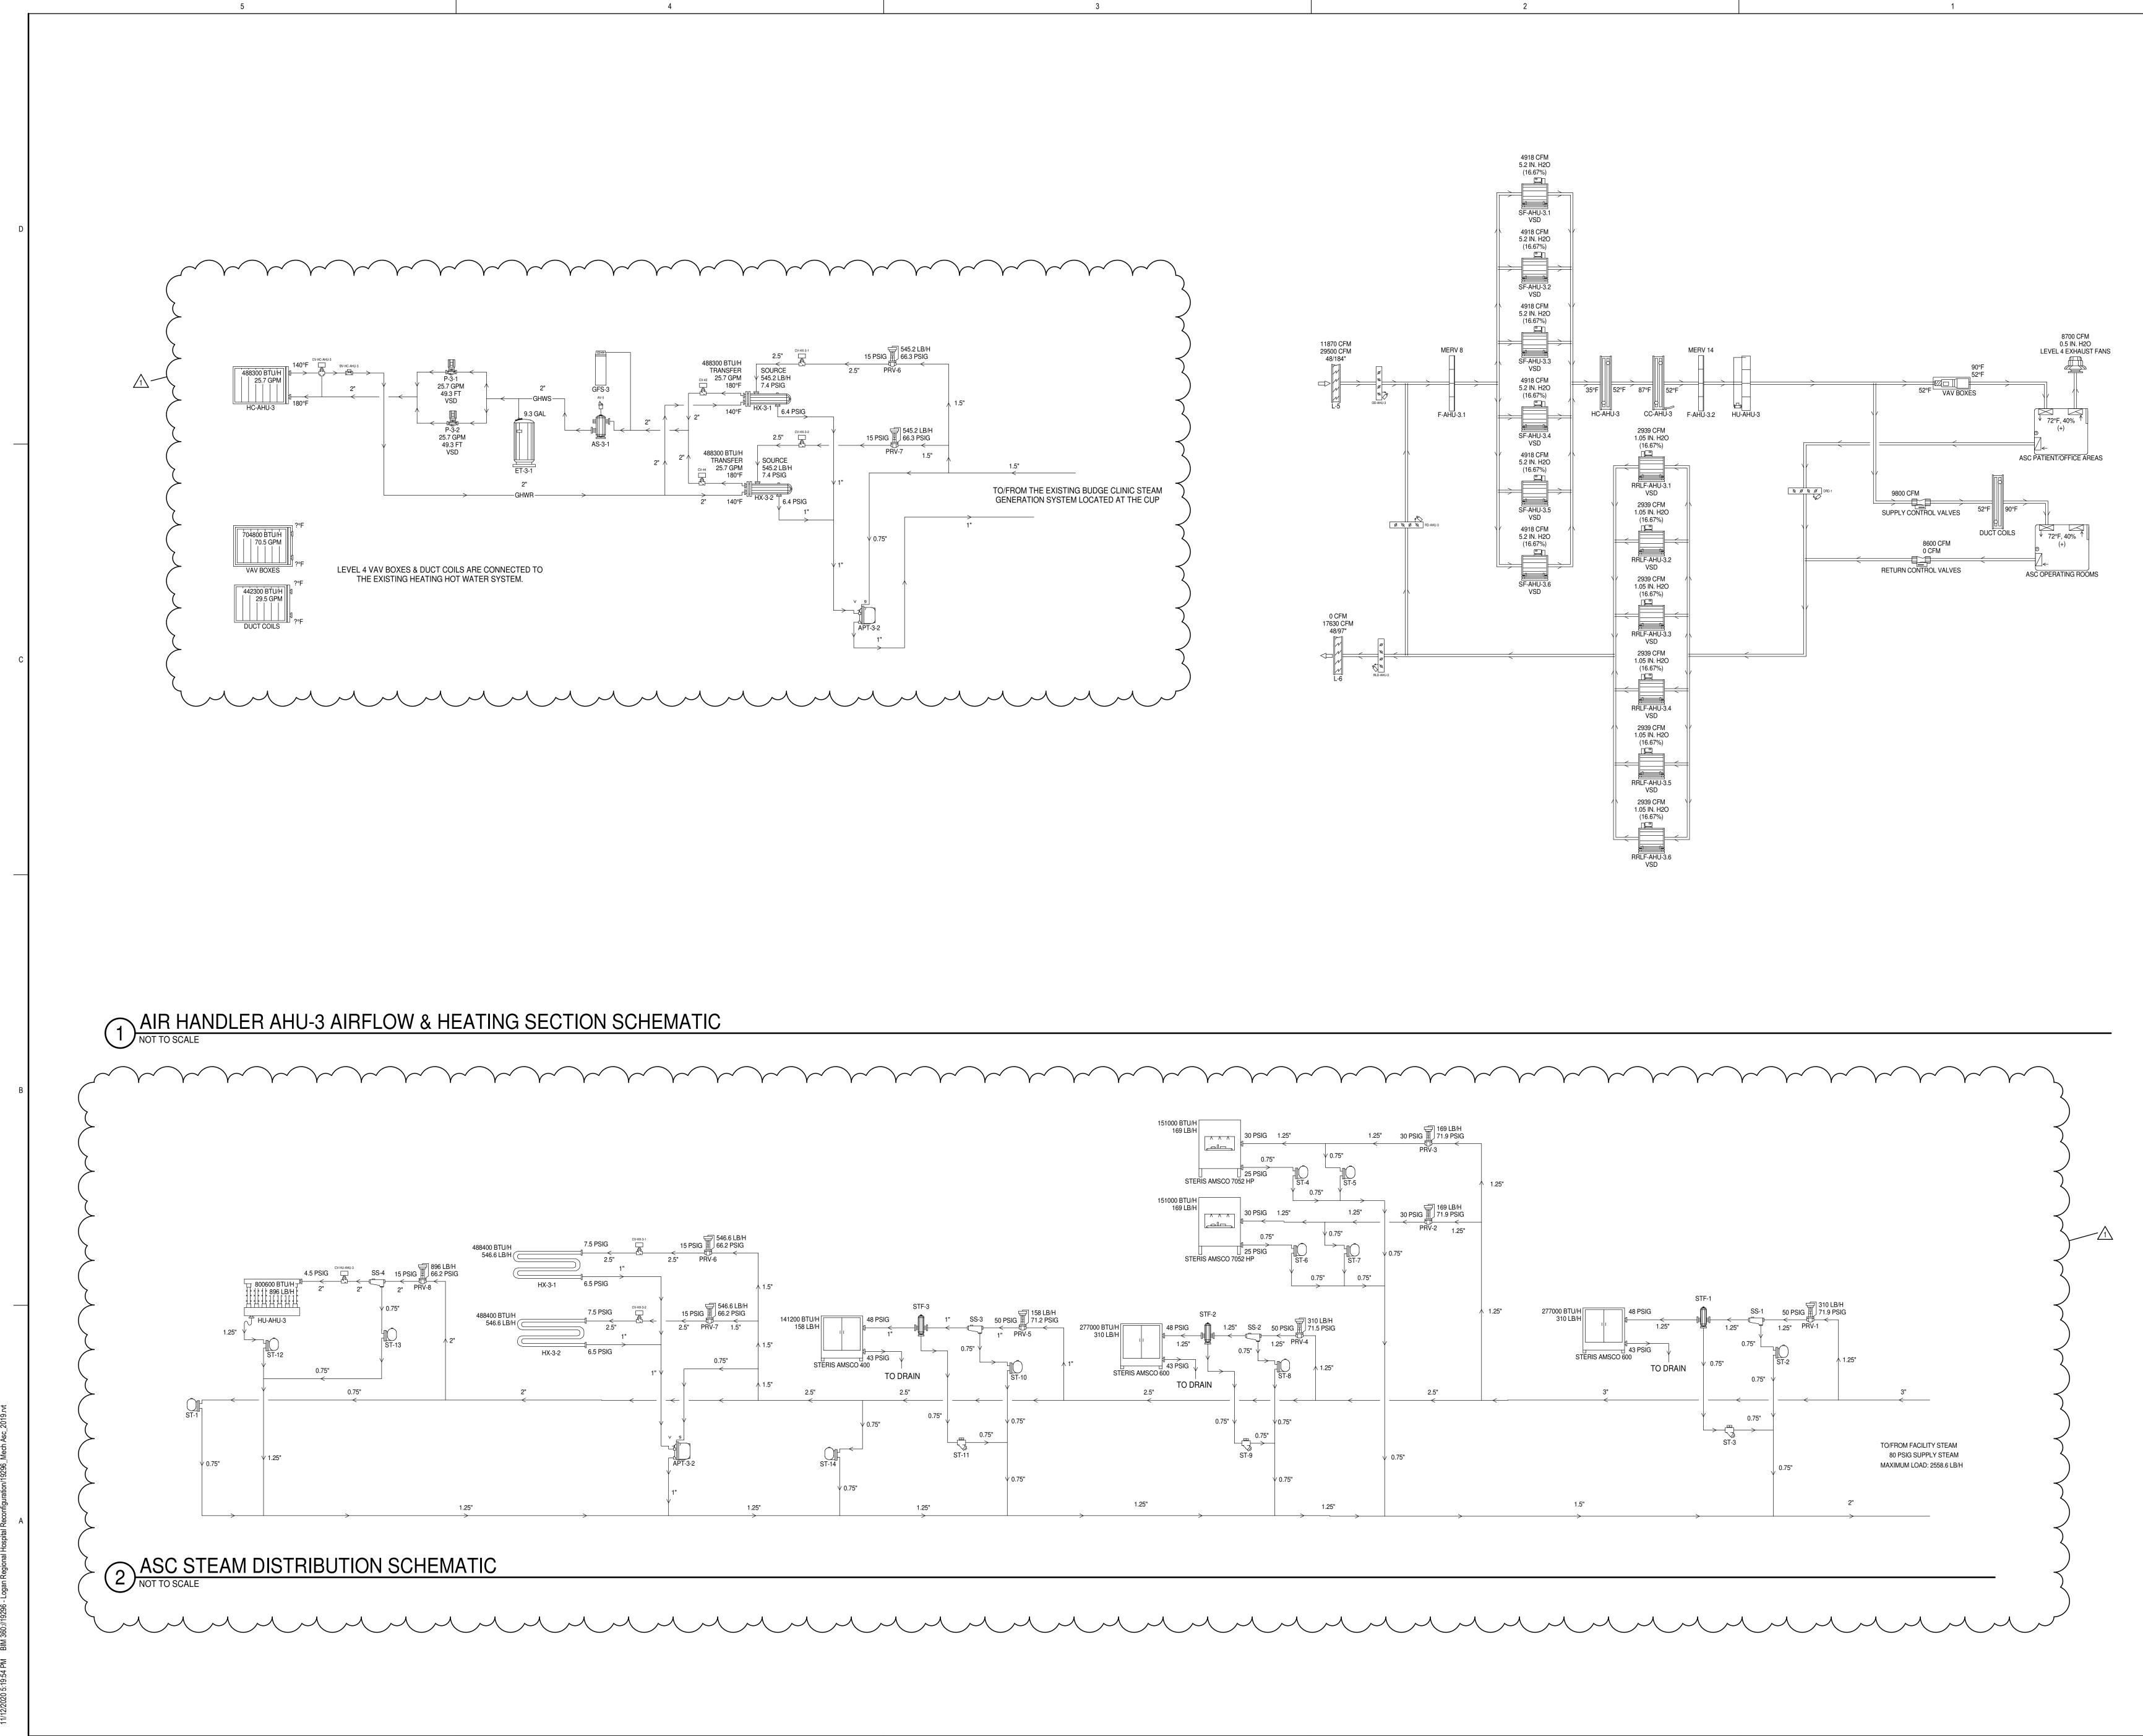





100% Construction Documents- Permit Set


	1	
	D	
	C	
	В	
9:55 PM BIM 360://19296 - Logan Regional Hospital Reconfiguration/19296_Mech Asc_2019.rvt	A	

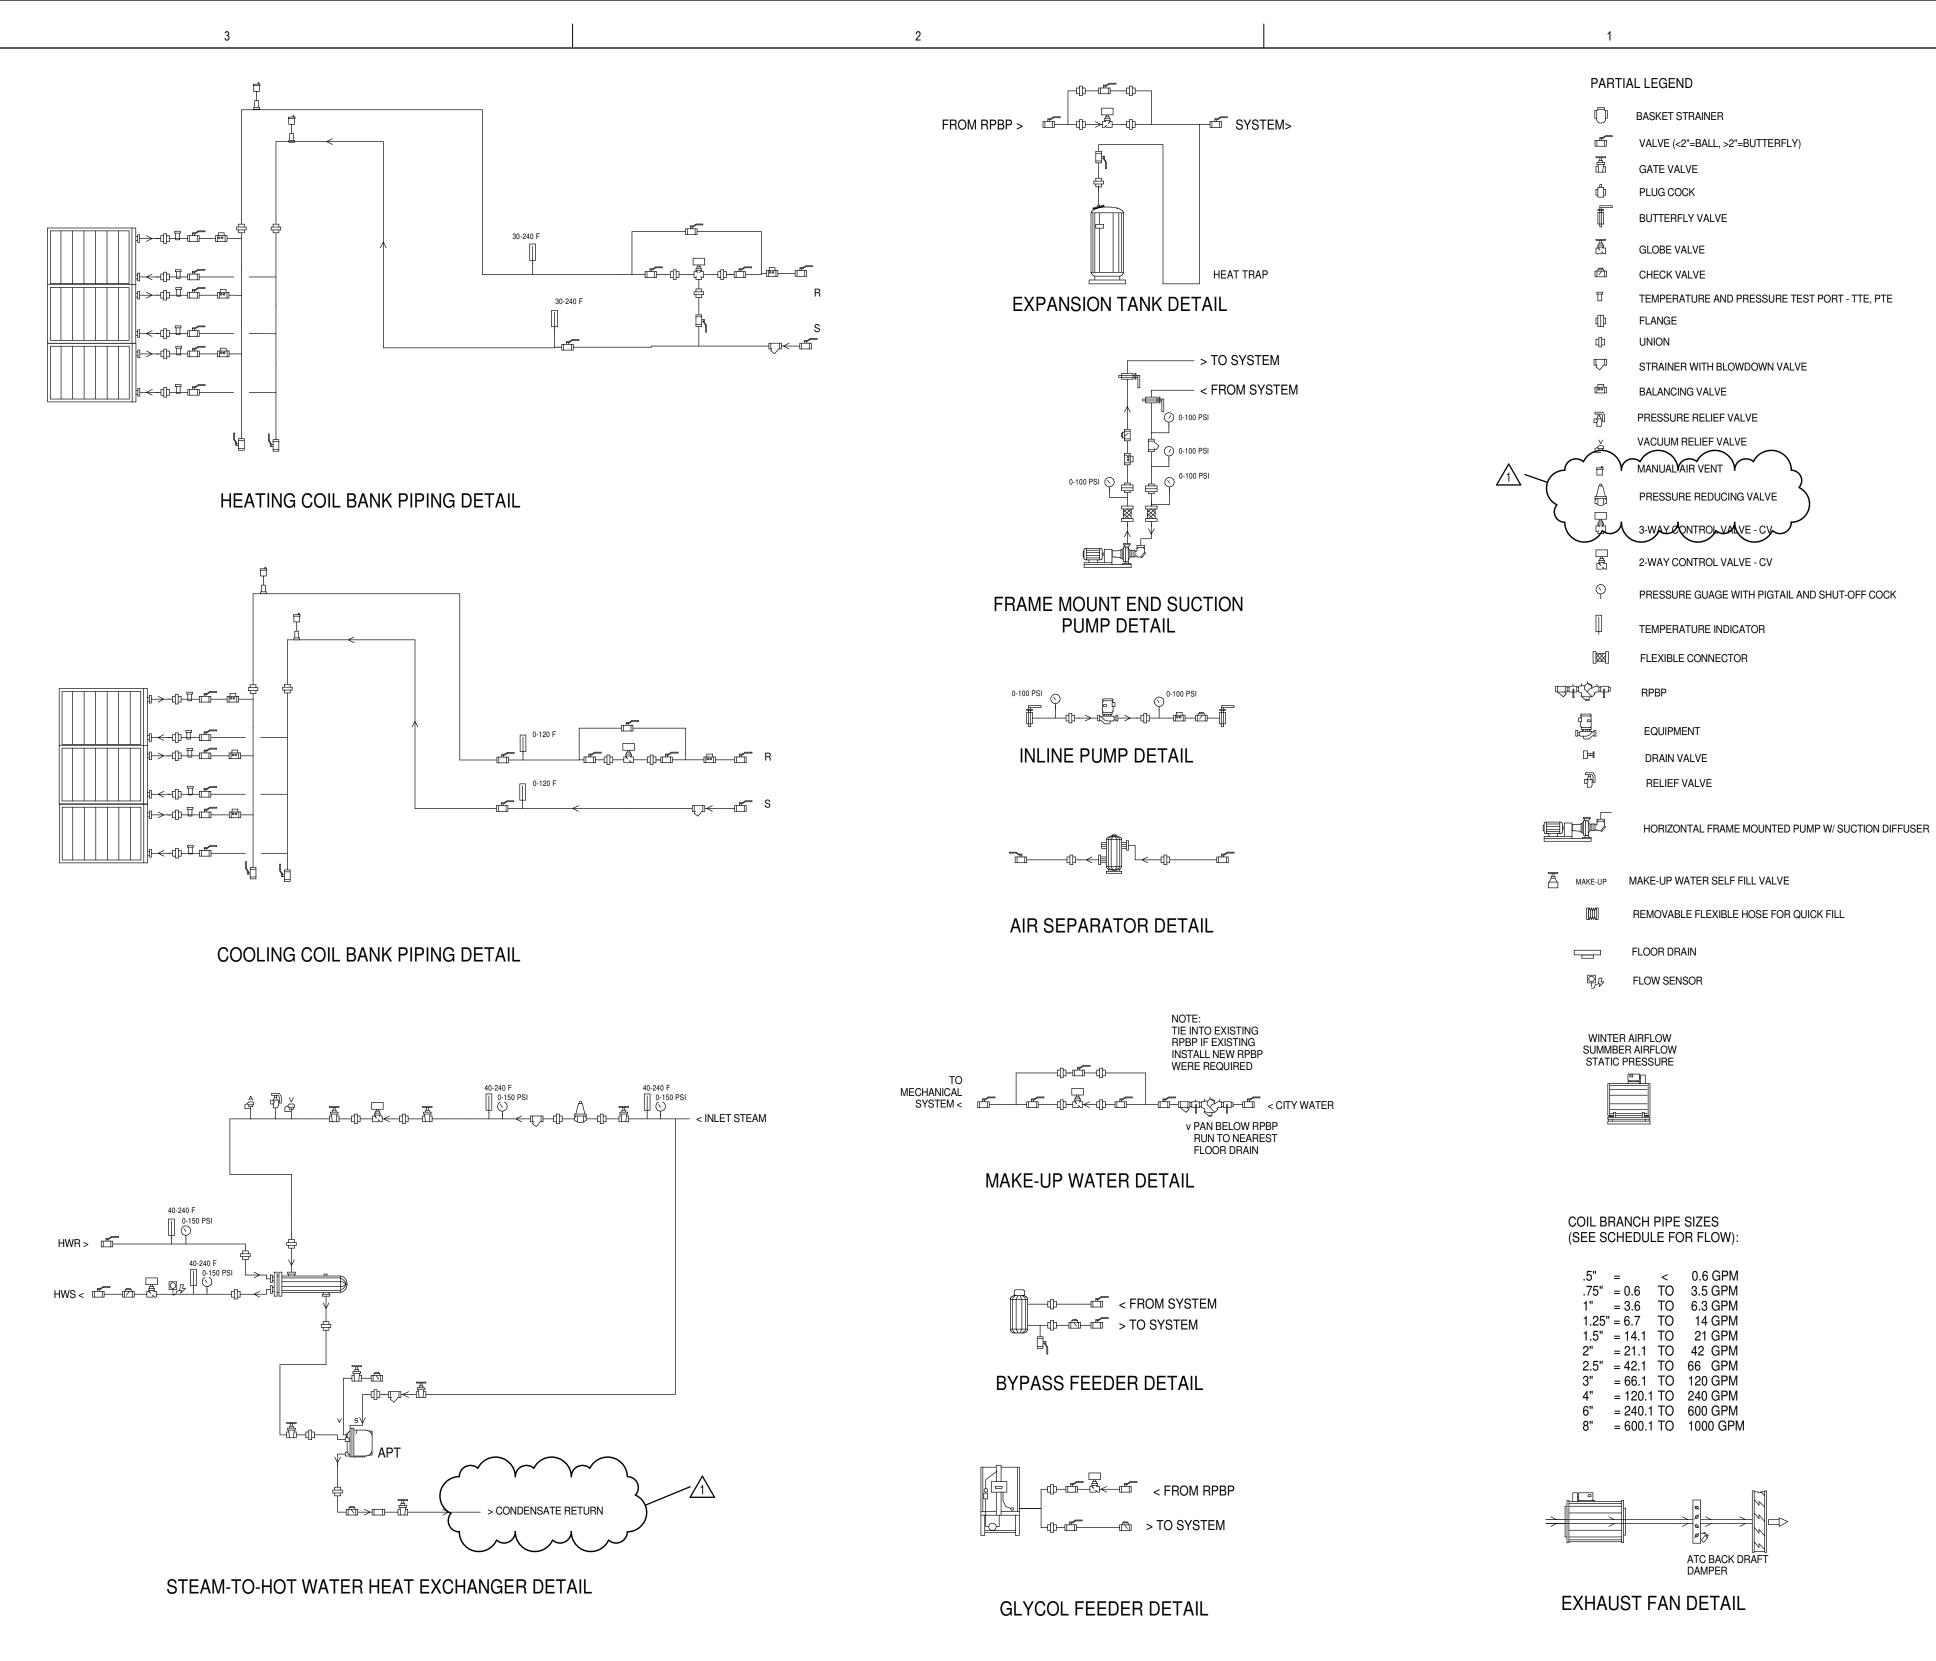


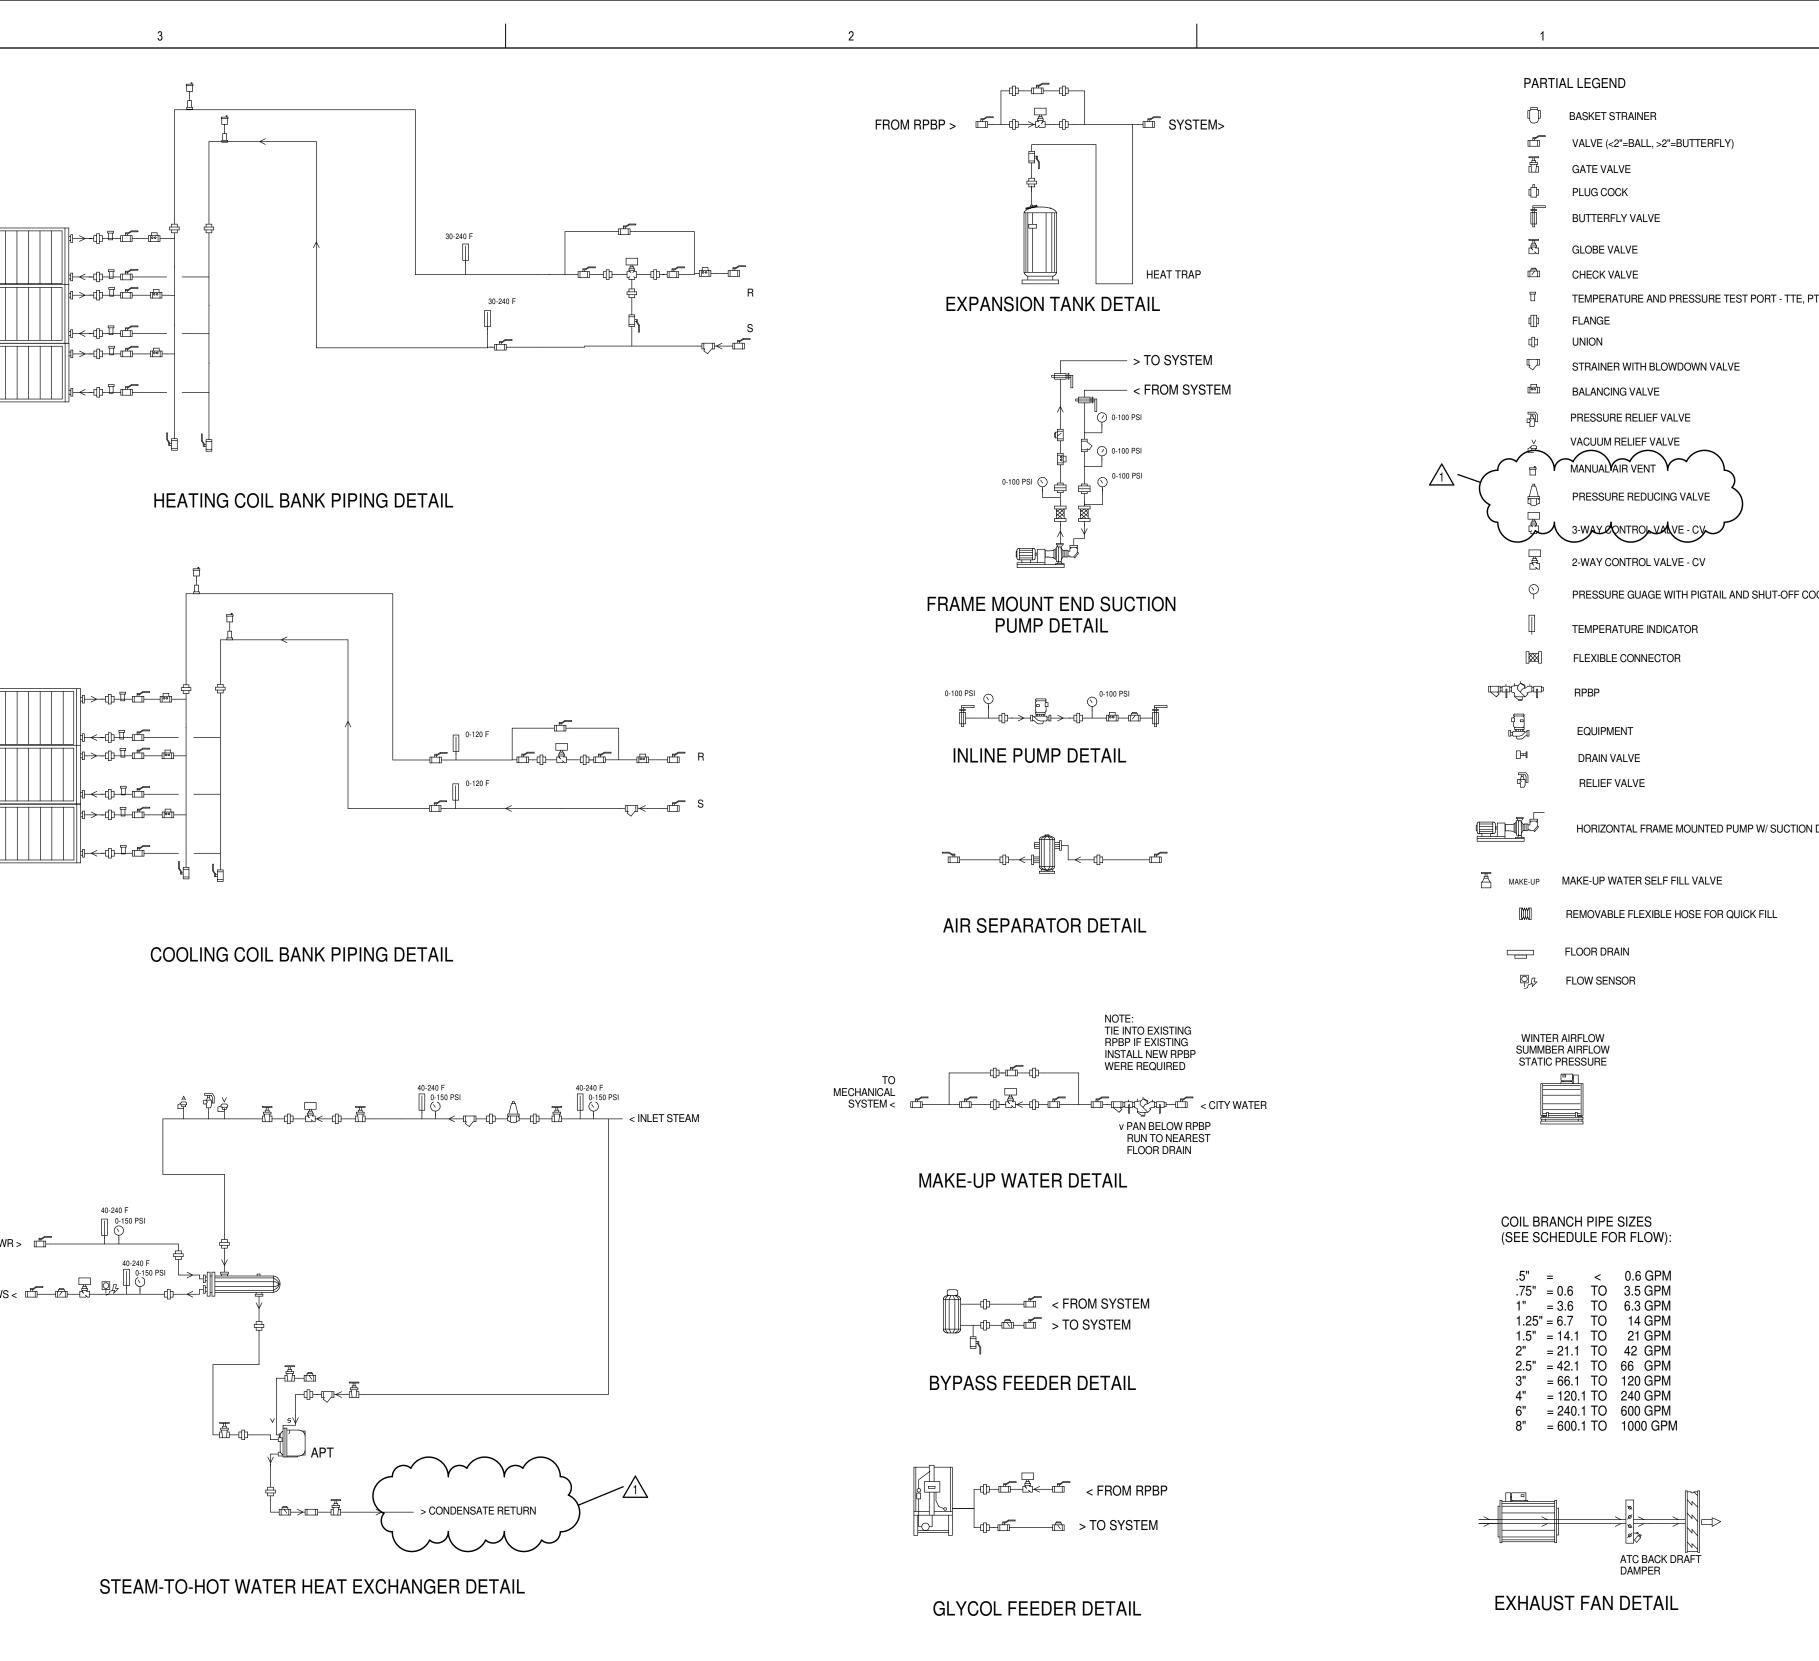





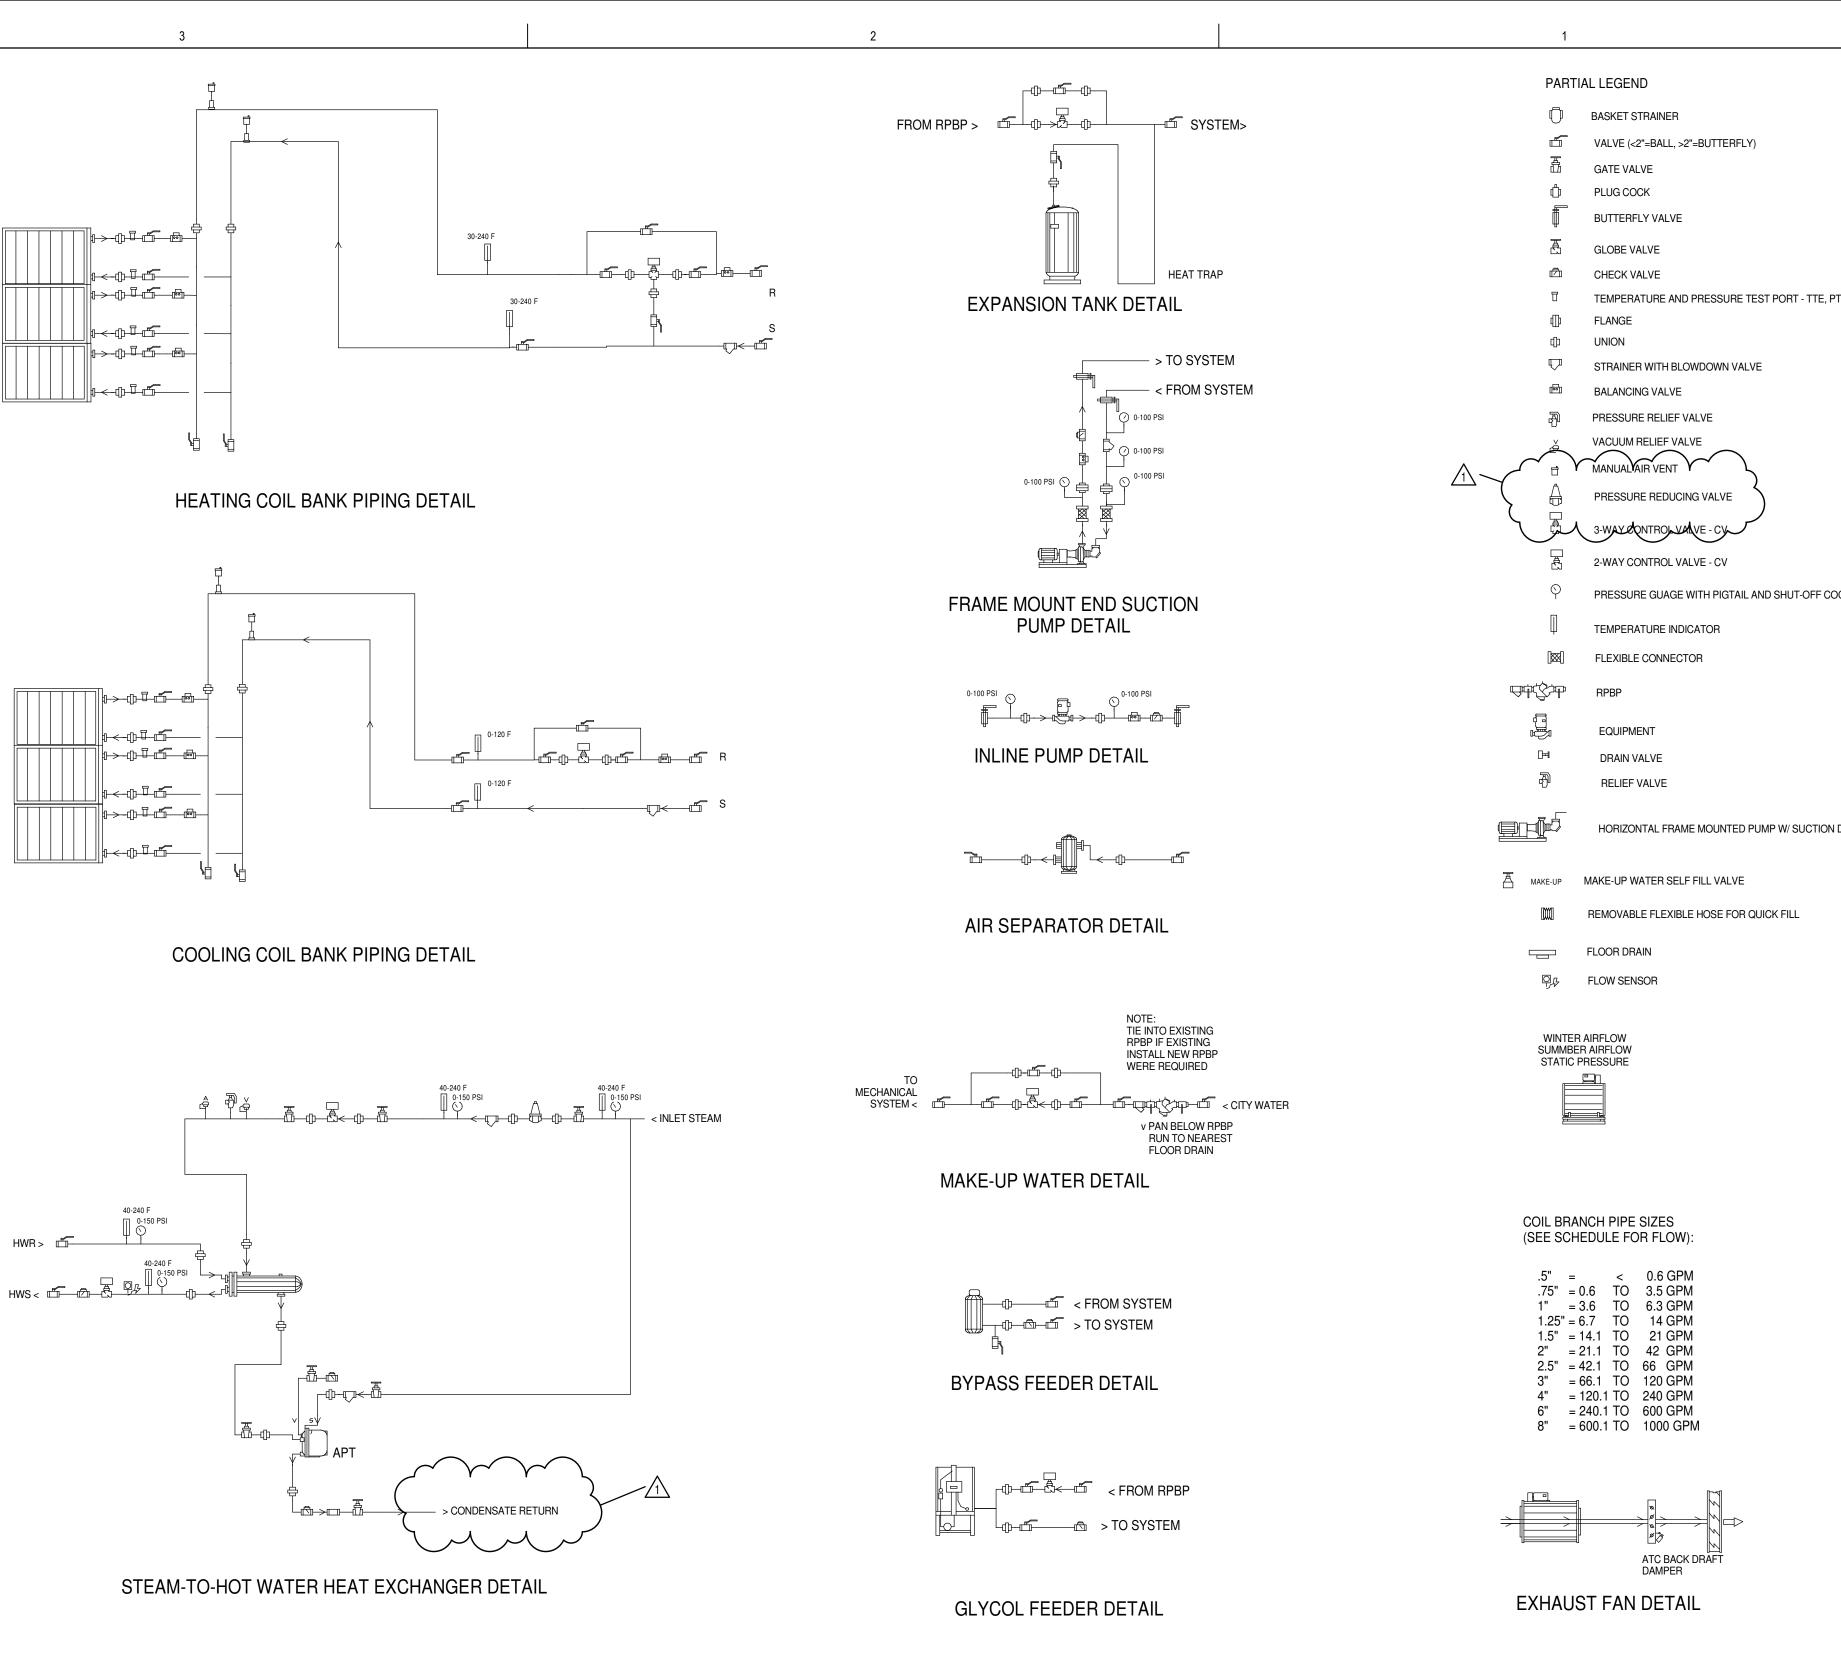


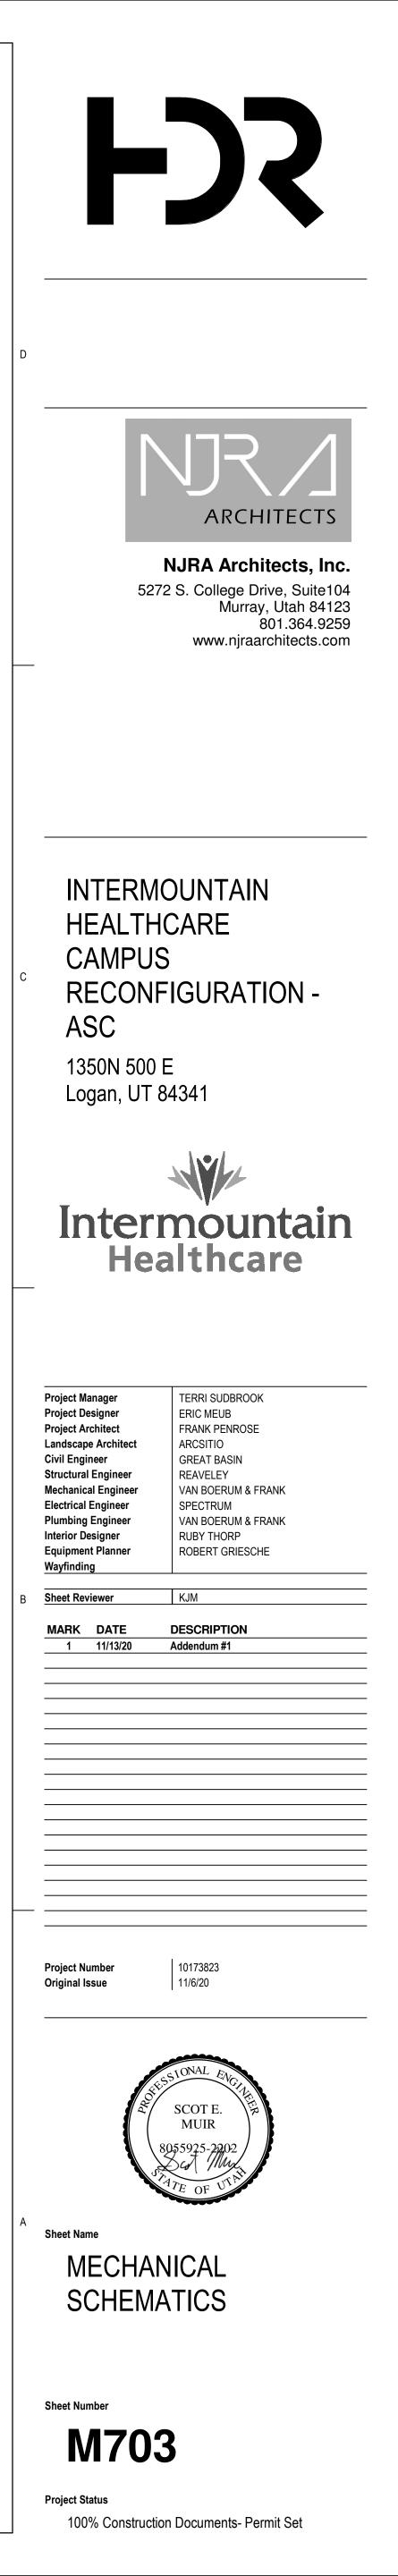

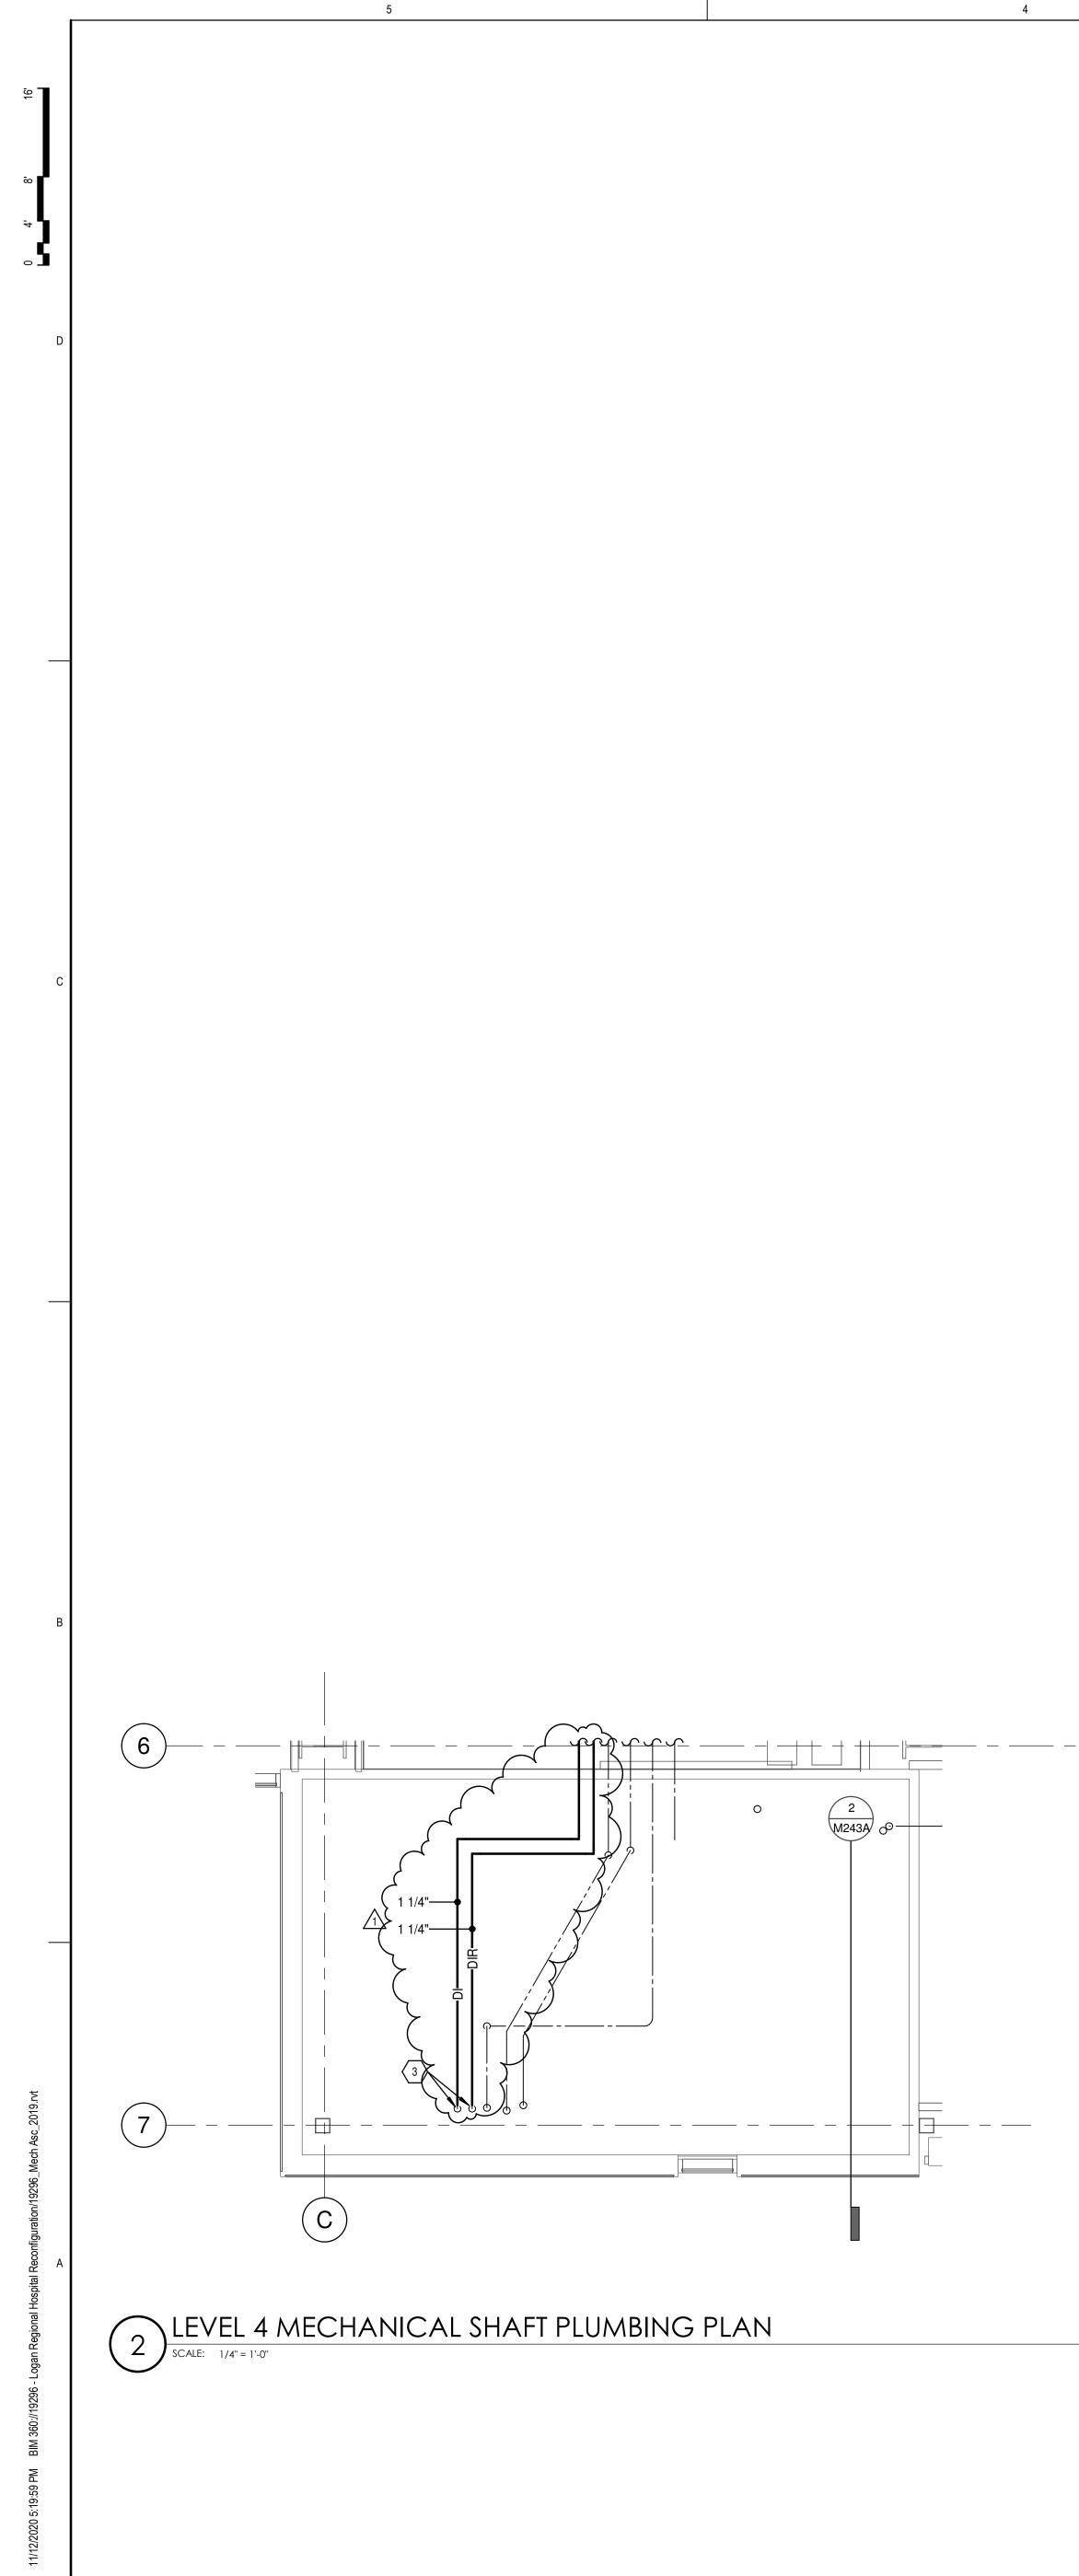


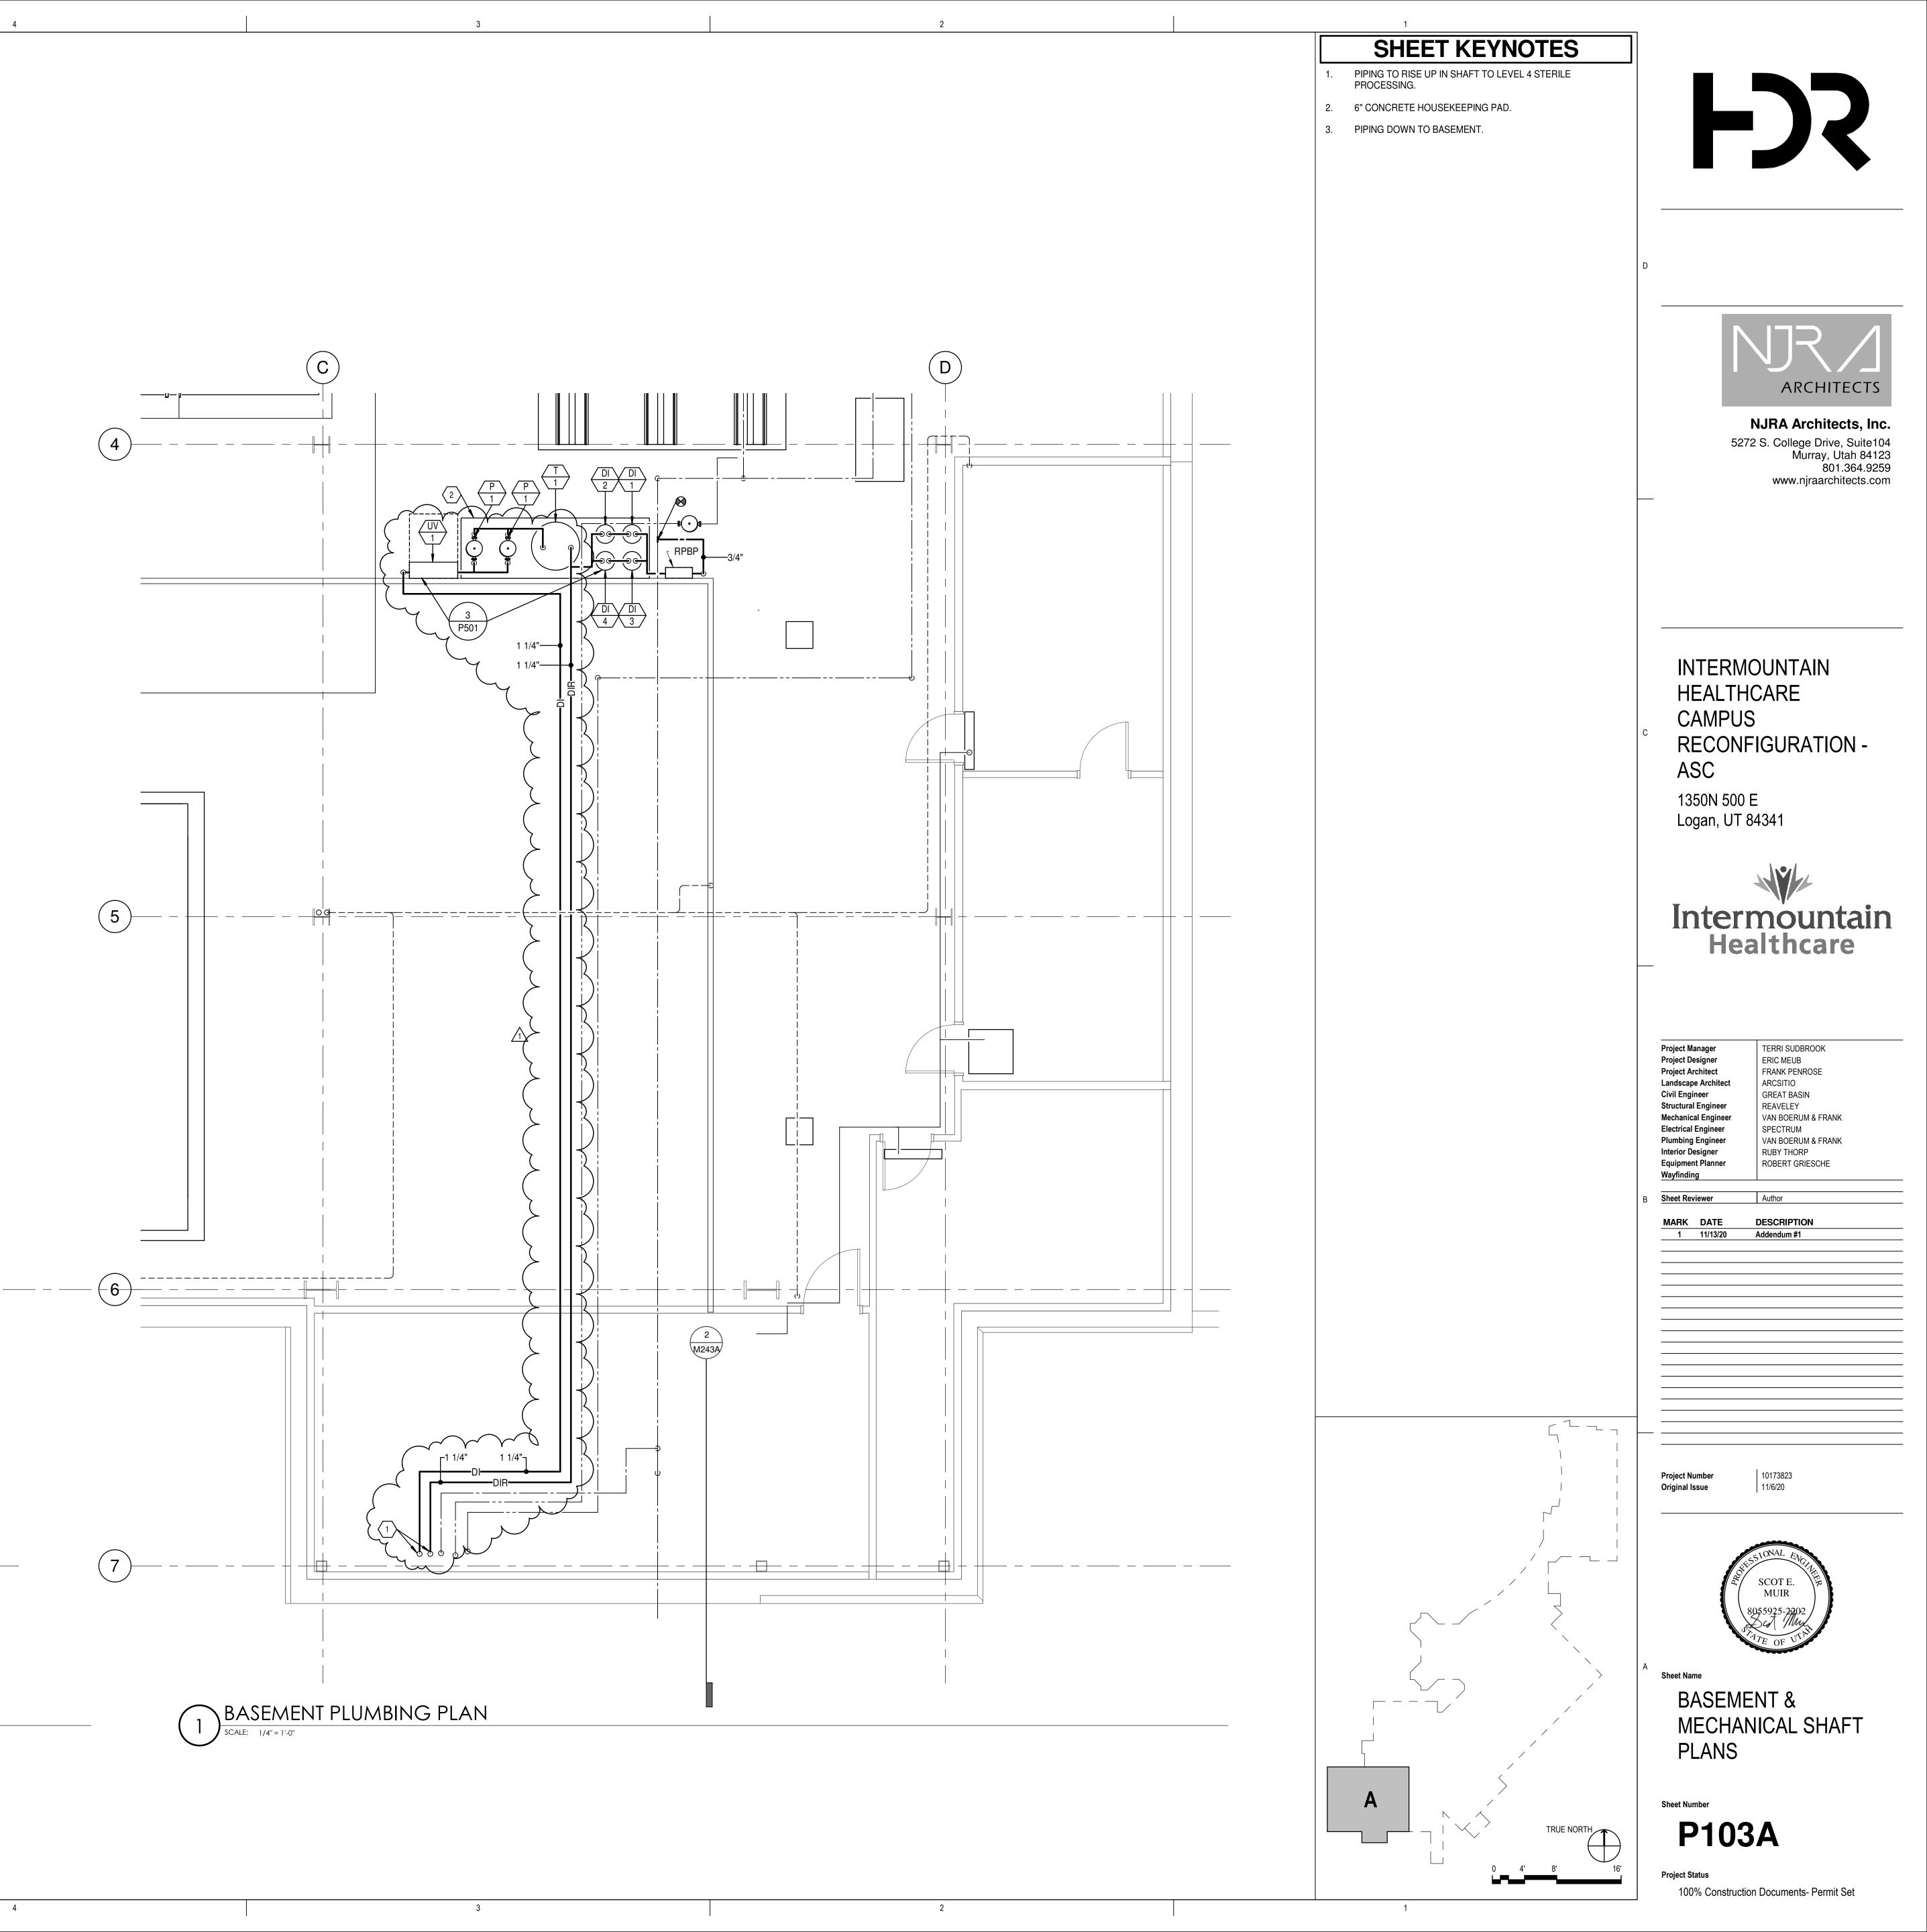


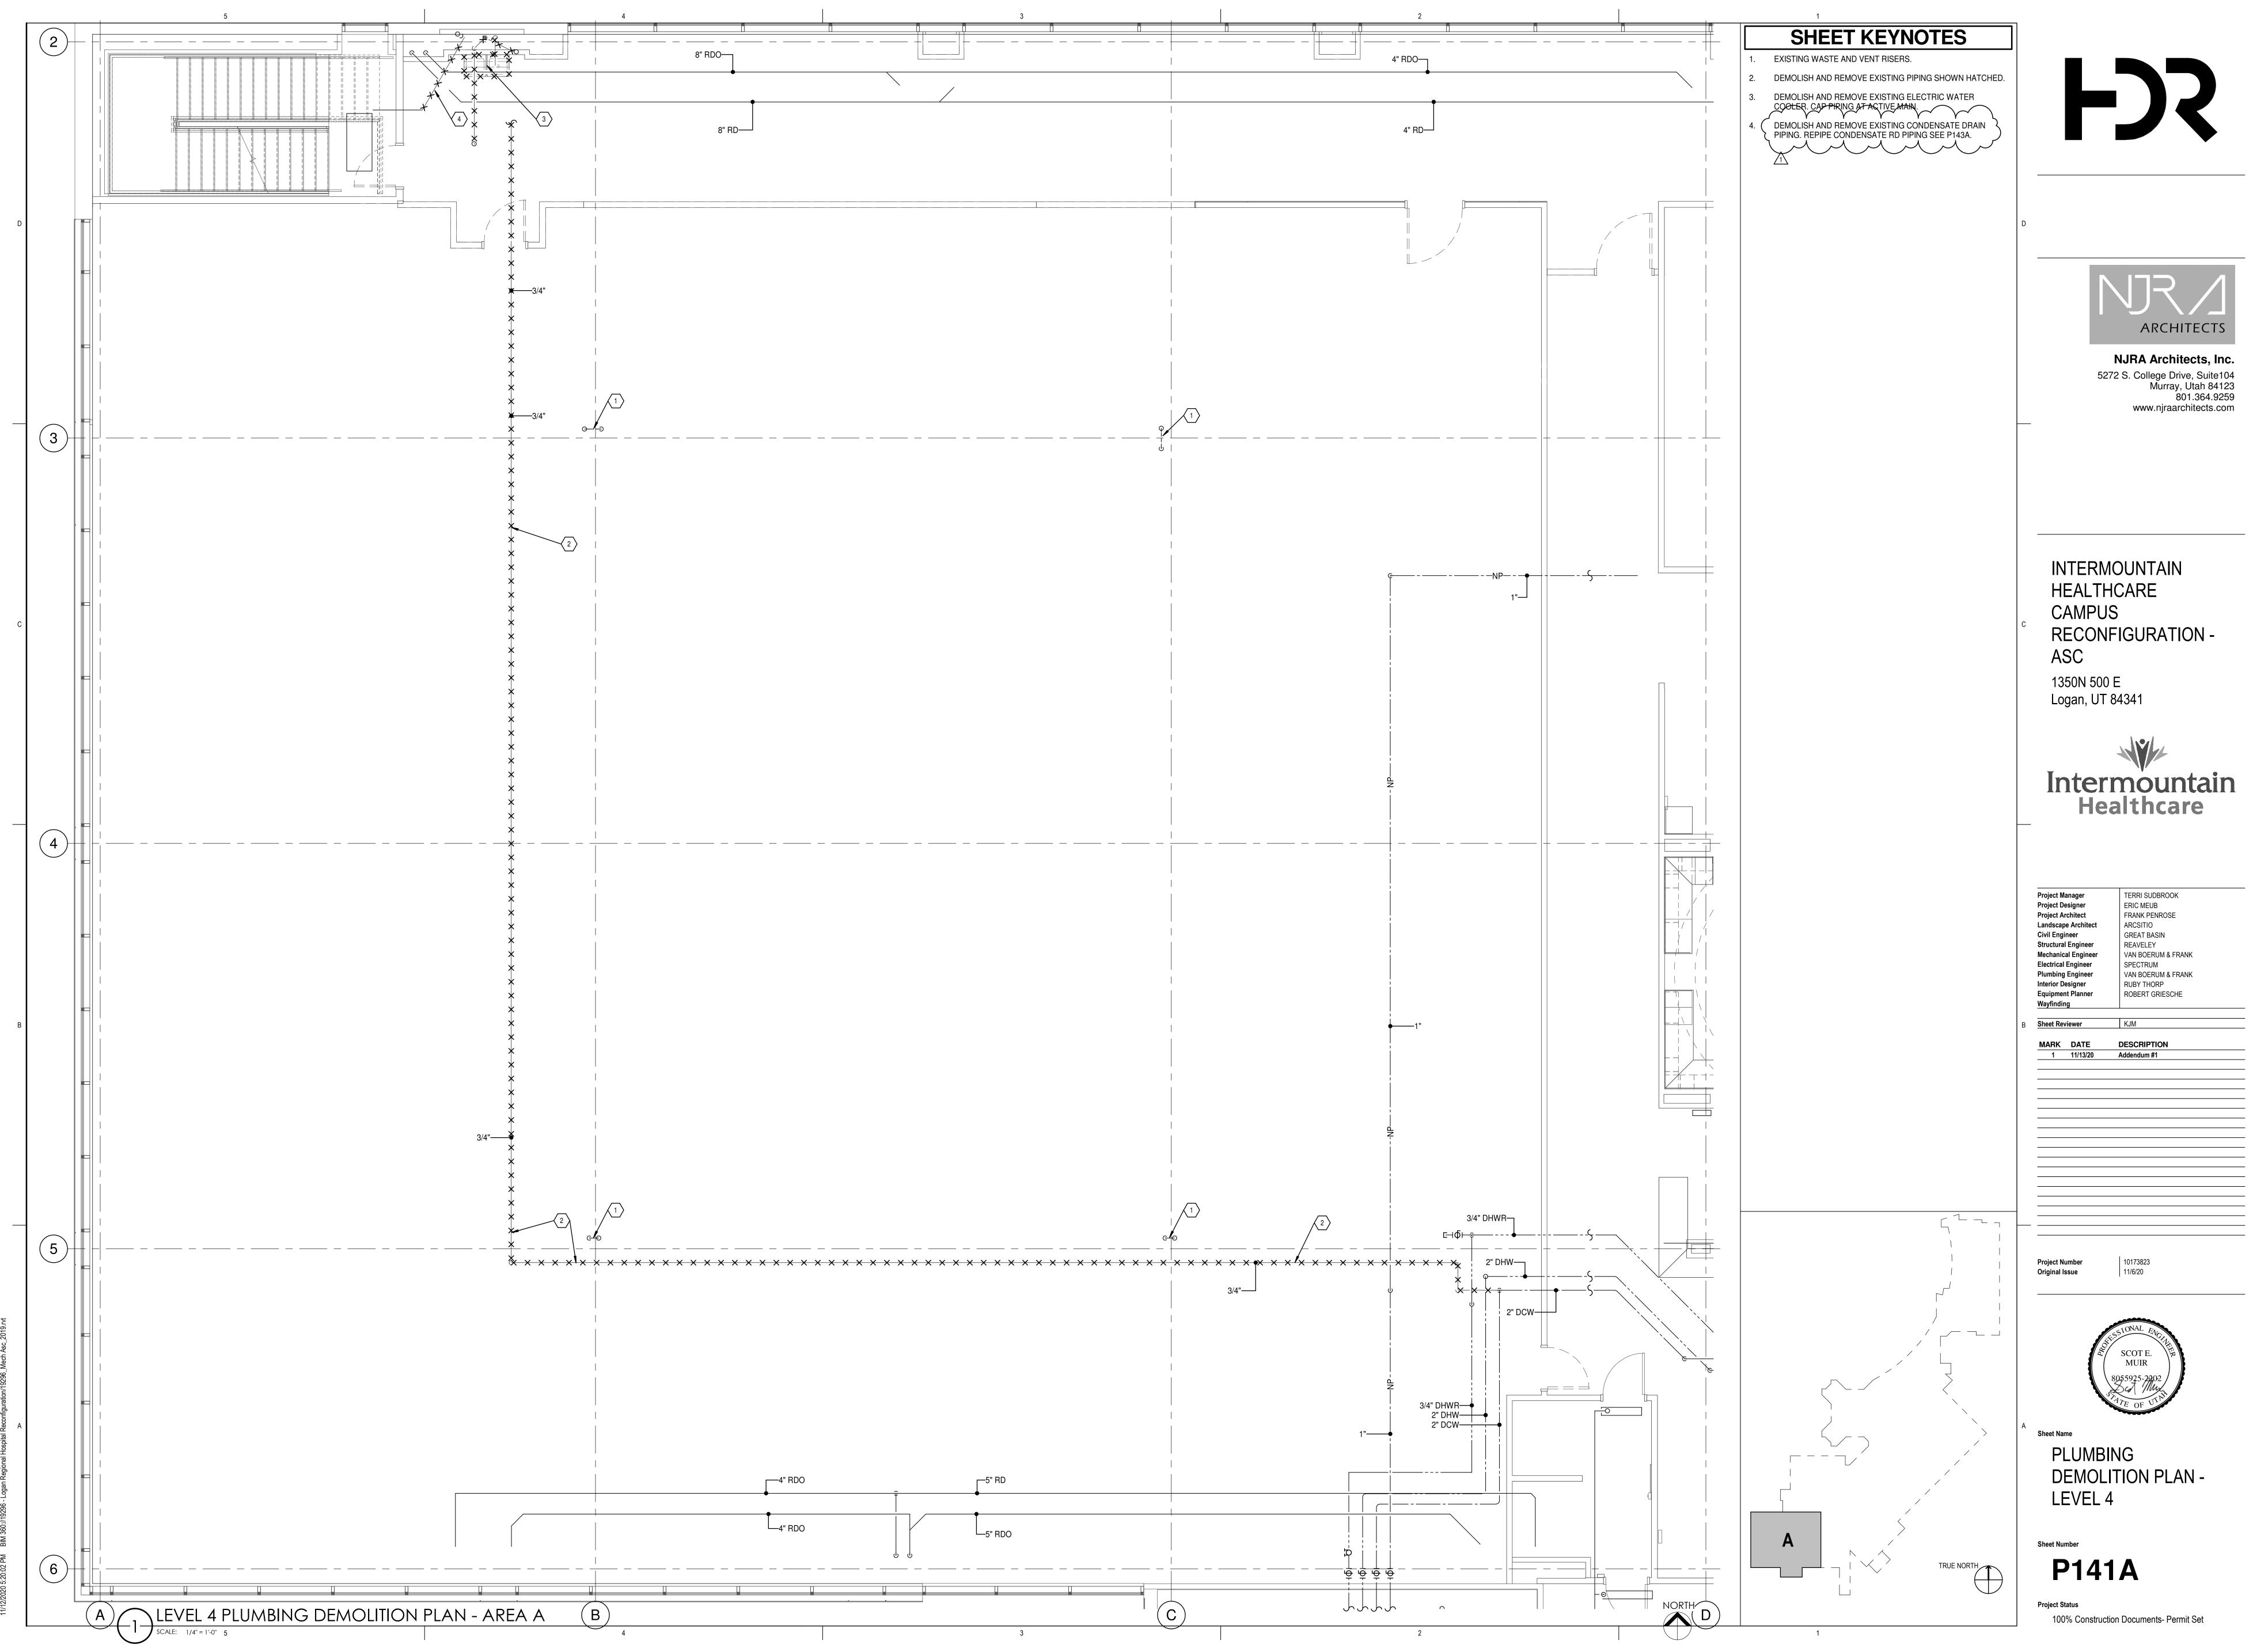


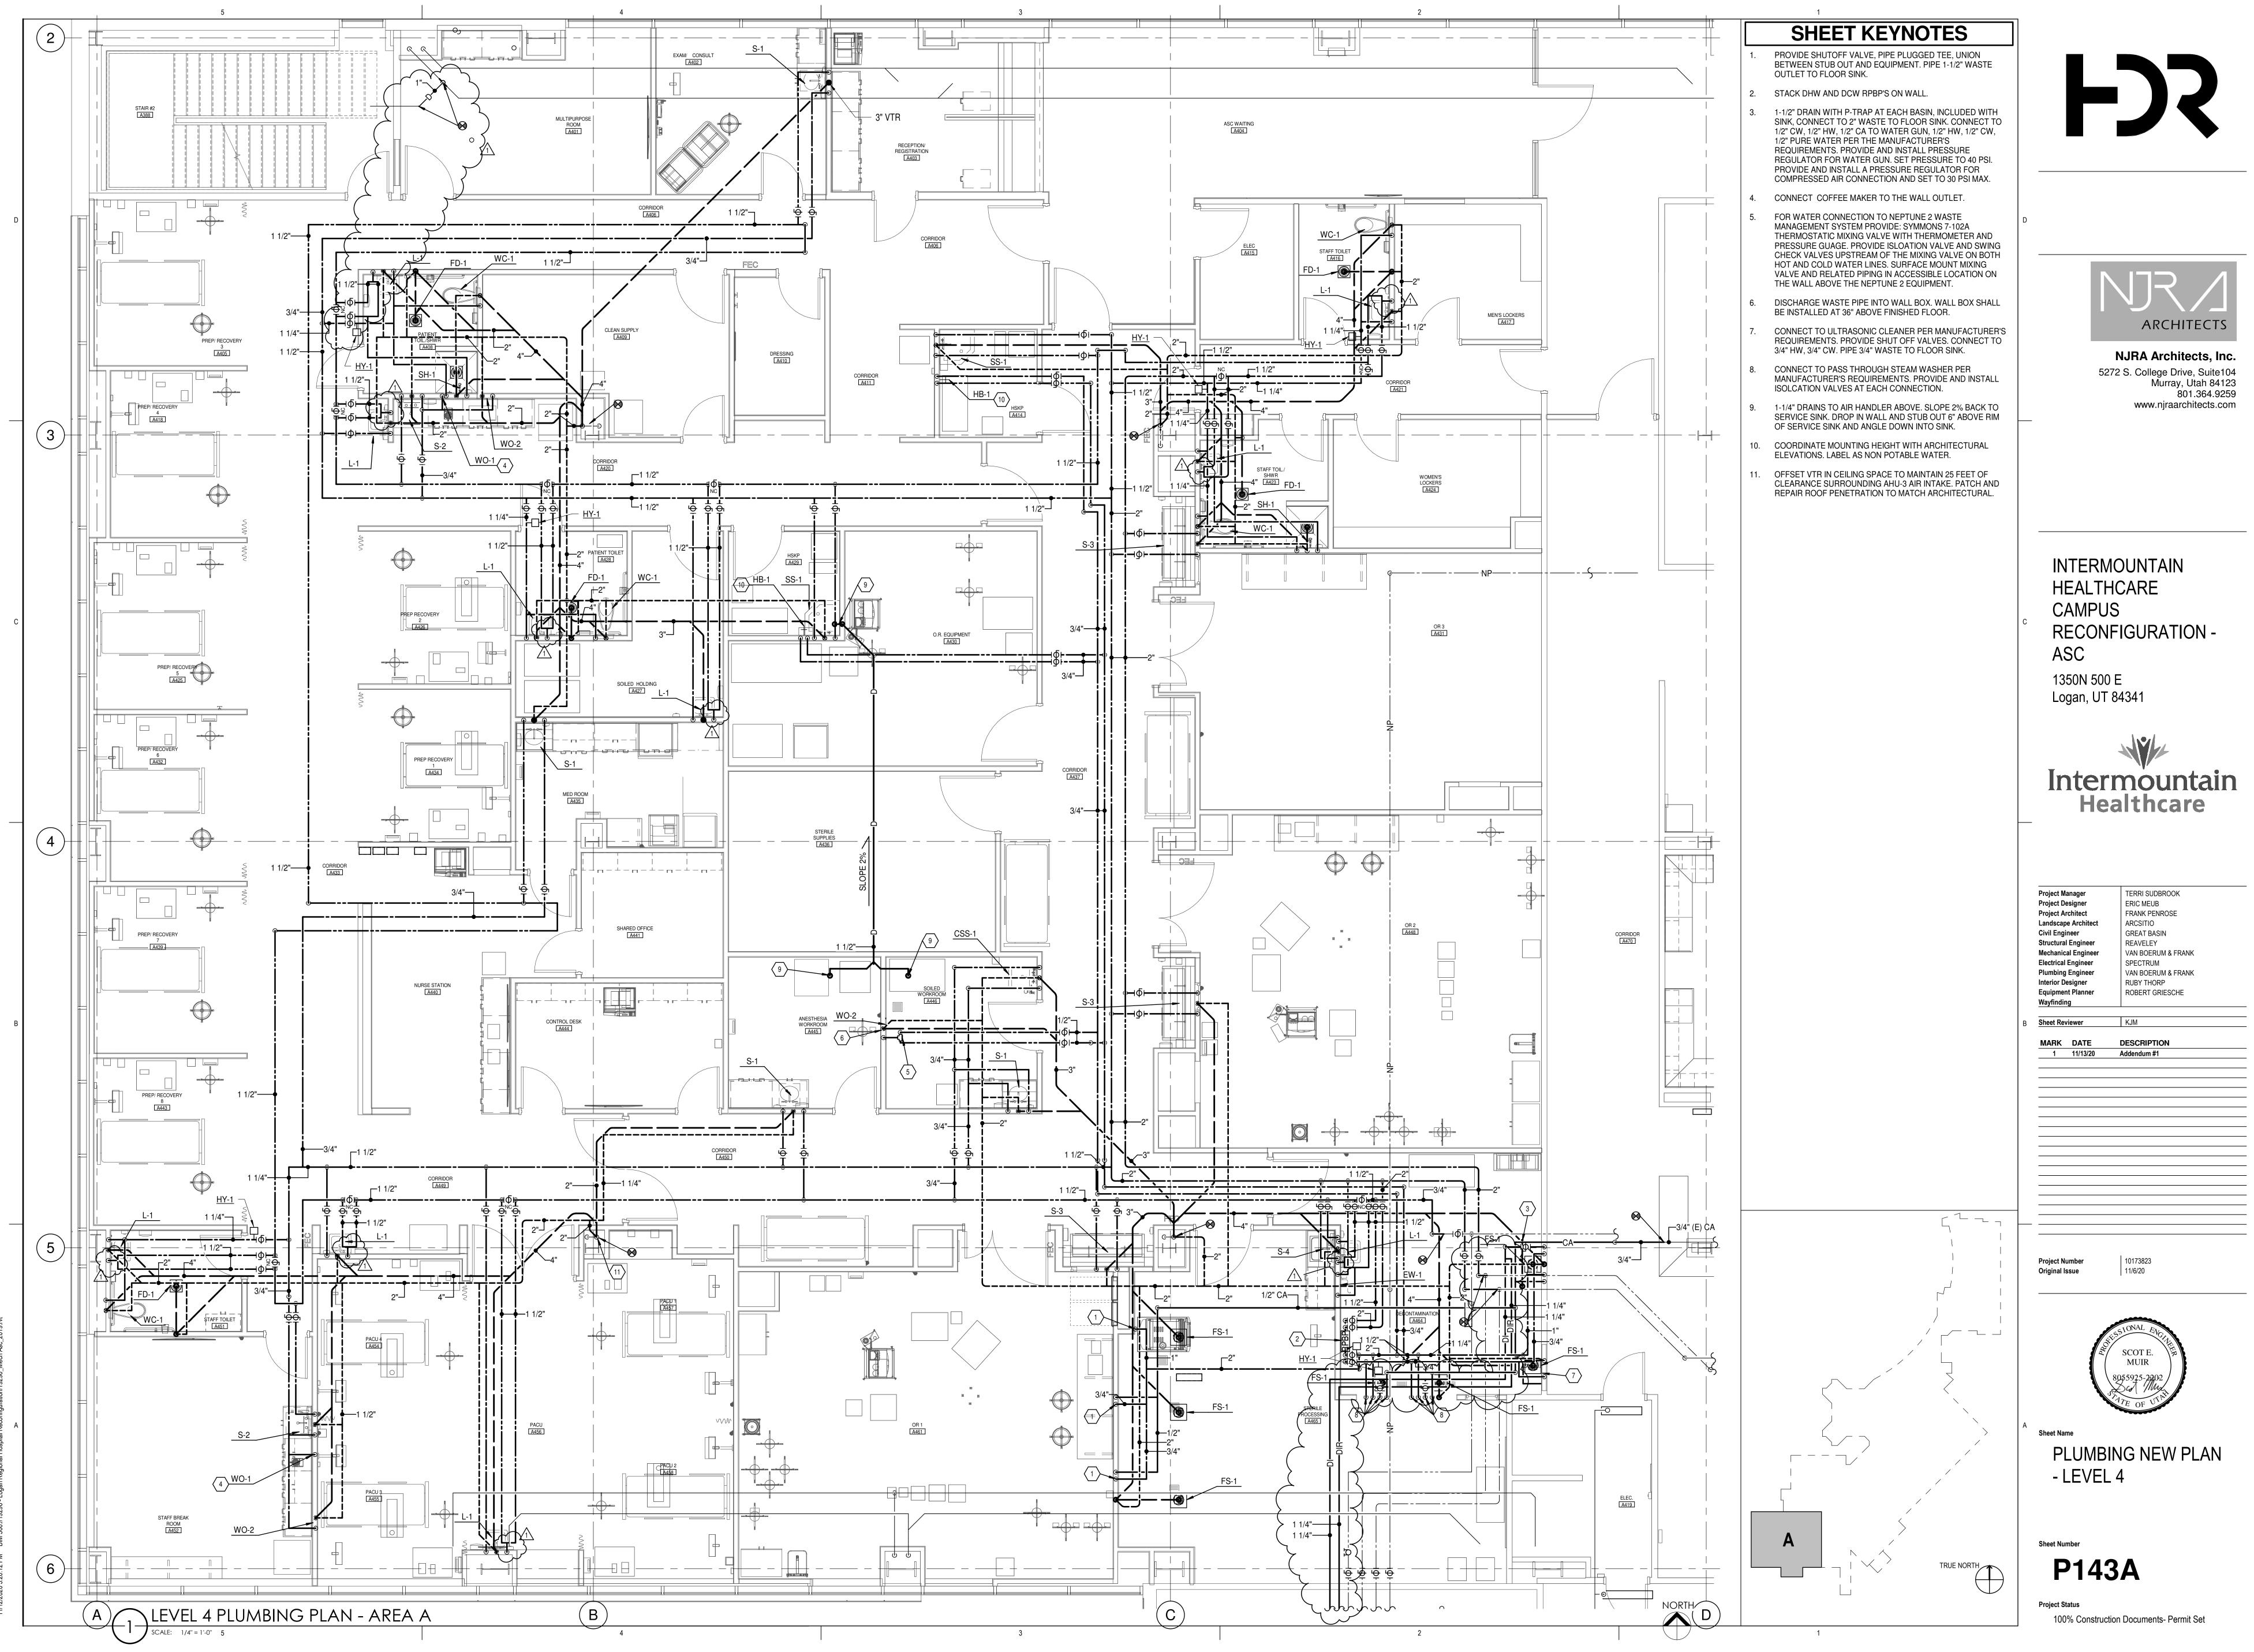



020 5:20:12 PM BIM 360://19296 - Logan Regional Hospital Reconfiguration/19296\_Mect

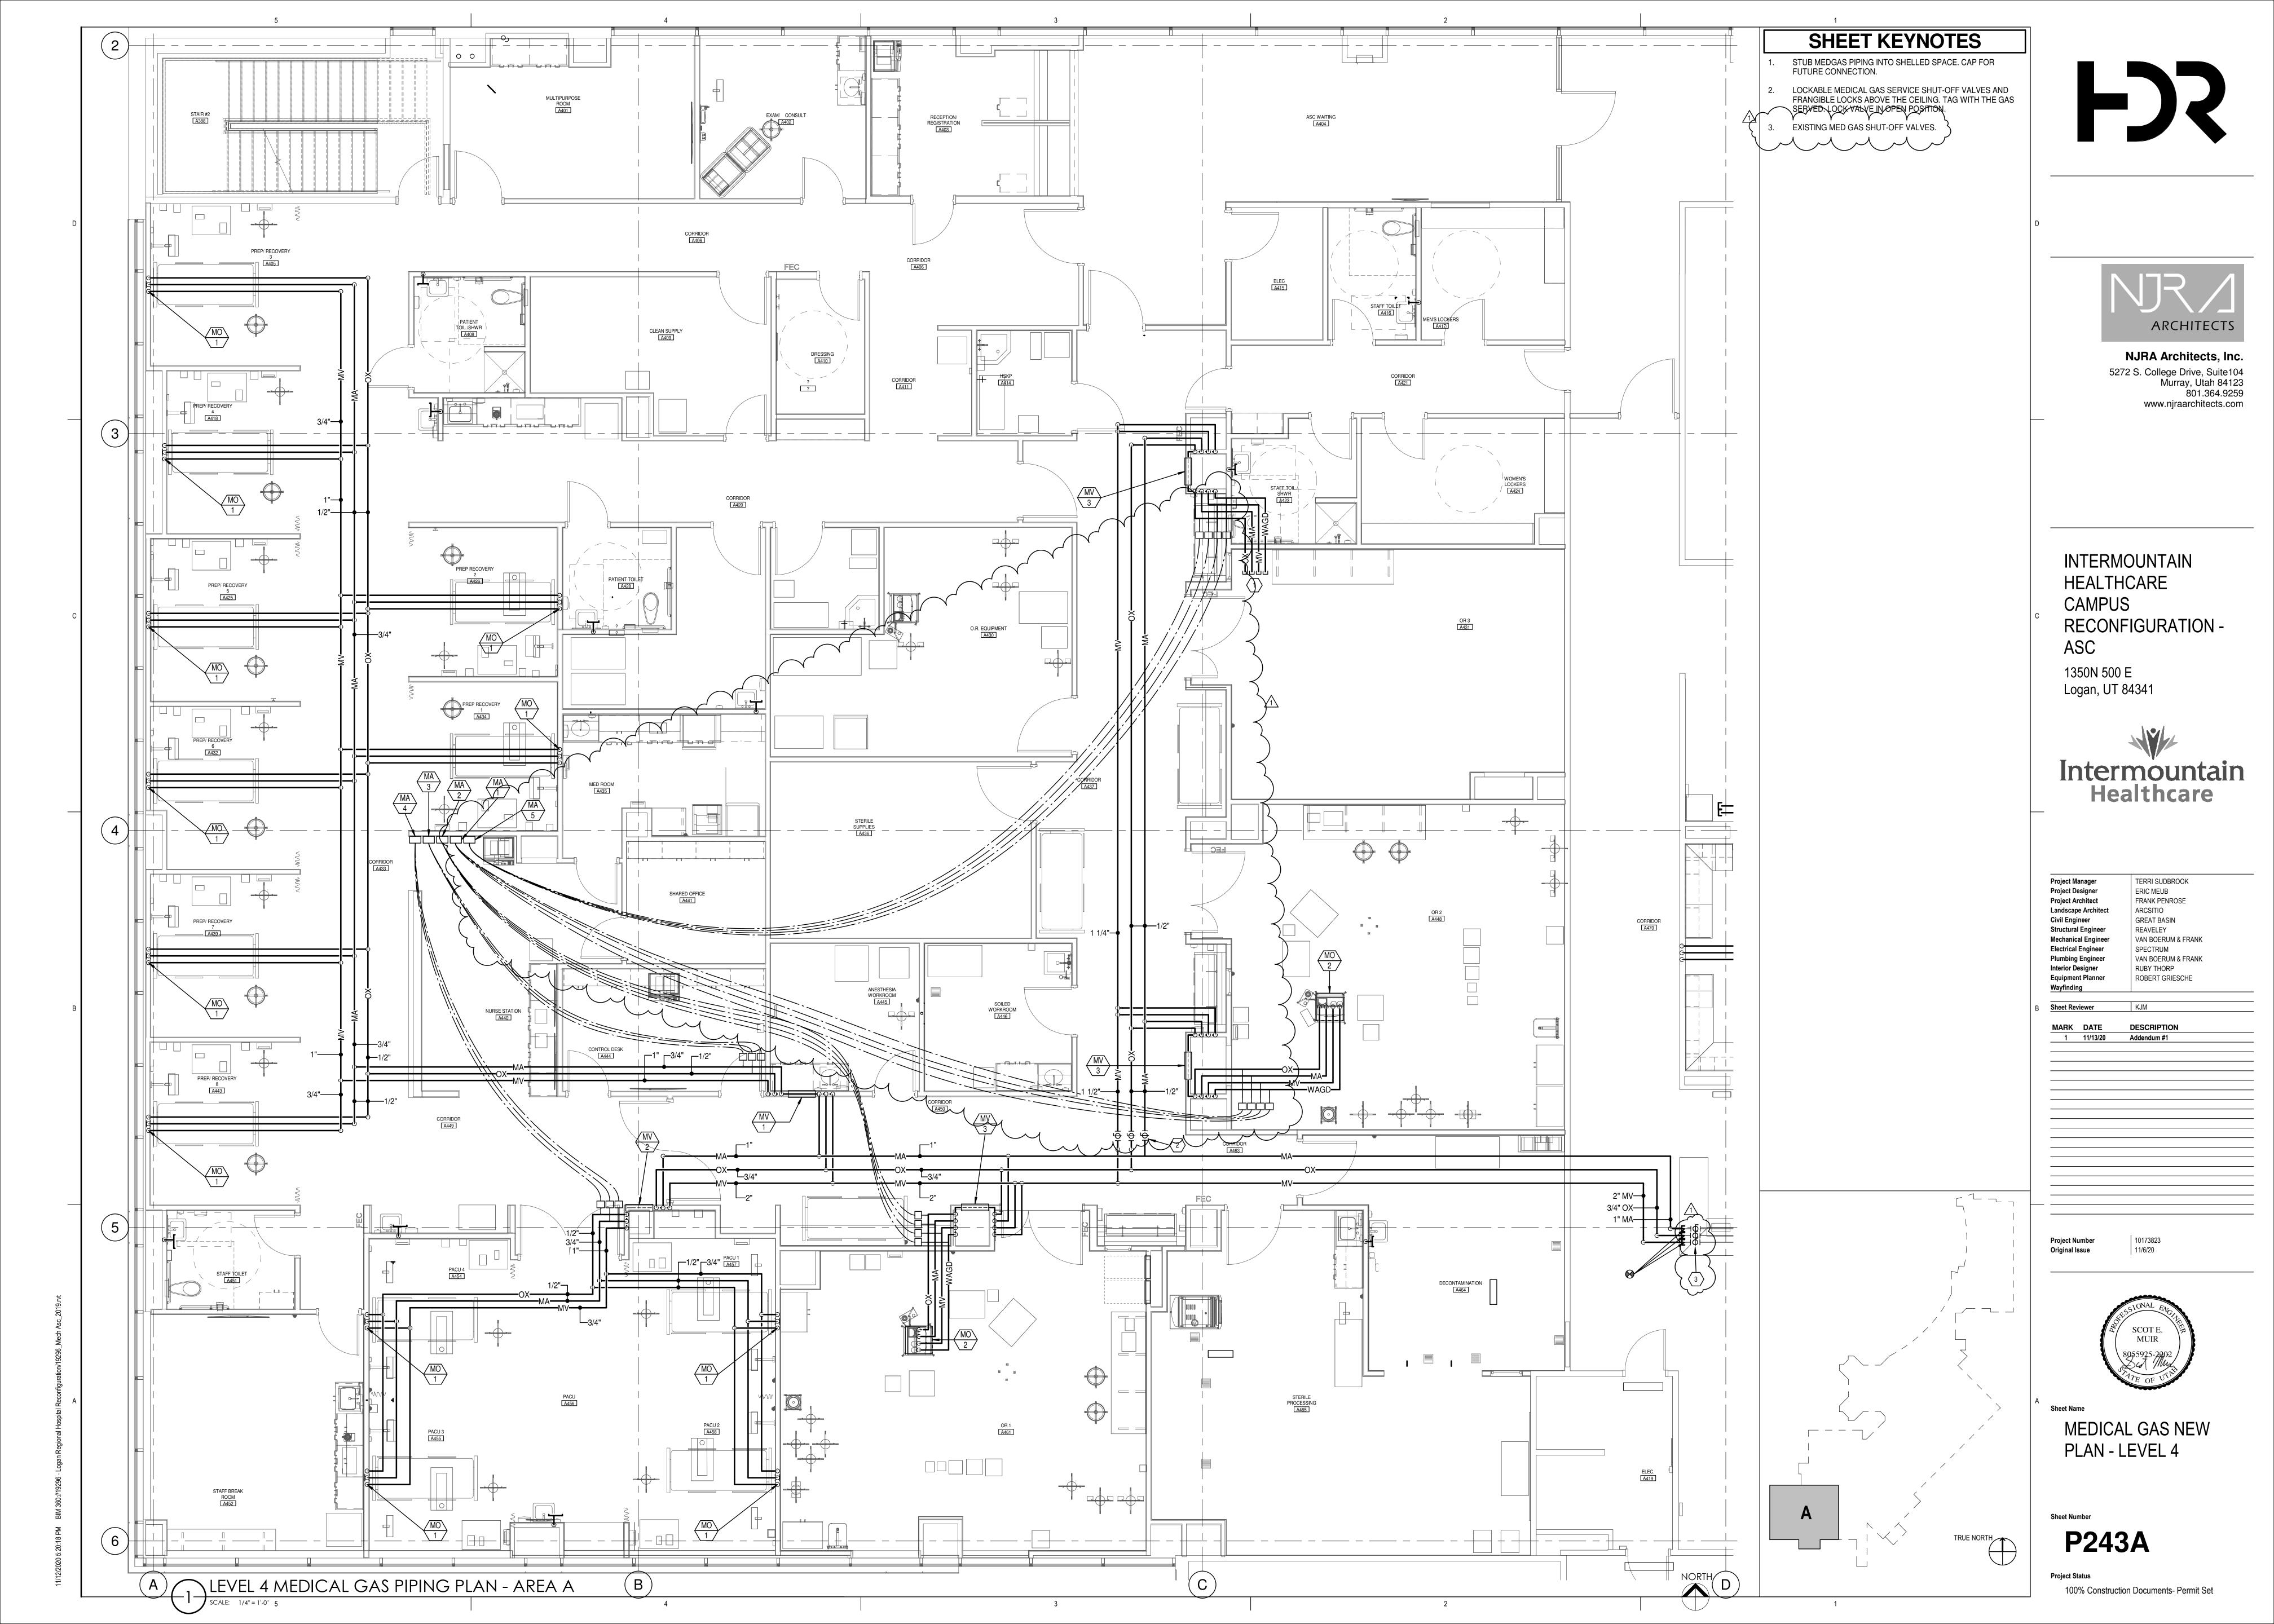


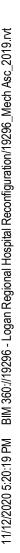


 

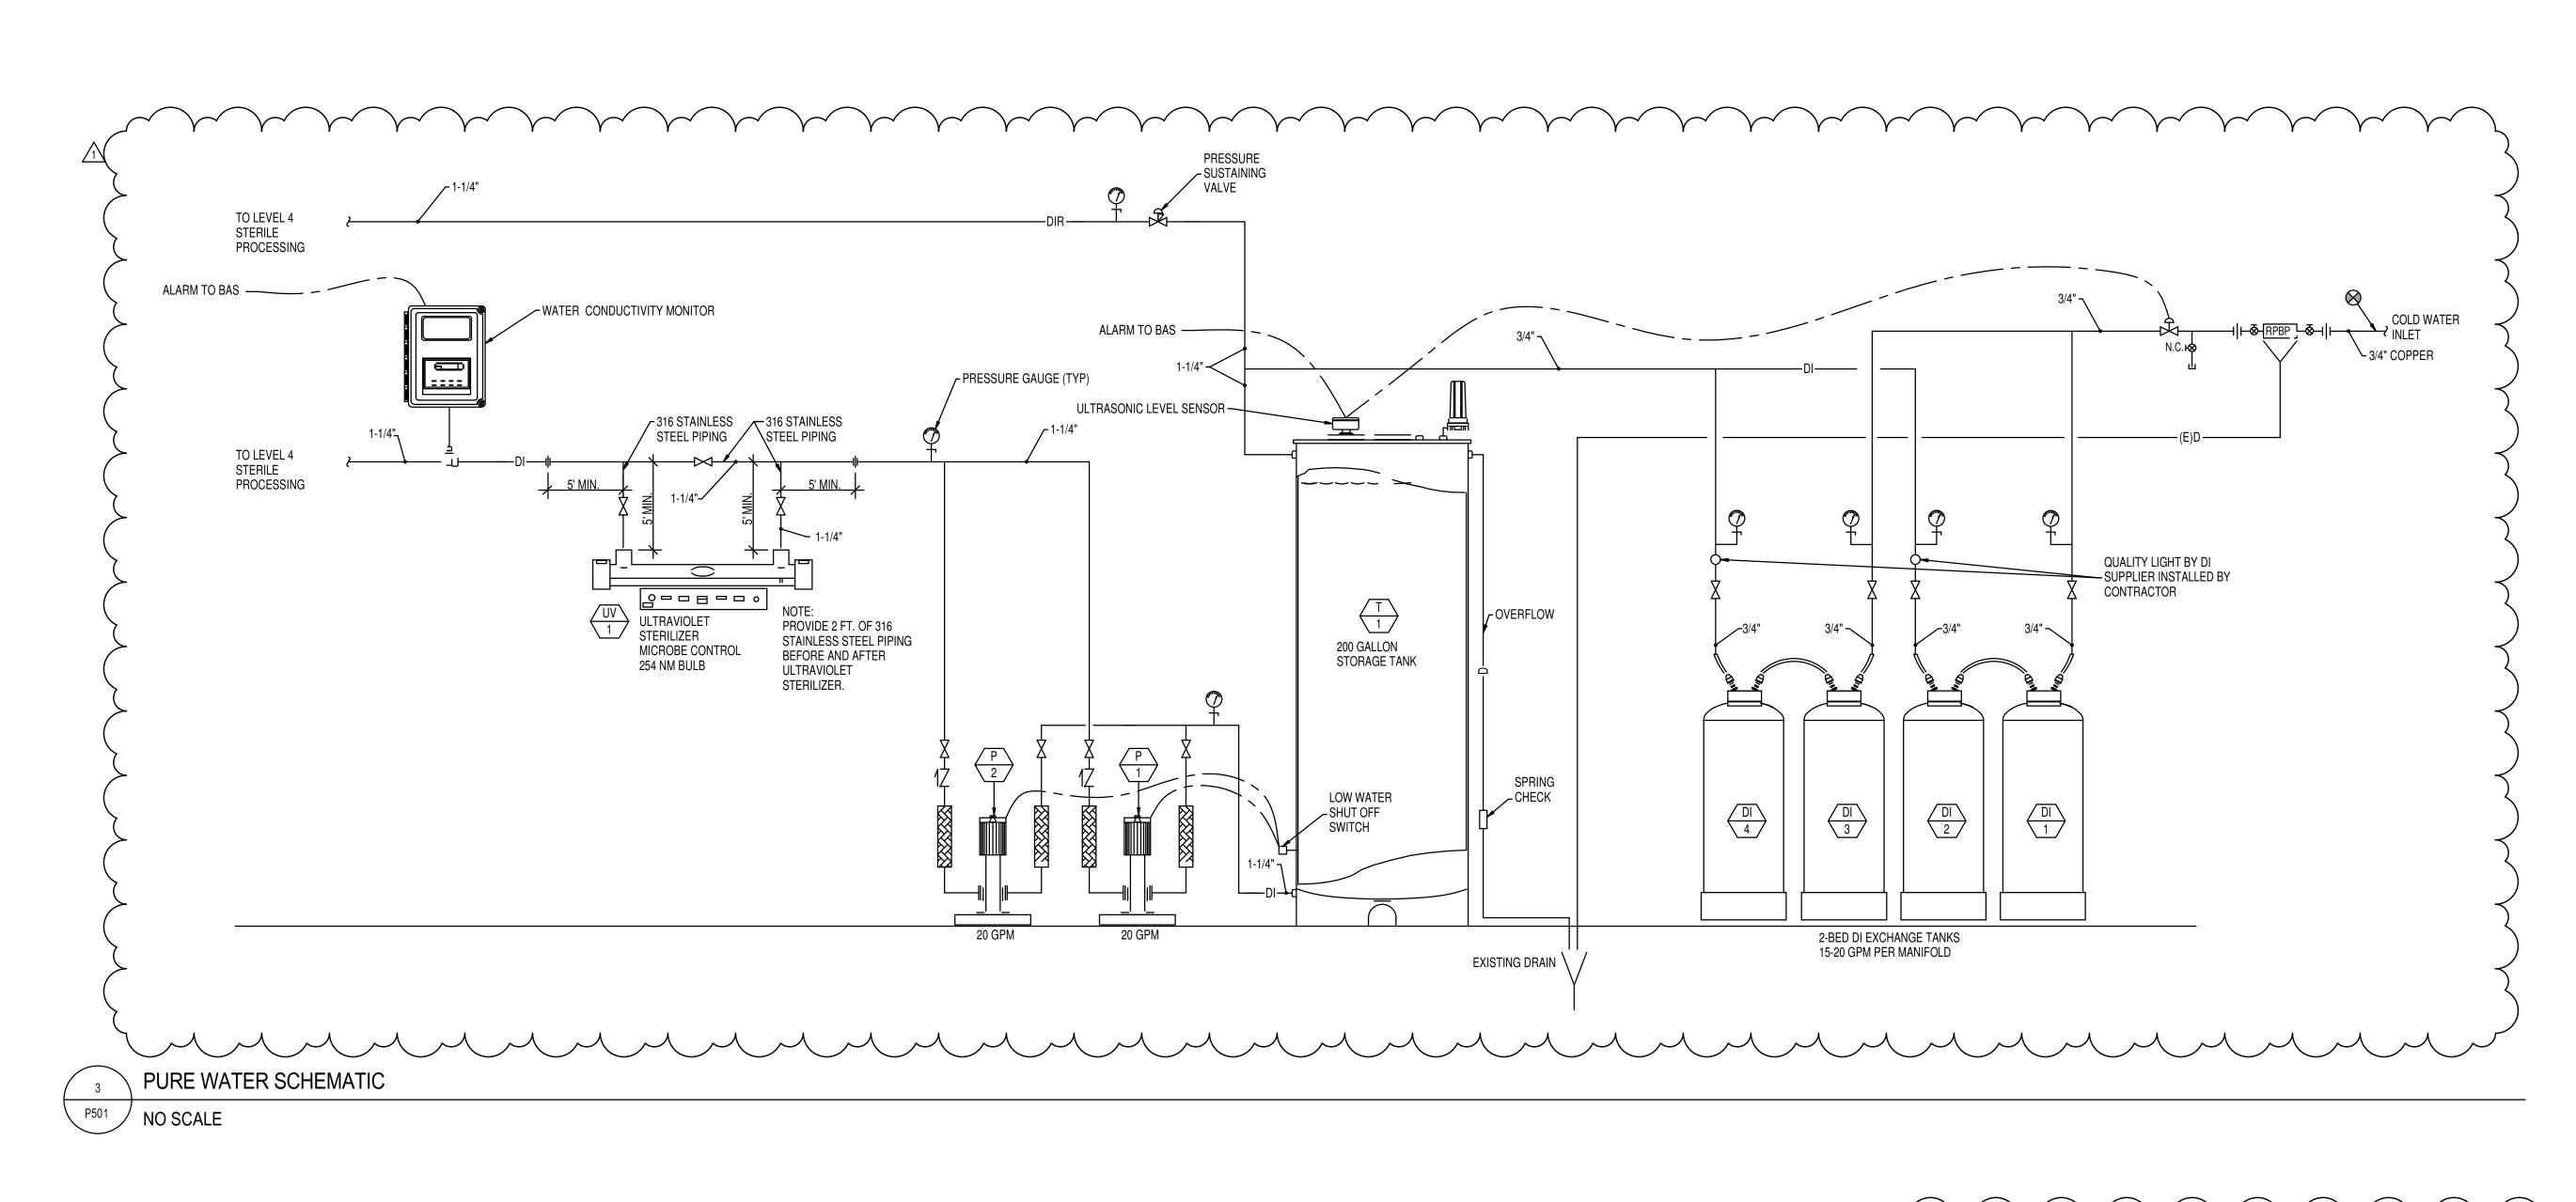

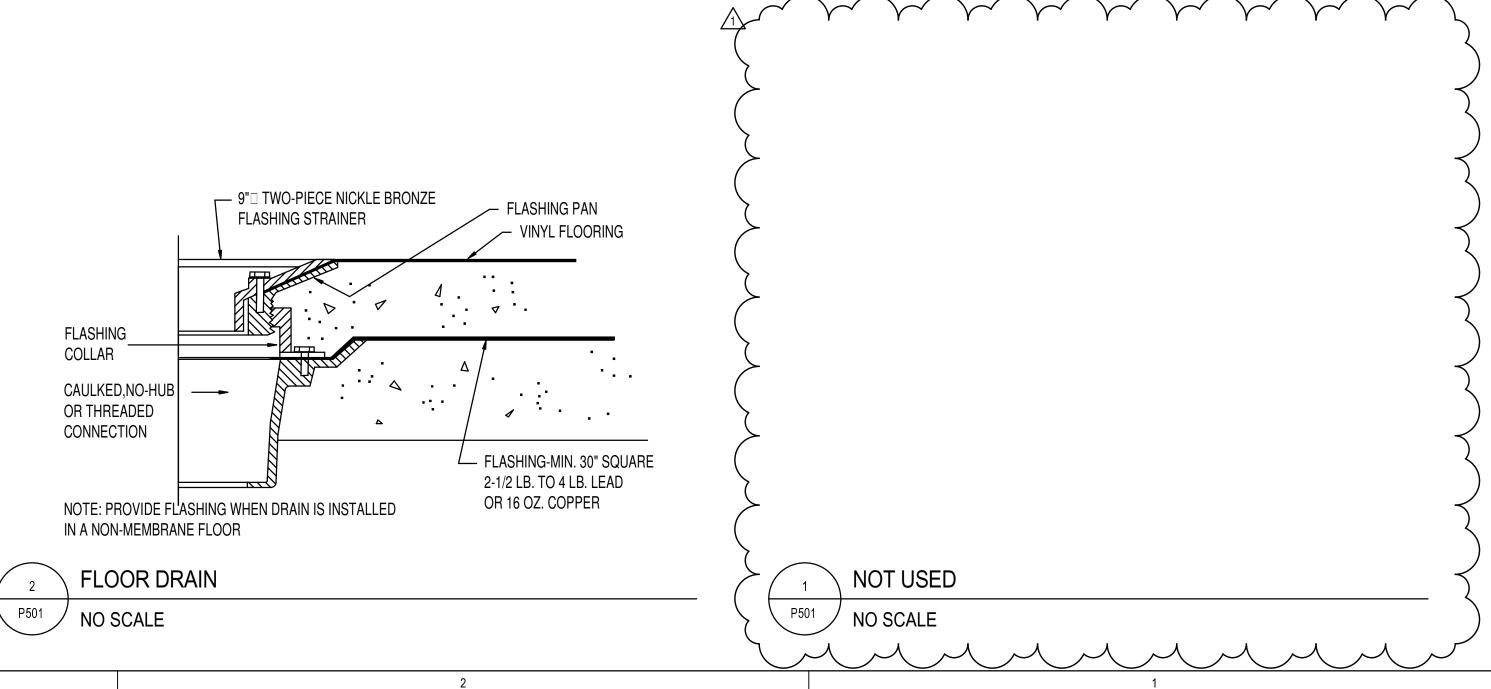

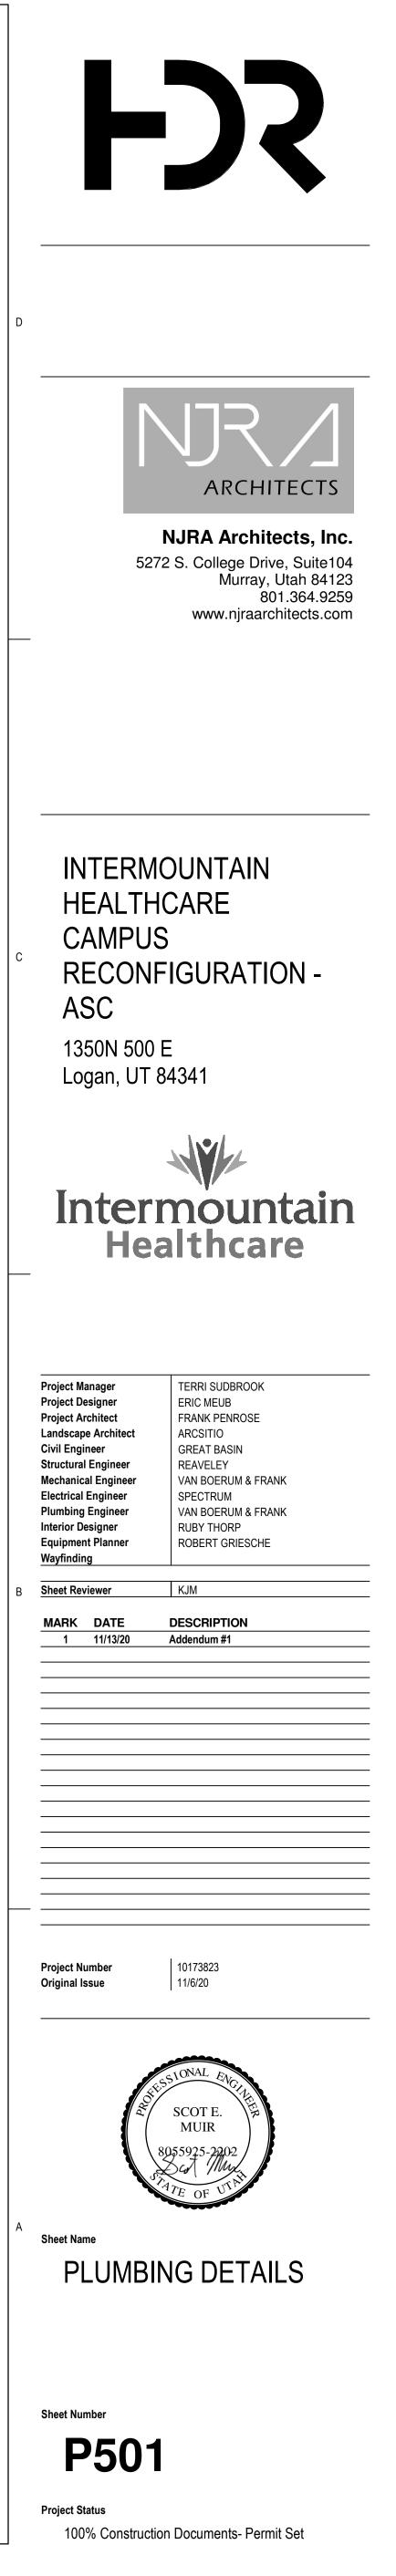

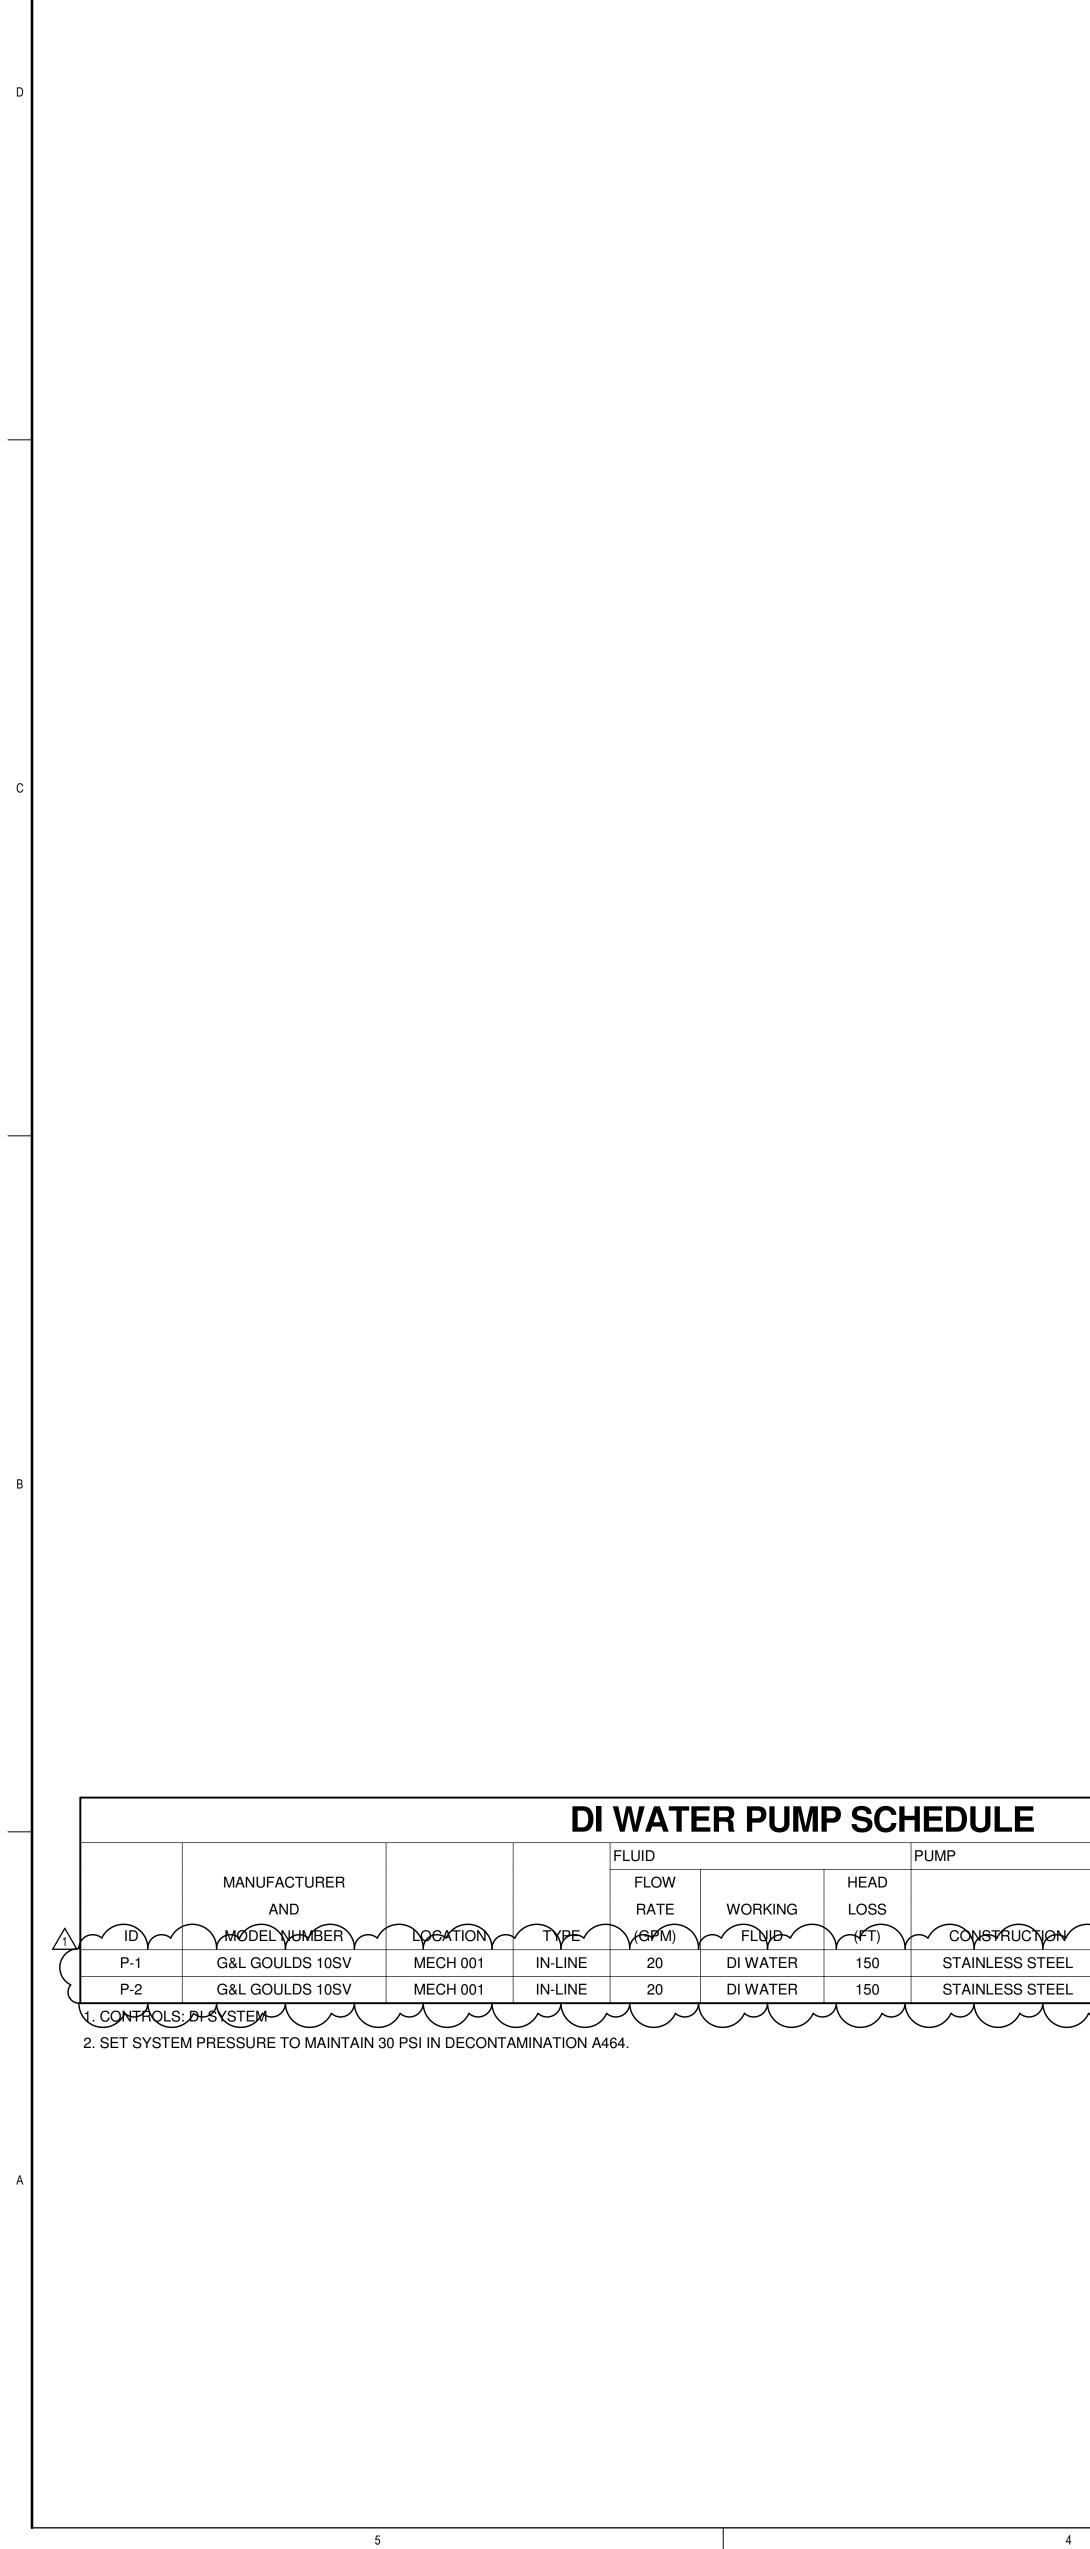

						PLUMBING F
ID	FIXTURE	DCW (IN)	DHW (IN)	W (IN)	V (IN)	DESCRIPTION
EW-1	EMERGENCY EYE WASH	1	1			TEPID WATER
FD-1	FLOOR DRAIN			2	2	GENERAL USE FLOOR DRAI
FS-1	FLOOR SINK			3	2	CENTRAL STERILE
HB-1	HOSE BIBB	1/2				HOSE BIBB
HY-1	HAMMER ARRESTOR					HAMMER ARRESTOR
L-1	LAVATORY	1/2	1/2	2	2	WALL HUNG, GOOSENECK FAUCET WITH MANUAL WRISTBLADES
S-1	SINK (INTEGRAL TO COUNTER)	1/2	1/2	2	2	SINK (INTEGRAL TO COUNTER)
S-2	BREAK ROOM SINK	1/2	1/2	2	2	COUNTER MOUNTED SINGL COMPARTMENT, STAINLES STEEL, SINGLE HANDLE
S-3	SURGEON SCRUB SINK	1/2	1/2	2	2	SURGEON SCRUB SINK
S-4	SINK	1/2	1/2	2	2	COUNTER MOUNTED SINGL COMPARTMENT, STAINLES STEEL, WRIST BLADE HANDLES
SS-1	SERVICE SINK	3/4	3/4	3	2	CORNER FLOOR MOUNT, JANITOR'S CLOSET
CSS-1	CLINICAL SERVICE SINK	1	1/2	4	2	FLOOR MOUNT, FLUSH VALVE, BED PAN WASHER
SH-1	SHOWER	1/2	1/2			ADA, FIXED AND HAND HELI SHOWER HEADS
WC-1	ADA WATER CLOSET	1		4	2	FLOOR MOUNTED, MANUA DUAL FLUSH VALVE, ADA
WO-1	WATER OUTLET BOX	1/2				WATER OUTLET BOX
WO-2	WATER OUTLET BOX	1/2		2	2	WATER OUTLET BOX

1. ALL UNDER GROUND WASTE AND VENT SHALL BE 2" OR GREATER.

	ELECTRICAL				
	MOTOR				
	SIZE				
$\frown$		RRM	VOLT/PH/HZ-	NOTES	

			Р	URE WA	ATER SYS	TEM SCH	EDULE						
		STORAGE T-1			DEIONIZERS (2)				ULTRA VIOLET	STERILIZEF	S		
							FLOW						
			TOTAL				RATE/						
	MANUFACTURER	MANUFACTURER	FLUID	DIA./			PRESS						
			CAPACITY	HEIGHT		CAPACITY	DROP	SIZE		FLOW			
ID		$\mathcal{I}$	(GAL)	(IN)	SYMBOL	(FT^3)	(GPM/PSI)	(IN)	SYMBOL	(GPM)	WATTS	VOLT/PH	NOTES
DI-1 {	WATER SPECIALTIES	NORWESCO	200	30/72	DI-1 THRU 4	9@3.6	20/23	14	UV-1	30	140	120/1	1,2,3,4
		7											

2

2

1. (QTY 2) 2-BED DI SYSTEMS PIPED IN PARALLEL.

2. SEE DOMESTIC PUMP SCHEDULE FOR REPRESSURE PUMPS.


3. FLOW RATE IS FOR EACH 2-BED TANK ARRANGEMENT.

4. UV STERILIZER SHALL BE SANITRON S2400C.

3

FI	XTURE SCHEDULE
	NOTES
	EMERGENCY EYE WASH STATION: GUARDIAN MODEL G5046BP WALL MOUNTED UNIT COMPLETE WITH DRENCH HOSE STYLE EYE/FACE WASH STATION WITH VACUUM BREAKER AND GUARDIAN G3600LF THERMOSTATIC MIXING VALVE INSTALLED ABOVE CEILING DIRECTLY OVER FIXTURE. SET THE OUTLET TEMPERATURE TO 85-90 F. PROVIDE WATTS LF7 DUAL CHECK VALVES ON HOT AND COLD LINES.
AIN	FLOOR DRAIN (RESTROOM): SMITH FIGURE 2005Y FLOOR DRAIN WITH CAST IRON BODY AND FLASHING COLLAR WITH 6" ROUND NICKEL BRONZE ADJUSTABLE STRAINER HEAD WITH SECURED GRATE. PROVIDE AND INSTALL TRAP GUARD TRAP SEAL.
	FLOOR SINK: SMITH FIGURE 3100Y CAST IRON FLANGED RECEPTOR WITH ACID RESISTANT INTERIOR COATING, NICKEL BRONZE RIM AND SECURED 1/2 GRATE AND ALUMINUM DOME BOTTOM STRAINER. PROVIDE AND INSTALL TRAP GUARD TRAP SEAL.
	HOSE BIBB: CHICAGO 897-RCF FAUCET WITH VACUUM BREAKER, PROVIDE WATTS NO. 7 DUAL CHECKS IN HOT AND COLD SUPPLIES, SCREWDRIVER STOPS IN SHANKS.
	HAMMER ARRESTER: JR SMITH FIGURE 5005 FIXTURE RATING 1-11, FIGURE 5010 FIXTURE RATING OF 12-32, FIGURE 5020 FIXTURE RATING 33-60 & FIGURE 5030 FIXTURE RATING 61-113.
ĸ	LAVATORY: KOHLER K-2030, GREENWICH, 20" X 18", VITREOUS CHINA, WITH FRONT OVERFLOW. CHICAGO 786-E72-245ABCP FAUCET WITH 4" WRIST BLADE HANDLES, GN2BJKABCP RIGID/SWING GOOSENECK SPOUT WITH 0.5 GPM LAMINAR FLOW CONTROL IN SPOUT. POWERS LFe480 THERMOSTATIC MIXING VALVE WITH WATTS LF7 DUAL CHECK VALVES ON HOT AND COLD LINES. FLEXIBLE STAINLESS STEEL SUPPLIES WITH WITH LOOSE KEY ANGLE STOPS. CHICAGO 327-XCP OPEN-GRID STRAINER AND CAST BRASS P-TRAP WITH CLEAN OUT PLUG. SMITH 0700-Z CONCEALED ARM CHAIR CARRIER WITH FOOT SUPPORT. PROVIDE ADA COMPLIANT UNDER COUNTER PIPING WRAP BY TRUE-BRO, COLOR TO BE WHITE.
	SINK (BASIN INTEGRAL TO COUNTERTOP) CHICAGO 786-GN8FCXKABCP FAUCET WITH WRIST BLADE HANDLES, GN8FC RIGID/SWING GOOSENECK SPOUT WITH 1.5 GPM LAMINAR FLOW CONTROL IN SPOUT. WATTS LFUSG-B-M2 THERMOSTATIC MIXING VALVE WITH WATTS #7 DUAL CHECK VALVES ON HOT AND COLD LINES INSTALLED IN CEILING. FLEXIBLE STAINLESS STEEL SUPPLIES WITH LOOSE KEY ANGLE STOPS; CHICAGO 327-XCP OPEN GRID STRAINER AND CAST BRASS P-TRAP WITH CLEAN OUT PLUG. PROVIDE ADA COMPLIANT UNDER COUNTER PIPING WRAP BY TRU-BRO, COLOR TO BE WHITE.
àLE SS	SINK: ELKAY LR-2219 18 GA. TYPE 302 STAINLESS STEEL SINK; 22" X 19" X 7½" DEEP; SELF RIMMING; (1) FAUCET HOLE; LK-35 DUO STRAINER; CHICAGO 430-ABCP SINGLE LEVER FAUCET 9-1/2" INTEGRAL SWING SPOUT; FLEXIBLE STAINLESS STEEL SUPPLIES WITH LOOSE KEY ANGLE STOPS; CAST BRASS P-TRAP WITH CLEAN-OUT PLUG.
	FIXTURE FURNISHED BY OTHERS. PROVIDE FLEXIBLE STAINLESS STEEL SUPPLIES WITH LOOSE KEY ANGLE STOPS AND CAST BRASS P-TRAP WITH CLEAN OUT PLUG.
ile SS	SINK: ELKAY LR-2219 18 GA. TYPE 302 STAINLESS STEEL SINK; 22" X 19" X 7½" DEEP; SELF RIMMING; (2) FAUCET HOLES ON 8" CENTER; CHICAGO 786-GN2FCXKABCP FAUCET WITH 4" WRIST BLADE HANDLES, RIGID/SWING GOOSENECK SPOUT WITH 1.5 GPM LAMINAR FLOW CONTROL IN SPOUT. WATTS LFUSG-B-M2 THERMOSTATIC MIXING VALVE WITH WATTS #7 DUAL CHECK VALVES ON HOT AND COLD LINES INSTALLED IN CEILING. FLEXIBLE STAINLESS STEEL SUPPLIES WITH LOOSE KEY ANGLE STOPS; CHICAGO 327-XCP OPEN GRID STRAINER AND CAST BRASS P-TRAP WITH CLEAN OUT PLUG. PROVIDE ADA COMPLIANT UNDER COUNTER PIPING WRAP BY TRU-BRO, COLOR TO BE WHITE.
- ,	JANITOR SINK (FLOOR MOUNTED, CORNER): KOHLER K6710, WHITBY, 28 X 28-INCH, ENAMELED CAST IRON FLOOR-MOUNTED CORNER MODEL, K9146-3" DRAIN WITH STRAINER, NO. K8940 REMOVABLE VINYL-COATED RIM GUARD; CHICAGO 897-RCF FAUCET WITH VACUUM BREAKER, PROVIDE WATTS NO. 7 DUAL CHECKS IN HOT AND COLD SUPPLIES, SCREWDRIVER STOPS IN SHANKS, 5 FOOT RUBBER HOSE AND WALL HOOK, 853.
R	KOHLER K-6676 TYRRELL FLOOR MOUNTED CLINIC SINK; CHICAGO 814-VBCP FAUCET; SLOAN REGAL 117 XL FLUSH VALVE; CHICAGO 910-GSL0777-19KCP WALL MOUNTED BEDPAN WASHER WITH FOOT PEDALS VACUUM BREAKER AND HAND HELD SPRAY HOSE. PROVIDE 10" HIGH CONCRETE BASE FOR FLOOR SINK. INSTALLED IN CEILING WITH ACCESS DOOR IF HARD CEILING, PROVIDE WATTS LFMMV THERMOSTATIC MIXING VALVE WITH WATTS #7 DUAL CHECK VALVES ON HOT AND COLD LINES.
LD	SHOWER (ADA COMPLIANT): SYMMONS 1-1170VT-T600B-36-V-X-1.5 VISU-TEMP EXTRA HEAVY DUTY SHOWER SYSTEM WITH PRESSURE BALANCING MIXING VALVE, CLEAR-VUE THERMOMETER, LEVER HANDLE, ADJUSTBABLE STOP SCREW, INTEGRAL SERVICE STOPS, 1.5 GPM SHOWER HEAD WITH ARM AND FLANGE, LEVER DIVERTER WITH INTEGRAL VOLUME CONTROL, 1.5 GPM WALL/HAND SHOWER WITH 6' FLEXIBLE METAL HOSE, INLINE BREAKER, WALL CONNECTION AND FLANGE AND SYMMONS 36" T600B ADA GRAB AND SLIDE BAR FOR HAND SHOWER MOUNTING.
AL A	WATER CLOSET: KOHLER K-4368 HIGHCLIFF VITREOUS CHINA, FLOOR MOUNTED, ELONGATED BOWL, 1-1/2" TOP SPUD, ADA TOILET WITH K-4670-C LUSTRA OPEN-FRONT SEAT. SLOAN WES-111 MANUAL DUAL FLUSH, 1.6 GPF FLUSH VALVE; PROVIDE "DIRT GRABBER" FLUSH VALVE FILTER, COORDINATE SIZE WITH FLUSH VALVE; INSTALL ACTUATOR ON WIDE SIDE OF FIXTURE. COORDINATE MOUNTING HIEGHT WITH ARCHITECTURAL DAWINGS.
	WATER OUTLET BOX: WATER-TITE 87978 ICE MAKER OUTLET BOX WITH HAMMER ARRESTER AND QUARTER TURN BALL VALVE FOR USE WITH COFFEE MACHINE. INSTALL ONLY COLD WATER BALL VALVE. NOTCH COUNTERTOP BACK-SPLASH. PROVIDE AND INSTALL AN ASSE 1022 BACKFLOW PREVENTOR IN THE CEILING ABOVE AND PIPE DISCHARGE TO THE P-TRAP OF THE ADJACENT SINK.
	WATER OUTLET BOX: WATER-TITE 82112 WASHING MACHINE OUTLET BOX WITH DRAIN, WATER HAMMER ARRESTER, AND COLD WATER QUARTER TURN BALL VALVE FOR USE WITH COUNTERTOP ICE MACHINE. NOTCH COUNTERTOP BACK-SPLASH AND INSTALL OUTLET BOX DRAIN FLUSH WITH COUNTERTOP. PROVIDE WITH PVC TRAP.

1

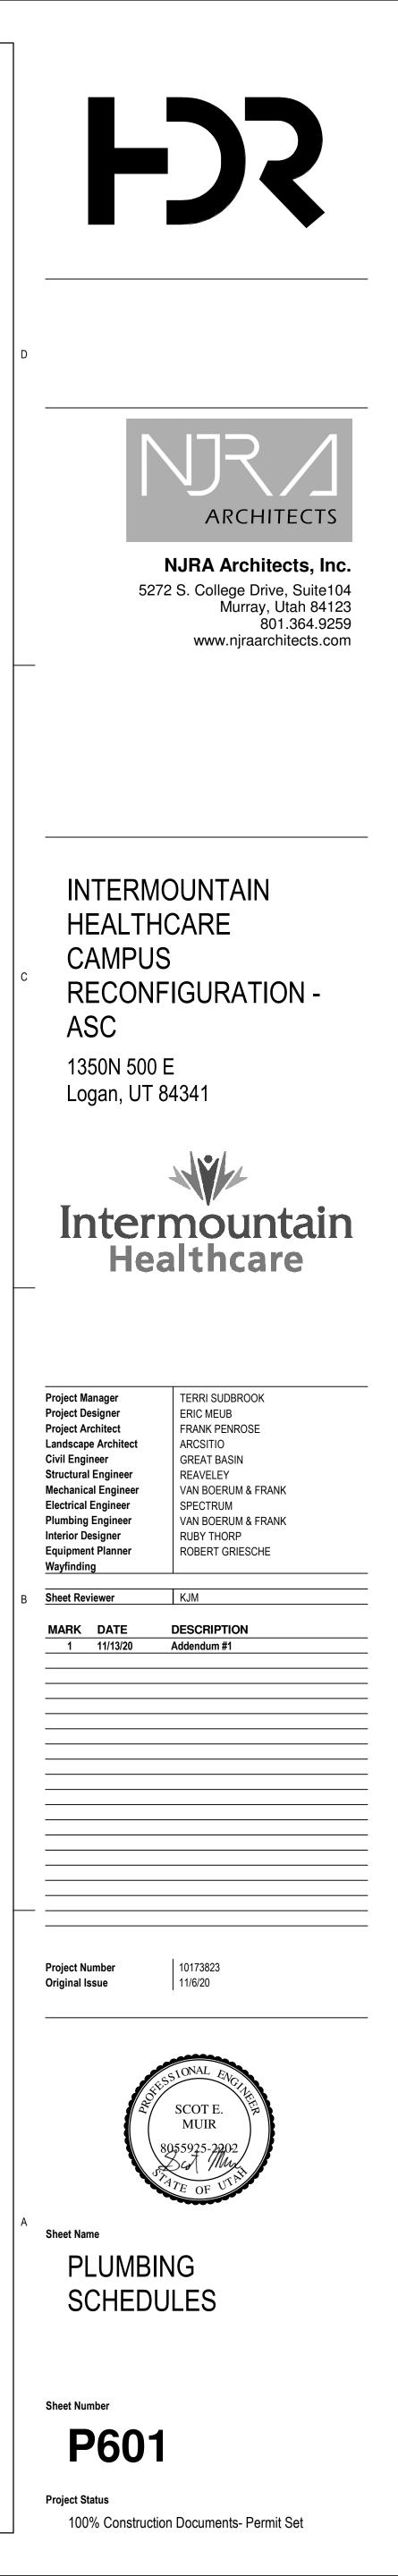


	D		
	C		
	В		
24 PM BIM 360://19296 - Logan Regional Hospital Reconfiguration/19296_Mech Asc_2019.rvt	A		

5

4

4

# MEDICAL GAS ALARM PANEL SCHEDULE

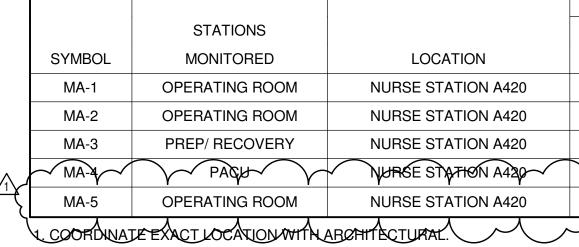

2. DEDICATED WIRING FROM SOURCE SIGNALS TO ALARM.

MEDICAL GAS VALVE SCHEDULE								
			PIPE	SIZE				
SYMBOL	AREA SERVED	ох	MA	MV	WAGD	REMARKS		
MV-1	PREP/RECOVERY	1/2"	3/4"	1"	-	1		
MV-2	PACU	1/2"	3/4"	1"	-	1		
MV-3	OPERATING ROOMS	1/2"	1/2"	1-1/4"	3/4"	1,2		

1. WITH GAUGES.

3

3

2. WRAP PIPING BEHIND THE VALVE BOX IN THE CONCEALED POCKET, AS REQUIRED TO FIT IN THE AVAILABLE HORIZONTAL DIMENSION OF THE WALL.


MEDICAL GAS OUTLETS SCHEDULE										
		# OF OUTLETS				PIPE DROP SIZE TO OUTLET(S)				
SYMBOL	ROOM TYPE	ОХ	MA	MV	WAGD	ох	MA	MV	WAGD	REMARKS
MO-1	PACU / PREP	1	1	1		1/2"	1/2"	3/4"		1,2
MO-2	O.R. CEILING	2	1	4	1	1/2"	1/2"	1"	1"	1,3

UNLESS NOTED OTHERWISE, ALL OUTLETS ARE CHEMETRON-STYLE QUICK-CONNECTS - SEE ARCHITECTURAL DRAWINGS FOR EXACT LOCATIONS AND ELEVATIONS. OUTLETS IN "MEDICAL EQUIPMENT" ARE SUPPLIED WITH THE PIECE OF EQUIPMENT. 1. PIPE DROP SIZES ARE FOR ONE SET OF OUTLETS.

2

1

2.WALLWOUNTED OUTLETS.  $\bigvee \bigvee \checkmark$  $\bigvee \bigvee \bigvee$  $\sqrt{}$ 3. CEILING MOUNTED DROPPED MED GAS HOSES IN OPERATING ROOM. CEILING MOUNTED OUTLETS REQUIRE DISS CONNECTION TO CONNECT TO THE DROP HOSES. THE HOSES SHALL HAVE QUICK DISCONNECTS ON THE USER END.

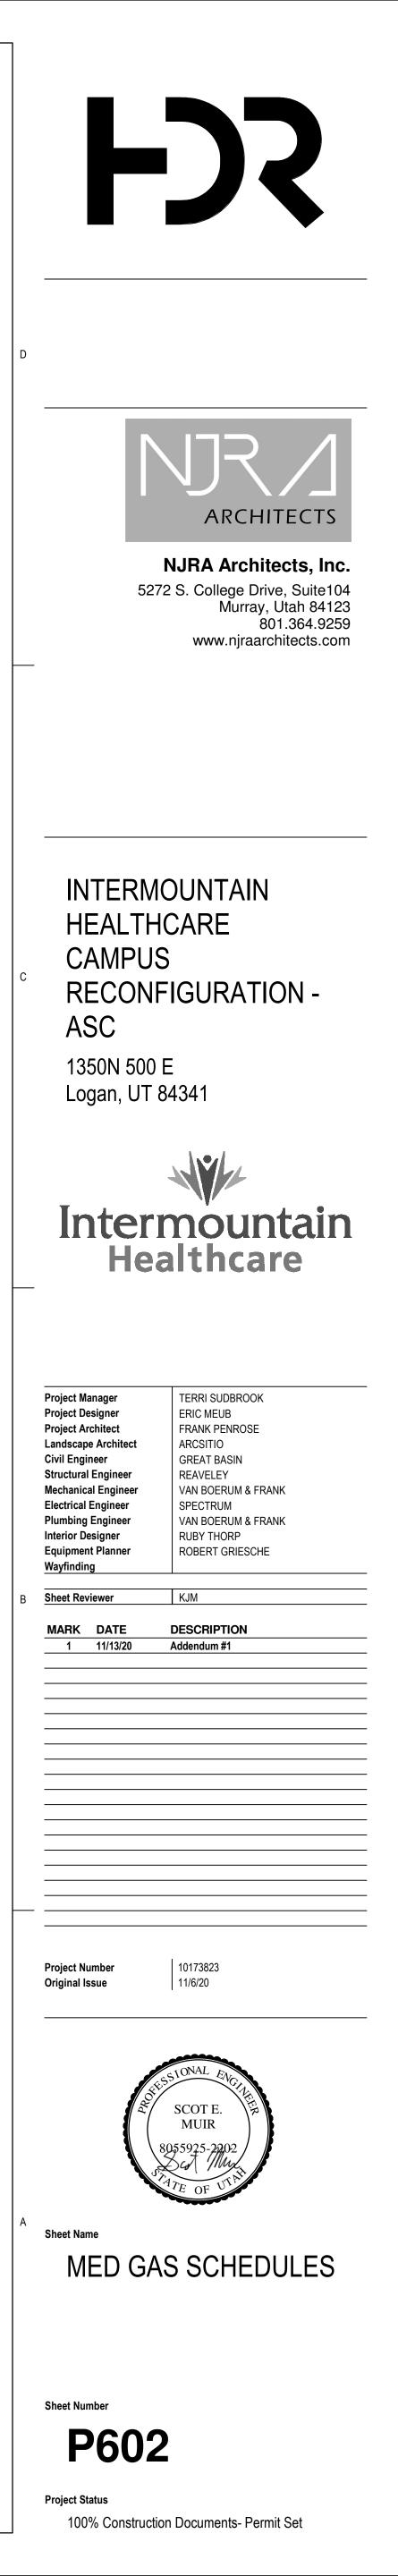



Mechanical Engineering Electrical Engineering Technology Engineering Lighting Design Theatre Design Fire Protection Engineering Building Commissioning

To: Company:	Shailesh Munot NJRA Architects 5272 S. College Drive, Suite 104 Murray, Utah 84123		404.614.5092 November 13, 2020
Re:	ASC Addendum #1		
From:	Carlton A. Getz	Job:	Salt Lake City Convention Center Hotel
[p]: Distributed	801.401.8461 I Via: E-Mail	Job No.: Email:	20190083 cag@spectrum-engineers.com

### Memo

This memorandum summarizes the revisions in Addendum #1 dated November 12, 2020:

#### Sheet EEA001

• USB Receptacle definition changed to clarify hospital grade.

#### Sheet EDA101

• Keynote #4 added for clarity.

#### Sheet EPA100

- MHDM1 (existing equipment) shown for the sake of circuiting P-1 and P-2.
- P-1 and P-2 circuiting and disconnects changed per mechanical coordination.

#### Sheet EPA101

- Duplex receptacles at scrub sinks are removed.
- The scrub sink circuit breaker changed to GFCI.
- Power and data added for PACU Omnicell.
- Keynote 17 added for clarity.
- Disconnects added for sterilizer equipment and washers.
- NEMA types specified for special receptacles.
- Elapsed time clocks keynoted for clarity.
- Waiting room duplex receptacles are no longer hospital grade.
- Steam washer circuits changed to new equipment panel.

#### Sheet EPA602

• Panel 4EQL2 updated.

#### Sheet EPA603

- P-1 and P-2 electrical details update per mechanical coordination.
- AHU-3 data updated.

#### Sheet EPA604

- MHDM1 (existing equipment) schedule added to show P-1 and P-2 connections.
- Steam washer circuits changed to new equipment panel.

#### Sheet EPA605

- Scrub sink breaker noted as GFCI per changes on plan.
- Power added for PACU Omnicell.
- AHU-3 CB size changed to 20A.
- Panel 4EQL2 size updated.

#### Sheet EPA606

• Panel sizes corrected.

#### Sheet ELA101

- TX-1 fixtures removed.
- Prep/Recovery lighting control and spec updated.
- Lighting control wiring shown where missing.
- Scrub sink controls changed to dimming.
- Some lighting shifted per clouding.
- Unused lighting controls removed from shell OR.
- Keynotes added to wall stations.
- Circuiting changed to separate corridors from other life safety lighting for the sake of lighting control.
- Exit light circuiting changed.
- Dimmers for green light control added to OR spaces.
- Designation and specification for OR 2x4 lighting changed to OR-1 (not clouded for clarity).
- Some OR lighting fixtures are tagged to include battery backup.

#### Sheet ELA601

- TX-1 fixtures removed from the schedule.
- G-4 spec added.
- GF spec changed to OR.
- W-4 spec changed.
- LX4 relay panel schedule moved to this sheet with new relay show.

#### Sheet ELA602

• Sheet removed.

#### Sheet EYA101

- Camera added above PACU Omnicell.
- Paging speakers circuited.
- Sound masking speakers added and keynoted.

Sheet FAA101

- Quantity of speaker devices increased per clouding.
- Toggle switches added to all FSDs.
- Pull Station added at nurse station.

### Sheet FAA601

• FA Matrix removed.

If you require any additional information, please contact me at (801).401.8461.

Regards,

Carlton A. Getz, P.E. Principal Spectrum Engineers, Inc.

	SYMBOL	5 SYMBOLS LEGEND DESCRIPTION
		DETAIL INDICATOR: A5 INDICATES DETAIL NUMBER, E-501 INDICATES DRAWING SHEET WHERE DETAIL IS SHOWN.
	02 A5 E-201	ELEVATION OR SECTION INDICATOR, EXTERIOR: A5 INDICATES ELEVATION OR SECTION NUMBER, E-201 INDICATES DRAWING SHEET WHERE ELEVATION OR SECTION IS SHOWN.
D	03 A5 E-201 ROOM NAME	ELEVATION OR SECTION INDICATOR, INTERIOR: A5 INDICATES ELEVATION OR SECTION NUMBER, E-201 INDICATES DRAWING SHEET WHERE ELEVATION OR SECTION IS SHOWN.
	$\begin{array}{c c} 04 & 100 \\ \hline 05 & 1 \end{array}$	ROOM IDENTIFIER WITH ROOM NAME AND NUMBER.
		REVISION INDICATOR.
	07 CU-1	EQUIPMENT INDICATOR.
	08 X-X XMDP	MECHANICAL EQUIPMENT INDICATOR. "X-X" INDICATES EQUIPMENT MARK SHOWN ON EQUIPMENT SCHEDULE. "XMDP" IDENTIFIES PANEL EQUIPMENT IS CIRCUITED TO. REFER TO EQUIPMENT SCHEDULE FOR ADDITIONAL INFORMATION.
		BREAK, STRAIGHT: TO BREAK PARTS OF DRAWING
		BREAK, ROUND MATCH LINE INDICATOR: CENTER, EXTRA WIDE LINE.
	12	NEW LINE: MEDIUM LINE.
	1 <u>3                                    </u>	HIDDEN FEATURES LINE: HIDDEN, THIN LINE
	14	EXISTING TO REMAIN LINE: THIN LINE.
	<sup>15</sup> 16	DEMOLITION LINE: DASHED, MEDIUM LINE
	17	PROPERTY LINE: DASHED, WIDE LINE.
	18	CONTRACT LIMIT LINE: DASHDOT, WIDE LINE. ELECTRICAL EQUIPMENT INDICATOR. "XXX" INDICATES TYPE OF
	XXX EF-X 19	EQUIPMENT OR EQUIPMENT ID. "EF-X" IDENTIFIES MECHANICAL EQUIPMENT BEING SERVED. REFER TO EQUIPMENT SCHEDULE FOR ADDITIONAL INFORMATION. EQUIPMENT INDICATOR. "X-X" INDICATES EQUIPMENT MARK
С	UNCERT NO DE	SHOWN ON EQUIPMENT SCHEDULE. "1LA-3" IDENTIFIES PANEL EQUIPMENT IS CIRCUITED TO. REFER TO EQUIPMENT SCHEDULE FOR ADDITIONAL INFORMATION.
	02	RECEPTACLE, DUPLEX: NEMA 5-20R.
	<sup>03</sup> 🗛	RECEPTACLE, DUPLEX, ABOVE COUNTER: NEMA 5-20R.
	04	RECEPTACLE, DUPLEX, CEILING: NEMA 5-20R.
		RECEPTACLE, DUPLEX WITH GROUND FAULT CIRCUIT INTERRUPTER, DRINKING FOUNTAIN: CONCEAL WATER COOLER RECEPTACLE BEHIND WATER COOLER. SEE MECHANICAL/PLUMBING SHOP DRAWINGS FOR INSTALLATION
	08	REQUIREMENTS. RECEPTACLE, DUPLEX, SWITCHED: NEMA 5-20R.
	11 0 WP	RECEPTACLE, DUPLEX, WEATHERPROOF: NEMA 5-20R.
	12 <b>b</b>	RECEPTACLE, DUPLEX, HOSPITAL GRADE: NEMA 5-20R.
		RECEPTACLE, DUPLEX ON EMERGENCY POWER: NEMA 5-20R.
	<sup>14</sup>	RECEPTACLE, DUPLEX, HOSPITAL GRADE ON EMERGENCY POWER: NEMA 5-20R.
		RECEPTACLE, DUPLEX, CONNECTED TO UPS: NEMA 5-20R. RECEPTACLE, DUPLEX WITH GROUND FAULT CIRCUIT
	17 <b>•</b>	INTERRUPTER: NEMA 5-20R. RECEPTACLE, DUPLEX WITH GROUND FAULT CIRCUIT INTERRUPTER, HOSPITAL GRADE: NEMA 5-20R.
	18	RECEPTACLE, DUPLEX WITH GROUND FAULT CIRCUIT INTERRUPTER, HOSPITAL GRADE ON EMERGENCY POWER:
	19	NEMA 5-20R. RECEPTACLE, DUPLEX WITH GROUND FAULT CIRCUIT
	₩P	INTERRUPTER, WEATHERPROOF: NEMA 5-20R.
		RECEPTACLE, DUPLEX, RECESSED: NEMA 5-20R. RECEPTACLE, QUADRAPLEX: NEMA 5-20R.
В		RECEPTACLE, QUADRAPLEX ON EMERGENCY POWER: NEMA 5-20R.
	24	RECEPTACLE, QUADRAPLEX, HOSPITAL GRADE: NEMA 5-20R.
	25 	RECEPTACLE, QUADRAPLEX, HOSPITAL GRADE ON EMERGENCY POWER: NEMA 5-20R.
	27	RECEPTACLE, QUADRAPLEX, CONNECTED TO UPS: NEMA 5-20R. RECEPTACLE, QUADRAPLEX WITH GROUND FAULT CIRCUIT
	<sup>2</sup> <sup>7</sup>	INTERRUPTER: NEMA 5-20R. RECEPTACLE, SPECIAL PURPOSE. PROVIDE RECEPTACLE TO
	29	MATCH EQUIPMENT PLUG. RECEPTACLE, SPECIAL PURPOSE ON EMERGENCY POWER. PROVIDE RECEPTACLE TO MATCH EQUIPMENT PLUG.
		MULTI-OUTLET ASSEMBLY: NEMA 5-20R.
	34 D 36	DROP CORD. SEE DETAIL.
	FB#	FLUSH FLOOR BOX. "#" SHOWN ON DRAWINGS. REFER TO WIRING DEVICE SCHEDULE IN THE ELECTRICAL SPECIFICATIONS FOR CONFIGURATION AND DEVICES.
	37 PP# 38	POWER POLE. "#" SHOWN ON DRAWINGS. REFER TO WIRING DEVICE SCHEDULE IN THE ELECTRICAL SPECIFICATIONS FOR CONFIGURATION AND DEVICES.
	38 PT# 39	FLUSH FIRE RATED POKE THRU. "#" SHOWN ON DRAWINGS. REFER TO WIRING DEVICE SCHEDULE IN THE ELECTRICAL SPECIFICATIONS FOR CONFIGURATION AND DEVICES.
	39 40 Х \$ 41 Х	SWITCH, DIMMER. SWITCH, SINGLE POLE ("x" INDICATES FIXTURES CONTROLLED).
	\$2 42 X	SWITCH, DOUBLE POLE ("X" INDICATES FIXTURES CONTROLLED).
A	\$3 43 X \$4	SWITCH, THREE-WAY ("x" INDICATES FIXTURES CONTROLLED). SWITCH, FOUR-WAY ("x" INDICATES FIXTURES CONTROLLED).
	45 \$К	SWITCH, KEY OPERATED.
	55	RECEPTACLE, DUPLEX WITH GROUND FAULT CIRCUIT INTERRUPTER, CONNECTED TO UPS: NEMA 5-20R.
	56	RECEPTACLE, SINGLE PLEX, WITH USB OUTLET, HOSPITAL GRADE
	57	RECEPTACLE, DULEX, RECESSED, NEMA 5-20R, AUTOMATICALLY CONTROLLED THROUGH TIME OR OCCUPANCY BASED CONTROLS (REFER TO PLANS FOR CONTROL METHOD)
	58	RECEPTACLE, QUADRAPLEX, RECESSED, NEMA 5-20R, AUTOMATICALLY CONTROLLED THROUGH TIME OR OCCUPANCY BASED CONTROLS (REFER TO PLANS FOR CONTROL METHOD)
	59 #	INDICATES A RECEPTACLE IS AUTOMATICALLY CONTROLLED THROUGH TIME OR OCCUPANCY BASED CONTROLS (REFER TO PLANS FOR CONTROL METHOD)

	SYMBOLS LEGEND
SYMBOL	DESCRIPTION
	THODS
02	WIRING.
$\odot$	WIRING TURNED UP OR TOWARDS OBSERVER.
03	WIRING TURNED DOWN OR AWAY FROM OBSERVER.
04	BRANCH CIRCUIT HOME RUN TO PANELBOARD: NUMBER OF ARROWS INDICATES NUMBER OF CIRCUITS. LETTER AND
A-1,3,5	NUMBER NOTATIONS IDENTIFY PANEL AND CIRCUIT NUMBERS. USE #12 CONDUCTORS, EXCEPT #10 CONDUCTORS SHALL BE
A-1,3,5	INSTALLED IF DISTANCES EXCEED THOSE SPECIFIED IN THE ELECTRICAL SPECIFICATIONS.
05	BRANCH CIRCUIT HOME RUN TO PANELBOARD: NUMBER OF
	ARROWS INDICATES NUMBER OF CIRCUITS. LETTER AND NUMBER NOTATIONS IDENTIFY PANEL AND CIRCUIT NUMBERS.
A-1,3,5	NUMBER IN BOX REFERS TO THE CONDUCTOR AND CONDUIT SCHEDULE. FOR BRANCH WIRING USE #12 CONDUCTORS,
7 ( 1,0,0	EXCEPT #10 CONDUCTORS SHALL BE INSTALLED IF DISTANCES EXCEED THOSE SPECIFIED IN THE ELECTRICAL
08	SPECIFICATIONS.
00	WIRING AND/OR RACEWAY: THIN LINE. WHERE "X" = :
	CATV = CABLE TELEVISION NC = NURSE CALL CCTV = CLOSED CIRCUIT P = POWER
— x —	TELEVISIONRC=RIGID CONDUFA=FIRE ALARMS=SOUNDFA=FIRE ALARMS=SOUND
	FO=FIBER OPTICST=TELEPHONEI=INTERCOMTV=TELEVISION
	OTHERS AS NOTED IN OTHER SCHEDULES. RACEWAYS AND WIRING SHALL BE SIZED AS SHOWN AND/OR SPECIFIED.
09	LOW VOLTAGE WIRING: DIVIDE, MEDIUM LINE.
10	
<b>+</b>	CONDUIT STUB. DIMENSION RECORD DRAWINGS AND MARK. CONDUCTOR & CONDUIT ("CC") SCHEDULE INDICATOR. REFER
1	TO ONE-LINE DIAGRAM.
(HC)	ADA ACCESS PUSH PLATE
<sup>13</sup> D	JUNCTION BOX.
<sup>14</sup> D <sub>SC</sub>	JUNCTION BOX, SYSTEMS FURNITURE COMMUNICATION CONNECTION.
<sup>15</sup> Ø <sub>SE</sub>	JUNCTION BOX, SECURITY SYSTEM. PROVIDE CONDUIT AND ROUGH-IN PER SECURITY DRAWINGS.
<sup>18</sup> РВ	PULL BOX.
21	
<u>_</u> 22	EARTH GROUND (ONE-LINE DIAGRAM).
<sup>23</sup>	JUNCTION BOX, CEILING.
	LADDER RACK.
<sup>25</sup>	MECHANICAL EQUIPMENT CONNECTION. REFER TO EQUIPMEN SCHEDULE FOR REQUIREMENTS.
	AL POWER AND DISTRIBUTION
	FUSE WITH RATING (ONE-LINE DIAGRAM).
<sup>02</sup> ၂	
	DISCONNECT, FUSED (ONE-LINE DIAGRAM).
03	DISCONNECT, NONFUSED (ONE-LINE DIAGRAM).
07	
Ċ	CIRCUIT BREAKER, MOLDED CASE (ONE-LINE DIAGRAM).
08	
	CIRCUIT BREAKER, MOLDED CASE WITH SHUNT TRIP (ONE-LINE DIAGRAM).
10	
	CIRCUIT BREAKER, SOLID STATE (ONE-LINE DIAGRAM).
	CIRCUIT BREAKER, SOLID STATE WITH GROUND FAULT
GFP	PROTECTION (ONE-LINE DIAGRAM).
16 []]]	
m	TRANSFORMER (ONE-LINE DIAGRAM).
22	
"1H"	PANELBOARD (ONE-LINE DIAGRAM).
23	
225/3 "1H"	PANELBOARD WITH MAIN LUGS ONLY. BUS SIZE AND PHASE AS
	SHOWN (ONE-LINE DIAGRAM).
24	
225/3	PANELBOARD WITH MAIN CIRCUIT BREAKER. SIZE AND PHASE
"1H"	AS SHOWN (ONE-LINE DIAGRAM).
25	
)225/3 "1H"	
	PANELBOARD WITH MAIN AND SUB FEED CIRCUIT BREAKER (ONE-LINE DIAGRAM).
60/3	
26	
225/3	
╡ ╺ ╺ ┺ ┨	PANELBOARD WITH MAIN LUGS ONLY AND SURGE PROTECTION WITH CIRCUIT BREAKER (ONE-LINE DIAGRAM).
25/3	
STRUCTUR	ED CABLING IHC
<sup>01</sup> $\nabla$	IHC COMMUNICATIONS DEVICE (1 DATA).
<sup>02</sup>	IHC COMMUNICATIONS DEVICE (1 DATA / 1 ANALOG).
03	IHC COMMUNICATIONS DEVICE (1 DATA WALL PHONE).
04 <b>V</b>	IHC COMMUNICATIONS DEVICE (2 DATA).
05 <b>▼</b> 3	
06	IHC COMMUNICATIONS DEVICE (3 DATA).
<b>▼</b> <sup>4</sup>	IHC COMMUNICATIONS DEVICE (4 DATA).
00	IHC COMMUNICATIONS DEVICE (6 DATA).
<sup>08</sup> ∇M	IHC COMMUNICATIONS DEVICE PHYSIOLOGICAL MONITOR (1 DATA).
<sup>09</sup> <b>▼</b> WAP	IHC COMMUNICATIONS DEVICE WIRELESS ACCESS POINT (2 DATA).
01 HC	CLOCK.
	CLOCK, SURFACE WITH WIRE GUARD.
G	

4

	SYMBOL	SYMBOLS LEGEND
		AL POWER AND DISTRIBUTION
	30	CT CABINET PER UTILITY'S REQUIREMENTS (ONE-LINE DIAGRAM).
R OF D MBERS. LL BE		TRANSFER SWITCH (ONE-LINE DIAGRAM).
THE NOF		DIGITAL MULTIMETER (ONE-LINE DIAGRAM).
D MBERS.	<sup>33</sup> ⊷Ų lu	SERVICE ENTRANCE SURGE PROTECTION (ONE-LINE DIAGRAM).
RS, ANCES	<sup>35</sup> G	GENERATOR, POWER (ONE-LINE DIAGRAM).
	36 M	METER. VARIABLE FREQUENCY MOTOR CONTROLLER (ONE-LINE
ECALL	ŬFC VFD 41 ☑∽	DIAGRAM).
ER CONDUIT ID		DISCONNECT SWITCH, FUSED.
PHONE /ISION	43 <b>X</b> 1	STARTER, COMBINATION WITH DISCONNECT SWITCH.
AND	44	STARTER OR MOTOR CONTROLLER.
	45	PUSHBUTTON.
IARK.	46 •	PUSHBUTTONS, MOTOR CONTROL.
	48	PANELBOARD CABINET, FLUSH MOUNTED.
	49	PANELBOARD CABINET, SURFACE MOUNTED, 1 SECTION. PANELBOARD CABINET, SURFACE MOUNTED, 2 SECTION.
1	50	DISTRIBUTION PANEL OR SWITCHBOARD.
AND	DP#	DISTRIBUTION PANEL OR SWITCHBOARD.
	52	LIGHTING RELAY, CONTACTOR PANEL, OR DIMMING ENCLOSURE.
	53	LIGHTING CONTROL STATION. DIMMING ENTRY STATION OR CONTROL STATION, FLUSH
	55 \$ST	MOUNTED. SWITCH, TOGGLE MOTOR STARTER WITH OVERLOAD
JIPMENT	<sup>56</sup> 75	PROTECTION. TRANSFORMER: NUMBER INDICATES kVA.
	<sup>59</sup> – <del>\</del>	RELAY CONTACT, NORMALLY CLOSED (ONE-LINE DIAGRAM).
		RELAY CONTACT, NORMALLY OPEN (ONE-LINE DIAGRAM).
		SPECIALIZED TRANSFER SWITCH (ONE-LINE DIAGRAM).
	00	PHASE ROTATION MONITOR (ONE-LINE DIAGRAM).
	01 (W-3)	REFER TO FIXTURE SCHEDULE FOR SYMBOLS)
		FIXTURE IDENTIFICATION: (W-3) INDICATES FIXTURE TYPE AS SCHEDULED.
	02 (W-3)	FIXTURE IDENTIFICATION, EMERGENCY WITH BATTERY PACK, CONNECTED TO GENERATOR AS INDICATED: (W-3) INDICATES FIXTURE TYPE AS SCHEDULED.
	<sup>05</sup> ↑	EGRESS DIRECTION ARROW (EXIT SIGNS).
		EXIT SIGN: SINGLE FACE; CEILING MOUNTED
		EXIT SIGN: SINGLE FACE; WALL MOUNTED EXIT SIGN: DOUBLE FACE; CEILING MOUNTED
	10 <b>•</b>	EXIT SIGN: DOUBLE FACE; WALL MOUNTED
	03	OCCUPANCY SENSOR, DUAL TECHNOLOGY, OMNI-DIRECTIONAL, CEILING.
		OCCUPANCY SENSOR, DUAL TECHNOLOGY, DIRECTIONAL.
IASE AS	07	OMNI-DIRECTIONAL, CEILING. VACANCY SENSOR, DUAL TECHNOLOGY, WALL.
	08 (P)	PHOTOCELL.
PHASE	<sup>09</sup> <b>т</b> с	TIME CLOCK.
	HR 1	HOUSE RELAY SCHEDULE INDICATOR.
KER	101 1-1-1	LITE TOUCH STATION INDICATOR.
	\$	SWITCH/OCCUPANCY SENSOR COMBO, DUAL TECHNOLOGY, WALL. SWITCH/VACANCY SENSOR COMBO, DUAL TECHNOLOGY, WALL.
	15 \$	DIMMER SWITCH/OCCUPANCY SENSOR COMBO, DUAL TECHNOLOGY, WALL.
ECTION	17 <b>•</b>	DIMMER SWITCH/VACANCY SENSOR COMBO, DUAL TECHNOLOGY, WALL.
	<sup>18</sup> a,b ≸	LOW VOLTAGE DIGITAL LIGHTING CONTROL SWITCH: LETTER "a,b" INDICATES ZONING WHERE SHOWN (REFER TO PLANS, SCHEDULES, AND DETAILS FOR EXACT BUTTON CONFIGURATION
	<sup>19</sup> DC	AND PROGRAMMING REQUIREMENTS) DIGITAL LIGHTING DIMMING CONTROLLER
	20 LC	DIGITAL PLUG LOAD CONTROLLER
	23 RC	DIGITAL LIGHTING ROOM CONTROLLER
	25 SM	LIGHTING NETWORK SEGMENT MANAGER
		LIGHTING SPACE CONTROL TYPE. X INDICATES TYPE. SEE SCHEDULE / DIAGRAM.
	оо ССТV	CCTV CABLE, POWER.
)R	02V	CCTV CABLE, POWER.
IT (2		CCTV HEADEND EQUIPMENT.
	04 M	CCTV MONITOR.
		CCTV CAMERA/ENCLOSURE WITH LENS, TYPICAL. SEE SCHEDULE.
	06 PTZ	CCTV CAMERA WITH PAN, TILT AND ZOOM.
	360°	PANNING CAMERA TRANSVERSE ANGLE.

	SYMBOLS LEGEND
SYMBOL	DESCRIPTION
	M
01 FSA	FIRE SYSTEM ANNUNCIATOR.
07 FCP	FIRE ALARM CONTROL PANEL, SEMI-RECESSED.
ой <u>СМ</u>	CONTROL MODULE.
09	MONITOR MODULE.
10 P	FIRE ALARM MANUAL PULL STATION.
R	SHUT DOWN RELAY: INSTALL RELAY IN CONTROL CIRCUIT OF EQUIPMENT TO BE CONTROLLED IN THE EVENT OF A FIRE.
<sup>11</sup> ත	MAGNETIC DOOR HOLDER.
15	DETECTOR, SMOKE.
<sup>19</sup> <b>2</b> <sub>E</sub>	DETECTOR, SMOKE, ELEVATOR RECALL DESIGNATION.
22	DETECTOR, SMOKE, DUCT WITH HOUSING AND SAMPLING TUBE.
25	STROBE.
<sup>26</sup> X 75	STROBE. SUBSCRIPT INDICATES CANDELA RATING.
$\mathbb{X}^{28}$	ALARM, HORN/STROBE, ONE ASSEMBLY.
<sup>29</sup> X 75	ALARM, HORN/STROBE, ONE ASSEMBLY. SUBSCRIPT INDICATES CANDELA RATING.
<sup>30</sup> X c	ALARM, CHIME/STROBE, ONE ASSEMBLY.
34 E	SPEAKER, EVACUATION.
35 E	SPEAKER, EVACUATION, COMBINATION STROBE.
$\diamond$	DETECTOR, FLOW SWITCH: FLOW SWITCHES SHALL BE PROVIDED AND INSTALLED WITH FIRE SPRINKLER SYSTEM AND SHALL BE CONNECTED TO LOCATIONS SHOWN ON THE FIRE SPRINKLER SHOP DRAWINGS.
36 Ø¥	DETECTOR, TAMPER SWITCH WITH VALVE: TAMPER SWITCHES SHALL BE PROVIDED AND INSTALLED WITH FIRE SPRINKLER SYSTEM AND SHALL BE CONNECTED TO LOCATIONS SHOWN ON THE FIRE SPRINKLER SHOP DRAWINGS.
37 SD	SMOKE DAMPER.
38 Ø FSD	FIRE AND SMOKE DAMPER.
<sup>42</sup> <b>⊳⊗⊲</b> 75	ALARM, HORN/STROBE, ONE ASSEMBLY, CEILING MOUNTED. SUBSCRIPT INDICATES CANDELA RATING.
<sup>43</sup> DO 75	ALARM, HORN, CEILING MOUNTED. SUBSCRIPT INDICATES CANDELA RATING.
44 🛞 75	ALARM, STROBE, CEILING MOUNTED. SUBSCRIPT INDICATES CANDELA RATING.
	OGY SYSTEMS
01	TECHNOLOGY SYSTEM CABLE. SEE SPECIFIC JOB EQUIPMENT LIST FOR APPLICABLE DESIGNATIONS.
	EXAMPLES: C = CONTROL CABLE
_x	G = GROUND CABLE, 10 AWG, 1 CONDUCTOR, GREEN INSULATED M = MICROPHONE CABLE S = SPEAKER CABLE, 70 VOLT SYSTEM Z = SPEAKER CABLE, 8 OHM SYSTEM
<sup>02</sup> (\$) <sub>#</sub>	SPEAKER, CEILING MOUNTED.
21	EQUIPMENT CABINET.
22	MEDIA CONNECTION PLATE.
23	AUDIO/VISUAL OUTLET.
24	SCREEN, PROJECTION, CEILING MOUNTED.
25	PROJECTOR, CEILING MOUNTED.
26 V	VIDEO CONFERENCING CAMERA.
<sup>35</sup> (V)	VOLUME CONTROL.
55 PA	AMPLIFIER (ONE-LINE DIAGRAM).
56 PB	POWER BRIDGE (VARIZONE DIGITAL PAGING SYSTEM).
<sup>57</sup>	TERMINATOR (VARIZONE DIGITAL PAGING SYSTEM).
NURSE CAI	-L
01 D	JUNCTION BOX.
02	CORRIDOR LIGHT.
03 <b>F</b>	BATHROOM PULL CORD STATION.
04 <b>D</b>	DUTY STATION.
05 <b>E</b>	EMERGENCY ASSISTANCE CALL STATION.
06 <b>€</b> CB	EMERGENCY ASSISTANCE CODE BLUE CALL STATION.
07 <b>P</b>	PATIENT STATION.
	STAFF STATION.
NCM	TOUCH SCREEN NURSE CALL MASTER STATION.
10 ZLC	ZONE LIGHT CONTROLLER.
CU	NURSE CALL AREA CONTROL UNIT & POWER SUPPLIES.
SECURITY	SECURITY CABLE. SEE EQUIPMENT SCHEDULE FOR CABLE
02	TYPE.
	ACCESS CONTROL HEADEND EQUIPMENT.
CTR 04	
05 #1	INTRUSION DETECTION HEADEND EQUIPMENT. CARD ACCESS DOOR TYPE #1 OR AS NOTED. SEE
06 CR >	SCHEDULE.
09	EXIT REQUEST.
<sup>™</sup> ® <sub>ER</sub>	REMOTE DOOR RELEASE BUTTON.
21 (P)	PANIC DURESS SWITCH.

	SYMBOLS LEGEND
SYMBOL	DESCRIPTION
TV DISTRIB	BUTION
01T	TV DISTRIBUTION CABLE, INDIVIDUAL DROPS.
02-TR	TV DISTRIBUTION CABLE, TRUNK.
CMB	COMBINER.
DC	DIRECTIONAL COUPLER.
DA	DISTRIBUTION AMPLIFIER (ONE-LINE DIAGRAM).
SPL	SPLITTER (ONE-LINE DIAGRAM).
07	TV OUTLET.
<sup>10</sup> -⁄WV-	TERMINATOR, 75 OHM (TV DISTRIBUTION).

# ABBREVIATIONS

	NOTE: ALL ABBREVIAT	IONS MAY	Y NOT BE USED.
1P	SINGLE POLE	kV	KILOVOLT
1PH	SINGLE-PHASE	kVA	KILOVOLT AMPERE
1WAY	ONE-WAY	kVAR	KILOVOLT AMPERE REACTIVE
2/C 2WAY	TWO-CONDUCTOR TWO-WAY	kW kWh	KILOWATT KILOWATT HOUR
2/VA1 3/C	THREE-CONDUCTOR		LIGHT EMITTING DIODE
3WAY	THREE-WAY	LFMC	LIQUID TIGHT FLEXIBLE META
40UT	QUADRUPLE RECEPTACLE		CONDUIT
	OUTLET	LFNC	LIQUID TIGHT FLEXIBLE NONMETALLIC CONDUIT
4PDT 4PST	FOUR-POLE DOUBLE THROW FOUR-POLE SINGLE THROW	LPS	LOW PRESSURE SODIUM
4P31 4W	FOUR-POLE SINGLE THROW FOUR-WIRE	LRA	LOCKED ROTOR AMPS
4WAY	FOUR-WAY	LTG	LIGHTING
А	ABOVE COUNTER	LV	LOW VOLTAGE
AC	ARMORED CABLE	MATV	MASTER ANTENNA TELEVISIC SYSTEM
ADA	AMERICANS WITH DISABILITIES	мах	MAXIMUM
ADJ	ADJACENT	MC	METAL CLAD
AFF	ABOVE FINISHED FLOOR	MCA	MINIMUM CIRCUIT AMPS
AFG	ABOVE FINISHED GRADE	MCB	MAIN CIRCUIT BREAKER
AIC	AMPERE INTERRUPTING	MCC	MOTOR CONTROL CENTER
ALUM	CAPACITY ALUMINUM	MCP MDP	MOTOR CIRCUIT PROTECTION MAIN DISTRIBUTION PANEL
AMP	AMPERE	MG	MOTOR GENERATOR
ANN	ANNUNCIATOR	МН	MANHOLE
AP	ACCESS POINT (WIRELESS	MIN	MINIMUM
AR	DATA) AS REQUIRED	MLO	
ASC	AMPS SHORT CIRCUIT	MOCP	MAXIMUM OVERCURRENT PROTECTION
ATS	AUTOMATIC TRANSFER	MTS	MANUAL TRANSFER SWITCH
	SWITCH	NA	NOT APPLICABLE
AV		NC	NORMALLY CLOSED
AWG BB	AMERICAN WIRE GAGE BUCK-BOOST TRANSFORMER	NEC NEMA	NATIONAL ELECTRICAL CODE NATIOANL ELECTRICAL
XFMR			MANUFACTURERS
С	CEILING MOUNTED		ASSOCIATION
CATV	COMMUNITY ANTENNA TELEVISION	NFC	NATIONAL FIRE CODE
СВ	CIRCUIT BREAKER	NFPA	NATIONAL FIRE PROTECTION ASSOCIATION
CCBA	CUSTOM COLOR AS SELECTED	NIC	NOT IN CONTRACT
	BY ARCHITECT	NL	NIGHT LIGHT
CCTV		NO	NORMALLY OPEN
CF/CI	CONTRACTOR FURNISHED/ CONTRACTOR INSTALLED	NTS OC	NOT TO SCALE ON CENTER
CF/OI	CONTRACTOR FURNISHED/	OC	OVER CURRENT PROTECTION
0554	OWNER INSTALLED	OF/CI	OWNER FURNISHED/
CFBA	CUSTOM FINISH AS SELECTED BY ARCHITECT		CONTRACTOR INSTALLED
СКТ	CIRCUIT	OF/OI	OWNER FURNISHED/ OWNER INSTALLED
CM	CONSTRUCTION MANAGER	OFP	OBTAIN FROM PLANS
CND	CONDUIT	OH DR	OVERHEAD (COILING) DOOR
CO COR	CONVENIENCE OUTLET CONTRACTING OFFICER'S	OL	OVERLOAD
COR	REPRESENTATIVE	PB	PUSHBUTTON
CP	CONTROL PANEL	PF PH	POWER FACTOR PHASE
СТ	CURRENT TRANSFORMER	PNL	PANEL
CTV CU	CABLE TELEVISION COPPER	PT	POTENTIAL TRANSFORMER
dBA	UNIT OF SOUND LEVEL	PTZ	PAN/TILT/ZOOM
DPDT	DOUBLE POLE, DOUBLE	QTY	QUANTITY
	THROW	R RCP	REMOVE REFLECTED CEILING PLAN
DS	DISCONNECT SWITCH	RMC	RIGID METAL CONDUIT
EA EM	EACH EMERGENCY	RNC	RIGID NONMETAL CONDUIT
EMT	ELECTRICAL METALLIC TUBING	RPM	REVOLUTIONS PER MINUTE
ENT	ELECTRIC NONMETALLIC	RR	REMOVE AND RELOCATE
	TUBING	S/S SCA	START/STOP SHORT CIRCUIT AMPS
EPO EQUIP	EMERGENCY POWER OFF EQUIPMENT	SCA	STANDARD COLOR AS
EQUIP	EXISTING		SELECTED BY ARCHITECT
F	FURNITURE MOUNTED	SF	SQUARE FOOT (FEET)
FA	FIRE ALARM	SFBA	STANDARD FINISH AS SELECTED BY ARCHITECT
FCP	FIRE ALARM CONTROL PANEL	SPD	SURGE PROTECTIVE DEVICE
FLA FMC	FULL LOAD AMPS FLEXIBLE METAL CONDUIT	SPDT	SINGLE POLE, DOUBLE THRO
FOB	FREIGHT ON BOARD	SPEC	SPECIFICATION
FVNR	FULL VOLTAGE	SPST ST	SINGLE POLE, SINGLE THROV SINGLE THROW
5.6	NON-REVERSING	SWBD	SWITCHBOARD
FVR G	FULL VOLTAGE REVERSING GROUND	SWGR	SWITCHGEAR
GEN	GENERATOR	TL	TWIST LOCK
GFCI	GROUND FAULT INTERRUPTER	TP	TELEPHONE POLE
GFP	GROUND FAULT PROTECTION	TP TTB	TWISTED PAIR TELEPHONE TERMINAL BOAR
HD		TV	TELEPHONE TERMINAL BOAR
HID HOA	HIGH INTENSITY DISCHARGE HAND-OFF-AUTOMATIC	TVSS	TRANSIENT VOLTAGE SURGE
HP	HAND-OFF-AUTOMATIC HORSE POWER	<b>.</b>	SUPPRESSER
HPF	HIGH POWER FACTOR	TYP UF	TYPICAL UNDERFLOOR
HPS	HIGH PRESSURE SODIUM		UNDERFLOOR
HV	HIGH VOLTAGE	UPS	UNINTERRUPTIBLE POWER
HZ I/O	HERTZ INPUT/ OUTPUT		SUPPLY
I/O IG	ISOLATED GROUND		VOLTS VOLT AMPERE
IMC	INTERMEDIATE METAL	VA VFC/VF	
N// C		D	CONTROLLER
IN/IS IR	INSULATED/ ISOLATED	W/	WITH
J-BOX	JUNCTION BOX	W/O WP	
	-	XFMR	WEATHERPROOF TRANSFORMER

# GENERAL ELECTRICAL NOTES

- CLARIFICATION METHODS: AT THE TIME OF BIDDING, BIDDERS SHALL FAMILIARIZE THEMSELVES WITH THE DRAWINGS AND SPECIFICATIONS. ANY QUESTIONS, MISUNDERSTANDINGS, CONFLICTS, DELETIONS, DISCONTINUED PRODUCTS, CATALOG NUMBER DISCREPANCIES, DISCREPANCIES BETWEEN THE EQUIPMENT SUPPLIED AND THE INTENT OR FUNCTION OF THE EQUIPMENT, ETC, SHALL BE SUBMITTED TO THE ARCHITECT/ENGINEER IN WRITING FOR CLARIFICATION PRIOR TO ISSUANCE OF THE FINAL ADDENDUM AND BIDDING OF THE PROJECT. WHERE DISCREPANCIES OR MULTIPLE INTERPRETATIONS OCCUR, THE MOST STRINGENT (WHICH IS GENERALLY RECOGNIZED AS THE MOST COSTLY) THAT MEETS THE INTENT OF THE DOCUMENTS SHALL BE ENFORCED.
- OWNER FURNISHED ITEMS: THE OWNER WILL FURNISH MATERIAL AND EQUIPMENT AS INDICATED IN THE CONTRACT DOCUMENTS TO BE INCORPORATED INTO THE WORK. THESE ITEMS ARE ASSIGNED TO THE INSTALLER AND COSTS FOR RECEIVING, HANDLING, STORAGE, IF REQUIRED, AND INSTALLATION ARE INCLUDED IN THE CONTRACT SUM.
- A. THE INSTALLER'S RESPONSIBILITIES ARE THE SAME AS IF THE INSTALLER FURNISHED THE MATERIALS OR EQUIPMENT.
- THE OWNER WILL ARRANGE AND PAY FOR DELIVERY OF OWNER Β. FURNISHED ITEMS FREIGHT ON BOARD JOB SITE AND THE INSTALLER WILL INSPECT DELIVERIES FOR DAMAGE. IF OWNER FURNISHED ITEMS ARE DAMAGED, DEFECTIVE OR MISSING, DOCUMENT DAMAGED ITEMS WITH THE TRANSPORT COMPANY AND THE OWNER WILL ARRANGE FOR REPLACEMENT. THE OWNER WILL ALSO ARRANGE FOR MANUFACTURER'S FIELD SERVICES, AND THE DELIVERY OF MANUFACTURER'S WARRANTIES AND BONDS TO THE INSTALLER.
- C. THE INSTALLER IS RESPONSIBLE FOR DESIGNATING THE DELIVERY DATES OF OWNER FURNISHED ITEMS AND FOR RECEIVING, UNLOADING AND HANDLING OWNER FURNISHED ITEMS AT THE SITE. THE INSTALLER IS RESPONSIBLE FOR PROTECTING OWNER FURNISHED ITEMS FROM DAMAGE, INCLUDING DAMAGE FROM EXPOSURE TO THE ELEMENTS, AND TO REPAIR OR REPLACE ITEMS DAMAGED AS A RESULT OF HIS OPERATIONS.
- EXPOSED STRUCTURE AREAS (EXCLUDING MECHANICAL, ELECTRICAL, AND COMMUNICATION SPACES): INSTALL RACEWAYS BETWEEN DECK AND STRUCTURE WHEREVER POSSIBLE IN EXPOSED STRUCTURE CEILING AREAS. ROUTE RACEWAYS IN CONCEALED AREAS WHEREVER POSSIBLE. REFER ALL CONDITIONS WHERE RACEWAYS MUST BE INSTALLED WHICH CANNOT COMPLY WITH THESE REQUIREMENTS TO THE ARCHITECT.
- SUBMITTALS: PROVIDE ORIGINAL ELECTRONIC PDF FORMAT, BOUND, BOOKMARKED (EACH SECTION AND PRODUCT), AND HIGHLIGHTED. JOB NAME AND SUBCONTRACTOR SHALL BE ON THE FRONT COVER. PREPARE INDEX OF EQUIPMENT SUBMITTED IN EACH TAB.
- REFLECTED CEILING PLANS: COORDINATE THE LOCATION OF LIGHT FIXTURES WITH THE ARCHITECTURAL REFLECTED CEILING PLANS. REFER ALL DISCREPANCIES TO THE ARCHITECT AND ENGINEER.
- ALL WORK SHALL BE DONE ACCORDING TO THE CURRENT NATIONAL ELECTRIC CODE (NEC), IBC, NFPA, AND IFC. COMPLIANCE AND FINAL APPROVAL IS SUBJECT TO THE ON SITE FIELD INSPECTION OF THE AHJ.

## DEFINITIONS NOTE: ALL DEFINITIONS MAY NOT BE USED.

INDICATED: THE TERM "INDICATED" REFERS TO GRAPHIC REPRESENTATIONS, NOTES, OR SCHEDULES ON THE DRAWINGS, OTHER PARAGRAPHS OR SCHEDULES IN THE SPECIFICATIONS, AND SIMILAR REQUIREMENTS IN THE CONTRACT DOCUMENTS. WHERE TERMS SUCH AS "SHOWN". "NOTED". "SCHEDULED", AND "SPECIFIED" ARE USED, IT IS TO HELP THE READER LOCATE THE REFERENCE, NO LIMITATION ON LOCATION IS INTENDED.

DIRECTED: TERMS SUCH AS "DIRECTED", "REQUESTED", AUTHORIZED", "SELECTED", "APPROVED", "REQUIRED", AND "PERMITTED" MEAN "DIRECTED BY THE ENGINEER", "REQUESTED BY THE ENGINEER", AND SIMILAR PHRASES.

APPROVED: THE TERM "APPROVED", WHERE USED IN CONJUNCTION WITH THE ENGINEER'S ACTION ON THE CONTRACTOR'S SUBMITTALS, APPLICATIONS, AND REQUESTS, IS LIMITED TO THE ENGINEER'S DUTIES AND RESPONSIBILITIES AS STATED IN GENERAL AND SUPPLEMENTARY CONDITIONS.

FURNISH: THE TERM "FURNISH" IS USED TO MEAN "SUPPLY AND DELIVER TO THE PROJECT SITE, READY FOR UNLOADING, UNPACKING, ASSEMBLY, INSTALLATION, AND SIMILAR OPERATIONS."


INSTALL: THE TERM "INSTALL" IS USED TO DESCRIBE OPERATIONS AT PROJECT SITE INCLUDING THE ACTUAL "UNLOADING, UNPACKING, ASSEMBLY, ERECTION, PLACING, ANCHORING, APPLYING, WORKING TO DIMENSION, FINISHING, CURING, PROTECTING, CLEANING, AND SIMILAR OPERATIONS."


PROVIDE: THE TERM "PROVIDE" MEANS "TO FURNISH AND INSTALL, COMPLETE AND READY FOR THE INTENDED USE."


INSTALLER: AN "INSTALLER" IS THE CONTRACTOR OR AN ENTITY ENGAGED BY THE CONTRACTOR, EITHER AS AN EMPLOYEE, SUBCONTRACTOR, OR SUB-SUBCONTRACTOR, FOR PERFORMANCE OF A PARTICULAR CONSTRUCTION ACTIVITY, INCLUDING INSTALLATION, ERECTION, APPLICATION, AND SIMILAR OPERATIONS. INSTALLERS ARE REQUIRED TO BE EXPERIENCED IN THE OPERATIONS THEY ARE ENGAGED TO PERFORM.


TECHNOLOGY SYSTEMS: THE TERM "TECHNOLOGY SYSTEMS" IS USED TO DESCRIBE ALL LOW VOLTAGE SYSTEMS GENERALLY REFERRED TO AS "SPECIAL SYSTEMS". THESE SYSTEMS INCLUDE BUT ARE NOT NECESSARILY LIMITED TO ALL SYSTEMS WHICH UTILIZE VOLTAGES OF LESS THAN 71 VOLTS SUCH AS SOUND SYSTEMS, VIDEO SYSTEMS, TV SYSTEMS, SECURITY SYSTEMS, VOICE AND DATA CABLING SYSTEMS, ETC...


F	ELECTRICAL SHEET INDEX
EEA001	SHEET INDEX, ABBREVIATIONS, AND GENERAL NOTES
EEA100	LEVEL 4 OVERALL PLAN
EEA501	ELECTRICAL DETAILS
EEA701	TYPICAL MOUNTING HEIGHT DETAILS
EEA702	TYPICAL LABELING DETAILS
EDA101	LEVEL 4 ELECTRICAL DEMOLITION PLAN
EP100	BASEMENT POWER PLAN
EPA101	LEVEL 4 POWER PLAN
EPA102	
EPA601	ONE-LINE DIAGRAM
EPA602	ONE-LINE DIAGRAM
EPA603	EQUIPMENT SCHEDULE
EPA604	PANEL SCHEDULES
EPA605	PANEL SCHEDULES
EPA606	PANEL SCHEDULES
ELA101	LEVEL 4 LIGHTING PLAN
ELA601	INTERIOR LIGHTING FIXTURE SCHEDULE
ETA001	TELECOM SCHEDULES AND NOTES
ETA101	LEVEL 4 TELECOM FLOOR PLAN
ETA501	TELECOM EQUIPMENT RACK ELEVATIONS
ETA502	TELECOM DETAILS
ETA503	TELECOM DETAILS
ETA504	TELECOM EQUIPMENT RACK GROUNDING DETAILS
ETA601	TELECOM RISER DIAGRAMS
EYA101	LEVEL 4 AUXILIARY PLAN
EYA601	AUXILIARY SCHEDULES
FAA101	LEVEL 4 FIRE ALARM PLAN
FAA601	FIRE ALARM RISER

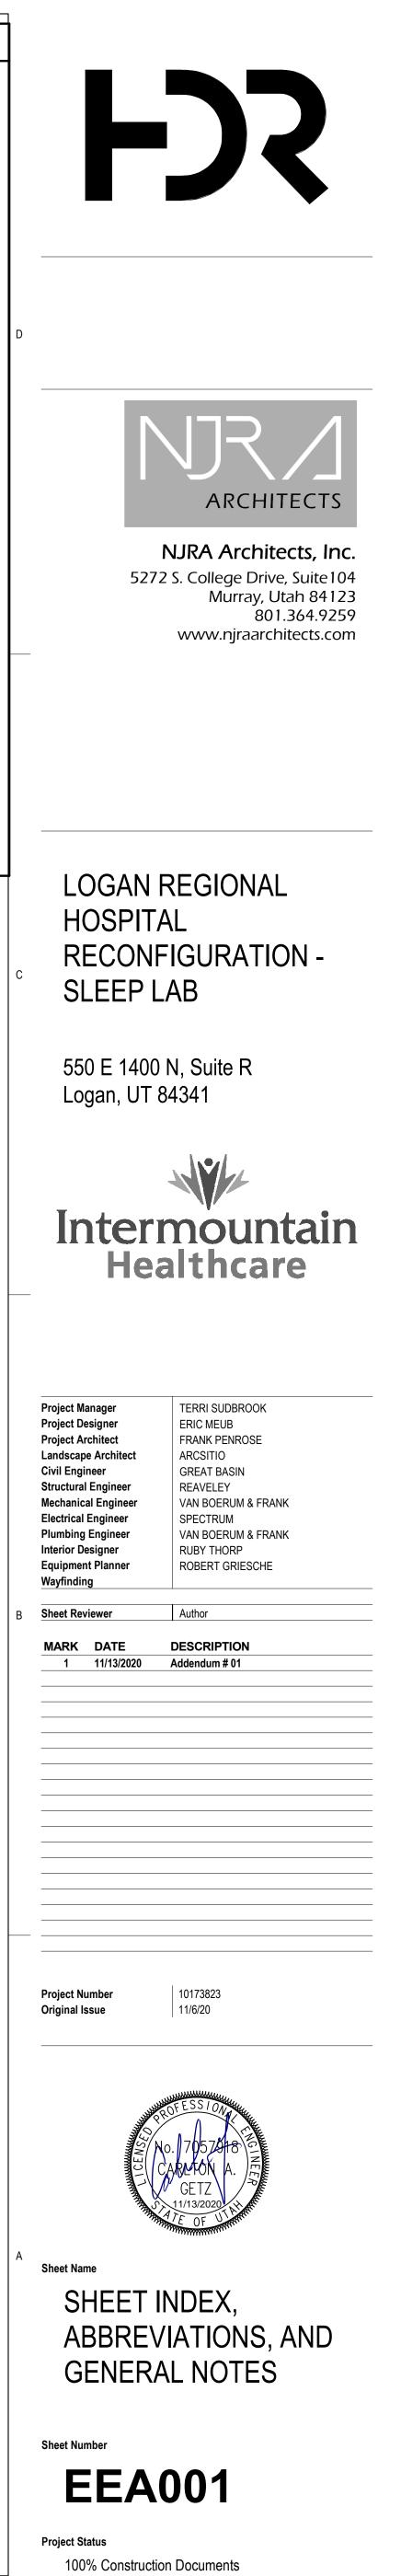

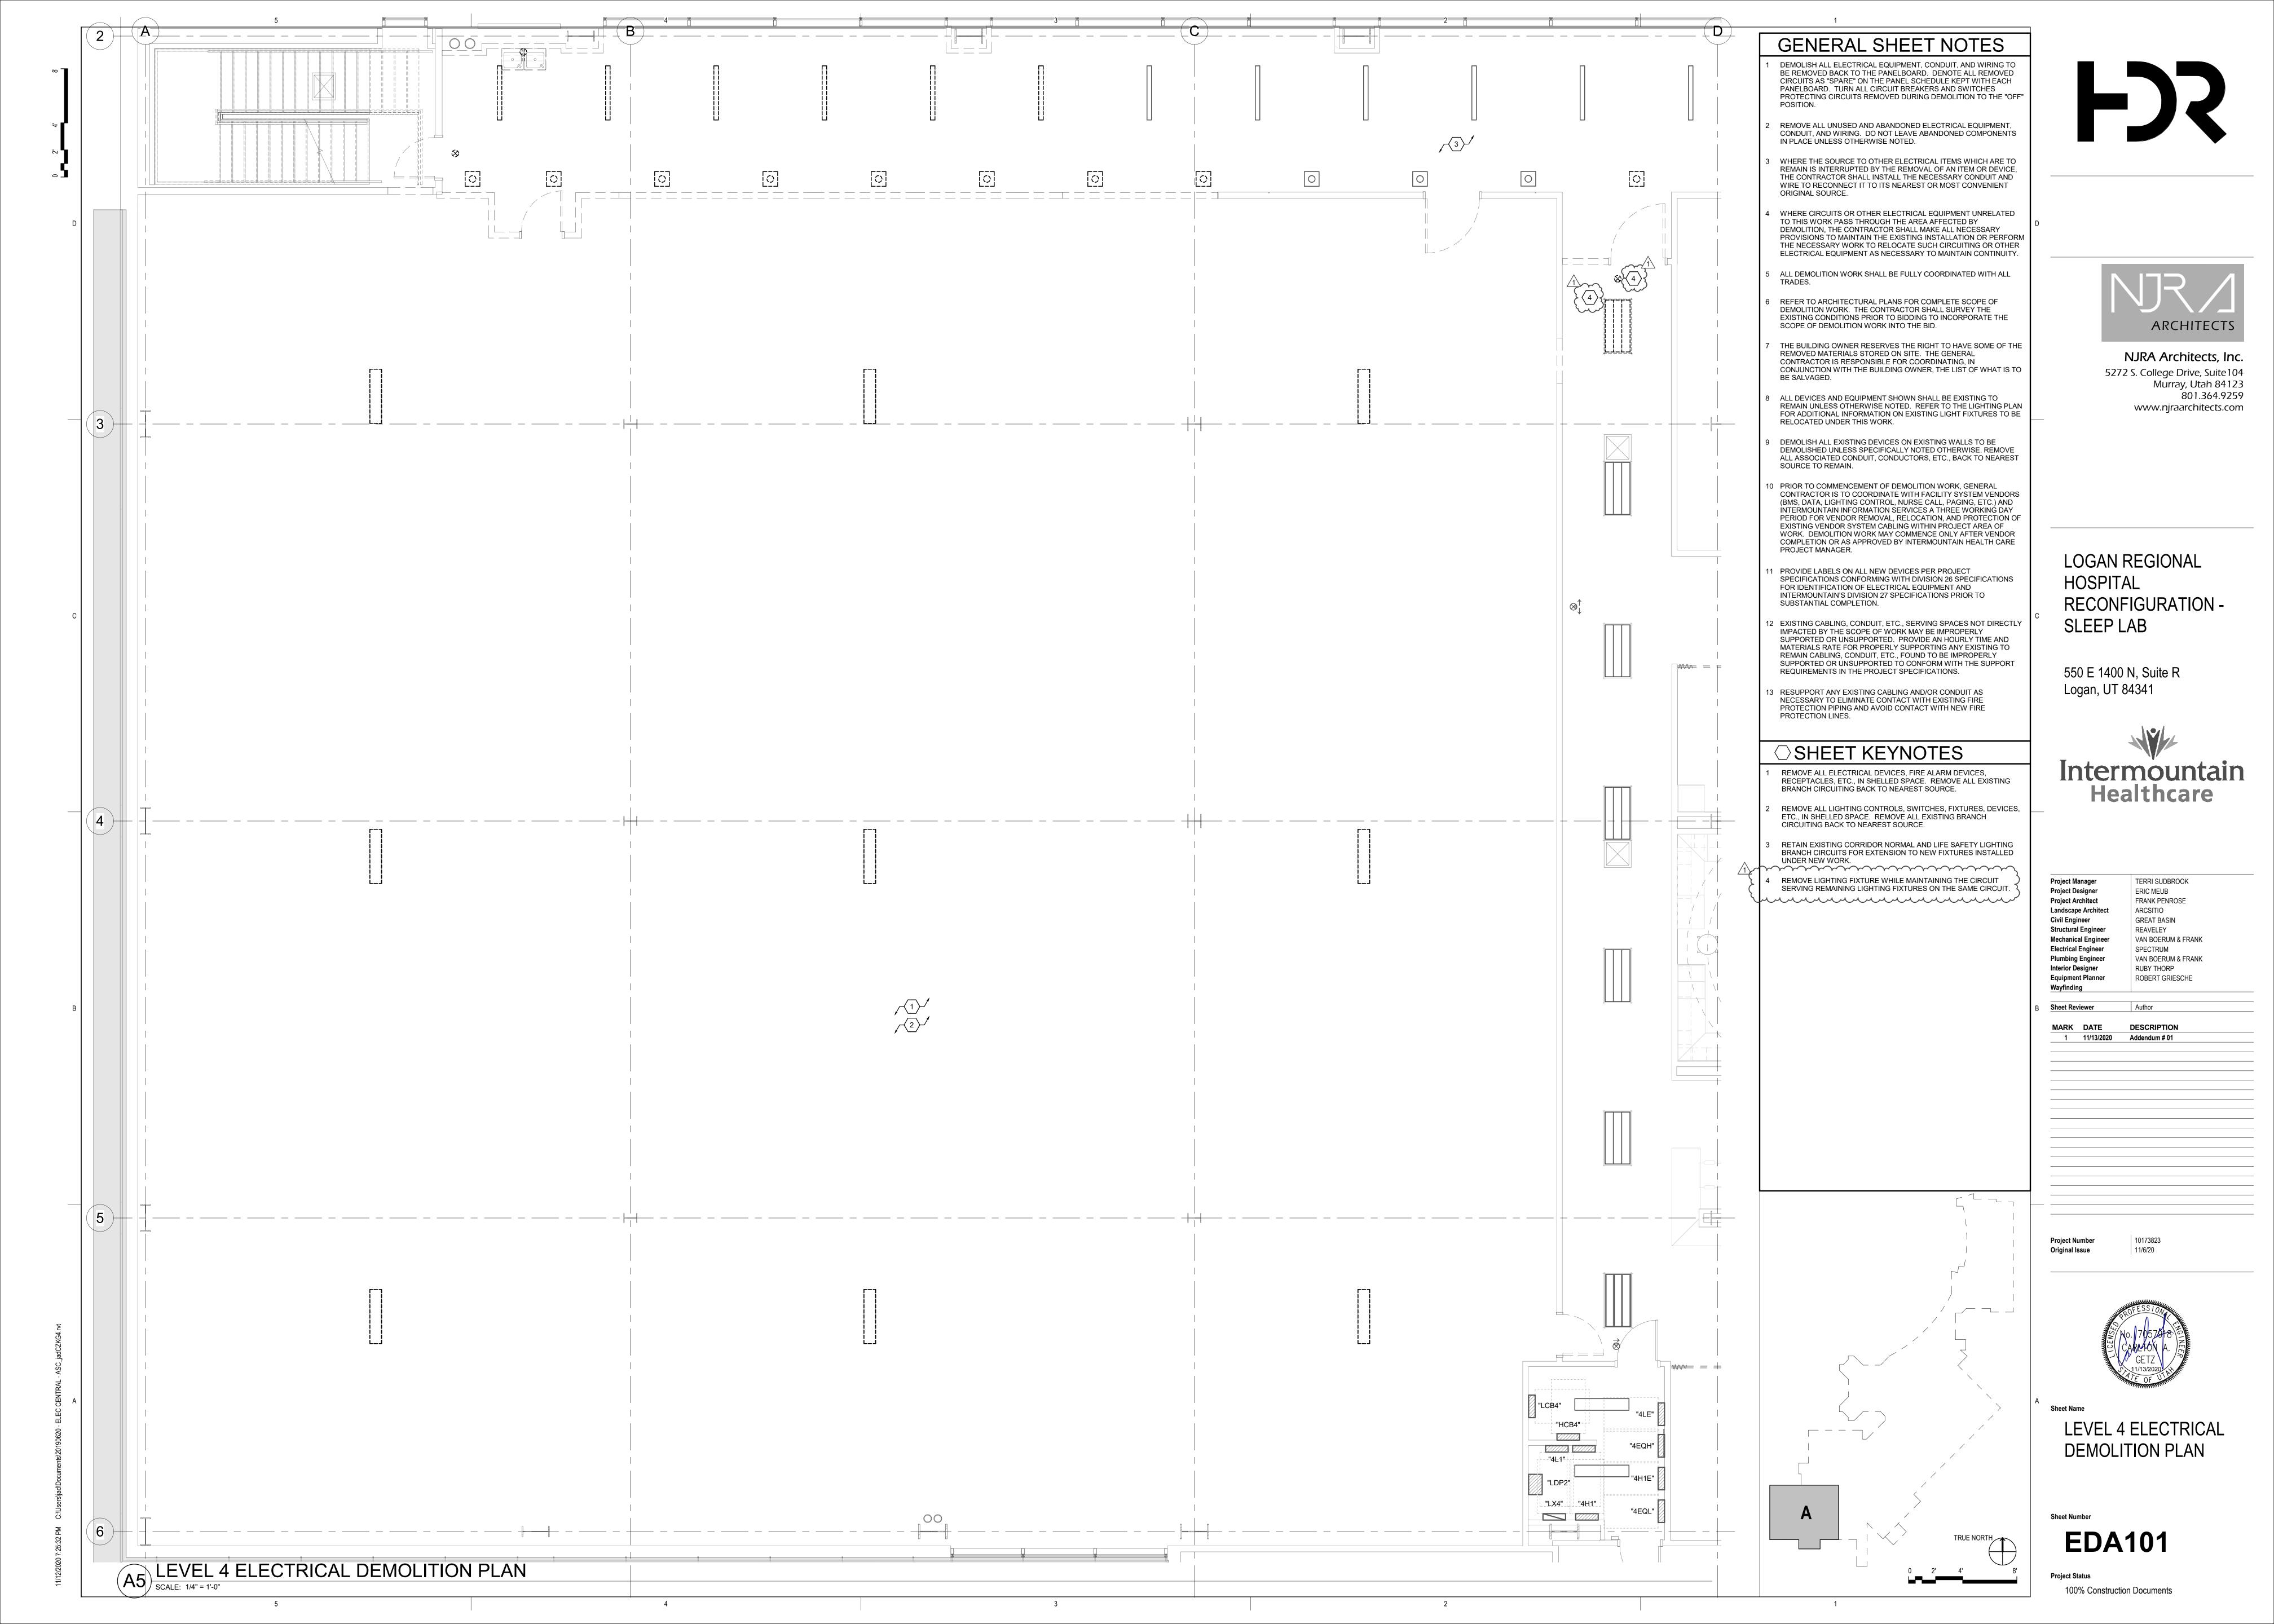


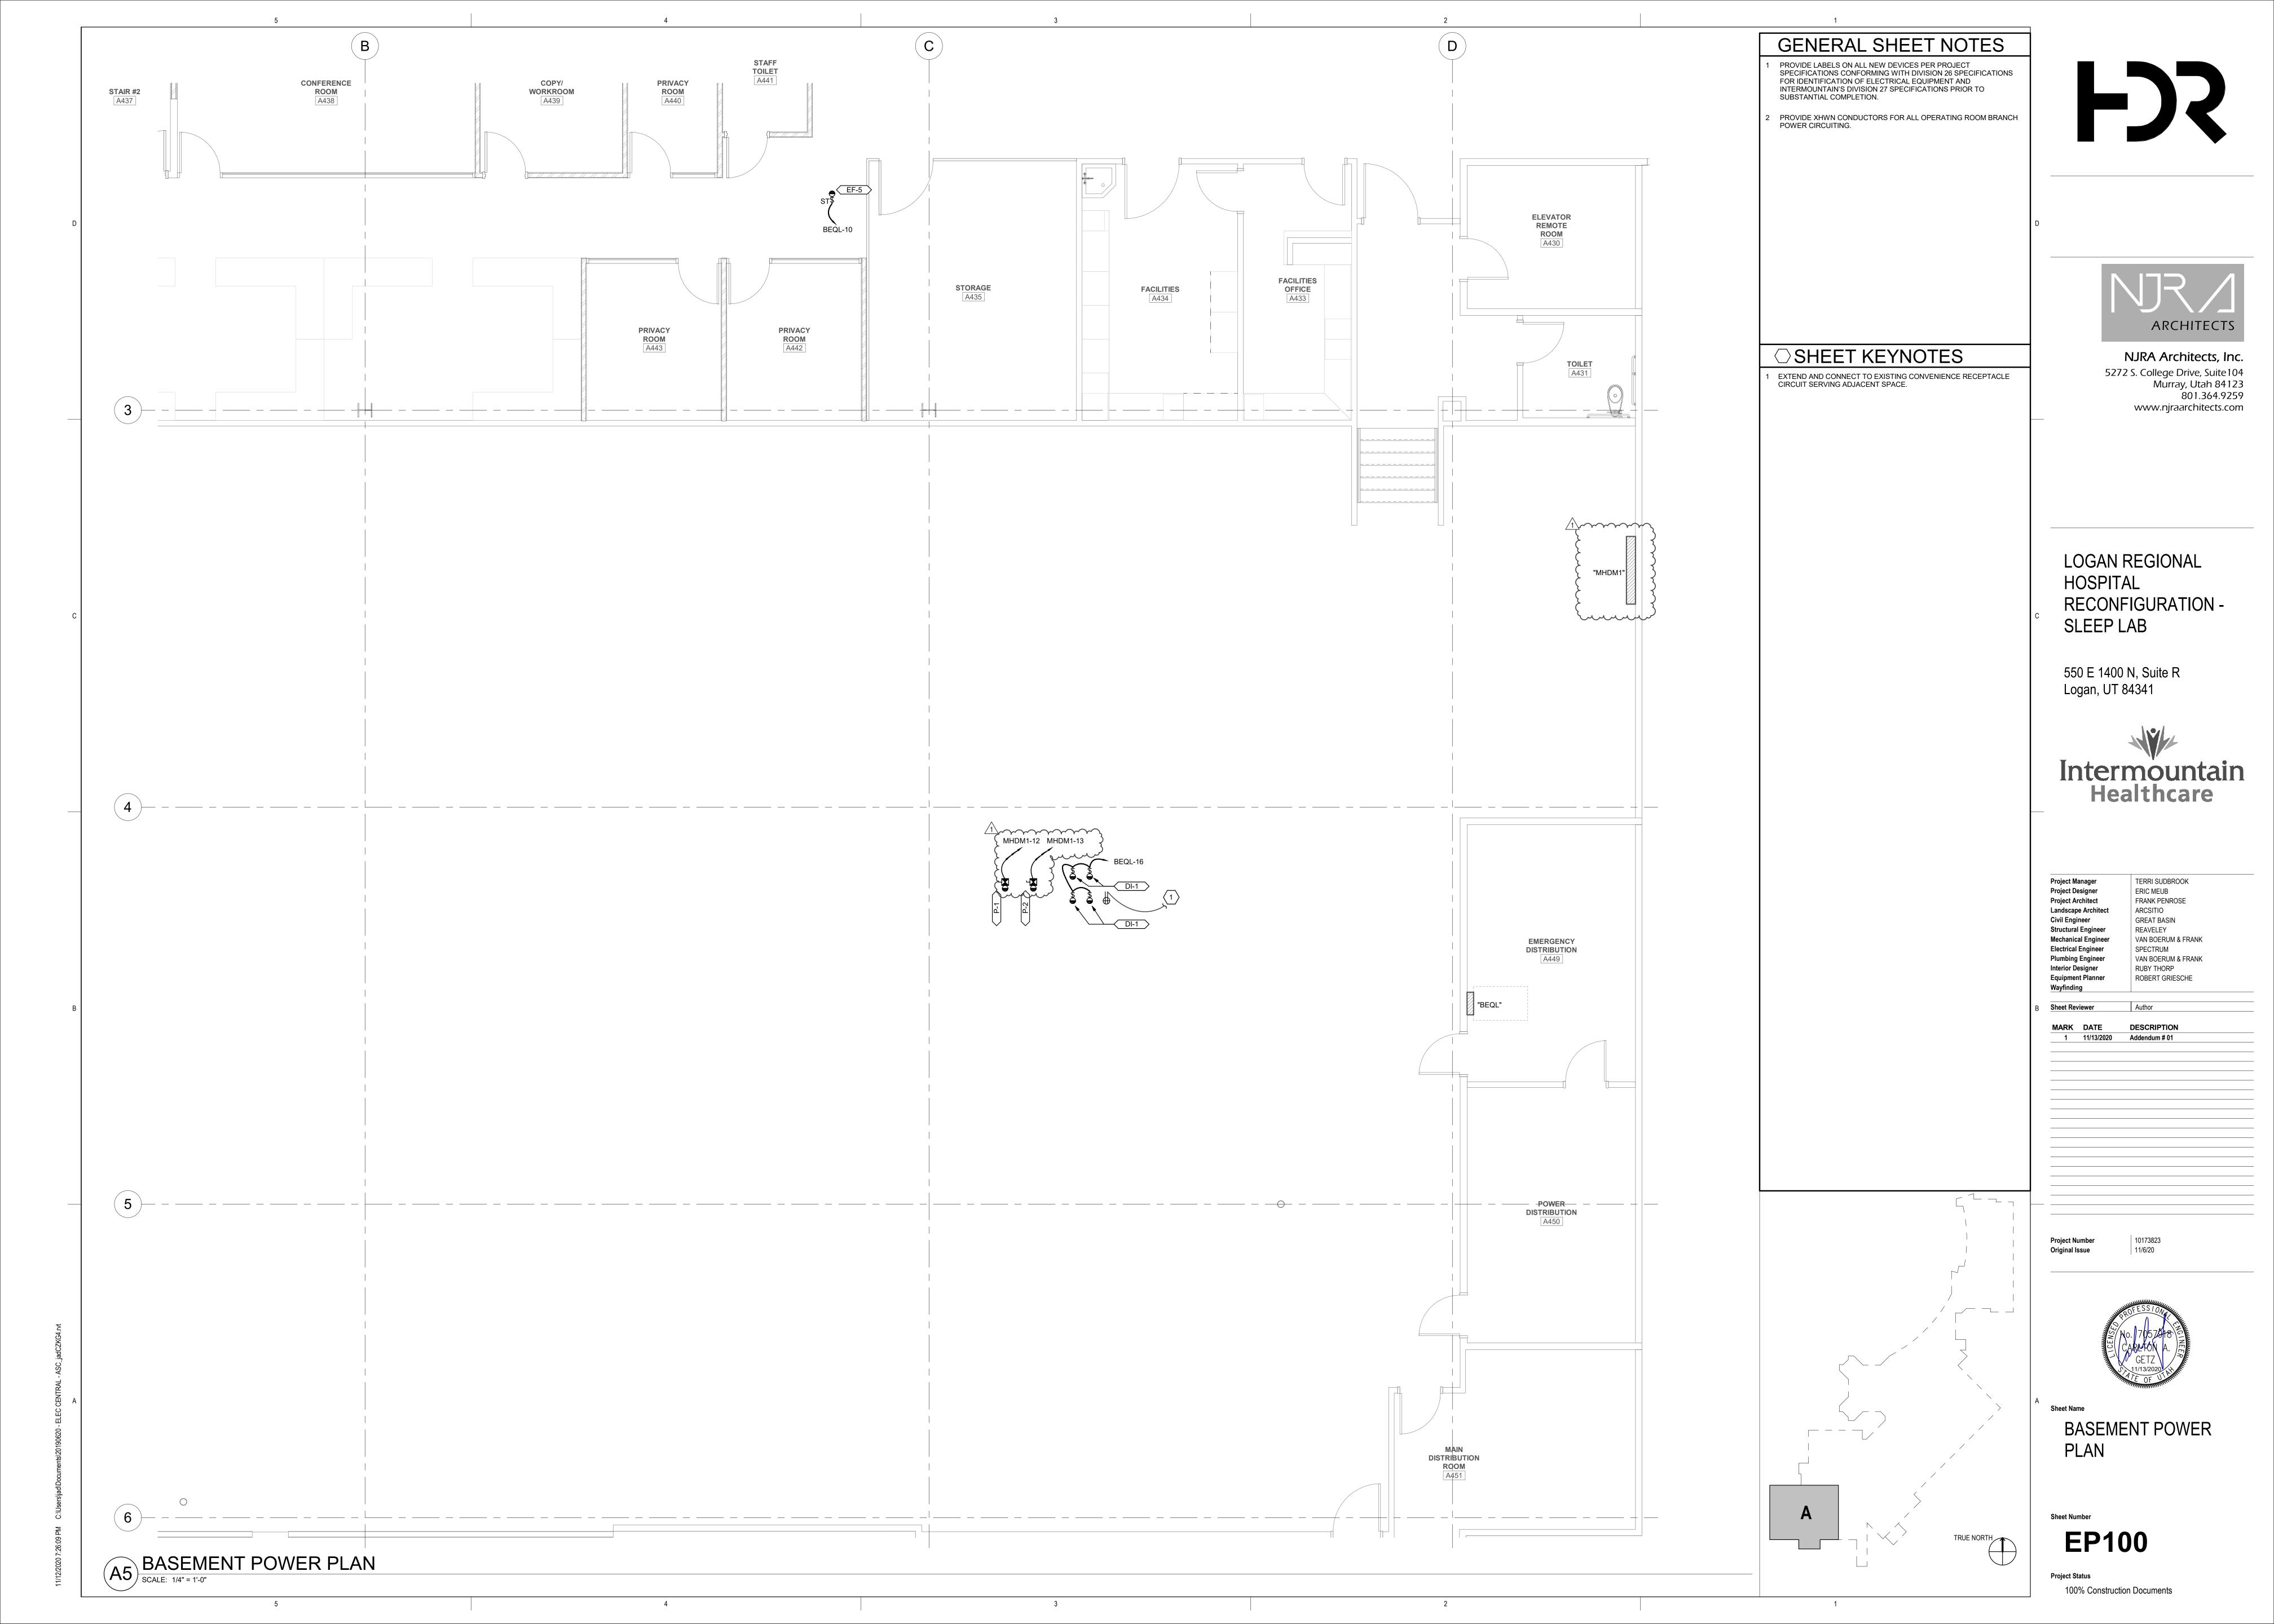

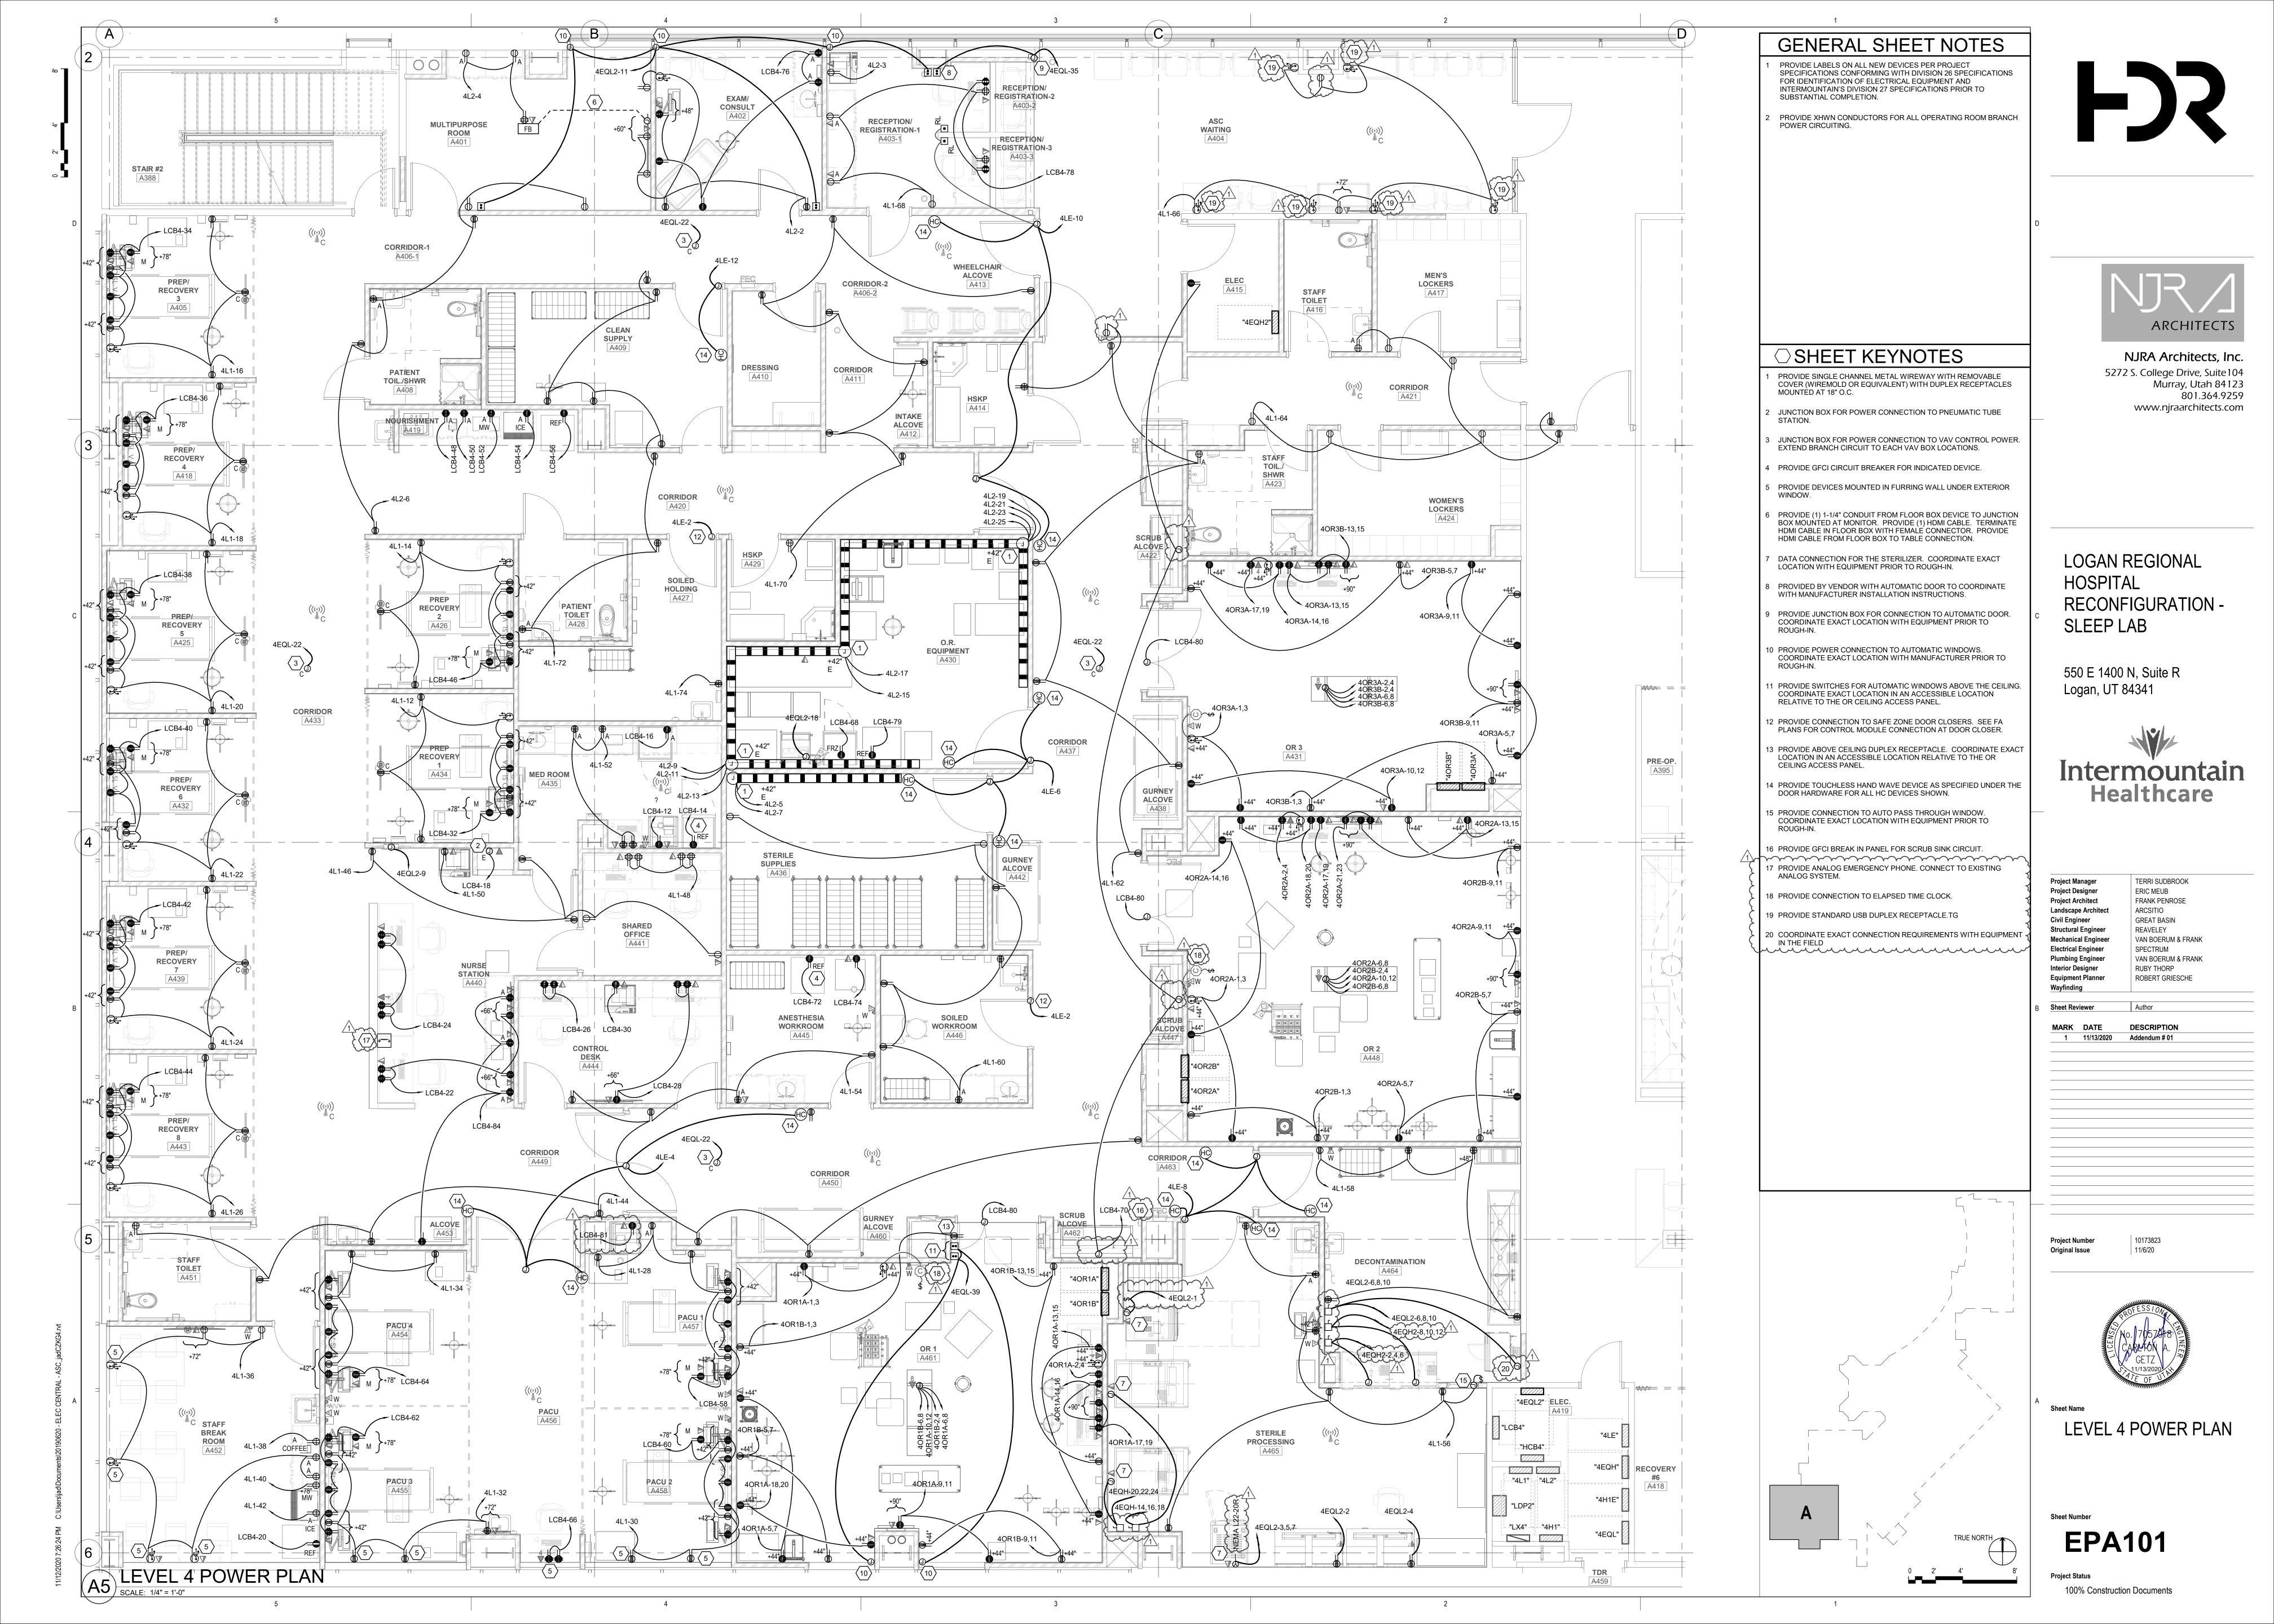

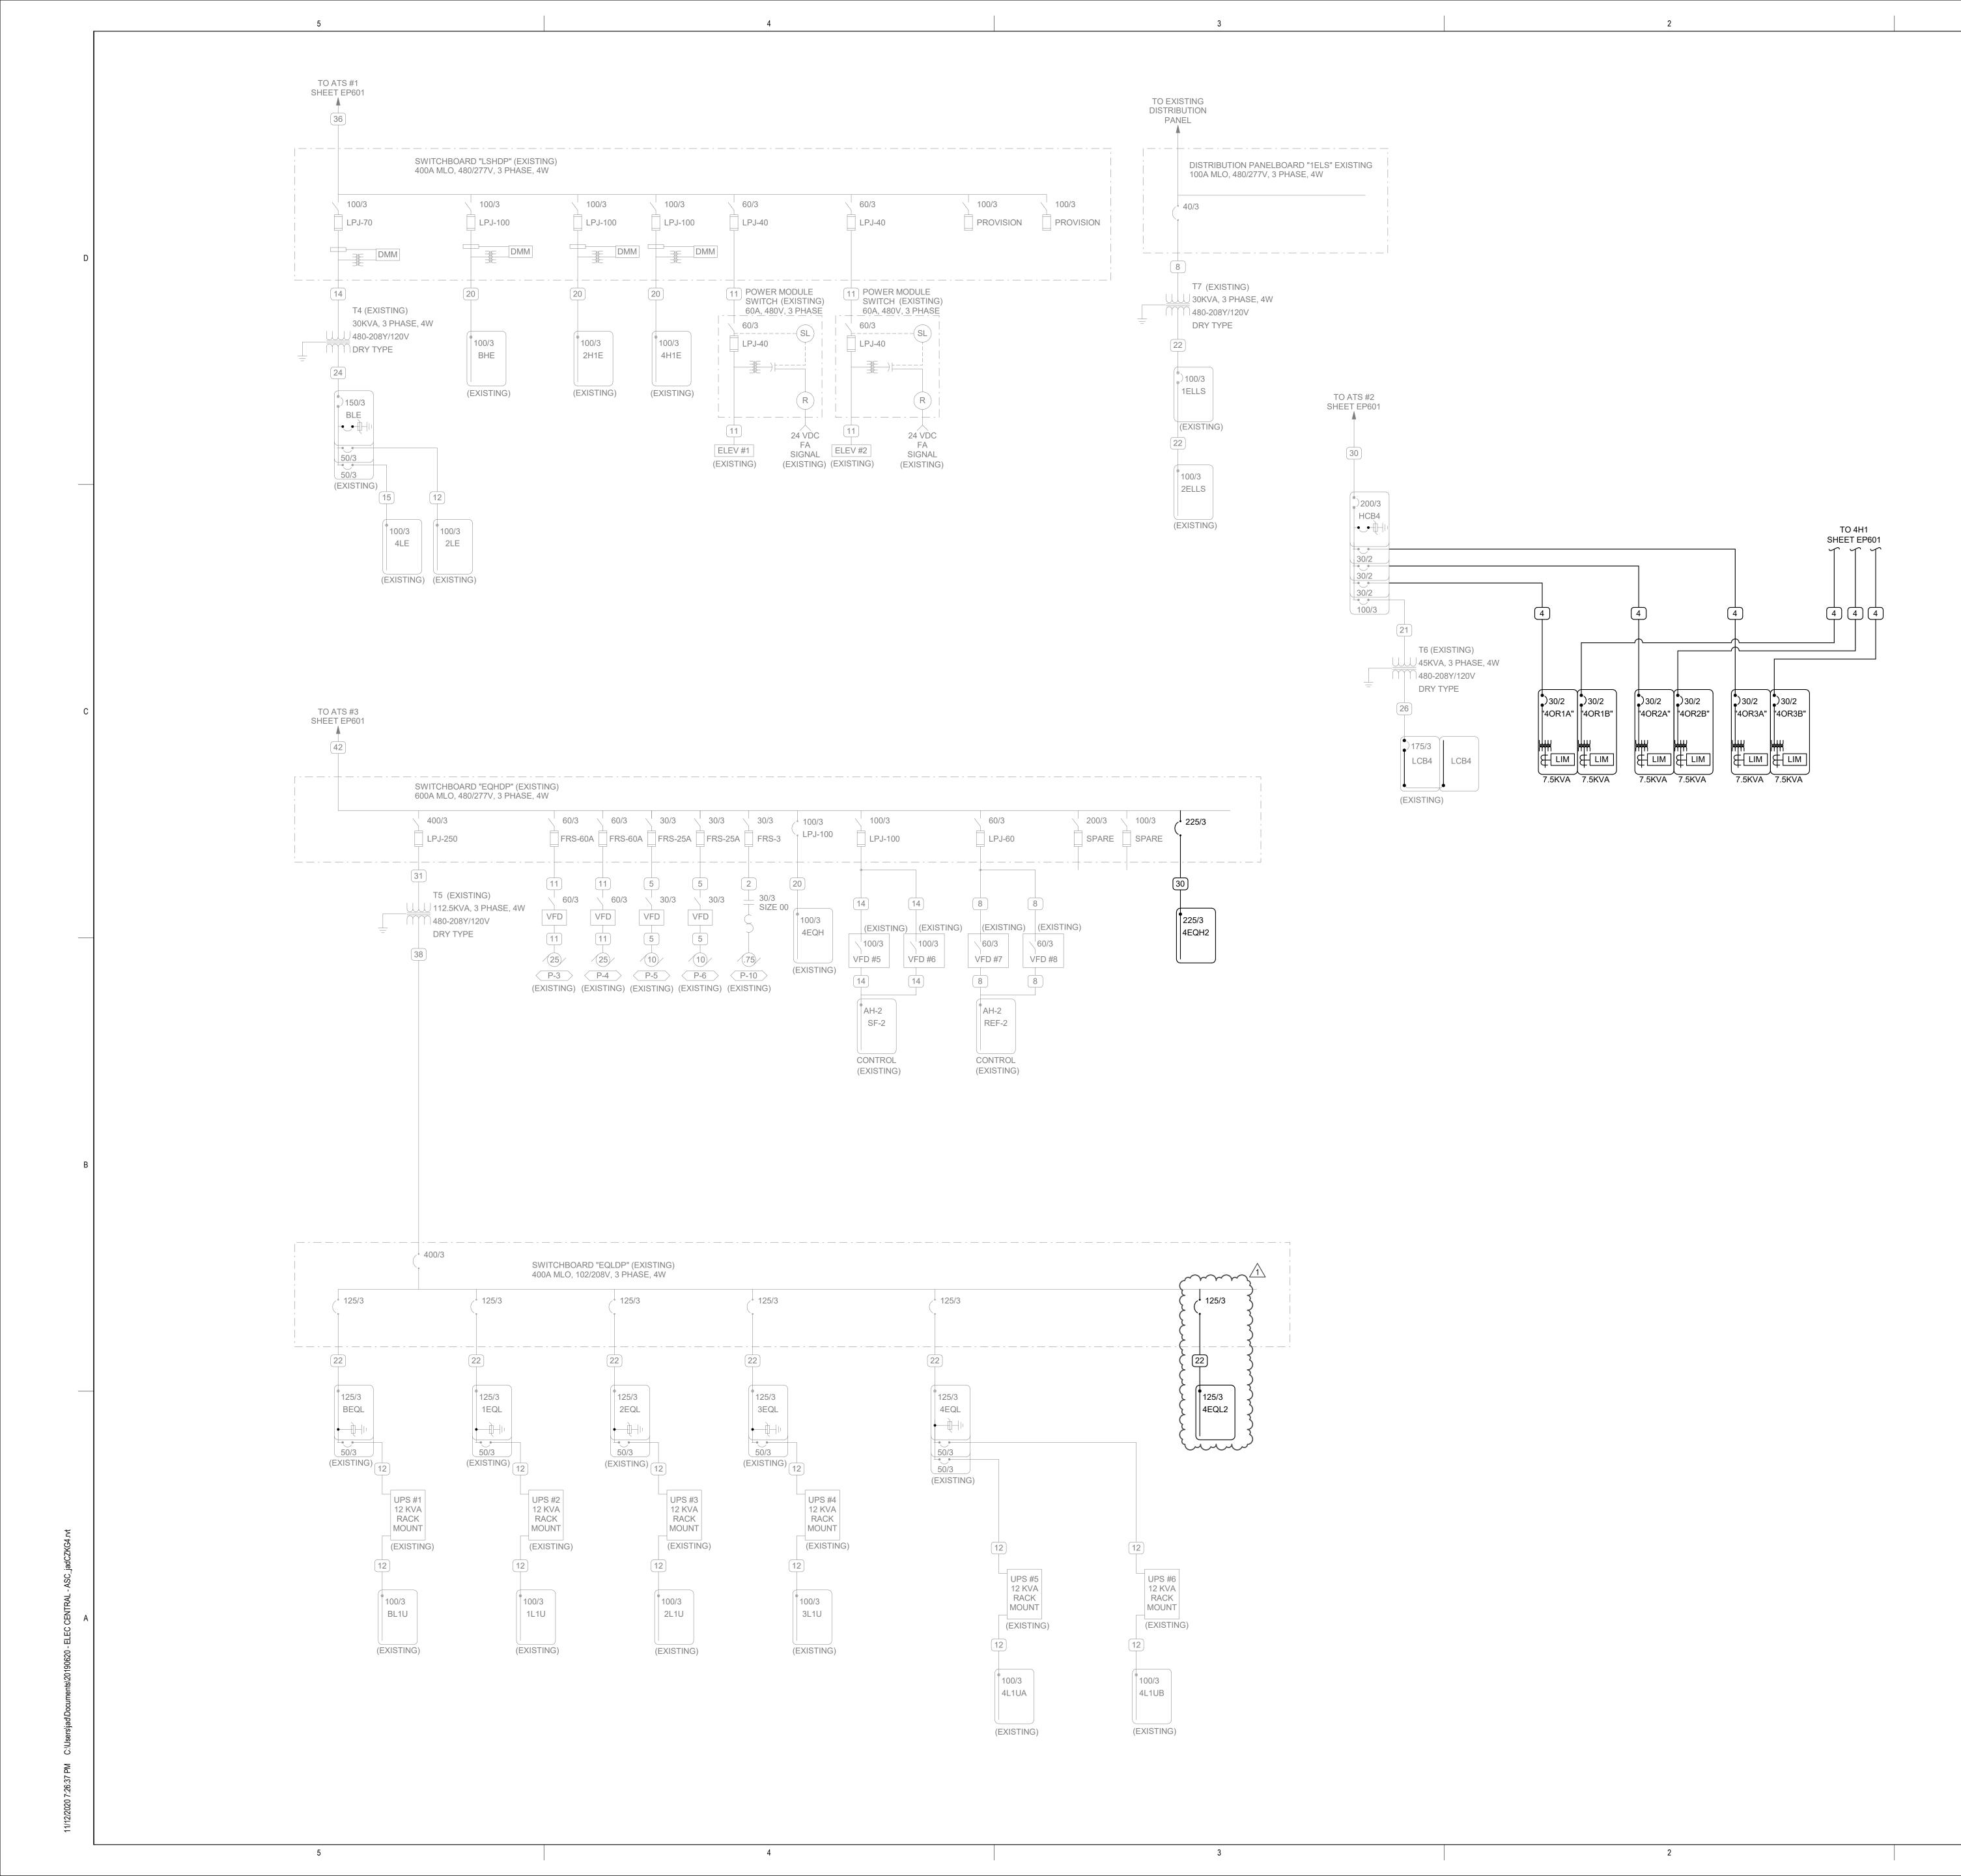


1
GENERAL SHEET NOTES
1 PROVIDE NEMA 3R ENCLOSURES FOR EQUIPMENT LOCATED OUTDOORS. REFER TO PLANS FOR EQUIPMENT LOCATIONS.
2 REFER TO PLANS FOR CONSTRAINTS ON PHYSICAL DIMENSIONS AND CLEARANCE REQUIREMENTS OF EQUIPMENT. PROVIDE EQUIPMENT DIMENSIONS THAT FALL WITHIN THE CONSTRAINTS OF EACH SPECIFIC LOCATION.
3 ALL EQUIPMENT SHALL BE CONSTRUCTED AND BRACED FOR THE SEISMIC CONDITIONS OF THE PROJECT. REFER TO ELECTRICAL SPECIFICATIONS FOR REQUIREMENTS.
4 PROVIDE PERFORMANCE TESTING FOR GROUND-FAULT PROTECTION SYSTEMS ON SITE WITH A WRITTEN RECORD OF THIS TEST SUBMITTED TO THE AUTHORITY HAVING JURISDICTION PER NEC 230.95(C).
○SHEET KEYNOTES

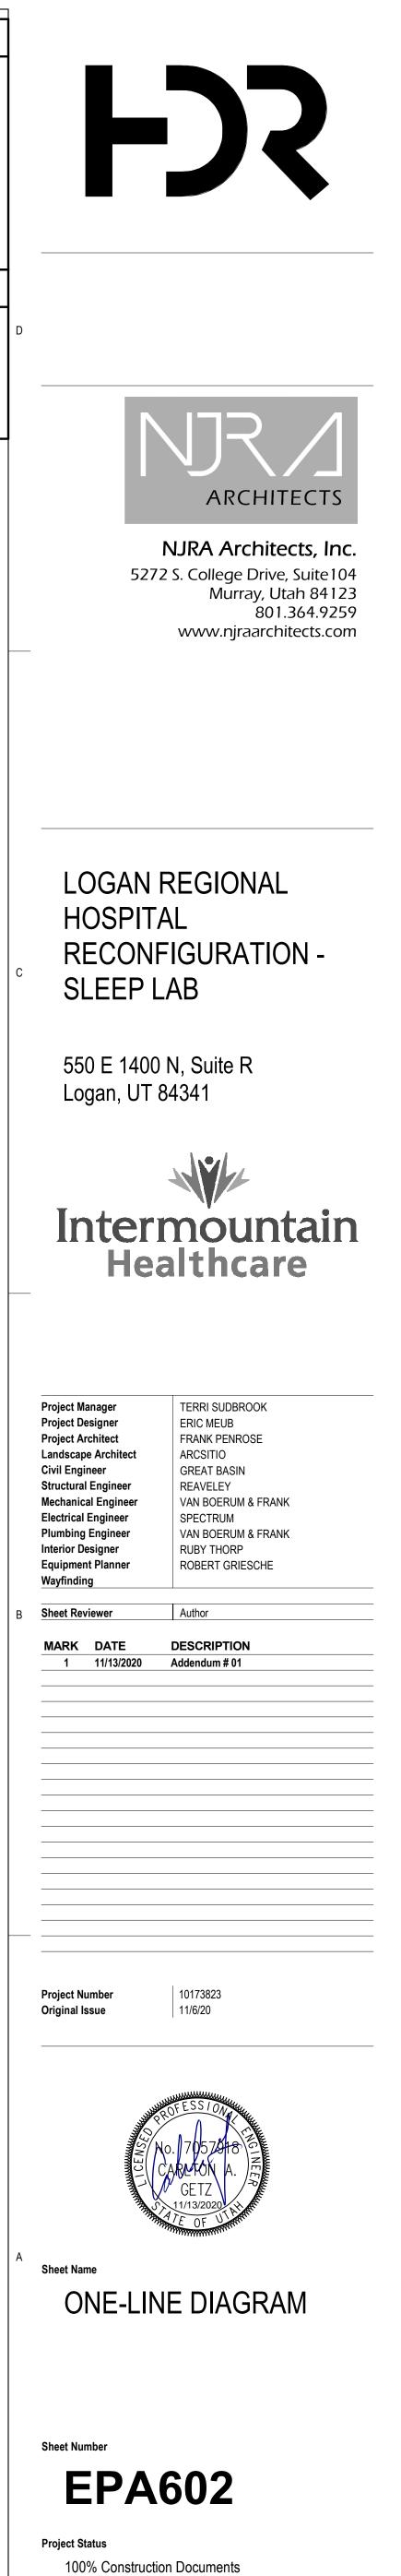

	D	
	C	
	В	
C:\Users\jad\Uocuments\2019U620 - ELEC CENTKAL - ASC_jadC2KG4.rvt	A	


MARK	QTY	ITEM DESCRIPTION			LOAD				WIREA			OVERCUR			DISCONNE	<u>ст</u>	1					ARTER DAT	^					NOTES	MARK
MARK		TTEM DESCRIPTION			LUAD	DATA			CONDUIT			PROTECT			DISCONNE	:01					51	ARIER DAI	4					NOTES	IVIARN
			HP	kW	MCA	FLA	VOLT	PH F		Ī				N FURN BY		LOCATION	FURN BY	DEVICE	LOCATION SI	IZE SPEED	 SELECTOR SWITCH	PUSH BUTTON	PILOT LAMP	OPEN	Y NORMALLY CLOSED S CONTACTS	PHASE FAILURE RELAY	SCHEMATIC REFERENCE		
AHU-3S	1	AIR HANDLER SUPPLY FANS	(6) 8		59.0	57	480	3 6	60 CC #1	4	E	60A C/B	PANEL	Q	VFD	ADJ. TO UNIT	Q	VFD	ADJ. TO UNIT										AHU-3
AHU-3R	1	AIR HANDLER RETURN FANS	(6) 3		27.0		480				E	30A	PANEL	Q	VFD	ADJ. TO UNIT	Q	VFD	ADJ. TO UNIT										AHU-3
AHU-3	1	AIR HANDLER LIGHTING/OUTLETS		1.6		13.3			50 CC #		E	20A .C/B.	PANEL	Q															AHU-3
DI-1	4	DOMESTIC PURE WATER SYSTEM		0.14		1.16	120				rte-t	20A C/B	PANEL	E	TOGGLE SWITCH	ADJ. TO UNIT		~~~~~											DI-1
EF-1	1	EXHAUST FAN	0.5	1.176	12.3	9.8	120	1 6	60 CC #	1	E	<u>С/В</u> 15А С/В	PANEL	Q	TOGGLE SWITCH	ADJ. TO UNIT	Q	VFD	ADJ. TO										EF-1
EF-2	1	EXHAUST FAN	0.334	0.864	9.0	7.2	120	1 6	60 CC #	1	E	15A C/B	PANEL	Q	TOGGLE	ADJ. TO UNIT	Q	VFD	ADJ. TO										EF-2
EF-3	1	EXHAUST FAN	0.75	1.643	9.9	7.9	208	1 6	50 CC #	1	E	15A C/B	PANEL	Q	30A D/S	ADJ. TO UNIT	Q	VFD	ADJ. TO										EF-3
EF-4	1	EXHAUST FAN	0.334	0.864	9.0	7.2	120	1 6	50 CC #	1	E	15A C/B	PANEL	Q	TOGGLE	ADJ. TO UNIT	Q	VFD	ADJ. TO										EF-4
EF-5	1	EXHAUST FAN	0.5	1.176	12.3	9.8	120	1 6	50 CC #	1	E	15A C/B	PANEL	Q	TOGGLE SWITCH	ADJ. TO UNIT	Q	VFD	ADJ. TO										EF-5
GFS-3	1	GLYCOL FEED SYSTEM		0.5	5.2	4.2	120		50 CC #		E	20A	PANEL	E	TOGGLE	ADJ. TO													GFS-
P-1	1	DOMESTIC PUMP	2	2.8	4.3	3.4	480		50 CC #		E	15A C/B	PANEL	E	30A D/S	ADJ. TO UNIT	E	FVNR	ADJ. TO										P-1
P-2	1	DOMESTIC PUMP	2	2.8	17.5			3 6			E	15A	PANEL	E	30A	ADJ. TO	E	FVNR «	ADJ. TO										P-2
P-3-1	1	HOT WATER PUMP	2.2		4.6	3.6	480	3 6	30 CC#	2	É	20A C/B	PANEL	- E	VFD	ADJ. TO UNIT	E	VFD	ADJ. TO UNIT										P-3-
P-3-2	1	HOT WATER PUMP	2.2		4.6	3.6	480	3 6	50 CC #	2	E	20A C/B	PANEL	E	VFD	ADJ. TO UNIT	E	VFD	ADJ. TO UNIT										P-3-
UH-1	1	HOT WATER UNIT HEATER			1.0	0.8	120	1 6	60 CC #	1	E	20A C/B	PANEL	E	TOGGLE SWITCH	ADJ. TO UNIT													UH-
WH-1	1	DOMESTIC WATER HEATER		0.5	5.2	4.2	120	1 6	50 CC #	1	E	20A C/B	PANEL	E	TOGGLE SWITCH														WH-
WS-1	1	WATER SOFTENER		0.5	5.2	4.2	120	1 6	60 CC #	1	E	20A C/B	PANEL	E	TOGGLE SWITCH	ADJ. TO UNIT													WS

EQUI	PMENT SCHEDULE KEY					
E	DIVISION 16					
Q	Q FURNISHED WITH THE EQUIPMENT					
*	COORDINATE WITH THE DIVISION 15 TEMPERATURE					
	CONTROL INSTALLER					
**	AUTOMATIC CONTROL WIRING BY DIVISION 15					

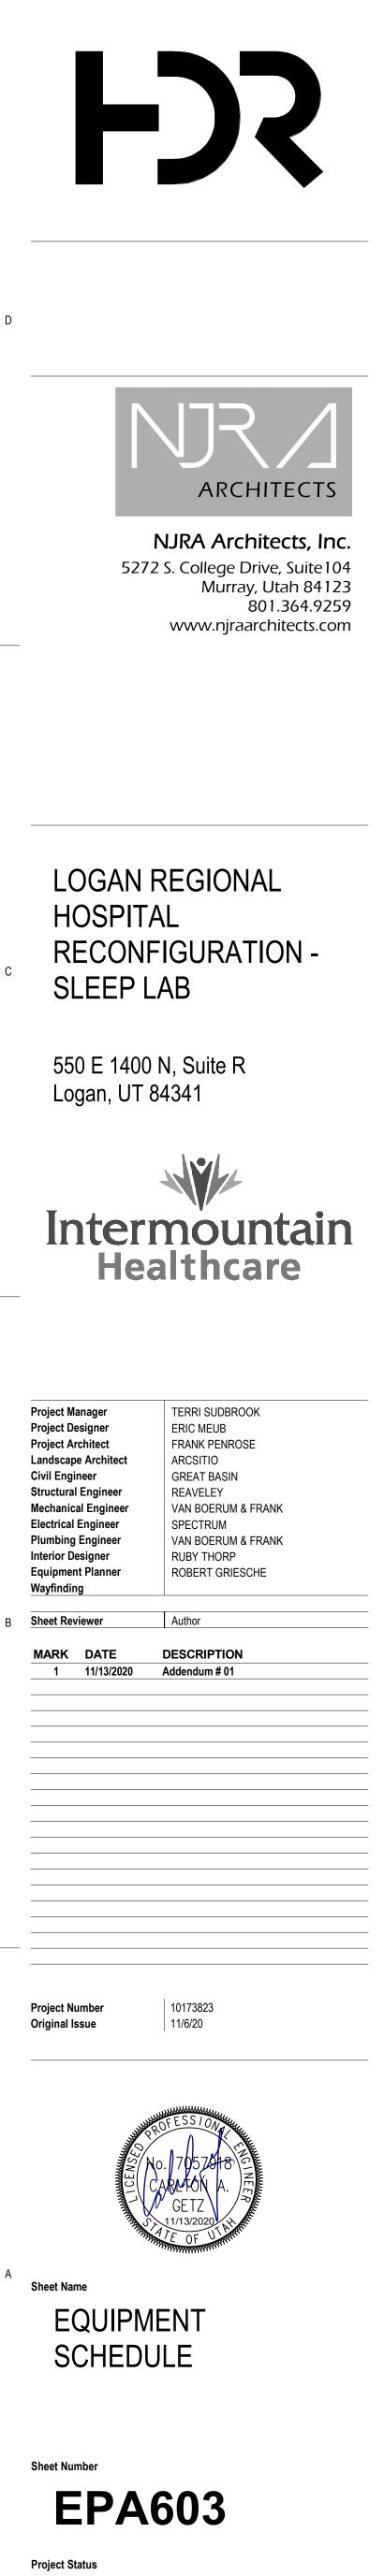


100% Construction Documents

SWITCHBOARD "LDP2"(EXISTING)	PANEL: "4H1"(EXISTING)	PANEL: "4L1"(EXISTING)
VOLTS/PHASE/WIRE: 120/208V,3 PH, 4 WIREMAIN SIZE & TYPE: 12000 AMPERE MAINLOCATION: ELEC. A419NOTES:	VOLTS/PHASE/WIRE:PANEL SIZE & TYPE:MAIN SIZE AND TYPE:FED FROM:CABINET:LOCATION:NOTES:480/277 V, 3 PH 4 WIRE22" W x 6" D, BOLT-ON225 AMPERE MAIN LUGSSURFACEELEC. A419	VOLTS/PHASE/WIRE:PANEL SIZE & TYPE:MAIN SIZE AND TYPE:FED FROM:CABINET:LOCATION:NOTES:120/208V, 3 PH 4 WIRE22" W x 6" D, BOLT-ON225 AMPERE MAIN LUGSSURFACEELEC. A419ELEC. A419
ACCESSORIES:       PANEL DIRECTORY, IDENTIFICATION, GROUNDING BAR       AIC RATING: (EXISTING)         CKT       OCP       LOAD (kVA)       PHASE LOAD (kVA)         NO       AMP       POLE       LTG       PWR       CO	ACCESSORIES:       PANEL DIRECTORY, IDENTIFICATION, GROUNDING BAR       AIC RATING: (EXISTING)         CKT       OCP       LOAD (kVA)       OCP       CKT         VID<       VID       PHASE LOAD       DOOD (kVA)       OCP       CKT	ACCESSORIES:       PANEL DIRECTORY, IDENTIFICATION, GROUNDING BAR       AIC RATING: (EXISTING)         CKT       OCP       LOAD (kVA)       OCP       CK         VIO       NIO       PHASE LOAD       DESCRIPTION       OCP       CK
1       225       3          (EXISTING) 3L3       0.0       0.0       0.0         2       225       3          (EXISTING) 3L2       0.0       0.0       0.0	NOAMPPOLEBKRLTGPWRCODESCRIPTIONABCDESCRIPTIONCOPWRLTGBKRPOLEAMPNO1201(EXISTING)LTG0.00.0 $\cdot$ $\cdot$ (EXISTING)PANELOR1A $\cdot$ - $\cdot$ $\cdot$ 23023201(EXISTING)LTG WAITING 41000 $\cdot$ 0.0 $\cdot$	NOAMPPOLEBKRLTGPWRCODESCRIPTIONABCDESCRIPTIONCOPWRLTGBKRPOLEAMPNO1201(EXISTING) RECOVERY #1411200.00.00.0(EXISTING) RECOVERY TV WAITING12023201(EXISTING) RECOVERY #2 411210.00.00.0(EXISTING) RECOVERY CO1204
3         225         3           (EXISTING) 3L1         0.0         0.0         0.0           4         225         3            (EXISTING) 4L1         0.0	5       20       1          (EXISTING) LTG HALLWAY 41021        0.0       0.0       (EXISTING) PANEL OR2A         2       30       6         7       20       3          (EXISTING) EF-1       0.0       0.0           2       30       6         9          (EXISTING) EF-1       0.0       0.0            8	5       20       1         (EXISTING) RECOVERY #3 41122        0.0       0.0       (EXISTING) NURSE CO          1       20       0         7       20       1         (EXISTING) RECOVERY #4 41123       0.0       0.0        (EXISTING) RECOVERY CO         1       20       6         9       20       1         (EXISTING) RECOVERY #4 4100 COPIER       0.0       0.0        (EXISTING) STORAGE CO         1       20       1
6         225         3            (EXISTING) SPARE         0.0         0.0         0.0         0.0           7         225         3            (EXISTING) SPARE         0.0         <	11               1       20       1          1       20       1          1       20       1         1       20       1         1       20       12         13       20       1         (EXISTING) LTG RM 41300       0.0       0.0       0.0       (EXISTING) PANEL OR3A         2       30       14	11       20       1         (EXISTING) RECEPTION CO        0.0       1.1       CO PREP RECOVERY 1 A434       1.1       0.0       0.0       1       20       1         13       20       1         (EXISTING) CO?       0.0       1.1       CO PREP RECOVERY 1 A434       1.1       0.0       0.0       1       20       1
8         225         3            (EXISTING) SPARE         0.0         0.0         0.0         0.0           9         225         3            (EXISTING) SPARE         0.0         0.0         0.0         0.0         0.0           10         225         3            (EXISTING) SPARE         0.0         0.0         0.0	15       20       1          (EXISTING) SPARE       0.0       0.0            16         17       20       1         (EXISTING) SPARE        0.0       0.0       0.0       (EXISTING) SPARE          16         19       20       1         (EXISTING) SPARE       0.0       0.0       (EXISTING) SPARE        1       20       18	15       20       1         (EXISTING) CO WAITING 4100       0.0       1.1       0.0       0.0       1       20       1         17       20       1         (EXISTING) RM 41000, 41028,        0.0       1.1       0.0       1.1       0.0       0.0       1       20       1         19       20       1         (EXISTING) CO HALLWAY 40121       0.0       1.1       CO PREP/ RECOVERY 4 A418       1.1       0.0       0.0       1       20       1
TOTALS:       CONNECTED kVA PER PHASE       0.0       0.0         CONNECTED AMPS PER PHASE       0       0       0         TOTAL CONNECTED kVA =       0.0       0       0	21       20       1          (EXISTING) SPARE       0.0       0.0       (EXISTING) SPARE         1       20       22         23       20       1         (EXISTING) SPARE        0.0       0.0       0.0       (EXISTING) SPARE        1       20       22         23       20       1         (EXISTING) SPARE        0.0       0.0       (EXISTING) SPARE        1       20       24         25       20       1         (EXISTING) SPARE       0.0       0.0       (EXISTING) SPARE         1       20       26	21       20       1         (EXISTING) PWR NRSE STTN        0.0       1.1       0.0       0.0       1       20       2         23       20       1         (EXISTING) PWR NRSE STTN        0.0       1.1       0.0       1.1       0.0       0.0       1       20       2         25       20       1         (EXISTING) PWR NRSE STTN       0.0       1.1       0.0       0.0       1       20       2         25       20       1         (EXISTING) PWR NRSE STTN       0.0       1.1       CO PREP/ RECOVERY 6 A433       1.1       0.0       0.0       1       20       2
AVERAGE CONNECTED AMPS PER PHASE =       0         NEC DIVERSIFIED LOAD CALCULATIONS	27       20       1         (EXISTING) SPARE       0.0       0.0       (EXISTING) SPARE         1       20       28         29       20       1         (EXISTING) SPARE       0.0       0.0       (EXISTING) SPARE         1       20       28         31       20       1         (EXISTING) SPARE       0.0       0.0       (EXISTING) SPARE        1       20       30         31       20       1         (EXISTING) SPARE       0.0       0.0       (EXISTING) SPARE        1       20       30	27       20       1         (EXISTING) CO PRE-OP 41113       0.0       0.9       CO PACU 1 A457       0.9       0.0       0.0       1       20       2         29       20       1         (EXISTING) CO PRE-OP 41112       -       6       0.0       0.7       0.0       0.0       1       20       3         31       20       1         (EXISTING) CO NRSE STTN 4111       0.0       0.9       0.0       0.7       0.0       0.0       1       20       3
LIGHTING & CONTINUOUS LOADS:       - 100% CONNECTED LOAD PLUS 25%       TOTAL DIVERSIFIED kVA = 0.0         RECEPTACLES:       - FIRST 10kVA @ 100%, REMAINDER @ 50%       AVERAGE AMPS PER PHASE = 0         ALL OTHER LOADS @ 100%:       0.0 kVA       - MOTOR TOTALS INCLUDED IN ALL OTHER LOADS	33       20       1         (EXISTING) SPARE       0.0       0.0       (EXISTING) SPARE         1       20       34         35       20       1         (EXISTING) SPARE       0.0       0.0       0.0       (EXISTING) SPARE        1       20       34	33       20       1         (EXISTING) CO PRE-OP 41110       0.0       0.7       CO PACU 4 A454       0.7       0.0       0.0       1       20       3         35       20       1         (EXISTING) CO PRE-OP 41009       6       6       0.0       1.4       CO STAFF BREAK ROOM A452       1.4       0.0       0.0       1       20       3
WITH LARGEST MOTOR CALCULATED @ 125% PER	37       20       1          (EXISTING) SPARE       0.0       0.0        (EXISTING) SPARE         1       20       38         39       20       1          (EXISTING) SPARE       0.0       0.0       0.0       (EXISTING) SPARE         1       20       38         41       20       1          (EXISTING) SPARE       0.0       0.0       (EXISTING) SPARE        1       20       40	37       20       1         (EXISTING) DF PWR RM 41000       0.0       1.4       COFFEE STAFF BREAK ROOM A452       0.0       1.4       0.0       1       20       3         39       20       1         (EX) CO RM 41101, 41008, 41009        0.0       1.7       0.0       1       20       4         41       20       1         (EX) CO RM 41023, 41103, 41104        0.0       1.3       ICE STAFF BREAK ROOM A452       0.0       1.4       0.0       1       20       4
	TOTALS:       CONNECTED kVA PER PHASE       0       0       0       CONNECTED TOTAL kVA =       0         CONNECTED AMPS PER PHASE       0       0       0       AVERAGE CONNECTED AMPS PER PHASE =       0         NEC DIVERSIFIED LOAD CALCULATIONS	43       20       1         (EXISTING) CO RM 41010, 41011       0.0       0.7       0.0       0.0       1       20       4         45       20       1         (EXISTING) PWR HALL 41020 DF       0.0       0.0       0.0       1       20       4         47       20       1         (EXISTING) CO RM 41025, 41020       0.0       0.0       1.4       0.0       0.0       0.0       1       20       4         47       20       1         (EXISTING) CO RM 41025, 41020       0.0       0.0       1.4       CO SHARED OFFICE A441       1.4       0.0       0.0       1       20       4
	LIGHTING & CONTINUOUS LOADS: - 100% CONNECTED LOAD PLUS 25% DIVERSIFIED TOTAL kVA = <b>0</b>	49       20       1         (EXISTING) CO OFFICE 41106       0.0       1.0        PRINTER NURSE STATION A440       0.0       1.0       0.0       1       20       5         51       20       1         (EXISTING) CO OFFICE 41107        0.0       1.1       0.0       0.0       1       20       5         53       20       1         (EXISTING) CO BREAK RM 41108        0.0       1.3       CO ANESTHESIA WORKROOM A445       1.3       0.0       0.0       1       20       5
	RECEPTACLES:       - FIRST 10kVA @ 100%, REMAINDER @ 50%       AVERAGE AMPS PER PHASE = 0         ALL OTHER LOADS @ 100% :       0.0 kVA       MOTOR TOTALS INCLUDED IN ALL OTHER LOADS WITH LARGEST MOTOR CALCULATED @ 125% PER NEC	55       20       1         (EXISTING) CO BREAK RM 41108       0.0       1.4        CO STERILE PROCESSING       1.3       0.1       0.0       1       20       5         57       20       1         (EXISTING) CO BREAK RM 41108       0.0       1.1       CO DECONTAMINATION A464       0.7       0.4       0.0       1       20       5         59       20       1         (EXISTING) CO BREAK RM 41108        0.0       1.3       CO SOILED WORKROOM A446       1.3       0.0       0.0       1       20       5
	BKR: GF=GFCI, GF3=30mA GFCI CAPABLE OF BEING LOCAKED OUT IN OPEN POSITION, IG=ISOLATED GROUND, AF=AFCI, ST=SHUNT TRIP, RED=PROVIDE RED COLORED BREAKER, AF=ARC FAULT CURRENT INTERRUPTER, GA=COMBINATION OF GROUND FAULT AND ARC FAULT CIRCUIT INTERRUPTER, GS=COMBINATION OF SHUNT TRIP WITH GFCI	61       20       1         (EXISTING) CO RM 41109/10/12       0.0       1.4        CO CORRIDOR A437       1.4       0.0       0.0       1       20       6         63       20       1         (EXISTING) PWR RM 41020 ADOOR        0.0       1.4       0.0       0.0       1       20       6         65       20       1         (EXISTING) CO ENDO CO        0.0       1.4       CO ASC WAITING A404       1.4       0.0       0.0       1       20       6
		60       10       11 <th< th=""></th<>
DISTRIBUTION PANEL "MHDM1"(EXISTING)	PANEL: "4EQH"(EXISTING)	73       20       1         (EXISTING) PWR WTNG 410000 DF       0.0       0.2       CO SOILED HOLDING A427       0.2       0.0       0.0       1       20       7         75       20       1         (EXISTING) SPARE (OFF)       0.0       0.0       0.0       0.0       0.0       0.0       1       20       7
VOLTS/PHASE/WIRE:     MAIN SIZE & TYPE:     LOCATION:     NOTES:       480/277 V, 3 PH, 4 WIRE     1200 AMPERE MAIN     Image: Accessories:     PANEL DIRECTORY, IDENTIFICATION, GROUNDING BAR     AIC RATING: (EXISTING)	VOLTS/PHASE/WIRE:       PANEL SIZE & TYPE:       MAIN SIZE AND TYPE:       FED FROM:       CABINET:       LOCATION:       NOTES:         480/277 V, 3 PH 4 WIRE       22" W x 6" D, BOLT-ON       100 AMPERE MAIN LUGS       SURFACE       ELEC. A419       ELEC. A419         ACCESSORIES:       PANEL DIRECTORY, IDENTIFICATION, GROUNDING BAR       AIC RATING: (EXISTING)	79       20       1         (EXISTING) PRE-OP TV       0.0       0.0        (EXISTING) SPARE (OFF)          1       20       1         81       20       1         (EXISTING) PRE-OP CO       0.0       0.0       0.0       (EXISTING) SPARE (OFF)         1       20       8
CKT         OCP         LOAD (kVA)         PHASE LOAD (kVA)           NO         AMP         POLE         LTG         PWR         CO         PANEL / EQUIPMENT         A         B         C	ACCESSORIES:       PANEL DIRECTORY, IDENTIFICATION, GROUNDING BAR       AIC RATING: (EXISTING)         KT       OCP       LOAD (kVA)       PHASE LOAD         NO       AMP       POLE       BKR       LTG       PWR       CO       DESCRIPTION       A       B       C       DESCRIPTION       CO       PWR       LTG       BKR       POLE       AMP       NO	TOTALS:       CONNECTED kVA PER PHASE       12       11       14       CONNECTED TOTAL kVA =       36         CONNECTED AMPS PER PHASE       96       95       113       AVERAGE CONNECTED AMPS PER PHASE =       101
1         20         1            (EXISTING) P-14         0.0           2         500         1           (EXISTING) SF-1         0.0         0.0           3         60         1           (EXISTING) PWR MECHANICAL ROOM 01007 P-1         0.0         0.0	1       20       3          (EXISTING) H-1       0.0       0.0        (EXISTING) CONDENSOR ROOF         3       30       2         3              3       30       2         3              3       30       2         3              4         5            0.0       0.0           4	NEC DIVERSIFIED LOAD CALCULATIONS         LIGHTING & CONTINUOUS LOADS:       - 100% CONNECTED LOAD PLUS 25%         DIVERSIFIED TOTAL kVA = 26
4         60         1           (EXISTING) PWR MECHANICAL ROOM 01007 P-2         0.0           5         20         1           (EXISTING) REF-1         0.0           6         20         1           (EXISTING) POWER MECHANICAL ROOM 01001         0.0	7       20       3          (EXISTING) H-2       0.0       0.0        (EXISTING) CONDENSOR ROOF          3       30       8         9              10	RECEPTACLES: 30.6 kVA @ 66% = 20.3 kVA       - FIRST 10kVA @ 100%, REMAINDER @ 50%       AVERAGE AMPS PER PHASE = 73         ALL OTHER LOADS @ 100% :
7         20         1           (EXISTING) POWER MECHANICAL ROOM 01011         0.0           8         20         1           (EXISTING)         0.0         0.0	11               12         13       20       3          (EXISTING) H-3       0.0       1.9         STERILIZER       0.0       5.8       0.0       3       20       14         15               16	BKR: GF=GFCI, GF3=30mA GFCI CAPABLE OF BEING LOCAKED OUT IN OPEN POSITION, IG=ISOLATED GROUND, AF=AFCI, ST=SHUNT TRIP, RED=PROVIDE RED COLORED BREAKER, AF=ARC FAULT CURRENT INTERRUPTER, GA=COMBINATION OF GROUND FAULT AND ARC FAULT CIRCUIT INTERRUPTER, GS=COMBINATION OF SHUNT TRIP WITH GFCI
9         20         1            (EXISTING) P-9         0.0         10           10         30         1            (EXISTING) P-8         0.0         0.0         10           11         30         1            (EXISTING) P-7         0.0         0.	17       10       10       1.0<	
12         15         3         0.0         2.8         0.0         (NEW) P-1         0.9 </th <th>23       20       1         (EXISTING) SPARE       0.0       1.9           24         25       20       1         (EXISTING) SPARE       0.0       0.0           1       20       26         27       20       1         (EXISTING) SPARE       0.0       0.0       (EXISTING) SPARE        1       20       26</th> <th>PANEL: "4L2" (EXISTING)         VOLTS/PHASE/WIRE:       PANEL SIZE &amp; TYPE:       MAIN SIZE AND TYPE:       FED FROM:       CABINET:       LOCATION:       NOTES:</th>	23       20       1         (EXISTING) SPARE       0.0       1.9           24         25       20       1         (EXISTING) SPARE       0.0       0.0           1       20       26         27       20       1         (EXISTING) SPARE       0.0       0.0       (EXISTING) SPARE        1       20       26	PANEL: "4L2" (EXISTING)         VOLTS/PHASE/WIRE:       PANEL SIZE & TYPE:       MAIN SIZE AND TYPE:       FED FROM:       CABINET:       LOCATION:       NOTES:
15            SPACE         0.0            16             SPACE         0.0	29       20       1           1       20       30         31       20       1         (EXISTING) SPARE       0.0       0.0       (EXISTING) SPARE        1       20       30         33       20       1         (EXISTING) SPARE       0.0       0.0       (EXISTING) SPARE        1       20       32         33       20       1         (EXISTING) SPARE       0.0       0.0       (EXISTING) SPARE        1       20       32	VOLTS/PRASE/WIRE       PANEL Size & TTPE.       MAIN Size AND TTPE.       PED FROM.       CABINET.       LOCATION.       NOTES.         120/208V, 3 PH 4 WIRE       22" W x 6" D, BOLT-ON       225 AMPERE MAIN LUGS       SURFACE       ELEC. A419       ACCESSORIES:       PANEL DIRECTORY, IDENTIFICATION, GROUNDING BAR       AIC RATING: (EXISTING)
TOTALS:       CONNECTED kVA PER PHASE       1.9       1.9       1.9         CONNECTED AMPS PER PHASE       7       7       7         TOTAL CONNECTED kVA =       5.6       5.6	35       20       1         (EXISTING) SPARE       0.0       0.0       (EXISTING) SPARE         1       20       36         37       20       1         (EXISTING) SPARE       0.0       0.0       (EXISTING) SPARE        1       20       36	CKT $\overrightarrow{OCP}$ $\overrightarrow{LOAD}$ (kVA) $\overrightarrow{PHASE}$ LOAD $\overrightarrow{DSCP}$ $\overrightarrow{LOAD}$ (kVA) $\overrightarrow{OCP}$ $\overrightarrow{CI}$ NOAMPPOLEBKRLTGPWRCODESCRIPTION $\overrightarrow{AMP}$ BCDESCRIPTIONCOPWRLTGBKRPOLEAMPN1201(EXISTING) ROOF CO0.01.1COCO EXAM/ CONSULT A4021.10.00.01202
AVERAGE CONNECTED AMPS PER PHASE = 7	39       20       1         (EXISTING) SPARE       0.0       0.0       (EXISTING) SPARE         1       20       40         41       20       1         (EXISTING) SPARE       0.0       0.0       (EXISTING) SPARE        1       20       40         41       20       1         (EXISTING) SPARE       0.0       0.0       (EXISTING) SPARE        1       20       42         TOTALS:       CONNECTED KVA PER PHASE       4       4       4       CONNECTED TOTAL KVA =       12       12	3       20       1       0.0       1.0       0.0       PRINTER REGISTRATION-1 A403-1       1.0       0.9       CO MULTIPURPOSE ROOM A401       0.7       0.2       0.0       1       20       4         5       20       1       0.0       0.0       1.0       STERILE SUPPLIES WIREMOLD       10       1.0       1.1       0.0       0.0       1       20       4
LIGHTING & CONTINUOUS LOADS:       - 100% CONNECTED LOAD PLUS 25%       TOTAL DIVERSIFIED kVA = 6.3         RECEPTACLES:       - FIRST 10kVA @ 100%, REMAINDER @ 50%       AVERAGE AMPS PER PHASE = 8         ALL OTHER LOADS @ 100%:       5.6 kVA       - MOTOR TOTALS INCLUDED IN ALL OTHER LOADS	CONNECTED AMPS PER PHASE 14 14 14 AVERAGE CONNECTED AMPS PER PHASE = 14	7       20       1       0.0       0.0       1.1       STERILE SUPPLIES WIREMOLD       1.1       1.1        ROOF CO       1.1       0.0       0.0       1       20       8         9       20       1       0.0       0.0       1.0       OR EQUIP WIREMOLD        1.0       0.0         1.1       20       1         11       20       1       0.0       0.0       1.1       OR EQUIP WIREMOLD         1.1       0.0       (EXISTING) SPARE         1       20       1         11       20       1       0.0       0.0       1.1       OR EQUIP WIREMOLD         1.1       0.0       (EXISTING) SPARE         1       20       1
	LIGHTING & CONTINUOUS LOADS:       - 100% CONNECTED LOAD PLUS 25%       DIVERSIFIED TOTAL kVA = 12         RECEPTACLES:       - FIRST 10kVA @ 100%, REMAINDER @ 50%       AVERAGE AMPS PER PHASE = 14	13       20       1       0.0       0.0       1.3       OR EQUIP WIREMOLD       1.3       0.0       1       (EXISTING) SPARE          1       20       1         15       20       1       0.0       0.0       1.1       OR EQUIP WIREMOLD       1       1.1       0.0       1       (EXISTING) SPARE         1       20       1         17       20       1       0.0       0.0       1.3       OR EQUIP WIREMOLD       Image: Comparison of the comp
	ALL OTHER LOADS @ 100% : 11.6 kVA - MOTOR TOTALS INCLUDED IN ALL OTHER LOADS WITH LARGEST MOTOR CALCULATED @ 125% PER NEC BKR: GF=GFCI, GF3=30mA GFCI CAPABLE OF BEING LOCAKED OUT IN OPEN POSITION, IG=ISOLATED GROUND, AF=AFCI, ST=SHUNT TRIP, RED=PROVIDE RED COLORED BREAKER,	19       20       1       0.0       0.0       0.9       OR EQUIP WIREMOLD       0.9       0.0           1       20       20         21       20       1       0.0       0.0       0.9       OR EQUIP WIREMOLD        0.9       0.0        (EXISTING) SPARE         1       20       20         23       20       1       0.0       0.8       OR EQUIP WIREMOLD        0.8       0.0       (EXISTING) SPARE         1       20       20
	AF=ARC FAULT CURRENT INTERRUPTER, GA=COMBINATION OF GROUND FAULT AND ARC FAULT CIRCUIT INTERRUPTER, GS=COMBINATION OF SHUNT TRIP WITH GFCI	25       20       1       0.0       0.0       0.7       OR EQUIP WIREMOLD       0.7       0.0       (EXISTING) SPARE         1       20       2         27       20       1         (EXISTING) SPARE       0.0       0.0       (EXISTING) SPARE         1       20       2         29       20       1         (EXISTING) SPARE       0.0       0.0       (EXISTING) SPARE        1       20       2
	PANEL: "4EQH2"(NEW)	31       20       1         (EXISTING) SPARE       0.0       0.0       (EXISTING) SPARE         1       20       3         TOTALS:       CONNECTED kVA PER PHASE       6       5       5       CONNECTED TOTAL kVA =       16
	VOLTS/PHASE/WIRE:PANEL SIZE & TYPE:MAIN SIZE AND TYPE:FED FROM:CABINET:LOCATION:NOTES:480/277 V, 3 PH 4 WIRE22" W x 6" D, BOLT-ON225 AMPERE MAIN LUGSSURFACEELEC A415ELEC A415	CONNECTED AMPS PER PHASE       51       41       44       AVERAGE CONNECTED AMPS PER PHASE =       45         NEC DIVERSIFIED LOAD CALCULATIONS
	ACCESSORIES:       PANEL DIRECTORY, IDENTIFICATION, GROUNDING BAR       AIC RATING: 22000         CKT       OCP       LOAD (kVA)       PHASE LOAD         NO       AMP       POLE       BKR       LTG       PWR       CO       DESCRIPTION       A       B       C       DESCRIPTION       CO       RWR       LTG       BKR       POLE       BKR       POLE       BKR       POLE       AMR       POLE       0 kVA@ 83% = 12.5 kVA       - FIRST 10kVA@ 100%, REMAINDER@ 50%       AVERAGE AMPS PER PHASE = 38</th>	LIGHTING & CONTINUOUS LOADS:       - 100% CONNECTED LOAD PLUS 25%       DIVERSIFIED TOTAL kVA = 14         RECEPTACLES:       15.0 kVA@ 83% = 12.5 kVA       - FIRST 10kVA@ 100%, REMAINDER@ 50%       AVERAGE AMPS PER PHASE = 38
	1       20       3       0.0       3.0       0.0       P-3-1       1.0       4.7       STEAM WASHER       0.0       14.1       0.0       3       25       2         3            1.0       4.7            4	ALL OTHER LOADS @ 100% : 1.2 kVA - MOTOR TOTALS INCLUDED IN ALL OTHER LOADS WITH LARGEST MOTOR CALCULATED @ 125% PER NEC BKR: GF=GFCI, GF3=30mA GFCI CAPABLE OF BEING LOCAKED OUT IN OPEN POSITION, IG=ISOLATED GROUND, AF=AFCI, ST=SHUNT TRIP, RED=PROVIDE RED COLORED BREAKER,
	5                6         7       20       3       0.0       3.0       0.0       P-3-2       1.0       4.7            6         9             6          6         10         10         10         10 <td< th=""><th>AF=ARC FAULT CURRENT INTERRUPTER, GA=COMBINATION OF GROUND FAULT AND ARC FAULT CIRCUIT INTERRUPTER, GS=COMBINATION OF SHUNT TRIP WITH GFCI</th></td<>	AF=ARC FAULT CURRENT INTERRUPTER, GA=COMBINATION OF GROUND FAULT AND ARC FAULT CIRCUIT INTERRUPTER, GS=COMBINATION OF SHUNT TRIP WITH GFCI
	11           1.0       4.7         13       60       3       0.0       47.4       0.0       AHU-3 SUPPLY FANS       15.8       0.0           1       20       14         15           15.8       0.0        SPARE         1       20       14	PANEL: "4LE"(EXISTING)
	17             1       20       18         19       30       3       0.0       21.6       0.0       AHU-3 RETURN FANS       7.2       0.0         SPARE         1       20       18         19       30       3       0.0       21.6       0.0       AHU-3 RETURN FANS       7.2       0.0        SPARE         1       20       20         21            7.2       0.0        SPARE         1       20       22	VOLTS/PHASE/WIRE:       PANEL SIZE & TYPE:       MAIN SIZE AND TYPE:       FED FROM:       CABINET:       LOCATION:       NOTES:         120/208V, 3 PH 4 WIRE       22" W x 6" D, BOLT-ON       100 AMPERE MAIN LUGS       SURFACE       ELEC. A419       AIC PATING:       (EXISTING)
	23              1       20       24         25       20       1         SPARE       0.0       0.0         1       20       24         27       20       1         SPARE       0.0       0.0        SPARE        1       20       26	ACCESSORIES:       PANEL DIRECTORY, IDENTIFICATION, GROUNDING BAR       AIC RATING: (EXISTING)         CKT       OCP       LOAD (kVA)       PHASE LOAD       LOAD (kVA)       OCP       CI         NO       AMP       POLE       BKR       LTG       PWR       CO       DESCRIPTION       A       B       C       DESCRIPTION       CO       PWR       LTG       BKR       POLE       AMP       NO
	29       20       1          SPARE        0.0       0.0       SPARE         1       20       30         31       20       1          SPARE       0.0       0.0        SPARE        1       20       30	1       20       1         (EX) PWR LBY 41003 / OF IRE DRS       0.0       0.4       SOLID HOLDING DOOR CLOSERS       0.0       0.4       0.0       1       20         3       20       1         (EX) PWR LBY 41003 FIRE DRS       0.0       1.1       AUTO DOORS       0.0       1.1       0.0       1       20       4         5       20       1         (EX) PWR ELEV FIRE DOORS       0.0       1.1       AUTO DOORS       0.0       1.1       0.0       1       20       4
	33       20       1          SPARE       0.0       0.0       Image: SPARE         1       20       34         35       20       1         Image: SPARE	7       20       1         (EX) 3RD FLOOR SMOKE CRTNS       0.0       1.1       -       AUTO DOORS       0.0       1.1       0.0       1       20       20         9       20       1         (EX) 3RD FLOOR SMOKE CRTNS       0.0       1.1       0.0       1       20       20         9       20       1         (EXISTING) SPARE       0.0       1.1       0.0       1.1       0.0       1       20       1
	39       20       1          SPARE       0.0       0.0       Image: Spare       I	13       20       1         (EXISTING) 3RD FLOOR FPS DATE       0.0       0.0       (EXISTING) SPARE          1       20       1         15       20       1         (EX) ELEV 1-2 SMOKE CRTNS       0.0       0.0       (EXISTING) SPARE         1       20       1
	CONNECTED AMPS PER PHASE       124       124       AVERAGE CONNECTED AMPS PER PHASE =       124         NEC DIVERSIFIED LOAD CALCULATIONS	17       20       1          (EXISTING) ELEV SHAFT LTG       0.0       0.0       (EXISTING) SPARE         1       20       1         19       20       1         (EXISTING) FIRE DOOR       0.0       0.0       (EXISTING) SPARE         1       20       1         21       20       1         (EXISTING) SPARE       0.0       0.0       (EXISTING) SPARE        1       20       2
	LIGHTING & CONTINUOUS LOADS:- 100% CONNECTED LOAD PLUS 25%DIVERSIFIED TOTAL kVA = 115RECEPTACLES:- FIRST 10kVA @ 100%, REMAINDER @ 50%AVERAGE AMPS PER PHASE = 138	23       20       1          (EXISTING) SPARE       0.0       0.0       (EXISTING) SPARE         1       20       2         25       20       1         (EXISTING) SPARE       0.0       0.0       (EXISTING) SPARE        1       20       2         27       20       1         (EXISTING) SPARE       0.0       0.0       (EXISTING) SPARE        1       20       2
	ALL OTHER LOADS @ 100% : 115.1 KVA - MOTOR TOTALS INCLUDED IN ALL OTHER LOADS WITH LARGEST MOTOR CALCULATED @ 125% PER NEC	29       20       1         (EXISTING) SPARE       0.0       0.0       (EXISTING) SPARE         1       20       33       20       1         (EXISTING) SPARE       0.0       0.0       (EXISTING) SPARE        1       20       33         33       20       1         (EXISTING) SPARE       0.0       0.0       (EXISTING) SPARE        1       20       3
	BKR: GF=GFCI, GF3=30mA GFCI CAPABLE OF BEING LOCAKED OUT IN OPEN POSITION, IG=ISOLATED GROUND, AF=AFCI, ST=SHUNT TRIP, RED=PROVIDE RED COLORED BREAKER, AF=ARC FAULT CURRENT INTERRUPTER, GA=COMBINATION OF GROUND FAULT AND ARC FAULT CIRCUIT INTERRUPTER, GS=COMBINATION OF SHUNT TRIP WITH GFCI	35       20       1          (EXISTING) SPARE        0.0       0.0       0.0       (EXISTING) SPARE         1       20       1         37       20       1         (EXISTING) SPARE       0.0       0.0       0.0       (EXISTING) SPARE        1       20 <td< th=""></td<>
		39       20       1         (EXISTING) SPARE       0.0       0.0       (EXISTING) SPARE         1       20       4         41       20       1         (EXISTING) SPARE       0.0       0.0       (EXISTING) SPARE        1       20       4         41       20       1         (EXISTING) SPARE       0.0       0.0       (EXISTING) SPARE        1       20       4         TOTALS:       CONNECTED KVA PER PHASE       1       2       2       CONNECTED TOTAL KVA =       5
		CONNECTED AMPS PER PHASE       12       18       14       AVERAGE CONNECTED AMPS PER PHASE =       15         NEC DIVERSIFIED LOAD CALCULATIONS
		LIGHTING & CONTINUOUS LOADS:- 100% CONNECTED LOAD PLUS 25%DIVERSIFIED TOTAL kVA = 5RECEPTACLES:- FIRST 10kVA @ 100%, REMAINDER @ 50%AVERAGE AMPS PER PHASE = 15
		ALL OTHER LOADS @ 100% : 5.3 KVA - MOTOR TOTALS INCLUDED IN ALL OTHER LOADS WITH LARGEST MOTOR CALCULATED @ 125% PER NEC
		BKR: GF=GFCI, GF3=30mA GFCI CAPABLE OF BEING LOCAKED OUT IN OPEN POSITION, IG=ISOLATED GROUND, AF=AFCI, ST=SHUNT TRIP, RED=PROVIDE RED COLORED BREAKER, AF=ARC FAULT CURRENT INTERRUPTER, GA=COMBINATION OF GROUND FAULT AND ARC FAULT CIRCUIT INTERRUPTER, GS=COMBINATION OF SHUNT TRIP WITH GFCI

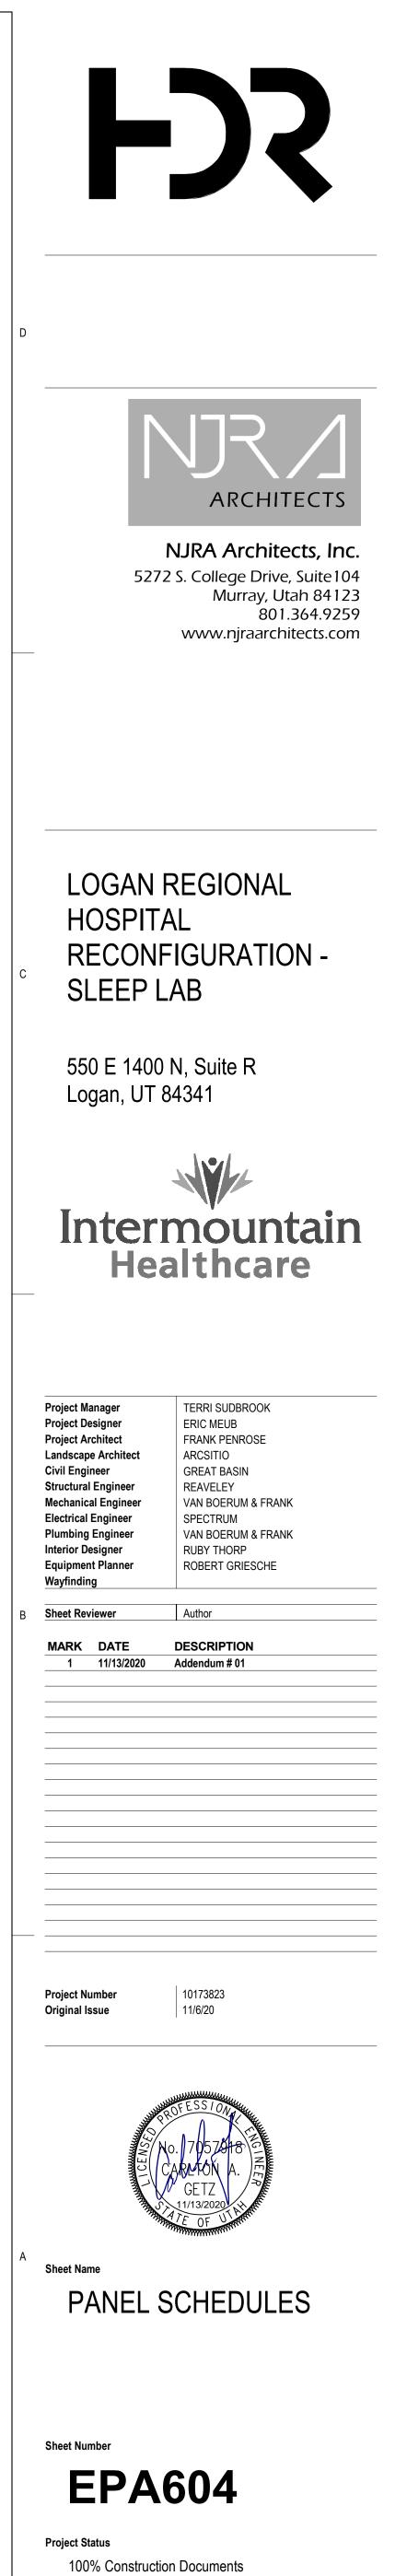


5	


5

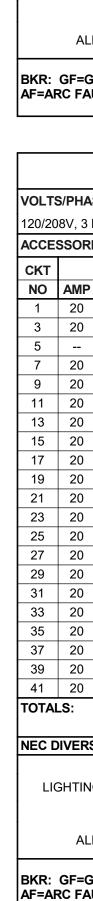

PANEL: "4H1E"(EXISTING)         VOLTS/PHASE/WIRE:       PANEL SIZE & TYPE:       MAIN SIZE AND TYPE:       FED FROM:       CABINET:       LOCATION:       NOTES:	PANEL: "4EQL"(EXISTING)         VOLTS/PHASE/WIRE:       PANEL SIZE & TYPE:       MAIN SIZE AND TYPE:       FED FROM:       CABINET:       LOCATION:       NOTES:
480/277 V, 3 PH 4 WIRE       22" W x 6" D, BOLT-ON       100 AMPERE MAIN LUGS       SURFACE       ELEC. A419         ACCESSORIES:       PANEL DIRECTORY, IDENTIFICATION, GROUNDING BAR       AIC RATING: (EXISTING)	120/208V, 3 PH 4 WIRE       22" W x 6" D, BOLT-ON       125 AMPERE MAIN LUGS       SURFACE       ELEC. A419         ACCESSORIES:       PANEL DIRECTORY, IDENTIFICATION, GROUNDING BAR       AIC RATING: (EXISTING)
CKT         OCP         LOAD (kVA)         PHASE LOAD         LOAD (kVA)         OCP         CKT           NO         AMP         POLE         BKR         LTG         PWR         CO         DESCRIPTION         A         B         C         DESCRIPTION         CO         PWR         LTG         BKR         POLE         AMP         NO	CKT         OCP         LOAD (kVA)         PHASE LOAD         LOAD (kVA)         OCP         CKT           NO         AMP         POLE         BKR         LTG         PWR         CO         DESCRIPTION         A         B         C         DESCRIPTION         CO         PWR         LTG         BKR         POLE         AMP         NO         AMP         AMP         AMP         AMP         DESCRIPTION         CO         PWR         LTG         BKR         POLE         AMP         NO
1       20       1         (EXISTING) LIGHTING LEVEL 3 EM       0.0       1.8       ASC LS LIGHTING EGRESS (LX4-8)       0.0       0.0       1.8       1       20       2         3       20       1         (EXISTING) LIGHTING WAITING       0.0       1.5       LIGHTING       0.0       0.0       1.5       1       20       4         5       20       1         (EXISTING) SPARE       0.0       1.5       0.0       0.0       (EXISTING) SPARE       1       20       4         7       20       1         (EXISTING) SPARE       0.0       0.0       0.0       (EXISTING) SPARE        1       20       8         0       1         (EXISTING) SPARE       0.0       0.0       (EXISTING) SPARE        1       20       8	1       20       2          (EXISTING) AC-7       0.0       0.0        (EXISTING) 4L1UA THRU UPS#5          3       50       2         3             0.0       0.0           3       50       2         3               4         5       20       2          (EXISTING) AC-8        0.0       0.0           4         7          (EXISTING) AC-8         0.0       0.0           4         7           0.0       0.0         0.0       10        10
9       20       1          (EXISTING) SPARE       0.0       0.0       (EXISTING) SPARE         1       20       10         11       20       1         (EXISTING) SPARE        0.0       0.0       0.0       (EXISTING) SPARE         1       20       10         11       20       1         (EXISTING) SPARE        0.0       0.0       (EXISTING) SPARE        1       20       12         13       20       1         (EXISTING) SPARE       0.0       0.0       0.0       (EXISTING) SPARE        1       20       14	9       20       1         (EXISTING) 4L2-1 RECEPTACLE       0.0       0.0            10         11       20       1          (EXISTING) EF-3        0.0       0.0       0.0       0.0            12         13       20       1         (EXISTING) EF-2       0.0       0.0        (EXISTING) EF-4         1       20       14
15       20       1          (EXISTING) SPARE       0.0       0.0       0.0       (EXISTING) SPARE         1       20       16         17       20       1         (EXISTING) SPARE        0.0       0.0       0.0       (EXISTING) SPARE        1       20       16         19       20       1         (EXISTING) SPARE       0.0       0.0       (EXISTING) SPARE         1       20       18         19       20       1         (EXISTING) SPARE       0.0       0.0        (EXISTING) SPARE        1       20       18         21       20       1         (EXISTING) SPARE       0.0       0.0        (EXISTING) SPARE         1       20       20         21       20       1          (EXISTING) SPARE        1       20       22	15       20       1         (EXISTING) VAV CONTROLS        0.0       0.0       (EXISTING) ROOF CO         1       20       16         17       20       1         (EXISTING) OUTLET ROOF         1       20       18         19       30       2         (EXISTING) DATA RACK 1       0.0       0.0        (EXISTING) SPARE         1       20       20         21            0.0       0.7        VAV BOXES       0.0       0.7       0.0       0.7       0.0       1       20       12
23       20       1          (EXISTING) SPARE        1       20       24         25       20       1          (EXISTING) SPARE       0.0       0.0       (EXISTING) SPARE        1       20       24         25       20       1         (EXISTING) SPARE       0.0       0.0       (EXISTING) SPARE        1       20       26         27       20       1         (EXISTING) SPARE       0.0       0.0       0.0       (EXISTING) SPARE         1       20       28	23       30       2          (EXISTING) DATA RACK 2       -       0.0       1.2       0.0       1.2       0.0       1       20       24         25           0.0       0.9        EF-1       0.0       1.2       0.0       1       20       24         25           0.0       0.9        EF-2       0.0       0.9       0.0       1       15       26         27       20       1         (EXISTING) SPARE       0.0       0.8        EF-3       0.0       1.6       0.0       2       15       28
29       20       1         (EXISTING) SPARE       0.0       0.0       (EXISTING) SPARE         1       20       30         31       20       1         (EXISTING) SPARE       0.0       0.0       (EXISTING) SPARE         1       20       30         33       20       1         (EXISTING) SPARE       0.0       0.0       (EXISTING) SPARE        1       20       32         33       20       1         (EXISTING) SPARE       0.0       0.0       (EXISTING) SPARE        1       20       34         35       20       1         (EXISTING) SPARE       0.0       0.0       (EXISTING) SPARE         1       20       34	29       20       1         (EXISTING) SOILED ROOM       -       0.0       0.8            30         31       30       2          (EXISTING) DATA RACK 3       0.0       0.8        EF-3       0.0       1.6       0.0       2       15       32         33            0.0       0.8           30         35       1       20       1       0.0       0.2       0.0       AUTO REGISTRATION DOOR       0.2       0.9       EF-4       0.0       0.9       0.0       1       15       36
30       20       1         (EXISTING) SPARE       0.0       0.0       (EXISTING) SPARE         1       20       38         39       20       1         (EXISTING) SPARE       0.0       0.0       (EXISTING) SPARE         1       20       38         41       20       1         (EXISTING) SPARE       0.0       0.0       (EXISTING) SPARE        1       20       40         41       20       1         (EXISTING) SPARE       0.0       0.0       (EXISTING) SPARE        1       20       40         41       20       1         (EXISTING) SPARE       0.0       0.0       (EXISTING) SPARE         1       20       42         TOTALS:       CONNECTED kVA PER PHASE       2       1       0       CONNECTED TOTAL kVA =       3	37       20       1       0.0       1.6       0.0       AHU-3 LIGHTING/OUTLETS       1.6       0.1       0.0       0.1       0.0       0.1       0.0       1       20       38         39       20       1       0.0       0.4       0.0       OR 1 AUTO WINDO POWER       0.
CONNECTED AMPS PER PHASE       7       6       0       AVERAGE CONNECTED AMPS PER PHASE =       4         NEC DIVERSIFIED LOAD CALCULATIONS	CONNECTED AMPS PER PHASE       29       36       25       AVERAGE CONNECTED AMPS PER PHASE =       30         NEC DIVERSIFIED LOAD CALCULATIONS
LIGHTING & CONTINUOUS LOADS: 3.2 kVA @ 125% = 4.0 kVA       - 100% CONNECTED LOAD PLUS 25%       DIVERSIFIED TOTAL kVA = 4         RECEPTACLES:       - FIRST 10kVA @ 100%, REMAINDER @ 50%       AVERAGE AMPS PER PHASE = 5         MOTOR TOTAL & INCLUDED IN ALL OTUER LOADS WITH       - OLDER WITH	LIGHTING & CONTINUOUS LOADS:       - 100% CONNECTED LOAD PLUS 25%       DIVERSIFIED TOTAL kVA = 11         RECEPTACLES:       - FIRST 10kVA @ 100%, REMAINDER @ 50%       AVERAGE AMPS PER PHASE = 31
ALL OTHER LOADS @ 100% : 0.0 kVA - MOTOR TOTALS INCLUDED IN ALL OTHER LOADS WITH LARGEST MOTOR CALCULATED @ 125% PER NEC BKR: GF=GFCI, GF3=30mA GFCI CAPABLE OF BEING LOCAKED OUT IN OPEN POSITION, IG=ISOLATED GROUND, AF=AFCI, ST=SHUNT TRIP, RED=PROVIDE RED COLORED BREAKER,	ALL OTHER LOADS @ 100% : 11.2 kVA - MOTOR TOTALS INCLUDED IN ALL OTHER LOADS WITH LARGEST MOTOR CALCULATED @ 125% PER NEC BKR: GF=GFCI, GF3=30mA GFCI CAPABLE OF BEING LOCAKED OUT IN OPEN POSITION, IG=ISOLATED GROUND, AF=AFCI, ST=SHUNT TRIP, RED=PROVIDE RED COLORED BREAKER,
AF=ARC FAULT CURRENT INTERRUPTER, GA=COMBINATION OF GROUND FAULT AND ARC FAULT CIRCUIT INTERRUPTER, GS=COMBINATION OF SHUNT TRIP WITH GFCI	AF=ARC FAULT CURRENT INTERRUPTER, GA=COMBINATION OF GROUND FAULT AND ARC FAULT CIRCUIT INTERRUPTER, GS=COMBINATION OF SHUNT TRIP WITH GFCI
PANEL SIZE & TYPE:       MAIN SIZE AND TYPE:       FED FROM:       CABINET:       LOCATION:       NOTES:	VOLTS/PHASE/WIRE:       PANEL SIZE & TYPE:       MAIN SIZE AND TYPE:       FED FROM:       CABINET:       LOCATION:       NOTES:
480/277 V, 3 PH 4 WIRE       22" W x 6" D, BOLT-ON       200 AMPERE MAIN CB       SURFACE       ELEC. A419         ACCESSORIES:       PANEL DIRECTORY, IDENTIFICATION, GROUNDING BAR       AIC RATING: (EXISTING)	120/208V, 3 PH 4 WIRE       22" W x 6" D, BOLT-ON       175 AMPERE MAIN CB       SURFACE       ELEC. A419         ACCESSORIES:       PANEL DIRECTORY, IDENTIFICATION, GROUNDING BAR       AIC RATING: (EXISTING)
CKT $\overrightarrow{OCP}$ $\overrightarrow{LOAD}$ (kVA) $\overrightarrow{OCP}$ $\overrightarrow{CKT}$ NOAMPPOLEBKRLTGPWRCODESCRIPTION $\overrightarrow{AMP}$ $\overrightarrow{B}$ $\overrightarrow{C}$ DESCRIPTION $\overrightarrow{COP}$ $\overrightarrow{CKT}$ 1201(EXISTING) LTG PROCEDURE0.00.0(EXISTING) PANEL LCB4 THRU T631002	CKT $\overrightarrow{OCP}$ $\overrightarrow{LOAD}(kVA)$ $\overrightarrow{OCP}$ $\overrightarrow{LOAD}(kVA)$ $\overrightarrow{OCP}$ $\overrightarrow{OCP}$ $\overrightarrow{CKT}$ NOAMPPOLEBKR $\overrightarrow{LG}$ PWRCODESCRIPTION $\overrightarrow{AVP}$ $\overrightarrow{BV}$ $\overrightarrow{DESCRIPTION}$ $\overrightarrow{CO}$ PWR $\overrightarrow{LG}$ BKRPOLEAMPNO1201(EX)CORECOVERY#1411200.00.0 $\overrightarrow{CV}$ (EXISTING)CORECOVERY1202 $\overrightarrow{CV}$ (EX)CORECOVERY#1411200.00.0 $\overrightarrow{CV}$ (EXISTING)CORECOVERY1202 $\overrightarrow{CV}$ (EX)CORECOVERY#1411200.00.00.0(EXISTING)CORECOVERY1202
3       20       1          (EXISTING) LTG HALL 41119       0.0       0.0            4         5       20       1          (EXISTING) LTG OR3       -        0.0       0.0            4         7       20       1       1.7       0.0       0.0       OR         0.0       0.0           4         9       20       1       1.7       0.0       0.0       OR1 LIGHTING       1.7       0.0           2       30       8         9       20       1       1.7       0.0       0.0       Interview       1.7       0.0          2       30       8         9       20       1       1.7       0.0       0.0       Interview       1.7       0.0          10         141       20       1       2.4       2.4       2.4       2.4       2.4       2.4       2.4	3       20       1         (EX) CO RECOVERY #2 41121       0.0       0.0       (EXISTING) CO RECOVERY         1       20       4         5       20       1         (EX) CO RECOVERY #3 41122        0.0       0.0       (EXISTING) SPARE (OFF)         1       20       6         7       20       1         (EX) CO RECOVERY #4 41123       0.0       0.0        (EX) SCOPE COMPRESSOR         1       20       8         9       20       1         (EXISTING) SPARE       0.
11       20       1       2.1       0.0       0.0       LIGHTING       -       2.1       0.0       PANEL OR2A & B         2       30       12         13       20       1       1.8       0.0       0.0       LIGHTING       1.8       0.0          2       30       12         15       20       1         (EXISTING) SPARE       0.0       0.0        PANEL OR3A & B         2       30       16	11       20       1         (EXISTING) PANEL CO       -       0.
17       20       1          (EXISTING) SPARE       0.0       0.0           18         19       20       1          (EXISTING) SPARE       0.0       0.0        (EXISTING) SPARE        18         19       20       1         (EXISTING) SPARE       0.0       0.0        (EXISTING) SPARE        1       20       20         21       20       1         (EXISTING) SPARE       0.0       0.0       (EXISTING) SPARE        1       20       20         23       20       1         (EXISTING) SPARE       0.0       0.0       (EXISTING) SPARE         1       20       24	17       20       1         (EX) PWR NURSE STATION 41117        0.0       0.2       0.0       0.1       20       18         19       20       1         (EX) PWR NURSE STATION 41117       0.0       0.2       PNEUMATIC TUBE STATION       0.0       0.2       0.0       1       20       18         19       20       1         (EXISTING) CO PRE-OP 41113       0.0       0.8        REF STAFF BREAK ROOM A452       0.0       0.8       0.0       1       20       20         21       20       1         (EXISTING) CO PRE-OP 41112        0.0       1.1       0.0       0.0       0.0       1       20       22         23       20       1         (EX) CO NURSE STATION 41111         0.0       1.4       CO NURSE STATION A440       1.4       0.0       0.0       1       20       24
25       20       1         (EXISTING) SPARE       0.0       0.0       (EXISTING) SPARE         1       20       26         27       20       1         (EXISTING) SPARE       0.0       0.0       0.0       (EXISTING) SPARE         1       20       26	25       20       1         (EXISTING) CO PRE-OP 41113       0.0       0.7       0.0       0.7       0.0       0.0       1       20       26         27       20       1         (EXISTING) CO PRE-OP 41112       0.0       0.9       0.0       0.0       0.0       1       20       26
29       20       1          (EXISTING) SPARE       0.0       0.0       (EXISTING) SPARE         1       20       30         31       20       1         (EXISTING) SPARE       0.0       0.0       (EXISTING) SPARE         1       20       32         33       20       1         (EXISTING) SPARE       0.0       0.0       0.0       (EXISTING) SPARE        1       20       32         33       20       1         (EXISTING) SPARE       0.0       0.0       0.0       (EXISTING) SPARE        1       20       34         35       20       1         (EXISTING) SPARE       0.0       0.0       (EXISTING) SPARE         1       20       36         37       20       1         (EXISTING) SPARE       0.0       0.0       (EXISTING) SPARE        1       20       38	29       20       1         (EXISTING) PWR TUBE       0.0       1.0       PRINTER CONTROL DESK A444       0.0       1.0       0.0       1       20       30         31       20       1         (EXISTING) RECEPTION 41100       0.0       1.1       0.0       0.0       1       20       32         33       20       1         (EXISTING) CO INTAKE 41102        0.0       1.1       0.0       0.0       1       20       34         35       20       1         (EXISTING) CO BREAK RM FRIDGE        0.0       1.1       CO PREP/RECOVERY 3 A405       1.1       0.0       0.0       1       20       34         35       20       1         (EXISTING) CO BREAK RM FRIDGE        0.0       1.1       CO PREP/RECOVERY 4 A418       1.1       0.0       0.0       1       20       36         37       20       1         (EX) CO ENDO REPROCESSING       0.0       11       CO PREP/RECOVERY 5 A425       11       0.0       0.0       1       20       38
37       20       1          (EXISTING) SPARE       0.0       0.0       0.0       (EXISTING) SPARE         1       20       38         39       20       1         (EXISTING) SPARE       0.0       0.0       0.0       (EXISTING) SPARE        1       20       38         41       20       1         (EXISTING) SPARE       0.0       0.0       (EXISTING) SPARE        1       20       40         41       20       1         (EXISTING) SPARE       0.0       0.0       (EXISTING) SPARE        1       20       40         41       20       1         (EXISTING) SPARE       0.0       0.0       (EXISTING) SPARE        1       20       42         TOTALS:       CONNECTED kVA PER PHASE       3       2       2       CONNECTED tVA = T       T	39       20       1         (EX) PWR NURSE STATION 41117        0.0       1.1       0.0       0.0       1.1       0.
CONNECTED AMPS PER PHASE       13       6       8       AVERAGE CONNECTED AMPS PER PHASE =       9         NEC DIVERSIFIED LOAD CALCULATIONS	45       20       1         (EXISTING) PWR ENDOSCOPE       0.0       1.1       0.0       0.0       1       20       46         47       20       1         (EXISTING) PWR HALL 41025       0.0       1.0       CO PREP RECOVERY 2 A426       1.1       0.0       0.0       1       20       48         49       20       1         (EXISTING) CO WRKSTATION       0.0       0.2       0       0.0       1.0       0.0       0.1       0.0       1       20       48
LIGHTING & CONTINUOUS LOADS: 7.2 kVA @ 125% = 9.0 kVA       - 100% CONNECTED LOAD PLUS 25%       DIVERSIFIED TOTAL kVA = 9         RECEPTACLES:       - FIRST 10kVA @ 100%, REMAINDER @ 50%       AVERAGE AMPS PER PHASE = 11         MOTOR TOTALS INCLUDED IN ALL OTHER LOADS WITH       MOTOR TOTALS INCLUDED IN ALL OTHER LOADS WITH	51       20       1         (EX) PWR RM 41112, 13, 16, 17       -       0.0       1.5       MW NOURISHMENT A419       0.0       1.5       0.0       1       20       52         53       20       1         (EX) PWR RM 41109, 10, 14, 17       -       -       0.0       1.0       0.0       1.0       1.0       0.0       1.0       0.0       1       20       54         55       20       1         (EX) HANDICAP DOOR OR3       0.0       1.0       -       POWER NOURISHMENT A419       0.0       1.0       0.0       1       20       56
ALL OTHER LOADS @ 100% : 0.0 kVA - LARGEST MOTOR CALCULATED @ 125% PER NEC BKR: GF=GFCI, GF3=30mA GFCI CAPABLE OF BEING LOCAKED OUT IN OPEN POSITION, IG=ISOLATED GROUND, AF=AFCI, ST=SHUNT TRIP, RED=PROVIDE RED COLORED BREAKER, AF=ARC FAULT CURRENT INTERRUPTER, GA=COMBINATION OF GROUND FAULT AND ARC FAULT CIRCUIT INTERRUPTER, GS=COMBINATION OF SHUNT TRIP WITH GFCI	57       20       1         (EXISTING) NURSE 3 COLUMN CO       0.0       1.4       0.0       0.0       1       20       58         59       20       1         (EXISTING) MED AU        60       1.4       0.0       1.4       0.0       0.0       1       20       60         61       20       1         (EXISTING) SPARE (OFF)       0.0       1.4       0.0       1.4       0.0       0.0       1       20       62         63       20       1         (EXISTING) NUTRITION CO       0.0       1.4       0.0       0.0       1       20       62         65       20       1         (EXISTING) NUTRITION CO       0.0       1.4       0.0       0.7       0.0       0.0       1       20       64
PANEL: "BEQL"(EXISTING)	63       20       1         (EXISTING) NUTRITION CO       0.0       0.0       0.0       0.0       0.0       0.0       0.0       1       20       00         67       20       1         (EXISTING) NUTRITION CO       0.0       1.8        FREEZER O.R. EQUIPMENT A430       0.0       1.8       0.0       1       1       20       68         69       20       1         (EXISTING) PRE-OP 3       0.0       0.4        CO SCRUB ALCOVES       0.2       0.0       GFCI       1       20       70         71       20       1         (EXISTING) PRE-OP 3       0.0       0.0       1.0       REF ANESTHESIA WORKROOM A445       0.0       1.0       0.0       GFCI       1       20       72
VOLTS/PHASE/WIRE:     PANEL SIZE & TYPE:     MAIN SIZE AND TYPE:     FED FROM:     CABINET:     LOCATION:     NOTES:       120/208V, 3 PH 4 WIRE     22" W x 6" D, BOLT-ON     125 AMPERE MAIN LUGS     SURFACE     EMERGENCY	73       20       1         (EXISTING) AC UNIT FAN COIL       0.0       0.5       Image: Constraint of the state of the
ACCESSORIES:         PANEL DIRECTORY, IDENTIFICATION, GROUNDING BAR         AIC RATING: (EXISTING)           CKT         OCP         LOAD (kVA)         OCP         CKT	79       20       1       0.0       0.2       0.0       REF. O.R. FOURMENT A430       0.2       0.8       Image: Constraint of the second seco
NOAMPPOLEBKRLTGPWRCODESCRIPTIONABCDESCRIPTIONCOPWRLTGBKRPOLEAMPNO1201(EXISTING)AH POWER CNTRLS0.00.0(EXISTING)BLUIU THRU UPS #135023202(EXISTING)AC-1,AC-2,AC-30.00.0450.00.04	83       20       1         (EXISTING) SPARE (OFF)       0.0       1.3       CO NURSE STATION A440       1.3       0.0       0.0       1       20       84         TOTALS:       CONNECTED kVA PER PHASE       12       12       12       CONNECTED TOTAL kVA =       36         CONNECTED AMPS PER PHASE       97       105       105       AVERAGE CONNECTED AMPS PER PHASE =       101         NEC DIVERSIFIED LOAD CALCULATIONS
7       20       1         (EXISTING) CO EM DISTRIBUTION       0.0       0.0       0.0       0.0       0.0       (EXISTING) PWR ELEV REMOTE         1       20       8         9       20       1         (EXISTING) ELEV REMOTE RM       0.0       1.2       0.0       1.2       0.0       1.2       0.0       1       10         11       20       1         (EXISTING) SP-2        0.0       0.0       0.0       0.0       1       12	LIGHTING & CONTINUOUS LOADS:       - 100% CONNECTED LOAD PLUS 25%       DIVERSIFIED TOTAL kVA = 30         RECEPTACLES:       22.7 kVA @ 72% = 16.3 kVA       - FIRST 10kVA @ 100%, REMAINDER @ 50%       AVERAGE AMPS PER PHASE = 84
13       20       1         (EXISTING) RCP-1       0.0       0       0       0       0       0       14         15       20       1         (EXISTING) OTHER       0.0       0.6       0       0.0       0.6       0.0	ALL OTHER LOADS @ 100% : 13.8 KVA - MOTOR TOTALS INCLUDED IN ALL OTHER LOADS WITH LARGEST MOTOR CALCULATED @ 125% PER NEC
19       20       1          (EXISTING) HX-1       0.0       0.0        (EXISTING) SPARE         1       20       20         21       20       1         (EXISTING) HX-8       0.0       0.0       (EXISTING) SPARE         1       20       22         23       20       1         (EXISTING) SPARE        0.0       0.0       (EXISTING) SPARE        1       20       22         23       20       1         (EXISTING) SPARE        0.0       0.0       (EXISTING) SPARE        1       20       24	BKR: GF=GFCI, GF3=30mA GFCI CAPABLE OF BEING LOCAKED OUT IN OPEN POSITION, IG=ISOLATED GROUND, AF=AFCI, ST=SHUNT TRIP, RED=PROVIDE RED COLORED BREAKER, AF=ARC FAULT CURRENT INTERRUPTER, GA=COMBINATION OF GROUND FAULT AND ARC FAULT CIRCUIT INTERRUPTER, GS=COMBINATION OF SHUNT TRIP WITH GFCI
25       20       1          (EXISTING) SPARE       0.0       0.0        (EXISTING) SPARE        1       20       26         27       20       1         (EXISTING) SPARE       0.0       0.0        (EXISTING) SPARE        1       20       26         29       20       1         (EXISTING) SPARE       0.0       0.0        (EXISTING) SPARE        1       20       28         29       20       1         (EXISTING) SPARE       0.0       0.0       (EXISTING) SPARE         1       20       28	PANEL: "4EQL2"(NEW)         VOLTS/PHASE/WIRE:       PANEL SIZE & TYPE:       MAIN SIZE AND TYPE:       1       FED FROM:       CABINET:       LOCATION:       NOTES:
31       20       1          (EXISTING) SPARE       0.0       0.0       0.0       0.0       0.0       0.0       (EXISTING) SPARE         1       20       32         33       20       1         (EXISTING) SPARE       0.0       0.0       0.0       0.0       (EXISTING) SPARE        1       20       32         35       20       1         (EXISTING) SPARE       0.0       0.0       0.0       (EXISTING) SPARE        1       20       34         35       20       1         (EXISTING) SPARE       0.0       0.0       0.0       (EXISTING) SPARE         1       20       34	120/208V, 3 PH 4 WIRE       22" W x 6" D, BOLT-ON       125 AMPERE MAIN LUGS       SURFACE       ELEC. A419         ACCESSORIES:       PANEL DIRECTORY, IDENTIFICATION, GROUNDING BAR       AIC RATING: 22000
37       20       1          (EXISTING) SPARE       0.0	CKT $\overrightarrow{OCP}$ $\overrightarrow{LOAD}(\overrightarrow{kVA})$ $\overrightarrow{OCP}$ $\overrightarrow{LOAD}(\overrightarrow{kVA})$ $\overrightarrow{OCP}$ $\overrightarrow{OCP}$ $\overrightarrow{CKT}$ NOAMPPOLEBKRLTGPWRCODESCRIPTION $\overrightarrow{A}$ B $\overrightarrow{C}$ DESCRIPTIONCOPWRLTGBKRPOLEAMPNO12010.00.20.0STERILIZER0.20.5 $\overrightarrow{C}$ STERILE PROCESS WORK STATION0.00.50.01202
TOTALS:       CONNECTED kVA PER PHASE       0       2       0       CONNECTED TOTAL kVA =       2         CONNECTED AMPS PER PHASE       0       15       0       AVERAGE CONNECTED AMPS PER PHASE =       5         NEC DIVERSIFIED LOAD CALCULATIONS       0       15       0       AVERAGE CONNECTED AMPS PER PHASE =       5	3       30       3       0.0       5.8       0.0       STERILIZER       1.9       0.5       STERILE PROCESS WORK STATION       0.0       0.5       0.0       1       20       4         5            1.9       0.4       1.9       0.4       UNITY ULTRASONIC REG       0.0       1.1       0.0       3       20       6         7         1.9       0.4          4        8

RECEPTACLES:       - FIRST 10kVA @ 100%, REMAINDER @ 50%       AVERAGE AMPS PER PHASE = 6         ALL OTHER LOADS @ 100% :       2.0 kVA       MOTOR TOTALS INCLUDED IN ALL OTHER LOADS WITH LARGEST MOTOR CALCULATED @ 125% PER NEC	15       20       1         SPARE       0.0       0.9       0.0       FSD       0.0       0.9       0.0       1       20       16         17       20       1         SPARE        SPARE        0.0       1.5       CABINATE WARMER       0.0       1.5       0.0       1       20       18         19       20       1         SPARE       0.0       0.0        SPARE        1       20       20
BKR: GF=GFCI, GF3=30mA GFCI CAPABLE OF BEING LOCAKED OUT IN OPEN POSITION, IG=ISOLATED GROUND, AF=AFCI, ST=SHUNT TRIP, RED=PROVIDE RED COLORED BREAKER, AF=ARC FAULT CURRENT INTERRUPTER, GA=COMBINATION OF GROUND FAULT AND ARC FAULT CIRCUIT INTERRUPTER, GS=COMBINATION OF SHUNT TRIP WITH GFCI	19       20       1          SPARE       0.0       0.0       0
	27       20       1         SPARE       -       0.0       0.0       0.0       SPARE         1       20       28         29       20       1         SPARE        0.0       0.0       0.0       SPARE        1       20       28         31       20       1         SPARE       0.0       0.0       SPARE        1       20       30
	33       20       1          SPARE        0.0       0.0       0.0       0.0       SPARE         1       20       34         35       20       1         SPARE        SPARE        1       20       34         37       20       1         SPARE       0.0       0.0        SPARE        1       20       36
	39       20       1         SPARE       0.0       0.0       SPARE         1       20       40         41       20       1         SPARE       0.0       0.0       SPARE         1       20       40         TOTALS:       CONNECTED kVA PER PHASE       4       4       5       CONNECTED TOTAL kVA =       13
	CONNECTED AMPS PER PHASE       4       4       5       CONNECTED TOTAL KVA -       13         CONNECTED AMPS PER PHASE       33       35       45       AVERAGE CONNECTED AMPS PER PHASE =       37         NEC DIVERSIFIED LOAD CALCULATIONS
	LIGHTING & CONTINUOUS LOADS: - 100% CONNECTED LOAD PLUS 25% DIVERSIFIED TOTAL kVA = 13 RECEPTACLES: - FIRST 10kVA @ 100%, REMAINDER @ 50% AVERAGE AMPS PER PHASE = 37
	ALL OTHER LOADS @ 100% : 13.5 kVA
	BKR: GF=GFCI, GF3=30mA GFCI CAPABLE OF BEING LOCAKED OUT IN OPEN POSITION, IG=ISOLATED GROUND, AF=AFCI, ST=SHUNT TRIP, RED=PROVIDE RED COLORED BREAKER, AF=ARC FAULT CURRENT INTERRUPTER, GA=COMBINATION OF GROUND FAULT AND ARC FAULT CIRCUIT INTERRUPTER, GS=COMBINATION OF SHUNT TRIP WITH GFCI
4	2

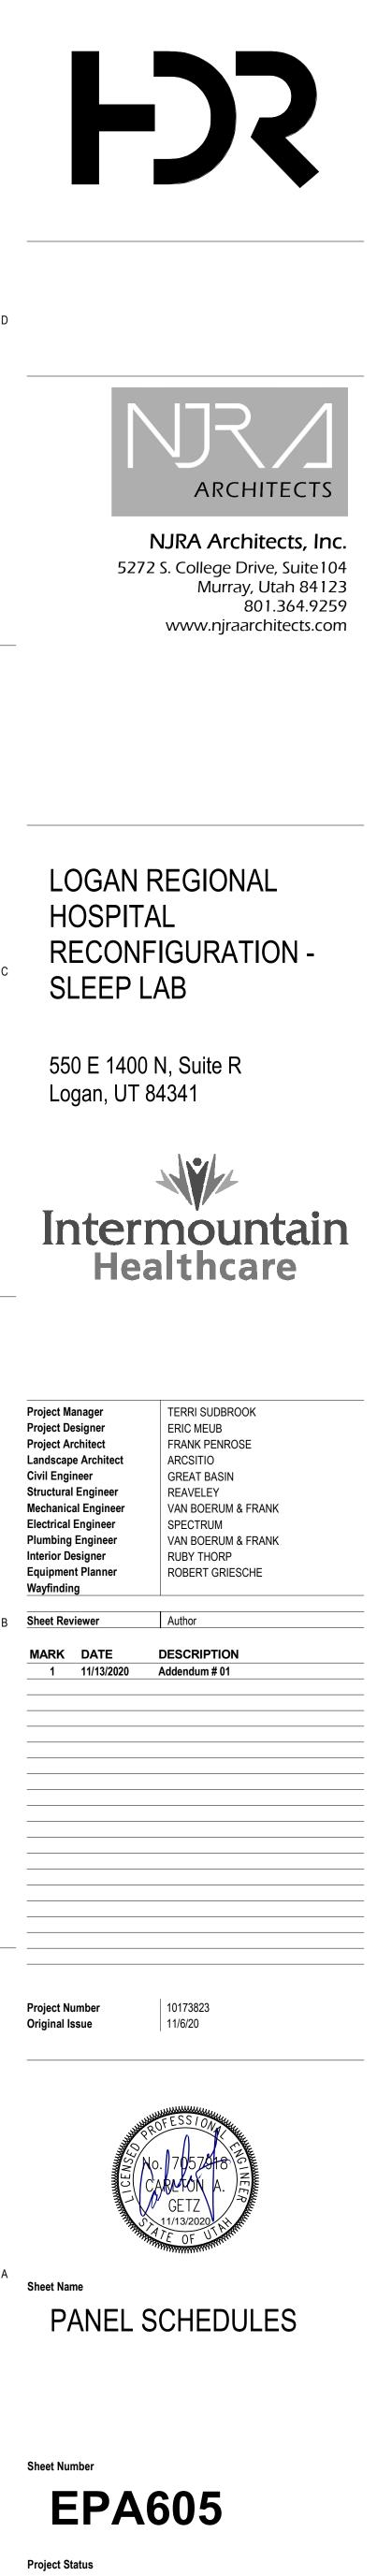

100% Construction Documents

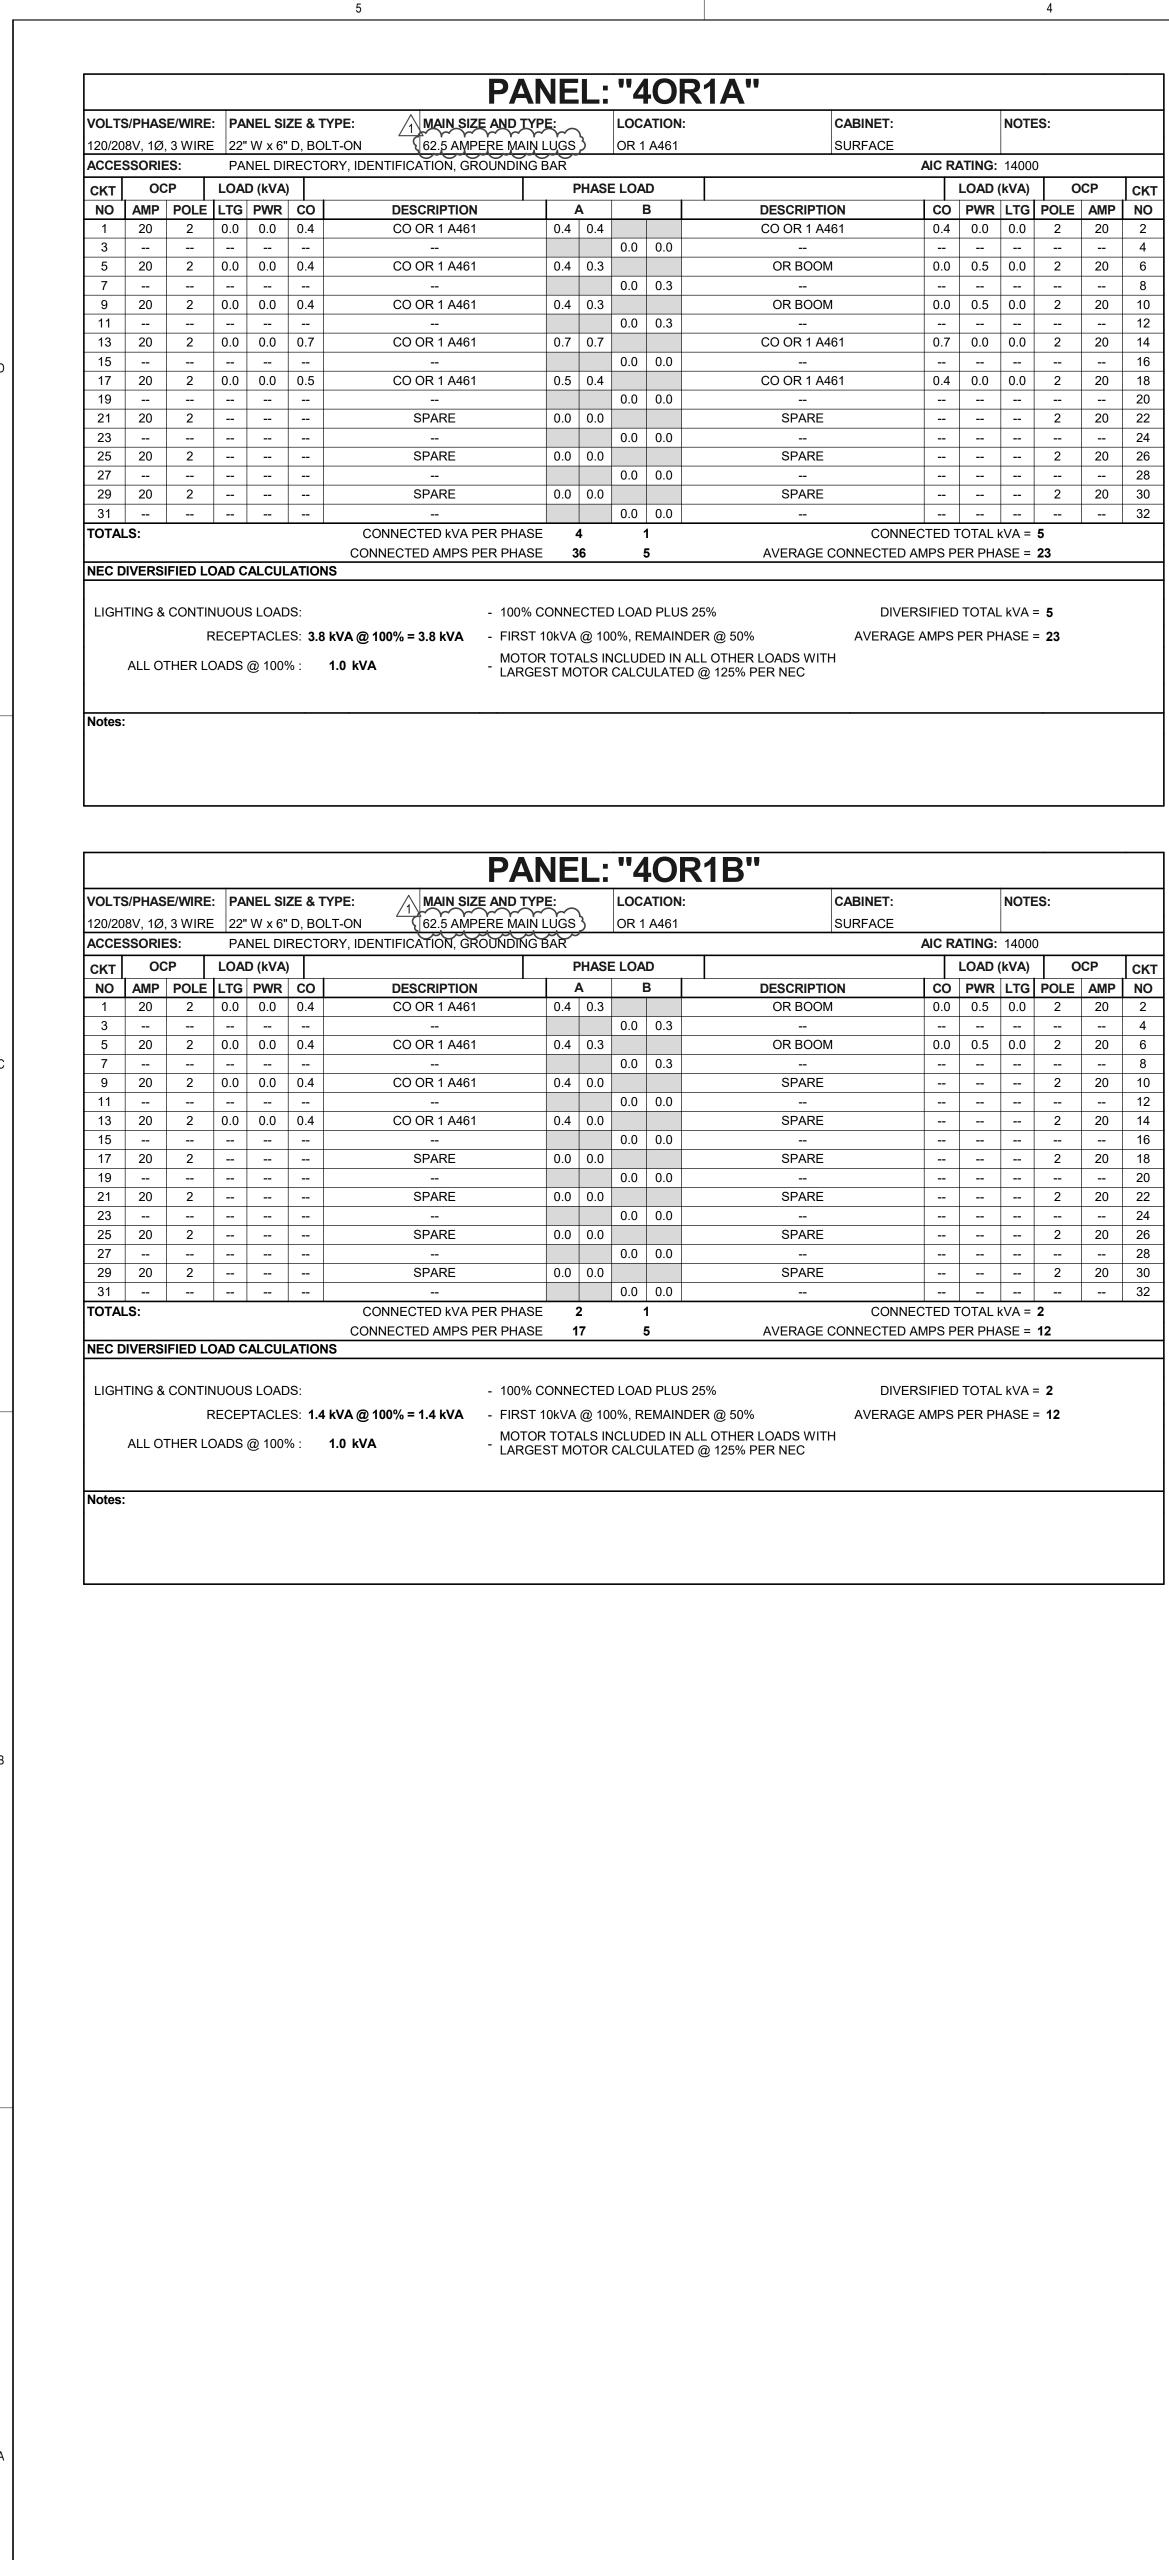

0	СР	СКТ
	AMP	NO
	20	2
		4
	20	6
		8
	20	10
		12
	20	14
		16
	20	18
		20
	20	22
		24
	20	26
		28
	20	30
		32

:								PAI	١E	L	"4	<b>O</b>	R2A"						
		VOLT	S/PHAS	E/WIRE	: PA		ZE & 1	TYPE: 1 MAIN SIZE AND TYP	E: _		LOCA	ATION:	CABINET:			NOTE	S:		
		120/20	)8V. 1Ø.	, 3 WIRE	- 22"	W x 6"	D. BC			3	OR 2	A448	SURFACE						
	1		SSORIE					ORY, IDENTIFICATION, GROUNDING I							ATING:	14000	)		
скт	1	скт	00			D (kVA)				PHASE					LOAD (			СР	скт
NO		NO		POLE		· · · ·	co	DESCRIPTION	ı —	4	E		DESCRIPTION	co	· · · ·	<i>,</i>			NO
2		1	20	2	0.0	0.0	0.4	CO OR 2 A448	0.4	1			CO OR 2 A448	0.5	0.0	0.0	2	20	2
4		3							0.1	0.0	0.0	0.0							4
6		5	20	2	0.0	0.0	0.4	CO OR 2 A448	0.4	0.3			OR BOOM	0.0	0.5	0.0	2	20	6
8		7									0.0	0.3							8
10		9	20	2	0.0	0.0	0.4	CO OR 2 A448	0.4	0.3			OR BOOM	0.0	0.5	0.0	2	20	10
12		11									0.0	0.3							12
14		13	20	2	0.0	0.0	0.5	CO OR 2 A448	0.5	0.4			CO OR 2 A448	0.4	0.0	0.0	2	20	14
16		15									0.0	0.0							16
18		17	20	2	0.0	0.0	0.4	CO OR 2 A448	0.4	0.5			CO OR 2 A448	0.5	0.0	0.0	2	20	18
20	1	19									0.0	0.0							20
22		21	20	2	0.0	0.0	0.5	CO OR 2 A448	0.5	0.0			SPARE				2	20	22
24		23									0.0	0.0							24
26	]	25	20	2				SPARE	0.0	0.0			SPARE				2	20	26
28		27									0.0	0.0							28
30		29	20	2				SPARE	0.0	0.0			SPARE				2	20	30
32		31									0.0	0.0							32
		ΤΟΤΑ	LS:					CONNECTED kVA PER PHASE	4	4	1		CONNEC	TED <sup>-</sup>	FOTAL k	VA =	5		
								CONNECTED AMPS PER PHASE	3	8	5	<u>;                                    </u>	AVERAGE CONNECTED AM	IPS P	ER PHA	SE =	24		
	ļ	NEC D	DIVERS	IFIED LO	OAD C	ALCUL	ATIO	NS											
		LIGH	TING &	CONTII				- 100% C D kVA @ 100% = 4.0 kVA - FIRST 1					S 25% DIVERS DER @ 50% AVERAGE A				-		

MOTOR TOTALS INCLUDED IN ALL OTHER LOADS WITH LARGEST MOTOR CALCULATED @ 125% PER NEC

IASE = **24** 

DIVERSIFIED TOTAL kVA = 2

AVERAGE AMPS PER PHASE = 10

4

	PA	ANEL:	"40R2	2B"													PA	NEL	_: "4	<b>IOR3E</b>	3''						
DLTS/PHASE/WIRE: PANEL SIZE & T			LOCATION:	CABINET:			NOTE	S:		VC	OLTS	/PHASE	/WIRE:	PAN	IEL SIZE	E & TYPE:	MAIN SIZE AND I	YPE:	LOC	ATION:	CABINET:			NO	TES:		
0/208V, 1Ø, 3 WIRE 22" W x 6" D, BO			OR 2 A448	SURFACE						12	20/208	3V, 1Ø, 3	3 WIRE	22"		, BOLT-ON	62.5 AMPERE MA	Ņ LŲGS)	OR 3	3 A431	SURFACE						
CCESSORIES: PANEL DIRECTO	DRY, IDENTIFICATION, GROUNDI	NG BAR		L.	AIC R	ATING:	14000			AC	CCES	SORIE	S:	PAN		ECTORY, ID	ENTIFICATION, GROUNDIN	G BAR	I			AIC	RATIN	<b>IG:</b> 140	000		
KT OCP LOAD (KVA)		PHAS	E LOAD			LOAD (	(kVA)	0	СР	кт сі	кт	OCF	<b>&gt;</b>	LOAD	(kVA)			PH	ASE LOA	\D			LOA	AD (kVA	4)	OCP	Р
NO AMP POLE LTG PWR CO	DESCRIPTION	A	В	DESCRIPTION	co	PWR	LTG	POLE	,, I		NO	AMP	POLE	LTG	PWR 0	co	DESCRIPTION	Α		в	DESCRIPTION		O PW		G PO	LEA	
1 20 2 0.0 0.0 0.4	CO OR 2 A448	0.4 0.3		OR BOOM	0.0	0.5	0.0	2	20	2	1	20	2	0.0	0.0 0	0.4	CO OR 3 A431	0.4 0	).3		OR BOOM	0./	0 0.5	.5 0.0	ງ 2	2 7	20
3			0.0 0.3							4	3								0.0	0.3						-	
5 20 2 0.0 0.0 0.4	CO OR 2 A448	0.4 0.3		OR BOOM	0.0	0.5	0.0	2	20	6	5	20	2	0.0	0.0 0	0.4	CO OR 3 A431	0.4 0	).3		OR BOOM	0.0	0 0.5	.5 0.0	ງ 2	2 :	20
7			0.0 0.3							8	7								0.0	0.3						-	
9 20 2 0.0 0.0 0.4	CO OR 2 A448	0.4 0.0		SPARE				2	20	10 9	9	20	2	0.0	0.0 0	0.4	CO OR 3 A431	0.4 0	0.0		SPARE				2	2 :	20
11			0.0 0.0							12 1	11								0.0	0.0						-	
13 20 2	SPARE	0.0 0.0		SPARE				2	20	4	13	20	2	0.0	0.0 0	0.5	CO OR 3 A431	0.5 0	0.0		SPARE				2	2 :	20
15			0.0 0.0							16 1	15								0.0	0.0						-	
17 20 2	SPARE	0.0 0.0		SPARE				2	20	18 1	17	20	2				SPARE	0.0 0	0.0		SPARE				2	2 :	20
19			0.0 0.0							20 1	19								0.0	0.0					·	-	
21 20 2	SPARE	0.0 0.0		SPARE				2	20	22 2	21	20	2				SPARE	0.0 0	0.0		SPARE				2	2 :	20
23			0.0 0.0							24 2	23								0.0	0.0					·	-	
25 20 2	SPARE	0.0 0.0		SPARE				2	20	26 2	25	20	2				SPARE	0.0 0	0.0		SPARE				2	2 ;	20
27			0.0 0.0							28 2	27								0.0	0.0					·	-	
29 20 2	SPARE	0.0 0.0		SPARE				2	20	30 2	29	20	2				SPARE	0.0 0	0.0		SPARE				2	2 1	20
31			0.0 0.0							32 3	31								0.0	0.0						-	
DTALS:	CONNECTED kVA PER PHA CONNECTED AMPS PER PHA		1 5	CONN AVERAGE CONNECTED	ECTED 1 AMPS P					ТС	OTAL	S:		·			CONNECTED kVA PER PHA DNNECTED AMPS PER PHA			1 5	CONN AVERAGE CONNECTED	NECTED D AMPS					

Notes:

LIGHTING & CONTINUOUS LOADS:

RECEPTACLES: 1.1 kVA @ 100% = 1.1 kVA - FIRST 10kVA @ 100%, REMAINDER @ 50% ALL OTHER LOADS @ 100% : 1.0 kVA

ALL OTHER LOADS @ 100% : 1.0 kVA

- 100% CONNECTED LOAD PLUS 25%

3

MOTOR TOTALS INCLUDED IN ALL OTHER LOADS WITH

LARGEST MOTOR CALCULATED @ 125% PER NEC

VOLTS	S/PHAS	E/WIRE		NEL SI	ZE & <sup>-</sup>	TYPE: MAIN SIZE AND TYP	E;~~~	<b>`</b>	LOC	ATION	: CABINET:			NOTE	S:		
120/20	8V, 1Ø	, 3 WIRE	22"	' W x 6"	D, BC		•	<u>}</u>	OR 3	A431	SURFACE						
ACCE	SSORIE	ES:	PA	NEL DI	RECT	ORY, IDENTIFICATION, GROUNDING E	BAR						ATING:	14000	)		
скт	00	P	LOA	D (kVA)	)		F	PHAS	E LOA	D			LOAD	(kVA)	0	СР	C
NO	AMP	POLE	LTG	PWR	co	DESCRIPTION		A	E	3	DESCRIPTION	co	PWR	LTG	POLE	AMP	1
1	20	2	0.0	0.0	0.4	CO OR 3 A431	0.4	0.3			OR BOOM	0.0	0.5	0.0	2	20	
3	-								0.0	0.3							
5	20	2	0.0	0.0	0.4	CO OR 3 A431	0.4	0.3			OR BOOM	0.0	0.5	0.0	2	20	
7	-								0.0	0.3							
9	20	2	0.0	0.0	0.4	CO OR 3 A431	0.4	0.4			CO OR 3 A431	0.4	0.0	0.0	2	20	
11	-								0.0	0.0							
13	20	2	0.0	0.0	0.7	CO OR 3 A431	0.7	0.5			CO OR 3 A431	0.5	0.0	0.0	2	20	
15									0.0	0.0							
17	20	2	0.0	0.0	0.5	CO OR 3 A431	0.5	0.0			SPARE				2	20	
19									0.0	0.0							2
21	20	2				SPARE	0.0	0.0			SPARE				2	20	
23									0.0	0.0							
25	20	2				SPARE	0.0	0.0			SPARE				2	20	
27									0.0	0.0							2
29	20	2				SPARE	0.0	0.0			SPARE				2	20	
31									0.0	0.0							;
ΓΟΤΑΙ	.S:					CONNECTED kVA PER PHASE	4	4		1	CONNEC	TED	TOTAL	kVA =	4		
						CONNECTED AMPS PER PHASE	3	32	Į	5	AVERAGE CONNECTED AM	/IPS P	ER PH/	ASE =	20		
NEC D	IVERS	IFIED LC	DAD C	ALCUL	ATIO	NS											
LIGH	TING &	CONTIN	NOOR	S LOAD	S:	- 100% C	ONNE	CTE	D LOAI	D PLU	S 25% DIVERS	SIFIED	) TOTAL	_ kVA =	= 4		
		F	RECEF	PTACLE	S: 3.2	2 kVA @ 100% = 3.2 kVA - FIRST 1	0kVA	@ 10	0% R	FMAIN	IDER @ 50% AVERAGE A	MPS	PER PH	HASE =	= 20		

LIGHTING & CONTINUOUS LOADS:

2

- 100% CONNECTED LOAD PLUS 25%

DIVERSIFIED TOTAL kVA = 3

ALL OTHER LOADS @ 100% : 1.0 kVA

RECEPTACLES: 1.6 kVA @ 100% = 1.6 kVA - FIRST 10kVA @ 100%, REMAINDER @ 50%

AVERAGE AMPS PER PHASE = 13

1

MOTOR TOTALS INCLUDED IN ALL OTHER LOADS WITH LARGEST MOTOR CALCULATED @ 125% PER NEC

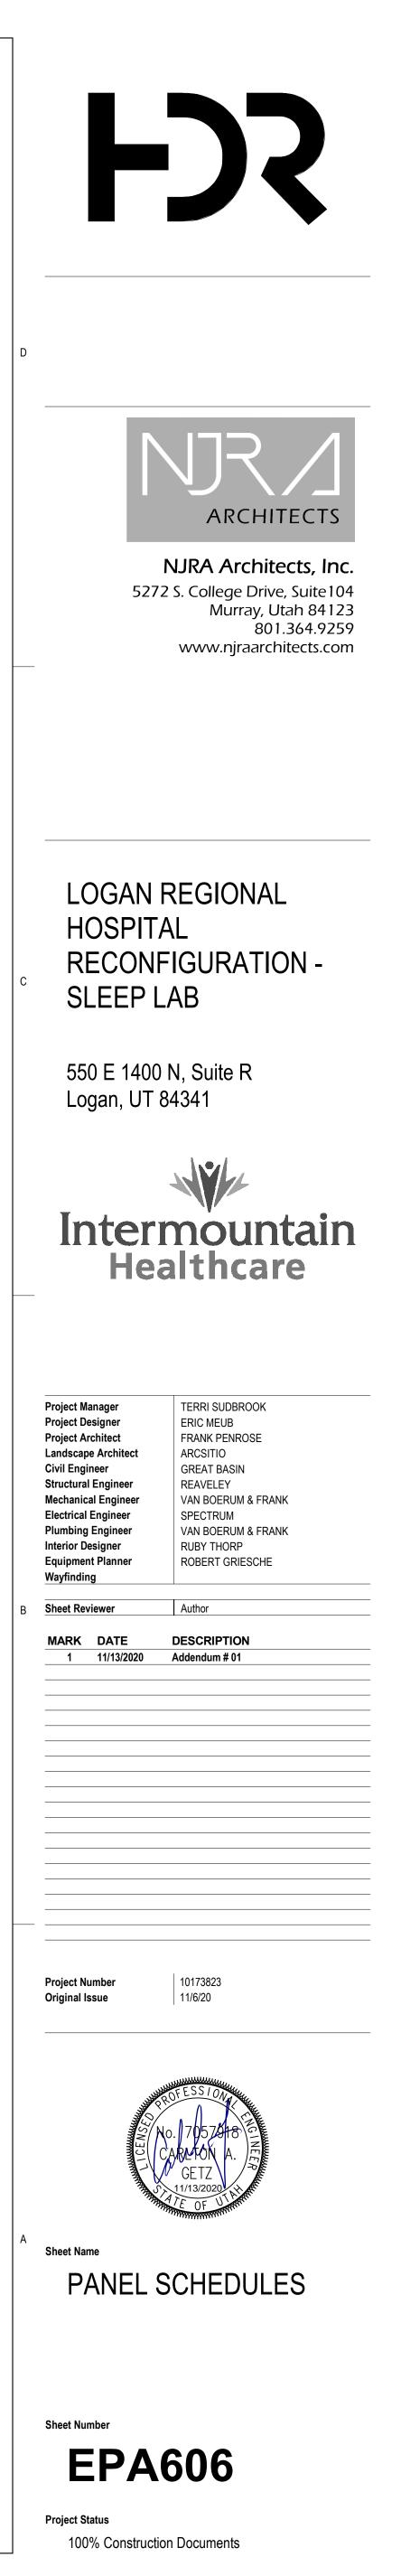






D	5        (EXISTING)       0       0       0       0        6         7        (EXISTING)       0       1751       0       0       ASC LS LIGHTING EGRESS       4H1E-2       8         CHANNEL       DIMMING       CHANNEL DESCRIPTION       CHANNEL PROGRAMMING REQUIREMENTS       0       1751       0
	B       NO       CORRIDOR & COMMON SPACE       TIME OFF (10PM)/TIME ON (6AM)**         C       NO       NIGHT LIGHTS       ALWAYS ON - NIGHT LIGHTING, MANUAL OFF VIA LOW VOLTAGE SWITCH         D       NO       EXTERIOR LIGHTS OUT AT MIDNIGHT       EXTERIOR PHOTOCELL ON/TIME OFF (12AM)         E       NO       EXTERIOR LIGHTING ALL NIGHT       EXTERIOR PHOTOCELL ON/OFF         F       NO       SPARE       PROGRAM AS DIRECTED BY OWNER
	F       NO       SPARE       PROGRAM AS DIRECTED BY OWNER         GENERAL NOTES: <ul> <li>PROGRAMMING OF SYSTEM SHALL COMPLY WITH CURRENT IECC REQUIREMENTS.</li> <li>COORDINATE INITIAL PROGRAMMING WITH OWNER AND MODIFY CONTROL TIMES AND OPERATION AS REQUESTED BY OWNER.</li> <li>PROVIDE FINE TUNING PROGRAMMING AND ADJUSTMENTS UPON REQUEST BY OWNER WITHIN FIRST 6 MONTHS AFTER SUBSTANTIAL COMPLETION.</li> <li>ALL SPARE RELAYS AND CHANNELS SHALL DE INCLUDED WITH ORIGINAL SYSTEM INSTALLATION.</li> <li>S. UPON LOSS OF NORMAL POWER, ALL EMERGENCY LIGHTING RELAYS SHALL TURN ON TO 100% UNTIL NORMAL POWER IS RESTORED, THEN GO BACK TO STANDARD MODE.</li> <li>** CHANNEL SHALL BE PROGRAMMED WITH 10 MINUTE WARNING PRIOR TO TURNING LIGHTS OFF BY BLINKING THE LIGHTS OFF/ON/OFF/ON.</li> </ul>
C	
В	
A	

# LIGHTING RELAY PANEL SCHEDULE (EXISTING)


4


### ACCESSORIES: INTEGRAL PROCESSOR


		CHAN	INEL	CON	TROL	-								CHAN	NEL	CON	TROL	.				
ION	Α	В	С	D	Е	F		L	DAD (	WATT	S)		F	Е	D	С	В	Α	DESCRIPTION	PANEL	DIMMING	RELA
G)							0	0											(EXISTING)			2
G)									0	0									(EXISTING)			4
G)											0	0							(EXISTING)			6
G)							0	1751											ASC LS LIGHTING EGRESS	4H1E-2		8
ON	CHA	NNE		) GR/		NG R	EQUIF	REMEN	NTS									·		•	•	
VEEP OFF	SWE	EP C	)FF A	T (10	PM),	MAN	JAL O	N/OFF	= VIA	LOW	VOLT	AGE S	WITC	H**								
N SPACE	TIM		<sup>-</sup> (10F	PM)/T	IME C	DN (6/	<b>\M)*</b> *															
	ALW	AYS	ON -	NIGH	IT LIG	GHTIN	IG, MA	ANUAI	_ OFF	VIA L	.OW V	<b>OLTA</b>	GE S	WITC	H							
T AT MIDNIGH	ГЕХТ	ERIO	R PH	ото	CELL	ON/T	IME C	) <b>FF (1</b> 2	2AM)													
LL NIGHT	EXT	ERIO	R PH	ото	CELL	ON/C	)FF															
	PRC	GRA	M AS	DIRE	ECTE	D BY	OWN	ER														
	H CUF	RREN	IT IEC	C RE	QUIF	REME	NTS.															
L COMPLY WIT																						

# LIGHTING FIXTURE SCHEDULE


NOTE TO BIDDERS: COMPLY WITH THE SPECIFICATIONS. REFER TO SPECIFICATIONS FOR IMPORTANT TECHNICAL REQUIREMENTS FOR LIGHTING FIXTURES, BALLASTS, AND LAMPS. THE CATALOG NUMBERS LISTED BELOW HAVE BEEN CAREFULLY PREPARED TO ASSIST BIDDERS IN SELECTING PRODUCTS TO ACHIEVE THE DESIGN CONCEPT, HOWEVER, PRIOR TO BIDDING, EACH MANUFACTURER SHALL COMPARE THE CATALOG NUMBERS SHOWN WITH THE DESCRIPTION AND REQUIREMENTS ON THE DRAWINGS, AND SHALL NOTIFY THE ARCHITECT/ENGINEER OF ANY DISCREPANCIES. SPECIFICALLY INCLUDED IN THIS EVALUATION SHALL BE THE VERIFYING OF PROPER MOUNTING KITS OR ACCESSORIES TO FACILITATE INSTALLATION AS SHOWN AT EACH LOCATION ON THE DRAWINGS. NO ALLOWANCE OR REDRESS WILL BE ALLOWED FOR DISCREPANCIES THAT WERE NOT REPORTED TO THE ARCHITECT/ENGINEER IN TIME FOR CORRECTION OR CLARIFICATION BEFORE THE BID. THE REPORTING OF ANY AMBIGUITY IS THE RESPONSIBILITY OF THE BIDDER. PROVIDE UNIT PRICES AND FIXTURE BRAND SELECTED FOR ADD/DELETE CHANGES FOR EACH FIXTURE TYPES SHOWN WITHIN 48 BUSINESS HOURS OF THE BID DATE. FAILURE TO COMPLY WITH THIS REQUIREMENT MAY DISQUALIFY THE PRODUCTS AND EMPOWER THE ENGINEER TO DETERMINE FAIR VALUE FOR FIXTURE AND INSTALLATION CHANGES, WITHOUT FURTHER INPUT FROM THE CONTRACTOR OR INSTALLER. SUBMITTAL PACKAGE SHALL INCLUDE LAMP MANUFACTURER AND CATALOG NUMBER ON EACH FIXTURE SHEET. ON ALL PENDANT MOUNTED FIXTURES, PROVIDE A SECOND SET OF PENDANTS, OF A DIFFERENT LENGTH, AS DIRECTED BY THE ARCHITECT/ENGINEER, PROVIDED AND INSTALLED AT NO ADDITIONAL CHARGE. ALL FIXTURES SHALL BE APPROVED BY UL OR ANOTHER ACCEPTABLE TESTING LAB FOR THE PURPOSE INTENDED AND WITH THE LAMP AND BALLAST PROPOSED. CONTRACTOR ALLOWANCE PRICES ARE ACCURATE WHEN THIS JOB WAS SPECIFIED, CONTRACTOR AND ELECTRICAL DISTRIBUTOR SHALL VERIFY THIS ALLOWANCE AND REPORT ANY PROBLEMS TO THE ENGINEER BEFORE THE BID. ALLOWANCE PRICE MAY OR MAY NOT INCLUDE LAMP(S) OR FREIGHT AS NOTED, AND DO NOT INCLUDE ANY TAXES. UNIVERSAL VOLTAGE (120/277) BALLASTS REQUIRED UNLESS NOTED OTHERWISE. DIMENSION SEQUENCE = (LENGTH X WIDTH X DEPTH) IN INCHES. FIXTURE CHARACTERISTICS BODY / AIR / MOUNTING / DOOR SYMBOL MARK LENS/LOUVER/REFLECTOR/OTHER LAMP WATTS VOLTS MANUFACTURER 1 NOTES RECESSED LED: SOLID STATE LED LIGHT ENGINE; CLASS P THERMALLY PROTECTED 0-10V SOLID STATE DIMMING DRIVER; MINUMUM SYSTEM RATED LIFE 50,000 HOURS AT 70% OUTPUT; UL LISTED FOR THROUGH-BRANCH WIRING AND DAMP LOCATION; LIGHT ENGINE, DRIVER, AND JUNCTION BOX ACCESSIBLE FROM ABOVE OR BELOW CEILING; SELF-FLANGING TRIM. LED 30W 277V LIGHTOLIER C6L1520DL-40K-M-CCL-W / CW-C6L15-N-2 D-89 6" APERTURE: COMFORT CLEAR DIFFUSER; 4000 K COLOR TEMP LED; PRESCOLITE GOTHAM ~1500 LUMENS; 30 INPUT WATTS; 277V; 0-10V SOLID STATE DIMMING PORTFOLIO DRIVER; LENS; WHITE FLANGE. LIGHTOLIER C7L1520-DL-40K-W-CCD-W / C7L35-N-2 D-99 7" APERTURE: COMFORT CLEAR LED 60W 277V DIFFUSER; 4000 K COLOR TEMP LED; PRESCOLITE ~3500 LUMENS; 60 INPUT WATTS; GOTHAM PORTFOLIO 120V; 0-10V SOLID STATE DIMMING DRIVER; LENS; WHITE FLANGE. E10 EXIT SIGN: METAL HOUSING; CEILING MOUNT, SEE DRAWINGS; ARROWS PER PLANS; LED LAMPS; A/C ONLY; EDGE LIGHTED CLEAR LENS; GREEN LETTERS ON CLEAR BACKGROUND. MUST MEET NFPA ILLUMINATION STANDARDS. UNITS SHOWN ARE CEILING MOUNT MODELS. CONTRACTOR TO PROVIDE MATCHING LOW LEVEL WALL MOUNTED UNITS WHERE REQUIRED. 20W 120/277V DUAL-LITE E10-1 SINGLE FACE: LESCGWA LED MCPHILBEN 45VL-1-GC-XX EELP EDG 1 GC W EM LITHONIA LRP W 1 GC XX 120/277 ISOLITE EUN-AC-G-1C EVENLITE SOV-AC-G-1C-WH-XX-XX CHLORIDE STDLX-X-1-GC-X LIGHTOLIER LEAC1GCX E10-2 DUAL FACE: LECDGWA 120/277V DUAL-LITE LED 20W MCPHILBEN 45VL-2-GM-XX EELP EDG 2 GC W EM LITHONIA LRP W 2 GMR XX 120/277 EUN-AC-G-2M ISOLITE EVENLITE SOV-AC-G-2M-WH-XX-XX CHLORIDE STDLX-X-2-GC-X DECORATIVE LENSED TROFFERS: RECESSED; ACRYLIC PRISMATIC LENS; EARTHQUAKE CLIPS, LED DRIVER 0-10 VOLT DIMMING DRIVER WHERE INDICATED IN PRODUCT NUMBER. RECESSED LED FIXTURE, 2X2, ACRYLIC LED 27W UNV 2VTL2-33L-ADP-EZ1-LP840 G-1 LITHONIA DIFFUSER, ~3300 LUMENS, MULTI VOLT, 4000K, GRID MOUNTED MINIMUM 82 CRI G-2 RECESSED LED FIXTURE, 2X4, ACRYLIC LED 2VTL4-48L-ADP-EZ1-LP840 40W UNV LITHONIA DIFFUSER, ~4800 LUMENS, MULTI VOLT, 4000K, MOUNTING PER PLAN, MINIMUM 82 CRI G-3 RECESSED LED FIXTURE, 1X4, ACRYLIC LED LITHONIA VTL4-48L-ADP-EZ1-LP840-DGA14 45W UNV DIFFUSER, ~4800 LUMENS, MULTI VOLT, 4000K, GYP MOUNTED, DIMMING, MINIMUM 82 CRI G-4 RECESSED LED FLAT PANEL FIXTURE, LED 60W UNV LITHONIA EPANL-2X4-6800LM-80CRI-35K-MIN1-ZT-MVOLT LUMENOPTIX LUZ 2X4, GRID MOUNTED, 3500K, MULTI VOLT, ~6700 LUMENS, ARCHIPELAGO LPNL24-60-35-A1 MINIMUM 80 CRI OR ASYMMETRIC LENSED TROFFER; RECESSED FRO GYP CEILING; ACRYLIC PRISMATIC LENS; EARTHQUAKE CLIPS; LED DRIVER; 0-10 VOTL DIMMING WHERE INDICATED IN PRODUCT NUMBER OR-1 RECESSED LED FIXTURE, 2X4, ACRYLIC LED 115W 277V KENALL M4SEDI-24-43G/100L-40K9-DCC-277-2F-2H -ASYM-RM DIFFUSER, ~14,000 LUMENS, 4000K, GYP MOUNTED, MINIMUM 80 CRI, WHITE AND GREEN EMERGENCY: LIGHT DUAL FIXTURE WITH SEPARATE M4SEDI-24-43G/100L-40K9-DCC-277-2F-2H KENALL CONTROL AND OPERATION. MIN 80 CRI -ASYM-RM-LEL UC LED UNDERCABINET LIGHT: LOW PROFILE 1" HIGH X 1-3/4"DEEP X LENGTH AS NOTED; EXTRUDED ALUMINUM BODY; EXTRUDED CLEAR, POLYCARBONATE LENS; INTERNAL LED DRIVER; EFFICACY GREATER THAN 40 LUMENS PER WATT; 50,000 HOUR RATED LAMP LIFE; 2700 - 3000 DEG KELVIN COLOR TEMPERATURE, WIRING COMPARTMENT; FLUSH END. CONNECTORS FOR ROW INSTALLATION (CONNECTORS ARE NOT INCLUDED IN THE FIXTURE SCHEDULE CATALOG NUMBERS - CONNECTOR CONFIGURATION TO BE FIELD DETERMINED BY CONTRACTOR PRIOR TO PURCHASE). UC-99 SURFACE MOUNTED UNDERCABINET LED 6W 120V ALKCO LINCS100-L19-120-WHG WAC LIGHTING LIGHT FIXTURE, LED, 19" NOMINAL LENGTH, GLOSSY WHITE, ~345 LUMENS KENALL HEALTHCARE MINIMUM W LOW PROFILE WRAPAROUND: SURFACE MOUNTED SUITABLE FOR MOUNTING ON LOW DENSITY CEILINGS; CURVED ACRYLIC PRISMATIC DIFFUSER; WHITE ENAMEL ENDPLATES; LED. LED 45W 277/120V KENALL MLRS12-48-F-MW-PP-1-45L40K-DCC-1-DV W-4 WIDE BODY WRAPAROUND; LED: ~5000 LUMENS WP SERFACE MOUNTED WET LISTED EMERGENCY LED FIXTURE; UL 924; FULLY GASKETED CORROSION-RESISTANCT ENCLOSURE: SOLID STATE CHARGING CIRCUIT: SEALED MOMENTARY PUSH-TO-TEST SWITCH WB-2 WALL MOUNTED 24" LINEAR FIXTURE; LED 20W 277V LIGHTOLIER MQ26-L-A-K-F-F-X-1-2-E-W UP AND DOWN LIGHTING; DUST COVER; ARCH LIGHTING HP2W-2-IHP900-4000K-WD-ILED-DHP900-LED; TOTAL LENGTH AS INDICATED ON 4000K-EXT-DLED-1CKT-UNV-AL RW2-2-B-09-L40-DIM-1C-FRF-SV-4'-DUST COVER PLANS AS EACH LOCATION NULITE

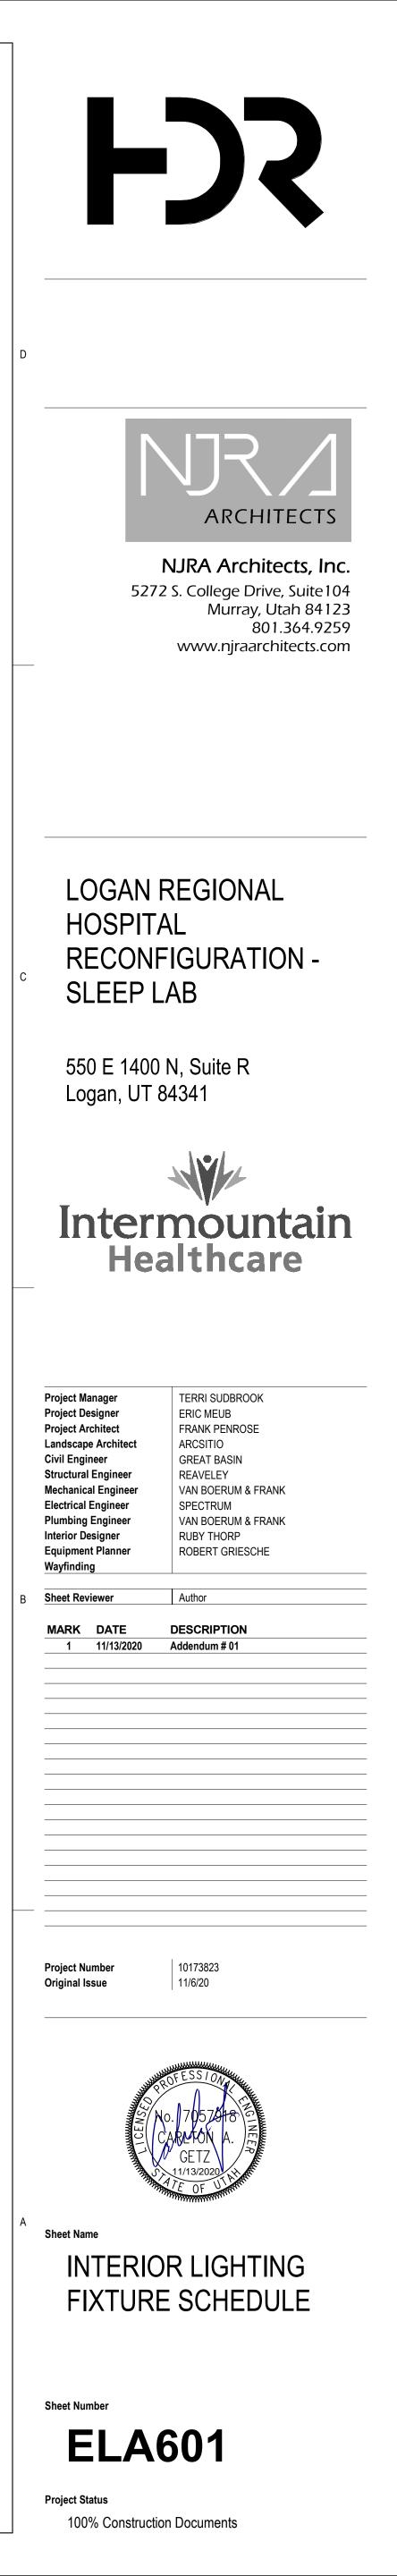

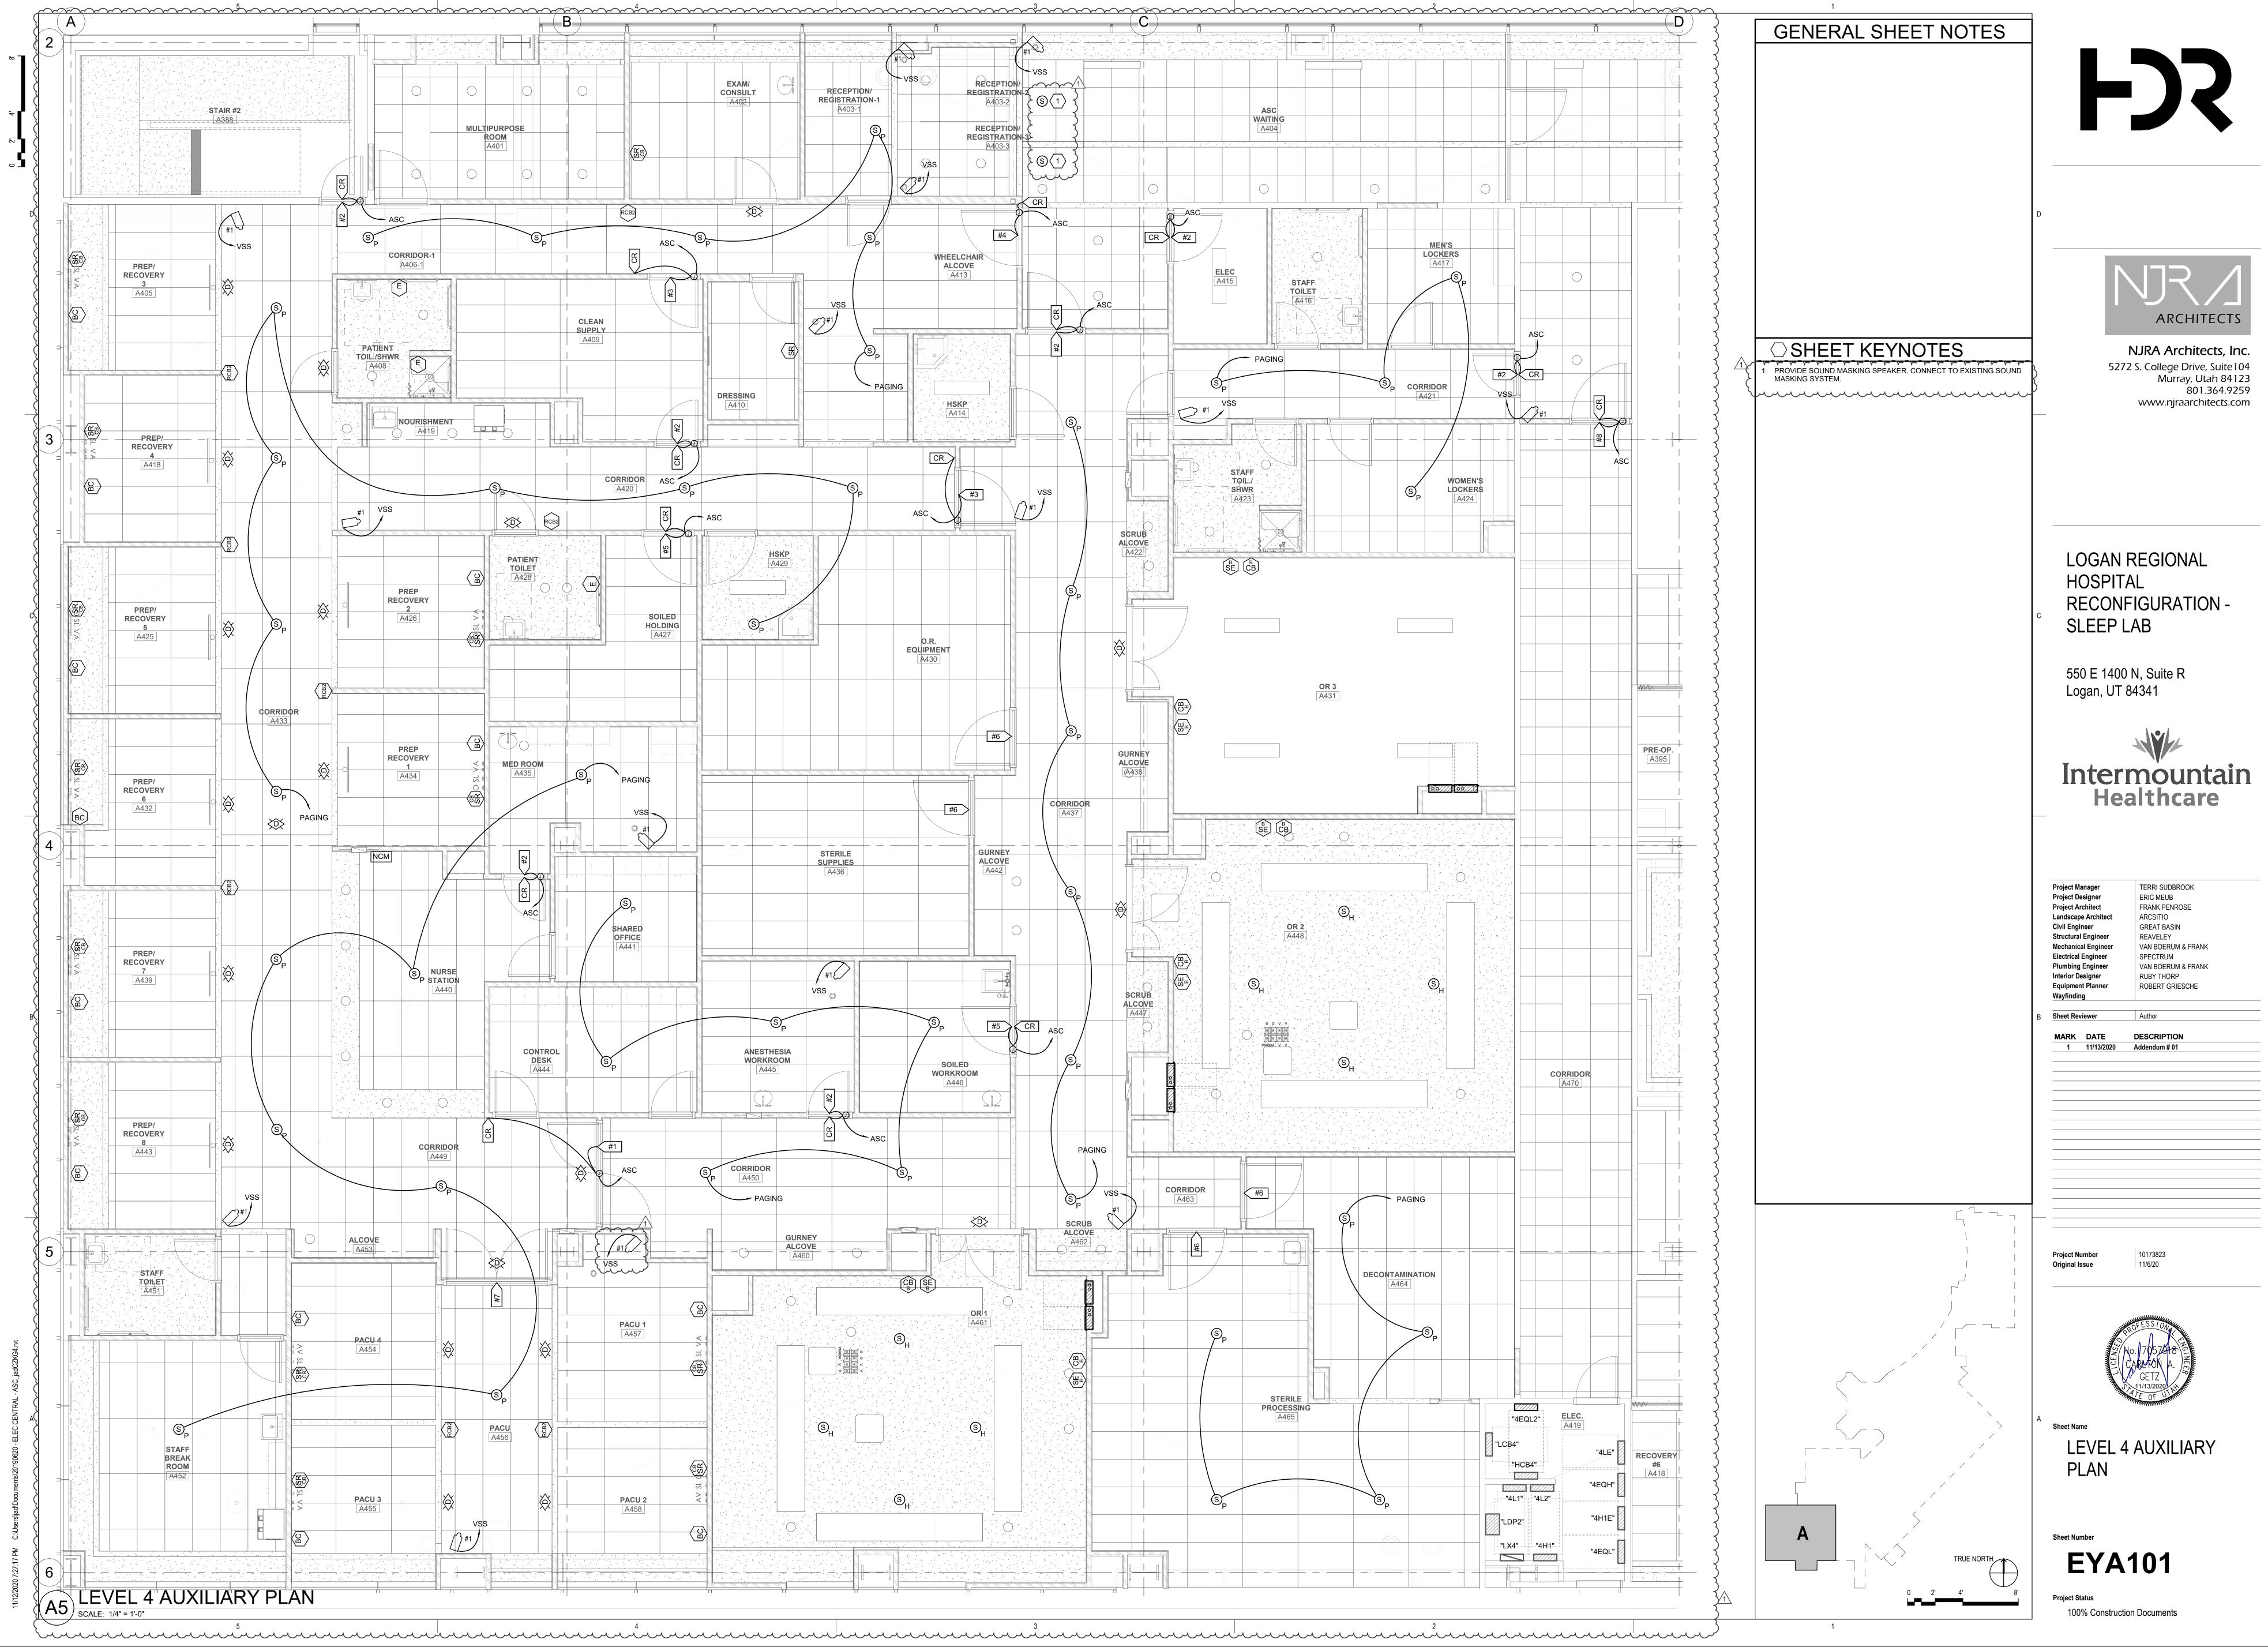

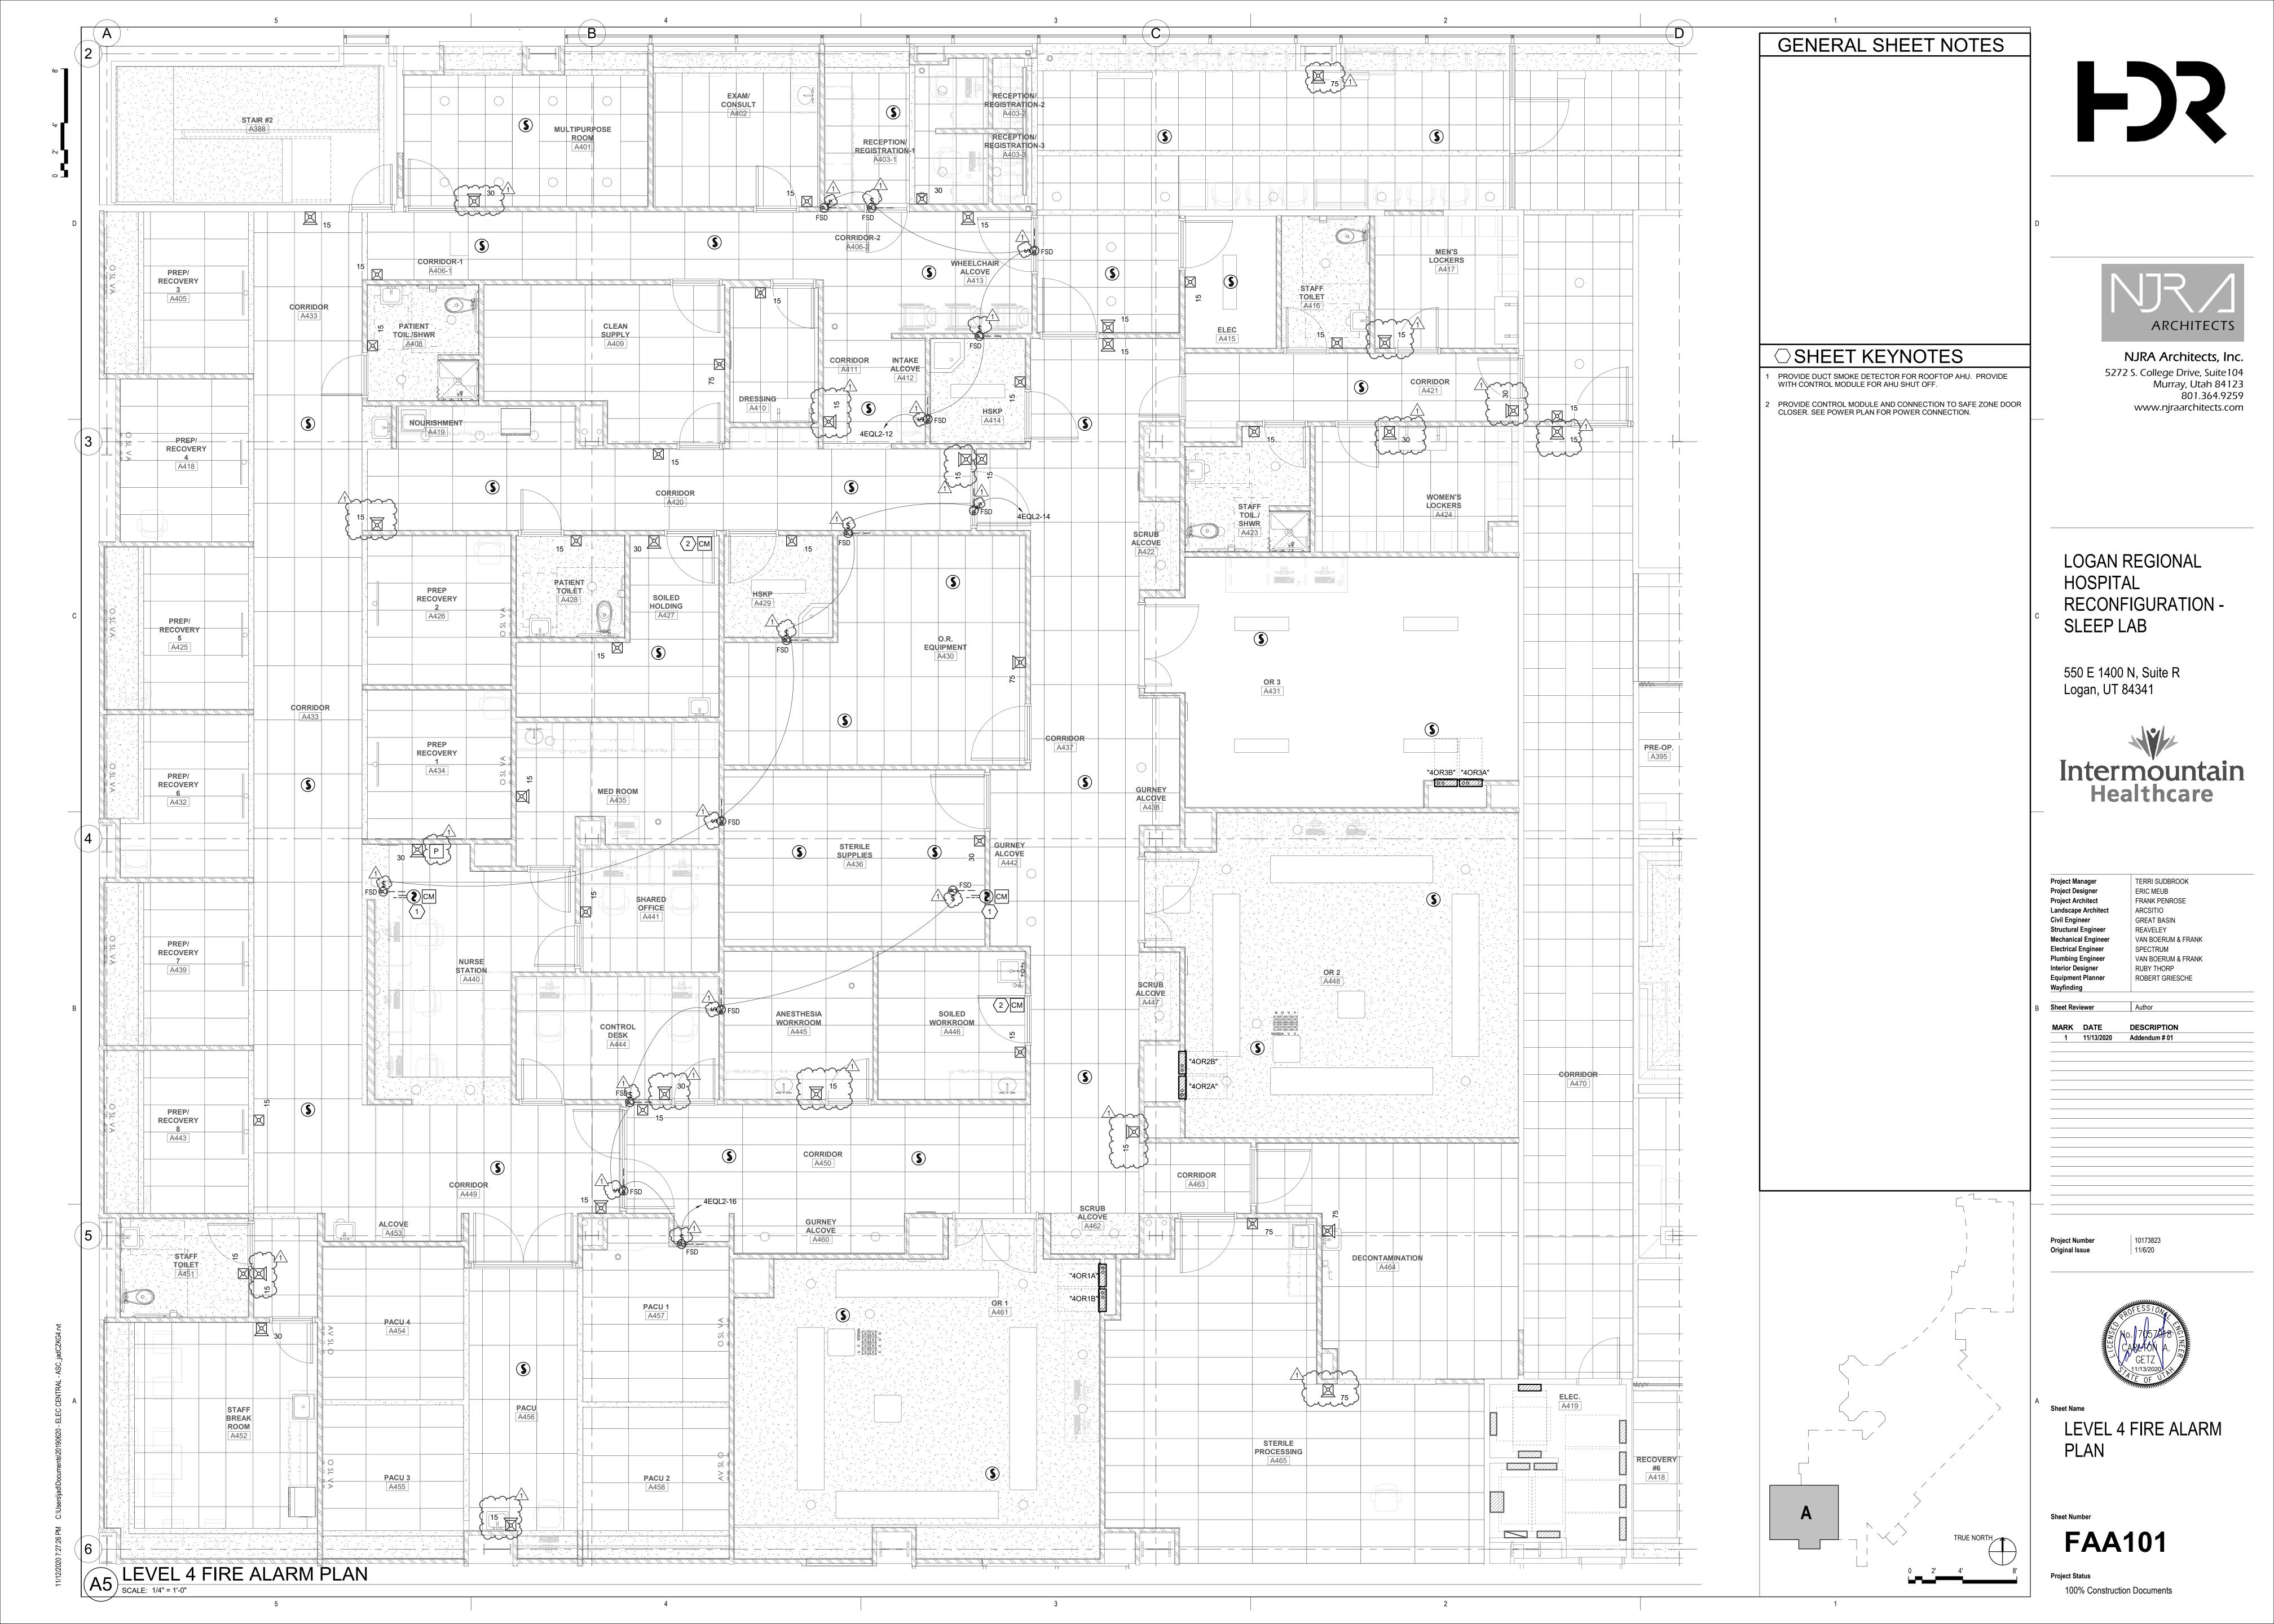

	D	
	C	
	В	
C:\Users\jad\Documents\2019U620 - ELEC CENTRAL - ASC_jadC2KG4.Nt	A	

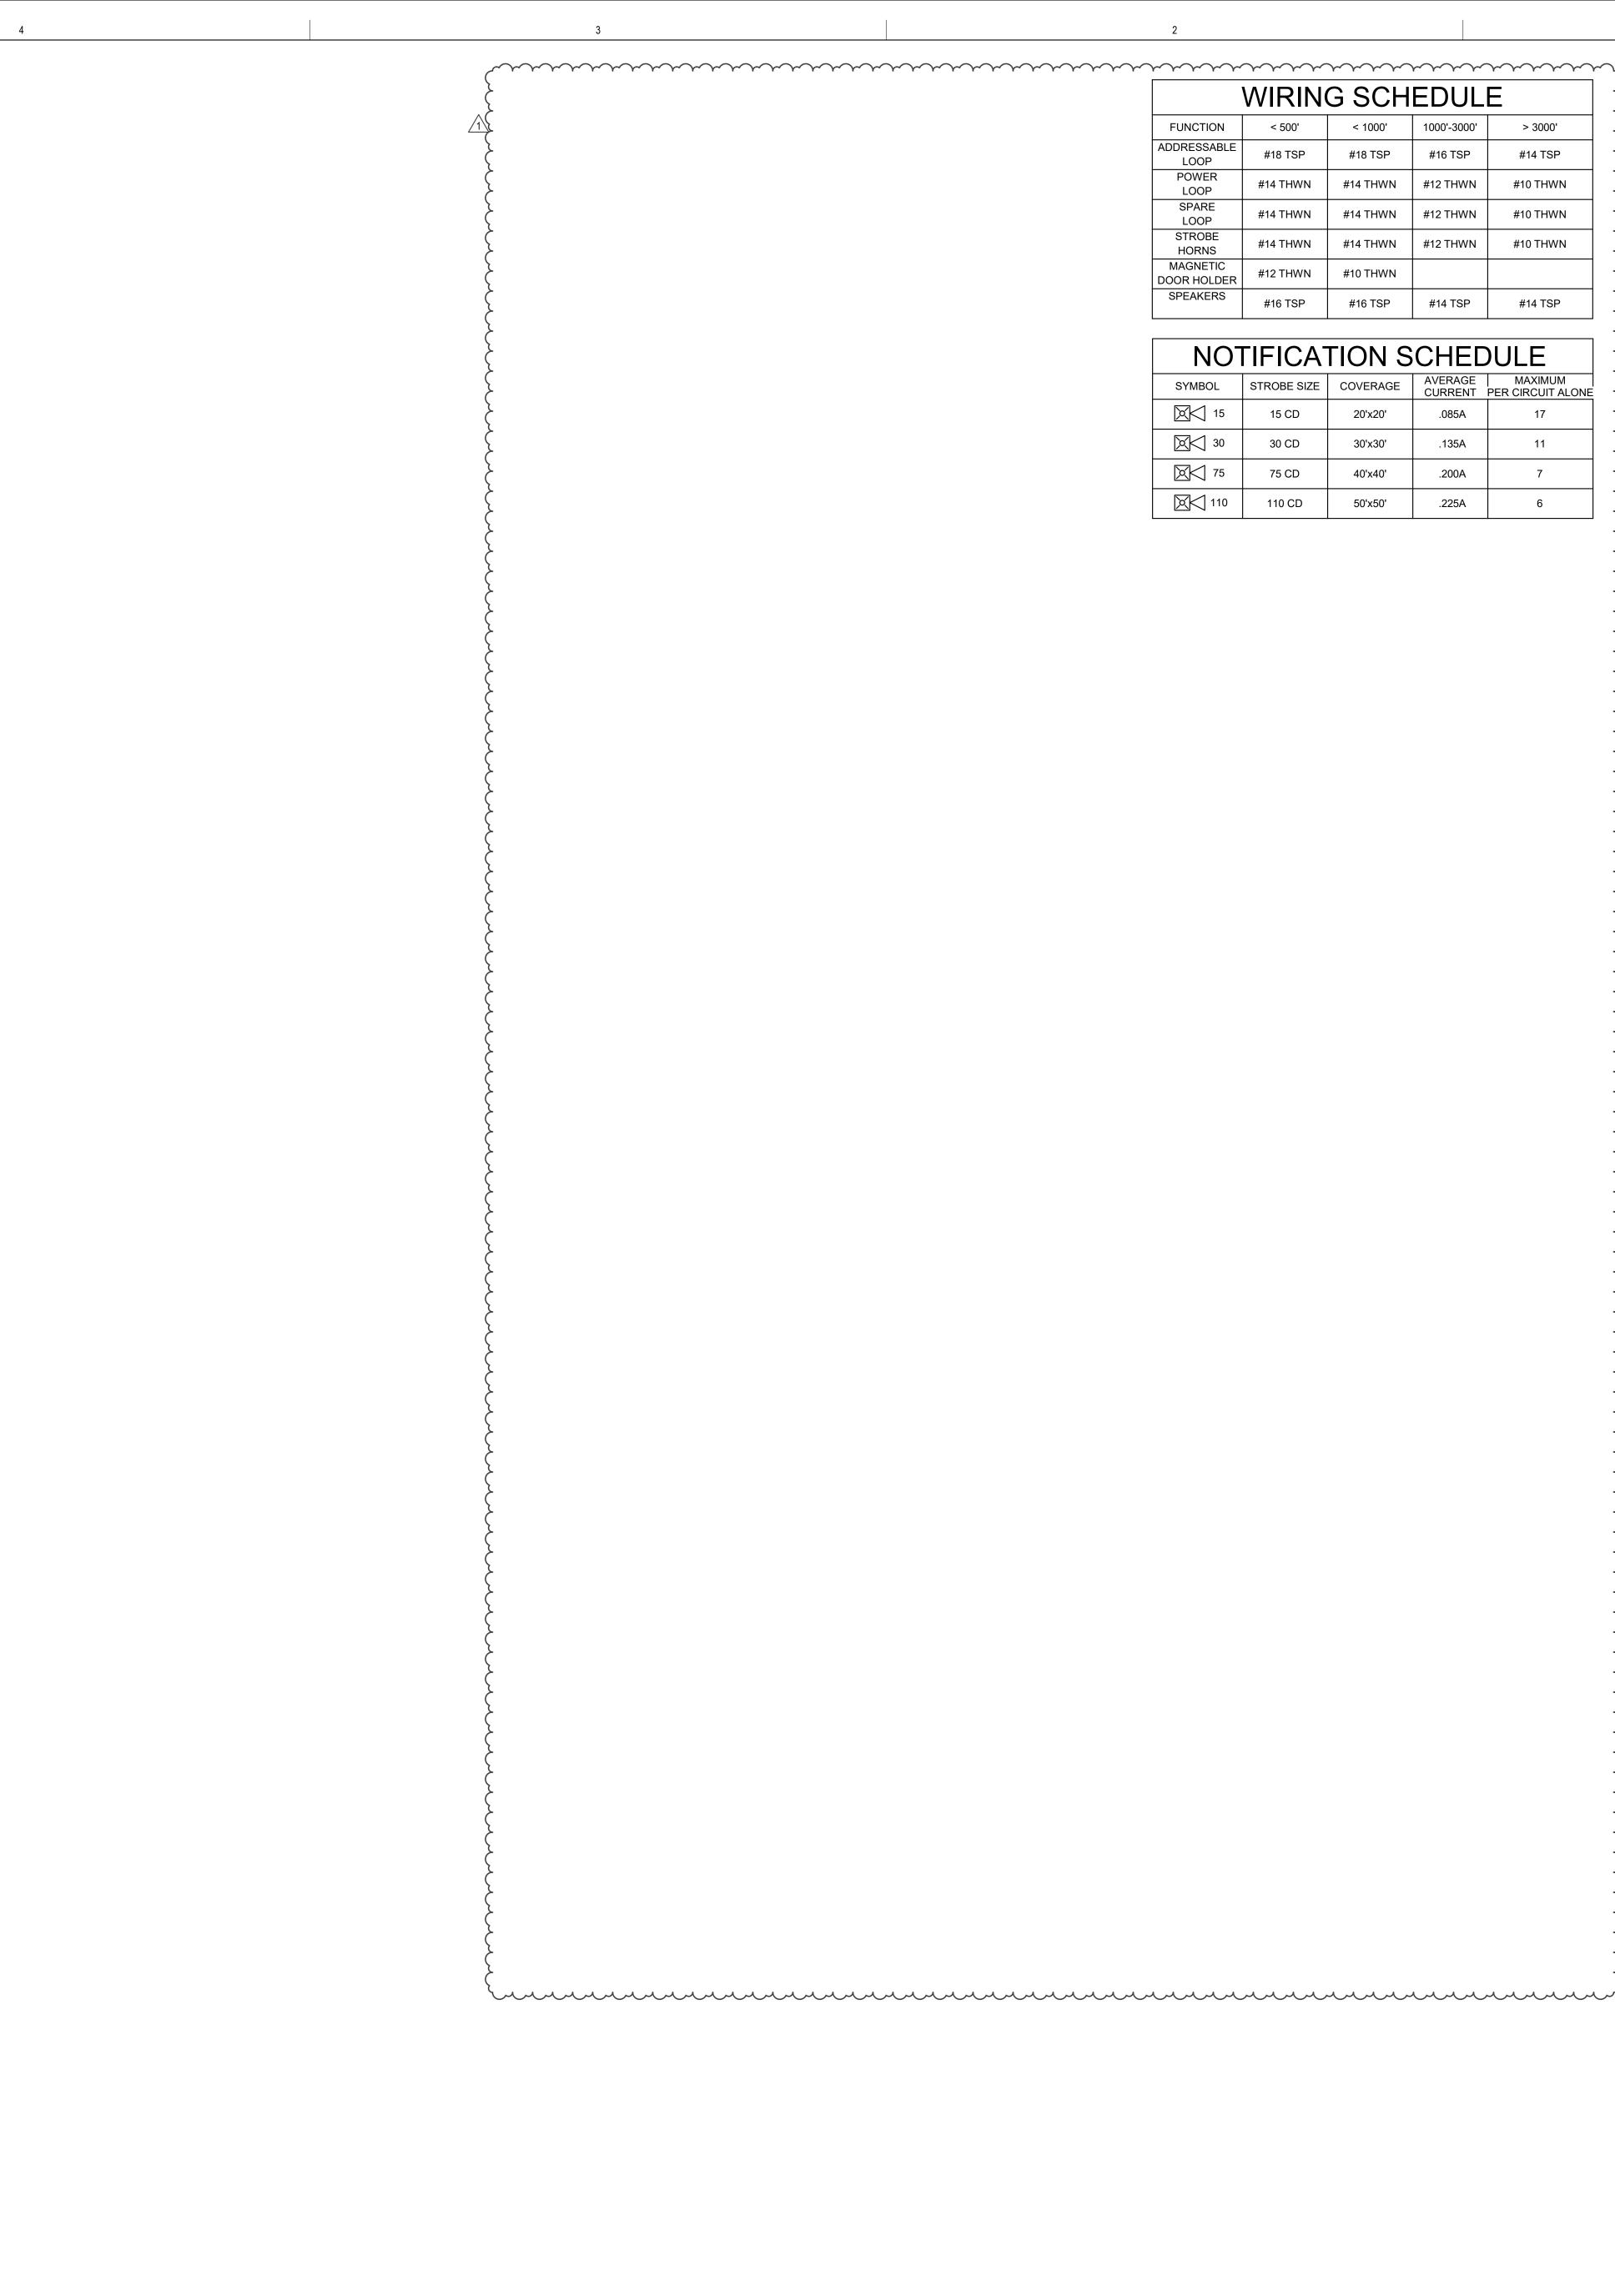

		$\sim$	$\sim \sim $
WIRIN	G SCH	EDUL	E
< 500'	< 1000'	1000'-3000'	> 3000'
#18 TSP	#18 TSP	#16 TSP	#14 TSP
#14 THWN	#14 THWN	#12 THWN	#10 THWN
#14 THWN	#14 THWN	#12 THWN	#10 THWN
#14 THWN	#14 THWN	#12 THWN	#10 THWN
#12 THWN	#10 THWN		
#16 TSP	#16 TSP	#14 TSP	#14 TSP
<b>FIFICA</b>	TION S	CHED	)ULE
STROBE SIZE	COVERAGE	AVERAGE CURRENT	MAXIMUM PER CIRCUIT ALONE

			CURRENT	PER CIRCUIT ALONE
15	15 CD	20'x20'	.085A	17
30	30 CD	30'x30'	.135A	11
75	75 CD	40'x40'	.200A	7
110	110 CD	50'x50'	.225A	6

	GENERAL SHEET NOTES
1	PLANS ARE BASED UPON 99 MONITOR AND CONTROL DEVICES PER ADDRESSABLE LOOP. OTHER CONFIGURATIONS ARE ACCEPTABLE SUBJECT TO CONTRACTOR ALLOWING FOR INCREASED WIRING REQUIREMENTS AND SUBMITTAL DRAWINGS SHOWING NEW WIRING CONFIGURATION. MAXIMUM INITIAL DEVICES PER LOOP SHALL NOT EXCEED 75% MAXIMUM ALLOWABLE.
2	PLANS ARE BASED UPON THE WIRING SCHEDULE SHOWN. WHERE MANUFACTURER'S REQUIREMENTS EXCEED REQUIREMENTS SHOWN, INCLUDE ADDITIONAL ASSOCIATED COSTS AND SUBMITTAL DRAWINGS INDICATING NEW WIRING CONFIGURATION.
3	PLANS ARE BASED UPON 2 AMPS AT 24 VDC, NOT TO EXCEED 75% (1.50 AMPS AVAILABLE), POWER SUPPLY CAPACITY PER NOTIFICATION CIRCUIT. NOTIFICATION DEVICE LOADS ARE BASED UPON NOTIFICATION DEVICE SCHEDULE SHOWN. INCLUDE ADDITIONAL ASSOCIATED COSTS FOR INCREASED WIRING AND POWER SUPPLY CAPACITY IF LOADS OF ACTUAL DEVICES PROVIDED EXCEED CIRCUIT CAPACITY, OR IF LOAD OUTPUT OF ACTUAL POWER SUPPLIES PROVIDED IS SIZED DIFFERENTLY. PROVIDE SUBMITTAL DRAWINGS SHOWING NEW WIRING CONFIGURATION.
4	FLOW AND TAMPER CONFIGURATION BASED UPON FIRE SPRINKLER DESIGN CONCEPT. FIELD VERIFY ACTUAL REQUIREMENTS. INCLUDE ANY ADDITIONAL MONITOR MODULES REQUIRED BY ACTUAL DESIGN REQUIREMENTS.
5	HEAT DETECTORS WHEN INSTALLED IN ELEVATOR SHAFTS OR MECHANICAL ROOMS FOR ELEVATOR SHUT DOWN SHALL HAVE HEAT DETECTOR WITH LOWER RESPONSE TIME INDEX THAN SPRINKLER HEAD.
6	PROVIDE POWER SUPPLY CAPACITY AS REQUIRED FOR DOOR HOLD OPENS SHOWN.
7	BATTERY CAPACITY TO BE ADEQUATE TO OPERATE 15 MINUTES AFTER 24 HOURS PLUS 25% SPARE CAPACITY.
8	VFD REQUIRES TWO RELAYS, ONE FOR SMOKE CONTROL, ONE SPARE.
9	RUN SPARE LOOPS IN SAME CONDUIT. DO NOT EXCEED 40% AREA FILL OF CONDUITS.
10	PROVIDE DUCT DETECTORS FOR SUPPLY AND RETURN AIR SYSTEMS OVER 2000 CFM. INSTALL DUCT DETECTORS PER NFPA 72 REQUIREMENTS AND PROVIDE ADDITIONAL DUCT DETECTORS DEPENDING UPON FINAL DUCT ARRANGEMENT.
11	PROVIDE DUCT DETECTOR AT EACH FLOOR, PRIOR TO CONNECTION TO A COMMON RETURN AND PRIOR TO RECIRCULATING OR FRESH AIR INLET IN AIR RETURN SYSTEMS OVER 15,000 CFM CAPACITY AND SERVING MORE THAN ONE STORY.
12	PROVIDE MANUAL PULL STATIONS IN BOILER ROOMS AND KITCHENS.
13	PROVIDE ONE YEAR OFF SITE MONITORING INCLUDING ALL INTERFACE DEVICES AND MONITORING CHARGES. COORDINATE WITH BUILDING OWNER'S OFF SITE MONITORING COMPANY.
14	LOCATE SMOKE DETECTORS MINIMUM 3' FROM AIR SUPPLY AND RETURN LOUVERS.
15	PROVIDE SYNCHRONIZED STROBES THROUGHOUT FACILITY. PROVIDE SYNCHRONIZATION MODULES PER MANUFACTURER'S REQUIREMENTS. INCLUDE ADDITIONAL WIRING, IF REQUIRED.
16	INITIATING AND INDICATING LOOPS SHALL NOT SERVE AN AREA OF GREATER THAN 22,500 SQUARE FEET. PROVIDE ADDITIONAL LOOPS FOR AREAS LARGER THAN THIS.
17	ALL OUTPUT DEVICES ARE DESIGNED ON SYSTEMS WITH 2 AMP POWER SUPPLY.
18	HORN/STROBE BASED ON 120 MILLIAMPS, DOOR HOLDERS BASED ON 70 MILLIAMPS.
19	INSTALL DUCT DETECTORS PER NFPA 72 REQUIREMENTS AND PROVIDE ADDITIONAL DUCT DETECTORS DEPENDING UPON FINAL DUCT ARRANGEMENT.

