

ADDENDUM

Date Issued:	February 18, 2020
Project:	Intermountain Healthcare Tooele Valley Dialysis Clinic Remodel 2356 North 400 East, Suite #102 Tooele, Utah 84074
Addendum Number:	2

The Contractors submitting proposals on the above-captioned project shall be governed by the following addendum, changes and explanations to the drawings and specifications and shall submit their bids in accordance therewith.

Item Number	General Items Description
1	Contractor shall install equipment and accessories noted as owner furnished contractor installed equipment like glove dispenser, sharp disposal, bathroom accessories and other items etc. as indicated in the construction documents as well as in the attached "Responsibility Matrix". Coordinate exact location with the Owner before proceeding with the work. Provide all necessary wall backing as required before installation. The attached matrix also lists Owner Furnished Owner Installed as well as Contractor Furnished Contractor installed items. The matrix does not necessarily include all items required in this project and is to be used in conjunction with the information provided in the construction documents and project specifications manual.
2	As indicated in Addendum #1- Contractor shall include disposal of lead from the existing X-Ray room in the bid by adopting approved methods and procedures for safe handling and disposing of lead from the site as approved by Authorities having Jurisdiction. Lead lined gypsum exists only up to 7'-0" Above floor finish on all walls of the X-ray room.
3	Wood doors at the building hallway adjacent to the other tenant occupied suites shall match the color and finish of the adjacent existing wood doors. The wood doors located inside the remodel suite shall be "Clear Maple". Color to be selected by Architect during submittal review process from manufacturers standard color chart and samples.
4	See attached Mechanical & Plumbing Addendum #2 from VBFA Engineers.
5	See attached Electrical Addendum #2 from Spectrum Engineers.

Sheet Number	Drawings							
Architecture	al							
G111	See attached revised- Code Compliance plan with revisions shown clouded.							
A113	See attached revised- Floor Plan- Level 1 sheet. Additional notes added.							
A115	See attached revised- Reflected Ceiling Plan- Level 1 sheet. Additional notes added.							
A116	See attached revised- Finish Floor Plan- Level 1 with revisions shown clouded.							
A251	See attached revised- Interior Elevations sheet with revisions shown clouded.							



NJRA Architects, Inc.

5272 S. College Drive, Suite 104 | Murray, Utah 84123 | 801.364.9259 |www.njraarchitects.com

Sheet Number	Drawings								
A252	ee attached revised- Interior Elevations sheet with revisions shown clouded.								
A505C	ee attached revised- Cabinet Details sheet with revisions shown clouded.								
Mechanical	& Plumbing								
PP100	See attached revised- Below Grade Plumbing Plan. Hopper sink removed from soiled room								
PP101	See attached revised- Level 1 Plumbing Plan. Hopper sink removed from soiled workroom.								
PP601	ee attached revised- Plumbing Fixture Schedule. Hopper Sink removed.								
Electrical									
EDP101	See attached revised- Demolition Power Plan.								
EP601	See attached revised- One-Line Diagram.								
EC101	See attached revised- Systems Plan- Level 1.								

Attachments:

Responsibility Matrix sheet, Mechanical Addendum #2 Memo, Electrical Addendum #2 Memo, Revised Sheet G111, A113, A115, A116, A251, A252, A505C, PP100, PP101, PP601, EDP101, EP601 & EC101.



RESPONSIBILITY MATRIX-Tooele Valley Dialysis Clinic
The following list identifies the majority of the items that are to be included in the capital project build-out.

OFOI - (Owner Furnished / Owner Installed	STATUS - Furnished / Installed	<u>NOTES</u>	Additiona	I Notes	
			Data	Power	Backing
Art	Owner / Vendor				
Brochure Racks Chart Racks	Owner / Vendor Owner / Vendor (Midwest-Peter Pepper)	G.C. to provide proper backing G.C. to provide proper backing			
Copiers, fax	Owner / Vendor	o.o. to provide proper basining	Yes	Yes	
Cup Dispensers Exam Tables	Owner / Vendor Owner / Vendor			Yes	
Systems Furniture	Owner / Vendor (Midwest Furn.)	Coordinate Modesty Panels with Elec. Outlets. Coordinate data and	Yes	Yes	
		power with Midwest & Design Team.			
Moveable Metal Shelving Recliners / Draw Chairs	Owner / Vendor Owner / Vendor				
Signage - Exterior	Owner / Vendor (IG Signs, YESCO)	Provide power and data to required exterior signage. Provide	Yes	Yes	Yes
		circuits for above ceiling signs. Coordinate thru-wall conduit sleeves			
		with weather barrier. Intermountain Logo Signs - (2) 20A Circuits - May vary.			
		InstaCare and other Signs - (1) 20 A Circuits - May vary.			
Signage - Interior	Owner / Vendor (Scribbly, or Hightech)	Provide power to required signage.			
Radiology Equipment	Owner / Vendor (IMG - James Jeppson; Hospitals - Steve Isakson)		Yes	Yes	
Clinical Garbage Cans (Clinical, Office, PT, Etc.)	Owner / Owner				
Computers, Printers, Scanners, Keyboards, Mice, etc.	Owner / Owner	In-ceiling & wall mounts, conduits and boxes mounted by G.C. IMG	Yes	Yes	Yes
Televisions, Digital Projectors, etc.	Owner / Owner	computers will be All-in-One computers. These items to be provided by Owner, but A/E to coordinate	Yes	Yes	Yes
Toloriolo, Digital Frojectore, etc.		locations and infrastructure			100
Coat Hooks (Offices only)	Owner / Owner				
Keyboard Trays	Owner / Owner				
PACS Marker Boards (if not shown in drawings)	Owner / Owner Owner / Owner				
Emergency Evacuation Medical Sled (Med Sled)	Owner / Vendor				
Supply Area Panels	Owner / Owner	G.C. to provide proper backing			Yes
<u>UPS</u>	Owner / Owner	Verify location with Owner		Yes	
OFCI - (Owner Furnished / Contractor Installed)		location of items with Owner/Users)	Data	Power	Backing
Automated External Defibrillator (AED)	Owner / Contractor	Verify locations with Owner, Architect to coordinate recess, semi-			
Time Clocks	Owner / Contractor	recessed, or surface mount options with Owner. Conduit and boxes by G.C., Coordinate location with Owner	Yes	Yes	
Paper Towel Dispensers	Owner / Contractor	Location coordinated during mockup	163	163	
Soap Dispensers	Owner / Contractor	Location coordinated during mockup			
Toilet Paper Dispensers Glove Dispensers	Owner / Contractor Owner / Contractor	Location coordinated during mockup Location coordinated during mockup			
Hand Sanitizer Dispensers (Avagard)	Owner / Contractor	Location coordinated during mockup			
Diagnostic Board (Otoscope / Ophthalmoscope)	Owner / Contractor	Location coordinated during mockup		Yes	
Sharps Disposal Container Stadiometers, Recessed Scales	Owner / Contractor Owner / Contractor	Location coordinated during mockup Location coordinated during mockup; coordinate power		Yes	
Procedure Lights	Owner / Contractor	Location coordinated during mockup; coordinate power Location coordinated during mockup; G.C. to provide and install		Yes	
		procedure light support structure			
Scrub Sinks & Carriers IV Track	Owner / Contractor	G.C. to coordinate with Owner for ordering for Install coord.			
Boom Mounting Plates (Equipment, Lighting, Anethesia)	Owner, Vendor / Contractor Owner / Contractor	G.C. to coordinate with Owner for ordering for Install coord.			
OR Clocks	Owner / Contractor	G.C. to coordinate with Owner for ordering for Install coord.	Yes	Yes	Yes
Clinical Clocks	Owner / Contractor	G.C. to coordinate with Owner for ordering for Install coord.	V	Yes	V
Digital Projector Mounts, TV Mounts, & Computer Mounts (Ergotron Brackets/Mounts, etc.)	Owner / Contractor	In-ceiling & wall mounts, conduits and boxes mounted by G.C. Facility to coordinate with A/V company to pull required cabling.	Yes	Yes	Yes
(Eligoron Brasiletti moante, etc.)		asimy to occidentate marror company to pair required capining.			
Radiation Protection Certification MRI Metal Detectors (Where these are required/approved)	Owner,(Medical Physics Consultants)/ Contractor Owner / Contractor	G.C. to coordinate prior to Gyp.install. G.C. to coordinate with Owner		Yes	
Nurse Call System & Patient Monitoring System (Hospital	Owner, Vendor (Hill-Rom) / Contractor	Hospital Local Facilities to contract directly with Nurse Call & Patient	Yes	Yes	
Campus)		Monitoring vendor for devices, equipment, monitors, etc. including			
		cabling and installation of devices. Contractor to provide & install infrastructure, back boxes, conduit & rough-ins etc.			
Staff Assist Notification System (Medical Group Clinics on	Owner, Vendor (Hill-Rom) / Contractor	System to be cooridinated with Medical Group Strategic Planner and	Yes	Yes	
hospital campuses to match nurse call system)		Operations Officer. IMG to contract directly with Staff Assist System vendor for devices, equipment, monitors, etc. including			
		cabling and installation of devices. Contractor to provide & install			
		infrastructure, back boxes, conduit & rough-ins etc.			
Staff Assist Notification System (Stand-alone Medical Group	Owner, Vendor / Contractor	System to be cooridinated with Medical Group Strategic Planner and	Yes	Yes	
Clinics)		Operations Officer. IMG to contract directly with Staff Assist			
		System vendor for devices, equipment, monitors, etc. including			
		cabling and installation of devices. Contractor to provide & install infrastructure, back boxes, conduit & rough-ins etc.			
Patient Lifts	Owner, Vendor (Liko Hill-Rom) / Contractor	G.C. to coordinate shop drawings and Installation. Connect to		Yes	
Building Alarms / Medication Refrigerator Alarm / Pharmacy	Owner / Contractor	Equipment branch if provided. G.C. to provide conduitand infrastructure into accessible ceiling for		Yes	
Alarm System		access from equipment and/or devices. Local Facility to contract			
Signago Estarior	Owner / Centractor	with alarm company for alarm, wire, and monitoring.		V-:	V-
Signage - Exterior	Owner / Contractor	G.C. to provide and install power and required backing		Yes	Yes
CFCI - (Contractor Furnished / Contractor Installed)			Data	Power	Backing
Blinds/Shades (manual and powered)	Contractor / Contractor			Yes	
Apron Hooks/Rack (Heavy Duty in Radiology)	Contractor / Contractor	Coordinate with Owner			Yes
Marker Boards & Cork Boards	Contractor / Contractor Contractor / Contractor	Coordinate with Owner Conduit and boxes by G.C.	Yes	Yes	Yes
	Contractor / Contractor	Coordinate Vendor with Owner			
Emergency Phones Med Gas Certification					Yes
Emergency Phones Med Gas Certification Diaper Changing Station	Contractor / Contractor	Chall most the ANCI requirements			
Emergency Phones Med Gas Certification Diaper Changing Station Emergency Shower Station / Eye Wash Station	Contractor / Contractor	Shall meet the ANSI requirements			
Emergency Phones Med Gas Certification Diaper Changing Station Emergency Shower Station / Eye Wash Station Free Extinguishers Grab Bars (Rest rooms, Radiology, Exam rooms, etc.)	Contractor / Contractor Contractor / Contractor Contractor / Contractor	Shall meet the ANSI requirements			Yes
Emergency Phones Med Gas Certification Diaper Changing Station Emergency Shower Station / Eye Wash Station Fire Extinguishers Grab Bars (Rest rooms, Radiology, Exam rooms, etc.) Mirrors (Rest rooms, Exams, Radiology, etc.)	Contractor / Contractor Contractor / Contractor Contractor / Contractor Contractor / Contractor		V	V	Yes
Emergency Phones Med Gas Certification Diaper Changing Station Emergency Shower Station / Eye Wash Station Free Extinguishers Grab Bars (Rest rooms, Radiology, Exam rooms, etc.)	Contractor / Contractor (SwissLog, Atreo Group, or	If Swisslog, verify pricing is per Intalere (Amerinet) Contract	Yes	Yes	Yes
Emergency Phones Med Gas Certification Diaper Changing Station Emergency Shower Station / Eye Wash Station Fire Extinguishers Grab Bars (Rest rooms, Radiology, Exam rooms, etc.) Mirrors (Rest rooms, Exams, Radiology, etc.) Pneumatic Tube Systems Plumbing Shrouds	Contractor / Contractor		Yes	Yes	Yes
Emergency Phones Med Gas Certification Diaper Changing Station Emergency Shower Station / Eye Wash Station Fire Extinguishers Grab Bars (Rest rooms, Radiology, Exam rooms, etc.) Mirrors (Rest rooms, Exams, Radiology, etc.) Pneumatic Tube Systems Plumbing Shrouds Sanitary Napkin Dispensers/Receptacles	Contractor / Contractor (SwissLog, Alreo Group, or other approved) Contractor / Contractor Contractor / Contractor Contractor / Contractor	If Swisslog, verify pricing is per Intalere (Amerinet) Contract Agreement. Design fees are included in this agreement.		Yes	Yes
Emergency Phones Med Gas Certification Diaper Changing Station Emergency Shower Station / Eye Wash Station Fire Extinguishers Grab Bars (Rest rooms, Radiology, Exam rooms, etc.) Mirrors (Rest rooms, Exams, Radiology, etc.) Pneumatic Tube Systems Plumbing Shrouds Sanitary Napkin Dispensers/Receptacles Security Cameras	Contractor / Contractor	If Swisslog, verify pricing is per Intalere (Amerinet) Contract Agreement. Design fees are included in this agreement. Coordinate final location with Owner.	Yes	Yes	Yes
Emergency Phones Med Gas Certification Diaper Changing Station Emergency Shower Station / Eye Wash Station Fire Extinguishers Grab Bars (Rest rooms, Radiology, Exam rooms, etc.) Mirrors (Rest rooms, Exams, Radiology, etc.) Pneumatic Tube Systems Plumbing Shrouds Sanitary Napkin Dispensers/Receptacles Security Cameras Voice/Data Cabling (all horizontal cabling - see Div. 27 specs)	Contractor / Contractor (AlphaCorp) Contractor / Contractor (AlphaCorp) Contractor / Contractor (Cache Valley Elec., IES Commercial, Data Tech Professionals, Americom)	If Swisslog, verify pricing is per Intalere (Amerinet) Contract Agreement. Design fees are included in this agreement. Coordinate final location with Owner. Coordinate with Owner/User on conections, pairs of fiber/copper, conduits, inner-ducts.	Yes Yes		







ADDENDUM #1

DATE: February 18, 2020

PROJECT NO: 19605

PROJECT: Intermountain Healthcare Tooele Dialysis Clinic

The following revision, additions, deletions, and/or items of clarification shall hereby be included as an integral part of the Contract Documents for the above-listed project and shall be fully binding. All other requirements of the original plans and specification shall remain in effect in their respective order.

DIVISION - 22 & 23

DRAWINGS

SHEET - PP100 - BELOW GRADE PLUMBING PLAN

Waste and vent removed for CS-1.

SHEET - PP101 - LEVEL 1 PLUMBING PLAN

- 1. CS-1 removed in Soiled (A128)
- 2. DCW main line resized for CS-1 being removed.

SHEET - PP601 - PLUMBING SCHEDULES

1. CS-1 removed from plumbing fixture schedule.



Electrical Addendum #2

Project: Tooele Dialysis Clinic From: Peter Johansen


Project No: 20190957 **Date:** February 18, 2020

DISCIPLINES
Mechanical Engineering
Electrical Engineering
Technology Design
Acoustical Engineering
Lighting Design
Theatre Design
Fire Protection Engineering
Building Commissioning

Drawings

EDP101 (See attached sheet)

- 1. Remove feeders and raceway feeding branch panel. Conduit will have to be reinstalled below rated ceiling. See revised keyed note #3.
 - 2. Remove all power and data receptacles above lay-in ceiling.
- 3. All existing MC cable, j-boxes and low voltage cabling running above ceiling must be removed during demolition. Wireway above branch panels also need to be removed. All existing receptacles to remain will have to be recircuited from the new branch panel location. All above ceiling electrical devices and cabling shown in sample pictures below must be removed in order to install rated sheet rock ceiling.

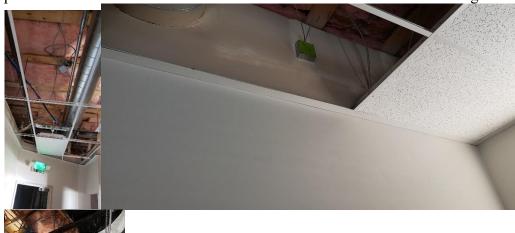

ENGINEERING EXCELLENCE
Healthcare
Higher Education
K-12 Education
Government
Houses of Worship
Special Projects

CENTERS OF

SALT LAKE CITY 324 S. State Street Suite 400 Salt Lake City, UT 84111 phone: 801-328-5151 fax: 801-328-5155

PHOENIX 1501 W. Fountainhead Parkway Suite 340

phone: 480-621-3444

fax: 480-621-3445

Tempe, AZ 85282



EP601 (See attached sheet)

Include in bid to pull new raceway for all branch panels in construction area. Feeders for panels will be long enough to repull in new raceway. See keyed note #3.

EL601

DISCIPLINES Mechanical Engineering Electrical Engineering Technology Design Acoustical Engineering Lighting Design Theatre Design Fire Protection Engineering

Building Commissioning

NF-4 & NF-8F: Change Lumens to 500 lumens per foot (2,000 lumens/4'). This lumen change is not reflected in part #'s below.

SA-1: Must have a lens.

OC-32 wall pack requires a battery pack

The following page has additional approved fixture manufacturers:

CENTERS OF ENGINEERING EXCELLENCE Healthcare Higher Education K-12 Education Government Houses of Worship Special Projects

Type	MFG	Part
DX-6	Halo	HC620D010 HM612835 61MDHWF (HALO, PDS)
G-1	TRULY GREEN SOLUTIONS, INC.	882240-35-S-F
G-2	TRULY GREEN SOLUTIONS, INC.	882450-35-S-F
NF-4	Neo-Ray	S124DR-S-375D-835-XX-4F0-1-U-DD- F-SCBA
NF-8F	Neo-Ray	S124DR-S-375D-835-XX-8F0-1-U-DD- F-SCBA

SALT LAKE CITY
324 S. State Street
Suite 400
Salt Lake City, UT 84111
phone: 801-328-5151
fax: 801-328-5155

PHOENIX 1501 W. Fountainhead Parkway

> Suite 340 Tempe, AZ 85282 phone: 480-621-3444 fax: 480-621-3445

Туре	MFG	Part
ESA-1	INDUSTRIAL LIGHTING PRODUCT	SS4-26WLED-U-35-FRAL / FI/
		ILBSLCP10
G-1	INDUSTRIAL LIGHTING PRODUCT	PAN22-30WLED-U-35
G-2	INDUSTRIAL LIGHTING PRODUCT	PAN24-36WLED-U-35
GS-2	Columbia Lighting	VSY24-35LWHEG-EDU
NF-4	LITECONTROL	4L-LG-D-*-*-SOF-C1-35K-D040-D01-
		1C-UNV
NF-8F	LITECONTROL	4L-LG-D-*-*-SOF-C1-35K-D040-D01-
		1C-UNV
OC-32	Hubbell Outdoor	TRP2-24L-50-4K7-3-UNV-DB-E
SA-1	INDUSTRIAL LIGHTING PRODUCT	SS4-26WLED-U-35-FRAL

EC101 (See attached sheet)

Show location of "RCB2" room control boards above ceiling

www.spectrum-engineers.com 800-678-7077



	Type	MFG	Part
	DX1	Gotham Lighting	EVO6 35/15 AR WD LSS MVOLT GZ10 TRW
	DX2	Gotham Lighting	EVO6 35/20 AR WD LSS MVOLT GZ10 TRW
DISCIPLINES	DX6	Gotham Lighting	EVO6 35/15 WR WD MVOLT EZB
Mechanical Engineering	E102	Isolite	UEL AC G 1C2M MTEBR
Electrical Engineering	ESA1	Lithonia Lighting	ZL1D L48 3000LM FST 277 35K 80CRI
Technology Design			E7W WH
Acoustical Engineering		Item Note: Verify vo	•
Lighting Design Theatre Design	G1	Lithonia Lighting	EPANL 2X2 3400LM 80CRI 35K MIN10 ZT MVOLT
Fire Protection Engineering	G2	Lithonia Lighting	EPANL 2X4 4800LM 80CRI 35K MIN10
Building Commissioning			ZT MVOLT
	GS2	Focal Point	FEQ2 24 AC 4500L 35K 1C UNV L11
		Itom Noto: Varify as	XX WH
CENTERS OF	NF4	Item Note: Verify ce Mark Architectural Lighting	iling type. SL4L LOP 4FT FLP TG 80CRI 35K
ENGINEERING EXCELLENCE	INF4	Mark Architectural Lighting	400LMF MIN10 277 ZT
Healthcare		Item Note: Verify vo	
Higher Education	NF8F	Mark Architectural Lighting	SL4L LOP 8FT FLP TG 80CRI 35K
K-12 Education			400LMF MIN10 277 ZT
Government	OC32	Lithonia Lighting	WST LED P3 40K VW MVOLT E7WC
Houses of Worship			DDBXD
Special Projects		-	dark bronze finish-Advise if different.
	SA1	Lithonia Lighting	ZL1D L48 3000LM FST MVOLT 35K 80CRI WH
	UC5	Healthcare Lighting Item Note: Verify vo	HUC523 277 LED35 S1 AM ltage.
	W3	Lithonia Lighting	LBL4 LP835
	Type	MFG	Part
	DX-1	Lightolier	6RN P6RDL15835CLZ10U
	DX-2	Lightolier	6RN P6RDL20835CLZ10U
SALT LAKE CITY	DX-6	Lightolier	6RN P6RSL20835CLZ10U
324 S. State Street	G-1	DayBrite	2FXP38L835-2-DS-UNV-DIM
Suite 400	G-2	DayBrite	2FXP43L835-4-DS-UNV-DIM
Salt Lake City, UT 84111	GS-2	Pinnacle Architectural Lighting	LU24-A-835HO-G1-U-PL2-1-0-W
phone: 801-328-5151	W-3	DayBrite	OWL450L835-UNV
fax: 801-328-5155	_	,	

PHOENIX

1501 W. Fountainhead Parkway Suite 340

Tempe, AZ 85282

phone: 480-621-3444 fax: 480-621-3445

fax: 480-621-3445

www.spectrum-engineers.com

800-678-7077



SPECIFICATIONS:

260923 – Lighting Control Devices Douglas Controls is an acceptable manufacturer

DISCIPLINES
Mechanical Engineering
Electrical Engineering
Technology Design
Acoustical Engineering
Lighting Design
Theatre Design
Fire Protection Engineering

Building Commissioning

275223 – Nurse Call system

Contractor is to acquire shop drawings from HillRom and coordinate exact rough-in requirements and device locations.

Contractor will provide rough-in boxes and raceway.

HillRom will provide and install all cabling and devices.

28311 – Digital Addressable Fire-Alarm System

Demolition: All existing fire alarm cabling and j-boxes in construction space must be removed. New cabling will have to be installed to existing devices to remain. Remove all

fire alarm j-boxes (see photo below)





SALT LAKE CITY 324 S. State Street Suite 400 Salt Lake City, UT 84111 phone: 801-328-5151 fax: 801-328-5155 Contact Stephen Pullan of Best for Fire alarm quote. He is the approved installer for the building.

Reference 3.2 for approved installation

PHOENIX

1501 W. Fountainhead Parkway Suite 340 Tempe, AZ 85282 phone: 480-621-3444 fax: 480-621-3445


www.spectrum-engineers.com 800-678-7077

LEGEND						
SYMBOL	DESCRIPTION	FIRE RESISTANCE RATING	DOOR FIRE RATING	WINDOW FIRE RATING		
•	COMMON PATH OF TRAVEL	N/A	N/A	N/A		
•	TRAVEL DISTANCE	N/A	N/A	N/A N/A		
ROOM NAME SQ. FT. ROOM # O.L. #	OCCUPANT LOAD	N/A	N/A			
SP	SMOKE PARTITION WALL	0 HOUR	SMOKE	SMOKE		
	SMOKE BARRIER WALL	1 HOUR	1/3 HOUR	1/3 HOUR		
	1 HOUR FIRE RATED WALL	1 HOUR	3/4 HOUR	3/4 HOUR		
→◆ →◆ →◆ →◆ 2 HOUR FIRE RATED WALL		2 HOUR	1-1/2 HOUR	1-1/2 HOUR		
	INDICATES AREA OUTSIDE THE SCOPE OF V	VORK				

01.02 EXISTING HIGH AND LOW DRINKING FOUNTAIN TO REMAIN. PROTECT DURING CONSTRUCTION. 01.06 NEW FIRE EXTINGUISHER AND CABINETS. SEE DETAIL 3/A506A



NJRA Architects, Inc. 5272 S. College Drive, Suite104 Murray, Utah 84123 801.364.9259 www.njraarchitects.com

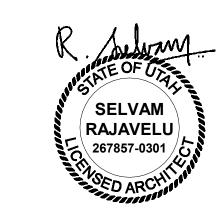

— COMMON PATH OF TRAVEL TRAINING ROOM 124 SF ROOM STORAGE 258 SF 247 SF TRAVEL DISTANCE __ 292.SE__ ___ <u>___ IN</u> - TRAVEL DISTANCE TRAINING ROOM 71" - 8" WORKROOM PRIVATE/ISOLATION 128 SF ___ 82 SF ___ 83 SF 80 SF CORRIDOR NEW DIALYSIS CLINIC 44 SF BAY #12 STATION 89 SF MED ROOM - TRAVEL DISTANCE **ELEVATOR** 139 SF 147 SF 58' - 5'' MACHINE **ROOM** BAY #13 54 SF 84 SF ELEVATOR • **STATION BAY #14** 146 SF 83 SF - COMMON PATH OF TRAVEL 13' - 2'' PHYSIÇAL THERAPY CLINIC BAY #5 BAY #4 EXIT

CODE REVIEW

APPLICABLE CODES
2018 INTERNATIONAL BUILDING CODE

OCCUPANCY CLASSIFICATION Business Group: B

REQUIRED SEPARATION OF OCCUPANCIES (Table 508.4, Page 108)

Between B & S1: 0 hour (No separation requirement)

FIRE SPRINKLER SYSTEM Building is equipped throughout with an automatic sprinkler system.

CONSTRUCTION TYPE
Building: Type V-B

BUILDING HEIGHT (Table 504.3, Page 98)

Allowable Building Height: 75 feet Actual Building Height: 45 feet & 4 inches

NUMBER OF STORIES (Table 504.4, Page 99)

Allowable Number of Stories (Occupancy – B): 4

Actual Number of Stories: 2 Below Grade Plane: 1 (Lift Pit Basement)

FLOOR AREA

Allowable Floor Area per Floor

Actual Floor Area on Level 1 – (Occupancy – B): 14,224 SF Remodel Floor Area at Level 1 6,442 SF

FIRE-RESISTANCE RATING REQUIREMENTS FOR BUILDING ELEMENTS

Floor construction and associated secondary members: 0 hour

(Table 601, Page 113) 0 hour Primary structural frame: Bearing walls – Exterior: 0 hour 0 hour Bearing walls – Interior: 0 hour Nonbearing walls and partitions – Exterior: Nonbearing walls and partitions – Interior: 0 hour

Roof construction and associated secondary members: 0 hour Dialysis Clinic is Ambulatory Care facility, therefore remodel suite is required to be separated from the other tenant occupied spaces with one-hour fire separation indicated in the code compliance plan including corridor walls and floor assembly above. See wall types sheet on A501 for UL listing for fire rated walls. See detail

Unlimited

FIRE-RESISTANCE RATING REQUIREMENTS FOR INCIDENTAL USES (ROOM OR AREA) (Table 509, Page 109)

3/A114 for fire rated floor assembly above ceiling for the entire remodel area.

Paint Shop: 1 hour or Automatic Sprinkler System Boiler Room: 1 hour or Automatic Sprinkler System Laundry Room: 1 hour or Automatic Sprinkler System SPACES WITH ONE EXIT OR EXIT ACCESS DOORWAY

(Table 1006.2.1, Page 254) Maximum Occupant Load of Space (Occupancy – B): 49 Common Path of Travel (Occupancy – B): 100 feet

EXIT ACCESS TRAVEL DISTANCE (Table 1017.2, Page 277)

Maximum Travel Distance (Occupancy – B): 300 feet

CORRIDOR FIRE-RESISTANCE RATING (Table 1020.1, Page 278)

MINIMUM CORRIDOR WIDTH

Corridor Walls (Occupancies A3, B, S1): 0 hour

(Table 1020.2, Page 279) Minimum corridor width required: 44 inches

Actual corridor width provided: 65 inches

DEAD END CORRIDORS (Page 279)

Occupancy - B: Not to exceed 50 feet

NJRA Project # Feb 4, 2020 Construction Documents Feb 18, 2020 1 Addendum 2

19230.00

Expansior

Clinic

Sis

Dialy

Code Compliance Plan Level 1 -Overall

01.08 CLEAN GOWN STORAGE.

- 01.14 DASHED LINE INDICATES AREA OF FUTURE TRAINING ROOM A141 TO BE BID UNDER BID ALTERNATE #1. THE ROOM SHALL HAVE WALLS AND DOOR IN BASE BID ALONG WITH PLUMBING PIPING, HVAC ITEMS NOTED IN CONSTRUCTION DOCUMENTS. NEW FINISHES, CEILING, MILLWORK, LIGHTING, PLUMBING FIXTURE ETC TO BE BID UNDER ALTERNATE #1.
- 01.16 SOILED GOWN STORAGE. 02.24 UPGRADE EXISTING WALL TO TYPE-Q BY REPLACING GYPSUM BOARD TO TYPE-X GYPSUM AND EXTENDING WALL TO DECK ABOVE FOR A ONE-HR FIRE
- 02.26 EXISTING FIRE RATED DOOR AND HARDWARE TO REMAIN. PROTECT DURING
- CONSTRUCTION. 02.39 EXISTING DOOR AND HARDWARE TO REMAIN. PROTECT DURING
- CONSTRUCTION. 02.44 REMOVE PORTION OF GYPSUM BOARD FROM EXISTING WALL TO INSTALL NEW
- FLOOR. PATCH REPAIR WALL TO ORIGINAL CONDITION AFTER WORK IS COMPLETED. SEE STRUCTURAL SHEET \$101 FOR MORE INFORMATION. 06.01 NEW CASEWORK. SEE INTERIOR ELEVATIONS AND FINISH PLANS.

KING STUD FRAMING AND STRUCTURAL ANCHOR BOLT TO THE CONCRETE

- 06.17 PLUMBING CHASE WALL. SEE INTERIOR ELEVATIONS AND DETAILS ON SHEET A505C. ALSO SEE ELECTRICAL AND PLUMBING DRAWINGS.
- 06.21 SOLID SURFACE INTEGRAL SINK. BASIS OF DESIGN: SAMSUNG, STARON A1181 SINK, COLOR "BRIGHT WHITE" BW010. ALSO SEE PLUMBING DRAWINGS.
- 08.01 NEW DOOR. SEE DOOR SCHEDULE FOR MORE INFORMATION. WOOD DOOR AT THE BUILDING HALLWAY SHALL MATCH COLOR AND FINISH OF THE ADJACENT EXISTING WOOD DOORS IN THE HALLWAY. WOOD DOORS INSIDE THE REMODEL SUITE SHALL BE CLEAR MAPLE FINISH.
- 08.03 CARD ACCESS, TYPICAL. SEE ELECTRICAL DRAWINGS.
- 08.04 CARD ACCESS AND AUTOMATED DOOR OPENER. SEE ELECTRICAL DRAWINGS.
- 08.05 PUSH PAD FOR AUTO DOOR ACTIVATION. SEE ELECTRICAL DRAWINGS. 08.07 OVERHEAD CONCEALED FULL BREAKOUT TRACKLESS UL 1784 SMOKE RATED NARROW STILE SINGLE SLIDE ALUMINUM AND GLASS DOOR. BASIS OF DESIGN: ASSA ABLOY VERSAMAX ICU DOOR SYSTEM. GLAZING TO BE 1/4" CLEAR TEMPERED. SEE DETAIL 8/A601A & 10/A601A.
- 08.08 EXISTING EXTERIOR WINDOWS TO REMAIN. PROTECT DURING CONSTRUCTION. 08.09 ALUMINUM AND GLASS MANUAL SLIDING WINDOW. BASIS OF DESIGN C. R. LAURENCE DW 4200 A TWO PANEL MANUAL DELUXE LOCKABLE SLIDING WINDOW. FINISH: SATIN ANODIZED. SEE SHEET A601A.
- 08.10 INTERIOR WINDOW . SEE SCHEDULE. HM WINDOW FRAME AND GLAZING TO BE 1-HR FIRE RATED.
- 09.04 PARTIAL HEIGHT WALL WITH SOLID SURFACE CAP. SEE WALL TYPE 'P' ON SHEET
- 09.08 3/4" THICK FIRE TREATED PLYWOOD FROM TOP OF BASE TO 7'-0" ABOVE BASE-ALL WALLS, TYPICAL, PAINT PLYWOOD TO MATCH WALL COLOR
- 09.27 PROVIDE SOLID SURFACE WINDOW SILL AT ALL EXTERIOR WINDOWS TYPICAL. SEE FINISH SCHEDULE AND DETAIL 5/A602A.
- 10.06 GRAB BARS. SEE SPECIFICATIONS. PROVIDE 'TYPE 1' METAL STUD BACKING PER DETAIL 5/A502A. SEE SHEET G003 FOR MOUNTING HEIGHTS.
- 10.11 METAL LOCKERS, 15" W X 18" D X 2 TIER. TOTAL 10 LOCKERS. SEE SPECIFICATIONS. SEE DETAIL 6/A506A FOR LOCKER BASE DETAIL.
- 10.18 COFFEE POT, OFCI. SEE ELECTRICAL DRAWINGS. 10.19 REFRIGERATOR, OFCI. SEE ELECTRICAL DRAWINGS.
- 11.02 NURSE CHARTING STATION. SEE DETAIL 1/A504A. ALSO SEE DETAIL 13/A502A FOR BACKING REQUIREMENTS. SEE ELECTRICAL DRAWINGS FOR POWER AND
- 11.03 PATIENT CHAIR/ RECLINER, OFOI.
- 11.05 METAL SHELVING, OFOI. 11.06 WALL MOUNTED MONITOR OFCI. SEE ELECTRICAL DRAWINGS. PROVIDE 3'-0"
- W X 2'-0" H X 18 GA SHEET METAL BACKING. 11.07 DIALYSIS HOSE AND SUPPLY BOX. SEE PLUMBING DRAWINGS. VERIFY LOCATION AND HEIGHT WITH OWNER BEFORE INSTALLATION.
- 11.08 TABLO HEMODIALYSIS SYSTEM. PROVIDED AND INSTALLED BY OWNERS
- 11.12 VENDING MACHINE, OFOI. SEE ELECTRICAL DRAWINGS 11.13 ICE AND WATER DISPENSER ON STAND, OFCI. SEE PLUMBING DRAWINGS.
- 11.14 FLUSH MOUNTED IN- FLOOR SCALE, OFCI. CONCRETE FLOOR TO HAVE A 3" RECESS FOR IN-FLOOR SCALE. RECESS TO BE 3'-0" W X 3'-4" D. PROVIDE 10" MINIMUM CLEARANCE FROM BACK WALL AND 6" MINIM CLEARANCE FROM SIDE WALL AS SHOWN. ALSO PROVIDE 3" RECESS FOR CONDUIT CENTERED ON THE RECESSED SLAB/IN-FLOOR SCALE FROM THE FLOOR SCALE TO WALL BEHIND. COORDINATE WITH IN-FLOOR SCALE MANUFACTURER. SEE DETAIL 2/A504A. POUR NEW THICKENED SLAB AFTER REMOVAL OF CONCRETE.
- 11.15 HIGH DENSITY WIRE SHELVING, OFOI 11.16 FLOOR MOUNTED BLANKET WARMER, OFCI. SEE ELECTRICAL DRAWINGS FOR
- POWER REQUIREMENTS. 11.17 LINEN CART, OFOI.
- 11.18 EXAM TABLE, OFOI. SEE ELECTRICAL DRAWINGS FOR POWER REQUIREMENTS. 12.01 FURNITURE, TO BE PROVIDED AND INSTALLED BY OWNERS VENDOR (MIDWEST
- COMMERCIAL INTERIORS MWCI) 12.02 PRIVACY CURTAIN AND TRACK. SEE FINISH SCHEDULE AND PROJECT MANUAL
- . SEE DETAIL 13/A503A 12.03 PROVIDE AND INSTALL 1" ALUMINUM BLINDS AT ALL EXTERIOR WINDOWS,
- TYPICAL THROUGHOUT THE PROJECT. FIELD VERIFY WINDOW SIZE BEFORE
- 22.01 FLOOR MOUNTED WATER CLOSET. SEE PLUMBING DRAWINGS. 22.02 WALL MOUNTED HAND WASH SINK. SEE PLUMBING DRAWINGS.
- 22.03 MOP SINK. SEE PLUMBING DRAWINGS. 22.04 COUNTER MOUNTED STAINLESS STEEL DEEP SINK. SEE PLUMBING DRAWINGS.
- 22.05 COUNTER MOUNTED EYE WASH. SEE PLUMBING DRAWINGS. 26.04 WALL MOUNTED PLUG STRIP. SEE ELECTRICAL DRAWINGS.
- 26.06 DOOR RELEASE BUTTON. SEE ELECTRICAL DRAWINGS.
- 26.14 NURSE CALL WITH PILLOW SPEAKER. SEE ELECTRICAL DRAWINGS.
- 26.16 WALL PHONE. SEE ELECTRICAL DRAWINGS. 26.17 FLOOR MOUNTED MULTI FUNCTION PRINTER/COPIER. SEE ELECTRICAL

RUN ELECTRICAL CONNECTIONS TO THE TABLE.

DRAWINGS FOR POWER AND DATA. 26.19 SEE ELECTRICAL DRAWINGS FOR FLOOR BOX RECESSED IN CONCRETE TO PROVIDE POWER AND DATA CONNECTION TO THE TABLE. COORDINATE WITH OWNERS VENDOR MIDWEST FURNITURE FOR LOCATION OF THE TABLE LEGS TO

ARCHITECTS

Murray, Utah 84123

www.njraarchitects.com

801.364.9259

NJRA Architects, Inc.

5272 S. College Drive, Suite 104

RAJAVELU

267857-0301

Expansio Sis Dialy

NJRA Project # Construction Documents Feb 4, 2020 1 Addendum 2 Feb 18, 2020

> Floor Plan Level 1

GENERAL NOTES

A. SEE SHEET G003 AND G005 FOR SYMBOLS, GENERAL NOTES AND LEGEND.

C. SEE SHEET A601 A FOR DOOR SCHEDULE AND WINDOW SCHEDULE

B. SEE SHEET A505A FOR CABINET LEGEND. E. SEE SHEET A602A FOR FINISH SCHEDULE AND GENERAL NOTES.



- 01.15 NO CEILING IN THIS ROOM. FINISHED & PAINTED TYPE-X GYPSUM BOARD ATTACHED TO THE FLOOR JOIST ABOVE WITH RESILIENT CHANNEL TO ACHIEVE 1-HR FIRE RATED FLOOR ASSEMBLY. SEE DETAIL 3/A114. 1-HR FIRE RATED FLOOR ASSEMBLY REQUIRED AT THE ENTIRE REMODEL SUITE.
- 09.35 ACOUSTIC CEILING TILES AND GRIDS. CEILING TILES TO BE ARMSTRONG ULTIMA HEALTH ZONE (ITEM # 1938) 24" X 48" X 3/4" EDGE DETAIL: SQUARE LAY-IN. GRIDS SHALL BE 15/16" PRELUDE XL EXPOSED TEE HEAVY DUTY. ANGLE MOLDING SHALL BE 7/8" WITH BERC 2 CLIPS. SEE CEILING DETAILS ON SHEET A503A. TYPICAL THROUGHOUT THE ENTIRE CLINIC/PROJECT.
- 09.36 ADD ONE LAYER OF 5/8" THICK, TYPE 'X' GYPSUM BOARD TO THE BOTTOM OF CEILING JOISTS . TYPICAL THROUGHOUT THE ENTIRE CLINIC/ PROJECT. GYP. BD. TO BE MUDDED AND TAPED ONLY. FINISH & PAINT GYP. BD. IN ROOMS THAT ARE EXPOSED TO VIEW AND DO NOT HAVE A LAY-IN OR A HARD LING CEILING BELOW.
- 09.37 GYPSUM BOARD CEILING. SEE DETAIL 5/A503A.

GENERAL NOTES

B. SEE SHEET A505A FOR CABINET LEGEND.

A. SEE SHEET G003 AND G005 FOR SYMBOLS, GENERAL NOTES AND LEGEND.

C. SEE SHEET A601 A FOR DOOR SCHEDULE AND WINDOW SCHEDULE

E. SEE SHEET A602A FOR FINISH SCHEDULE AND GENERAL NOTES.

- 09.38 GYPSUM BOARD SOFFIT. SEE DETAIL 9/A503A.
- 09.39 GYPSUM BOARD HEADER. SEE DETAIL 6/A503A. 09.42 CEILING MOUNTED CCTV CAMERA. SEE ELECTRICAL DRAWINGS.
- 11.10 CEILING MOUNTED TV. OFCI. PROVIDE 3" STAINLESS STEEL GROMMET AT OPENING IN CEILING TILE AT ALL CEILING MOUNTED TV LOCATIONS, TYPICAL.

RAJAVELU **** 267857-0301 /

ARCHITECTS

Murray, Utah 84123

www.njraarchitects.com

801.364.9259


NJRA Architects, Inc.

5272 S. College Drive, Suite 104

NJRA Project # Construction Documents 1 Addendum 2

Feb 4, 2020 Feb 18, 2020

Reflected Ceiling Plan Level 1

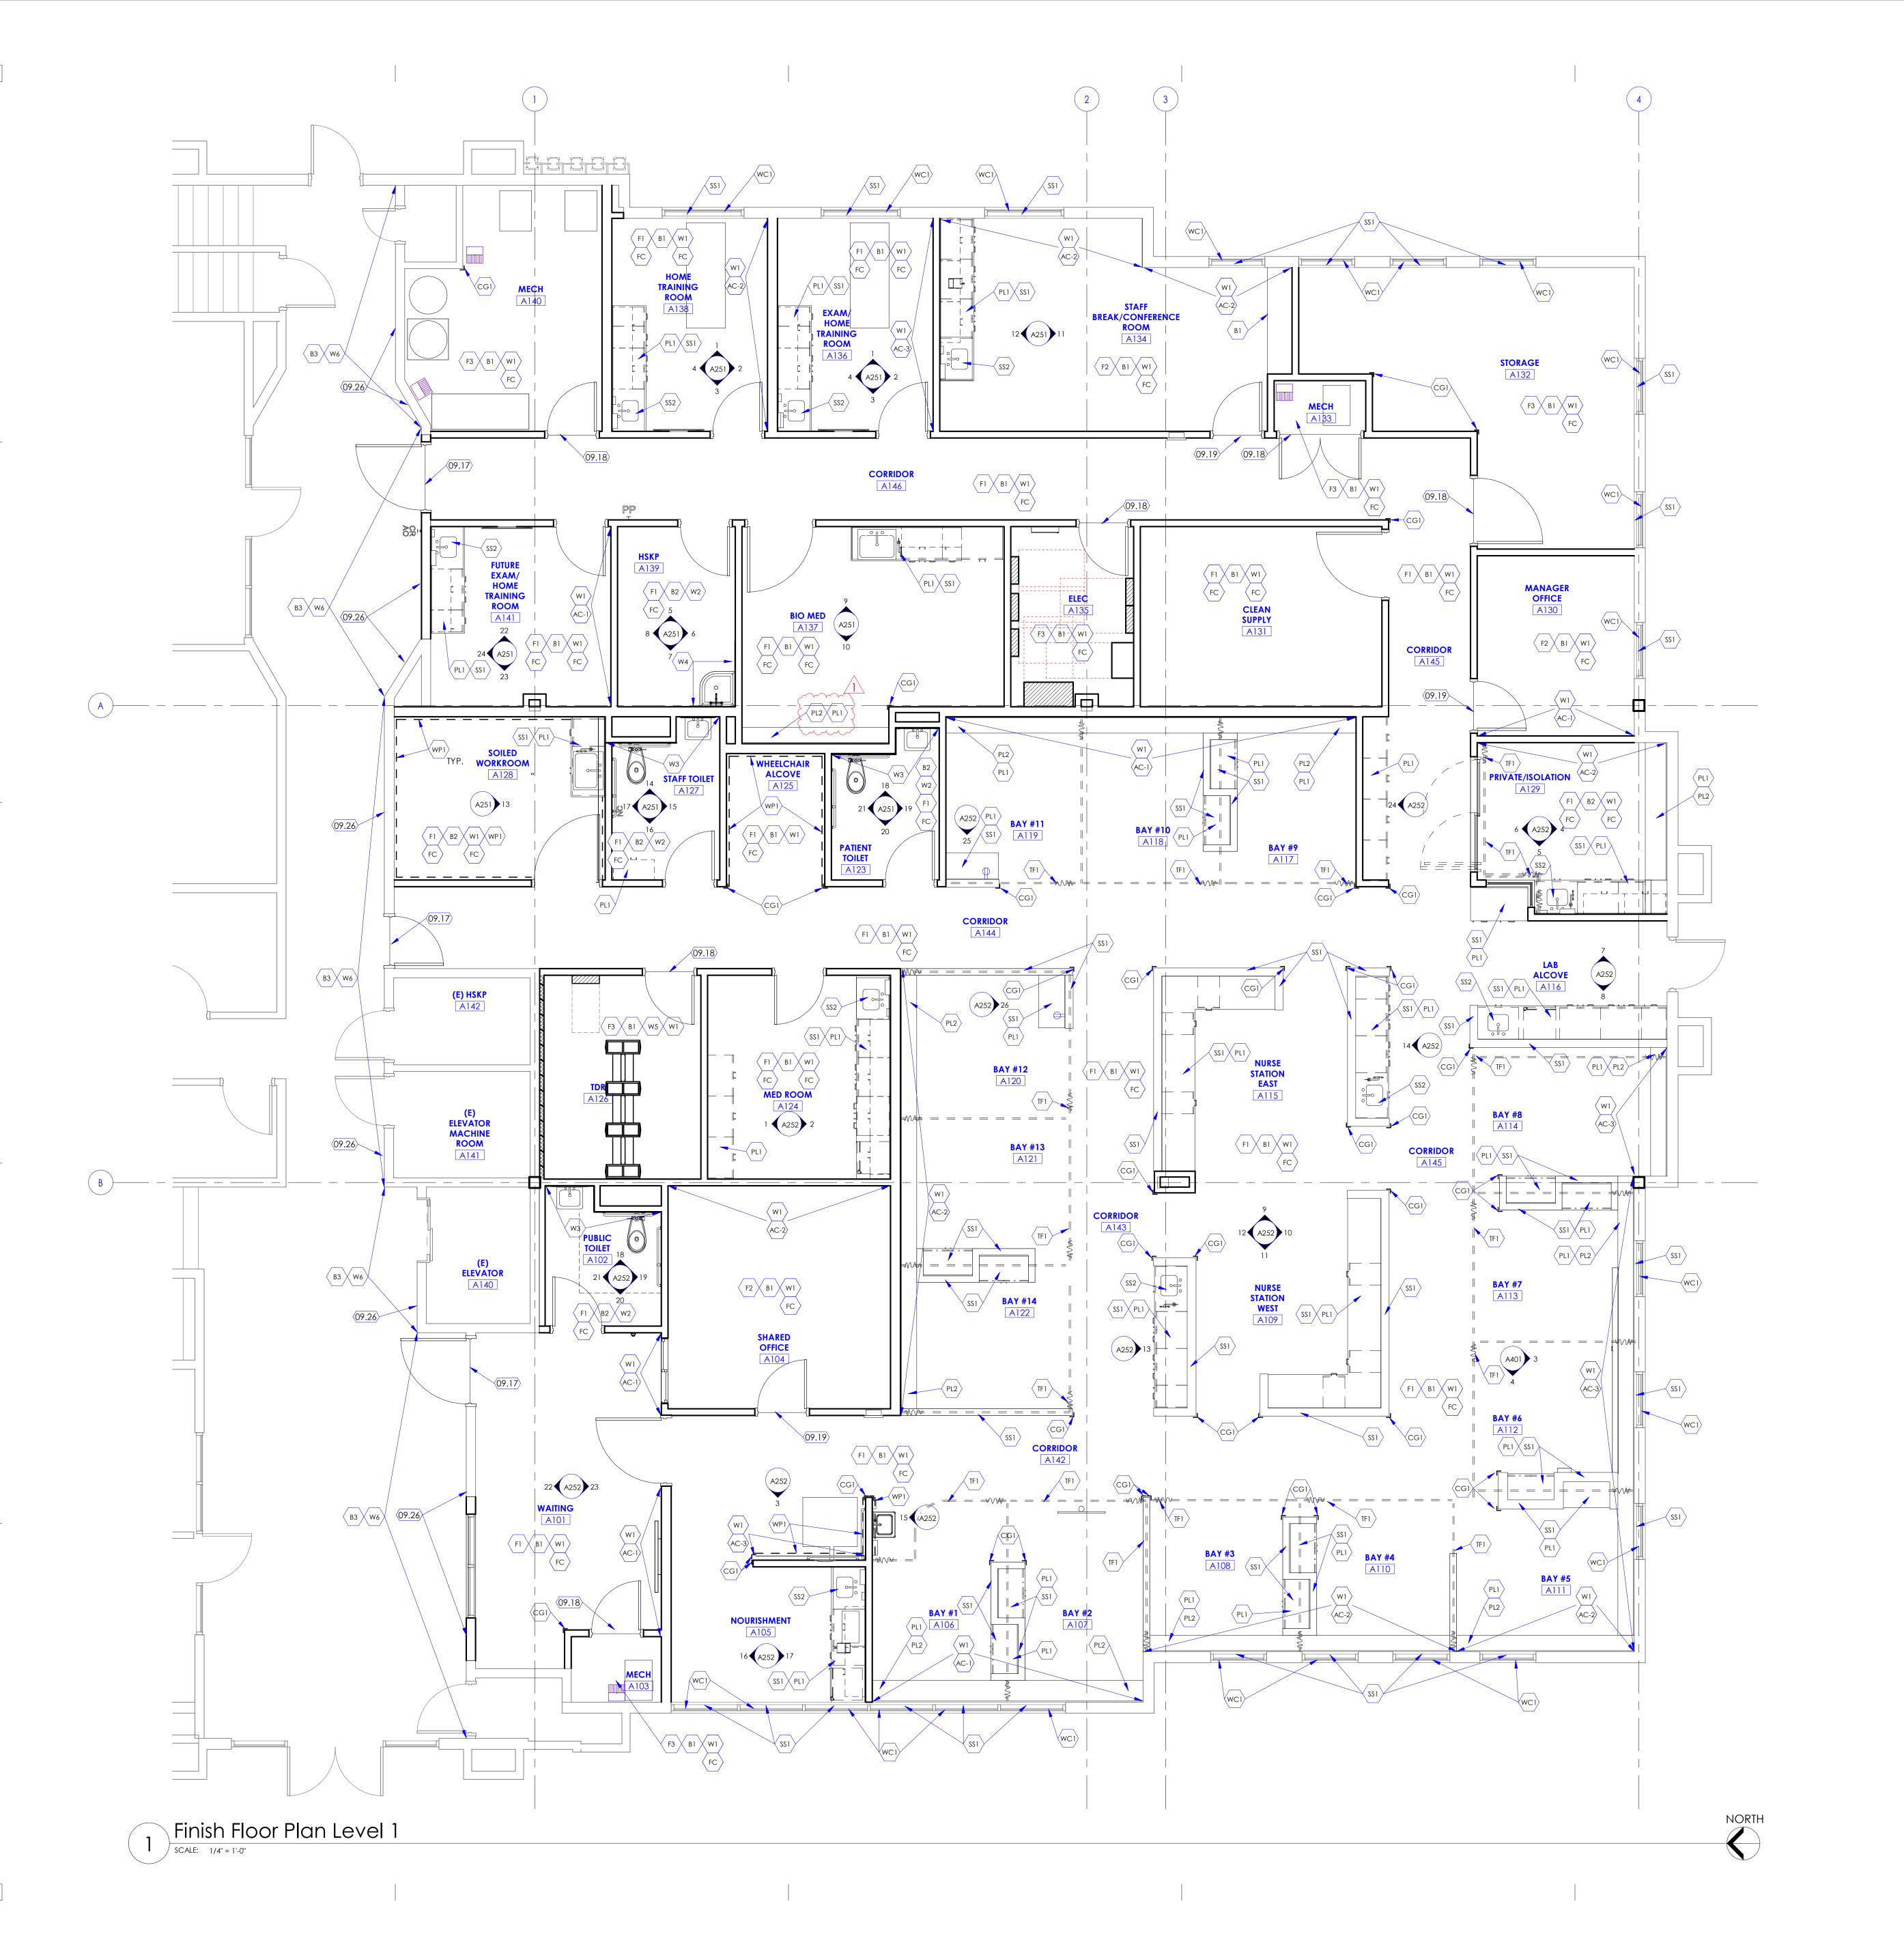


- 09.17 PROVIDE TRANSITION BETWEEN SHEET VINYL FLOORING AND CARPET FLOORING. SEE DETAIL 2/A602A.

 09.18 PROVIDE TRANSITION BETWEEN SHEET VINYL FLOORING AND EPOXY PAIN
- 09.18 PROVIDE TRANSITION BETWEEN SHEET VINYL FLOORING AND EPOXY PAINTED CONCRETE FLOOR. SEE DETAIL 3/A602A.
- 09.19 FLOAT FLOOR TO PROVIDE A SMOOTH TRANSITION.
- 09.26 PAINT AND FINISH CORRIDOR WALL TO MATCH COLOR AND FINISH OF THE ADJACENT EXISTING BUILDING HALLWAY. PROVIDE MATCHING WALL BASE. SEE FINISH SCHEDULE.



NJRA Architects, Inc. 5272 S. College Drive, Suite104 Murray, Utah 84123 801.364.9259 www.njraarchitects.com

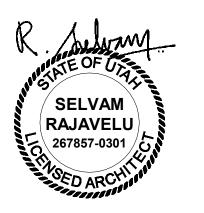


ey Dialysis Clinic Expansi

orthpointe Medical Park, Bldg B

NJRA Project #
Construction Documents
1 Addendum 2

Finish Floor Plan Level 1

A116

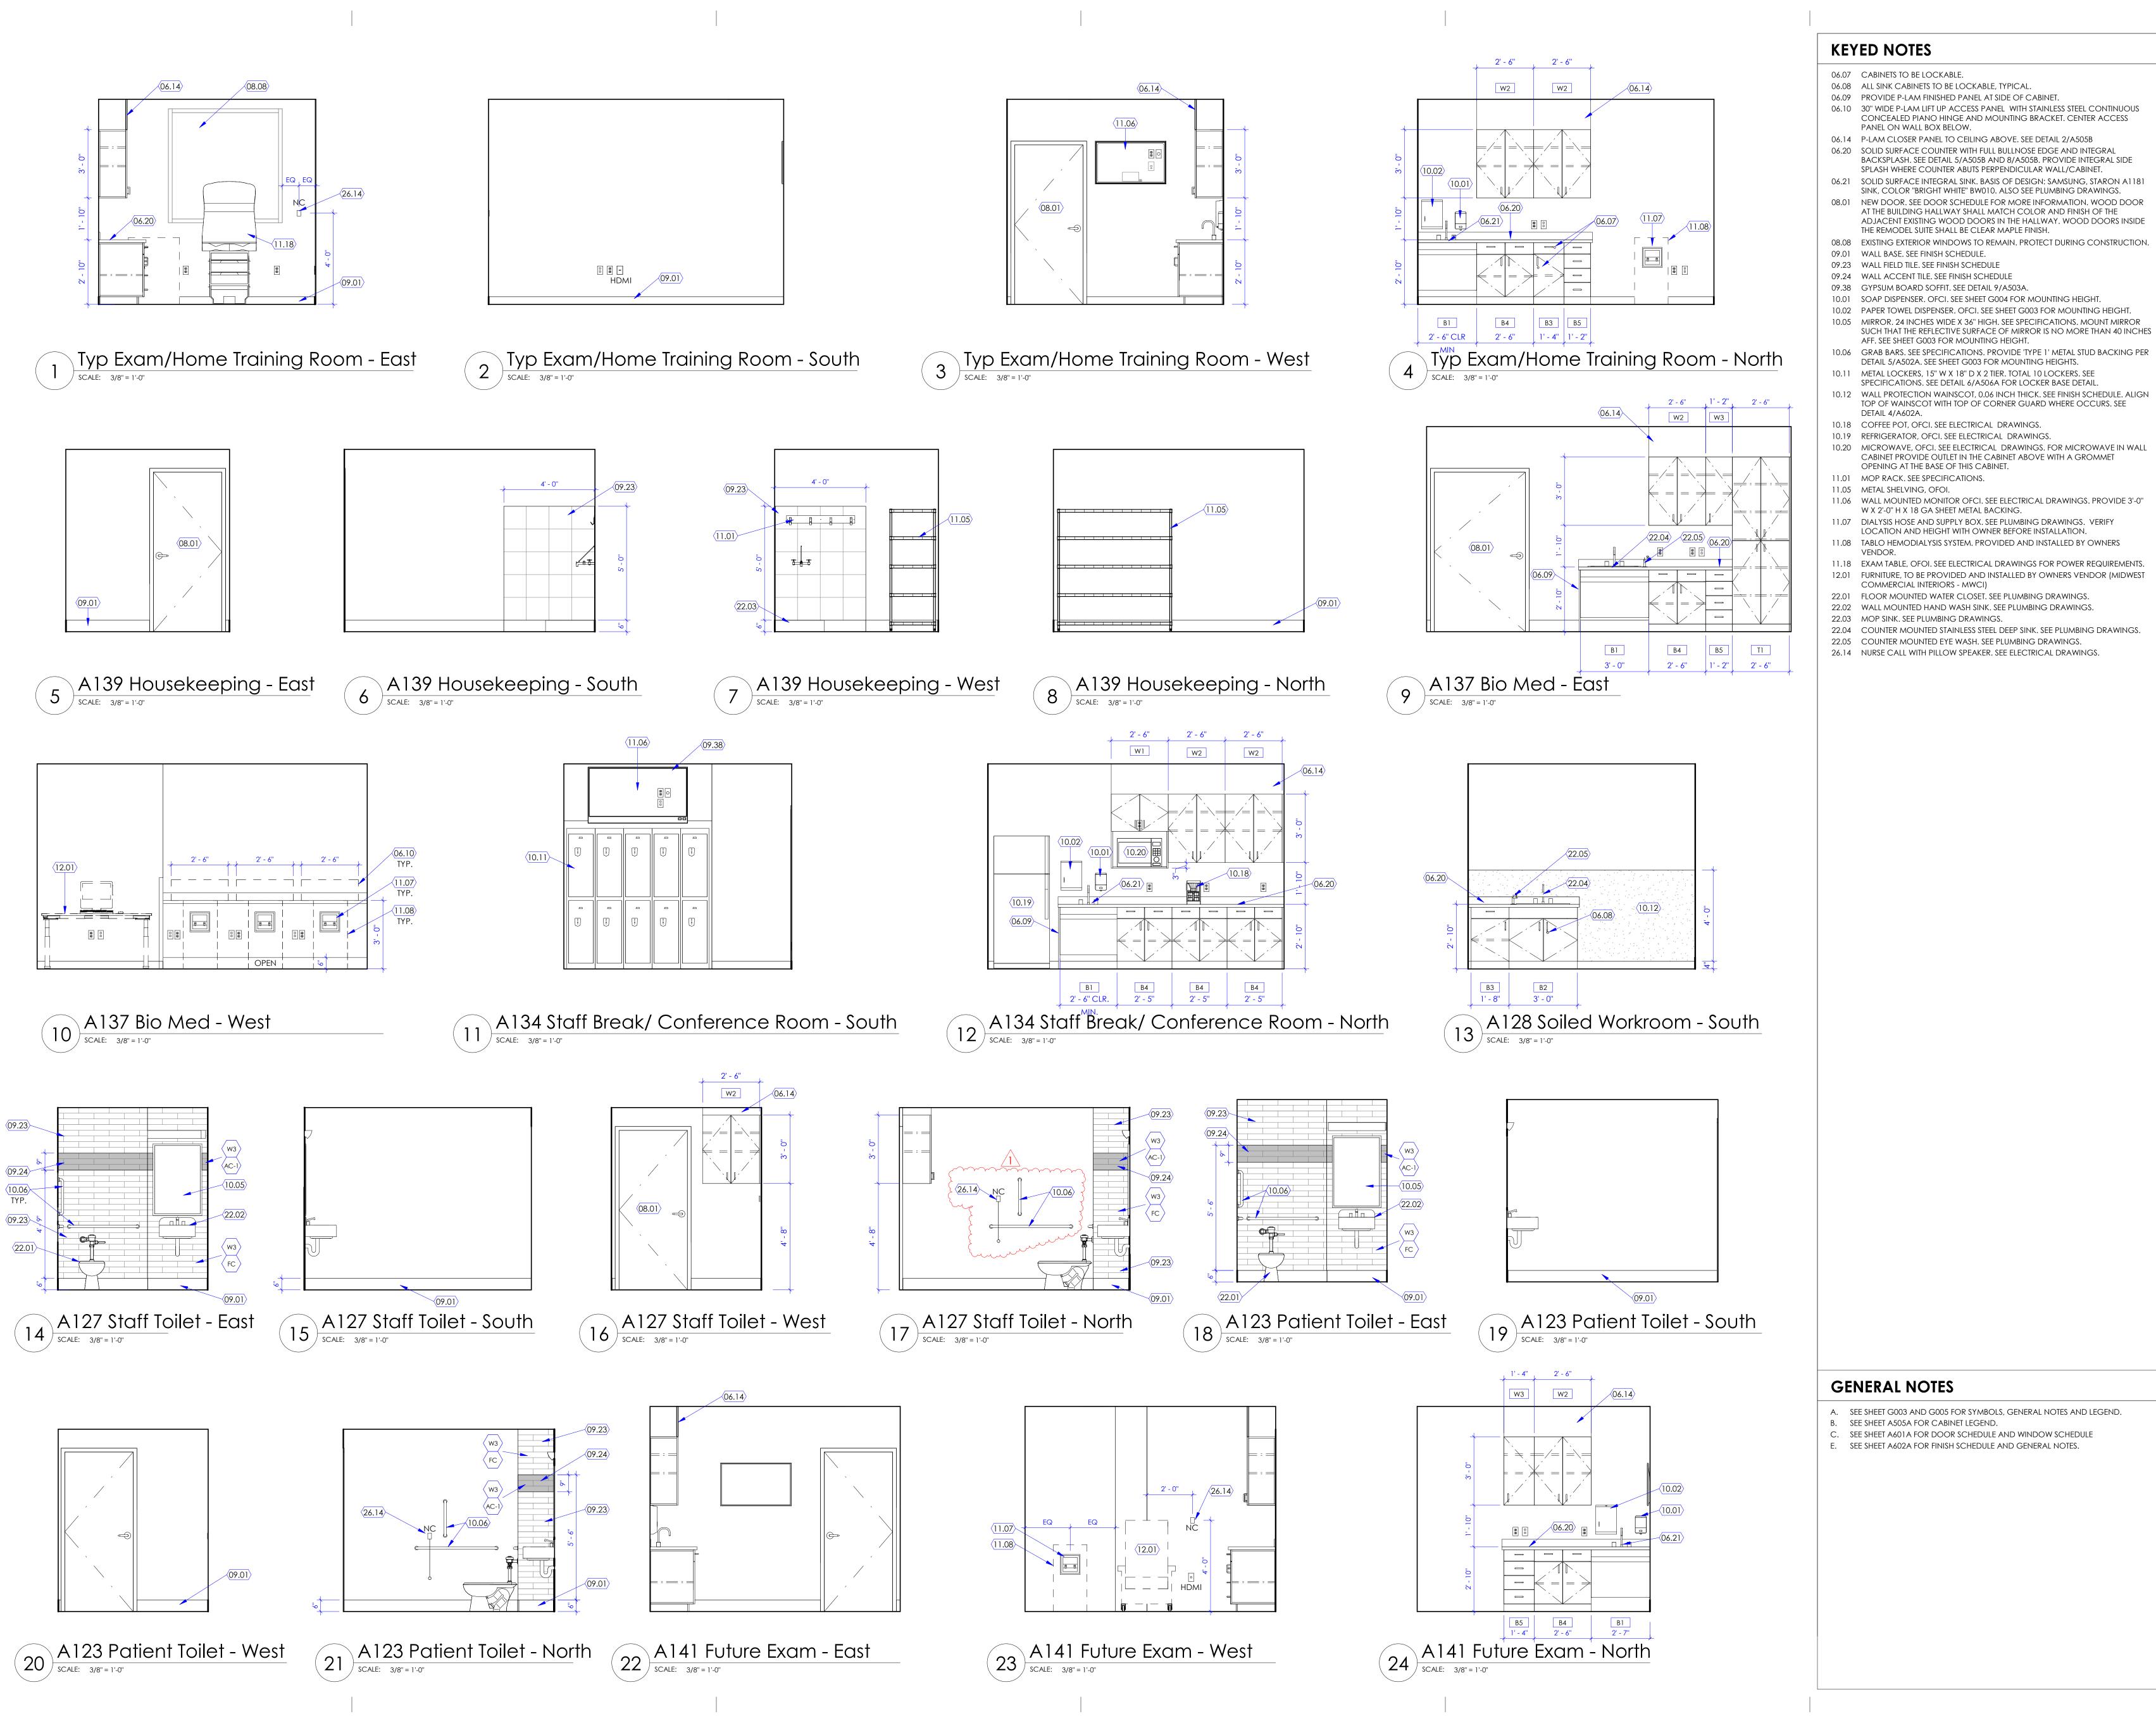

ARCHITECTS

NJRA Architects, Inc. 5272 S. College Drive, Suite104 Murray, Utah 84123 801.364.9259 www.njraarchitects.com



NJRA Project #

1 Addendum 2

Construction Documents

GENERAL NOTES

A. SEE SHEET G003 AND G005 FOR SYMBOLS, GENERAL NOTES AND LEGEND


B. SEE SHEET A505A FOR CABINET LEGEND.

C. SEE SHEET A601A FOR DOOR SCHEDULE AND WINDOW SCHEDULE

E. SEE SHEET A602A FOR FINISH SCHEDULE AND GENERAL NOTES.

Interior Elevations

A251

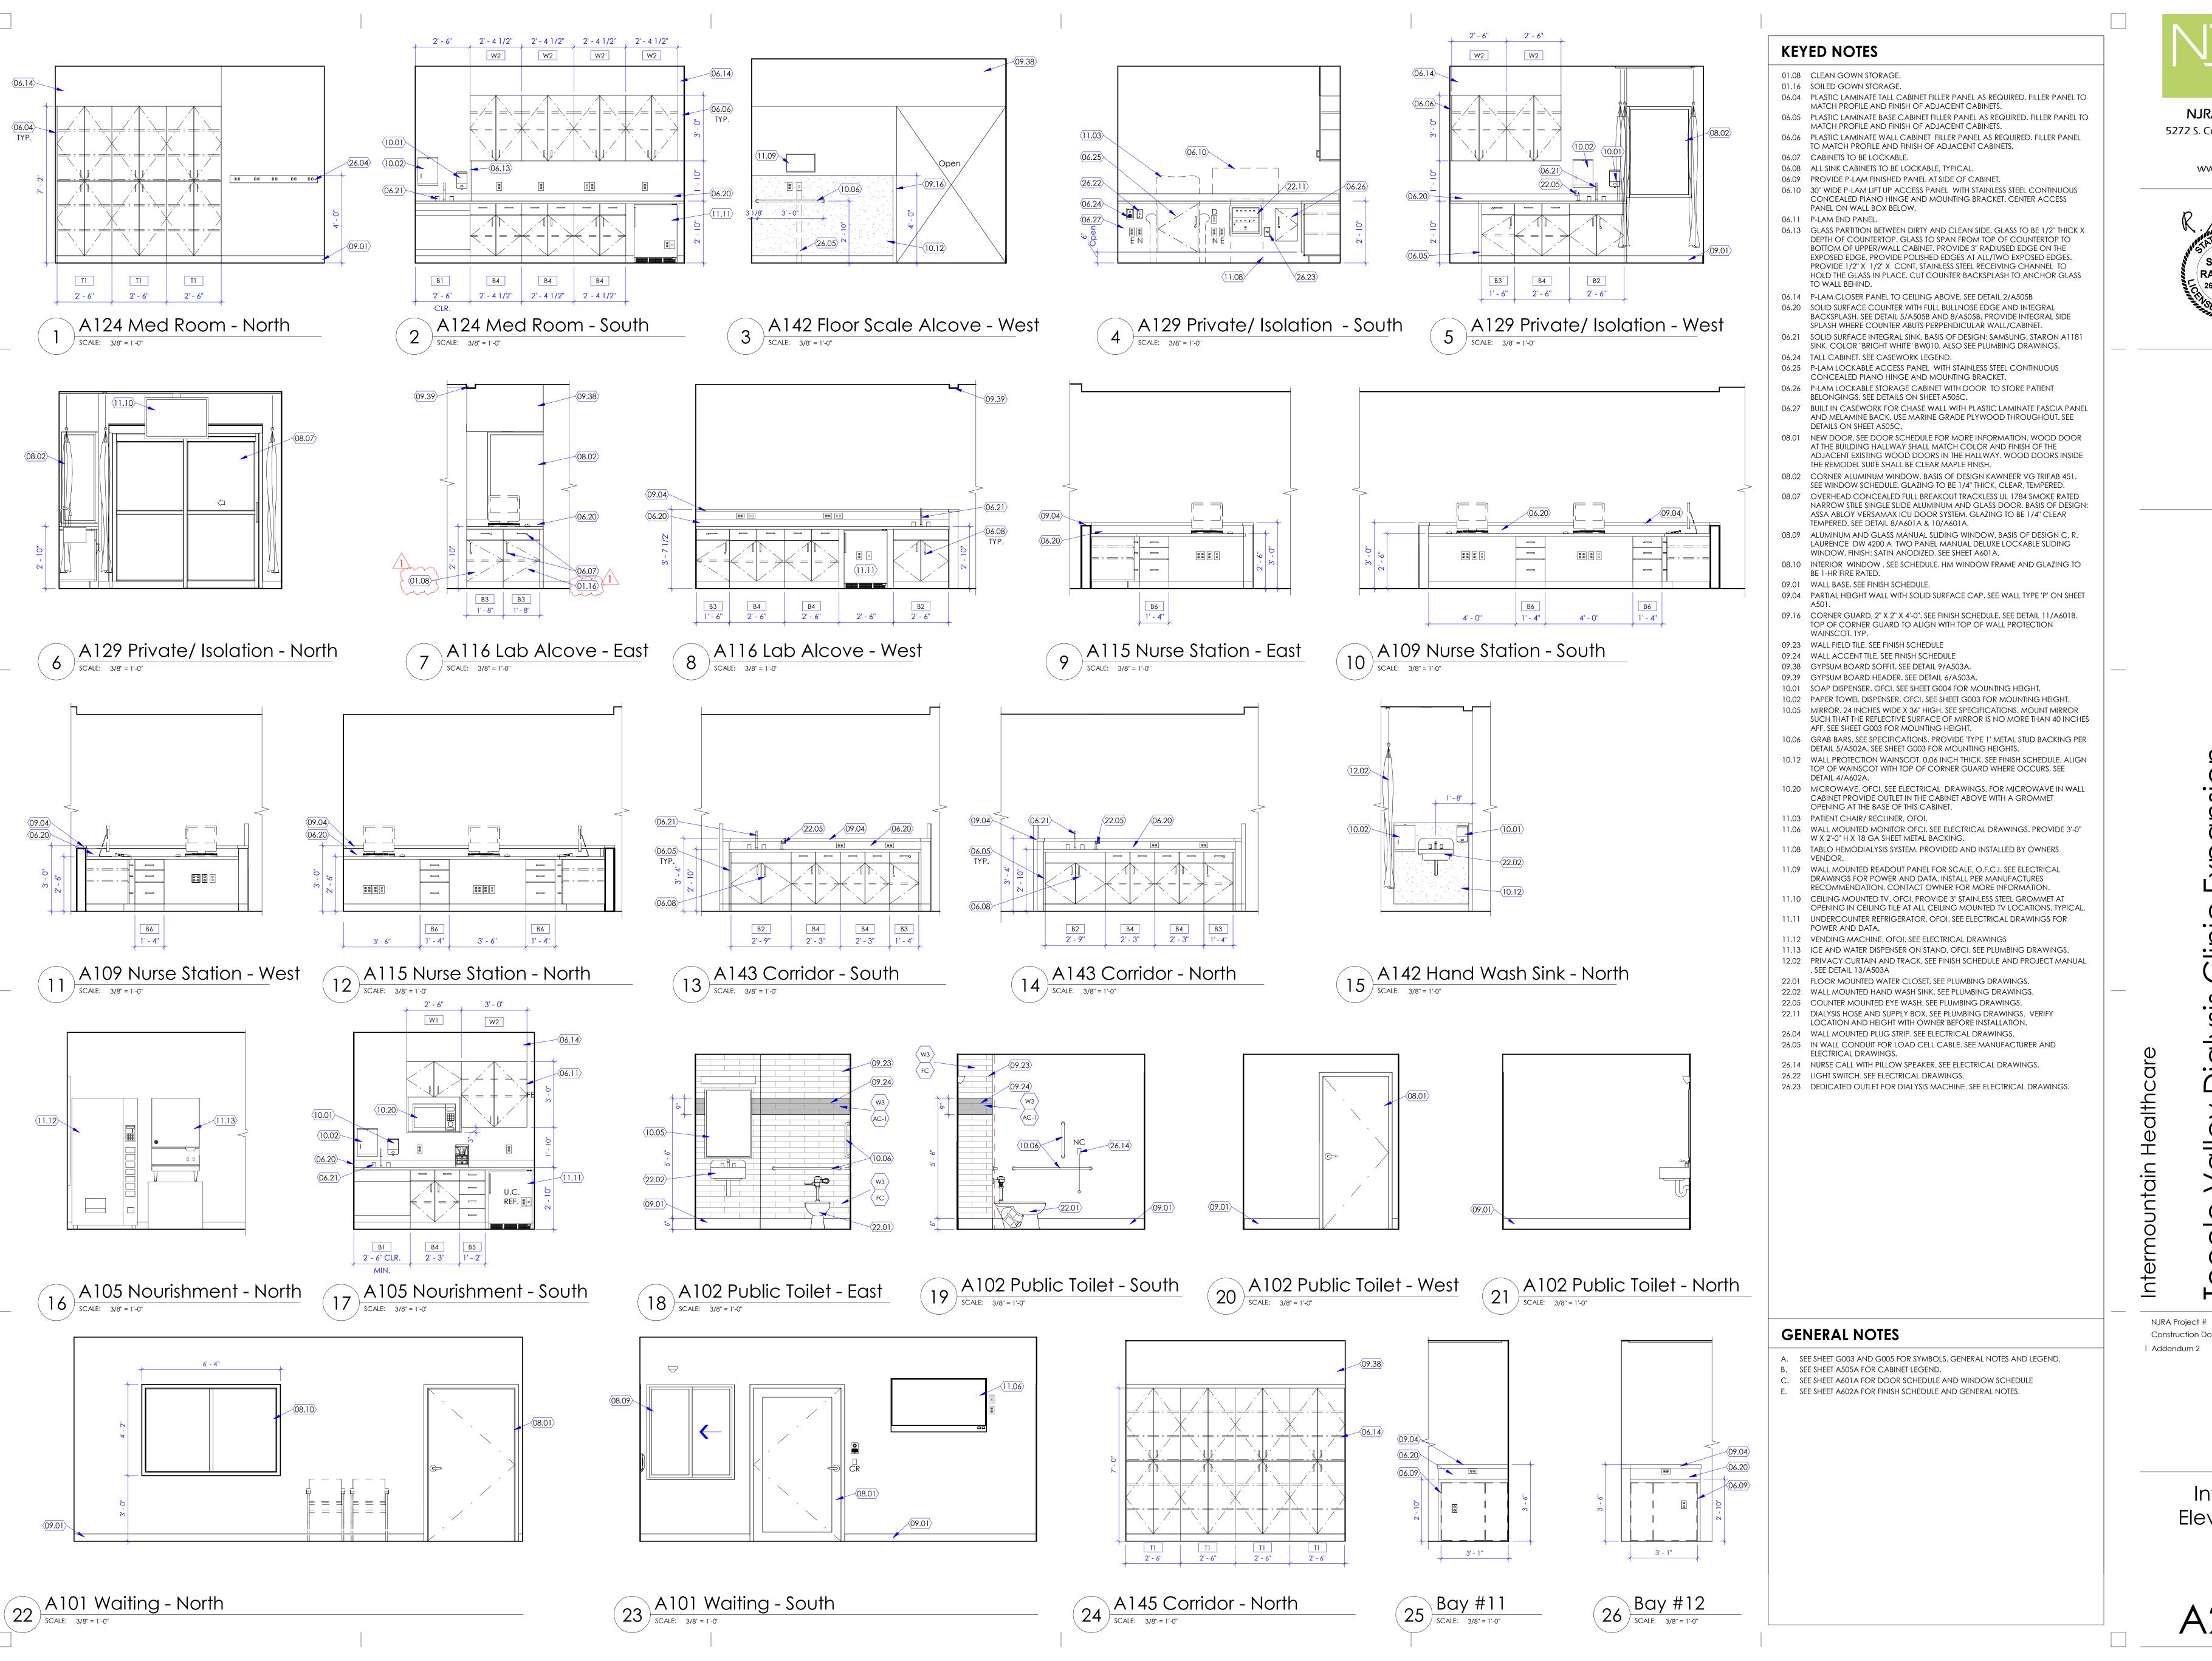

ARCHITECTS

NJRA Architects, Inc. 5272 S. College Drive, Suite104 Murray, Utah 84123 801.364.9259 www.njraarchitects.com



Expansior Clinic Dialysis

Construction Documents

19230.00

Feb 4, 2020 Feb 18, 2020


O


Interior Elevations


A252



NJRA Architects, Inc. 5272 S. College Drive, Suite104 Murray, Utah 84123 801.364.9259 www.njraarchitects.com

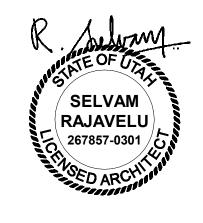

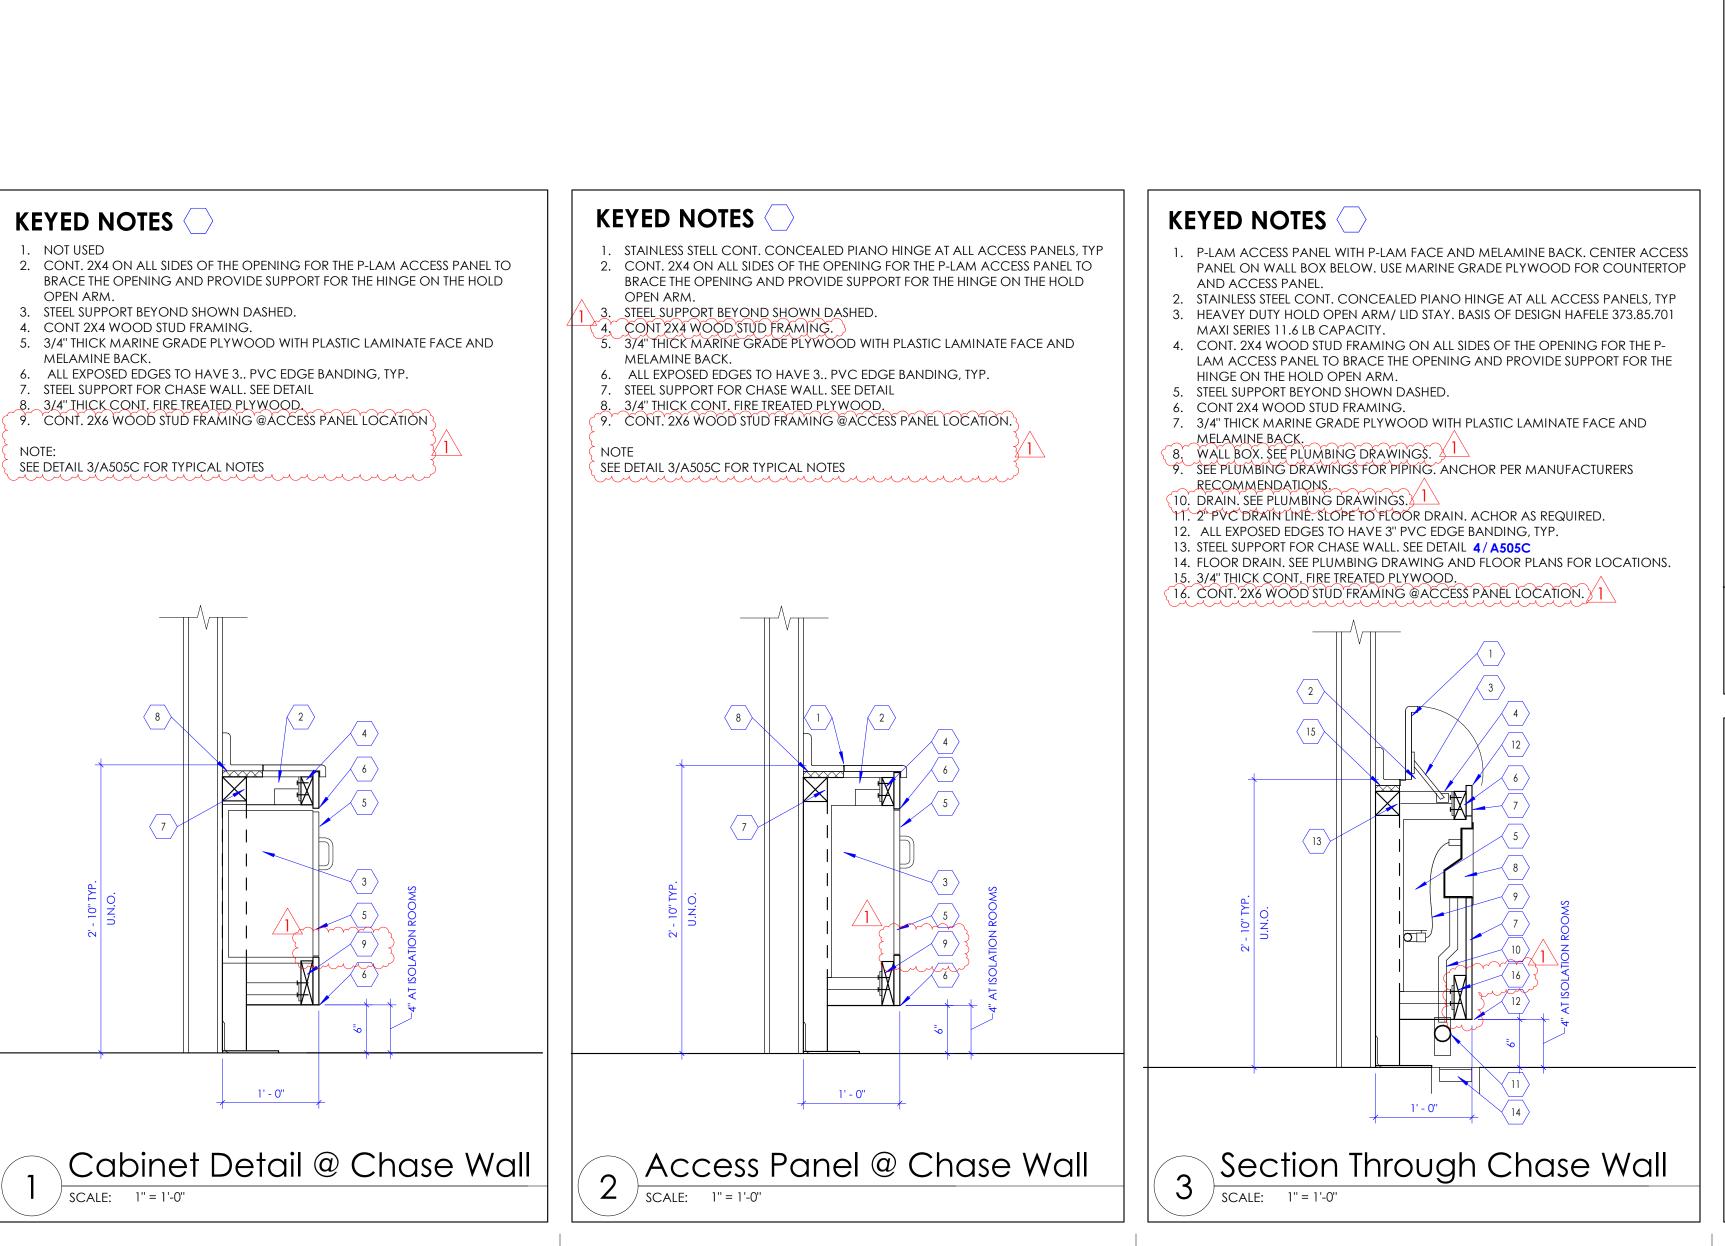

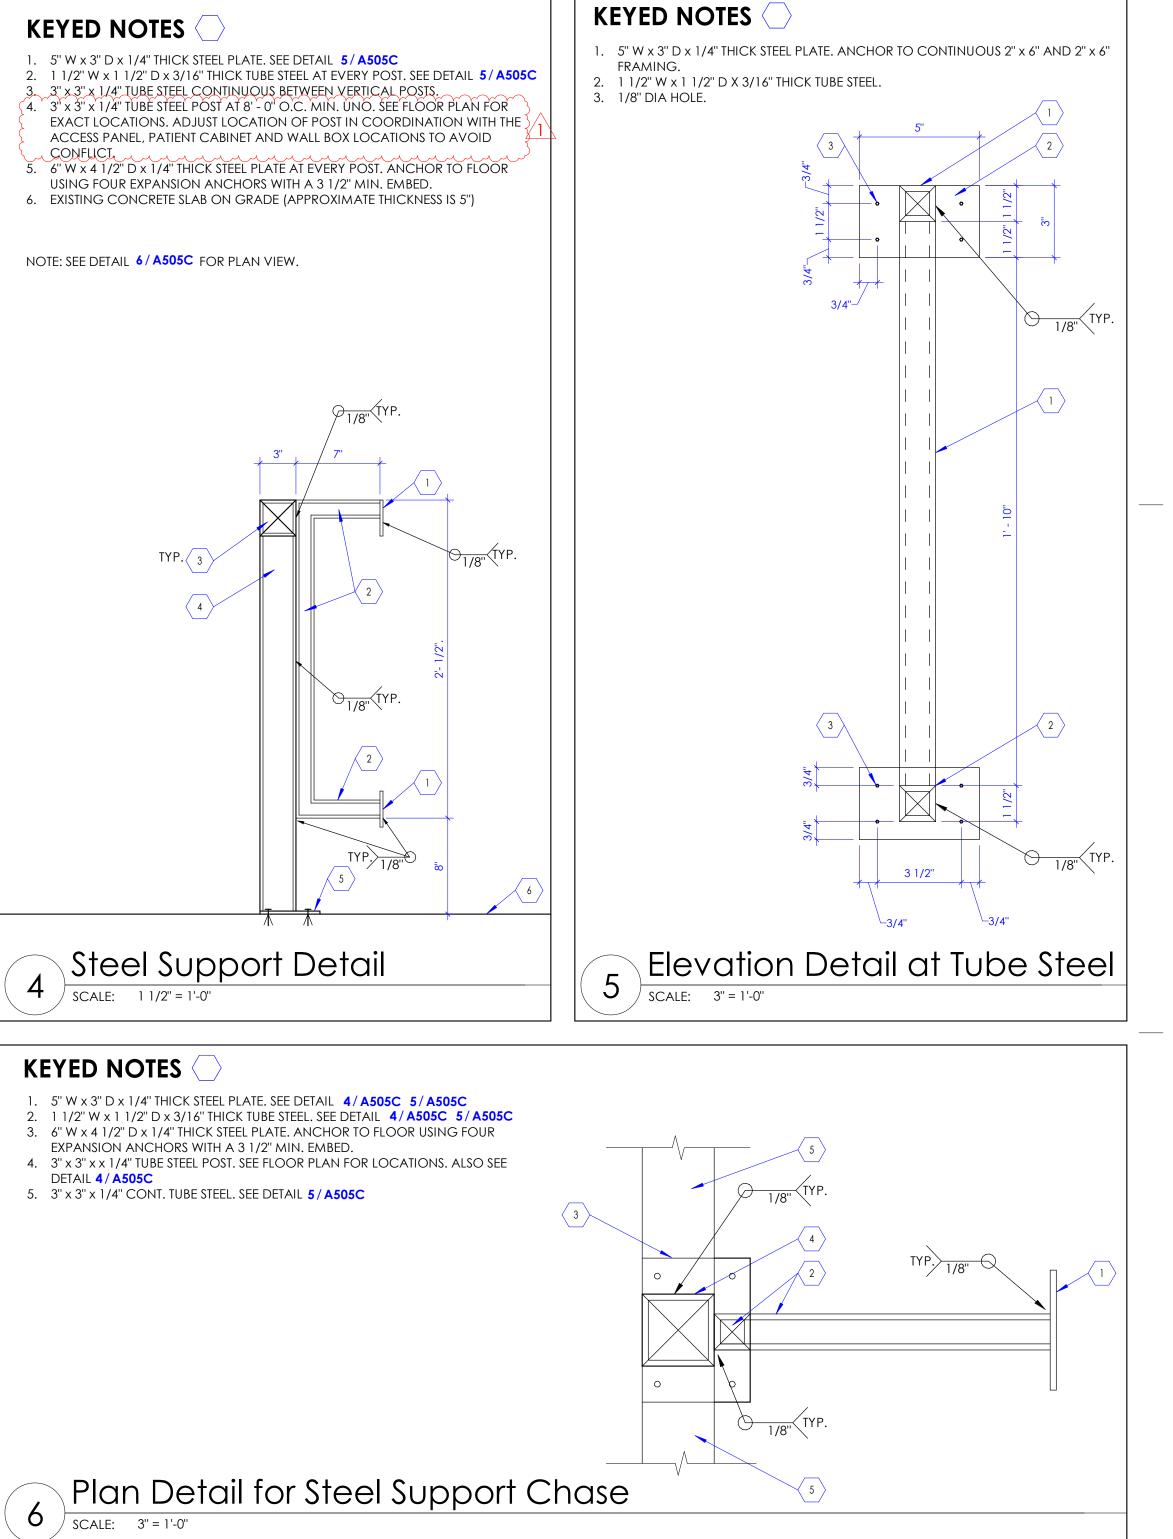


Intermountain Healthcare


NJRA Project # 19230.00
Construction Documents Feb 4, 2020
1 Addendum 2 Feb 18, 2020

Cabinet Details

A505C

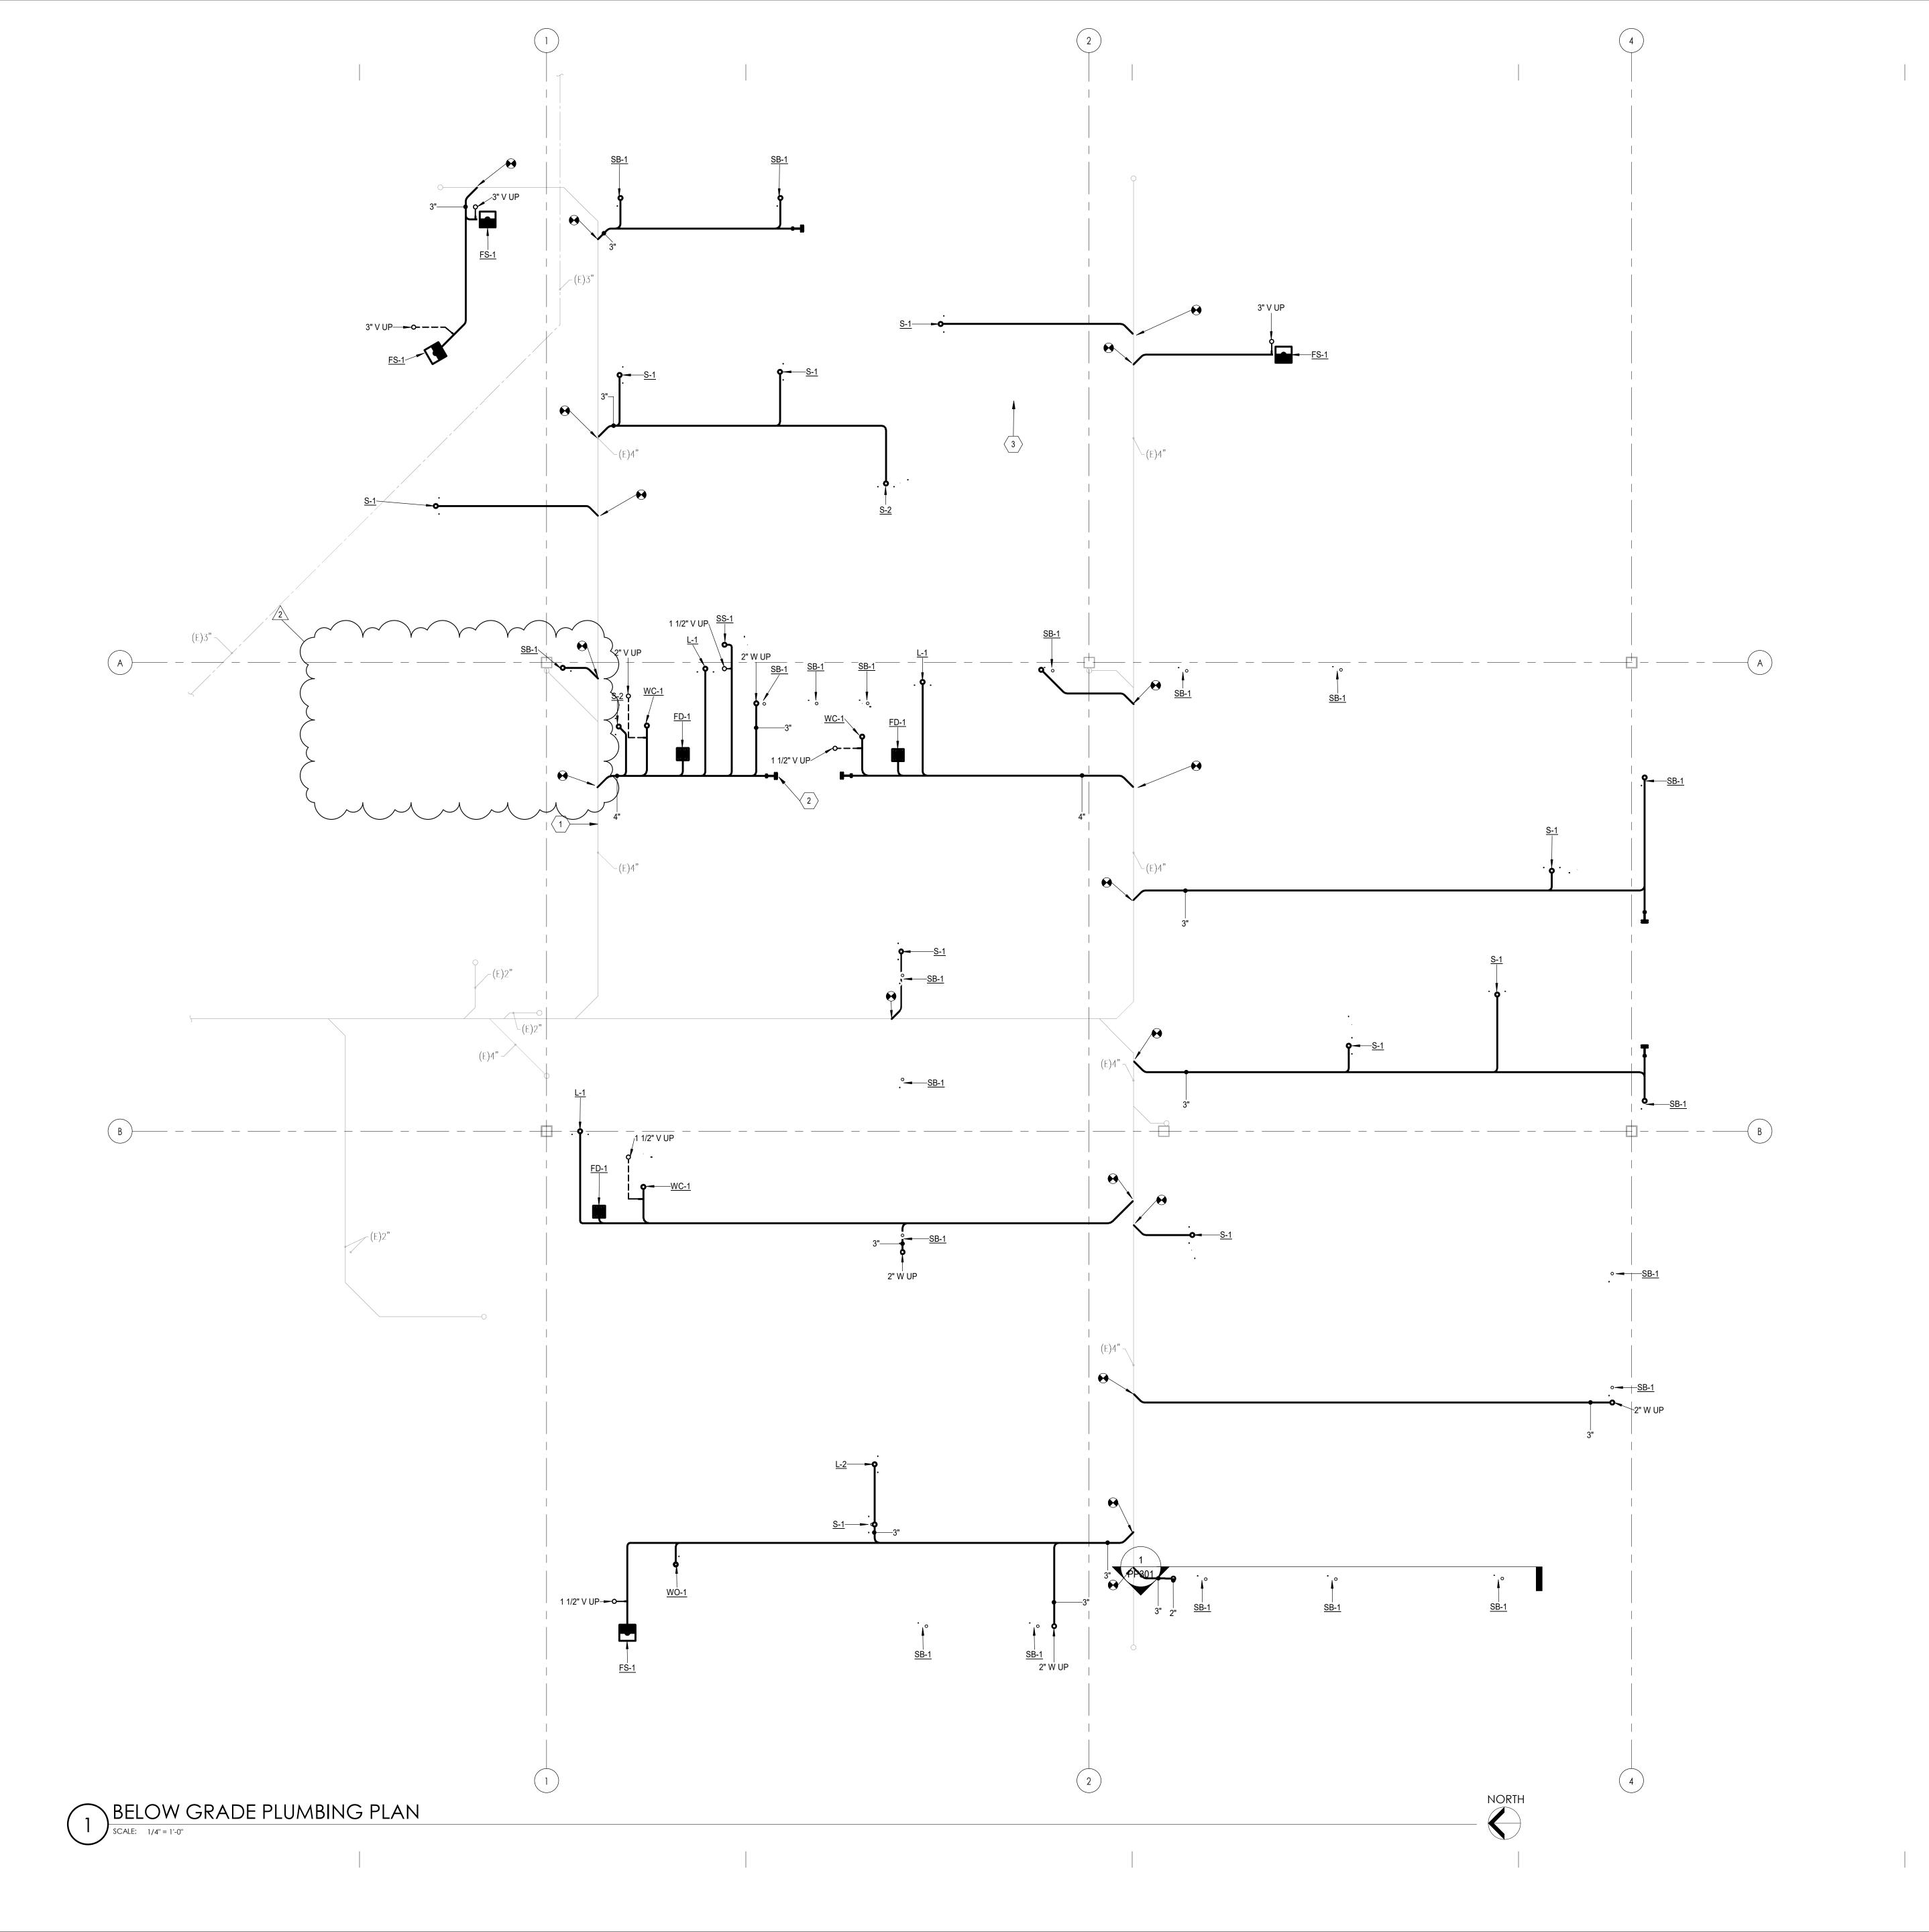

- 1. EXISTING ELEMENTS SHOWN LIGHT, TYPICAL.
- 2. CONTRACTOR RESPONSIBLE FOR COORDINATING AND LOCATING ALL CLEANOUTS PER CODE IN ADDITION TO CLEANOUTS CALLED OUT ON PLANS, TYPICAL.
- 3. WALLS SHOWN FROM ABOVE, TYPICAL.



NJRA Architects, Inc. 5272 S. College Drive, Suite104 Murray, Utah 84123 801.364.9259 www.njraarchitects.com



VAN BOERUM
& FRANKASSOCIATES, INC.
CONSULTING ENGINEERS

WWW.VBFA.COM


Salt Lake City. Logan · St. George · Tempe
330 South 300 East 801.530.3148 T
Salt Lake City, UT 84111 801.530.3150 F
VBFA Project Number: 19605

Dialysis Clinic Expansion

NJRA Project # 19230.00
Construction Documents February 03, 2020
1 Addendum #1 02/17/20
2 Addendum #2 02/18/20

BELOW GRADE PLUMBING PLAN

PP100

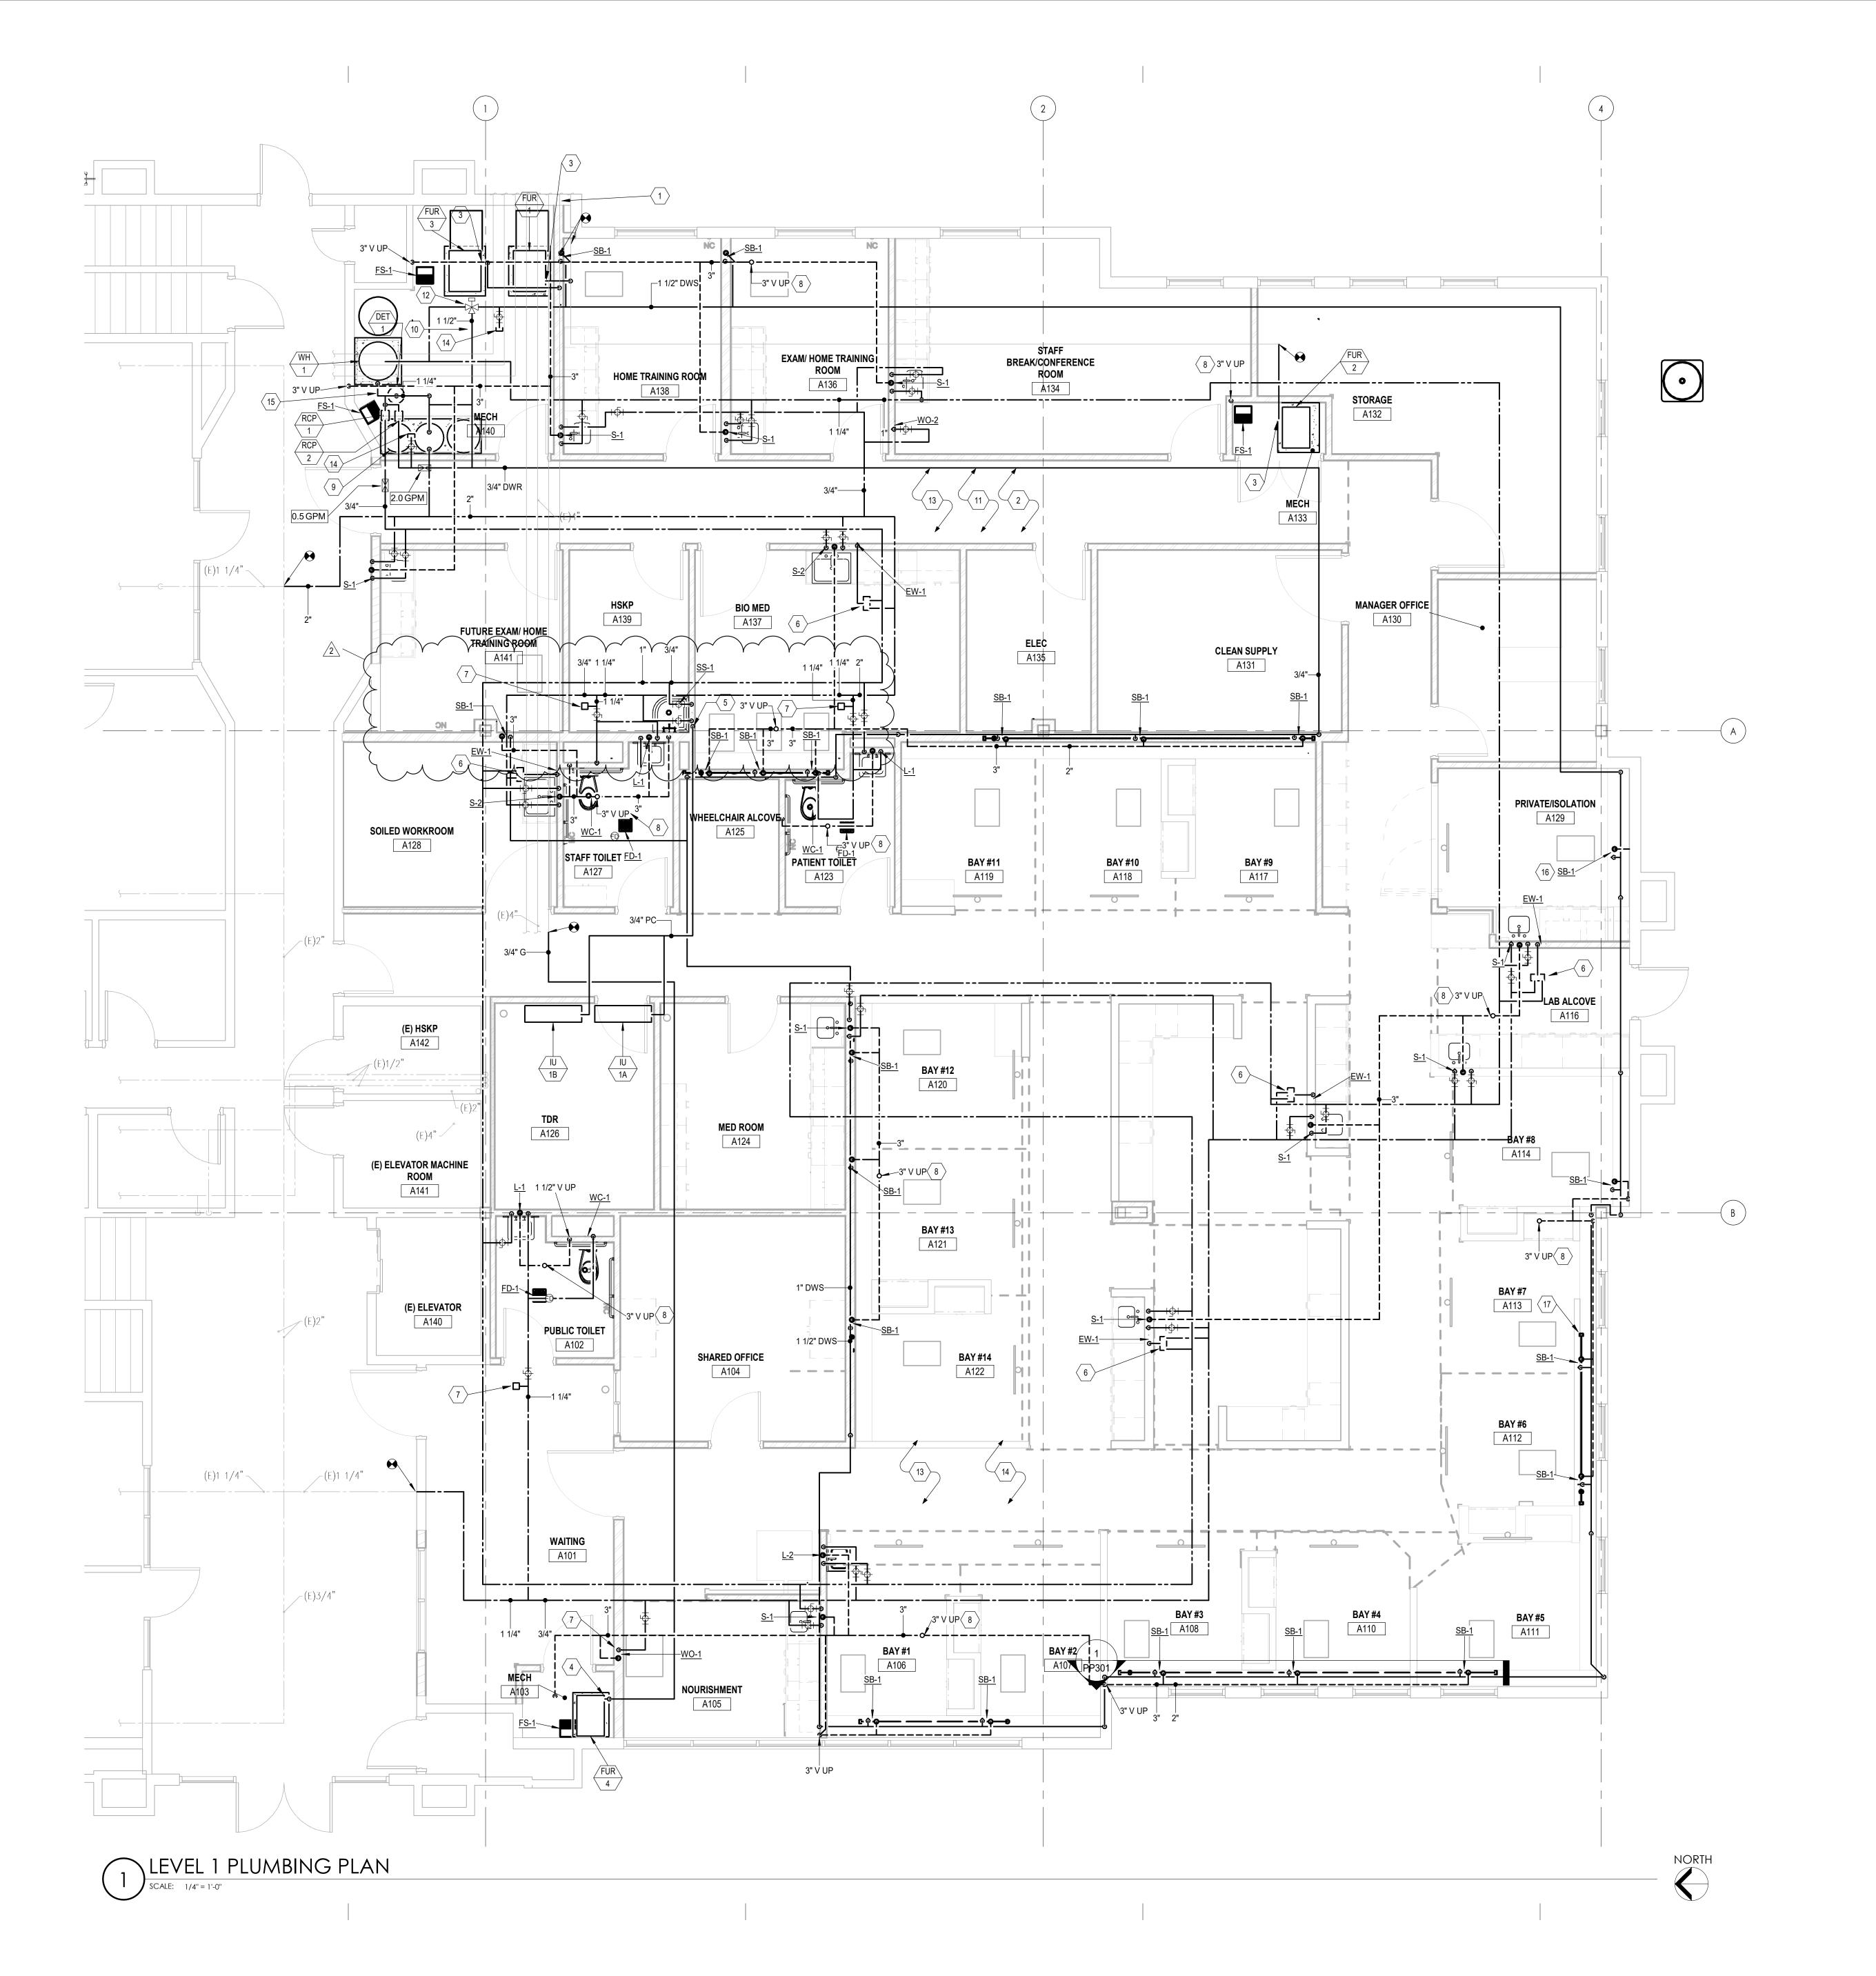

- 1. EXISTING ELEMENTS SHOWN LIGHT TO REMAIN, TYPICAL.
- 2. INSTALL NEW FIRE SPRINKLERS.
- 3. RELOCATE EXISTING PRV
- 4. INSTALL NEW 4 OZ PRV.
- 5. DROP DOWN WALL AND TERMINATE IN SERVICE SINK.
- 6. THERMOSTATIC MIXING VALVE INSTALLED IN CEILING.
- PROVIDE HAMMER ARRESTOR ON ALL FAST ACTING VALVES,
- 8. FIELD VERIFY LOCATION OF EXISTING VENT LINES PENETRATING LEVEL 2 FLOOR. CONNECT NEW VENT LINES TO EXISTING VENT LINES PENETRATING LEVEL 2 FLOOR. RUN ADDITIONAL PIPING AS NECESSARY.
- 9. OWNER PROVIDED WATER SOFTENER.
- 10. CONNECT TO OWNER PROVIDED WATER SOFTENER.
- 11. ALL SPRINKLER HEADS SHALL BE QUICK RESPONSE
 THROUGHOUT EACH REMODELED COMPARTMENT, TYPICAL.
 FIRE SPRINKLERS SHALL BE INSTALLED TO MEET NFPA 13-2016
 REQUIREMENTS, TYPICAL.
- 12. INSTALL THERMOSTATIC MIXING VALVE FOR REVERSE OSMOSIS APPLICATIONS.
- 13. INSTALL FIRE SPRINKLER SPRINKLERS AND PIPING AS NECESSARY FOR THE REMODELED SPACE, INCLUDING NEW FLOOR PLAN, CEILING PLAN, AND CEILING HEIGHT ADJUSTMENTS. REFER TO THE ARCHITECTURAL SHEETS FOR COMPLETE SCOPE OF THE PROJECT.
- 14. VALVE AND CAP FOR OWNER TO CHLORINATE LINE.
- 15. CONNECT RETURN LINE TO WATER HEATER PER MANUFACTURER RECOMMENDATIONS.
- 16. SEE ARCHITECTURAL PLANS FOR ELEVATION AND EXACT LOCATION OF SUPPLY BOX, TYPICAL.
- 17. TYPICAL CLEANOUT, SEE PP301 FOR SECTION.
- 18. DISASSEMBLE GAS PIPING FOR SHEETROCK INSTALLATION TO JOISTS.



NJRA Architects, Inc. 5272 S. College Drive, Suite104 Murray, Utah 84123 801.364.9259 www.njraarchitects.com



VAN BOERUM
& FRANKASSOCIATES, INC.
CONSULTING ENGINEERS
WWW.VBFA.COM

Salt Lake City. Logan . St. George . Tempe
330 South 300 East 801.530.3148 T
Salt Lake City, UT 84111 801.530.3150 F
VBFA Project Number: 19605

alysis Clinic Expansior

NJRA Project # 19230.00
Construction Documents February 03, 2020
1 Addendum #1 02/17/20
2 Addendum #2 02/18/20

LEVEL 1 PLUMBING PLAN

PP101

						PLUMBING FIXTURE SCH	
ID	FIXTURE		HW (IN)		V (IN)	DESCRIPTION	SPECIFICATION
EW-1	EMERGENCY EYEWASH		1/2			COUNTER MOUNTED, TEPID WATER	GUARDIAN G5022BP EYEWASH/DRENCH HOSE DECK MOUNTED UNITS WITH SLOAN ETF-470-A SINGLE CHECK VALVES ON HOT AND COLD LINES AND GUARDIAN G3600LF THERMOSTATIC MIXING VALVE. INSTALL THE EYEWASH/DRENCH HOSE UNIT ON THE COUNTER NEXT TO THE SINK. INSTALL THE MIXING VALVE ABOVE THE CEILING WITH THE OUTLET TEMPERATURE SET TO 75-80°F.
FD-1	FLOOR DRAIN			2	1-1/2	FLOOR DRAIN	FLOOR DRAIN: SMITH FIGURE 2005Y-P050 FLOOR DRAIN WITH CAST IRON BODY AND FLASHING COLLAR WITH 6-INCH ROUND NICKEL BRONZE ADJUSTABLE STRAINER HEAD WITH SECURED GRATE. PROVIDE TRAP GUARD TYPE TRAP SEAL DEVICE.
FS-1	MECHANICAL ROOM FLOOR SINK			3	1-1/2	MECHANICAL ROOM FLOOR SINK	FLOOR SINK: SMITH FIGURE 3100Y CAST IRON FLANGED RECEPTOR WITH ACID RESISTANT INTERIOR COATING, NICKEL BRONZE RIM AND SECURED 1/2 GRATE AND ALUMINUM DOME BOTTOM STRAINER.
L-1	PUBLIC TOILET ROOM LAVATORY	1/2	1/2	1-1/2	1-1/2	WALL HUNG, VITREOUS CHINA, GOOSENECK FAUCET WITH WRISTBLADES	LAVATORY: KOHLER K2030, GREENWICH, 20" X 18", VITREOUS CHINA, WITH FRONT OVERFLOW, 8" CENTERS. CHICAGO 786-GN2FCXKABCP FAUCET, WITH WRIST BLADE HANDLES, GN2 5-1/4" RIGID/SWING GOOSENECK WITH PLAIN END SPOUT AND 0.5 GPM LAMINAR FLOW CONTROL IN SPOUT INLET. WATTS LFUSG-B-M2 THERMOSTATIC MIXING VALVE WITH SLOAN ETF-470-A SINGLE CHECK VALVES ON HOT AND COLD LINES. FLEXIBLE STAINLESS STEEL SUPPLIES WITH 1/4 TURN ANGLE STOPS. CHICAGO 327-XCP OPEN-GRID STRAINER AND CAST BRASS P-TRAP WITH CLEANOUT PLUG. SMITH 0700-Z CONCEALED ARM CHAIR CARRIER WITH FOOT SUPPORT. PROVIDE ADA COMPLIANT UNDER COUNTER PIPING WRAP BY TRUE-BRO, COLOR TO BE WHITE.
L-2	LAVATORY	1/2	1/2	1-1/2	1-1/2	WALL HUNG, VITREOUS CHINA, GOOSENECK FAUCET WITH WRISTBLADES	LAVATORY: KOHLER K2030, GREENWICH, 20" X 18", VITREOUS CHINA, WITH FRONT OVERFLOW, 8" CENTERS. CHICAGO 786-GN2FCXKABCP FAUCET, WITH WRIST BLADE HANDLES, GN2 5-1/4" RIGID/SWING GOOSENECK WITH PLAIN END SPOUT AND 1.5 GPM LAMINAR FLOW CONTROL IN SPOUT INLET. WATTS LFUSG-B-M2 THERMOSTATIC MIXING VALVE WITH SLOAN ETF-470-A SINGLE CHECK VALVES ON HOT AND COLD LINES. FLEXIBLE STAINLESS STEEL SUPPLIES WITH 1/4 TURN ANGLE STOPS. CHICAGO 327-XCP OPEN-GRID STRAINER AND CAST BRASS P-TRAP WITH CLEANOUT PLUG. SMITH 0700-Z CONCEALED ARM CHAIR CARRIER WITH FOOT SUPPORT. PROVIDE ADA COMPLIANT UNDER COUNTER PIPING WRAP BY TRUE-BRO, COLOR TO BE WHITE.
S-1	TYPICAL SINK	1/2	1/2	2	1-1/2	INTEGRAL, GOOSENECK FAUCET WITH WRISTBLADES	SINK: INTEGRAL SINK. CHICAGO 895-317GN2FCXKABCP FAUCET, WITH WRIST BLADE HANDLES, 5-1/4" GN2 RIGID/SWING GOOSENECK SPOUT WITH 1.5 GPM LAMINAR FLOW CONTROL IN SPOUT INLET. WATTS LFUSG-B-M2 THERMOSTATIC MIXING VALVE WITH SLOAN ETF-470-A SINGLE CHECK VALVES ON HOT AND COLD LINES. FLEXIBLE STAINLESS STEEL SUPPLIES WITH 1/4 TURN ANGLE STOPS AND CAST BRASS P-TRAP WITH CLEANOUT PLUG. REPLACE QUATURN COMPRESSION OPERATING CARTRIDGE WITH CERAMIC 1/4-TURN OPERATING CARTRIDGE. PROVIDE WITH PLAIN END SPOUT.
S-2	WORKROOM SINK	1/2	1/2	2	1-1/2	ADA, COUNTER MOUNTED, STAINLESS STEEL, GOOSENECK FAUCET WITH WRISTBLADES	SINK: JUST SLN-ADA-2131-A-GR 16" X 28" X 6-1/2" I.D. COUNTER MOUNT 18 GA. STAINLESS STEEL SINK WITH 3 HOLE 8" CENTERS DRILLING, INTEGRA STAINLESS STEEL FLAT GRID AND REAR CENTER DRAIN LOCATION. CHICAGO 786-GN8FCXKABCP FAUCET, WITH WRIST BLADE HANDLES, 8" GN8 RIGID/SWING GOOSENECK SPOUT WITH 1.5 GPM LAMINAR FLOW CONTROL IN SPOUT INLET. WATTS LFUSG-B-M2 THERMOSTATIC MIXING VALVE WITH SLOAN ETF-470-A SINGLE CHECK VALVES ON HOT AND COLD LINES. FLEXIBLE STAINLESS STEEL SUPPLIES WITH 1/4 TURN ANGLE STOPS AND CAST BRASS P-TRAP WITH CLEANOUT PLUG.
SB-1	SUPPLY BOX	3/4		2	1-1/2	SINGLE TEMP HOSE BOX, WASTE OUTLET, VACUM BREAKER	HOSE AND SUPPLY BOX: ACORN 8181 STAINLESS STEEL RECESSED SUPPLY AND WASTE HOSE BOX WITH VACUUM BREAKER 3/4" MALE HOSE THREAD AND WHEEL HANDLE. PROVIDE WITH ABS P-ASSEMBLY.
SS-1	CORNER MOUNTED SERVICE SINK	1/2	1/2	3	1-1/2	CORNER FLOOR MOUNTED	SERVICE SINK (FLOOR MOUNTED): KOHLER K6710, WHITBY, 28 X 28-INCH, ENAMELED CAST IRON FLOOR-MOUNTED CORNER MODEL, K9146-3" DRAIN WITH STRAINER, NO. K8940 REMOVABLE VINYL-COATED RIM GUARD; CHICAGO 897-CP FAUCET WITH VACUUM BREAKER, SCREWDRIVER STOPS IN SHANKS, 5 FOOT RUBBER HOSE AND CHICAGO 853 WALL HOOK. WATTS LFUSG-B-M2 THERMOSTATIC MIXING VALVE. WATTS # 7 DUAL CHECK VALVES ON HOT AND COLD LINES, INSTALLED IN CEILING ABOVE SERVICE SINK WITH ACCESS DOOR IF HARD CEILING.
WC-1	TYPICAL FLOOR MOUNTED WATER CLOSET	1		4	2	FLOOR MOUNTED	WATER CLOSET: KOHLER K-96057 HIGHCLIFF ULTRA VITREOUS CHINA, FLOOR MOUNTED, ELONGATED BOWL, 1-1/2" TOP SPUD, ADA TOILET WITH K-4670-C LUSTRA OPEN-FRONT SEAT. SLOAN ROYAL-111-1.28 GPF FLUSH VALVE; INSTALL ACTUATOR ON WIDE SIDE OF FIXTURE.
WO-1	WATER OUTLET	1/2		2	1-1/2	FLUSH MOUNTED IN WALL, WATER SUPPLY, DRAIN	WATER OUTLET BOX: WATER-TITE 82148 WASHING MACHINE OUTLET BOX WITH DRAIN QUARTER TURN BALL VALVE WITH WATER ARRESTOR FOR USE WITH ICE MACHINE. INSTALL ONLY COLD WATER BALL VALVE. NOTCH COUNTERTOP BACK-SPLASH AND INSTALL OUTLET BOX DRAIN FLUSH WITH COUNTERTOP. MATCH ARCHITECTURAL ELEVATIONS.
WO-2	WATER OUTLET	1/2				FLUSH MOUNTED IN WALL, WATER SUPPLY	FRIDGE CONNECTION: WATER-TITE AB9700HACP WATER OUTLET BOX WITH QUARTER TURN BALL VALVE AND WATER HAMMER ARRESTOR.




5272 S. College Drive, Suite104 Murray, Utah 84123 801.364.9259 www.njraarchitects.com



VAN BOERUM & FRANKASSOCIATES, INC. CONSULTING ENGINEERS WWW.VBFA.COM

Salt Lake City. Logan · St. George · Tempe 330 South 300 East 801.530.3148 T Salt Lake City, UT 84111 801.530.3150 F VBFA Project Number: 19605

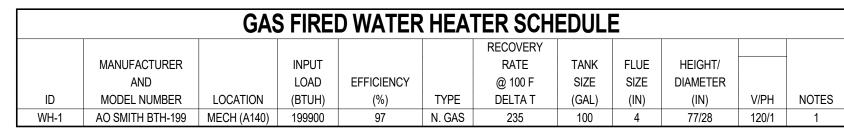

1. PROVIDE WITH CONECENTRIC VENT SET. 2. SET LEAVING DISCHARGE TEMPERATURE FOR WATER HEATER TO 140 DEGREE FAHRENHEIT.

RECIRCULATION PUMP SCHEDULE											
				FLUID				ELECTRICA	NL		
	MANUFACTURER			FLOW		HEAD		MOTOR	MOTOR		
	AND			RATE	WORKING	LOSS		SIZE	SPEED		
ID	MODEL NUMBER	LOCATION	TYPE	(GPM)	FLUID	(FT)	CONSTRUCTION	(HP)	(RPM)	VOLT/PH/HZ	NOTES
RCP-1	B&G PR 3/4	MECH A140	DOMESTIC	0.5	WATER	5	LEAD-FREE BRONZE	1/6	1725	115/1/60	
RCP-2	B&G PR3/4	MECH A140	DOMESTIC	2	WATER	5	LEAD-FREE BRONZE	1/6	1725	115/1/60	

DOMESTIC EXPANSION TANK SCHEDULE											
				FLUID		PHYSICAL					
	MANUFACTURER				MIN. TANK/	TANK	RELIEF	DIA./	NPT		
	AND			WORKING	ACCEPTANCE	SIZE	VALVE	HEIGHT	FITTING		
ID	MODEL NUMBER	LOCATION	TYPE	FLUID	(GAL)	(GAL)	(PSIG)	(IN)	(IN)	NOTES	
DET-1	AMTROL ST-12-C	MECH A140	DOMESTIC	WATER	0.9	2	150	12/18	0.75	1	

1. TANK LINER SUITABLE FOR POTABLE WATER

PIPING MINIMUM INSULATION THICKNESS											
TEMPERATURE	EMPERATURE CONDUCTIVITY, MEAN RATING PIPE SIZE (IN)										
RANGE (OF)	BTU·IN/H·FT2·OF	TEMPERATURE OF	<1	1 to >1-1/2	1-1/2 to <4	4 to <8	8 & Larger	NOTES			
>350	0.32 TO 0.34	250	4.5	5.0	5.0	5.0	5.0	1,2,3,4			
251-350	0.29 TO 0.32	200	3.0	4.0	4.5	4.5	4.5	1,2,3,4			
201-250	0.27 TO 0.30	150	2.5	2.5	2.5	3.0	3.0	1,2,3,4			
141-200	0.25 TO 0.29	125	1.5	1.5	2.0	2.0	2.0	1,2,3,4			
105-140	0.22 TO 0.28	100	1.0	1.0	1.5	1.5	1.5	1,2,3,4			
40-60	0.21 TO 0.27	75	0.5	0.5	1.0	1.0	1.0	1,2,3,4			
>40	0.20 TO 0.26	50	1.0	1.0	1.0	1.0	1.5	1,2,3,4			

- 1. INSULATION THICKNESS FOR RUNOUT PIPING BETWEEN THE CONTROL VALVE AND HVAC EQUIPMENT MAY BE REDUCED TO 1"
- 2. INSULATION THICKNESS FOR PIPING LOCATED OUTDOORS OR EXPOSED TO OUTSIDE AIR SHALL BE INCREASED BY 1".
- 3. WHERE SCHEDULED THICKNESS DIFFERS FROM SPECIFICATIONS THE THICKER DIMENSION SHALL BE USED. 4. REFER TO ASHRAE-90.1-2016 TABLE 6.8.3-1 AND 6.8.3-2 FOR ADDITIONAL INFORMATION.

Dialysis NJRA Project #

19230.00 Construction Documents February 03, 2020 02/17/20 1 Addendum #1 2 Addendum #2 02/18/20

PLUMBING SCHEDULES

PP601

GENERAL SHEET NOTES

UNLESS OTHERWISE INDICATED, REMOVE ALL LIGHTING FIXTURES, OUTLETS, DEVICES AND EQUIPMENT IN HATCHED AREAS. REMOVE ASSOCIATED CONDUIT AND WIRING BACK TO THE PANELBOARD OF ORIGINATION. SYSTEMATICALLY CHECK EACH BRANCH PANELBOARD CIRCUIT TO VERIFY EACH THAT CIRCUIT BREAKER NO LONGER HAS ANY ACTIVE LOADS, DISCONNECT THE WIRING AND TURN THE CIRCUIT BREAKER OFF. ANY REMAINING ACTIVE LOADS SHALL BE LABELED AT THE PANELBOARD AS TO WHAT LOAD IS SERVED.

UNLESS NOTED OTHERWISE REMOVE ALL LIGHTING FIXTURES DEVICES AND EQUIPMENT SHOWN DASHED. REMOVE CONDUIT AND WIRING BACK TO PANELBOARD OF ORIGIN OR TO FIRST ACTIVE DEVICE THAT REMAINS.

SALVAGE ALL POWER POLES, LIGHT FIXTURES, TWIST-LOCK RECEPTACLES AND WALLPLATES, CEILING SPEAKERS AND SECURITY AND FIRE ALARM DEVICES TO OWNER. PROTECT SALVAGED EQUIPMENT FROM DAMAGE.

PRIOR TO SUBMITTING BID, VISIT THE SITE AND FIELD VERIFY THE EXTENT OF ELECTRICAL DEMOLITION WORK TO MEET THE INTENT OF THE BID DOCUMENTS AND INCLUDE ALL COSTS IN BID.

PRIOR TO REMOVAL OF ANY ELECTRICAL EQUIPMENT OR WIRING, FIELD VERIFY THAT THE EQUIPMENT OR WIRING IS INACTIVE OR NO LONGER IN USE.

REMOVE ALL DEVICES, RACEWAYS AND WIRING FROM WALLS TO BE REMOVED. WHERE ACTIVE RACEWAYS OCCUR IN WALLS TO BE REMOVED, REROUTE THE RACEWAY WITH ASSOCIATED WIRING TO KEEP THE CIRCUIT OPERATIONAL.

REMOVE ALL FIRE ALARM DEVICES WHERE EXISTING WALLS AND CEILINGS ARE BEING REMOVED, WITH ASSOCIATED CONDUIT AND WIRING. EXISTING FIRE ALARM DEVICES AND SYSTEM NOT INDICATED FOR REMOVAL SHALL REMAIN ACTIVE THROUGHOUT DEMOLITION AND CONSTRUCTION UNTIL THE NEW SYSTEM IS TESTED AND OPERATIONAL. MAINTAIN ALL CLASS A FIRE ALARM INITIATING AND INDICATING LOOPS WHERE EXISTING DEVICES ARE REMOVED.

REMOVE ALL ABANDONED RACEWAY, CONDUIT, WIRING AND CABLING WHETHER ABANDONED PREVIOUS TO THIS PROJECT OR AS A RESULT OF THIS PROJECT. NOT ALL ABANDONED ITEMS ARE SHOWN ON THESE PLANS AND FIELD VERIFICATION OF DEMOLITION SCOPE EXTENT IS REQUIRED.

DEVICES MARKED "RR" ARE TO BE REMOVED AND RELOCATED PER NEW PLANS. EXTEND CIRCUITING AS REQUIRED FOR RELOCATION.

REMOVE 208/1 VOLT 200 AMP FUSED DISCONNECT WHICH PREVIOUSLY FED X-RAY

REMOVE FEEDER AND RACEWAY RUNNING IN CONSTRUCTION SPACE FOR BRANCH PANEL. CONDUIT WILL HAVE TO BE REINSTALLED BELOW RATED CEILING TO NEW LOCATION. IT IS ACCEPTABLE TO REINSTALL CONDUCTORS IN NEW

REMOVE POWER TO FURNACE.

REMOVE POWER TO CONDENSING UNIT DISCONNECTS WHICH CORRESPOND TO THE FURNACES BEING DEMOLISHED IN THE CONSTRUCTION AREA.

6 EXISTING "SILENT KNITE" FIRE ALARM CONTROL PANEL TO REMAIN.

EXISTING FIBER AND COPPER MDF EQUIPMENT TO REMAIN.

8 EXISTING TV HEAD-END.

ARCHITECTS

NJRA Architects, Inc. 5272 S. College Drive, Suite104 Murray, Utah 84123 801.364.9259 www.njraarchitects.com



○ SHEET KEYNOTES

EQUIPMENT. REMOVE ALL CORRESPONDING X-RAY CONDUIT AND CABLING.

REMOVE STRUCTURAL CABLING AND VOICE/DATA EQUIPMENT.

RACEWAY RUNNING TO NEW ELECTRICAL ROOM.

NJRA Project # Construction Documents

Feb 03, 2020

DEMOLITION POWER PLAN LEVEL 1

EDP101

BUS	FAULT CURRENT
1L1	13,561 SCA
EC1	9,073 SCA
EDP	13,814 SCA
ELS	10,274 SCA
FQ1	8.113 SCA

PROVIDE FULLY RATED CIRCUIT BREAKERS IN PANELBOARDS FOR THE FAULT CURRENT SHOWN. SERIES RATINGS WITH NEXT LEVEL UPSTREAM OVERCURRENT PROTECTIVE DEVICES ARE PERMITTED SUBJECT TO FACTORY UL DOCUMENTATION OF SERIES RATING SUBMITTED TO ENGINEER. IF DEVICE OR EQUIPMENT FAULT CURRENT RATING IS NOT SHOWN, ASSUME 100,000 AIC.

○SHEET KEYNOTES

CONTRACTOR SHALL SUBMIT VARIATIONS FROM ASSUMPTIONS PRIOR TO ORDERING EQUIPMENT. THE SERVICE EQUIPMENT SHALL BE PROVIDED WITH A PERMANENT LABEL INCLUDING: NOMINAL SYSTEM VOLTAGE, AVAILABLE FAULT CURRENT, AND CLEARING TIME ON MAIN OVERCURRENT PROTECTIVE DEVICE BASED ON THE

AVAILABLE FAULT CURRENT. IT IS ACCEPTABLE TO RE-PULL EXISTING CONDUCTORS IN NEW RACEWAY RUNNING TO TRANSFER SWITCH AND NORMAL PANEL LOCATIONS.

GENERAL SHEET NOTES


- PROVIDE NEMA 3R ENCLOSURES FOR EQUIPMENT LOCATED OUTDOORS. REFER TO PLANS FOR EQUIPMENT LOCATIONS.
- REFER TO PLANS FOR CONSTRAINTS ON PHYSICAL DIMENSIONS AND CLEARANCE REQUIREMENTS OF EQUIPMENT. PROVIDE EQUIPMENT DIMENSIONS THAT FALL WITHIN THE CONSTRAINTS OF EACH SPECIFIC
- ALL EQUIPMENT SHALL BE CONSTRUCTED AND BRACED FOR THE SEISMIC CONDITIONS OF THE PROJECT. REFER TO ELECTRICAL SPECIFICATIONS FOR REQUIREMENTS.

PROVIDE PERFORMANCE TESTING FOR GROUND-FAULT PROTECTION SYSTEMS ON SITE WITH A WRITTEN RECORD OF THIS TEST SUBMITTED TO THE AUTHORITY HAVING JURISDICTION PER 2011 NEC 230.95(C).



NJRA Architects, Inc. 5272 S. College Drive, Suite104 Murray, Utah 84123 801.364.9259 www.njraarchitects.com



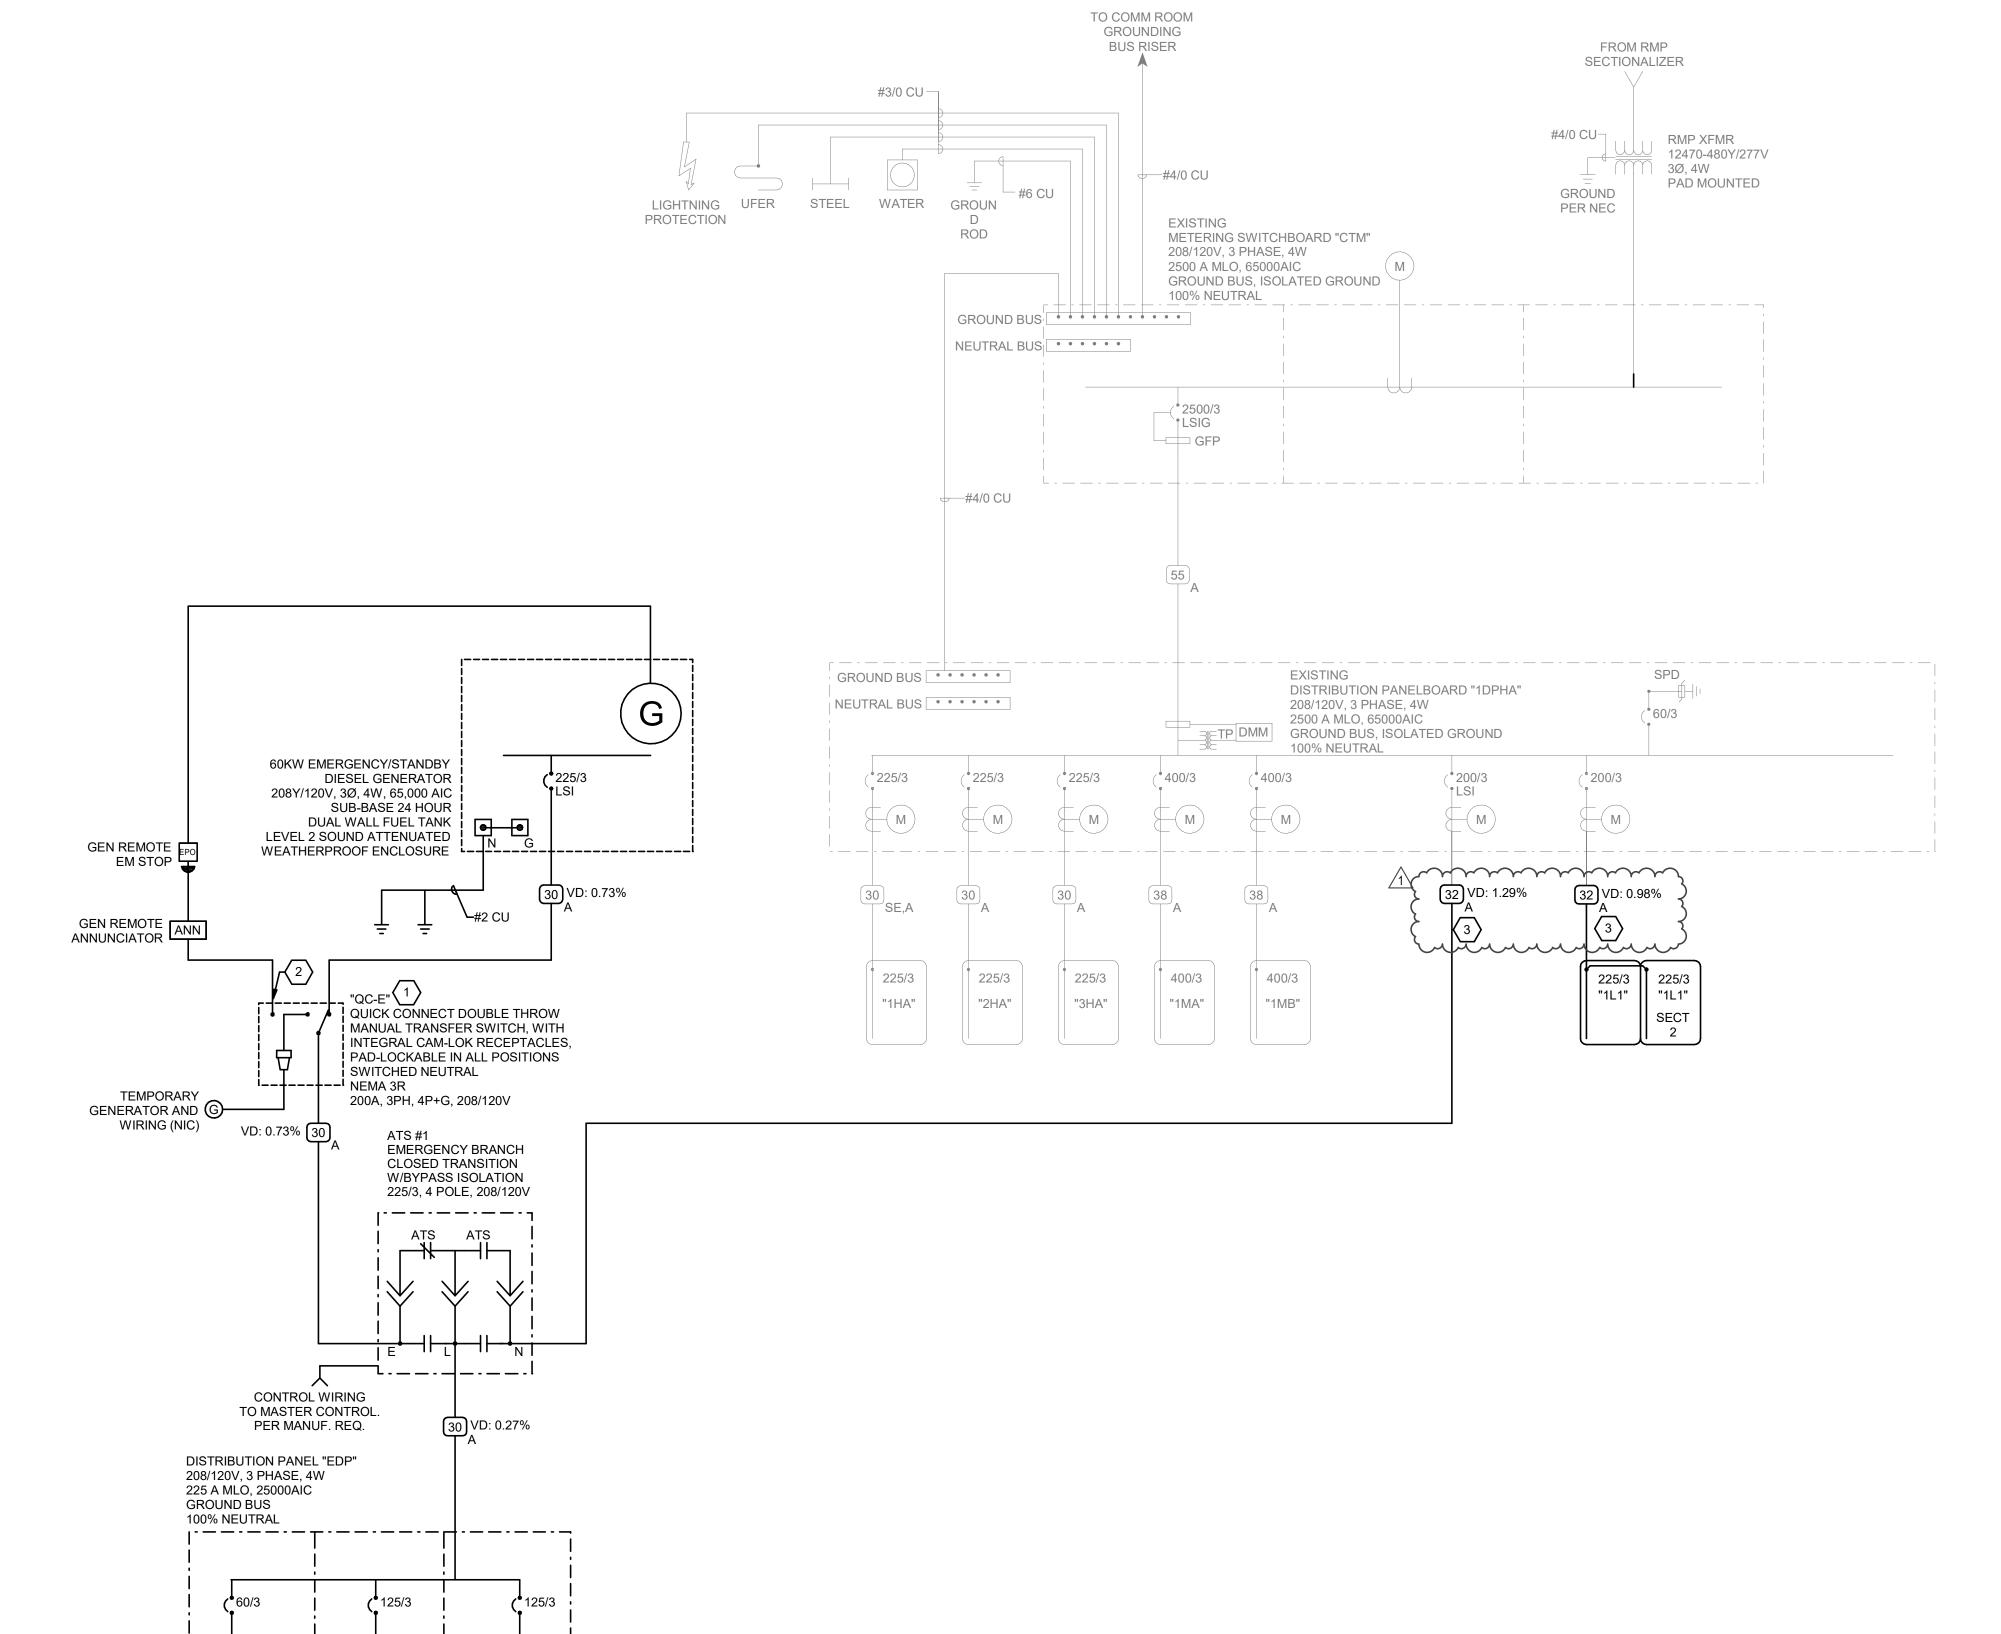

ALUMINUM CONDUCTOR AND CONDUIT SCHEDULE SCHEDULE NUMBER (E.G.) 5 *--SUBSCRIPT (NOTE 5) SYM AMP SIZE QTY SIZE G SE NOTES 130 | 2 | 3 | 2/0 | 4 | 1/0 | 4 | 130 | 2 | 4 | 2/0 | 4 | 1/0 | 4 | 2 A 150 2 4 3/0 4 1/0 4 2,7 A 175 2 3 4/0 4 1/0 2 2,7 J_A 175 2.50 4 4/0 4 1/0 2 2,7 J_A 200 2.50 3 250 4 1/0 2 2,7 9_A 230 2.50 3 300 2 1/0 1/0 2 29A 230 230 3 300 2 170 170 2,7 30A 230 3 4 300 2 1/0 1/0 2,7 31A 250 3 3 350 2 2/0 1/0 2,7 32A 250 3 4 350 2 2/0 1/0 2,7 JA 310 3 3 300 1 370 170 2,7 JA 310 4 4 500 1 3/0 1/0 2,7 JA 380 2 EA 2.50 3 250 1 4/0 3/0 2,7 JA 380 2 EA 3 4 250 1 4/0 3/0 2,7 JA 400 2 EA 2.50 3 250 1/0 4/0 3/0 2,7 JB 400 2 EA 2.50 4 250 1/0 4/0 3/0 2,7 JB 200 2 EA 2.50 3 250 1/0 4/0 3/0 2,7 500 2 EA 3 3 350 1/0 300 3/0 2,4,7 40A 500 2 EA 3 4 350 1/0 300 3/0 2,4,7 41A 620 2 EA 3 3 500 3/0 300 3/0 2,4,7 42A 620 2 EA 4 4 500 3/0 300 3/0 2,4,7 43A 750 3 EA 3 3 350 3/0 300 4/0 2,4,7 44A 750 3 EA 3 4 350 3/0 300 4/0 2,4,7 3_A 810 3 EA 3 3 400 4/0 300 250 2,4,7 BA 810 3 EA 4 4 400 4/0 300 250 2,4,7 47_A 1000 4 EA 3 3 350 4/0 300 250 4,7 48_A 1000 4 EA 3 4 350 4/0 300 250 4,7 O_A 1240 4 EA 4 4 500 350 300 250 4,7 3_{A} 1620 | 6 EA 4 | 4 | 400 | 400 | 350 | 250 | 4,7 D_A 2170 7 EA 4 4 500 400 500 250 4,7 A 2170 7 EA 4 4 750 600 750 750 4,7 A 3080 8 EA 4 4 750 600 750 750 4,7 A 4235 11 EA 4 4 750 800 750 750 4,7

CONDUIT AND CONDUCTOR SCHEDULE NOTES 1 CONDUCTORS SHOWN ARE SHOWN FOR EACH CONDUIT WITH MODIFICATIONS AS NOTED IN NOTE 5. ALL CONDUCTORS SHOWN ARE THWN UNLESS OTHERWISE NOTED.

- 2 PROVIDE EQUIPMENT GROUND CONDUCTORS PER TABLE 250-122 WHEN CIRCUIT BREAKERS ARE SIZED GREATER THAN AMPERE RATING SHOWN IN
- 3 PROVIDE #10 NEUTRALS FOR MULTIWIRE BRANCH CIRCUITS SERVING 4 GROUND (G) CONDUCTOR MAY BE DELETED ON SERVICE ENTRANCE CONDUCTORS. 5 SYMBOL SUBSCRIPTS:

CONDUCTORS.

 - "HH": NEUTRAL CURRENTS EXIST DUE TO HIGH HARMONIC "NONLINEAR" LOADS. CURRENT CARRYING CONDUCTORS DERATED ACCORDINGLY.
 - "IG": INCLUDE IG (INSULATED/ISOLATED GROUND CONDUCTOR) SCHEDULED ALONG WITH THE GROUND OF EQUIPMENT GROUND CONDUCTOR.
 - "SE": SUBSTITUTE "SE" CONDUCTOR FOR "G" CONDUCTOR SHOWN, WHICH IS SIZED FOR THE GROUNDING OF THE SECONDARY OF THE SEPARATELY DERIVED SYSTEM.

CONDUIT SCHEDULE											
SCHEDULE NUMBER											
SUBSCRIPT (NOTE 5) (E.G.) 5											
		НН	CONDUIT	COND	JCTOR (1	NOTE 1)					
SYM	AMP	AMPS	SIZE	QTY	SIZE	G	IG/HH	SE	NOTES		
1	20	-	.75	2	12	12	12	8	2		
2	20	-	.75	3	12	12	12	8	2,3		
3	20	24	.75	4	12	12	12	8	2,3		
4	30	-	.75	2	10	10	10	8	2		
(5)	30	-	.75	3	10	10	10	8	2		
6	30	32	.75	4	10	10	10	8	2		
7	40	-	1	2	8	10	8	6	2		
8	40	-	1	3	8	10	8	6	2		
9	40	44	1	4	8	10	8	6	2		
10	55	-	1	2	6	10	8	4	2		
11	55	_	1	3	6	10	8	4	2		

COPPER CONDUCTOR AND

0)/14		HH	CONDUIT		JCTOR (N		10/11/1	05	NOTEO
SYM	AMP	AMPS	SIZE	QTY	SIZE	G	IG/HH	SE	NOTES
1	20	-	.75	2	12	12	12	8	2
2	20	-	.75	3	12	12	12	8	2,3
3	20	24	.75	4	12	12	12	8	2,3
4	30	-	.75	2	10	10	10	8	2
5	30	-	.75	3	10	10	10	8	2
6	30	32	.75	4	10	10	10	8	2
7	40	-	1	2	8	10	8	6	2
8	40	-	1	3	8	10	8	6	2
9	40	44	1	4	8	10	8	6	2
10	55	-	1	2	6	10	8	4	2
11	55	-	1	3	6	10	8	4	2
12	55	60	1.25	4	6	10	8	4	2
13	70	-	1	2	4	8	4	2	2
(14)	70	-	1.25	3	4	8	4	2	2
(15)	70	76	1.25	4	4	8	4	2	2
(16)	85	-	1.25	2	3	8	3	2	2
(17)	85	-	1.25	3	3	8	3	2	2
18	85	92	1.25	4	3	8	3	2	2
19	95	-	1.25	3	2	8	2	2	2
20	95	104	1.50	4	2	8	2	2	2
(21)	130	- 104	1.50	3	1	6	2	2	2
22	130	116	1.50	4	1	6	2	2	2
23	150	110	2		1/0	6	2	1/0	2
		126		3					
24	150	136	2	4	1/0	6	2	1/0	2
25	175	-	2	3	2/0	6	2	2/0	2
26	175	156	2	4	2/0	6	2	2/0	2
27	200	-	2	3	3/0	6	2	2/0	2
28	200	180	2.50	4	3/0	6	2	2/0	2
29	230	-	2.50	3	4/0	4	2	2/0	2
30	230	208	2.50	4	4/0	4	2	2/0	2
31	255	-	2.50	3	250	4	1	2/0	2
32	255	232	2.50	4	250	4	1	2/0	2
33	310	-	3	3	350	3	1/0	3/0	2
34	310	280	3	4	350	3	1/0	3/0	2
35	380	-	3.50	3	500	3	3/0	3/0	2
36	380	344	4	4	500	3	3/0	3/0	2
37)	400	-	2 EA 2	3	3/0	3	3/0	3/0	2
(38)	400	360	2 EA 2.50	4	3/0	3	3/0	3/0	2
39	510	-	2 EA 2.50	3	250	1	4/0	3/0	2
40	510	464	2 EA 3	4	250	1	4/0	3/0	2
41)	620	-	2 EA 3	3	350	1/0	4/0	3/0	2,4
42	620	560	2 EA 3	4	350	1/0	4/0	3/0	2,4
43	760	-	2 EA 3.50	3	500	1/0	4/0	3/0	2,4
(44)	760	688	2 EA 4	4	500	1/0	4/0	3/0	2,4
45	855		3 EA 3	3	300	2/0	4/0	3/0	2,4
46	855	768	3 EA 3	4	300	2/0	4/0	3/0	2,4
47)	1000	-	3 EA 3.50	3	400	2/0	4/0	3/0	4
48	1000	912	3 EA 3.50	4	400	2/0	4/0	3/0	4
49				3		3/0		3/0	4
	1140	-	3 EA 4		500		4/0		
<u>50</u>	1140	1032	3 EA 4	4	500	3/0	4/0	3/0	4
<u>51</u>	1240	-	4 EA 3	3	350	3/0	4/0	3/0	4
52	1240	1120	4 EA 3	4	350	3/0	4/0	3/0	4
<u>53</u>	1675	1520	5 EA 4	4	400	4/0	4/0	4/0	4
54	2010	1824	6 EA 4	4	400	250	250	250	4
55	2660	2408	7 EA 4	4	500	350	350	350	4
56	3040	2752	8 EA 4	4	500	500	500	500	4
57	4180	3784	11 EA 4	4	500	500	500	500	4
58	-	-	5 EA 4	-	-	-	-	-	6
59	-	_	5	-		-	-	-	6
60	-	-	10 EA 4	_	-	-	-	-	6
			CONDUIT	AND C	ONDUCT	OR SCH	EDULE N	OTES	

CONDUCTORS SHOWN ARE SHOWN FOR EACH CONDUIT WITH MODIFICATIONS AS NOTED IN NOTE 5. ALL CONDUCTORS SHOWN ARE THWN UNLESS OTHERWISE NOTED.

PROVIDE EQUIPMENT GROUND CONDUCTORS PER TABLE 250-122 WHEN CIRCUIT BREAKERS ARE SIZED GREATER THAN AMPERE RATING SHOWN IN PROVIDE #10 NEUTRALS FOR MULTIWIRE BRANCH CIRCUITS SERVING COMPUTERS.

GROUND (G) CONDUCTOR MAY BE DELETED ON SERVICE ENTRANCE

CONDUCTORS. SYMBOL SUBSCRIPTS: "2N": INCLUDE TWO NEUTRAL CONDUCTORS SIZED AS SCHEDULED FOR PHASE AND NEUTRAL CONDUCTORS WHERE THE CONDUCTOR IS #1/0 OR LARGER. INCLUDE A SINGLE 200% RATED CONDUCTOR THAT IS TWICE THE AMPACITY OF THE SCHEDULED PHASE AND NEUTRAL

CONDUCTOR WHERE THE CONDCUTOR IS BELOW #1/0

- "FG" FULL SIZE GROUND, SIZE EQUIPMENT GROUNDING CONDUCTOR TO BE SAME SIZE AS THE PHASE CONDUCTORS.
- "HH": NEUTRAL CURRENTS EXIST DUE TO HIGH HARMONIC "NONLINEAR" LOADS. CURRENT CARRYING CONDUCTORS DERATED ACCORDINGLY. PROVIDE THE IG/HH SIZE FOR THE EQUIPMENT GROUNDING CONDUCTOR.
- "IG": INCLUDE IG (INSULATED/ISOLATED GROUND CONDUCTOR) SCHEDULED ALONG WITH THE GROUND OF EQUIPMENT GROUND CONDUCTOR.
- "SE": SUBSTITUTE "SE" CONDUCTOR FOR "G" CONDUCTOR SHOWN, WHICH IS SIZED FOR THE GROUNDING OF THE SECONDARY OF THE SEPARATELY DERIVED SYSTEM.

RACEWAY ONLY. CONDUCTORS PROVIDED BY UTILITY.

19230.00 NJRA Project # Construction Documents Feb 03, 2020 02/18/20

> ONE-LINE DIAGRAM

15 VD: 0.01%

22 VD: 0.56%

125/3

"EC1"

22 VD: 0.52%

125/3

"EQ1"

