

SALT LAKE CITY INTERNATIONAL AIRPORT NATIONAL WEATHER SERVICE TI

2242 WEST NORTH TEMPLE STREET
SALT LAKE CITY, UT 84116

SLCDA PROJECT NO. 54 8201 1849

MAYOR OF SALT LAKE CITY
ERIN MENDENHALL
EXECUTIVE DIRECTOR OF AIRPORTS
BILL WYATT

DESIGN & CONSTRUCTION
MANAGEMENT DIVISION
SALT LAKE CITY
DEPARTMENT OF AIRPORTS
P.O. BOX 145550
SALT LAKE CITY, UT 84114-5550
TELEPHONE: 801-575-2924



ROBERT S. BAILEY, P.E.
ASSISTANT DIRECTOR, DESIGN & PROJECT MANAGEMENT

DATE _____

STATUS


PROJECT NO.:
54 8201 1849
SHEET NO. _____
OF _____ SHEETS

ABBREVIATIONS


GENERAL SYMBOLS

SEE PLUMBING, MECHANICAL AND ELECTRICAL FOR DISCIPLINE SYMBOLS

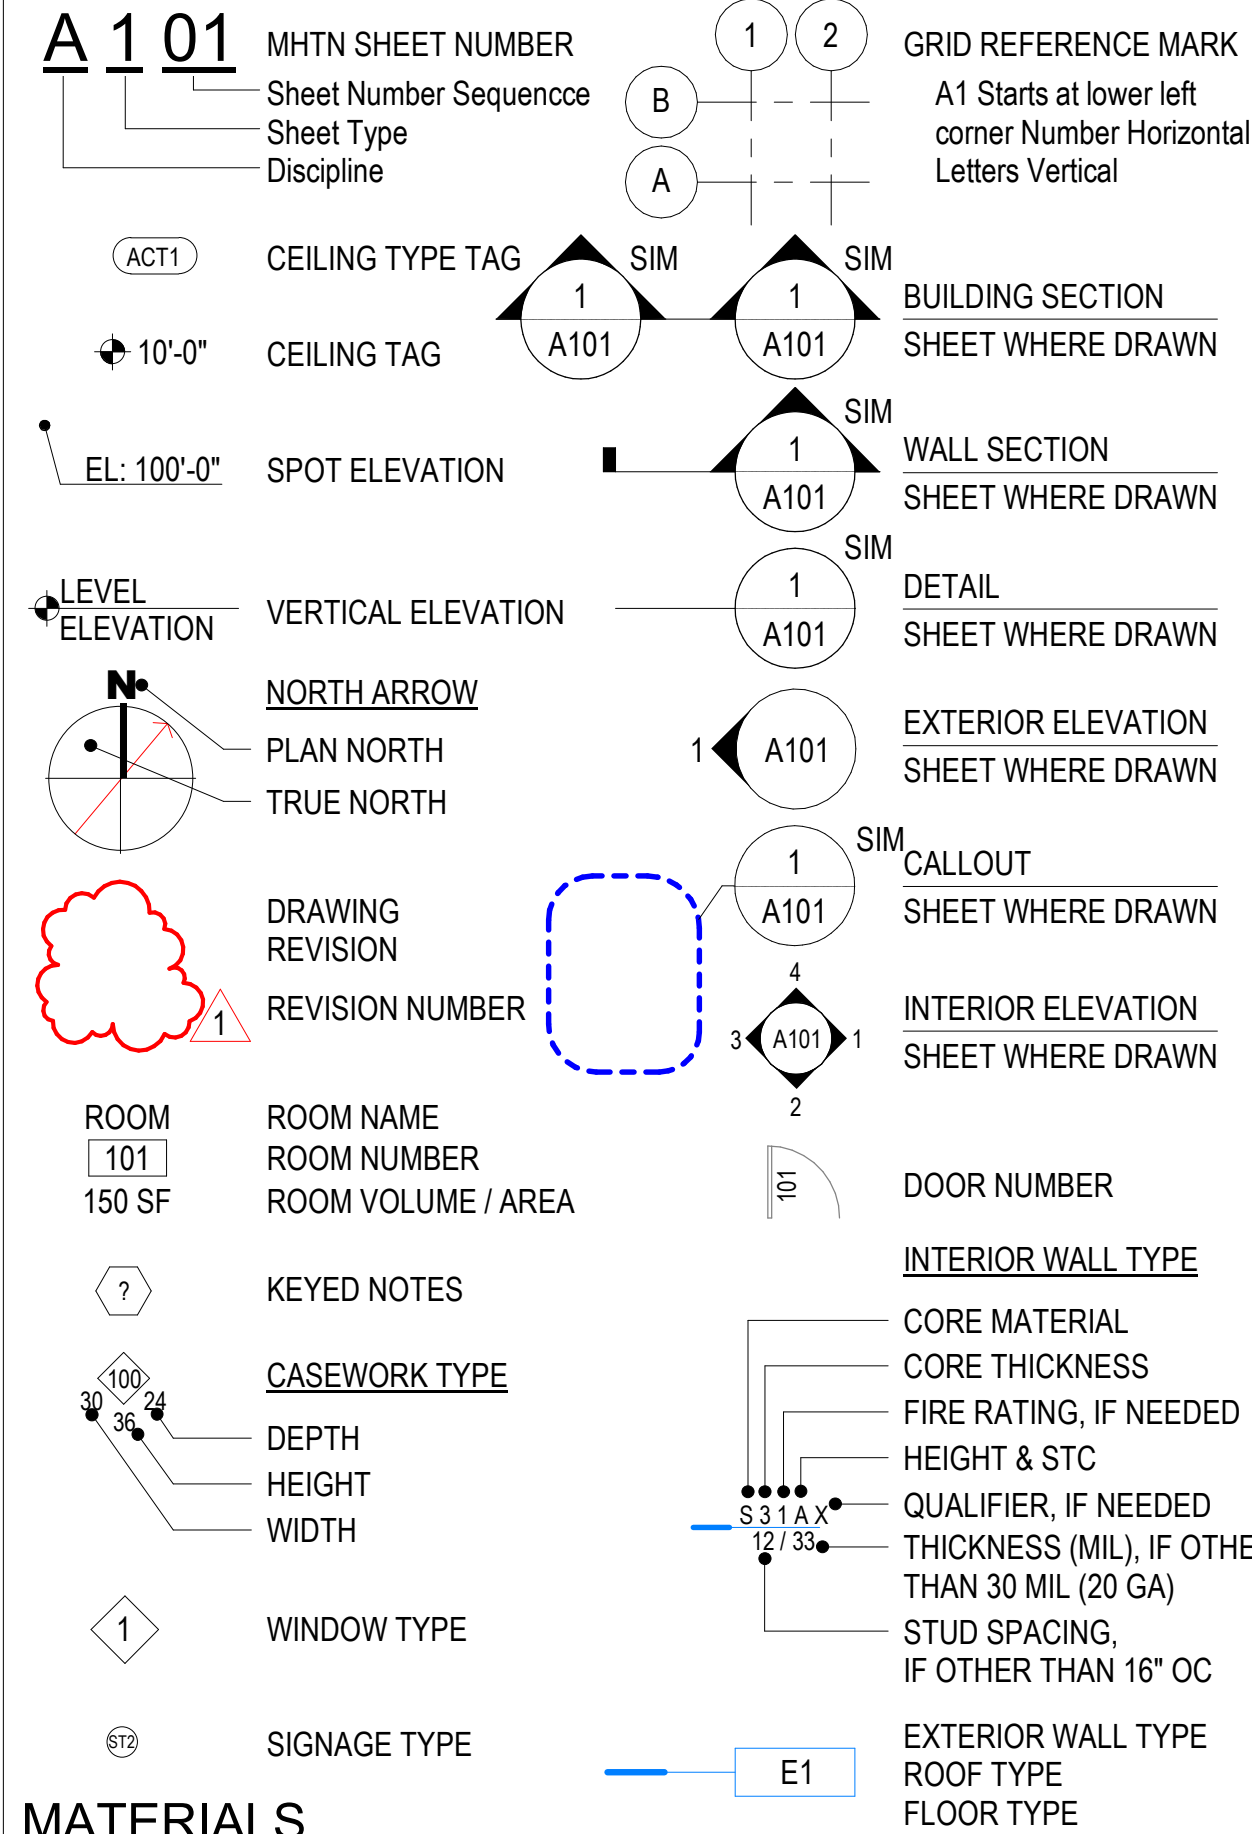

MATERIALS

Table of material patterns and names: CONCRETE, EIFS, STEEL, MASONRY BRICK, GYPSUM BOARD, WOOD FRAMING, BLOCKING, EARTH, GRAVEL, PRECAST, STONE, CONCRETE MASONRY UNIT, HARDWOOD, BATT INSULATION, RIGID/SEMI-SAFING INSULATION.

SLCDA NATIONAL WEATHER SERVICE TI SALT LAKE INTERNATIONAL AIRPORT SALT LAKE CITY, UTAH CONSTRUCTION DOCUMENTS - BID SET MAY 02, 2024


GENERAL NOTES

- 1. PRIOR TO SUBMITTING A BID OR PROCEEDING WITH ANY PORTION OF THE WORK, THE CONTRACTOR SHALL VERIFY ALL DIMENSIONS & EXISTING CONDITIONS AT THE SITE AND VERIFY THAT DIMENSIONS AND FINISHES COMPLY WITH THE CONTRACT DOCUMENTS... 2. CUT AND PATCH EXISTING BUILDING CONSTRUCTION AS REQUIRED... 3. WHENEVER QUESTIONS ARISE OR CONDITIONS ARE ENCOUNTERED WHICH ARE NOT COVERED BY OR ARE IN CONFLICT WITH THE CONTRACT DOCUMENTS, CONSULT WITH THE ARCHITECT PRIOR TO TAKING ANY FURTHER ACTION...

ADD ALTERNATE:

- 01. BASE BID: ROOM 110 BE A STORAGE ROOM W/ NEW PAINT, BASE, AND OTS CEILING. ADD ALTERNATE: ROOM 110 TO BE A SHOWER ROOM W/ WATER CLOSET, LAVATORY, SHOWER, PLUMBING ACCESSORIES, AND NEW FINISHES. RE: SHEET A400

VICINITY MAP

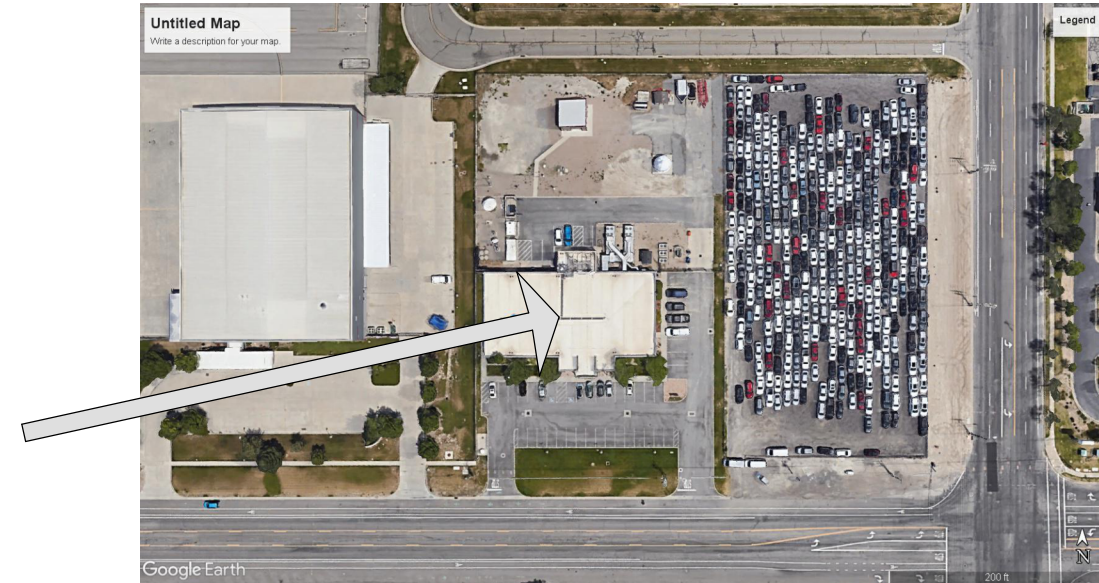

APPROVALS

Approval table with columns for APPROVERS NAME, TITLE, and DATE.

PROJECT DATA

APPLICABLE CODES

International Building Code, including Appendix J (IBC), 2021 ed. International Mechanical Code (IMC), 2021 ed. International Plumbing Code (IPC), 2021 ed. National Electrical Code (NEC), 2020 ed. International Energy Conservation Code (IECC), 2021 ed., Prescriptive/Work Area/Performance International Existing Building Code (IEBC), 2021 ed., International Fire Code (IFC), 2021 ed. International Fuel Gas Code (IFGC), 2021 ed. ICC/ANSI A117.1, 2017 ed.

CRITERIA

Occupancy Classification B - No Change in occupancy

Separation of Occupancies Non-separated

Construction Type V-B

Sprinkled No

Building Area/Height Allowable Height (Stories/Feet) 2 / 40 Allowable Height (Stories/Feet) 2 / 40 ft Actual Building Height (Stories/Feet) 1 / 20 ft

Building Area

1st Floor (Area of Work) 6,466 s.f. 1st Floor (Total) 13,044 s.f.

Allowable Building Area Calculation

Not Applicable (Existing building with no increase in square footage and no change in Occupancy) Building Perimeter (P) x Width of Public Way or Open Space (W) Weighted Average W = (L1xw1 + L2xw2 + L3xw3...) / F = Frontage Increase If = (F/P - 0.25)W/30 = (.75 is the maximum value)

Single Occupancy, One Story At = 9,000 s.f. NS = 9,000 s.f. Allowable Area Aa = 15,039 s.f. = At + (NS x If) = (.61) - 9,000 + (9,000 x .67) If = (F/P - 0.25)W/30 = (448/523 - 0.25) 33/30 = (.61) x 1.1 = .67 W = (76'x12' + 42'x80' + 34'x160' + 120'x189' + 76'x65' + 42'x100' + 50'x90' + 100'x110') / 448' = 100

Scope of Work Description

- Civil 1. A new driveway from the existing roadway for light duty delivery trucks. Structural 1. N/A Architectural 1. New finishes throughout the 6,466 SF. 2. Demolition and installation of new millwork in Break Room 109. 3. Demolition of existing an existing door and installation of new door in WCM Office 104. 4. Converting existing closet to storage. 5. Converting the existing storage into 3 spaces (Quite Room 127, Corridor 126, Training/Office 128, and Storage 129). 6. Demolition and installation of new toilet partitions. 7. New Shower Room 110. Mechanical/Plumbing 1. Demolition and installation of new plumbing fixtures Mens Restroom 122 and Womens restroom 118. 2. Demolition and installation of new sink and faucet in Break Room 109. 3. Demolition of wall mounted humidifiers. 4. Demolition and installation of new drinking fountain. 5. Installation of accessible shower. Electrical 1. Added power and data in specified locations. 2. Relocated light switches in specified locations.

INDEX TO DRAWINGS - CONSTRUCTION DOCUMENTS - BID SET

Index table listing drawing numbers and titles: G000 COVER SHEET, G001 INDEX SHEET, G101 FIRST FLOOR LIFE SAFETY PLAN, G200 MOUNTING HEIGHTS & CLEARANCES, CIVIL C000 CIVIL DEMOLITION PLAN, C100 SITE PLAN, C200 GRADING & DRAINAGE PLAN, C500 DETAILS, ARCHITECTURAL AD100 PHASING PLAN, AD101 DEMOLITION PLAN, AD701 DEMOLITION RCP, ARCHITECTURAL A101 FIRST FLOOR PLAN, A101A FIRST FLOOR PLAN - AREA A, A101B FIRST FLOOR PLAN - AREA B, A400 PARTIAL PLANS - ADD ALTERNATE 01, A410 INTERIOR ELEVATIONS, A411 INTERIOR ELEVATIONS, A412 INTERIOR ELEVATIONS, A413 INTERIOR ELEVATIONS, A414 INTERIOR ELEVATIONS, A415 INTERIOR ELEVATIONS, A416 INTERIOR ELEVATIONS, A417 INTERIOR ELEVATIONS, A418 INTERIOR ELEVATIONS, A419 INTERIOR ELEVATIONS, A430 DETAILS, A600 DOOR, FRAME AND WALL TYPE SCHEDULE, A610 DOOR DETAILS, A640 FINISH SCHEDULE, A651 FIRST FLOOR PATTERN PLAN, A701 REFLECTED CEILING PLAN, A702 REFLECTED CEILING PLAN Copy 1, MECHANICAL / PLUMBING MD101 MECHANICAL DEMOLITION FLOOR PLAN, M101 MECHANICAL FLOOR PLAN, M401 ENLARGED MECHANICAL PLANS, M501 MECHANICAL SCHEDULES, M601 MECHANICAL DETAILS, PD101 PLUMBING DEMOLITION FLOOR PLAN, P101 PLUMBING FLOOR PLAN, P401 ENLARGED PLUMBING PLAN, P501 PLUMBING SCHEDULES & DETAILS, ELECTRICAL EG001 GENERAL NOTES AND SYMBOLS LIST, ED101 DEMOLITION PLAN, EL101 FLOOR PLAN - LIGHTING, EL501 DETAILS, EL601 SCHEDULES, DETAILS, AND WIRING DIAGRAMS, EP101 FLOOR PLAN - POWER AND SYSTEMS, EP501 DETAILS, EP601 ONE-LINE AND RISER DIAGRAMS, EP701 SCHEDULES

MHTN ARCHITECTS, Inc. 280 South 400 West Suite 250 Salt Lake City, Utah 84101 Telephone (801) 595-6700 www.mhtn.com

SLCDA NATIONAL WEATHER SERVICE TI SALT LAKE INTERNATIONAL AIRPORT SALT LAKE CITY, UTAH

CONFIDENTIALITY NOTICE: This document is intended for use on the Project identified herein by individuals and companies involved in the design, permitting, bidding and construction of the Project. MHTN Architects, Inc. grants limited rights to distribute and reproduce this document for the express purpose only. Distribution, printing or copying this document for purposes other than those indicated is strictly prohibited. If a digital copy of this document is received in error, please delete it.



MHTN PROJECT NO 2023573 VIEW AND PRINT THIS DRAWING IN COLOR Original drawing is 24 x 36. Do not scale contents of this drawing.

ISSUED table with columns for NO., DATE, and DESCRIPTION: 01 Oct 27, 2023 SCHEMATIC DESIGN, 02 Nov 16, 2023 60% CONSTRUCTION DOCS, 03 Dec 15, 2023 80% CONSTRUCTION DOCS, 04 Jan 31, 2024 100% CONSTRUCTION DOCS

REVISIONS table with columns for NO., DATE, and DESCRIPTION: 4 Apr 16, 2024 City Review Comments, 5 May 21, 2024 Appendix 01


CONSTRUCTION DOCUMENTS - BID SET MAY 02, 2024

INDEX SHEET

G001

Autodesk Docs/2023573 SLCIA Airport NWSF T12023573 SLCIA Airport NWSF T1.rvt 5/21/2024 9:00:02 AM

- PHASE 1 - ENABLING - RESTROOM TRAILER, ULYSSES OFFICE??
- START OF PHASE 2 - IT TECH FURNITURE MOVE, CONCRETE CUTTING, VAV WORK, RESTRMS AND D.F. BECOME UNUSABLE AND LONG DURATION PORTIONS OF WORK BEGIN. ENDS WITH PHASE 6
- PHASE 3 - MISC VAV WORK WITH REQUIRMENTS TO MOVE FURNITURE
- START OF PHASE 4 - BREAKROOM REMODEL STARTED AFTER DRINKING FOUNTAIN INSTALLED. EAST OPS WALL DISPLAYS REWIRED AND REATTACHED. ENDS WITH PHASE 6
- START OF PHASE 5 - IT TECH FURNITURE MOVE TO TEMP STORAGE, DARREN'S OFFICE FINISH REMODEL AT SAME TIME AS FRONT ENTRY CABINET DEMO AND WALL INFILL AND MEDIA ROOM DOOR REMOVAL DUE TO ADJACENT DEMO NOISE. AFTER NORTH SIDE COMPLETED TO RETAIN AREA OF BLUE WAL. ENDS WITH PHASE 6
- PHASE 6 - FINAL FINISHING OF ALL PHASES - INCL FINAL WALL PAINTING, CARPET, AND BASE.
- VAV REPLACEMENT - CONSTRUCTED INDIVIDUALLY

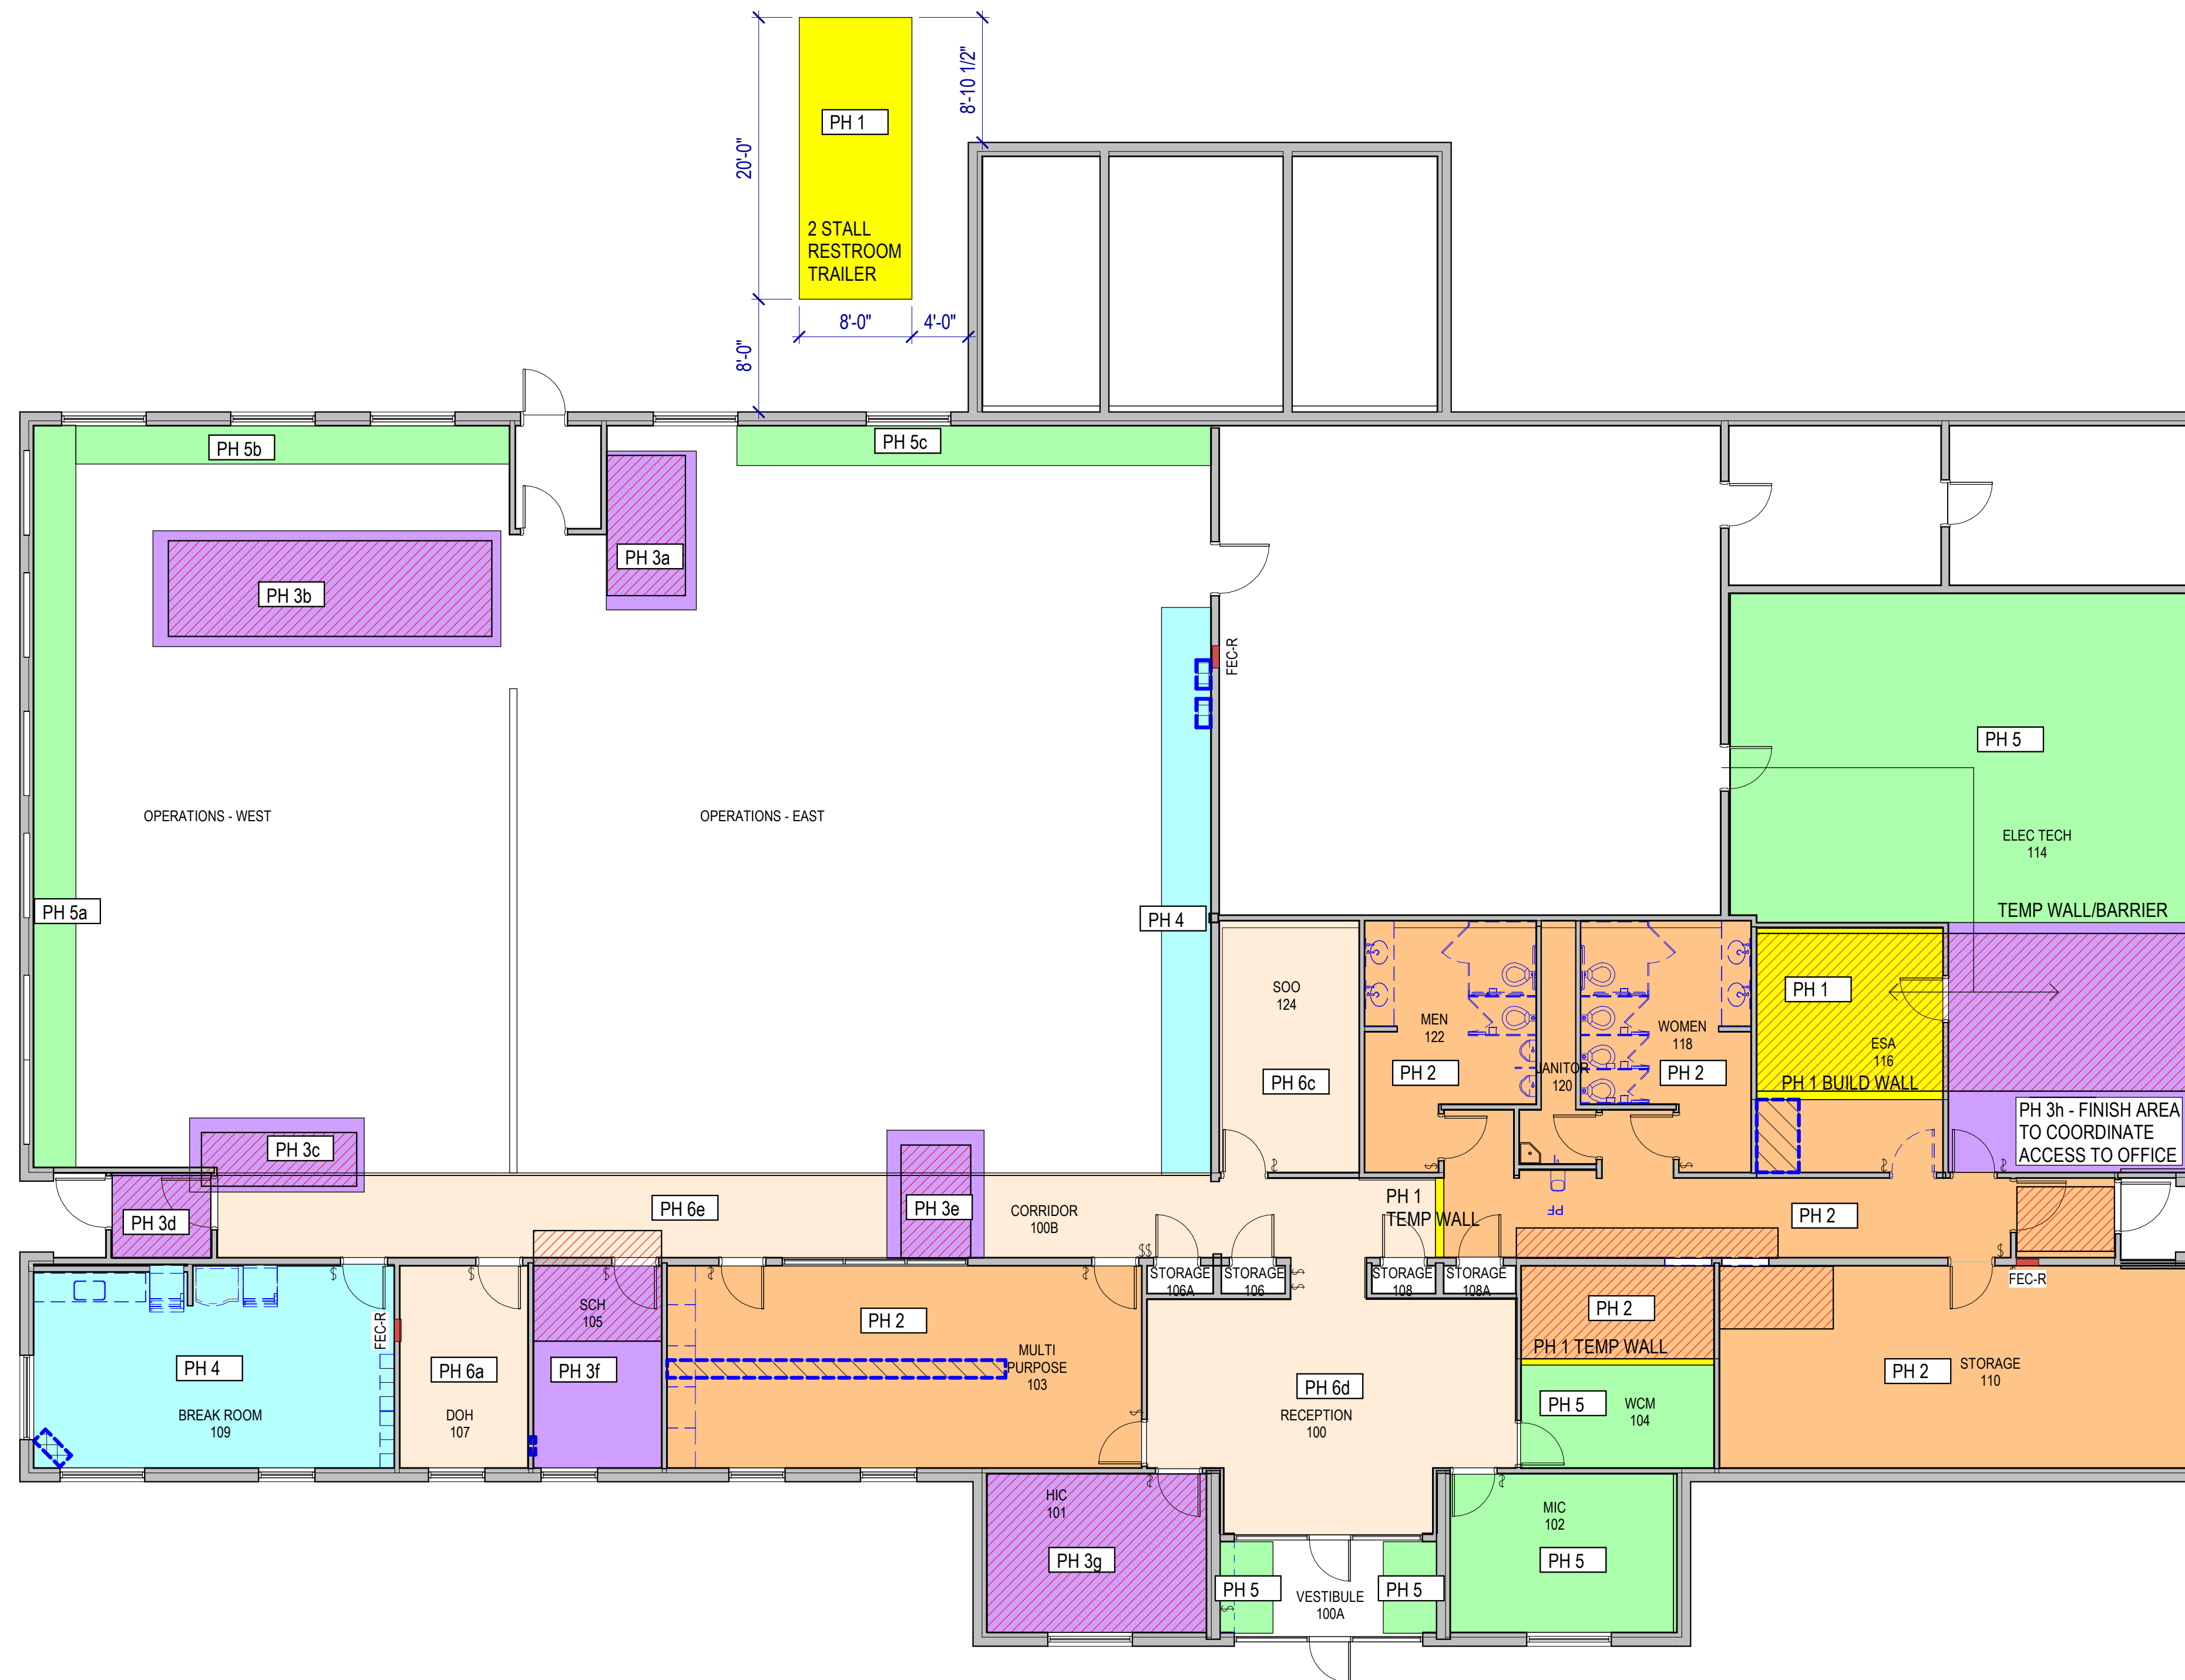

SLCDA
NATIONAL WEATHER
SERVICE TI
 SALT LAKE INTERNATIONAL AIRPORT
 SALT LAKE CITY, UTAH

8/2023 MHTN ARCHITECTS, INC.
 Confidentiality Notice:
 This document is intended for use on the Project identified herein by individuals and companies involved in the design, permitting, bidding and construction of the Project. MHTN Architects, Inc. grants limited rights to distribute and reproduce this document for this express purpose only. Distribution, printing or copying this document for purposes other than those indicated is strictly prohibited. If a digital copy of this document is received in error, please delete it.



MHTN PROJECT NO 2023573
VIEW AND PRINT THIS DRAWING IN COLOR
Original drawing is 24 x 36. Do not scale contents of this drawing.

NO.	DATE	DESCRIPTION
01	Oct 27, 2023	SCHEMATIC DESIGN
02	Nov 14, 2023	60% CONSTRUCTION DOCS
03	Dec 15, 2023	80% CONSTRUCTION DOCS
04	Jan 31, 2024	100% CONSTRUCTION DOCS


NO.	DATE	DESCRIPTION
1	May 21, 2024	Appendum 01

CONSTRUCTION DOCUMENTS - BID SET
 MAY 02, 2024


PHASING PLAN

CONSTRUCTION PHASING

1. Contractor to coordinate with tenant and provide schedule with dates for localized power outage, concrete cutting, demolition, welding, millwork install, painting, carpet, and associated possession and completion of areas.
2. Contractor to delay taking possession on an area until construction materials needed for that area are on-site or available for install
3. Contractor to delay demolition and construction of breakroom until at least one restroom and drinking fountain are complete to maintain accessibility to culinary water.
4. Contractor to coordinate furniture relocation with tenant to ensure that there is continuous access to a sufficient number of desks as determined by tenant.

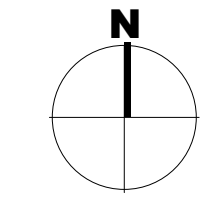

1 FIRST FLOOR PLAN - PROPOSED CONSTRUCTION PHASING
 SCALE: 1/8" = 1'-0"

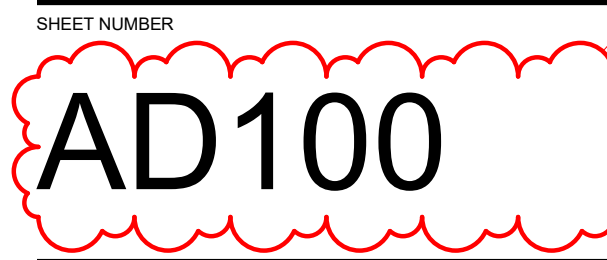

Autodesk Docs://2023573 SLCIA Airport NWSF T1/2023573 SLCIA Airport NWSF T1.rvt
 5/21/2024 9:01:12 AM

CONSTRUCTION PHASING

1. Contractor to coordinate with the tenant regarding phasing of spaces to be demolished.
2. Contractor to delay taking possession
3. Contractor to delay demolition and construction of breakroom until at least one restroom and drinking fountain are complete to maintain accessibility to culinary water.
4. Contractor to coordinate furniture relocation with tenant to ensure that there is continuous access to a sufficient number of desks as determined by tenant.
- 5.

LEGEND - DEMOLITION

- AREA OF NO WORK
- EXISTING TO REMAIN
- REMOVE DOOR & FRAME WALLS & OTHER ITEMS TO BE DEMOLISHED
- EXISTING CUBICLES TO BE DEMOUNTED, PROTECTED, AND PRESERVE FOR RE-INSTALLATION
- EXISTING CARPET FLOORING AND BASE TO BE DEMOLISHED
- EXISTING VINYL FLOORING AND BASE TO BE DEMOLISHED
- EXISTING TILE FLOORING AND BASE TO BE DEMOLISHED

NOTE: WHERE WALLS AND OTHER ITEMS ARE SHOWN WITH DASHED LINES, WHETHER KEYNOTED OR NOT, REMOVE THESE ITEMS TO THE EXTENT INDICATED AND AS REQUIRED BY NEW CONSTRUCTION.

DEMOLITION GENERAL NOTES

Existing Conditions: Verify that existing equipment that is to remain, to be salvaged or to be re-installed, is in working condition. Provide written documentation to the Owner for any items that not in working condition before beginning work in the area.

Protection: Protect existing construction to remain from damage during demolition and new construction work. Repair any damage resulting from this work.

Protect in-place, existing mechanical, plumbing and electrical systems above ceilings that are not shown to be removed. This includes, but is not limited to: network cabling, coax cabling, conduits, piping, ductwork, etc.

Salvage: Review with owner all existing ceiling elements to be salvaged and returned to owner or disposed by contractor.

Coordination: Coordinate extent of ceiling to be removed with the architectural ceiling plan(s).

Concrete slab cutting, trenching, and wall tile removal in restrooms to be performed after business hours. Coordinate hours with the Owner.

Building owner to provide a portable restroom trailer for 3 months with three single occupant restrooms. Building Owner to provide power connection to building. Trailer to include water and sewer tanks serviced by provider. Trailer does not need skirting.


Asbestos: Building owner to test and remediate as needed any asbestos containing materials prior to start of remodel.

Where indicated to be removed, salvage undamaged acoustical ceiling panels for use in repair, patching and modifications of existing ceilings. Use only in ceilings where panels match.

Patch and repair existing construction to remain where affected by and adjacent to demolition Work. match existing adjacent finishes.


KEYNOTES

- C41 REMOVE EXISTING TELEPHONE AND / OR CONNECTION PLATE, TERMINATE WIRING AND INSTALL BLANK COVER.
- D01 REMOVE EXISTING CARPET AND BASE (GRAPHICALLY SHADED AREAS). REFER TO GENERAL NOTES REGARDING TESTING.
- D02 REMOVE EXISTING HEATER AND ELECTRICAL. PATCH AND REPAIR WALL.
- D03 REMOVE EXISTING HUMIDIFIERS, PLUMBING, AND ELECTRICAL (NOT IN CONTRACT)
- D04 REMOVE EXISTING LOCKERS
- D05 RELOCATE EXISTING REFRIGERATOR AND VENDING MACHINE, SEE NEW CONSTRUCTION DRAWINGS
- D06 REMOVE EXISTING TOILET STALLS.
- D07 REMOVE EXISTING SINKS AND COUNTERTOP.
- D08 REMOVE EXISTING COUNTERTOP, SINK, AND CABINERY
- D09 REMOVE EXISTING DRINKING FOUNTAIN, ELECTRICAL AND PLUMBING TO REMAIN.
- D10 REMOVE & SALVAGE EXISTING DOOR AND RELOCATE, PATCH AND REPAIR AS NECESSARY, RELOCATE LIGHT SWITCH, SEE ELECTRICAL.
- D11 REMOVE EXISTING FLOOR TILE AND BASE. REFER TO GENERAL NOTES REGARDING TESTING.
- D12 REMOVE EXISTING MILLWORK AND SOFFIT, PATCH AND REPAIR EXISTING WALLS, CEILING, AND FLOOR AS REQUIRED.
- D13 DEMO WALL AREA FOR NEW DOOR. SEE NEW CONSTRUCTION DRAWINGS.
- D14 DEMO EXISTING SLAB AS REQUIRED FOR NEW SHOWER AND PLUMBING. PERFORM AFTER GROUND PENETRATING RADAR SURVEY OR APPROVED EQUIVALENT. SEE NEW CONSTRUCTION DRAWINGS.
- D15 RELOCATE EXISTING THERMOSTAT.
- D16 REMOVE EXISTING DOOR AND PORTION OF WALL AS CONSTRUCTION DRAWINGS INDICATE.
- D18 TRENCH EXISTING SLAB FOR NEW DATA / POWER TO CENTER TABLE. PERFORM AFTER GROUND PENETRATING RADAR SURVEY OR APPROVED EQUIVALENT.
- D21 DEMO EXISTING MARKERBOARD CABINET, PATCH AND REPAIR WALL FOR PAINT
- D22 DEMO EXISTING CARPET TRANSITION. REFER TO GENERAL NOTES REGARDING TESTING.
- D23 EXISTING JANITOR SINK TO REMAIN
- D25 REMOVE EXISTING TELEPHONE AND / OR CONNECTION PLATE, TERMINATE WIRING AND INSTALL BLANK COVER
- D26 EXISTING CUBICLE LAYOUT TO BE DOCUMENTED AND DISASSEMBLED AS NEED FOR CONSTRUCTION. CUBICLES TO BE PROTECTED AND RELOCATED TO A SECURE STORAGE UNIT/FACILITY, AND REINSTALLED TO MATCH EXISTING CONDITIONS
- D27 REMOVE EXISTING VINYL TILE FLOORING, ADHESIVE, AND WALL BASE (CROSSHATCHED AREA). AND PREPARE FLOOR AND PATCH AS NECESSARY FOR NEW SDT FLOORING. REFER TO GENERAL NOTES REGARDING TESTING.
- D28 CARPET AT WALL TO BE REMOVED, WALL SURFACE TO BE REPAIRED AND PATCHED, AND PAINTED. REFER TO GENERAL NOTES REGARDING TESTING. RELOCATE EXISTING CUBICLES AS NEEDED FOR DEMO AND REPAIR.
- D29 DELIVER SURPLUS SHELIVING TO OWNER.
- D30 REMOVE EXISTING SHOWCASE DISPLAYS, PATCH AND REPAIR WALL FOR PAINT.
- D31 REMOVE EXISTING TV, SAVE FOR RELOCATION
- D32 DEMO EXISTING STORAGE CABINET
- D33 REMOVE EXISTING WALLCOVERING, PATCH AND PREPARE SURFACE FOR NEW PAINT

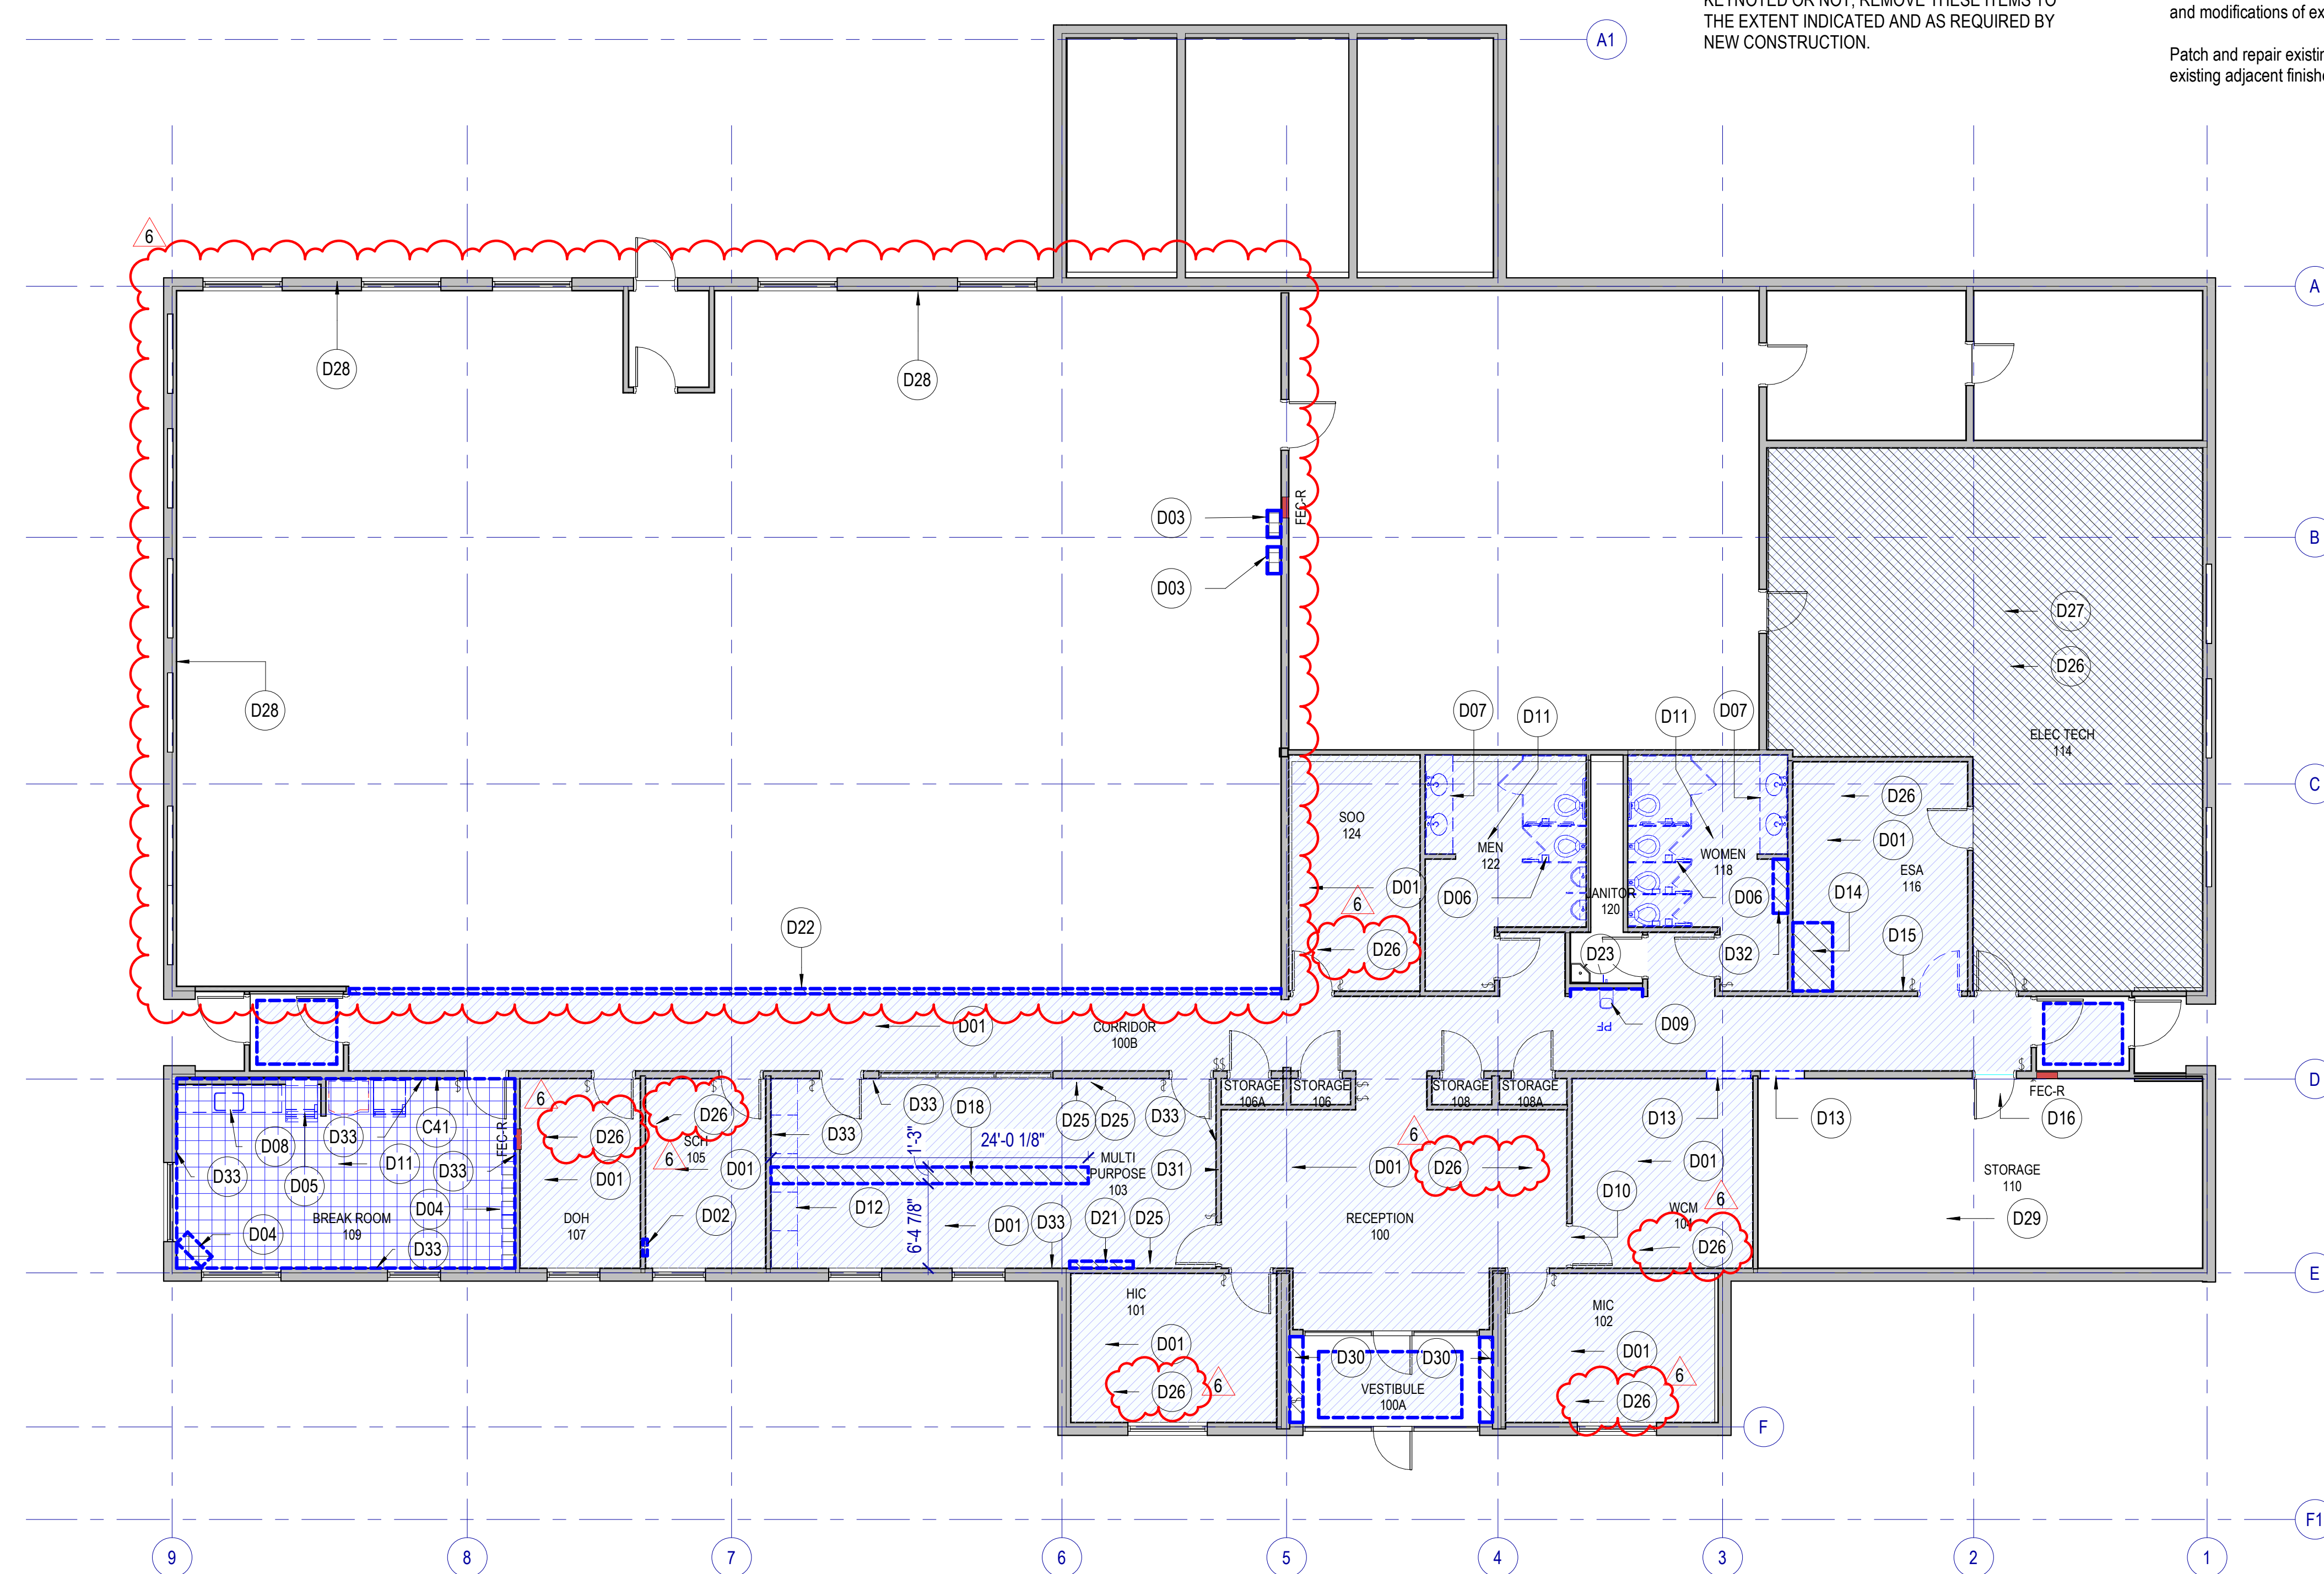

FIRST FLOOR PLAN DEMO

SCALE: 1/8" = 1'-0"

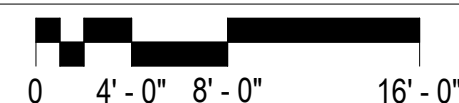

MHTN PROJECT NO 2023573
VIEW AND PRINT THIS DRAWING IN COLOR
 Original drawing is 24 x 36. Do not scale contents of this drawing.

NO.	DATE	DESCRIPTION
01	Oct 27, 2023	SCHEMATIC DESIGN
02	Nov 14, 2023	60% CONSTRUCTION DOCS
03	Dec 15, 2023	80% CONSTRUCTION DOCS
04	Jan 31, 2024	100% CONSTRUCTION DOCS

REVISIONS
 CONTRACTOR TO VERIFY DRAWINGS IN FIELD USE REFLECT LAST REVISION DATE

NO.	DATE	DESCRIPTION
1	May 21, 2024	Appendum 01

CONSTRUCTION DOCUMENTS - BID SET
 MAY 02, 2024

DEMOLITION PLAN

SHEET NUMBER
AD101

FLOOR PLAN GENERAL NOTES

References to sheets below are provided to aid in navigating the drawings.

RE: A101 for Interior Wall Types, walls are tagged on drawings A101A, and A101B.

RE: A651 Floor Finish plan for floor finishes

Furniture may be shown for space planning; however, all furniture is not in contract.

Acoustical sealant to be used for all walls in Shower Room 110, Quiet Room 127, and Office 128.

Rated Construction: Provide as shown on the plans, the Life Safety Plans and elsewhere in the documents. Seal penetrations with systems applicable to the application and that have UL or other testing agency certifications.

Keynotes: Not all keynotes apply to this sheet.

Door Schedule Abbreviations
TME - To Match Existing

©2023 MHTN ARCHITECTS, INC.
Confidentiality Notice:
This document is intended for use on the Project identified herein by individuals and companies involved in the design, permitting, bidding and construction of the Project. MHTN Architects, Inc. grants limited rights to distribute and reproduce this document for this express purpose only. Distribution, printing or copying this document for purposes other than those indicated is strictly prohibited. If a digital copy of this document is received in error, please delete it.



MHTN PROJECT NO 2023573
VIEW AND PRINT THIS DRAWING IN COLOR
Original drawing is 24 x 36. Do not scale contents of this drawing.

ISSUED:	NO.	DATE	DESCRIPTION
	01	Oct 27, 2023	SCHEMATIC DESIGN
	02	Nov 14, 2023	60% CONSTRUCTION DOCS
	03	Dec 15, 2023	80% CONSTRUCTION DOCS
	04	Jan 31, 2024	100% CONSTRUCTION DOCS


REVISIONS
CONTRACTOR TO VERIFY DRAWINGS IN FIELD USE REFLECT
LAST REVISION DATE

NO.	DATE	DESCRIPTION
4	Apr 18, 2024	City Review Comments
5	Apr 26, 2024	City Review Comments 2
6	May 21, 2024	Addendum 01

CONSTRUCTION DOCUMENTS - BID SET
MAY 02, 2024



SHEET NAME
FIRST FLOOR PLAN

SHEET NUMBER
A101

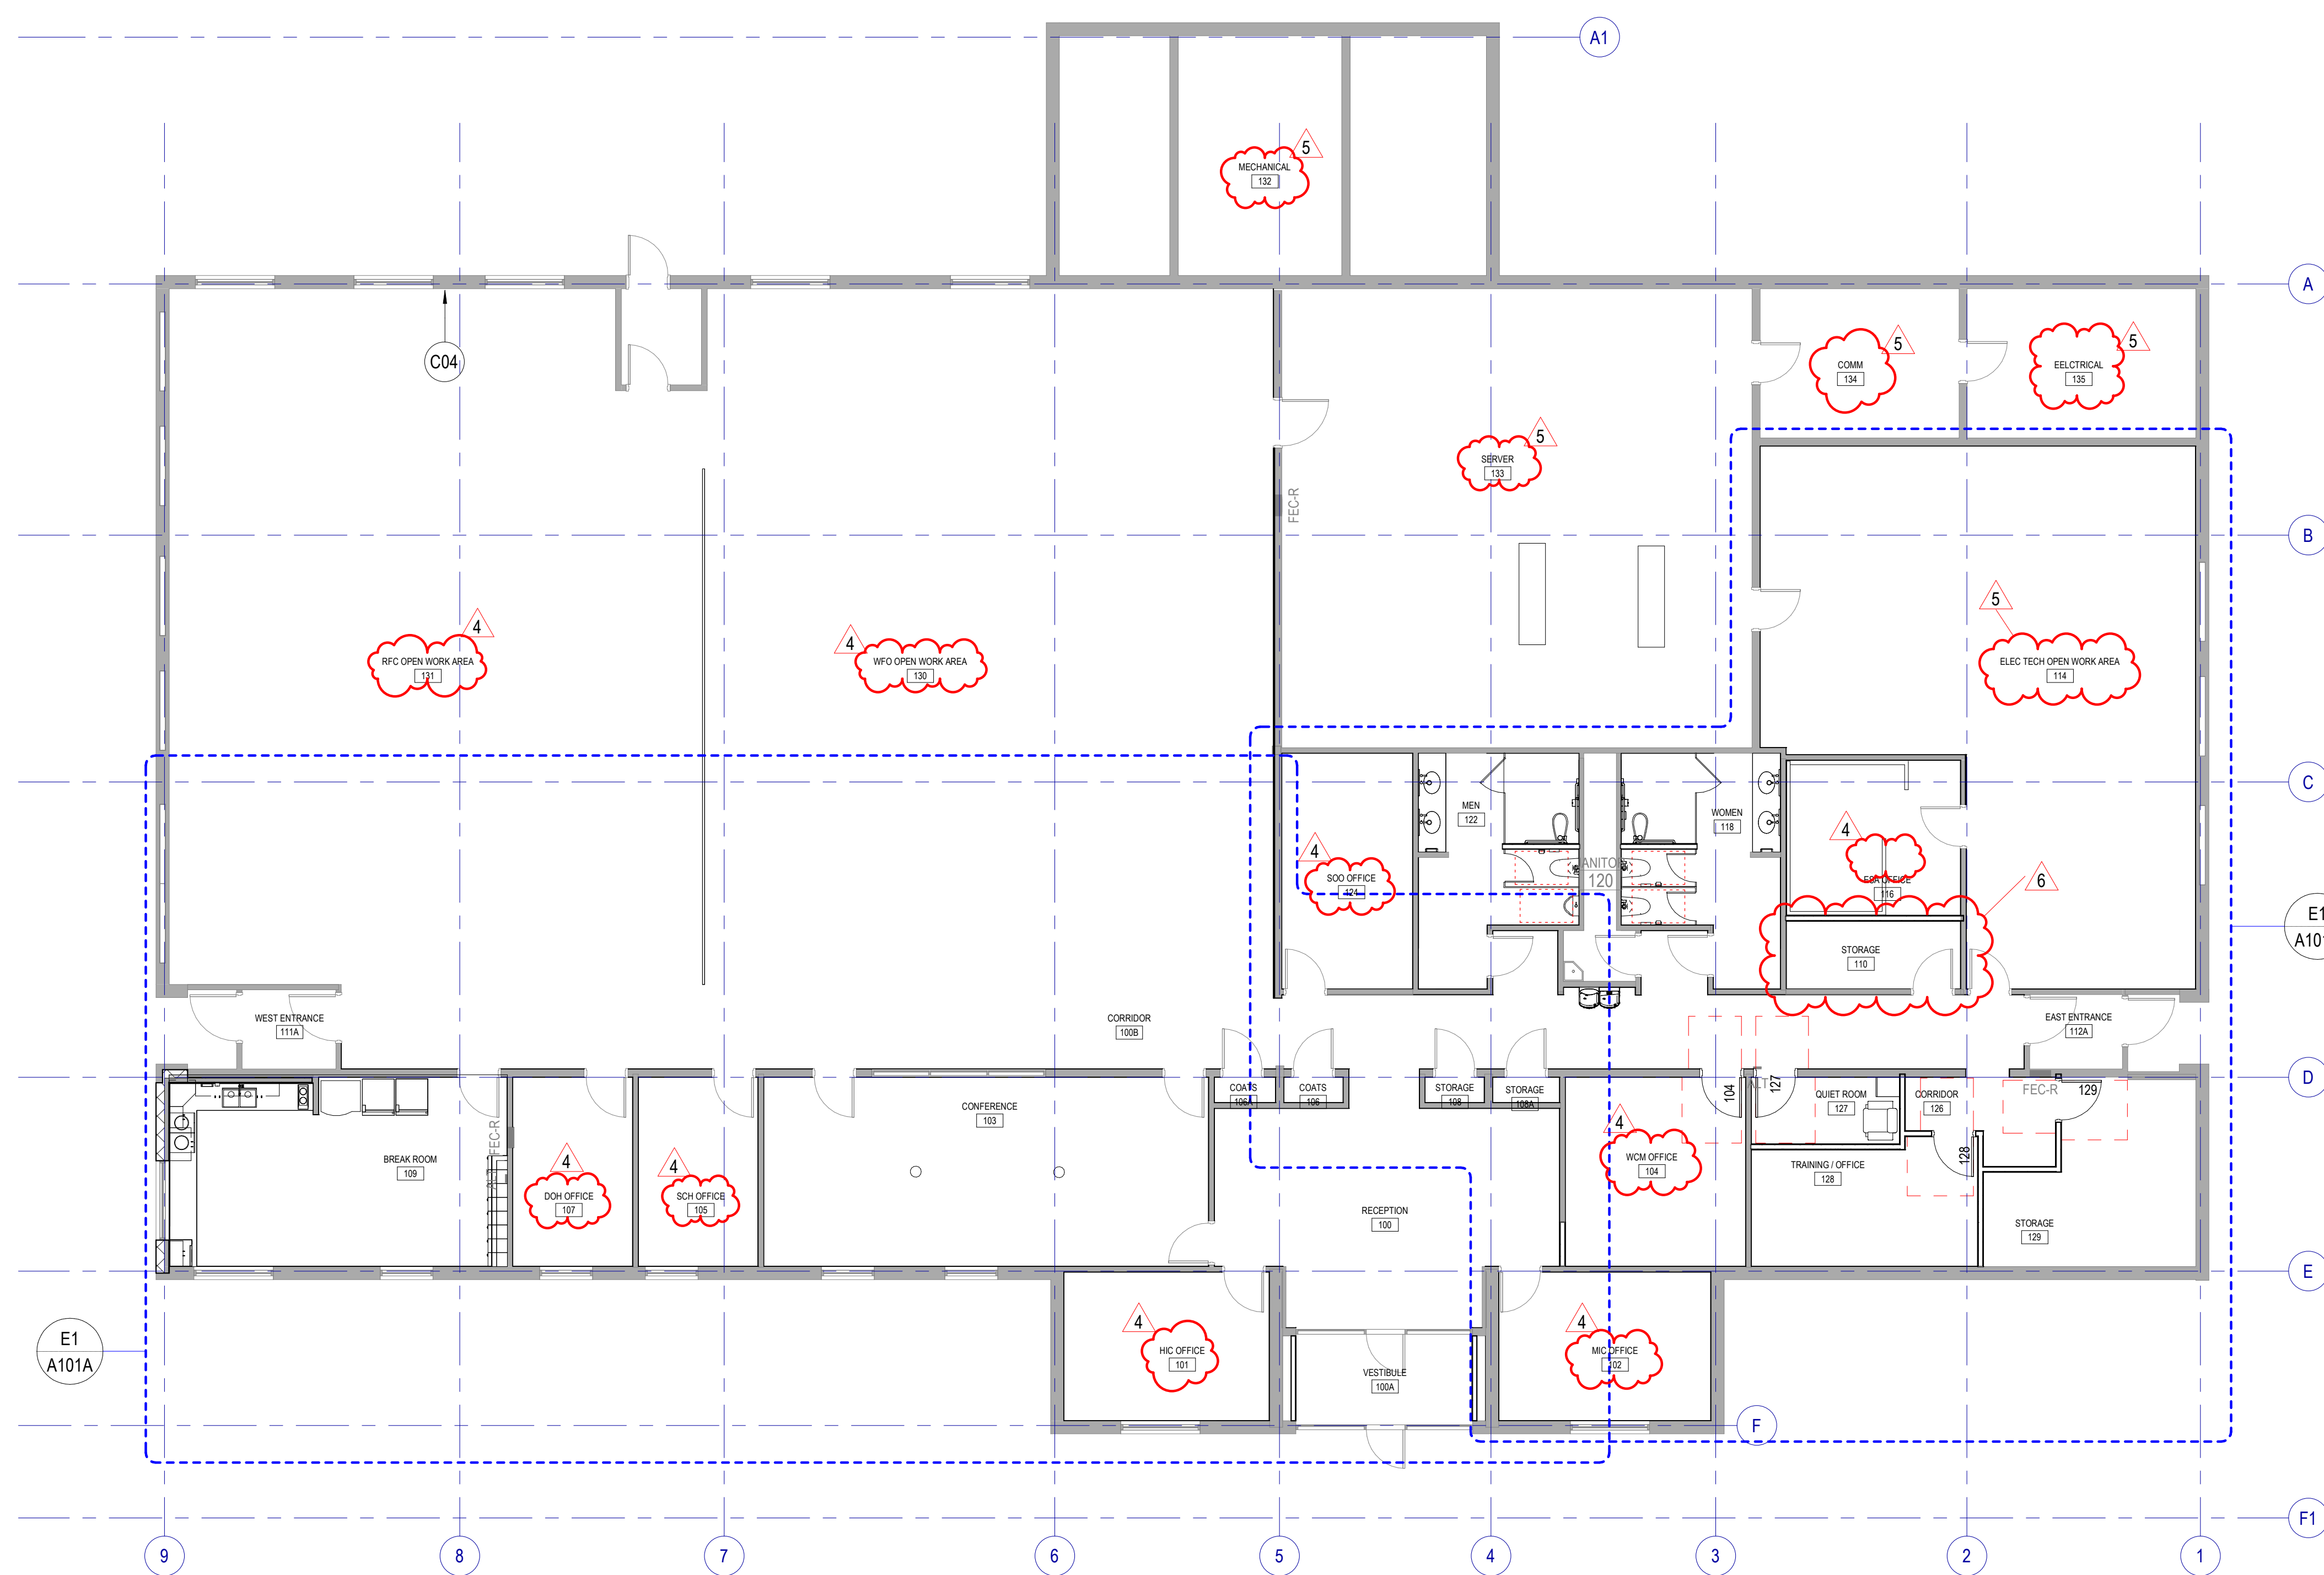

FIRST FLOOR PLAN

SCALE: 1/8" = 1'-0"

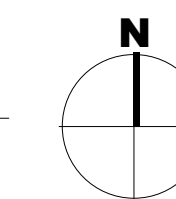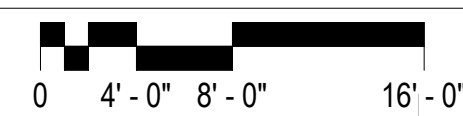

LEGEND - FLOOR PLAN

- FIRE EXTINGUISHER + CABINET SURFACE MOUNTED
- FIRE EXTINGUISHER + CABINET SEMI-RECESSED
- FIRE EXTINGUISHER
- AUTOMATED EXTERNAL DEFIBRILLATOR
- CORNER GUARD
- WALL MOUNTED TOILET RE: PLUMBING
- FLOOR MOUNTED TOILET RE: PLUMBING
- URINAL RE: PLUMBING
- WALL HUNG LAVATORY RE: PLUMBING
- COUNTER MOUNTED SINK RE: PLUMBING
- ELECTRICAL WATER COOLER RE: PLUMBING
- MOP SINK RE: PLUMBING


NOTE: PROVIDE ITEMS INDICATED IN THE LEGEND IN THE QUANTITIES SHOWN ON THE PLAN.

KEYNOTES

- C01 NEW RESTROOM FIXTURES AND STALLS, FLOOR MOUNT OR WALL MOUNT TOILETS AS SHOWN ON DRAWINGS, FIXTURES TO BE ADA / ABAAS COMPLIANT.
- C04 NEW WALL, PAINT, AND BASE
- C05 NEW DOOR AND FRAME TO MATCH EXISTING
- C09 RELOCATED THERMOSTAT, TERMINATE WIRING AND REPLACE WITH BLANK COVER.
- C10 NEW DRINKING FOUNTAINS WITH BOTTLE FILLER
- C15 NEW INFILL WALL TO MATCH EXISTING WALL CONSTRUCTION, PAINT AND FINISH TO MATCH.
- C16 NEW CARPET AND BASE. CARPET INSTALL PATTERN TO BE ASHLAR.
- C18 NEW COUNTER, SINKS, FAUCETS, MIRRORS. FIXTURES TO BE ADA / ABAAS COMPLIANT.
- C19 NEW LOW REFRIGERATOR AND ELECTRICAL, FRIDGE NOT IN CONTRACT.
- C25 NEW LIGHT SWITCH OR RELOCATE EXISTING SWITCH
- C31 PATCH AND REPAIR GYPSUM BOARD, NEW PAINT
- C45 NEW SHELVING ABOVE EXISTING FURNITURE, ADJUSTABLE WITH BRACKETS, FULL CLOSET DEPTH.
- C47 EXISTING FURNITURE TO BE RELOCATED TO THIS LOCATION.
- C48 EXISTING WALL AT NEW CONSTRUCTION, ADD 5/8" GYPSUM BOARD ABOVE CEILING TILE TO DECK, TAPE AND MUD ABOVE ACOUSTIC CEILING
- C49 EXISTING DOOR AND FRAME RELOCATED FROM CORRIDOR, PROTECT FROM DAMAGE AND REPAIR / REPAINT AS NECESSARY.
- C69 PAPER TOWEL DISPENSER
- C84 EXISTING BASE TO REMAIN
- C92 EXISTING JANITOR SINK TO REMAIN.
- C93 NEW EPOXY FLOORING AND BASE

SCLCDA
NATIONAL WEATHER SERVICE TI
SALT LAKE INTERNATIONAL AIRPORT
SALT LAKE CITY, UTAH

©2023 MHTN ARCHITECTS, INC.
 Confidentiality Notice:
 This document is intended for use on the Project identified herein by individuals and companies involved in the design, permitting, bidding and construction of the Project. MHTN Architects, Inc. grants limited rights to distribute and reproduce this document for the express purpose only. Distribution, printing or copying this document for purposes other than those indicated is strictly prohibited. If a digital copy of this document is received in error, please delete it.

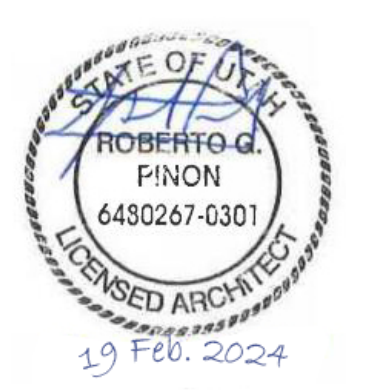

MHTN PROJECT NO 2023573
VIEW AND PRINT THIS DRAWING IN COLOR
Original drawing is 24 x 36. Do not scale contents of this drawing.


ISSUED:	NO.	DATE	DESCRIPTION
	01	Oct 27, 2023	SCHEMATIC DESIGN
	02	Nov 14, 2023	60% CONSTRUCTION DOCS
	03	Dec 15, 2023	80% CONSTRUCTION DOCS
	04	Jan 31, 2024	100% CONSTRUCTION DOCS

REVISIONS	NO.	DATE	DESCRIPTION
CONTRACTOR TO VERIFY DRAWINGS IN FIELD USE REFLECT LAST REVISION DATE	1	Apr 26, 2024	City Review Comments 2
	2	May 21, 2024	Appendum 01

CONSTRUCTION DOCUMENTS - BID SET
 MAY 02, 2024

SHEET NAME
FIRST FLOOR PLAN - AREA B

SHEET NUMBER
A101B

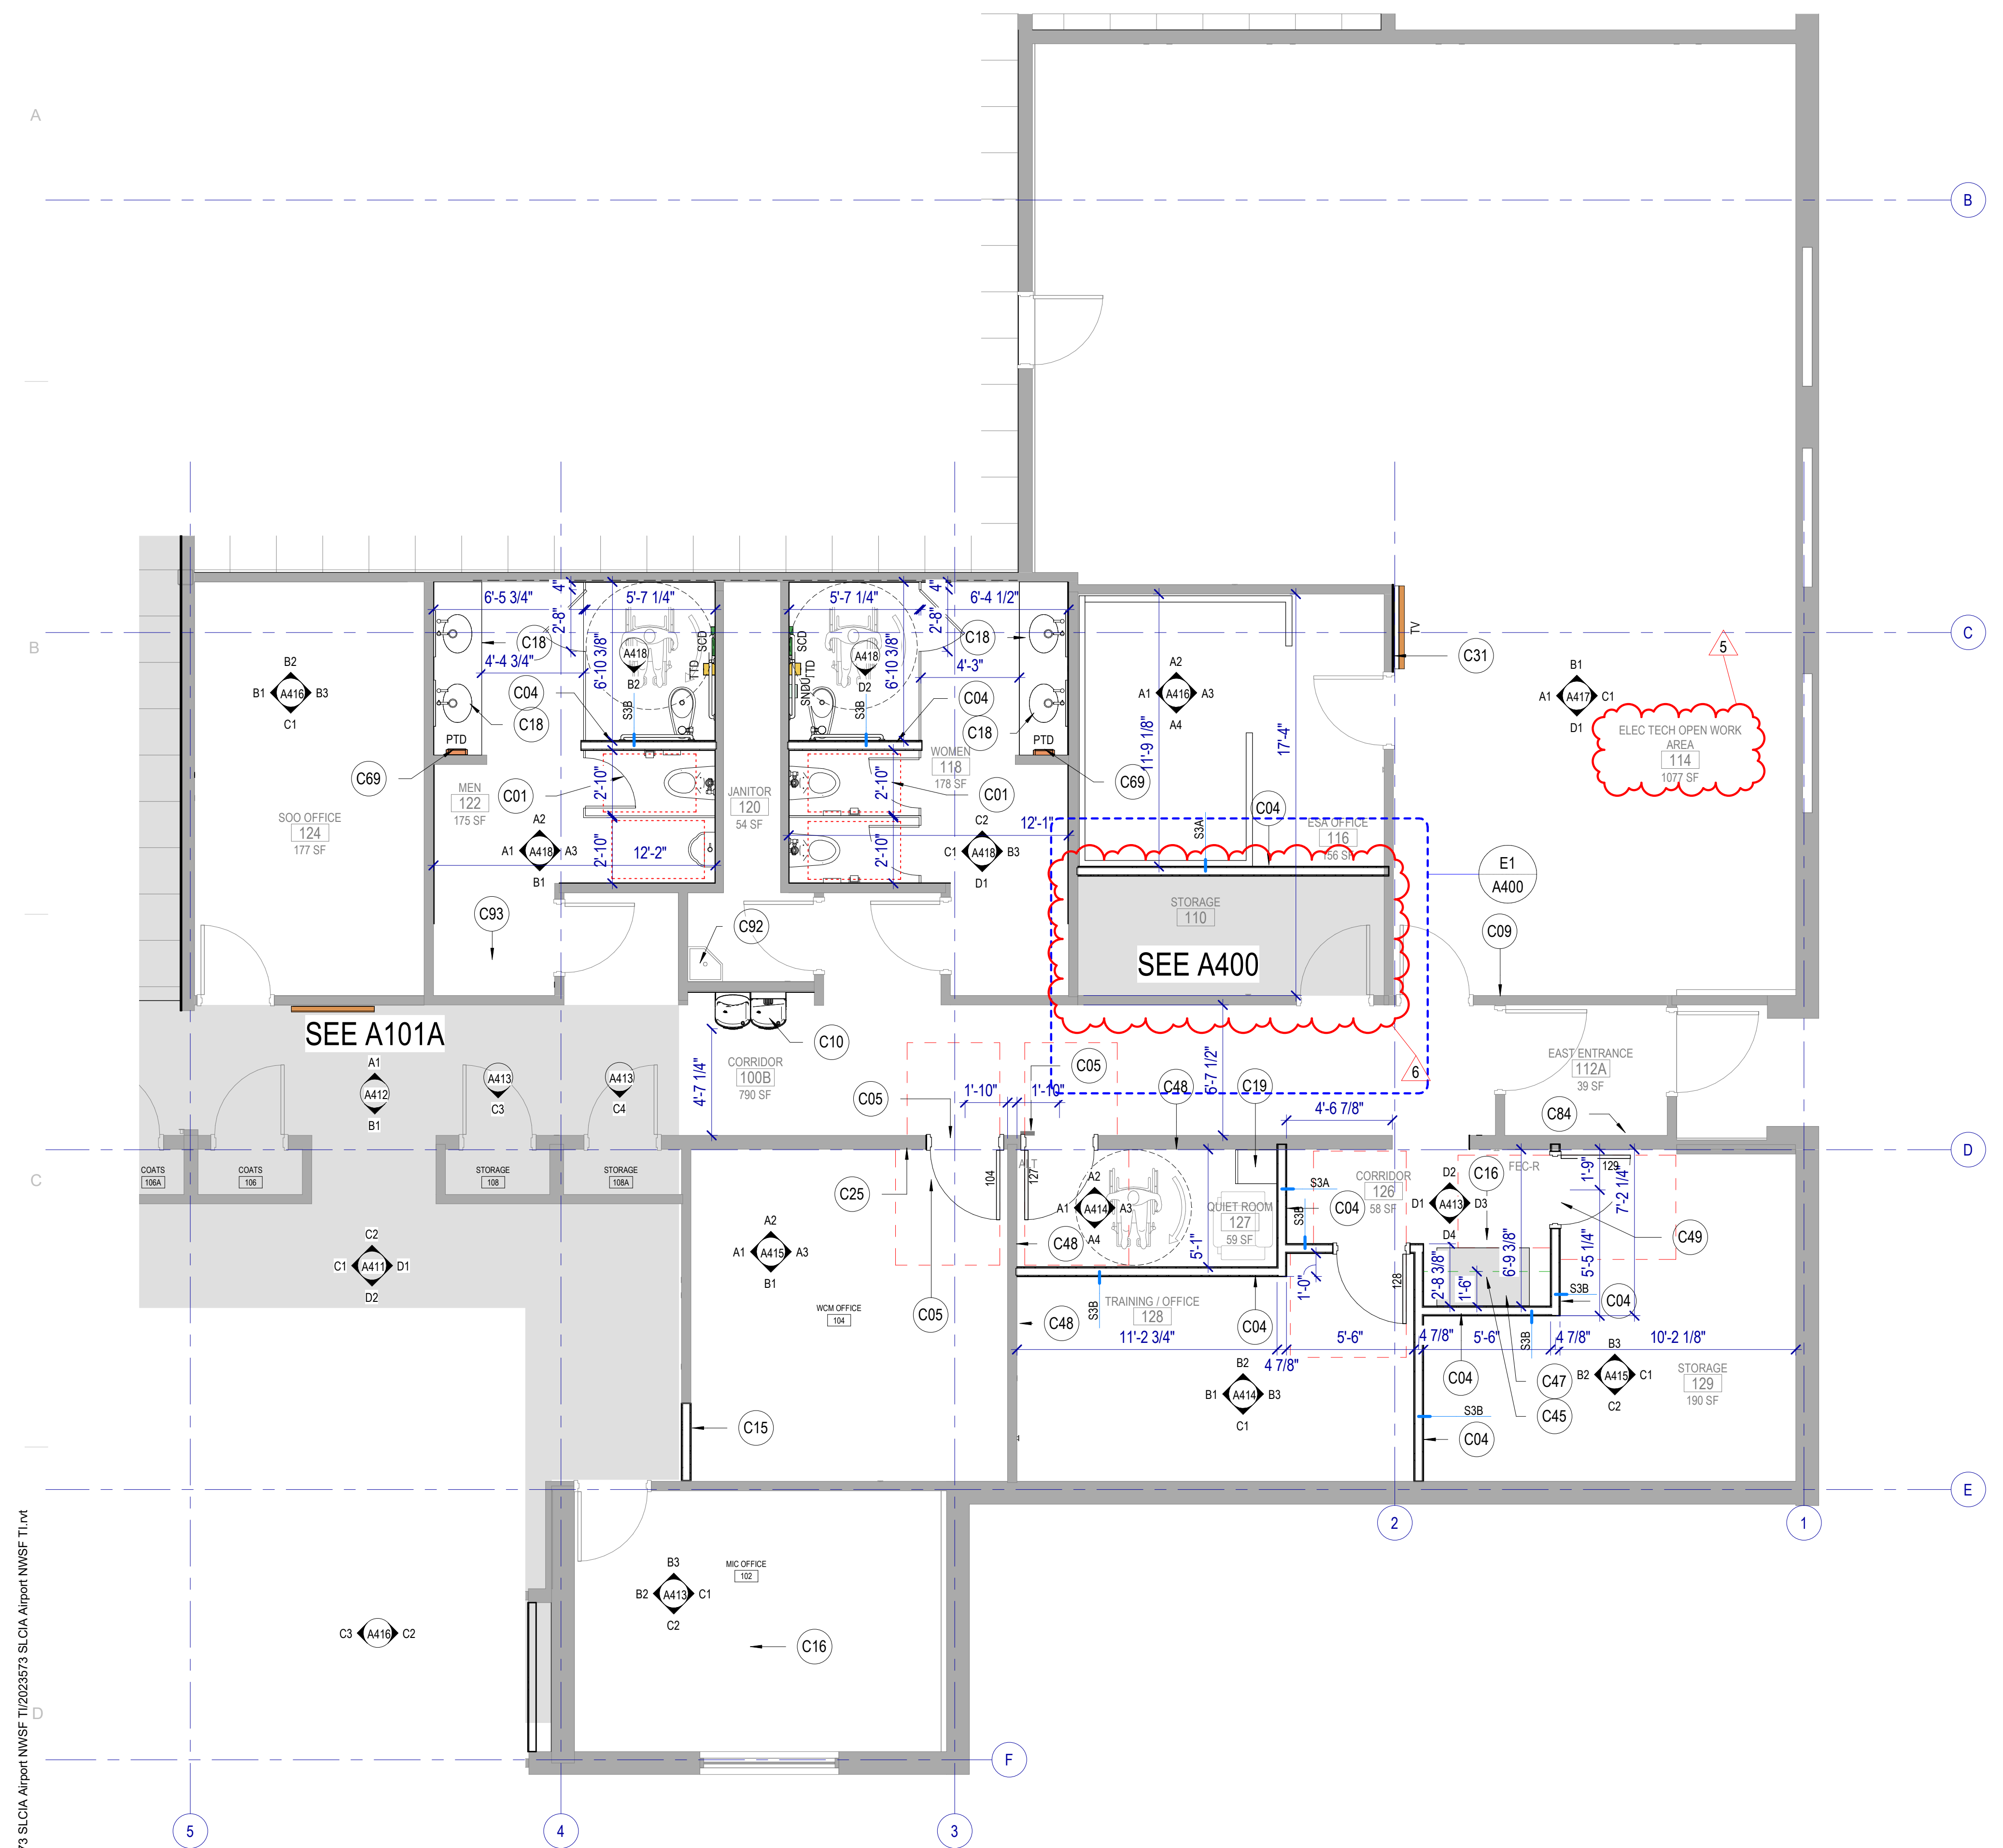

E1 FIRST FLOOR PLAN - AREA B
 SCALE: 1/4" = 1'-0"

Autodesk Docs/2023573 SCLCDA Airport NWSF TI/2023573 SCLCDA Airport NWSF TI.rvt
 5/2/2024 1:06:17 PM

62023 MHTN ARCHITECTS, INC.
 Confidentiality Notice:
 This document is intended for use on the Project identified herein by individuals and companies involved in the design, permitting, bidding and construction of the Project. MHTN Architects, Inc. grants limited rights to distribute and reproduce this document for this express purpose only. Distribution, printing or copying this document for purposes other than those indicated is strictly prohibited. If a digital copy of this document is received in error, please delete it.



MHTN PROJECT NO 2023573
VIEW AND PRINT THIS DRAWING IN COLOR
 Original drawing is 24 x 36. Do not scale contents of this drawing.

ISSUED:	NO.	DATE	DESCRIPTION


REVISIONS	CONTRACTOR TO VERIFY DRAWINGS IN FIELD USE REFLECT		
NO.	DATE	DESCRIPTION	LAST REVISION DATE
6	May 21, 2024	Appendum 01	

CONSTRUCTION DOCUMENTS - BID SET
 MAY 02, 2024


SHEET NAME
PARTIAL PLANS - ADD ALTERNATE 01

SHEET NUMBER


A400

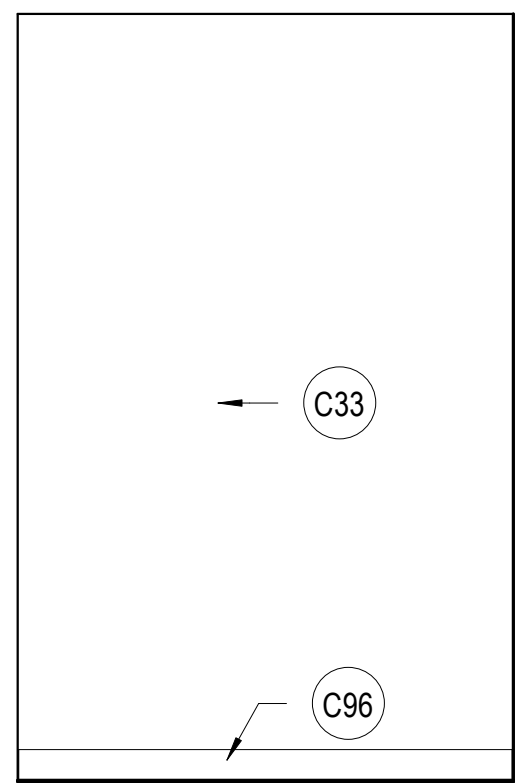


B1 STORAGE 110 WEST
 SCALE: 1/2" = 1'-0"

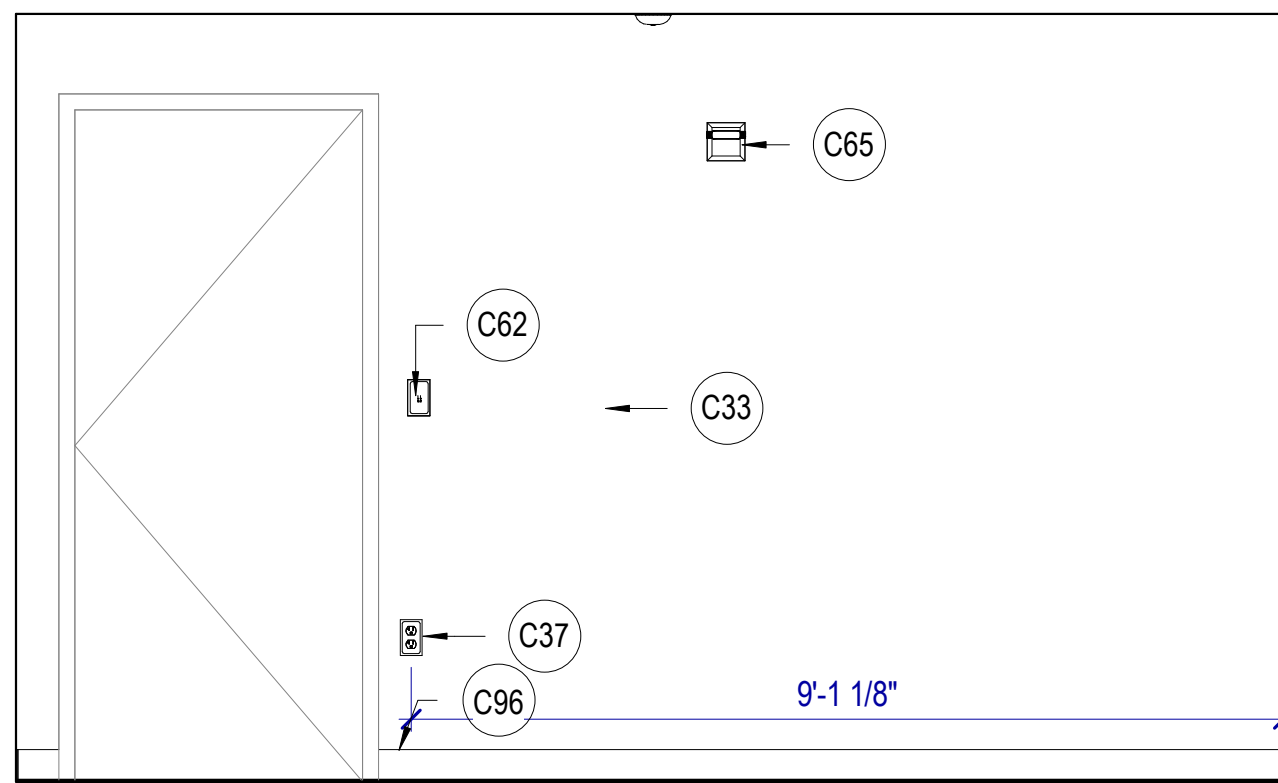


B2 STORAGE 110 SOUTH
 SCALE: 1/2" = 1'-0"

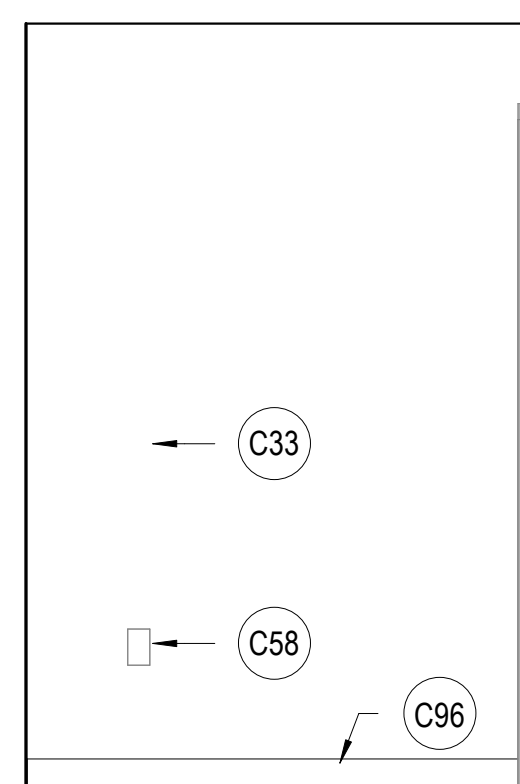


C1 STORAGE 110 EAST
 SCALE: 1/2" = 1'-0"

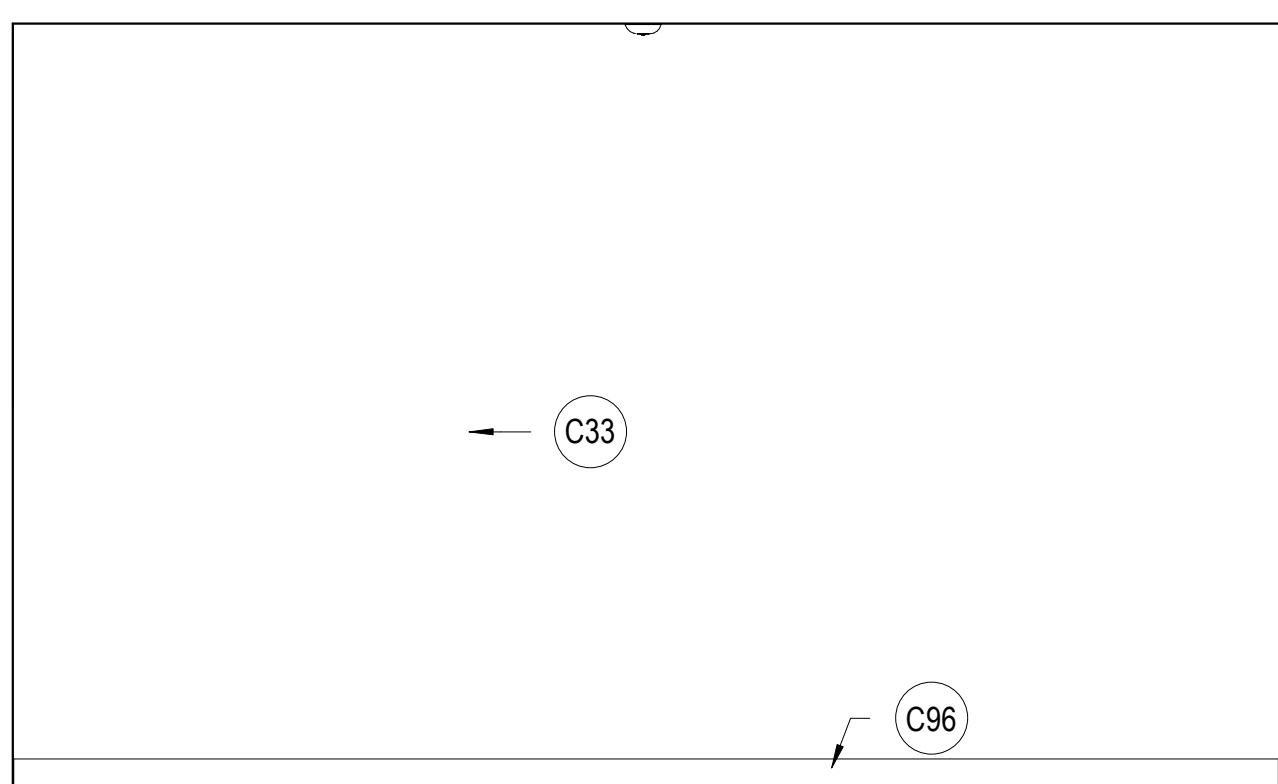


C2 STORAGE 110 NORTH
 SCALE: 1/2" = 1'-0"

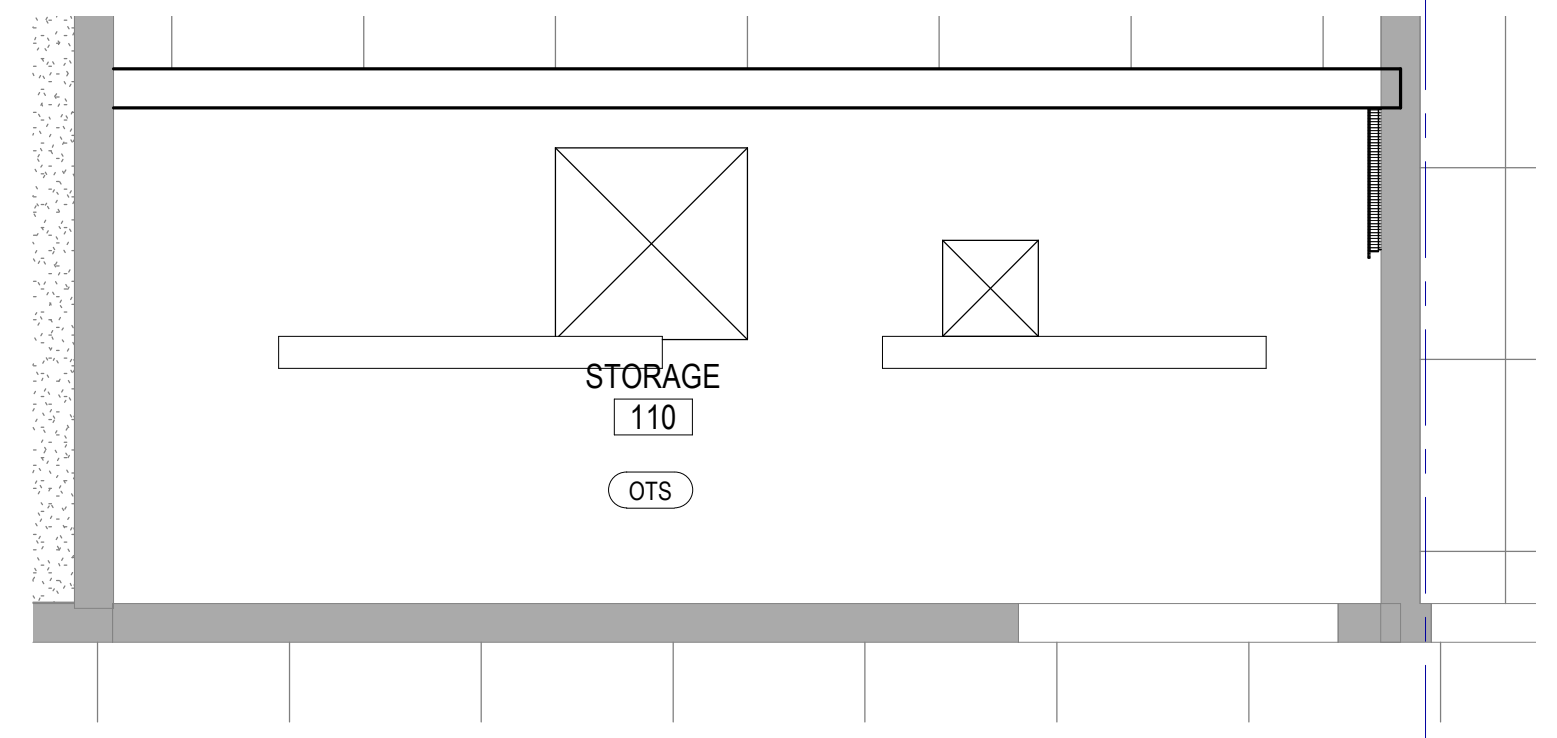


D1 STORAGE 110 RCP -BASE BID
 SCALE: 1/2" = 1'-0"

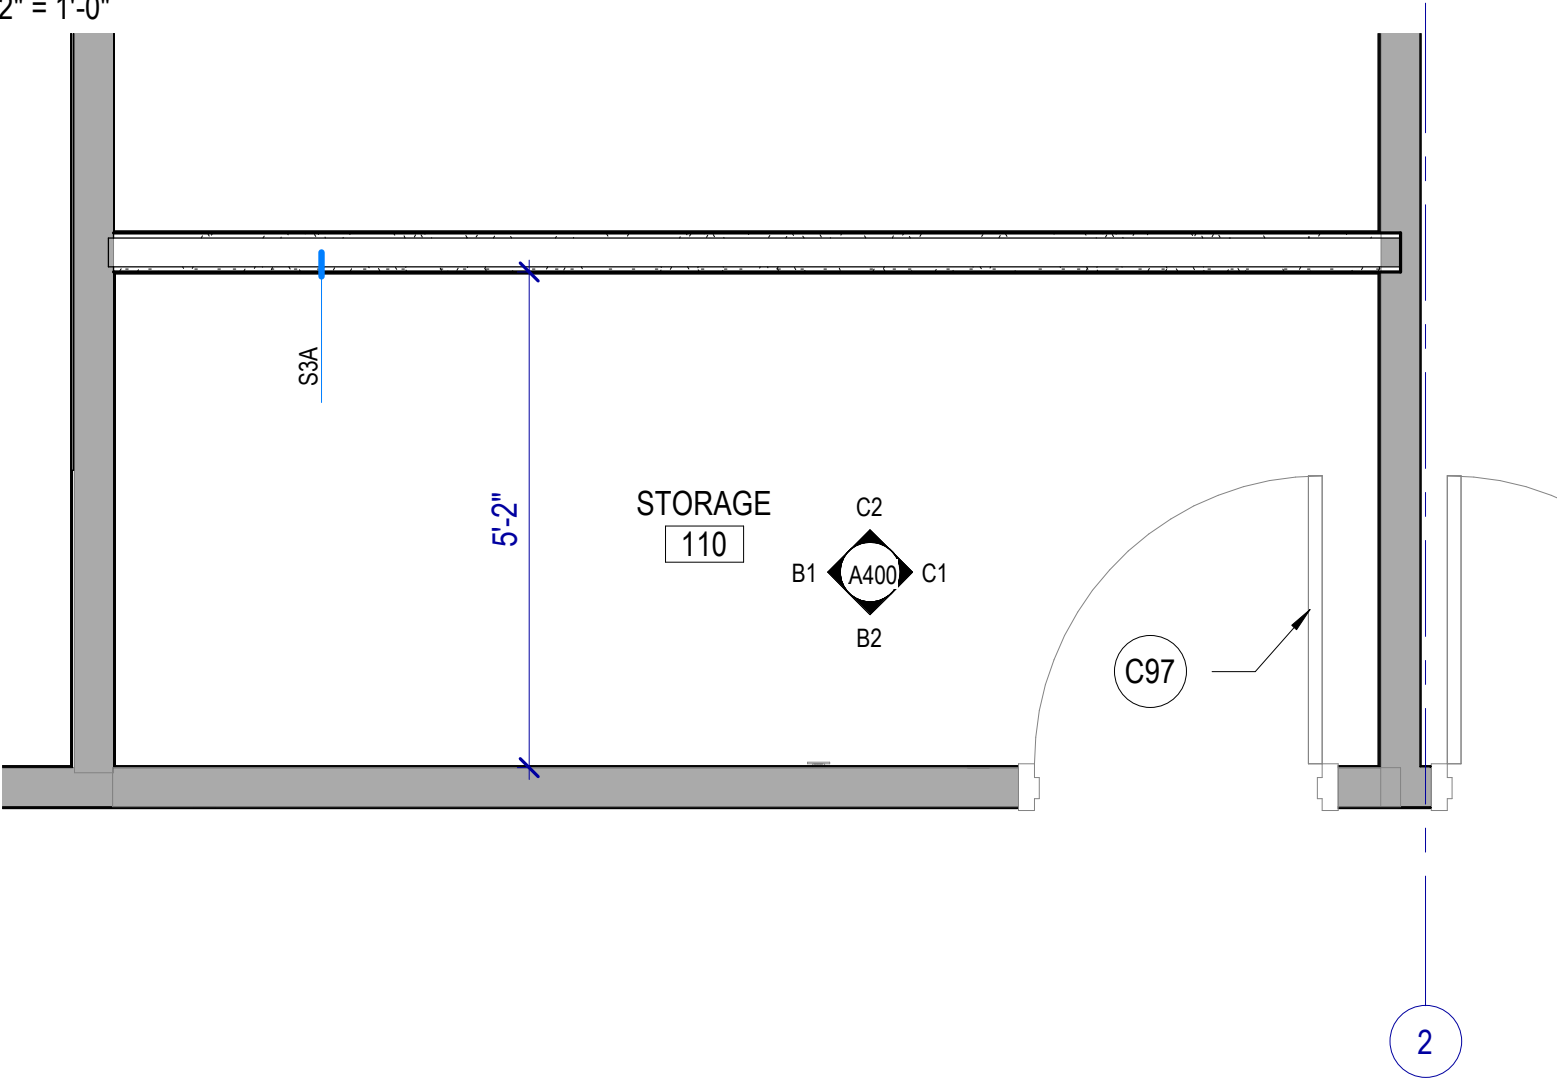


E1 STORAGE 110 - BASE BID
 SCALE: 1/2" = 1'-0"

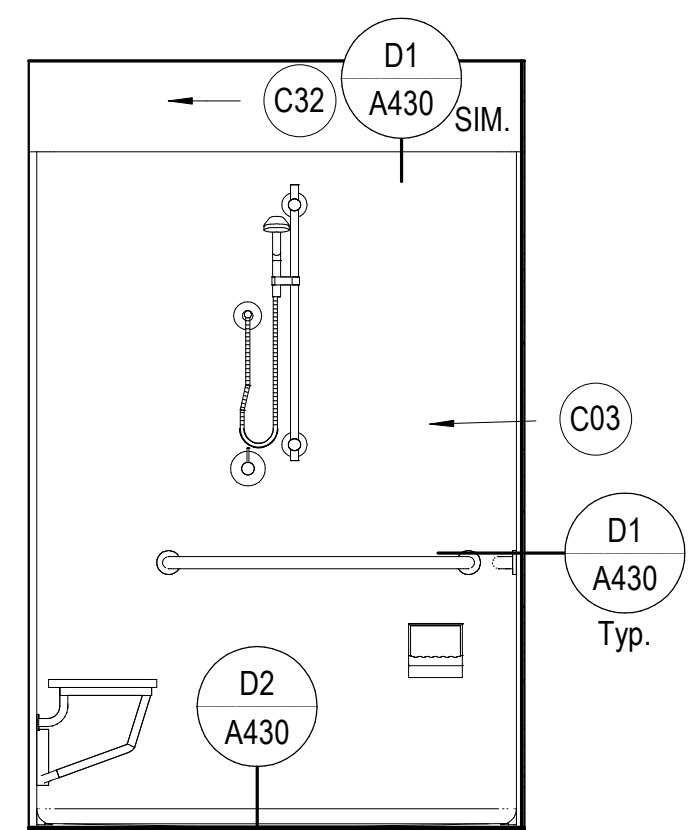


B3 SHOWER 110 WEST
 SCALE: 1/2" = 1'-0"

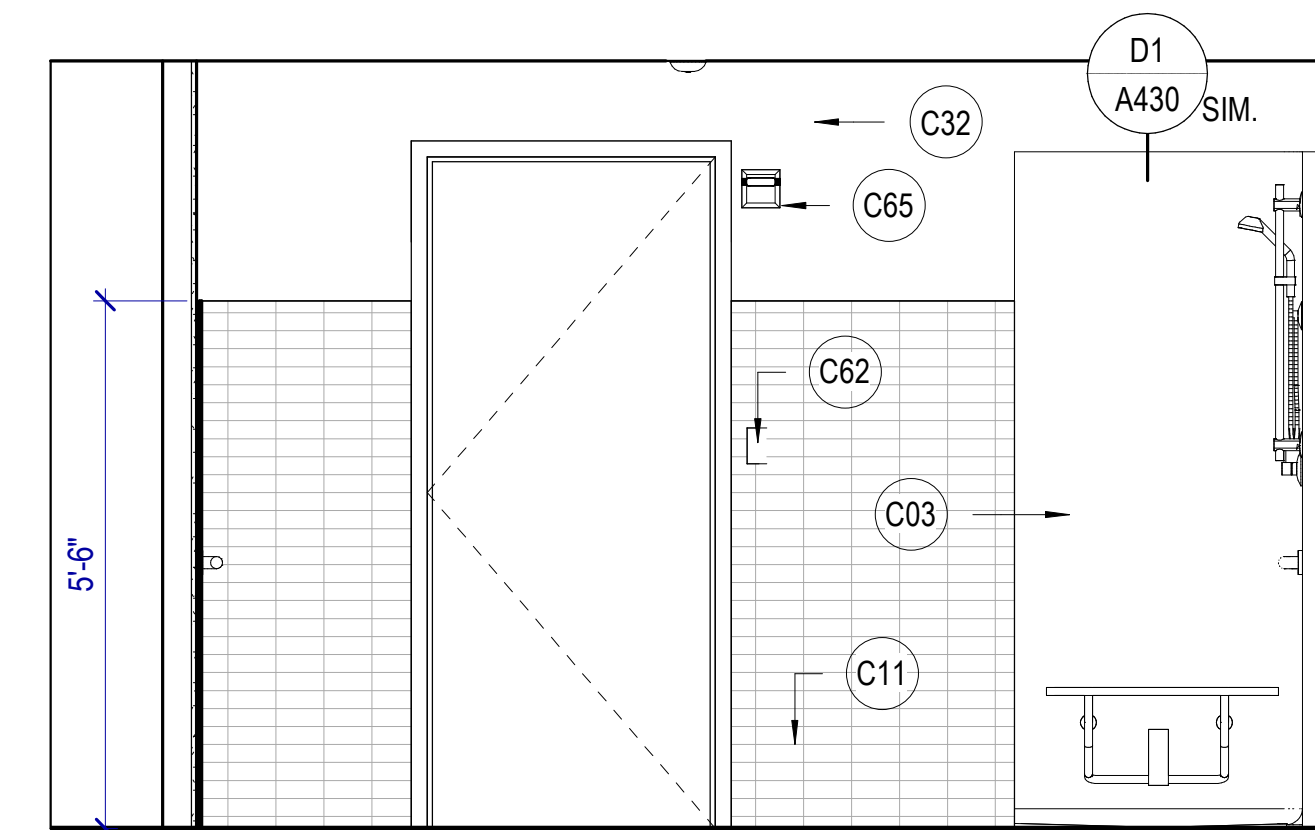


B4 SHOWER 110 SOUTH
 SCALE: 1/2" = 1'-0"

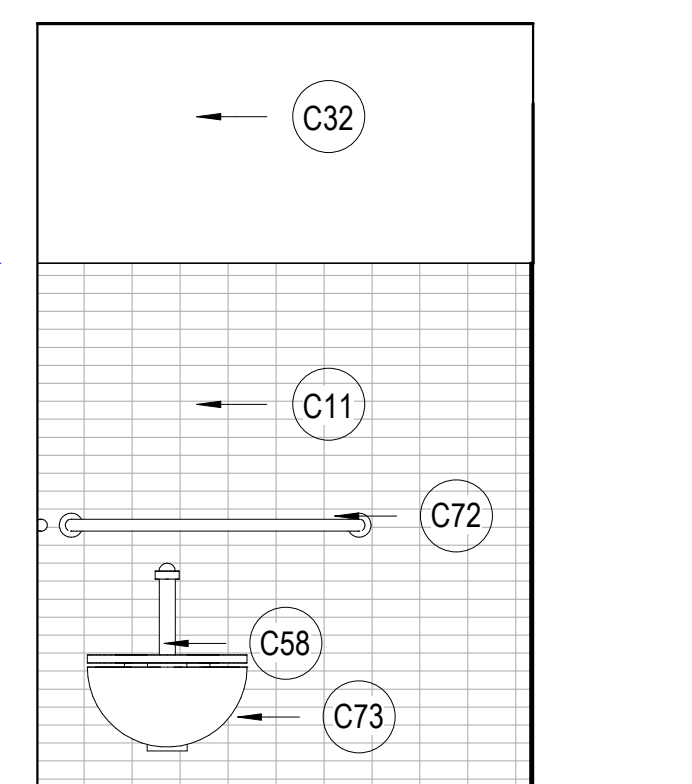


C3 SHOWER 110 EAST
 SCALE: 1/2" = 1'-0"

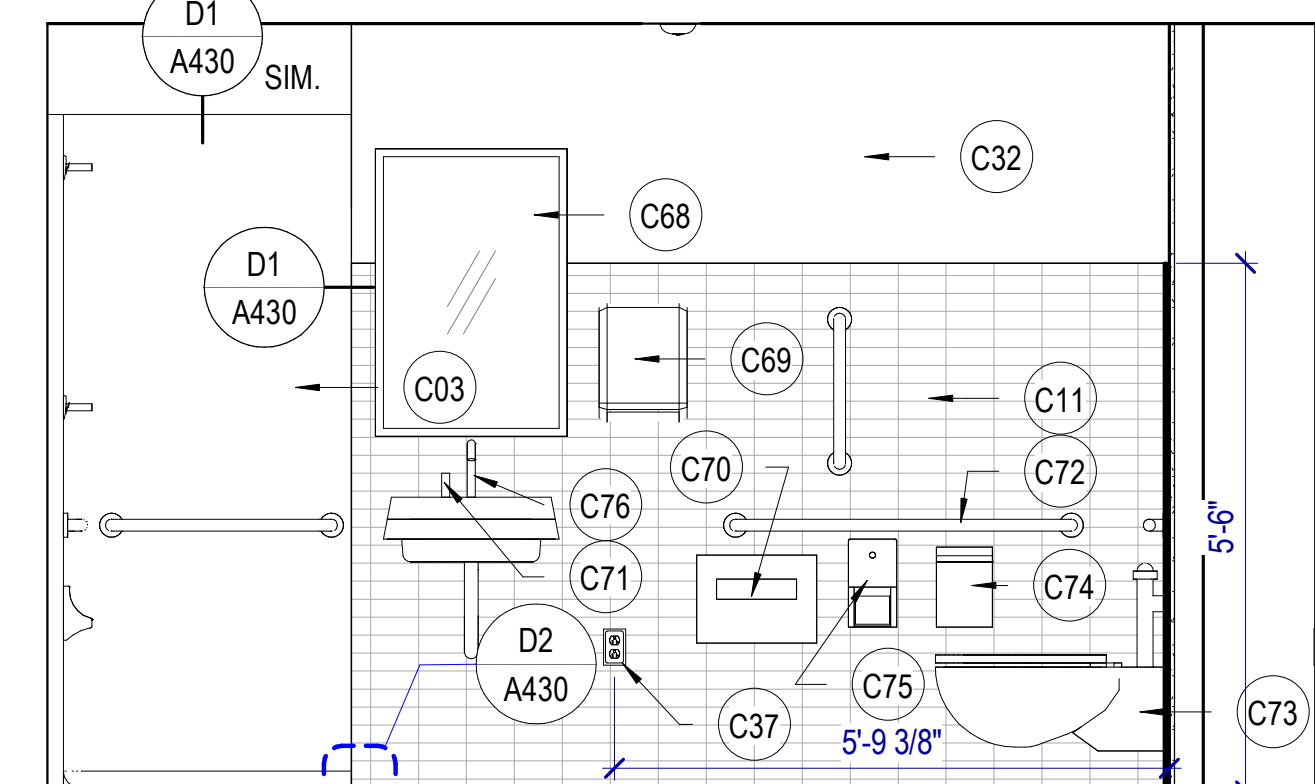

C4 SHOWER 110 NORTH
 SCALE: 1/2" = 1'-0"

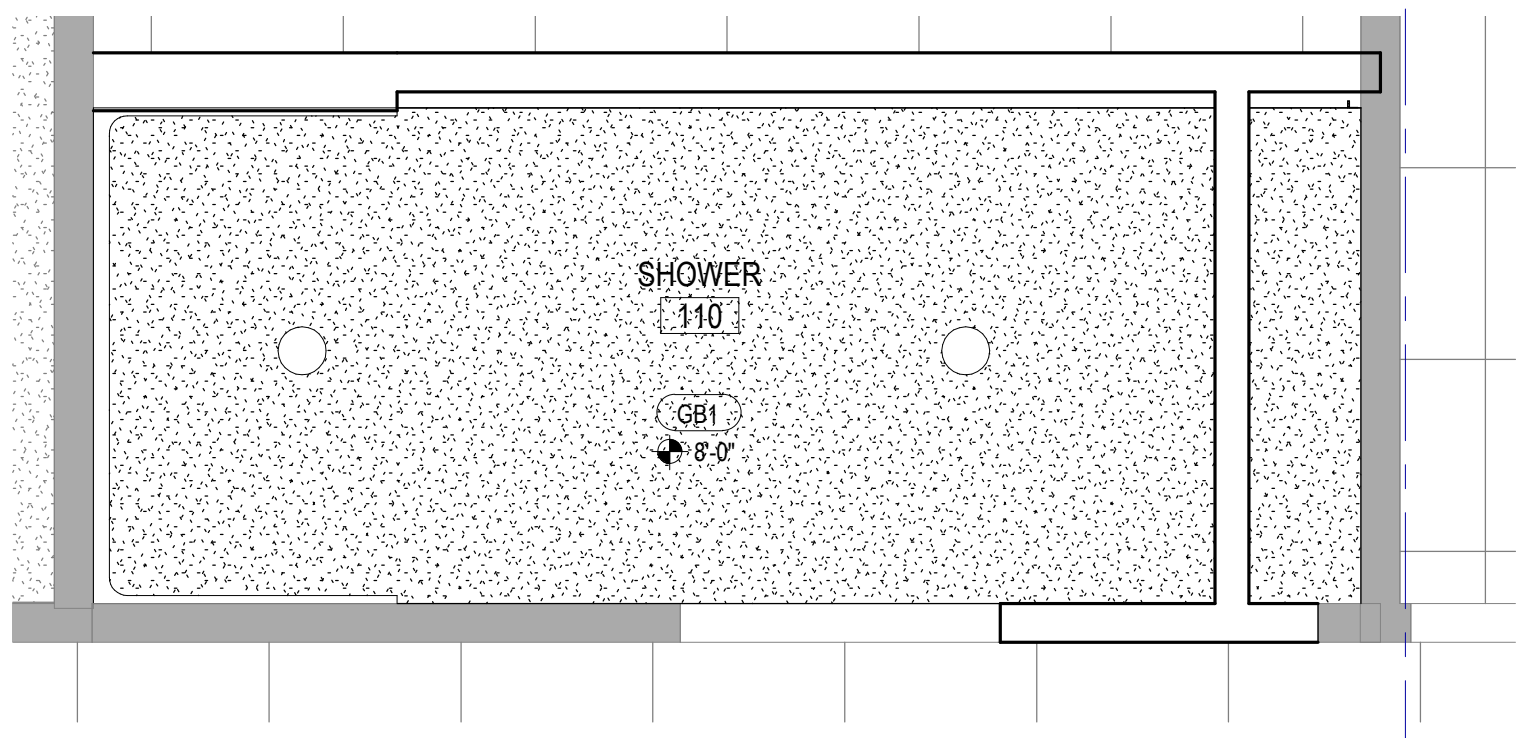

D3 SHOWER 110 RCP -ADD ALT 01
 SCALE: 1/2" = 1'-0"

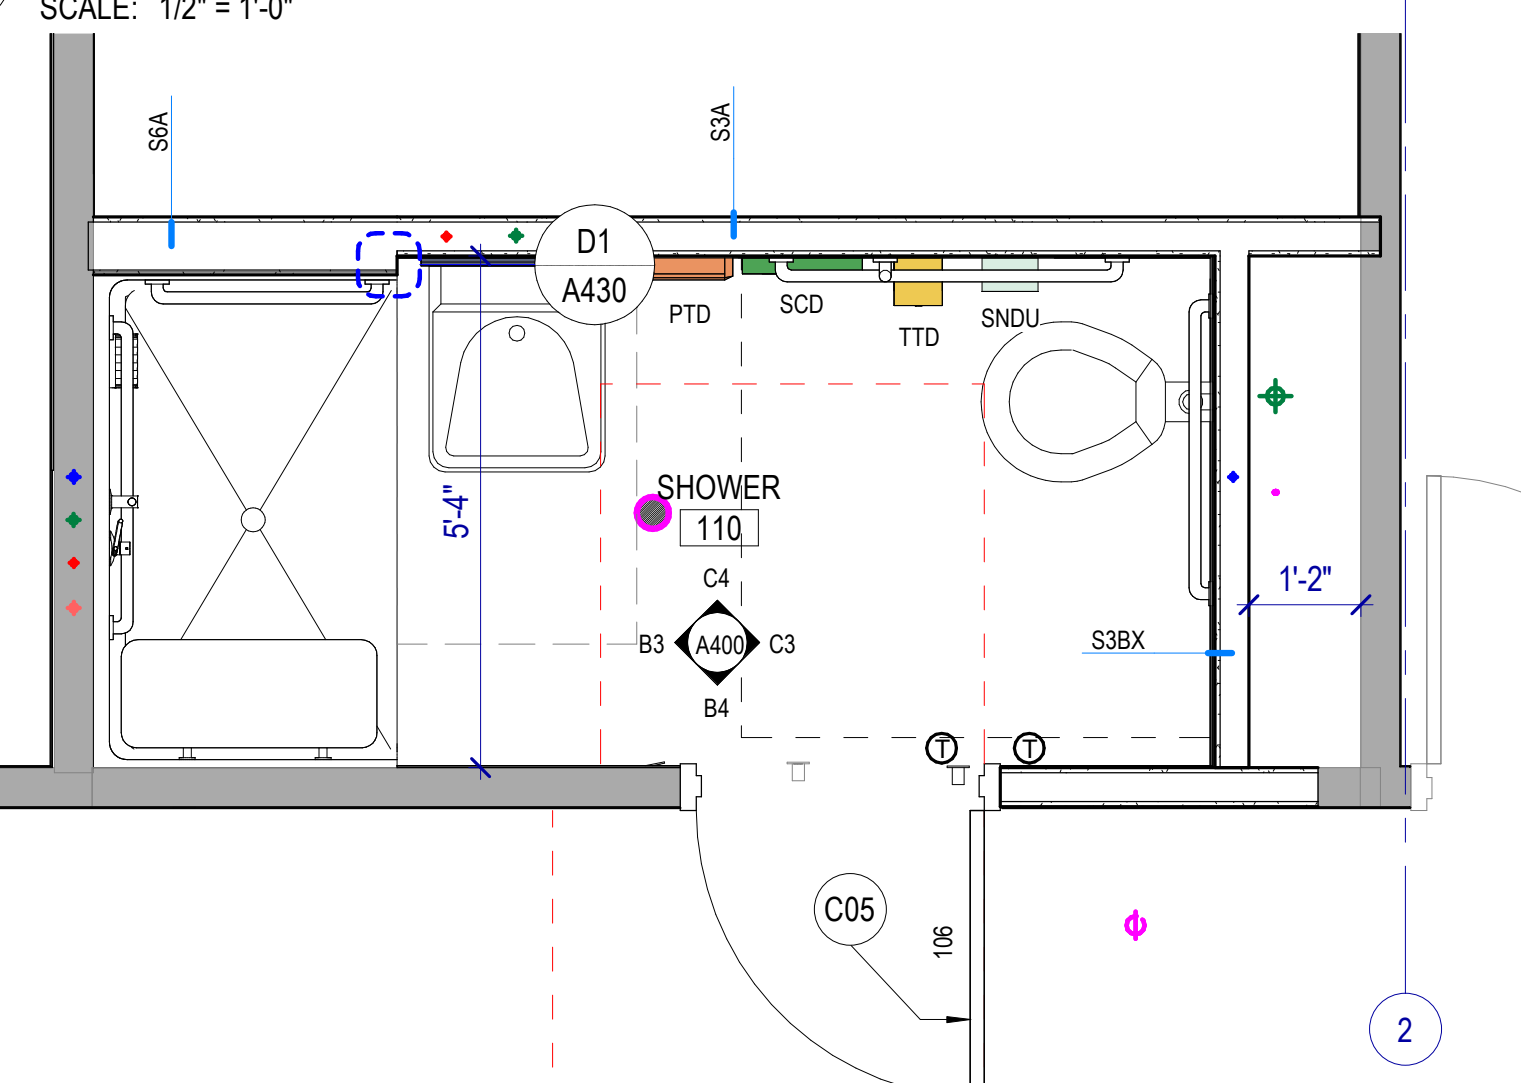

E3 SHOWER 110 - ADD ALT 01
 SCALE: 1/2" = 1'-0"


LEGEND - TOILET ROOMS

PLAN	ELEVATION	DESCRIPTION
TTD		TOILET TISSUE DISPENSER
M24x36		FRAMED MIRROR
SD		SOAP DISPENSER
PTD		PAPER TOWEL DISPENSER
SNDU		SANITARY NAPKIN DISPOSAL UNIT
SCD		SEAT COVER DISPENSER
		WALL MOUNTED WATER CLOSET
SD		WALL HUNG LAVATORY


KEYNOTES

- C03 NEW ROLL-IN SHOWER ENCLOSURE AND PLUMBING, TO BE ADA / ABAAS COMPLIANT.
- C05 NEW DOOR AND FRAME TO MATCH EXISTING
- C11 NEW TILE AND BASE
- C32 NEW EPOXY PAINT
- C33 NEW PAINT
- C37 NEW GFCI OUTLET OR RELOCATED GFCI
- C58 TERMINATE AND BLANK COVER EXISTING POWER / DATA.
- C62 NEW LIGHTS SWITCH, HEIGHT TO MATCH EXISTING, SEE ELECTRICAL
- C65 NEW FIRE BEACON, SEE ELECTRICAL
- C68 FRAMELESS MIRROR
- C69 PAPER TOWEL DISPENSER
- C70 SEAT COVER DISPENSER
- C71 SOAP DISPENSER WITH SENSOR
- C72 GRAB BAR ADA / ABAS COMPLIANT
- C73 WATER CLOSET ADA / ABAS COMPLIANT WITH SENSOR
- C74 SANITARY NAPKIN DISPOSAL
- C75 TOILET TISSUE DISPENSER
- C76 FAUCET WITH SENSOR
- C96 NEW BASE
- C97 EXISTING DOOR TO REMAIN


Autodesk Docs/2023573 SLCIA Airport NWSF TI/2023573 SLCIA Airport NWSF TI.rvt
 5/21/2024 1:02:48 PM

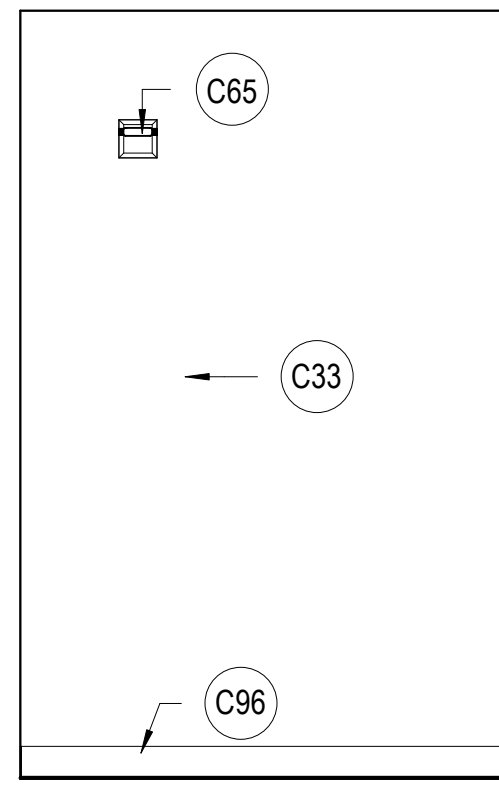


A1 PRIVATE OFFICE 127 WEST
 SCALE: 1/2" = 1'-0"

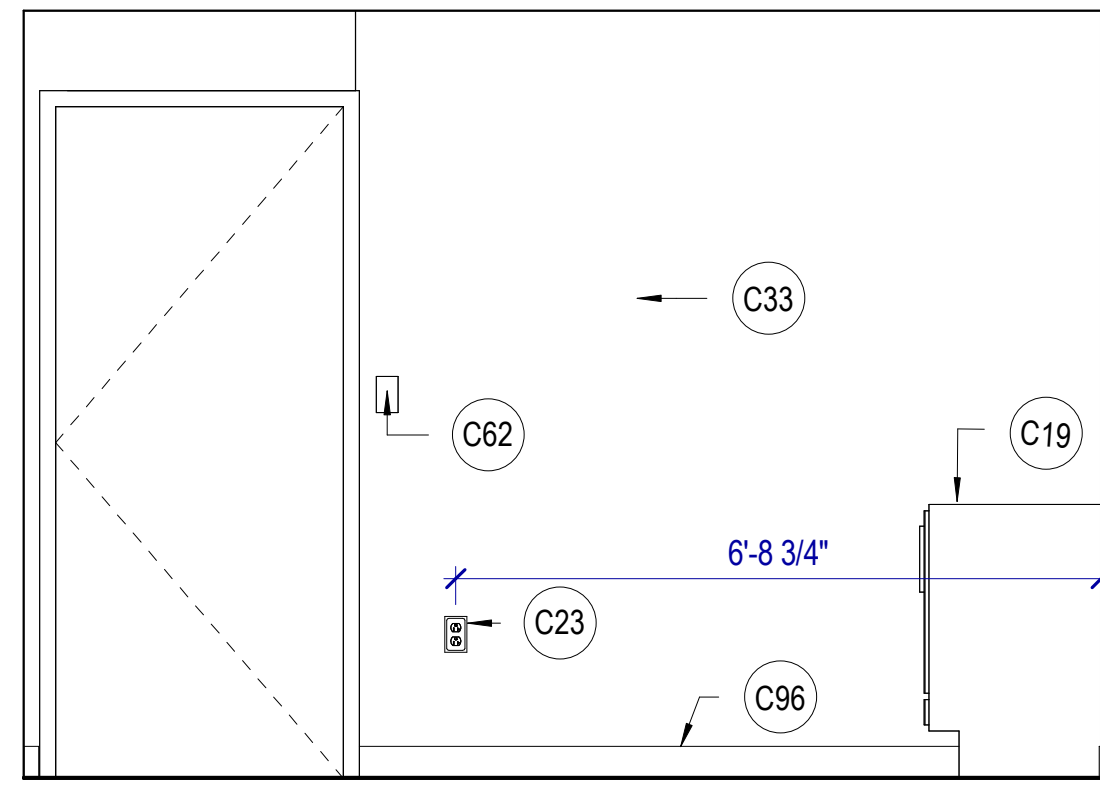


A2 PRIVATE OFFICE 127 NORTH
 SCALE: 1/2" = 1'-0"

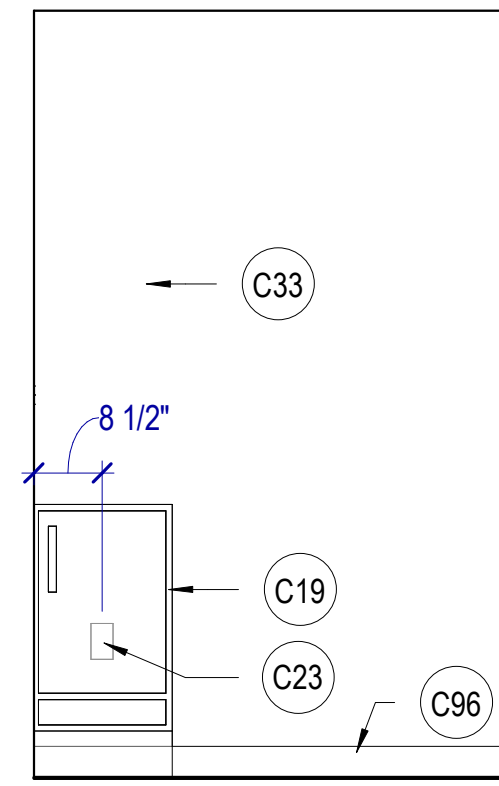


A3 PRIVATE OFFICE 127 EAST
 SCALE: 1/2" = 1'-0"

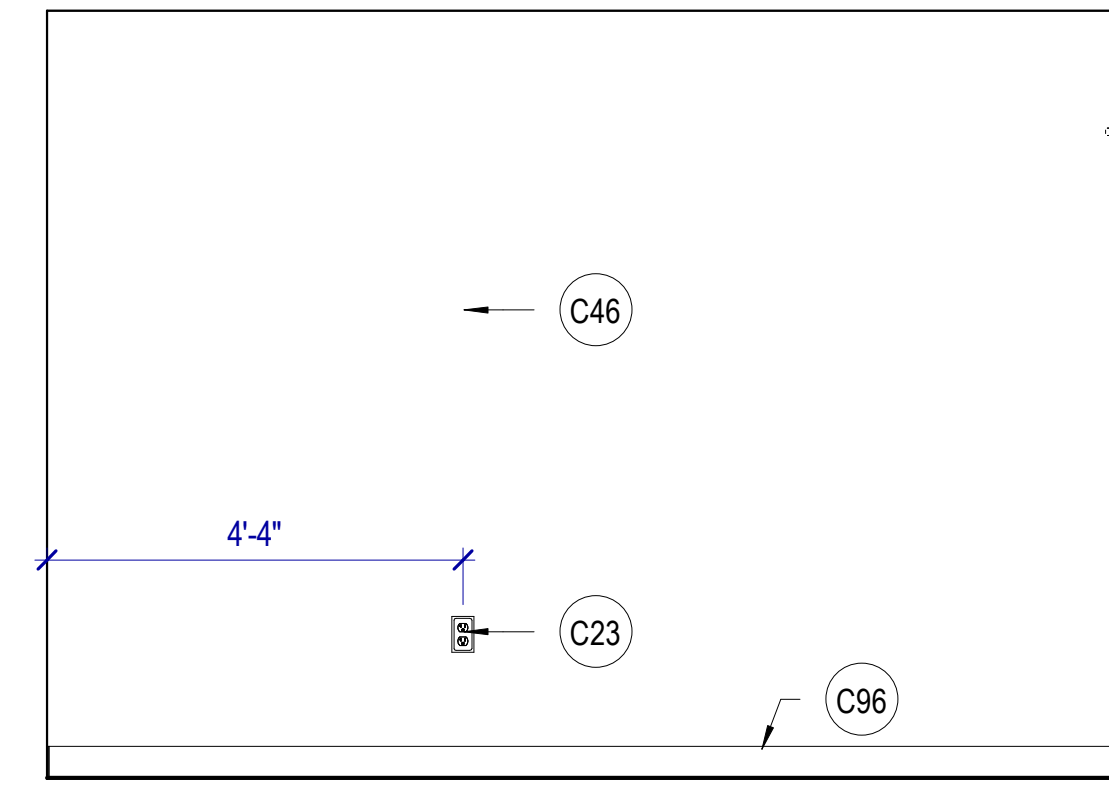


A4 PRIVATE OFFICE 127 SOUTH
 SCALE: 1/2" = 1'-0"

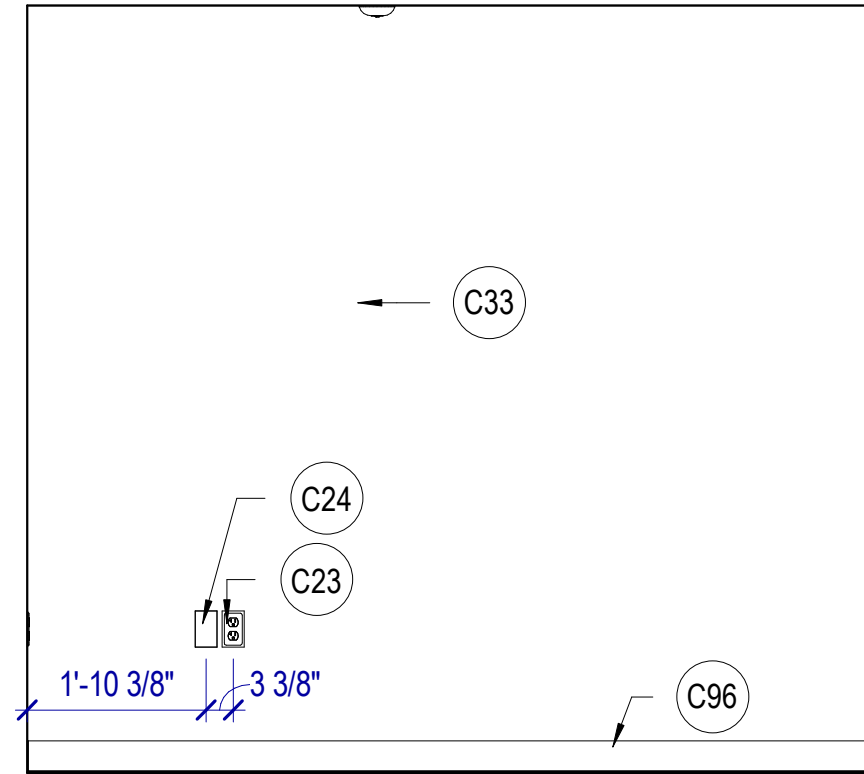


B1 TRAINING / OFFICE 128 WEST
 SCALE: 1/2" = 1'-0"

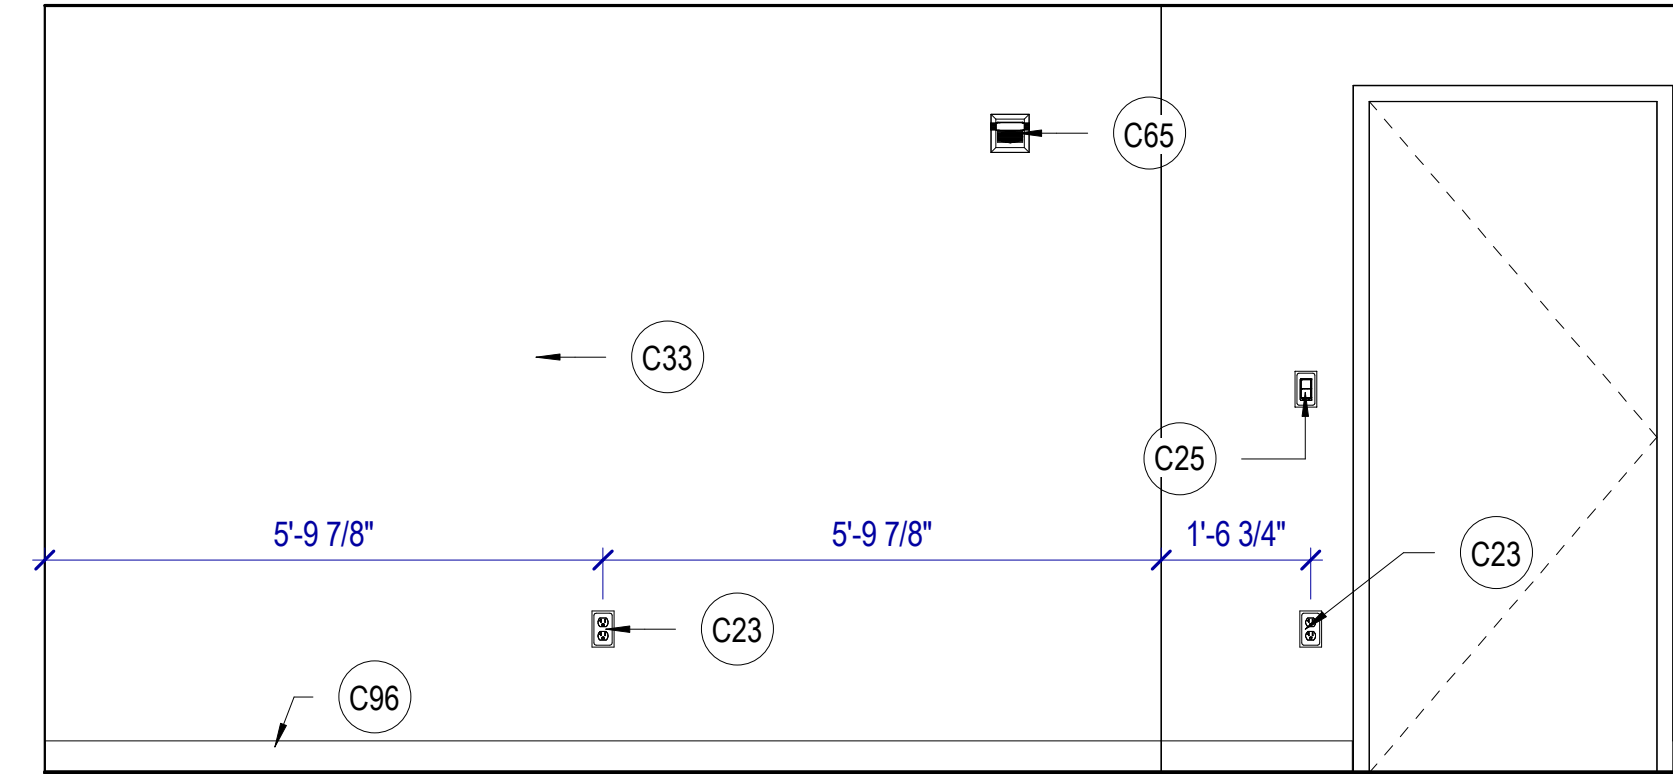

B2 TRAINING / OFFICE 128 NORTH
 SCALE: 1/2" = 1'-0"

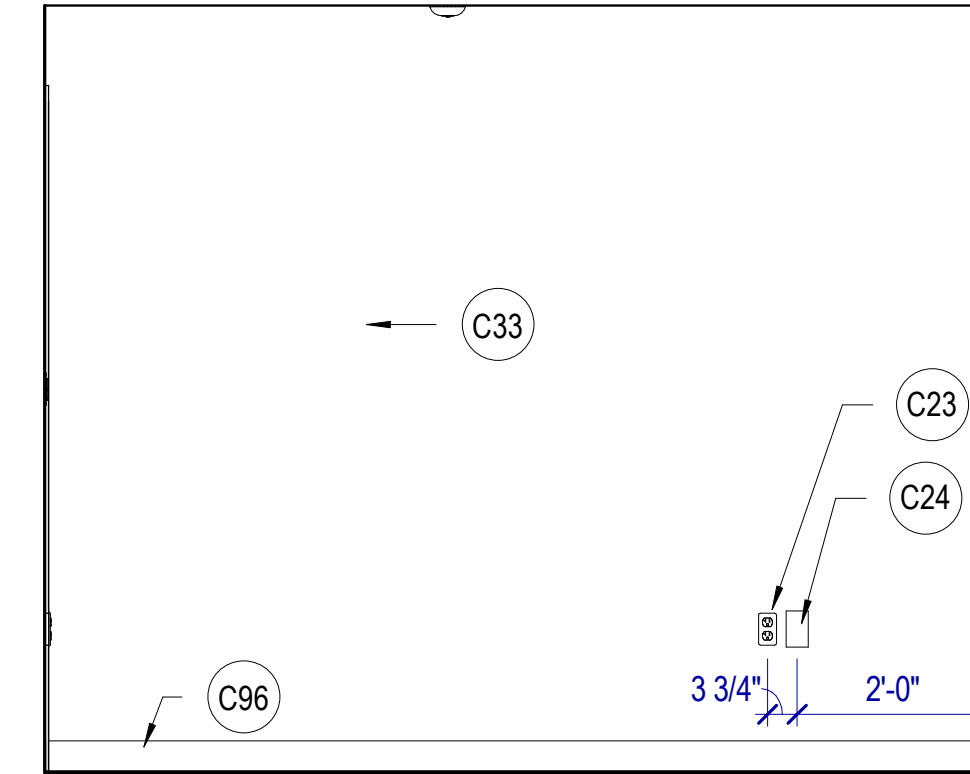

B3 TRAINING / OFFICE 128 EAST
 SCALE: 1/2" = 1'-0"

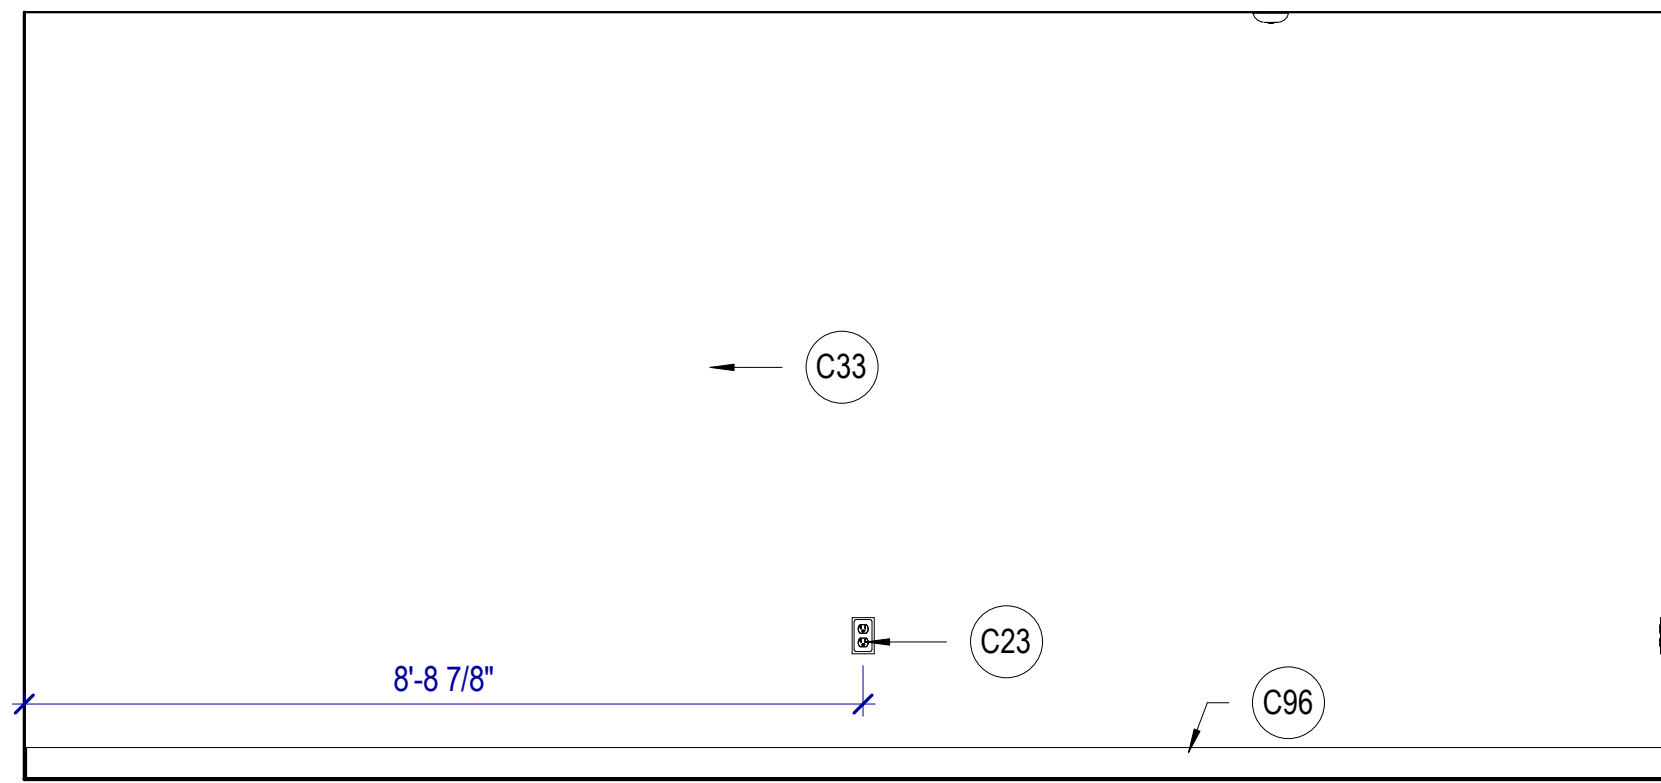

C1 TRAINING / OFFICE 128 SOUTH
 SCALE: 1/2" = 1'-0"

KEYNOTES

- C19 NEW LOW REFRIDGERATOR AND ELECTRICAL, FRIDGE NOT IN CONTRACT.
- C23 NEW POWER OUTLET OR RELOCATE EXISTING OUTLET, PLACE AT HEIGHT TO MATCH EXISTING UNLESS NOTED OTHERWISE. SEE ELECTRICAL
- C24 NEW DATA LOCATION OR RELOCATE EXISTING DATA, SEE ELECTRICAL.
- C25 NEW LIGHT SWITCH OR RELOCATE EXISTING SWITCH
- C33 NEW PAINT
- C46 NEW ACCENT PAINT AND BASE, SEE FINISH SCHEDULE.
- C62 NEW LIGHTS SWITCH, HEIGHT TO MATCH EXISTING, SEE ELECTRICAL
- C65 NEW FIRE BEACON, SEE ELECTRICAL
- C96 NEW BASE

SLCDA
NATIONAL WEATHER SERVICE TI
 SALT LAKE INTERNATIONAL AIRPORT
 SALT LAKE CITY, UTAH

©2023 MHTN ARCHITECTS, INC.
 Confidentiality Notice:
 This document is intended for use on the Project identified herein by individuals and companies involved in the design, permitting, bidding and construction of the Project. MHTN Architects, Inc. grants limited rights to distribute and reproduce this document for this express purpose only. Distribution, printing or copying this document for purposes other than those indicated is strictly prohibited. If a digital copy of this document is received in error, please delete it.



MHTN PROJECT NO 2023573
VIEW AND PRINT THIS DRAWING IN COLOR
 Original drawing is 24 x 36. Do not scale contents of this drawing.

ISSUED:	NO.	DATE	DESCRIPTION
	01	Oct 27, 2023	SCHEMATIC DESIGN
	02	Nov 14, 2023	60% CONSTRUCTION DOCS
	03	Dec 15, 2023	80% CONSTRUCTION DOCS
	04	Jan 31, 2024	100% CONSTRUCTION DOCS

REVISIONS			
CONTRACTOR TO VERIFY DRAWINGS IN FIELD USE REFLECT LAST REVISION DATE			
NO.	DATE	DESCRIPTION	
6	May 21, 2024	Appendum 01	

CONSTRUCTION DOCUMENTS - BID SET
 MAY 02, 2024

SHEET NAME
INTERIOR ELEVATIONS

SHEET NUMBER
A414

DOOR SCHEDULE GENERAL NOTES

RE: Division 8 Section "Door Hardware" for hardware sets.

Door Leaves: At each door, provide the number of leaves shown on the plans. Where two leaves are shown, provide equal leaves, UNO.


Frame Depth: Coordinate hollow metal frame depth with wall thickness, wrapping stud framed walls. Provide depths as scheduled for masonry walls, UNO.

Abbreviations: Door and Frame Schedule Remarks abbreviations:


- ADA ADA Actuator
- CR Card Reader
- DE Delayed Egress
- EL Electric Latch
- ES Electric Strike
- MO Motor Operation
- MHO Magnetic Hold Open

DOOR AND FRAME SCHEDULE										
DOOR #	TYPE	DOOR				FRAME		REMARKS		
		WIDTH	HEIGHT	THICKNESS	MATERIAL	TYPE	MATERIAL			
104	F	3'-0"	7'-0"	1 3/4"		1	TME	RELOCATED DOOR & FRAME, CLOSER, HARDWARE TME		
106	F	3'-0"	7'-0"	1 3/4"		1	TME	NEW DOOR, CLOSER, HARDWARE TME W/ NEW VACANCY/OCCUPANCY LOCK. ADD ALT. 01		
127	F	3'-0"	7'-0"	1 3/4"		1	TME	NEW DOOR, CLOSER, HARDWARE TME W/ NEW VACANCY/OCCUPANCY LOCK		
128	F	3'-0"	7'-0"	1 3/4"		1	TME	NEW DOOR, CLOSER, HARDWARE TME		
129	F	3'-0"	7'-0"	1 3/4"		1	TME	DOOR AND HARDWARE RELOCATED FROM CORRIDOR 100B		
Grand total: 5										


INTERIOR WALL TYPE SCHEDULE											
TAG	DESCRIPTION	CONSTRUCTION	WIDTH	TERMINATION	LIMITING HEIGHT	HEAD DETAIL	BASE DETAIL	FIRE RESISTANCE	ACOUSTICAL		
MARK								FIRE RATING	STANDARD	SOUND BATT	STC
S3A	5/8" GB + 3 5/8" MTL STUD + 5/8" GB	4 7/8"	TO DECK	16'-6"						Yes	40
S3B	5/8" GB + 3 5/8" MTL STUD + 5/8" GB	4 7/8"	TO DECK	16'-6"						No	37
S3BX	5/8" GB + 3 5/8" MTL STUD	4 1/4"	TO DECK	15'-6"						No	

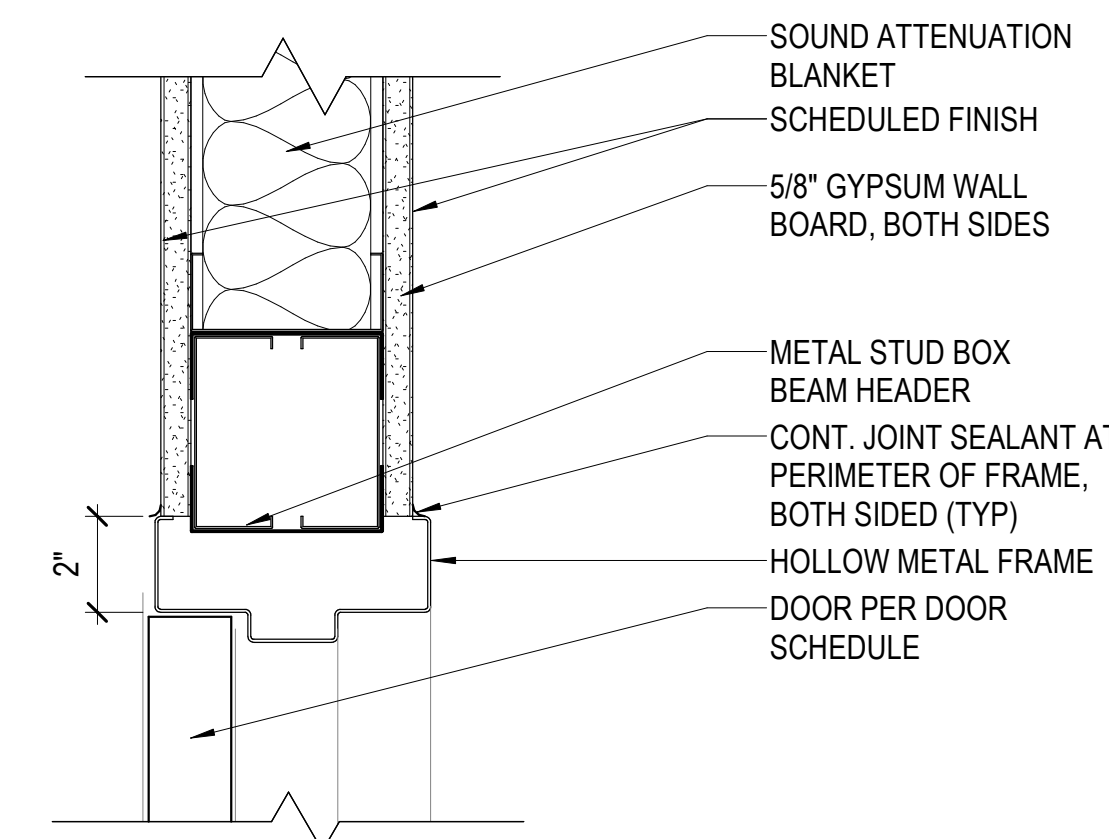


D3 DETAIL
SCALE: 3" = 1'-0"

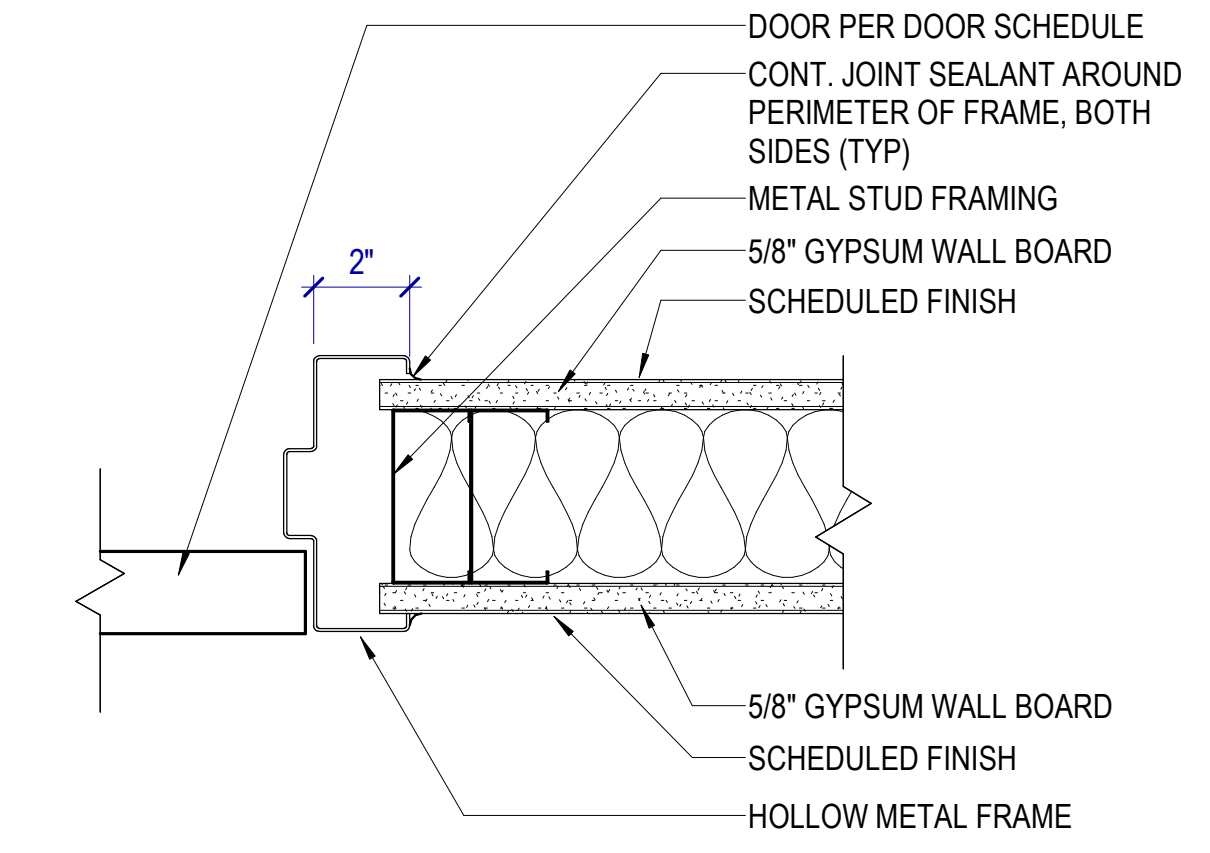


D4 DETAIL
SCALE: 3" = 1'-0"

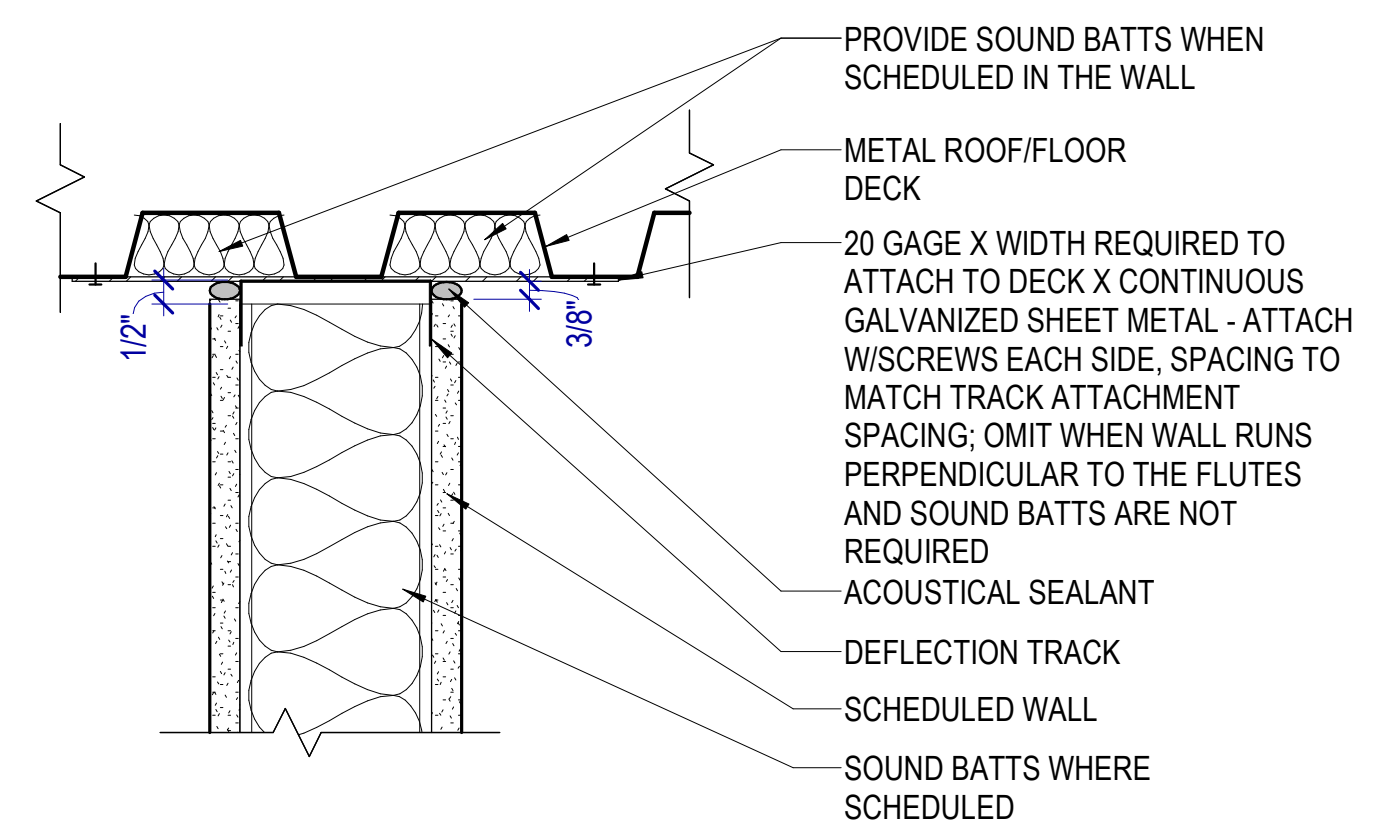

E2 NON-RATED WALL HEAD DETAIL
SCALE: 3" = 1'-0"

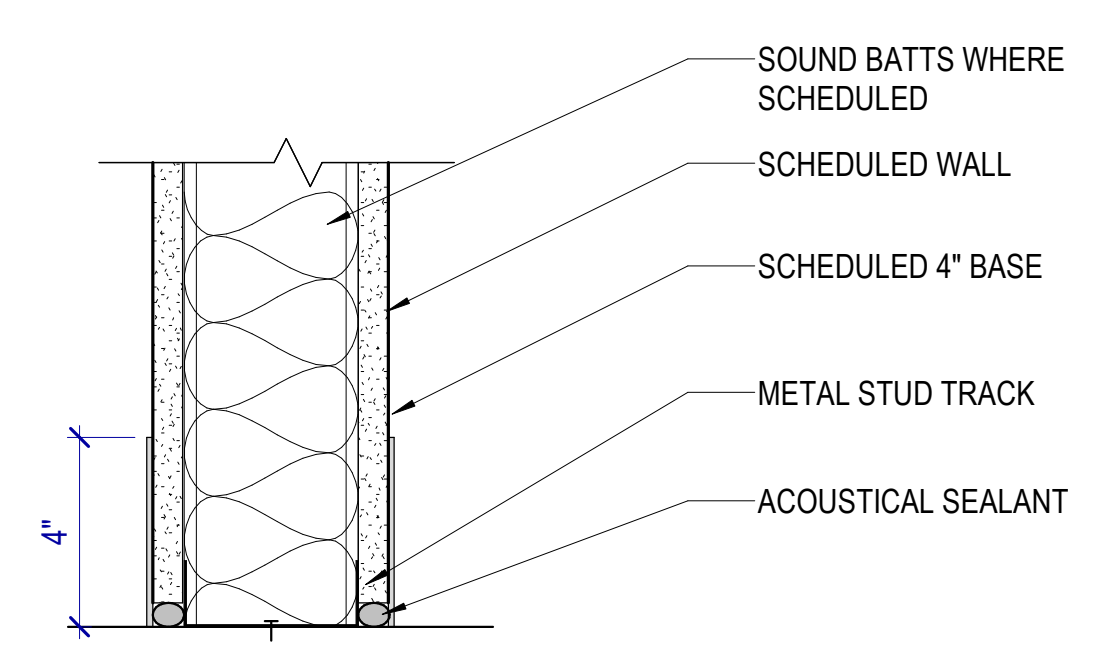

E3 WALL BASE DETAIL
SCALE: 3" = 1'-0"

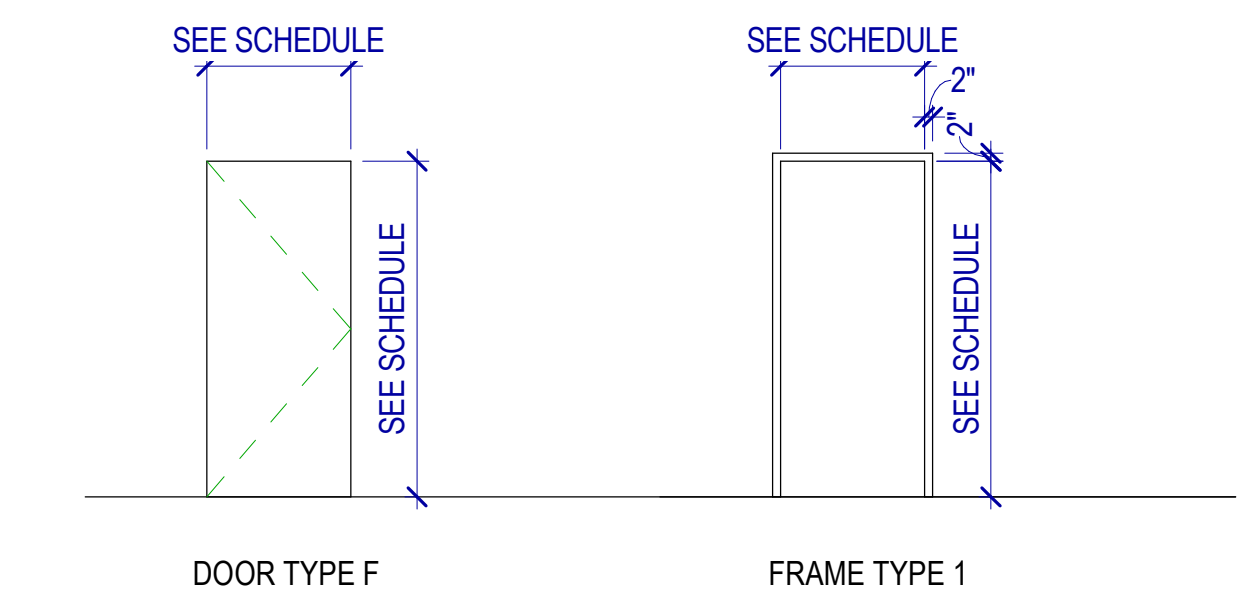

DOOR & FRAME TYPES

SLCDA NATIONAL WEATHER SERVICE TI
 SALT LAKE INTERNATIONAL AIRPORT
 SALT LAKE CITY, UTAH

82023 MHTN ARCHITECTS, INC.
 Confidentiality Notice:
 This document is intended for use on the Project identified herein by individuals and companies involved in the design, permitting, bidding and construction of the Project. MHTN Architects, Inc. grants limited rights to distribute and reproduce this document for this express purpose only. Distribution, printing or copying this document for purposes other than those indicated is strictly prohibited. If a digital copy of this document is received in error, please delete it.



MHTN PROJECT NO 2023573
VIEW AND PRINT THIS DRAWING IN COLOR
 Original drawing is 24 x 36. Do not scale contents of this drawing.

NO.	DATE	DESCRIPTION

REVISIONS
 CONTRACTOR TO VERIFY DRAWINGS IN FIELD USE REFLECT
 LAST REVISION DATE

NO.	DATE	DESCRIPTION
6	May 21, 2024	Addendum 01

CONSTRUCTION DOCUMENTS - BID SET
 MAY 02, 2024

SHEET NAME
DOOR, FRAME AND WALL TYPE SCHEDULE

SHEET NUMBER
A600

FINISH SCHEDULE LEGEND

FLOOR FINISHES

EF - EPOXY FLOORING
MANUFACTURER: DUDICK
STYLE: STER-QUARTZ T
COLOR: SQT106

VF1 - LINOLEUM TILE FLOORING
MANUFACTURER: MANNINGTON
STYLE: ABSTRACT
COLOR: STUCCO FLAX
SIZE: CUSTOM
INSTALLATION: ASPEKT LARGE

VF2 - LINOLEUM TILE FLOORING
MANUFACTURER: MANNINGTON
STYLE: ABSTRACT
COLOR: STUCCO INDIGO
SIZE: CUSTOM
INSTALLATION: ASPEKT LARGE

VF3 - LINOLEUM TILE FLOORING
MANUFACTURER: MANNINGTON
STYLE: STONE
COLOR: BASILICA SHALE
SIZE: CUSTOM
INSTALLATION: ASPEKT LARGE

CPT1 - GENERAL CARPET TILE
MANUFACTURER: MANNINGTON
STYLE: RPM RMX
COLOR: SWING
SIZE: 12"x36"
INSTALLATION: VERTICAL ASHLAR

CPT2 - ACCENT CARPET TILE
MANUFACTURER: MANNINGTON
STYLE: RPM RMX
COLOR: BLUEGRASS
SIZE: 12"x36"
INSTALLATION: VERTICAL ASHLAR

CPT3 - WALK-OFF
MANUFACTURER: MILLIKEN
STYLE: OBEX TILE CUT/STIPPLE STC 119
COLOR: DARK GREY
SIZE: 19.7"x19.7"
INSTALLATION: GRID

ESD - ELECTROSTATIC CONDUCTIVE TILE
MANUFACTURER: SCHLUTER
STYLE: ESD
COLOR: STRATUS BLUE/ 753
SIZE: 36" X 36"
INSTALLATION: GRID

**TRANSITION STRIP
(TO BE VERIFIED BY FLOORING CONTRACTOR)**

T1 - TRANSITION STRIP
MANUFACTURER: SCHLUTER
STYLE: SCHIENE
COLOR: ANODIZED ALUMINUM

T2 - TRANSITION STRIP
MANUFACTURER: MANNINGTON
STYLE: FUSION RUBBER TRANSITION
COLOR:

T3 - TRANSITION STRIP
MANUFACTURER: ROPPE
STYLE: TILE TO CARPET JOINER
COLOR:

BASES

RB - RUBBER BASE
MANUFACTURER: ROPPE
COLOR:
HEIGHT: 4"

WALL FINISHES

PT1 - GENERAL WALL: WATERBASED LATEX PAINT
MANUFACTURER: BENJAMIN MOORE
COLOR: GLACIER WHITE OC-37
FINISH: EG-SHELL

PT2 - WATERBASED LATEX PAINT
MANUFACTURER: BENJAMIN MOORE
COLOR: VAN DEUSEN BLUE/HC-156
FINISH: EG-SHELL

PT3 - WATERBASED LATEX PAINT
MANUFACTURER: SHERWIN WILLIAMS
COLOR: HALCYON GREEN/ SW6213
FINISH: EG-SHELL

PT4 - WATERBASED LATEX PAINT
MANUFACTURER: BEHR
COLOR: MATCH EXISTING
FINISH: EG-SHELL

PT5 - GENERAL CEILING: WATERBASED LATEX PAINT
MANUFACTURER: BENJAMIN MOORE
COLOR: GLACIER WHITE OC-37
FINISH: FLAT

EPT - EPOXY, WATERBASED
MANUFACTURER: BENJAMIN MOORE
COLOR: GLACIER WHITE OC-37
FINISH: EG-SHELL

WT1 - CERAMIC WALL TILE
MANUFACTURER: DAL TILE
PRODUCT: MULTITUDE
STYLE: FLAT / MU18
COLOR: URBAN GREY
SIZE: 12" x 24"
GROUT COLOR: MAPEI, 5002 PEWTER

WT2 - CERAMIC WALL TILE
MANUFACTURER: DAL TILE
PRODUCT: MULTITUDE
STYLE: RECTANGLE WAVE MU19
COLOR: NOSTALGIC BLUE
SIZE: 12" x 24"
GROUT COLOR: MAPEI, 5002 PEWTER

WT3 - WALL TILE TRIM
MANUFACTURER: ROPPE
PRODUCT: JOLLY
COLOR: SATIN ANODIZED

WP - WALL PROTECTION
MANUFACTURER:
PRODUCT:
COLOR:

CEILINGS

ACP1 - 12" X 12" ACOUSTICAL CEILING TILE
MANUFACTURER: ARMSTRONG
PRODUCT: CORTEGA ANGLED TEGULAR
COLOR: WHITE

GB1 - PAINTED GYPSUM BOARD, BENJAMIN MOOR GLACIER WHITE OC-37

GB2 - EPOXY PAINTED GYPSUM BOARD, BENJAMIN MOOR GLACIER WHITE OC-37

CABINET

PL1 - PLASTIC LAMINATE
MANUFACTURER: WILSONART
COLOR: GREY ELM 8201
FINISH: 12

PL2 - PLASTIC LAMINATE
MANUFACTURER: WILSONART
COLOR: CLASSIC LINEN 4943
FINISH: 38

FEN - FENOLIC
MANUFACTURER: ASI
COLOR: PASTEL GREY #3074
FINISH: #3074

COUNTER TOP

OZ - QUARTZ COUNTERTOP
MANUFACTURER: CAMBRIA
COLOR: PORTRUSH

SS - SOLID SURFACE
MANUFACTURER: CORIAN
COLOR: JUNIPER

MISC

DOOR FRAME
DF - PAINTED FINISH, MATCH EXISTING

DOORS
D1 - MATCH EXISTING WOOD, STAIN AND FINISH

FINISH SCHEDULE GENERAL NOTES

RE: A610 for typical floor finish transition details

RE: A651 for Floor Pattern Plans

Finishes

Provide finishes as indicated in the finish schedule. Refer to interior elevations, where drawn, for clarification, dimensions and additional information. The absence of an interior elevation does not override the requirement to provide the finish indicated in the schedule.

Where a finish is partly hidden by an object, extend that finish behind the object.

Where multiple finishes are scheduled, refer to interior elevations and floor pattern plans for transition locations.

Floor: Extend floor finishes into knee spaces at cabinets, under counters and under all other objects, which in a floor plan view may obscure the extent of the floor finish.

Base: Where base is scheduled for a room, provide base at all walls whether shown in elevation, including alcoves and offsets. At gypsum board walls, if no base is scheduled or shown in interior elevations, provide 4" rubber base.

Walls: Extend wall finishes behind cabinets, behind mirrors, and into other areas that may be hidden in elevation views.

Ceilings: Paint areas above suspended ceilings that are visible from below. Color: black.

Doors, Windows and Frames: Unless specified to be pre-finished at the factory, provide paint finish on hollow metal doors and hollow metal door and window frames. Color as indicated, or if not indicated, then as selected by the Architect. Provide specified stain finish at wood doors.

Unfinished and Primed Metal Surfaces: Paint all unfinished and primed metal surfaces that are visible with the specified system(s). Color by Architect.

Standing and Running Trim: Provide specified stain finish at wood trim.

Floor Finish Transitions at Doors: Locate floor finish material transitions that occur at doors under the center of the door, UNO.

Floor Drains: Coordinate location of floor drains with Plumbing drawings.

Typical Colors, UNO:

Walls: PT1
Doors: MATCH EXISTING
Frames: MATCH EXISTING

Seaming Diagrams: Provide diagrams for broadloom carpet and sheet flooring.

Wall Covering Seams: Apply wall covering to minimize seams, to provide equal panels and locate seams no closer than 1'-0" from corners.

ROOM FINISHES												
Area	Name	Number	CEILING FINISH	EAST WALL FINISH	NORTH WALL FINISH	WEST WALL FINISH	SOUTH WALL FINISH	COUNTER TOP FINISH	BASE FINISH	CABINET FINISH	FLOOR FINISH	NOTES
380 SF	RECEPTION	100	PT5	PT1	PT1	PT1	PT1	--	RB	--	CPT1/CPT2	
99 SF	VESTIBULE	100A	PT5	PT1	PT1	PT1	PT1		EXISTING TO REMAIN		CPT3	EXISTING FLOOR TILE TO REMAIN
790 SF	CORRIDOR	100B	EXISTING TO REMAIN	PT1/PT2	PT1/PT2/WP	PT1/PT2	PT1	--	RB	--	CPT1	
175 SF	HIC OFFICE	101	EXISTING TO REMAIN	PT1	PT1	PT1	PT1	--	RB	--	CPT1	
181 SF	MIC OFFICE	102	EXISTING TO REMAIN	PT1	PT1	PT1	PT1	--	RB	--	CPT1	
483 SF	CONFERENCE	103	ACP1	PT2	PT1	PT1	PT1	--	RB	--	CPT1/CPT2	
198 SF	WCM OFFICE	104	EXISTING TO REMAIN	PT4	PT1	PT1	PT4	--	RB	--	CPT1	TOUCH-UP EXISTING PAINT WHERE NEEDED
130 SF	SCH OFFICE	105	EXISTING TO REMAIN	PT1	PT1	PT1	PT1	--	RB	--	CPT1	
9 SF	COATS	106	PT5	PT1	PT1	PT1	PT1		RB		CPT1	
9 SF	COATS	106A	PT5	PT1	PT1	PT1	PT1		RB		CPT1	
130 SF	DOH OFFICE	107	EXISTING TO REMAIN	PT1	PT1	PT1	PT1	--	RB	--	CPT1	
9 SF	STORAGE	108	PT5	PT1	PT1	PT1	PT1		RB		CPT1	
10 SF	STORAGE	108A	PT5	PT1	PT1	PT1	PT1		RB		CPT1	
363 SF	BREAK ROOM	109	EXISTING TO REMAIN	PT1	PT1	PT1	PT1	--	RB	--	VF1-VF3	VINYL FLOOR PATTERNS
68 SF	STORAGE	110	OPEN TO STRUCTURE	PT1	PT1	PT1	PT1		RB		EF	BASE BID
41 SF	WEST ENTRANCE	110A	PT5	EXISTING TO REMAIN	PT1	EXISTING TO REMAIN	PT1		EXISTING TO REMAIN		CPT3	EXISTING FLOOR TILE TO REMAIN
39 SF	EAST ENTRANCE	112A	PT5	EXISTING TO REMAIN	PT1	EXISTING TO REMAIN	PT1		EXISTING TO REMAIN		CPT3	EXISTING FLOOR TILE TO REMAIN
1077 SF	ELEC TECH OPEN WORK AREA	114	EXISTING TO REMAIN	PT1	PT1	PT1/PT2	PT1/PT2		RB		ESD	
156 SF	ESA OFFICE	116	EXISTING TO REMAIN	PT1	PT1	PT1	PT1	--	RB	--	CPT1	
178 SF	WOMEN	118	EPT	EPT/WT1/WT2	EPT/WT1	EPT/WT1	EPT/WT1		RB		EF	
54 SF	JANITOR	120	EXISTING TO REMAIN	EXISTING TO REMAIN	EXISTING TO REMAIN	EXISTING TO REMAIN	EXISTING TO REMAIN		EXISTING TO REMAIN		EXISTING TO REMAIN	
175 SF	MEN	122	EPT	EPT/WT1	EPT/WT1	WPT/WT1/WT2	EPT/WT1		OZ		EF	
177 SF	SOO OFFICE	124	EXISTING TO REMAIN	PT1	PT1	PT1	PT1	--	RB	--	CPT1	
58 SF	CORRIDOR	126	ACP1	PT1	PT1	PT1	PT1	--	RB	--	CPT1	
59 SF	QUIET ROOM	127	ACP1	PT3	PT1	PT1	PT3		RB		CPT1	
157 SF	TRAINING / OFFICE	128	ACP1	PT1	PT1/PT2	PT1/PT2	PT1		RB		CPT1	
190 SF	STORAGE	129	OPEN TO STRUCTURE	PT1	PT1	PT1	PT1		RB WEST WALLS		EXISTING TO REMAIN	RUBBER RUBBER BASE ON NEW WALLS ONLY
2273 SF	WFO OPEN WORK AREA	130	EXISTING TO REMAIN	PT2	PT1	N/A	N/A		RB		EXISTING TO REMAIN	
2125 SF	RFC OPEN WORK AREA	131	EXISTING TO REMAIN	N/A	PT1	PT1	PT1		RB		EXISTING TO REMAIN	

ADD ALTERNATE 01												
68 SF	SHOWER	110	EPT	EPT/WT1	EPT/WT1	EPT/WT1	EPT/WT1				EF	



SLCDA
NATIONAL WEATHER SERVICE TI
SALT LAKE INTERNATIONAL AIRPORT
SALT LAKE CITY, UTAH

62023 MHTN ARCHITECTS, INC.
Confidentiality Notice: This document is intended for use on the Project identified herein by individuals and companies involved in the design, permitting, bidding and construction of the Project. MHTN Architects, Inc. grants limited rights to distribute and reproduce this document for the express purpose only. Distribution, printing or copying this document for purposes other than those indicated is strictly prohibited. If a digital copy of this document is received in error, please delete it.



MHTN PROJECT NO 2023573
VIEW AND PRINT THIS DRAWING IN COLOR
Original drawing is 24 x 36. Do not scale contents of this drawing.

NO.	DATE	DESCRIPTION

REVISIONS CONTRACTOR TO VERIFY DRAWINGS IN FIELD USE REFLECT LAST REVISION DATE




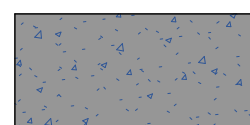
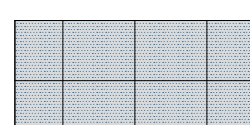
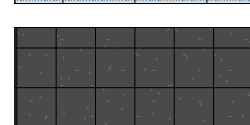
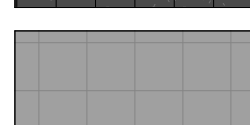

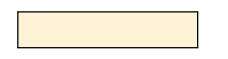







NO.	DATE	DESCRIPTION
6	May 21, 2024	Addendum 01

CONSTRUCTION DOCUMENTS - BID SET
MAY 02, 2024

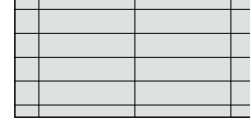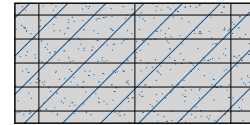SHEET NAME
FINISH SCHEDULE


SHEET NUMBER
A640

LEGEND - FLOOR PATTERN

-  CPT1 - GENERAL CARPET PLANK
-  CPT2 - ACCENT CARPET PLANK
-  LF - VINYL FLOOR
3 DIFFERENT COLORS
-  EF - EPOXY FLOORING
-  EDS1
-  WALK-OFF
-  EXISTING NOT CHANGING
-  T1 - TRANSITION STRIP
-  T2 - TRANSITION STRIP
-  T3 - TRANSITION STRIP
-  PT2 - NEW ACCENT PAINT
-  PT3 - NEW ACCENT PAINT
QUIET ROOM ONLY
-  EXISTING ACCENT PAINT
-  WT1 - WALL TILE
-  WT2 - WALL TILE
-  WP - WALL PROTECTION

PATTERN PLAN GENERAL NOTES

RE: A640 for the Finish Schedule.
 RE: A640 For Carpet Installation.
 RE: A610 for typical floor finish transition details
 RE: Structural drawings for recessed slabs.
Floor Finish Transitions at Doors: Locate floor finish material transitions that occur at doors under the center of the door, UNO.
Floor Drains: Coordinate location of floor drains with Plumbing drawings.

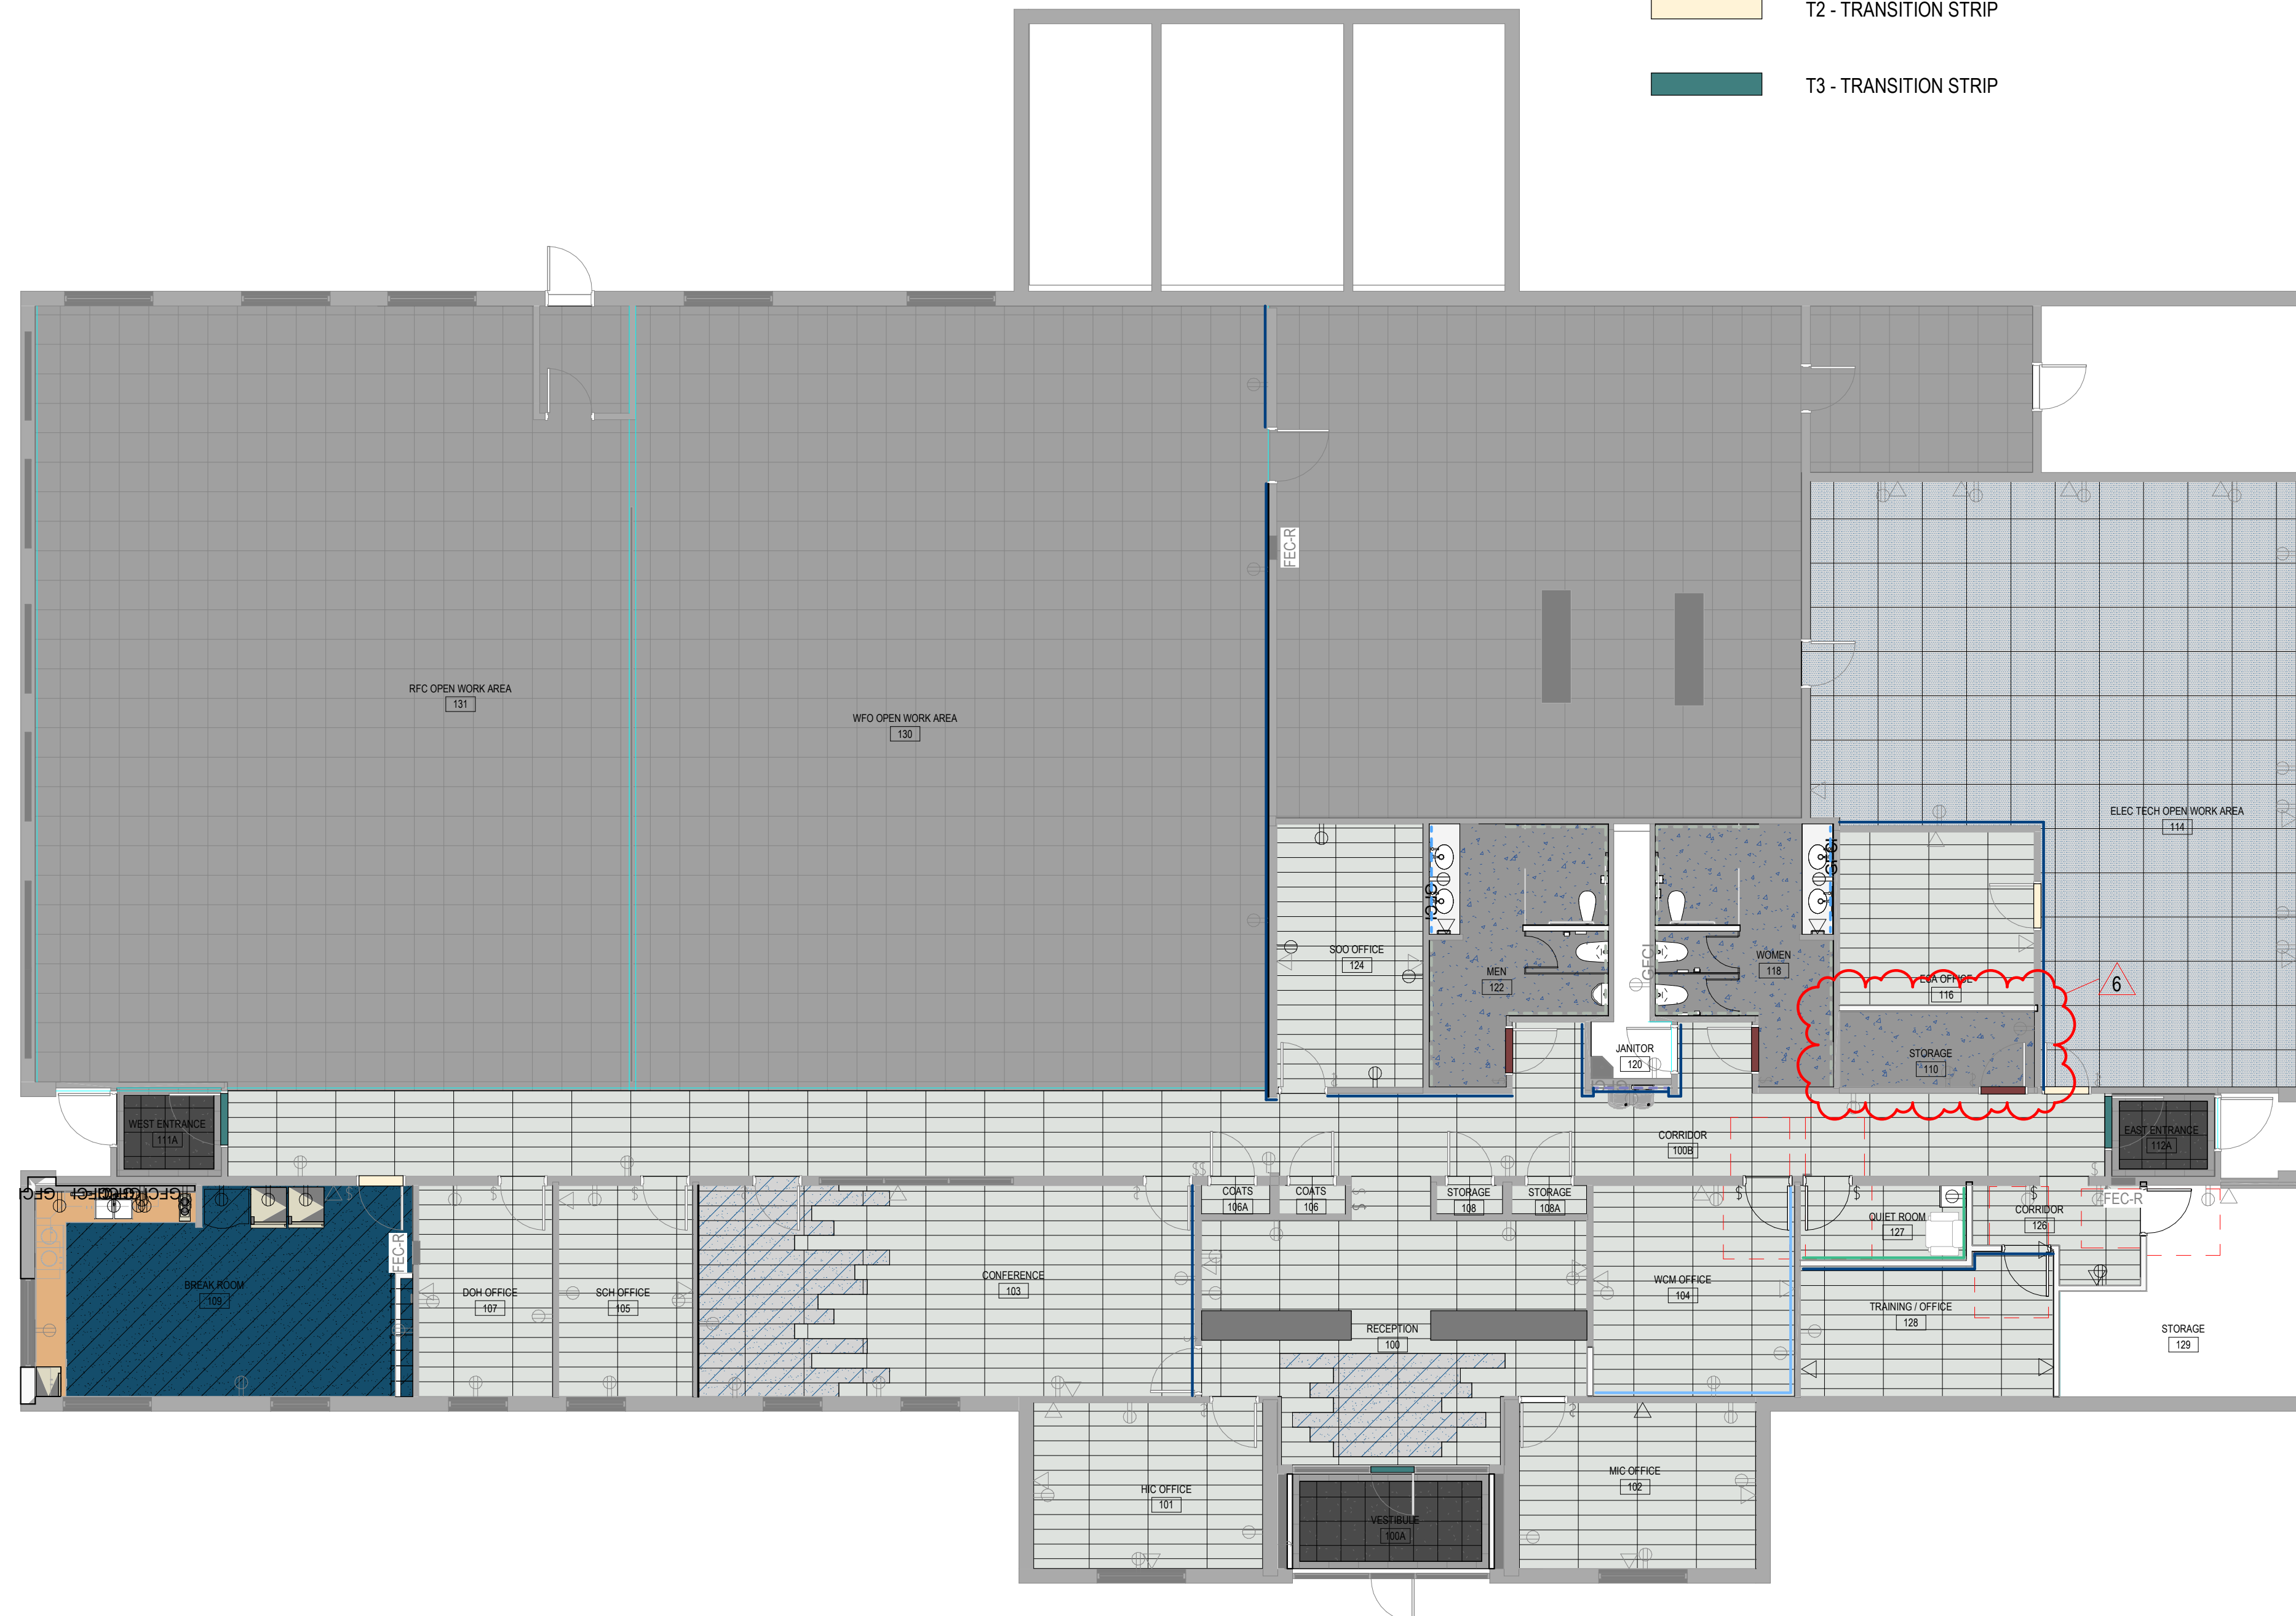

SLCDA
NATIONAL WEATHER SERVICE TI
 SALT LAKE INTERNATIONAL AIRPORT
 SALT LAKE CITY, UTAH

©2023 MHTN ARCHITECTS, INC.
 Confidentiality Notice:
 This document is intended for use on the Project identified herein by individuals and companies involved in the design, permitting, bidding and construction of the Project. MHTN Architects, Inc. grants limited rights to distribute and reproduce this document for this express purpose only. Distribution, printing or copying this document for purposes other than those indicated is strictly prohibited. If a digital copy of this document is received in error, please delete it.



MHTN PROJECT NO 2023573
VIEW AND PRINT THIS DRAWING IN COLOR
 Original drawing is 24 x 36. Do not scale contents of this drawing.

NO.	DATE	DESCRIPTION

REVISIONS
 CONTRACTOR TO VERIFY DRAWINGS IN FIELD USE REFLECT
 LAST REVISION DATE

NO.	DATE	DESCRIPTION
6	May 21, 2024	Addendum 01



CONSTRUCTION DOCUMENTS - BID SET
 MAY 02, 2024

SHEET NAME
FIRST FLOOR PATTERN PLAN

SHEET NUMBER
A651

FIRST FLOOR PATTERN PLAN

SCALE: 1/8" = 1'-0"

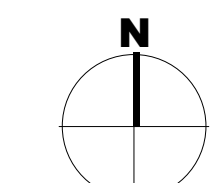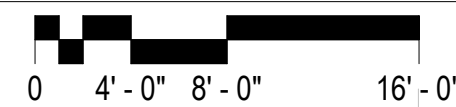

Autodesk Docs/2023573 SLCIA Airport NWSF TI/2023573 SLCIA Airport NWSF TI.rvt
 5/21/2024 1:00:19 PM

REFLECTED CEILING PLAN GENERAL NOTES

Ceiling Height: 9'-0" UNO. Where floor height varies in a room, ceiling height is shown at the entry to the room, UNO.

Ceiling Grid/Panel Alignment: The design intent of the Reflected Ceiling Plans is center ceiling grids or acoustical panels between walls in both directions, or to center grids in one direction, panels in the other. If the grid does not comply with the design intent, then coordinate with Architect to adjust the ceiling layout prior to installation.

Seismic Design Category: D: Heavy-duty suspension system required / Refer to Structural / Refer to Specifications.

Seismic Bracing: Rigid bracing required at ceilings over 1,000 SF and at all ceilings with fire sprinklers and other penetrations.

Seismic Control Joints: Provide seismic control joints in suspended acoustical ceilings greater than 2,500 SF.

Control Joints: Provide control joints in gypsum board ceilings at 30'-0" max spacing. Coordinate locations with Architect to align joints with other elements in the ceilings or on the walls.

Exposed Elements: Paint exposed structure, pipe, conduit and HVAC duct at open ceilings and at open areas around ceiling clouds. Color: As selected by Architect.

Walls to Deck: Extend all walls to deck, including all components of the wall assembly, UNO.


Fire Sprinklers: Center sprinkler heads in acoustical panels; run in straight lines in orthogonal, rectangular spaces.

Electrical, Mechanical and other Devices: Center in acoustical panels. Coordinate feature lighting layout with Architect prior to rough-in.

Keynotes: Not all keynotes apply to this sheet.

KEYNOTES

- C04 NEW WALL, PAINT, AND BASE
- C20 NEW ACOUSTIC DROP CEILING TO MATCH EXISTING, FIT AROUND EXISTING LIGHTING / OTHER CEILING ELEMENT.
- C32 NEW EPOXY PAINT
- C33 NEW PAINT
- C44 NEW EXHAUST FAN AND DUCTING
- C48 EXISTING WALL AT NEW CONSTRUCTION, ADD 5/8" GYPSUM BOARD ABOVE CEILING TILE TO DECK, TAPE AND MUD ABOVE ACOUSTIC CEILING

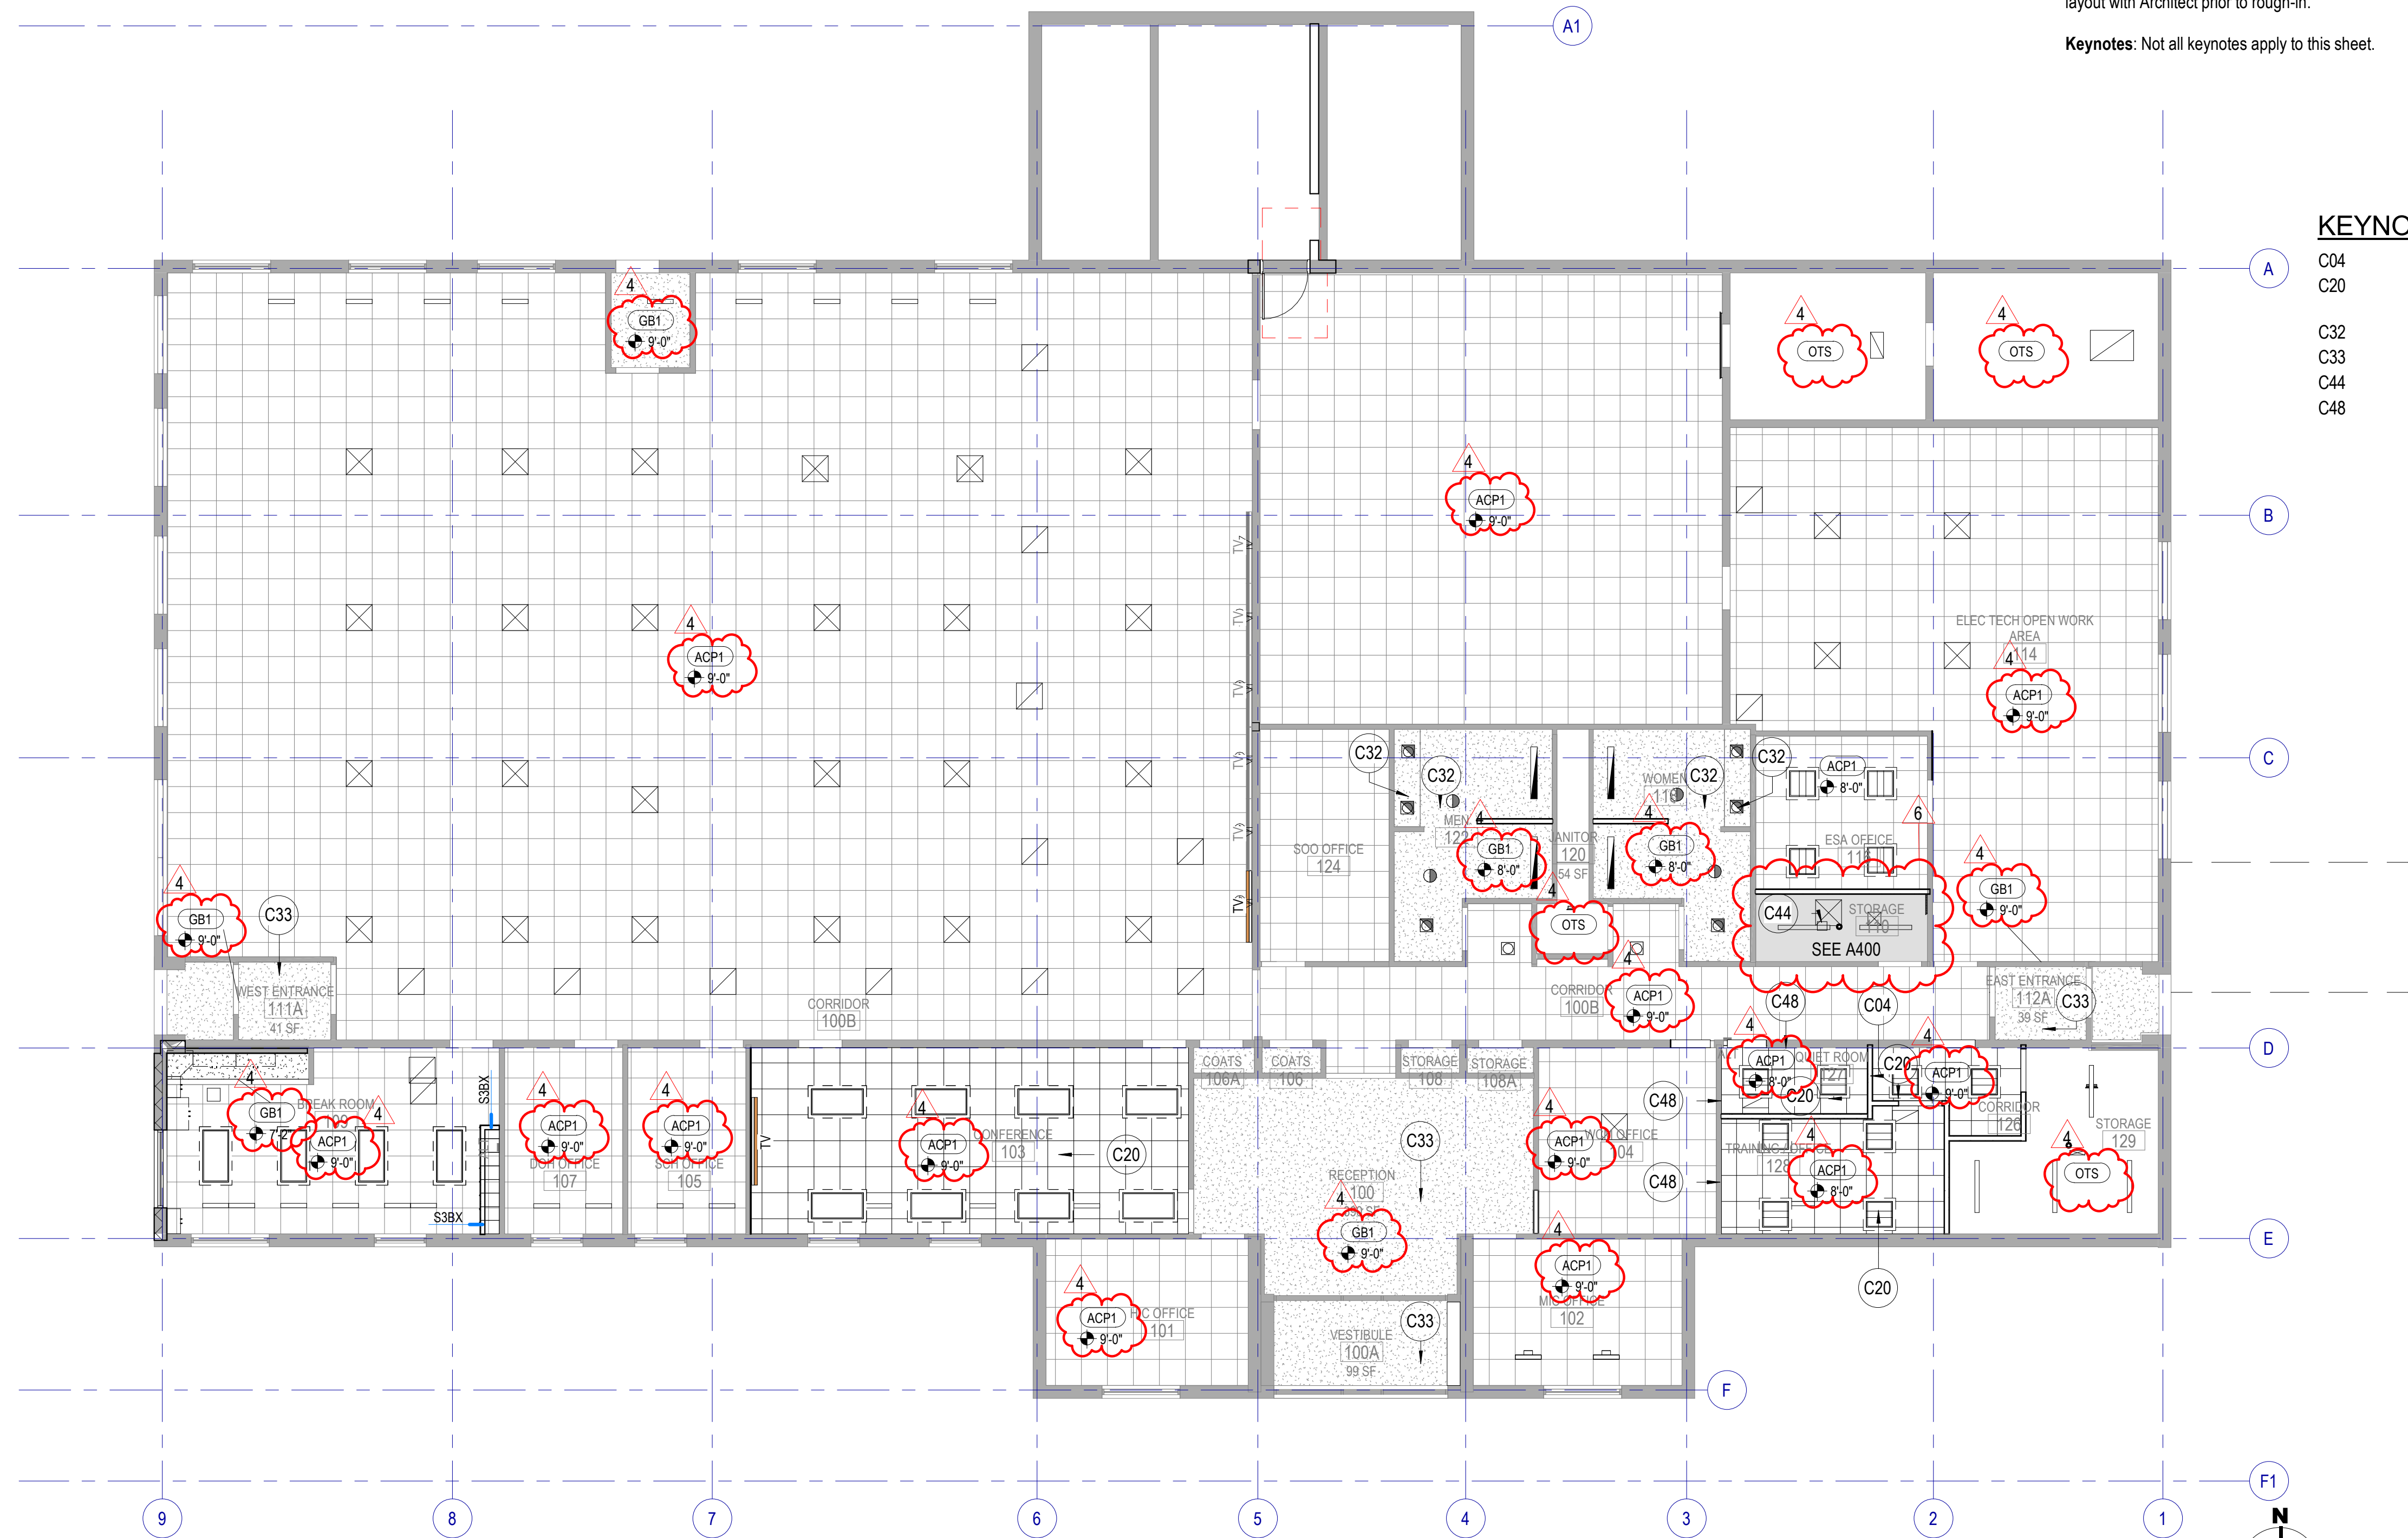

D1 FIRST FLOOR REFLECTED CEILING PLAN
 SCALE: 1/8" = 1'-0"

S/CLCDA
NATIONAL WEATHER SERVICE TI
 SALT LAKE INTERNATIONAL AIRPORT
 SALT LAKE CITY, UTAH

©2023 MHTN ARCHITECTS, INC.
 Confidentiality Notice:
 This document is intended for use on the Project identified herein by individuals and companies involved in the design, permitting, bidding and construction of the Project. MHTN Architects, Inc. grants limited rights to distribute and reproduce this document for the express purpose only. Distribution, printing or copying this document for purposes other than those indicated is strictly prohibited. If a digital copy of this document is received in error, please delete it.



MHTN PROJECT NO 2023573
VIEW AND PRINT THIS DRAWING IN COLOR
 Original drawing is 24 x 36. Do not scale contents of this drawing.

ISSUED:	NO.	DATE	DESCRIPTION
	01	Oct 27, 2023	SCHEMATIC DESIGN
	02	Nov 14, 2023	60% CONSTRUCTION DOCS
	03	Dec 15, 2023	80% CONSTRUCTION DOCS
	04	Jan 31, 2024	

REVISIONS	CONTRACTOR TO VERIFY DRAWINGS IN FIELD USE REFLECT
NO. DATE DESCRIPTION	LAST REVISION DATE
4 Apr 18, 2024 City Review Comments	
6 May 21, 2024 Appendix 01	


CONSTRUCTION DOCUMENTS - BID SET
 MAY 02, 2024

SHEET NAME
REFLECTED CEILING PLAN

SHEET NUMBER
A701

SLCDA NATIONAL WEATHER SERVICE T1 SALT LAKE INTERNATIONAL AIRPORT SALT LAKE CITY, UTAH

62023 MHTN ARCHITECTS, INC.
 Confidentiality Notice:
 This document is intended for use on the Project identified herein by individuals and companies involved in the design, permitting, bidding and construction of the Project. MHTN Architects, Inc. grants limited rights to distribute and reproduce this document for the express purpose only. Distribution, printing or copying this document for purposes other than those indicated is strictly prohibited. If a digital copy of this document is received in error, please delete it.

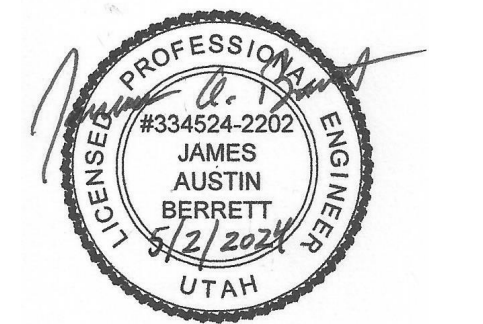

MHTN PROJECT NO 2023573
VIEW AND PRINT THIS DRAWING IN COLOR
 Original drawing is 24 x 36. Do not scale contents of this drawing.

NO.	DATE	DESCRIPTION


REVISIONS
 CONTRACTOR TO VERIFY DRAWINGS IN FIELD USE REFLECT LAST REVISION DATE.

NO.	DATE	DESCRIPTION
1	05-15-2024	Addendum 01


ISSUE
CONSTRUCTION DOCUMENTS - BID SET
 MAY 02, 2024


SHEET NAME
MECHANICAL FLOOR PLAN

SHEET NUMBER
M101

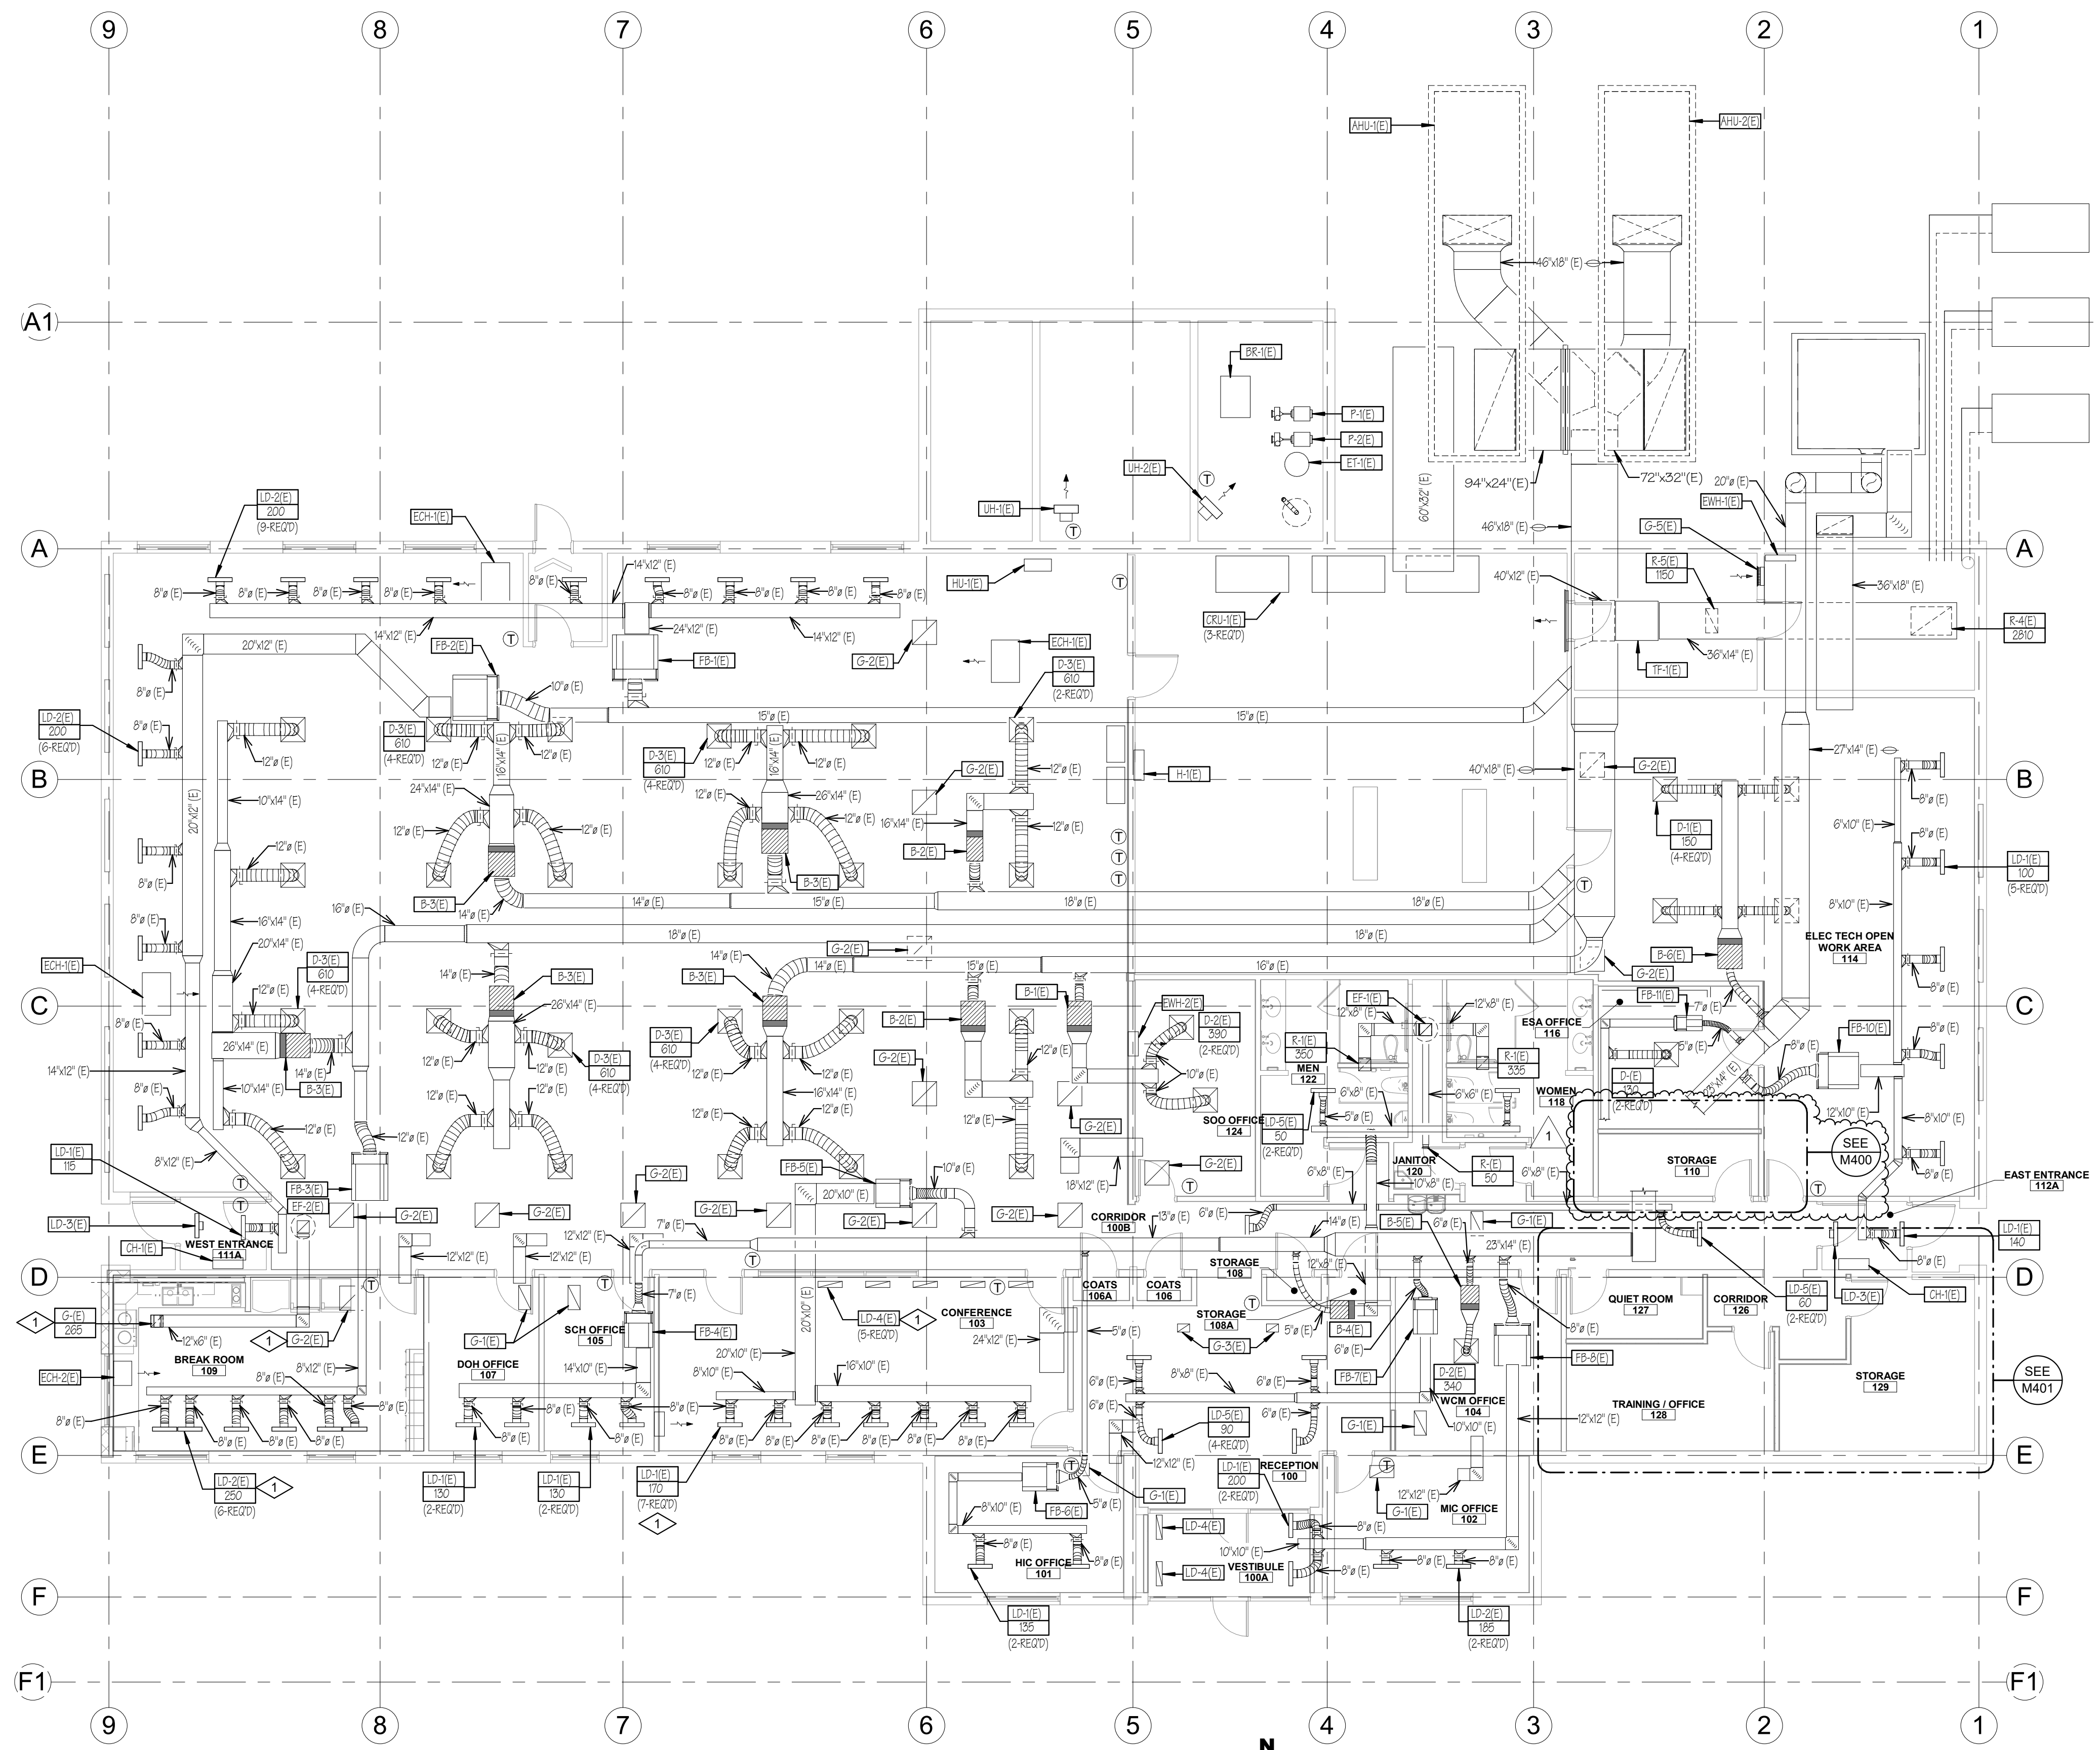

MECHANICAL FLOOR PLAN
 0 4' - 0" 8' - 0" 16' - 0"
 SCALE: 1/8" = 1'-0"

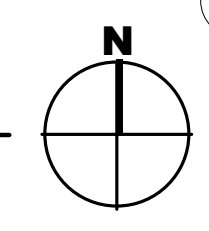

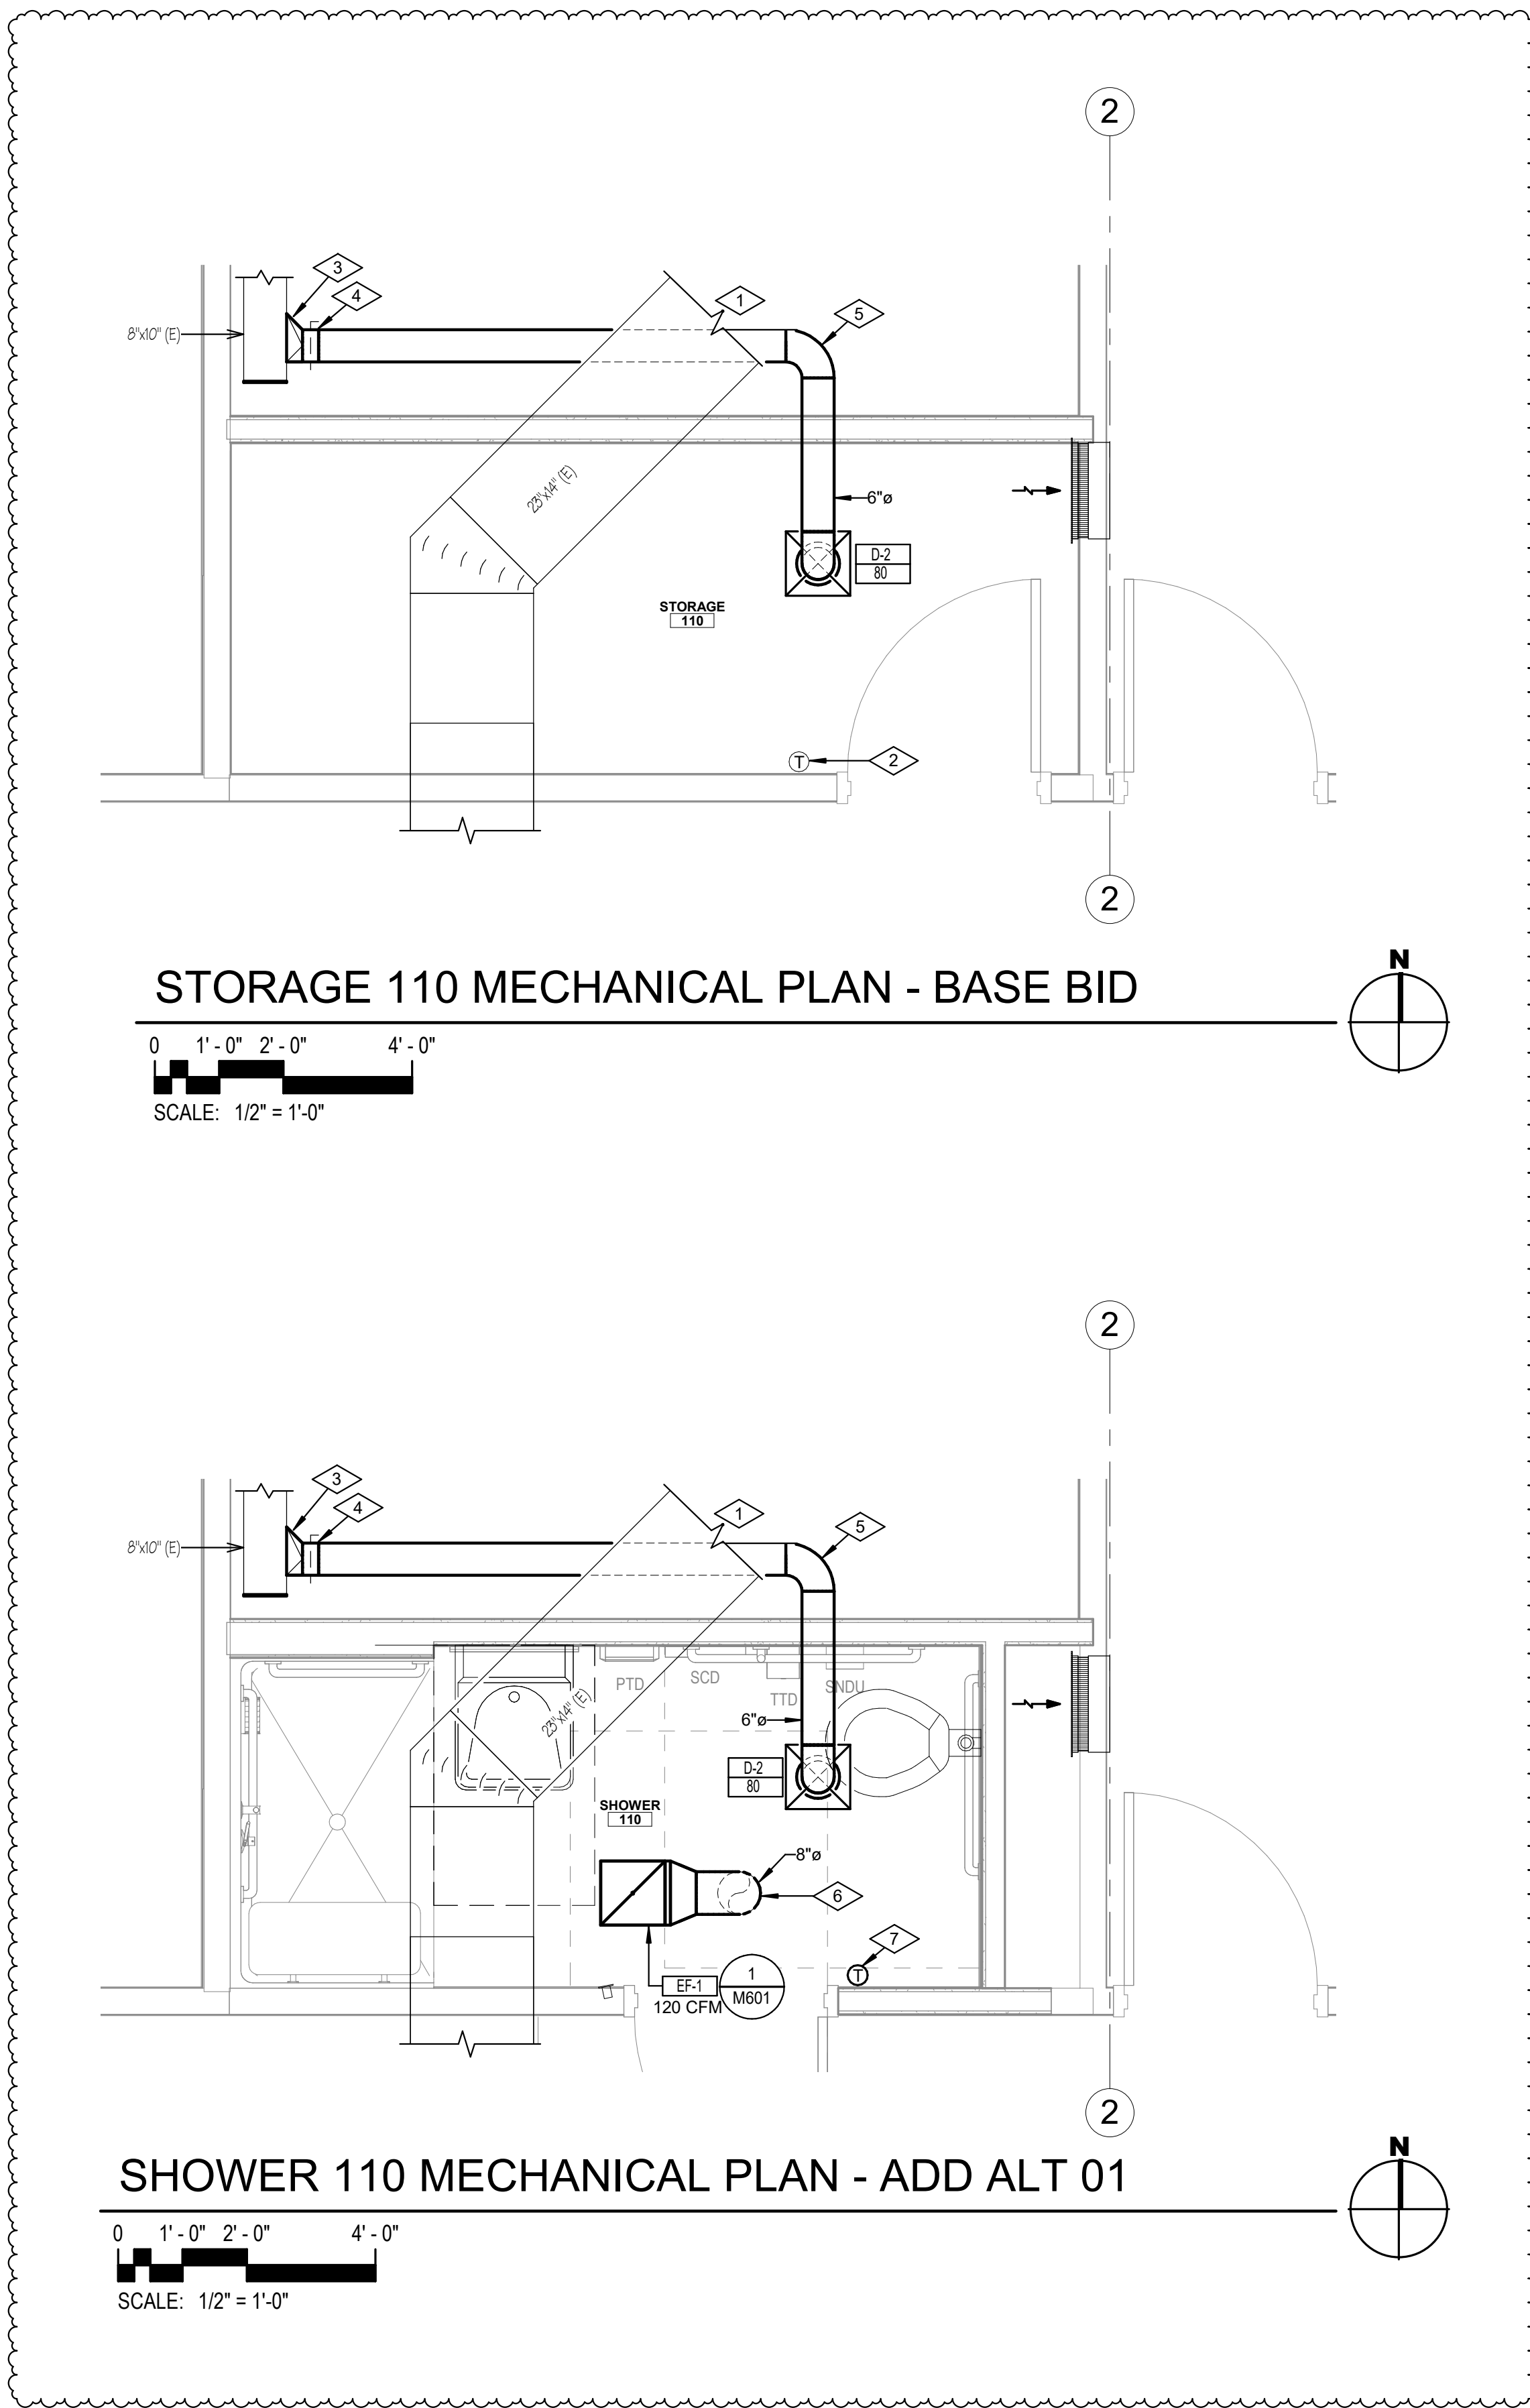


- REFERENCE NOTES**
- 1 EXISTING DUCTWORK TO REMAIN.
 - 2 EXISTING THERMOSTAT TO REMAIN.
 - 3 CONNECT TO EXISTING SUPPLY DUCT.
 - 4 HET FITTING WITH MANUAL BALANCING DAMPER.
 - 5 DUCT TO RUN ABOVE CEILING. COORDINATE WITH EXISTING CONDITION.
 - 6 NEW EXHAUST FAN; ROUTE EXHAUST UP THROUGH ROOF TO RAINPROOF CAP. SEE DETAIL 8/M601.
 - 7 RELOCATE EXISTING THERMOSTAT TO THIS APPROXIMATE LOCATION.

A CENTURY OF DESIGN
MHTN ARCHITECTS
 MHTN Architects, Inc.
 280 South 400 West
 Suite 250
 Salt Lake City, Utah 84101
 Telephone (801) 595-6700
 www.mhtn.com

OLSEN & PETERSON
 consulting engineers, inc.
 14 E. 2700 S. Salt Lake City, UT. 84115 Ph: (801) 486-4646

SLCDA
NATIONAL WEATHER SERVICE TI
SALT LAKE INTERNATIONAL AIRPORT
SALT LAKE CITY, UTAH

©2023 MHTN ARCHITECTS, INC.
 Confidentiality Notice:
 This document is intended for use on the Project identified herein by individuals and companies involved in the design, permitting, bidding and construction of the Project. MHTN Architects, Inc. grants limited rights to distribute and reproduce this document for this express purpose only. Distribution, printing or copying this document for purposes other than those indicated is strictly prohibited. If a digital copy of this document is received in error, please delete it.

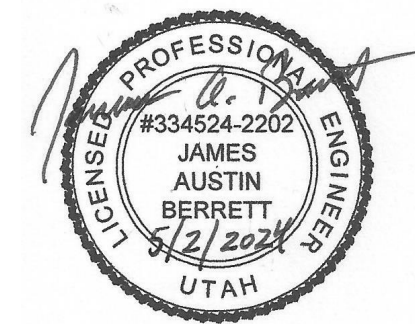

MHTN PROJECT NO.2023573
VIEW AND PRINT THIS DRAWING IN COLOR
 Original drawing is 24 x 36. Do not scale contents of this drawing.

ISSUED:

NO.	DATE	DESCRIPTION

REVISIONS
 CONTRACTOR TO VERIFY DRAWINGS IN FIELD USE REFLECT
 LAST REVISION DATE:


NO.	DATE	DESCRIPTION
1	05-15-2024	Addendum 01

ISSUE
CONSTRUCTION DOCUMENTS - BID SET
 MAY 02, 2024



SHEET NAME
PARTIAL MECHANICAL PLANS - ADD ALTERNATE 01

SHEET NUMBER
M400

- REFERENCE NOTES**
- 1 PROVIDE NEW FAN POWERED BOX AND ASSOCIATED DUCTWORK AND CONTROLS.
 - 2 PROVIDE NEW VAV BOX AND ASSOCIATED DUCTWORK AND CONTROLS.
 - 3 PROVIDE NEW LINEAR SLOT DIFFUSER, COORDINATE WITH OTHER PROJECT FOR CONNECTIONS SIZES.
 - 4 PROVIDE NEW HWS & HWR PIPING AS REQUIRED. PROVIDE NEW HW VALVE.
 - 5 NEW DIGITAL HEATING/COOLING THERMOSTAT.
 - 6 TRANSFER AIR DUCT. PROVIDE OPENINGS AT EACH END ON TOP FOR SOUND ATTENUATION.
 - 7 CONNECT NEW HWS AND HWR PIPING TO EXISTING AT APPROXIMATELY THIS LOCATION. REPAIR PIPE INSULATION AT TIE-IN.
 - 8 HET FITTING WITH MANUAL BALANCING DAMPER.

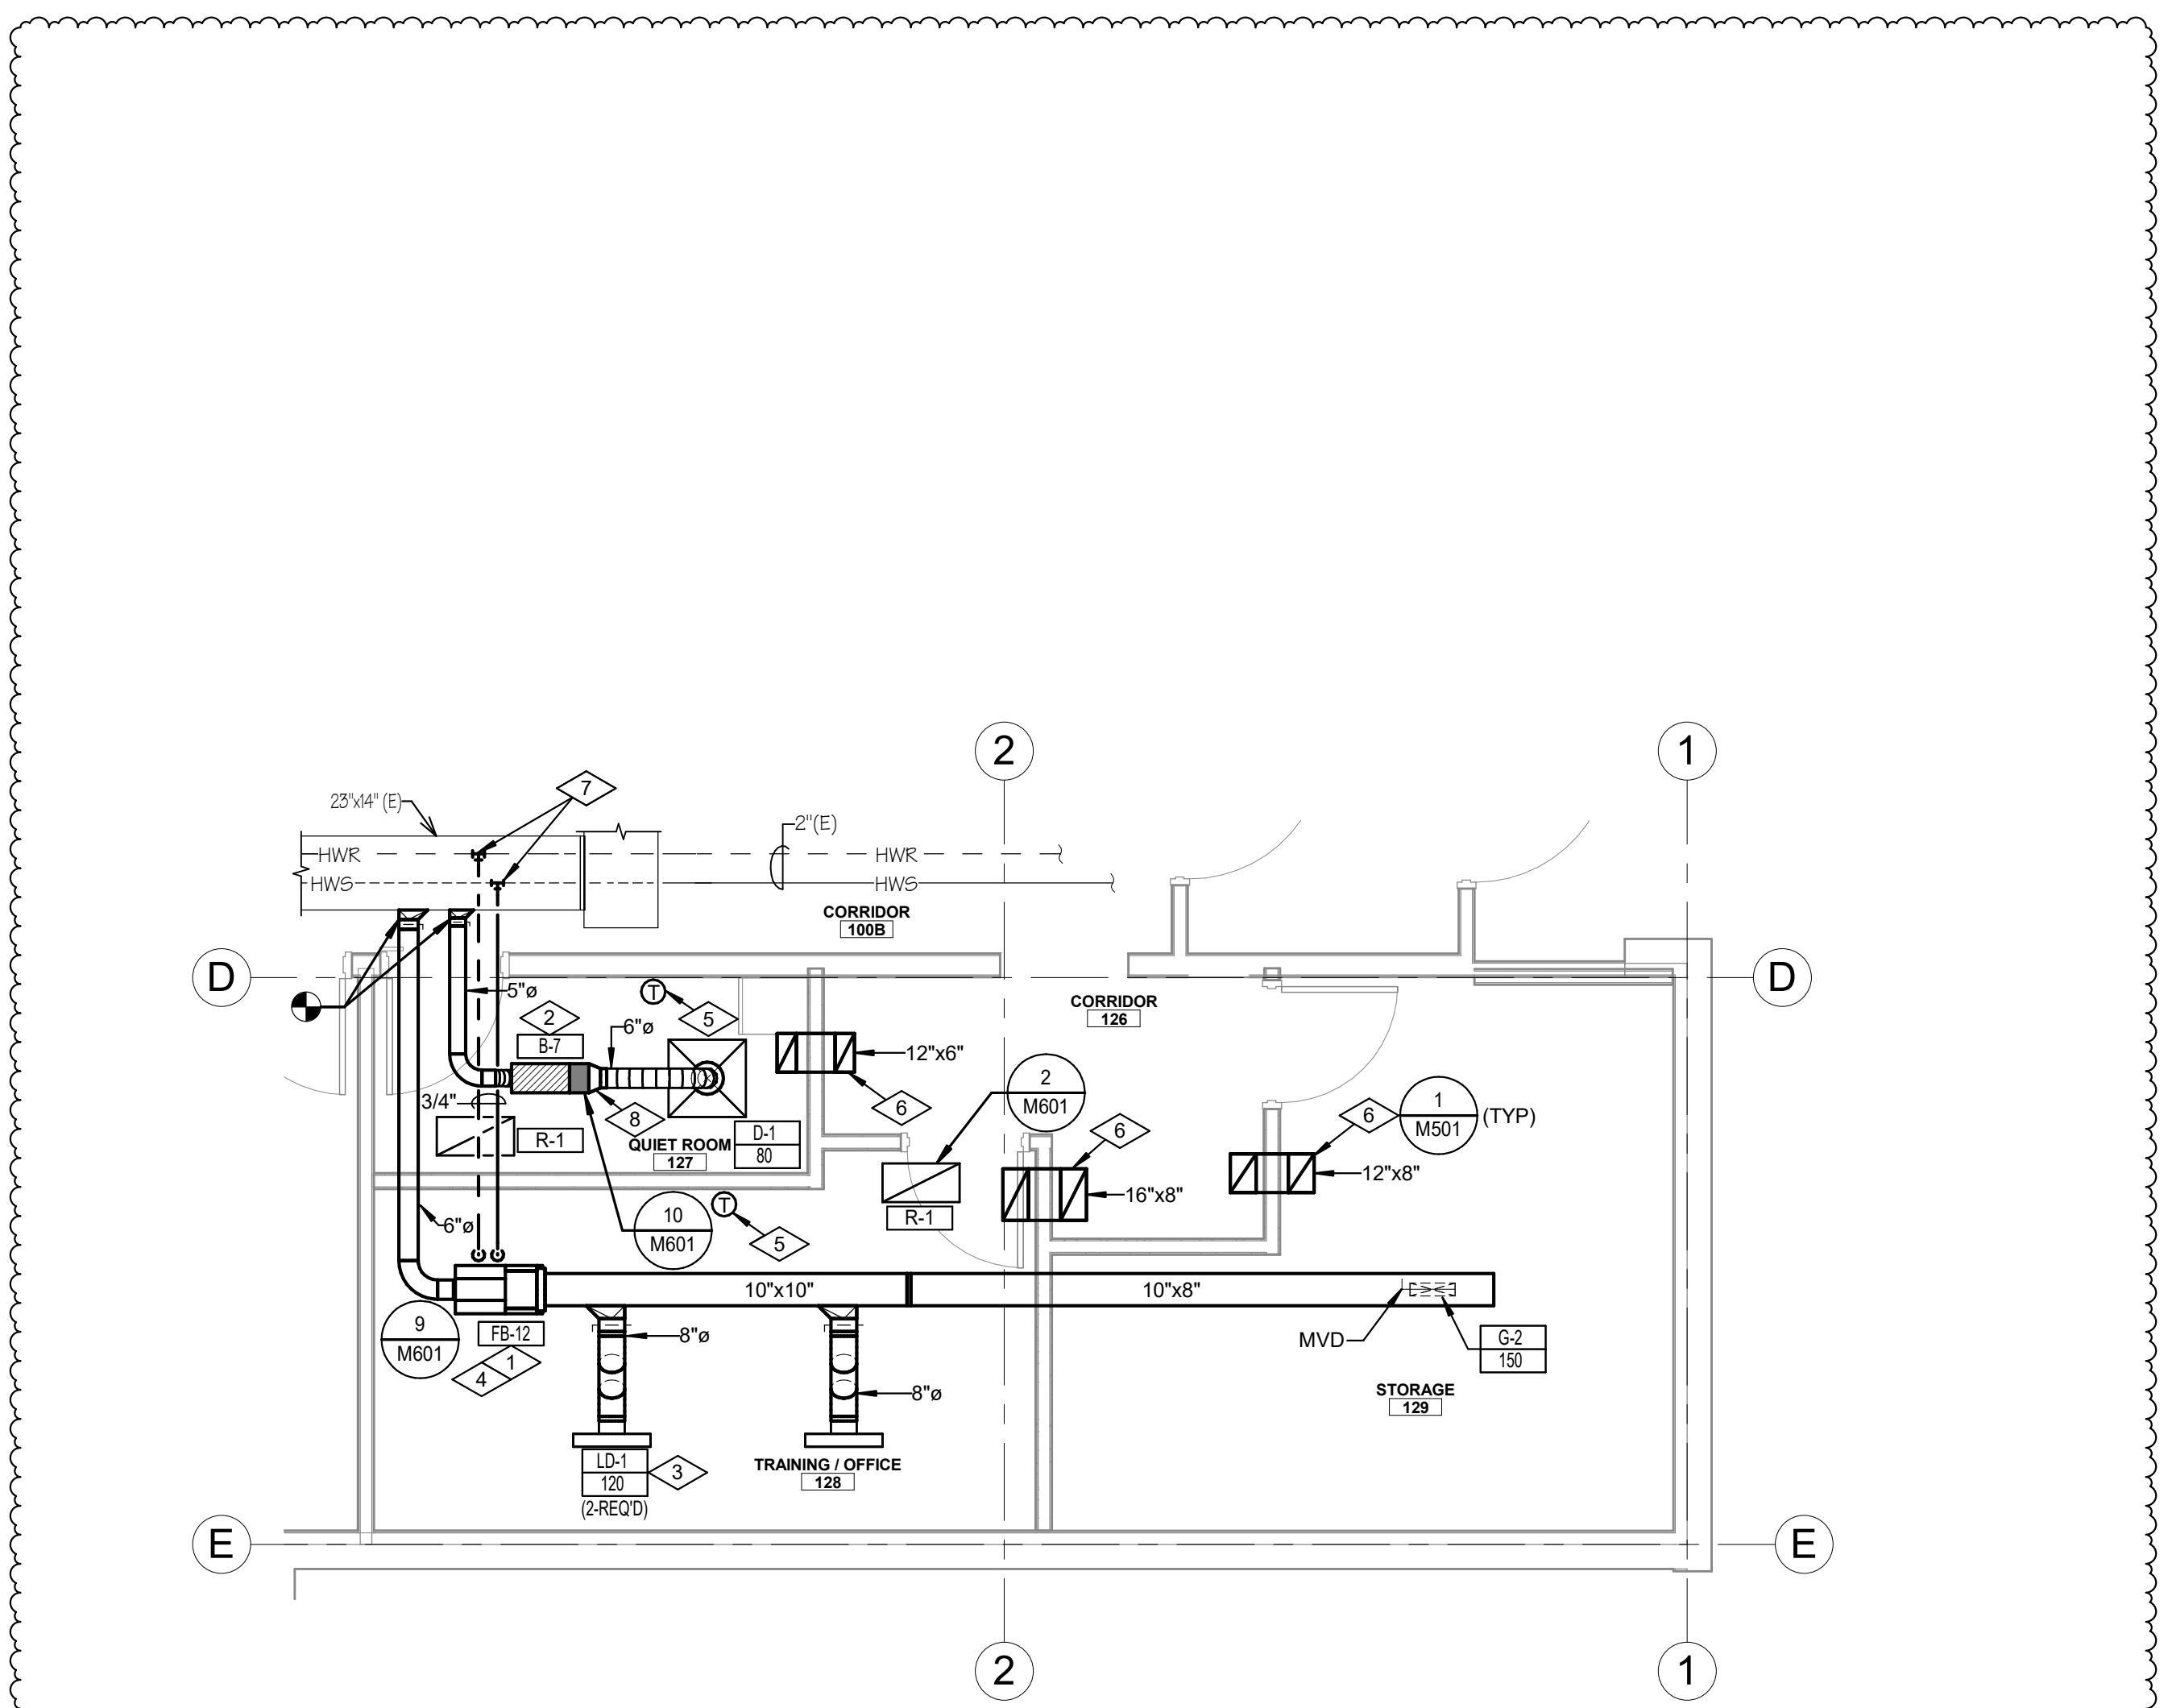


ENLARGED TRAINING/OFFICE & LACTATION NEW WORK MECH PLAN

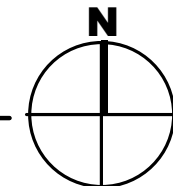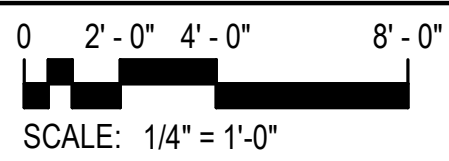

SLCDA
NATIONAL WEATHER SERVICE TI
SALT LAKE INTERNATIONAL AIRPORT
SALT LAKE CITY, UTAH

©2023 MHTN ARCHITECTS, INC.
 Confidentiality Notice:
 This document is intended for use on the Project identified herein by individuals and companies involved in the design, permitting, bidding and construction of the Project. MHTN Architects, Inc. grants limited rights to distribute and reproduce this document for this express purpose only. Distribution, printing or copying this document for purposes other than those indicated is strictly prohibited. If a digital copy of this document is received in error, please delete it.

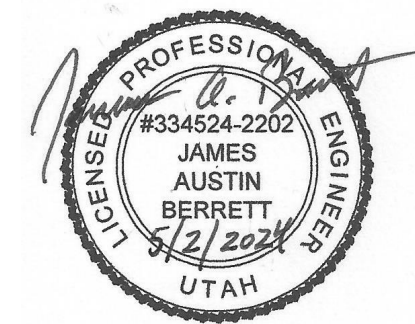

MHTN PROJECT NO. 2023573
VIEW AND PRINT THIS DRAWING IN COLOR
 Original drawing is 24 x 36. Do not scale contents of this drawing.

ISSUED:

NO.	DATE	DESCRIPTION

REVISIONS
 CONTRACTOR TO VERIFY DRAWINGS IN FIELD USE REFLECT LAST REVISION DATE.


NO.	DATE	DESCRIPTION
1	05-15-2024	Addendum 01

ISSUE
CONSTRUCTION DOCUMENTS - BID SET
MAY 02, 2024



SHEET NAME
ENLARGED MECHANICAL PLAN

SHEET NUMBER
M401

Autodesk Docs://2023573 SLCIA Airport NWSF TIM22 NWSF T1.rvt
5/21/2024 2:49:57 PM

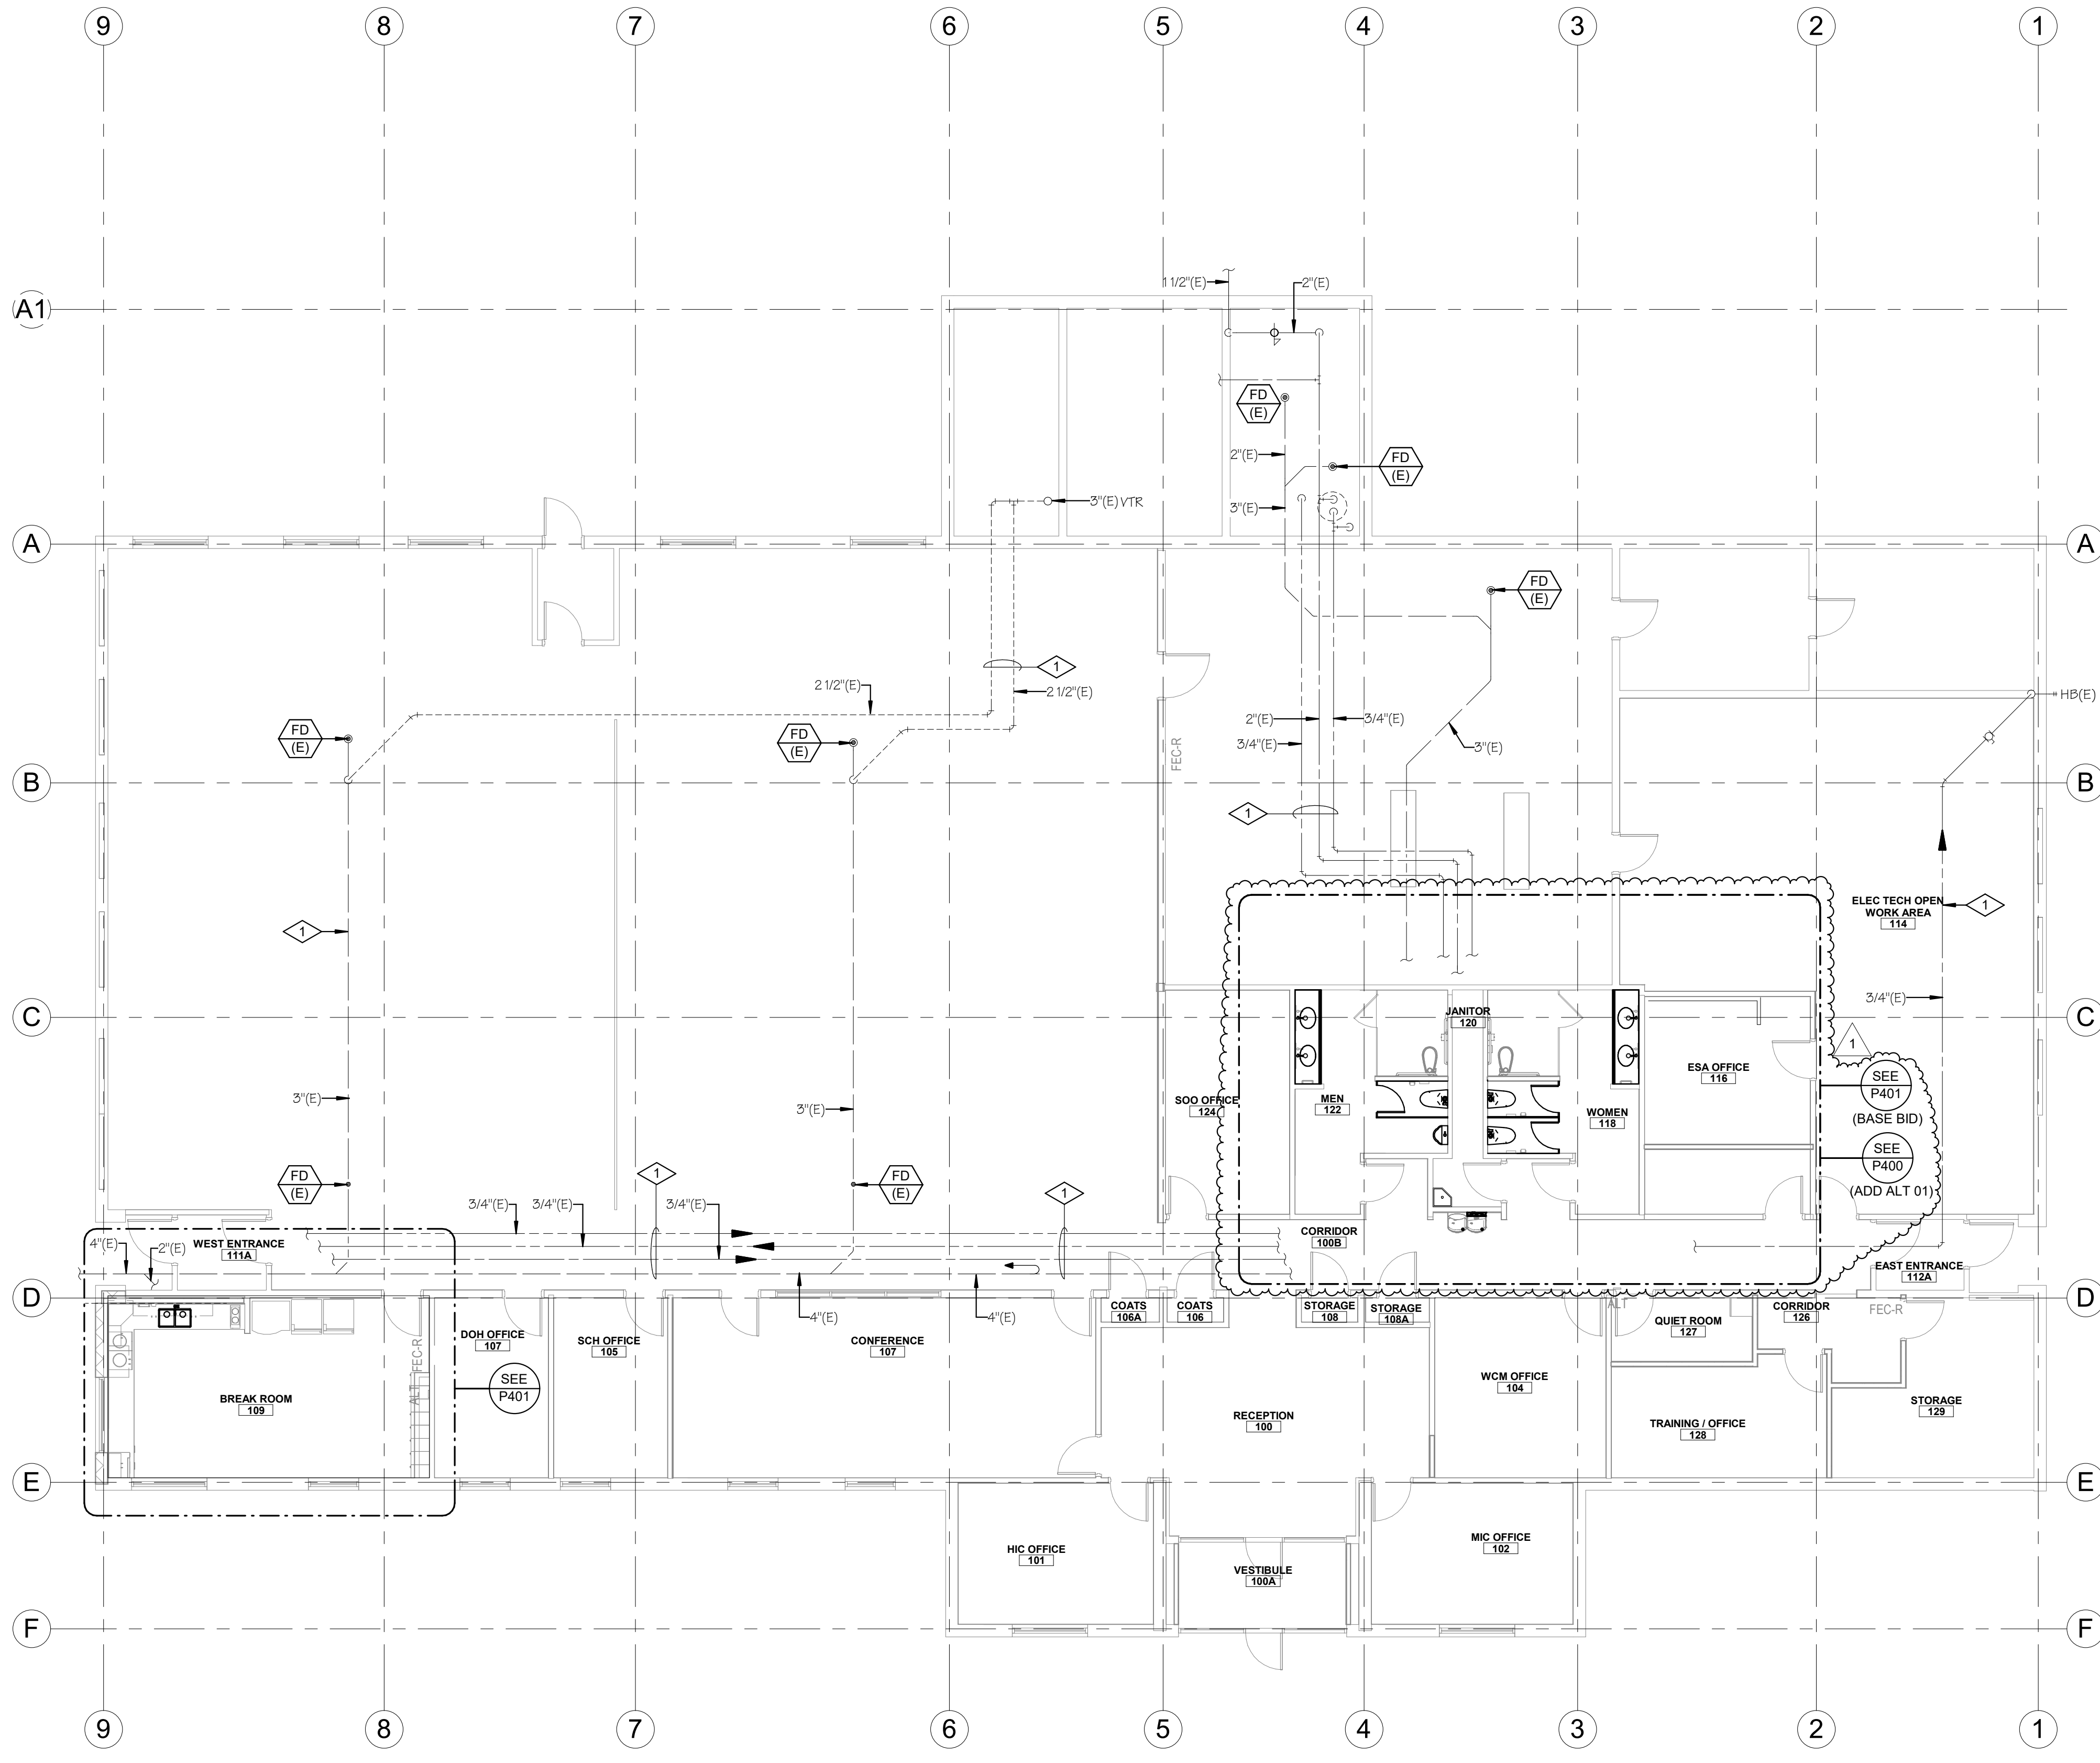

LEVEL 1 OVERALL PLUMBING PLAN

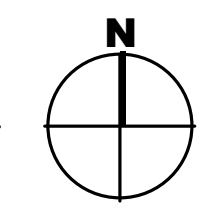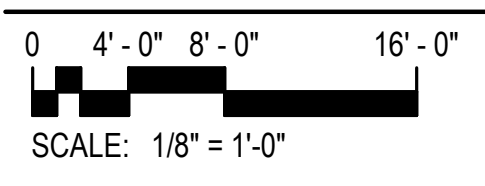


REFERENCE NOTES
1 EXISTING PLUMBING TO REMAIN.

MHTN ARCHITECTS
MHTN Architects, Inc.
280 South 400 West
Suite 250
Salt Lake City, Utah 84101
Telephone (801) 595-6700
www.mhtn.com

OLSEN & PETERSON
consulting engineers, inc.
14 E. 2700 S. Salt Lake City, UT. 84115 PH: (801) 486-4646

SLCDA
NATIONAL WEATHER SERVICE TI
SALT LAKE INTERNATIONAL AIRPORT
SALT LAKE CITY, UTAH

CONFIDENTIALITY NOTICE:
This document is intended for use on the Project identified herein by individuals and companies involved in the design, permitting, bidding and construction of the Project. MHTN Architects, Inc. grants limited rights to distribute and reproduce this document for this express purpose only. Distribution, printing or copying this document for purposes other than those indicated is strictly prohibited. If a digital copy of this document is received in error, please delete it.

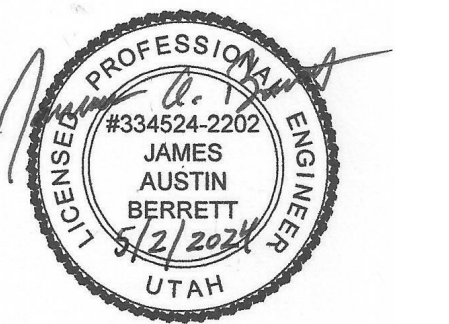

MHTN PROJECT NO. 2023573
VIEW AND PRINT THIS DRAWING IN COLOR
Original drawing is 36 x 36. Do not scale contents of this drawing.

NO.	DATE	DESCRIPTION

REVISIONS
CONTRACTOR TO VERIFY DRAWINGS IN FIELD USE REFLECT LAST REVISION DATE.


NO.	DATE	DESCRIPTION
1	05-15-2024	Addendum 01

ISSUE
CONSTRUCTION DOCUMENTS - BID SET
MAY 02, 2024



SHEET NAME
PLUMBING FLOOR PLAN

SHEET NUMBER
P101

- REFERENCE NOTES**
- 1 LINE SIZE BALL VALVES; PROVIDE ACCESS PANEL IN ACCESSIBLE LOCATION NEW VALVES FOR ADJUSTMENT.
 - 2 PROVIDE CIRCUIT SETTER; SET VALVE AT 0.25 GPM.
 - 3 TIE IN NEW 2" WASTE LINE FROM NEW SHOWER DRAIN TO EXISTING WASTE LINE IN THIS APPROXIMATE LOCATION. CONTRACTOR TO FIELD VERIFY EXACT LOCATION FOR TIE IN, AND PROVIDE SAW CUT WITH BACK FILL AND NEW CONCRETE TO MATCH EXISTING.
 - 4 PROVIDE NEW 2" FLOOR CLEANOUT. COORDINATE WITH EXISTING CONDITIONS. FLOOR CLEANOUT MUST BE VISIBLE ABOVE FLOOR FINISH.

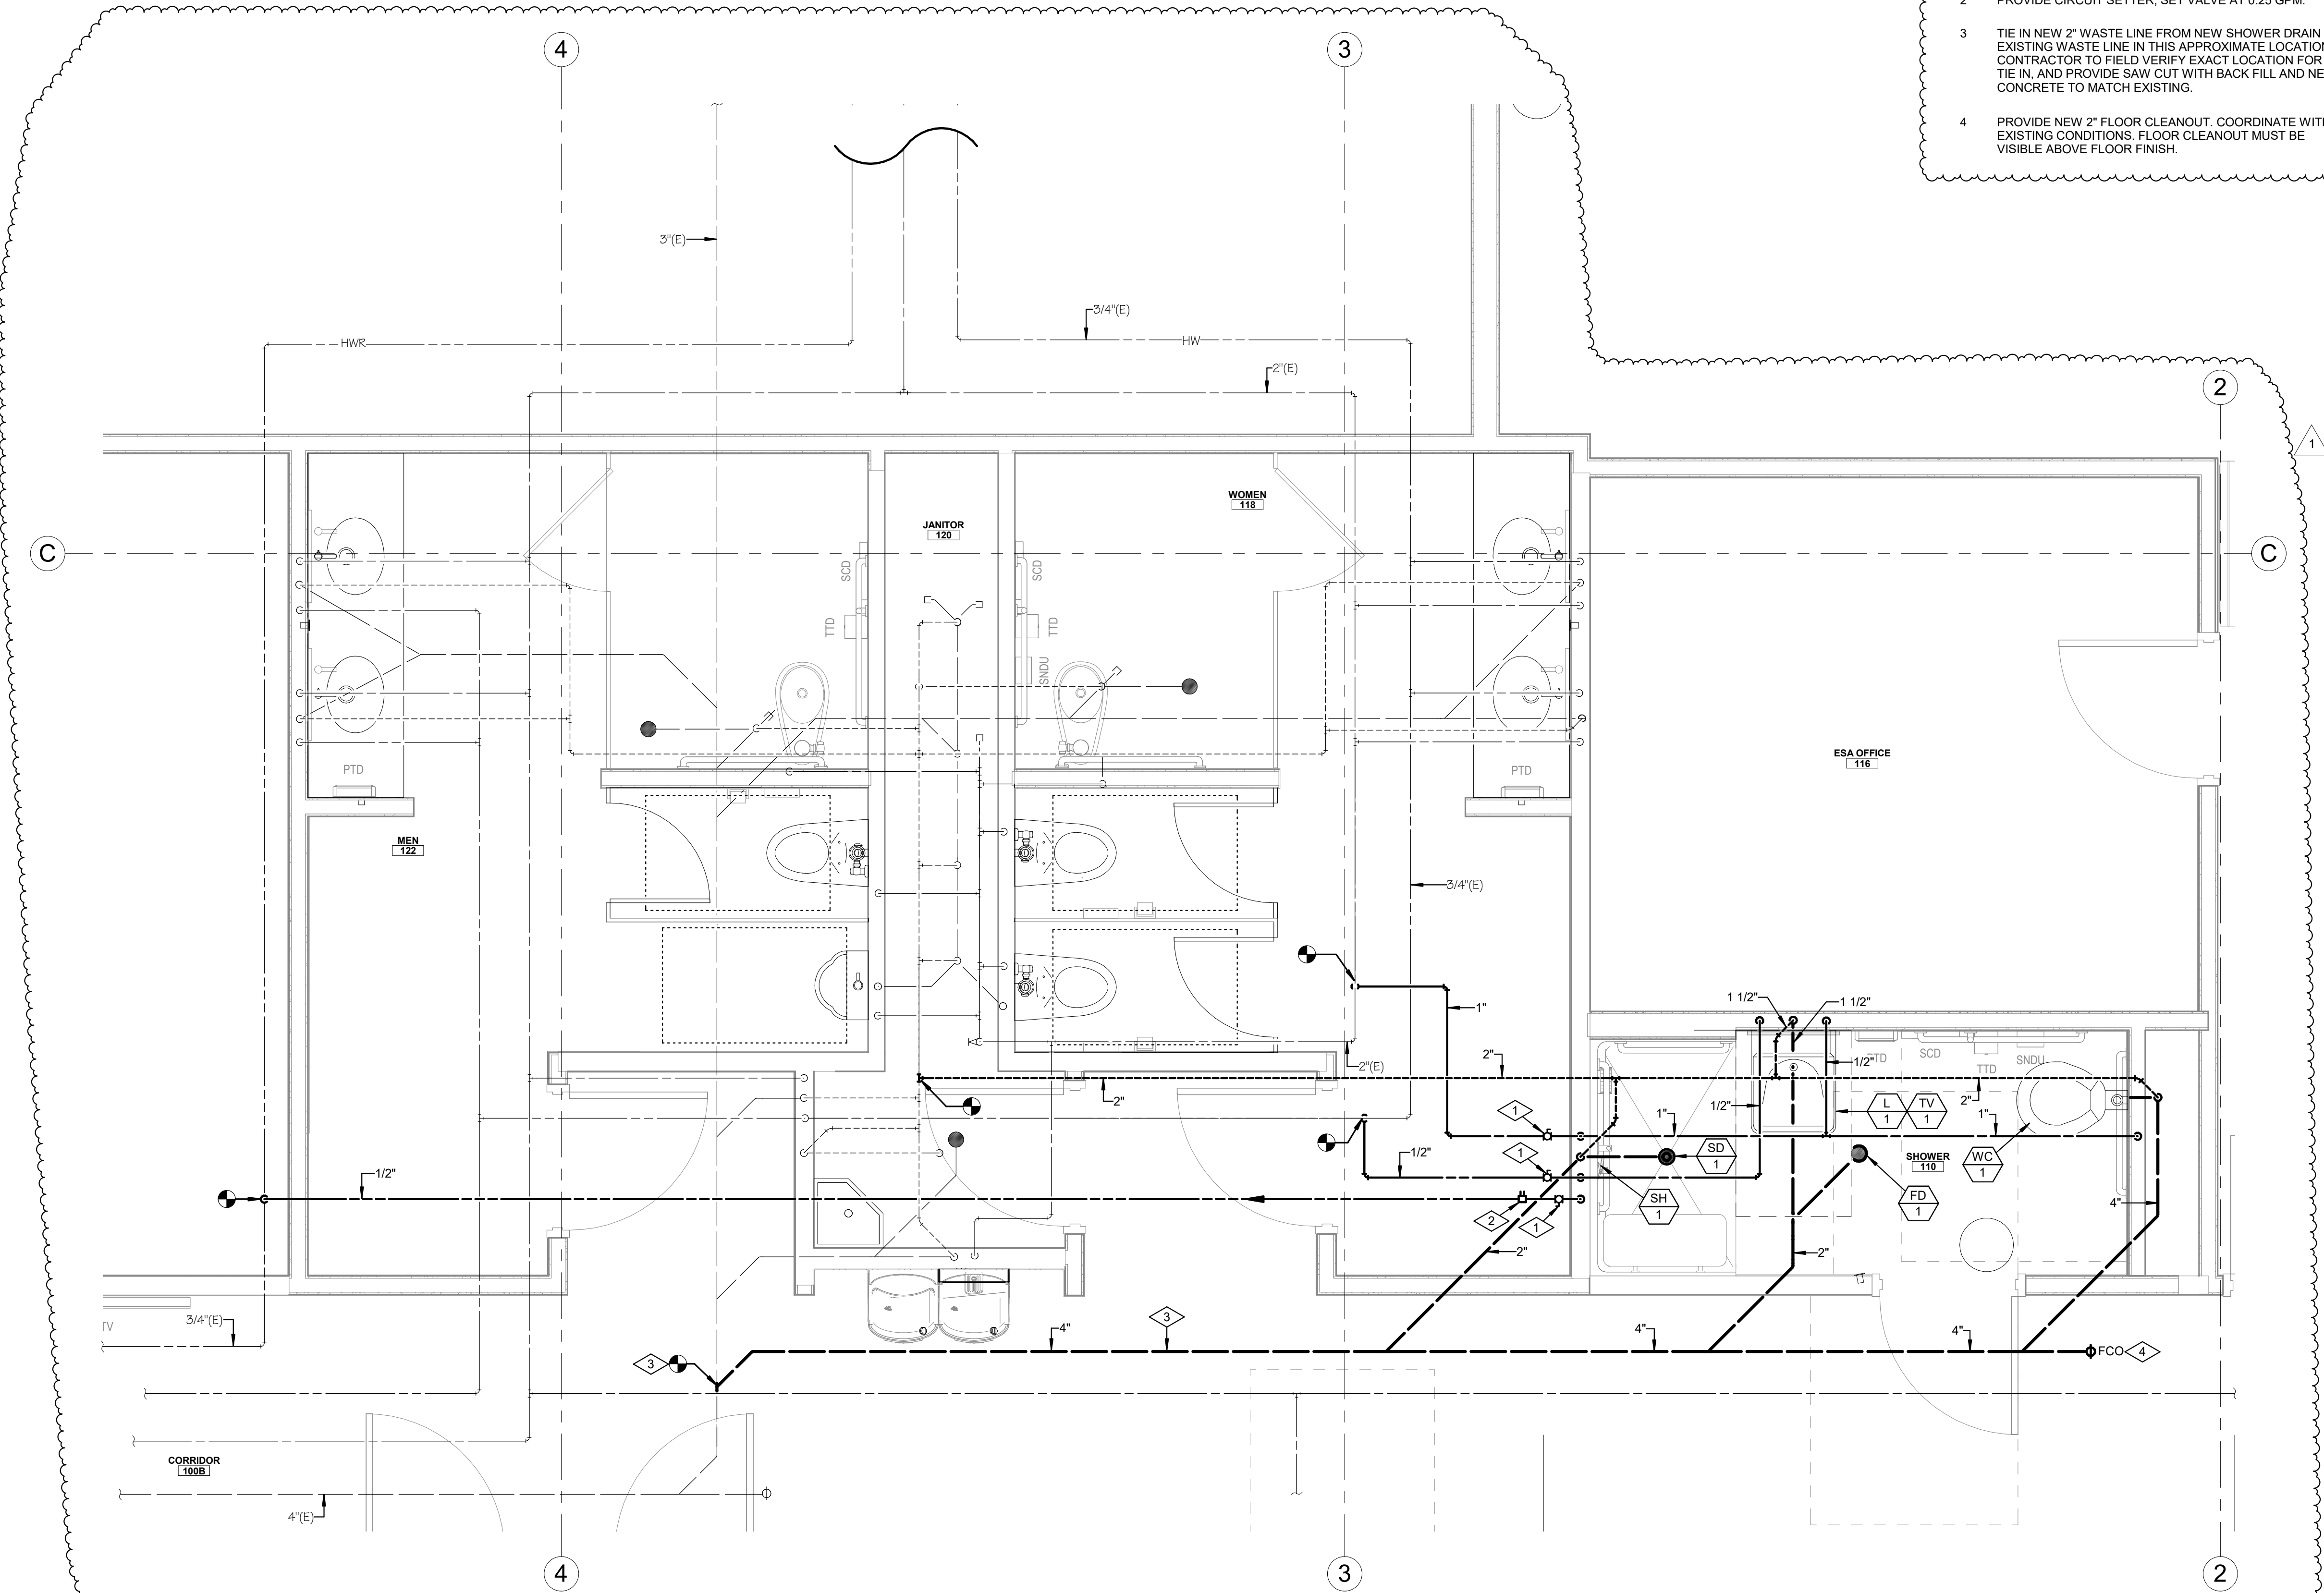


SHOWER 110 PLUMBING PLAN - ADD ALT 01

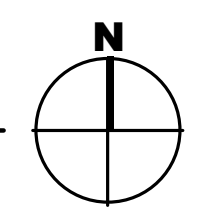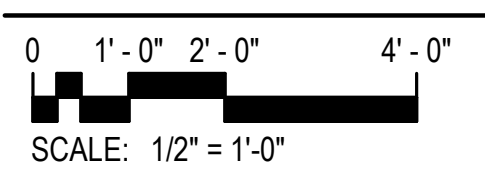

SLCDA
NATIONAL WEATHER
SERVICE TI
SALT LAKE INTERNATIONAL
AIRPORT
SALT LAKE CITY, UTAH

©2023 MHTN ARCHITECTS, INC.
 Confidentiality Notice:
 This document is intended for use on the Project identified herein by individuals and companies involved in the design, permitting, bidding and construction of the Project. MHTN Architects, Inc. grants limited rights to distribute and reproduce this document for the express purpose only. Distribution, printing or copying this document for purposes other than those indicated is strictly prohibited. If a digital copy of this document is received in error, please delete it.

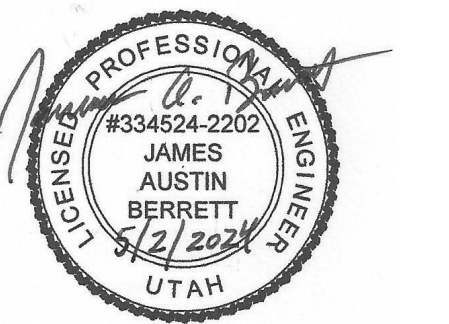

MHTN PROJECT NO. 2023573
VIEW AND PRINT THIS DRAWING IN COLOR
 Original drawing is 36 x 36. Do not scale contents of this drawing.

ISSUED:

NO.	DATE	DESCRIPTION

REVISIONS
 CONTRACTOR TO VERIFY DRAWINGS IN FIELD USE REFLECT
 LAST REVISION DATE:


NO.	DATE	DESCRIPTION
1	05-15-2024	Addendum 01

ISSUE
CONSTRUCTION DOCUMENTS - BID SET
 MAY 02, 2024

SHEET NAME
PARTIAL
PLUMBING
PLANS - ADD
ALTERNATE 01

SHEET NUMBER
P400

62023 MHTN ARCHITECTS, INC.
 Confidentiality Notice:
 This document is intended for use on the Project identified herein by individuals and companies involved in the design, permitting, bidding and construction of the Project. MHTN Architects, Inc. grants limited rights to distribute and reproduce this document for this express purpose only. Distribution, printing or copying this document for purposes other than those indicated is strictly prohibited. If a digital copy of this document is received in error, please delete it.

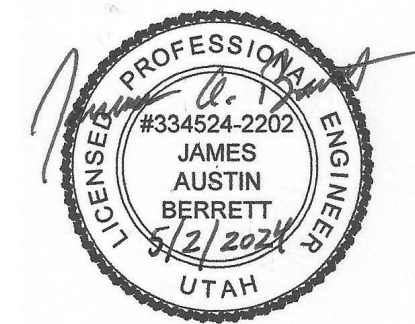

MHTN PROJECT NO 2023573
VIEW AND PRINT THIS DRAWING IN COLOR
 Original drawing is 36 x 36. Do not scale contents of this drawing.

NO.	DATE	DESCRIPTION

REVISIONS
 CONTRACTOR TO VERIFY DRAWINGS IN FIELD USE REFLECT LAST REVISION DATE.


NO.	DATE	DESCRIPTION
1	05-15-2024	Addendum 01

ISSUE
CONSTRUCTION DOCUMENTS - BID SET
 MAY 02, 2024



SHEET NUMBER
ENLARGED PLUMBING PLAN

SHEET NUMBER
P401



- REFERENCE NOTES**
- REMOVE EXISTING SINK COMPLETE. REMOVE WATER LINES BACK TO WALL AND COORDINATE WITH NEW WORK FOR CONNECTION OF EXISTING TO NEW.
 - REMOVE ALL EXISTING PLUMBING FIXTURES AS HIGHLIGHTED ON PLAN. REMOVE EXISTING WATER, WASTE AND VENT CONNECTIONS. CAP EXISTING LINES THAT ARE NOT RE-USED, AND COORDINATE WITH NEW WORK FOR EXTENT OF DEMOLITION FOR CONNECTION TO NEW.
 - REMOVE EXISTING WATER FOUNTAIN. REMOVE EXISTING WATER AND WASTE CONNECTIONS. COORDINATE WITH NEW WORK FOR EXTENT OF DEMOLITION FOR CONNECTION TO NEW.
 - REMOVE FLOOR DRAINS DOWN TO TRAP. CAP EXISTING WASTE LINE BELOW FLOOR. COORDINATE WITH NEW WORK FOR EXTENT OF DEMOLITION FOR CONNECTION TO NEW.
 - REMOVE EXISTING WATER LINES AND DROPS WHERE SHOWN; COORDINATE CONNECTION OF NEW TO EXISTING. TYPICAL ALL WATER CLOSETS AND URINALS.
 - EXISTING WATER LINES, VENT LINES AND WASTE LINES TO REMAIN.
 - NEW SINK. UNDER COUNTER MOUNT. CONNECT NEW WATER LINES BACK TO WALL AND RECONNECT TO EXISTING. PROVIDE NEW 1/4 STOPS.
 - PROVIDE NEW WATER CLOSETS AND URINALS. CONNECT NEW WATER, WASTE AND VENT CONNECTIONS TO EXISTING; CONTRACTOR TO SAW CUT WHERE REQUIRED TO INSTALL NEW WASTE LINES BELOW SLAB FOR FLOOR MOUNT WATER CLOSETS. PROVIDE NEW 2" VENT RISER FROM EACH NEW FIXTURE AND TIE INTO EXISTING IN CHASE.
 - PROVIDE NEW DUAL WATER FOUNTAIN WITH BOTTLE FILLER. THE NEW WATER, WASTE AND VENT CONNECTIONS TO EXISTING.
 - PROVIDE NEW FLOOR DRAINS WHERE SHOWN; 2" WASTE LINE TO BE ROUTED BACK TO EXISTING. COORDINATE NEW WORK WITH ARCHITECTURAL PLANS FOR FLOOR SLOPING TO FLOOR DRAIN. CONTRACTOR TO PROVIDE SAW CUTS FOR INSTALLATION OF NEW FLOOR DRAINS TO EXISTING WASTE LINE.
 - PROVIDE NEW WATER LINES AND DROPS WHERE SHOWN; 1" CW DROPS TO EACH WATER CLOSET AND URINAL.
 - EXISTING WATER LINES, VENT LINES AND WASTE LINES TO REMAIN.
 - REMOVE WASTE LINE UNDER COUNTER BACK TO SINK SIDE OF WALL; COORDINATE WITH NEW WORK FOR RE-CONNECTION.
 - REMOVE WATER LINES TO SINK UNDER CABINET BACK TO CABINET PENETRATION AT INSIDE OF CABINET; COORDINATE WITH NEW WORK FOR RE-CONNECTION.
 - REMOVE EXISTING SINK AND DISPOSER COMPLETE. COORDINATE WITH ARCHITECTURAL DEMOLITION PLANS.
 - RE-CONNECT NEW SINK TO EXISTING CW AND HW LINES BELOW SINK CABINET. COORDINATE WITH ARCHITECTURAL PLANS FOR CABINET STYLE. PROVIDE NEW 1/4 STOPS.
 - DISPOSAL BELOW CABINET IN CORNER; PIPE NEW WASTE LINES TO/FROM THE NEW SINK TO DISPOSAL AND SLOPE BACK TO EXISTING WASTE LINE CONNECTION BELOW CABINET. COORDINATE CLEARANCES AND REQUIREMENTS FOR PIPING PRIOR TO COMMENCEMENT OF WORK. DISPOSER TO BE LOCATED TO THE WEST WALL TO ALLOW INSTALLATION OF ADA SKIRT AT SINK. ACCESS WILL BE PROVIDED IN THE MILLWORK.
 - ICE MAKER BOX IN WALL TO SERVE (2) REFRIGERATORS. PROVIDE 1/4" COPPER PIPING TO BOTH REFRIGERATORS. MOUNT AT 48" A.F.F. PLUMBING CONTRACTOR TO PROVIDE 3/8" BRAIDED WATER CONNECTION LINES FROM IMB-1 TO EXISTING REFRIGERATORS. FIELD COORDINATE REQUIREMENTS.
 - LINE SIZE BALL VALVES; PROVIDE ACCESS PANEL IN ACCESSIBLE LOCATION NEW VALVES FOR ADJUSTMENT.
 - PROVIDE NEW 2" WASTE LINE CONNECTION AND 1-1/2" VENT TO EXISTING. COORDINATE WITH DEMOLITION PRIOR TO COMMENCEMENT OF WORK.
 - EXISTING 1-1/2" VENT TO 3" VTR TO REMAIN.
 - EXISTING SERVICE SINK AND RELATING PIPING TO REMAIN.

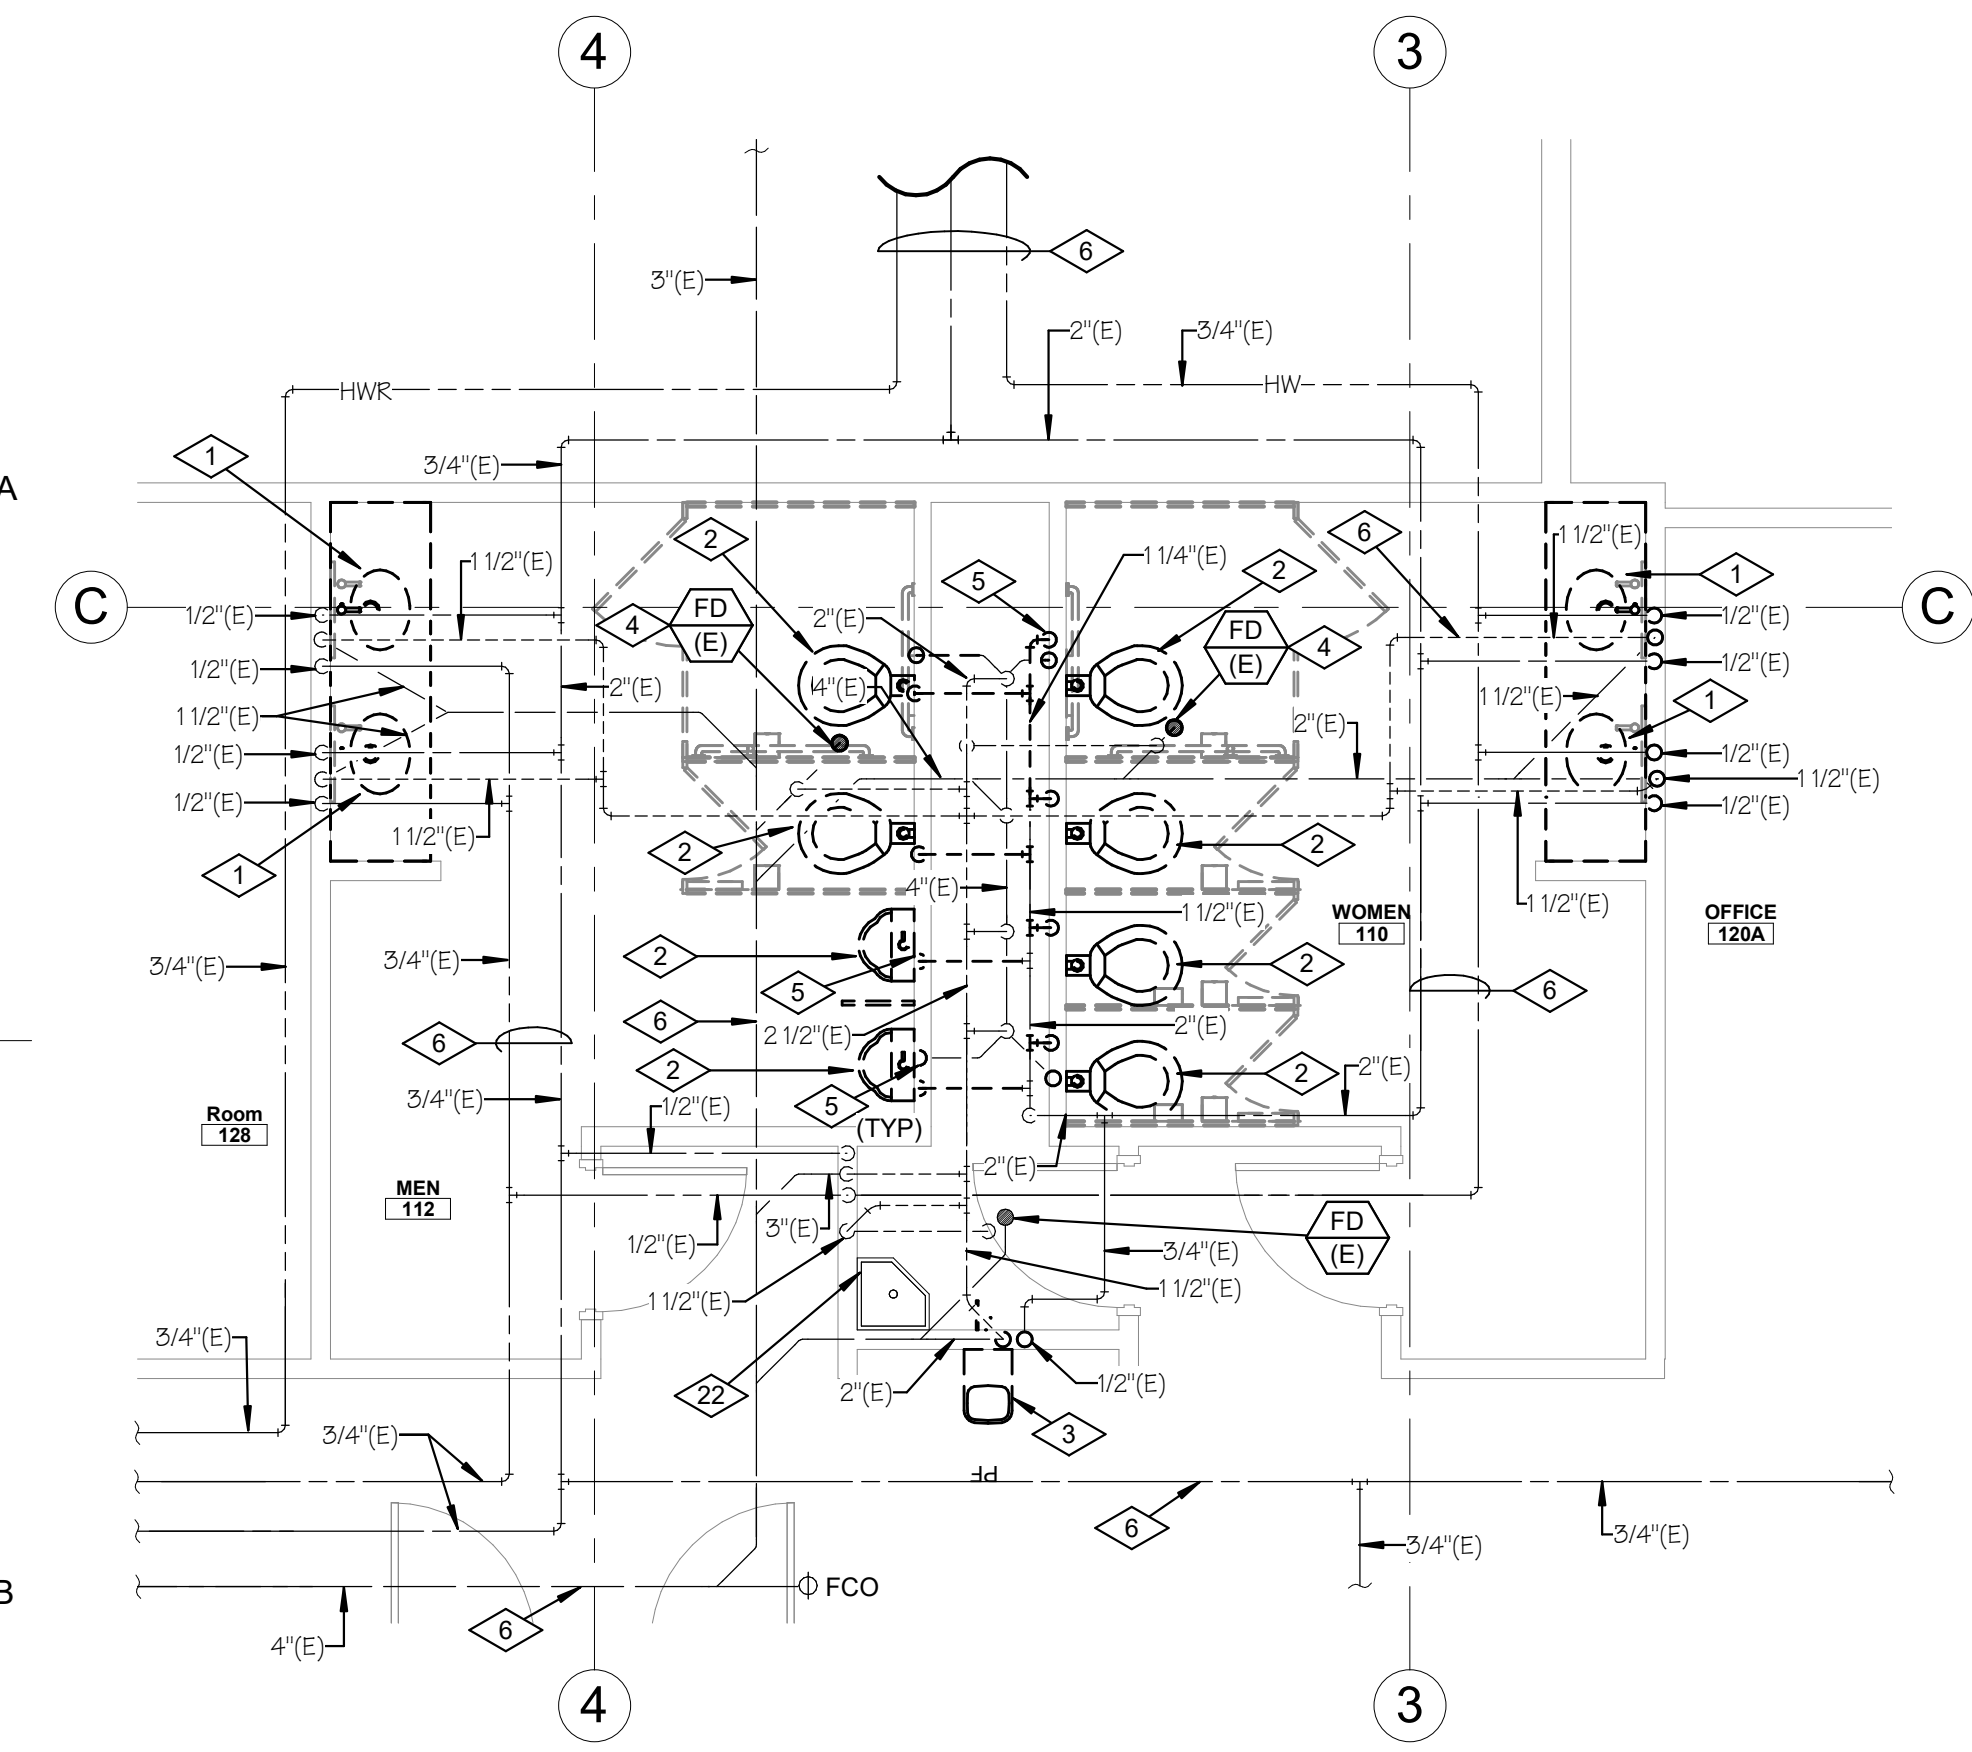



ENLARGED RESTROOM DEMO PLUMBING PLAN

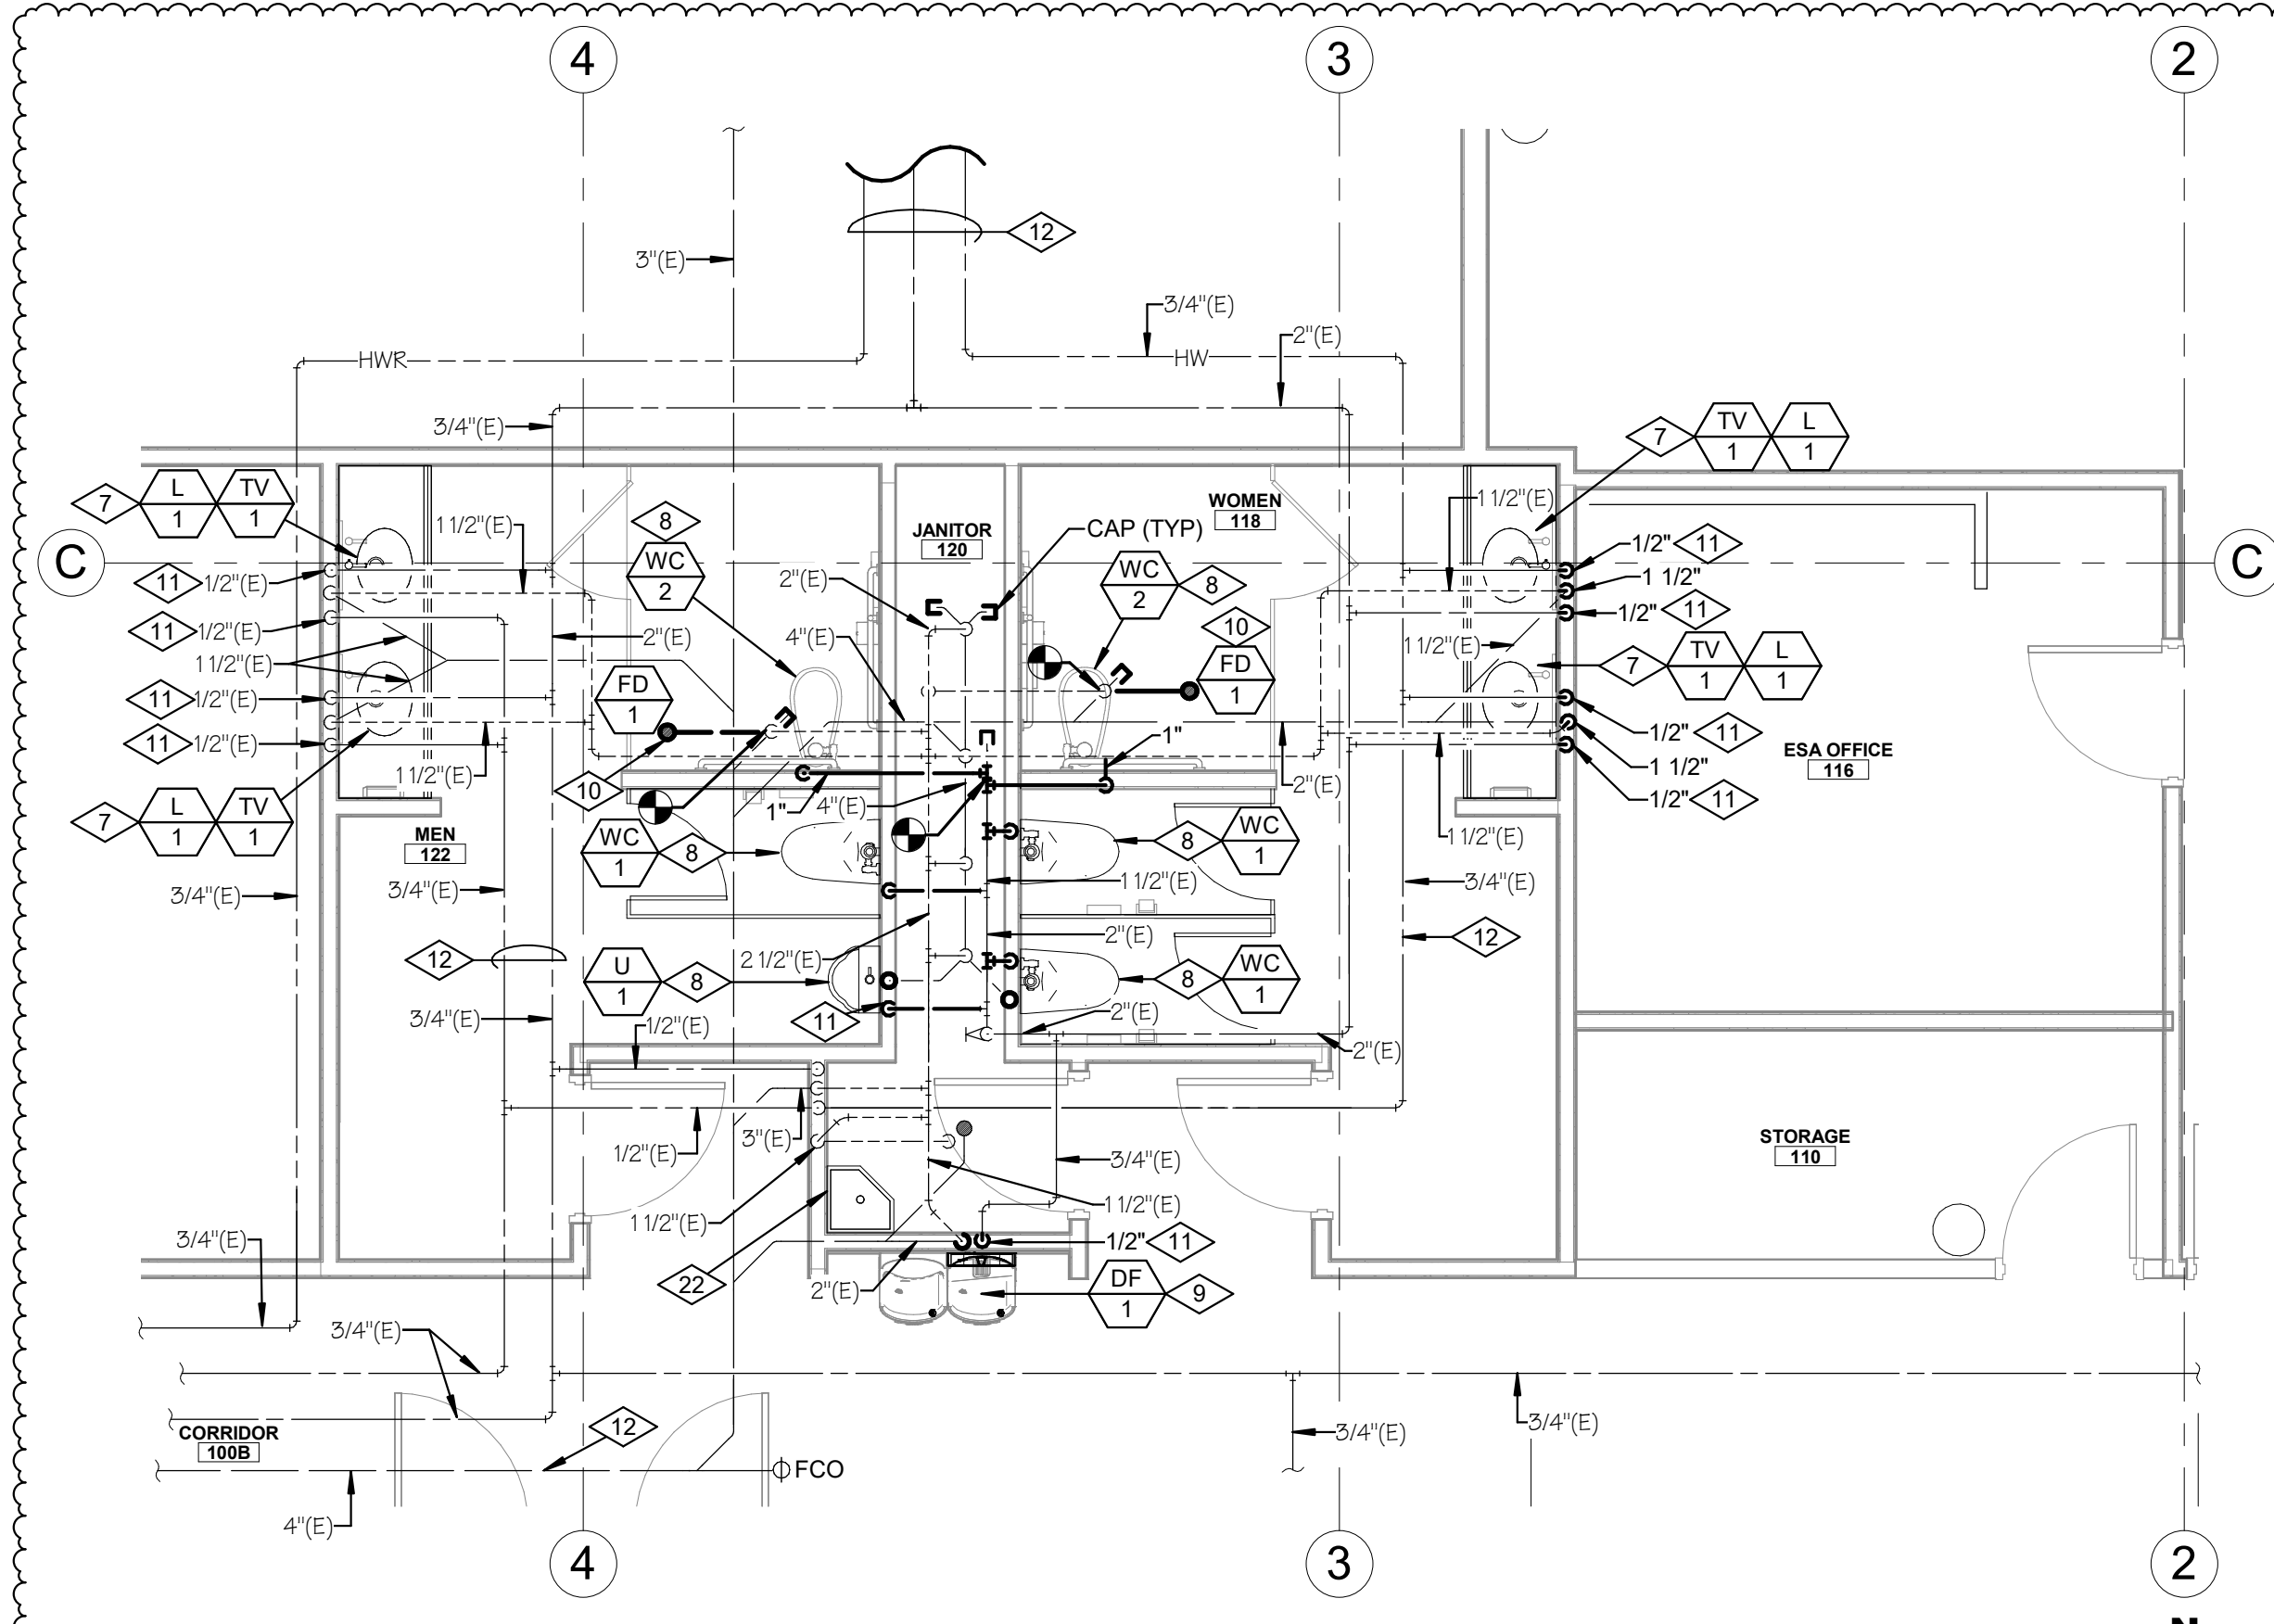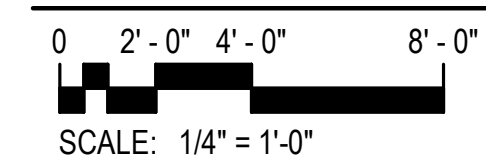


ENLARGED RESTROOM NEW WORK PLUMBING PLAN - BASE BID

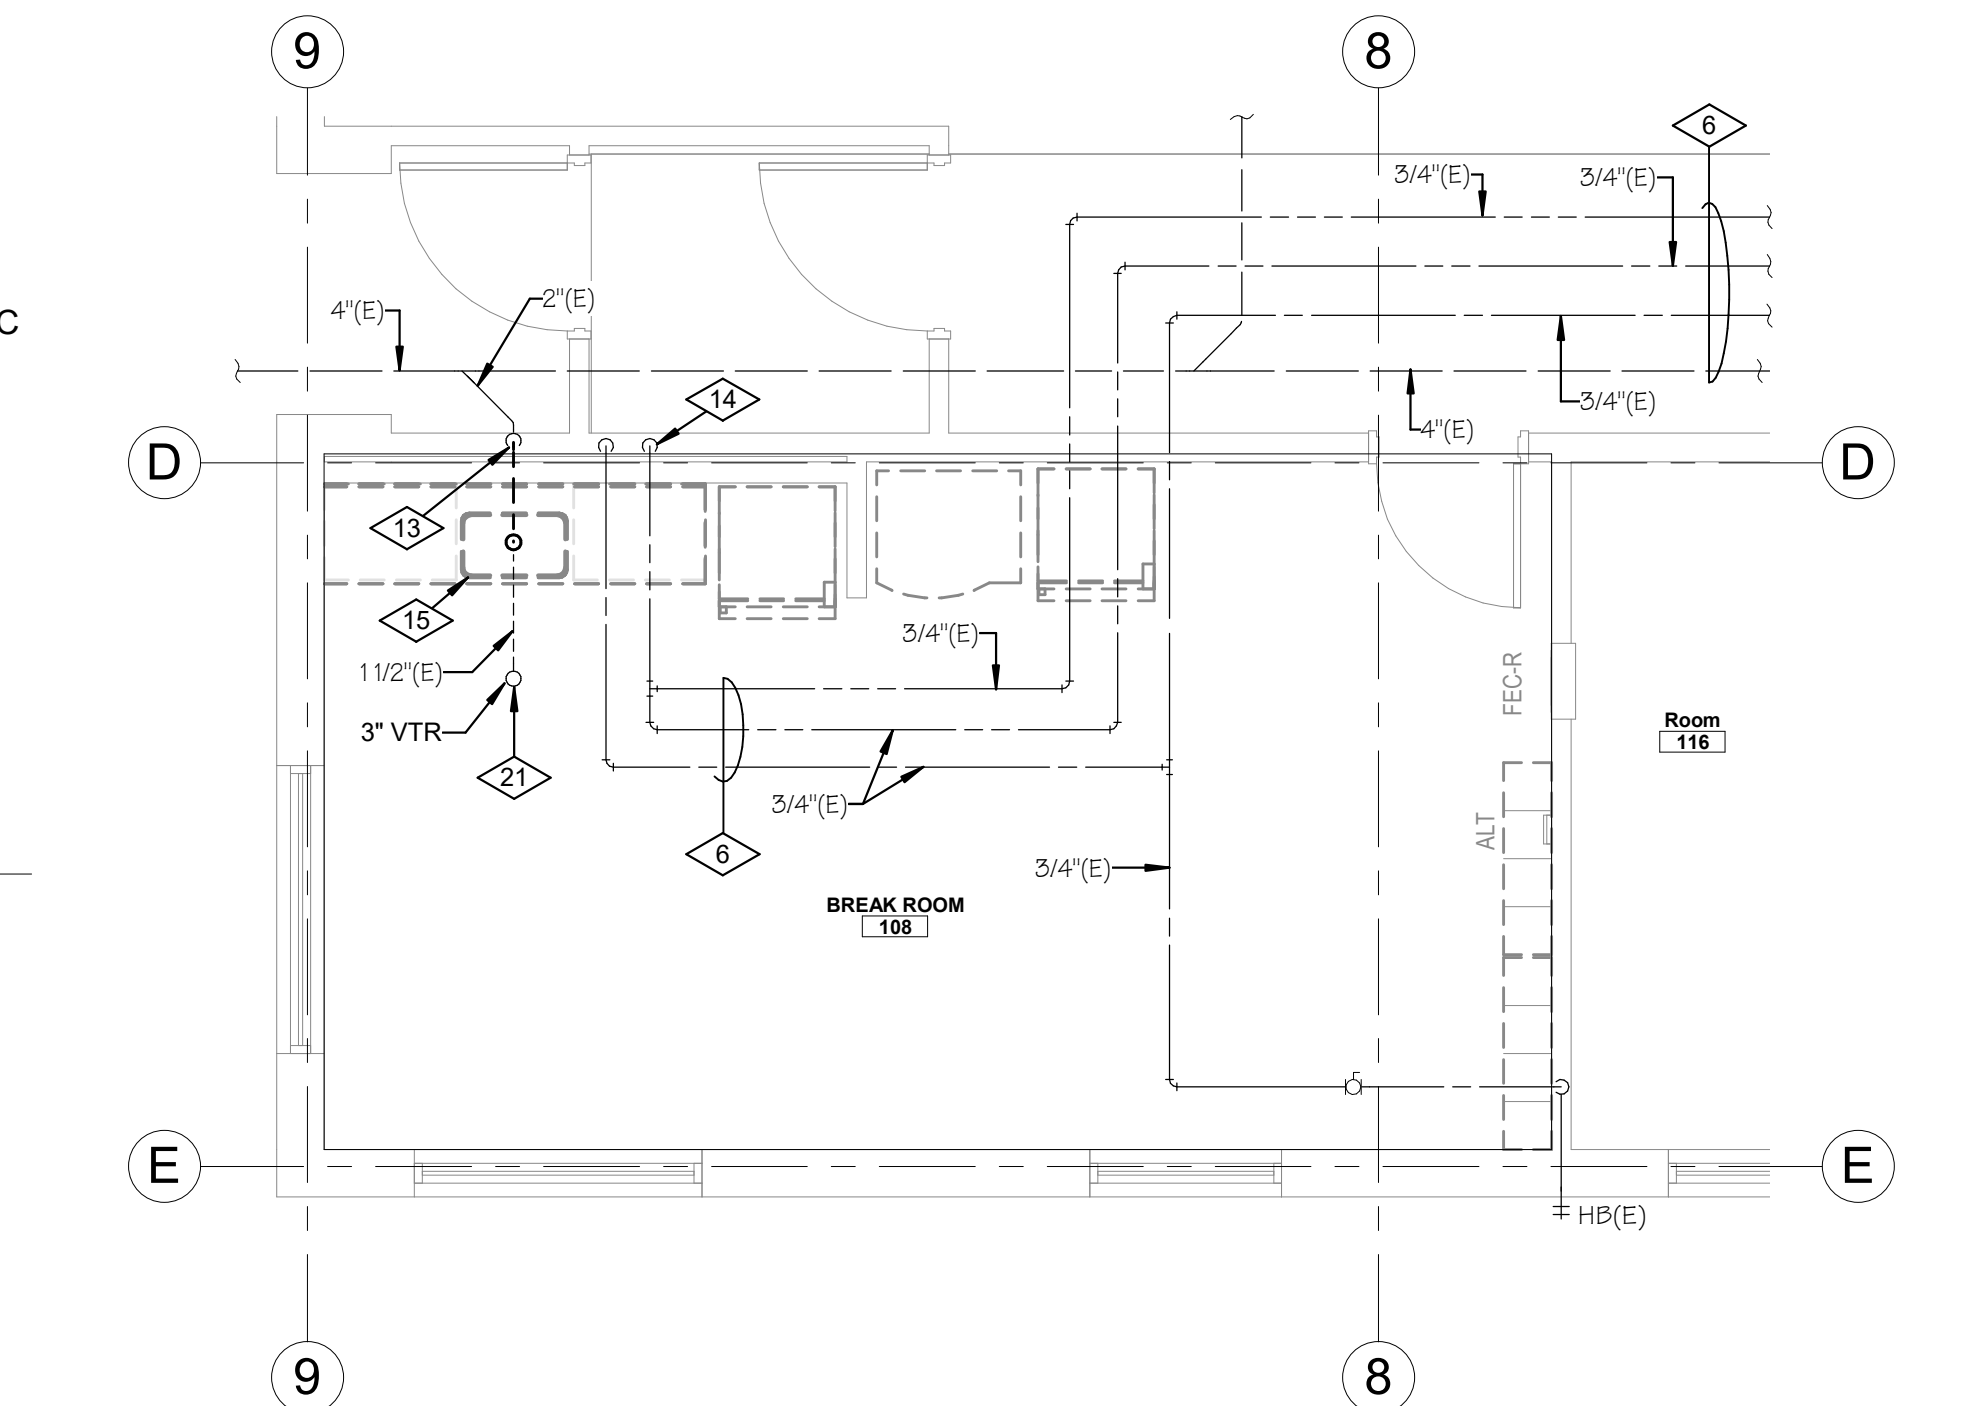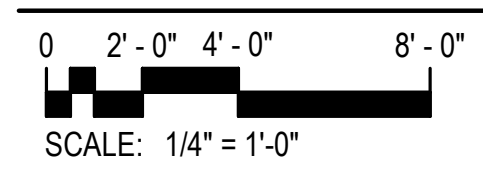



ENLARGED BREAKROOM DEMO PLUMBING PLAN

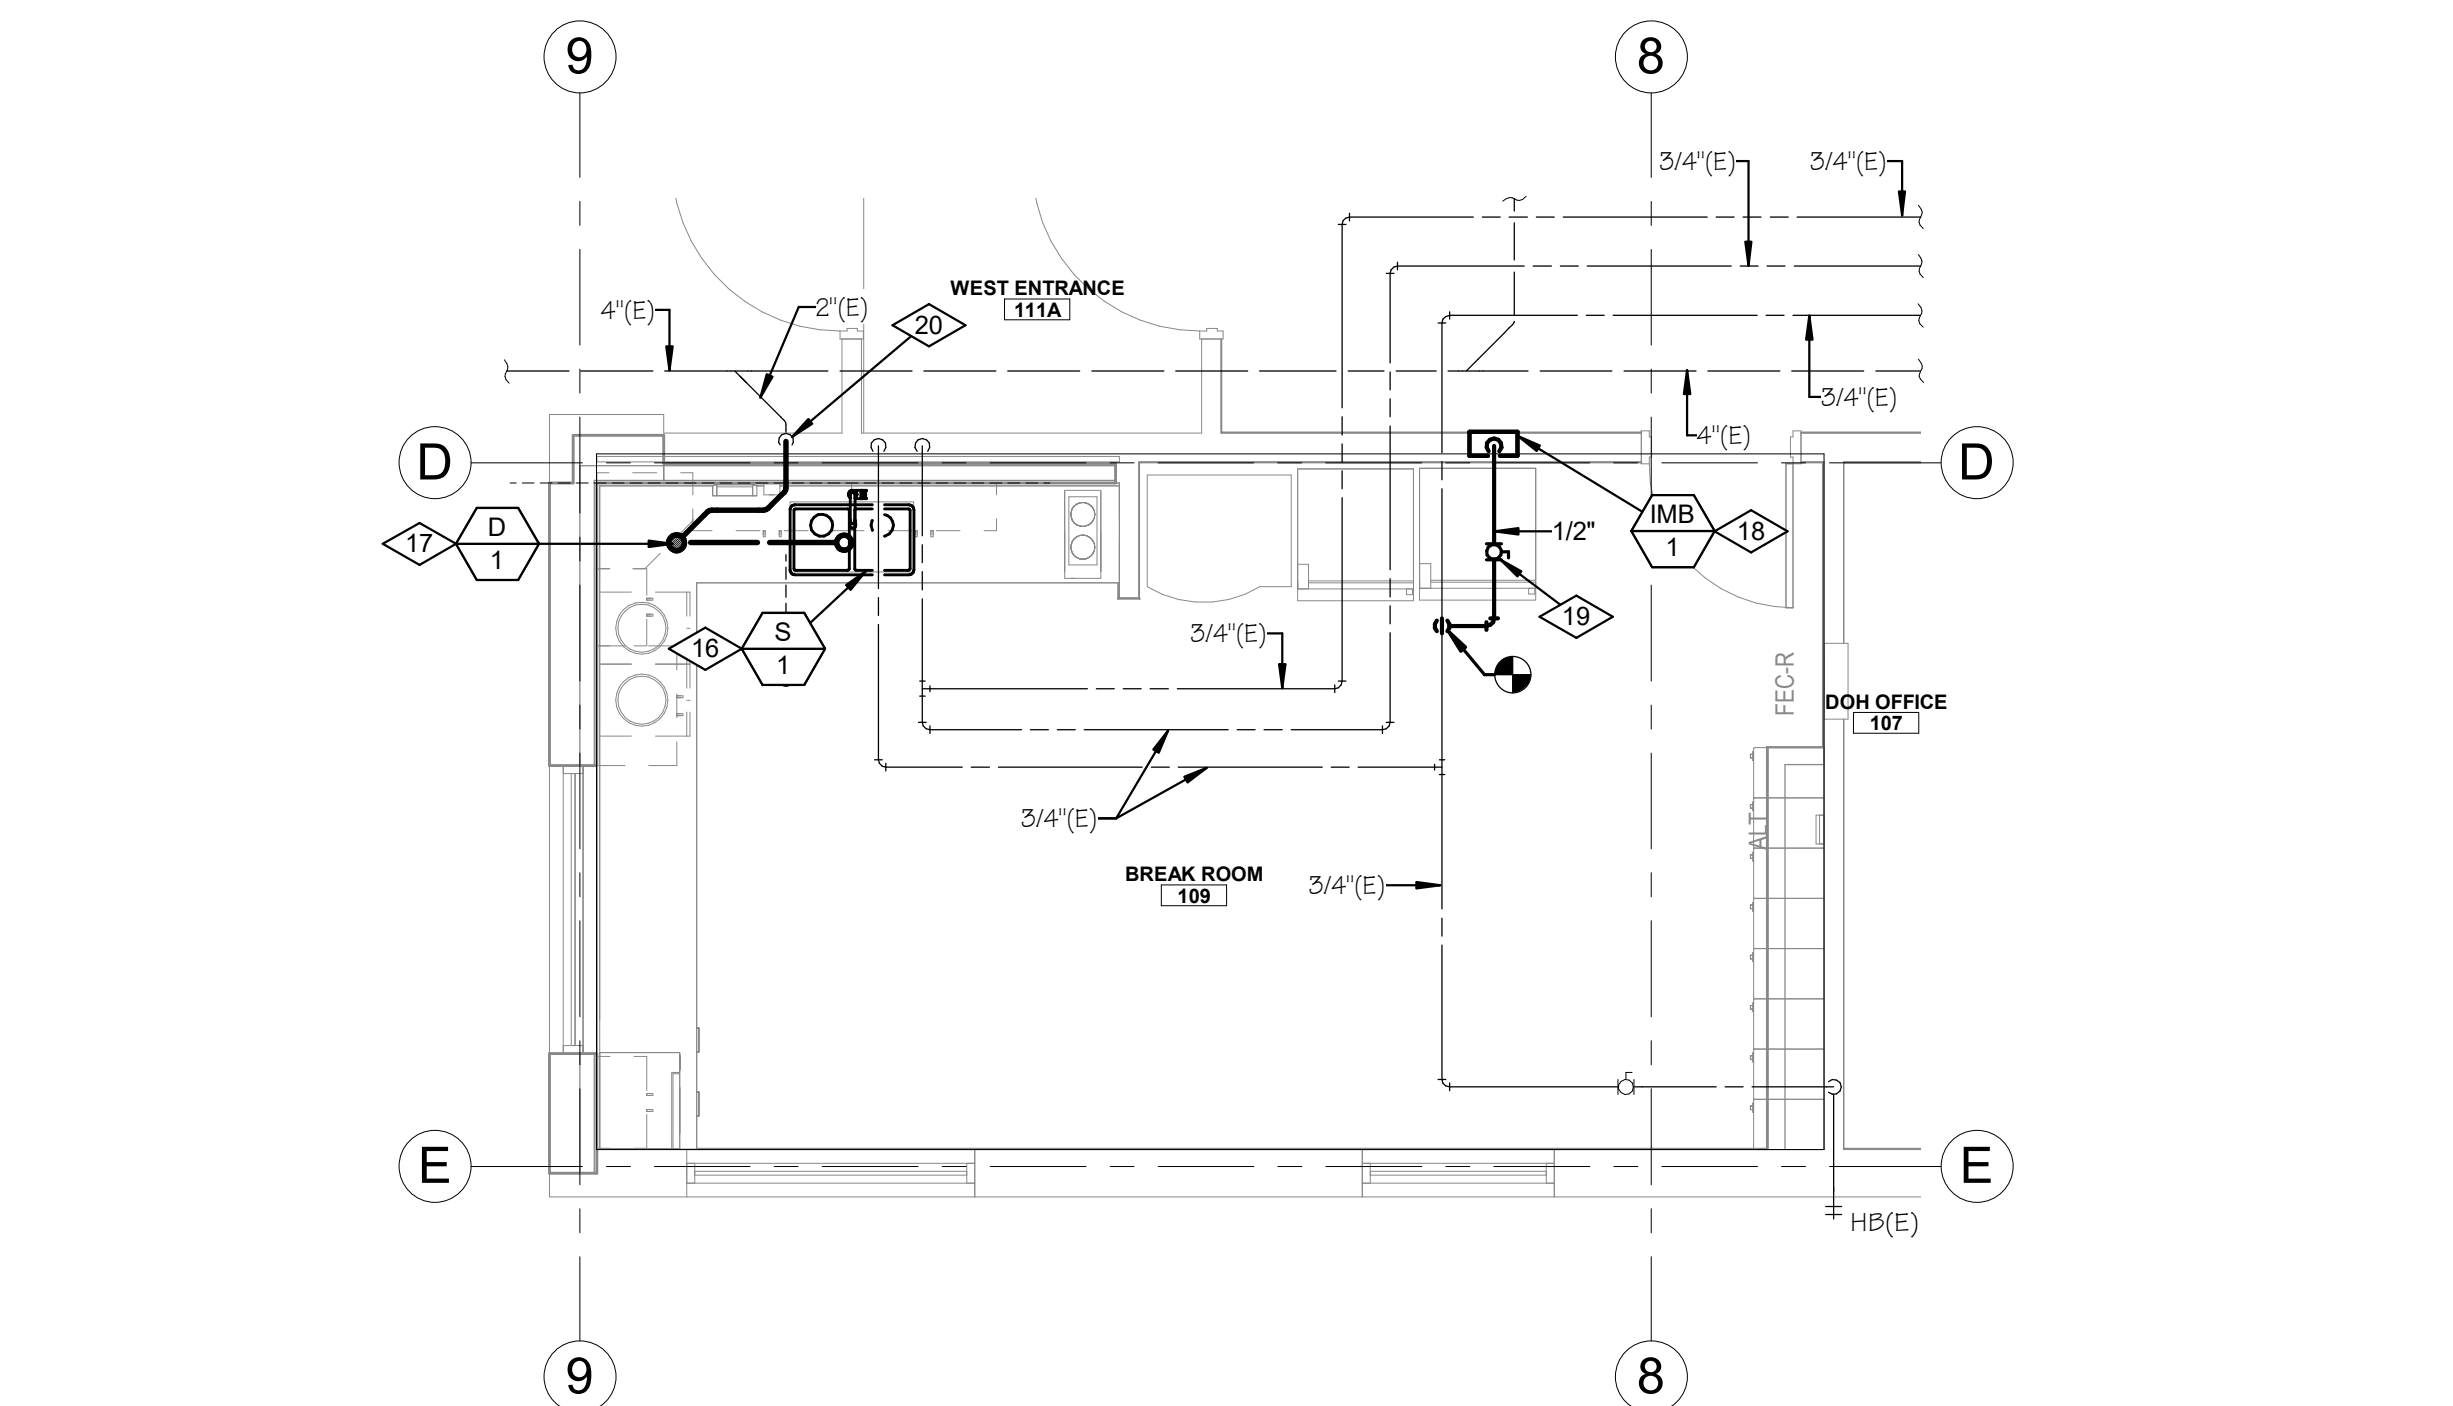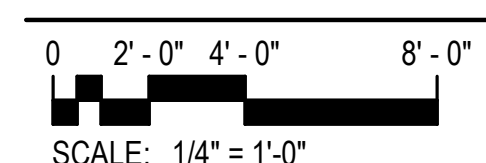

ENLARGED BREAKROOM NEW WORK PLUMBING PLAN

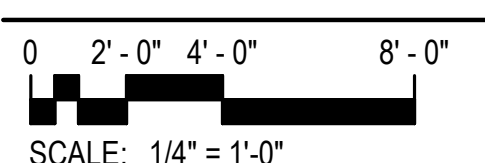


- LIGHTING GENERAL NOTES:**
- REFER TO LIGHTING DETAILS SHEETS FOR TYPICAL CONTROL WIRING DIAGRAMS. PROVIDE COMPLETE SYSTEM WITH ALL REQUIRED CONDUIT, WIRING, SWITCHES, SENSORS, POWER PACK, ETC.
 - LOCATE POWER PACKS AND ROOM CONTROLLERS ABOVE ACCESSIBLE CEILING NEAR ROOM ENTRANCES.
 - CONFIRM ALL LOCATIONS OF LIGHT FIXTURES WITH ARCHITECT PRIOR TO INSTALLATION.
 - PROVIDE UNSWITCHED HOT FOR ALL EMERGENCY LIGHTS AND BATTERY PACKS.
- KEYED NOTES** #
- L1 PROVIDE NEW SWITCH TO CONTROL EXISTING LIGHT FIXTURES. EXTEND CONDUITS AND CONDUCTORS AS REQUIRED.
- L2 TIE ALL NEW LIGHT FIXTURES IN THIS SPACE TO NEAREST AVAILABLE EXISTING LIGHTING CIRCUIT.

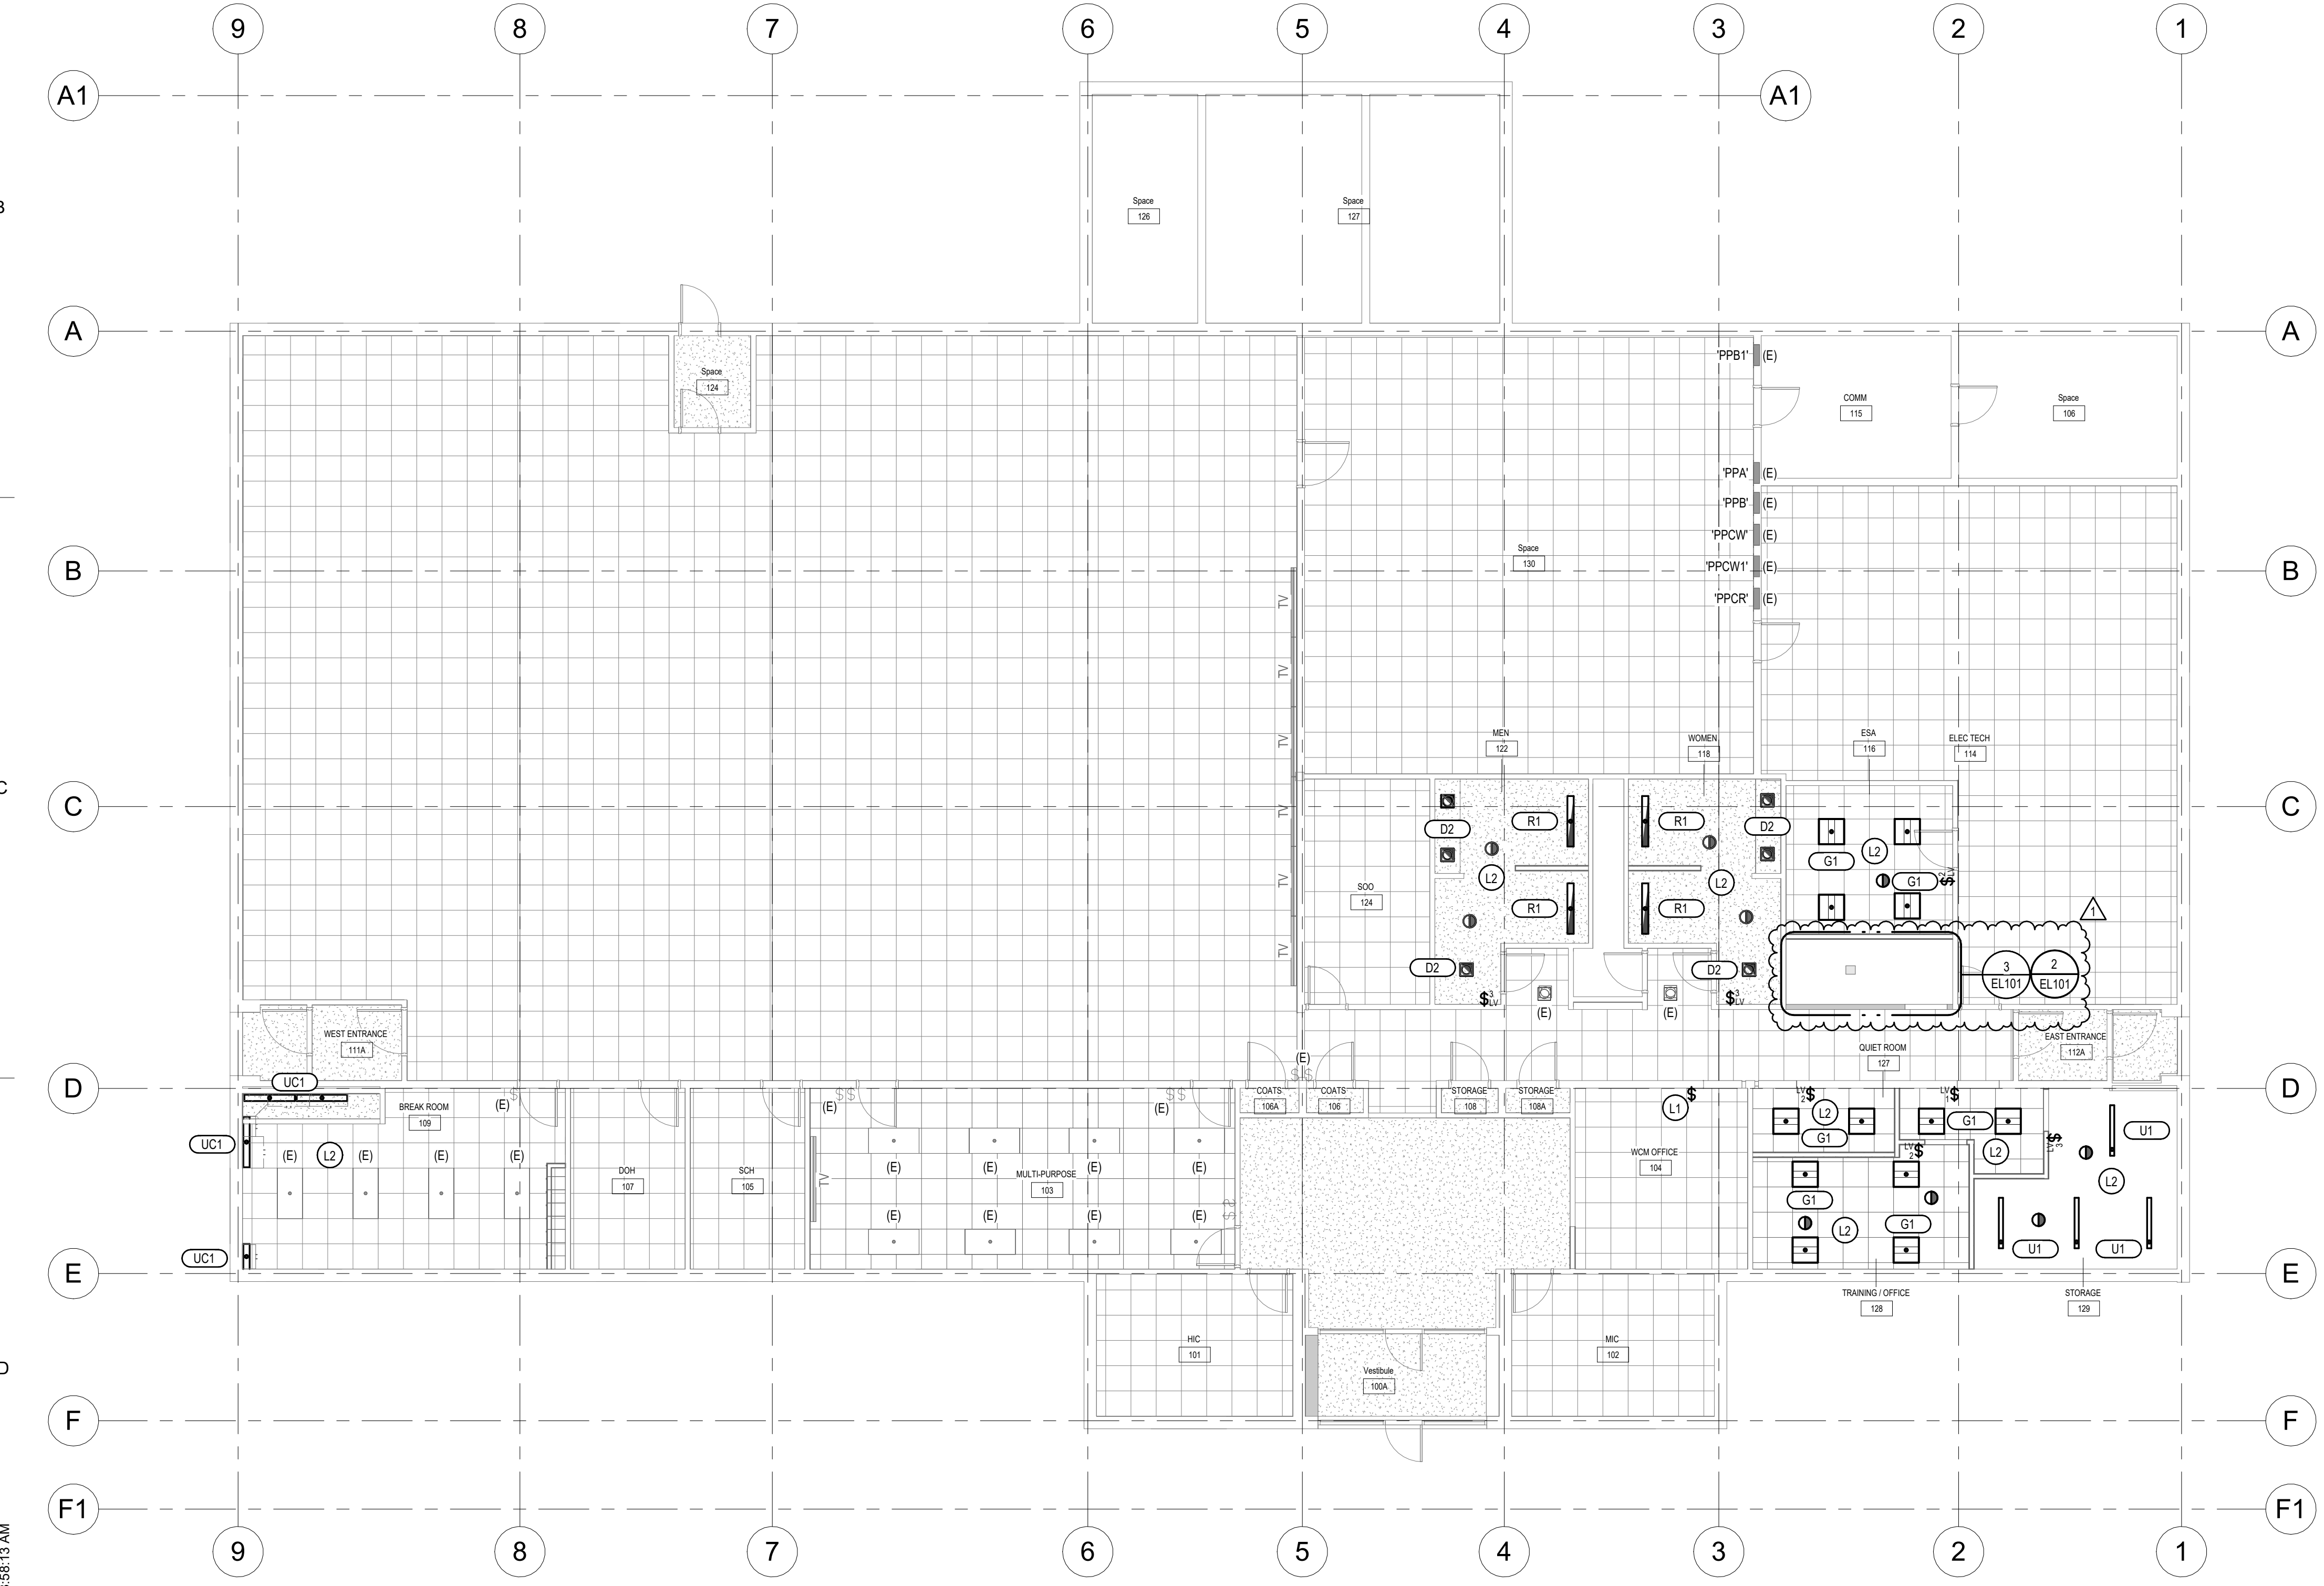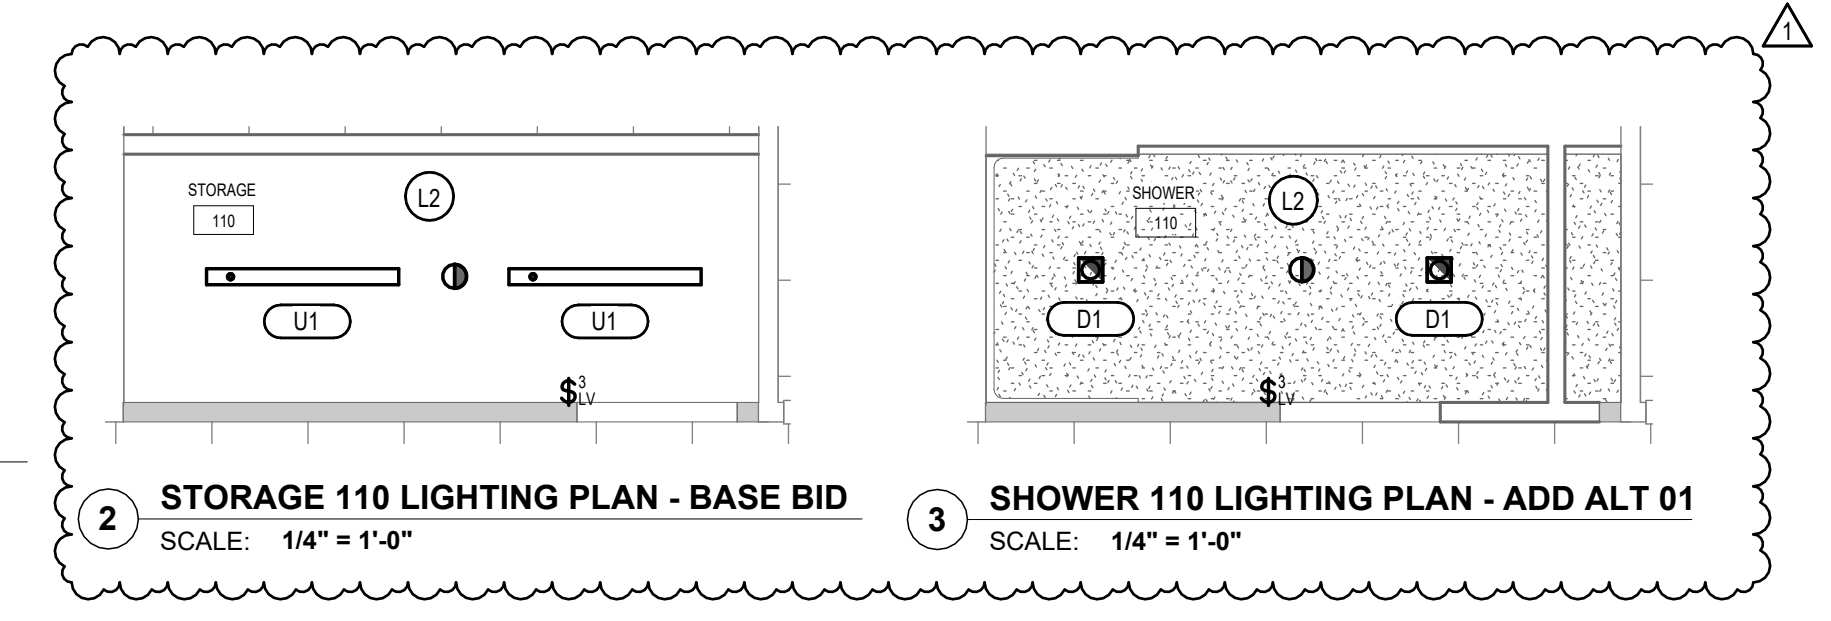

1 FLOOR PLAN - LIGHTING
SCALE: 1/8" = 1'-0"

SLCDA
NATIONAL WEATHER SERVICE TI
SALT LAKE INTERNATIONAL AIRPORT
SALT LAKE CITY, UTAH

©2023 MHTN ARCHITECTS, INC.
Confidentiality Notice:
This document is intended for use on the Project identified herein by individuals and companies involved in the design, permitting, bidding and construction of the Project. MHTN Architects, Inc. grants limited rights to distribute and reproduce this document for this express purpose only. Distribution, printing or copying this document for purposes other than those indicated is strictly prohibited. If a digital copy of this document is received in error, please delete it.

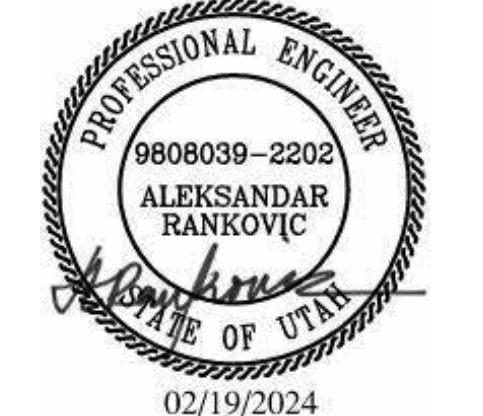

MHTN PROJECT NO 2023573

Original drawing is 24 x 36. Do not scale contents of this drawing.

ISSUED:		
NO.	DATE	DESCRIPTION

REVISIONS
CONTRACTOR TO VERIFY DRAWINGS IN FIELD USE REFLECT LAST REVISION DATE.

NO.	DATE	DESCRIPTION
1	05/17/2024	ADDENDUM 1

CONSTRUCTION DOCUMENTS - BID SET
MAY 02, 2024

SHEET NAME
FLOOR PLAN - LIGHTING



SHEET NUMBER
EL101

POWER GENERAL NOTES:

- ALL 120V, 20AMP OUTLETS THAT ARE WITHIN 6' OF ANY SINK SHALL BE GFCI.
- THE DIVISION 26 CONTRACTOR SHALL DETERMINE THE EXACT ROUTING OF ALL CONDUITS IN THE FIELD. THIS PLAN REPRESENTS A SCHEMATIC REPRESENTATION OF DEVICE LOCATIONS AND CONDUIT RUNS.

KEYED NOTES #

- P1 PROVIDE JUNCTION BOX WITH SINGLE MUD RING AND COVER PLATE WITH 2" RUBBER GROMMET. SIZE BOX PER NEC.
- P2 PROVIDE JUNCTION BOX AND TOGGLE SWITCH (EQUIVALENT TO HUBBELL HBL1221L, 20A, 1-POLE, 120V) FOR AUTO SINK FAUCET. PROVIDE JUNCTION BOX TO SINK LOCATION. PLUMBING CONTRACTOR SHALL PROVIDE TRANSFORMER AND LOW VOLTAGE WIRING.
- P3 TIE TO EXISTING CIRCUIT. EXTEND CONDUIT AND CONDUCTORS AS REQUIRED.
- P4 PROVIDE JUNCTION BOX WITH SINGLE MUD RING AND COVER PLATE WITH 2" RUBBER GROMMET. . . EXTEND 1" CONDUIT WITH PULLSTRING FROM JUNCTION BOX TO EXISTING TELECOM RACK.
- P5 EXTEND 1.25" CONDUIT WITH PULLSTRING FROM FLOOR BOX TO WALL MOUNTED JUNCTION BOX FOR TV CABLING. SAWCUT EXISTING SLAB AS REQUIRED. REFER TO ARCHITECTURAL PLANS FOR MORE INFORMATION.
- P7 PROVIDE JUNCTION BOX AND TOGGLE SWITCH (EQUIVALENT TO HUBBELL HBL1221L, 20A, 1-POLE, 120V) FOR AUTO URINALS AND WATER CLOSETS. PROVIDE JUNCTION BOX IN THE LOCATION SHOWN. PLUMBING CONTRACTOR SHALL PROVIDE TRANSFORMER AND LOW VOLTAGE WIRING.
- P8 PROVIDE BLANK FACE GFCI FOR PROTECTING MICROWAVE RECEPTACLE. PROVIDE LABEL "MW GFCI".
- P9 RE-USE EXISTING CONDUIT AND CONDUCTORS WHEREVER POSSIBLE IN THE SPACE. EXTEND NEW CONDUIT AND BRANCH CIRCUIT WIRING AS REQUIRED.

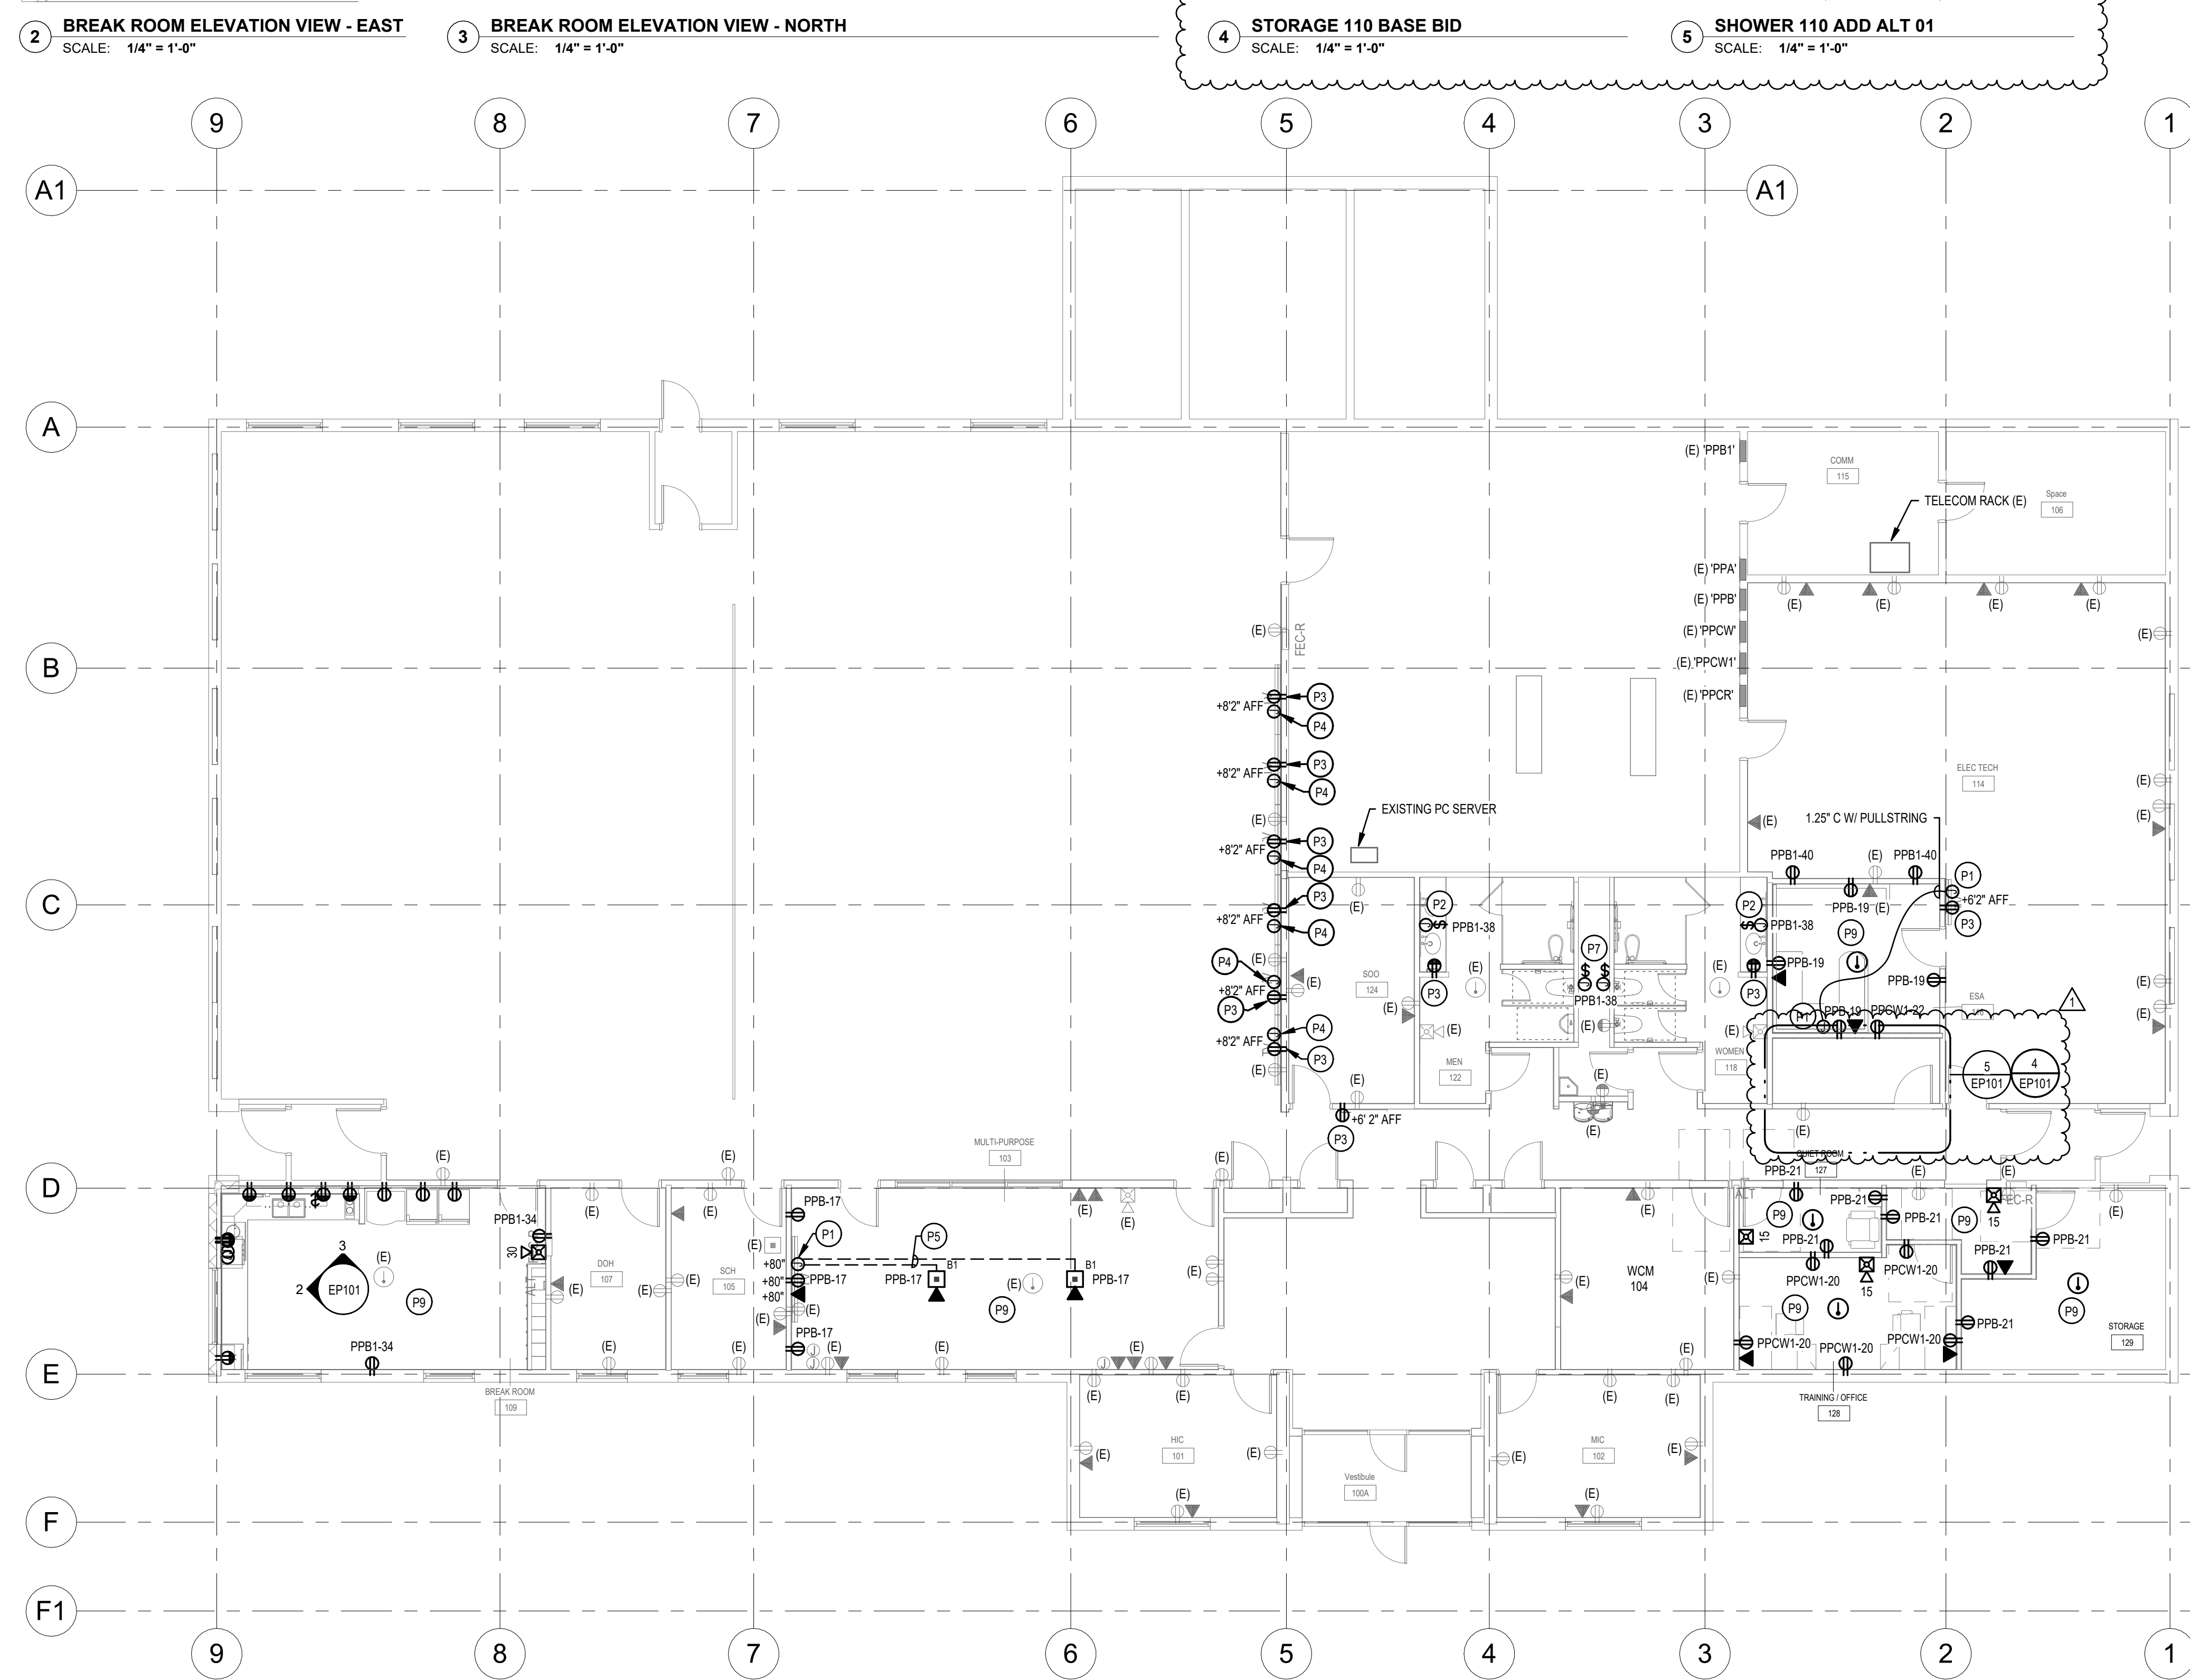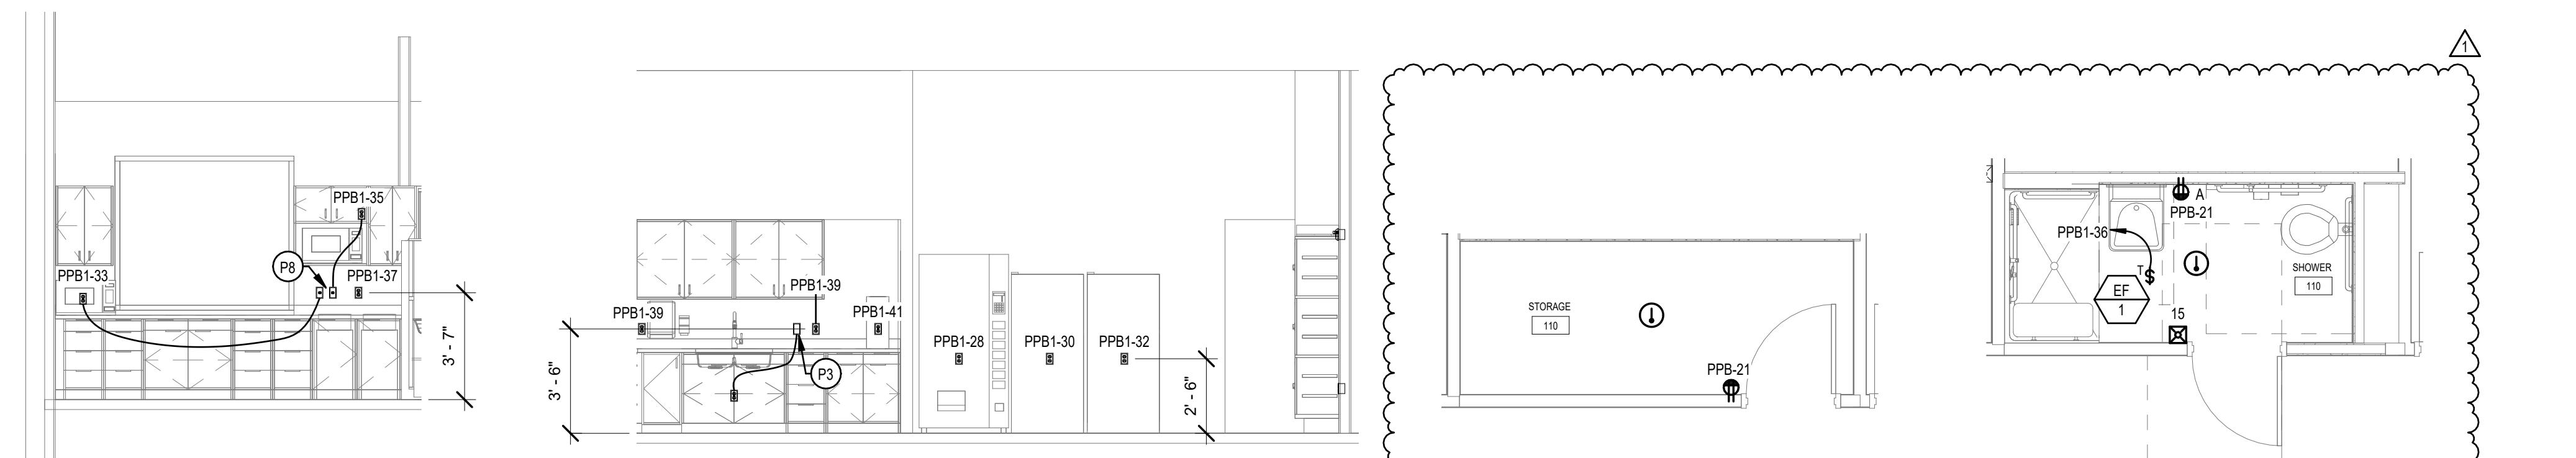


MHTN ARCHITECTS
MHTN Architects, Inc.
280 South 400 West
Suite 250
Salt Lake City, Utah 84101
Telephone (801) 595-6700
www.mhtn.com

ENVISION ENGINEERING
240 E. MORRIS AVE. SUITE 200
SALT LAKE CITY, UT 84115
P (801) 534-1130
F (801) 534-1080
www.envisioneng.com

SCLCDA NATIONAL WEATHER SERVICE TI
SALT LAKE INTERNATIONAL AIRPORT
SALT LAKE CITY, UTAH

©2023 MHTN ARCHITECTS, INC.
Confidentiality Notice:
This document is intended for use on the Project identified herein by individuals and companies involved in the design, permitting, bidding and construction of the Project. MHTN Architects, Inc. grants limited rights to distribute and reproduce this document for the express purpose only. Distribution, printing or copying this document for purposes other than those indicated is strictly prohibited. If a digital copy of this document is received in error, please delete it.

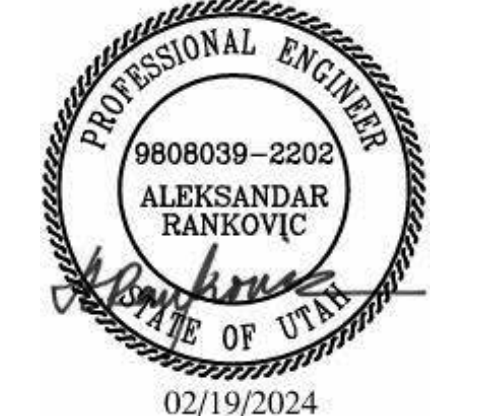

02/19/2024
MHTN PROJECT NO 2023573

Original drawing is 24 x 36. Do not scale contents of this drawing.

NO.	DATE	DESCRIPTION

REVISIONS
CONTRACTOR TO VERIFY DRAWINGS IN FIELD USE REFLECT LAST REVISION DATE.

NO.	DATE	DESCRIPTION
1	05/17/2024	ADDENDUM 1

CONSTRUCTION DOCUMENTS - BID SET
MAY 02, 2024

SHEET NAME
FLOOR PLAN - POWER AND SYSTEMS

SHEET NUMBER
EP101