
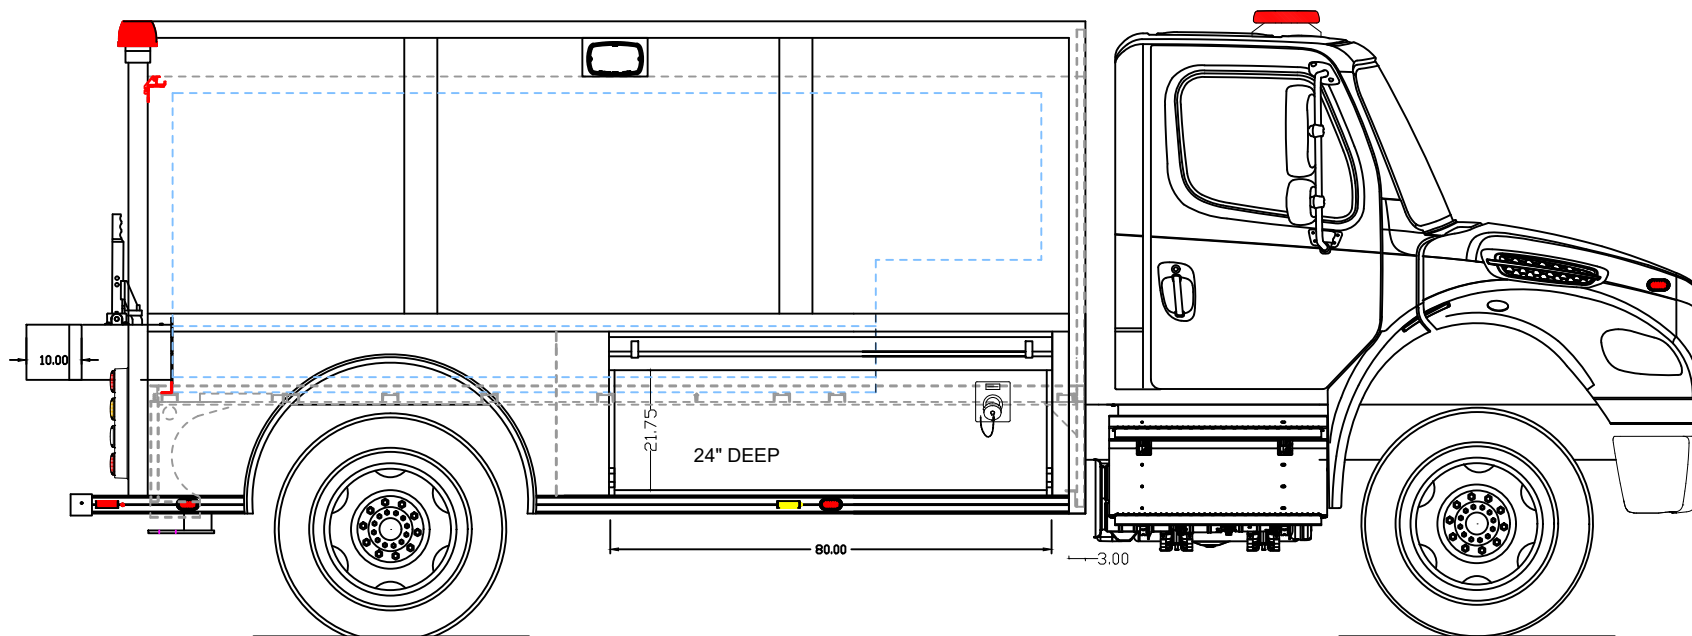
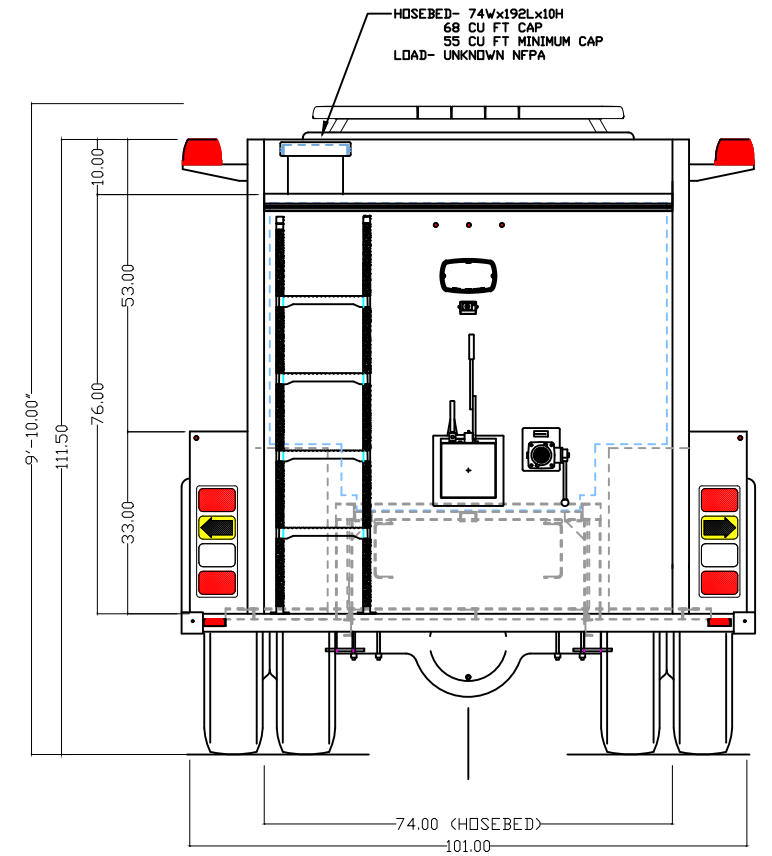


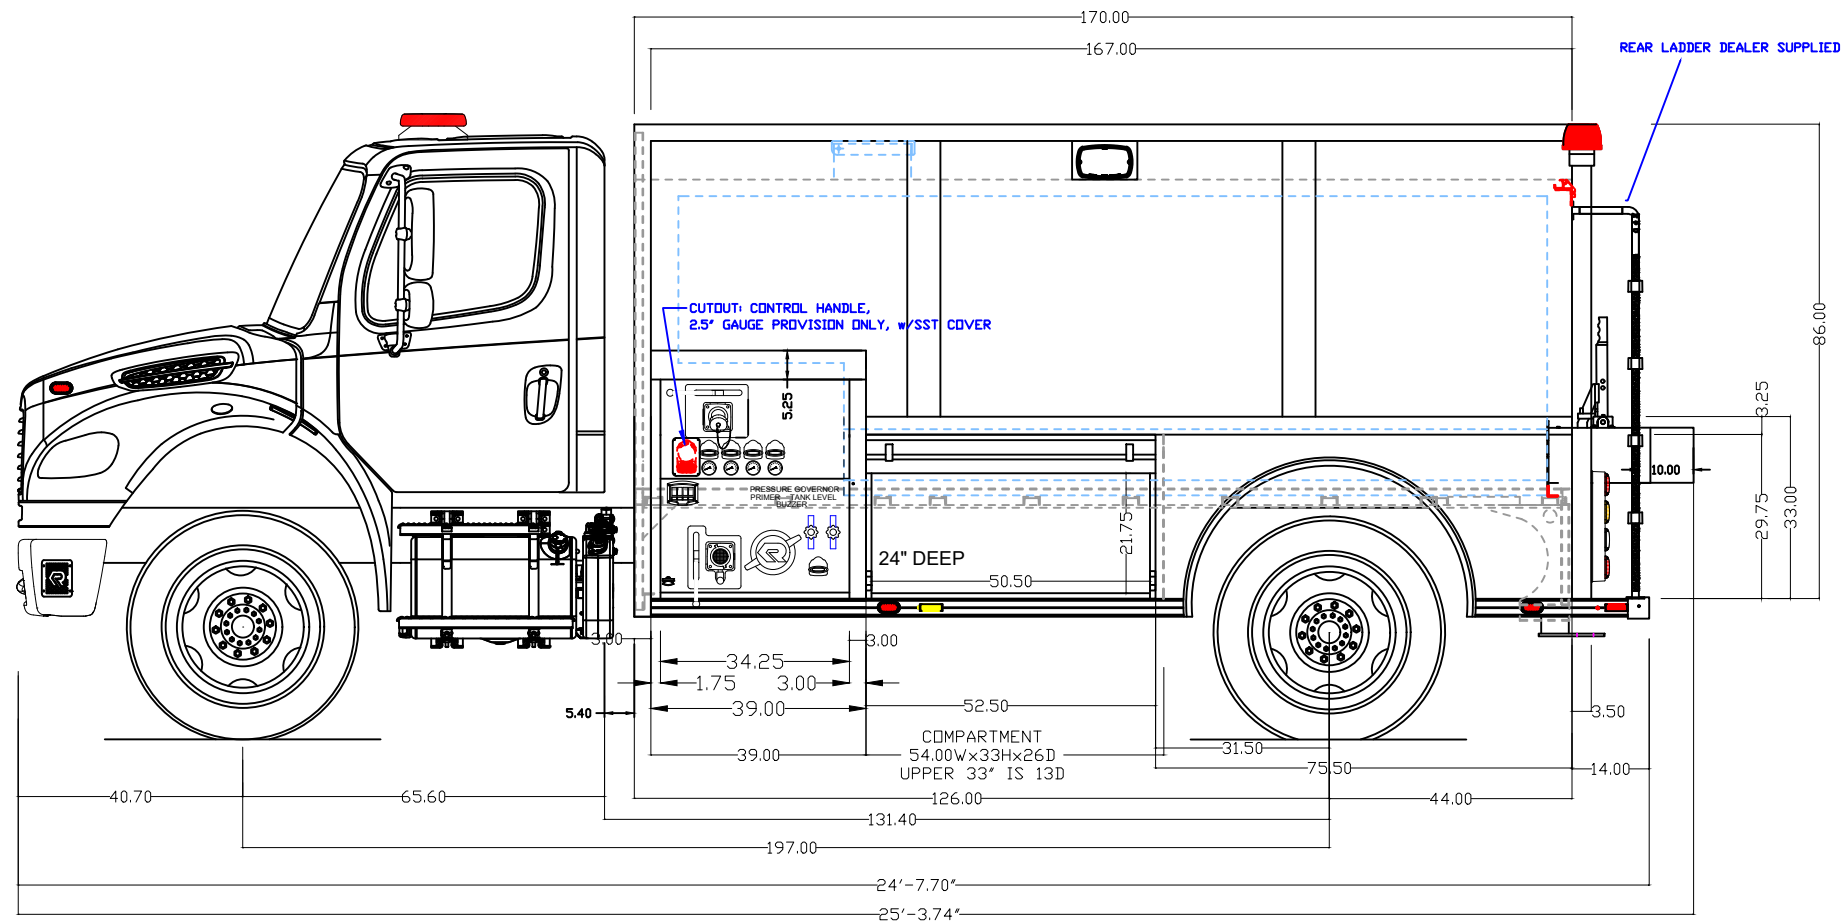

INITIALS: EH
JOB NUMBER: 22543
DATE: 8/12/2025

PRODUCTION APPROVED

- NOTES:
- OVERALL HEIGHT IS IN LOADED CONDITION. UNLOADED HEIGHTS MAY BE 4" ABOVE HEIGHTS SHOWN.
 - DO NOT SCALE DRAWING.
 - ALL DIMENSIONS ARE APPROXIMATE AND SUBJECT TO ENGINEERING CHANGES.
 - DRAWING MAY OR MAY NOT SHOW ALL ITEMS AS DESCRIBED IN THE WRITTEN DETAIL SPECIFICATIONS.
 - INCLUSION OF AN ITEM ON THE DRAWING DOES NOT CONSTITUTE INCLUSION OF THAT ITEM WITH THE FINAL DELIVERED UNIT.

REV 5:	EH	DATE: 8-12-25	RELEASED
REV 2:	MJ	DATE: 6-25-25	MARKED UP DRAWING
REV 1:	MHA	DATE: 5-6-25	PRECON SCRUB
DRAWN:	MJ	DATE: -	

PROPRIETARY AND CONFIDENTIAL
THE INFORMATION CONTAINED IN THIS DRAWING IS
THE SOLE PROPERTY OF ROSENBAUER. ANY
REPRODUCTION IN PART OR AS A WHOLE WITHOUT
THE WRITTEN PERMISSION OF ROSENBAUER IS
PROHIBITED.

APPROVED BY:

MAXIMUM HEIGHT	NONE
MAXIMUM LENGTH	NONE
BODY WIDTH	101"

CHASSIS: FREIGHTLINER 2DR

PUMP: WATEROUS CGVK 750 GPM

TANK: 2000 / - FOAM

HEIMAN STOCK
WK236 TANKER



ROSENBAUER FX 1/8"

JOB NUMBER	DRAWING NUMBER	REV
22543	2214-D	5