
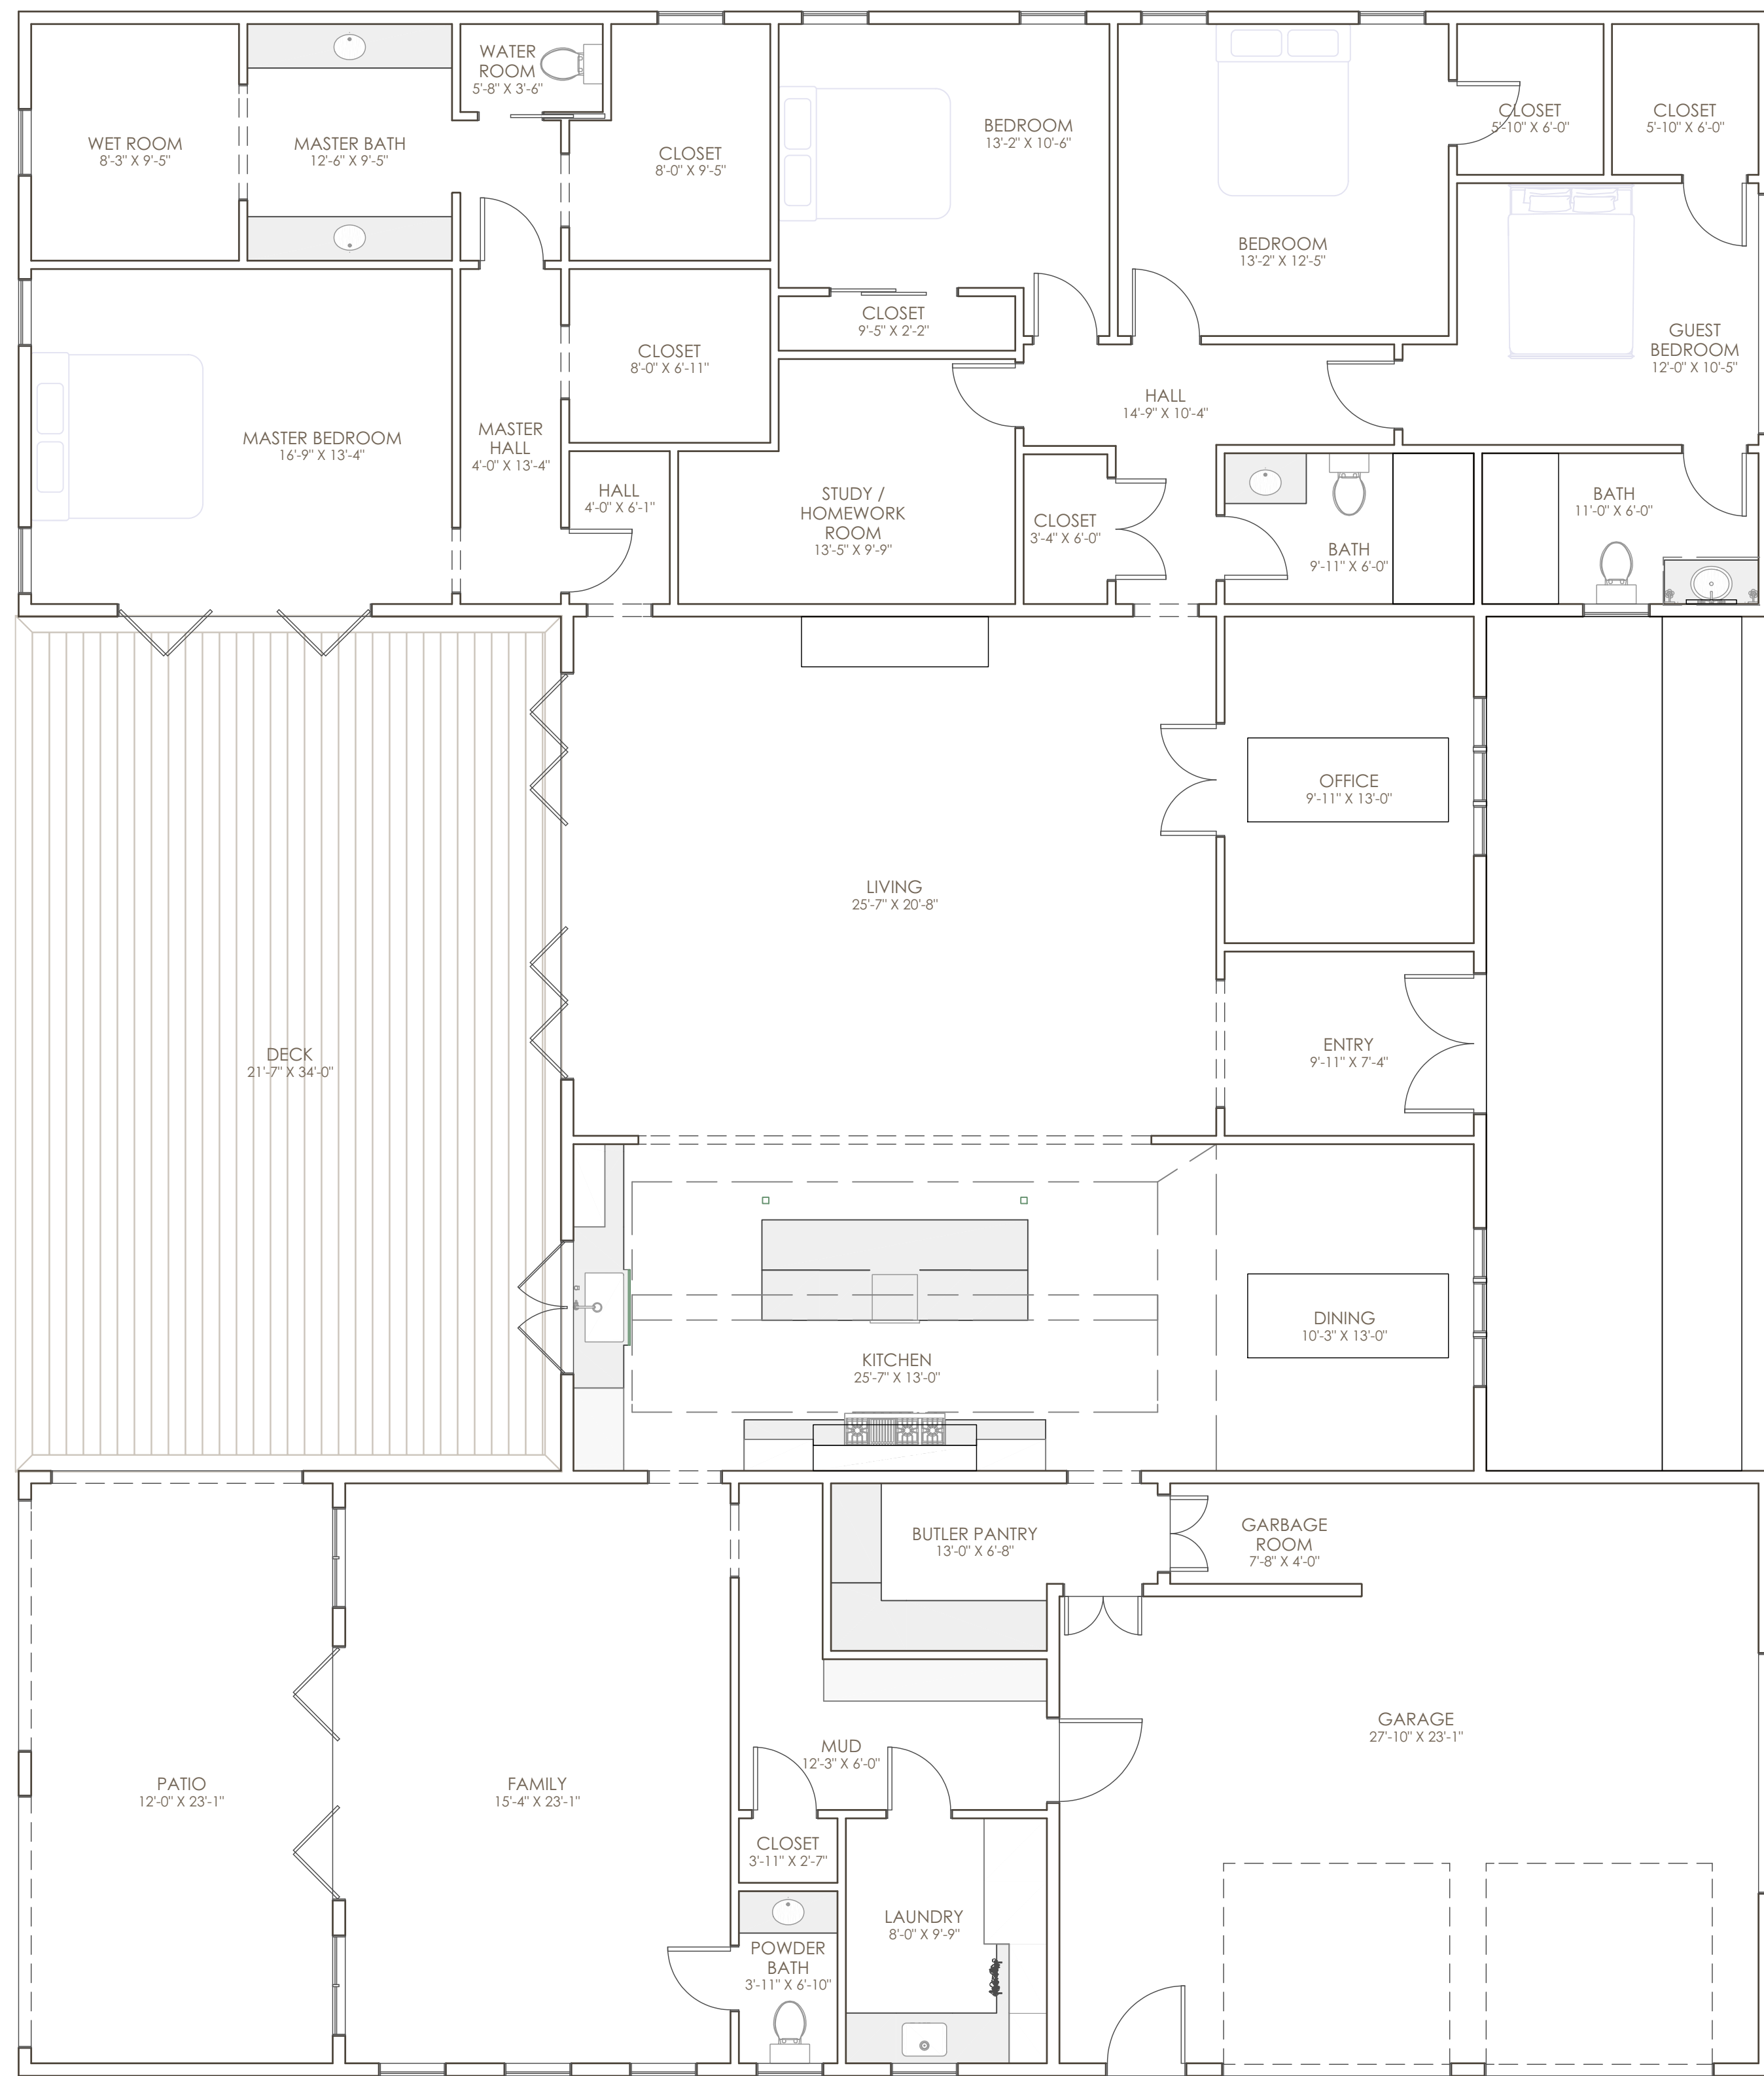


TABLE OF CONTENTS

PAGE	TITLE
1	BEFORE / AFTER FLOOR PLAN
2	REDLINE NOTES AND DESCRIPTIONS
3	EXTERIOR ELEVATION
4	ROOM SCHEDULE

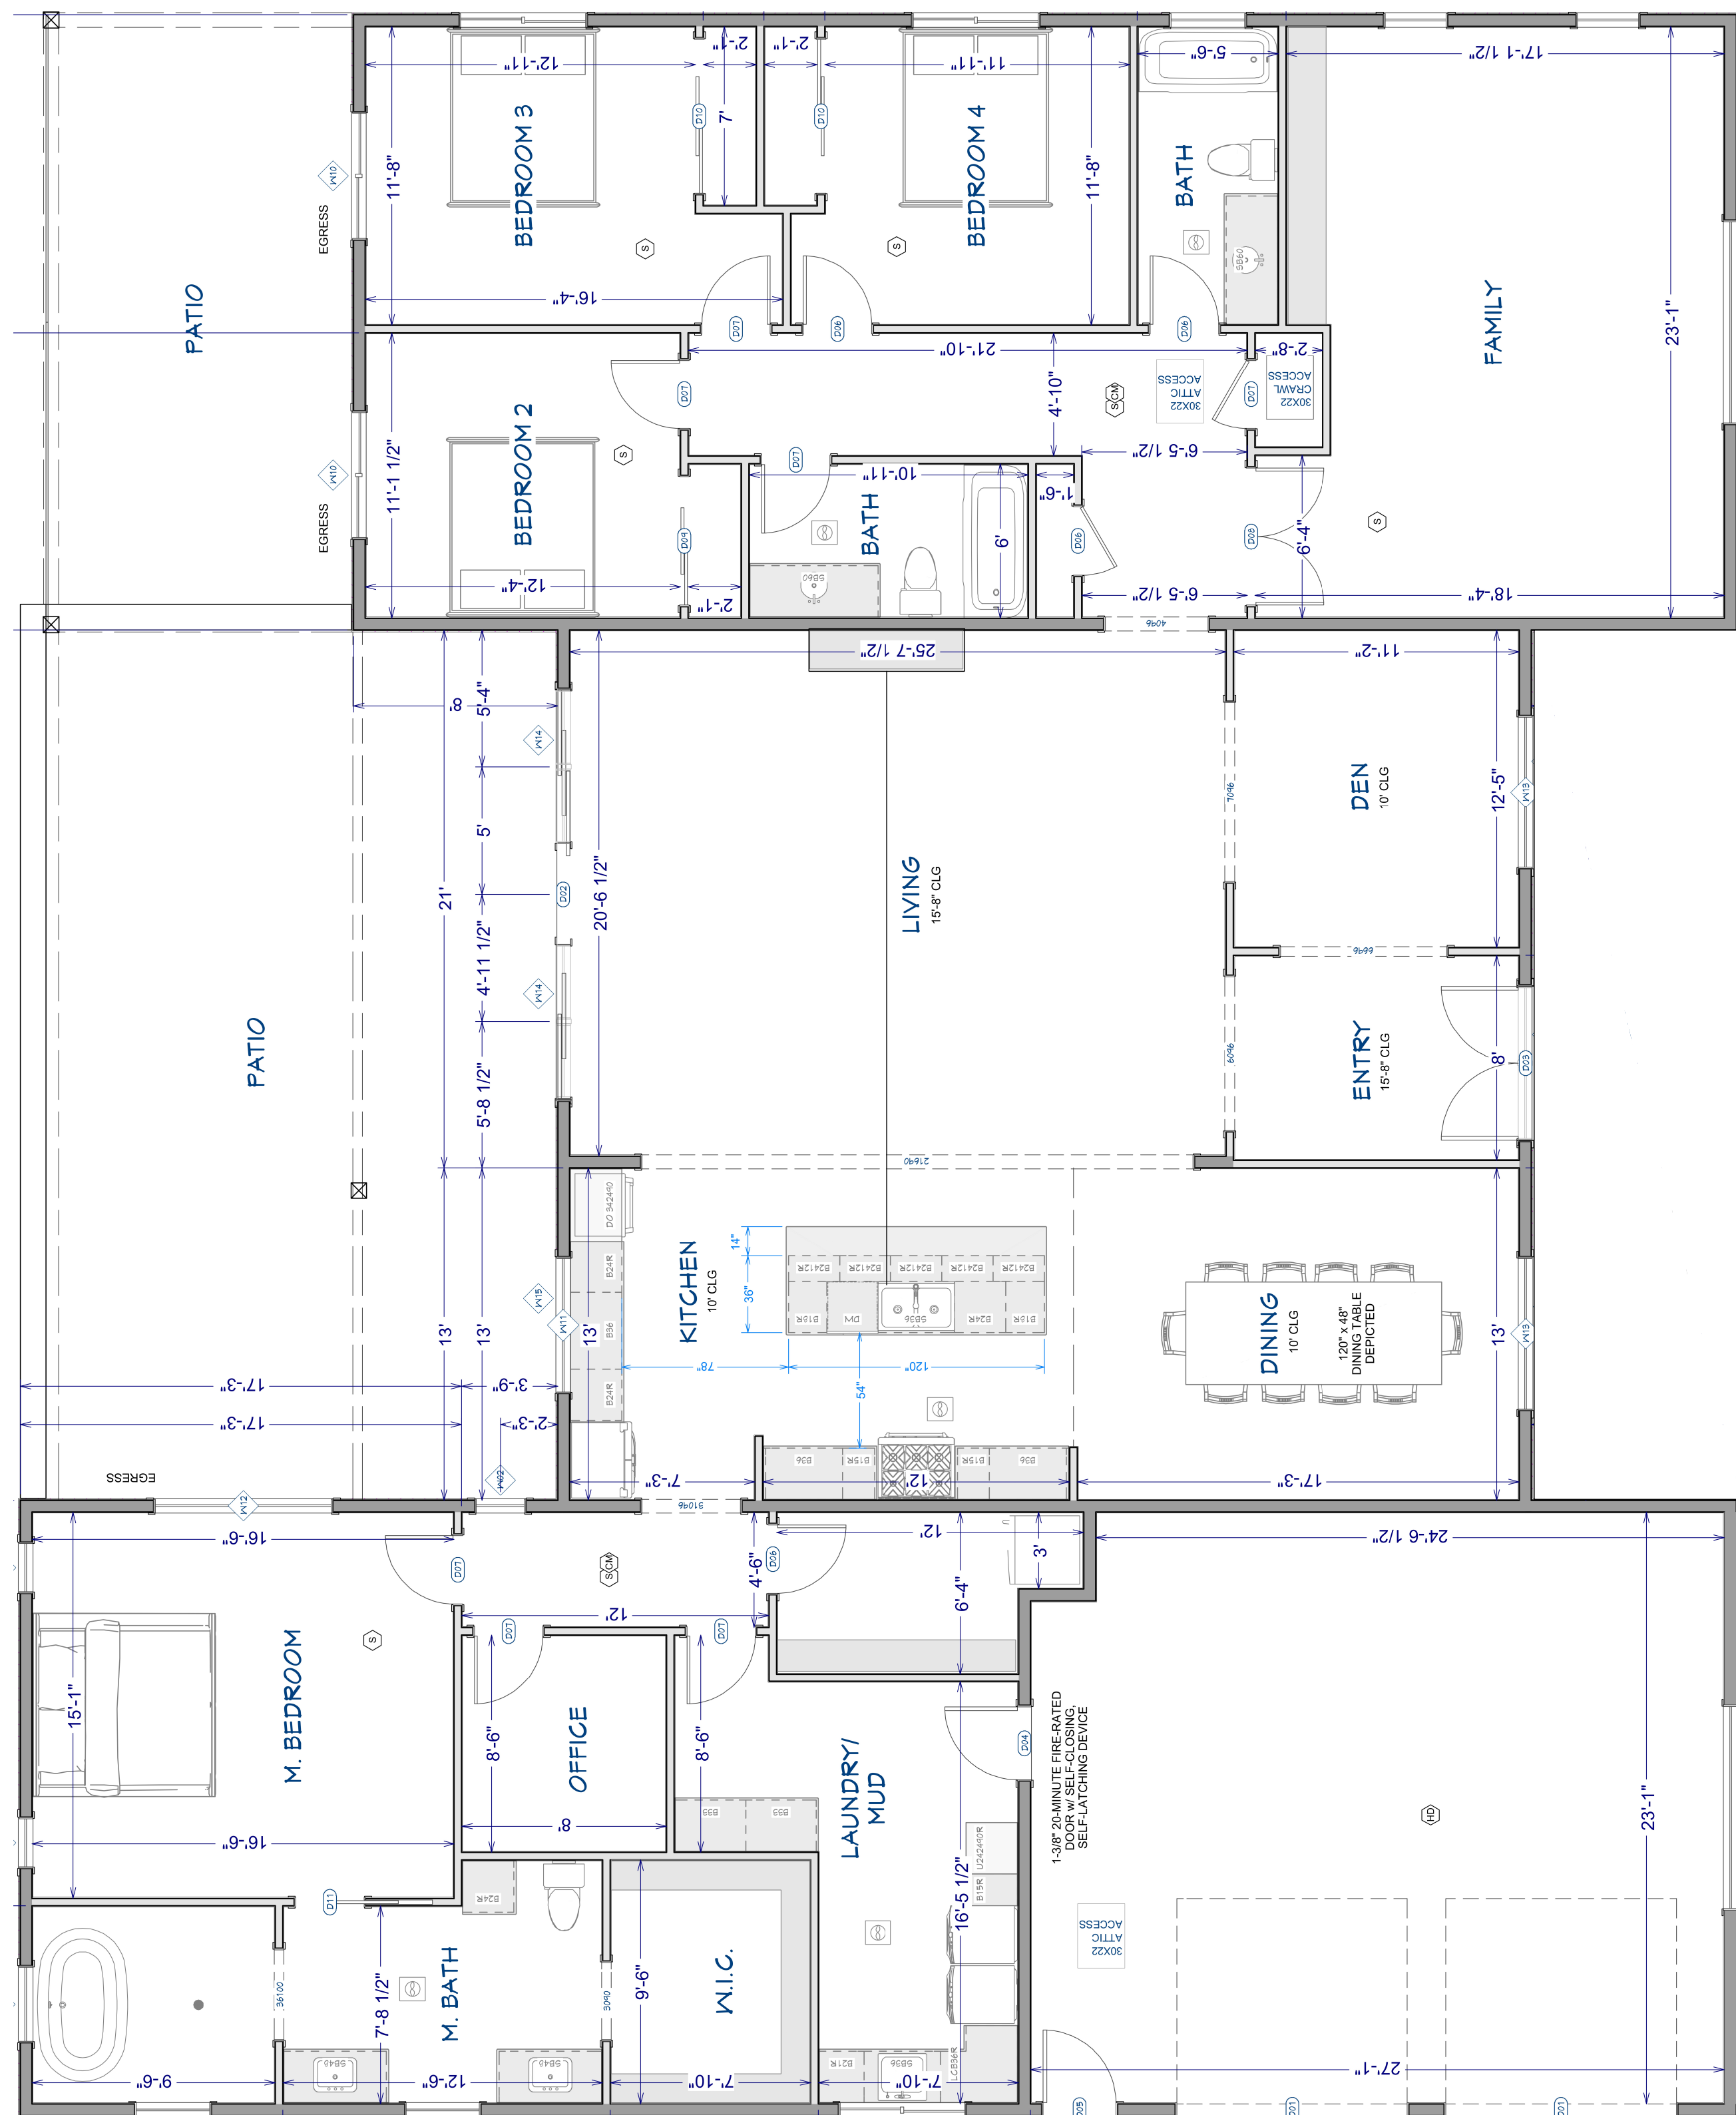

FLOOR PLAN COMPARISON VIEW
1/5 IN = 1 FT


BEFORE / AFTER FLOOR PLAN

CLIENT:

DRAWINGS PROVIDED BY:
M.D.S.

SHEET SIZE: ARCH D (24" X 36")
PAGE: 1
DATE: 5/1/2026

DISCLAIMER:
All dimensions, designations, and extents are subject to site verification prior to the commencement of work by the contractor. These drawings and associated design materials are the intellectual property of the designer and are protected by copyright law. They may not be reproduced, distributed, published, or used in whole or in part without the express written consent of the designer. All designs, drawings, mood boards, renderings, and visualizations are conceptual representations intended to illustrate the design intent. Actual materials, finishes, colors, furnishings, and dimensions may vary due to site conditions, product availability, manufacturing variations, and contractor execution. The designer is not responsible for construction means and methods, structural integrity, code compliance, or the performance of contractors, subcontractors, suppliers, or vendors. All measurements, installation details, and construction conditions must be verified by the appropriate licensed professionals prior to fabrication or installation. By proceeding with the design, the client acknowledges that all drawings and visualizations are artistic interpretations of the proposed design and that minor variations between renderings and the final installed result are to be expected.

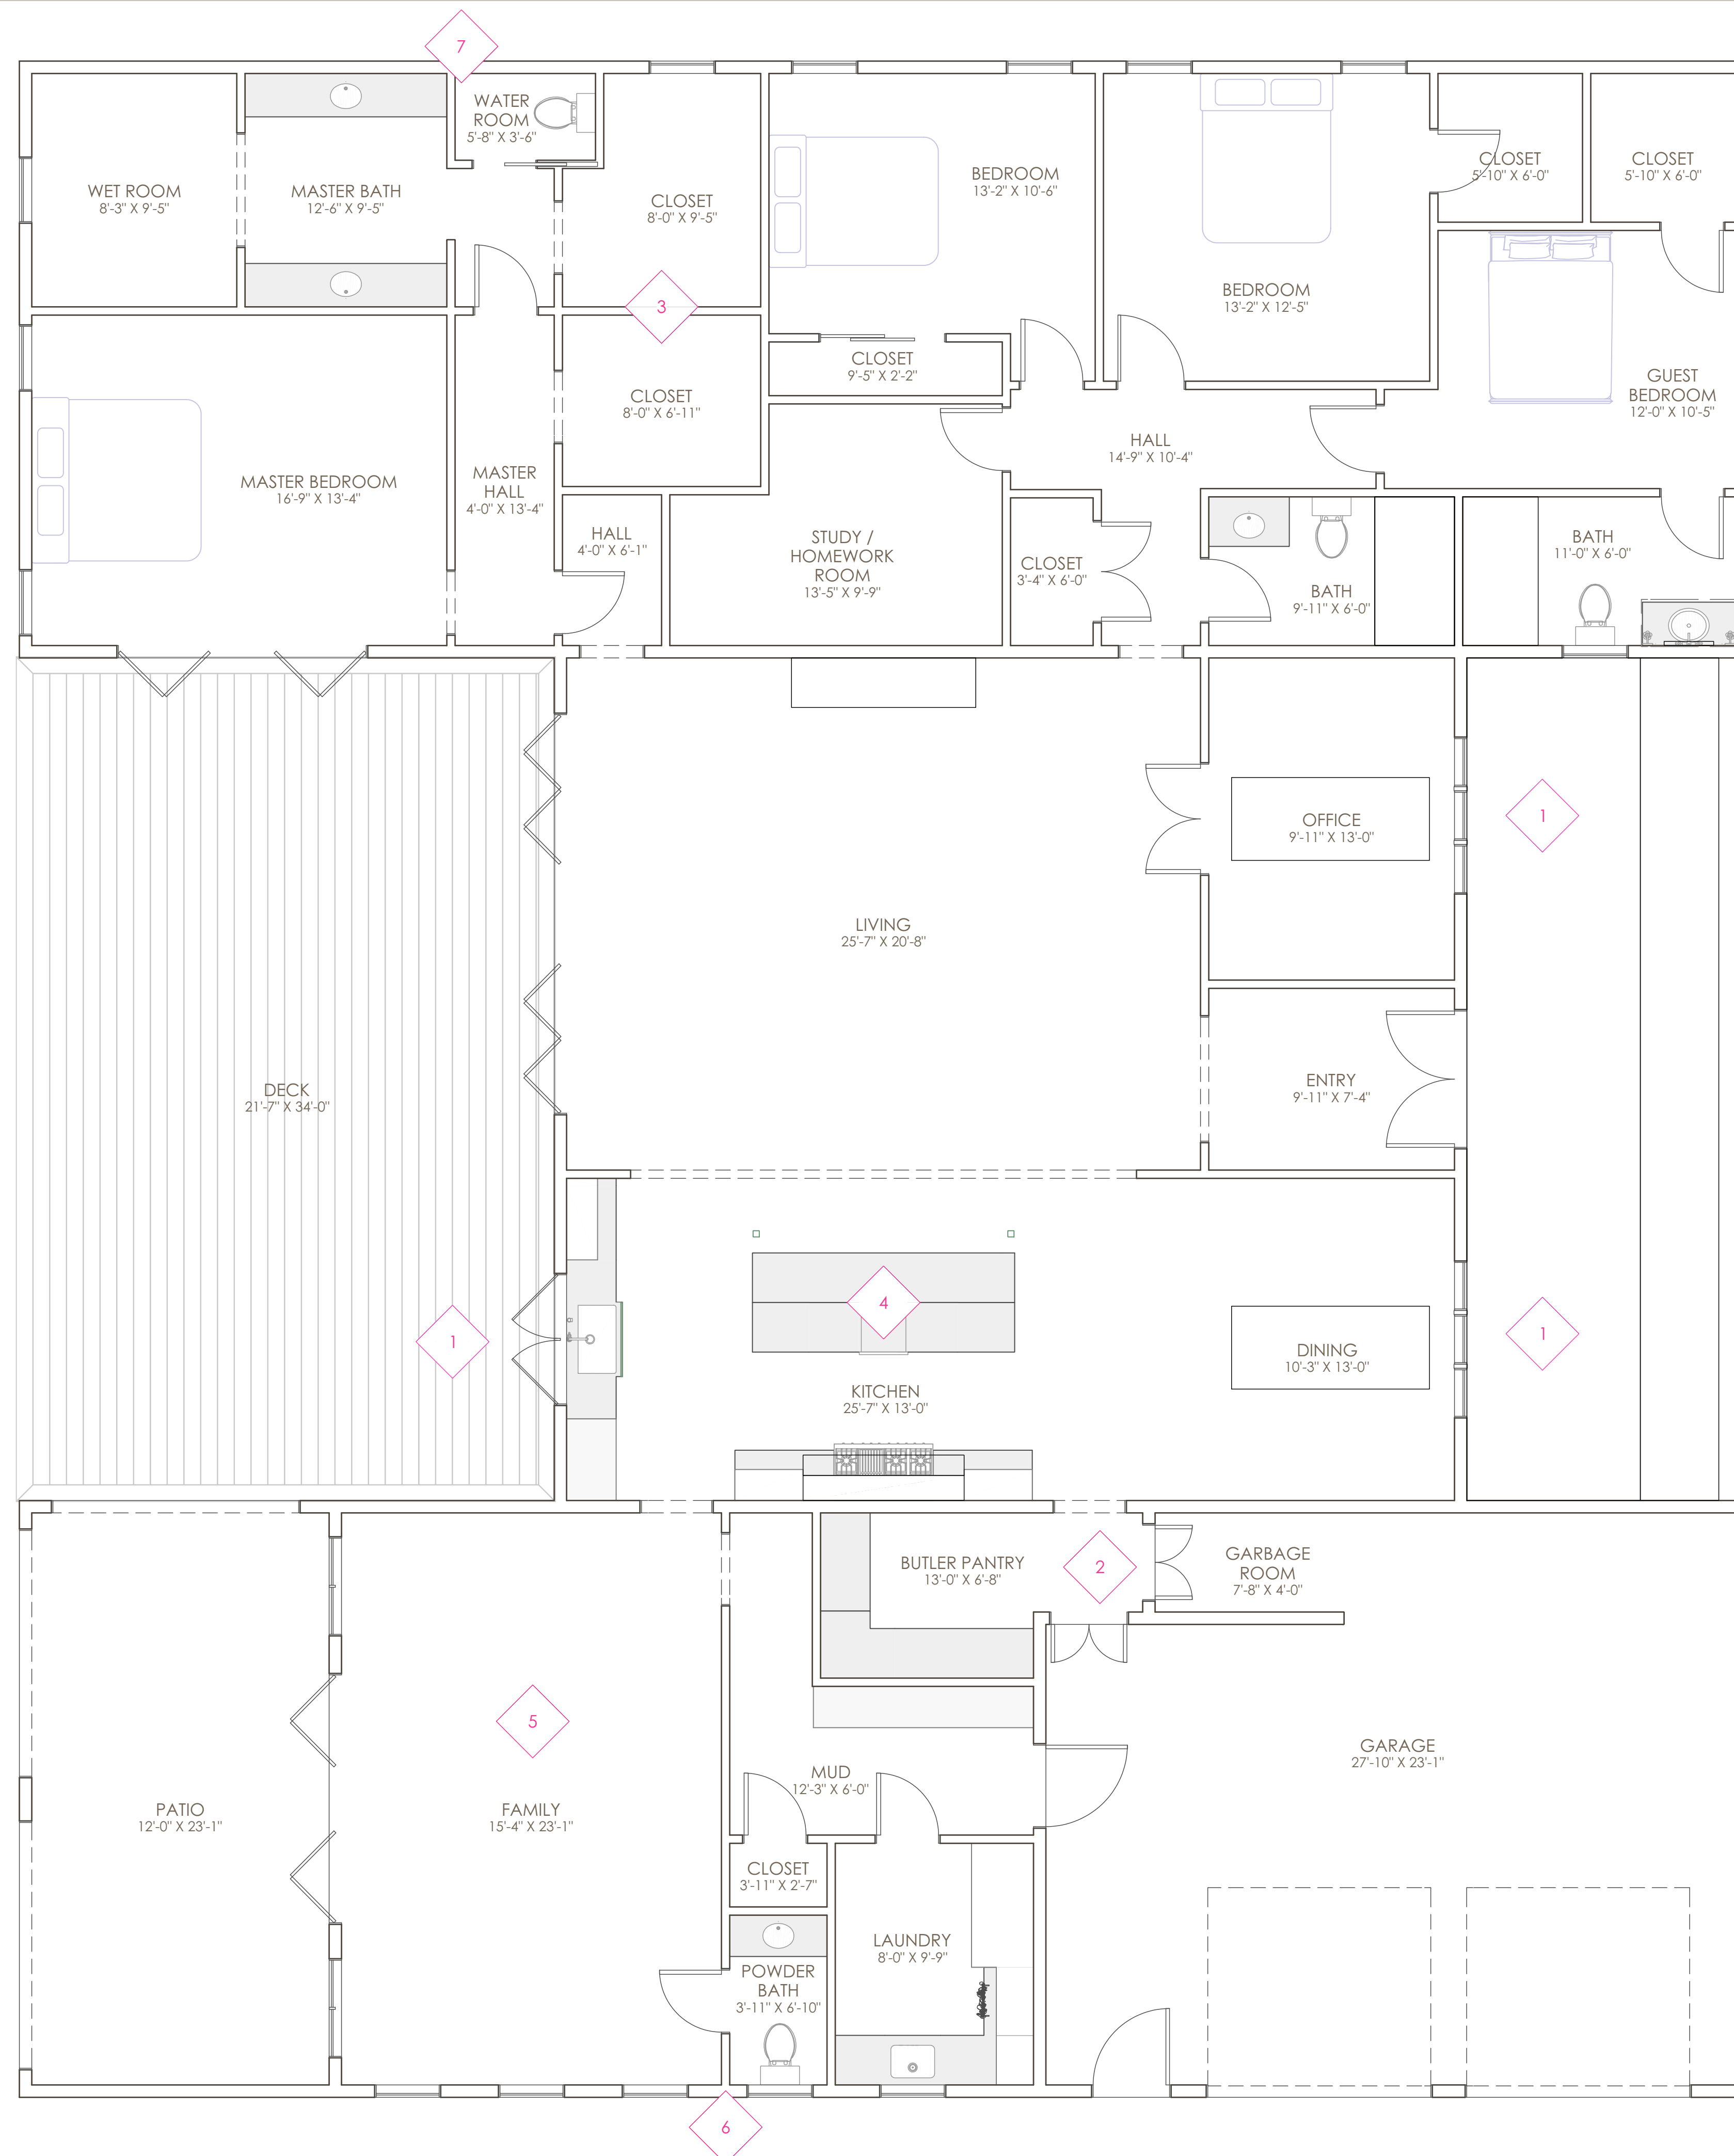

MAJOR CHANGES NOTES	
1	ADJUSTED WINDOW PLACEMENT TO ACHIEVE PROPER ALIGNMENT WITH ROOM
2	INCORPORATED A GARBAGE CHUTE AND ADDED A PASS-THROUGH GROCERY WINDOW CONNECTING THE PANTRY TO THE GARAGE
3	HIS AND HER CLOSETS
4	RECONFIGURED KITCHEN LAYOUT TO ALIGN WITH FIREPLACE
5	RELOCATED THE FAMILY ROOM TO THE WEST WING TO PROVIDE DIRECT ACCESS TO THE PATIO
6	ADDED A POWDER ROOM FOR GUEST USE AND CONVENIENT ACCESS FROM THE BACKYARD
7	INCLUDED A PRIVATE WATER CLOSET

FLOOR PLAN VIEW SHELL
1/4 IN = 1 FT

TABLE OF CONTENTS

PAGE	TITLE
1	BEFORE / AFTER FLOOR PLAN
2	REDLINE NOTES AND DESCRIPTIONS
3	EXTERIOR ELEVATION
4	ROOM SCHEDULE

REDLINE NOTES AND DESCRIPTIONS

CLIENT:

DRAWINGS PROVIDED BY:



SHEET SIZE:
ARCH D (24" X 36")

PAGE:

2

DATE:
5/1/2026

DISCLAIMER:
All dimensions, designations, and extents are subject to site verification prior to the commencement of work by the contractor. These drawings and associated design materials are the intellectual property of the designer and are protected by copyright law. They may not be reproduced, distributed, published, or used in whole or in part without the express written consent of the designer. All designs, drawings, mood boards, renderings, and visualizations are conceptual representations intended to illustrate the design intent. Actual materials, finishes, colors, furnishings, and dimensions may vary due to site conditions, product availability, manufacturing variations, and contractor execution. The designer is not responsible for construction means and methods, structural integrity, code compliance, or the performance of contractors, subcontractors, suppliers, or vendors. All measurements, installation details, and construction conditions must be verified by the appropriate licensed professionals prior to fabrication or installation. By proceeding with the design, the client acknowledges that all drawings and visualizations are artistic interpretations of the proposed design and that minor variations between renderings and the final installed result are to be expected.

TABLE OF CONTENTS

PAGE	TITLE
1	BEFORE / AFTER FLOOR PLAN
2	REDLINE NOTES AND DESCRIPTIONS
3	EXTERIOR ELEVATION
4	ROOM SCHEDULE



EXTERIOR ELEVATION

CLIENT:

DRAWINGS PROVIDED BY:



SHEET SIZE:
ARCH D (24" X 36")

PAGE:

DATE:
5/1/2026

3

DISCLAIMER:
All dimensions, designations, and extents are subject to site verification prior to the commencement of work by the contractor. These drawings and associated design materials are the intellectual property of the designer and are protected by copyright law. They may not be reproduced, distributed, published, or used in whole or in part without the express written consent of the designer. All designs, drawings, mood boards, renderings, and visualizations are conceptual representations intended to illustrate the design intent. Actual materials, finishes, colors, furnishings, and dimensions may vary due to site conditions, product availability, manufacturing variations, and contractor execution. The designer is not responsible for construction means and methods, structural integrity, code compliance, or the performance of contractors, subcontractors, suppliers, or vendors. All measurements, installation details, and construction conditions must be verified by the appropriate licensed professionals prior to fabrication or installation. By proceeding with the design, the client acknowledges that all drawings and visualizations are artistic interpretations of the proposed design and that minor variations between renderings and the final installed result are to be expected.

ROOM TYPE	ROOM NAME	QTY	AREA	DIMENSIONS
BATH	BATH	1	59.5	119"X72"
BATH	BATH	1	66	132"X72"
BATH	POWDER BATH	1	26.89	47 1/8"X82 3/16"
BEDROOM	GUEST BEDROOM	1	133.67	144"X125"
BEDROOM	BEDROOM	1	144.8	158"X126"
BEDROOM	BEDROOM	1	163.49	158"X149"
CLOSET	CLOSET	1	10.09	47 1/8"X30 13/16"
CLOSET	CLOSET	1	19.86	40"X71 1/2"
CLOSET	CLOSET	1	20.4	113"X26"
CLOSET	CLOSET	2	35	70"X72"
CLOSET	CLOSET	1	55.33	96"X83"
CLOSET	CLOSET	1	68.94	96"X113"
DECK	DECK	1	732.42	258 1/2"X408"
DINING	DINING	1	133.25	123"X156"
ENTRY	ENTRY	1	72.72	119"X88"
FAMILY	FAMILY	1	353.96	184"X277"
GARAGE	GARAGE	1	588.09	333 7/8"X277"
GARAGE	GARBAGE ROOM	1	30.5	91 1/2"X48"
HALL	HALL	1	24.33	48"X73"
HALL	HALL	1	84.49	177"X124"
KITCHEN	KITCHEN	1	332.58	307"X156"
LAUNDRY	MUD	1	96.9	147 1/8"X72"
LAUNDRY	LAUNDRY	1	78	96"X117"
LIVING	LIVING	1	528.72	307"X248"
MASTER BATH	MASTER BATH	1	99.99	149 3/4"X113"
MASTER BATH	WATER ROOM	1	19.83	68"X42"
MASTER BATH	WET ROOM	1	77.89	99 1/4"X113"
MASTER BEDROOM	MASTER BEDROOM	1	223.33	201"X160"
MASTER BEDROOM	MASTER HALL	1	53.33	48"X160"
OFFICE	OFFICE	1	128.92	119"X156"
PANTRY	BUTLER PANTRY	1	74.91	156"X80"
PATIO	PATIO	1	277	144"X277"
STUDY	STUDY / HOMEWORK ROOM	1	116.15	161"X117"
TOTALS:			4966.28	

TABLE OF CONTENTS

PAGE	TITLE
1	BEFORE / AFTER FLOOR PLAN
2	REDLINE NOTES AND DESCRIPTIONS
3	EXTERIOR ELEVATION
4	ROOM SCHEDULE

ROOM SCHEDULE

CLIENT:

DRAWINGS PROVIDED BY:



SHEET SIZE: ARCH D (24" X 36")

DATE: 5/1/2026

PAGE: **4**

DISCLAIMER: All dimensions, designations, and extents are subject to site verification prior to the commencement of work by the contractor. These drawings and associated design materials are the intellectual property of the designer and are protected by copyright law. They may not be reproduced, distributed, published, or used in whole or in part without the express written consent of the designer. All designs, drawings, mood boards, renderings, and visualizations are conceptual representations intended to illustrate the design intent. Actual materials, finishes, colors, furnishings, and dimensions may vary due to site conditions, product availability, manufacturing variations, and contractor execution. The designer is not responsible for construction means and methods, structural integrity, code compliance, or the performance of contractors, subcontractors, suppliers, or vendors. All measurements, installation details, and construction conditions must be verified by the appropriate licensed professionals prior to fabrication or installation. By proceeding with the design, the client acknowledges that all drawings and visualizations are artistic interpretations of the proposed design and that minor variations between renderings and the final installed result are to be expected.