


Deputy Director of
Town Planning Dept.
Pimpri - Chinchwad, M.P.L.
Corporation, Pimpri, Pune-411 018

Commissioner
Pimpri-Chinchwad Municipal Corporation
Pimpri - 411 018


Modification Proposed u/s 37 of M.R.T.P. Act, 1966 as per General Body
Resolution No. 307, Dated 27/6/2013.
(Notice No. TPS/WS/10/632/2014, Dated:- 6/1/2014)

Flood Lines

- 25 years Blue Flood line,
- 100 years Red Flood line.

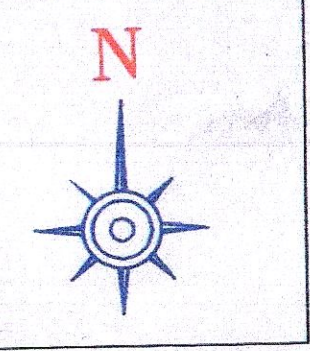

SCALE 1:5000

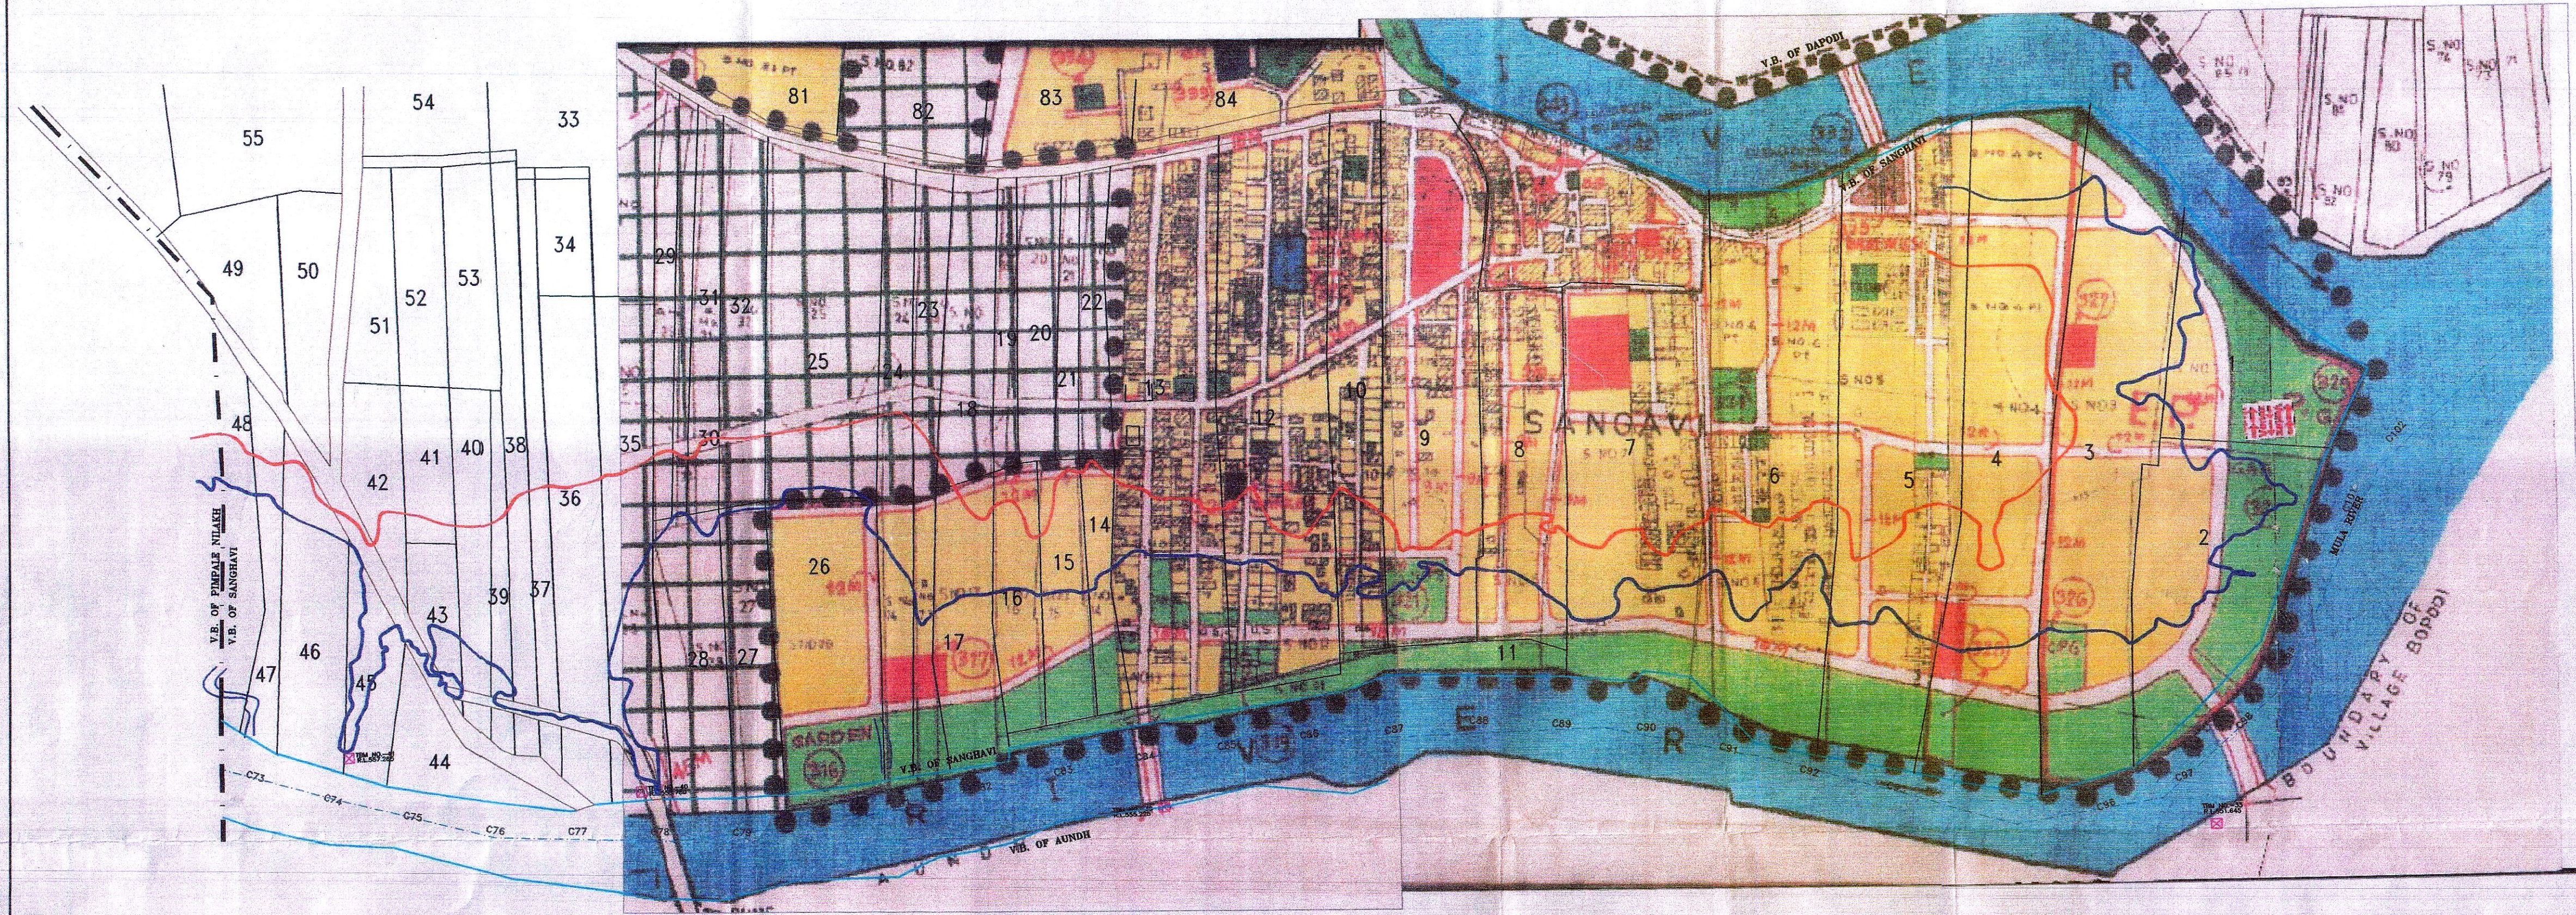

NOTE :

- 1) H.F.L. (Blue line & Red line) in respect of Mula River is marked on D.P. Drawings received from P.C.M.C.
- 2) Further village maps are superimposed on the D.P. drawings. However, there seems to be variations in case of certain portions of villages as appear in D.P. drawings.
- 3) For the sake of accuracy, data contained in village maps obtained from D.L.R. may be considered for all practical purposes.

25 Years line BLUE LINE
100 Years line RED LINE

GOVERNMENT OF MAHARASHTRA			
WATER RESOURCES DEPARTMENT			
PUNE IRRIGATION CIRCLE PUNE			
PUNE IRRIGATION DIVISION , PUNE			
NAME OF WORK: COMPUTATION OF H.F.L. & HYDRAULIC STUDY OF MULA RIVER MARKING OF BLUE & RED LINE VILLAGE : SANGHAVI			
DRAWN BY			
CHECKED BY	SUB DIVISIONAL ENGINEER Shadalwasa Canal Sub-Divn No-2, Pune.	EXECUTIVE ENGINEER, Pune Irrigation Division Pune	SUPERINTENDING ENGINEER Pune Irrigation Circle PUNE
SCALE:- 1:5000			